

**STATE OF HAWAII  
DEPARTMENT OF TRANSPORTATION  
HIGHWAYS DIVISION**

**ADDENDUM NO. 5  
for  
FARRINGTON HIGHWAY WIDENING  
KAPOLEI GOLF COURSE ROAD TO FORT WEAVER ROAD  
PROJECT NO. 7101A-01-20**

The following amendments shall be made to the Bid Documents:

**A. SPECIAL PROVISIONS**

1. Replace Table of Contents dated 06/08/22 with attached Table of Contents dated r07/21/22.
2. Replace Special Provision Section 201 – Clearing and Grubbing dated 11/25/20 with attached Special Provision Section 201 – Clearing and Grubbing dated r07/21/22.
3. Replace Special Provision Section 203 – Excavation and Embankment dated 06/08/22 with attached Special Provision Section 203 – Excavation and Embankment dated r07/21/22.
4. Replace Special Provision Section 204 – Excavation and Backfill for Miscellaneous Facilities dated r06/08/22 with attached Section 204 – Excavation and Backfill for Miscellaneous Facilities dated r07/26/22.
5. Add Special Provision Section 316 – Polypropylene Biaxial Geogrid dated 07/21/22.
6. Replace Special Provision Section 401 – Hot Mix Asphalt (HMA) Pavement dated 06/08/22 with attached Special Provision Section 401 – Hot Mix Asphalt (HMA) dated r07/21/22.
7. Replace Special Provision Section 503 – Concrete Structures dated 06/08/22 with attached Special Provision Section 503 – Concrete Structures dated r07/21/22.
8. Replace Special Provision Section 624 – Water System dated 05/15/21 with attached Special Provision Section 624 – Water System dated r07/21/22.

9. Replace Special Provision Section 651 – Horizontal Directional Drilling dated 04/14/22 with attached Special Provision Section 651 – Horizontal Directional Drilling dated r07/21/22.
10. Add Special Provision Section 652 – Pilot Tube Microtunneling dated 07/21/22.
11. Replace Special Provision Section 660 – Gas System dated 09/24/21 with attached Special Provision Section 660 – Gas System dated r07/26/22.
12. Replace Special Provision Section 675 – Mass Concrete dated 04/14/22 with attached Special Provision Section 675 – Mass Concrete dated r07/21/22.
13. Replace Special Provision Section 680 – Electric and Communication Systems dated 04/19/22 with the attached Special Provision Section 680 – Electric and Communication Systems dated r07/22/22.

**B. PROPOSAL**

1. Replace Proposal page P-4 dated 3/3/2021 with Proposal page P-4 dated r7/26/2022
2. Replace Proposal pages P-11 to P-47 dated r06/08/2022 with Proposal Pages P-11 to P-46 dated r07/22/2022.

**C. PLANS**

1. Replace Civil Plan Sheets C-5, C-6, C-12, C-13, C-15, C-20, C-27, C-31 to C-41, C-53, C-60, C-63, C-65, C-68, C-77, C-81, C-85, C-87, C-95, C-98, C-101, C-103, C-116, C-117, C-120 to C-C-124, C-127, C-129 to C-136, C-140, C-142, C-146, C-149, C-151, C-152, C-154 to C-160, C-162, C-165, C-168 to C-178, C-181, C-182, C-195, C-207, C-208 to C-211, C-222 to C-233, C-236, C-244, C249, C-250, CP-1, CP-2, CP-3, CP-4 dated 06/08/2022 with the attached Civil Plan Sheets C-5, C-6, C-12, C-13, C-15, C-20, C-27, C-31 to C-41, C-53, C-60, C-63, C-65, C-68, C-77, C-81, C-85, C-87, C-95, C-98, C-101, C-103, C-116, C-117, C-120 to C-C-124, C-127, C-129 to C-136, C-140, C-142, C-146, C-149, C-151, C-152, C-154 to C-160, C-162, C-165, C-168 to C-178, C-181, C-182, C-195, C-207, C-208 to C-211, C-222 to C-233, C-236, C-244, C249, C-250, CP-1, CP-2, CP-3, CP-4 dated 07/15/2022.



2. Replace Structural Plan Sheets S0.4, SA1.1, SA1.2, SA2.4, SA2.6, SA7.1 to SA7.13, SA7.16, SA7.18, SA8.1 to SA8.4, SA11.2, SA13.1, SA13.2, SB2.4, SB5.2, SB12.2 to SB12.4, SC2.5 to SC2.8, SC2.18, SC2.20, SC3.01, SC3.18, SC2.20, SC3.1, SC3.18, SC3.19, SD2.1, SD3.2, SD3.4, SD4.2, SD5.3 dated 06/08/2022 with the attached Structural Plan Sheets S0.4, SA1.1, SA1.2, SA2.4, SA2.6, SA7.1 to SA7.13, SA7.16, SA7.18, SA8.1 to SA8.4, SA11.2, SA13.1, SA13.2, SB2.4, SB5.2, SB12.2 to SB12.4, SC2.5 to SC2.8, SC2.18, SC2.20, SC3.01, SC3.18, SC2.20, SC3.1, SC3.18, SC3.19, SD2.1, SD3.2, SD3.4, SD4.2, SD5.3 dated 07/15/2022.
3. Replace Electrical Plan Sheets EA-1, EA-2, EA-6, EB-04, EB-14, EB-15, EB-19, EB-25, ED-01, ED-02, ED-06, ED-24, ED-32, ED-33, ED-34, EE-14, EE-17, EF-19, EG-01, EK-02, EK-05, EL-05, EL-06, EM-04, EM-05 dated 06/08/2022 with the attached Electrical Plan Sheets EA-1, EA-2, EA-6, EB-04, EB-14, EB-15, EB-19, EB-25, ED-01, ED-02, ED-06, ED-24, ED-32, ED-33, ED-34, EE-14, EE-17, EF-19, EG-01, EK-02, EK-05, EL-05, EL-06, EM-04, EM-05 dated 07/15/2022.
4. Add the attached Civil Plan Sheet C-179 dated 07/15/22.
5. Add the attached Structural Plan Sheets SD3.5 and SD3.6 dated 07/15/22.

**D. ANSWERS TO QUESTIONS FROM PROSPECTIVE BIDDERS**

1. Attached are RFIs and responses for your information.

Please acknowledge receipt of this Addendum No. 5 by recording the date of its receipt in the space provided on page P-4 of the Proposal.



---

Jade T. Butay  
Director of Transportation

## TABLE OF CONTENTS

Notice to Bidders

Instructions for Contractor's Licensing

Special Provisions Title Page

Special Provisions

<b>DIVISION 100 - GENERAL PROVISIONS</b>		
<b>Section</b>	<b>Description</b>	<b>Pages</b>
101	Terms, Abbreviations, and Definitions	101-1a – 101-12a
102	Bidding Requirements and Conditions	102-1a – 102-14a
103	Award and Execution of Contract	103-1a – 103-5a
104	Scope of Work	104-1a – 104-2a
105	Control of Work	105-1a – 105-3a
106	Material Restrictions and Requirements	106-1a
107	Legal Relations and Responsibility to Public	107-1a – 107-6a
108	Prosecution and Progress	108-1a – 108-25a
109	Measurement and Payment	109-1a – 109-2a

<b>DIVISION 200 - EARTHWORK</b>		
<b>Section</b>	<b>Description</b>	<b>Pages</b>
201	Clearing and Grubbing	201-1a – 201-2a
202	Removal of Structures and Obstructions	202-1a – 202-2a
203	Excavation and Embankment	203-1a – 203-4a
204	Excavation and Backfill for Miscellaneous Facilities	204-1a
205	Excavation and Backfill for Bridge and Retaining Structures	205-1a - 205-2a
206	Excavation and Backfill for Drainage Facilities	206-1a
207	Ditch and Channel Excavation	207-1a
209	Temporary Water Pollution, Dust, and Erosion Control	209-1a - 209-28a

<b>DIVISION 300 - BASES</b>		
<b>Section</b>	<b>Description</b>	<b>Pages</b>
301	Hot Mix Asphalt Base Course	301-1a – 301-2a
304	Aggregate Base Course	304-1a
305	Aggregate Subbase Course	305-1a
316	Polypropylene Biaxial Geogrid	316-1a – 316-2a

<b>DIVISION 400 - PAVEMENTS</b>		
<b>Section</b>	<b>Description</b>	<b>Pages</b>
401	Hot Mix Asphalt (HMA) Pavement	401-1a – 401-37a
407	Tack Coat	407-1a
411	Portland Cement Concrete Pavement	411-1a – 411-53a

<b>DIVISION 500 - STRUCTURES</b>		
<b>Section</b>	<b>Description</b>	<b>Pages</b>
503	Concrete Structures	503-1a – 503-10a
504	Prestressed Concrete Members	504-1a – 504-3a
507	Railings	507-1a
511	Drilled Shafts	511-1a – 511-27a
540	Very Early Strength Latex Modified Concrete (VESLMC)	540-1a – 540-13a

<b>DIVISION 600 - INCIDENTAL CONSTRUCTION</b>		
<b>Section</b>	<b>Description</b>	<b>Pages</b>
601	Structural Concrete	601-1a – 601-15a
602	Reinforcing Steel	602-1a
603	Culverts and Storm Drains	603-1a
607	Chain Link Fences and Gates	607-1a
614	Street Survey Monuments	614-1a
619	Planting	619-1a
621	Enhanced Vehicle Classification System	621-1a – 621-19a
622	Roadway and Sign Lighting System	622-1a – 622-2a
623	Traffic Signal System	623-1a – 623-6a
624	Water System	624-1a – 624-2a
625	Sewer System	625-1a
626	Manholes and Valve Boxes for Water and Sewer Systems	626-1a
627	Traffic Monitoring and Signal Control System	627-1a – 627-11a
629	Pavement Markings	629-1a – 629-4a
631	Traffic Control Regulatory, Warning, and Miscellaneous Signs	631-1a
634	Portland Cement Concrete Sidewalks	634-1a – 634-2a
635	E-Construction	635-1a
638	Portland Cement Concrete Curb and Gutter	638-1a – 638-2a
641	Hydro-Mulch Seeding	641-1a
645	Work Zone Traffic Control	645-1a
647	Fiber Optic Cable	647-1a – 647-8a

650	Curb Ramps	650-1a
651	Horizontal Directional Drilling	651-1a – 651-8a
652	Pilot Tube Microtunneling	652-1a – 652-13a
655	Dumped Riprap	655-1a
660	Gas System	660-1a – 660-3a
670	Glass Fiber Reinforced Polymer Rebar	670-1a – 670-3a
675	Mass Concrete	675-1a – 675-5a
680	Electric and Communication Systems	680-1a – 680-19a
695	Just in Time Training	695-1a – 695-2a
696	Field Office and Project Site Laboratory	696-1a
697	Project Web Page	697-1a – 697-2a
699	Mobilization	699-1a

<b>DIVISION 700 - MATERIALS</b>		
<b>Section</b>	<b>Description</b>	<b>Pages</b>
702	Bituminous Materials	702-1a
705	Joint Materials for Concrete Structures	705-1a
706	Concrete, Clay, and Plastic Pipe	706-1a
709	Reinforcing Steel, Wire Rope and Prestressing Steel	709-1a
712	Miscellaneous	712-1a
720	Macro-Synthetic Fibers for Concrete Sidewalk Reinforcement	720-1a
750	Traffic Control Sign and Marker Materials	750-1a – 750-2a
755	Pavement Marking Materials	755-1a
760	Roadway and Sign Lighting Systems Materials	760-1a – 760-2a
770	Traffic Signal Materials	770-1a – 770-11a

Requirements of Chapter 104, HRS  
Wages and Hours of Employees on Public Works Law

Proposal Title Page

Proposal ..... P-1 – P-10  
Proposal Schedule ..... P-11 – P-45

Surety Bid Bond

Sample Form Title Page

Contract

Performance Bond (Surety)

Performance Bond

Labor and Material Payment Bond (Surety)

Labor and Material Payment Bond

Chapter 104, HRS Compliance Certificate

Certification of Compliance for Employment of State Residents

**END OF TABLE OF CONTENTS**



47 (III) Amend **201.05 – Payment** by revising lines 170 to 179 to read as follows:

48

49 **“201.05 Payment.** The Engineer will pay for accepted pay items listed  
50 below at contract price per pay unit, as shown in the proposal schedule.  
51 Payment will be full compensation for the work prescribed in this section and the  
52 contract documents.

53

54 The Engineer will pay for the following pay items when included in the  
55 proposal schedule:

56

<b>Pay Item</b>	<b>Pay Unit</b>
-----------------	-----------------

57

Clearing and Grubbing	Acre
-----------------------	------

58

Additional Grubbing	Force Account
---------------------	---------------

59

60  
61  
62  
63 An estimated amount for force account is allocated in proposal schedule  
64 under ‘Additional Grubbing’, but actual amount to be paid will be the sum shown  
65 on accepted force account records, whether this sum be more or less than  
66 estimated amount allocated in proposal schedule. The Engineer will pay for  
67 additional grubbing requested by the Engineer that are beyond the scope of the  
68 original contract work on a force account basis. No progress payment will be  
69 authorized until the Engineer accepts additional grubbing in writing.”

70

71

72

73

74

**END OF SECTION 201**





46 (III) Amend **203.04 – Measurement** by revising lines 345 to 366 to read as  
47 follows:

48

49 **“203.04 Measurement.**

50

51 (A) The Engineer will measure roadway excavation per cubic yard.  
52 The Engineer will compute quantities of roadway excavation by average  
53 end area method and centerline distances. Curvature correction will not  
54 be applied to quantities within roadway prism, as indicated in the contract  
55 documents. In computing excavation quantities from outside the roadway  
56 prism, where roadway centerline is used as a base, curvature correction  
57 will be applied when centerline radius is 1,000 feet or less.

58

59 When roadway excavation quantities by average end area method  
60 cannot be computed due to the nature of a particular operation or changed  
61 conditions, the Engineer will determine and use computation method that  
62 will produce an accurate quantity estimate.

63

64 (B) The Engineer will measure imported borrow per cubic yard in  
65 accordance with the contract documents. The Engineer will compute  
66 quantities of imported borrow incorporated into the work on a volume  
67 basis, using average end area method in place at work site.

68

69 (B) The Engineer will only measure over excavation, moisture  
70 conditioning and recompaction when requested by the Engineer on a force  
71 account basis in accordance with Subsection 109.06 – Force Account  
72 Provisions and Compensation.”

73

74 (III) Amend **203.05 – Payment** by revising lines 368 to 457 to read as follows:

75

76 **“203.05 Payment.** The Engineer will pay for the accepted pay items listed  
77 below at the contract price per pay unit, as shown in the proposal schedule.  
78 Payment will be full compensation for the work prescribed in this section and the  
79 contract documents.

80

81 The Engineer will pay for each of the following pay items when included in  
82 the proposal schedule:

83

Pay Item	Pay Unit
Roadway Excavation	Cubic Yard

87

88 The Engineer will pay for:

89

90 (1) 15 percent of the contract bid price upon completion of  
91 obliterating old roadways and hauling.

92  
93  
(2) 30 percent of the contract bid price upon completion of preparing subgrade.

(3) 40 percent of the contract bid price upon completion of placing selected material in final position, rounding of slopes, and using water for compaction.

(4) 15 percent of the contract bid price upon completion of disposing of surplus excavation material.

Imported Borrow

Cubic Yard

The Engineer will pay for accepted quantities of subexcavation, as roadway excavation at the contract unit price per cubic yard, when ordered by the Engineer, for work prescribed in Subsection 203.03(A)(4) – Subexcavation. Payment will be full compensation for the work prescribed therein and in the contract documents.

The Engineer will pay for accepted quantities of unlined gutter excavation as roadway excavation at the contract unit price per cubic yard, when gutter is located as follows: within median area of a divided highway; and between roadbed shoulder and adjacent cut slope. Payment will be full compensation for removing and disposing of excavated material; backfilling and compacting; and for the work prescribed in the contract documents.

The Engineer will not pay for stockpiling selected material, placing selected material in final position, or placing selected material in windrows along tops of roadway slopes for erosion control work, separately and will consider the cost as included in the unit prices for the various excavation contract pay items. The cost is for work prescribed in this section and the contract documents.

The Engineer will not pay for overhaul separately and will consider the cost as included in the unit prices for the various excavation contract pay items. The cost is for work prescribed in this section and the contract documents.

The Engineer will not pay for embankment separately and will consider the cost as included in the unit price for roadway excavation. The cost is for work prescribed in this section and the contract documents.

The Engineer will not pay for Non-Woven Geotextile Fabric (Mirafi 180N or approved equal) separately and will consider the cost as included in the unit price for roadway excavation. The cost is for work prescribed in this section and the contract documents.

138  
139  
Over Excavation, Moisture Condition and Recompaction                      Force Account

An estimated amount for force account is allocated in proposal schedule under 'Additional Grubbing', but actual amount to be paid will be the sum shown on accepted force account records, whether this sum be more or less than estimated amount allocated in proposal schedule. The Engineer will pay for additional grubbing requested by the Engineer that are beyond the scope of the original contract work on a force account basis. No progress payment will be authorized until the Engineer accepts additional grubbing in writing."

**END OF SECTION 203**



1 Add Section 316 – Polypropylene Biaxial Geogrid to read as follows:  
2

3 **“SECTION 316 – POLYPROPYLENE BIAXIAL GEOGRID**  
4

5 **316.01 Description.** This work includes furnishing and placing polypropylene  
6 biaxial geogrid over a non-woven geotextile fabric.  
7

8 **316.02 Material.** The grid material shall meet the following:  
9

10 The biaxial geogrid shall be a punched and drawn polypropylene geogrid with the  
11 following characteristics based on the minimum average roll values (MARV):  
12

- 13 • Aperture Dimensions = 1 to 1.3 inches
- 14
- 15 • Minimum Rib Thickness = 0.05 inch
- 16
- 17 • Tensile Strength at 2% Strain (ASTM D6637-01) = 380 lb/ft in machine  
18 direction, 510 lb/ft in cross-machine direction
- 19
- 20 • Tensile Strength at 5% Strain (ASTM D6637-01) = 720 lb/ft in machine  
21 direction, 1,000 lb/ft in cross-machine direction
- 22
- 23 • Ultimate Tensile Strength (ASTM D6637-01) = 1,400 lb/ft in machine  
24 direction, 1,610 lb/ft in cross-machine direction
- 25
- 26 • Junction Efficiency (GRI-GG2-05) = 93%
- 27
- 28 • Flexural Stiffness (ASTM D5732-01) = 750,000 mg-cm
- 29
- 30 • Aperture Stability (U.S. Army Corps of Engineers Methodology for  
31 measurement of Torsional Rigidity) = 0.48 m-N/deg
- 32
- 33 • Resistance to Installation Damage in Gravel = 75%
- 34
- 35 • Resistance to Long Term Degradation (EPA 9090 immersion test) = 100%
- 36
- 37 • Resistance to UV Degradation (500 hours of UV in accordance with ASTM  
38 D4355-05) = 100%
- 39

40 **316.03 Construction Requirements.**  
41

42 Place geogrid onto the geotextile fabric.  
43

44 The geogrid material shall have a minimum overlap of 12 inches for  
45 transverse joints. The means and methods to attain this minimum overlap is  
46 the responsibility of the Contractor. However, one method could involve  
47 flapping the geogrids upwards and placing temporary fill that is easier to  
48 remove when excavating the adjacent area.  
49

50 Due to constructability issues, overlaps are not required for the longitudinal  
51 joints between lanes.

52

53 **316.04 Method of Measurement.** The Engineer will measure geogrid per  
54 square yard of geogrid finished surface, not including overlaps.

55

56 **316.05 Basis of Payment.** The Engineer will pay for the accepted geogrid at  
57 the contract unit price per square yard. Payment will be full compensation for the  
58 work prescribed in this section and the contract documents

59

60 The Engineer will pay for the following pay item when included in the  
61 proposal schedule::

62

Pay Item	Pay Unit
Polypropylene Biaxial Geogrid	Square Yard"

66

67

68

69

**END OF SECTION 316**

1 **Amend Section 401- HOT MIX ASPHALT (HMA) PAVEMENT to read as follows:**

2  
3 **“SECTION 401 – HOT MIX ASPHALT (HMA) PAVEMENT**

4  
5 **401.01 Description.** This section describes furnishing and placing dense graded  
6 HMA pavement (herein referred to as HMA) on a prepared surface.

7  
8 **401.02 Materials.**

9  
10 Asphalt Cement (PG 64-16) 702.01(A)

11  
12 Use for non-surface mixes, unless otherwise specified in the project documents.

13  
14 Asphalt Cement (PG 64E-22) 702.01(B)

15  
16 Use for all surface mixes, except for on Lanai and Molokai, and unless otherwise  
17 specified in the project documents. Polymer modified asphalt (PMA) pavement  
18 refers to asphalt mix using PG 64E-22, unless otherwise indicated.

19  
20 Emulsified Asphalt 702.04

21  
22 Warm Mix Asphalt Additive 702.06

23  
24 Aggregate for Hot Mix Asphalt Pavement 703.09

25  
26 Filler 703.15

27  
28 Hydrated Lime or a liquid anti-strip approved by the engineer 712.03

29  
30 **(A) General.** HMA pavement shall be plant mixed and shall include  
31 mixture of aggregate and asphalt binder and may include reclaimed asphalt  
32 pavement (RAP) or filler, or both.

33  
34 The manufacture of HMA may include warm mix asphalt (WMA)  
35 processes in accordance with these specifications. WMA processes include  
36 combinations of organic additives, chemical additives, and foaming.

37  
38 HMA pavement shall include surface course and may include one or  
39 more binder courses, depending on HMA pavement thickness indicated in  
40 the contract documents.

41  
42 RAP is defined as removed or reprocessed pavement materials  
43 containing asphalt and aggregates. Process RAP by crushing until 100  
44 percent of RAP passes 3/4-inch sieve. Size, grade uniformly, and combine  
45 materials such that blend of RAP and aggregate material conforms to grading  
46 requirements of Subsection 703.09 - Aggregate for Hot Mix Asphalt

47  
48  
Pavement.

In surface and binder courses, aggregate for HMA may include RAP quantities up to 20 percent of total mix weight.

Quantity of filler material to correct deficiencies in aggregate gradation passing the No. 200 sieve shall not exceed 3 percent by weight of fine aggregates.

**(B) Job-Mix Formula and Tests.** Design job-mix formula in accordance with procedures contained in current edition of Asphalt Institute's *Mix Design Methods for Asphalt Concrete and Other Hot Mix Types*, Manual Series No. 2 (MS-2) for either Marshall Method or Hveem Method of Mix Design.

Limit compacted lift thickness and asphalt content of job-mix formula as specified in Table 401.02-1 - Limits of Compacted Lift Thickness and Asphalt Content.

<b>TABLE 401.02-1 - LIMITS OF COMPACTED LIFT THICKNESS AND ASPHALT CONTENT</b>				
<b>MIX NO.</b>	<b>II</b>	<b>III</b>	<b>IV</b>	<b>V</b>
Minimum to Maximum Compacted Thickness for Individual Lifts (Inches)	2-1/4 to 3	2 to 3	1-1/2 to 3	1-1/4 to 3
Asphalt Content Limits (Percent of Total Weight of Mix)	3.8 to 6.1	4.3 to 6.1	4.3 to 6.5	4.8 to 7.0

65  
66  
67  
68  
69  
70  
71  
72  
73

Asphalt content limits for porous aggregate may be exceeded only if it is requested ahead of placement and is reviewed then accepted in writing by the Engineer.

Meet job-mix formula design criteria specified in Table 401.02-2 - Job-Mix Formula Design Criteria.



<b>TABLE 401.02-2 - JOB-MIX FORMULA DESIGN CRITERIA</b>	
<b>Hveem Method Mix Criteria (AASHTO T 246 and AASHTO T 247)</b>	
Stability, minimum	37
Air Voids (percent) <sup>1</sup>	3 - 5
<b>Marshall Method Mix Criteria (AASHTO T 245)</b>	
Compaction (number of blows each end of specimen)	75
Stability, minimum (pounds)	1,800
Flow (x 0.01 inch)	8 - 16
Air Voids (percent) <sup>1</sup>	3 - 5
<b>Notes:</b>	
1. Air Voids: AASHTO T 166 or AASHTO T 275; AASHTO T 209, AASHTO T 269.	

75  
76  
77  
78  
79

Minimum percent voids in mineral aggregates (VMA) of job-mix formula shall be as specified in Table 401.02-3 - Minimum Percent Voids in Mineral Aggregates (VMA).

<b>TABLE 401.02-3 - MINIMUM PERCENT VOIDS IN MINERAL AGGREGATES (VMA)</b>					
Nominal Maximum Particle Size, (Inches)	1-1/2	1	3/4	1/2	3/8
VMA, (percent) <sup>1</sup>	11.0	12.0	13.0	14.0	15.0
<b>Notes:</b>					
1. VMA: See Asphalt Institute Manual MS-2					

80  
81  
82  
**(C) Submittals.** Establish and submit job-mix formula for each type of HMA pavement mix indicated in the contract documents a minimum of 30 days before paving production. Job mix shall include the following applicable information:

- (1) Design percent of aggregate passing each required sieve size.
- (2) Design percent of asphalt binder material (type determined by type of mix) added to the aggregate (expressed as % by weight of total mix),
- (3) Design proportion of processed RAP.
- (4) Design temperature of mixture at point of discharge at paver.

- 96 (5) Source of aggregate.
- 97
- 98 (6) Grade of asphalt binder.
- 99
- 100 (7) Test data used to develop job-mix formula.
- 101

102 Except for item (4) in this subsection, if design requirements are  
 103 modified after the Engineer accepts job-mix formula, submit new job-mix  
 104 formula before using HMA produced from modified mix design. Submit any  
 105 changes to the design temperature of mixture at point of discharge for  
 106 acceptance by the Engineer.

107  
 108 Submit a certificate of compliance for the asphalt binder, accompanied  
 109 by substantiating test data from a certified testing laboratory.

110  
 111 **(D) Range of Tolerances for HMA.** Provide HMA within allowable  
 112 tolerances of accepted job mix formula as specified in Table 401.02-4 -  
 113 Range of Tolerances HMA. These tolerances are not to be used for the  
 114 design of the job mix, they are solely to be used during the testing of the  
 115 production field sample of the HMA mix.

116

<b>TABLE 401.02-4 - RANGE OF TOLERANCES HMA</b>	
Passing No. 4 and larger sieves (percent)	± 7.0
Passing No. 8 to No. 100 sieves (inclusive) (percent)	± 4.0
Passing No. 200 sieve (percent)	± 3.0
Asphalt Content (percent)	± 0.4
Mixture Temperature (degrees F)	± 20

117  
 118 The tolerances shown are the allowable variance between the physical  
 119 characteristics of laboratory job mix submitted mix design and the production  
 120 or operational mix, i.e., field samples.

121

122 **401.03 Construction.**

123

124 **(A) Weather Limitations.** Placement of HMA shall not be allowed under  
 125 the following conditions:

126

- 127 (1) On wet surfaces, e.g., surface with ponding or running water,  
 128 surface that has aggregate or surface that appears beyond surface  
 129 saturated dry, as determined by the Engineer.

130

131  
(2) When air temperature is below 50 degrees F and falling. HMA may be applied when air temperature is above 40 degrees F and rising. Air temperature will be measured in shade and away from artificial heat.

(3) When weather conditions prevent proper method of construction.

**(B) Equipment.**

(1) **Mixing Plant.** Use mixing plants that conform to AASHTO M 156, supplemented as follows:

**(a) All Plants.**

1. **Automated Controls.** Control proportioning, mixing, and mix discharging automatically. When RAP is incorporated into mixture, provide positive controls for proportioning processed RAP.

2. **Dust Collector.** AASHTO M 156, Requirements for All Plants, Emission Controls is amended as follows:

Equip plant with dust collector. Dispose of collected material. In the case of baghouse dust collectors, dispose of collected material or return collected material uniformly.

3. **Modifications for Processing RAP.** When RAP is incorporated into mixture, modify mixing plant in accordance with plant manufacturer's recommendations to process RAP.

**(b) Drum Dryer-Mixer Plants.**

1. **Bins.** Provide separate bin in cold aggregate feeder for each individual aggregate stockpile in mix. Use bins of sufficient size to keep plant in continuous operation and of proper design to prevent overflow of material from one bin to another.



218  
219  
220  
- (a) Self-contained, power-propelled units.
- (b) Equipped with activated screed or strike-off assembly, heated if necessary.
- (c) Capable of spreading and finishing courses of HMA mixtures in lane widths applicable to typical section and thicknesses indicated in the contract documents.
- (d) Equipped with receiving hopper having sufficient capacity for uniform spreading operation.
- (e) Equipped with automatic feed controls to maintain uniform depth of material ahead of screed.
- (f) Equipped with automatic screed controls with sensors capable of sensing grade from outside reference line, sensing transverse slope of screed, and providing automatic signals to control screed grade and transverse slope.
- (g) Capable of operating at constant forward speeds consistent with satisfactory laying of mixture.
- (h) Equipped with a means of preventing the segregation of the coarse aggregate particles from the remainder of the bituminous plant mix when that mix is carried from the paver hopper back to the paver augers. The means and methods used shall be approved by the paver manufacturer and may consist of chain curtains, deflector plates, or other such devices and any combination of these.

The following specific requirements shall apply to the identified bituminous pavers:

1. **Blaw-Knox Bituminous Pavers.** Blaw-Knox bituminous pavers shall be equipped with the Blaw-Knox Materials Management Kit (MMK).
2. **Cedarapids Bituminous Pavers.** Cedarapids bituminous pavers shall be those that were manufactured in 1989 or later.

260  
261  
262  
**3. Barber-Green/Caterpillar Bituminous Pavers.**  
Barber-Green/Caterpillar bituminous pavers shall be equipped with deflector plates as identified in the December 2000 Service Magazine entitled “New Asphalt Deflector Kit {6630, 6631, 6640}”.

Bituminous pavers not listed above shall have similar attachments or designs that shall make them equivalent to the bituminous pavers listed above. The Engineer will solely decide if it is equal to or better than the setups described for the equipment listed above.

Submit for review and acceptance, prior to the start of using the paver for the placing of plant mix, a full description in writing of the means and methods that will be used to prevent the bituminous paver from having both aggregate and temperature segregation. Use of any paver that has not been accepted is prohibited until acceptance of the paver is received from the Engineer. Any pavement placed with an unaccepted paver will be regarded as not compliant work and may not be paid for and may require removal.

Supply a Certificate of Compliance that verifies that the manufacturer’s approved means and methods used to prevent bituminous paver from having both aggregate and temperature segregation have been implemented on all pavers used on the project and are working in accordance with the manufacturer’s requirements and Contract Documents.

**(4) Rollers.** Rollers shall be self-propelled, steel-tired tandem, pneumatic-tired, or vibratory-type rollers capable of reversing without shoving or tearing the just placed HMA mixture. Provide sufficient number, sequencing, type, and rollers of sufficient weight to compact the mixture to required density while mixture is still in workable condition unless otherwise indicated. Equipment shall not excessively crush aggregate. Operate rollers in accordance with manufacturer’s recommendations and Contract Documents. The use of intelligent compaction is encouraged and may be required elsewhere in the Contract Documents.

**(a) Steel-Tired Tandem Rollers.** Steel-tired tandem rollers used for initial breakdown or intermediate roller passes shall have minimum gross weight of 12 tons and shall provide minimum 250-pound weight per linear inch of width on drive wheel.

306 Steel-tired tandem rollers used for finish roller passes  
307 shall have minimum total gross weight of 3 tons.  
308

309 Do not use roller with grooved or pitted rolling drum or  
310 worn scrapers or wetting pads. Replace excessively worn  
311 scrapers and wetting pads before use.  
312

313 **(b) Pneumatic-Tired Rollers.** Pneumatic-tired rollers shall  
314 be oscillating-type, equipped with smooth-tread pneumatic tires  
315 of equal size and diameter. Maintain tire pressure within 5  
316 pounds per square inch of designated operational pressure  
317 when hot. Space tires so that gaps between adjacent tires are  
318 covered by following set of tires.  
319

320 Pneumatic-tired rollers used for breakdown or  
321 intermediate roller passes shall have a ballast capable of  
322 establishing an operating weight per tire of not less than 3,000  
323 pounds. Equip rollers with tires having minimum 20-inch wheel  
324 diameter with tires inflated to 70 to 75 pounds per square inch  
325 pressure when cold and 90 pounds per square inch when hot.  
326 Equip rollers with skirt-type devices to maintain temperature of  
327 tires during rolling operations.  
328

329 Pneumatic-tired rollers used for kneading finished  
330 asphalt surfaces shall have a ballast capable of establishing an  
331 operating weight per tire of not less than 1,500 pounds. Equip  
332 rollers with tires having minimum 15-inch wheel diameter with  
333 tires inflated to 50 to 60 pounds per square inch pressure. If  
334 required, equip rollers with skirt-type devices to maintain  
335 temperature of tires during rolling operations.  
336

337 **(c) Vibratory Rollers.** Vibratory rollers shall be steel-tired  
338 tandem rollers having minimum total weight of 3 tons. Equip  
339 vibratory rollers with amplitude and frequency controls and  
340 speedometer. Operate vibratory roller in accordance with  
341 manufacturer's recommendations. For very thin lifts, 1 inch or  
342 less in thickness, vibratory rollers shall not be used in the  
343 vibratory mode. Instead, operate the unit in the static mode.  
344

345 **(5) Hand Tools.** Keep hand tools used in production, hauling, and  
346 placement of HMA clean and free of contaminants. Diesel or mineral  
347 spirits or other cleaning material that is potentially deleterious to HMA  
348 may be used to clean hand tools providing:  
349

350 **(a)** It does not contaminate HMA with cleaning material.  
351

352  
(b) Clean hand tools over catch pan with capacity to hold all the cleaning material.

(c) Remove all diesel or mineral spirits or other cleaning material that is potentially deleterious to HMA from hand tools before using with HMA.

(d) Hand tools used shall be in a condition such that it meets the requirements that it was manufactured for, e.g., a straightedge shall meet the straightness requirement of the manufacturer.

**(6) Material Transfer Vehicle (MTV).**

(a) **Usage.** MTV usage applies to surface courses of paving projects on all Islands except Lanai, unless otherwise indicated. When placing HMA surface course use MTV to independently deliver mixtures from hauling equipment to paving equipment. MTV usage will not be required for the following:

1. Projects with less than 1,000 tons of HMA.
2. Temporary pavements.
3. Bridge deck approaches.
4. Shoulders.
5. Tapers.
6. Turning lanes.
7. Driveways.
8. Areas with low overhead clearances.

(b) **Equipment.** When using MTV, install minimum 10-ton-capacity hopper insert in conventional paver hopper. Provide the following equipment:

1. High-capacity truck unloading system in MTV capable of receiving HMA from hauling equipment.
2. MTV storage bin with minimum 15-ton capacity.
3. An auger mixing system in one of the following:



398  
399  
400  
the MTV storage bin, or paver hopper insert, or paver hopper to continuously mix HMA prior to discharging to the paver's conveyor system.

Avoid stop-and-go operations by coordinating plant production rate, number of haul units, and MTV and paver speeds to provide a continuous, uniform, segregation-free material flow and smooth HMA pavement. Maintain uniform paver speed to produce smooth pavements.

**(c) Performance Evaluation.** Evaluate the performance of MTV and mixing equipment by measuring mat temperature profile immediately behind paver screed on first day of paving and when it feels the need to do so due to perceived changes in performance or as directed by the Engineer.

Use a hand-held temperature device that has been calibrated within the past 12 months. It shall be an infrared temperature gun is capable of measuring in one degree or finer increments between the temperatures of 80 degrees to 400 degrees F with a laser to indicate where the temperature reading is being taken. Six temperature profile measurements shall be taken of mat surface using infrared temperature gun at 50-foot intervals behind paver. Each temperature profile shall consist of three surface temperature measurements taken transversely across the mat in approximately a straight line from screed while paver is operating. For each profile, temperatures shall be measured approximately 1 foot from each edge and in middle of mat. The difference between maximum and minimum temperature measurements for each temperature profile shall not exceed 10 degrees F. If any two or more temperature profiles exceeds the allowable 10-degree F temperature differential, halt paving operation and adjust MTV or mixing equipment to ensure that material placed by paver meets specified temperature requirements. Redo the measuring of mat temperature profile until adjustment of the MTV or mixing equipment is adequate. Submit all temperature profiles to the Engineer by next business day. Information on the report shall show location and temperature readings and time test was performed. Enough information shall be given, so the Engineer will be able to easily locate the test site of the individual measurement.

When requested temperature profile measurements shall be done in the presence of the Engineer.

443 Once adjustments are made, repeat measurement  
444 procedure for the next two placements to verify that material  
445 placed by paver meets specified temperature requirements.  
446 Terminate paving if temperature profile requirements are not  
447 met during repeated measurement procedure. If equipment  
448 fails to meet requirements after measurement procedure is  
449 repeated once, replace equipment before conducting any  
450 further temperature profile measurements  
451

452 The Engineer may perform surface temperature profile  
453 measurements at any time during project. The Engineer may  
454 in lieu of a hand-held infrared temperature device use an  
455 infrared camera or device that is capable of measuring  
456 temperatures to locate cold spots. If such cold spots exist, the  
457 Engineer may require adjustments to the MTV.  
458

459 If bleeding or fat spots occur in the pavement adjust  
460 means and methods to eliminate such pavement defects and  
461 perform remedial repair to pavement acceptable to the  
462 Engineer. Bleeding is defined as excess binder occurring on  
463 the surface of the pavement. It may create a shiny, glass-like,  
464 reflective appearance and may be tacky to the touch. Fat spots  
465 are localized bleeding.  
466

467 **(d) Transport.**  
468

469 **1. Trailered MTV.** Transport MTV by means of  
470 truck-tractor/trailer combination in accordance with  
471 Chapter 104 of Title 19, Department of Transportation,  
472 entitled "The Movement by Permit of Oversize and  
473 Overweight Vehicles on State Highways".  
474

475 **2. Crossing Bridges for Self-Powered MTV.**  
476 When self-powered MTV exceeds legal axle or total  
477 weight limits for vehicles under the HRS, Chapter 291,  
478 conform to the following when crossing bridges within  
479 project limits unless otherwise indicated:  
480

- 481 **a.** Completely remove mix from MTV.
- 482
- 483 **b.** Move MTV at relatively constant speed not  
484 exceeding 5 miles per hour. MTV will not be  
485 allowed to stop on bridge.  
486

487 c. No other vehicle or equipment will be  
488 allowed on bridge.

489  
490 d. The MTV shall not attempt to cross a  
491 bridge where the posted load limit is less than or  
492 equal to the weight of the MTV empty.  
493 Permission to cross the bridge shall be obtained  
494 from the Engineer and HWY-DB in writing.  
495

496 **(C) Preparation of Surface.** Clean existing pavement in accordance with  
497 Section 310 - Brooming Off. Apply tack coat in accordance with Section 407  
498 - Tack Coat. Tack coat shall not be applied to surfaces to receive an  
499 application of joint adhesive.  
500

501 Where indicated, bring irregular surfaces to uniform grade and cross  
502 section by furnishing and placing one or more leveling courses of HMA Mix  
503 V. Spread leveling course in variable thicknesses to eliminate irregularities  
504 in existing surface. Place leveling course such that maximum depth of each  
505 course, when thoroughly compacted to the Contract Documents'  
506 requirements, does not exceed 3 inches.  
507

508 In multiple-lift leveling course construction, spread subsequent lifts  
509 beyond edges of previously spread lifts in accordance with procedures  
510 contained in current edition of the Asphalt Institute's *Construction of Hot Mix*  
511 *Asphalt Pavements*, Manual Series No. 22 (MS-22) for leveling wedges.  
512

513 Notify the Engineer of existing surfaces that may not be in a condition  
514 that will have enough strength to be a good bonding surface or foundation  
515 and should be removed or have remedial repairs done before new pavement  
516 placement.  
517

518 **(D) Plant Operation.**  
519

520 **(1) Preparation of Asphalt Binder.** Uniformly heat asphalt binder  
521 and provide continuous supply of heated asphalt cement from storage  
522 to mixer. Do not heat asphalt binder above the recommendation of  
523 the supplier for modified binders or above 350 degrees F for neat  
524 binders.  
525

526 **(2) Preparation of Aggregate.** Dry and heat aggregate material  
527 at temperature sufficient to produce design temperature of job-mix  
528 formula. Do not exceed 350 degrees F. Adjust heat source used for  
529 drying and heating to avoid damage to and contamination of  
530 aggregate. When dry, aggregate shall not contain more than 1  
531 percent moisture by weight.  
532

533 For batch plants, screen aggregates immediately after heating  
534 and drying into three or more fractions. Convey aggregates into  
535 separate compartments ready for batching and mixing with asphalt  
536 binder.

537  
538 **(3) Mixing.** Measure aggregate and asphalt; or aggregate, RAP,  
539 and asphalt into mixer in accordance with an accepted job-mix  
540 formula. Mix until components are completely mixed and adequately  
541 coated with asphalt binder in accordance with AASHTO M 156.  
542 Percent of coated particles shall be 95 percent when tested in  
543 accordance with AASHTO T 195.

544  
545 **(4) Plant Inspection.** For control and acceptance testing during  
546 periods of production, provide a testing laboratory that meets the  
547 requirements of AASHTO M 156. Provide space, utilities, and  
548 equipment required for performing specified tests.

549  
550 **(E) Spreading and Finishing.** Prior to each day's paving operation,  
551 check screed or strike-off assembly surface with straight edge to ensure  
552 straight alignment and there is no damage or wear to the machine that will  
553 affect performance. Provide screed or strike-off assembly that produces  
554 finished surface without tearing, shoving, and gouging HMA. Discontinue  
555 using spreading equipment that leaves ridges, indentations, or other marks,  
556 or combination thereof in surface that cannot be eliminated by rolling or  
557 affects the final smoothness of the pavement or be prevented by adjustment  
558 in operation.

559  
560 Maintain HMA at minimum 250 degrees F temperature at discharge to  
561 paver. The Engineer shall observe the contractor measuring the temperature  
562 of mix in hauling vehicle just before depositing into spreader or paver or MTV.

563  
564 Deposit HMA in a manner that minimizes segregation. Raise truck  
565 beds with tailgates closed before discharging HMA.

566  
567 Lay, spread, and strike off HMA upon prepared surface. Where  
568 practical, use asphalt pavers to distribute mixture.

569  
570 Where practical, control horizontal alignment using automatic grade  
571 and slope controls from reference line, slope control device. Existing  
572 pavements or features shall not be used for grade control alone.

573  
574 Obtain sensor grade reference, horizontal alignment by using  
575 established grade and slope controls. For subsequent passes, substitution  
576 of one ski with joint-matching shoe riding on finished adjacent pavement is  
577 acceptable. Use of a comparable non-contact mobile reference system and  
578 joint matching shoe is acceptable.

579           Avoid stop-and-go operation. Maintain a constant forward speed of  
580 paver during paving operation and minimize other methods that impact  
581 smoothness.  
582

583           Offset longitudinal joint in successive lifts by approximately 6 inches.  
584 Incorporate into paving method an overlap of material of 1-inch +/- 0.5 inches  
585 at the longitudinal joint. The HMA overlap material shall be left alone when  
586 initially placed and shall not be bumped back or pushed back with a lute or  
587 any other hand-held device. If the overlap exceeds the maximum amount,  
588 remove the excess with a flat shovel, allowing recommended amount of  
589 overlap HMA material to remain in place to be compacted. Do not throw the  
590 removed excess HMA material on to the paving mat. The longitudinal joint  
591 in a surface course when total roadway width is comprised of two lanes shall  
592 be near the centerline of pavement or near lane lines when roadway is more  
593 than two lanes in width. The longitudinal joint shall not be constructed in the  
594 wheel path or under the longitudinal lane lines. Make a paving plan drawing  
595 showing how the longitudinal joint will not be located in these areas.  
596

597           Control the horizontal alignment of the longitudinal edge of the HMA  
598 mat being installed so that the edge is parallel to the centerline or has a  
599 uniform alignment, e.g., the edge of the mat is straight line or uniform curve,  
600 no wavy edge, etc. to have a consistent amount of HMA material at the joint.  
601

602           Check the compaction of the longitudinal joint during paving often  
603 enough to ensure that it will meet the compaction requirements.  
604

605           If nuclear gauges and ground penetrating radar are used as the  
606 contractor's quality control method, they shall be properly calibrated and  
607 periodically checked by comparison to cores taken from the pavement. The  
608 use of sand as an aid in properly seating the gauge may also be considered  
609 for improving the accuracy of the gauge.  
610

611           In areas where irregularities or unavoidable obstacles make use of  
612 mechanical spreading and finishing equipment impracticable, spread, rake,  
613 and lute mixture by hand tools. For such areas, deposit, spread evenly, and  
614 screed mixture to required compacted thickness.  
615

616           Demonstrate competence of personnel operating grade and crown  
617 control device before placing surface courses. If automatic control system  
618 becomes inoperative during the day's work, the Engineer will permit the  
619 Contractor to finish day's work using manual controls. The Engineer may  
620 also allow additional HMA to be ordered and placed using manual controls if  
621 it will provide a safer work site for the public to travel through. Do not resume  
622 work until automatic control system is made operative. The Engineer may  
623 waive requirement for electronic screed control device when paving gores,

624 shoulders, transitions, and miscellaneous reconstruction areas where the  
625 use of the devices is not practical.

626  
627 When production of HMA can be maintained and when practicable,  
628 use pavers in echelon shall be used to place surface course in adjacent  
629 lanes.

630  
631 At the end of each workday, HMA pavement that is open to traffic shall  
632 not extend beyond the panel of the adjacent new lane pavement by more  
633 than the distance normally placed in one workday. At end of each day's  
634 production, construct tapered transitions along all longitudinal and transverse  
635 pavement drop-offs; this shall apply to areas where existing pavement is to  
636 meet newly placed pavement. Use slopes of 6:1 for longitudinal taper  
637 transitions and 48:1 for transverse tapered transitions. Maximum drop-off  
638 height along the joints shall be 2 inches. Also, using a 48:1 slope provides a  
639 taper around any protruding object, e.g., manholes, drain boxes, survey  
640 monuments, inlets, etc., that may be above pavement surface when opened  
641 to the public. If the object is below the surface of the pavement then fill the  
642 depression until it is level with the surrounding pavement or raise depressed  
643 objects to the finish grade of the placed pavement. Remove and dispose of  
644 all transition tapers before placing adjoining panel or next layer of HMA.  
645 Notify traveling public of pavement drop-offs or raised objects with signs  
646 placed in every direction of traffic that may use and encounter pavement  
647 drop-offs or protruding objects or holes.

648  
649 Use the same taper rates for areas where there is a difference in  
650 elevation due to construction work.

651  
652 At end of each workweek, complete full width of the roadway's  
653 pavement, including shoulders, to same elevation with no drop-offs.

654  
655 **(F) Compaction.** Immediately after spreading and striking off HMA and  
656 adjusting surface irregularities, uniformly compact mixture by rolling.

657  
658 Initiate compaction at highest mix temperature allowing compaction  
659 without excessive horizontal movement. Temperature shall not be less than  
660 220 degrees F.

661  
662 Finish rolling using tandem roller while HMA temperature is at or  
663 above 175 degrees F.

664  
665 On superelevated curves, begin rolling at lower edge and progress to  
666 higher edge by overlapping of longitudinal trips parallel to centerline.

667  
668 If necessary, repair damage immediately using rakes and fresh mix.  
669 Do not displace line and grade of HMA edges during rolling.

670  
671  
Keep roller wheels properly moistened with water or water mixed with small quantities of detergent. Use of excess liquid, diesel, and petroleum-based liquids will not be allowed on rollers.

Along forms, curbs, headers, walls and other places not accessible to rollers, compact mixture with hot hand tampers, smoothing irons, or mechanical tampers. On depressed areas, trench roller or cleated compression strips under roller may be used to transmit compression.

Before the start of compaction or during compaction or both remove pavement that is loose, broken, or contaminated, or combination thereof; pavement that shows an excess or deficiency in asphalt binder content; and pavement that is defective in any way. Replace with fresh HMA pavement of same type, and compact. Remove and replace defective pavement and compact at no increase in contract price or contract time.

Operate rollers at slow and uniform speed with no sudden stops. The drive wheels shall be nearest to the paver. Continue rolling to attain specified density and until roller marks are eliminated.

Rollers shall not be parked on the pavement placed that day or shift.

**(1) HMA Pavement Courses One and a Half Inches Thick or Greater.** Where HMA pavement compacted thickness indicated in the Contract Documents is 1-1/2 inches or greater, compact to not less than 93.0 percent nor greater than 97.0 percent of the maximum specific gravity determined in accordance with AASHTO T 209, modified by deletion of Supplemental Procedure for Mixtures Containing Porous Aggregate.

Place HMA pavement in individual lifts that are within minimum and maximum allowable compacted thickness for various types of mixture as specified in Table 401.02-1 - Limits of Compacted Lift Thickness and Asphalt Content.

**(2) HMA Pavement Courses Less Than One and a Half Inches Thick.** Where HMA pavement compacted thickness indicated in the contract documents is less than 1-1/2 inches, compaction to a specified density will not be required.

Use only non-vibratory, steel-tired, tandem roller. Roll entire surface with minimum of two roller passes. A roller pass is defined as one trip of the roller in one direction over any one spot.

For intermediate rolling, roll entire surface with minimum of four

716  
717  
passes of roller.

Finish rolling using steel-tired, tandem roller. Continue rolling until entire surface has been compacted with minimum of three passes of roller, and roller marks have been eliminated.

Do not use rollers that will excessively crush aggregate.

**(3) HMA Pavement Courses One and a Half Inches Thick or Greater In Special Areas Not Designated For Vehicular Traffic.**

For areas such as bikeways that are not part of roadway and other areas not subjected to vehicular traffic, compact to not less than 90.0 percent of maximum specific gravity determined in accordance with AASHTO T 209, modified by deletion of Supplemental Procedure for Mixtures Containing Porous Aggregate. Increase asphalt content by at least 0.5 percent above that used for HMA pavements designed for vehicular traffic. Paved shoulders shall be compacted in the same manner as pavements designed for vehicular traffic.

**(G) Joints, Trimming Edges and Utility Marking.** At HMA pavement connections to existing pavements, make joints vertical to depth of new pavement. Saw cut existing pavement and cold plane in accordance with Section 415 - Cold Planing of Existing Pavement to depth equal to thickness of surface course or as indicated in the Contract Documents.

At HMA connections to previously placed lifts, form transverse joints by cutting back on previous run to expose full depth of course. Dispose of material trimmed from edges. Protect end of freshly laid mixture from rollers.

Before and after paving, identify and mark location of existing utility manholes, valves, and handholes on finished surface. Adjust existing frames and covers and valve boxes to final pavement finish grade in accordance with Section 604 - Manholes, Inlets and Catch Basins and Section 626 - Manholes and Valve Boxes for Water and Sewer Systems.

**(1)** Longitudinal joints. Submit for review the means and methods that will be used to install longitudinal joints at the required compaction and density. Compact longitudinal joints to be not less than 91.0 percent of the maximum specific gravity determined in accordance with AASHTO T 209, modified by deletion of Supplemental Procedure for Mixtures Containing Porous Aggregate. Verify the compaction of the longitudinal joints meets requirements by using non-destructive testing methods during paving and submit the results on the daily quality control test reports.

Test for compaction and density regardless of layer thickness.



762 Compaction and density of the longitudinal joint shall be determined by using  
763 six-inch diameter cores. For longitudinal joints made using butt joints cores  
764 shall be taken over the joint with half of the core being on each side of the  
765 joint. For longitudinal joints using butt wedge joints, center core over the  
766 center of the wedge so that 50 percent of the material is from the most  
767 recently paved material and the remaining 50 percent of the core is from the  
768 material used to pave the previous layer. One core shall be taken at a  
769 maximum of every 250 tons of longitudinal joint and any fraction of that length  
770 for each day of paving with a minimum of one core taken for each longitudinal  
771 joint per day. Cores taken for the testing of the longitudinal joint may be used  
772 to determine pavement thickness.

773  
774 When the longitudinal joints are found to have less than 91.0 percent  
775 of the maximum specific gravity, overband all longitudinal joints within the  
776 entire lot represented by the non-compliant core, PG binder seal coat, or  
777 other type of joint enrichment accepted by the Engineer. The overband shall  
778 not decrease the skid resistance of the pavement under any ambient weather  
779 condition. Submit overband material's catalog cuts, test results and  
780 application procedure for review and acceptance by the Engineer before use.  
781 Center the overband over the longitudinal joint. The overband shall be placed  
782 in a uniform width and horizontal alignment. The overband shall have no  
783 holidays or streaking in its placement. The width of the overband shall be  
784 based on how the longitudinal joint was constructed or as directed by the  
785 Engineer. If a butt joint is used, the overband width shall be a minimum of  
786 12-inches. For butt wedge or wedge joints the overband width shall be the  
787 width of the wedge plus an additional six-inches minimum. Replace any  
788 pavement markings damaged or soiled by the overband remedial repair  
789 process.

790  
791 For longitudinal joints that have a compaction of less than 89 percent  
792 of the maximum specific gravity; removal may be required by the Engineer  
793 instead of overbanding the non-compliant joint.

794  
795 Persistent low compaction results may be cause to suspend work and  
796 remove non-conforming work. During the suspension of paving, revise  
797 means and methods used in constructing longitudinal joints and submit to the  
798 Engineer for review and acceptance. Suspension may occur when:

- 799  
800 **(1)** Two or more longitudinal joints tests fail to meet the minimum  
801 compaction  
802 **(2)** One sample reveals that the joint compaction is 89 percent or  
803 less.

804  
805 Compaction results for longitudinal joints until January 1, 2023 will not  
806 be included in any Sliding Scale Pay Factor for Compaction payment  
807 calculation. After, January 1, 2023 it will be included.

808  
809  
**(H) HMA Pavement Samples.** Obtain test samples from compacted HMA pavement within 72 hours of lay down. Provide minimum 4-inch diameter cores consisting of undisturbed, full-depth portion of compacted mixture taken at locations designated by the Engineer in accordance with the “Sampling and Testing Guide for Acceptance and Verification” in Hawaii DOT Highways Division, *Quality Assurance Manual for Materials*, Appendix 3. Cores shall be taken in the presence of the Engineer. Turn cores over to Engineer immediately after cores have been taken.

For pavement samples for longitudinal joints provide 6-inch diameter cores minimum. For pavement samples for other than longitudinal joints 4-inch diameter cores minimum shall be taken. All cores shall consist of undisturbed, full-depth of the lift of the compacted mixture taken at locations designated by the Engineer in accordance with the “Sampling and Testing Guide for Acceptance and Verification” in Hawaii DOT Highways Division, *Quality Assurance Manual for Materials*, appendix 3. Coring of longitudinal joints shall use a modified HDOT Sampling and Testing Guide as required by the Contract Documents.

Cores that separate shall indicate to the Engineer that there is insufficient bonding of layers. Modify the previously used paving means and methods to prevent future debonding of layers. Debonding of a core sample after adjustment of the Contractor’s methods will be an indication of continued non-conforming work and the Engineer may direct removal of the layer at no additional cost or contract time.

Restore HMA pavement immediately after obtaining samples. Clean core hole and walls of all deleterious material that will prevent the complete filling of the core hole and the bonding of the new HMA to the existing. Apply tack coat to vertical faces of sample holes. Fill sampled area with new HMA pavement of same type as that removed. If hand compaction is used; fill in layers not exceeding the minimum thickness stated in Table 401.02-1 - Limits of Compacted Lift Thickness And Asphalt Content. Compact each layer to compaction requirements. If Mechanical Compaction methods are used, then layers may be the maximum layer thickness stated in Table 401.02-1 - Limits of Compacted Lift Thickness And Asphalt Content. Using tires or hand tamping to compact the HMA material to restore the pavement shall not be considered as mechanical compaction.

Only sample and test leveling course if 1-1/2 inches or greater. No compaction requirements for less than 1-1/2 inches.

**(I) HMA Pavement Thickness Tolerances.**

The Engineer will measure thickness of pavement by cores obtained

854 by the Contractor in accordance with HDOT TM 09-19 Field Sampling  
855 Bituminous Material after Compaction (Obtaining Cores). The Engineer will  
856 measure cores in accordance with HDOT TM 09-19, except that  
857 measurement will be taken to nearest one thousandth of an inch; and  
858 average of such measurements will be taken to nearest one hundredth of an  
859 inch.

860  
861 Thickness of finished HMA pavement shall be within 0.25 inch of  
862 thickness indicated in the Contract Documents. Pavement not meeting the  
863 thickness requirements of the Contract Documents may be required by the  
864 Engineer to be removed and replaced.

865  
866 Corrective methods taken on pavement exceeding specified  
867 tolerances, e.g., insufficient thickness by methods accepted by the Engineer,  
868 including removal and replacement, shall be at no increase in contract price  
869 or contract time.

870  
871 The checking of pavement thickness shall be done after all remedial  
872 repairs, e.g., smoothness compliance repairs, compaction, have been  
873 completed, reviewed, and accepted by the Engineer.

874  
875 **(J) Quality Control Using New Technology.** The Engineer and MTRB  
876 reserves the right to utilize new technology and methods to improve the  
877 detection of noncompliant work on the project. The technology or method  
878 may be used to locate defects in the work, e.g., ground penetrating radar to  
879 locate delaminations, moisture damage, thin sections, voids, non-compliant  
880 compaction, other non-destructive testing to locate flaws. The defect will be  
881 verified by the methods stated in the Contract Documents or by other  
882 established conventional means. If the technology or method has already  
883 been accepted elsewhere or has standardized testing procedures the results  
884 may be judged acceptable by the Engineer and no further testing will be  
885 required. These new technologies and methods may be used for the  
886 selection of sampling locations.

887  
888 **(K) Protection of HMA Pavement.** Except for construction equipment  
889 directly connected with paving operations, keep traffic off HMA pavement.

890  
891 Protect HMA pavement from damage until it has cooled and set.

892  
893 Do not refuel equipment or clean equipment or hand tools over paved  
894 surfaces unless catch pan or device that will contain spilled fuel and other  
895 products is provided. After completion of refueling or cleaning, remove catch  
896 pan or device without spilling any of the collected content.

897  
898 Do not park roller or other paving equipment on HMA pavement paved  
899 within 24 hours of laydown.

900  
901  
**(L) Pavement Joint Adhesive**

**(1) Pavement Joint Adhesive on Joints.** Use on all asphalt pavement construction where joints are formed at such locations but not limited to the following:

**(a)** Adjacent asphalt pavements, e.g., trafficked lanes, shoulders, etc.

**(b)** Asphalt pavement and adjacent concrete pavement or curb and gutter or any other surface where the bonding of the asphalt pavement and concrete surface is desired,

**(c)** Transverse joints between asphalt pavements not placed at the same time or if the pavement's temperature on one side of the joint is below the minimum temperature the mix can be at, during asphalt pavement compaction or installation.

**(d)** Cut face of an existing pavement where it will have new HMA pavement placed against it, e.g., utility trenches, partial or full depth repairs, etc.

Pavement joint adhesive is not required on a longitudinal construction joint between adjacent hot mix asphalt pavements formed by echelon paving. Echelon paving is defined as paving multiple lanes side-by-side with adjacent pavers slightly offset at the same time.

A longitudinal construction joint between one shift's work and another shall have pavement joint adhesive applied at the joint. Any longitudinal construction joint formed, with the temperature on one side of the joint that is below the minimum temperature the mix can be when compacted to contract requirements during asphalt pavement installation, shall have pavement joint adhesive applied at the joint.

**(2) Material requirements.** Asphalt joint adhesive shall meet requirements as specified in Table 401.03-1 - Asphalt Joint Adhesive Specifications.

<b>TABLE 401.03-1 – ASPHALT JOINT ADHESIVE SPECIFICATIONS</b>		
<b>TEST</b>		<b>SPECIFICATION</b>
Brookfield Viscosity, 204 °C [400 °F]	ASTM D 3236	4,000-10,000 cp
Cone Penetration, 25 °C [77 °F]	ASTM D 5329	60-100 dmm
Resilience, 25 °C [77 °F]	ASTM D 5329	30% minimum
Ductility, 25 °C [77 °F]	ASTM D 113	30 cm minimum
Ductility, 4 °C [39.2 °F]	ASTM D 113	30 cm minimum
Tensile Adhesion, 25 °C [77 °F]	ASTM D 5329	500% minimum
Softening Point	ASTM D 36	77 °C [170 °F] min.
Asphalt Compatibility	ASTM D 5329	Pass

940  
941  
**(3) Construction Requirements for Asphalt Joint Adhesive**

**(a) Equipment Requirements.** Use a jacketed double boiler type melting unit, with both agitation and recirculation systems. Provide a pressure feed wand application system.

**(b) Material Handling.** Submit a copy of the manufacturer's recommendations for heating, re-heating, and applying the joint adhesive material. Follow manufacturer's recommendations. Do not remove the joint adhesive from the package until immediately before it is placed in the melter. Joint adhesive boxes must be clearly marked with the name of the manufacturer, the trade name of the adhesive, the manufacturer's batch and lot number, the application/pour temperature, and the safe heating temperature. Feed additional material into the melter at a rate equal to the rate of material used.

Verify the pouring temperature of the joint adhesive at least once per hour at the point of discharge. Stop production if the adhesive falls below the recommended application/pour temperature. When the temperature of the adhesive exceeds the maximum safe heating temperature, stop production, empty the melter, and dispose of that adhesive in an environmentally safe method. No payment will be made for this material or its disposal.

Do not blend or mix different manufacturer's brands or different types of adhesives.

**(c) Joint Adhesive Application:** The face of the joint that the new asphalt pavement will bind to shall be clean and dry

973  
974  
before the joint adhesive is applied. Apply the pavement joint adhesive material to the entire face of the surface where HMA pavement shall be installed. The thickness of the asphalt adhesive application shall be approximately 1/8 inch. Use an application shoe attached to the end of application wand. Do not overlap the joint by greater than 1/2-inch at the top of the joint or two-inches at the bottom of the joint. Apply the joint adhesive immediately in front of the paving operation. If the adhesive is tracked by construction vehicles, repair the damaged area, and restrict traffic from driving on the adhesive.

**(d) Field Sampling.** Take a sample from the application wand during the first 20 minutes of placing sealant. One sample should be taken per manufacturer's batch or minimum of every 6 months on the Project in the presence of the Engineer.

Each sample shall consist of one quart in an aluminum or steel sample container. The sampling container shall be labeled with Contractor's name; project name and number; date and time sample taken; location of where material was used at, e.g., from where to where it was used at in stations; manufacturer and lot number of the sealant. Turn over samples to Engineer without Engineer losing sight of the sample. The Engineer reserves the right to conduct supplementary sampling and testing of the sealant material.

**(M) Pavement Smoothness Rideability Test.** Perform surface profile tests frequently to ensure that the means and methods being used produces pavement that is compliant with the surface profile smoothness requirement. Test the pavement surface for smoothness with High-Speed Inertial Profiler to determine the International Roughness Index (IRI) of the pavement. For the locations determined by the Engineer, a 10-foot straightedge shall be used to measure smoothness.

All smoothness testing must be performed with the presence of the Engineer. The High-Speed Inertial Profiler operator shall be a certified operator by MTRB or the manufacturer.

The High-Speed Inertial Profiler operator's certification shall be no older than five years old at the date of the Notice to Proceed and at the day of the pavement profile measurement.

The finished pavement shall comply to all the following requirements:

1018  
1019  
**(a) Smoothness Test using 10-Foot Straightedge (Manual or rolling)** The 10-foot straightedge is used to identify the locations that vary more than 3/16 inch from the lower edge when the 10-foot straightedge is laid on finished pavement on the direction parallel with the centerline or perpendicular to centerline. Remove the high points that cause the surface to exceed that 3/16 inch tolerance by grinding.

The Contractor shall use a 10-foot straightedge for the following locations:

1. Longitudinal profiling parallel to centerline, when within 15 feet of a bridge approach or existing pavement which is being joined.
2. Transverse profiling of cross slopes, approaches, and as otherwise directed. Lay the straightedge in a direction perpendicular to the centerline.
3. When pavement abuts bridge approaches or pavement not under this Contract, ensure that the longitudinal slope deviations of the finished pavement comply with Contract Document's requirements.
4. Short pavement sections up to 600 feet long, including both mainline and non-mainline sections on tangent sections and on horizontal curves with a centerline radius of curve less than 1,000 feet.
5. Within a superelevation transition on horizontal curves having centerline curve radius less than 1,000 feet, e.g., curves, turn lanes, ramps, tapers, and other non-mainline pavements.
6. Within 15 feet of transverse joint that separates pavement from existing pavement not constructed under the contract, or from bridge deck or approach slab for longitudinal profiling.
7. At miscellaneous areas of improvement where width is less than 11 feet, such as medians, gore areas, and shoulders.
8. As otherwise directed by the Engineer. The Engineer may confine the checking of through traffic lanes with the straightedge to joints and obvious irregularities or choose to use it at locations not specifically stated in this Section.

1064 **(b) High-Speed Inertial Profiler**

1065  
1066 There shall be a minimum 3 profile runs per lane, for each wheel path  
1067 (left and right) which is approximately three feet from edge lane line. The  
1068 segment length shall be 0.1 mi. The final segments in a lane that are less  
1069 than 0.1 mi shall be evaluated as an independent segment and pay  
1070 adjustments will be prorated for length. The profiles shall be taken in the  
1071 direction of traffic only.

1072  
1073 The latest version of FHWA ProVAL software shall be used to conduct  
1074 profile analysis to determine IRI and areas of localized roughness. The IRI  
1075 values shall be reported in units of in/mi.

1076  
1077 Areas of localized roughness will be identified by using ProVAL's  
1078 "Smoothness Assurance" analysis, calculating IRI with a continuous short  
1079 interval of 25 feet and the 250-mm filter applied.

1080  
1081 Additional runs may be required by the Engineer if the data indicate a  
1082 lack of repeatability of results. A 92% agreement is required for repeatability  
1083 and IRI values shall have at minimum a 95% confidence level.

1084  
1085 **(N) Required Pavement Smoothness**

1086  
1087 The IRI for the left and right wheel paths in an individual lane will be  
1088 computed and then averaged to determine the Mean Roughness Index (MRI)  
1089 values. The MRI will be used to determine acceptance and pay adjustment.  
1090 Each lane shall be tested and evaluated separately.

1091  
1092 There are three (3) categories of target MRI values:

1093

<b>TABLE 401.03-2 – PAVEMENT SMOOTHNESS CATEGORIES</b>		
Category	Description	MRI
Type A	Three or more opportunities for improving ride	Shall not exceed 60 in/mi
Type B	Two opportunities for improving ride	Shall not exceed 70 in/mi
Type C	One opportunity for improving ride	Shall not exceed 75 in/mi

1094  
1095 An opportunity for improving ride is considered as one (1) lift of asphalt  
1096 pavement, including but not limited to HMAB, HMA, PMA, and SMA.

1097  
1098 For the location where a 10-foot manual straightedge is required, the  
1099 surface shall not vary more than 3/16 inch from the lower edge of a  
1100 straightedge.



1101  
1102 No pre-final inspection, final inspection, and substantial completion  
1103 granted will be made until the pavement meets smoothness requirement and  
1104 all required profile reports are submitted to the Engineer and MTRB and are  
1105 accepted.

1106  
1107 **(O) Request for Profile Testing by the Department.**

1108  
1109 For Type C, prior to pavement activities, the Engineer will measure the  
1110 smoothness of the existing pavement.

1111  
1112 The Contractor shall submit a written request to the Engineer to  
1113 perform all required profile tests.

1114  
1115 The request shall be made at least 30 days before desired testing date  
1116 and shall include an approximate acceptance profile testing date, a plan view  
1117 drawing of the area to be tested with the limits of the test area highlighted.

1118 The Contractor shall reimburse HDOT for any incurred cost related to  
1119 any Contractor-caused cancellation or a deduction to the monthly payment  
1120 will be made.

1121  
1122 **(P) Department Requirements for Profile Testing.** When a request for  
1123 testing is made, the requested area to be tested shall be 100% of the total  
1124 area indicated to be paved in the Contract Documents unless the requirement  
1125 is waived by the Engineer and MTRB.

1126  
1127 Department acceptance surface tests will not be performed earlier  
1128 than 14 days after HMA placement.

1129  
1130 Clean debris and clear obstructions from area to be tested, as well as  
1131 a minimum of 100 feet before and beyond the area to be tested before testing  
1132 starts for use as staging areas. Provide traffic control for all profile testing.

1133  
1134 The Engineer or MTRB or both may cancel the profile testing if the test  
1135 area is not sufficiently clean, traffic control is unsatisfactory, or the area is not  
1136 a safe work environment or test area does not meet Contract Document  
1137 requirements. This canceled profile test will count as one profile test.

1138  
1139  
1140 **(Q) Cost of Acceptance Profile Testing by The Department.** The  
1141 Engineer, MTRB, or State's Third-Party Consultant will perform one initial  
1142 profile test, at no cost to the Contractor for each area to be tested.

1143  
1144 The Department's High-Speed Inertial Profiler pavement profile will be  
1145 used to determine if the pavement's profile, i.e., smoothness is acceptable.

1147 If the profile of the pavement does not meet the requirements of the  
1148 Contract Documents, the Contractor shall perform remedial work, i.e.  
1149 corrective work then retest the area to ensure that the area has the required  
1150 MRI, i.e., smoothness, before requesting another profile test by the Engineer.  
1151

1152 **(1) Additional testing.** Additional testing, by the Department  
1153 beyond the initial test will be performed at cost to the Contractor as  
1154 follows:  
1155

1156 **(a)** \$2,500 per test will be required when Department  
1157 personnel or State's Third-Party Consultant is used.  
1158

1159 **(R) Remedial Work for Pavements.**  
1160

1161 **(1)** Corrective work shall be required for any 25 ft interval with a  
1162 localized roughness in excess of 160 in/ mi. The Engineer may waive  
1163 localized roughness requirements for deficiencies resulting from  
1164 manholes or other similar appurtenances. Adjust manholes or other  
1165 similar appurtenances so that using a 10-ft. straightedge the area  
1166 around that manhole or other similar appurtenance shall not have  
1167 more than 3/16-in. variation between any 2 contacts on the  
1168 straightedge.  
1169

1170 If corrective action is not successful, the Engineer may require  
1171 continued corrective action, or apply a payment adjustment of \$250  
1172 per occurrence.  
1173

1174 **(2)** Corrective work shall also be required for any 0.1 mile interval  
1175 with an average MRI above 95.0 in/mi for Types A and B. For Type A,  
1176 correct the deficient section to an MRI of 60 in/mi or less. For Type B,  
1177 correct the deficient section to an MRI of 70 in/mi or less. For Type C,  
1178 corrective work may be required by the Engineer for 0.1 mile intervals  
1179 that have an average MRI above the threshold shown in Table  
1180 401.03-4 - Smoothness Pay Disincentives with MRI and  
1181 Table 401.03-5 - Smoothness Pay Disincentives For Percent  
1182 Improvement, as applicable.  
1183

1184 If corrective action does not produce the required improvement, the  
1185 Engineer may require continued corrective action, or apply payment  
1186 adjustment as shown in Table 401.03-4 - Smoothness Pay  
1187 Disincentives with MRI and Table 401.03-5 - Smoothness Pay  
1188 Disincentives For Percent Improvement  
1189

1190 **(3)** The Contractor shall notify the Engineer at least 24 hours prior  
1191 to commencement of the corrective work. The Contractor shall not

1192  
1193  
commence corrective work until the methods and procedure have been approved in writing by the Engineer.

**(4)** All smoothness corrective work for areas of localized roughness shall be for the entire lane width. Pavement cross slope shall be maintained through corrective areas.

**(5)** The remedial repair areas shall be neat, rectangular areas having a uniform surface appearance.

**(6)** If grinding is used on HMA pavement, the surface shall have nearly invisible grinding marks to passing motorist.

**(7)** Other methods may include milling and overlaying HMA pavement. The length, depth of the milling and the replacement material will be solely decided by the Engineer.

**(8)** The finished repaired pavement surface shall leave no ridges or valleys or fins of pavement other than those allowed below.

**(9)** Remedial repairs shall not leave any drainage structures' inlets higher than the surrounding pavement or alter the Contract Document's drainage pattern.

**(10)** For items in the pavement other than drainage structures, e.g., manhole frame and covers, survey monuments, expansion joints etc., the finish pavement, ground or not, shall not be more than 1/4 inch in elevation difference. Submit to the Engineer remedial repair method to correct these conditions for acceptance.

**(11)** Pick up immediately grinding operation residue by using a vacuum attached to grinding machine or other method acceptable to the Engineer.

**(a)** Any remaining residue shall be picked up before the end of shift or before the area is open to traffic, whichever is earlier.

**(b)** Prevent residue from flowing across pavement or from being left on pavement surface or both.

**(c)** Residue shall not be allowed to enter the drainage system.

**(d)** The residue shall not be allowed to dry or remain on the pavement.

1238  
1239  
(e) Dispose of all material that is the result of the remedial repair operation, e.g., HMA residue, wastewater, and dust at a legal facility.

(12) Complete corrective work before determining pavement thickness for HMA pavements in accordance with Subsection 401.03(I) – HMA Pavement Thickness Tolerances.

(13) All HMA wearing surface areas that have been ground shall receive a coating, e.g., a coating material that will restore any lost impermeability of the HMA due to the grinding of the surface. The coating used shall not be picked up or tracked by passing vehicles or be degraded after a short period of time has passed, i.e., it shall have a service life equal to or greater than the HMA pavement. The coating shall not decrease the pavement's friction value. The coating's limits shall be the full width of the lane regardless how small. If the remedial repair area extends into the next lane, then the repair area will be full lane width also. Extend the length of coating areas in order for the coating area to look like the rest of the road and does not have patches on it, i.e., make the road look uniform in color. The coating shall be of a color that matches the surrounding pavement. The areas receiving the coating shall not be open to traffic until it has cured enough so that it cannot be picked up or tracked by passing vehicles or degrade. Submit means and methods of the coating and type of coating to the Engineer or MTRB for review and acceptance. Do not proceed with the coating without acceptance from the Engineer.

(14) Recompact cold HMA, i.e., HMA that has reached ambient temperature is not an acceptable remedial repair method.

(15) Replace all pavement markings damaged or discolored by remedial repairs.

(16) Reprofile the corrected area and provide the Engineer the results that show the corrective action, i.e., remedial repairs were successful.

**(S) Pavement Smoothness and Acceptance.**

(1) Price and payment in various paving sections, e.g., 401 (Hot Mix Asphalt Pavement), shall be full compensation for all work and materials specified in the various paving sections and this section, including but not limited to furnishing all labor, materials, tools, equipment, testing, incidentals and for doing all work involved in micro milling, milling (cold planing), grinding existing or new pavement, removing residue, cleaning the pavement, necessary disposal of

1284  
 1285  
 1286  
 1287  
 1288  
 1289  
 1290  
 1291  
 1292  
 1293

residue, furnishing of any water or air used in cleaning the pavement and any other related ancillary work or material or services. Also, it includes any remedial work, e.g., re-paving, surface grinding, application of a coating, curing compound, and replacement of damaged pavement markings.

(2) The contract price in those sections may be adjusted for pavement smoothness by the Engineer. The pavement smoothness contract unit price adjustments and work acceptance will be made in accordance with the following schedules.

<b>TABLE 401.03-3 –SMOOTHNESS PAY INCENTIVES</b>		
<b>Category</b>	<b>MRI (in/mi)</b>	<b>Pay Adjustment \$ per 0.1 mi</b>
Type A	<30.0	\$580
	30.0- less than 35.0	\$480
	35.0- less than 40.0	\$380
	40.0- less than 45.0	\$280
	45.0- less than 50.0	\$180
	50.0- less than 55.0	\$80
	55.0- less than 60.0	\$0
Type B	<35.0	\$420
	35.0- less than 40.0	\$360
	40.0- less than 45.0	\$300
	45.0- less than 50.0	\$240
	50.0- less than 55.0	\$180
	55.0- less than 60.0	\$120
	60.0- less than 65.0	\$60
	65.0- less than 70.0	\$0
Type C	<40.0	\$280
	40.0- less than 45.0	\$240
	45.0- less than 50.0	\$200
	50.0- less than 55.0	\$160
	55.0- less than 60.0	\$120
	60.0- less than 65.0	\$80
	65.0- less than 70.0	\$40
	70.0- less than 75.0	\$0

1294

(3) Pay Pavement Smoothness Adjustment will be based on the

1295  
1296  
initial measured MRI for both left and right wheel path, prior to any corrective work for the 0.10-mile section, except for sections that the Contractor has chosen to remove and replace. For sections that are replaced, assessments will be based on the MRI determined after replacement.

**(a)** The Pavement Smoothness Adjustment will be computed using the plan surface area of pavement shown in the Contract Documents. This Pavement Smoothness Adjustment will apply to the total area of the 0.10-mile section for the lane width represented by MRI for the same lane. It does not include any other price adjustments specified in the Contract Documents. Those price adjustments will be, for each adjustment, calculated separately using the original contract price to determine the amount of adjustment to be made to the contract price. Sections shorter than 0.1 mile and longer than 50 feet shall be prorated.

**(b)** For 0.1 mile intervals with an average MRI above the threshold shown in Table 401.03-3 - Smoothness Pay Incentives, the Engineer shall apply a disincentive payment adjustment up to the limit shown.

i. For Types A and B, payment adjustments shall be applied up to an MRI of 95.0 per Table 401.03-4 - Smoothness Pay Disincentives with MRI.

ii. For Type C, the payment adjustment shall be dependent on the average MRI of the pavement prior to paving activities

1. If the MRI of the pavement prior to paving activities is 125.0 in/mi or less, the payment adjustment shall be per Table 401.03-4 - Smoothness Pay Disincentives with MRI.

2. If the MRI of the pavement prior to paving activities is more than 125.0 in/mi, the disincentive payment adjustment shall be per Table 401.03-5 - Smoothness Pay Disincentives for Percent Improvement, and based on the percent improvement using the following formula:

$$\% \text{ Improvement} = (\text{Initial segment MRI} - \text{Final segment MRI}) \times 100 / (\text{Initial Segment MRI})$$

1340

<b>TABLE 401.03-4 –SMOOTHNESS PAY DISINCENTIVES WITH MRI</b>		
<b>Category</b>	<b>MRI (in/mi)</b>	<b>Pay Adjustment \$ per 0.1 mi</b>
Type A	60.0- less than 65.0	-\$100
	65.0- less than 70.0	-\$250
	70.0- less than 75.0	-\$350
	75.0- less than 80.0	-\$450
	80.0- less than 85.0	-\$550
	85.0- less than 95.0	-\$650
	> 95.0	Corrective Work
Type B	70.0- less than 75.0	-\$100
	75.0- less than 80.0	-\$200
	80.0- less than 85.0	-\$300
	85.0- less than 95.0	-\$400
	> 95.0	Corrective Work
Type C (pre-paving MRI < 125)	75.0- less than 80.0	-\$50
	80.0- less than 85.0	-\$100
	85.0- less than 90.0	-\$150
	90.0- less than 100.0	-\$200
	>100.0	-\$250

1341

<b>TABLE 401.03-5 –SMOOTHNESS PAY DISINCENTIVES FOR PERCENT IMPROVEMENT</b>		
<b>Category</b>	<b>Percent Improvement %</b>	<b>Pay Adjustment \$ per 0.1 mi</b>
Type C	≥ 40	\$0
(pre-paving MRI > 125)	20.0- less than 40.0	-\$100
	< 20	-\$200

1342

1343

1344

1345

1346

1347

1348

(c) Incentives will not apply to areas where payment deductions or remedial repairs has been made for non-compliant work, e.g., low compaction, thin pavement, thermal segregation, low compressive or flexural strength, non-compliant alignment. Incentives will also not apply to areas where corrective work was required to meet contract

1349  
1350  
smoothness requirements, unless the pavement section was replaced. All areas where corrective work was performed shall be tested again to ensure the smoothness requirements are met.

**(d)** There will be no incentive price adjustments to the contract prices regardless of the pavement meeting the Contract Documents' requirements for incentive contract price adjustment, when 25% of the total area paved of that particular type of pavement on the project has failed to meet any of the Contract document requirements, e.g., smoothness, thickness, unit weight, asphalt content, pavement defects, compaction, flexural or compressive strength. Areas exempt from the smoothness requirements may not be included in the total area calculation unless it is non-compliant.

**(e)** For contracts using lump sum the method described in Subsection 104.06 Methods of Price Adjustment paragraph (3), will be used to calculated proportionate unit price, i.e., the Engineer's calculated theoretical unit price. This calculated proportionate unit price will be used to calculate the unit price adjustment.

**401.04 Measurement.**

**(A)** The Engineer will measure HMA and PMA pavement per ton in accordance with the Contract Documents.

**(B)** Engineer will measure additional State pavement profiling work when applicable on a cost-plus basis as specified in this section and as ordered by Engineer. The Engineer will issue a billing for the pavement profile work done for the time period with the invoices and receipts that the billing was based on attached to the Contractor for each contract item. The Contractor's pavement profile work required in this section will not be measured and will be considered incidental to the various paving items unless stated otherwise.

**401.05 Payment.** The Engineer will pay for the accepted HMA or PMA pavement at the contract price per pay unit, as shown in the proposal schedule. Payment will be full compensation for the work prescribed in this section and the contract documents.

**(A)** Price and payment in Section 401 – HMA Pavement will be full compensation for all work and materials specified in this Section including furnishing all labor, materials, tools, equipment, testing, pavement profiles and incidentals and for doing all work involved in grinding existing or new pavement, removing residue, and cleaning the pavement, including



1395 necessary disposal of residue and furnishing any water or air used in  
1396 cleaning the pavement and remedial work needed to conform to the  
1397 requirements of the Contract Documents.

1398  
1399 **(B)** No payment for the Contractor's pavement profile work required in this  
1400 section will be made. The Contractor's pavement profile work shall be  
1401 considered incidental to the various paving items unless stated otherwise.

1402  
1403 **(C)** Engineer will pay or deduct for the following pay items when included  
1404 in proposal schedule:

1405	<b>Pay Item</b>	<b>Pay Unit</b>
1406		
1407		
1408	Pavement Smoothness Incentive	Allowance
1409		
1410	_____ HMA Pavement Speed Table, Mix No. _____	Ton
1411		
1412	_____ PMA Pavement, Mix No. _____	Ton
1413		

1414 **(1)** 70% of the contract unit price or the theoretical calculated unit  
1415 price upon completion of submitting a job-mix formula acceptable to  
1416 the Engineer; preparing the surface, spreading, and finishing the  
1417 mixture; and compacting the mixture.

1418  
1419 **(2)** 20% of the contract unit price or the theoretical calculated unit  
1420 price upon completion of cutting samples from the compacted  
1421 pavement for testing; placing and compacting the sampled area with  
1422 new material conforming to the surrounding area; protecting the  
1423 pavement; and compaction acceptance. Maintain temporary  
1424 pavement markings and other temporary work zone items, maintain a  
1425 clean work site.

1426  
1427 **(3)** 10% of the contract unit price or calculate the unit price when  
1428 the final configuration of the pavement markings is in place.

1429  
1430 The Engineer will pay for adjusting existing frames and covers and valve  
1431 boxes in accordance with and under Section 604 – Manholes, Inlets and Catch  
1432 Basins. Adjustments for existing street survey monument frames and covers will be  
1433 paid for as if each were a valve box frame and cover.

1434  
1435 The Engineer may, at his sole discretion, in lieu of requiring removal and  
1436 replacement, use the sliding scale factor to accept HMA pavements compacted  
1437 below 93.0 percent and above 97.0 percent. The Engineer will make payment for  
1438 the material in that production day, if the Engineer decides to use a sliding scale  
1439 factor, at a reduced price arrived at by multiplying the contract unit price by the pay  
1440 factor. The Engineer is not obligated to allow non-compliant work to remain in place

1441 and may at any time chose not to use a sliding scale factor method of payment and  
1442 instead require removal of the noncompliant pavement that is greater than 97.0 or  
1443 less than 93.0.  
1444

1445 In compliance with Subsection 105.12 Removal of Non-Conforming and  
1446 Unauthorized Work remove and replace HMA compacted below 90.0 percent.  
1447

1448 The Engineer will solely decide if the noncompliant work would be acceptable  
1449 if a reduced payment for the noncompliant work is made. The Engineer is not  
1450 obligated to allow noncompliant work to remain in place and may at any time choose  
1451 not to use a sliding scale factor method of payment as a method of resolution.  
1452 Instead, utilize the remedy allowed in Subsection 105.12 Removal of Non-  
1453 Conforming and Unauthorized Work, requiring removal of the noncompliant  
1454 pavement, shall be used.  
1455

1456 Such a reduced payment, if made and accepted by the Contractor, shall be  
1457 a mutually agreeable resolution to the noncompliant work being addressed. If it is  
1458 not mutually acceptable, the noncompliant work shall be removed. If the reduced  
1459 payment is acceptable; the Engineer will make the reduced payments for the  
1460 noncompliant work in accordance with Table 401.05-2 - Sliding Scale Pay Factor  
1461 for Compaction. The amount of tonnage to be reduced will be determined by the  
1462 Engineer by using the initial cores taken on the mat. No additional cores shall be  
1463 taken to determine the limits of the non-compliant area unless requested by the  
1464 Engineer.  
1465

1466 The Engineer, for determining the reduced tonnage for noncompliant work,  
1467 will assume the level of compaction is linear and will proportion the compaction level  
1468 from the last core that indicated an acceptable compaction level to the nearest core  
1469 indicating a noncompliant compaction level to determine the calculated limit of  
1470 acceptable compaction. The length will be the linear distance between the cores  
1471 measured along the baseline. If there is no core that was taken for the shift's or  
1472 day's work that were compliant then the limit will be the end or start of the day's or  
1473 shift's work. The width will be the nominal paving width. Use the day's specific  
1474 gravity of the mix to determine tonnage. The thickness will be the nominal paving  
1475 thickness.  
1476

1477 The total reduced noncompliant tonnage to be paid will be determined by  
1478 multiplying the applicable percent of reduction by the computed tonnage of the  
1479 noncompliant work. Percent of Quantity Paid shall be the percentage shown in  
1480 Table 401.05-2 - Sliding Scale Pay Factor for Compaction. The reduced tonnage  
1481 shall be used as the payment quantity for the noncompliant work. The reduced  
1482 quantity paid that is used for the monthly payment will be arrived at by multiplying  
1483 the contract unit price by the reduced tonnage.  
1484

1485  
1486

<b>Table 401.05-2 – Sliding Scale Pay Factor for Compaction</b>	
<b>Percent Compaction</b>	<b>Percent of Quantity Paid</b>
> 98.0	Removal
>97.0 - 98.0	95
93.0- 97.0	100
90.0 - <93.0	80
<90.0	Removal

1487  
1488  
1489  
1490  
1491

**END OF SECTION 401”**



47 grade. Discontinue concrete placement when settlements deviate more than ±  
48 3/8 inch from those indicated on falsework drawings. In such affected areas,  
49 provide corrective measures prior to initial set of concrete. Remove  
50 unacceptable concrete.”

51

52 **(VI)** Amend **503.03(C)(1) Construction** by revising the first paragraph  
53 between lines 169 and 172 as follows:

54

55 **(1) Construction.** “Use wood or metal forms that are impervious to  
56 moisture, non-staining to concrete, mortar tight and sufficiently rigid to prevent  
57 distortion due to pressure of concrete and other loads, including vibration,  
58 incidental to construction. Construct and maintain forms to prevent joints from  
59 opening. Formwork joints shall be filled with approved material that is impervious  
60 to moisture, will not stain concrete, and produces tight joints.”

61

62 **(VII)** Amend **503.03(C)(1) Construction** by revising the second paragraph  
63 between lines 174 and 176 to read as follows:

64

65 “Unless otherwise indicated in the contract documents, place minimum ¾  
66 inch by ¾ inch chamfer at sharp edges of exposed concrete surfaces. Give  
67 girder and coping forms bevels or drafts to ensure easy removal.”

68

69 **(VIII)** Amend **503.03(C)(1) Construction** by adding the following sentence to  
70 the ninth paragraph at line 209:

71

72 “The Engineer will stop the use of the forms or forming systems which  
73 produce a concrete surface with excessive undulations until the Contractor  
74 makes modification acceptable to the Engineer.”

75

76 **(IX)** Amend **503.03(C)(2) Form Lumber** by adding the following sentence to  
77 the first paragraph after line 223:

78

79 “When requested by the Engineer, submit certificates verifying grade and  
80 species of any piece of lumber which does not have a grade or species stamp.”

81

82 **(X)** Amend **503.03(D) Removal of Falsework and Forms** by revising Table  
83 503.03-1 – Removal of Falsework and Forms at line 297 to read as follows:

84

85

86

87

88

89

90

91

92

<b>“TABLE 503.03-1 – REMOVAL OF FALSEWORK AND FORMS</b>						
Railing and Barriers – 12 Hours Removal Time						
Beams, Arches, and Other Members – 14 days Removal Time						
Slabs With Maximum Thickness of (Inches)	9		12		More Than 12	
Removal Time (Days)	7		10		14	
Walls, Columns, and Vertical Sides of Beams With Maximum Height of (Feet)	2	5	10	20	30	<b>40 or More</b>
Removal Time (Days)	0.5	1	2	3	5	7
Note: Where forms also support vertical or horizontal loads imposed on slab or beam soffits, use 14 days for removal time.”						

94  
 95  
 96  
**(XI)** Amend **503.03(D) Removal of Falsework and Forms** by deleting the last paragraph between lines 329 and 334.

**(XII)** Amend **503.03(E) Loading** by deleting the words, “except abutment walls and wing walls” in line 337.

**(XIII)** Amend **503.03(F)(1) General** by adding the following paragraphs after line 419:

“At the time of placement, the concrete temperature shall not exceed 90 degrees Fahrenheit.

The rate of evaporation shall be measured by using the nomograph: ACI 308R Figure 4.1 Nomograph for Estimating the Maximum Potential Rate of Evaporation of the Environment Assuming a Water-Covered Surface in Which the Water Temperature Is Equal to the Concrete Temperature or by using an evaporation rate calculator e.g., Kestrel 5200 hat has been reviewed and accepted by the Engineer. Use procedures as stated in ACI 308R Chapter 4 – Monitoring Curing and Curing Effectiveness. Approximately 30 minutes prior to the scheduled start of concrete placement measure the ambient air temperature, relative humidity and wind velocity with industrial grade weather monitoring instruments or with an evaporation rate calculator to determine the on-site evaporation rate. When the rate of evaporation is equal to or exceeds 0.05 lb/sq

118 ft/h fogging shall begin. During the placement of the concrete recalculate  
119 evaporation rate every 15 minutes using new real-time data including actual  
120 temperature of concrete being placed. The concrete shall be fogged before,  
121 during and after finishing. Fogging shall start at the point the bleed water starts to  
122 evaporate. Fogging may stop when the curing compound application is complete.  
123 Fogging shall be accomplished by self-powered atomized mister, e.g. BossTek  
124 DustBoss, that creates a mist of water droplets above the concrete surface that  
125 will float in the air. The droplets should float in the air, not fall on the concrete.  
126 The goal is to humidify the air, not wet the concrete. Let the water evaporate  
127 before finishing. If the concrete is fogger before floating, brooming or trowelling,  
128 do not finish the accumulated surface water into the concrete surface or it will  
129 weaken it. Do not allow water to run off the concrete surface. Adjust foggers or  
130 pause its operation. Foggers shall not drip water on the poured concrete surface.  
131 Point foggers into the air above the concrete pour not at it and not in the direction  
132 of the incoming wind. It shall not be acceptable to use a water hose to spray  
133 water into the air as a substitute. This will be considered adding additional water  
134 to the deck surface. If plastic shrinkage cracks appear during the finishing, the  
135 cracks shall be closed by striking each side of the crack with a float and  
136 refinishing the concrete.”

137  
138 **(XIV) Amend 503.03(F)(2) Box Culverts** by revising the paragraphs from lines  
139 421 to 429 as follows:

140  
141 **(2) Box Culverts.** “Place and allow base slab or footings of box culverts  
142 to set at least 12 hours before constructing remainder of culvert.

143  
144 When constructing box culverts, place and allow concrete in walls to set at  
145 least 12 hours before placing top slab. Provide appropriate keys in  
146 sidewalls for anchoring top slab.”

147  
148 **(XV) Amend 503.03(F)(3) Box Girder Spans** by revising the title Box Girder  
149 Spans at line 431 to read Sequence.

150  
151 **(XVI) Amend 503.03(F)(7) Hot Weather Concreting** by adding the word  
152 “ambient” in front of the word “temperature” at line 560.

153  
154 **(XVII) Amend 503.03(F) Placing Concrete** by adding the following Subsection  
155 after line 565:

156  
157 **“(8) Certified Concrete Flatwork Finisher Requirement.** Perform  
158 the placement, and finishing operations of concrete flatwork with a  
159 minimum ratio of one certified ACI Concrete Flatwork Finisher and  
160 Technician with 4,500 hours of acceptable work experience (certified  
161 craftsman) per three concrete finishers (concrete finishers without ACI  
162 Concrete Flatwork Finisher and Technician certification and 4,500 hours of  
163 acceptable work experience) at each location having flatwork done. The

164 concrete flatwork shall be under the direct supervision of a certified  
165 craftsman. Designate the certified craftsman who will be supervising and  
166 responsible for determining the quality of the finish of the concrete flatwork  
167 being performed. No flatwork shall be performed without the required  
168 amount of certified craftsman present.

169  
170 (a) Flatwork concrete is defined as any concrete work that  
171 requires tools or machines to be used during the placement and  
172 finishing operations of concrete. Concrete flatwork includes  
173 concrete work that requires a specified finishing, smoothness or  
174 rigid surface tolerances such as sidewalks, walkways, Portland  
175 cement concrete pavement, concrete white-topping, girder seats,  
176 pier caps, bridge decks, on-grade concrete slabs, approach slabs,  
177 concrete overlays, and concrete repairs which exceed one square  
178 foot per day.

179  
180 (b) Areas that are not considered flatwork concrete are the top  
181 of foundations or structures that will have backfill material placed  
182 directly on the concrete surface.

183  
184 (c) Submit copies of the craftsman's current ACI certification 30  
185 days before concrete flatwork begins for the Engineer's review and  
186 acceptance. The Engineer has the right to require the removal,  
187 replacement, retraining and re-certification of a certified craftsman if  
188 that person does not, in the opinion of the Engineer, demonstrate  
189 the ability to place and finish concrete in accordance with the  
190 practices recommended in the ACI Concrete Flatwork Finisher  
191 Certification Program and to meet the finishing standards required  
192 by the contract documents.

193  
194 (d) Any cost or impact to the contractor in providing, training,  
195 certification, retraining, replacement or re-certification is incidental  
196 to the contract items that require concrete flatwork.”

197  
198 **(XVIII)** Amend **503.03(G) Joints** by adding the following sentence after line 566:

199  
200 “Prior to backfilling with earth or other materials against the joints, all  
201 construction, expansion, contraction, and control joints shall be waterproofed with  
202 flashing compound waterproofing as detailed in the Standard Plans.”

203  
204 **(XIX)** Amend **503.03(G)(1) Construction Joints** by revising the second  
205 paragraph between lines 572 and 579 to read as follows:

206  
207 “Before placing concrete on substrate concrete at construction joint, the  
208 following work shall be performed:

209



210 (a) Remove laitance, loose particles, dust, dirt, impervious  
211 membrane curing compound, and any other material foreign to the  
212 construction joint and projecting reinforcement.

213  
214 (b) Roughen horizontal construction joint by abrasive blast  
215 cleaning or other approved methods to full amplitude of  
216 approximately ¼ inch.”

217  
218 **(XX)** Amend **503.03(G)(3) Contraction Joints** by revising the first paragraph  
219 from lines 661 to 665 to read as follows:

220  
221 **“(3) Contraction Joints.** Contraction joints in walls and in other  
222 structures shall be spaced at not more than 20 feet on centers and shall  
223 be spaced, at abrupt changes in height or thickness and at obtuse corners  
224 unless otherwise directed by the Engineer.”

225  
226 **(XXI)** Amend **503.03(I)(3) Flashing Compound for Joints** between lines 755  
227 and 757 by deleting this subsection.

228  
229 **(XXII)** Amend **503.03(L) Curing Methods** by adding the following paragraph  
230 after line 794:

231  
232 “The Contractor shall have the option to use curing compound SINAK WCE or  
233 SINAK LITHIUM for bridge structures when approved by the Engineer. Six  
234 copies of the manufacturer’s brochure and certificates of test results shall be  
235 submitted. All work shall conform with the manufacturer’s recommendations.”

236  
237 **(XXIII)** Amend **503.03(L)(2) Impervious Membrane Curing** by revising the third  
238 sentence of the first paragraph from lines 818 to 819, to read as follows:

239  
240 “Use ratio of at least one gallon for each 100 square feet of concrete  
241 surface.”

242  
243 **(XXIV)** Amend **503.03(L)(2) Impervious Membrane Curing** by adding the  
244 following sentences to the first paragraph after line 819:

245  
246 “The curing compound shall be applied to the concrete following the surface  
247 finishing operation, immediately before the moisture sheen disappears from the  
248 surface, but before any drying shrinkage or craze cracks begin to appear. In the  
249 event of any drying or cracking of the surface, application of water with an  
250 atomizing nozzle (fog spray) as specified in Section 503.03(L)(1), “Water Curing”,  
251 shall be started immediately and shall be continued until application of the  
252 compound is resumed or started; however, the compound shall not be applied  
253 over any resulting freestanding water. Should the film of compound be damaged  
254 from any cause before the expiration of 7 days after the concrete is placed in the

255 case of structures and 72 hours in the case of pavement, the damaged portion  
256 shall be repaired immediately with additional compound.”

257

258 **(XXV) Amend 503.03(L)(2) Impervious Membrane Curing** by revising the last  
259 sentence of the second paragraph between lines 822 and 825 as follows:

260

261 “Do not apply membrane curing compound on surfaces to which concrete  
262 is to be bonded or to which waterproofing or epoxy is to be applied.”

263

264 **(XXVI) Amend 503.03(M) Finishing Concrete Surfaces** by adding the following  
265 sentences at line 841:

266

267 “No additional water shall be added to the concrete surfaces in an effort to  
268 aid the finishing operation as the application of water to aid the finishing  
269 operation will result in the rejection of the concrete pour. Finishing aids or  
270 evaporation retarders may be used only with written authorization by the  
271 Engineer. Only finishing aids shall be used to finish the concrete surface and  
272 only evaporation retarders used to minimize the evaporation rate of the plastic  
273 concrete. These solutions shall not be used interchangeably.”

274

275 **(XXVII) Amend 503.03(M)(3)(a)1. Machine Finishing** by adding the following  
276 sentences at the end of the second paragraph at line 1021:

277

278 “The screed rails shall be adjustable for elevations. The screed shall be  
279 set to elevations, with allowances for anticipated settlement, camber and  
280 deflection, as required to form the surface of the bridge deck to the line and  
281 grade shown in the contract. The Contractor shall install screed rail type such  
282 that the rails shall not deflect appreciably under the applied loads. The supports  
283 for the screed rails shall not be placed within the full width of the bridge.

284

285 The Contractor shall not apply any additional water to the deck surface in  
286 an effort to aid his finishing operation. The unauthorized application of water will  
287 result in the rejection of that day’s concrete placement.”

288

289 **(XXVIII) Amend 503.03(M)(3)(a)1. Machine Finishing** by deleting the last three  
290 paragraphs between lines 1098 to 1111 and adding the following five  
291 paragraphs:

292

293 “Concrete bridge decks, concrete sleeper slabs, and concrete approach  
294 slabs shall be textured longitudinally by mechanical grooving. Grooves shall be  
295 cut into the hardened concrete using a mechanical water-cooled diamond edge  
296 blade saw device which shall produce straight uniformly spaced grooves spaced  
297 at 3/4 inch. The groove width shall be 1/8 inch plus or minus 0.02 inch and the  
298 groove depth shall be 1/8 inch plus 1/16 inch or minus zero inches.

299

300 If grooves cannot be cut into a continuous longitudinal operation, the  
301 continuation of grooves shall be aligned such that joints are not visible.  
302

303 Before grooves are cut into the accepted hardened concrete, the upper  
304 1/8 inch of the concrete surface for the bridge deck, approach slabs, and sleeper  
305 slabs shall be removed by grinding. Grooving shall be done after the concrete  
306 has attained sufficient strength to prevent spalling and raveling, and before the  
307 structure is opened to traffic.  
308

309 A working drawing to control, collect and dispose of run-off water at an  
310 accepted off-site facility shall be submitted to the Engineer.  
311

312 The requirements of Section 411.03(N) Surface Test shall apply to  
313 concrete bridge decks and concrete approach slabs. If additional grinding is  
314 required to achieve the specified profile index, the grinding shall be performed  
315 prior to the mechanical grooving and shall be done only in the longitudinal  
316 direction.”  
317

318 **(XXIX) Amend 503.03(M)(3)(b) Sidewalk and Median Strip** by revising the first  
319 and second paragraphs from lines 1182 to 1191 to read as follows:  
320

321 **(b) Sidewalks and Median Strips.** “Provide final finish for concrete  
322 sidewalks and median strips using wooden float and broom finish. Do not plaster  
323 surface. Use edging tool with ¼-inch radius to finish outside edges of sidewalk.  
324 Finish sidewalk as plane surface with 2-percent (allowable construction tolerance  
325 of plus or minus 0.4 percent maximum) cross slope towards roadway. Test  
326 surface of concrete sidewalk with 10-foot straightedge. Correct any deviation in  
327 excess of ¼ inch.”  
328

329 **(XXX) Amend 503.03 Construction** by adding subsection 503.03(0) beginning  
330 at line 1200 as follows:  
331

332 **“(0) Tolerance for Concrete Construction and Materials.** Conform to  
333 the stricter of tolerances specified in the specifications, ACI 117 Standard  
334 Specifications for Tolerance for Concrete Construction and Materials, PCI  
335 Tolerance for Precast and Prestressed Concrete, and PCI MNL-116 Manual for  
336 Quality Control of Plants and Production of Structural Precast Concrete  
337 Products.”  
338

339 **(XXXI) Amend 503.04 Measurement** by revising lines 1201 to 1205 to read as  
340 follows:  
341

342 **“503.04 Measurement.** The Engineer will not measure concrete when  
343 contracted on a lump sum basis.  
344

345 The Engineer will not make deductions for the volume occupied by  
346 reinforcing steel, piles, floor drains, weepholes, timber bumpers, pipes less  
347 than eight (8) inches, conduits, or expansion joint materials.”  
348

349 **(XXXII)** Amend **503.05 Payment** by revising lines 1206 to 1223 to read  
350 as follows:

351  
352 **“503.05 Payment.** The Engineer will pay for the accepted quantities of  
353 concrete complete in place and the accepted mechanical grooving and grinding  
354 at the contract lump sum price for the pay items listed below and contained in the  
355 proposal.  
356

357 The contract lump sum amount paid shall be full compensation for  
358 mechanical grooving; for grinding upper concrete deck surface; for the concrete;  
359 for placing, curing and finishing; for furnishing materials including admixtures and  
360 cement (including extra cement added to concrete deposited under water); for  
361 furnishing and installing drains, scuppers, premolded joint fillers, joint seals,  
362 waterproofing at construction joints, waterstops, pipes and conduits; for  
363 furnishing and installing metal rockers, anchor bolts, structural shapes for  
364 expansion joints and other similar items; for timber bumpers, forms, form lining  
365 and falsework or centering, bearing pads, structural steel bearing plates; and for  
366 equipment, tools, labor, materials and incidentals necessary to complete the  
367 work.  
368

369 The Engineer will pay for the following pay item when included in the  
370 proposal schedule:

371	372 Pay Item	373 Pay Unit
374	Concrete for _____	Lump Sum
375	(Class _____ if applicable)	
376		
377	Blanket Grinding and Mechanical Grooving	Lump Sum
378	for _____	
379		
380	Concrete Head Wall, 3.00 feet to 3.99 feet	Lump Sum
381		
382	Concrete Head Wall, 4.00 feet to 4.99 feet	Lump Sum
383		
384	Concrete Head Wall, 5.00 feet to 5.99 feet	Lump Sum
385		
386	Concrete Head Wall, 10.00 feet to 10.99 feet	Lump Sum
387		

388 The Engineer will pay for excavation and backfill for foundations in accordance  
389 with and under Section 205 – Excavation and Backfill for Bridge and Retaining  
390 Structures and Section 206 – Excavation and Backfill for Drainage Facilities.”

391  
392  
393  
394

**END OF SECTION 503**



48           The Engineer will pay for each of the following pay items when included in  
49 the proposal schedule:

50		
51	<b>Pay Item</b>	<b>Pay Unit</b>
52		
53	_____ - Inch Ductile Iron Pipe, Class 53	Linear Foot
54		
55	_____ - Inch Bevel Geared Gate Valve	Each
56		
57	_____ - Inch Gate Valve	Each
58		
59	_____ - Inch ARV	Each
60		
61	_____ - Inch Offset ARV	Each
62		
63	Relocate Water Service Lateral at Station 144+92.6	Lump Sum
64		
65	Fire Hydrant	Each
66		
67	Cathodic Protection	Lump Sum
68		
69	Temporary Waterline By-Pass _____	Lump Sum
70		
71	Relocate Irrigation System	Force Account'

72

73           An estimated amount for force account is allocated in proposal schedule  
74 under 'Relocate Irrigation System', but actual amount to be paid will be the sum  
75 shown on accepted force account records, whether this sum be more or less  
76 than estimated amount allocated in proposal schedule. The Engineer will pay for  
77 additional grubbing requested by the Engineer that are beyond the scope of the  
78 original contract work on a force account basis. No progress payment will be  
79 authorized until the Engineer accepts additional grubbing in writing."

80  
81  
82  
83

**END OF SECTION 624**

1 Make this section a part of the Standard Specifications:  
2

3 **“SECTION 651 - HORIZONTAL DIRECTIONAL DRILLING**  
4  
5

6 **651.01 Description.** This work shall consist of furnishing and installing  
7 underground pipelines using the horizontal directional drilling (HDD) method of  
8 installation, also commonly referred to as directional boring or guided horizontal  
9 boring.  
10

11 **651.02 Materials.** Materials shall be approved by the Engineer prior to use.  
12

13 (A) HDD Pipe. HDD pipe shall be high density polyethylene (HDPE) pipe  
14 meeting the requirements of Subsection 706.10 – High Density  
15 Polyethylene Pipe.  
16

17 **651.03 Construction** The requirements set forth herein specify a wide range  
18 of procedural precautions necessary to ensure that the very basic, essential  
19 aspects of a proper directional bore installation are adequately controlled. Strict  
20 adherence is required under specifically covered conditions outlined in this  
21 specification. Adherence to the specifications contained herein, or the Engineer's  
22 approval of any aspect of any directional bore operation covered by this  
23 specification, shall in no way relieve the Contractor of their ultimate responsibility  
24 for the satisfactory completion of the work authorized under the Contract.  
25

26 (A) Qualifications. HDD installer shall have demonstrated by previous  
27 experience ability to do the work. The required previous experience of the  
28 Contractor shall consist of having performed a minimum of five horizontal  
29 directional drill installations of 500 feet or more using 6" or greater diameter  
30 pipe. The Supervisor must have at least two years directional drilling  
31 experience. A competent and experienced supervisor representing the  
32 Drilling Contractor shall be present at all times during the drilling operations.  
33 The HDD operator shall have at least two years of experience and shall  
34 have worked on at least two projects using the same equipment proposed  
35 for this project in similar ground conditions.  
36

37 (B) Submittals  
38

39 Work Plan. Prior to beginning work, the Contractor shall submit to  
40 the Engineer a general work plan outlining the procedure and  
41 schedule to be used to execute the work. The work plan shall include  
42 a list of subcontractors, details of the proposed method of  
43 construction and the sequence of operations to be performed during  
44 construction, a safety plan, a traffic control plan, an environmental  
45 protection plan and contingency plans for possible problems. In  
46 addition, the Contractor shall submit drawings showing the layout of  
47 the HDD equipment, and location of the entry and exit pits.



48  
49  
(1) Equipment. The Contractor shall submit specifications on all directional drilling equipment to be used to ensure that the equipment will be adequate to complete the work.

(2) Materials. Specifications on material to be used, including pipe and method(s) for joining pipe, shall be submitted to the Engineer.

(3) Qualifications. The Contractor shall submit information to verify that the HDD installer meets the required qualifications specified in this Section. As part of the bid submission, include contact information of the responsible party for each installation listed.

(4) Detailed Bore Plan. Following completion of the required field exploratory work and prior to HDD installation, the Contractor shall submit for approval a detailed bore plan. At a minimum, the bore plan shall include pipe bell and barrel diameters, bore path inside diameter, entry and exit points, entry and exit angles, any horizontal bend radii, and a profile showing points of tangent and curvature, vertical radii, and the depth of the bore along the alignment.

(5) Calculations. The Contractor shall submit calculations demonstrating that the HDPE pipe selected can support the maximum anticipated earth loads and superimposed live loads, which may be imposed on the pipe. Submit calculations to determine the additional stresses (such as pull back forces) imposed on the pipe during pull back operations and upgrade the quality and strength of the pipe to the extent necessary to withstand the additional stresses imposed by the HDD operation. The maximum calculated pulling force shall not exceed the manufacturer's or supplier's recommended yield tensile strength and factor of safety for the proposed pipe material and fused joints.

(6) As-Built Drawings. The Contractor shall submit, no later than one week after completion of the HDD work, the as-built alignment of the utility line installed by HDD.

(7) All submittals shall be in accordance with Section 105 – Control of Work.

**(C) Equipment Requirements.**

(1) Work Included. The directional drilling equipment shall consist of a directional drilling rig of sufficient capacity to perform the

95  
96  
bore and pull-back the pipe, a drilling fluid mixing and delivery system of sufficient capacity to successfully complete the work, a guidance system to accurately guide boring operations, and trained and competent personnel to operate the system. Equipment shall include a vacuum trailer to withdraw excess drilling fluid and a drilling fluid cleaning system truck for mixing and recycling drilling fluid. All equipment shall be in good, safe, operating condition with sufficient supplies, materials, and spare parts on hand to maintain the system in good working order for the duration of the work.

**(2) Drilling System.**

**(a) Drilling Rig.** The directional drilling machine shall consist of a hydraulically powered system to rotate, push, and pull hollow drill pipe into the ground at a variable angle while delivering a pressurized fluid mixture to a guidable drill (bore) head. The machine shall be anchored to the ground to withstand the pulling, pushing, and rotating pressure required to complete the crossing. The hydraulic power system shall be self-contained with sufficient pressure and volume to power drilling operations. The hydraulic system shall be free of leaks. The rig shall have a system to monitor and record maximum pull-backpressure during pull-back operations, and shall be grounded during drilling and pull-back operations. There shall be a system to detect electrical current from the drill string and an audible alarm, which automatically sounds when an electrical current is detected.

**(b) Drill Head.** The drill head shall be steerable by changing its rotation and shall provide the necessary cutting surfaces and drilling fluid jets.

**(c) Mud Motors.** Mud motors (where required) shall be of adequate power to turn the required drilling tools.

**(d) Drill Pipe.** Select the appropriate drill rod to be used for the installation of the product pipe along the planned alignment and in the anticipated subsurface conditions. Submit certified statement that the drill pipe has been inspected and is in satisfactory condition for its intended use.

**(3) Guidance System.** The guidance system shall be of a proven type (walkover guidance systems are not acceptable for this project) and shall be set up and operated by personnel trained and experienced with the system. If using a magnetic system, the operator shall be aware of any magnetic anomalies and shall consider such influences in the operation of the guidance system.

142  
143  
The guidance system shall be capable of knowing, at all times during the drilling operations, the exact location (vertical, horizontal, and degree of inclination) of the drill head. The guidance system shall be accurate to 2% of the vertical depth of the borehole at sensing position at depths up to one hundred feet and accurate within 1.5 meters horizontally.

**(4) Drilling Fluid (Mud) System.**

**(a) Mixing System.** A self-contained, closed, drilling fluid mixing system shall be of sufficient size to mix and deliver drilling fluid composed of bentonite clay, potable water, and appropriate additives. The mixing system shall be able to molecularly shear individual bentonite particles from the dry powder to avoid clumping and ensure thorough mixing. The drilling fluid reservoir tank shall be of sufficient size for the work. The mixing system shall continually agitate the drilling fluid during drilling operations.

**(b) Drilling Fluid.** Drilling fluid shall be composed of clean water and an appropriate additive. Water shall be from a clean source with proper pH to ensure no contamination is introduced into the soil during the drilling, reaming, and pipe installation process. The Contractor is responsible for any required pH adjustments. . The water and additives shall be mixed thoroughly and be absent of any clumps or clods. No hazardous additives may be used. Drilling fluid shall be maintained to ensure borehole stability, cutting suspension and transport, bit and electronics cooling, and hole lubrication to reduce drag on the drill pipe and the product pipe. All materials, including any additives used to make up the drilling fluid, shall be approved by the Engineer prior to use.

**(c) Delivery System.** The mud pumping system shall have sufficient capacity and be capable of delivering the drilling fluid at a constant pressure to meet the needs of the work. The delivery system shall have filters in-line to prevent solids from being pumped into the drill pipe. Connections between the pump and drill pipe shall be relatively leak-free. Used drilling fluid and drilling fluid spilled during drilling operations shall be contained and properly disposed of. A containment system shall be maintained around drill rigs, drilling fluid mixing system, entry and exit pits, drilling fluid recycling system, and environment. Pumps and/or vacuum truck(s) of sufficient size shall be in place to convey excess drilling fluid from containment areas to storage facilities.

189  
190  
**(5) Other Equipment.**

**(a) Pipe Rollers.** Pipe rollers shall be of sufficient size to fully support the weight of the pipe during pull-back operations. Sufficient number of rollers shall be used to prevent excess sagging of pipe.

**(b) Pipe Rammers.** Hydraulic or pneumatic pipe rammers may only be used if necessary and with the authorization of Engineer.

**(c) Restrictions.** Other devices or utility placement systems for providing horizontal thrust other than those previously defined shall not be used unless approved by the Engineer prior to commencement of the work. Consideration for approval will be made on an individual basis for each specified location. The proposed device or system will be evaluated prior to approval or rejection on its potential ability to complete the utility placement satisfactorily without undue stoppage and to maintain line and grade within the tolerances prescribed by the particular conditions of the project.

**(D) Construction Requirements.**

**(1) General.** The Engineer must be notified 48 hours in advance of starting work. The directional bore shall not begin until the Engineer is present at the job site and agrees that proper preparations for the operation have been made. The Engineer approval for beginning the installation shall in no way relieve the Contractor of the ultimate responsibility for the satisfactory completion of the work as authorized under the Contract. The Contractor is responsible for damages to utilities and repairs for such damages, at no cost to the State.

**(2) Personnel.** All personnel shall be fully trained in their respective duties as part of the directional drilling crew and in safety.

**(3) Drilling Procedure.**

**(a) Site Preparation.** Prior to any alterations to the work site, the Contractor shall photograph or video the entire work area, including entry and exit points, one copy of which shall be provided to the Engineer and one copy to remain with the Contractor for a period of 1 year following the completion of the project.

235  
236  
Work site, as indicated on the Plans, within right-of-way, shall be graded or filled to provide a level working area. The Contractor is responsible for design and construction of the drill entrance and exit pits. No alterations beyond what is required for operations are to be made. The Contractor shall confine all activities to designated work areas.

Prior to anchoring the drilling rig to the ground, the Contractor shall confirm locations of all underground utilities in the area of the drilling rig, the entry and exit pits, and along the HDD alignment.

**(b)** Drill Path Survey. The entire drill path shall be accurately surveyed, with entry and exit stakes placed in the appropriate locations within the areas indicated on the Plans. If the Contractor is using a magnetic guidance system, the drill path will be surveyed for any surface geo-magnetic variations or anomalies.

**(c)** Environmental Protection. The Contractor shall place silt fence between all drilling operations and any drainage, wetland, waterway, or other area designated for such protection by the Contract Documents or state, federal, and local regulations. Additional environmental protection necessary to contain any hydraulic or drilling fluid spills shall be put in place, including berms, liners, turbidity curtains, and other measures. Disposal of fluids is the responsibility of the Contractor. The Contractor shall adhere to all applicable environmental regulations. Fuel or oil may not be stored in bulk containers within 200 feet of any water body or wetland.

**(d)** Safety. The Contractor shall adhere to all applicable state, federal, and local safety regulations and all operations shall be conducted in a safe manner. Safety meetings shall be conducted at least weekly written record of attendance and topic submitted to the Engineer.

**(e)** Pilot Hole. The pilot hole shall be drilled on the bore path with no deviations greater than 5% of depth over a length of 100 feet. In the event the pilot hole does deviate from the bore path more than 5% of depth in 100', the Contractor will notify the Engineer and the Engineer may require the Contractor to pull-back and re-drill from the location along the bore path before the deviation.

In the event that a drilling fluid fracture, inadvertent returns, or returns loss occurs during pilot hole drilling operations, the

282 Contractor shall cease drilling until fluid loss volumes can be  
283 brought under control to minimize further inadvertent returns  
284 in the project area. If mud fracture or returns loss continues,  
285 the Contractor will cease operations and notify the Engineer.  
286 The Engineer and the Contractor will discuss additional  
287 options and work will then proceed accordingly. The  
288 Contractor shall clean up locations where drilling fluid  
289 inadvertently returns and restore the surface area to its  
290 original condition.

291  
292 **(f) Reaming.** Upon successful completion of the pilot hole,  
293 the Contractor will ream the bore hole up to a maximum  
294 diameter of 1.5 times the outside diameter of the pipe using  
295 the appropriate tools. The Contractor will not attempt to ream  
296 at one time more than the drilling equipment and mud system  
297 are designed to safely handle.

298  
299 **(g) Pull-Back.** After successfully reaming the bore, the  
300 Contractor will pull the pipe through the bore hole. Pipe  
301 lengths shall be connected together in one length. Pipe shall  
302 be placed on rollers with rollers spaced close enough to  
303 prevent excessive sagging of pipe. In front of the pipe will be  
304 a swivel. Once pull-back operations have commenced,  
305 operations must continue without interruption until the pipe is  
306 completely pulled into the bore hole. During pull-back  
307 operations, the Contractor will not apply more than the pipe  
308 manufacturer's maximum safe pipe pull pressure at any time.  
309 In the event that the pipe becomes stuck, the Contractor will  
310 cease pulling operations to allow any potential hydro-lock to  
311 subside and will commence pulling operations. If the pipe  
312 remains stuck, the Contractor will notify the Engineer. The  
313 Engineer and the Contractor will discuss options and then  
314 work will proceed accordingly.

315  
316 **(h) Inlet Grouting.** Upon completion of installation, the  
317 excess pipe shall be removed and the bore hole shall be filled  
318 with flowable fill or cement grout as directed by the Engineer.

319  
320 **(E) Site Restoration.** Following drilling operations, the Contractor will  
321 de-mobilize equipment and restore the work-site to original condition. All  
322 excavations will be backfilled and compacted to 95% of the maximum dry  
323 unit weight determined in accordance with AASHTO T 180. Landscaping  
324 will be restored to original to the satisfaction of the Engineer.

325  
326 **(F) Record Keeping, As-Builts.** The Contractor shall maintain a daily  
327 project log of drill operations and a guidance system log with a copy given

328 to the Engineer at completion of the work. As-built drawings shall be  
329 certified as to accuracy by the Contractor.

330  
331 **651.04 Method of Measurement.** The installation and construction of  
332 communication ductlines will be paid on a lump sum basis. Measurement for  
333 payment will not apply.

334  
335 **651.05 Basis of Payment.** The Engineer will pay for the accepted pay item  
336 below at the contract lump sum basis. Payment will be full compensation for the  
337 work prescribed in this section and the work prescribed in this section and the  
338 contract documents. Payment shall be full compensation for furnishing all labor,  
339 tools, equipment, and materials; for excavation, sheeting and bracing, de-watering,  
340 and backfilling; for furnishing and installing the HDD pipe and carrier pipe utilizing  
341 horizontal directional boring method of installation; for furnishing and installing pipe  
342 spacers and end seals; for restoration of physical features; and for all work  
343 required for a complete installation of the highway crossing including clearing,  
344 grubbing, erosion control, excavation, excavation support, dewatering, drilling,  
345 removal of tailings, backfilling, compaction, and flushing; for preparing and  
346 furnishing required submittals, reports, and as-built drawings; and for furnishing all  
347 labor, materials, tools, equipment, and incidentals necessary to complete the work.

348  
349 The Engineer will pay for the following pay item when included in the  
350 proposal schedule:

Pay Item	Pay Unit
AT&T One 6-Inch Conduit Encased in Concrete Jacket with Four 1.5-Inch Inner Ducts – Honouliuli Bridge, Horizontal Directional Drilling	Lump Sum

351  
352  
353  
354  
355  
356  
357  
358  
359  
360  
361  
362

**END OF SECTION 651**

1 Make this section a part of the Standard Specifications:  
2

3 **“SECTION 652 – PILOT TUBE MICROTUNNELING**  
4

5  
6 **652.01 Description.** This Section includes requirements for installation of  
7 waterline using pilot tube microtunneling methods at the location shown on the  
8 Plans.  
9

10 **(A) Definition.** Pipe jacking methods using pilot tube microtunneling  
11 equipment shall be employed to install the jacking casing pipes, or directly  
12 install the waterline, at the locations indicated on the Plans and in  
13 accordance with the Contract requirements. The Contractor is responsible  
14 to select, design, and provide a pilot tube microtunneling system to install  
15 the waterline along the alignment and profile as shown on the Plans.  
16

17 Take all precautions necessary to protect existing utilities, trees, historic  
18 structures, and other adjoining structures from damage by construction  
19 activities. Repair and/or restore any existing utilities, trees, and all nearby  
20 structures damaged by pilot tube microtunneling and related work  
21 immediately, at no additional cost to the State.  
22

23 Pilot Tube Microtunneling is defined as an underground method of  
24 constructing a pipeline that involves jacking a laser-guided, steerable pilot  
25 tube using hydraulic jacks to the receiving pit. Excavation is then carried  
26 out with trailing segments of casing encased continuous flight augers.  
27 When the casings and augers segments are jacked to the receiving pit,  
28 the product pipe segments are jacked behind the casing, following the  
29 previously excavated path, to the receiving pit.  
30

31 Pilot Tube Microtunneling equipment shall be capable of excavating into  
32 the hard rock formations with unconfined compressive strength ranging  
33 from 5,000 to 15,000 psi. Unforeseen Obstructions are defined as  
34 underground obstruction(s) exceeding the anticipated range of subsurface  
35 conditions described in the Geotechnical Report, such as high strength  
36 material (substantially exceeding 15,000 psi unconfined compressive  
37 strength), metal debris, existing utilities not shown correctly on Plans, and  
38 old foundations, or other unknown obstructions, which stop the pilot tube  
39 microtunneling system from advancing and must be removed to continue  
40 pilot tube microtunneling.  
41

42 **(B) Design Criteria.**  
43

44 **(1) Pilot Tube Microtunneling And Associated Equipment.** Pilot  
45 tube microtunneling and associated equipment shall selected by  
46 the Contractor shall be compatible with the geologic conditions



47  
48  
described in the Geotechnical Report for the waterline section of this project, and other requirements specified herein.

**(2) Settlement.** Control ground surface settlement or heave above the centerline of the waterline to 1 inch or less. The Contractor shall repair any damage resulting from surface settlement or heave caused by pilot tube microtunneling, or jacking and receiving pit excavation and construction, at no additional cost to the State.

**(3) Thrust Block.** The thrust block shall be constructed perpendicular to the proposed pipe alignment and shall be designed to withstand the maximum jacking pressure to be used, with a factor of safety of at least 2.5, without excessive deflection or displacement.

**(4) Dewatering.** Dewatering methods for groundwater control will not be permitted for all shaft or trenching excavation for construction of the waterline.

**(5) Tolerances.** The jacking pipes for the waterline shall be installed to meet the following tolerances along the entire length of the jacked pipes:

**(a) Line Tolerance.** Line Tolerance:  $\pm 2$  inches from design horizontal alignment.

**(b) Grade Tolerance.** Grade Tolerance:  $\pm 1$  inch from design grade.

**(C) Submittals** Submit the following 90 days prior to mobilization of pilot tube microtunneling equipment. Provide sufficient detail to allow the Engineer to judge whether the proposed equipment, materials, and procedures, and the qualifications of the actual Contractor work force, will meet the Contract requirements.

**(1) Manufacturer Specifications and Shop Drawings.** Provide manufacturer's literature and shop drawings describing in detail the pilot tube microtunneling system(s) to be used. Provide manufacturer's written verification that the pilot tube microtunneling equipment is compatible with the range of anticipated ground conditions outlined in the Geotechnical Report and for the required alignment shown on the Plans. Provide descriptions of at least three (3) projects on which this entire system has been successfully used, including names, addresses, and telephone numbers of Owner's representatives for these projects, as well as length, diameter, pipe material used, project cost, and geologic conditions encountered.

- 94  
95  
- (2) **Alignment.** Provide a description of the alignment control procedures, and steering related systems. Provide manufacturer's literature, drawings showing setup and support provisions, and other details for the laser or laser-theodolite navigation systems. Submit a description of surveying methods and procedures to set laser or laser-theodolite positions. Submit description to check laser and reset or re-align laser or laser-theodolite during construction. Submit equipment and systems manufacturers' confirmation that these systems can achieve the required pipeline line-and-grade within the specified tolerances.
  - (3) **Capacity, Number, and Arrangement of Main Jacks.** Provide details of thrust ring, jacking controls, and pressure gages. Provide an estimate of the maximum jacking force expected to be required to complete each drive, including jacking loads calculations for each drive and name and qualifications of person performing the calculations.
  - (4) **Thrust Block And Jacking Frame Design and Details.** Submit calculations demonstrating that the thrust block can transfer the maximum planned forces developed by the main jacks to the ground without excessive movements.
  - (5) **Entry and Exit Seals Design and Details.** Submit shop drawing for documentation that the entry and exit seals are designed and fabricated to withstand the anticipated hydrostatic head and operation stresses.
  - (6) **Spoils.** Spoil handling, transport, and disposal equipment and procedures indicating spoil disposal sites. Provide written documentation from the approved disposal site(s) indicating that they will accept the spoil and are in compliance with all City, State, and Federal regulations.
  - (7) **Settlement.** Layout of all surface settlement points and monitoring provisions.
  - (8) **Nearby Obstacles.** Provisions for protecting adjacent utilities, trees, and structures within 50 feet of the waterline centerline. Provide sufficient details to demonstrate proposed means and methods to install casing waterline under very tight pipe clearance under existing utilities.
  - (9) **Safety Plan.** A safety plan for the pilot tube microtunneling operations. Provide the name of a Contractor's site safety representative responsible for implementing the safety program.

141  
142  
- (10) Obstacle Removal.** Provide a general plan, procedures, and details for constructing recovery shafts, drilling operation, and other methods to remove obstructions that may be encountered before or during pilot tube microtunneling.
- (11) Schedule.** Schedule for pilot tube microtunneling work identifying all major construction activities as independent items. The schedule shall include as a minimum the following activities: mobilization; verification of utilities; protection of existing utilities; pre-drilling; shaft excavation and excavation support; jacking equipment setup; installation of casing and distribution pipes; annulus grouting, site restoration; cleanup; and demobilization. The schedule shall also include the working hours for each activity, and a written description of the construction methods and equipment to be employed in completing each of the work activities shown on the schedule. Any action with an anticipated duration longer than one (1) week should be listed separately in the task list of the schedule. The schedule shall be reviewed with the Engineer and be updated and resubmitted by the Contractor on a weekly basis.
- (12) Licenses.** Submit the name(s) and resume(s) of a surveyor licensed in the State of Hawaii who will be responsible for setting survey control and laser or laser-theodolite for pipe installation and all related construction, including the survey and documentation of the location and elevation of the pilot tube microtunneling machine on the jacking frame prior to the launch of each drive.
- (13) Reports and Records**

  - (a)** All relevant control data, which include but not limited to the following, must be accessible for observation and documentation by the Engineer:

    - i.Length of the tunnel or Station of Pilot Tube Microtunneling.
    - ii.Rate of advance
    - iii.Line-and-grade deviation
    - iv.Roll
    - v.Inclination
    - vi.Thrust force
    - vii.Torque

188 The Contractor shall at all times provide and maintain  
189 instrumentation that will accurately provide to the Engineer  
190 all required reports and records.

191  
192 (b) Submit to the Engineer copies of field notes used to  
193 establish all lines-and-grades and allow the Engineer to  
194 review laser or laser-theodolite set-up prior to beginning pilot  
195 tube microtunneling.

196  
197 (c) Submit survey measurements of surface settlement points  
198 and markers to the Officer-in-Charge by the end of the same  
199 day that measurements are taken.

200

#### 201 (D) Quality Assurance

202

203 (1) **Qualifications.** All pilot tube microtunneling work shall be  
204 performed by an experienced contractor, whose staff shall include a pilot  
205 tube microtunneling project manager, a pilot tube microtunneling  
206 superintendent, and a pilot tube microtunneling machine operator(s). The  
207 Contractor's pilot tube microtunneling project manager or pilot tube  
208 microtunneling superintendent shall attend weekly progress meetings at  
209 the site. All pilot tube microtunneling work must be supervised full time by  
210 the pilot tube microtunneling superintendent. The pilot tube  
211 microtunneling machine operator must have prior successful experience in  
212 working with at least one of the pilot tube microtunneling guidance  
213 systems that can be used for this project.

214

215 The pilot tube microtunneling system shall be manufactured by a company  
216 that specializes in the design and fabrication of this type of equipment and  
217 has at least five years of experience in manufacturing such pilot tube  
218 microtunneling systems.

219

220 (2) **Surveying.** All surveying, including stake out of all construction  
221 locations, shall be performed by a surveyor licensed in the State of Hawaii.  
222 The surveyor responsible for setting survey control for pilot tube  
223 microtunneling work shall have prior experience in providing surveying  
224 and setting survey controls for pilot tube microtunneling or tunneling work.

225

226 (3) **Safety.** Perform all work in accordance with the current applicable  
227 regulations of Federal, State, and local agencies, including, but not limited  
228 to, 29 CFR Part 1926, Subpart S, Underground Construction by OSHA.

229

#### 230 652.03 Materials and Products

231

##### 232 (A) Pilot Tube Microtunneling System

233

234  
235  
- (1) **Compatibility.** The pilot tube microtunneling system shall be compatible with the range of geologic conditions along the waterline alignment as described in the Geotechnical Report.
- (2) **Stabilization Capability.** The pilot tube microtunneling system shall be capable of fully supporting the surrounding ground, during both excavation and shutdown periods, prevent water inflow, and shall have the capability of exerting a controllable, measurable, continuous, stabilizing pressure at the face as required to prevent loss of ground. The auger drill transport system, if used, must be capable of synchronizing the rate of excavation spoil removed at the tunnel face with the rate of advance of the pilot tube microtunnel systems so there is no over-excavation or loss of ground, or jamming of the flight augers.
- (3) **Operation.** The pilot tube microtunneling system shall be remotely operated, laser- or theodolite-guided, and monitored continuously by the operator. A display showing the position of the pilot tube in relation to design line-and-grade shall be provided at the operation location or display unit to allow the operator to monitor jacking pressure, roll, inclination, laser position, steering attitude, rate of advance, installed length, thrust force, and other necessary instrumentation to achieve the desired results.
- (4) **Optics.** The pilot tube microtunneling system shall have a laser or laser-theodolite guidance system with a light sensitive or electronic target appropriate for the drive lengths required and capable of achieving the line-and-grade control requirements for the project.
- (5) **Steering.** The pilot tube microtunneling systems and procedures shall have the capability to steer in both vertical and horizontal directions to maintain line-and-grade within the specified tolerances.
- (6) **Lubrication.** If necessary, a pipe lubrication injection system shall be provided to inject pipe lubricants as required to minimize jacking forces.
- (7) **Gaskets and Seals.** The pilot tube microtunneling system and the entry and exit area of the jacking and reception pits shall have gaskets and seals to prevent material from running or flowing into the system and pits.

- 280 (8) **Over-cut.** The maximum allowable over-cut shall not be  
281 greater than ½-inch larger in diameter than the outside of the  
282 jacked pipe.  
283  
284 (9) **Jacking and Control System.** The jacking and control  
285 system shall be capable of continuously monitoring the  
286 jacking pressure, the rate of advancement, and the distance  
287 jacked. The jacking system shall develop a uniform  
288 distribution of jacking forces on the end of the pipe.  
289  
290 (B) **Jacking Pipe.** Steel jacking casing that meets all specified project  
291 requirements of Standard Specification, Section 712.04 to grout all  
292 annular voids with non-shrink grout.  
293  
294 (C) **Distribution Pipes.**  
295  
296 (1) 36" Ductile Iron Pipe Class 53 Waterline  
297  
298 (2) 60" Permalok steel casing or approved equal  
299

### 300 **652.03 Construction Requirements**

#### 301 (A) **General Construction Requirements**

- 302 (1) Pilot tube microtunneling shall not begin until the following  
303 has been completed:  
304  
305 (a) Required submittals have been made and the  
306 Engineer has reviewed and accepted all submittals.  
307  
308 (b) Required pre-construction surveys have been  
309 completed in accordance with the specified  
310 requirements.  
311  
312 (c) All additional potholing and obstruction removal work,  
313 if any, has been satisfactorily completed.  
314  
315 (d) Jacking and receiving pit excavation and support  
316 have been completed.  
317  
318 (e) Groundwater control measures, if applicable,  
319 including related ground improvement work are  
320 properly completed for launching pilot tube  
321 microtunneling out of jacking pits and breaking into  
322 receiving pits.  
323  
324  
- (2) The waterlines shall be installed using pilot tube microtunneling methods between the limits indicated on the Plans and to the specified lines-and-grades with due regard for safety of workers, adjacent structures and improvements, utilities, and the public. Jacking and receiving pits shall be located as identified on the Plans, unless approved otherwise by the Engineer.
  - (3) All work shall conform to the requirements of OSHA. Perform all work in accordance with current applicable regulations of Federal, State, and local agencies. In the event of conflict, comply with the most stringent applicable requirement.
  - (4) Furnish all necessary equipment, power, water, and utilities for pilot tube microtunneling, pipe lubricant mixing and pumping, removal and disposal of spoil, and other associated work required for the Contractor's methods of construction.
  - (5) A thrust block is required to transfer jacking loads to the soil behind the jacking pit. The thrust block shall be designed to meet or exceed the specified requirements, properly constructed, and shall be perpendicular to the proposed pipe alignment.
  - (6) Provide suitable and effective launching seals to prevent inflow of groundwater, loss of ground and loss of lubricants at jacking and receiving pits.
  - (7) No gasoline-powered equipment shall be permitted in jacking and receiving pits. Diesel, electrical, hydraulic, and air-powered equipment are acceptable, subject to applicable City, State, and Federal regulations.
  - (8) Conduct all operations such that trucks and other construction vehicles do not create a dust nuisance in the streets and adjacent properties. Promptly clean up, remove, and properly dispose of any spoil spillage. Traffic control shall be provided as indicated on the Plans.
  - (9) All work shall be done so as not to disturb roadways, adjacent structures, trees, landscaped areas, or utilities. Any damage shall be immediately repaired to the satisfaction of the property owner, residents, agency, or utility having jurisdiction, and the Engineer, at no additional cost to the State.

373  
374  
**(10)** The Contractor shall provide a drill rig and crew and all necessary equipment, in accordance with accepted submittals, for obstruction removal. When requested and authorized by the Engineer, the Contractor shall apply for applicable drilling permits for anticipated probing and drilling locations requested. If unforeseen obstructions exceeding the anticipated subsurface conditions described in the Geotechnical Report and herein which stops the pilot tube microtunneling machine from advancing are encountered, probing and drilling shall be performed as authorized by the Engineer. A minimum 8-inch diameter drill hole(s) shall be drilled to fragment and/or remove the obstruction and minimize delays in the work. The drilled hole(s) shall be backfilled with compacted granular backfill to 3 feet below ground surface. The top 3 feet of the drill hole(s) shall be backfilled with cement grout. The 28-day unconfined compressive strength of the cement grout shall be a minimum of 100 psi.

**(11)** The Contractor shall construct emergency recovery or access shafts along the waterline alignment for removal of unforeseen obstructions during pilot tube microtunneling, if obstructions such as high strength material (substantially exceeding 15,000 psi unconfined compressive strength) and large boulders, metal debris, existing utilities not shown correctly on Plans, and old foundations, or other unknown obstructions, are encountered which stop the pilot tube microtunneling machine from advancing. Obstruction removal shall include use of drilling rigs with casings to support the drilled holes where necessary. The shafts shall be properly supported with suitable shoring provisions to minimize loss of ground and ground movements that could damage adjacent utilities, streets, or structures. Provide traffic control as indicated in the plans. Obtain necessary approvals from affected agencies and proceed with the construction of recovery shafts as required to remove obstructions and minimize delays in the work.

**(B) Pipe Installation**

- (1)** Pipe installation shall be completed in accordance with approved shop drawings, and accepted submittals.
- (2)** Provide a suitable jacking frame and thrust block to carry out the work.



- 420  
421  
- (3) Special care shall be taken when setting the pipe guide rails prior to starting the work in the jacking pit to ensure correctness of the alignment, grade, and stability. A licensed surveyor retained by the Contractor shall survey the location and orientation of the pipe guide rails to ensure they are on the proper line-and-grade and verify that they are properly supported.
  - (4) Jacking pipe sections shall be handled and transported from the storage area to the jacking pit properly in accordance with the manufacturer's recommendations to avoid damage. Set the jacking pipe sections properly, braced and supported by guide rails. Join the two pipe sections together following the below joint connection procedures or as indicated in approved submittals.
    - (a) Clean both ends of each pipe section and the joint components.
    - (b) Apply joint lubricant to the bell interior surface and gaskets. Use only lubricants approved by the pipe manufacturer.
    - (c) Use suitable equipment and end protection to push the pipes together. Install all required joint protection measures.
    - (d) Do not exceed forces recommended by the manufacturer for jointing or pushing pipe.
  - (5) The axial forces from the thrust jacks shall be distributed to the pipe uniformly through a properly designed thrust ring and cushion materials, as recommended by the pipe manufacturer, to prevent damage to the ends of the pipe. Jacking forces shall be applied uniformly to the pipe wall. The jacking system shall be capable of continuously monitoring the jacking pressure and advance rate.
  - (6) Pipes shall be jacked into position following the design line-and-grade of the waterline without damaging the pipes. In the event a section of the pipe is damaged during the jacking operation, the pipe shall be jacked through to the receiving pit and removed. Other methods of repairing the damaged pipe may be used, subject to the approval by the Engineer.
  - (7) Pilot tube microtunneling shall be operated so as to minimize both surface heave and loss of ground during pilot tube

467  
468  
microtunneling. Restrict the excavation of the materials to only those materials that are physically displaced by the pilot tube and augers themselves in order to prevent loss of ground, settlement, or possible damage to overlying structures. Control the advance rate, monitor the volume of material excavated, and adjust the advance rate, as required to avoid loss of ground, overexcavation, and surface heave.

- (8) The pilot tube shall be steered to maintain line-and-grade within the tolerance specified. This shall be achieved by continuously monitoring and recording rate of advance, line-and-grade deviation, roll, inclination, and steering adjustments during the operation for each pipe section installed.

**(C) Control of Line-and-Grade**

- (1) The benchmarks and other primary survey control have been established and are shown on the Plans. The Contractor and a licensed surveyor retained by the contractor shall verify the accuracy of these benchmarks at the beginning of construction and report any errors or discrepancies to the Engineer immediately.
- (2) When satisfied that all benchmarks are correct, use these benchmarks to furnish and maintain all reference lines-and-grades for pilot tube microtunneling. For pilot tube microtunneling, use these lines-and-grades to establish the location of the pipe using a laser, or laser-theodolite guidance system. The Contractor shall be fully responsible for the accuracy of the work and the correction of defective work, as required.
- (3) Laser or laser-theodolite shall be mounted independently from the thrust block and jacking frame to maintain the alignment of the laser or laser-theodolite. Stop pilot tube microtunneling operations and reset laser or laser-theodolite, if laser or laser-theodolite alignment shifts or is moved off of pre-set design alignment and grade for any reason. Laser or laser-theodolite should only be reset by qualified surveying personnel in accordance with approved procedures. When requested by the Engineer, reset laser or laser-theodolite using a licensed surveyor retained by the Contractor at no additional cost to the State.
- (4) Monitor line-and-grade continuously during pilot tube microtunneling operations. Record deviation with respect to

514 design line-and-grade and submit records to the Engineer as  
515 requested. Control line-and-grade of the pipe to within the  
516 specified tolerances. Notify the Engineer immediately if pilot  
517 tube microtunneling exceeded the specified line or grade  
518 tolerances.

519  
520 (5) When the pilot tube microtunneling excavation is off line or  
521 grade, make the necessary corrections and return to the  
522 design line-and-grade at a rate of not more than 1 inch per  
523 25 feet.

524  
525 (6) If the pipe installation exceeds the specified tolerances for  
526 deviations, correct the installation, including, if necessary,  
527 redesign and reconstruction of the waterline. All corrective  
528 work shall be performed as approved by the Engineer, at no  
529 additional cost to the State.

530  
531 **(D) Spoil Transport and Disposal**

532  
533 (1) Auger drill spoil transport methods may be used for pilot tube  
534 pilot tube microtunneling.

535  
536 (2) Properly transport and dispose of all excavated materials  
537 away from the construction sites in accordance with all  
538 applicable City, State, and Federal regulations.

539  
540 **(E) Temporary Ventilation.** Furnish and operate when personnel are  
541 underground, a temporary ventilation system and air monitoring  
542 system conforming to the requirements of OSHA. Provide a  
543 sufficient supply of fresh air and maintain an atmosphere free of  
544 flammable gasses in all underground work areas.

545  
546 **(F) Surface Settlement Monitoring**

547  
548 (1) Install and monitor surface settlement points as appropriated.  
549 A three-point array of settlement points and markers shall be  
550 established every 25 feet along the alignment of the  
551 waterline to be installed by pilot tube microtunneling.

552  
553 (2) Measurements of installed settlement points and markers  
554 shall be taken daily while pilot tube microtunneling  
555 operations are taking place and within 100 feet of the  
556 settlement point, and at least once per week thereafter until  
557 all subsidence stops.

558  
559 **(G) Leakage Testing.** Perform testing of the completed waterline in  
560 accordance with Section 624.

561  
562  
(H) Cleanup and Restoration. Restoration shall follow construction activities as the work progresses and shall be completed as soon as possible, in accordance with Section 203, "Excavation and Embankment." Restore and repair any damage resulting from surface settlement caused by shaft construction or pilot tube microtunneling. Any property damaged or destroyed shall be restored to a condition equal to or better than existing prior to construction. Final restoration that cannot be performed within the thirty (30) day period due to adverse weather conditions may, upon written request that includes a proposed procedure and time schedule, be performed as approved by the Engineer.

**652.04 Method of Measurement.** The pilot tube microtunneling will be paid on a lump sum basis. Measurement for payment will not apply.

**652.05 Basis of Payment.** The Engineer will pay for the waterline installed by pilot tube microtunneling, in place completed within specified line-and-grade tolerances and satisfying the leakage test requirements at the contract lump sum price. Payment will be full compensation for the work prescribed in this section and the contract documents. Payment shall be full compensation for furnishing all labor, tools, equipment, and materials; for jacking and receiving pits excavation, sheeting and bracing, de-watering, and backfilling; for furnishing and installing the waterline and carrier pipe utilizing pilot tube microtunneling method of installation; for furnishing and installing pipe spacers and end seals; for restoration of physical features; and for all work required for a complete installation of the highway crossing including clearing, grubbing, erosion control, excavation, excavation support, dewatering, drilling, removal of tailings, backfilling, compaction, and flushing; for preparing and furnishing required submittals, reports, and as-built drawings; and for furnishing all labor, materials, tools, equipment, and incidentals necessary to complete the work.

The Engineer will pay for the following pay item when included in the proposal schedule:

<b>Pay Item</b>	<b>Pay Unit</b>
36-Inch Ductile Iron Pipe Class 53 Waterline Pilot Tube Microtunneling	Lump Sum

**END OF SECTION 653**

1 Add **Section 660 – Gas System** in its entirety to the specifications:

2  
3 **“SECTION 660 - GAS SYSTEM**

4  
5 **660.01 Description.** This section describes constructing gas systems.

6  
7 **660.02 Materials.**

8  
9 Trench Backfill Material 703.21

10  
11 **660.03 Construction.**

12  
13 **(A) General.** Notify Hawaii Gas in writing at least one month (30 calendar  
14 days) before commencement of work of gas system.

15  
16 Invert grades of gas pipelines shall provide a minimum of three feet  
17 cover from top of pipe to finish grades.

18  
19 Minimum vertical and horizontal clearance between the gas pipelines  
20 and other pipelines, conduits, ductlines, or other facilities shall comply with  
21 the maximum clearance needed based on the standards of the utility  
22 companies.

23  
24 **(B) Trench Excavation.**

25  
26 **(1) General.** Pile excavated material next to trench, or haul and  
27 store to site acceptable to the State Engineer.

28  
29 In fill areas, compact fill to subbase or to elevation 4 feet above  
30 top of pipe, whichever is less, before excavating trench.

31  
32 Excavate trenches in accordance with Section 204 –  
33 Excavation and Backfill for Miscellaneous Facilities, and as modified  
34 below.

35  
36 Do not construct trench with jumps or spaces unless  
37 acceptable to the State Engineer. Maintain excavation during  
38 installation of gas systems and placing of backfill.

39  
40 Construct trench widths for various size pipes in accordance  
41 with the Construction Plans.

42  
43 Correct trenches over-excavated below specified grade with  
44 trench backfill material, compacted, at no increase in contract price or  
45 contract time.

47  
48  
49  
**(2) Removal of Mud and Other Unsuitable Material from Trench Bottom.** If soft, spongy, or other unsuitable material is encountered at specified depths, remove material under pipe to maximum depth of 30 inches below invert grade of pipe. Backfill space to 6 inches below invert grade of pipe with untreated base. Use untreated base with maximum aggregate size of 1-1/2 inches. Compact untreated base until relative compaction is not less than 95 percent.

**(3) Sheathing.** Properly sheath and brace excavation to provide secure excavation. Remove sheathing and bracing before completing backfill. When sheathing is necessary, widen trench beyond those widths specified in Subsection 624.03(B)(1) - General. Follow OSHA requirements.

**(4) Dewatering.** Keep trenches free from water while installing and testing pipe and backfilling trench. Comply with NPDES requirements and other applicable regulations. Obtain NPDES construction dewatering permit for discharge of uncontaminated ground water.

**(5) Use of Explosives.** The use of explosives is not permitted, in accordance with Subsection 104.10 – Use of Explosives.

**(C) Trench Backfill.**

**(1) General.** Do not use adobe, clay or material of similar nature for backfill. When removal of unsuitable excavated materials creates shortage of backfill material, furnish suitable material. Material from roadway or other excavation may be used.

**(2) Preparation of Trench Bottom.** After excavating trench to proper depth below invert grade of pipe, backfill trench bottom to required invert grade of trench with trench backfill material.

**(3) Backfilling.** Upon completion of installation and testing of pipelines by Hawaii Gas, conform to following:

**(a)** Backfill trench widths in accordance with the Construction Plans.

**(b)** Backfill remainder of trench with trench backfill material, conforming to Subsection 703.21 – Trench Backfill Material.

**(c)** Place trench backfill materials in layers not exceeding six inches in loose thickness. Compact each layer to not less

93 than 95 percent relative compaction conforming to Subsection  
94 203.03(C)(2) Relative Compaction Test.

95  
96 **(D) Laying Pipe.** Gas pipelines shall be provided and installed by Hawaii  
97 Gas.

98  
99 **660.04 Measurement.** Gas system will be paid on a force account basis in  
100 accordance with Subsection 109.06 – Force Account Provisions and Compensation.  
101 Measurement for payment will not apply.

102 **660.05 Payment.** The Engineer will pay for the fee for the Installation of Gas  
103 Pipeline on a force account basis in accordance with Subsection 109.06 – Force  
104 Account Provisions and Compensation. Payment will be full compensation as  
105 prescribed in this section and contract documents. The actual amount to be paid  
106 will be the sum shown on the accepted force account records whether this sum be  
107 more or less than the estimated amount allocated in the proposal schedule.

108		
109	<b>Pay Item</b>	<b>Pay Unit</b>
110		
111	Allowance for Trench Excavation and Backfill, and	
112	Installation of Gas Pipeline	Force Account
113		
114		
115		
116		

**END OF SECTION 660”**

1 Make this Section a part of the Standard Specifications:

2  
3 **SECTION 675 – MASS CONCRETE**

4  
5 **675.01 Description.** This Section describes mass concrete, which is the placement  
6 of any large volume of cast-in-place concrete with dimensions large enough to require  
7 taking measures to cope with the generation of heat from hydration of cement and  
8 attendant volume change. Elements that are considered mass concrete include but  
9 are not limited to the drilled shaft cap beams and end beams for both Honouliuli  
10 Stream Bridge and Kalo Stream Bridge.

11  
12 **675.02 Materials.**

13	Portland Cement	701.01
14		
15	Fine Aggregate for Concrete	703.01
16		
17	Coarse Aggregate for Portland Cement Concrete	703.02
18		
19	Admixtures	711.03
20		
21	Water	712.01
22		
23		
24		

25 **675.03 Construction.**

26  
27 **(A) Submittals.**

28  
29 **(1)** At least 14 days prior to the mass concrete pour, submit a Thermal  
30 Control Plan prepared by a specialty Engineer with at least 5 years of  
31 experience in the design and temperature control of mass concrete. The  
32 plan shall follow ACI 207.1R “Guide to Mass Concrete” and also address  
33 the following issues:

34  
35 **(a)** An analysis of anticipated thermal developments within the  
36 mass pour placements using proposed materials and casting  
37 methods. List locations of anticipated mass concrete pours, type  
38 of structure, and anticipated volume of concrete

39  
40 **(b)** A plan which includes mix design, insulation and cooling  
41 outlining specific measures to be taken to control the temperature  
42 differential and the maximum temperature

43  
44 **(c)** The proposed monitoring system

45  
46 **(d)** Duration and method of curing



47  
48  
(e) An outline of corrective actions to maintain the temperature differential and the maximum temperature to avoid cracking

(f) Proposed methods of repairs or corrective actions if the mass concrete member is not accepted as well as preventative measures to ensure issues do not reoccur

(2) Drilled shaft concrete heat of hydration development shall be addressed independently from the Thermal Control Plan considering ambient ground conditions and range of expected placement temperatures to ensure conformance with the maximum temperature limit and gradients set forth herein.

**(B) Quality Control.** Mass Concrete production requires Contractor responsibility for quality control of materials during handling, blending, mixing, curing, and placement operations.

Sample, test, and inspect concrete to ensure quality control of component materials and concrete. Sampling and testing for quality control in accordance with standard methods shall be performed by certified ACI Concrete Field Technician Grade I. Perform quality control tests for slump, air content, temperature, and unit weight during production of mass concrete other than concrete for incidental construction. Submit quality control test results.

Cease all mass placement operations and revise the Thermal Control Plan as necessary if either the maximum core temperature or maximum differential temperature is exceeded.

If any mass concrete placed under these Specifications proves unsatisfactory, the Contractor will be required to make the necessary repairs or to remove and replace the material at the Contractor's expense.

The Engineer will be the sole judge in determining the acceptance of a mass concrete member. Corrective actions, as approved in the Thermal Curing Plan Report, shall be made in those areas directed by the Engineer before the mass concrete member will be considered for acceptance.

**(C) Pre-Operational Conference.** Schedule a meeting with the Contractor, and suppliers representatives involved in construction operation of the mass concrete and the Engineer, at a mutually agreed time, to discuss and verify the methods of accomplishing all phases of the mass concrete operations, contingency planning, and standards of workmanship for the completed items of work. Include the Contractor's superintendents, foremen, subcontractors, and supplier's technical representatives, and all key personnel involved with the mass concrete work as attendees of the pre-operation conference. Do not begin

93 placement of mass concrete before the Engineer accepts the pre-operational  
94 conference as completed.

95  
96 **(D) Just-In-Time Training.** JITT shall conform to Section 695 – JUST IN  
97 TIME TRAINING.

98  
99 **(E) Mix Design.** The specialty Engineer shall select the concrete mix  
100 proportions that will generate the lowest maximum temperature possible to  
101 ensure that no Delayed Ettringite Formation (DEF) will occur and also the  
102 lowest temperature differential to ensure there will be no thermal cracking.  
103 Mass concrete shall conform to the provisions in Section 601 – Structural  
104 Concrete with the following exceptions:

105  
106 **(1)** Select concrete ingredients, e.g., aggregates, gradation,  
107 admixtures, and cement types that minimize the heat of hydration.

108  
109 **(2) Cementitious Material:** Mass concrete shall contain a minimum of  
110 505 pounds of cementitious material per cubic yard of concrete. To  
111 better control the heat of hydration of the mass concrete, the concrete  
112 mix design shall contain a pozzolanic material such as fly ash, silica  
113 fume, or ground granulated blast furnace slag (GGBFS). GGBFS shall  
114 be compliance with ASTM C989. The minimum amount of fly ash or  
115 natural pozzolan shall be the weight of the total amount of cementitious  
116 material.

117  
118 **(a)** When supplementary cementitious (SCM) material is  
119 GGBFS, the amount of SCM shall be 50 to 75 percent by weight  
120 of the total cementitious material used in the mix. When the SCM  
121 is not GGBFS, the SCM content shall be from 25 to 35 percent  
122 by weight of the total cementitious material used in the mix.

123  
124 **(3) Temperature Sensing Equipment:** Use thermistor-type temperature-  
125 sensing devices or an approved equal capable of indicating  
126 temperatures over a range of 50 to 200 degrees Fahrenheit, with an  
127 accuracy and precision of  $\pm 1$  degree Fahrenheit. Connect the sensors  
128 to a device that continuously records and displays temperatures and  
129 produces a record that can be detached and filed.

130  
131 **(F) Monitoring and Controlling Temperature.**

132  
133 **(1)** Thermally cure the concrete in order to maintain a temperature  
134 differential between the internal (hottest: located as close as possible to  
135 the center of the pour but not less than 12 inches from the surface) and  
136 external (coolest temperature of the concrete) of 35 degrees Fahrenheit  
137 maximum. In addition, the internal temperature of the concrete  
138 (measured at the hottest point located at the center of the pour) shall at

139  
140  
no time exceed 160 degrees Fahrenheit. The Contractor may submit a mix design that is outside of these temperature parameters if the analysis shows no signs of thermal cracking or Delayed Ettringite Formation (DEF). The Engineer will be the sole judge in determining the acceptance of the newly proposed temperature requirements.

**(2)** Use a combination of the following elements to thermally cure the concrete to maintain internal and differential temperature:

- (a)** Use of shaved, flaked, or chipped ice or other concrete cooling ingredients
- (b)** Use of liquid nitrogen dosing systems
- (c)** Controlling the rate or time of concrete placement
- (d)** Using insulation or supplemental external heat to control heat loss
- (e)** Using supplementary cementing materials or additives that will reduce heat of hydration without affecting strength or durability
- (f)** Using a mechanical cooling system
- (g)** Using a cooling system to control the core temperature
- (h)** Other methods accepted by the Engineer

**(3)** Provide temperature monitoring devices to record temperature development between the interior and exterior of the element at points approved by the Engineer, and shall monitor the mass pours to measure temperature differentials. Temperature monitoring shall continue until the interior temperature is within 35 degrees Fahrenheit of the lowest ambient temperature, and when the interior temperature has plateaued and is decreasing.

- (a)** Furnish and install a temperature monitoring and recording system. This system shall consist of temperature sensors and a data acquisition system. Use these devices to simultaneously measure and record the temperature of the concrete at the core, the surface, and the ambient temperature within 12 inches of the concrete pour. The Engineer may adjust the locations for all temperature sensors from those stated in the Contractor's Thermal Control Plan.

185  
186  
**(b)** Record each set of readings as they are taken and make a temperature chart for each mass pour element showing temperature readings vs. time. The temperature chart showing temperature differential shall have both the interior temperature and ambient temperatures on the same chart. Submit to the Engineer the readings and chart. If the temperatures indicate temperatures are trending toward non-compliant temperatures immediately inform the Engineer and take action as presented in the Thermal Control Plan. Record the temperature readings hourly or more frequently. The Engineer may change the recording frequency of the reading at any time.

**(c)** Methods of concrete consolidation and placement shall prevent damage to the temperature monitoring and recording system. Wiring from temperature sensors cast into the concrete shall be protected to prevent movement. Wire runs shall be kept short as possible. The ends of the temperature sensors shall not come into contact with concrete form or with bar reinforcing steel or casing.

**(4)** If monitoring indicates that the proposed measures are not controlling the concrete temperature differential within the 35 degrees Fahrenheit specified, implement corrective actions as presented in the Thermal Curing Plan to maintain the temperature differential.

**675.04 Measurement.** The Engineer will measure mass concrete as concrete used in other sections in accordance with that other applicable sections.

**675.05 Payment.** The Engineer will pay for the accepted mass concrete as concrete used in other sections as concrete under that other applicable sections.”

**END OF SECTION 675**

1 This Section shall be made a part of the Standard Specifications:  
2

3 **SECTION 680 - ELECTRIC AND COMMUNICATION SYSTEMS**  
4

5 **680.01 Description.** This work shall consist of furnishing all labor, materials and  
6 equipment to install in place and in operating condition underground structures required  
7 for the facilities of Hawaiian Electric, herein referred to as HE, the facilities of Hawaiian  
8 Telcom herein referred to as HT, AT&T Corporation hereinafter referred to a AT&T, and  
9 the facilities of Spectrum Oceanic herein referred to as CATV. Such works shall be  
10 performed and tested at the indicated locations in accordance with the requirements  
11 herein specified and the indicated details, or as ordered by the Engineer, and includes  
12 but is not limited to the following.  
13

14 **(A)** Complete underground duct system extension including excavation,  
15 backfilling, concrete work, conduits, handholes, and manholes, to be used in the  
16 future by HE for their cables and equipment. Work shall also include securing the  
17 approval of the HE inspector.  
18

19 **(B)** Complete underground duct system extension including excavation,  
20 backfilling, concrete work, conduits, handholes, and manholes to be used in the  
21 future by HT for their cables and equipment. Work shall also include securing the  
22 approval of the HT inspector.  
23

24 **(C)** Complete underground duct system extension including excavation,  
25 backfilling, concrete work, conduits, handholes and manholes, to be used in the  
26 future by CATV for their cables and equipment. Work shall also include securing  
27 the approval of the CATV inspector.  
28

29 **(D)** Complete underground duct system extension including excavation,  
30 backfilling, concrete work, conduits and pullboxes, to be used in the future by AT&T  
31 for their cables and equipment. Work shall also include securing the approval of  
32 the AT&T inspector.  
33

34 **(E)** Coordinate work and arrange for periodic inspections by HE, HT, AT&T,  
35 CATV and Engineer.  
36

37 **(F)** Provide warning tape above utility ductlines in accordance with the  
38 respective standard specifications of the respective utility companies and as  
39 indicated on the contract drawings.  
40

41 **(G)** Pass test mandrel through all ducts and conduits, and make corrections as  
42 directed by the utility inspectors or Engineer.  
43

44 **(H)** Provide pulling wire, polypropelene cord, in all empty ducts and conduits,  
45 unless indicated otherwise. Provide duct measuring/cable pulling tape in all HT  
46 ducts and conduits.  
47

48 (I) Immediately report and pay for damages to existing equipment and existing  
49 utility installations.

50  
51 (J) Obtain and pay for electrical permits, arrange for periodic inspection by local  
52 authorities and deliver certificate of final inspection to Engineer.

53  
54 (K) Contractor shall check and test the installation for completeness and  
55 functional operation as described by the drawings and specified herein. Final test  
56 shall be in the presence of Engineer and representatives of utility companies.  
57 Contractor shall arrange and pay for all testing costs.

58  
59 (1) Incidental parts which are not shown on the plans or specified herein  
60 and which are necessary to complete the underground electric, telephone,  
61 and cable television duct systems shall be furnished and installed by the  
62 Contractor as though such parts were shown on the plans, or specified  
63 herein or in the special provisions.

64  
65 (2) All electrical equipment shall conform to the NEMA Standards, and  
66 all electrical work shall conform to ordinances of City and County of  
67 Honolulu; latest edition of National Electrical Code; Title 6, Chapter 37,  
68 Hawaii Administrative Rules, State of Hawaii; and Regulations and  
69 Standard Practices of HE, HT, AT&T, and CATV.

70  
71 (L) Applicable rules, standards and specifications of following associations  
72 shall apply to materials and workmanship:

73  
74 (1) American National Standards Institute (ANSI)

75  
76 (2) Edison Electric Institute (EEI)

77  
78 (3) Illumination Engineer Society (IES)

79  
80 (4) National Board of Fire Underwriters (NBFU)

81  
82 (5) National Electrical Manufacturer's Association (NEMA)

83  
84 (6) National Fire Protection Association (NFPA)

85  
86 (7) Underwriters' Laboratories, Inc. (UL)

87  
88 **680.02 Materials.**

89  
90 (A) Materials shall meet the requirements specified in the following subsections  
91 of Division 700 - Materials.

92  
93 Concrete Pull Box 712.06(B)

96  
97 **(B)** Ducts and Conduits shall conform to the requirements of Section 712.27 -  
98 Conduits. Ducts and conduits required shall be new and provided by the  
99 Contractor in accordance with the construction drawings and specifications.

100  
101 **(1)** Polyvinyl Chloride (PVC) Schedule 40 type ducts shall be provided  
102 for the HE, HT, and CATV duct systems. The fittings shall be of the same  
103 material as the conduit and duct.

104 **(2)** High-Density Polyethylene (HDPE) SDR 11 Type duct casing,  
105 designed for directional boring use, shall be provided for the AT&T duct  
106 systems when installed via trenchless directional boring.

107  
108 **(a)** Duct lengths shall be 20'-0".

109 **(b)** Joints shall be secure, water-proof without the use of solvent  
110 cement.

111 **(c)** Product shall be CAN-LOC Directional Boring Conduit as  
112 manufactured by CANTEX INC. or approved equivalent.

113 **(3)** High-Density Polyethylene (HDPE) SDR 11 Type innerduct.  
114

115 **(C) Fluidized Thermal Backfill.** Submit concrete mix designs using State  
116 Highways Division form DOT 4-151. Fluidized thermal backfill shall meet the  
117 following requirements:  
118

119 The proportions for the following mix designs shall be in accordance with  
120 the guidelines of ACI 211 and ASTM C94 "Standard Specification for Ready Mix  
121 Concrete, Option B". The mixes may be modified to maintain yield, slump, setting  
122 time and strength. Prior to unloading, a maximum of two gallons of water per cubic  
123 yard, may be added, provided that the specification limits for slump and time are  
124 not exceeded. Reinforced masonry group proportions are selected from  
125 compression test results per ASTM C 1019, "Standard Method of Sampling and  
126 Testing Grout".  
127

128

Material	Fine Agg	Fine Agg	Course Agg
Type	Orca Stratum	Conc. Sand	#3 Fine
Source	B C-Basalt	Kapaa-Basalt	Kapaa-Basalt
Spec	ASTM C-33	ASTM C-33	ASTM C-33

Material	Course Agg	Cement	Water
Type	3/8" Pea Gravel	I / II	Water
Source	Kapaa-Basalt	Hawaiian	City-Water
Spec	ASTM C-33	ASTM C-150	ASTM C-1602

129  
130 Weight in LBS Per Cubic Yard (SSD)  
131 Mix: Fluidized Thermal Backfill 150 psi

Material Type	Sp. G	Volume (ft3)	XX67HE04
Slump			8" ± 1"
Cement	3.15	0.59	115 lb
Orca Stratum	2.75	5.54	950 lb
Conc. Sand	2.65	3.27	540 lb
#3 Fine	2.70	7.89	1330 lb
3/8" Pea Gravel	2.70	3.01	507 lb
Water	1.00	6.28	47.0 gal
Air		0.40	1.5%

133

134

135

136

137

138

(1) Fluidized Thermal Backfill design mix shall be coordinated with Geotherm, Inc. (21239 FM529 Rd, Bldg F Cypress, Texas 77433, telephone (281) 985-9344, fax (925) 999-8837) to ensure that the design thermal rho will be acceptable.

139

140

141

142

143

144

145

146

147

(2) In addition to the normal testing, two standard compression test cylinders shall be made from each design mix of the Fluidized Thermal Backfill. The test cylinders shall be made using the normal methods except each shall contain a special heater and thermocouple device properly located for the purpose of testing the thermal rho of the Fluidized Thermal Backfill. The special devices, laboratory testing, and consultation costs shall be paid by the Contractor and shall be purchased from Geotherm, Inc. Shipping costs shall be paid by the Contractor.

148

149

150

151

152

153

154

155

156

(D) Submit concrete mix design using State Highways Division form DOT 4-151. Concrete shall conform to the requirements of Section 601 - Structural Concrete, except that for concrete jackets and concrete caps, the maximum size of coarse aggregate shall be 3/4 inch in lieu of the one-inch to No. 4 specified and the slump shall be 6-inch minimum and 7-inch maximum. Concrete for manholes, handholes, and pullboxes shall be Class A. Concrete for jacketing conduits and ducts shall be Class B except that the cement content shall be 5.6 sacks per cubic yard.

157

158

159

160

(E) **Thermal Concrete (Class II Mix).** Submit concrete mix design using State Highways Division form DOT 4-151. Thermal concrete shall meet the following requirements:

161

162

163

164

(1) Class II design mix shall be coordinated with Geotherm, Inc. (21239 FM529 Rd, Bldg F Cypress, Texas 77433, telephone (281) 985-9344, fax (925) 999-8837) to ensure that the design thermal rho will be acceptable.

165

166

167

168

169

170

(2) In addition to the normal testing, two standard compression test cylinders shall be made from each design mix of the Class II concrete for the purpose of determining the thermal rho characteristics of the concrete. The test cylinders shall be made using the normal methods except each shall contain a special heater and thermocouple device properly located for the purpose of testing the thermal rho of the concrete. The special devices,



171 laboratory testing, and consultation costs shall be paid by the Contractor  
 172 and shall be purchased from Geotherm, Inc. Shipping costs shall also be  
 173 paid by the Contractor.  
 174

175 **(3)** The proportions for the following mix designs shall be in accordance  
 176 with the guidelines of ACI 211 and ASTM C94 "Standard Specification for  
 177 Ready Mix Concrete, Option B". The mixes may be modified to maintain  
 178 yield, slump, setting time and strength. Prior to unloading, a maximum of  
 179 two gallons of water per cubic yard, may be added, provided that the  
 180 specification limits for slump and time are not exceeded. Reinforced  
 181 masonry group proportions are selected from compression test results per  
 182 ASTM C 1019, "Standard Method of Sampling and Testing Grout".  
 183

Material	Fine Agg	Fine Agg	Course Agg	Course Agg
Type	Orca Stratum	Conc. Sand	#3 Fine	3/8" Pea Gra
Source	B C-Basalt	Kapaa-Basalt	Kapaa-Basalt	Kapaa-Basalt
Spec	ASTM C-33	ASTM C-33	ASTM C-33	ASTM C-33

184

Material	Cement	Water	Admix	Admix
Type	I / II	Water	MASTERPOZ ZOLITH 322	MASTERSET DELVO
Source	Hawaiian	City-Water	BASF-A	BASF-B
Spec	ASTM C-150	ASTM C-1602	ASTM C-494	ASTM C-494

185

186 Weight in LBS Per Cubic Yard (SSD)  
 187 Mix: 3,000 PSI-3/4" Pump  
 188

Material Type	Sp. G	Volume (ft3)	3067HE04
Slump			6" ± 1"
Cement	3.15	3.28	645 lb
Orca Stratum Sand	2.75	4.87	835 lb
Conc. Sand	2.65	2.39	395 lb
#3 Fine	2.70	8.16	1375 lb
3/8" Pea Gravel	2.70	2.82	475 lb
Water	1.00	5.08	38.0 gal
MASTERPOZZOLITH 322			19-45 lq oz
MASTERSET DELVO			0-45 lq oz
Air		0.41	1.5%

189

190

191 **(F)** Concrete Bricks shall conform to Subsection 704.02 - Concrete Brick. The  
 192 use of broken bricks will not be permitted.  
 193

194

195 **(G)** Cement Mortar for Setting Bricks shall conform to the requirements of  
 196 Section 601 - Structural Concrete. Submit concrete mix designs using State  
 Highways Division form DOT 4-151. Cement mortar shall be a one-to-three

197 volumetric mix of portland cement and a combined fine aggregate. Combined fine  
198 aggregate shall conform to Section 703 - Aggregates.

199  
200 **(H)** Concrete Covers, Steel Frames and Miscellaneous Metals and  
201 Appurtenances for Handholes and Manholes. Steel shapes shall conform to the  
202 applicable provisions of Section 713 - Structural Steel and Related Materials.  
203 Fabrication of steel frames shall conform to the applicable provisions of Section  
204 501 - Steel Structures. Steel frames shall be hot-dipped galvanized after  
205 fabrication. Concrete for covers shall be Class A and shall conform to Section  
206 601 - Structural Concrete. Cast iron frame and cover shall conform to Subsection  
207 712.07 (A) - Frame and Covers.

208  
209 **(I) Reinforcing Steel.** Reinforcing Steel for manholes, handholes and  
210 pullboxes, and concrete jackets shall conform to the requirements of Section  
211 602 - Reinforcing Steel.

212  
213 **(J)** Materials will be subject to inspection at any time. Failure of the Engineer  
214 to note faulty material or workmanship during construction will not relieve the  
215 Contractor of his responsibility for removing or replacing such materials and  
216 dredging the work at his expense.

217  
218 **680.03 Construction.**

219  
220 **(A) General.**

221  
222 **(1)** The Contractor shall in performing required excavation and backfill,  
223 exercise due care to avoid disturbing existing facilities. He shall remove  
224 and dispose of all demolished or excess material from the job site.

225  
226 **(2)** Upon completion of the work, the Contractor shall submit an 'As Built'  
227 or corrected plan showing in detail thereon all construction changes.

228  
229 **(3)** Before bidding, the Contractor shall visit project site, carefully review  
230 each section of the Specification and all Drawings of this Contract, and  
231 obtain and review the standards, specifications and drawings of the local  
232 utility companies.

233  
234 **(a)** The Contractor shall report any error, conflicts or omissions  
235 to the Engineer at least one week before submission of bids for  
236 interpretation or clarification. If errors or omissions are not reported,  
237 the Contractor shall provide necessary work at no cost to the State  
238 of Hawaii to properly complete intent of Specification and Plans.

239  
240 **(4)** The Contractor shall make detailed arrangements for work by utility  
241 companies pertaining to this contract. Payment to utility companies for their  
242 work shall be by the State.

243

244 (5) Electric and telecommunication utility cables and equipment shall be  
245 by respective utility companies.

246  
247 **(B) Existing Utilities.** Existing utilities are shown on the drawings in  
248 approximate locations for the convenience of the Contractor. It is not the intention  
249 of plans to imply that all existing utilities are drawn and located, and the fact that  
250 any utility is not shown on the drawings shall not relieve the Contractor of his  
251 responsibility under this Section. It shall be the Contractor's responsibility to  
252 ascertain the location of all existing utilities which may be subject to damages by  
253 construction under this Contract. The Contractor shall:

254  
255 (1) Support and protect all HE, HT, AT&T, and CATV utilities during  
256 construction,

257  
258 (2) Notify HE, HT, AT&T, and CATV immediately of any damage to its  
259 system caused by construction under this Contract, and

260  
261 (3) Reconstruct, at his expense, damaged portions of the utility system  
262 in accordance with the requirements and specifications of HE, HT, AT&T,  
263 and CATV.

264  
265 (4) Contractor shall provide 24-hour access to all utility poles in the  
266 vicinity of the construction area.

267  
268 (5) Where the Contractor determines that bracing of utility poles is  
269 required for execution of the work, the Contractor shall develop detailed  
270 pole bracing plans and back-up structural calculations for submission to and  
271 review by the utility companies. The plans and calculations are to be  
272 stamped by a Structural Engineer licensed in the State of Hawaii.  
273 Concurrence by the utility companies of the pole bracing plans does not  
274 relieve the Contractor of the responsibility for the integrity of the poles. Any  
275 damage occurring as a result of pole damage or failure shall be the paid for  
276 by the Contractor. Work to develop the pole bracing designs and supporting  
277 calculations is considered incidental to the Contract.

278  
279 (6) The Contractor shall be responsible for and shall pay for all damages  
280 to existing utilities of all types.

281  
282 (7) Existing Transite Ductlines may contain asbestos. Any removal or  
283 demolition of existing transite ductlines shall meet Federal, State, and  
284 County Requirements For Hazardous Material Demolition and Removal  
285 Work.

286  
287 **(C) HE Facilities.** The Contractor shall provide HE with 24-hour access to all  
288 existing HE facilities that are to remain, or, for facilities that are to be removed,  
289 until they are removed and to all new HE facilities after they are installed. The  
290 Contractor shall be responsible for any delays in utility company work due to his

291 failure to provide access to utility company facilities. All existing HE facilities shall  
292 remain in place until proposed permanent facilities are completed and energized.  
293 Any cost for temporary relocations arising during construction shall be borne by  
294 the Contractor.  
295

296 (1) Electrical equipment or conductors, whether electrically energized or  
297 not, shall remain in place at all time during construction. Handling and  
298 moving of electrical equipment or conductors, when required by the  
299 Engineer, shall be done by HE. Work by the Contractor in areas with  
300 energized electrical equipment or conductors shall be performed with  
301 extreme caution to prevent accidents and to avoid disturbing or damaging  
302 this equipment or conductors or any temporary supports or protective  
303 guards that are constructed. Unless otherwise permitted by HE, all work by  
304 the Contractor in areas with energized equipment of conductors shall be  
305 performed in the presence of a HE inspector and/or standby man. The  
306 Contractor shall have the sole responsibility for maintaining safe and  
307 efficient working conditions and procedures in these areas.  
308

309 (2) Any existing or new HE facilities including equipment or conductors  
310 damaged by the Contractor during construction shall be replaced by HE at  
311 the Contractor's expense.  
312

313 (3) The Contractor shall give HE two weeks advance notice for any work  
314 to be done by HE on its facilities. Unless otherwise indicated on the  
315 drawings or otherwise directed by the Engineer, HE will:  
316

317 (a) Remove the concrete envelope from existing underground  
318 HE ducts containing electrical cables.  
319

320 (b) Construct temporary supports and protective barriers for  
321 bare duct and electrical cables immediately after removal of the  
322 concrete envelope is completed. Material for such supports and  
323 barriers shall be furnished by the Contractor as an incidental cost.  
324

325 (c) Remove temporary supports and protective barriers  
326 constructed under item (2) above.  
327

328 **(D) HT, AT&T and CATV Facilities.** The Contractor shall provide HT, AT&T,  
329 and CATV with 24-hour access to all existing HT, AT&T, and CATV facilities that  
330 are to remain, or, for facilities that are to be removed, until they are removed and  
331 to all new HT, AT&T and CATV facilities after they are installed. The Contractor  
332 shall be responsible for any delays in utility company work due to his failure to  
333 provide access to utility company facilities. All existing HT, AT&T, and CATV  
334 facilities shall remain in place until proposed permanent facilities are completed  
335 and energized. Any cost for temporary relocations arising during construction shall  
336 be borne by the Contractor.  
337

338 (1) Telecommunications equipment or cables, shall remain in place at  
339 all time during construction. Handling and moving of telecommunications  
340 equipment or cables, when required by the Engineer, shall be done by their  
341 respective Owners. Unless otherwise permitted by HT, AT&T and CATV,  
342 all work by the Contractor in areas with energized equipment of conductors  
343 shall be performed in the presence of their respective inspector and/or  
344 standby man. The Contractor shall have the sole responsibility for  
345 maintaining safe and efficient working conditions and procedures in these  
346 areas.

347  
348 (2) Any existing or new HT, AT&T and CATV facilities including  
349 equipment or cables damaged by the Contractor during construction shall  
350 be replaced by their respective Owners (HT, AT&T and CATV) at the  
351 Contractor's expense.

352  
353 (3) The Contractor shall give HT, AT&T and CATV two weeks advance  
354 notice for any work to be done by on their respective facilities.

355  
356  
357 **(E) Excavation and Backfill.** All excavation and backfill for electric, telephone,  
358 AT&T, and cable television underground structures and trenches shall conform to  
359 the requirements of Section 206 - Excavation and Backfill for Drainage Facilities,  
360 modified as follows:

361 (1) Excavation.

362 (a) The width of trenches for concrete encased ducts shall be  
363 not less than the width of the encasement nor more than that  
364 required to properly and safely execute the work.

365  
366 (b) Ducts encased in concrete jackets which are bedded in  
367 disturbed (fill) ground shall be installed in the following manner:  
368 Embankments shall be built up and thoroughly compacted to the  
369 elevation which is three feet above the top-of-jacket elevation, or to  
370 the required elevation shown on the plans, whichever is less than  
371 five times the width of the jacket. This work shall conform to the  
372 requirements of Section 203 - Excavation and Embankment. The  
373 trench to accommodate the jacket shall then be excavated through  
374 the constructed embankment.

375  
376 (c) The Contractor shall not excavate for manholes, handholes  
377 and duct lines until he has the locations for these structures staked  
378 out and verified to be correct, and approved by the respective utility  
379 company inspectors.

380  
381 (d) Trenches shall be excavated at least 50 feet ahead of duct  
382 placement so that any obstruction to the duct line can be avoided  
383  
384

through gradual alignment. The profile grade may be adjusted by the Engineer to increase or decrease the excavation depth (up to 3 feet) as a result of unforeseen obstruction at no additional cost.

**(e)** Excavation for each handhole and manhole, plus 50 feet of trenching for all ducts connected to those structures shall be completed, and the locations and depths of the handholes and manholes shall be verified and approved by the respective utility company inspectors prior to construction or installation of the structures. All cuts in excess of depths required shall be filled with concrete, beach sand, or Type A backfill. The lateral limit for handholes and manholes shall be the vertical surfaces two feet outside the neat lines of the structures.

**(f)** The bottom of the trench excavation shall be flat and smooth. All trenches shall be approved by the Engineer and the utility company inspectors before any ducts or conduits are placed or any structures and foundations are constructed.

**(g)** The trenches shall be widened at handholes and manholes to permit proper entry of the ducts and conduits.

**(h)** The Contractor shall provide all sheathing and bracing to support the sides of the excavated trench. Provision and removal of these items are incidental to the trenching work.

**(2)** Backfill.

**(a)** No backfilling shall be done until the duct and conduit installations and the handhole and manhole placements have been verified to be correct and approved by the respective utility company inspectors.

**(b)** Material for use as trench backfill for direct buried cable above select backfill shall be non-expansive and shall conform to Subsection 680.03 (D) (2) (c) below. Backfilling and compaction shall be as specified in Section 206 – Excavation and Backfill for Drainage Facilities. Backfill material shall be beach sand, earth or earth and gravel mixture. If earth and gravel, mixture must pass 1/2 inch mesh screen and contain not more than 20 percent of rock particles by volume.

**(c)** Material for use as select backfill for direct buried cables shall be non-expansive and shall conform to the requirements of Subsection 703.15 Filler.

**(d)** Backfilling shall be to finished grades indicated on

432 accompanying drawings, and/or matching existing conditions.  
433 Backfill material shall be placed in maximum of 8" layers in loose  
434 thickness before compacting. Backfill shall be thoroughly  
435 compacted with hand or mechanical tampers to 95% of the ASTM  
436 D1557 maximum dry density. In no case shall tamping be  
437 accomplished by using the wheels or tracks of a vehicle.  
438

439 **(3)** Fluidized Thermal Backfill. Backfill for ductbank noted on the  
440 contract drawings shall meet the following requirements.  
441

442 **(a)** Install Fluidize Thermal Backfill where shown on the  
443 drawings to encase pipes and ducts, and at other locations.  
444

445 **(b)** Notify Engineer and respective utility inspector three working  
446 days before placing Fluidize Thermal Backfill. Fluidize Thermal  
447 Backfill shall be placed only in the presence of the Engineer or  
448 respective utility inspector.  
449

450 **(c)** Trench shall be free of all debris and free of standing water  
451 before Fluidize Thermal Backfill is poured.  
452

453 **(d)** Anchor pipe type casings to the trench bottom to prevent  
454 flotation during Fluidize Thermal Backfill installation. Alternatively,  
455 a first thin layer of Fluidize Thermal Backfill shall be poured around  
456 the pipe so that when it has hardened it will adequately hold the pipe  
457 down without floating, then a second layer of Fluidize Thermal  
458 Backfill shall be poured to the prescribed thickness.  
459

460 **(e)** Fluidize Thermal Backfill shall be supplied and transported in  
461 such a way as to minimize segregation and facilitate installation.  
462 Fluidize Thermal Backfill shall be poured or pumped into the trench  
463 and shall completely fill all voids without causing segregation. Flow  
464 requirements may have to be adjusted for installations using pumps.  
465

466 **(f)** If trenches are shored or bulkheads are used on sloping  
467 ground, the shoring shall be lifted no later than one hour after the  
468 Fluidize Thermal Backfill is poured while the Fluidize Thermal  
469 Backfill is still in a semi-fluid state. The Fluidize Thermal Backfill  
470 should not be allowed to develop cracks. If cracks or voids are  
471 found to exist, they shall be filled by pouring additional Fluidize  
472 Thermal Backfill.  
473

474 **(g)** In poorly draining native soils, provisions shall be made to  
475 allow excess bleed water to drain away or be pumped away.  
476

477 **(h)** Where Fluidize Thermal Backfill is used for direct buried  
478 conduit applications, place an electrical warning tape 12 inches

479  
480  
above the top of the direct buried conduits.

**(i)** Field Testing: Conduct testing and submit reports for the following. Costs of all testing shall be borne by the Contractor.

**1.** Consistency (Flow Test): Shall conform to ASTM C 143-03; one test when a set of strength test cylinders is prepared.

**2.** Thermal Resistivity (Thermal Probe Test): Conduct thermal resistivity test using Geotherm TPA-7000 equipment in accordance with IEEE Standard 442-1981 and ICC guidelines for the transient thermal probe test. Two cylinders for thermal testing shall be prepared each time strength cylinders are taken. Tests shall be conducted on a sample cured for 4 days and on a sample totally dried in an oven at 105 degrees C.

**3.** Air Content: Conduct air content test per ASTM C 231-03 when compressive strength test cylinders are prepared.

**4.** Density Tests: Conduct density tests when thermal resistivity tests are performed.

**5.** Unconfined compressive strength: A set of 3 cylinders shall be prepared per ASTM C 31-03 for each day's pour plus additional sets for each 100 cubic yards or fraction thereof. Conduct compressive strength tests on each set: 1 at 7 days and 2 at 28 days per ASTM C 39-03.

**(F) Installation of Conduits and Duct Banks.** All joints shall be water tight and all ducts shall be installed to drain towards pull points unless otherwise shown on the plans.

**(1)** Plastic Duct Joints.

**(a)** Field cutting of plastic ducts shall be performed by the Contractor and only with the use of a miter box. Burrs shall be removed by filing before the joint is made. All foreign matter shall be wiped off the sockets of the fittings and the edges of the duct with a clean cloth.

**(b)** Cement for plastic duct joints shall be obtained from the duct manufacturer. Thinning of the cement will not be permitted. A liberal and uniform coat of cement shall be applied with a natural bristle brush to the inside of the coupling and to the outside of the duct end. Immediately thereafter, the duct shall be slipped into the



526  
527  
socket of the fitting with a half-twist, and the excess cement shall be wiped off.

**(c)** Allow the joined members to cure for at least five minutes before disturbing or applying stress to the joint. After this initial cure, care must be exercised in handling to prevent twisting or pulling the joint. In damp weather, this interval shall be increased to allow for slower evaporation of the solvent.

**(d)** Another fitting or section of conduit may be added to the opposite end within 2 or 3 minutes if care is exercised in handling so that strain is not placed on the previous assembly.

**(e)** Any joint included in a section of conduit to be bent in the trench shall be assembled above ground and allowed to lie undisturbed for at least two hours before installation. In cases where a plastic connection is made with the union under stress due to misalignment or other factors, the union shall be staked out to relieve stress on the joint until the conduit is backfilled or encased.

**(2)** Plastic Duct Installation.

**(a)** The Contractor shall provide spacers to maintain proper separation between ducts. The bottom duct spacers shall be placed on the prepared trench bottom, the first tier of ducts placed in the grooves of the spacers, and couplings attached to the duct ends. Spacers shall be 15 inches or more away from any coupling or joint. Successive lengths of ducts shall then be placed and connected to the preceding lengths as specified above. The second tier of duct spacers shall then be placed over the ducts previously placed and followed by installation of couplings. The operation shall be repeated for each successive tier until the top tier is set in place after which the top spacers are placed.

**(b)** When conduit is assembled above the ground, the spacer shall be supported in a vertical position by use of a No. 4 rebar and smooth black steel wire, No. 14 gage.

**(c)** Duct alignment shall be as straight as feasible. Such directional changes as are required shall be made by using field made bends or with segments using angle couplings or deflection couplings, except where otherwise indicated. The deflection angle between two adjacent lengths of duct shall not exceed five degrees, unless otherwise indicated.

**(d)** Horizontal and vertical bends for HE conduits/ducts shall be constructed with 30-foot minimum radius curves unless otherwise

573 approved by the utility inspector. Horizontal bends for HT, and  
574 CATV conduits/ducts shall be constructed with 25-foot minimum  
575 radius curves unless indicated otherwise or approved by the  
576 respective utility company inspector. Vertical bends for HT, and  
577 CATV conduits/ducts shall be constructed with 25-foot minimum  
578 radius curves unless indicated otherwise or approved by the  
579 respective utility company inspector.

580  
581 **(e)** Spacers shall not be located at the centers of a long radius  
582 bend. On pre-fabricated bends, the spacer shall be located in the  
583 tangent, free of the coupling. On trench formed bend, the spacer  
584 shall be located midway between the tangent and center of the  
585 bend.

586  
587 **(f)** Precaution shall be taken to prevent damage in plastic duct  
588 lines from thermal expansion and contraction. All ducts shall be cool  
589 when placed in trenches and when the concrete jacket is being  
590 poured.

591  
592 **(g)** Ducts ending in manholes shall be terminated with junior end  
593 bells. End bells, terminators or ducts shall be flush to inside wall  
594 surfaces; duct extension into boxes is not acceptable.

595  
596 **(h)** The terminated ends of the conduit in an underground  
597 structure shall be free of support for a distance of at least 10 feet  
598 from the structure. The conduit shall be aligned and supported  
599 inside the structure with proper spacing and shall be cut to length  
600 after the concrete envelope has cured.

601  
602 **(i)** The ends of the conduit shall be sealed with a plastic cap,  
603 plug, or approved substitute at the end of each day's work, when  
604 work on duct installation has to be interrupted, where ducts may be  
605 submerged in water, and in stub outs.

606  
607 **(j)** For installation of ducts and innerducts for AT&T, see AT&T  
608 Corp. Construction Notes in the contract drawings.

609  
610 **(3)** A 4" wide warning tape, orange in color with a black imprinted  
611 message "WARNING -- STOP DIGGING -- CALL HAWAIIAN TELCOM,  
612 COMMUNICATIONS CABLE BURIED BELOW, FAILURE TO COMPLY  
613 COULD RESULT IN LEGAL ACTION", shall be placed 12" below the  
614 surface over the duct or concrete jacket for the entire length of duct  
615 installations. See HT Standard Drawing No. 34028. Recommended tape  
616 is manufactured by Thor Enterprises, Inc., Sun Prairie, WI 53590, part  
617 numbers DTOGTE-41 (1,000 feet), and DTOGTE-46 (6,000 feet).  
618 Equivalent tapes are acceptable.

619

620 (4) The Contractor shall apply a thin coat of sealing compound on ducts  
621 and conduits at couplings and bells.

622  
623 (5) Conduits stubbed for future connections shall be plugged and  
624 marked.

625  
626 (6) The Contractor shall securely anchor duct banks prior to pouring  
627 concrete encasement to prevent ducts from floating.

628  
629 **(G) Installation of Split Ducts Encased in Concrete Jacket.** Split ducts with  
630 concrete jacket shall be installed around existing cables to remain in service,  
631 where shown on the plans.

632  
633 (1) Field cutting of plastic ducts longitudinally into two equal halves shall  
634 be performed by the Contractor with the use of accepted tools and  
635 equipment.

636  
637 (2) The two equal halves of plastic ducts shall be placed carefully around  
638 existing cables and sturdily bound together with wire or tape in order not to  
639 dislodge during pouring of concrete. The Contractor shall take necessary  
640 precautions not to damage the cables and shall work in an expeditious  
641 manner in order to keep uncovered cable exposed for as short a period of  
642 time as possible.

643  
644 (3) Subsequent to binding of the plastic ducts, concrete shall be poured  
645 to fully encase the ducts. The dimensions of the concrete encasement shall  
646 be similar to standard duct formation encasement dimensions.

647  
648 **(H)** The Contractor shall test the completed ducts by passing a test mandrel  
649 through the length of each duct of each duct run. For HE, and CATV conduits, the  
650 mandrel shall be a bullet shaped, blunt tipped type, unless indicated otherwise,  
651 about 14 inches long with a diameter 1/2 inch less than the inside diameter of the  
652 ducts through the length of each duct run. Mandrel for HT ducts shall be bullet  
653 shaped, blunt tipped type about 12 inches long with a diameter 1/4 inch less than  
654 the inside diameter of the ducts through the length of each duct run. Scars in the  
655 mandrel deeper than 1/32 inch, other than that caused by normal abrasion  
656 between the duct line and bottom of mandrel shall be considered an indication of  
657 the presence of burrs and/or obstructions in the duct run. The Contractor shall  
658 remove such burrs and/or obstructions, after which the test mandrel will be passed  
659 through again. All tests shall be conducted in the presence of the Engineer and  
660 respective utility company inspectors, and shall be repeated until the results  
661 obtained are satisfactory to the Engineer and to the utility company inspectors.

662  
663 **(I)** Unless indicated otherwise, the Contractor shall furnish and install a 1/8  
664 inch Polyolefin pull line between pull points in all ducts after testing.

665  
666 (1) For HT ducts, provide duct measuring/cable pulling tape (NEPTCO

667 WP1800P Muletape or approved equal) in each new duct. Using the duct  
668 measuring/cable pulling tape, Contractor shall measure the actual lengths  
669 for duct runs and for at least one duct of each common duct run. The  
670 distances shall be marked on the record prints and submitted to the Owner  
671 at the final inspection. A copy of the record prints shall also be submitted  
672 to the HT inspector for record keeping.

673  
674 **(2)** For HE ducts, provide duct measuring/cable pulling tape (NEPTCO  
675 WP1800P Muletape or approved equal) in each new duct.

676  
677 **(J) Concrete.** The Contractor shall notify the utility companies inspector a  
678 minimum of 72 hours prior to placement of any concrete.

679  
680 **(1)** Securely anchor duct banks prior to pouring concrete encasement to  
681 prevent ducts from floating.

682  
683 **(2)** When pouring concrete, prevent heavy masses of concrete from  
684 falling directly on ducts. If unavoidable, protect ducts with plank.

685  
686 **(3)** Direct flow of concrete down sides of duct bank to bottom, allowing  
687 concrete to rise between ducts, filling all open spaces uniformly.

688  
689 **(4)** To insure against voids in concrete, work a long, flat splicing bar or  
690 spatula liberally and carefully up and down the vertical rows of ducts.  
691 Mechanical vibrators shall be used for stacked duct banks of three ducts or  
692 higher.

693  
694 **(5)** Cure concrete for a minimum of 72 hours before permitting traffic  
695 and/or backfilling.

696  
697 **(6)** Convey concrete from mixer to forms rapidly to prevent segregation.  
698 Free drop shall be limited to five feet, unless authorized by inspector.

699  
700 **(7)** Placing.

701  
702 **(a)** Clean and remove all debris from inside forms and trenches  
703 before placing concrete.

704  
705 **(b)** Place concrete only on clean damp surfaces, free from water.

706  
707 **(c)** Place concrete in forms, in horizontal layers not exceeding  
708 18" thickness.

709  
710 **(d)** Place concrete to avoid segregation of materials and  
711 displacement of ducts, inserts and reinforcing.

712  
713 **(e)** Vibrate structural concrete thoroughly during and

714 immediately after placing to insure dense watertight concrete.

715

716 **(8)** Forming.

717

718 **(a)** Forms shall be of good sound lumber with sufficient strength  
719 and conforming to shapes and dimensions indicated on drawings.

720

721 **(b)** Forms shall be treated with non-staining form oil immediately  
722 before each use.

723

724 **(9)** Patching: Patch all voids, pour joints and holes before concrete is  
725 thoroughly dry. Use mortar of same proportions as original concrete.

726

727 **(10)** Curing: Curing of concrete shall be accomplished by impervious  
728 membrane method with liquid membrane compound. Apply two or more  
729 coats to obtain a total of one gallon for each 150 square feet of concrete  
730 surface.

731

732 **(K) Reinforcing Steel.**

733

734 **(1)** Clean reinforcing of mill or rust scale and form to dimensions  
735 indicated.

736

737 **(2)** Install reinforcing in proper locations and secure in place to prevent  
738 movement during concrete placing or vibrating.

739

740 **(L) Concrete Brick.**

741

742 **(1)** Concrete brick shall be laid in full bed of mortar, both horizontally and  
743 vertically.

744

745 **(2)** Mortar shall be one-part cement and three parts sand, thoroughly  
746 mixed and used when fresh. Re-tampering will not be allowed.

747

748 **(3)** Setting bed shall be of depth required to bring top of blocks flush with  
749 finish line.

750

751 **(M) Restoration of Existing Streets and Other Improvements.** Street,  
752 sidewalks, curbs, gutters, traffic detection loops, and other improvements of the  
753 State, private owners, or those of the City and County which are maintained by the  
754 State, which are damaged by rearrangements to the electric, cable television,  
755 AT&T, or telephone system, shall be restored by the Contractor to their original  
756 condition. Materials and workmanship shall conform to the applicable sections in  
757 these specifications. Payment for all materials and labor required shall be  
758 considered as incidental to the various contract items.

759

760 **(1)** Repairing of City streets and other improvements not maintained by

761 the State and where such work is called for on the plans shall conform to  
762 the requirements of the City and County of Honolulu.

763  
764 (2) All disturbed unpaved surfaces shall be backfilled and graded to  
765 match the surrounding areas, and sodded areas shall be replanted with the  
766 same type of grass. Fences and other improvements shall be restored to  
767 their original condition. This work shall be incidental to and included in the  
768 appropriate contract item under which the rearranged facility is provided.

769  
770 **680.04 Measurement.**

771  
772 (A) The electric and communication ductlines, intercept handhole, intercept  
773 manhole and demolition of utility ductlines and structures will be paid on a lump  
774 sum basis. Measurement for payment will not apply.

775  
776 (B) The Engineer will measure the handhole penetration, manhole penetration,  
777 transformer pad, pullbox, handhole and manhole per each in accordance with the  
778 contract documents.

779  
780 **680.05 Payment.** The Engineer will pay for the accepted pay items listed below on  
781 a contract lump sum basis, as shown in proposal schedule. Payment will be full  
782 compensation for work prescribed in this section and in contract documents.

783  
784 The Engineer will pay for each of the following pay items when included in proposal  
785 schedule:

786	787 <b>Pay Item</b>	788	789 <b>Pay Unit</b>
789	HECo Ductline, _____	790	Lump Sum
791	HTCo Ductline, _____	792	Lump Sum
793	CATV Ductline, _____	794	Lump Sum
795	Demolish _____	796	Lump Sum
797	_____ Handhole/Manhole Penetration	798	Each
799	_____ Handhole/Manhole Adjustment	800	Each
801	_____ Handhole	802	Each
803	_____ Manhole	804	Each
805	_____ Intercept Handhole	806	Lump Sum
807	_____ Intercept Manhole	807	Lump Sum

808		
809	HECO Transformer Pad Penetration ____	Each
810		
811	AT&T One 6-Inch Conduit Encased in Concrete Jacket	
812	with Four 1.5-Inch Inner Ducts	Lump Sum
813		
814	HECO _-Phase Transformer Pad ____	Each
815		
816	Demolish and Remove Existing Concrete Encased	
817	Asbestos-Containing Transite Ductline After	
818	Cables are Removed by ____;	Lump Sum
819		

820           The Engineer will pay for the accepted hauling and stockpiling of salvaged  
821 materials and equipment off the right-of-way, in accordance with Subsection 104.02 –  
822 Changes.”

823  
824           The Engineer will not pay for trench and structure excavation and backfill; saw  
825 cutting and repairing of existing pavement, sidewalk, curb or gutter; conduit stub-outs;  
826 conduit stub-out markers; conduit risers; steel reinforcement for ductlines; conduit  
827 interception; manhole/handhole interception of existing ductlines; ductline tie-in, and duct  
828 sealing of conduits separately. The Engineer will consider the cost as included in the  
829 contract prices of the various contract items. The cost is for the work described in this  
830 section and in the contract documents.

831  
832  
833

**END OF SECTION 680**

The undersigned bidder acknowledges receipt of any addendum issued by the Department by recording in the space below the date of receipt.

Addendum No. 1 \_\_\_\_\_ Addendum No. 3 \_\_\_\_\_  
Addendum No. 2 \_\_\_\_\_ Addendum No. 4 \_\_\_\_\_  
Addendum No. 5 \_\_\_\_\_ Addendum No. 6 \_\_\_\_\_

In accordance with Section 103D-302, Hawaii Revised Statutes, the undersigned as bidder has listed the name of each person or firm, who will be engaged by the bidder on the project as Joint Contractor or Subcontractor and the nature of work to be done by each. It is understood that failure to comply with the aforementioned requirements may be cause for rejection of the bid submitted.

	<u>Name of Subcontractor</u>	<u>Nature and Scope of Work</u>
1.	_____	_____
2.	_____	_____
3.	_____	_____
4.	_____	_____
5.	_____	_____
6.	_____	_____
7.	_____	_____
8.	_____	_____
9.	_____	_____

	<u>Name of Joint contractor</u>	<u>Nature and Scope of Work</u>
1.	_____	_____
2.	_____	_____
3.	_____	_____

("None" or if left blank indicates no Subcontractor or Joint Contractor; if more space is needed, attach additional sheets.)



## PROPOSAL SCHEDULE

ITEM NO.	ITEM	APPROX. QUANTITY	UNIT	UNIT PRICE	AMOUNT
201.1000	Clearing and Grubbing	37	Acre	\$ _____	\$ _____
201.1100	Additional Grubbing	F.A.	F.A.	F.A.	\$56,000.00
202.1000	Removal of Existing Bridges	L.S.	L.S.	L.S.	\$ _____
202.2000	Removal of Guardrails	1,965	L.F.	\$ _____	\$ _____
202.2100	Removal of Miscellaneous Walls and Fences	814	L.F.	\$ _____	\$ _____
202.3000	Removal of AC Pavement	50,594	S.Y.	\$ _____	\$ _____
202.3300	Removal of Concrete Curb and Gutter	3,292	L.F.	\$ _____	\$ _____
202.3500	Removal of Concrete Sidewalk	54	S.Y.	\$ _____	\$ _____
202.3600	Removal of Pavement Striping and Markers	L.S.	L.S.	L.S.	\$ _____
202.4000	Removal of 5-Inch, 24-Inch, 30-Inch, and 36-Inch Water Lines	2,920	L.F.	\$ _____	\$ _____
202.4200	Removal of gate valves, valve boxes, manholes, reaction blocks, thrust beams, fire hydrants, concrete jackets, and any other waterline appurtenances and incidentals	L.S.	L.S.	L.S.	\$ _____
202.4300	Removal of Drainage Culverts and Headwalls.	L.S.	L.S.	L.S.	\$ _____
202.4400	Removal of Excess Excavated Material, including Selected Material and Borrow Excavated Material.	63,914	C.Y.	\$ _____	\$ _____

## PROPOSAL SCHEDULE

ITEM NO.	ITEM	APPROX. QUANTITY	UNIT	UNIT PRICE	AMOUNT
203.0100	Roadway Excavation	83,127	C.Y.	\$ _____	\$ _____
203.0200	Imported Borrow	19,213	C.Y.	\$ _____	\$ _____
203.1000	Over Excavation, Moisture Conditioning and Recompaction	F.A.	F.A.	F.A.	\$100,000.00
204.1000	Trench Excavation for Water Lines	7,887	C.Y.	\$ _____	\$ _____
204.1100	Trench Backfill for Water Lines	2,482	C.Y.	\$ _____	\$ _____
204.2000	Trench Excavation for Sewer Lines	536	C.Y.	\$ _____	\$ _____
204.2100	Trench Backfill for Sewer Lines	529	C.Y.	\$ _____	\$ _____
205.1000	Structure Excavation for Kaloi Abutments and Wingwalls	880	C.Y.	\$ _____	\$ _____
205.1100	Structure Excavation for Honouliuli Abutments and Wingwalls	1,500	C.Y.	\$ _____	\$ _____
205.1200	Structure Excavation for Honouliuli Retaining Walls	371	C.Y.	\$ _____	\$ _____
205.2000	Structure Excavation for Palehua Box Culvert, Inlet and Outlet Structure	1,160	C.Y.	\$ _____	\$ _____
205.2100	Structure Excavation for Hunehune Box Culvert, Inlet and Outlet Structure	1,470	C.Y.	\$ _____	\$ _____
205.2200	Structure Excavation for 42-Inch Inlet/Outlet Structure	150	C.Y.	\$ _____	\$ _____
205.3000	Structure Excavation for Retaining Wall at Kahi Mohala	620	C.Y.	\$ _____	\$ _____

## PROPOSAL SCHEDULE

ITEM NO.	ITEM	APPROX. QUANTITY	UNIT	UNIT PRICE	AMOUNT
205.4000	Structure Backfill for Kaloi Abutments and Wingwalls	500	C.Y.	\$ _____	\$ _____
205.4100	CLSM Backfill for Honouliuli Abutments and Wingwalls	1,176	C.Y.	\$ _____	\$ _____
205.4200	Structure Backfill for Honouliuli Abutments and Wingwalls	62	C.Y.	\$ _____	\$ _____
205.4300	Structure Backfill for Honouliuli Retaining Walls	486	C.Y.	\$ _____	\$ _____
205.5000	Structure Backfill for Palehua Box Culvert	520	C.Y.	\$ _____	\$ _____
205.5100	Structure Backfill for Hunehune Box Culvert	1,300	C.Y.	\$ _____	\$ _____
205.5200	Structure Backfill for 42-Inch Inlet/Outlet Structure	48	C.Y.	\$ _____	\$ _____
205.6000	Structure Backfill for Retaining Wall at Kahi Mohala	700	C.Y.	\$ _____	\$ _____
205.7000	Filter Material	290	C.Y.	\$ _____	\$ _____
206.1000	Excavation for Drain Lines and Drain Culvert	19,368	C.Y.	\$ _____	\$ _____
207.1000	Channel Excavation (Kaloi and Honouliuli)	9,443	C.Y.	\$ _____	\$ _____
207.2000	Basin Excavation	31,957	C.Y.	\$ _____	\$ _____
209.0100	Installation, Maintenance, Monitoring, and Removal of BMP	L.S.	L.S.	L.S.	\$ _____
209.0200	Additional Water Pollution, Dust, and Erosion Control	F.A.	F.A.	F.A.	\$250,000.00

## PROPOSAL SCHEDULE

ITEM NO.	ITEM	APPROX. QUANTITY	UNIT	UNIT PRICE	AMOUNT
301.1000	Hot Mix Asphalt Base Course	44,385	TON	\$ _____	\$ _____
304.1000	Aggregate Base	202	C.Y.	\$ _____	\$ _____
305.1000	Aggregate Subbase	46,058	C.Y.	\$ _____	\$ _____
316.1000	Polypropylene Biaxial Geogrid	128,773	S.Y.	\$ _____	\$ _____
401.1000	2-Inch PMA Pavement, Mix No. IV	10,905	TON	\$ _____	\$ _____
401.1000	3-Inch HMA Pavement Speed Table, Mix No. IV	139	TON	\$ _____	\$ _____
401.1100	3-Inch PMA Pavement, Mix No. IV	71	TON	\$ _____	\$ _____
401.1200	2.5-Inch PMA Pavement, Mix No. IV	84	TON	\$ _____	\$ _____
411.1000	11-Inch Concrete Pavement	90	C.Y.	\$ _____	\$ _____
503.1000	Concrete for Kaloj Drilled Shaft Cap Beams	L.S.	L.S.	L.S.	\$ _____
503.1010	Concrete for Kaloj Wing Wall	L.S.	L.S.	L.S.	\$ _____
503.1020	Concrete for Kaloj Bridge Deck, End Beams, Diaphragms, and Corbels	L.S.	L.S.	L.S.	\$ _____
503.1030	Concrete for Kaloj Approach Slab with Sleeper Slab	L.S.	L.S.	L.S.	\$ _____
503.1040	Concrete for Kaloj Sidewalks	L.S.	L.S.	L.S.	\$ _____

## PROPOSAL SCHEDULE

ITEM NO.	ITEM	APPROX. QUANTITY	UNIT	UNIT PRICE	AMOUNT
503.1100	Concrete for Honouliuli Drilled Shaft Cap Beams	L.S.	L.S.	L.S.	\$ _____
503.1120	Concrete for Honouliuli Wing Walls and Keywalls	L.S.	L.S.	L.S.	\$ _____
503.1130	Concrete for Honouliuli Bridge Deck, End Beams, Diaphragms, and Corbels	L.S.	L.S.	L.S.	\$ _____
503.1140	Concrete for Honouliuli Approach Slabs and Sleeper Slabs	L.S.	L.S.	L.S.	\$ _____
503.1150	Concrete for Honouliuli Sidewalks	L.S.	L.S.	L.S.	\$ _____
503.1160	Concrete for Honouliuli Retaining Walls	L.S.	L.S.	L.S.	\$ _____
503.2000	Concrete for Palehua Box Culvert	L.S.	L.S.	L.S.	\$ _____
503.2010	Concrete for Palehua Box Culvert Inlet and Outlet Structures	L.S.	L.S.	L.S.	\$ _____
503.2100	Concrete for Hunehune Box Culvert	L.S.	L.S.	L.S.	\$ _____
503.2110	Concrete for Hunehune Box Culvert Inlet and Outlet Structures	L.S.	L.S.	L.S.	\$ _____
503.2200	Concrete for 42-Inch Inlet/Outlet Structures	L.S.	L.S.	L.S.	\$ _____
503.3000	Concrete for Retaining Walls at Kahi Mohala	L.S.	L.S.	L.S.	\$ _____
503.4000	Blanket Grinding and Mechanical Grooving for Kalo	L.S.	L.S.	L.S.	\$ _____
503.5000	Blanket Grinding and Mechanical Grooving for Honouliuli	L.S.	L.S.	L.S.	\$ _____

## PROPOSAL SCHEDULE

ITEM NO.	ITEM	APPROX. QUANTITY	UNIT	UNIT PRICE	AMOUNT
503.7000	Concrete for Reinforced Concrete Jackets	L.S.	L.S.	L.S.	\$ _____
503.7100	Concrete for Reinforced Concrete Reaction Blocks	L.S.	L.S.	L.S.	\$ _____
503.8000	Concrete Head Wall, 3.00 feet to 3.99 feet	L.S.	L.S.	L.S.	\$ _____
503.8010	Concrete Head Wall, 4.00 feet to 4.99 feet	L.S.	L.S.	L.S.	\$ _____
503.8020	Concrete Head Wall, 5.00 feet to 5.99 feet	L.S.	L.S.	L.S.	\$ _____
503.8030	Concrete Head Wall, 10.00 feet to 10.99 feet	L.S.	L.S.	L.S.	\$ _____
504.1000	Prestressed Concrete Girders for Kaloi	10	EACH	\$ _____	\$ _____
504.1100	Prestressed Concrete Girders for Honouliuli	10	EACH	\$ _____	\$ _____
507.1000	Bridge Concrete Railing for Kaloi	250	L.F.	\$ _____	\$ _____
507.1010	Concrete End Post Railing for Kaloi	4	EACH	\$ _____	\$ _____
507.1100	Bridge Concrete Railing for Honouliuli	355	L.F.	\$ _____	\$ _____
507.1110	Concrete End Post Railing for Honouliuli	4	EACH	\$ _____	\$ _____
511.0100	Furnishing Drilled Shaft Drilling Equipment	L.S.	L.S.	L.S.	\$ _____
511.0200	Obstructions	40	HOURS	\$ _____	\$ _____

## PROPOSAL SCHEDULE

ITEM NO.	ITEM	APPROX. QUANTITY	UNIT	UNIT PRICE	AMOUNT
511.0300	Load Test at Kaloi (48-inch Diameter)	1	EACH	\$ _____	\$ _____
511.0310	Load Test at Honouliuli (48-inch Diameter)	1	EACH	\$ _____	\$ _____
511.0400	Drilled Shaft at Kaloi (48-Inch Diameter)	624	L.F.	\$ _____	\$ _____
511.0410	Drilled Shaft at Honouliuli (48-Inch Diameter)	507	L.F.	\$ _____	\$ _____
511.0500	Unclassified Shaft Excavation at Kaloi (48-Inch Diameter)	624	L.F.	\$ _____	\$ _____
511.0510	Unclassified Shaft Excavation at Honouliuli (48-Inch Diameter)	507	L.F.	\$ _____	\$ _____
511.0600	Trial Shaft at Kaloi (48-inch Diameter)	90	L.F.	\$ _____	\$ _____
511.0610	Trial Shaft at Honouliuli (48-inch Diameter)	90	L.F.	\$ _____	\$ _____
511.0700	Coring for Integrity Testing for Acceptable Drilled Shafts	275	L.F.	\$ _____	\$ _____
540.1000	VESLMC for Kaloi Closure Pour	L.S.	L.S.	L.S.	\$ _____
602.1000	Reinforcing Steel for Kaloi Drilled Shaft Cap Beams	L.S.	L.S.	L.S.	\$ _____
602.1010	Reinforcing Steel for Kaloi Wing Wall	L.S.	L.S.	L.S.	\$ _____
602.1020	Reinforcing Steel for Kaloi Bridge Deck, End Beams, Diaphragms, and Corbels	L.S.	L.S.	L.S.	\$ _____
602.1030	Reinforcing Steel for Kaloi Approach Slabs with Sleeper Slabs	L.S.	L.S.	L.S.	\$ _____

## PROPOSAL SCHEDULE

ITEM NO.	ITEM	APPROX. QUANTITY	UNIT	UNIT PRICE	AMOUNT
602.1040	Reinforcing Steel for Kaloi Sidewalks	L.S.	L.S.	L.S.	\$ _____
602.1100	Reinforcing Steel for Honouliuli Drilled Shaft Cap Beam	L.S.	L.S.	L.S.	\$ _____
602.1120	Reinforcing Steel for Honouliuli Wing Walls and Keywalls	L.S.	L.S.	L.S.	\$ _____
602.1130	Reinforcing Steel for Honouliuli Bridge Deck, End Beams, Diaphragms, and Corbels	L.S.	L.S.	L.S.	\$ _____
602.1140	Reinforcing Steel for Honouliuli Approach Slabs and Sleeper Slab	L.S.	L.S.	L.S.	\$ _____
602.1150	Reinforcing Steel for Honouliuli Sidewalk	L.S.	L.S.	L.S.	\$ _____
602.1160	Reinforcing Steel for Honouliuli Retaining Walls	L.S.	L.S.	L.S.	\$ _____
602.2000	Reinforcing Steel for Palehua Box Culvert	L.S.	L.S.	L.S.	\$ _____
602.2010	Reinforcing for Palehua Box Culvert Inlet and Outlet Structures	L.S.	L.S.	L.S.	\$ _____
602.2100	Reinforcing Steel for Hunehune Box Culvert	L.S.	L.S.	L.S.	\$ _____
602.2110	Reinforcing Steel for Hunehune Box Culvert Inlet and Outlet Structures	L.S.	L.S.	L.S.	\$ _____
602.2200	Reinforcing Steel for 42-Inch Inlet/Outlet Structures	L.S.	L.S.	L.S.	\$ _____
602.3000	Reinforcing Steel for Retaining Wall at Kahi Mohala	L.S.	L.S.	L.S.	\$ _____
602.3200	Reinforcing Steel for Reinforced Concrete Jackets and Reaction Blocks	L.S.	L.S.	L.S.	\$ _____



## PROPOSAL SCHEDULE

ITEM NO.	ITEM	APPROX. QUANTITY	UNIT	UNIT PRICE	AMOUNT
603.1000	Bed Course Material for Culvert	3,554	C.Y.	\$ _____	\$ _____
603.2000	24-Inch Reinforced Concrete Pipe, Class III	11,846	L.F.	\$ _____	\$ _____
603.2001	30-Inch Reinforced Concrete Pipe, Class III	1,935	L.F.	\$ _____	\$ _____
603.2002	36-Inch Reinforced Concrete Pipe, Class III	34	L.F.	\$ _____	\$ _____
603.2003	42-Inch Reinforced Concrete Pipe, Class III	73	L.F.	\$ _____	\$ _____
603.2004	48-Inch Reinforced Concrete Pipe, Class III	269	L.F.	\$ _____	\$ _____
603.3000	Clean Existing Culvert	F.A.	F.A.	F.A.	\$10,000.00
604.1000	Type C Manholes, 14.99 Feet to 14 Feet	1	EACH	\$ _____	\$ _____
604.1001	Type C Manholes, 13.99 Feet to 13 Feet	1	EACH	\$ _____	\$ _____
604.1002	Type C Manholes, 11.99 Feet to 11 Feet	4	EACH	\$ _____	\$ _____
604.1003	Type C Manholes, 10.99 Feet to 10 Feet	1	EACH	\$ _____	\$ _____
604.1004	Type C Manholes, 8.99 Feet to 8 Feet	2	EACH	\$ _____	\$ _____
604.1005	Type C Manholes, 7.99 Feet to 7 Feet	1	EACH	\$ _____	\$ _____
604.1006	Type C Manholes, 6.99 Feet to 6 Feet	2	EACH	\$ _____	\$ _____

## PROPOSAL SCHEDULE

ITEM NO.	ITEM	APPROX. QUANTITY	UNIT	UNIT PRICE	AMOUNT
604.2000	Type Special Manholes, 9.99 Feet to 9 Feet	1	EACH	\$ _____	\$ _____
604.3000	Type 2A-9P Inlet, 14.99 Feet to 14 Feet	1	EACH	\$ _____	\$ _____
604.3001	Type 2A-9P Inlet, 13.99 Feet to 13 Feet	1	EACH	\$ _____	\$ _____
604.3002	Type 2A-9P Inlet, 12.99 Feet to 12 Feet	2	EACH	\$ _____	\$ _____
604.3003	Type 2A-9P Inlet, 11.99 Feet to 11 Feet	2	EACH	\$ _____	\$ _____
604.3004	Type 2A-9P Inlet, 10.99 Feet to 10 Feet	5	EACH	\$ _____	\$ _____
604.3005	Type 2A-9P Inlet, 9.99 Feet to 9 Feet	2	EACH	\$ _____	\$ _____
604.3006	Type 2A-9P Inlet, 8.99 Feet to 8 Feet	11	EACH	\$ _____	\$ _____
604.3007	Type 2A-9P Inlet, 7.99 Feet to 7 Feet	14	EACH	\$ _____	\$ _____
604.3008	Type 2A-9P Inlet, 6.99 Feet to 6 Feet	25	EACH	\$ _____	\$ _____
604.3009	Type 2A-9P Inlet, 5.99 Feet to 5 Feet	3	EACH	\$ _____	\$ _____
604.4000	Type Special 2A-9P Inlet, 17.99 Feet to 17 Feet	1	EACH	\$ _____	\$ _____
604.4001	Type Special 2A-9P Inlet, 15.99 Feet to 15 Feet	2	EACH	\$ _____	\$ _____
604.4002	Type Special 2A-9P Inlet, 13.99 Feet to 13 Feet	1	EACH	\$ _____	\$ _____

## PROPOSAL SCHEDULE

ITEM NO.	ITEM	APPROX. QUANTITY	UNIT	UNIT PRICE	AMOUNT
604.4003	Type Special 2A-9P Inlet, 12.99 Feet to 12 Feet	1	EACH	\$ _____	\$ _____
604.4004	Type Special 2A-9P Inlet, 11.99 Feet to 11 Feet	2	EACH	\$ _____	\$ _____
604.4005	Type Special 2A-9P Inlet, 10.99 Feet to 10 Feet	1	EACH	\$ _____	\$ _____
604.4006	Type Special 2A-9P Inlet, 9.99 Feet to 9 Feet	5	EACH	\$ _____	\$ _____
604.4007	Type Special 2A-9P Inlet, 7.99 Feet to 7 Feet	3	EACH	\$ _____	\$ _____
604.4008	Type Special 2A-9P Inlet, 6.99 Feet to 6 Feet	7	EACH	\$ _____	\$ _____
607.1000	6-Foot Chain Link Fence	5,737	L.F.	\$ _____	\$ _____
607.2000	Chain Link Gate, 6 Feet High and 12 Feet Wide	10	EACH	\$ _____	\$ _____
610.1000	4-Inch Reinforced Concrete Driveway	L.S.	L.S.	L.S.	\$ _____
612.1000	Grouted Rubble Paving	L.S.	L.S.	L.S.	\$ _____
614.1000	New Street Survey Monuments	12	EACH	\$ _____	\$ _____
616.1000	Temporary Irrigation System	L.S.	L.S.	L.S.	\$ _____
619.1000	Planting	L.S.	L.S.	L.S.	\$ _____
621.1000	Counting Stations	L.S.	L.S.	L.S.	\$ _____

## PROPOSAL SCHEDULE

ITEM NO.	ITEM	APPROX. QUANTITY	UNIT	UNIT PRICE	AMOUNT
622.1000	State Street Light Standard, 98W LED Luminaire, 8' Bracket Arm, Standard Pole, Base and Appurtenances	111	EACH	\$ _____	\$ _____
622.1010	State Street Light Standard, 98W LED Luminaire, 8' Bracket Arm, 18' Pole, Base and Appurtenances	2	EACH	\$ _____	\$ _____
622.1020	State Street Light Standard, 98W LED Luminaire, 8' Bracket Arm, 17' Pole, Base and Appurtenances	1	EACH	\$ _____	\$ _____
622.1030	State Street Light Standard, 120W LED Luminaire, 8' Bracket Arm, Standard Pole, Base and Appurtenances	15	EACH	\$ _____	\$ _____
622.1040	State Street Light Standard, 120W LED Luminaire, 8' Bracket Arm, 18' Pole, Base and Appurtenances	1	EACH	\$ _____	\$ _____
622.1050	State Street Light Standard, 120W LED Luminaire, 8' Bracket Arm, 25' Pole, Base and Appurtenances	105	EACH	\$ _____	\$ _____
622.1060	State Street Light, 98W LED Luminaire, 8' Bracket Arm, Mounted on HECO Wood Pole	8	EACH	\$ _____	\$ _____
622.1070	Street Light Metering Cabinet, pad, panelboard, meter socket and appurtenances	2	EACH	\$ _____	\$ _____
622.1080	GE Light Grid Node	243	EACH	\$ _____	\$ _____
622.1090	Type "B" Streetlight Pullboxes	225	EACH	\$ _____	\$ _____
622.1100	Streetlight Conductors, #2 RHW	95,260	L.F.	\$ _____	\$ _____
622.1110	Streetlight 2"C Pvc Sch 40	35,390	L.F.	\$ _____	\$ _____
622.1120	Street Light Trench Excavation	35,390	L.F.	\$ _____	\$ _____
622.1130	Street Light Concrete	136	C.Y.	\$ _____	\$ _____

## PROPOSAL SCHEDULE

ITEM NO.	ITEM	APPROX. QUANTITY	UNIT	UNIT PRICE	AMOUNT
622.2000	Remove Type "B" Streetlight Pull box	12	EACH	\$ _____	\$ _____
622.2010	Remove Pole Mounted Streetlight, Bracket Arm, Luminaire, and Appurtenances	15	EACH	\$ _____	\$ _____
622.2020	Remove Standalone Streetlight Base, 30' Pole, Bracket Arm, Luminaire, and Appurtenances	22	EACH	\$ _____	\$ _____
622.2030	Remove Streetlight Ductbank	2,640	L.F.	\$ _____	\$ _____
622.2040	Remove Streetlight Cables	2,640	L.F.	\$ _____	\$ _____
622.3000	HECo. Service Charge for Street Light Service	L.S.	L.S.	L.S.	\$ _____
623.0001	Traffic Signal Cabinet and Foundation	5	EACH	\$ _____	\$ _____
623.0002	Type I Traffic Signal Standard (10' Arm) with conduit & Cabling	38	EACH	\$ _____	\$ _____
623.0005	Type II Traffic Signal Standard (20' Arm) with conduit & Cabling	2	EACH	\$ _____	\$ _____
623.0006	Type II Traffic Signal Standard (25' Arm) with conduit & Cabling	10	EACH	\$ _____	\$ _____
623.0007	Type II Traffic Signal Standard (25'/15' Arm) with conduit & Cabling	2	EACH	\$ _____	\$ _____
623.0008	Type II Traffic Signal Standard (30' Arm) with conduit & Cabling	20	EACH	\$ _____	\$ _____
623.0009	Type II Traffic Signal Standard (35' Arm) with conduit & Cabling	6	EACH	\$ _____	\$ _____
623.0010	Type II Traffic Signal Standard (40' Arm) with conduit & Cabling	1	EACH	\$ _____	\$ _____

## PROPOSAL SCHEDULE

ITEM NO.	ITEM	APPROX. QUANTITY	UNIT	UNIT PRICE	AMOUNT
623.0011	Type II Traffic Signal Standard (45' Arm) with conduit & Cabling	2	EACH	\$ _____	\$ _____
623.0012	Type II Traffic Signal Standard (50' Arm) with conduit & Cabling	2	EACH	\$ _____	\$ _____
623.0013	Street Light Traffic Signal Standard	11	EACH	\$ _____	\$ _____
623.0014	Traffic Signal Assembly, All Ball, with Cabling	35	EACH	\$ _____	\$ _____
623.0015	Traffic Signal Assembly, Straight Arrow, with Cabling	16	EACH	\$ _____	\$ _____
623.0016	Traffic Signal Assembly, Left Arrow, with Cabling	14	EACH	\$ _____	\$ _____
623.0017	Traffic Signal Assembly, Left Arrow, Programmed Visibility	16	EACH	\$ _____	\$ _____
623.0018	Traffic Signal Assembly, Yellow Flasher, with Cabling	2	EACH	\$ _____	\$ _____
623.0019	Pedestrian Signal Assembly with Cabling	32	EACH	\$ _____	\$ _____
623.0020	Pedestrian Pushbutton with Instruction Sign with Cabling	32	EACH	\$ _____	\$ _____
623.0021	Type "A" Pullbox	14	EACH	\$ _____	\$ _____
623.0022	Type "B" Pullbox	45	EACH	\$ _____	\$ _____
623.0023	Type "C" Pullbox	241	EACH	\$ _____	\$ _____
623.0024	Pullbox Tie-in	103	EACH	\$ _____	\$ _____

## PROPOSAL SCHEDULE

ITEM NO.	ITEM	APPROX. QUANTITY	UNIT	UNIT PRICE	AMOUNT
623.0025	Loop Detector Sensing Unit (6 Ft. x 6 Ft.) with Cabling	161	EACH	\$ _____	\$ _____
623.0026	EVP Optical Receiver	20	EACH	\$ _____	\$ _____
623.0027	EVP Optical Receiver Cabling	3,000	L.F.	\$ _____	\$ _____
623.0028	Traffic Signal Ductline 1-2"C Pvc Sch 40, Conc. Encased	6,200	L.F.	\$ _____	\$ _____
623.0029	Traffic Signal Ductline 2-2"C Pvc Sch 40, Conc. Encased	20	L.F.	\$ _____	\$ _____
623.0030	Traffic Signal Ductline 6-2"C Pvc Sch 40, Conc. Encased	7,000	L.F.	\$ _____	\$ _____
623.0031	Traffic Signal Ductline 7-2"C Pvc Sch 40, Conc. Encased	300	L.F.	\$ _____	\$ _____
623.0032	Traffic Signal Ductline 8-2"C Pvc Sch 40, Conc. Encased	200	L.F.	\$ _____	\$ _____
623.0033	Type 1 Cable - 26C#14	6,000	L.F.	\$ _____	\$ _____
623.0034	Type 2 Cable - 2C#14	20,000	L.F.	\$ _____	\$ _____
623.0035	Type 6 Cable - Electrical Service Cable	500	L.F.	\$ _____	\$ _____
623.0036	Demolish Traffic Signal Conduits, Cables, and Equipment	L.S.	L.S.	L.S.	\$ _____
623.0037	Service and Metering Equipment Assembly	6	EACH	\$ _____	\$ _____
623.0039	HECo. Service Charge for Traffic Signal Service	L.S.	L.S.	L.S.	\$ _____

## PROPOSAL SCHEDULE

ITEM NO.	ITEM	APPROX. QUANTITY	UNIT	UNIT PRICE	AMOUNT
624.0000	6-Inch Ductile Iron Pipe, Class 53	115	L.F.	\$ _____	\$ _____
624.0001	8-Inch Ductile Iron Pipe, Class 53	72	L.F.	\$ _____	\$ _____
624.0002	12-Inch Ductile Iron Pipe, Class 53	433	L.F.	\$ _____	\$ _____
624.0003	16-Inch Ductile Iron Pipe, Class 53	212	L.F.	\$ _____	\$ _____
624.0004	20-Inch Ductile Iron Pipe, Class 53	823	L.F.	\$ _____	\$ _____
624.0005	24-Inch Ductile Iron Pipe, Class 53	106	L.F.	\$ _____	\$ _____
624.0006	30-Inch Ductile Iron Pipe, Class 53	92	L.F.	\$ _____	\$ _____
624.0007	36-Inch Ductile Iron Pipe, Class 53	1,532	L.F.	\$ _____	\$ _____
624.0008	42-Inch Ductile Iron Pipe, Class 53	56	L.F.	\$ _____	\$ _____
624.1000	20-Inch Bevel Geared Gate Valve	1	EACH	\$ _____	\$ _____
624.1001	30-Inch Bevel Geared Gate Valve	1	EACH	\$ _____	\$ _____
624.1002	36-Inch Bevel Geared Gate Valve	2	EACH	\$ _____	\$ _____
624.1200	12-Inch Gate Valve	5	EACH	\$ _____	\$ _____
624.1210	6-Inch Gate Valve	3	EACH	\$ _____	\$ _____



## PROPOSAL SCHEDULE

ITEM NO.	ITEM	APPROX. QUANTITY	UNIT	UNIT PRICE	AMOUNT
624.1300	3/4-Inch ARV	2	EACH	\$ _____	\$ _____
624.1301	2-Inch Offset ARV	7	EACH	\$ _____	\$ _____
624.2000	Relocate Water Service Lateral at Station 144+92.6	L.S.	L.S.	L.S.	\$ _____
624.2100	Fire Hydrant	4	EACH	\$ _____	\$ _____
624.3000	Cathodic Protection	L.S.	L.S.	L.S.	\$ _____
624.8000	Temporary Waterline By-Pass 1	L.S.	L.S.	L.S.	\$ _____
624.8001	Temporary Waterline By-Pass 2	L.S.	L.S.	L.S.	\$ _____
624.8002	Temporary Waterline By-Pass 3	L.S.	L.S.	L.S.	\$ _____
624.8003	Temporary Waterline By-Pass 4	L.S.	L.S.	L.S.	\$ _____
624.8004	Temporary Waterline By-Pass 5	L.S.	L.S.	L.S.	\$ _____
624.8005	Temporary Waterline By-Pass 6	L.S.	L.S.	L.S.	\$ _____
624.8006	Temporary Waterline By-Pass 7	L.S.	L.S.	L.S.	\$ _____
624.8007	Temporary Waterline By-Pass 8	L.S.	L.S.	L.S.	\$ _____
624.8008	Temporary Waterline By-Pass 9	L.S.	L.S.	L.S.	\$ _____

## PROPOSAL SCHEDULE

ITEM NO.	ITEM	APPROX. QUANTITY	UNIT	UNIT PRICE	AMOUNT
624.8009	Temporary Waterline By-Pass 10	L.S.	L.S.	L.S.	\$ _____
624.8010	Temporary Waterline By-Pass 11	L.S.	L.S.	L.S.	\$ _____
624.8011	Temporary Waterline By-Pass 12	L.S.	L.S.	L.S.	\$ _____
624.8012	Temporary Waterline By-Pass 13	L.S.	L.S.	L.S.	\$ _____
624.8013	Temporary Waterline By-Pass 14	L.S.	L.S.	L.S.	\$ _____
624.8014	Temporary Waterline By-Pass 15	L.S.	L.S.	L.S.	\$ _____
624.8015	Temporary Waterline By-Pass 16	L.S.	L.S.	L.S.	\$ _____
624.8016	Temporary Waterline By-Pass 17	L.S.	L.S.	L.S.	\$ _____
624.8017	Temporary Waterline By-Pass 18	L.S.	L.S.	L.S.	\$ _____
624.8018	Temporary Waterline By-Pass 19	L.S.	L.S.	L.S.	\$ _____
624.8019	Temporary Waterline By-Pass 20	L.S.	L.S.	L.S.	\$ _____
624.8020	Temporary Waterline By-Pass 21	L.S.	L.S.	L.S.	\$ _____
624.8021	Temporary Waterline By-Pass 22	L.S.	L.S.	L.S.	\$ _____
624.8022	Temporary Waterline By-Pass 23	L.S.	L.S.	L.S.	\$ _____

## PROPOSAL SCHEDULE

ITEM NO.	ITEM	APPROX. QUANTITY	UNIT	UNIT PRICE	AMOUNT
624.9000	Relocate Irrigation System	F.A.	F.A.	F.A.	\$10,000.00
625.1000	10-Inch PVC for Sewer System	385	L.F.	\$ _____	\$ _____
626.1000	Sewer Manhole, 14 Feet to 14.99 Feet	1	EACH	\$ _____	\$ _____
626.2300	Type "A" Manhole 11.99 Feet to 11 Feet	4	EACH	\$ _____	\$ _____
626.3501	Type "D" Manhole 7.99 Feet to 7 Feet	6	EACH	\$ _____	\$ _____
626.4000	Type "C" Manhole 9.99 Feet to 9 Feet	1	EACH	\$ _____	\$ _____
626.5000	12-Inch Gate Valve Standard Valve Box	5	EACH	\$ _____	\$ _____
626.5100	6-Inch Gate Valve Standard Valve Box	3	EACH	\$ _____	\$ _____
626.6000	3/4-Inch Air Relief Valve Standard Valve Box	2	EACH	\$ _____	\$ _____
626.7000	Adjusting Water Manhole Frame and Cover	L.S.	L.S.	L.S.	\$ _____
626.8000	Adjusting Water Valve Box	L.S.	L.S.	L.S.	\$ _____
653.1000	36-Inch Ductile Iron Pipe Class 53 Waterline Pilot Tube Microtunneling	L.S.	L.S.	L.S.	\$ _____
627.0001	CCTV, Controller, CCTV	6	EACH	\$ _____	\$ _____
627.0002	CCTV Type "C" Pullbox	78	EACH	\$ _____	\$ _____

## PROPOSAL SCHEDULE

ITEM NO.	ITEM	APPROX. QUANTITY	UNIT	UNIT PRICE	AMOUNT
627.0003	CCTV Ductline 2-2"C Pvc Sch 40, Conc. Encased	4,600	L.F.	\$ _____	\$ _____
627.0004	CCTV Ductline 4-2"C Pvc Sch 40, Conc. Encased	6,400	L.F.	\$ _____	\$ _____
627.0005	CCTV Ductline 5-2"C Pvc Sch 40, Conc. Encased	100	L.F.	\$ _____	\$ _____
627.0006	CCTV Ductline 6-2"C Pvc Sch 40, Conc. Encased	400	L.F.	\$ _____	\$ _____
627.0007	Dual Camera Site Equipment	4	EACH	\$ _____	\$ _____
627.0008	Quad Camera Site Equipment	1	EACH	\$ _____	\$ _____
627.0009	CCTV Camera Cable	1,000	L.F.	\$ _____	\$ _____
627.0010	Demolish CCTV Conduits, Cables, and Equipment	L.S.	L.S.	L.S.	\$ _____
627.0011	Broadband Type "B" Pullbox	78	EACH	\$ _____	\$ _____
627.0012	Broadband Ductline 2-2"C Pvc Sch 40, Conc. Encased	6,000	L.F.	\$ _____	\$ _____
629.1000	Profiled Thermoplastic Striping	2,051	L.F.	\$ _____	\$ _____
629.1100	4-Inch Pavement Striping (Thermoplastic)	37,884	L.F.	\$ _____	\$ _____
629.1200	6-Inch Pavement Striping (Thermoplastic)	56,643	L.F.	\$ _____	\$ _____
629.1300	8-Inch Pavement Striping (Thermoplastic)	10,165	L.F.	\$ _____	\$ _____

## PROPOSAL SCHEDULE

ITEM NO.	ITEM	APPROX. QUANTITY	UNIT	UNIT PRICE	AMOUNT
629.1400	12-Inch Pavement Striping (Thermoplastic)	8,943	L.F.	\$ _____	\$ _____
629.1500	24-Inch Pavement Striping (Thermoplastic)	292	L.F.	\$ _____	\$ _____
629.2000	Crosswalk Marking (Thermoplastic)	161	LANE	\$ _____	\$ _____
629.3000	Pavement Arrow (Thermoplastic)	40	EACH	\$ _____	\$ _____
629.3100	Pavement Symbol (Thermoplastic)	192	EACH	\$ _____	\$ _____
629.4000	Pavement Word (Thermoplastic)	46	EACH	\$ _____	\$ _____
629.5100	Type "C" Pavement Marker	332	EACH	\$ _____	\$ _____
629.5200	Type "D" Pavement Marker	5	EACH	\$ _____	\$ _____
629.5300	Type "H" Pavement Marker	999	EACH	\$ _____	\$ _____
629.5400	Type "F" Pavement Marker	4	EACH	\$ _____	\$ _____
629.6000	Temporary Construction Zone Markings	F.A.	F.A.	F.A.	\$50,000.00
631.1000	Regulatory Sign (10 Square Feet or Less)	130	EACH	\$ _____	\$ _____
634.1000	Portland Cement Concrete Sidewalk	31,695	S.Y.	\$ _____	\$ _____
635.1000	E-Construction License	F.A.	F.A.	F.A.	\$10,000.00

## PROPOSAL SCHEDULE

ITEM NO.	ITEM	APPROX. QUANTITY	UNIT	UNIT PRICE	AMOUNT
638.1000	Curb, Type 2D	16,915	L.F.	\$ _____	\$ _____
638.2000	Curb and Gutter, Type 2DG	17,360	L.F.	\$ _____	\$ _____
641.1000	Hydro-Mulch Seeding	L.S.	L.S.	\$ _____	\$ _____
642.1000	Plant Maintenance	9	MONTH	\$ _____	\$ _____
642.2000	Irrigation Maintenance	9	MONTH	\$ _____	\$ _____
645.1000	Traffic Control	L.S.	L.S.	L.S.	\$ _____
645.2000	Additional Police Officers, Additional Traffic Control Devices, and Advertisements	F.A.	F.A.	F.A.	\$750,000.00
647.0001	Type "B" Pullbox	78	EACH	\$ _____	\$ _____
647.0002	ITS, 72 Strand, Fiber Optic Cable	24,000	L.F.	\$ _____	\$ _____
647.0003	ITS 3-cell Innerduct	65,600	L.F.	\$ _____	\$ _____
647.0004	ITS Ductline 3-2"C Pvc Sch 40, Conc. Encased	4,000	L.F.	\$ _____	\$ _____
647.0005	ITS Ductline 1-4"C Pvc Sch 40, Conc. Encased	3,200	L.F.	\$ _____	\$ _____
647.0006	ITS Ductline 3-2" & 1-4"C Pvc Sch 40, Conc. Encased	16,000	L.F.	\$ _____	\$ _____
647.0007	ITS Demolish Conduits, Cables, and Equipment	L.S.	L.S.	L.S.	\$ _____

## PROPOSAL SCHEDULE

ITEM NO.	ITEM	APPROX. QUANTITY	UNIT	UNIT PRICE	AMOUNT
648.1000	Field-Posted Drawings	L.S.	L.S.	L.S.	\$ _____
650.1100	Curb Ramp, Type A	55	EACH	\$ _____	\$ _____
650.1200	Curb Ramp, Type B	12	EACH	\$ _____	\$ _____
650.1400	Curb Ramp, Type D	4	EACH	\$ _____	\$ _____
651.0000	AT&T One 6-Inch Conduit Encased in Concrete Jacket with Four 1.5-Inch Inner Ducts - Honouliuli Bridge, Horizontal Directional Drilling	L.S.	L.S.	L.S.	\$ _____
652.1000	36-Inch Ductile Iron Pipe Class 53 Waterline Pilot Tube Microtunneling	L.S.	L.S.	L.S.	\$ _____
655.1000	Dumped Riprap	986	C.Y.	\$ _____	\$ _____
660.1000	Allowance for Trench Excavation and Backfill, and Installation of Gas Pipelines	F.A.	F.A.	F.A.	\$65,000.00
680.2000	CATV Ductline, Two 4-Inch Conduit Encased in Concrete Jacket	L.S.	L.S.	L.S.	\$ _____
680.2100	CATV Ductline, One 4-Inch Conduit Encased in Concrete Jacket	L.S.	L.S.	L.S.	\$ _____
680.2200	CATV 3' x 5' Intercept Handhole	1	EACH	\$ _____	\$ _____
680.2300	CATV Handhole/Manhole Penetration	4	EACH	\$ _____	\$ _____
680.2400	CATV Handhole/Manhole Adjustment	3	EACH	\$ _____	\$ _____
680.2500	Demolish CATV Ductline	L.S.	L.S.	L.S.	\$ _____

## PROPOSAL SCHEDULE

ITEM NO.	ITEM	APPROX. QUANTITY	UNIT	UNIT PRICE	AMOUNT
680.2600	Demolish CATV Handhole/Manhole	L.S.	L.S.	L.S.	\$ _____
680.3000	CATV Ductline, Two 4-Inch Conduit Encased in Concrete Jacket (For Future Development)	L.S.	L.S.	L.S.	\$ _____
680.3011	CATV Ductline, Four 4-Inch Conduit Encased in Concrete Jacket (For Future Development)	L.S.	L.S.	L.S.	\$ _____
680.3100	CATV Ductline, One 4-Inch Conduit Encased in Concrete Jacket (For Future Development)	L.S.	L.S.	L.S.	\$ _____
680.3200	CATV 2' x 6' Handhole	1	EACH	\$ _____	\$ _____
680.4010	HTCO Ductline, Three 4-Inch Conduit Encased in Concrete Jacket	L.S.	L.S.	L.S.	\$ _____
680.4100	HTCO Ductline, Two 4-Inch Conduit Encased in Concrete Jacket	L.S.	L.S.	L.S.	\$ _____
680.4200	HTCO Ductline, One 4-Inch Conduit Encased in Concrete Jacket	L.S.	L.S.	L.S.	\$ _____
680.4310	HTCO 5' x 10' Manhole	2	EACH	\$ _____	\$ _____
680.4400	HTCO Handhole/Manhole Penetration	6	EACH	\$ _____	\$ _____
680.4500	HTCO Handhole/Manhole Adjustment	4	EACH	\$ _____	\$ _____
680.4600	Demolish HTCO Ductline	L.S.	L.S.	L.S.	\$ _____
680.4700	Demolish HTCO Handhole/Manhole	L.S.	L.S.	L.S.	\$ _____
680.4800	Demolish HTCO Equipment pad	L.S.	L.S.	L.S.	\$ _____



## PROPOSAL SCHEDULE

ITEM NO.	ITEM	APPROX. QUANTITY	UNIT	UNIT PRICE	AMOUNT
680.4900	Demolish and Remove Existing Concrete Encased Asbestos-Containing Transite Ductline After Cables are Removed by HTCO	L.S.	L.S.	L.S.	\$ _____
680.5100	HTCO Ductline, Two 4-Inch Conduit Encased in Concrete Jacket (For Future Development)	L.S.	L.S.	L.S.	\$ _____
680.6010	HECO 6' x 14' Manhole	3	EACH	\$ _____	\$ _____
680.6011	HECO Betterment 6' x 14' Manhole	9	EACH	\$ _____	\$ _____
680.6012	HECO Betterment Upsize to 6' x 14' Manhole (Betterment)	1	EACH	\$ _____	\$ _____
680.6013	HECO Betterment 6' x 11' Manhole	1	EACH	\$ _____	\$ _____
680.6020	HECO 6' x 11' Manhole	3	EACH	\$ _____	\$ _____
680.6030	HECO 5' x 8' Manhole	3	EACH	\$ _____	\$ _____
680.6100	HECO 3' x 5' Handhole	2	EACH	\$ _____	\$ _____
680.6200	HECO 3' x 5' Handhole (For Traffic Signal Electric Service)	1	EACH	\$ _____	\$ _____
680.6300	HECO 1-Phase Transformer Pad (For Traffic Sign Electric Service)	1	EACH	\$ _____	\$ _____
680.6400	HECO Handhole/Manhole Penetration	2	EACH	\$ _____	\$ _____
680.6410	HECO Transformer Pad Penetration	1	EACH	\$ _____	\$ _____
680.6420	HECO Transformer Pad Penetration (For Street Light Service)	1	EACH	\$ _____	\$ _____

## PROPOSAL SCHEDULE

ITEM NO.	ITEM	APPROX. QUANTITY	UNIT	UNIT PRICE	AMOUNT
680.6500	HECO Handhole/Manhole Adjustment	1	EACH	\$ _____	\$ _____
680.6600	Demolish HECO Ductline	L.S.	L.S.	L.S.	\$ _____
680.6700	Demolish HECO Handhole/Manhole	L.S.	L.S.	L.S.	\$ _____
680.6800	Demolish HECO Equipment pad	L.S.	L.S.	L.S.	\$ _____
680.6900	Demolish HECO 138kV Foundation	L.S.	L.S.	L.S.	\$ _____
680.7000	Demolish and Remove Existing Concrete Encased Asbestos-Containing Transite Ductline After Cables are Removed by HECO	L.S.	L.S.	L.S.	\$ _____
680.7200	HECO Ductline, Two 6-Inch Conduit Encased in Concrete Jacket	L.S.	L.S.	L.S.	\$ _____
680.7300	HECO Ductline, Four 5-Inch Conduit Encased in Thermal Concrete Jacket & FTB	L.S.	L.S.	L.S.	\$ _____
680.7310	HECO Ductline, Eight 5-Inch Conduit Encased in Concrete Jacket & FTB	L.S.	L.S.	L.S.	\$ _____
680.7400	HECO Ductline, Four 5-Inch Conduit Encased in Concrete Jacket	L.S.	L.S.	L.S.	\$ _____
680.7410	HECO Ductline, Two 5-Inch Conduit Encased in Concrete Jacket	L.S.	L.S.	L.S.	\$ _____
680.7500	HECO Ductline, Two 4-Inch Conduit Encased in Concrete Jacket	L.S.	L.S.	L.S.	\$ _____
680.7600	HECO Ductline, Two 3-Inch Conduit Encased in Concrete Jacket	L.S.	L.S.	L.S.	\$ _____
680.7700	HECO Ductline, Two 2-Inch Conduit Encased in Concrete Jacket	L.S.	L.S.	L.S.	\$ _____

## PROPOSAL SCHEDULE

ITEM NO.	ITEM	APPROX. QUANTITY	UNIT	UNIT PRICE	AMOUNT
680.8000	HECO Ductline, Two 4-Inch Conduit Encased in Concrete Jacket (For Future Development)	L.S.	L.S.	L.S.	\$ _____
680.8100	HECO Ductline, Four 5-Inch Conduit Encased in Concrete Jacket	L.S.	L.S.	L.S.	\$ _____
680.8200	HECO Handhole/Manhole Penetration	1	EACH	\$ _____	\$ _____
680.8300	HECO Ductline, Four 5-Inch Conduit Encased in Concrete Jacket.	L.S.	L.S.	L.S.	\$ _____
680.8400	HECO Ductline, Four 5-Inch Conduit Encased in Thermal Concrete Jacket & FTB.	L.S.	L.S.	L.S.	\$ _____
680.9000	AT&T One 6-Inch Conduit Encased in Concrete Jacket with Four 1.5-Inch Inner Ducts	L.S.	L.S.	L.S.	\$ _____
680.9100	AT&T 4' x 4' Intercept Manhole	LS	L.S.	L.S.	\$ _____
680.9200	AT&T 4' x 4' Manhole	LS	L.S.	L.S.	\$ _____
680.9300	AT&T Handhole/Manhole Adjustment	3	EACH	\$ _____	\$ _____
680.9400	Demolish AT&T Ductline	L.S.	L.S.	L.S.	\$ _____
680.9500	Demolish AT&T Manhole	L.S.	L.S.	L.S.	\$ _____
695.1000	Just-In-Time-Training	L.S.	L.S.	L.S.	\$ _____
696.1000	Field Office Trailer (Not to Exceed \$50,000)	L.S.	L.S.	L.S.	\$ _____
696.3000	Maintenance of Trailers	F.A.	F.A.	F.A.	\$25,000.00

**PROPOSAL SCHEDULE**

ITEM NO.	ITEM	APPROX. QUANTITY	UNIT	UNIT PRICE	AMOUNT
699.1000	Mobilization (Not to Exceed 6% of the Sum of All Items Excluding the Bid Price of This Item).	L.S.	L.S.	L.S.	\$ _____
A. Sum of All Items					\$ _____
NOTE: Bidders must complete all unit prices and amounts. Failure to do so may be grounds for rejection of bid.					

## **PROPOSAL SCHEDULE**

**PAGE LEFT INTENTIONALLY BLANK**

## PROPOSAL SCHEDULE-QUEEN'S WEST INTERSECTION WORK

ITEM NO.	ITEM	APPROX. QUANTITY	UNIT	UNIT PRICE	AMOUNT
201.1000Q	Clearing and Grubbing	1	Acre	\$ _____	\$ _____
201.1100Q	Additional Grubbing	F.A.	F.A.	F.A.	\$1,000.00
202.3000Q	Removal of AC Pavement	3,448	S.Y.	\$ _____	\$ _____
202.3300Q	Removal of Concrete Curb and Gutter	1,009	L.F.	\$ _____	\$ _____
203.0100Q	Roadway Excavation	3,836	C.Y.	\$ _____	\$ _____
203.1000Q	Over Excavation, Moisture Conditioning and Recompaction	F.A.	F.A.	F.A.	\$20,000.00
209.0100Q	Installation, Maintenance, Monitoring, and Removal of BMP	L.S.	L.S.	L.S.	\$ _____
209.0200Q	Additional Water Pollution, Dust, and Erosion Control	F.A.	F.A.	F.A.	\$35,000.00
301.1000Q	Hot Mix Asphalt Base Course	1,198	TON	\$ _____	\$ _____
305.1000Q	Aggregate Subbase	1,230	C.Y.	\$ _____	\$ _____
316.1000Q	Polypropylene Biaxial Geogrid	2,960	S.Y.	\$ _____	\$ _____
401.1000Q	2-Inch PMA Pavement, Mix No. IV	299	TON	\$ _____	\$ _____
604.3004Q	Type 2A-9P Inlet, 10.99 Feet to 10 Feet	1	EACH	\$ _____	\$ _____

## PROPOSAL SCHEDULE-QUEEN'S WEST INTERSECTION WORK

ITEM NO.	ITEM	APPROX. QUANTITY	UNIT	UNIT PRICE	AMOUNT
604.4007Q	Type Special 2A-9P Inlet, 6.99 Feet to 6 Feet	1	EACH	\$ _____	\$ _____
614.1000Q	New Street Survey Monuments	1	EACH	\$ _____	\$ _____
616.1000Q	Temporary Irrigation System	L.S.	L.S.	L.S.	\$ _____
623.0001Q	Traffic Signal Cabinet and Foundation	1	EACH	\$ _____	\$ _____
623.0002Q	Type I (10') Traffic Signal Standard with conduit & Cabling	2	EACH	\$ _____	\$ _____
623.0003Q	Type II Traffic Signal Standard (10' Arm) with conduit & Cabling	1	EACH	\$ _____	\$ _____
623.0004Q	Type II Traffic Signal Standard (15' Arm) with conduit & Cabling	1	EACH	\$ _____	\$ _____
623.0008Q	Type II Traffic Signal Standard (30' Arm) with conduit & Cabling	1	EACH	\$ _____	\$ _____
623.0009Q	Type II Traffic Signal Standard (35' Arm) with conduit & Cabling	3	EACH	\$ _____	\$ _____
623.0013Q	Street Light Traffic Signal Standard	3	EACH	\$ _____	\$ _____
623.0014Q	Traffic Signal Assembly, All Ball, with Cabling	4	EACH	\$ _____	\$ _____
623.0015Q	Traffic Signal Assembly, Straight Arrow, with Cabling	6	EACH	\$ _____	\$ _____
623.0016Q	Traffic Signal Assembly, Left Arrow, with Cabling	5	EACH	\$ _____	\$ _____

## PROPOSAL SCHEDULE-QUEEN'S WEST INTERSECTION WORK

ITEM NO.	ITEM	APPROX. QUANTITY	UNIT	UNIT PRICE	AMOUNT
623.0017Q	Traffic Signal Assembly, Left Arrow, Programmed Visibility	6	EACH	\$ _____	\$ _____
623.0018Q	Traffic Signal Assembly, Yellow Flasher, with Cabling	2	EACH	\$ _____	\$ _____
623.0019Q	Pedestrian Signal Assembly with Cabling	8	EACH	\$ _____	\$ _____
623.0020Q	Pedestrian Pushbutton with Instruction Sign with Cabling	8	EACH	\$ _____	\$ _____
623.0020Q	Type "A" Pullbox	2	EACH	\$ _____	\$ _____
623.0022Q	Type "B" Pullbox	9	EACH	\$ _____	\$ _____
623.0023Q	Type "C" Pullbox	23	EACH	\$ _____	\$ _____
623.0024Q	Pullbox Tie-in	9	EACH	\$ _____	\$ _____
623.0025Q	Loop Detector Sensing Unit (6 Ft. x 6 Ft.) with Cabling	52	EACH	\$ _____	\$ _____
623.0026Q	EVP Optical Receiver	4	EACH	\$ _____	\$ _____
623.0027Q	EVP Optical Receiver Cabling	800	L.F.	\$ _____	\$ _____
623.0028Q	Traffic Signal Ductline 1-2"C Pvc Sch 40, Conc. Encased	750	L.F.	\$ _____	\$ _____
623.0030Q	Traffic Signal Ductline 6-2"C Pvc Sch 40, Conc. Encased	800	L.F.	\$ _____	\$ _____



## PROPOSAL SCHEDULE-QUEEN'S WEST INTERSECTION WORK

ITEM NO.	ITEM	APPROX. QUANTITY	UNIT	UNIT PRICE	AMOUNT
623.0031Q	Traffic Signal Ductline 7-2"C Pvc Sch 40, Conc. Encased	200	L.F.	\$ _____	\$ _____
623.0032Q	Traffic Signal Ductline 8-2"C Pvc Sch 40, Conc. Encased	100	L.F.	\$ _____	\$ _____
623.0033Q	Type 1 Cable - 26C#14	1,500	L.F.	\$ _____	\$ _____
623.0034Q	Type 2 Cable - 2C#14	6,000	L.F.	\$ _____	\$ _____
623.0035Q	Type 6 Cable - Electrical Service Cable	800	L.F.	\$ _____	\$ _____
623.0037Q	Service and Metering Equipment Assembly	1	EACH	\$ _____	\$ _____
623.0039Q	HECo. Service Charge for Traffic Signal Service	L.S.	L.S.	L.S.	\$ _____
629.1000Q	Profiled Thermoplastic Striping	865	L.F.	\$ _____	\$ _____
629.1100Q	4-Inch Pavement Striping (Thermoplastic)	2,720	L.F.	\$ _____	\$ _____
629.1200Q	6-Inch Pavement Striping (Thermoplastic)	26	L.F.	\$ _____	\$ _____
629.1300Q	8-Inch Pavement Striping (Thermoplastic)	40	L.F.	\$ _____	\$ _____
629.1400Q	12-Inch Pavement Striping (Thermoplastic)	120	L.F.	\$ _____	\$ _____
629.2000Q	Crosswalk Marking (Thermoplastic)	7	LANE	\$ _____	\$ _____

## PROPOSAL SCHEDULE-QUEEN'S WEST INTERSECTION WORK

ITEM NO.	ITEM	APPROX. QUANTITY	UNIT	UNIT PRICE	AMOUNT
629.3000Q	Pavement Arrow (Thermoplastic)	22	EACH	\$ _____	\$ _____
629.3100Q	Pavement Symbol (Thermoplastic)	8	EACH	\$ _____	\$ _____
629.4000Q	Pavement Word (Thermoplastic)	3	EACH	\$ _____	\$ _____
629.5100Q	Type "C" Pavement Marker	20	EACH	\$ _____	\$ _____
629.5200Q	Type "D" Pavement Marker	10	EACH	\$ _____	\$ _____
629.5300Q	Type "H" Pavement Marker	8	EACH	\$ _____	\$ _____
629.6000Q	Temporary Construction Zone Markings	F.A.	F.A.	F.A.	\$15,000.00
631.1000Q	Regulatory Sign (10 Square Feet or Less)	5	EACH	\$ _____	\$ _____
634.1000Q	Portland Cement Concrete Sidewalk	408	S.Y.	\$ _____	\$ _____
638.1000Q	Curb, Type 2D	643	L.F.	\$ _____	\$ _____
638.2000Q	Curb and Gutter, Type 2DG	282	L.F.	\$ _____	\$ _____
645.1000Q	Traffic Control	L.S.	L.S.	L.S.	\$ _____
645.2000Q	Additional Police Officers, Additional Traffic Control Devices, and Advertisements	F.A.	F.A.	F.A.	\$75,000.00

## PROPOSAL SCHEDULE-QUEEN'S WEST INTERSECTION WORK

ITEM NO.	ITEM	APPROX. QUANTITY	UNIT	UNIT PRICE	AMOUNT
650.1100Q	Curb Ramp, Type A	3	EACH	\$ _____	\$ _____
650.1200Q	Curb Ramp, Type B	1	EACH	\$ _____	\$ _____
650.1300Q	Curb Ramp, Type C	3	EACH	\$ _____	\$ _____
696.1000Q	Field Office Trailer (Not to Exceed \$50,000)	L.S.	L.S.	L.S.	\$ _____
696.2000Q	Project Site Laboratory Trailer (Not to Exceed \$50,000)	L.S.	L.S.	L.S.	\$ _____
696.3000Q	Maintenance of Trailers	F.A.	F.A.	F.A.	\$10,000.00
699.1000Q	Mobilization (Not to Exceed 6% of the Sum of All Items Excluding the Bid Price of This Item).	L.S.	L.S.	L.S.	\$ _____
B. Sum of All Items (Queen's West Intersection Work)				\$ _____	
C. Sum of Item A on P-38				\$ _____	
Sum of Item B on P-45				\$ _____	
Total of Item A and Item B				\$ _____	
NOTE:	Bidders must complete all unit prices and amounts. Failure to do so may be grounds for rejection of bid.				

1 **PROPOSAL SCHEDULE**

2  
3 The bidder is directed to Subsection 105.16 – Subcontracts.  
4

5 The bidder's attention is directed to Sections 696 - Field Office and Project  
6 Site Laboratory and 699 - Mobilization for the limitation of the amount bidders are  
7 allowed to bid.  
8

9 If the bid price for any proposal item having a maximum allowable bid  
10 indicated therefore in any of the contract documents is in excess of such a  
11 maximum amount, the bid price for such proposal item shall be adjusted to reflect  
12 the limitation thereon. The comparison of bids to determine the successful  
13 bidder and the amount of contract to be awarded shall be determined after such  
14 adjustments are made, and such adjustments shall be binding upon the bidder.  
15  
16  
## Project Bench Mark

The project bench mark is referenced to the City traverse station "Street Monument A" located in the vicinity of Farrington Highway, near the intersection of Kapolei Golf Course Road. The elevation of "Street Monument A" is 112.95-feet mean sea level (msl). Benchmark provided by ControlPoint Surveying Inc.

## Notes for Construction (City and County of Honolulu)

- All applicable construction work shall be done in accordance with the Standard Specifications for Public Works Construction, September 1986 and Standard Details for Public Works Construction, September 1984, as amended, of the Department of Public Works, City and County of Honolulu and the counties of Kauai, Maui, and Hawaii.
- The underground pipes, cables or ductlines known to exist by the Engineer from his search of records are indicated on the plans. The contractor shall verify the locations and depths of the facilities and exercise proper care in excavating in the area. Wherever connections of new utilities to existing utilities are shown on the plans, the contractor shall expose the existing lines at the proposed connections to verify their locations and depths prior to excavation for the new lines.
- No contractor shall perform any construction operation so as to cause falling rocks, soil or debris in any form to fall, slide or flow into existing City drainage systems, or adjoining properties, streets or natural watercourses. should such violations occur, the contractor may be cited and the contractor shall immediately make all remedial actions necessary.
- The general contractor/developer/owner of the project shall be responsible for conformance with applicable provisions of the Hawaii Administrative Rules, Title 11, Chapter 54, "Water Quality Standards," and Title 11, Chapter 55, "Water Pollution Control," as well as Chapter 14 of the Revised Ordinances of Honolulu, as amended. Best management practices shall be employed at all times during construction.

The general contractor/developer/owner of the project shall obtain National Pollutant Discharge Elimination System (NPDES) permit coverage(s) for the following:

- Storm water discharges associated with construction activities that disturb one (1) acre or more, and
- Discharges of hydrotesting effluent, dewatering effluent, and well drilling effluent to State waters.

In accordance with State law, all discharges related to project construction or operations are required to comply with State Water Quality Standards (Hawaii Administrative Rules, Chapter 11-54). Best management practices shall be used to minimize or prevent the discharge of sediment, debris, and other pollutants to state waters. Permit coverage is available from the Department of Health, Clean Water Branch at <http://health.hawaii.gov/cwb>. The owner/developer/contractor is responsible for obtaining other federal, state, or local authorizations as required by law.

- For non-City projects, the contractor shall notify the Civil Engineering Branch, D.P.P. at 768-8084 to arrange for inspectional services and submit two (2) sets of approved construction plans seven (7) days prior to commencement of construction work. For city projects, the contractor shall coordinate inspectional services with the responsible city agency.

## Notes for Construction (City and County of Honolulu) Cont.

- The contractor may submit a substitution request to precast any City owned and/or maintained drainage structure (ex., catch basins, drain manholes, drain inlets, culverts, etc.) However, prior to construction and installation of any precast structure, the contractor shall a) submit six (6) sets of shop drawings to the Civil Engineering Branch, Department of Planning and Permitting and obtain written approval and b) notify the Civil Engineering Branch, Department of Planning and Permitting at 768-8084 to arrange for inspectional services. non-compliance with any of these requirements shall mean immediate suspension of all precast construction work and rejection of all precast structures already constructed.



- Confined space

For entry by City personnel, including inspectors, into a permit required confined space as defined in 29 CFR part 1910.146(b), the contractor shall be responsible for providing:

- All safety equipment required by the confined space regulations applicable to all parties other than the construction industry, to include, but not limited to, the following:
  - full body harnesses for up to two personnel.
  - lifeline and associated clips.
  - ingress/egress and fall protection equipment.
  - two-way radios (walkie-talkies) if out of line-of-sight.
  - emergency (escape) respirator (10 minute duration).
  - cellular telephone to call for emergency assistance.
  - continuous gas detector (calibrated) to measure oxygen, hydrogen, sulfide, carbon monoxide and flammables (capable of monitoring at a distance of at least 20-feet away).
  - personal multi-gas detector to be carried by inspector.
- Continuous forced air ventilation adequate to provide safe entry conditions.
- One attendant/rescue personnel topside (two, if conditions warrant it).

- Pursuant to Chapter 6E, HRS, in the event any artifacts or human remains are uncovered during construction operations, the contractor shall immediately suspend work and notify the Honolulu Police Department, the State Department of Land and Natural Resources-Historic Preservation Division (692-8015). In addition, for non-City projects, the contractor shall inform the Civil Engineering Branch, Department of Planning and Permitting (768-8084); and for City projects, notify the responsible City agency.
- For projects abutting State Highways' rights-of-way, the owner or his authorized representative shall notify the State Department of Transportation, Highways Division, Oahu District, Drainage Discharge Unit at 831-6793 for an assessment of State Highways permit requirements.



- For bench mark, see sheet C-23.

FED. ROAD DIST. NO.	STATE	PROJ. NO.	FISCAL YEAR	SHEET NO.	TOTAL SHEETS
HAWAII	HAW.	7101A-01-20	2021	6	767

ORIGINAL PLAN	DATE
NO. _____	_____
SURVEY PLOTTED BY _____	DATE _____
DRAWN BY _____	DATE _____
TRACED BY _____	DATE _____
QUANTITIES BY _____	DATE _____
CHECKED BY _____	DATE _____



THIS WORK WAS PREPARED BY ME OR UNDER MY SUPERVISION AND CONSTRUCTION OF THIS PROJECT WILL BE UNDER MY OBSERVATION.

Signature: *Craig W. Luke*  
 EXPIRATION DATE OF THE LICENSE: April 30, 2024

DATE	REVISION
07/15/22	Rev. notes.
06/08/22	Deleted note, revised note

STATE OF HAWAII  
 DEPARTMENT OF TRANSPORTATION  
 HIGHWAYS DIVISION

### Construction Notes - 4

FARRINGTON HIGHWAY WIDENING  
 Kapolei Golf Course Road to Fort Weaver Road  
 Project No. 7101A-01-20

Scale: As Shown Date: April 2022

FILE: K:\civil\23146 Farrington Hwy Widening\Draw\Construction\Draw\23146-C-5 Construction Notes - 4.dwg saved July 8, 2022



### Environmental Control Notes For Grading

- In accordance with Chapter 11-60.1, AIR POLLUTION CONTROL, Title 11, Hawaii Administrative Rules, the Property Owner/Developer shall be responsible for ensuring that effective control measures are provided to minimize or prevent any visible dust emission caused by the construction work from impacting the surrounding areas; including the off-site roadways used to enter/exit the project. These measures include but are not limited to the use of water wagons, sprinkler systems, dust fences, etc.
- In accordance with Chapter 11-55, WATER POLLUTION CONTROL and Chapter 11-54, WATER QUALITY STANDARDS, Title 11, Hawaii Administrative Rules, the Property Owner/Developer shall be responsible for ensuring that the Best Management Practice (BMP) to minimize or prevent the discharge of sediments, debris and other water pollutant into State waters are provided at all times.
- In accordance with Chapter 11-56, SOLID WASTE MANAGEMENT CONTROL, Title 11, Hawaii Administrative Rules, the Property Owner/Developer shall be responsible for ensuring that grub material, demolition waste and construction waste generated by the project are disposed of in a manner or at a site approved by the State Department of Health. Disposal of any of these wastes by burning or burying is prohibited.
- The Contractor shall be responsible for compliance with all applicable permits from the Department of Health including but not limited to (NPDES), Notice of Intent and General Permit for storm water, hydrostatic test and dewatering discharges.
- The Contractor shall remove daily all silt and debris resulting from this work and deposited in drainage facilities, roadways and other areas. The cost incurred for any necessary remedial action by the Engineer shall be payable by the Contractor.
- Best Management Practices (BMP's) shall be employed at all times to the maximum extent practicable to prevent damage by sedimentation, erosion or dust to streams, watercourses, natural areas and the property of others.
- In accordance with Chapter 11-46, COMMUNITY NOISE, Hawaii Administrative Rules, the Contractor and the Property Owner/Developer shall be responsible for providing effective control measures to minimize or prevent construction related noise from impacting the residents in the immediate area. If required, noise reduction measures shall be implemented by the Contractor during the construction work.
- The property may harbor rodents which will be dispersed to the surrounding areas when the site is cleared. In accordance with Chapter 11-26, VECTOR CONTROL, Title 11, HAR, the applicant shall ascertain the presence or absence of rodents on the property. Should the presence of rodents be determined, the applicant shall eradicate the rodents prior to clearing the site.
- A copy of the plans, construction schedule and/or written measures that is required to be submitted by the Contractor (Dust Control Measures/Plans) should also be sent to the Department of Health for monitoring purposes.

### Notes for Grading (City and County of Honolulu)

- All grading work shall be done in accordance with Chapter 14, Articles 13, 14, 15 and 16, as related to grading, soil erosion and sediment control of the Revised Ordinances of Honolulu, 1990, as amended, and soil reports by Geolabs Inc., entitled "Geotechnical Engineering Exploration-Farrington Highway Improvements-Kapolei Golf Course to Fort Weaver Road-Ewa, Oahu, Hawaii" dated August 4, 2021.
- No Contractor shall perform any grading operation so as to cause falling rocks, soil or debris in any form to fall, slide or flow onto adjoining properties, streets or natural watercourses. should such violations occur, the contractor may be cited and the contractor shall immediately make all remedial actions necessary.
- The contractor, at his own expense, shall keep the project area and surrounding area free from dust nuisance. The work shall be in conformance with the Air Pollution Control Standards contained in the Hawaii Administrative Rules, Title 11, Chapter 60.1, "Air Pollution Control."
- The underground pipes, cables or ductlines known to exist by the Engineer from his search of records are indicated on the plans. The contractor shall verify the locations and depths of the facilities and exercise proper care in excavating in the area. wherever connections of new utilities to existing utilities are shown on the plans, the contractor shall expose the existing lines at the proposed connections to verify their locations and depths prior to excavation for the new lines.
- Adequate provisions shall be made to prevent surface waters from damaging the cut face of an excavation or the sloped surfaces of a fill. furthermore, adequate provisions shall be made to prevent sediment-laden run off from leaving the site.
- All slopes and exposed areas shall be sodded, planted, or sprayed with soil sement chemical stabilizer as soon as final grades have been established. planting shall not be delayed until all grading work has been completed. grading to final grade shall be continuous, and any area, within which work has been interrupted or delayed, shall be planted.
- Fills on slopes steeper than 5H:1V shall be keyed.
- The City shall be informed of the location of the borrow/disposal site for the project when the application for a grading permit is made. The borrow/disposal site must also fulfill the requirements of the Grading Ordinance.
- No grading work shall be done on Saturdays, Sundays and Holidays at any time without prior notice to the Director, D.P.P., provided such grading work is also in conformance with the Community Noise Control Standards contained in the Hawaii Administrative Rules, Title 11, Chapter 46, "Community Noise Control".
- The limits of the area to be graded shall be flagged before the commencement of the grading work.
- The general contractor/developer/owner of the project shall be responsible for conformance with applicable provisions of the Hawaii Administrative Rules, Title 11, Chapter 54, "Water Quality Standards," and Title 11, Chapter 55, "Water Pollution Control," as well as Chapter 14 of the Revised Ordinances of Honolulu, as amended. best management practices shall be employed at all times during construction. The general contractor/developer/owner of the project shall obtain National Pollutant Discharge Elimination System (NPDES) permit coverage(s) for the following:
  - Storm water discharges associated with construction activities that disturb one (1) acre or more, and
  - Discharges of hydrotesting effluent, dewatering effluent, and well drilling effluent to State waters.


In accordance with State law, all discharges related to project construction or operations are required to comply with State Water Quality Standards (Hawaii Administrative Rules, Chapter 11-54). best management practices shall be used to minimize or prevent the discharge of sediment, debris, and other pollutants to state waters. permit coverage is available from the department of health, clean water branch at <http://health.hawaii.gov/cwb>. The owner/developer/contractor is responsible for obtaining other federal, state, or local authorizations as required by law.

FED. ROAD DIST. NO.	STATE	PROJ. NO.	FISCAL YEAR	SHEET NO.	TOTAL SHEETS
HAWAII	HAW.	7101A-01-20	2021	7	767

### Notes for Grading (Continued)

- Where applicable and feasible the measures to control erosion and other pollutants shall be in place before any earth moving phase of the grading is initiated.
- Temporary erosion controls shall not be removed before permanent erosion controls are in-place and established.
- Temporary erosion control procedures shall be submitted for approval prior to application for grading permit.
- If the grading work involves contaminated soil, then all grading work shall be done in conformance with applicable State and Federal requirements.
- For non-City projects, the contractor shall notify the Civil Engineering Branch, D.P.P. at 768-8084 to arrange for inspectional services and submit two (2) sets of approved construction plans seven (7) days prior to commencement of construction work. For City projects, the contractor shall coordinate inspectional services with the responsible City agency.
- Pursuant to Chapter 6e, HRS, in the event any artifacts or human remains are uncovered during construction operations, the contractor shall immediately suspend work and notify the Honolulu Police Department, the State Department of Land and Natural Resources-Historic Preservation Division (692-8015). In addition, for non-City projects, the contractor shall inform the Civil Engineering Branch, Department of Planning and Permitting (768-8084); and for City projects, notify the responsible City agency.
- For all projects, which will disturb one (1) acre or more of land, the contractor shall not start construction until a Notice of General Permit Coverage (NGPC) is received from the Department of Health, State of Hawaii, and has satisfied any other applicable requirements of the NPDES permit program. Also, for non-City and other non-governmental agency projects, the contractor shall provide a written copy of the NGPC to the permitting and inspection section, Civil Engineering Branch, D.P.P., at least seven (7) calendar days before the start of construction. for city or other governmental projects, the contractor should provide a written copy of the ngpc to the appropriate city department or governmental agency per their requirements.
- All grading and construction work shall implement measures to ensure that the discharge of pollutants from the construction site will be reduced to the maximum extent practicable and will not cause or contribute to an exceedance of water quality standards.
- Non-compliance to any of the above requirements shall mean immediate suspension of all work, and remedial work should commence immediately. all costs incurred shall be billed to the violator. furthermore, violators shall be subjected to administrative, civil and/or criminal penalties.
- For bench mark, see sheet C-23.

SURVEY PLOTTED BY	DATE
DRAWN BY	
TRACED BY	
QUANTITIES BY	
CHECKED BY	
ORIGINAL PLAN	
NOTE BOOK	
No.	

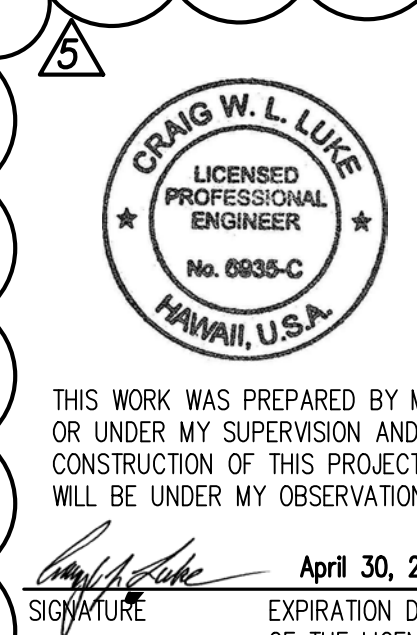

THIS WORK WAS PREPARED BY ME OR UNDER MY SUPERVISION AND CONSTRUCTION OF THIS PROJECT WILL BE UNDER MY OBSERVATION.  
 SIGNATURE: *Craig W. Luke* EXPIRATION DATE OF THE LICENSE: April 30, 2024

07/15/22 Rev. notes.

STATE OF HAWAII  
 DEPARTMENT OF TRANSPORTATION  
 HIGHWAYS DIVISION

**Construction Notes - 5**

FARRINGTON HIGHWAY WIDENING  
 Kapolei Golf Course Road to Fort Weaver Road  
 Project No. 7101A-01-20

Scale: As Shown Date: April 2022

FILE: K:\civil\23146 Farrington Hwy Widening\Draw\Construction\Draw\23146 Construction Notes - 5.dwg saved July 8, 2022



Water Notes (Board of Water Supply)

1. Unless otherwise specified, all materials and construction of water system facilities and appurtenances shall be in accordance with the STANDARD SPECIFICATIONS FOR ROAD AND BRIDGE CONSTRUCTION, dated 2005, as amended, of the Hawaii Highways Division, Department of Transportation, and the City and County of Honolulu Board of Water Supply's "WATER SYSTEM STANDARDS", DATED 2002, THE "WATER SYSTEM EXTERNAL CORROSION CONTROL STANDARDS", VOLUME 3, DATED 2021, and all subsequent amendment and additions.
2. No deviation to the Board of Water Supply 2002 Water System Standards shall be allowed without the manager and Chief Engineer's approval.
3. All ductile iron pipe and fittings, including sections requiring reinforced concrete jacketing shall be ductile iron pipe class 53, with a bonded dielectric coating per the Board of Water Supply 2002 System Standards as amended.
4. Test pressure shall be 200 psi. During the 30-minute pressure test, the pressure shall not drop more than 10 psi.
5. The Contractor shall notify Board of Water Supply Capital Projects Division, Construction Section in writing or call (808) 748-5730, and submit six (6) sets of 24" x 36" approved construction drawings, one week prior to commencing construction activities.
6. The contractor shall chlorinate the entire inside surface of each pipe and fitting with disinfection solution of 5 ounces of sodium hypochlorite (5% chlorine bleach) mixed with 10 gallons of water. (For connection only).
7. The contractor shall be responsible for the protection of all water lines during construction. The contractor shall be especially careful when excavating behind water lines, tees, and bends wherever there is a possibility of water line movement due to the removal of the supporting earth beyond the existing reaction blocks. The contractor shall take whatever measures necessary to protect the water lines, such as constructing special reaction blocks (with BWS approval) and/or modifying his construction method.
8. The existence and location of underground utilities and structures as shown on the plans are from the latest available data but is not guaranteed as to the accuracy or the encountering of other obstacles during the course of the work. The contractor shall be responsible and shall pay for all damages to existing utilities. The contractor shall not assume that where no utilities are shown, that none exist.
9. Prior to installation, the contractor shall submit for approval by Board of Water Supply, the manufacturer's certification that all cast iron (gray or ductile) fittings for the project conform in all respects to the Water System Standards, dated 2002.
10. Polygon shape for mechanical joint glands as described in AWWA Standard C111 shall be "straight-sided" or an approved equal on a job to job basis.
11. Re-approval shall be required if this project is not under construction within a period of two (2) years.
12. Contractor shall cut and plug all existing unused laterals at the main whether or not shown on the plans. The damaged area shall be repaired to an equal or better condition than the immediate area. All work shall be done at the expense of the contractor.

6. The contractor shall chlorinate the entire inside surface of each pipe and fitting with disinfection solution of 5 ounces of sodium hypochlorite (5% chlorine bleach) mixed with 10 gallons of water. (For connection only).

Water Notes (Board of Water Supply) (Continued)

13. The contractor/developer shall obtain a NPDES permit prior to chlorination and/or dewatering. A copy of the permit shall be submitted to the Board of Water Supply, Capital Projects Division, Construction Section.
14. Soil resistivity for the site has a corrosion rating of Moderately to Severely Corrosive as reported by Geolabs, Inc. in their report entitled "Geotechnical Engineering Exploration, Farrington Highway Improvements, Kapolei Golf Course Road to Fort Weaver Road, Ewa, Oahu, Hawaii, Dated August 4, 2021. All required electrical isolation procedures and corrosion control requirements shall apply.
15. Pipe cushion shall be of high resistivity material. The contractor shall submit a soil certification that high resistant cushion material has a resistivity greater than 5,000 ohm-cm. Remainder of the backfill material shall be as specified in volume 1 of the Water System Standards. Pipe cushion and backfill material shall contain no hazardous substances above regulatory action levels including but not limited to lead, asbestos, mercury, chromium, cadmium, zinc, strontium, and polychlorinated biphenyls (PCB).
16. Upon completion of the project, the developer shall provide the BWS with a certificate from a registered soils engineer certifying that the road prism has been constructed in accordance to City and County road standards.
17. Two-way blue reflective hydrant markers type DB shall be installed at all new fire hydrant installations. Contractor shall verify the exact locations of hydrant markers with the nearest Honolulu Fire Department battalion chief.
18. Cleaning shall be by the use of "pigs" introduced into the pipeline and run completely through all installed pipelines and all branch lines for fire hydrants. "Pigging" of service laterals is not required. Bare foam "pigs" shall be used to swab piping clean as each length of the pipeline is installed. The type, density, size, diameter and length of the pig shall be submitted for review and approval by the Manager prior to pigging work. "Pig" shall be used per manufacturer's specifications. Prior to use, the "pig" shall be submerged in a chlorine solution of 1 oz. of 5% chlorine bleach in 5 gallons of water. "Pigging" of the pipeline shall be considered incidental to the installation of the new pipeline. Manual sweeping, hand cleaning or swabbing may be allowed in lieu of "pigging" as approved by the Board of Water Supply Manager.
19. The contractor shall install electronic markers to all mains and test the electronic markers prior to installations to verify proper operation. BWS personnel shall verify the number and locations of placed electronic markers before final paving of the project.
20. The Board of Water Supply will not send a completion notice to the Department of Planning and Permitting until easement documents are submitted to the Board of Water Supply and recorded.
21. Prior to any excavating, the Contractor shall verify in the field, the location of existing waterlines and appurtenances.
22. Any adjustments to the existing water system required during construction, to meet the requirements of the BWS Standards, whether shown on the plans or not, shall be done by the Contractor at no cost to the Board of Water Supply.
23. After installation of tapping sleeve and tapping valve and prior to tapping the existing water main, the assembly shall be pressure tested at 200 psi on both sides of the valve and in accordance with the Water System Standards, dated 2002.

Water Notes (Board of Water Supply) (Continued)

24. Maintain 3'-0" minimum cover for all existing waterlines from new finish grade. The contractor shall probe the waterline and service laterals and submit the probing data to BWS Capital Projects Division, Construction Section.
25. The contractor shall furnish and install an insulating corporation stop and petrolatum wax tape at all taps (for DI pipe and copper lateral combination only).
26. All ductile iron pipe fittings and valves shall be coated with a bonded dielectric coating and wrapped with petrolatum wax tape.
27. At the electrical/cable/signal ductline and water crossings, adjust all electrical/cable/signal ductline elevations to maintain the required vertical clear separation from all water mains. Conformance to the Board of Water Supply 2002 Water System Standards as amended shall be at no cost and adhered to.
28. Maintain the required minimum horizontal clear separation between electrical/cable/signal appurtenances, (including any modular units) and the nearest water mains or water appurtenance. Contractor shall field verify for any conflicts at each electrical/cable/signal appurtenance location. Where conflicts occur, the contractor shall coordinate with the project engineer to revise the electrical/cable/signal appurtenance to provide the required clearances. Conformance to the Board of Water Supply, Water System Standards, dated 2002, as amended, shall be at no cost and adhered to.
29. All plans approved by the Board of Water Supply are based solely on the adequacy of the water supply.
30. Maintain the required minimum horizontal clear separation between all water mains, and the nearest electrical/cable/signal ductlines paralleling the water system. Conformance to the Board of Water Supply 2002 Water System as amended shall be at no cost and adhered to.

FED. ROAD DIST. NO.	STATE	PROJ. NO.	FISCAL YEAR	SHEET NO.	TOTAL SHEETS
HAWAII	HAW.	7101A-01-20	2021	13	767

SURVEY PLOTTED BY: _____	DATE: _____
DRAWN BY: _____	DATE: _____
TRACED BY: _____	DATE: _____
DESIGNED BY: _____	DATE: _____
CHECKED BY: _____	DATE: _____
ORIGINAL PLAN NO. _____	
NOTE BOOK NO. _____	

APPROVED: \_\_\_\_\_ DATE \_\_\_\_\_  
 Manager and Chief Engineer, BWS  
 (for work affecting BWS facilities in City/State R/W & BWS easements only)

07/15/22	Revised notes
06/08/22	Note Added
DATE	REVISION



THIS WORK WAS PREPARED BY ME OR UNDER MY SUPERVISION AND CONSTRUCTION OF THIS PROJECT WILL BE UNDER MY OBSERVATION.  
 Signature: \_\_\_\_\_ April 30, 2024  
 EXPIRATION DATE OF THE LICENSE

STATE OF HAWAII  
 DEPARTMENT OF TRANSPORTATION  
 HIGHWAYS DIVISION

**Construction Notes - 11**

FARRINGTON HIGHWAY WIDENING  
 Kapolei Golf Course Road to Fort Weaver Road  
 Project No. 7101A-01-20

Scale: As Shown Date: April 2022

FILE: K:\civil\23146 Farrington Hwy Widening\Draw\Construction\Draws\C-12 Construction Notes - 11.dwg saved July 6, 2022



FED. ROAD DIST. NO.	STATE	PROJ. NO.	FISCAL YEAR	SHEET NO.	TOTAL SHEETS
HAWAII	HAW.	7101A-01-20	2021	14	767

### Water Notes (Board of Water Supply) (Continued)

30. Install 4 mil thick, non-metallic, blue colored, 6 inches wide warning tape over centerline of the pipe and below the base course along the entire length of trench. Tape should be marked with "caution water line buried below".
31. Board of Water Supply approval of these plans does not constitute a water commitment. Availability of water will be determined when building permit is presented to the department. Water commitment will depend upon the status of the water system at that time. Should water service be made available, the water commitment will be effective when the project receives an approved building permit from the building department. All water commitments will be canceled in the event the building permit is canceled.
32. When a utility (gas, sewer, electrical duct line, fiber optic, drainage, etc.) crosses below a Board of Water Supply water main, the designer of record and their construction engineer shall be responsible for determining the adequate water main structural support and submit the construction method and shop drawing, stamped by a licensed engineer and reviewed and accepted by the designer of record, to the Board of Water Supply for review and approval. All work shall be at no cost to the Board of Water Supply.
33. At utility crossings where proper compaction under a water main is difficult to achieve, CLSM shall be installed in place of backfill material and pipe cushion material. CLSM mixture to be furnished shall be in accordance with Division 200 - Materials, Section 209.06 Controlled Low Strength Material (CLSM) of the Water System Standards, as amended.

### Chlorination and Hydrotesting Effluent Note

1. The contractor shall only use dechlorinated hydrotesting effluent for dust control, irrigation and/or other purposes that do not involve discharges to waters of the State of Hawaii.

### Trenchless Installation Work

1. For trenchless utility work (micro-tunneling, directional drilling, pipe ramming/jacking of new utilities such as electrical duct lines, sewer lines or drain lines) crossing or paralleling existing waterlines, provide the required minimum horizontal and vertical clearance to existing waterlines. No deviation shall be allowed without the Manager and Chief Engineer's approval. The utility owner or contractor shall make adjustments to meet the minimum clearances should the utility line be installed closer to the existing waterlines, at no cost to the Board of Water Supply. The contractor shall submit as-built plans of the new utility lines after inspection of the project.

### Waterline Chlorination and Testing Procedures

1. The contractor shall follow the following revised chlorination and water sampling procedures:

The following chlorination and water sample collection procedure shall apply to all water pipeline projects (all work to be coordinated through BWS inspector):

#### Chlorination of Water Systems

- A. The contractor shall provide a 4-week advance notice, in writing, to the Officer-In-Charge for proposed flushing, filling and bacterial testing of the new pipeline.

5

### Waterline Chlorination and Testing Procedures (Continued)

- B. The Contractor shall hire a State of Hawaii - Department of Health certified laboratory to provide water sampling services and to deliver water samples to the Micro Lab for analysis. Water samples for bacterial testing shall be delivered no later than 2:30 p.m. on the day the samples are taken to the Board of Water Supply Micro Lab located at 630 S. Beretania St., Honolulu, HI 96843. The Micro Lab shall perform analysis and provide their results to the Officer-In-Charge by 4:30 p.m. on the following day (in some cases, final results notification may take up to 48 hours).
- C. Water mains shall be disinfected in accordance with the Board of Water Supply Water System Standards (2002), as amended, Section 302.29.

#### Step 1 - Preliminary Flushing (Prior to Chlorination):

The mains shall be flushed with maximum available pressure and velocity. Adequacy of turnovers shall be determined by the absence of particles. Turbidity shall be less than 1.0 NTU before chlorination. During all flushing operations, the Manager or the Manager's authorized representative shall determine the rate of water use.

#### Step 2 - Chlorination:

The Contractor shall submit to the Manager, for approval, a sketch showing locations of sampling points and a plan or schedule delineating the method or steps the Contractor proposes to use to accomplish the work. The following methods for chlorination shall be used:

1. The following chlorination and water sample collection procedure shall apply to all water pipeline projects:
  - a. Step 1: Chlorinate main by filling with water and introducing chlorine in sufficient quantity to obtain a minimum chlorine concentration of 50 parts per million. Leave chlorinated water in main overnight.
  - b. Step 2: Flush main with fresh water until all chlorine has been flushed out as evidenced by the N, N-diethyl-p-phenylenediamine (DPD) test, then collect a water sample while continuing to flush the main.
  - c. Step 3: Repeat Steps 1 and 2. After collecting the second water sample, stop flushing and allow the water to stand in the main overnight.
  - d. Step 4: Thoroughly flush the main with fresh water until all water that had been standing in the main overnight has been flushed out. Stop flushing and let the water stand in the main for one hour. Collect a water sample.
2. The main is deemed acceptable and certified when (I) the three consecutive water samples, collected 24 hours apart under Steps 1 and 2, show no TC (Total Coliform bacteria), no E. Coli, less than 200 CFU/ml (Colony Forming Units per ml) of HPC (Heterotrophic Plate Count bacteria) or less than 202 HPC using the MPN (Most Probable Number) method and Turbidity <1.0 NTU and (II) the sample of water held in the main for one hour, collected under Step 4, also shows no TC, no E. coli, less than 200 CFU/ml of HPC or less than 202 HPC using the MPN method and Turbidity <1.0 NTU.

### Waterline Chlorination and Testing Procedures (Continued)

3. Chlorination, flushing, sampling and testing will be extended should unsatisfactory results be encountered. Any sample that shows positive TC, E. coli, HPC>200 CFU/ml, HPC>202 MPN or Turbidity > 1.0 NTU is unsatisfactory.
4. Steps 1 and 2 may be repeated before collecting the one hour hold sample specified in Step 4. Repeating Steps 1 and 2 is recommended in the event samples show the presence of TC and/or E. coli and/or increasing total bacterial results from one sample to the next.
5. Water samples that show the presence of atypical results, debris, high turbidity or results inconsistent with existing water are subject to reconfirmation. The Manager reserves the right to request and test additional water samples in the interest of safeguarding public health and safety at no additional cost to the Department.
6. Liquid chlorine, chlorine based liquid disinfectants or calcium hypochlorite that has been tested and certified as meeting the specifications of the ANSI/NSF Standard 60, Drinking Water Treatment Chemicals - Health Effects, shall be used for the chlorination of the water mains.

APPROVED: \_\_\_\_\_ DATE \_\_\_\_\_  
 Manager and Chief Engineer, BWS  
 (for work affecting BWS facilities in  
 City/State R/W & BWS easements only)

DATE	REVISION
07/15/22	Notes Revised
06/08/22	Numbering Revised



THIS WORK WAS PREPARED BY ME OR UNDER MY SUPERVISION AND CONSTRUCTION OF THIS PROJECT WILL BE UNDER MY OBSERVATION.  
 SIGNATURE: \_\_\_\_\_ EXPIRATION DATE OF THE LICENSE: April 30, 2024

STATE OF HAWAII  
 DEPARTMENT OF TRANSPORTATION  
 HIGHWAYS DIVISION

## Construction Notes - 12

FARRINGTON HIGHWAY WIDENING  
 Kapolei Golf Course Road to Fort Weaver Road  
 Project No. 7101A-01-20

Scale: As Shown Date: April 2022

DATE	_____
SURVEY PLOTTED BY	_____
DRAWN BY	_____
TRACED BY	_____
DESIGNED BY	_____
CHECKED BY	_____
ORIGINAL PLAN	_____
NOTE BOOK	_____
No.	_____

FILE: K:\civil\23146 Farrington Hwy Widening\Draw\Construction\Draw\13 Construction Notes - 12.dwg saved June 30, 2022



## Water Meter Installations (For Meters 3-In. and Larger) (Continued)

13. The Contractor shall chlorinate the entire inside surface of each pipe and fitting with disinfection solution of 5 ounces of sodium hypochlorite (5% chlorine bleach) mixed with 10 gallons of water. (For connection only).
14. All ductile iron pipe, fittings, and valves shall be coated with a bonded dielectric coating and wrapped with petrolatum wax tape.
15. All ductile iron pipe and fittings, including sections requiring reinforced concrete jacketing, shall be ductile iron Class 53, and bonded dielectric coated as per the Board of Water Supply 2002 Water System Standards, as amended.
16. The project shall pay the applicable water system facilities and/or one-time service charge and for the meter which will be furnished by Board of Water Supply and installed by the Contractor when the lateral is installed.
17. Contractor shall cut and plug and remove all existing unused laterals at the main whether or not shown on the plans. Meter and valve boxes to be or already abandoned shall be demolished or removed and properly disposed of. The damaged area shall be repaired to an equal or better condition than the immediate area. All work shall be done at the expense of the Contractor.
18. After installation of tapping sleeve and tapping valve and prior to tapping the existing water main, the assembly shall be pressure tested at 200 psi on both sides of the valve and in accordance with the WATER SYSTEM STANDARDS, dated 2002.
19. For meters 3 inches and larger (Compound, F.M., and Detector Check), Contractor shall notify Customer Care Division – Service Engineering Section in writing after the plan is approved, no later than 120 days, prior to withdrawing meter from Board of Water Supply storeyard. Such notice shall indicate number, size, and type of meter (Compound, F.M., or Detector Check) and approximate month and year meter is anticipated to be drawn out. If the approved plan is allowed to lapse, the 120-day notice will be voided.
20. Board of Water Supply approval of these plans does not constitute a water commitment. Availability of water will be determined when building permit is presented to the Department. Water commitment will depend upon the status of the water system at that time. Should water service be made available, the water commitment will be effective when the project receives an approved building permit from the Building Department. All water commitments will be canceled in the event the building permit is canceled.
21. The project shall be subject to the Board of Water Supply's Cross-Connection Control requirements prior to issuance of the Building Permit.
22. Easement documents must be submitted to Board of Water Supply and recorded before meter is issued.
23. The installation, chlorination, and testing of the water main and facilities after the property line shall not be the responsibility of the Board of Water Supply.
24. Prior to installation, the Contractor shall submit for approval by the Board of Water Supply, the manufacturer's certification that all cast iron (gray or ductile) fittings for the project conform in all respects to the Board of Water Supply Water System Standards, dated 2002 and addendums.
25. Polygon shape for mechanical joint glands as described in AWWA Standard C111 shall be "straight-sided" or an approved equal on a job-to-job basis.
26. The backflow preventer device must be installed before meter is issued.
27. Pipe cushion shall be of high resistivity material. The Contractor shall submit a soil certification that high resistant cushion material has a resistivity greater than 5,000 OHM-CM. Remainder of the backfill material shall be as specified in the Water System Standards. Pipe cushion and backfill material shall contain no hazardous substances above regulatory action levels including but not limited to lead, asbestos, mercury, chromium, cadmium, zinc, strontium, and polychlorinated biphenyls (PCB).

ORIGINAL PLAN	DATE
SURVEY PLOTTED BY	
DRAWN BY	
TRACED BY	
NOTED BY	
QUANTITIES BY	
CHECKED BY	
No.	

## Water Meter Installations (For Meters 3-In. and Larger) (Continued)

28. The Contractor shall install electronic markers to all mains and test the electronic markers prior to installations to verify proper operation. Board of Water Supply personnel shall verify the number and locations of placed electronic markers before final paving of the project.
29. The Contractor shall furnish and install an insulting corporation stop and petrolatum wax tape at all taps (for D.I. pipe and copper lateral combination only).
30. Install 4 mil thick, non-metallic, blue colored, 6 inches wide warning tape over centerline of the pipe and below the base course along the entire length of trench. Tape should be marked with "CAUTION WATER LINE BURIED BELOW".

## Honolulu Board of Water Supply Right-of-Entry

1. The Contractor shall be fully responsible for all costs related to the processing and obtaining of the Consent of Entry (COE) and Release and Waiver (R&W) with the Honolulu Board of Water Supply (BWS). Any delays caused by obtaining the COE and R&W will be at the cost of the Contractor. The Contractor shall coordinate all COE and R&W work with Mr. Michael Matsuo, BWS Land Division, Land Administrator, phone number: (808) 748-5951.

## Honolulu Board of Water Supply Reinforced Concrete Jackets on Existing Waterlines Notes:

1. Reinforced concrete jackets on existing waterlines are based upon the as-built location of the pipe joints. The Contractor shall verify the pipe joint locations in the field and shall extend the reinforced concrete jackets as necessary to comply with BWS Std. Det. B1. Shortening of the reinforced concrete jacket is not allowed.
2. The Contractor shall obtain BWS approval of the means and methods to construct the reinforced concrete jackets on the existing waterlines. The Contractor shall provide a schematic shop drawing to BWS that details the materials and procedures necessary to safely encase the existing waterlines without a water shutdown.
3. In order to provide additional stability beneath the existing waterlines, the Contractor shall provide a CLSM cushion beneath the bell ends of the existing waterlines that are to be encased in a reinforced concrete jacket. The CLSM cushion shall be a minimum of 6" thick and shall extend 1' in each direction from the end of the reinforced concrete jacket.

FED. ROAD DIST. NO.	STATE	PROJ. NO.	FISCAL YEAR	SHEET NO.	TOTAL SHEETS
HAWAII	HAW.	7101A-01-20	2021	16	767

APPROVED:	
Manager and Chief Engineer, BWS	DATE
(for work affecting BWS facilities in City/State R/W & BWS easements only)	

07/15/22	Notes Revised
06/08/22	Notes Added
DATE	REVISION



THIS WORK WAS PREPARED BY ME OR UNDER MY SUPERVISION AND CONSTRUCTION OF THIS PROJECT WILL BE UNDER MY OBSERVATION.

Signature: *Craig W. Luke*  
 EXPIRATION DATE OF THE LICENSE: April 30, 2024

STATE OF HAWAII  
 DEPARTMENT OF TRANSPORTATION  
 HIGHWAYS DIVISION

### Construction Notes - 14

FARRINGTON HIGHWAY WIDENING  
 Kapolei Golf Course Road to Fort Weaver Road  
 Project No. 7101A-01-20

Scale: As Shown      Date: April 2022

FED. ROAD DIST. NO.	STATE	PROJ. NO.	FISCAL YEAR	SHEET NO.	TOTAL SHEETS
HAWAII	HAW.	7101A-01-20	2021	21	767

**Legend:**

	<u>Existing:</u>	<u>Proposed:</u>
Baseline		
Property Line		
Delta		
State Right-of-way	r/w	R/W
Property Line or City Right-of-way		
Easement Line		
Power Pole		
Guy Wire		
Overhead Utility Line	o/h	O/H
Traffic Light Pole		
Traffic Signal, Street Light or Electric Box		
Street Light		
Chain Link Fence		
Metal Guardrail		
Hedge/Brush		
Trees		
Benchmark		
Top of Bank		
Bottom of Bank		
	Fill Condition	Cut Condition
Riprap		
Drain Manhole		
Grated Drain Inlet Box		
Bridge Scupper		
Catch Basin		
Drainline	D24	D24
Drainage Flow Direction		
Sign on Post		
Raised Pavement Markings		
Waterline	EW16	W24
Sewerline	S8	S8

**Abbreviations:**

AASHTO	American Association of State Highway and Transportation Officials	Pav't.	Pavement
Ac.	Acre	PC	Point of Curvature
AC	Asphalt Concrete	PCC	Portland Cement Concrete
ASTM	Association Society for Testing and Materials	Ph.	Phase
BC	Bottom of Curb	PI	Point of Intersection
Blk.	Block	PIVC	Point of Inflection Vertical Curve
Bot.	Bottom	PMA	Polymer Modified Asphalt
BV	Bottom Vertical	POC	Point on Curve
BVC	Begin Vertical Curve	PP	Power Pole
BW	Bottom of Wall	Psi	Pounds Per Square Inch
BWS	Board of Water Supply	PT	Point of Tangency
C	Chord	Pt.	Point
CB	Catch Basin	R	Radius
Cl.	Class	RC	Reinforced Concrete
Clr.	Clear	Rd.	Road
CO	Cleanout	Rt.	Right
Comm.	Communications	R/W	Right-of-Way
Conc.	Concrete	Shldr.	Shoulder
Conn.	Connect	Sht.	Sheet
Cont.	Continuous	SLB	Street Light Box
Decel.	Deceleration	Spec.	Specification
Det.	Detail	Sp.	Special
D.I.	Ductile Iron	STA.	Station
D.I.P.	Ductile Iron Pipe	Std.	Standard
DI	Drain Inlet	Struct.	Structure
Dia.	Diameter	St.	Street
D.L.	Drainline	Sq.	Square
DMH	Drain Manhole	SWQ	Storm Water Quality
D.P.P.	Department of Planning and Permitting	T	Tangent
D.S.	Downspout	TC	Top of Curb
E.P.	Edge of Pavement	TD	Top of Deck
E.S.	Edge of Shoulder	TLP	Traffic Light Pole
EVC	End Vertical Curve	TMK	Tax Map Key
Exist.	Existing	TSB	Traffic Signal Box
FE	Flanged End	TV	Top Vertical
GDI	Grated Drop Inlet	TW	Top of Wall
GV	Gate Valve	Typ.	Typical
HDOT	Hawaii Department of Transportation	VB	Valve Box
HGL	Hydraulic Grade Line	V.E.	Vertical Curve
Hwy.	Highway	W.L.	Waterline
I.B.	Inbound	WV	Water Valve
Inv.	Invert	WWF	Welded Wire Fabric
Lc	Length of Chord	Yd.	Yard
Lt.	Left		
LP	Light Pole		
O.B.	Out Bound		
O.C.	On Center		
o/s	Offset		
Max.	Maximum		
Min.	Minimum		
Mod.	Modified		
MJ	Mechanical Joint		
No.	Number		

SURVEY PLOTTED BY	DATE
DRAWN BY	
TRACED BY	
DESIGNED BY	
CHECKED BY	
ORIGINAL PLAN	
NOTE BOOK	
No.	

APPROVED: \_\_\_\_\_ DATE \_\_\_\_\_  
 Manager and Chief Engineer, BWS  
 (for work affecting BWS facilities in  
 City/State R/W & BWS easements only)

07/15/22	
DATE	REVISION



THIS WORK WAS PREPARED BY ME OR UNDER MY SUPERVISION AND CONSTRUCTION OF THIS PROJECT WILL BE UNDER MY OBSERVATION.  
 SIGNATURE: \_\_\_\_\_ EXPIRATION DATE OF THE LICENSE: April 30, 2024



STATE OF HAWAII  
 DEPARTMENT OF TRANSPORTATION  
 HIGHWAYS DIVISION

**General Legend and Abbreviations**

FARRINGTON HIGHWAY WIDENING  
 Kapolei Golf Course Road to Fort Weaver Road  
 Project No. 7101A-01-20

Scale: As Shown Date: April 2022

FED. ROAD DIST. NO.	STATE	PROJ. NO.	FISCAL YEAR	SHEET NO.	TOTAL SHEETS
HAWAII	HAW.	7101A-01-20	2021	28	767

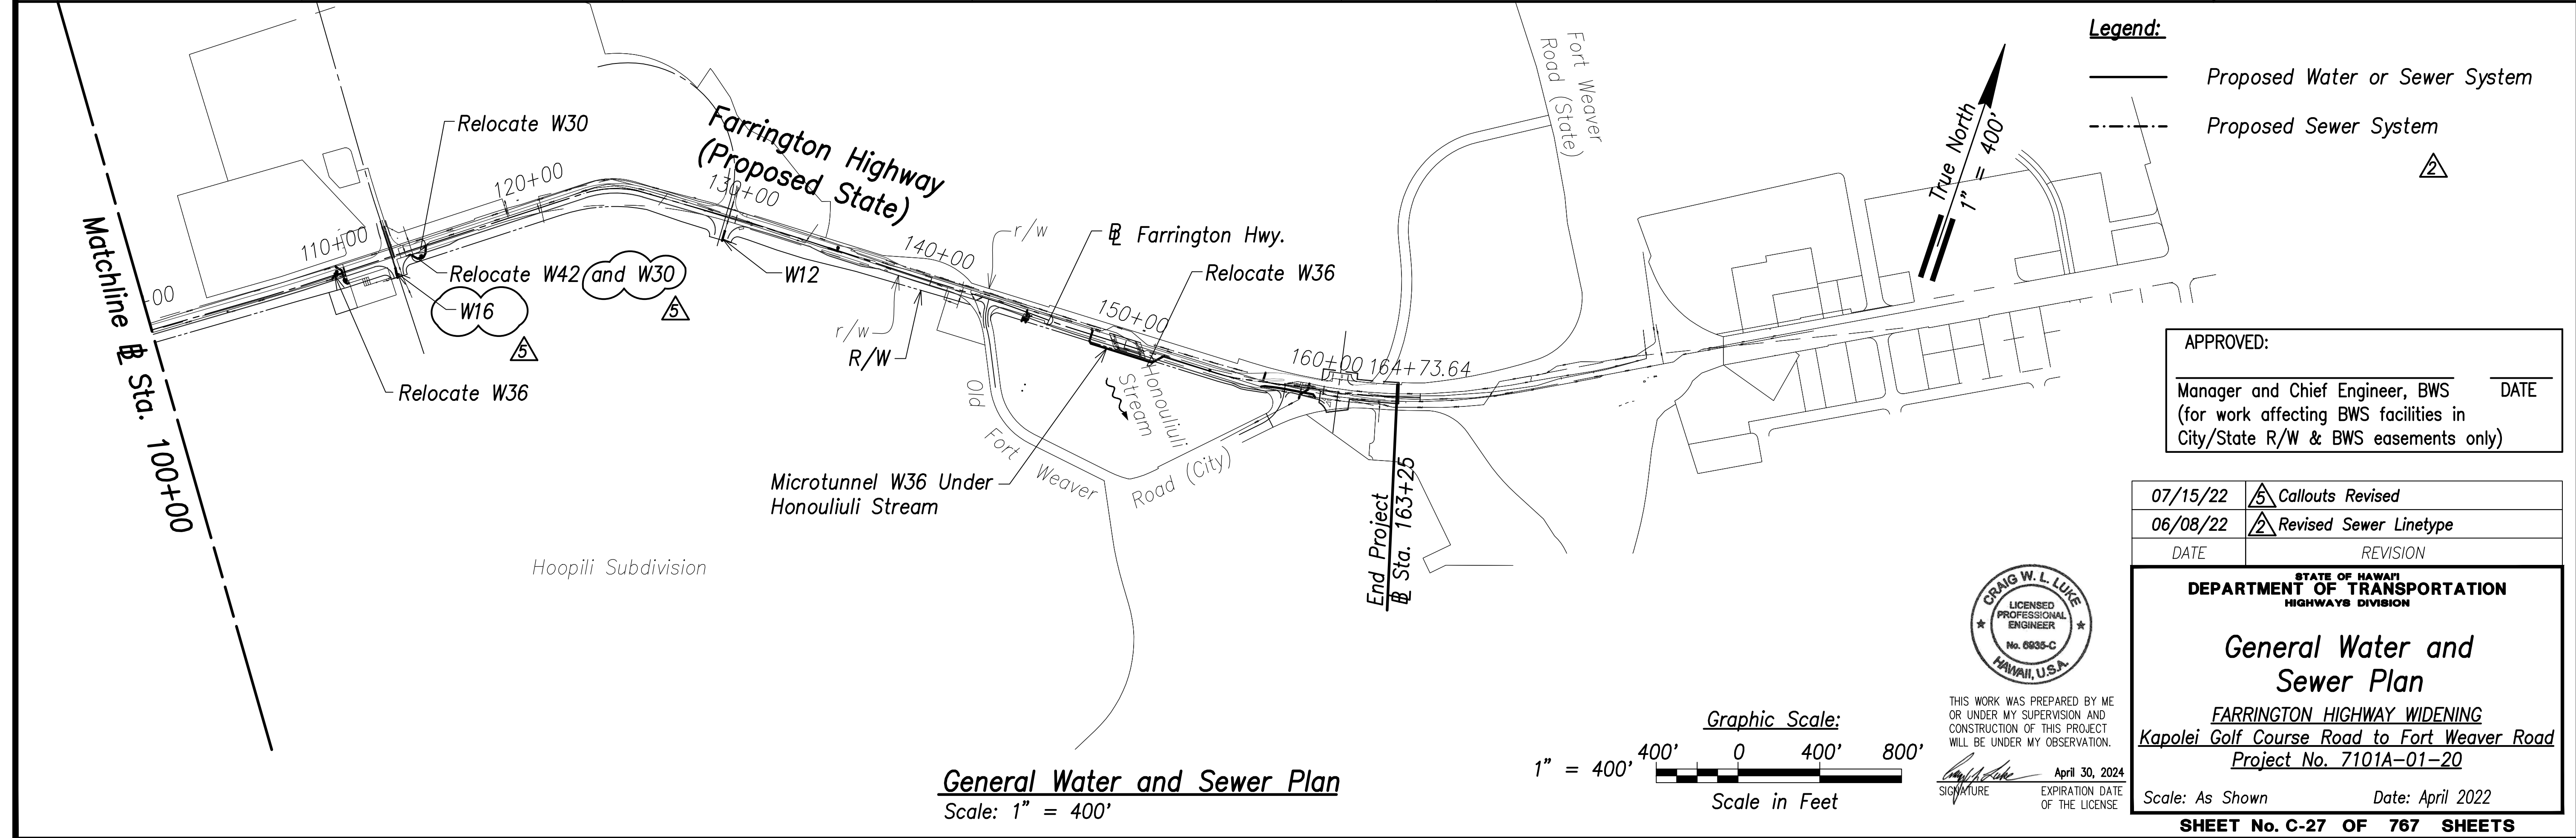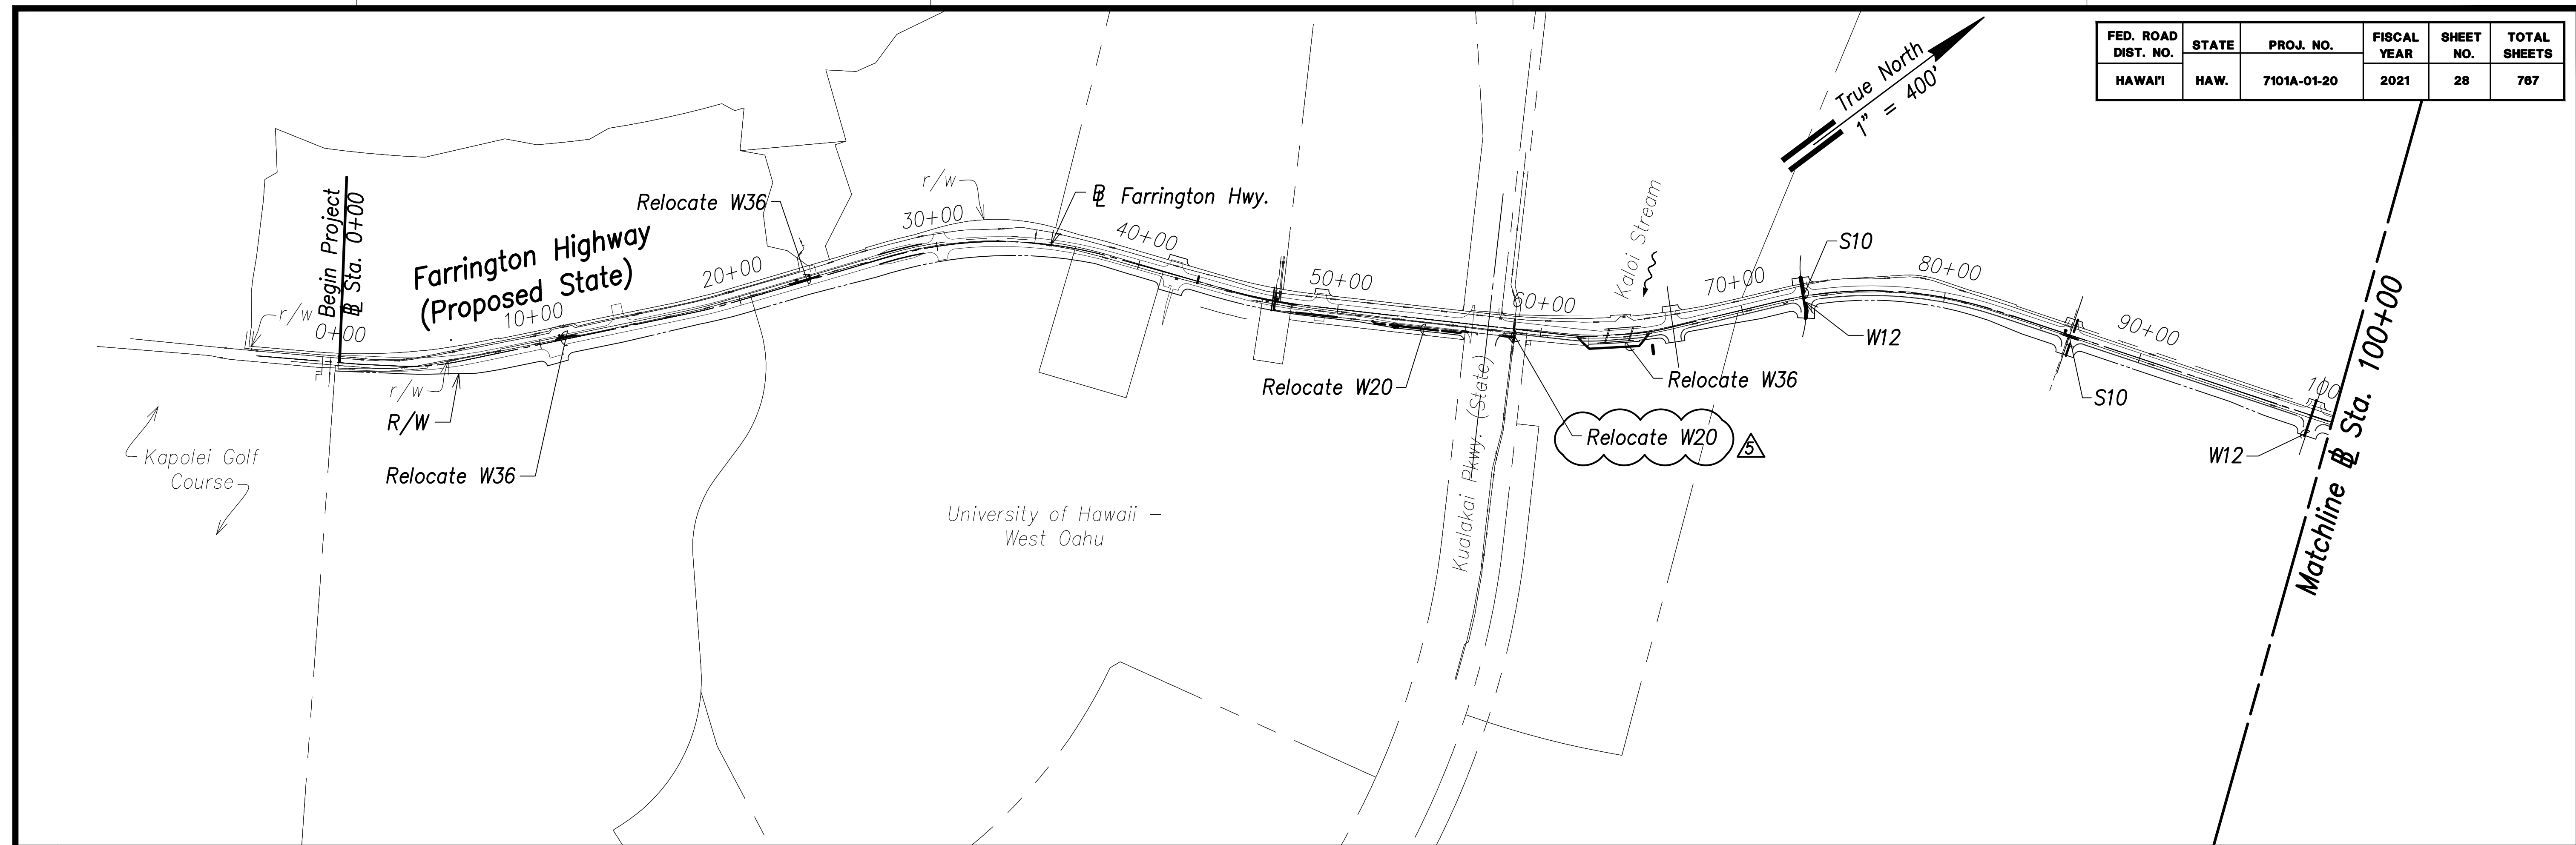

- Legend:**
- Proposed Water or Sewer System
  - - - Proposed Sewer System
  - △

APPROVED:

Manager and Chief Engineer, BWS      DATE

(for work affecting BWS facilities in City/State R/W & BWS easements only)

DATE	REVISION
07/15/22	△ Callouts Revised
06/08/22	△ Revised Sewer Linetype



THIS WORK WAS PREPARED BY ME OR UNDER MY SUPERVISION AND CONSTRUCTION OF THIS PROJECT WILL BE UNDER MY OBSERVATION.

Signature: *Craig W. Luke*      EXPIRATION DATE OF THE LICENSE: April 30, 2024


STATE OF HAWAII  
DEPARTMENT OF TRANSPORTATION  
HIGHWAYS DIVISION

**General Water and Sewer Plan**

FARRINGTON HIGHWAY WIDENING  
Kapolei Golf Course Road to Fort Weaver Road  
Project No. 7101A-01-20

Scale: As Shown      Date: April 2022

**SHEET NO. C-27 OF 767 SHEETS**

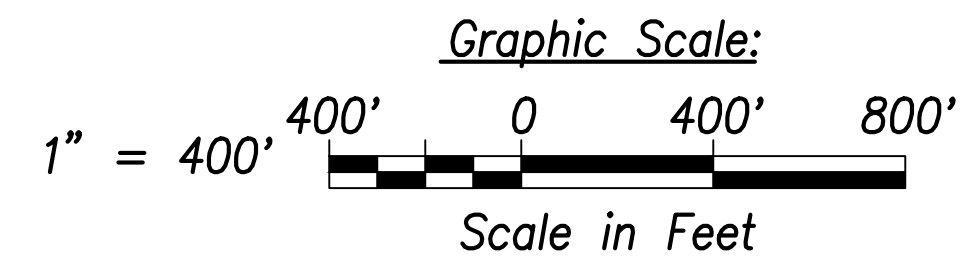

**General Water and Sewer Plan**  
Scale: 1" = 400'

SURVEY PLOTTED BY: _____	DATE: _____
DRAWN BY: _____	DATE: _____
TRACED BY: _____	DATE: _____
QUANTIFIED BY: _____	DATE: _____
CHECKED BY: _____	DATE: _____
ORIGINAL PLAN NOTE BOOK No. _____	



FILE: K:\civil\23146 Farrington Hwy Widening\Draw\Construction\Draw\C-27 General Water Plan.dwg saved June 30, 2022






FED. ROAD DIST. NO.	STATE	PROJ. NO.	FISCAL YEAR	SHEET NO.	TOTAL SHEETS
HAWAII	HAW.	7101A-01-20	2021	33	767

- Notes:**
- All drainage structures, curbs, gutters, sidewalks, pavement, guardrails, striping, vegetation, posts, and signing shall be removed within the limit of demolition and removal.
  - See Structural Drawings for Demolition and Removal of Bridge Deck and Structural Members.
  - Remove by grinding pavement striping, to avoid conflicts with existing striping. See Signing and Marking Plans.
  - For Demolition of Electrical and Telecommunication Utilities and Structures, Refer to Electrical Site Demolition Plans. The Contractor is Responsible for Coordinating all Electrical Work with Respective Utility Companies.
  - The Contractor Shall Ensure Demolition and Removal Work of Contaminated Materials is Done in Compliance with the State Department of Health and Federal Environmental Protection Agency Guidelines.
  - The Contractor shall coordinate all work with impacted utility owners and ensure continuous access.
  - Service shall be maintained at all times to impacted utilities. No interruption in service will be allowed. The contractor shall phase work to allow for continuous utility service.
  - All Water, Sewer, Fuel, and Gas Systems Shall Remain Undisturbed Unless Indicated For Demolition.
  - The Contractor shall reconstruct tops of all existing utility manholes, valve boxes, meter boxes and structures that are remaining in service and contained within the project area flush with the finished grade.
  - The Contractor Shall Comply With Traffic Notes on Sht. C-19.

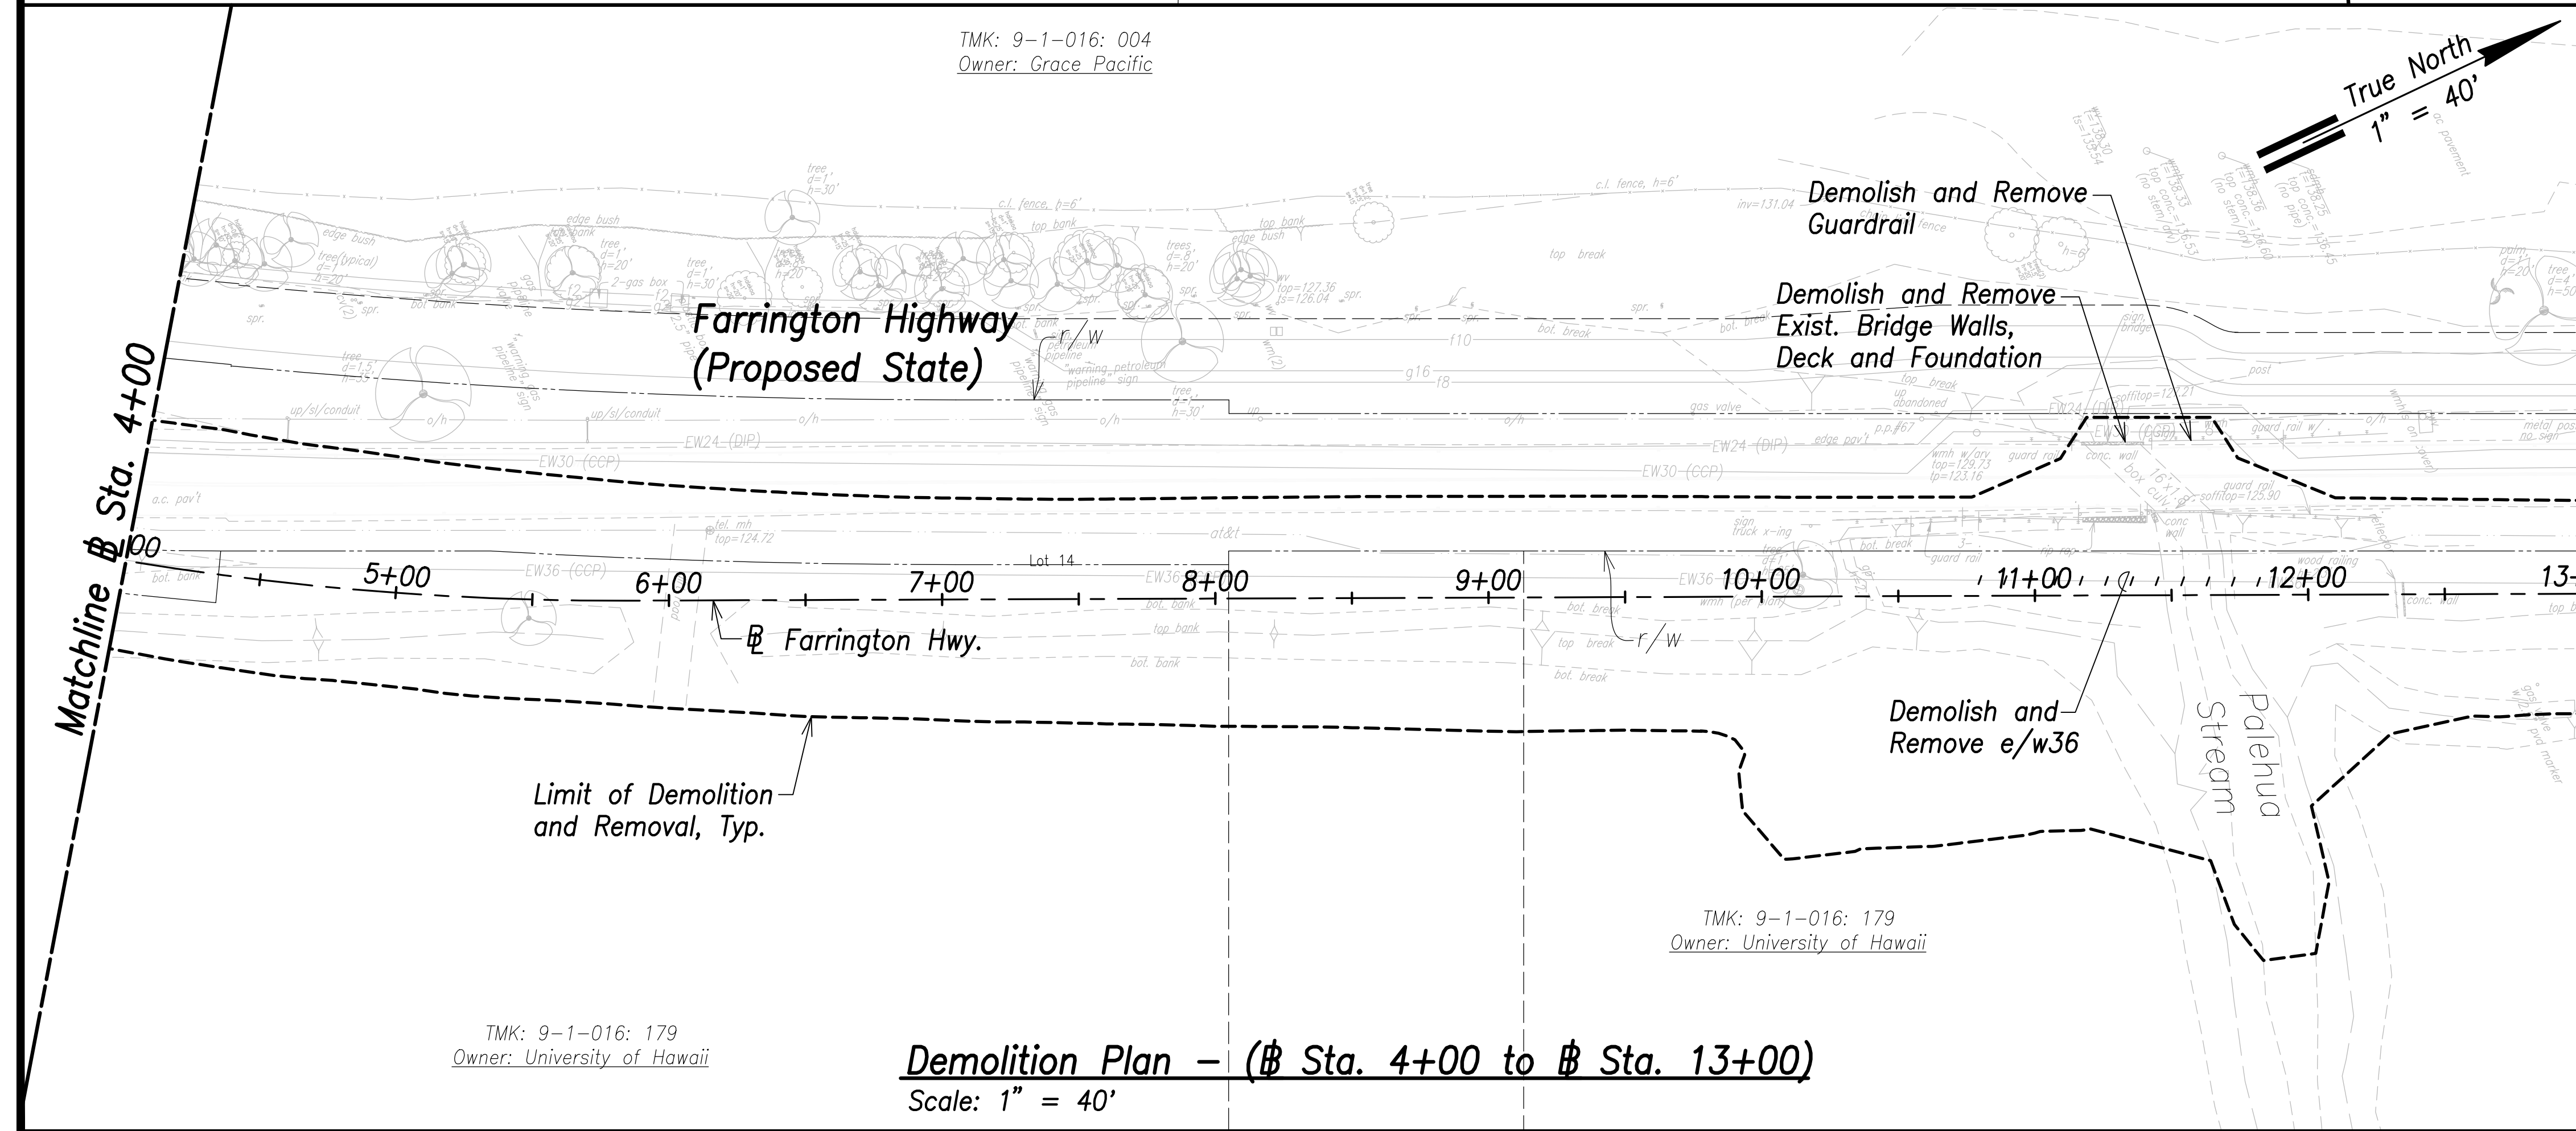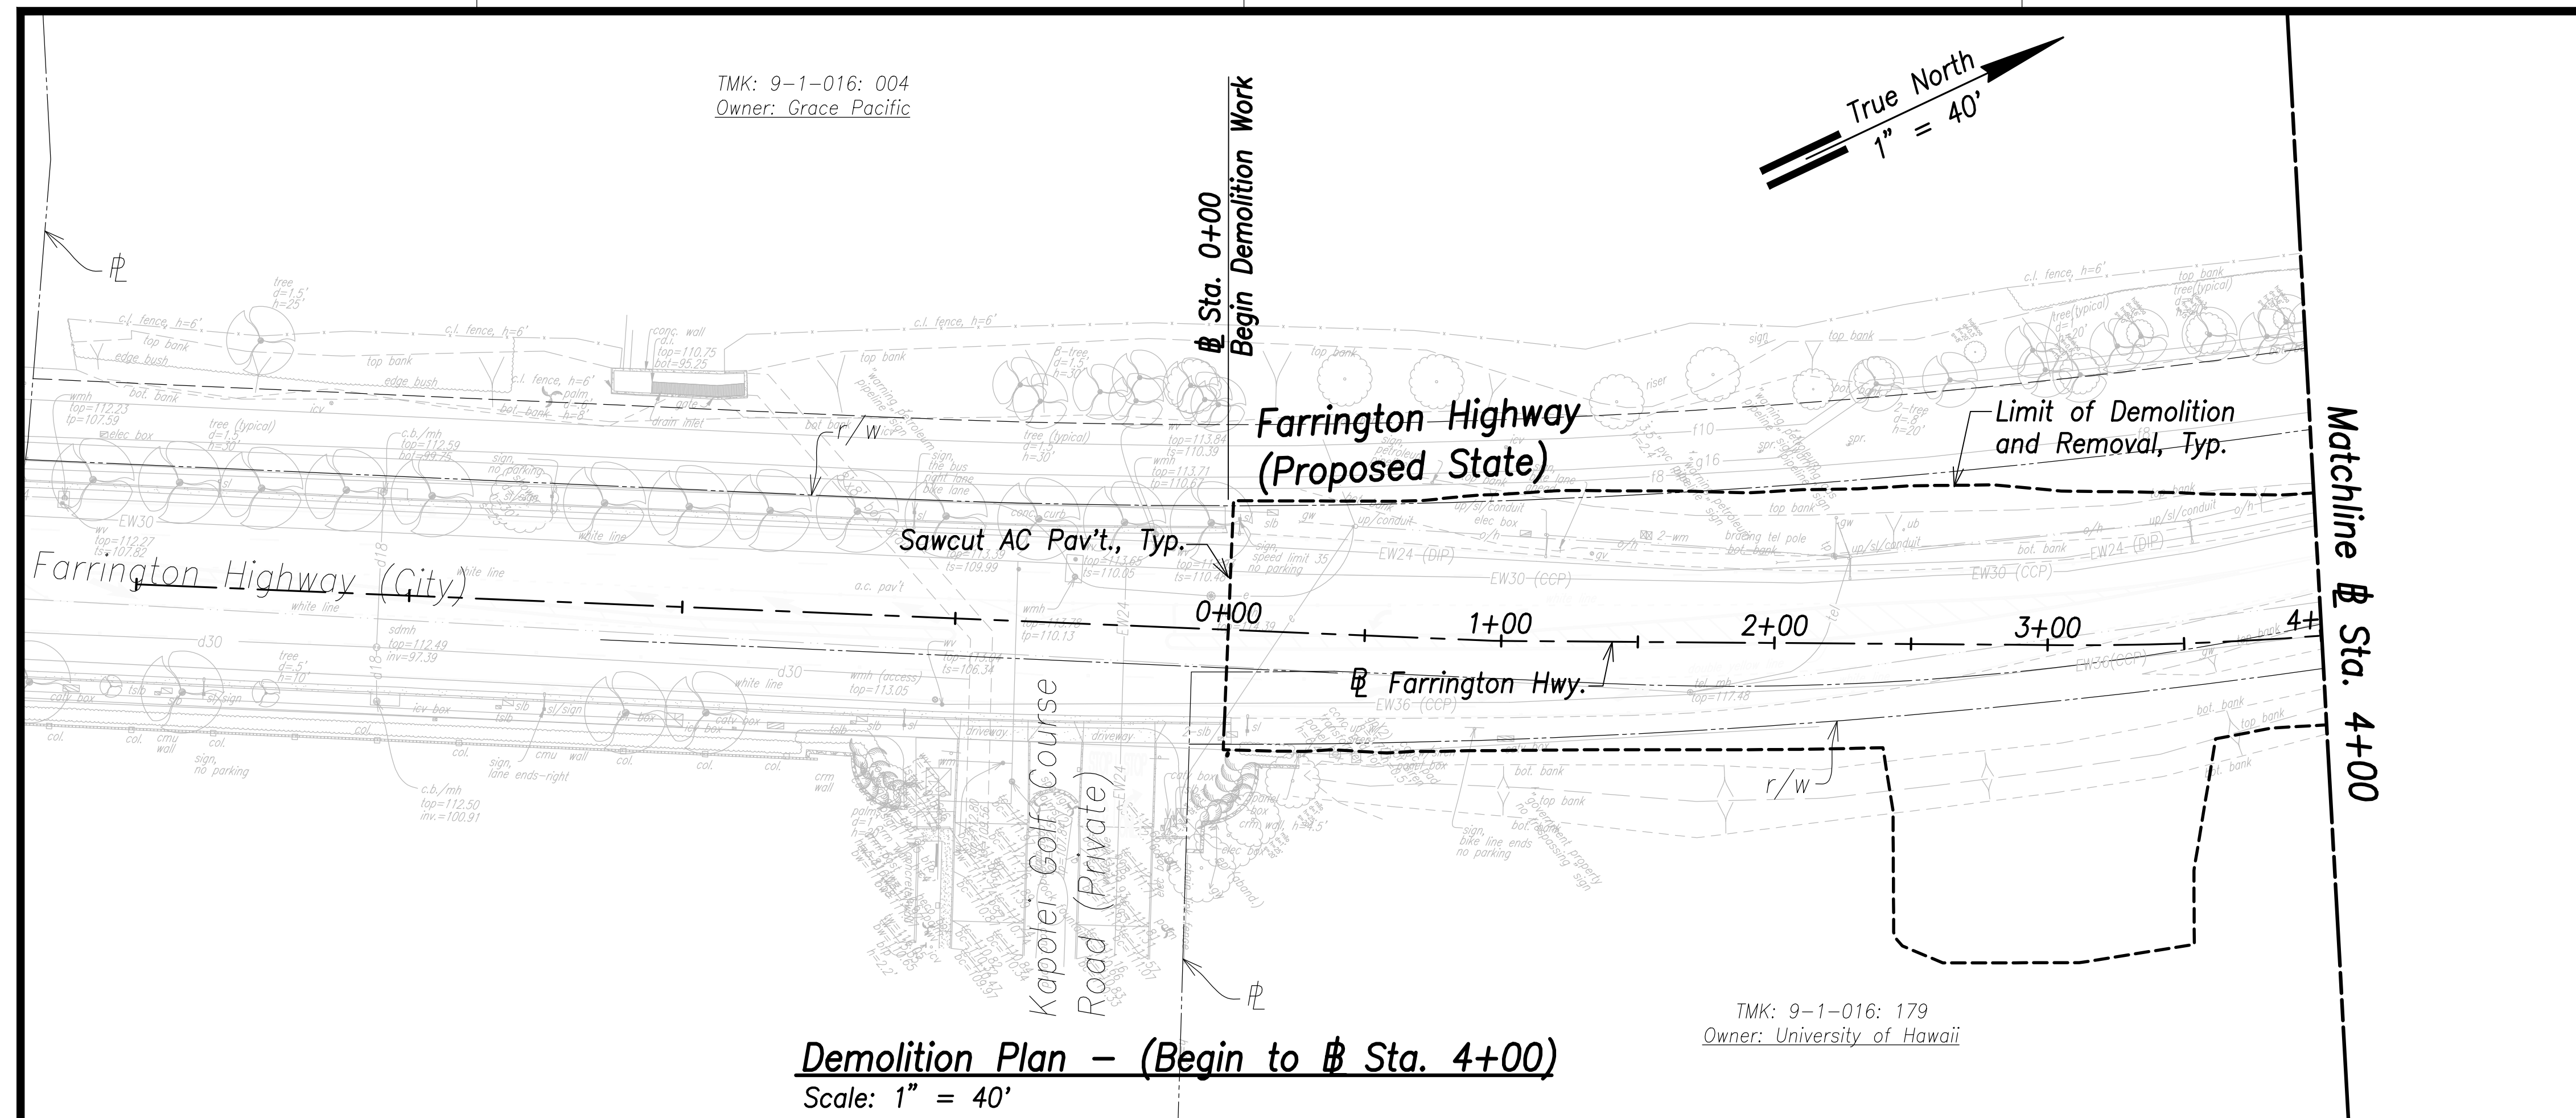

APPROVED:

Manager and Chief Engineer, BWS DATE  
(for work affecting BWS facilities in City/State R/W & BWS easements only)

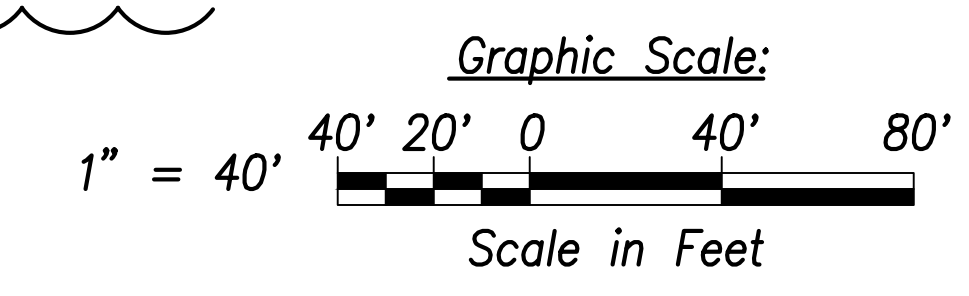

07/15/22	Signature Block Revised
DATE	REVISION



THIS WORK WAS PREPARED BY ME OR UNDER MY SUPERVISION AND CONSTRUCTION OF THIS PROJECT WILL BE UNDER MY OBSERVATION.

Signature: [Signature]  
EXPIRATION DATE OF THE LICENSE: April 30, 2024

STATE OF HAWAII  
DEPARTMENT OF TRANSPORTATION  
HIGHWAYS DIVISION

**Demolition Plan**  
Sta. 0+00 to Sta. 13+00

FARRINGTON HIGHWAY WIDENING  
Kapolei Golf Course Road to Fort Weaver Road  
Project No. 7101A-01-20

Scale: As Shown Date: April 2022

SHEET NO. C-32 OF 767 SHEETS


SURVEY PLOTTED BY:	DATE:
DRAWN BY:	
TRACED BY:	
CHECKED BY:	
ORIGINAL PLAN NOTE BOOK No.:	




FED. ROAD DIST. NO.	STATE	PROJ. NO.	FISCAL YEAR	SHEET NO.	TOTAL SHEETS
HAWAII	HAW.	7101A-01-20	2021	34	767

**Notes:**

- All drainage structures, curbs, gutters, sidewalks, pavement, guardrails, striping, vegetation, posts, and signing shall be removed within the limit of demolition and removal.
- See Structural Drawings for Demolition and Removal of Bridge Deck and Structural Members.
- Remove by grinding pavement striping, to avoid conflicts with existing striping. See Signing and Marking Plans.
- For Demolition of Electrical and Telecommunication Utilities and Structures, Refer to Electrical Site Demolition Plans. The Contractor is Responsible for Coordinating all Electrical Work with Respective Utility Companies.
- The Contractor Shall Ensure Demolition and Removal Work of Contaminated Materials is Done in Compliance with the State Department of Health and Federal Environmental Protection Agency Guidelines.
- The Contractor shall coordinate all work with impacted utility owners and ensure continuous access.
- Service shall be maintained at all times to impacted utilities. No interruption in service will be allowed. The contractor shall phase work to allow for continuous utility service.
- All Water, Sewer, Fuel, and Gas Systems Shall Remain Undisturbed Unless Indicated For Demolition.
- The Contractor shall reconstruct tops of all existing utility manholes, valve boxes, meter boxes and structures that are remaining in service and contained within the project area flush with the finished grade.
- The Contractor Shall Comply With Traffic Notes on Sht. C-19.

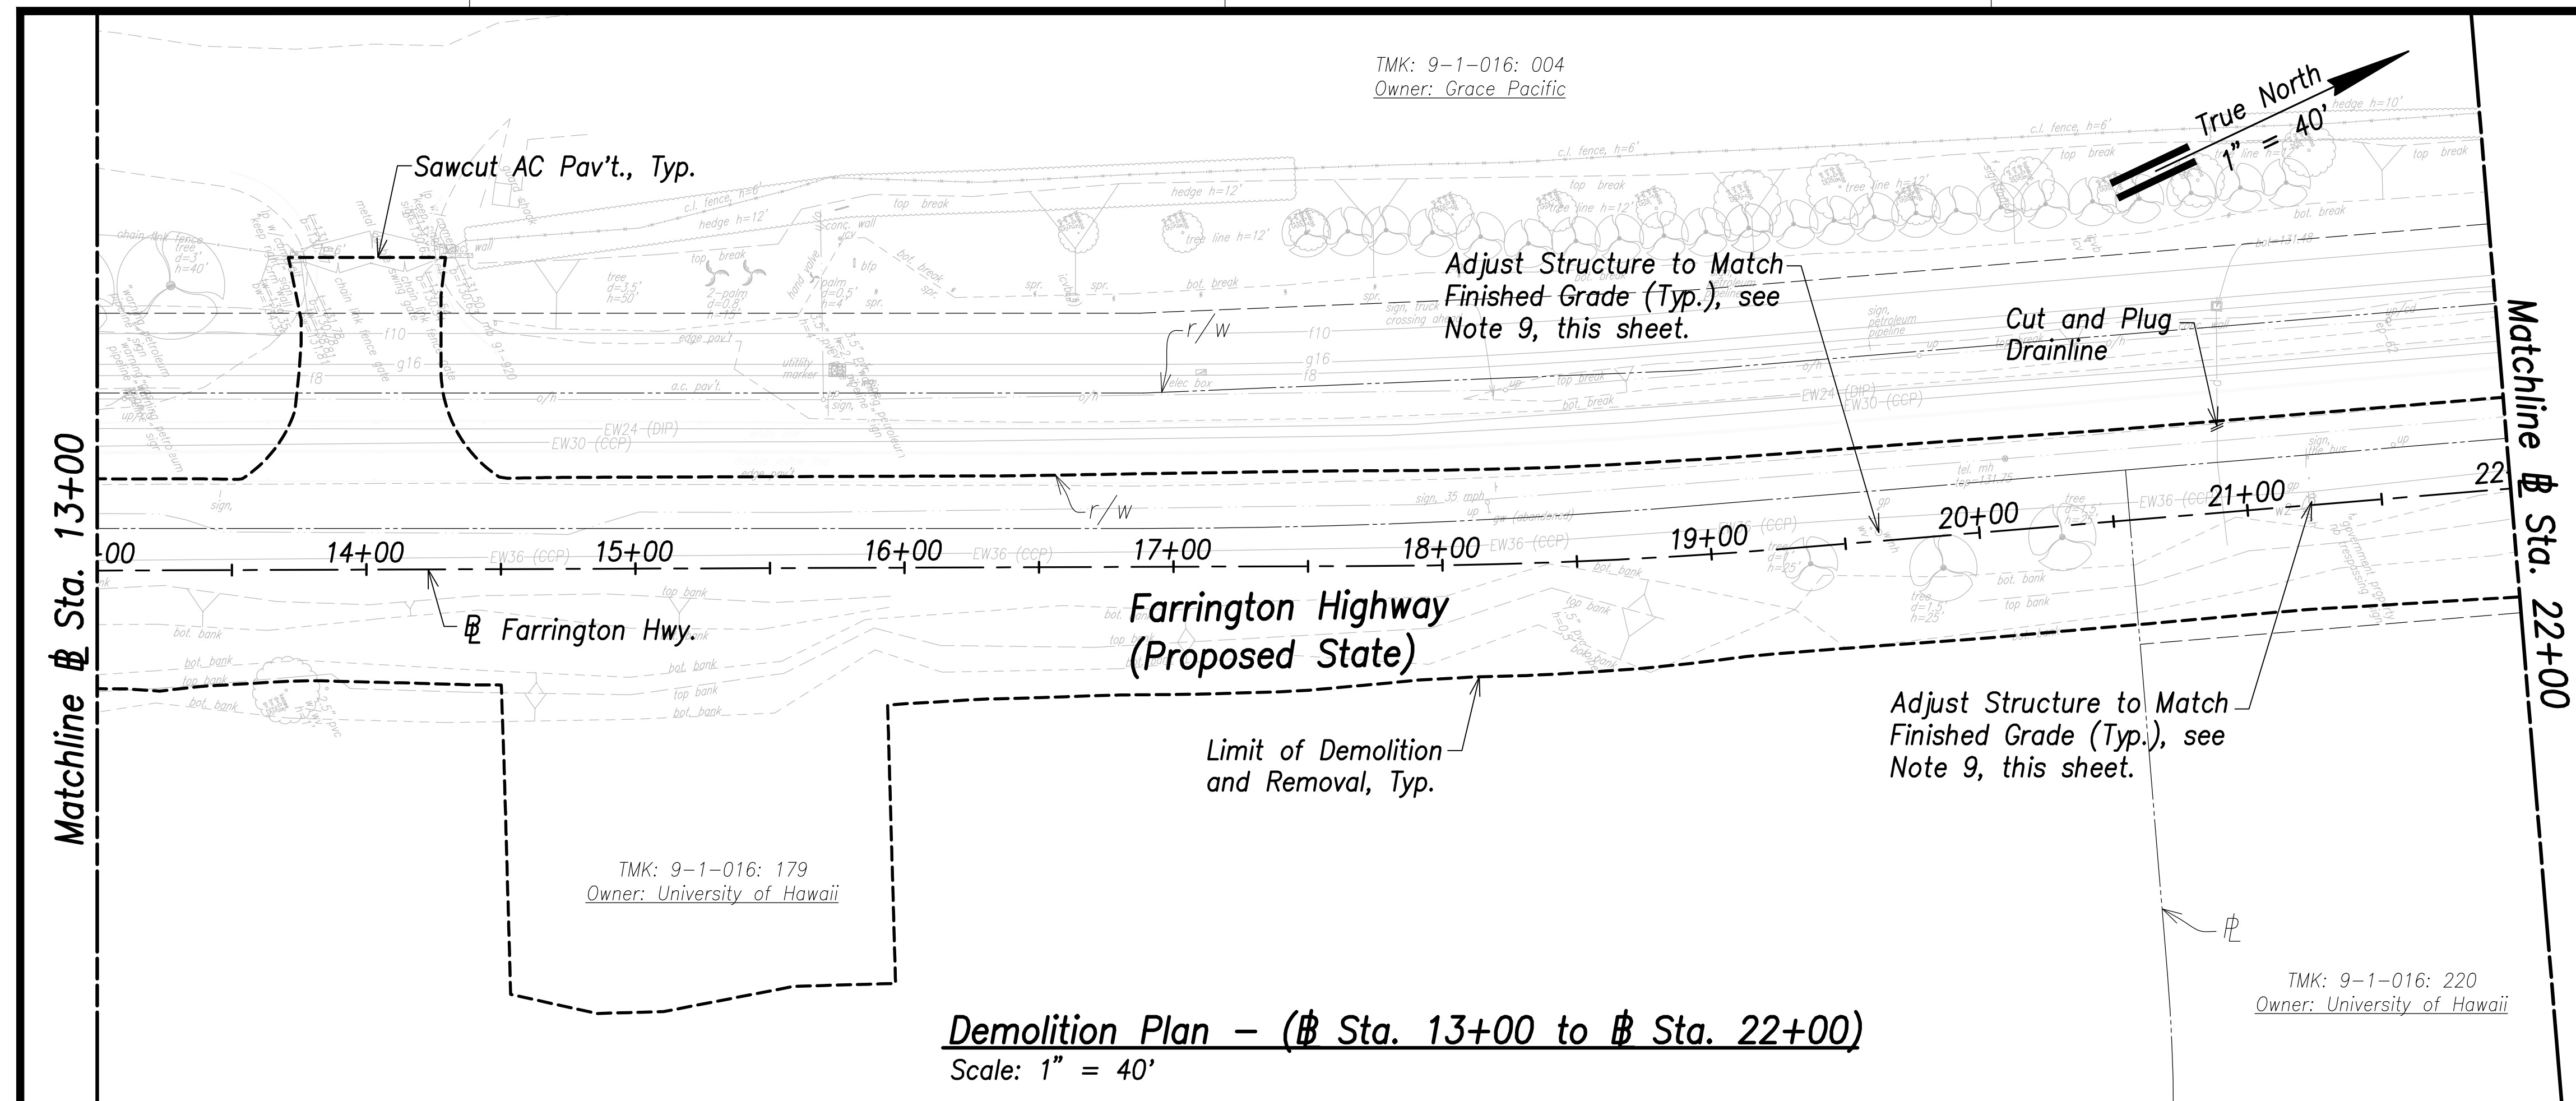


**Demolition Plan - (Sta. 13+00 to Sta. 22+00)**  
Scale: 1" = 40'

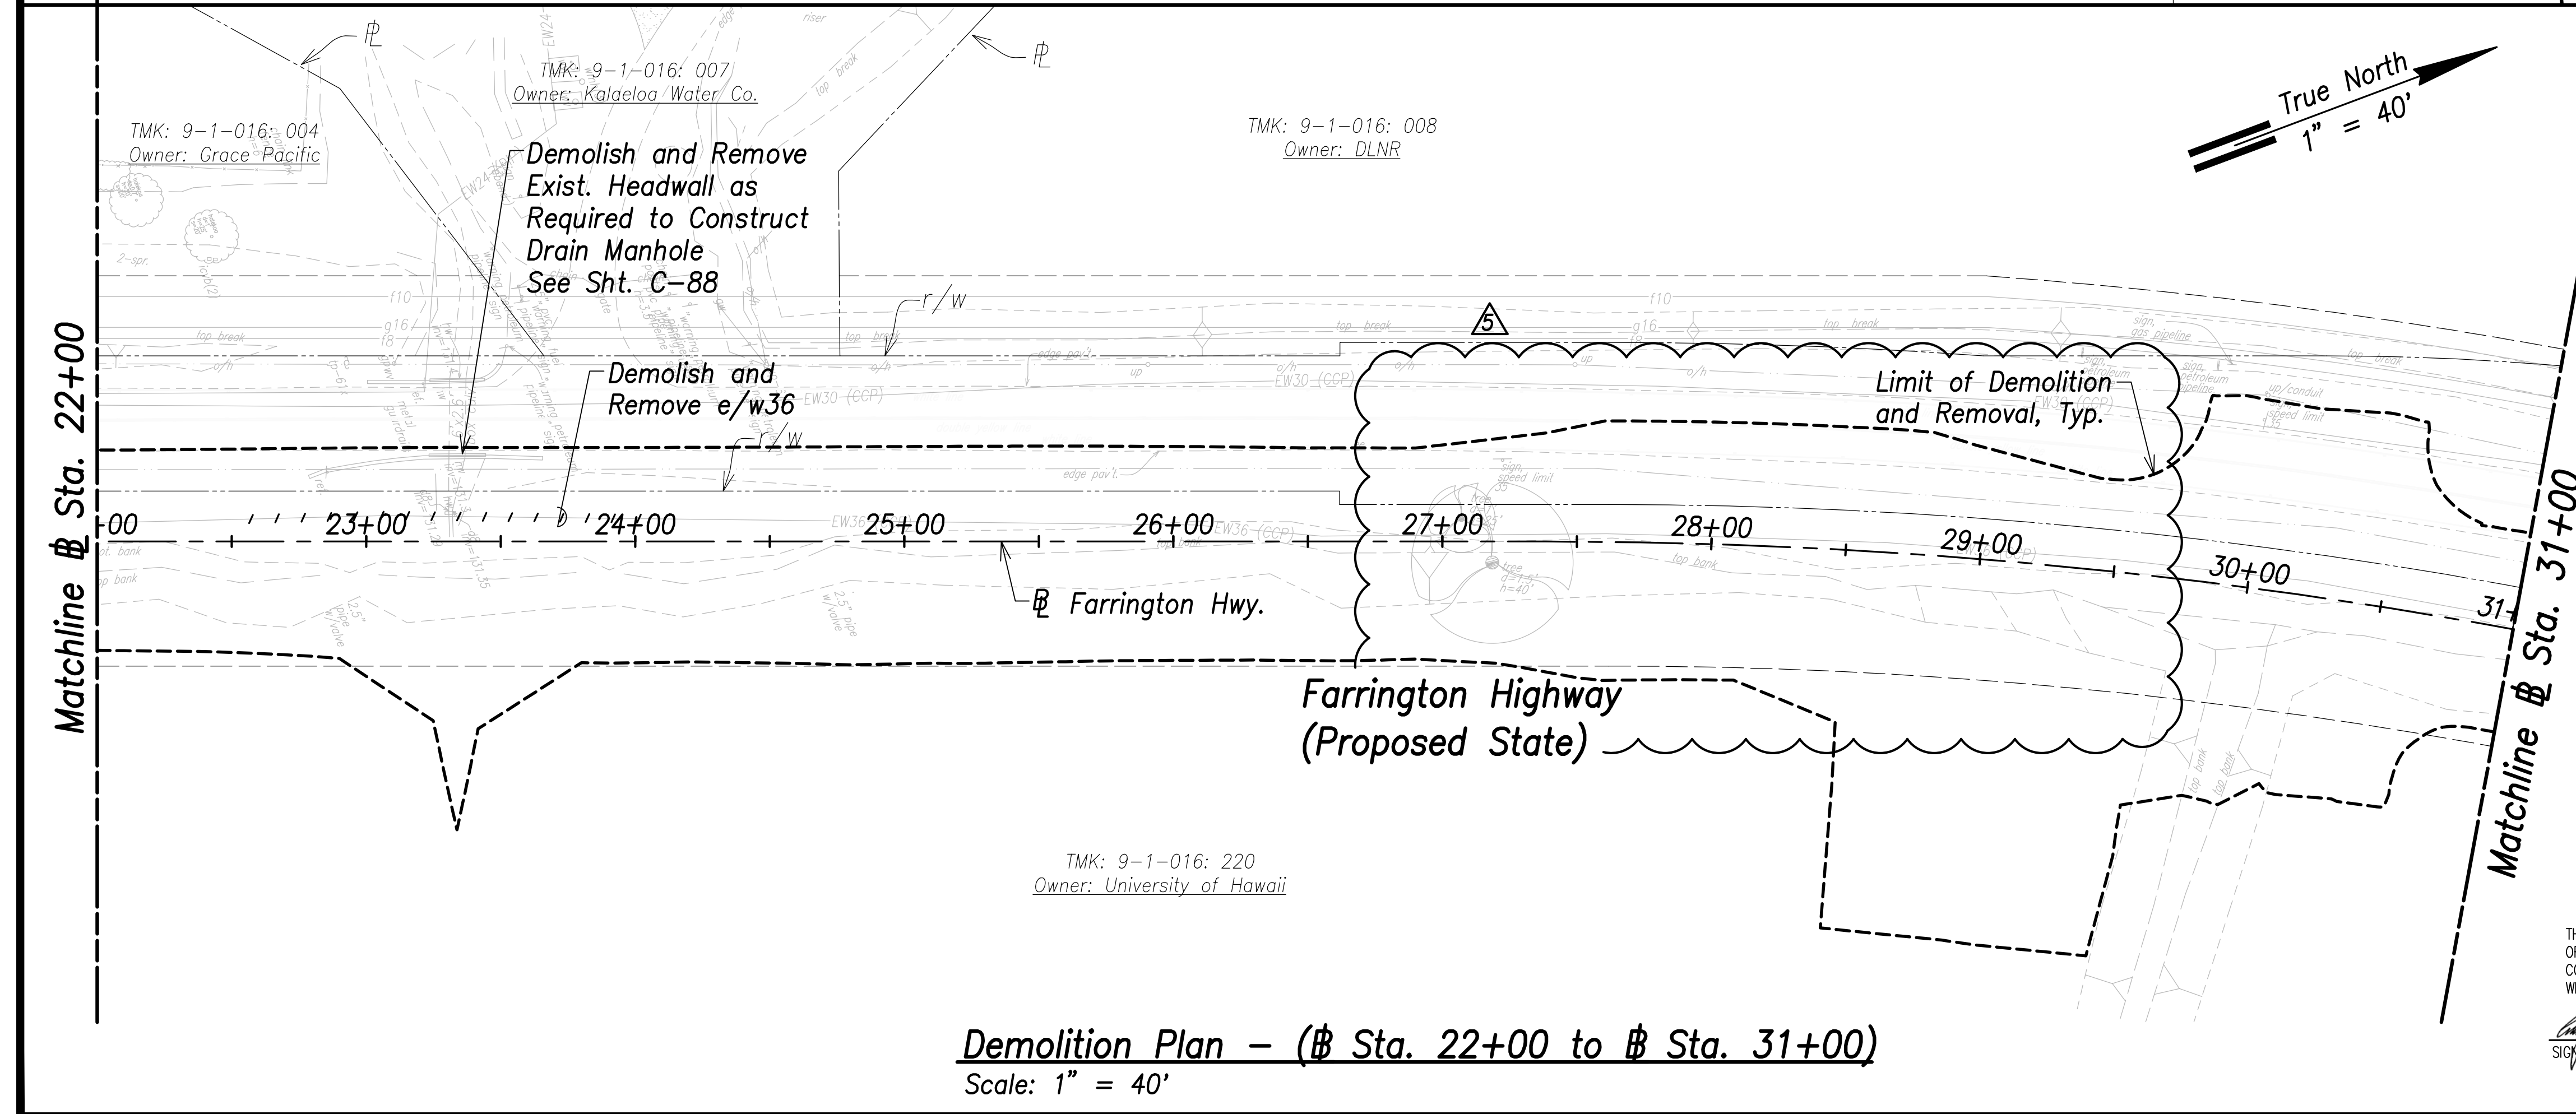

**Demolition Plan - (Sta. 22+00 to Sta. 31+00)**  
Scale: 1" = 40'

SURVEY PLOTTED BY	DATE
DRAWN BY	
TRACED BY	
QUANTITIES BY	
CHECKED BY	
ORIGINAL PLAN	
NOTE BOOK	
No.	

APPROVED: \_\_\_\_\_ DATE \_\_\_\_\_  
 Manager and Chief Engineer, BWS  
 (for work affecting BWS facilities in  
 City/State R/W & BWS easements only)

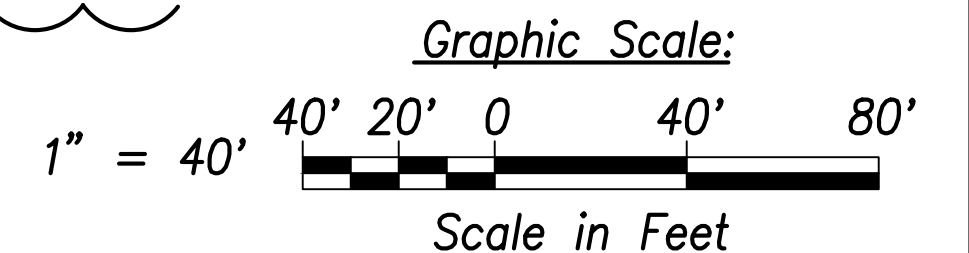

07/15/22	Signature Block and Limit Revised
DATE	REVISION



THIS WORK WAS PREPARED BY ME OR UNDER MY SUPERVISION AND CONSTRUCTION OF THIS PROJECT WILL BE UNDER MY OBSERVATION.  
 SIGNATURE: \_\_\_\_\_ EXPIRATION DATE OF THE LICENSE: April 30, 2024

STATE OF HAWAII  
 DEPARTMENT OF TRANSPORTATION  
 HIGHWAYS DIVISION

**Demolition Plan**  
 Sta. 13+00 to Sta. 31+00  
 FARRINGTON HIGHWAY WIDENING  
 Kapolei Golf Course Road to Fort Weaver Road  
 Project No. 7101A-01-20

Scale: As Shown Date: April 2022



TMK: 9-1-016: 008  
Owner: DLNR

TMK: 9-1-018: 008  
Owner: DLNR

FED. ROAD DIST. NO.	STATE	PROJ. NO.	FISCAL YEAR	SHEET NO.	TOTAL SHEETS
HAWAII	HAW.	7101A-01-20	2021	35	767


**Notes:**

- All drainage structures, curbs, gutters, sidewalks, pavement, guardrails, striping, vegetation, posts, and signing shall be removed within the limit of demolition and removal.
- See Structural Drawings for Demolition and Removal of Bridge Deck and Structural Members.
- Remove by grinding pavement striping, to avoid conflicts with existing striping. See Signing and Marking Plans.
- For Demolition of Electrical and Telecommunication Utilities and Structures, Refer to Electrical Site Demolition Plans. The Contractor is Responsible for Coordinating all Electrical Work with Respective Utility Companies.
- The Contractor Shall Ensure Demolition and Removal Work of Contaminated Materials is Done in Compliance with the State Department of Health and Federal Environmental Protection Agency Guidelines.
- The Contractor shall coordinate all work with impacted utility owners and ensure continuous access.
- Service shall be maintained at all times to impacted utilities. No interruption in service will be allowed. The contractor shall phase work to allow for continuous utility service.
- All Water, Sewer, Fuel, and Gas Systems Shall Remain Undisturbed Unless Indicated For Demolition.
- The Contractor shall reconstruct tops of all existing utility manholes, valve boxes, meter boxes and structures that are remaining in service and contained within the project area flush with the finished grade.

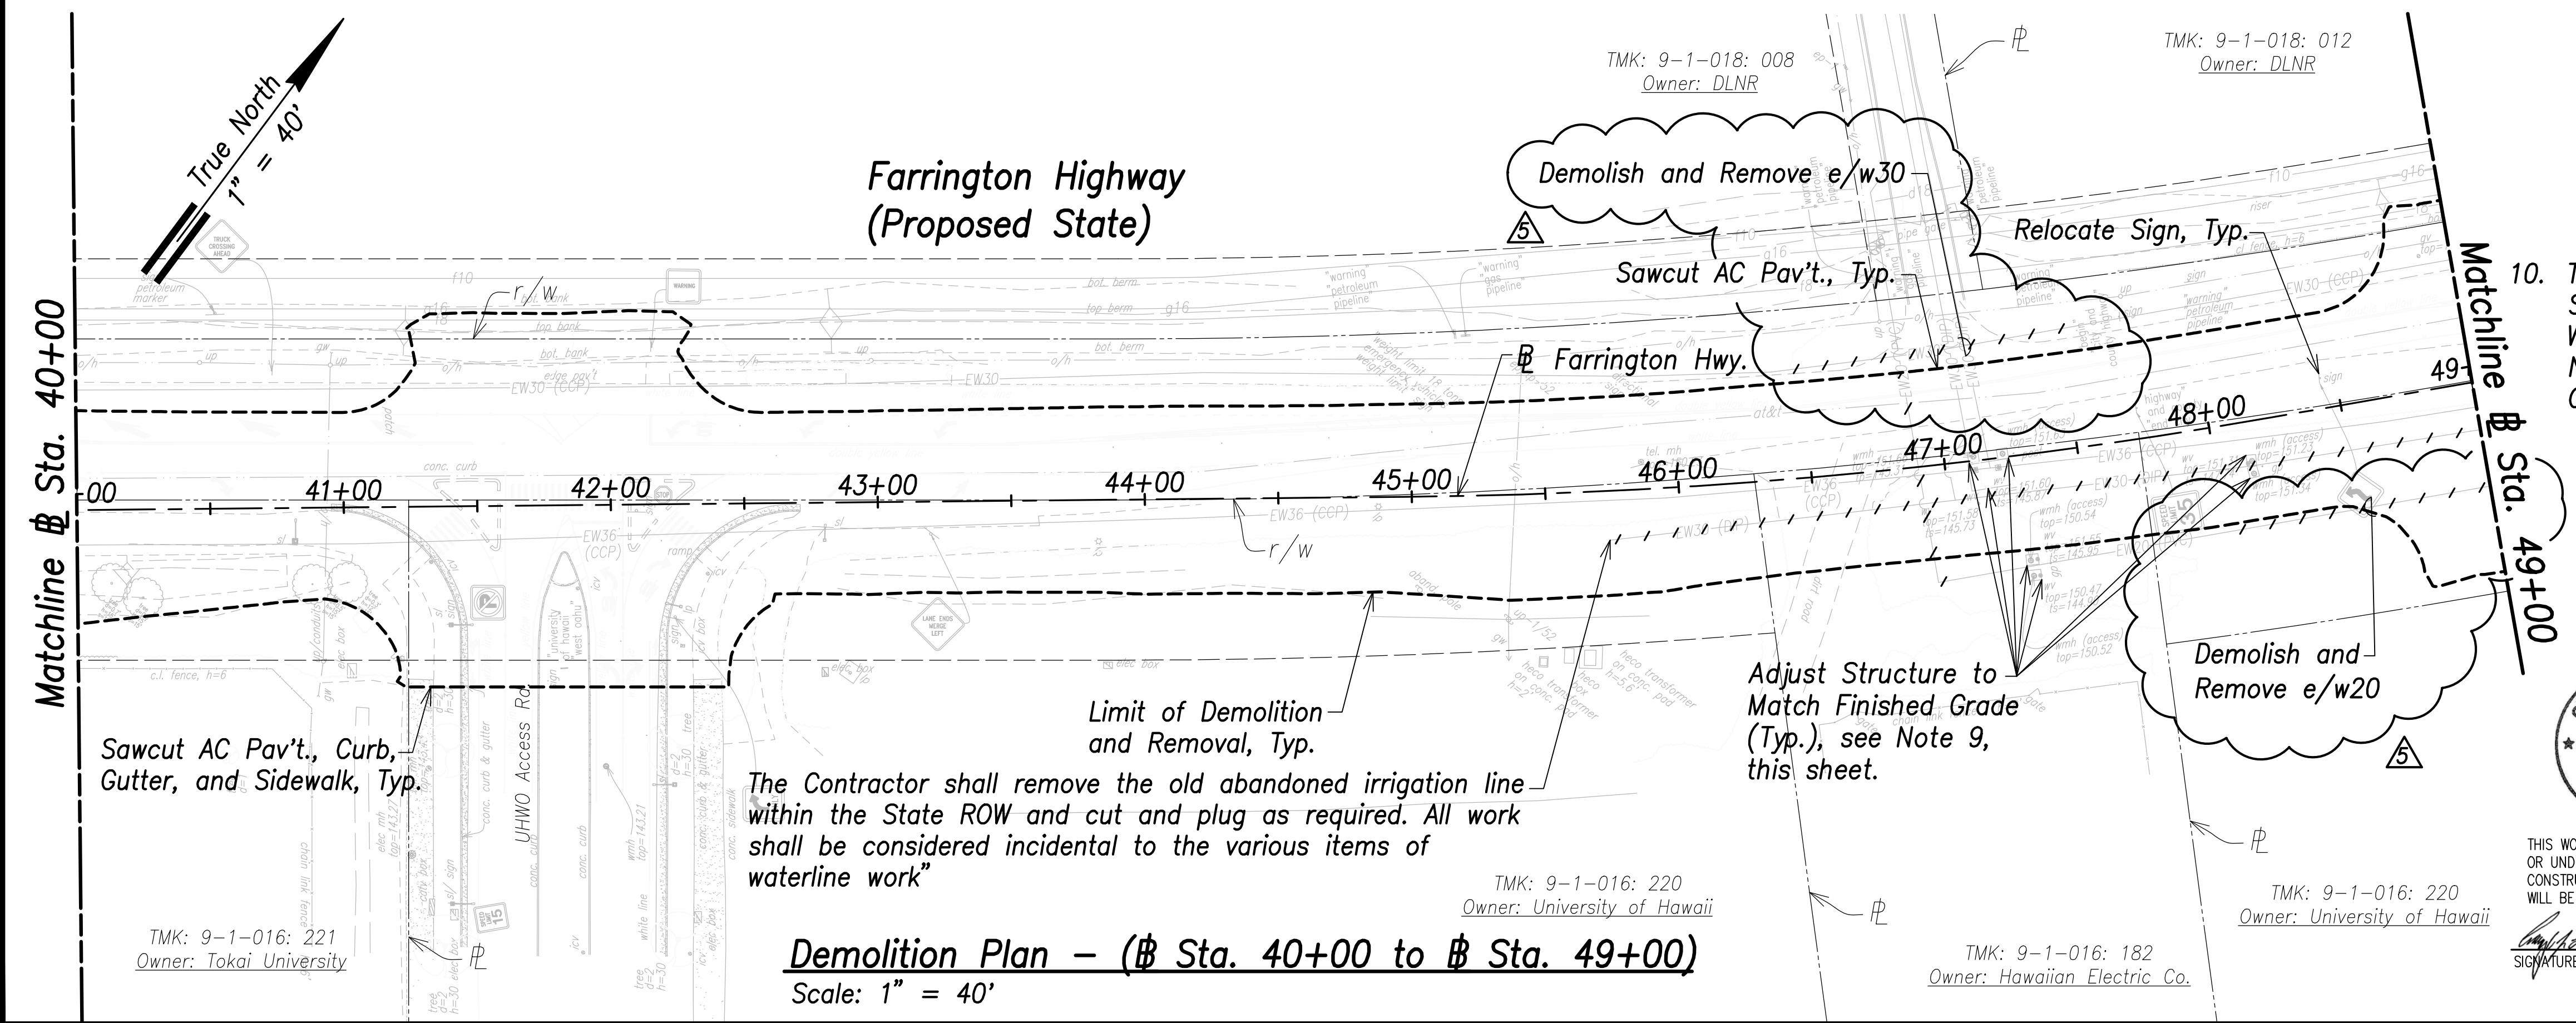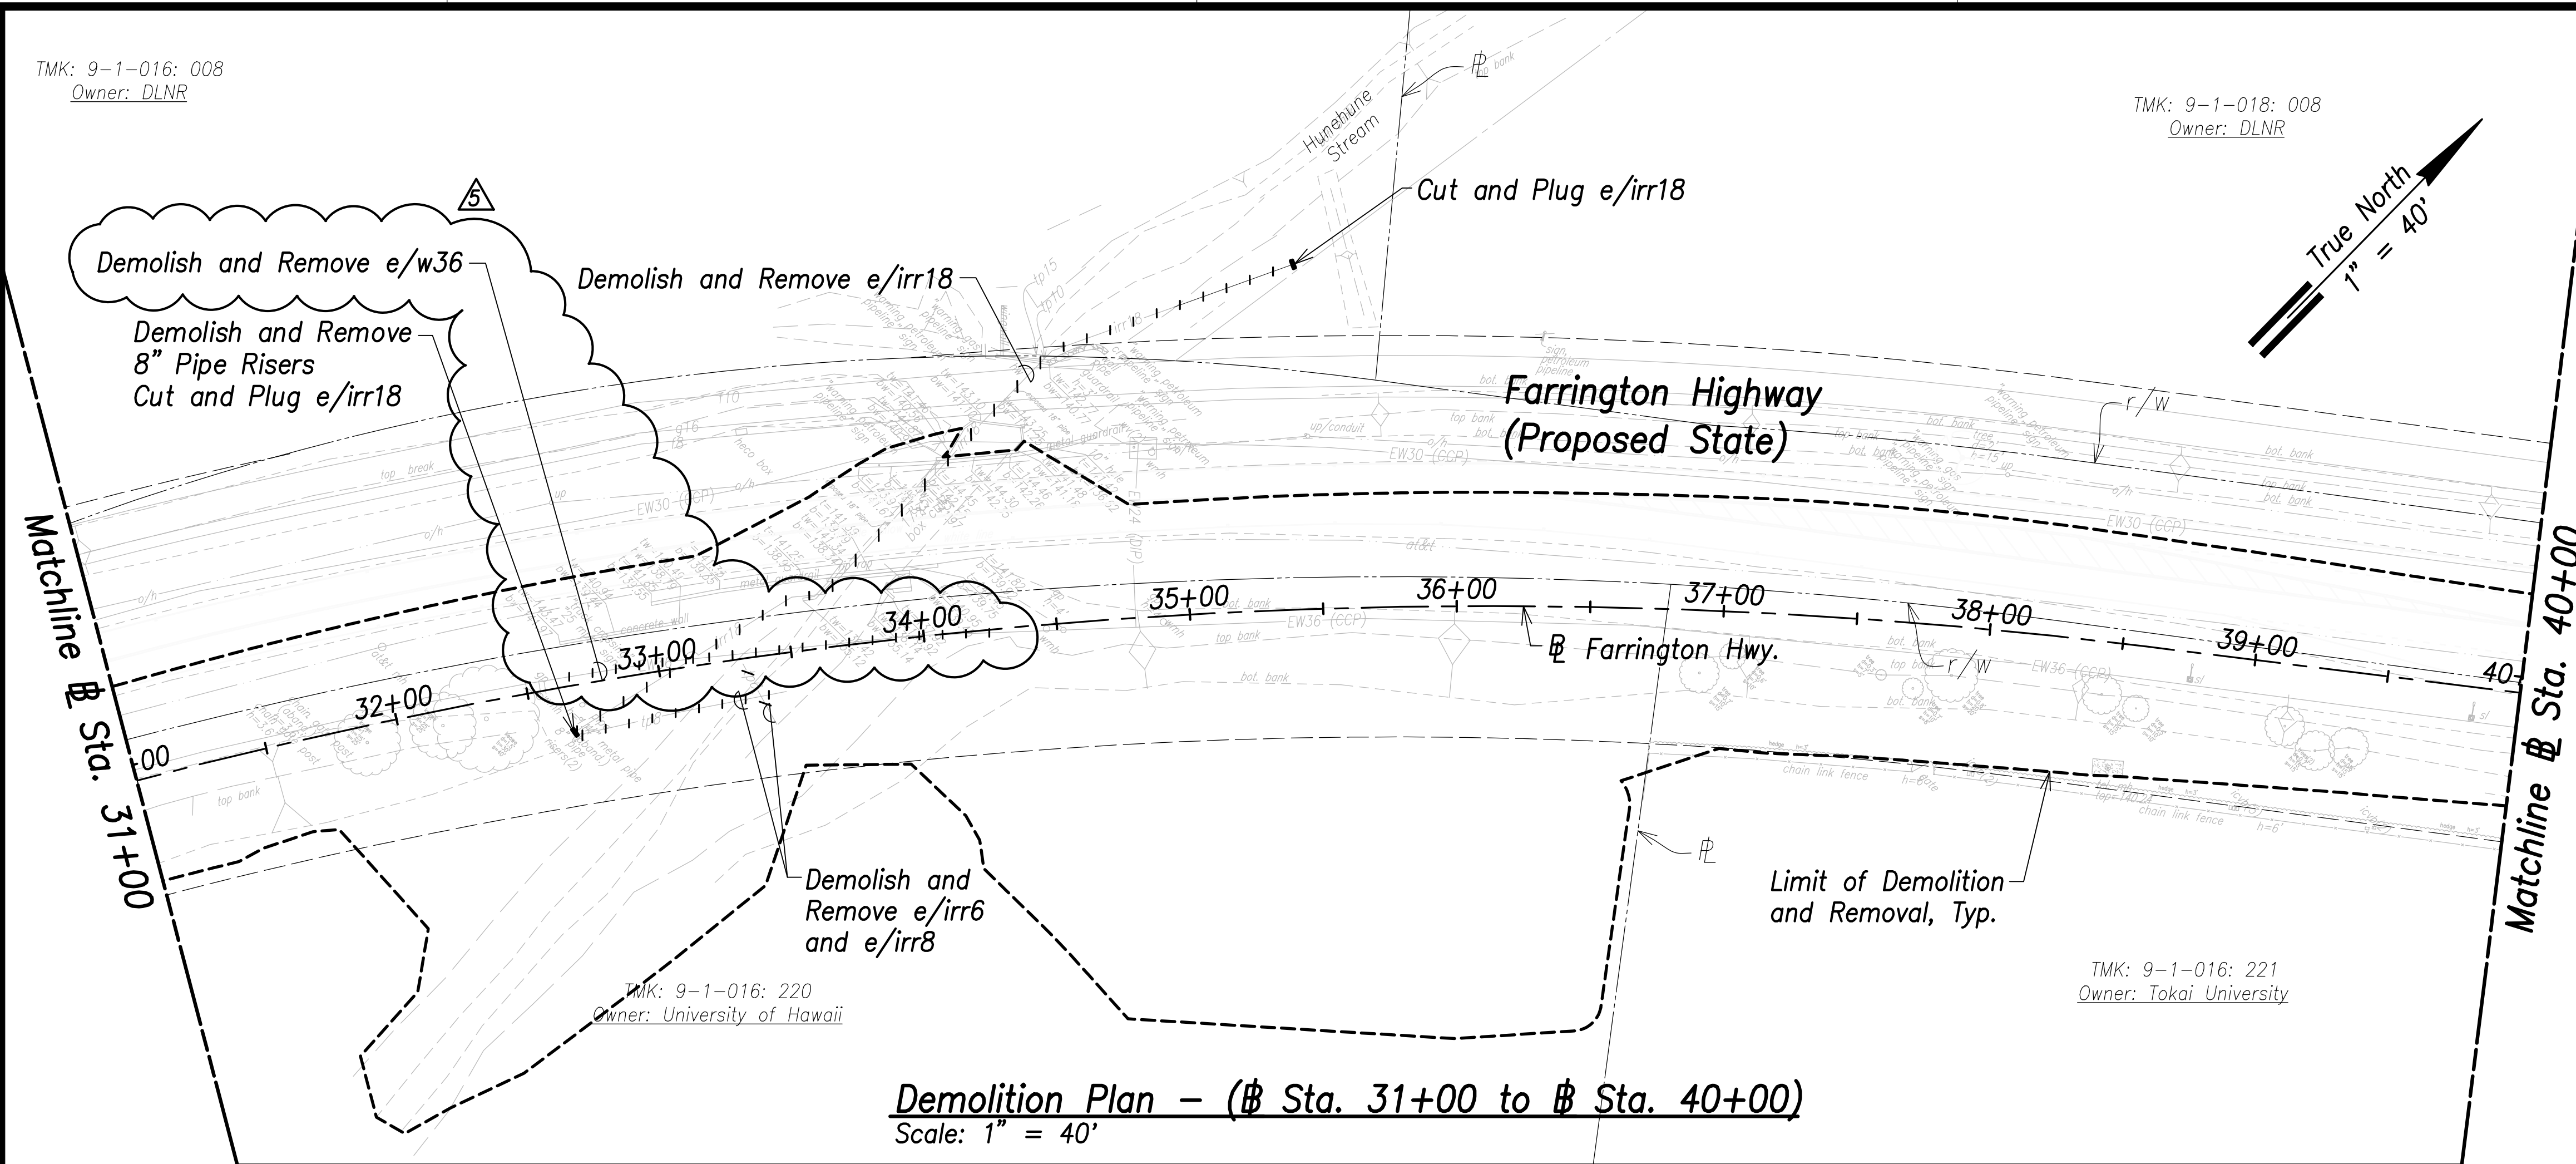

10. The Contractor Shall Comply With Traffic Notes on Sht. C-19.

**APPROVED:**  
 \_\_\_\_\_ DATE  
 Manager and Chief Engineer, BWS  
 (for work affecting BWS facilities in City/State R/W & BWS easements only)

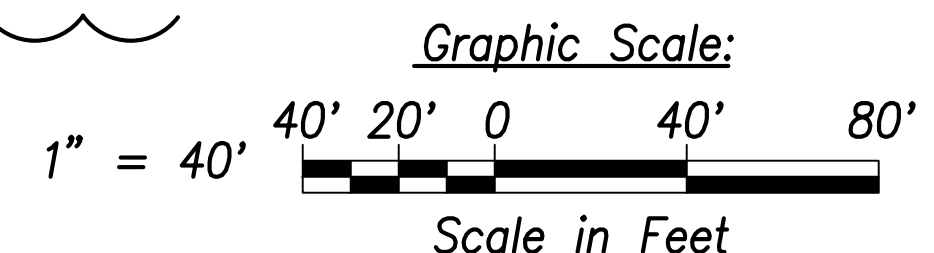

SURVEY PLOTTED BY	DATE
DRAWN BY	
TRACED BY	
QUANTITIES BY	
CHECKED BY	
ORIGINAL PLAN	
NOTE BOOK	
No.	



THIS WORK WAS PREPARED BY ME OR UNDER MY SUPERVISION AND CONSTRUCTION OF THIS PROJECT WILL BE UNDER MY OBSERVATION.  
 \_\_\_\_\_  
 SIGNATURE  
 APRIL 30, 2024  
 EXPIRATION DATE OF THE LICENSE

07/15/22	Revised demolition and signature block
DATE	REVISION

**STATE OF HAWAII**  
**DEPARTMENT OF TRANSPORTATION**  
**HIGHWAYS DIVISION**

**Demolition Plan**  
**Sta. 31+00 to Sta. 49+00**  
**FARRINGTON HIGHWAY WIDENING**  
**Kapolei Golf Course Road to Fort Weaver Road**  
**Project No. 7101A-01-20**

Scale: As Shown Date: April 2022

**SHEET NO. C-34 OF 767 SHEETS**










FED. ROAD DIST. NO.	STATE	PROJ. NO.	FISCAL YEAR	SHEET NO.	TOTAL SHEETS
HAWAII	HAW.	7101A-01-20	2021	37	767

- Notes:**
- All drainage structures, curbs, gutters, sidewalks, pavement, guardrails, striping, vegetation, posts, and signing shall be removed within the limit of demolition and removal.
  - See Structural Drawings for Demolition and Removal of Bridge Deck and Structural Members.
  - Remove by grinding pavement striping, to avoid conflicts with existing striping. See Signing and Marking Plans.
  - For Demolition of Electrical and Telecommunication Utilities and Structures, Refer to Electrical Site Demolition Plans. The Contractor is Responsible for Coordinating all Electrical Work with Respective Utility Companies.
  - The Contractor Shall Ensure Demolition and Removal Work of Contaminated Materials is Done in Compliance with the State Department of Health and Federal Environmental Protection Agency Guidelines.
  - The Contractor shall coordinate all work with impacted utility owners and ensure continuous access.
  - Service shall be maintained at all times to impacted utilities. No interruption in service will be allowed. The contractor shall phase work to allow for continuous utility service.
  - All Water, Sewer, Fuel, and Gas Systems Shall Remain Undisturbed Unless Indicated For Demolition.
  - The Contractor shall reconstruct tops of all existing utility manholes, valve boxes, meter boxes and structures that are remaining in service and contained within the project area flush with the finished grade.
  - The Contractor Shall Comply With Traffic Notes on Sht. C-19.

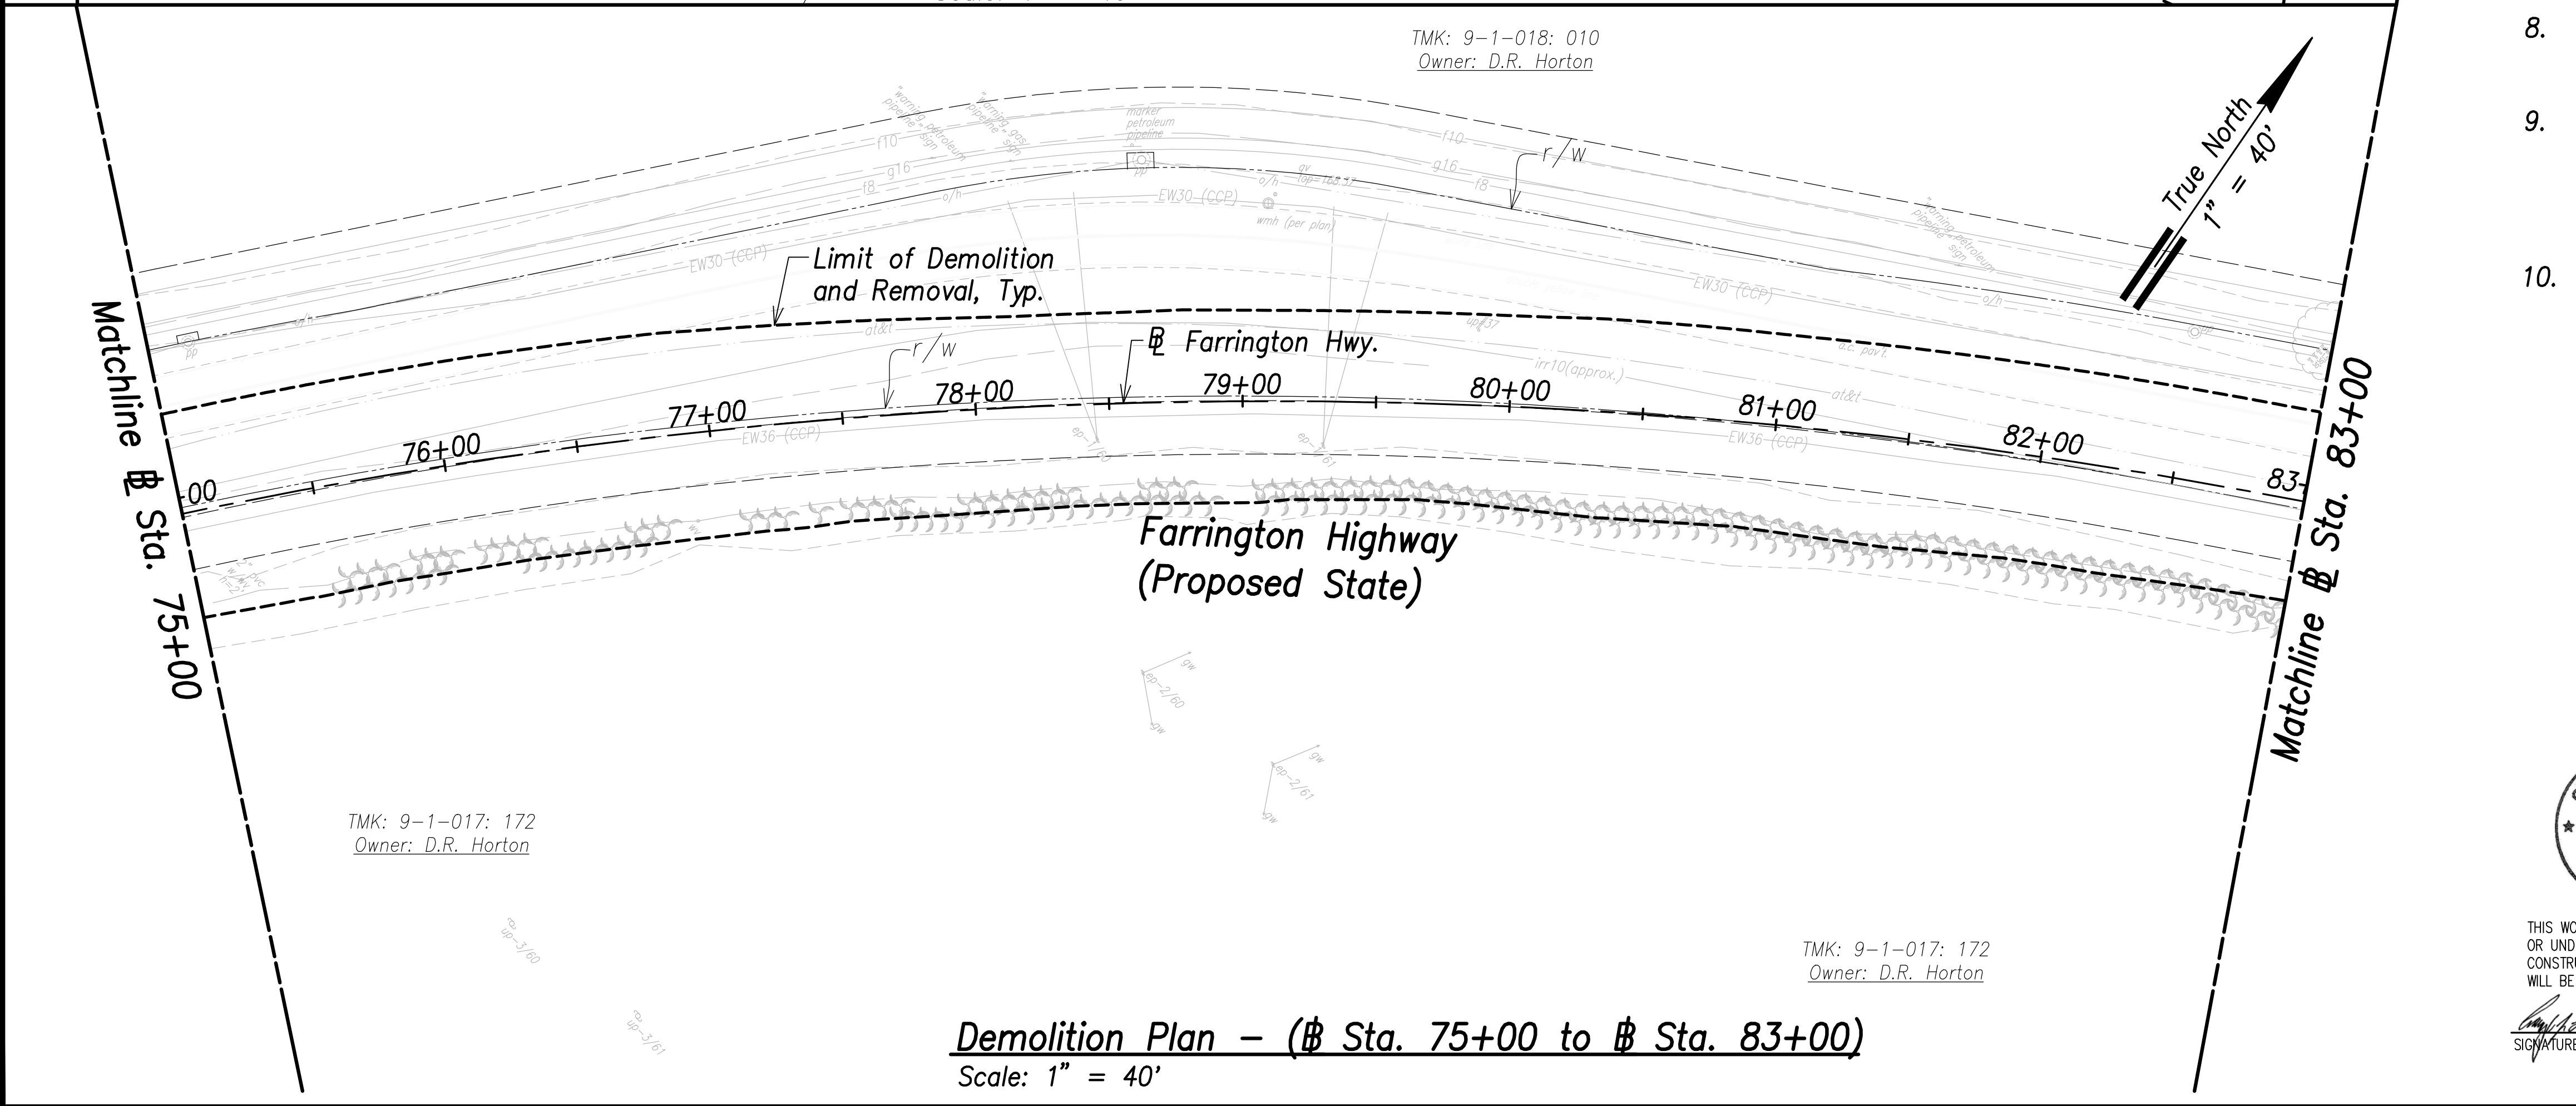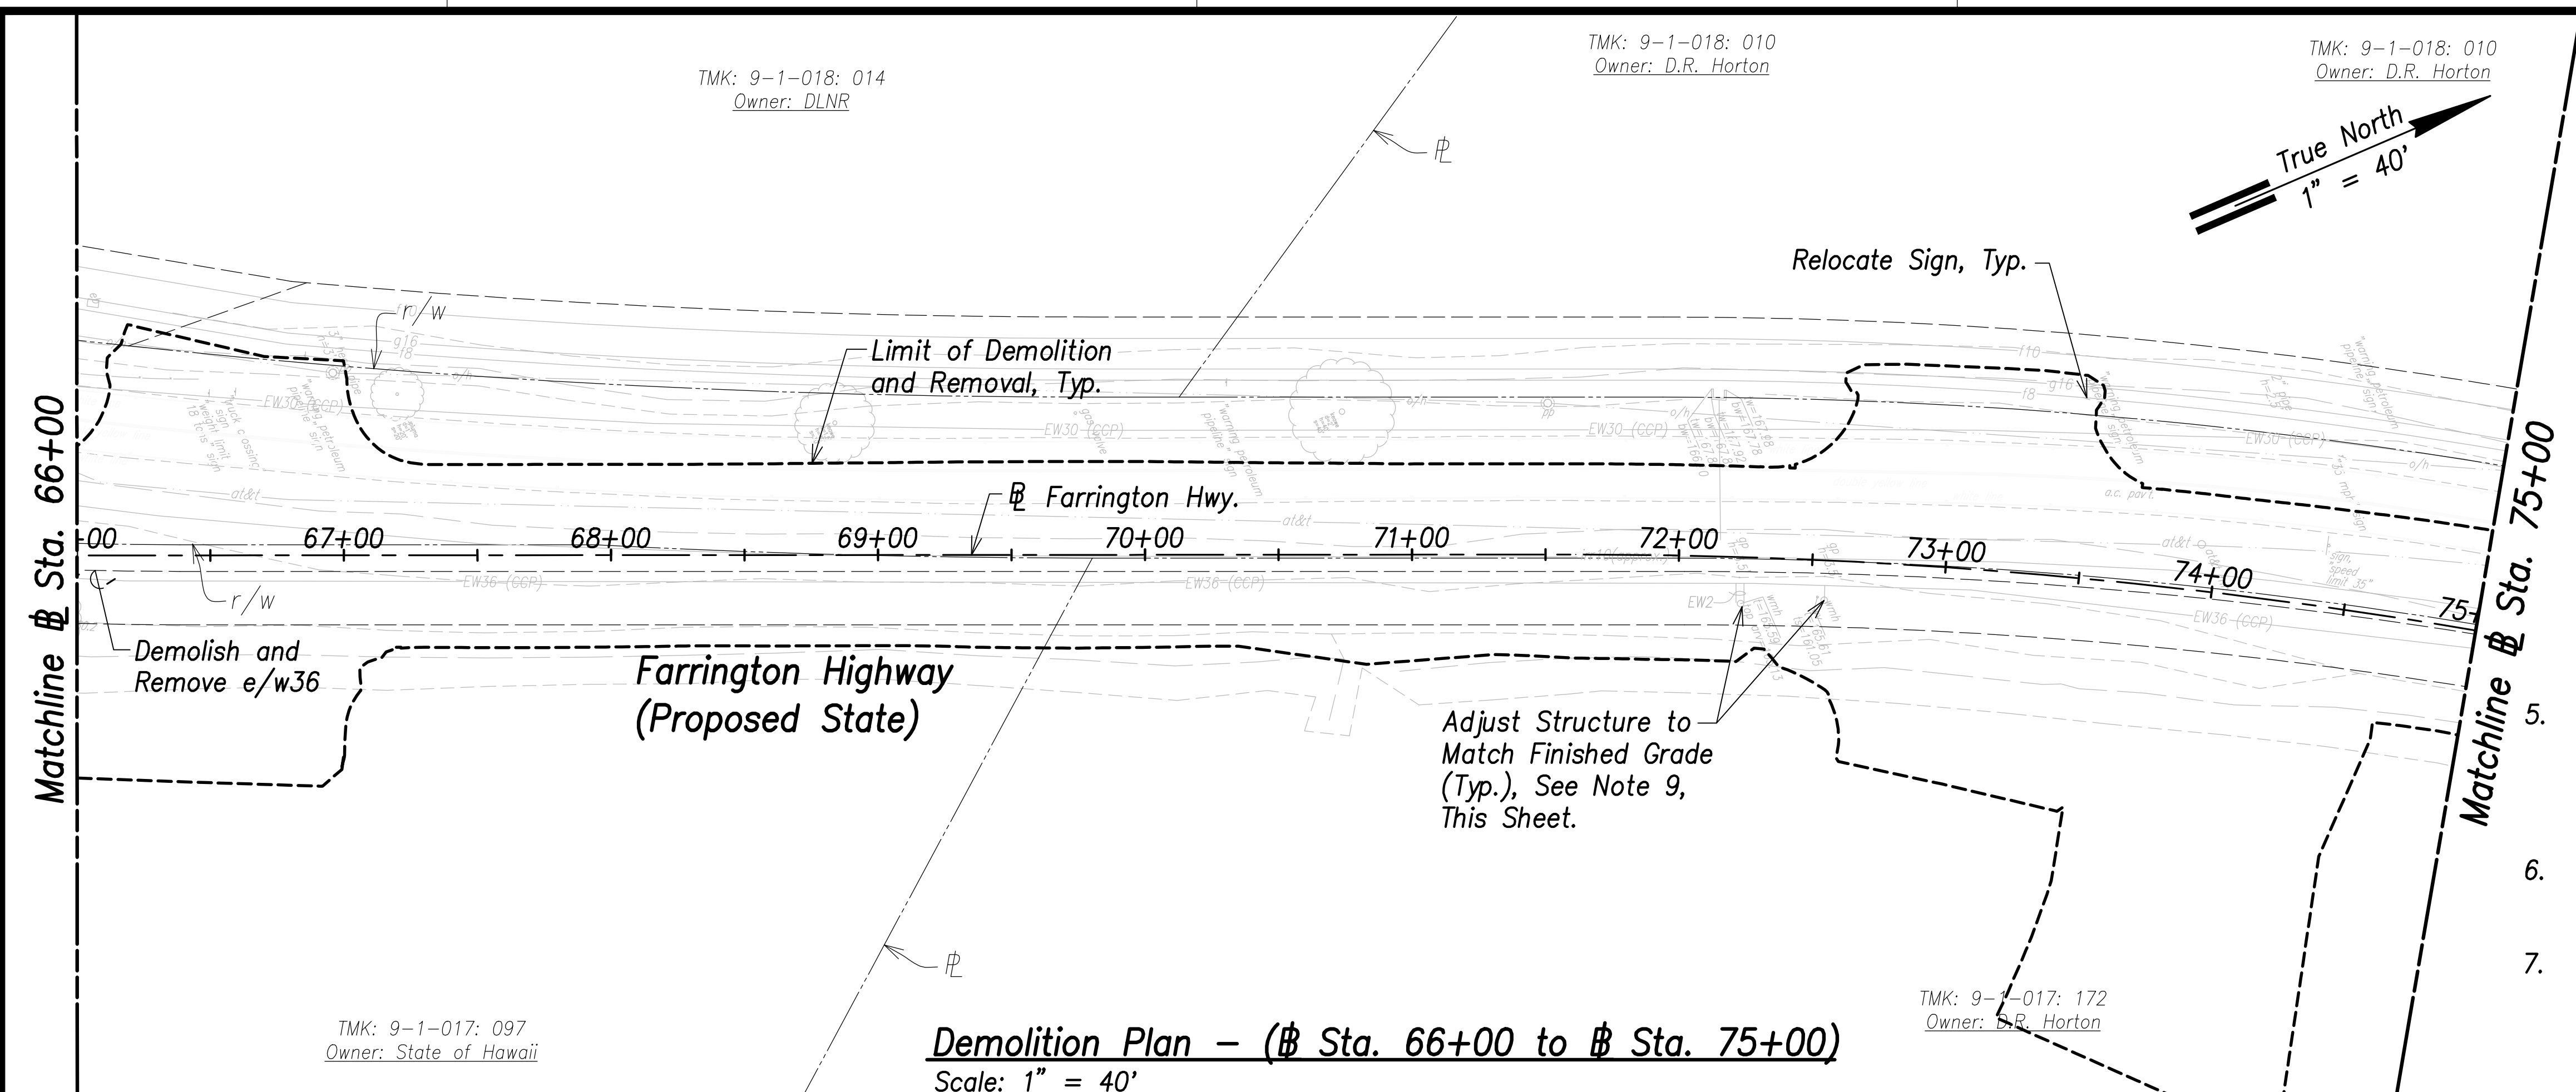

APPROVED:

Manager and Chief Engineer, BWS \_\_\_\_\_ DATE \_\_\_\_\_  
(for work affecting BWS facilities in City/State R/W & BWS easements only)

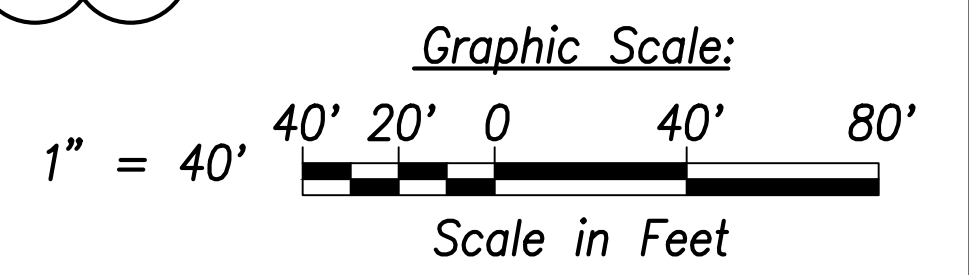

07/15/22	Signature Block Revised
DATE	REVISION



THIS WORK WAS PREPARED BY ME OR UNDER MY SUPERVISION AND CONSTRUCTION OF THIS PROJECT WILL BE UNDER MY OBSERVATION.

Signature: \_\_\_\_\_  
EXPIRATION DATE OF THE LICENSE: April 30, 2024

STATE OF HAWAII  
DEPARTMENT OF TRANSPORTATION  
HIGHWAYS DIVISION

**Demolition Plan**  
Sta. 66+00 to Sta. 83+00


FARRINGTON HIGHWAY WIDENING  
Kapolei Golf Course Road to Fort Weaver Road  
Project No. 7101A-01-20

Scale: As Shown Date: April 2022


SURVEY PLOTTED BY: _____	DATE: _____
DRAWN BY: _____	
TRACED BY: _____	
QUANTITIES BY: _____	
CHECKED BY: _____	
ORIGINAL PLAN NOTE BOOK No. _____	

FILE: K:\civil\23146 Farrington Hwy Widening\Draw\Construction\Draw\C-36 Demolition Plan - Sta. 66+00 to 83+00.dwg saved July 8, 2022


FED. ROAD DIST. NO.	STATE	PROJ. NO.	FISCAL YEAR	SHEET NO.	TOTAL SHEETS
HAWAII	HAW.	7101A-01-20	2021	38	767

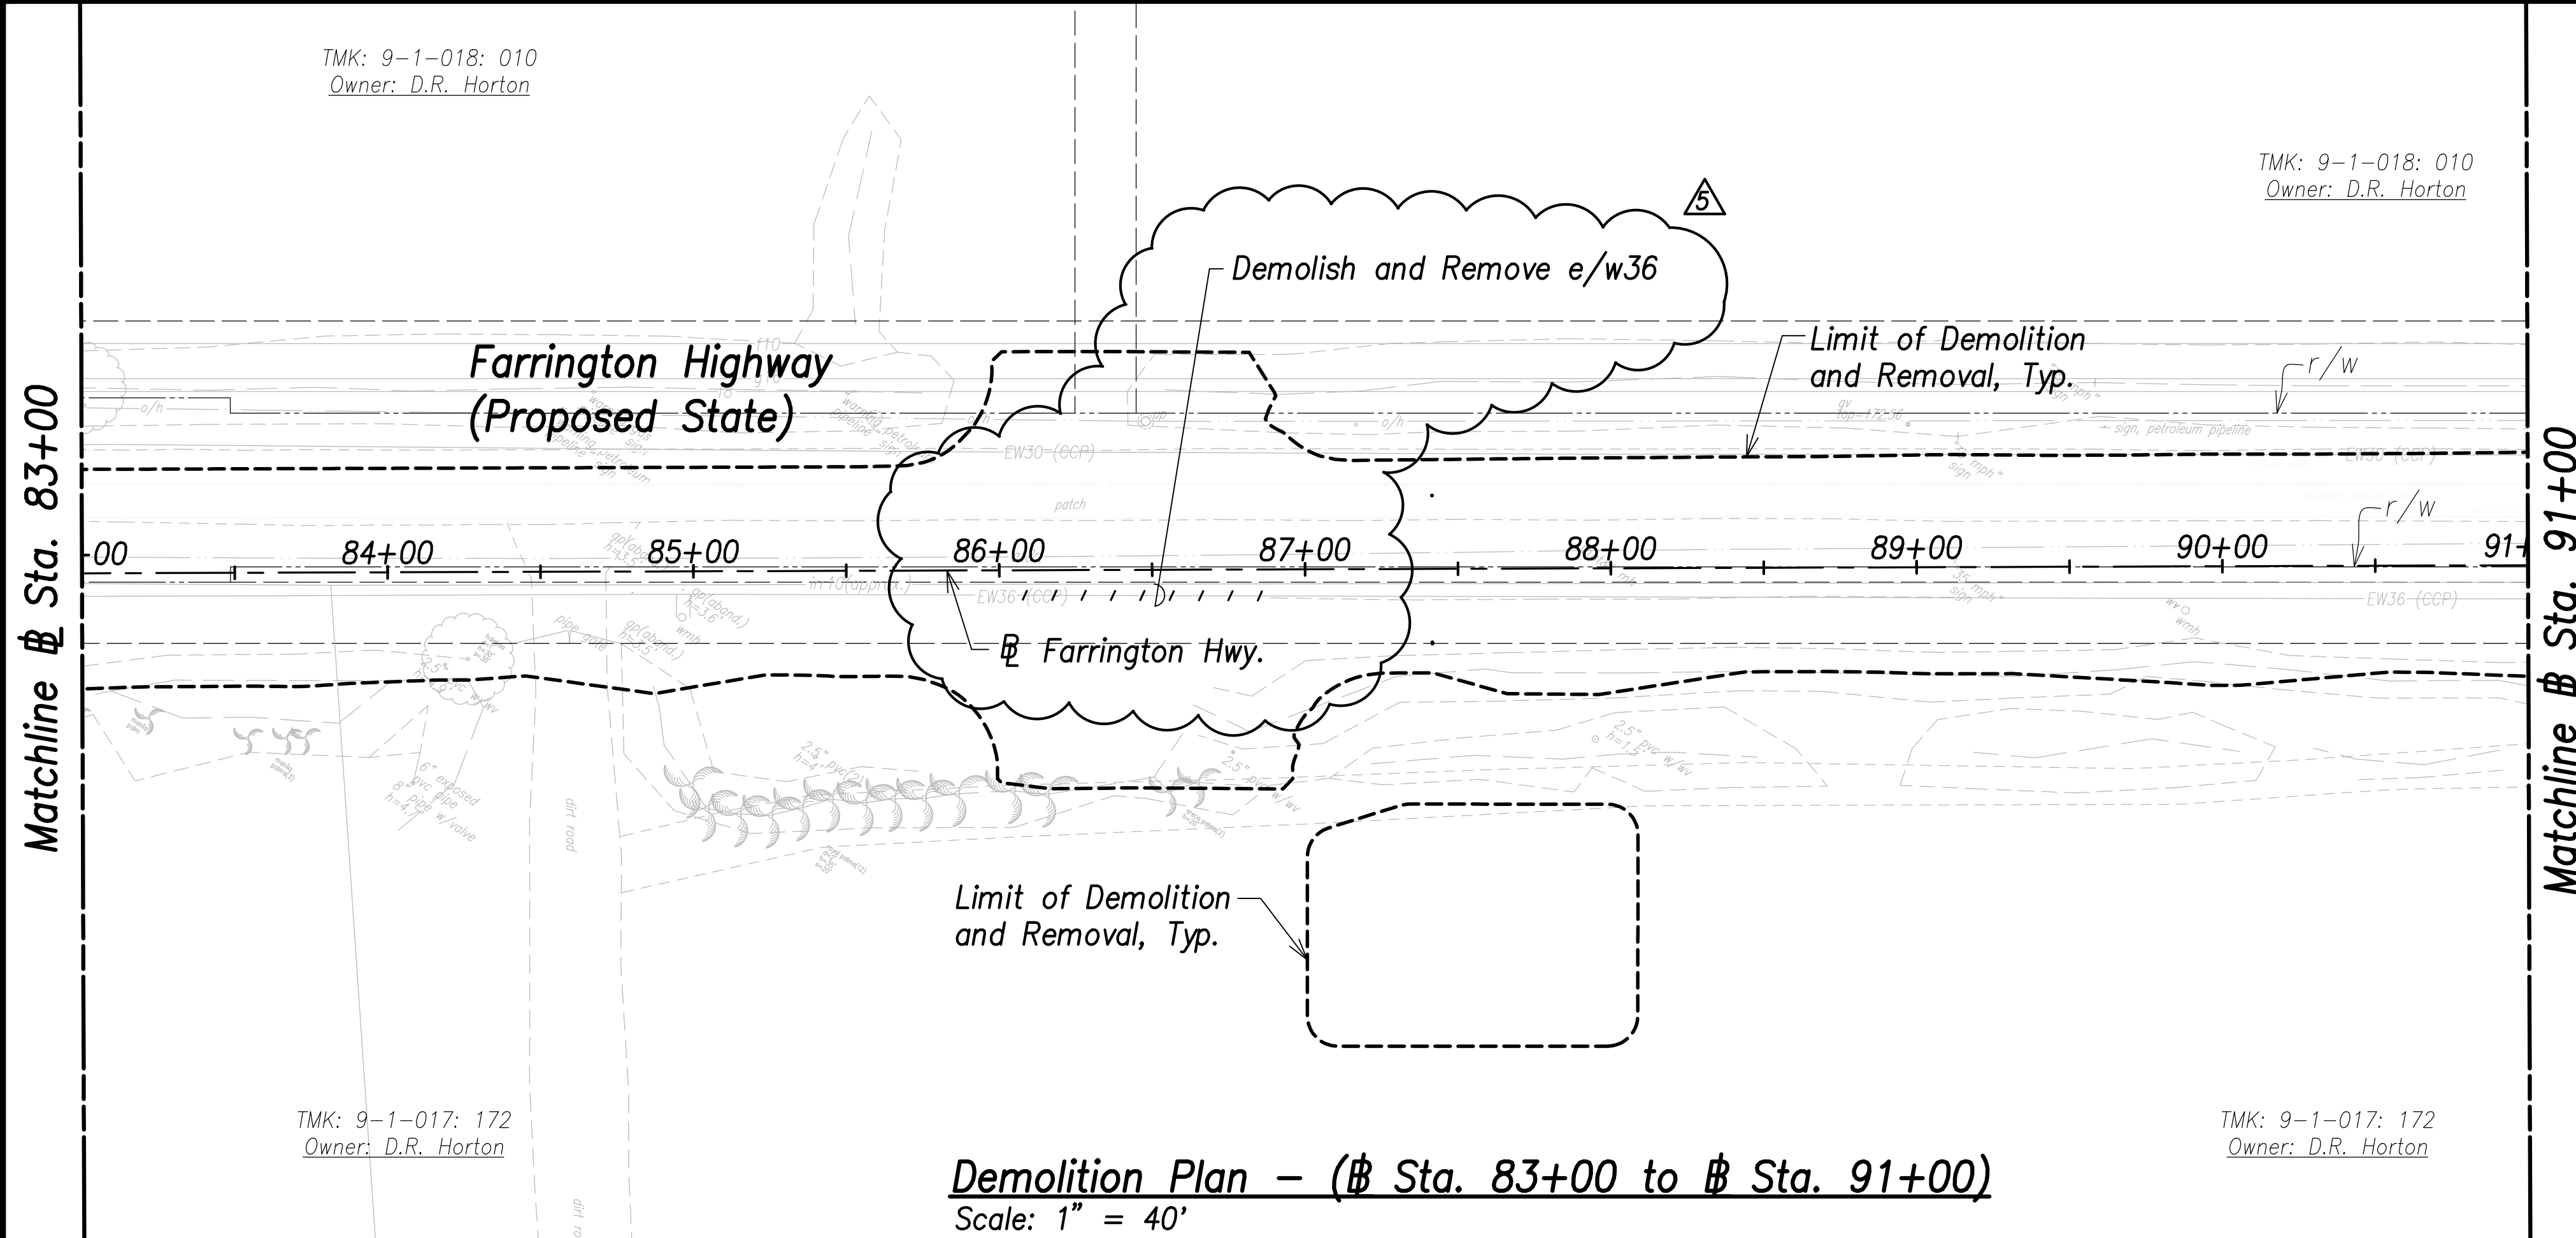

**Demolition Plan - (Sta. 83+00 to Sta. 91+00)**  
Scale: 1" = 40'

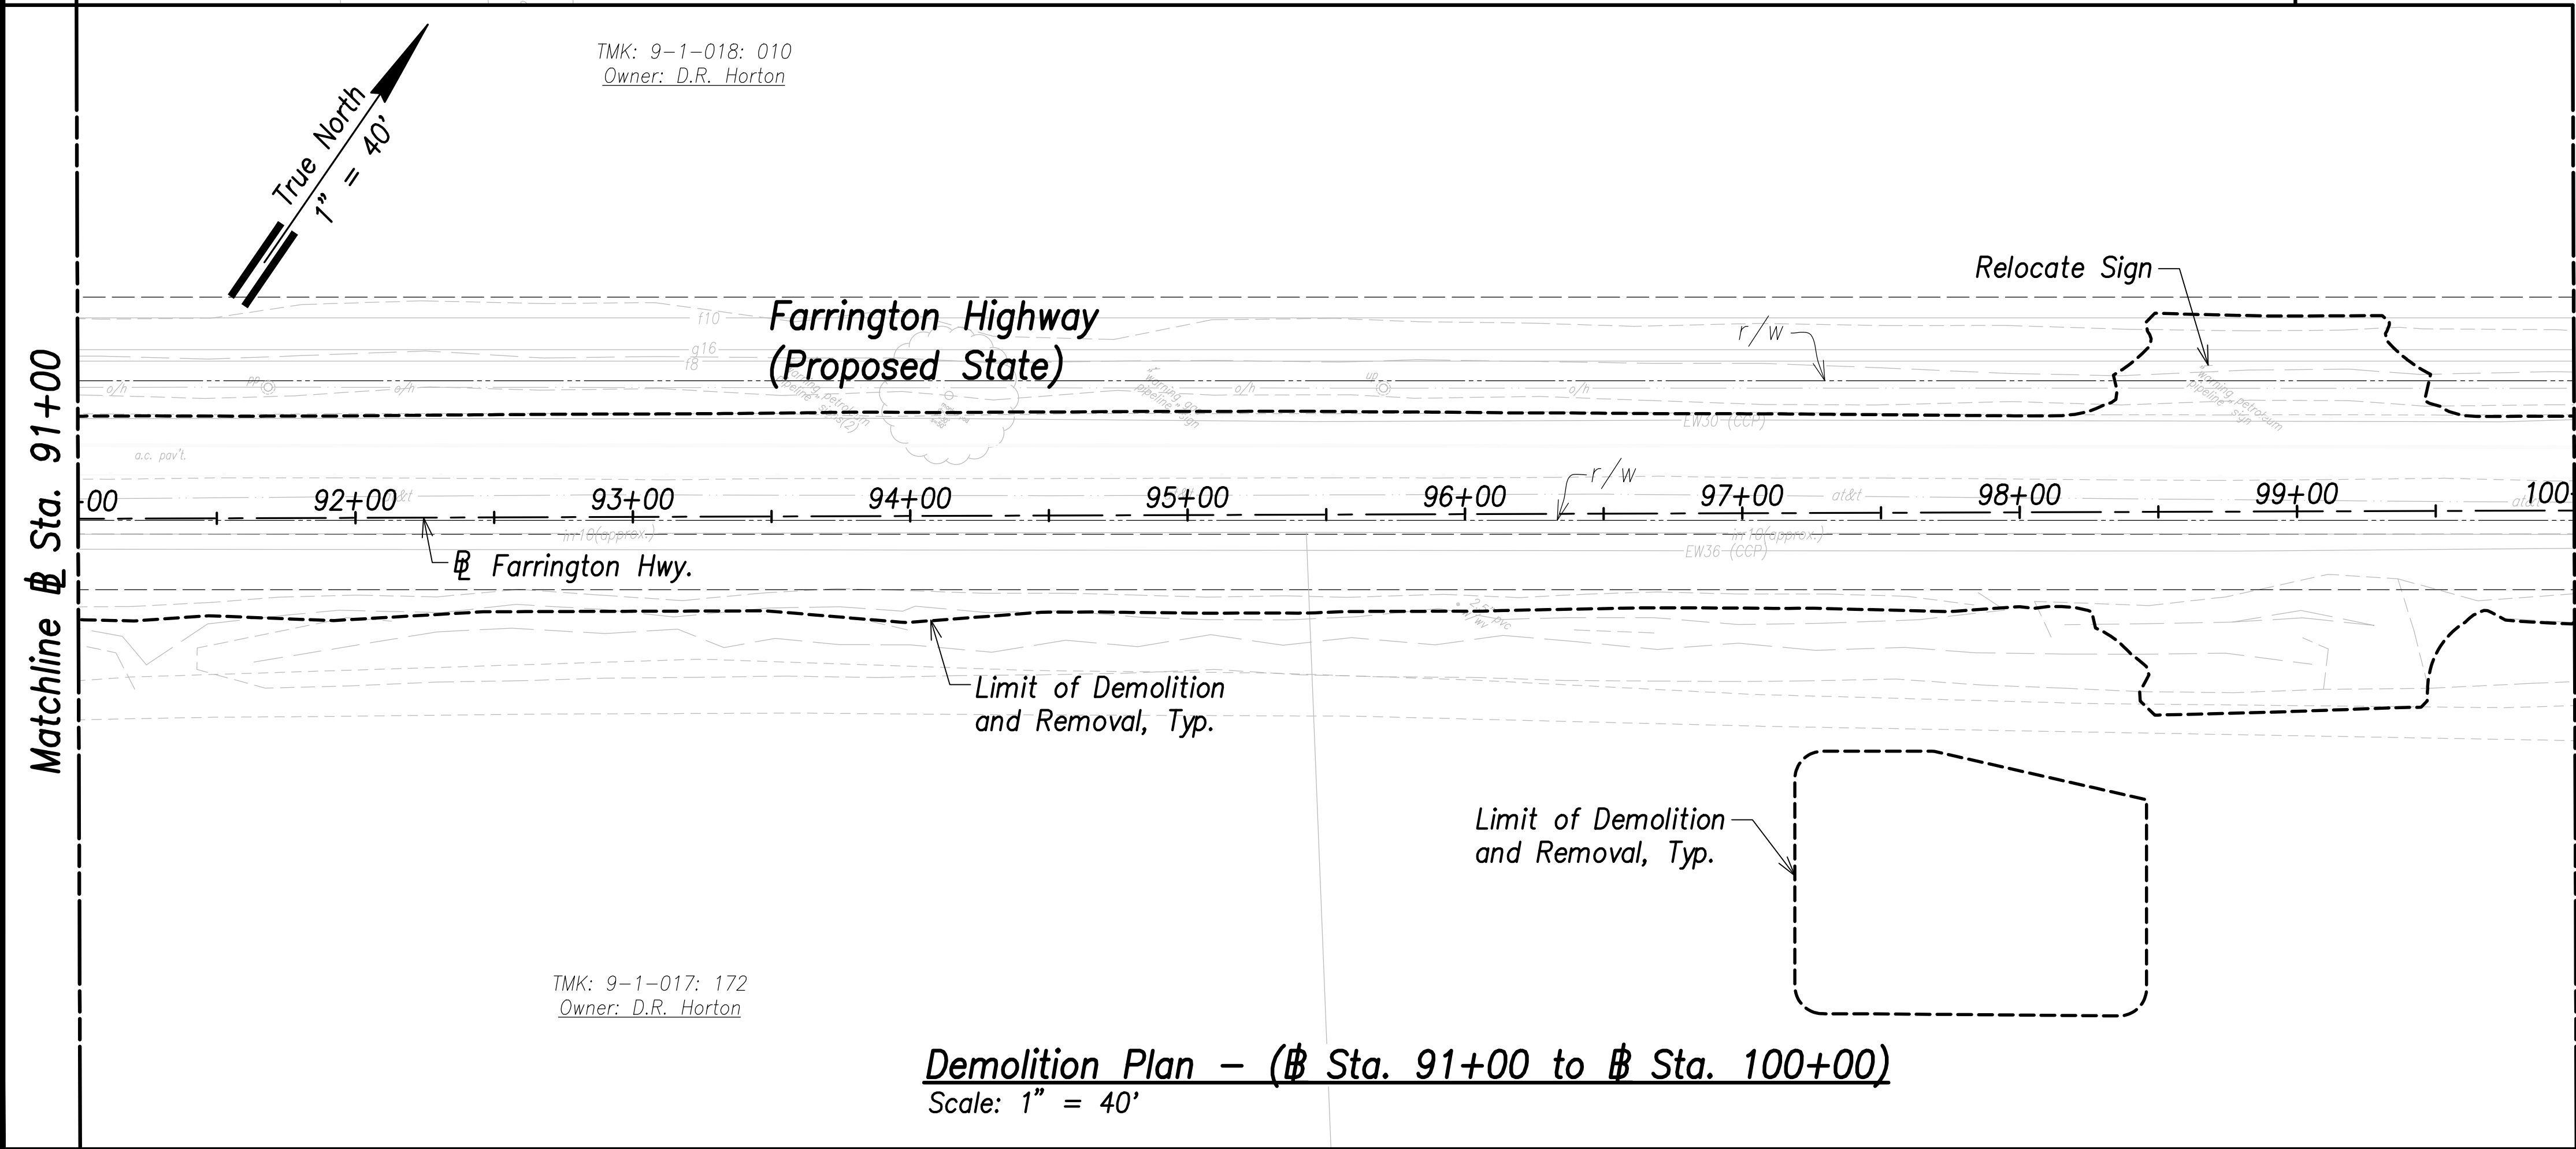


**Demolition Plan - (Sta. 91+00 to Sta. 100+00)**  
Scale: 1" = 40'

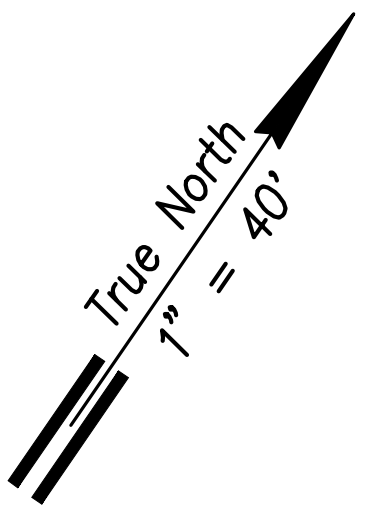

- Notes:**
- All drainage structures, curbs, gutters, sidewalks, pavement, guardrails, striping, vegetation, posts, and signing shall be removed within the limit of demolition and removal.
  - See Structural Drawings for Demolition and Removal of Bridge Deck and Structural Members.
  - Remove by grinding pavement striping, to avoid conflicts with existing striping. See Signing and Marking Plans.
  - For Demolition of Electrical and Telecommunication Utilities and Structures, Refer to Electrical Site Demolition Plans. The Contractor is Responsible for Coordinating all Electrical Work with Respective Utility Companies.
  - The Contractor Shall Ensure Demolition and Removal Work of Contaminated Materials is Done in Compliance with the State Department of Health and Federal Environmental Protection Agency Guidelines.
  - The Contractor shall coordinate all work with impacted utility owners and ensure continuous access.
  - Service shall be maintained at all times to impacted utilities. No interruption in service will be allowed. The contractor shall phase work to allow for continuous utility service.
  - All Water, Sewer, Fuel, and Gas Systems Shall Remain Undisturbed Unless Indicated For Demolition.
  - The Contractor shall reconstruct tops of all existing utility manholes, valve boxes, meter boxes and structures that are remaining in service and contained within the project area flush with the finished grade.
  - The Contractor Shall Comply With Traffic Notes on Sht. C-19.

APPROVED:  
 Manager and Chief Engineer, BWS \_\_\_\_\_ DATE \_\_\_\_\_  
 (for work affecting BWS facilities in City/State R/W & BWS easements only)

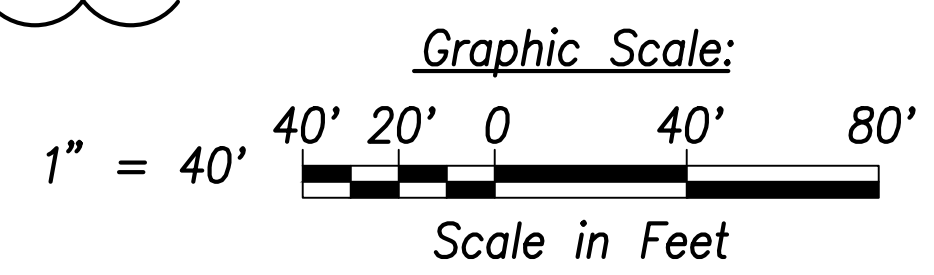

DATE	REVISION
07/15/22	Revised demolition and signature block



THIS WORK WAS PREPARED BY ME OR UNDER MY SUPERVISION AND CONSTRUCTION OF THIS PROJECT WILL BE UNDER MY OBSERVATION.  
 Signature: \_\_\_\_\_ April 30, 2024  
 EXPIRATION DATE OF THE LICENSE

STATE OF HAWAII  
**DEPARTMENT OF TRANSPORTATION**  
 HIGHWAYS DIVISION

**Demolition Plan**  
**Sta. 83+00 to Sta. 100+00**  
 FARRINGTON HIGHWAY WIDENING  
 Kapolei Golf Course Road to Fort Weaver Road  
 Project No. 7101A-01-20


Scale: As Shown Date: April 2022

DATE	BY
	SURVEY PLOTTED BY
	DRAWN BY
	TRACED BY
	CHECKED BY
	DATE
	NO.




FED. ROAD DIST. NO.	STATE	PROJ. NO.	FISCAL YEAR	SHEET NO.	TOTAL SHEETS
HAWAII	HAW.	7101A-01-20	2021	39	767

- Notes:**
- All drainage structures, curbs, gutters, sidewalks, pavement, guardrails, striping, vegetation, posts, and signing shall be removed within the limit of demolition and removal.
  - See Structural Drawings for Demolition and Removal of Bridge Deck and Structural Members.
  - Remove by grinding pavement striping, to avoid conflicts with existing striping. See Signing and Marking Plans.
  - For Demolition of Electrical and Telecommunication Utilities and Structures, Refer to Electrical Site Demolition Plans. The Contractor is Responsible for Coordinating all Electrical Work with Respective Utility Companies.
  - The Contractor Shall Ensure Demolition and Removal Work of Contaminated Materials is Done in Compliance with the State Department of Health and Federal Environmental Protection Agency Guidelines.
  - The Contractor shall coordinate all work with impacted utility owners and ensure continuous access.
  - Service shall be maintained at all times to impacted utilities. No interruption in service will be allowed. The contractor shall phase work to allow for continuous utility service.
  - All Water, Sewer, Fuel, and Gas Systems Shall Remain Undisturbed Unless Indicated For Demolition.
  - The Contractor shall reconstruct tops of all existing utility manholes, valve boxes, meter boxes and structures that are remaining in service and contained within the project area flush with the finished grade.
  - The Contractor Shall Comply With Traffic Notes on Sht. C-19.

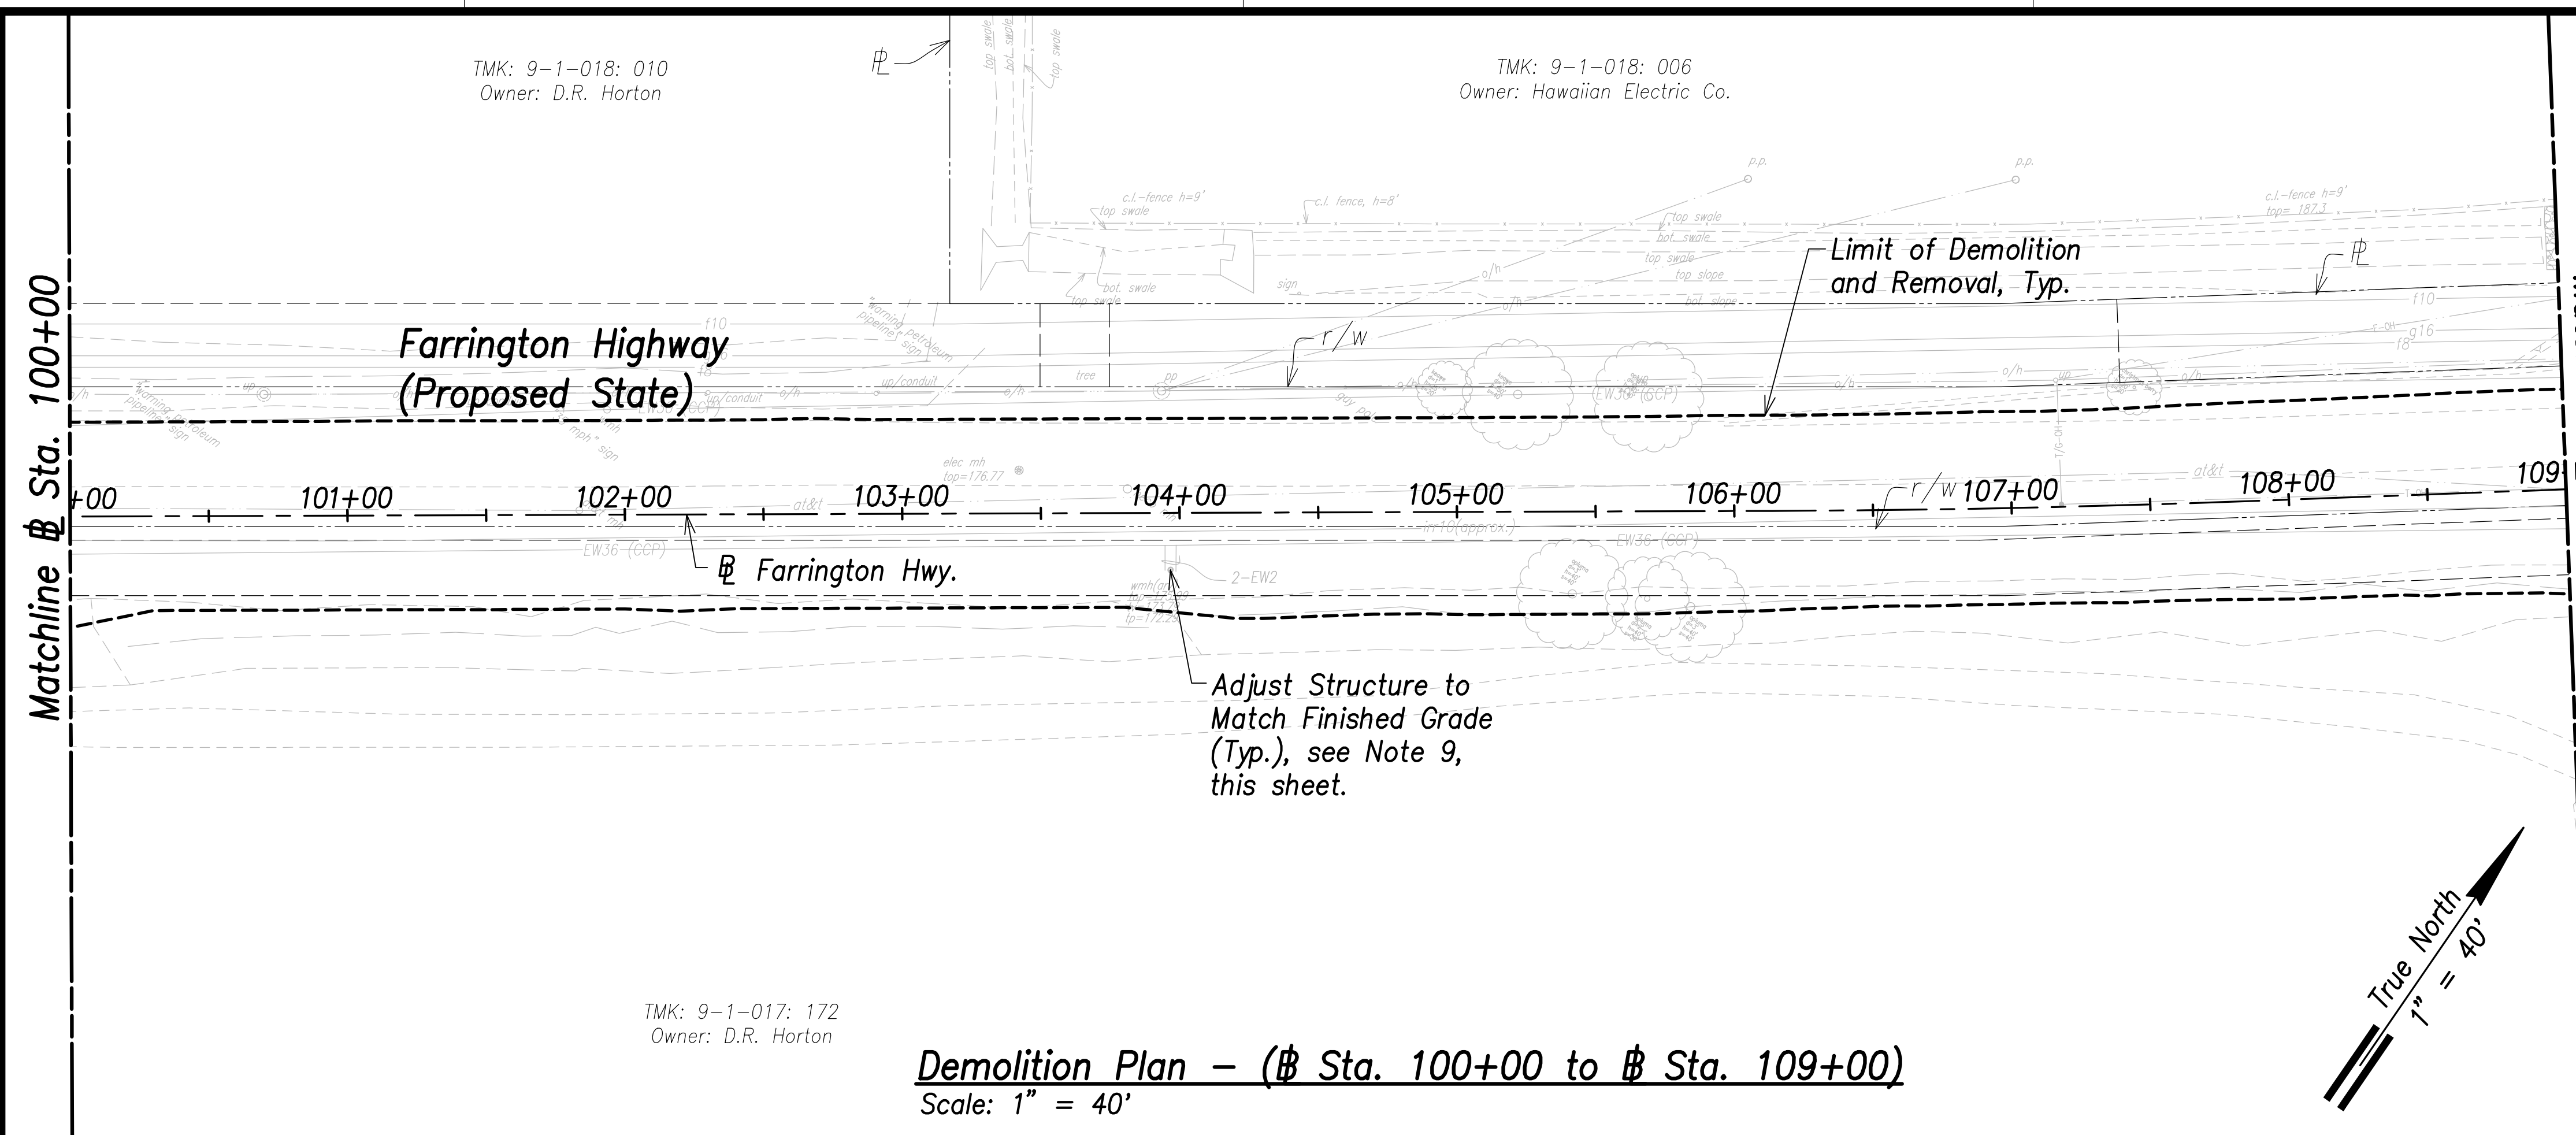


**Demolition Plan - (Sta. 100+00 to Sta. 109+00)**  
Scale: 1" = 40'

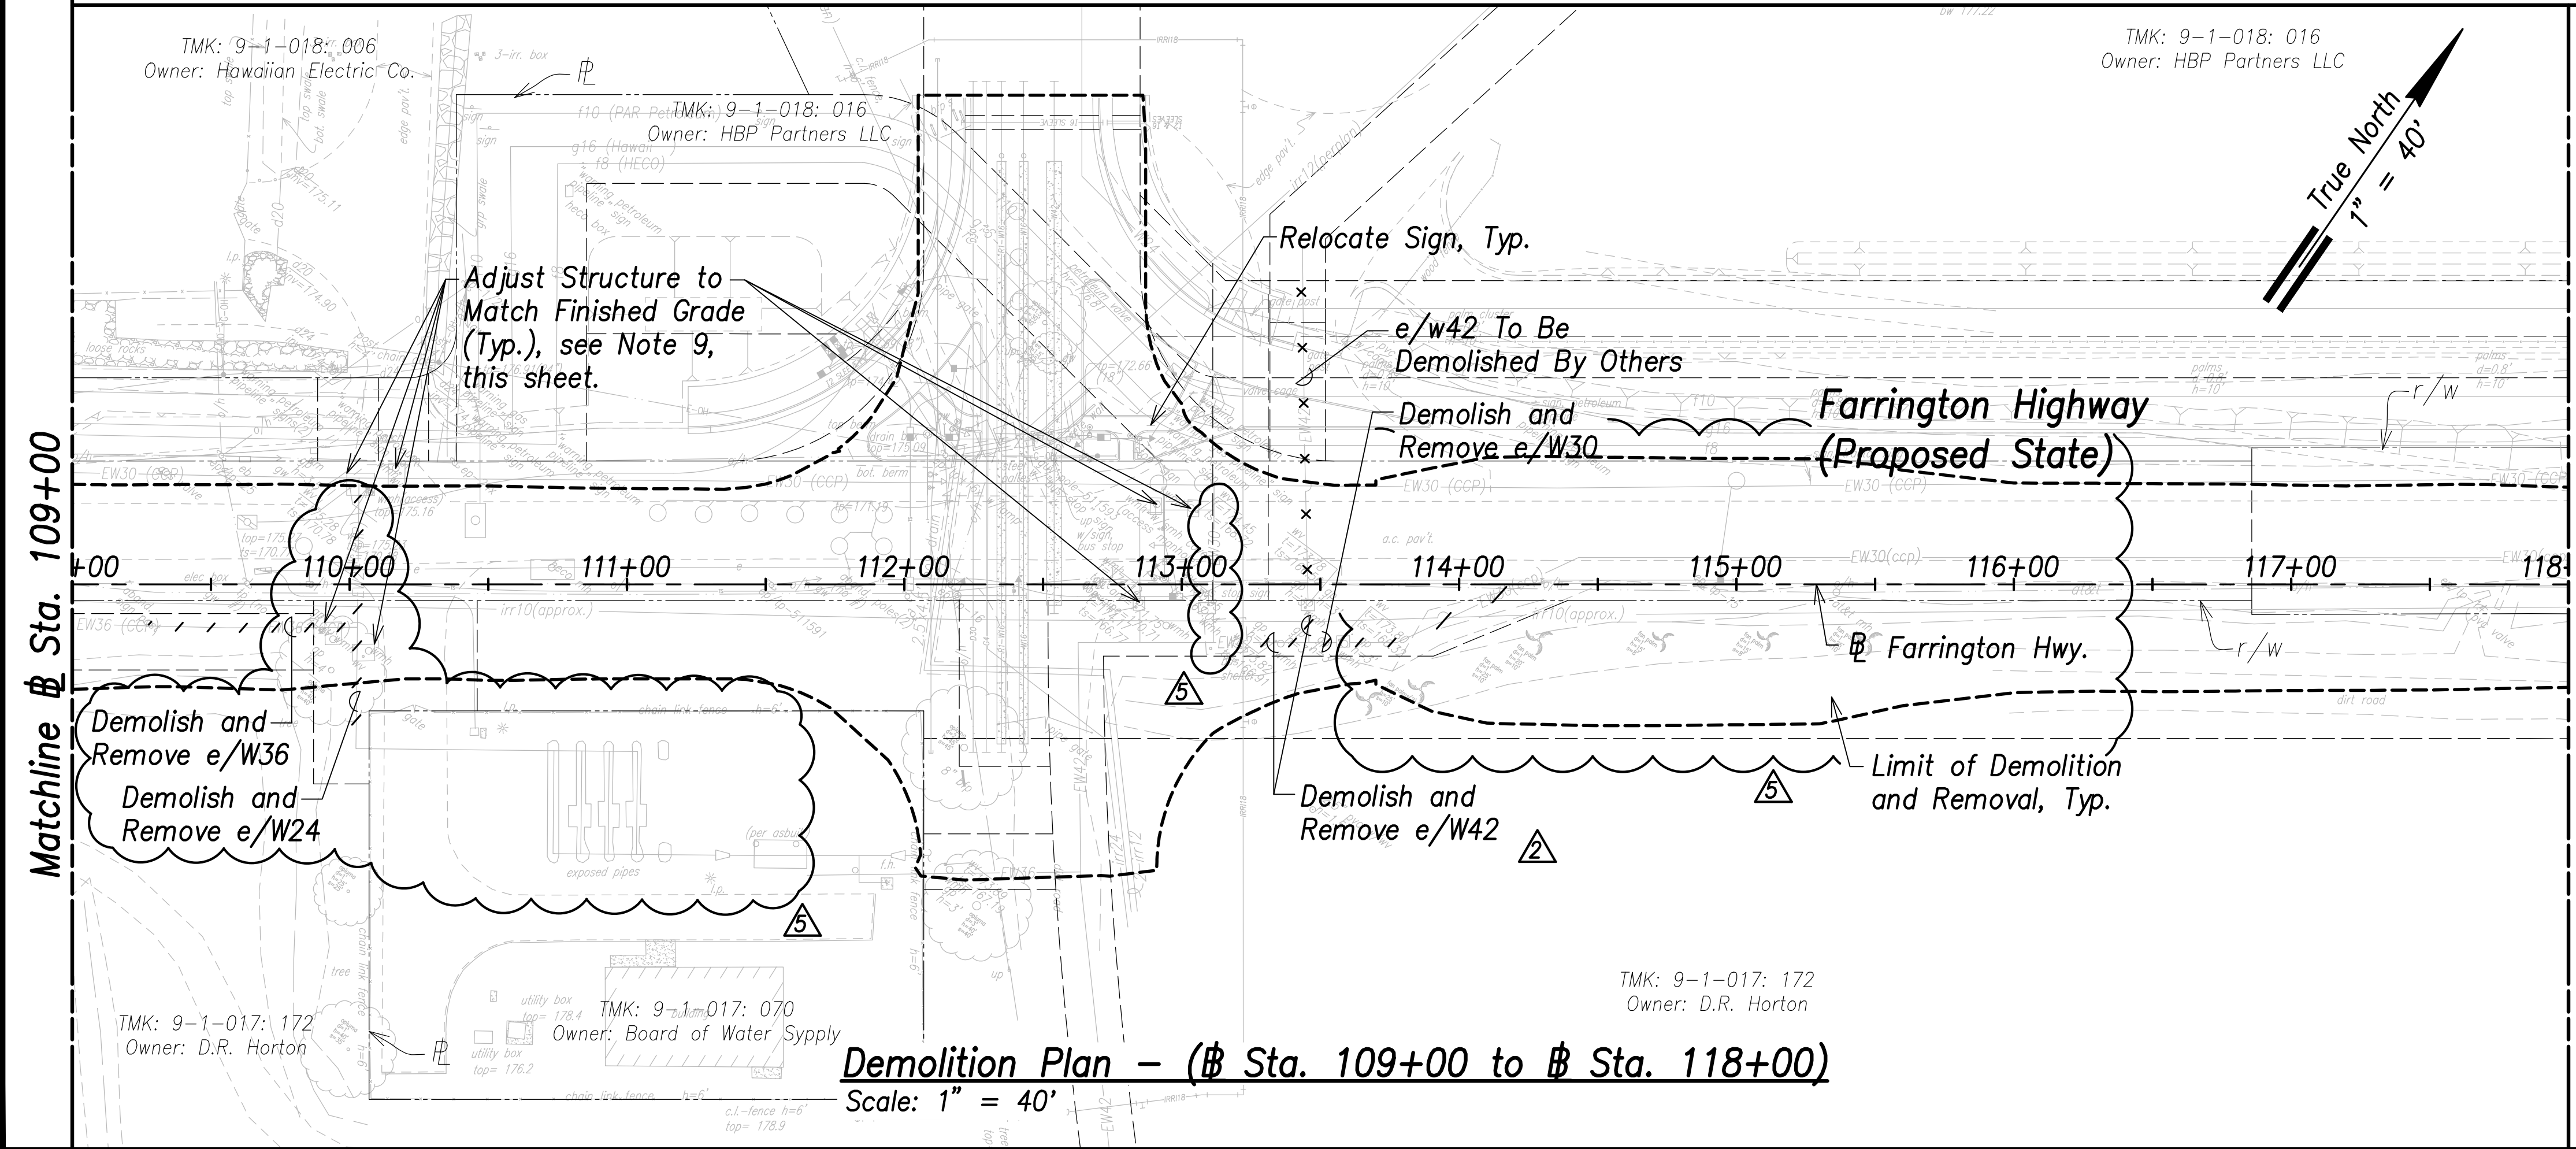

**Demolition Plan - (Sta. 109+00 to Sta. 118+00)**  
Scale: 1" = 40'

DATE	
SURVEY PLOTTED BY	
DRAWN BY	
TRACED BY	
QUANTITIES BY	
CHECKED BY	
ORIGINAL PLAN	
NOTE BOOK	
No.	

APPROVED:  
 Manager and Chief Engineer, BWS DATE  
 (for work affecting BWS facilities in City/State R/W & BWS easements only)

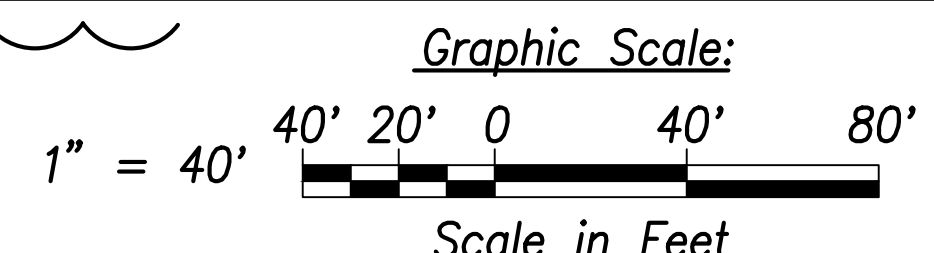

DATE	REVISION
07/15/22	Signature Block, Limit, and Callouts Revised
06/08/22	Added Waterline Demolition



THIS WORK WAS PREPARED BY ME OR UNDER MY SUPERVISION AND CONSTRUCTION OF THIS PROJECT WILL BE UNDER MY OBSERVATION.  
 SIGNATURE: [Signature] EXPIRATION DATE OF THE LICENSE: April 30, 2024

STATE OF HAWAII  
 DEPARTMENT OF TRANSPORTATION  
 HIGHWAYS DIVISION

**Demolition Plan**  
 Sta. 100+00 to Sta. 118+00  
 FARRINGTON HIGHWAY WIDENING  
 Kapolei Golf Course Road to Fort Weaver Road  
 Project No. 7101A-01-20

Scale: As Shown Date: April 2022



SHEET No. C-38 OF 767 SHEETS





FED. ROAD DIST. NO.	STATE	PROJ. NO.	FISCAL YEAR	SHEET NO.	TOTAL SHEETS
HAWAII	HAW.	7101A-01-20	2021	41	767


- Notes:**
- All drainage structures, curbs, gutters, sidewalks, pavement, guardrails, striping, vegetation, posts, and signing shall be removed within the limit of demolition and removal.
  - See Structural Drawings for Demolition and Removal of Bridge Deck and Structural Members.
  - Remove by grinding pavement striping, to avoid conflicts with existing striping. See Signing and Marking Plans.
  - For Demolition of Electrical and Telecommunication Utilities and Structures, Refer to Electrical Site Demolition Plans. The Contractor is Responsible for Coordinating all Electrical Work with Respective Utility Companies.
  - The Contractor Shall Ensure Demolition and Removal Work of Contaminated Materials is Done in Compliance with the State Department of Health and Federal Environmental Protection Agency Guidelines.
  - The Contractor shall coordinate all work with impacted utility owners and ensure continuous access.
  - Service shall be maintained at all times to impacted utilities. No interruption in service will be allowed. The contractor shall phase work to allow for continuous utility service.
  - All Water, Sewer, Fuel, and Gas Systems Shall Remain Undisturbed Unless Indicated For Demolition.
  - The Contractor shall reconstruct tops of all existing utility manholes, valve boxes, meter boxes and structures that are remaining in service and contained within the project area flush with the finished grade.
  - The Contractor Shall Comply With Traffic Notes on Sht. C-19.

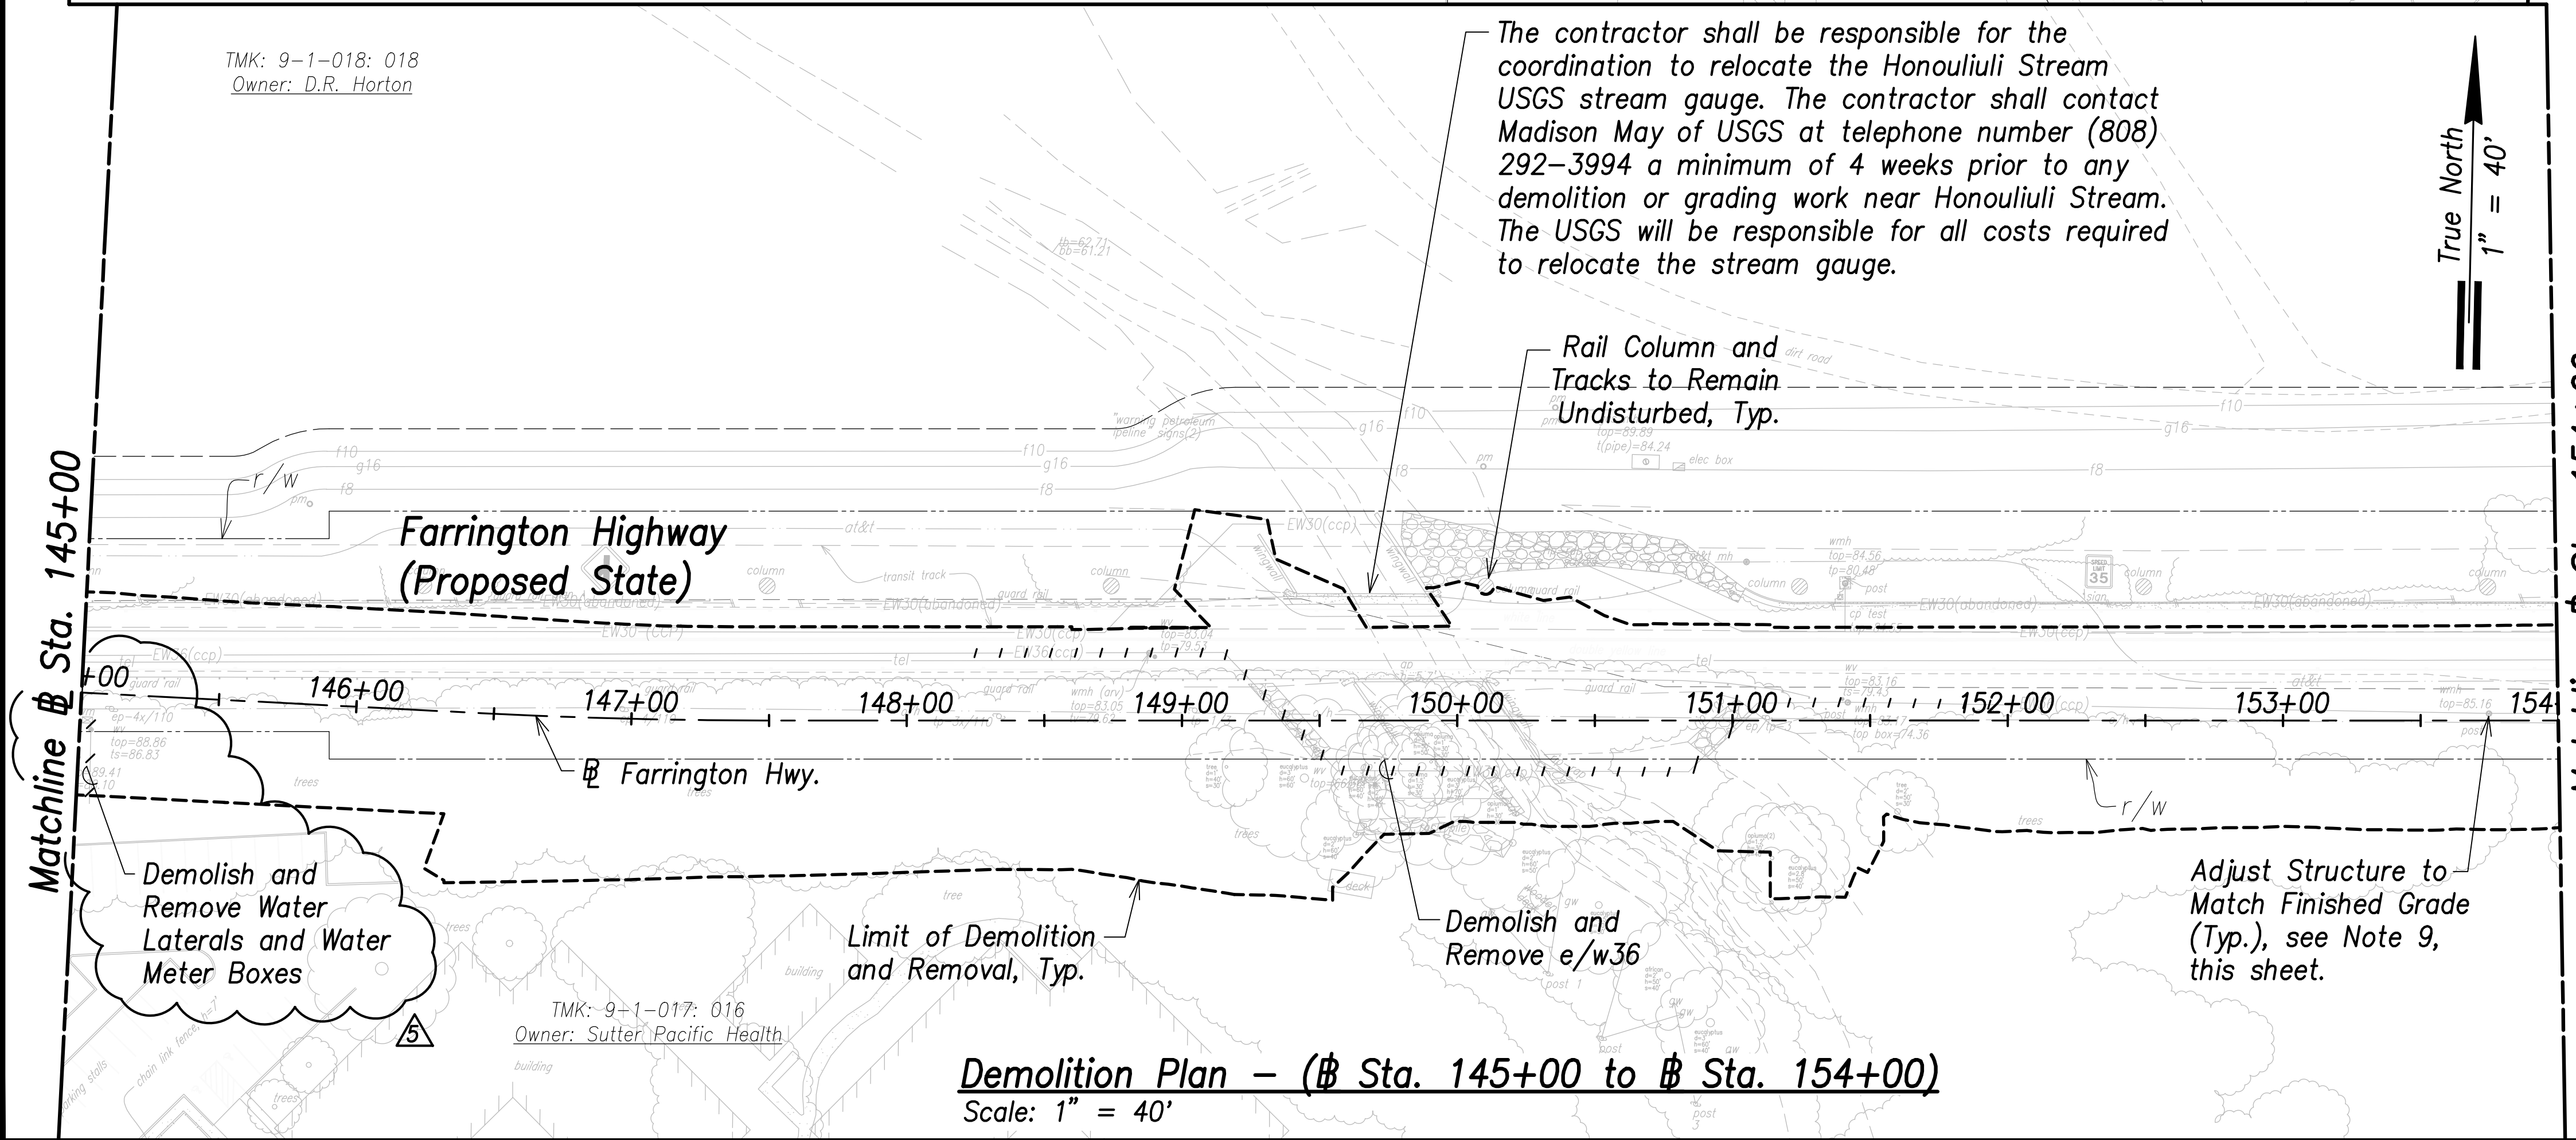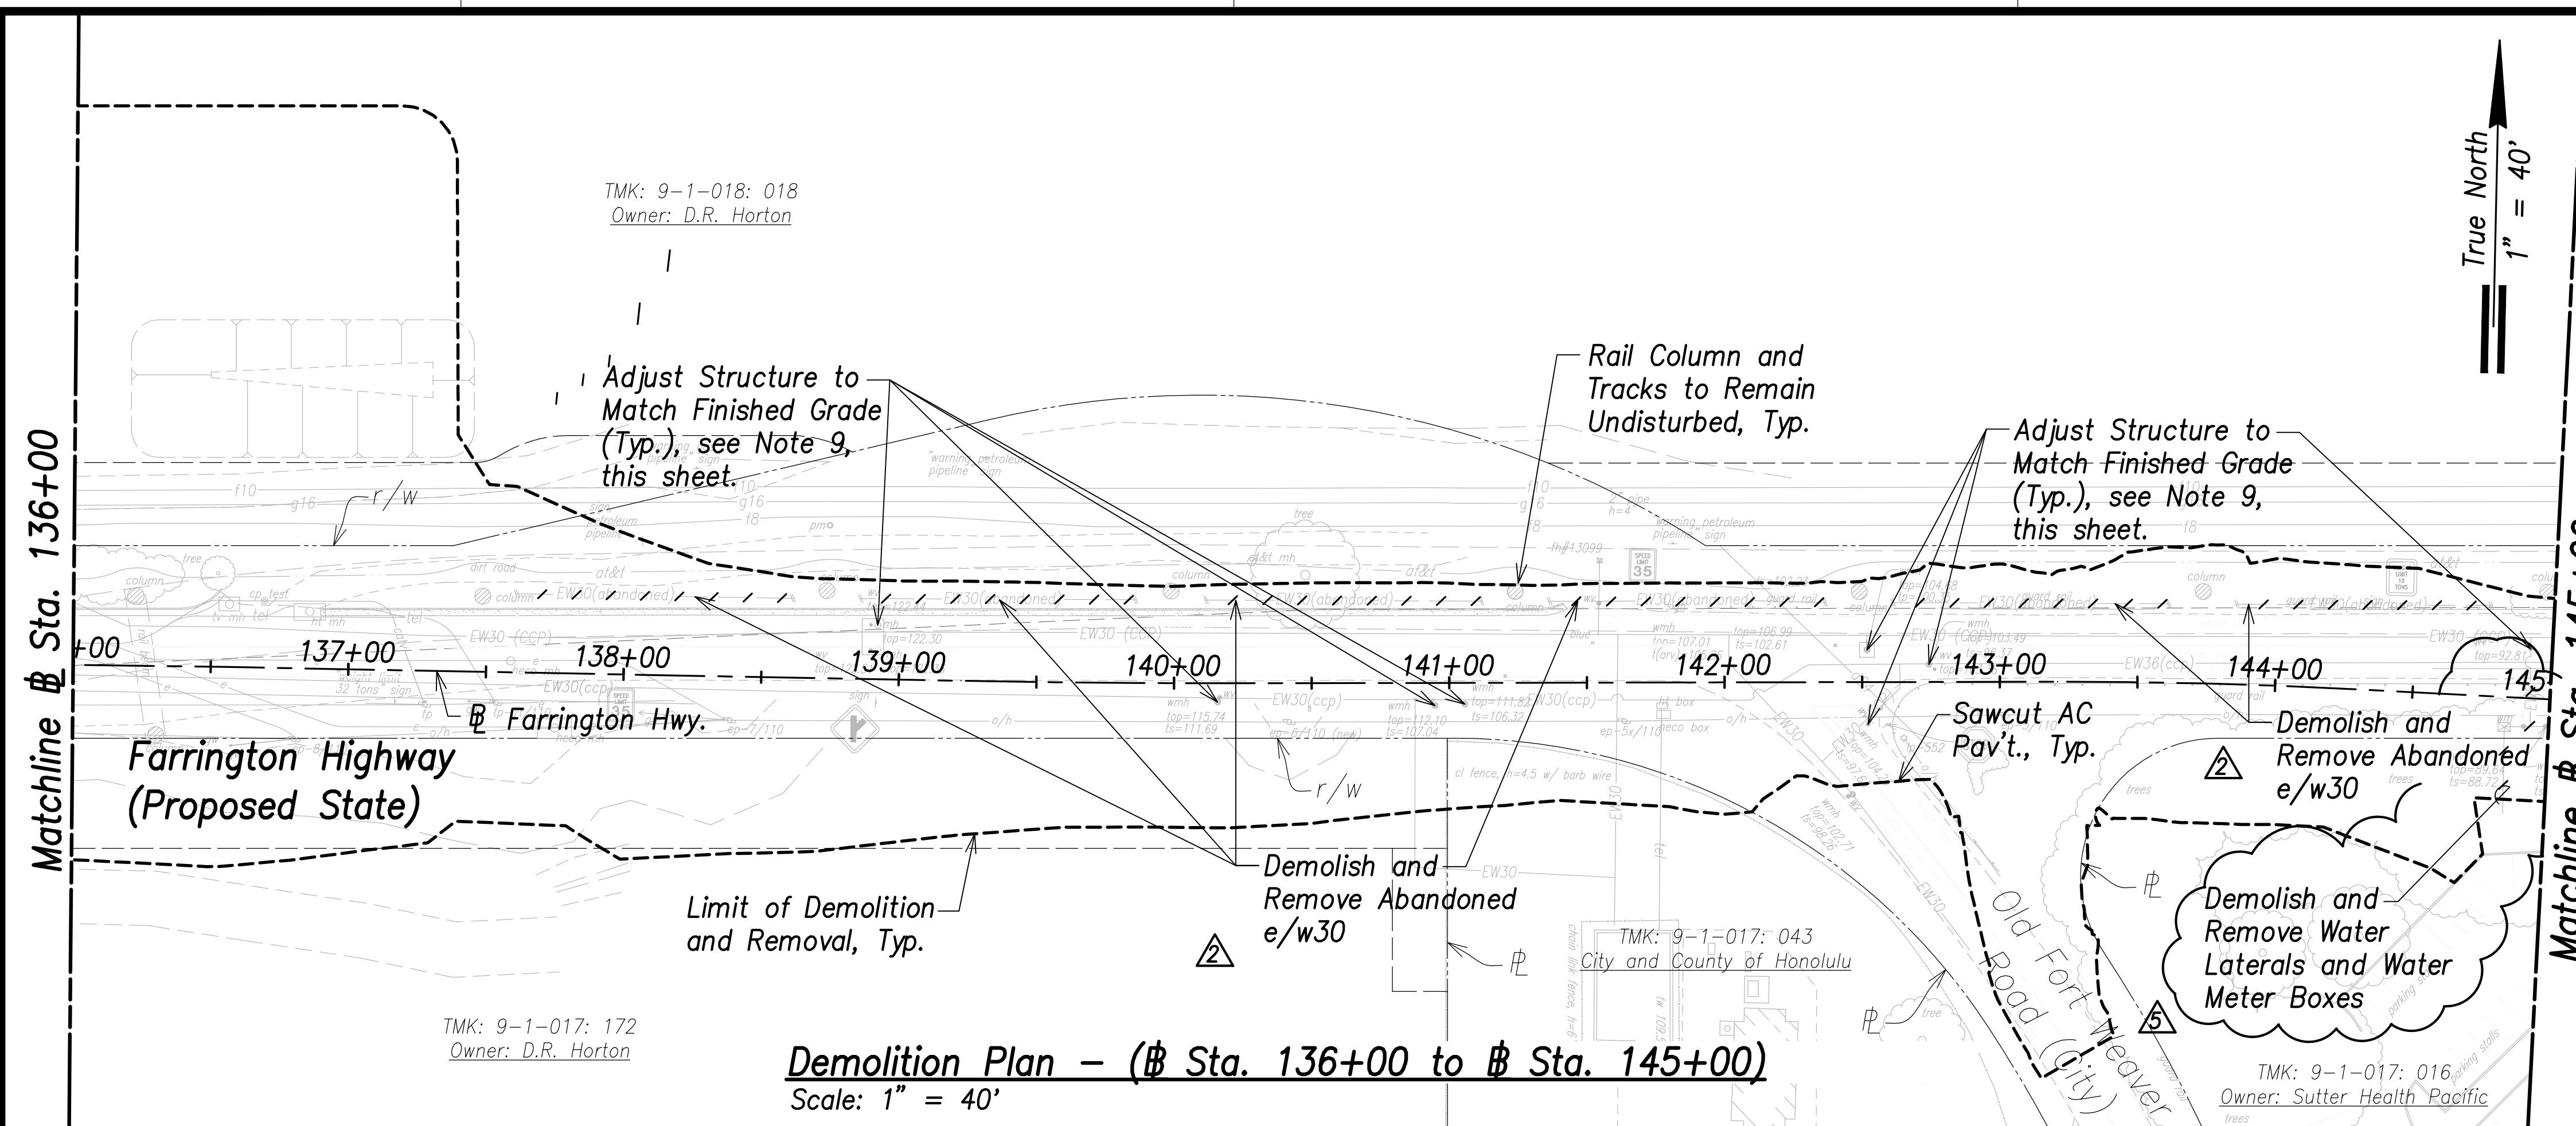

SURVEY PLOTTED BY	DATE
DRAWN BY	
TRACED BY	
NOTED BY	
CHECKED BY	
ORIGINAL PLAN	
NOTE BOOK	
No.	

APPROVED:

Manager and Chief Engineer, BWS DATE  
(for work affecting BWS facilities in City/State R/W & BWS easements only)

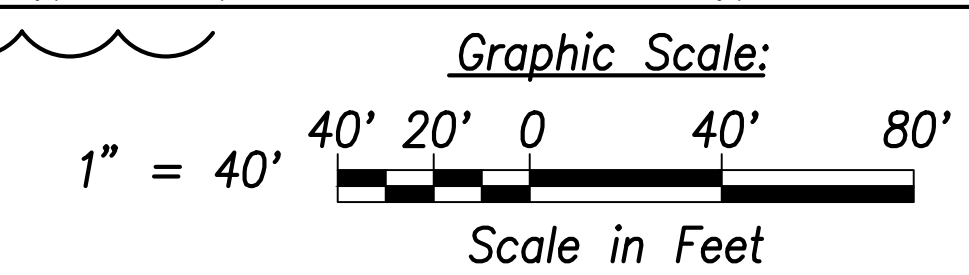

07/15/22	Revised demolition and signature block
06/08/22	Added Waterline Demolition
DATE	REVISION



THIS WORK WAS PREPARED BY ME OR UNDER MY SUPERVISION AND CONSTRUCTION OF THIS PROJECT WILL BE UNDER MY OBSERVATION.

Signature: *Craig W. L. Luke*  
April 30, 2024  
EXPIRATION DATE OF THE LICENSE

STATE OF HAWAII  
DEPARTMENT OF TRANSPORTATION  
HIGHWAYS DIVISION

**Demolition Plan**  
Sta. 136+00 to Sta. 154+00

FARRINGTON HIGHWAY WIDENING  
Kapolei Golf Course Road to Fort Weaver Road  
Project No. 7101A-01-20

Scale: As Shown Date: April 2022


SHEET No. C-40 OF 767 SHEETS




FED. ROAD DIST. NO.	STATE	PROJ. NO.	FISCAL YEAR	SHEET NO.	TOTAL SHEETS
HAWAII	HAW.	7101A-01-20	2021	42	767

**Notes:**

- All drainage structures, curbs, gutters, sidewalks, pavement, guardrails, striping, vegetation, posts, and signing shall be removed within the limit of demolition and removal.
- See Structural Drawings for Demolition and Removal of Bridge Deck and Structural Members.
- Remove by grinding pavement striping, to avoid conflicts with existing striping. See Signing and Marking Plans.
- For Demolition of Electrical and Telecommunication Utilities and Structures, Refer to Electrical Site Demolition Plans. The Contractor is Responsible for Coordinating all Electrical Work with Respective Utility Companies.
- The Contractor Shall Ensure Demolition and Removal Work of Contaminated Materials is Done in Compliance with the State Department of Health and Federal Environmental Protection Agency Guidelines.
- The Contractor shall coordinate all work with impacted utility owners and ensure continuous access.
- Service shall be maintained at all times to impacted utilities. No interruption in service will be allowed. The contractor shall phase work to allow for continuous utility service.
- All Water, Sewer, Fuel, and Gas Systems Shall Remain Undisturbed Unless Indicated For Demolition.
- The Contractor shall reconstruct tops of all existing utility manholes, valve boxes, meter boxes and structures that are remaining in service and contained within the project area flush with the finished grade.
- The Contractor Shall Comply With Traffic Notes on Sht. C-19.

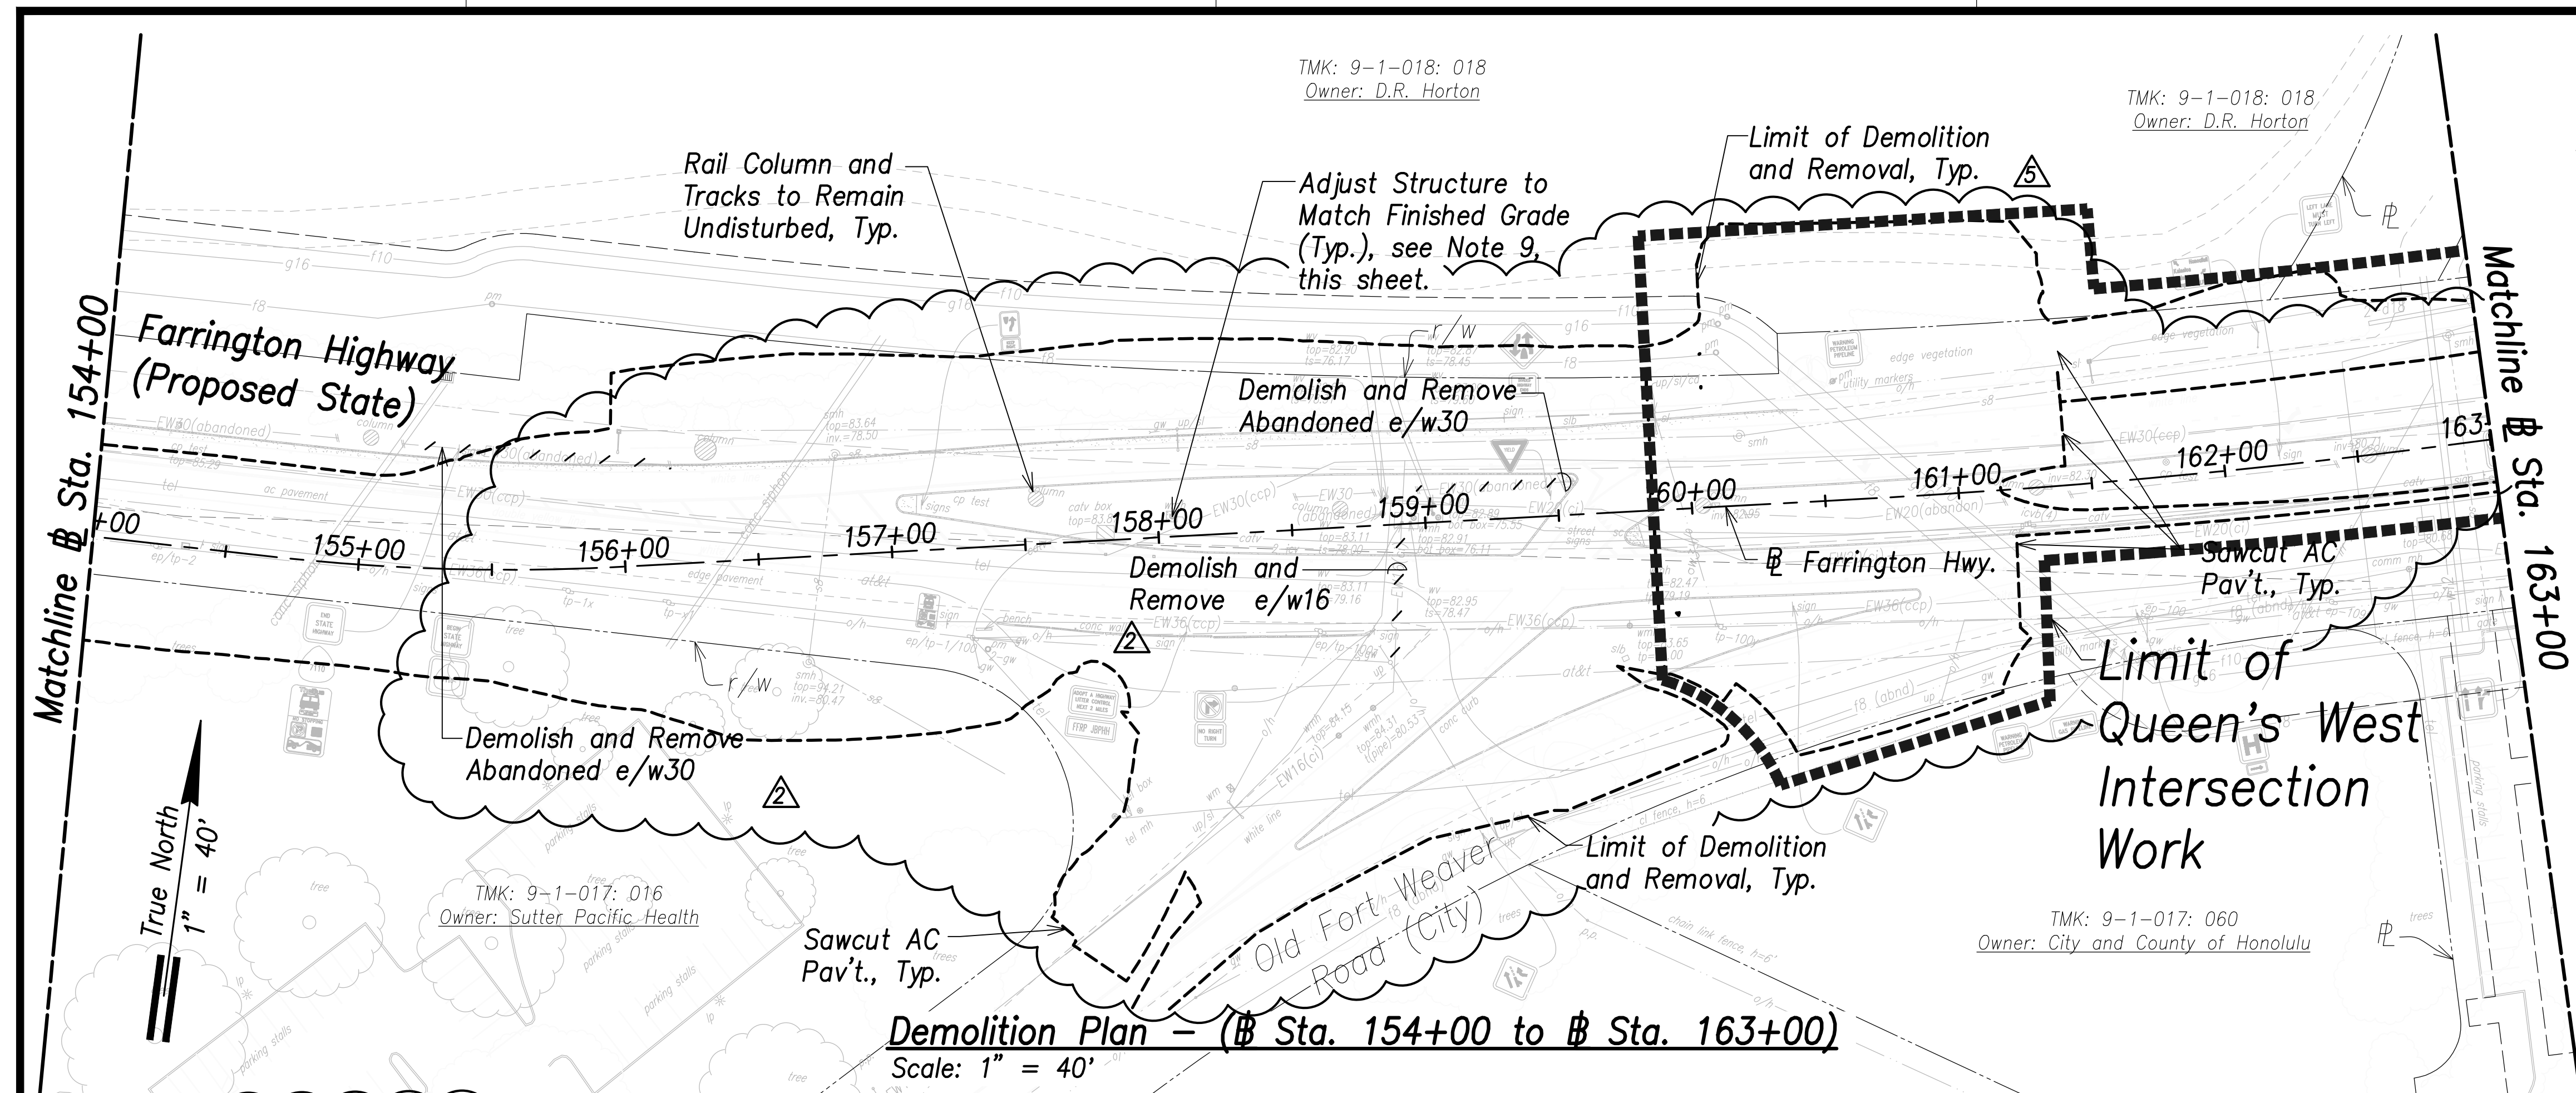


**Demolition Plan - (Sta. 154+00 to Sta. 163+00)**  
Scale: 1" = 40'

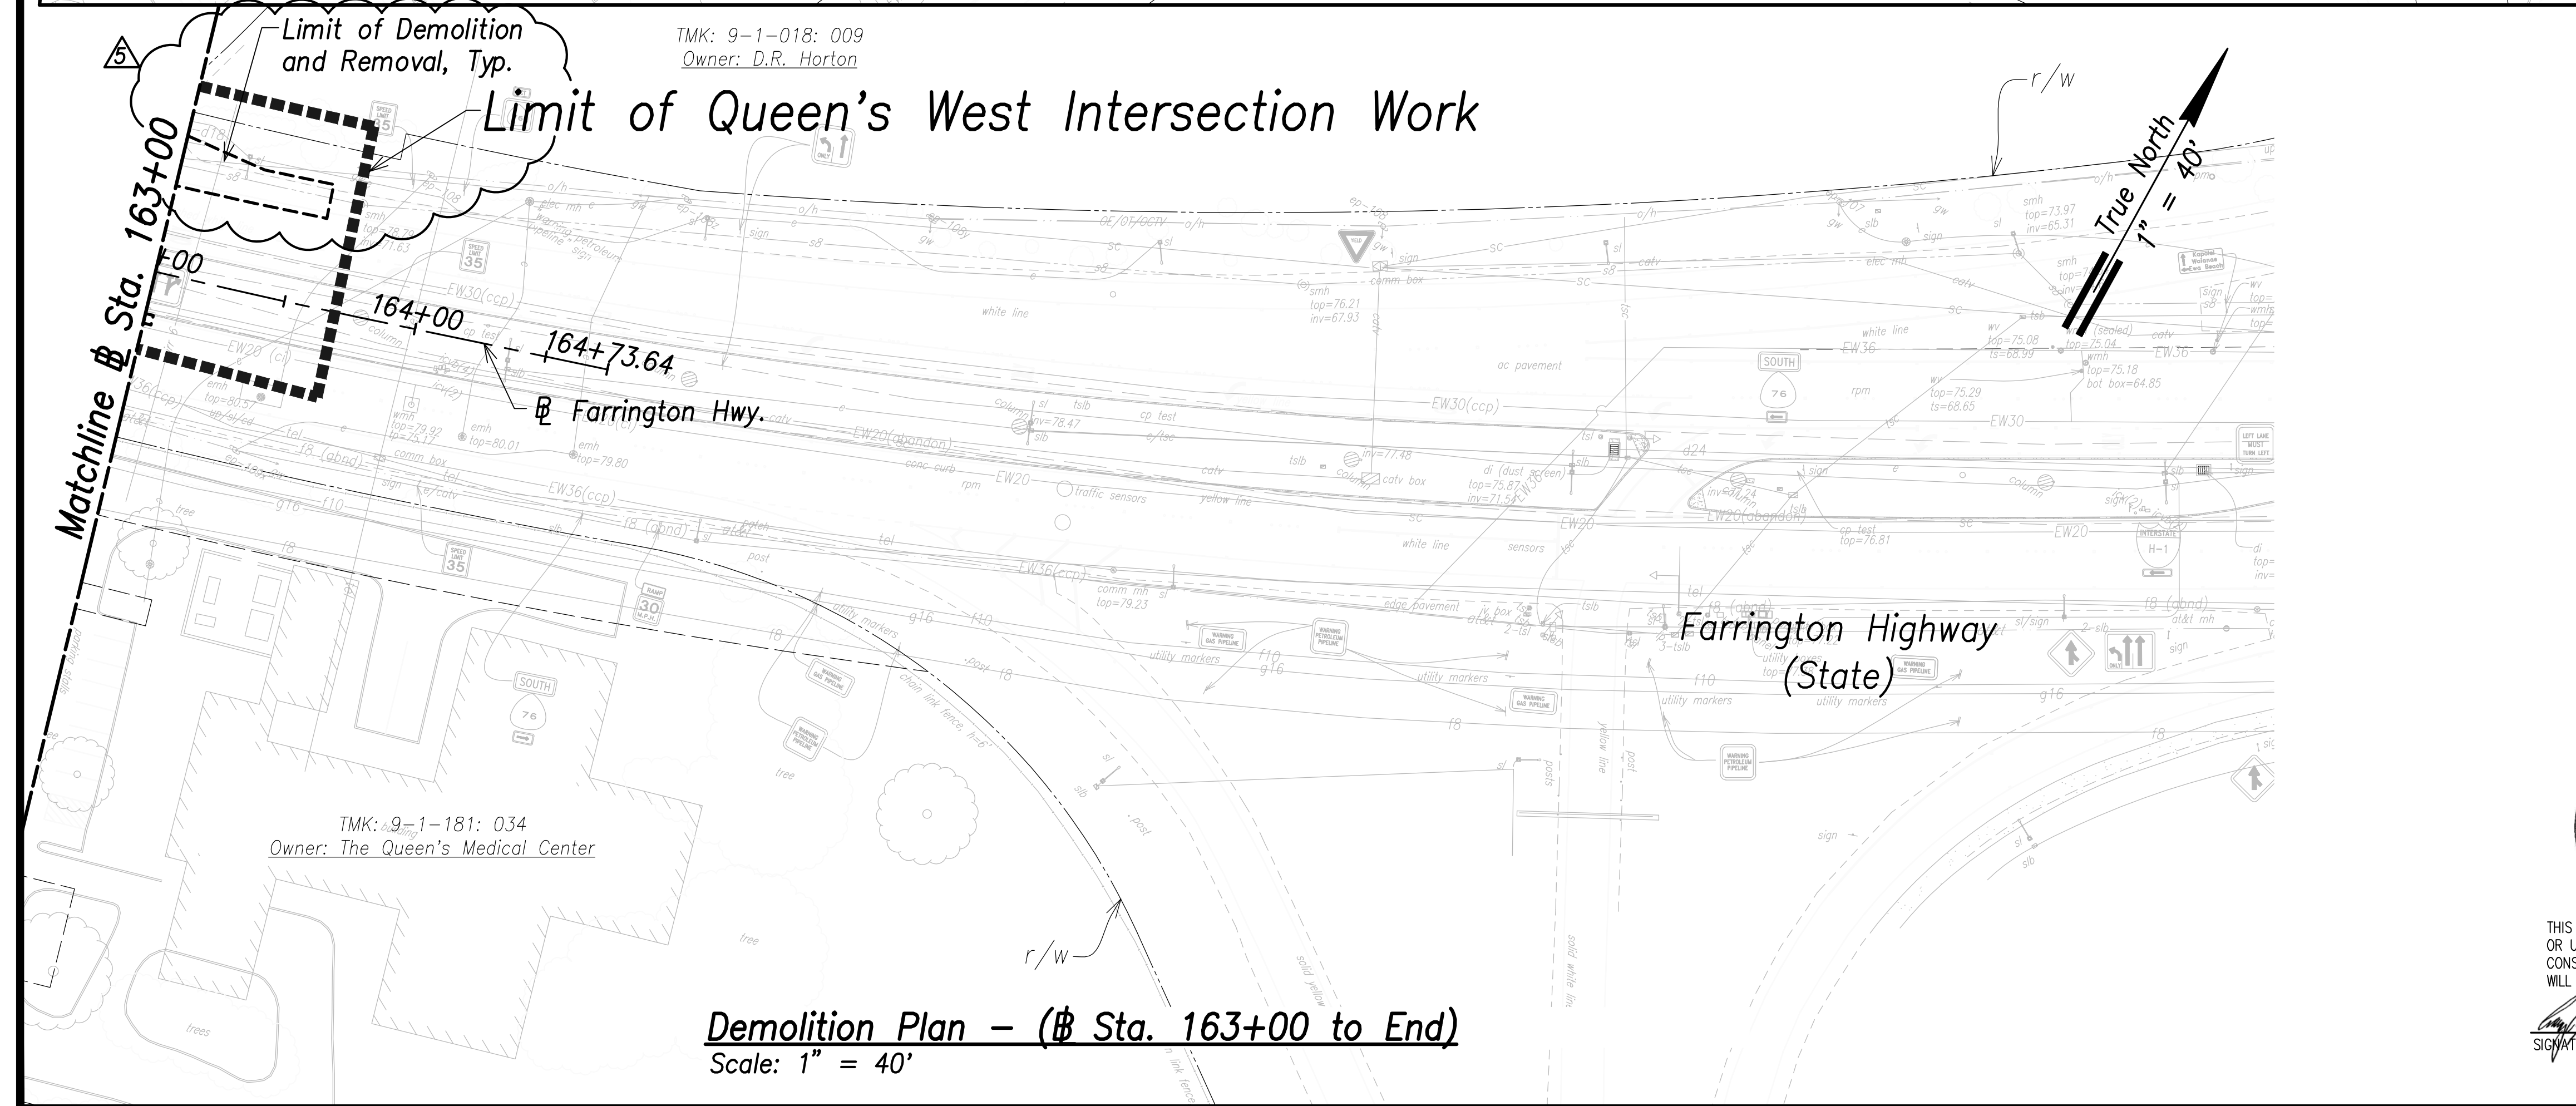

**Demolition Plan - (Sta. 163+00 to End)**  
Scale: 1" = 40'

SURVEY PLOTTED BY	DATE
DRAWN BY	
TRACED BY	
QUANTITIES BY	
CHECKED BY	
ORIGINAL PLAN	
NOTE BOOK	
No.	

APPROVED: \_\_\_\_\_ DATE \_\_\_\_\_  
Manager and Chief Engineer, BWS  
(for work affecting BWS facilities in City/State R/W & BWS easements only)

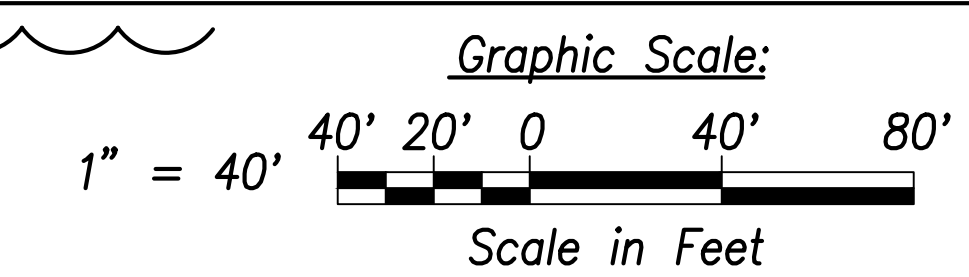

07/15/22	Revised demolition and signature block
06/08/22	Added Waterline Demolition
DATE	REVISION



THIS WORK WAS PREPARED BY ME OR UNDER MY SUPERVISION AND CONSTRUCTION OF THIS PROJECT WILL BE UNDER MY OBSERVATION.  
SIGNATURE: \_\_\_\_\_ EXPIRATION DATE OF THE LICENSE: April 30, 2024

STATE OF HAWAII  
DEPARTMENT OF TRANSPORTATION  
HIGHWAYS DIVISION


**Demolition Plan**  
**Sta. 154+00 to End**  
FARRINGTON HIGHWAY WIDENING  
Kapolei Golf Course Road to Fort Weaver Road  
Project No. 7101A-01-20

Scale: As Shown Date: April 2022






FED. ROAD DIST. NO.	STATE	PROJ. NO.	FISCAL YEAR	SHEET NO.	TOTAL SHEETS
HAWAII	HAW.	7101A-01-20	2021	61	767

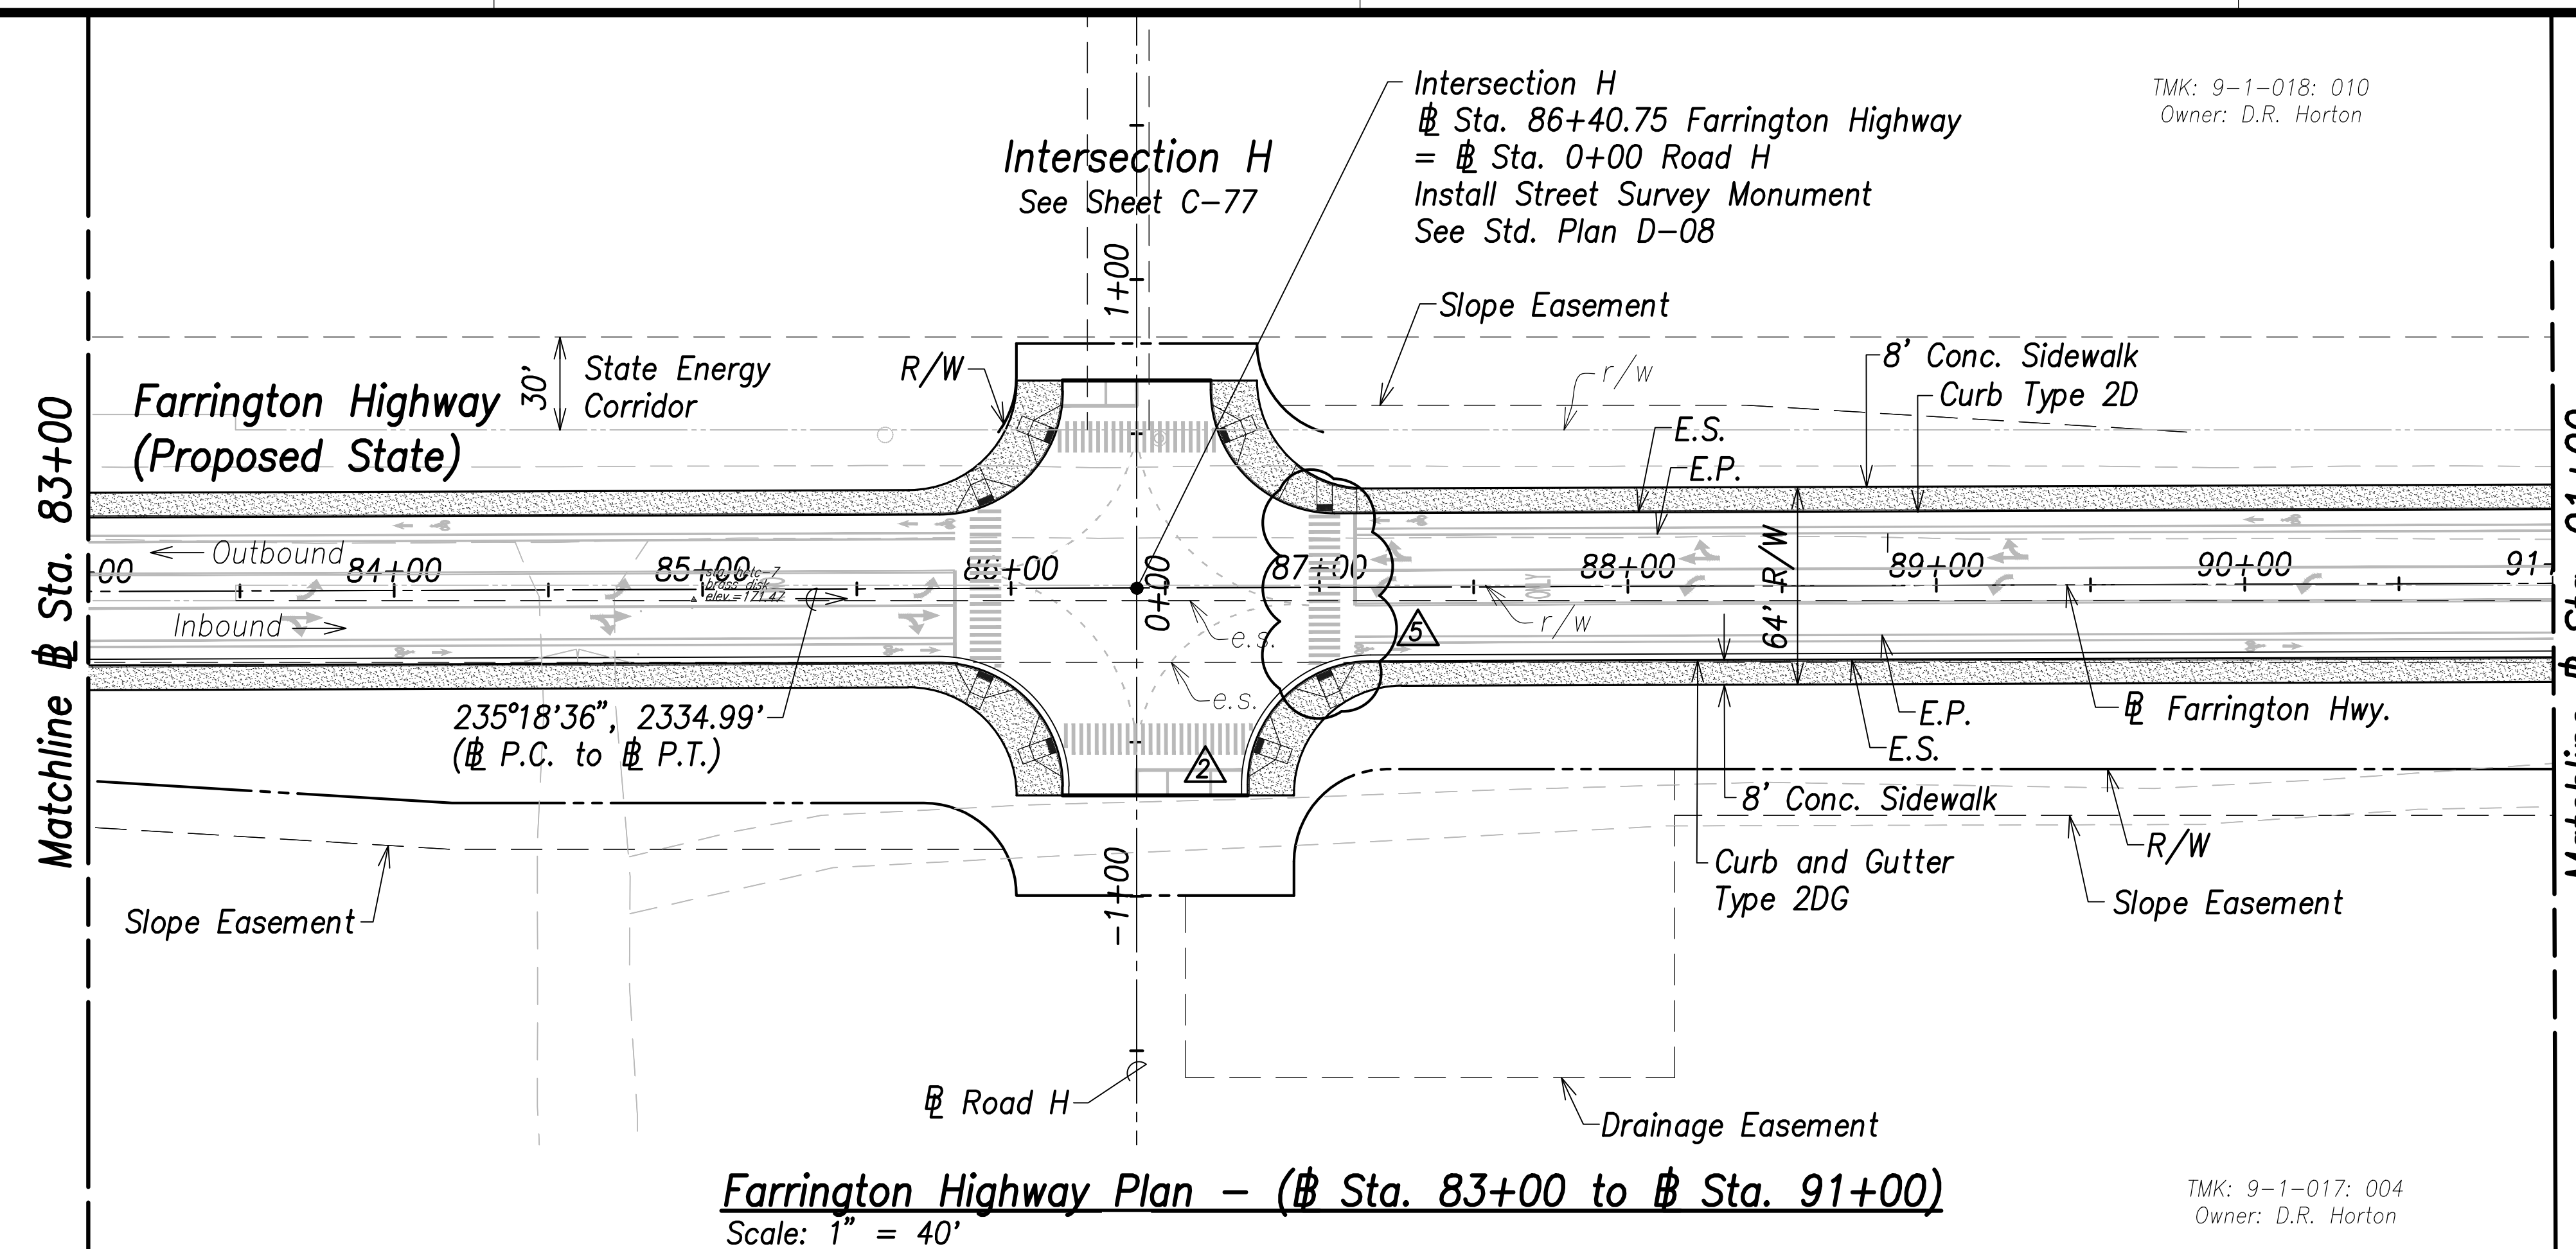


**Farrington Highway Plan - (Sta. 83+00 to Sta. 91+00)**  
Scale: 1" = 40'

TMK: 9-1-017: 004  
Owner: D.R. Horton

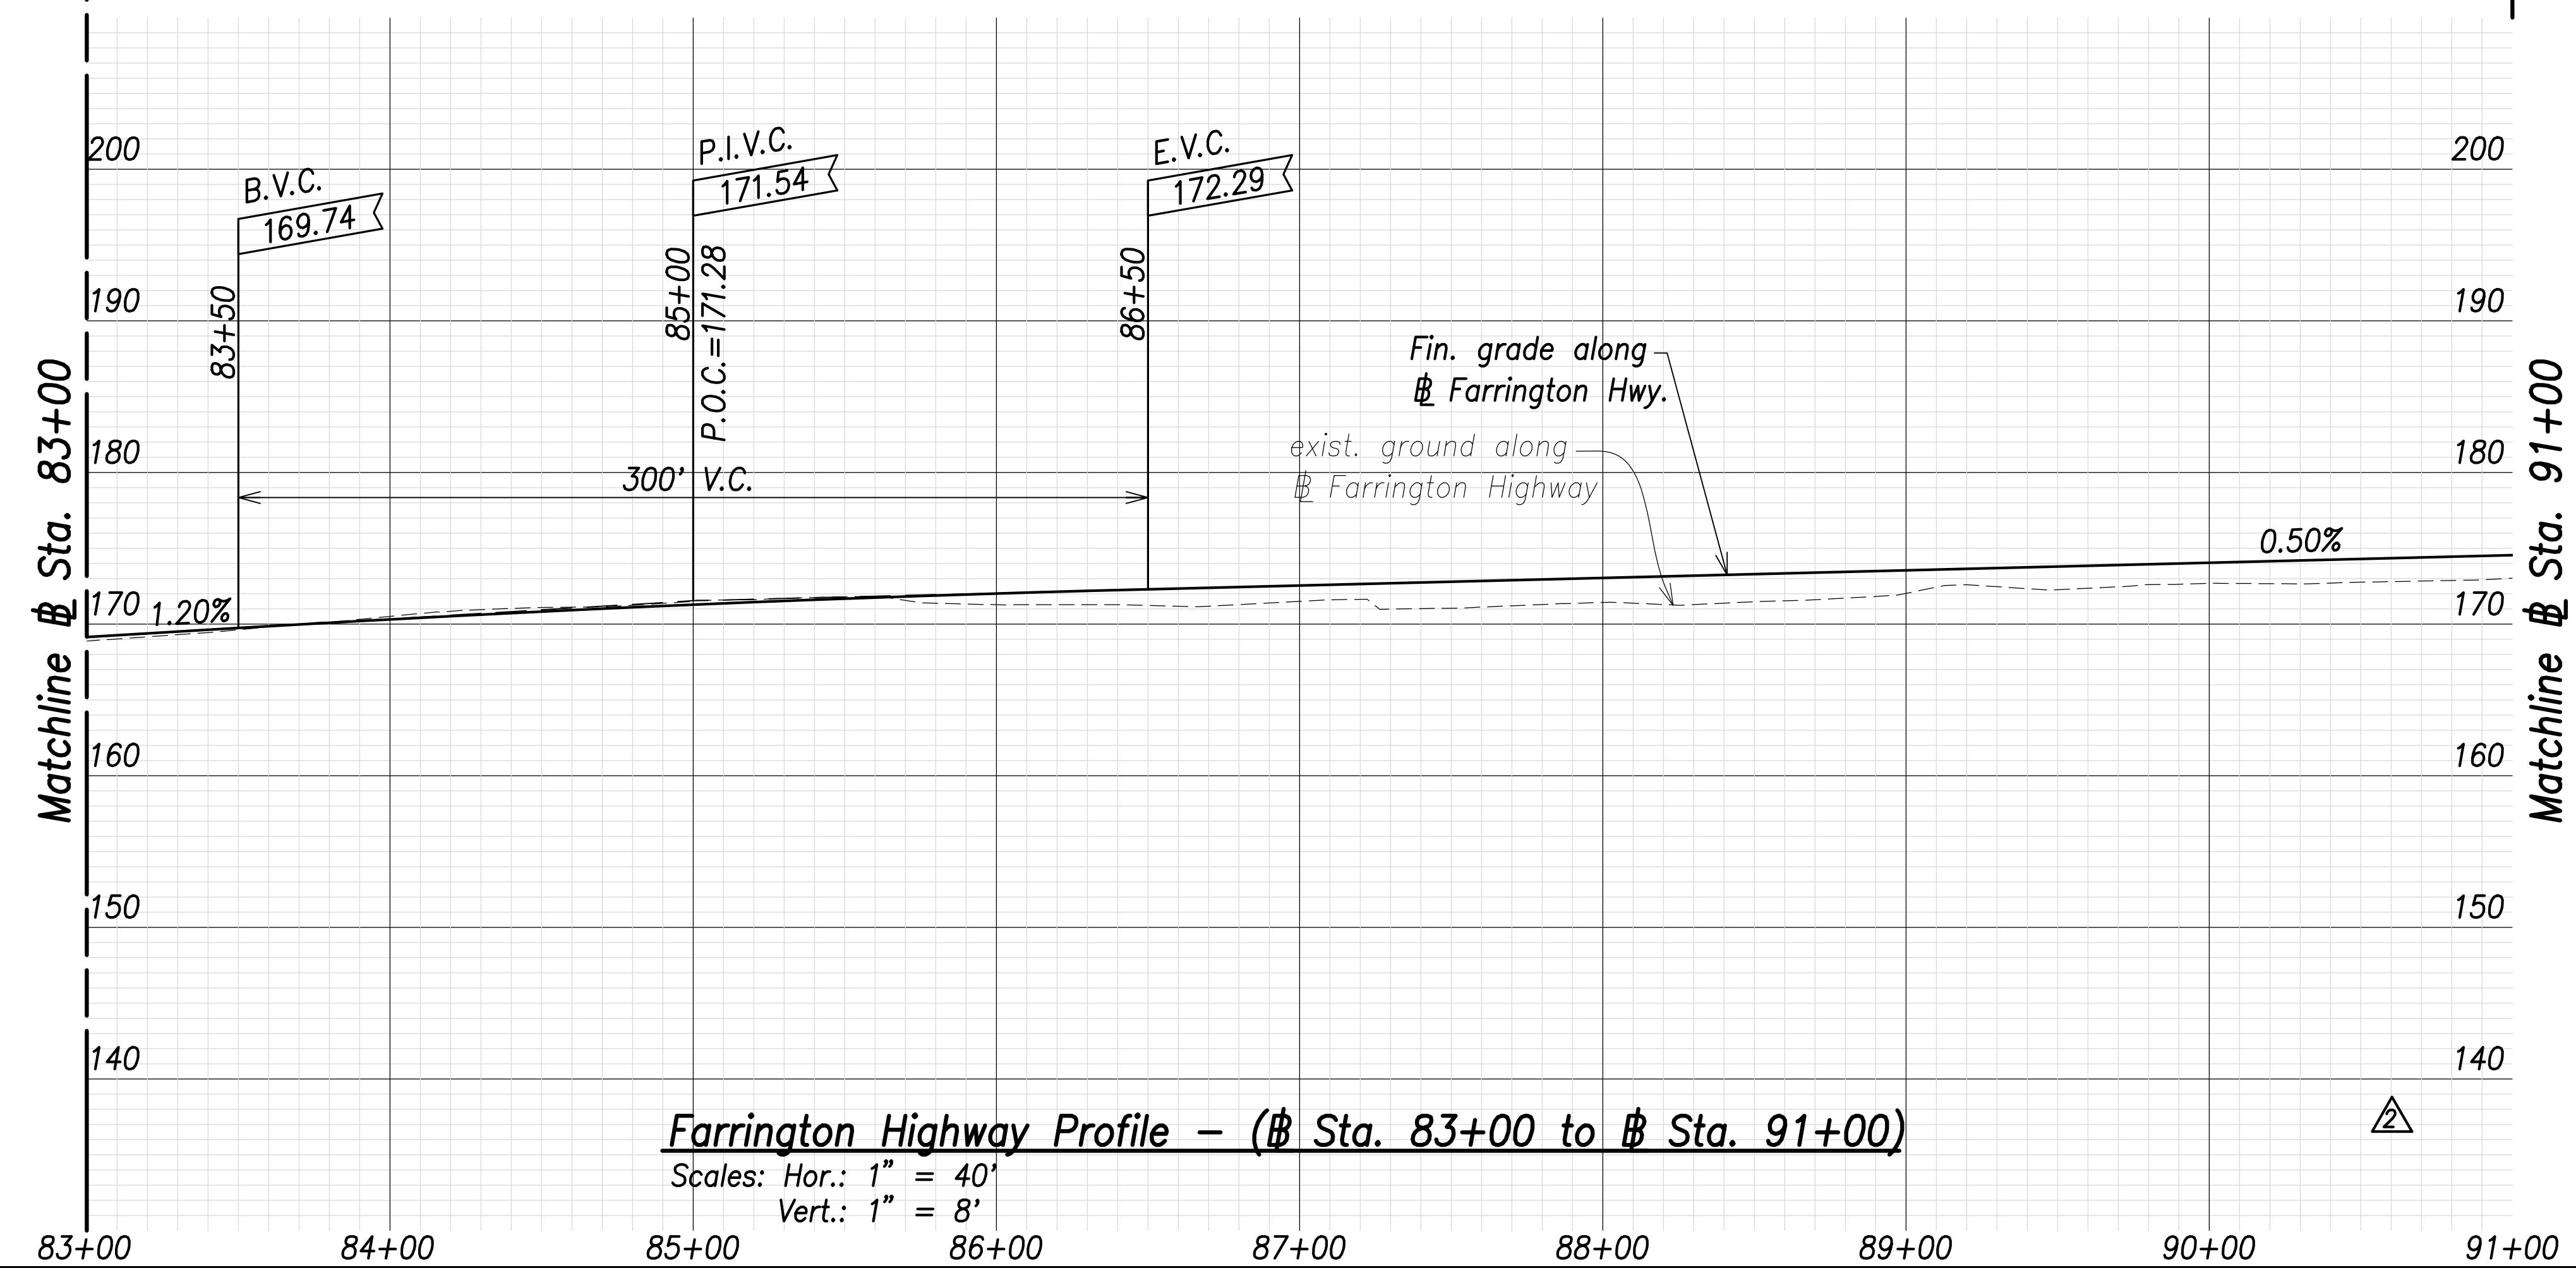

**Farrington Highway Profile - (Sta. 83+00 to Sta. 91+00)**  
Scales: Hor.: 1" = 40'  
Vert.: 1" = 8'

**Note:**  
The Contractor Shall Phase Construction to Ensure 1 Lane in Each Direction Remains Operational

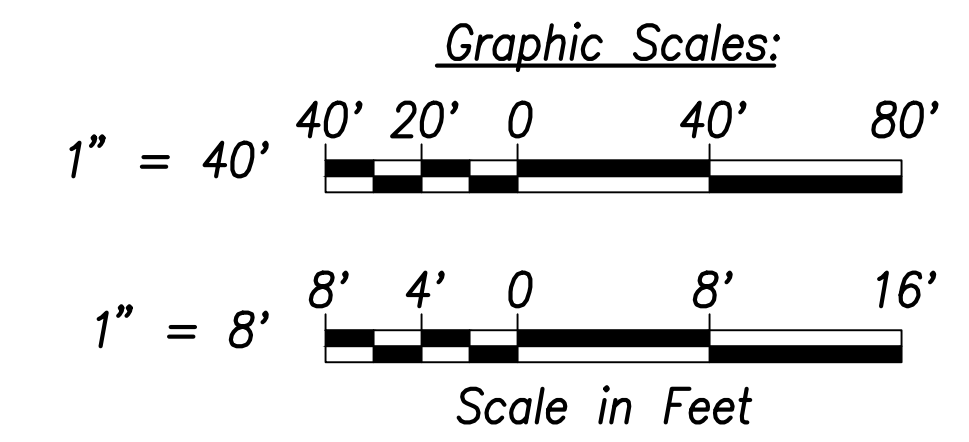

DATE	REVISION
07/15/22	Speed Table removed
06/08/22	Revised exist. ground; Added exist. edge of shoulder callouts



THIS WORK WAS PREPARED BY ME OR UNDER MY SUPERVISION AND CONSTRUCTION OF THIS PROJECT WILL BE UNDER MY OBSERVATION.  
Signature: *Craig W. L. Luke*  
April 30, 2024  
EXPIRATION DATE OF THE LICENSE

STATE OF HAWAII  
DEPARTMENT OF TRANSPORTATION  
HIGHWAYS DIVISION

**Roadway Plan and Profile**  
Sta. 83+00 to Sta. 91+00

FARRINGTON HIGHWAY WIDENING  
Kapolei Golf Course Road to Fort Weaver Road  
Project No. 7101A-01-20

Scale: As Shown Date: April 2022


DATE	BY
	SURVEY PLOTTED BY
	DRAWN BY
	TRACED BY
	CHECKED BY
	DATE
	NO.

FILE: K:\civil\23146 Farrington Hwy Widening\Drawings\Construction\Drawings\C-60 Roadway Plan - Sta. 83+00 to 91+00 - PLAN.dwg saved July 12, 2022







FED. ROAD DIST. NO.	STATE	PROJ. NO.	FISCAL YEAR	SHEET NO.	TOTAL SHEETS
HAWAII	HAW.	7101A-01-20	2021	66	767

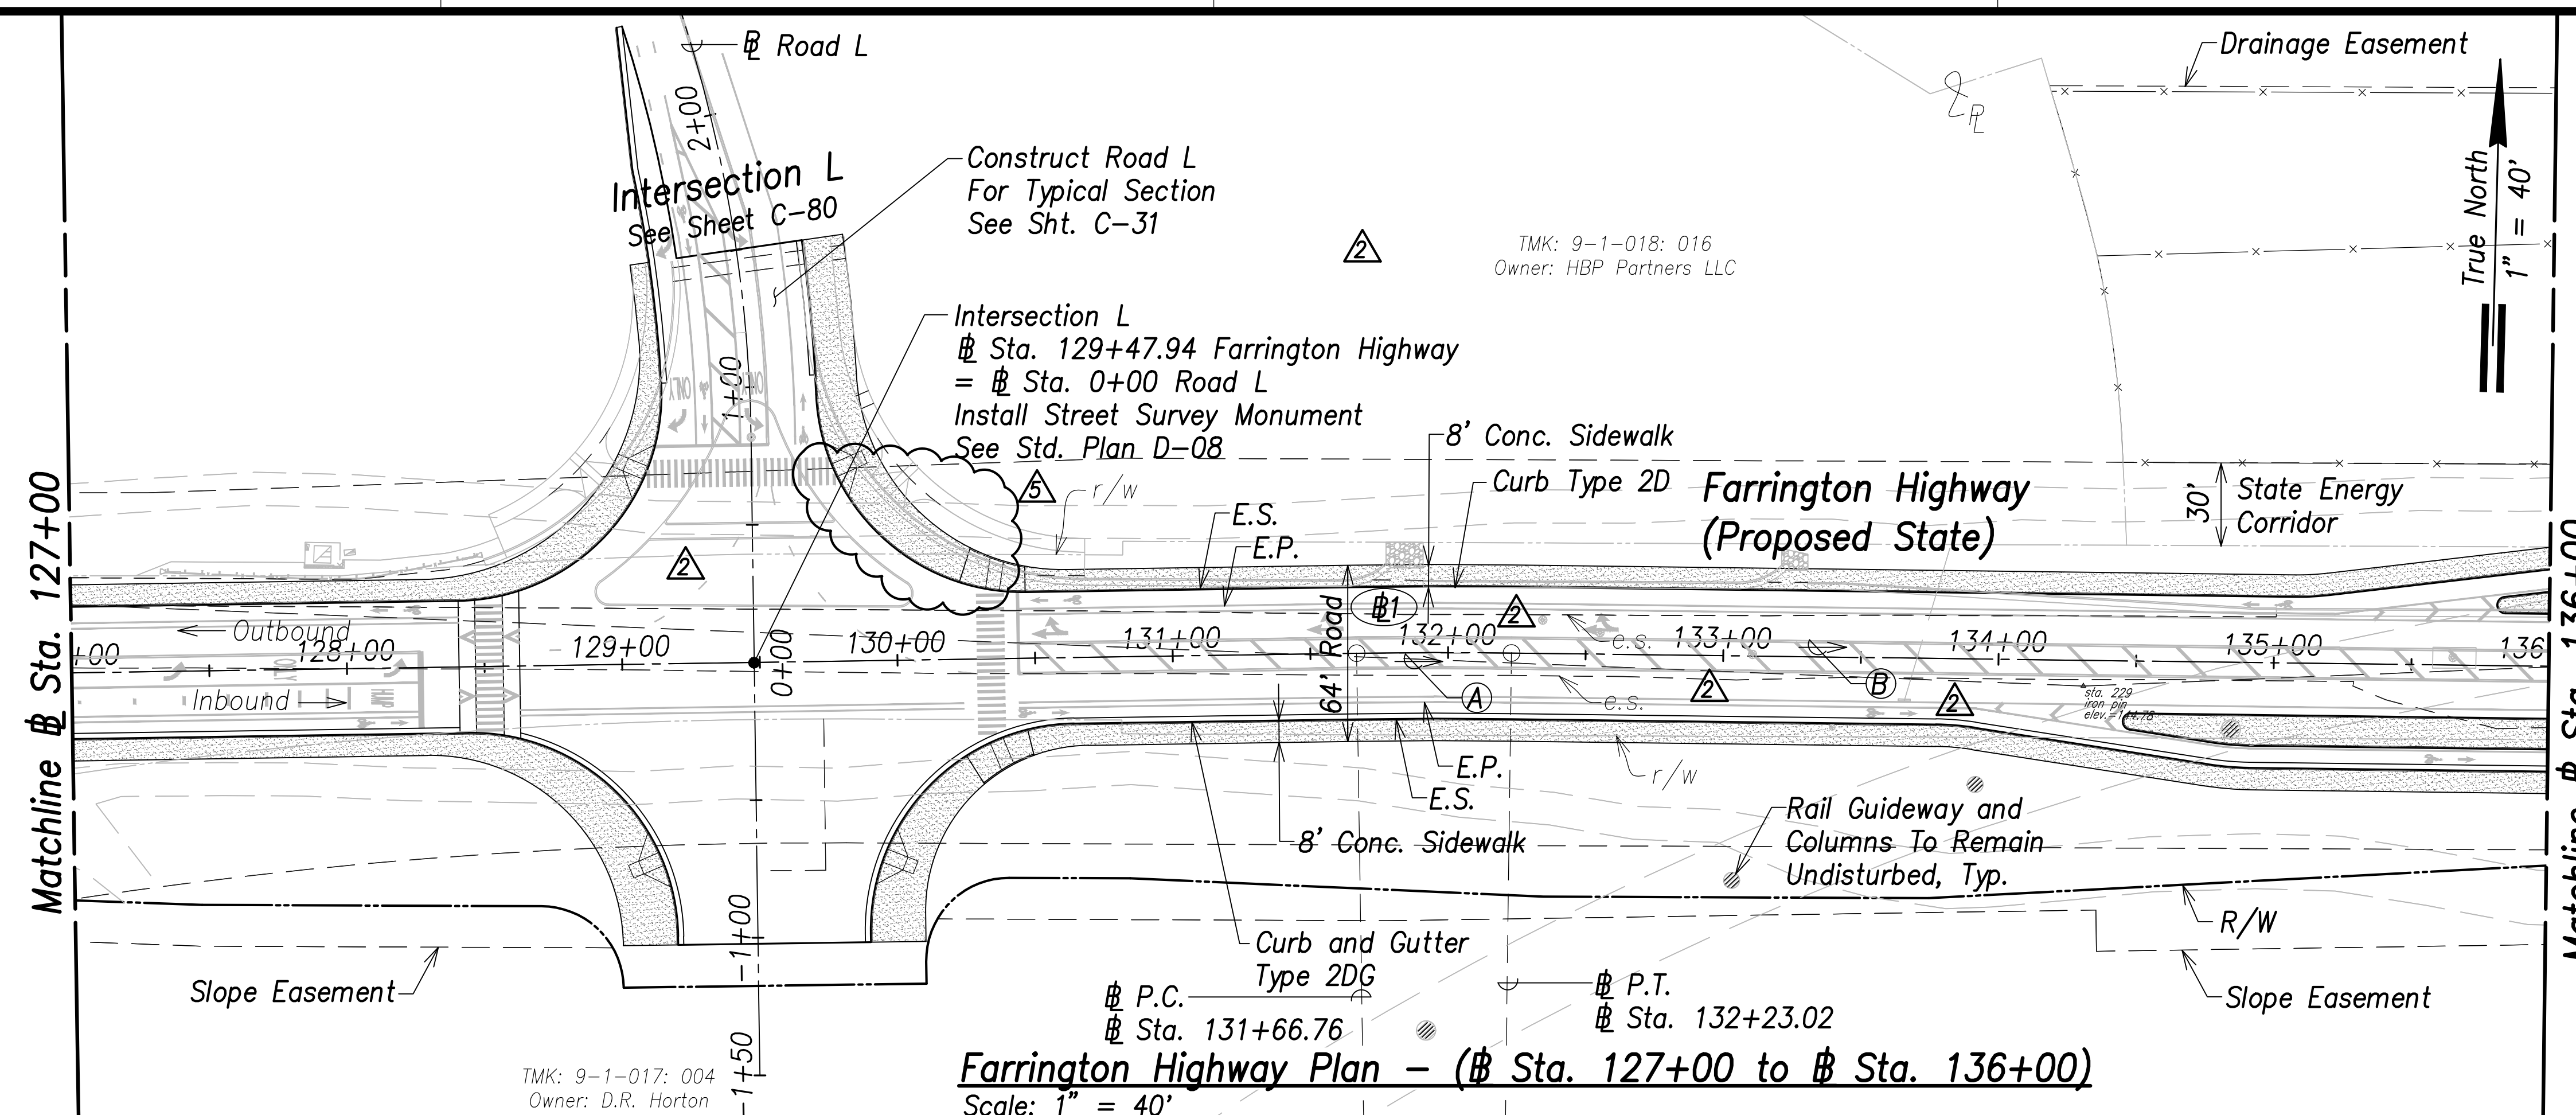

**Curve Data:**

- ⊙1
  - Δ = 1°36'42"
  - Δ/2 = 0°48'21"
  - R = 2000.00'
  - T = 28.13'
  - C = 56.26'
  - Lc = 56.26'
- ⊙
  - 268°25'39", 56.26'
  - (⊙ P.C. to ⊙ P.T.)
- ⊙
  - 269°14'00", 381.64'
  - (⊙ P.T. to ⊙ P.C.)

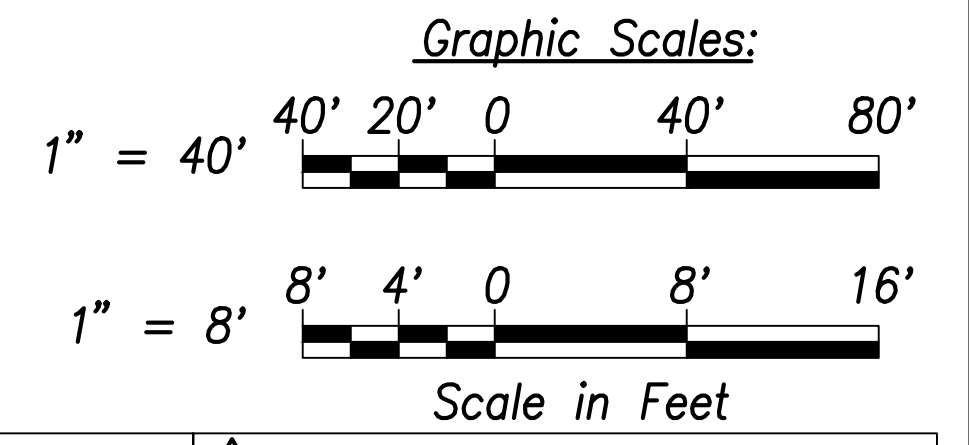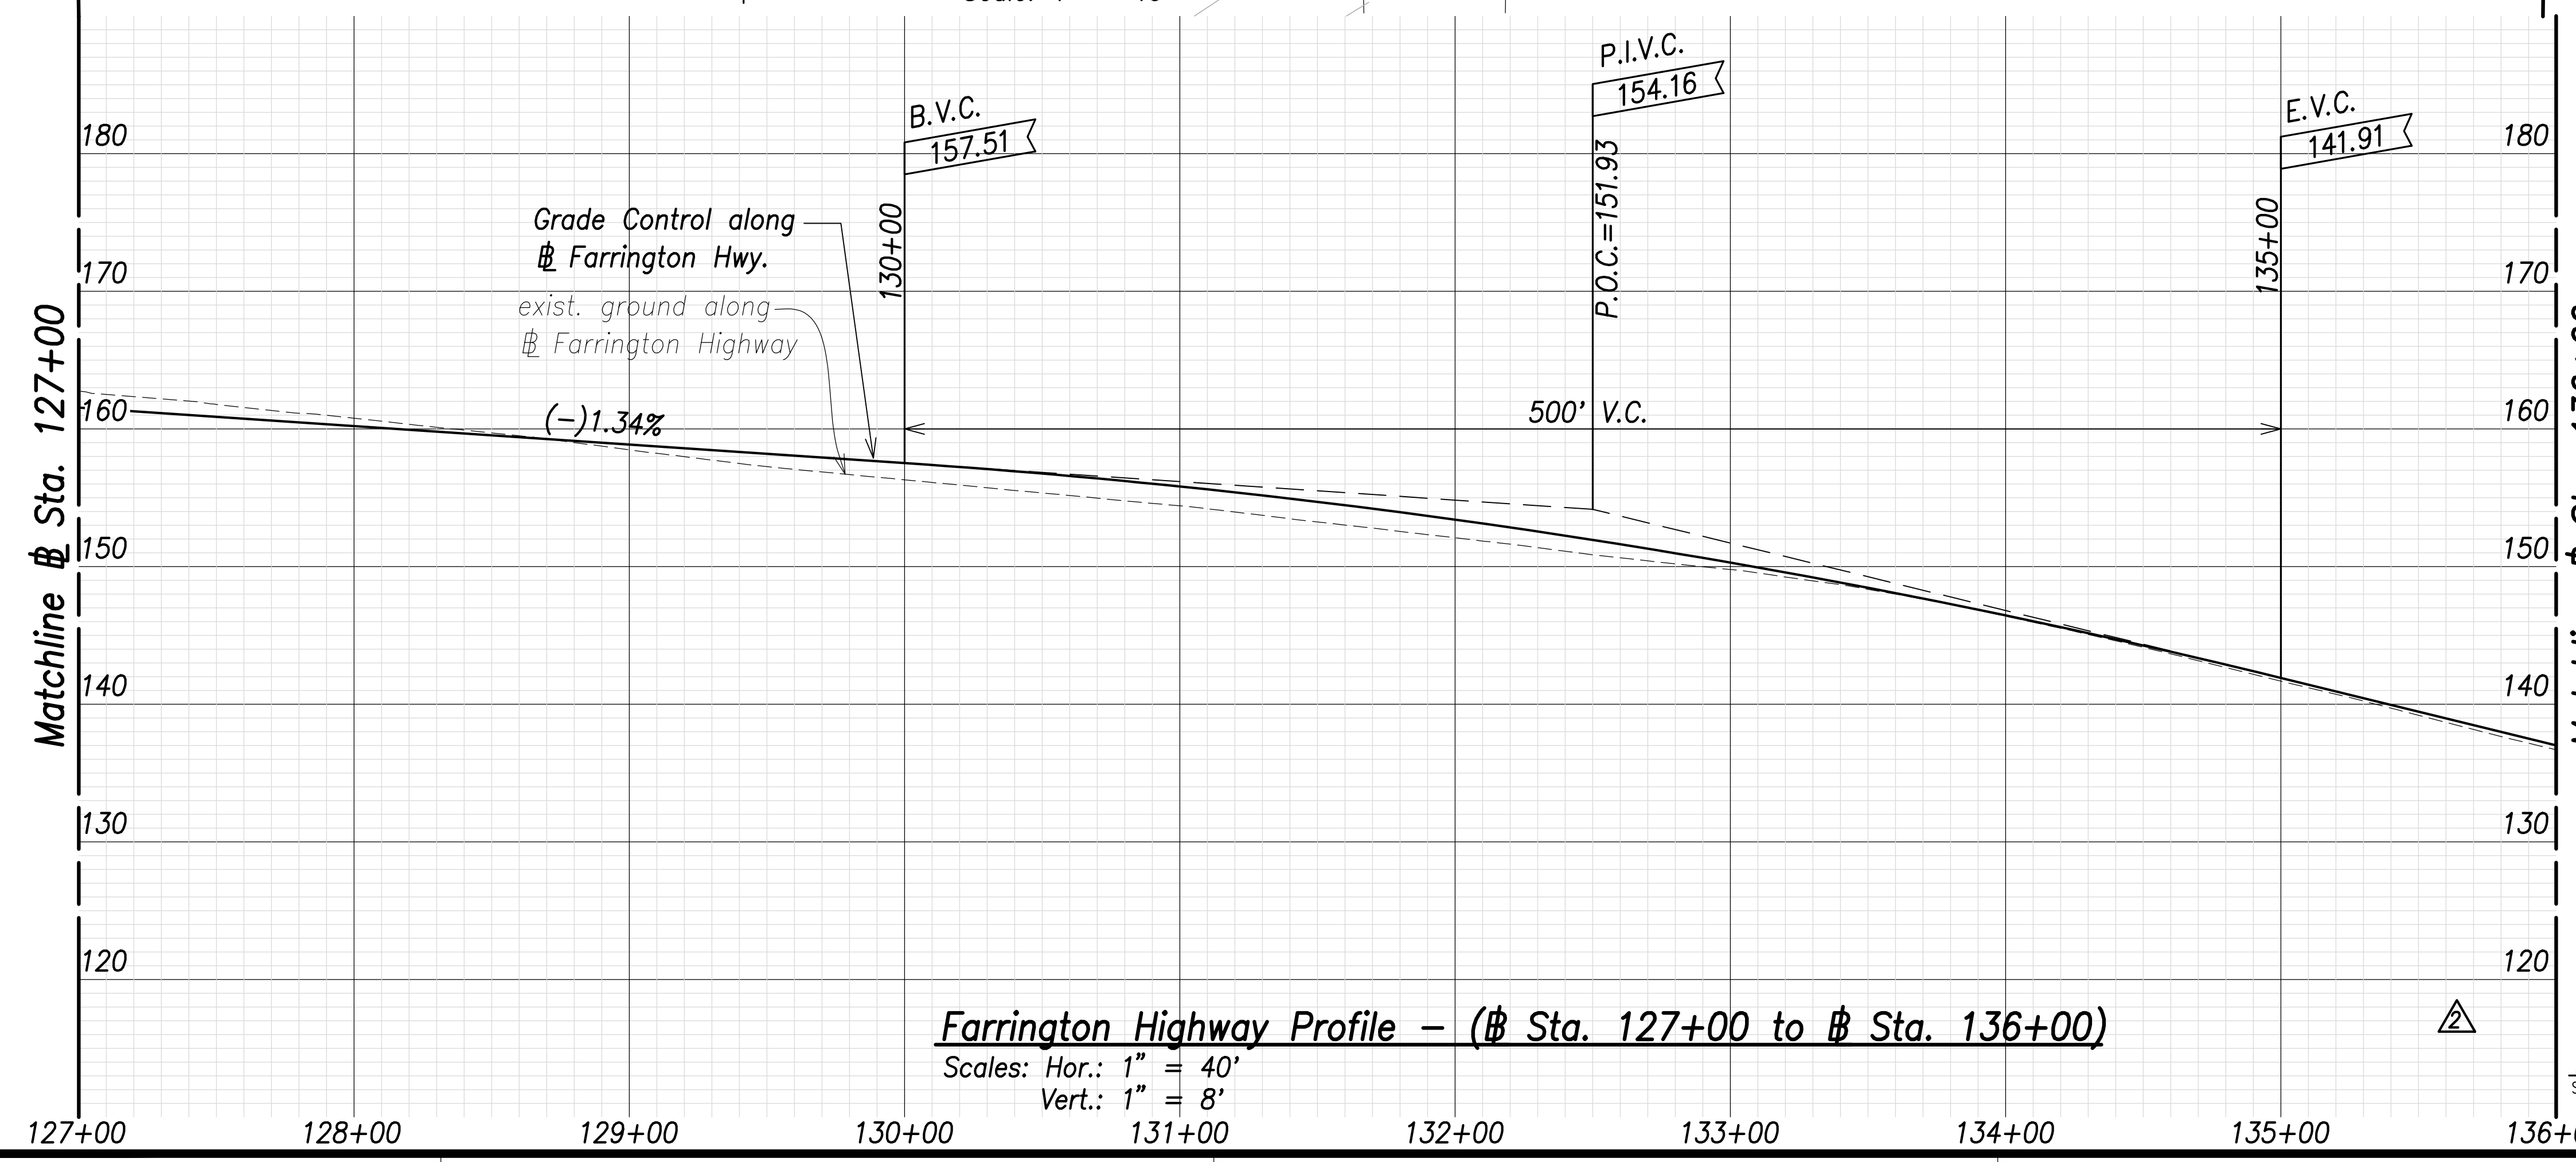

DATE	REVISION
07/15/22	⊙ Delete callout
06/08/22	⊙ Added Street Survey Monument; Revised callout; Revised exist. ground; Added exist. edge of shoulder callouts



THIS WORK WAS PREPARED BY ME OR UNDER MY SUPERVISION AND CONSTRUCTION OF THIS PROJECT WILL BE UNDER MY OBSERVATION.

SIGNATURE: *Craig W. Luke*    EXPIRATION DATE OF THE LICENSE: April 30, 2024

STATE OF HAWAII  
DEPARTMENT OF TRANSPORTATION  
HIGHWAYS DIVISION

**Roadway Plan and Profile**  
Sta. 127+00 to Sta. 136+00

FARRINGTON HIGHWAY WIDENING  
Kapolei Golf Course Road to Fort Weaver Road  
Project No. 7101A-01-20

Scale: As Shown    Date: April 2022

DATE	SURVEY PLOTTED BY
DATE	DRAWN BY
DATE	TRACED BY
DATE	QUANTIFIED BY
DATE	CHECKED BY

**Farrington Highway Profile - (Sta. 127+00 to Sta. 136+00)**  
Scales: Hor.: 1" = 40'  
Vert.: 1" = 8'

**Farrington Highway Plan - (Sta. 127+00 to Sta. 136+00)**  
Scale: 1" = 40'


TMK: 9-1-017: 004  
Owner: D.R. Horton

TMK: 9-1-018: 016  
Owner: HBP Partners LLC

FILE: K:\civil\23146 Farrington Hwy Widening\Draw\Construction\Draw\C-65 Roadway Plan - Sta. 127+00 to 136+00 - PLAN.dwg saved July 6, 2022




FED. ROAD DIST. NO.	STATE	PROJ. NO.	FISCAL YEAR	SHEET NO.	TOTAL SHEETS
HAWAII	HAW.	7101A-01-20	2021	69	767

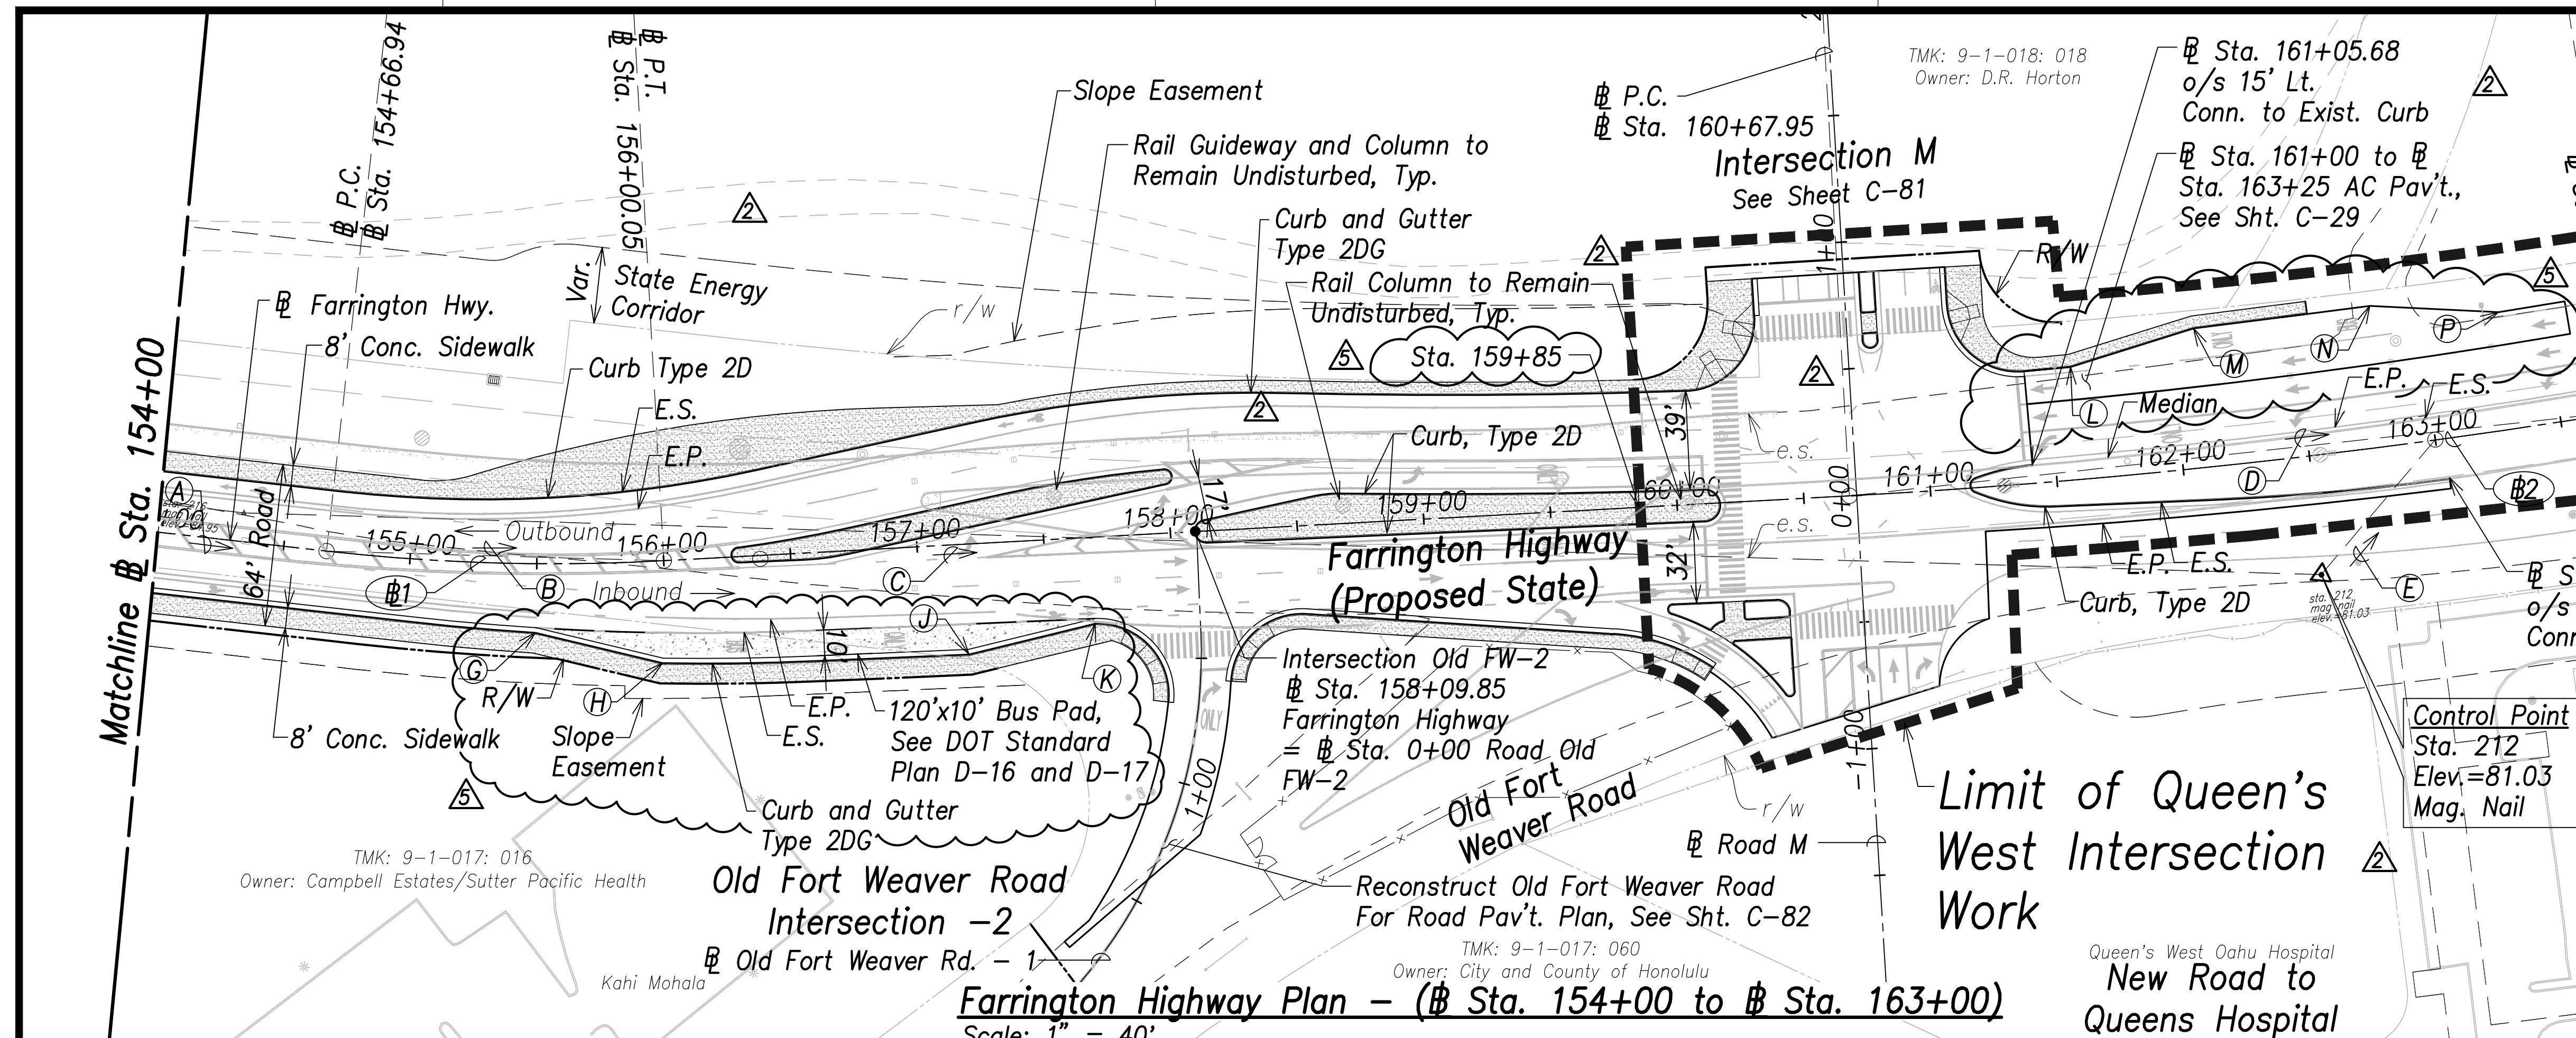

True North  
1" = 40'

Ⓐ	268°44'00", 718.74' (# P.T. to # P.C.)
Ⓑ	263°58'01", 132.95' (# P.C. to # P.T.)
Ⓒ	259°12'01", 467.91' (# P.T. to # P.C.)
Ⓓ	266°06'17", 311.07' (# P.C. to # P.T.)
Ⓔ	212°31'39", 69.59' (Sta. 212 to Sta. 163+00)

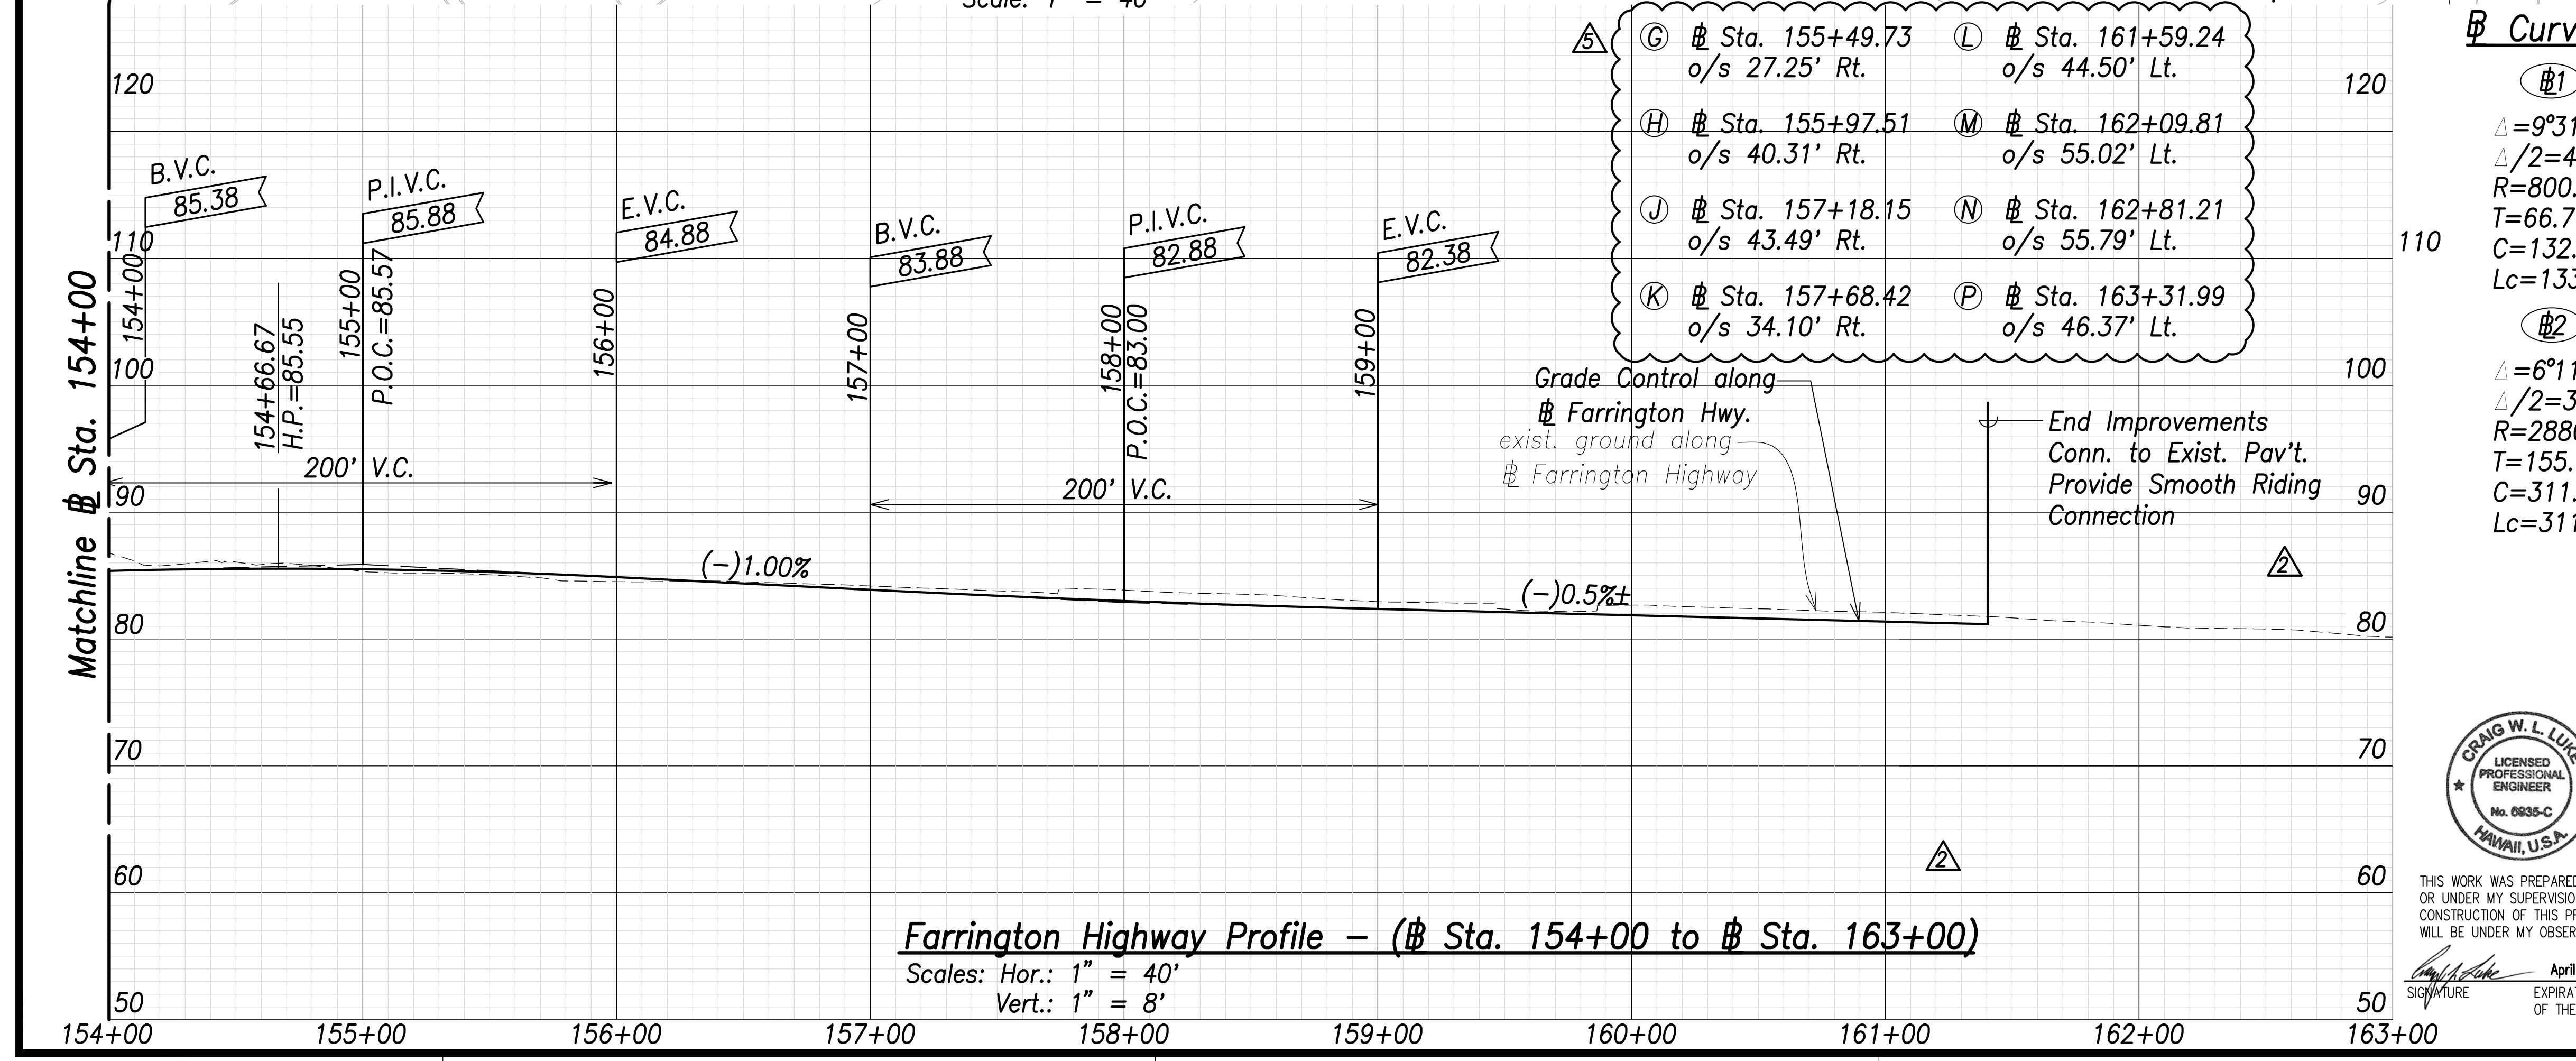


Ⓒ # Sta. 155+49.73 o/s 27.25' Rt.	Ⓓ # Sta. 161+59.24 o/s 44.50' Lt.
Ⓗ # Sta. 155+97.51 o/s 40.31' Rt.	Ⓜ # Sta. 162+09.81 o/s 55.02' Lt.
Ⓙ # Sta. 157+18.15 o/s 43.49' Rt.	Ⓝ # Sta. 162+81.21 o/s 55.79' Lt.
Ⓚ # Sta. 157+68.42 o/s 34.10' Rt.	Ⓟ # Sta. 163+31.99 o/s 46.37' Lt.

**Curve Data:**

Ⓒ1  
 $\Delta = 9^{\circ}31'59''$   
 $\Delta/2 = 4^{\circ}45'59.5''$   
 $R = 800.00'$   
 $T = 66.71'$   
 $C = 132.95'$   
 $L_c = 133.11'$

Ⓒ2  
 $\Delta = 6^{\circ}11'29''$   
 $\Delta/2 = 3^{\circ}5'44.5''$   
 $R = 2880.00'$   
 $T = 155.76'$   
 $C = 311.07'$   
 $L_c = 311.22'$

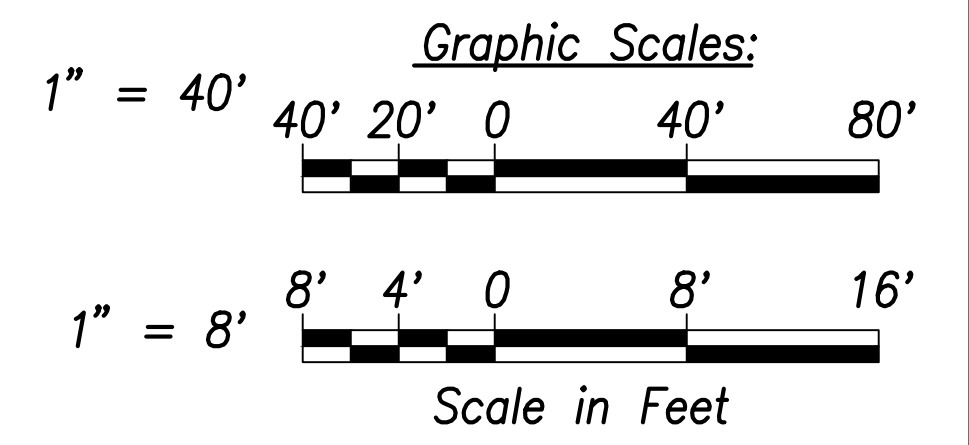

DATE	REVISION
07/15/22	Ⓐ Add Bus Bay; Added Station Callout
06/08/22	Ⓐ Median and Lane Revised; Added Tie; Revised callout; Revised profile callouts; Added bus pad; Revised exist. ground; Added exist. edge of shoulder callouts



THIS WORK WAS PREPARED BY ME OR UNDER MY SUPERVISION AND CONSTRUCTION OF THIS PROJECT WILL BE UNDER MY OBSERVATION.

Signature: *Craig W. L. Luke*  
 EXPIRATION DATE OF THE LICENSE: April 30, 2024

STATE OF HAWAII  
 DEPARTMENT OF TRANSPORTATION  
 HIGHWAYS DIVISION

**Roadway Plan and Profile**  
 # Sta. 154+00 to # Sta. 163+00



FARRINGTON HIGHWAY WIDENING  
 Kapolei Golf Course Road to Fort Weaver Road  
 Project No. 7101A-01-20

Scale: As Shown      Date: April 2022

DATE	SURVEY PLOTTED BY
DATE	DRAWN BY
DATE	TRACED BY
DATE	QUANTITIES BY
DATE	CHECKED BY

**Farrington Highway Profile - (# Sta. 154+00 to # Sta. 163+00)**  
 Scales: Hor.: 1" = 40'  
 Vert.: 1" = 8'

FED. ROAD DIST. NO.	STATE	PROJ. NO.	FISCAL YEAR	SHEET NO.	TOTAL SHEETS
HAWAII	HAW.	7101A-01-20	2021	78	767

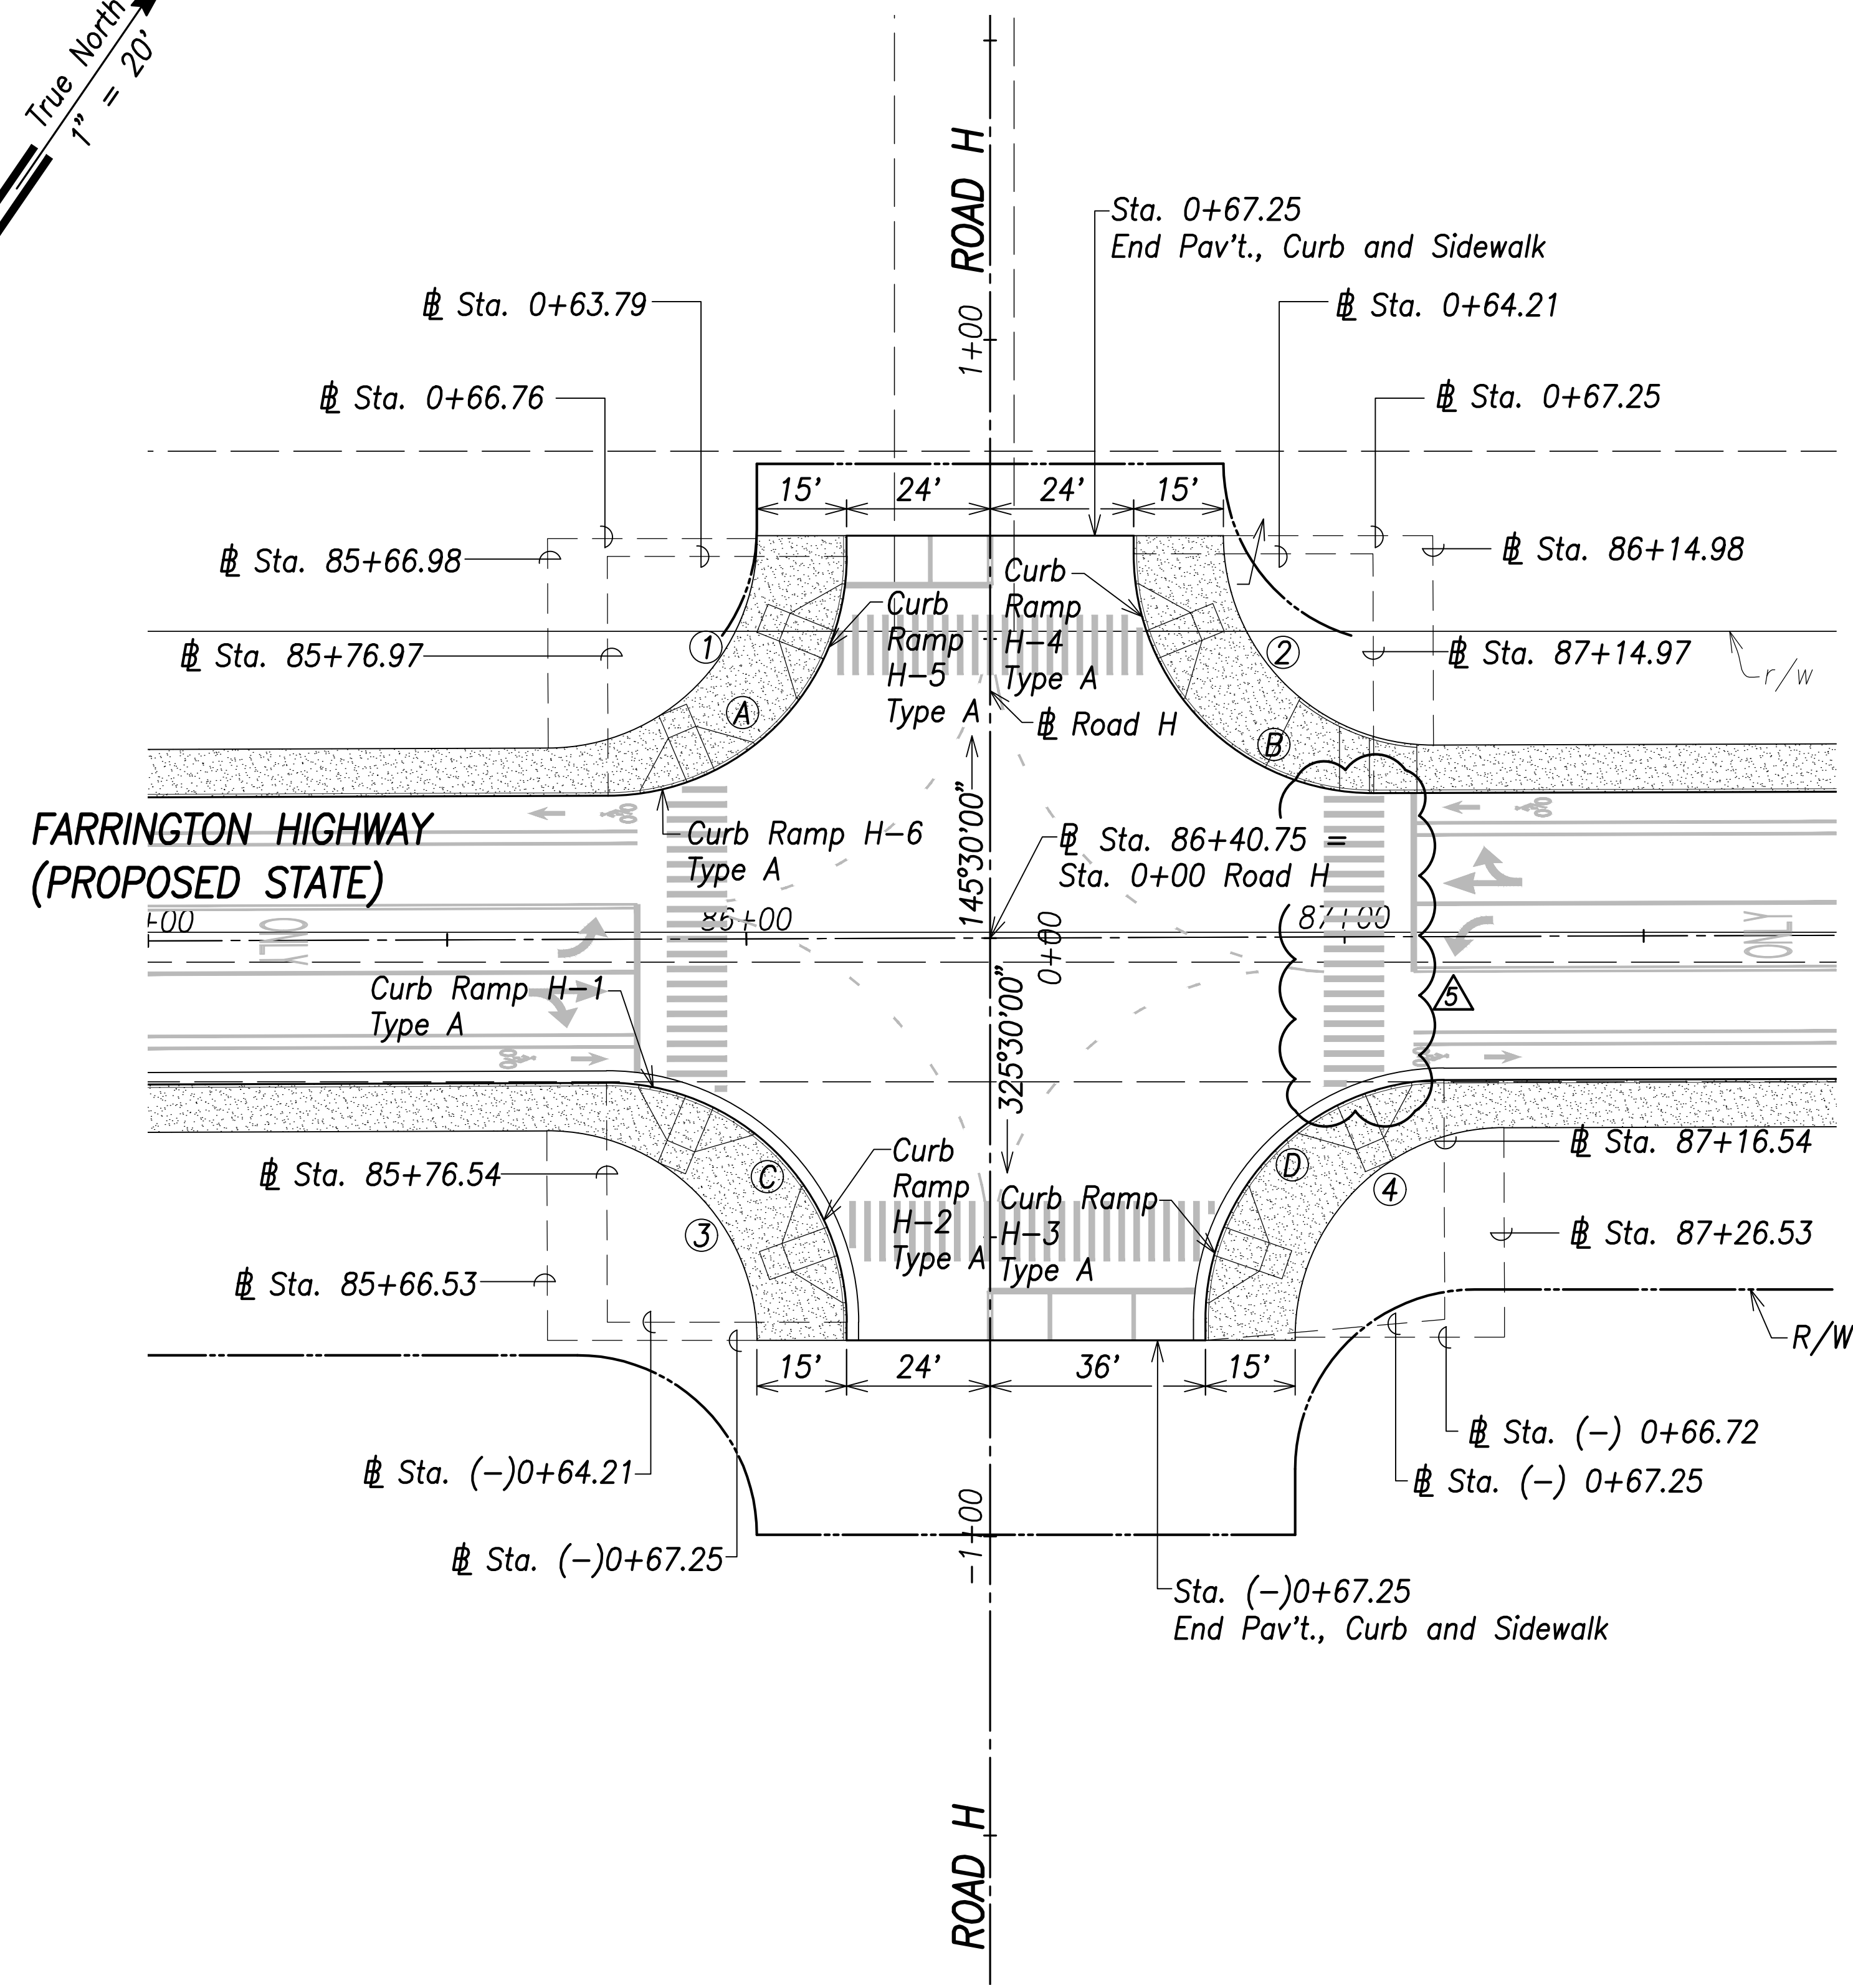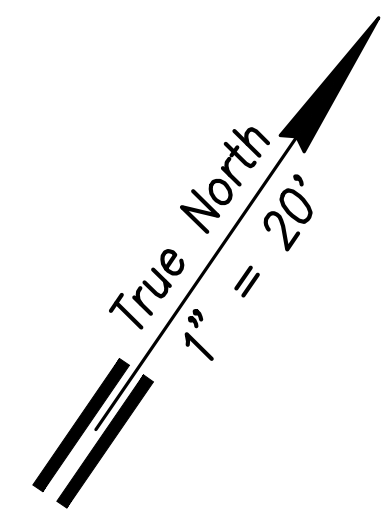


**Curb Curve Data:**

- (A)  $\Delta=89^{\circ}48'36''$   
 $\Delta/2=44^{\circ}54'84''$   
 $R=40.00'$   
 $T=39.87'$   
 $C=56.47'$   
 $Lc=62.70'$
- (B)  $\Delta=90^{\circ}11'24''$   
 $\Delta/2=45^{\circ}05'42''$   
 $R=40.00'$   
 $T=40.13'$   
 $C=56.66'$   
 $Lc=62.96'$
- (C)  $\Delta=90^{\circ}11'24''$   
 $\Delta/2=45^{\circ}05'42''$   
 $R=40.00'$   
 $T=40.13'$   
 $C=56.66'$   
 $Lc=62.96'$
- (D)  $\Delta=89^{\circ}48'36''$   
 $\Delta/2=44^{\circ}54'18''$   
 $R=40.00'$   
 $T=39.87'$   
 $C=56.47'$   
 $Lc=62.70'$

**Back of Curb Curve Data:**


- (1)  $\Delta=89^{\circ}48'36''$   
 $\Delta/2=44^{\circ}54'18''$   
 $R=35.00'$   
 $T=34.88'$   
 $C=49.42'$   
 $Lc=54.86'$
- (2)  $\Delta=90^{\circ}11'24''$   
 $\Delta/2=45^{\circ}05'42''$   
 $R=35.00'$   
 $T=35.12'$   
 $C=49.58'$   
 $Lc=55.09'$
- (3)  $\Delta=90^{\circ}11'24''$   
 $\Delta/2=45^{\circ}05'42''$   
 $R=35.00'$   
 $T=35.12'$   
 $C=49.58'$   
 $Lc=55.09'$
- (4)  $\Delta=89^{\circ}48'36''$   
 $\Delta/2=44^{\circ}54'18''$   
 $R=35.00'$   
 $T=34.88'$   
 $C=49.42'$   
 $Lc=54.86'$

**Curb Return Grades:**  
(Elevations refer to top of curb)

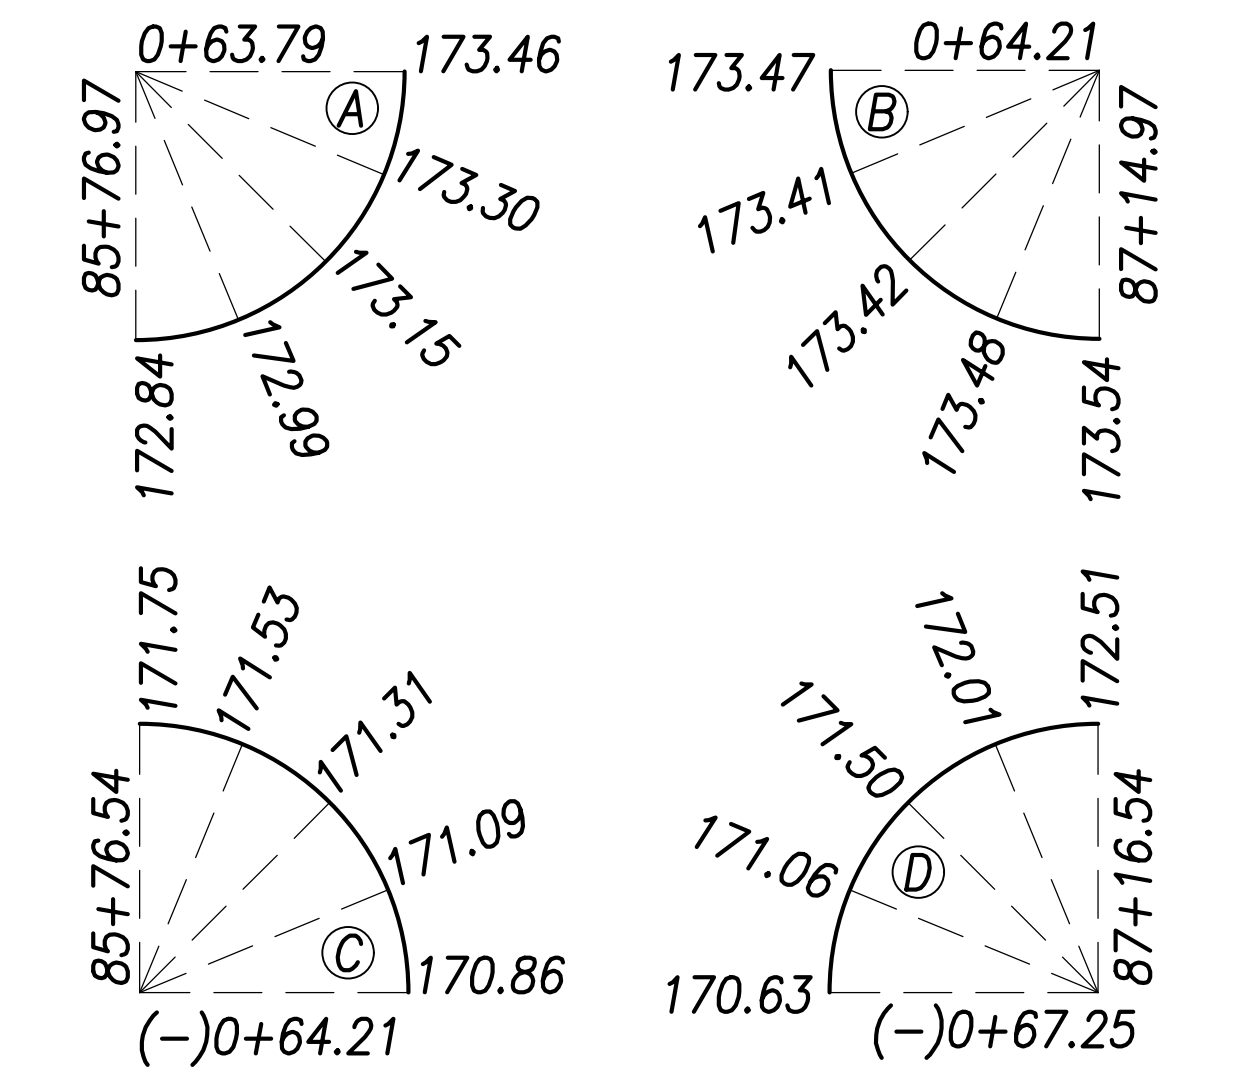


**Notes:**

- For roadway plans and profiles, see sheets C-50 to C-68.
- For roadway grading, drainage, and stormwater quality, see sheets C-86 to C-103.
- For curb ramp layout and grading, see sheets C-184 to C-202.
- Future HECO Electrical System, Construction Will Occur at the Same as this Project (Farrington Highway Improvements). The Contractor Shall Fully Coordinate Work with HECO and their Contractor. The Cost to Coordinate Work Will be Considered Incidental to the Various Items of Work.

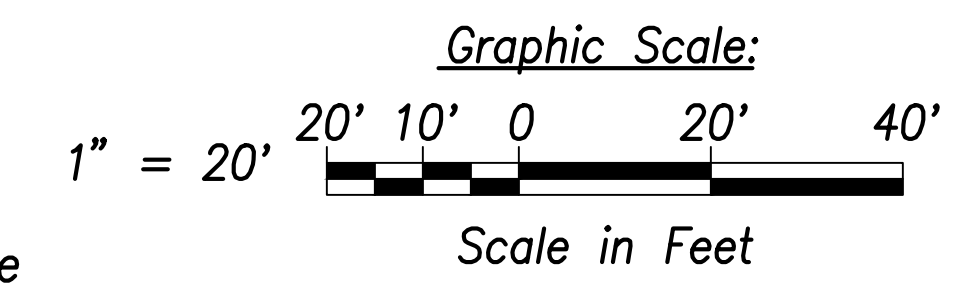

SURVEY PLOTTED BY	DATE
DRAWN BY	
TRACED BY	
DESIGNED BY	
CHECKED BY	
ORIGINAL PLAN NOTE BOOK No.	

**Intersection Plan - Intersection H**  
Scale: 1" = 20'

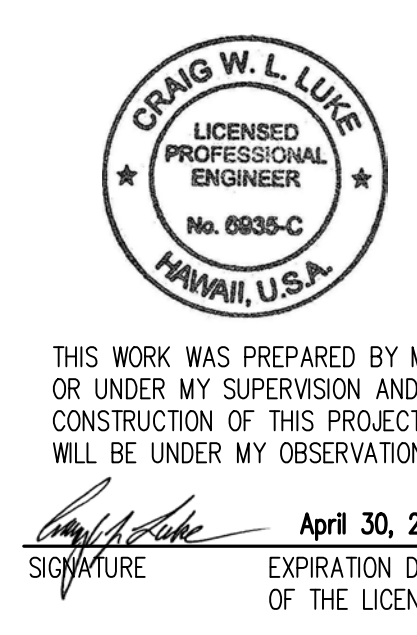

07/15/22 Speed Table removed

STATE OF HAWAII  
DEPARTMENT OF TRANSPORTATION  
HIGHWAYS DIVISION

**Intersection Plan**  
**Intersection H**

FARRINGTON HIGHWAY WIDENING  
Kapolei Golf Course Road to Fort Weaver Road  
Project No. 7101A-01-20


Scale: As Shown      Date: April 2022

**SHEET No. C-77 OF 767 SHEETS**



FED. ROAD DIST. NO.	STATE	PROJ. NO.	FISCAL YEAR	SHEET NO.	TOTAL SHEETS
HAWAII	HAW.	7101A-01-20	2021	82	767

True North  
1" = 20'

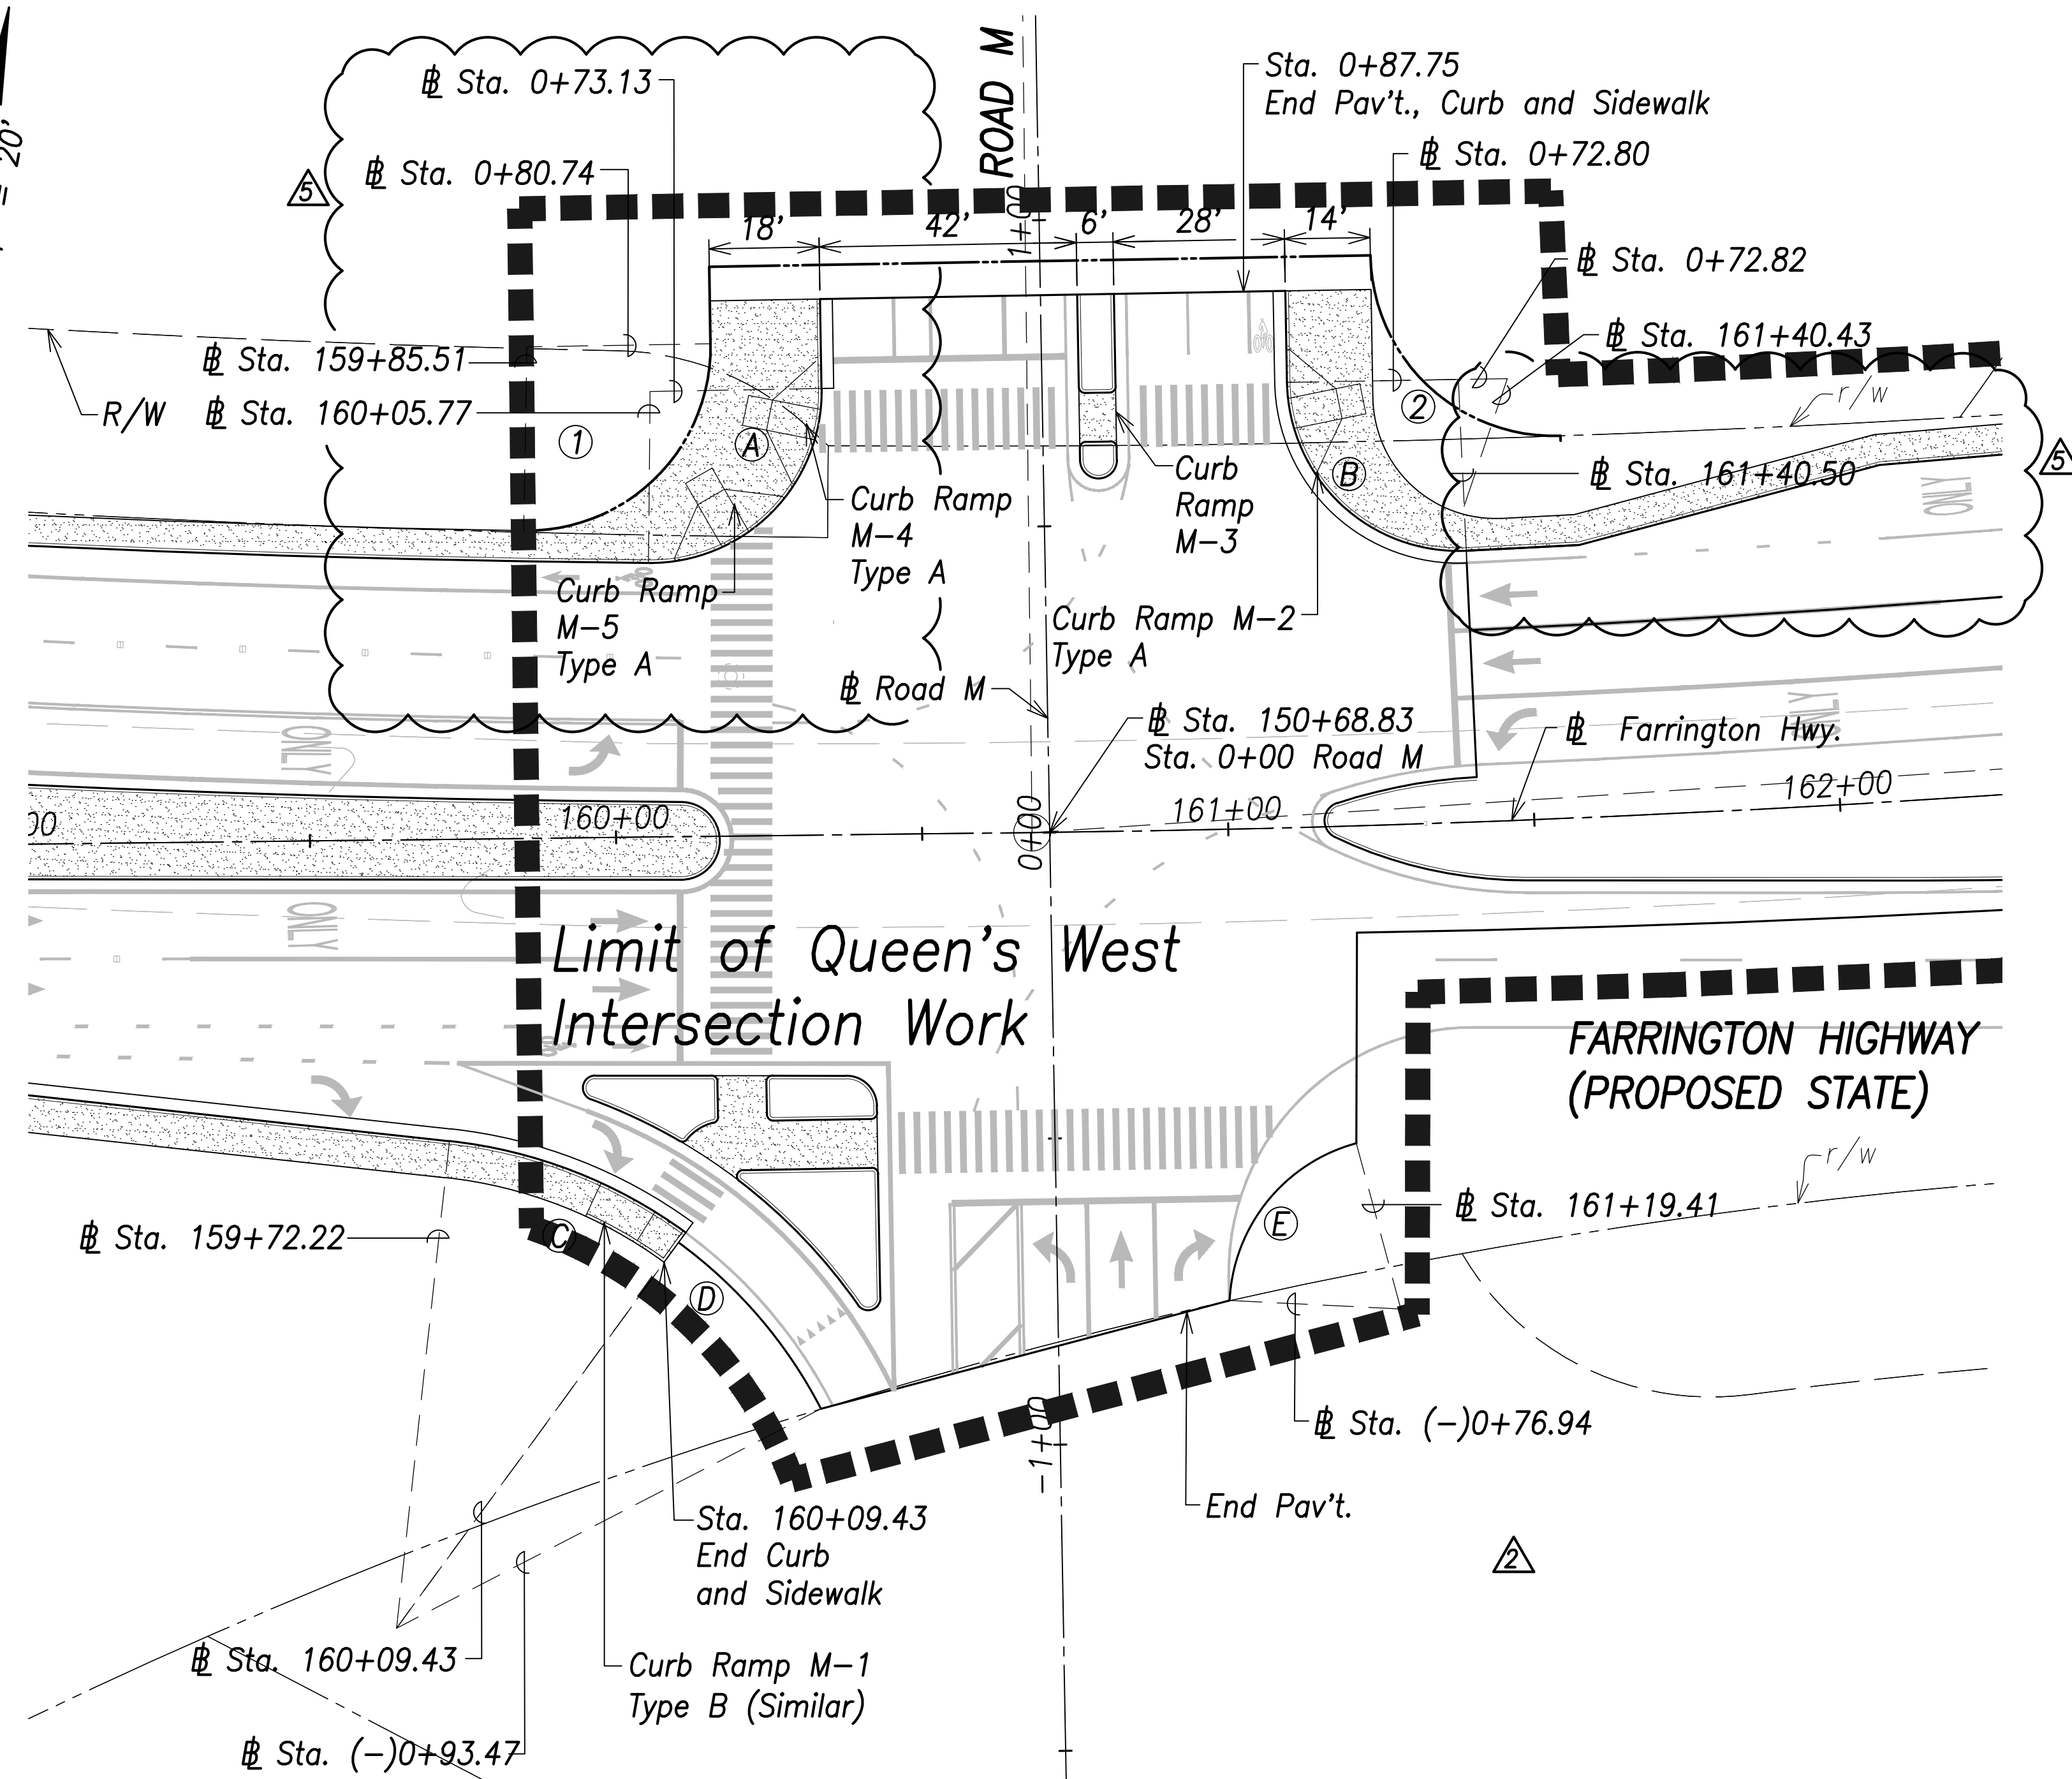


**Curb Curve Data:**

- ①  
 $\Delta=91^{\circ}32'42''$   
 $\Delta/2=45^{\circ}46'21''$   
 $R=28.00'$   
 $T=28.77'$   
 $C=40.13'$   
 $Lc=44.74'$
- ②  
 $\Delta=91^{\circ}40'23''$   
 $\Delta/2=45^{\circ}50'12''$   
 $R=28.00'$   
 $T=28.83'$   
 $C=40.17'$   
 $Lc=44.80'$
- ③  
 $\Delta=29^{\circ}58'43''$   
 $\Delta/2=14^{\circ}59'21''$   
 $R=80.00'$   
 $T=21.42'$   
 $C=41.38'$   
 $Lc=41.86'$

**Back of Sidewalk Data:**

- ①  
 $\Delta=91^{\circ}57'48''$   
 $\Delta/2=45^{\circ}58'54''$   
 $R=30.00'$   
 $T=31.05'$   
 $C=43.15'$   
 $Lc=48.15'$
- ②  
 $\Delta=70^{\circ}21'32''$   
 $\Delta/2=35^{\circ}10'46''$   
 $R=22.00'$   
 $T=15.51'$   
 $C=25.35'$   
 $Lc=27.02'$



**Curb Return Grades:**  
(Elevations refer to top of curb)

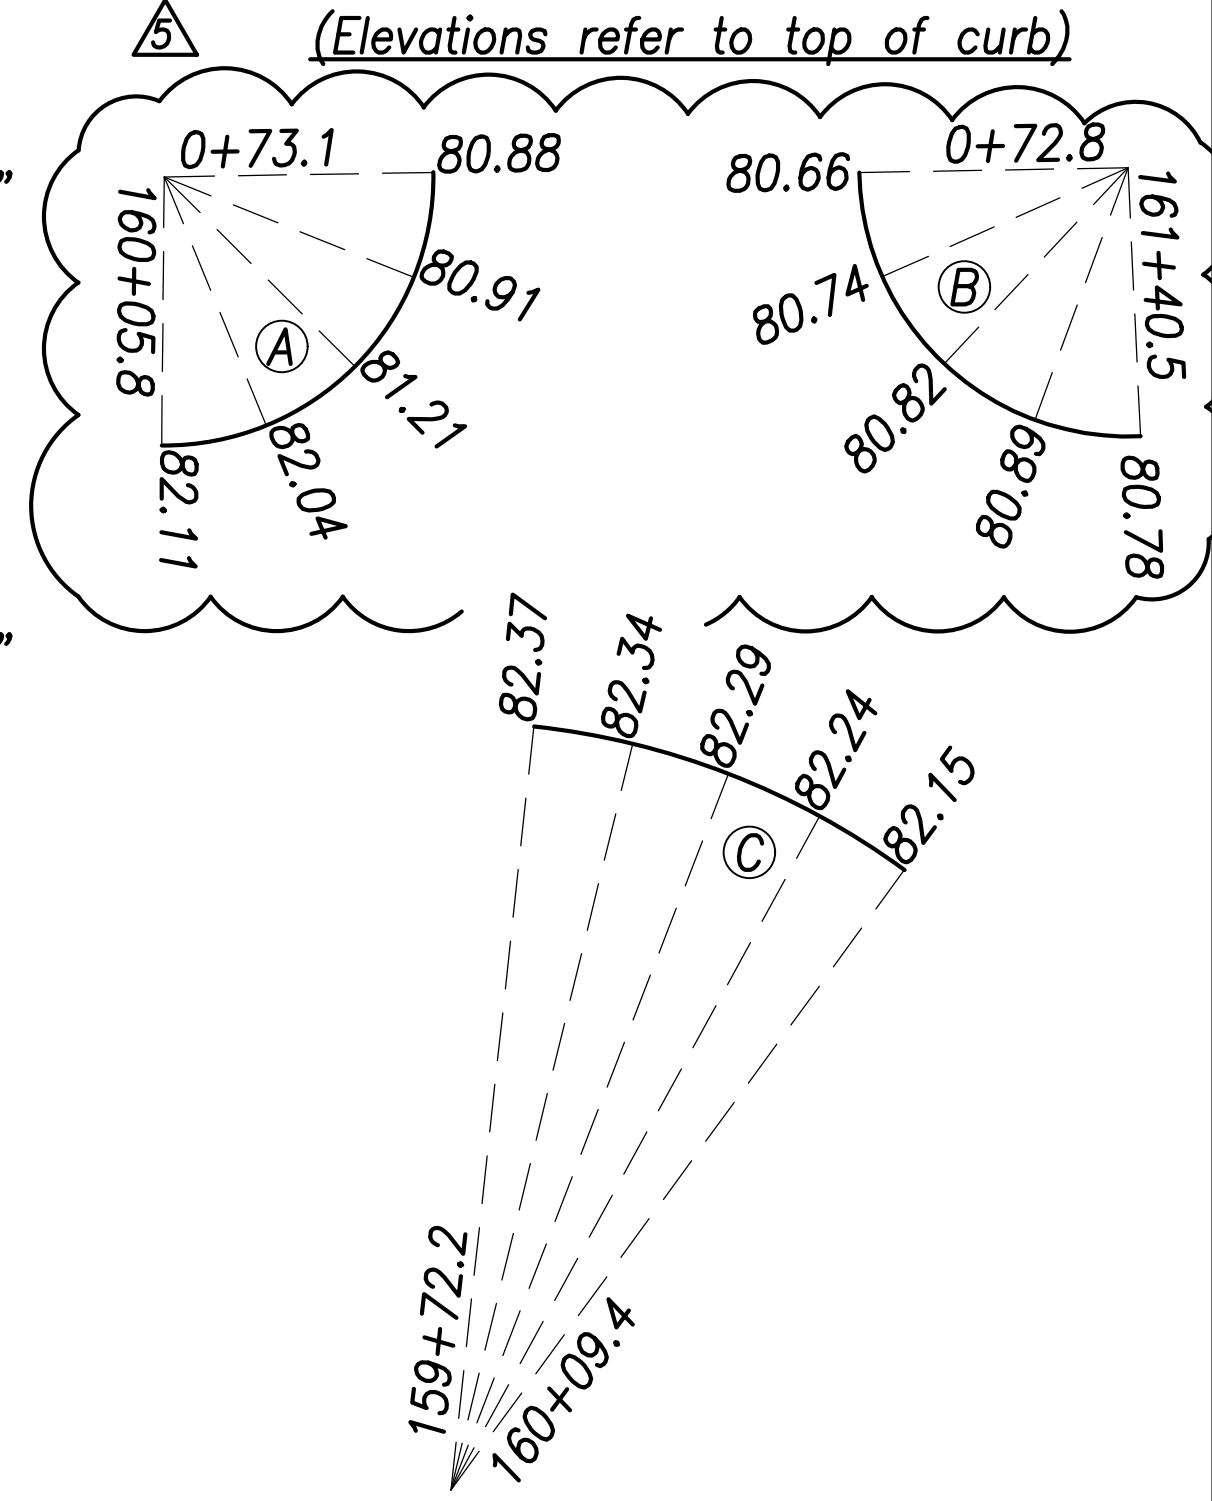

**EOP Curve Data:**

- ④  
 $\Delta=26^{\circ}29'15''$   
 $\Delta/2=13^{\circ}14'37''$   
 $R=78.00'$   
 $T=18.36'$   
 $C=35.74'$   
 $Lc=36.06'$
- ⑤  
 $\Delta=72^{\circ}07'23''$   
 $\Delta/2=36^{\circ}03'41''$   
 $R=28.00'$   
 $T=20.39'$   
 $C=32.96'$   
 $Lc=35.25'$

**EOP Return Grades:**

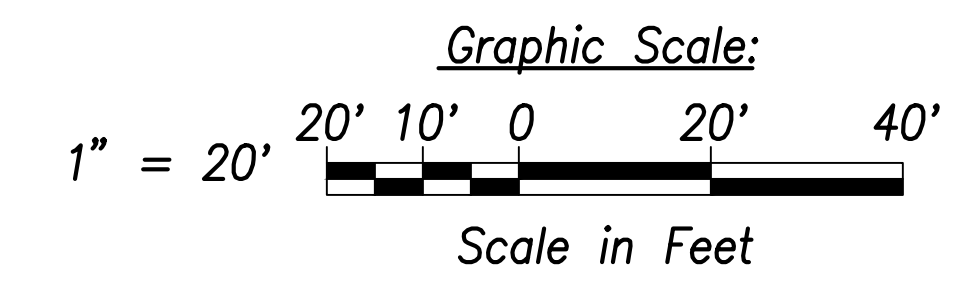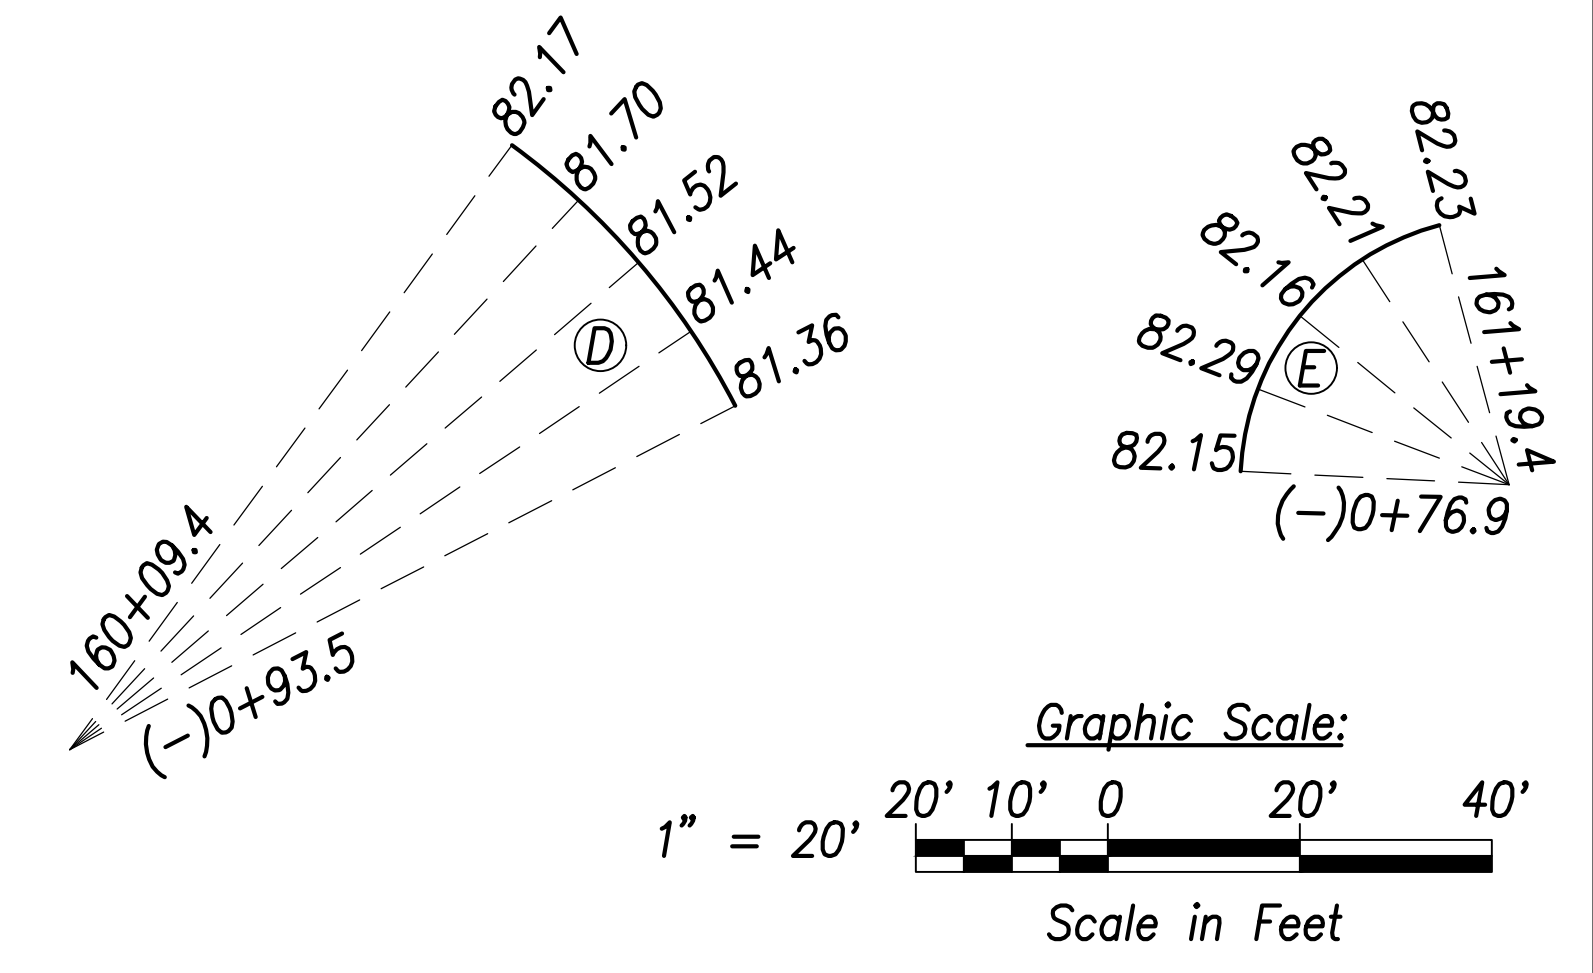

SURVEY PLOTTED BY	DATE
DRAWN BY	
TRACED BY	
QUANTITIES BY	
CHECKED BY	
ORIGINAL PLAN	
NOTE BOOK	
No.	

**Intersection Plan - Intersection M**  
Scale: 1" = 20'

**Notes:**

- For roadway plans and profiles, see sheets C-50 to C-68.
- For roadway grading, drainage, and stormwater quality, see sheets C-86 to C-103.
- For curb ramp layout and grading, see sheets C-184 to C-202.



THIS WORK WAS PREPARED BY ME OR UNDER MY SUPERVISION AND CONSTRUCTION OF THIS PROJECT WILL BE UNDER MY OBSERVATION.  
 SIGNATURE: [Signature] EXPIRATION DATE OF THE LICENSE: April 30, 2024

DATE	REVISION
07/15/22	⑤ Curb Return Revised
06/08/22	② Revised callout

STATE OF HAWAII  
**DEPARTMENT OF TRANSPORTATION**  
 HIGHWAYS DIVISION

**Intersection Plan**  
**Intersection M**


FARRINGTON HIGHWAY WIDENING  
 Kapolei Golf Course Road to Fort Weaver Road  
 Project No. 7101A-01-20

Scale: As Shown Date: April 2022



**SHEET No. C-81 OF 767 SHEETS**

FED. ROAD DIST. NO.	STATE	PROJ. NO.	FISCAL YEAR	SHEET NO.	TOTAL SHEETS
HAWAII	HAW.	7101A-01-20	2021	86	767

**Curve Data:**

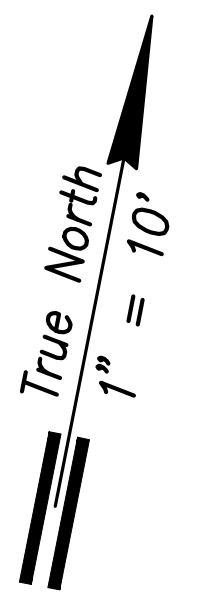

A	B	C	D	E	F	G	H	J
$\Delta=18^{\circ}46'01''$	$\Delta=8^{\circ}50'12''$	$\Delta=4^{\circ}45'50''$	$\Delta=7^{\circ}17'20''$	$\Delta=13^{\circ}40'49''$	$\Delta=12^{\circ}46'05''$	$\Delta=2^{\circ}48'16''$	$\Delta=34^{\circ}34'37''$	$\Delta=3^{\circ}14'20''$
$\Delta/2=9^{\circ}23'0.5''$	$\Delta/2=4^{\circ}25'6''$	$\Delta/2=2^{\circ}22'55''$	$\Delta/2=3^{\circ}38'40''$	$\Delta/2=6^{\circ}50'25''$	$\Delta/2=6^{\circ}23'2.4''$	$\Delta/2=1^{\circ}24'8''$	$\Delta/2=17^{\circ}17'18.5''$	$\Delta/2=1^{\circ}37'10''$
R=500.00'	R=1027.00'	R=520.00'	R=498.00'	R=519.00'	R=50.50'	R=2852.30'	R=92.60'	R=2813.3'
T=82.63'	T=79.35'	T=21.63'	T=31.72'	T=62.26'	T=5.65'	T=69.82'	T=28.82'	T=79.54'
C=163.04'	C=158.24'	C=43.22'	C=63.31'	C=123.62'	C=11.23'	C=139.59'	C=55.04'	C=159.02'
Lc=163.77'	Lc=158.39'	Lc=43.24'	Lc=63.35'	Lc=123.92'	Lc=11.25'	Lc=139.61'	Lc=55.88'	Lc=159.04'

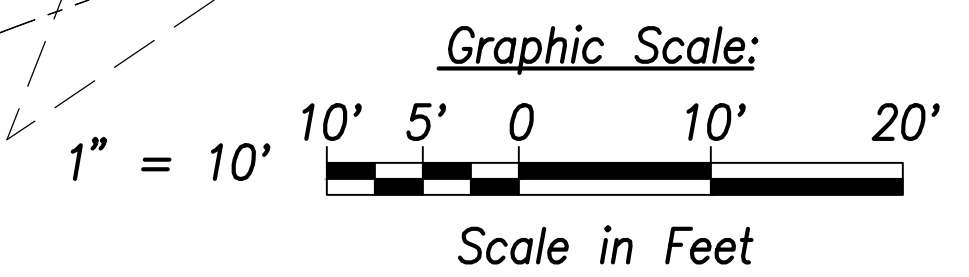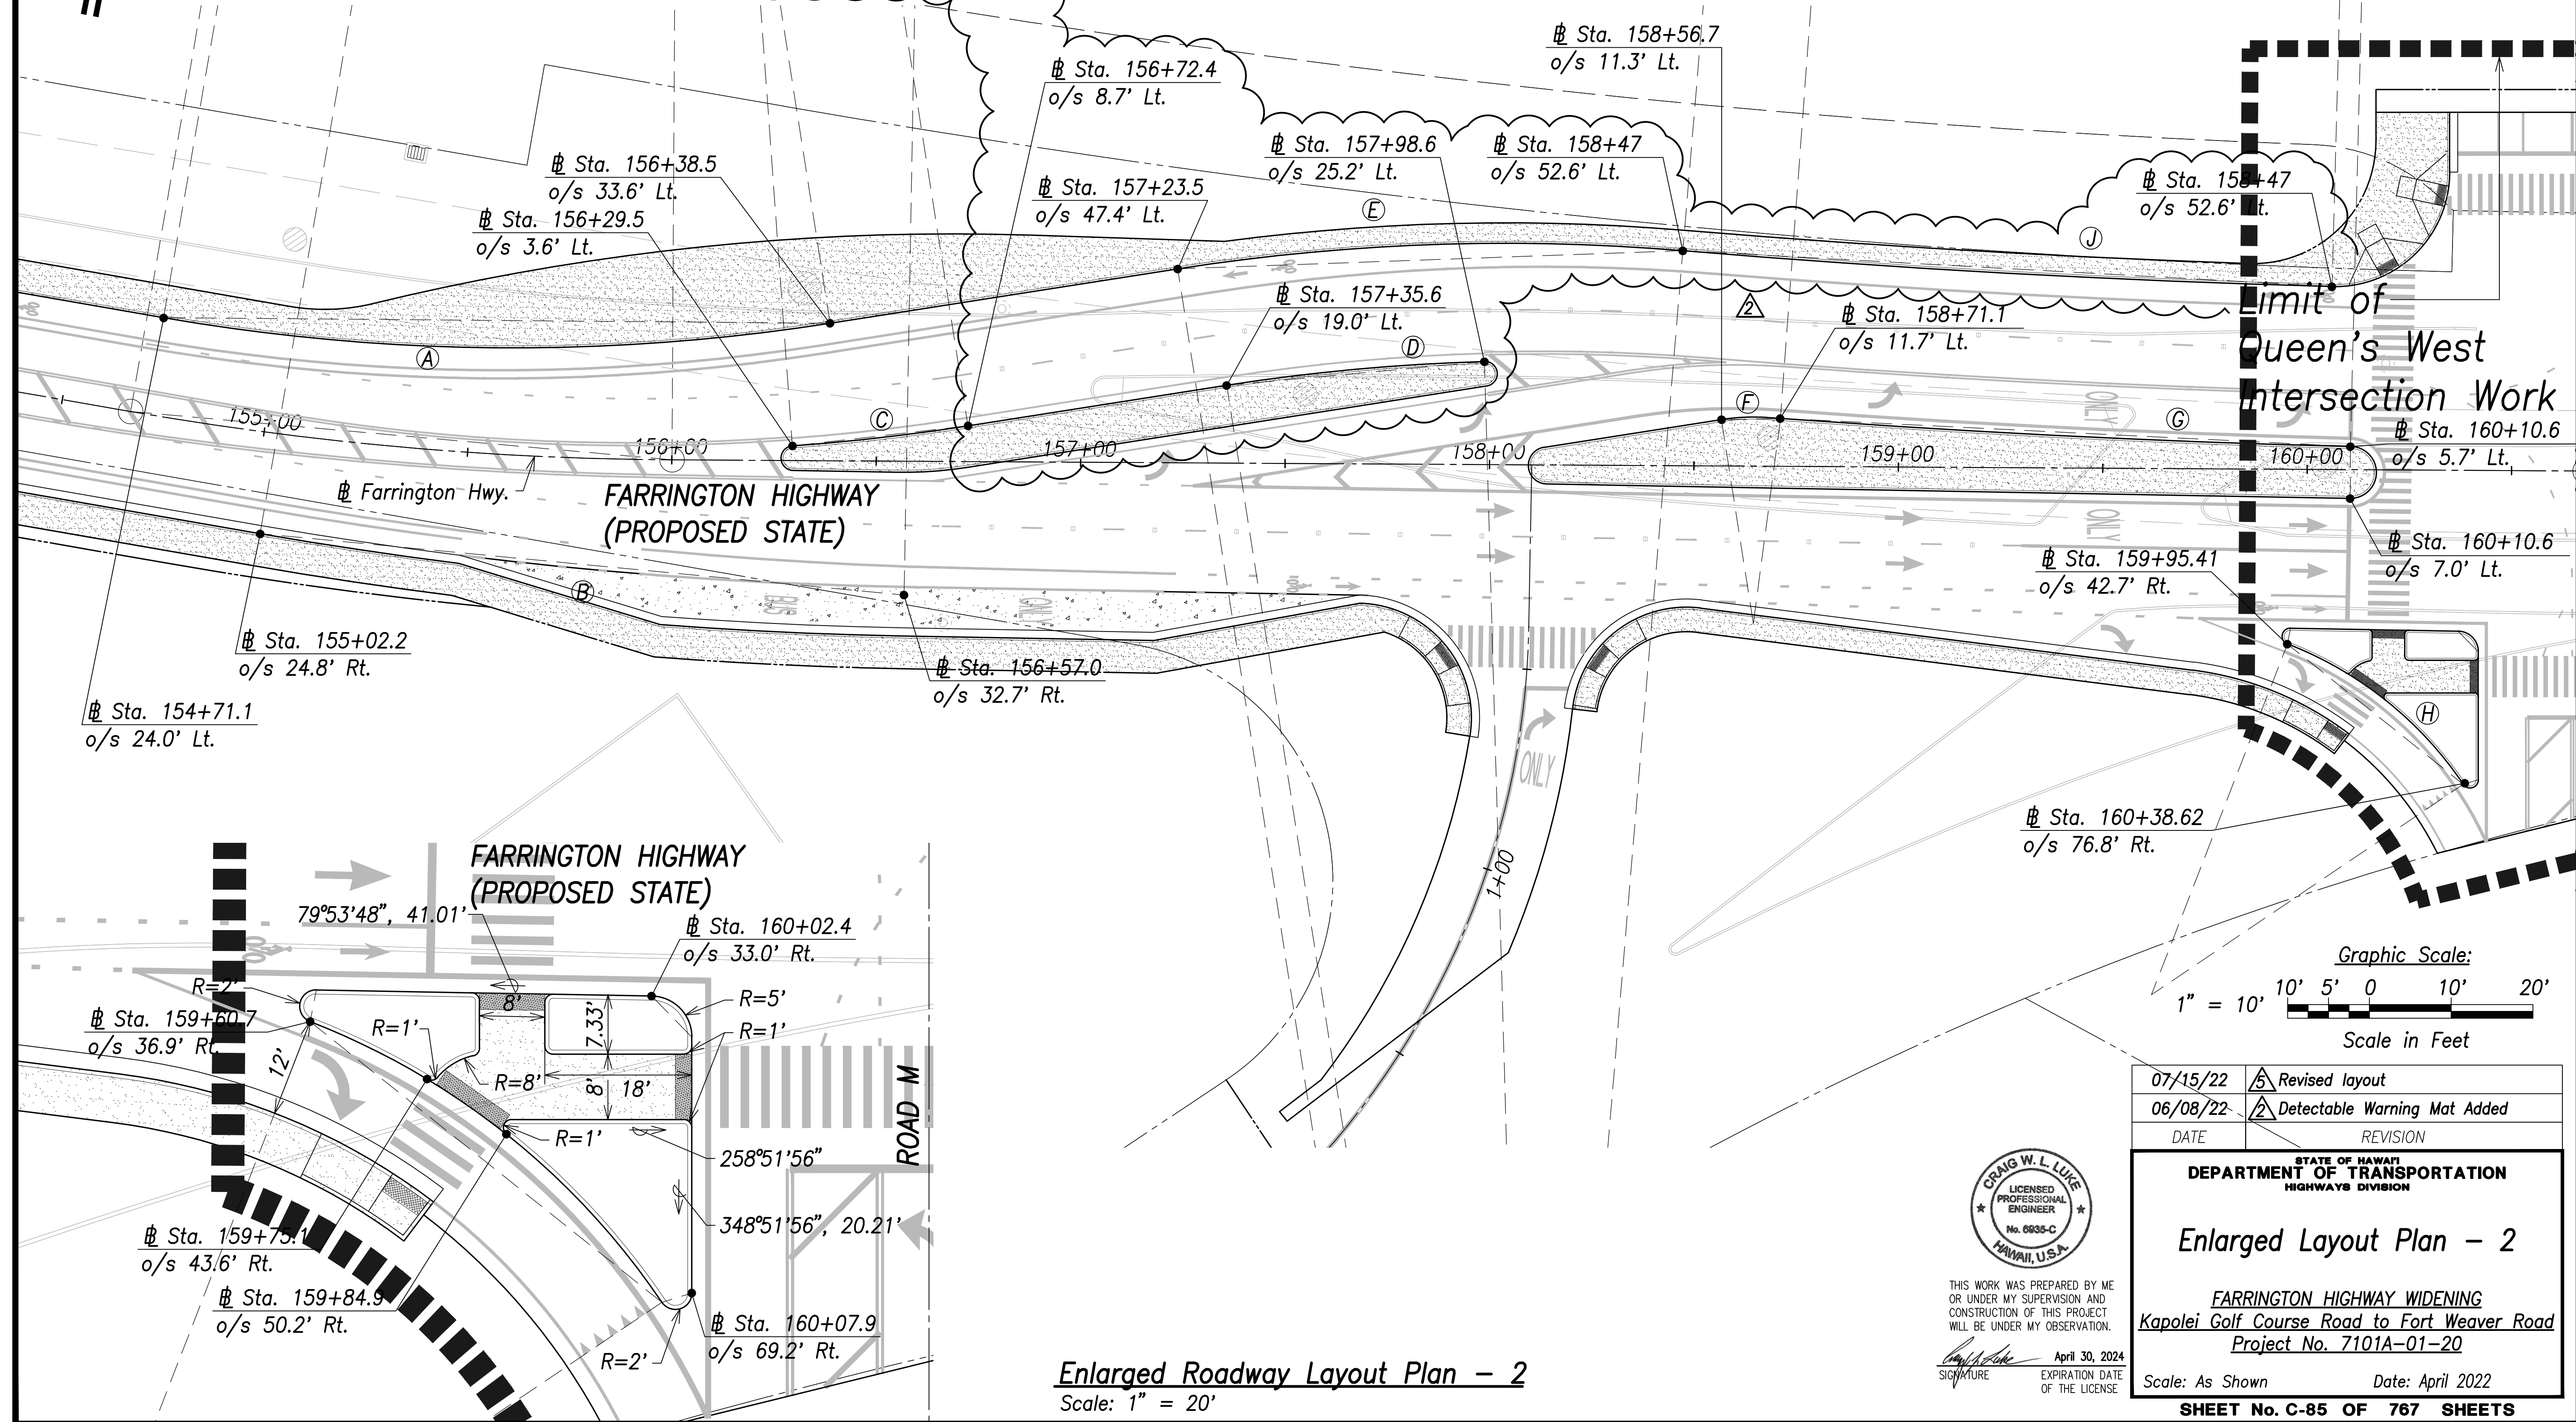

SURVEY PLOTTED BY	DATE
DRAWN BY	
TRACED BY	
NOTED BY	
CHECKED BY	
ORIGINAL PLAN	No.
NOTE BOOK	

07/15/22	5	Revised layout
06/08/22	2	Detectable Warning Mat Added
DATE		REVISION



THIS WORK WAS PREPARED BY ME OR UNDER MY SUPERVISION AND CONSTRUCTION OF THIS PROJECT WILL BE UNDER MY OBSERVATION.  
 Signature: *Craig W. Luke*  
 EXPIRATION DATE OF THE LICENSE: April 30, 2024

STATE OF HAWAII  
 DEPARTMENT OF TRANSPORTATION  
 HIGHWAYS DIVISION

**Enlarged Layout Plan - 2**

FARRINGTON HIGHWAY WIDENING  
 Kapolei Golf Course Road to Fort Weaver Road  
 Project No. 7101A-01-20

Scale: As Shown Date: April 2022



**SHEET No. C-85 OF 767 SHEETS**

**Enlarged Roadway Layout Plan - 2**  
 Scale: 1" = 20'



FED. ROAD DIST. NO.	STATE	PROJ. NO.	FISCAL YEAR	SHEET NO.	TOTAL SHEETS
HAWAII	HAW.	7101A-01-20	2021	88	767


TMK: 9-1-016: 004  
Owner: Grace Pacific

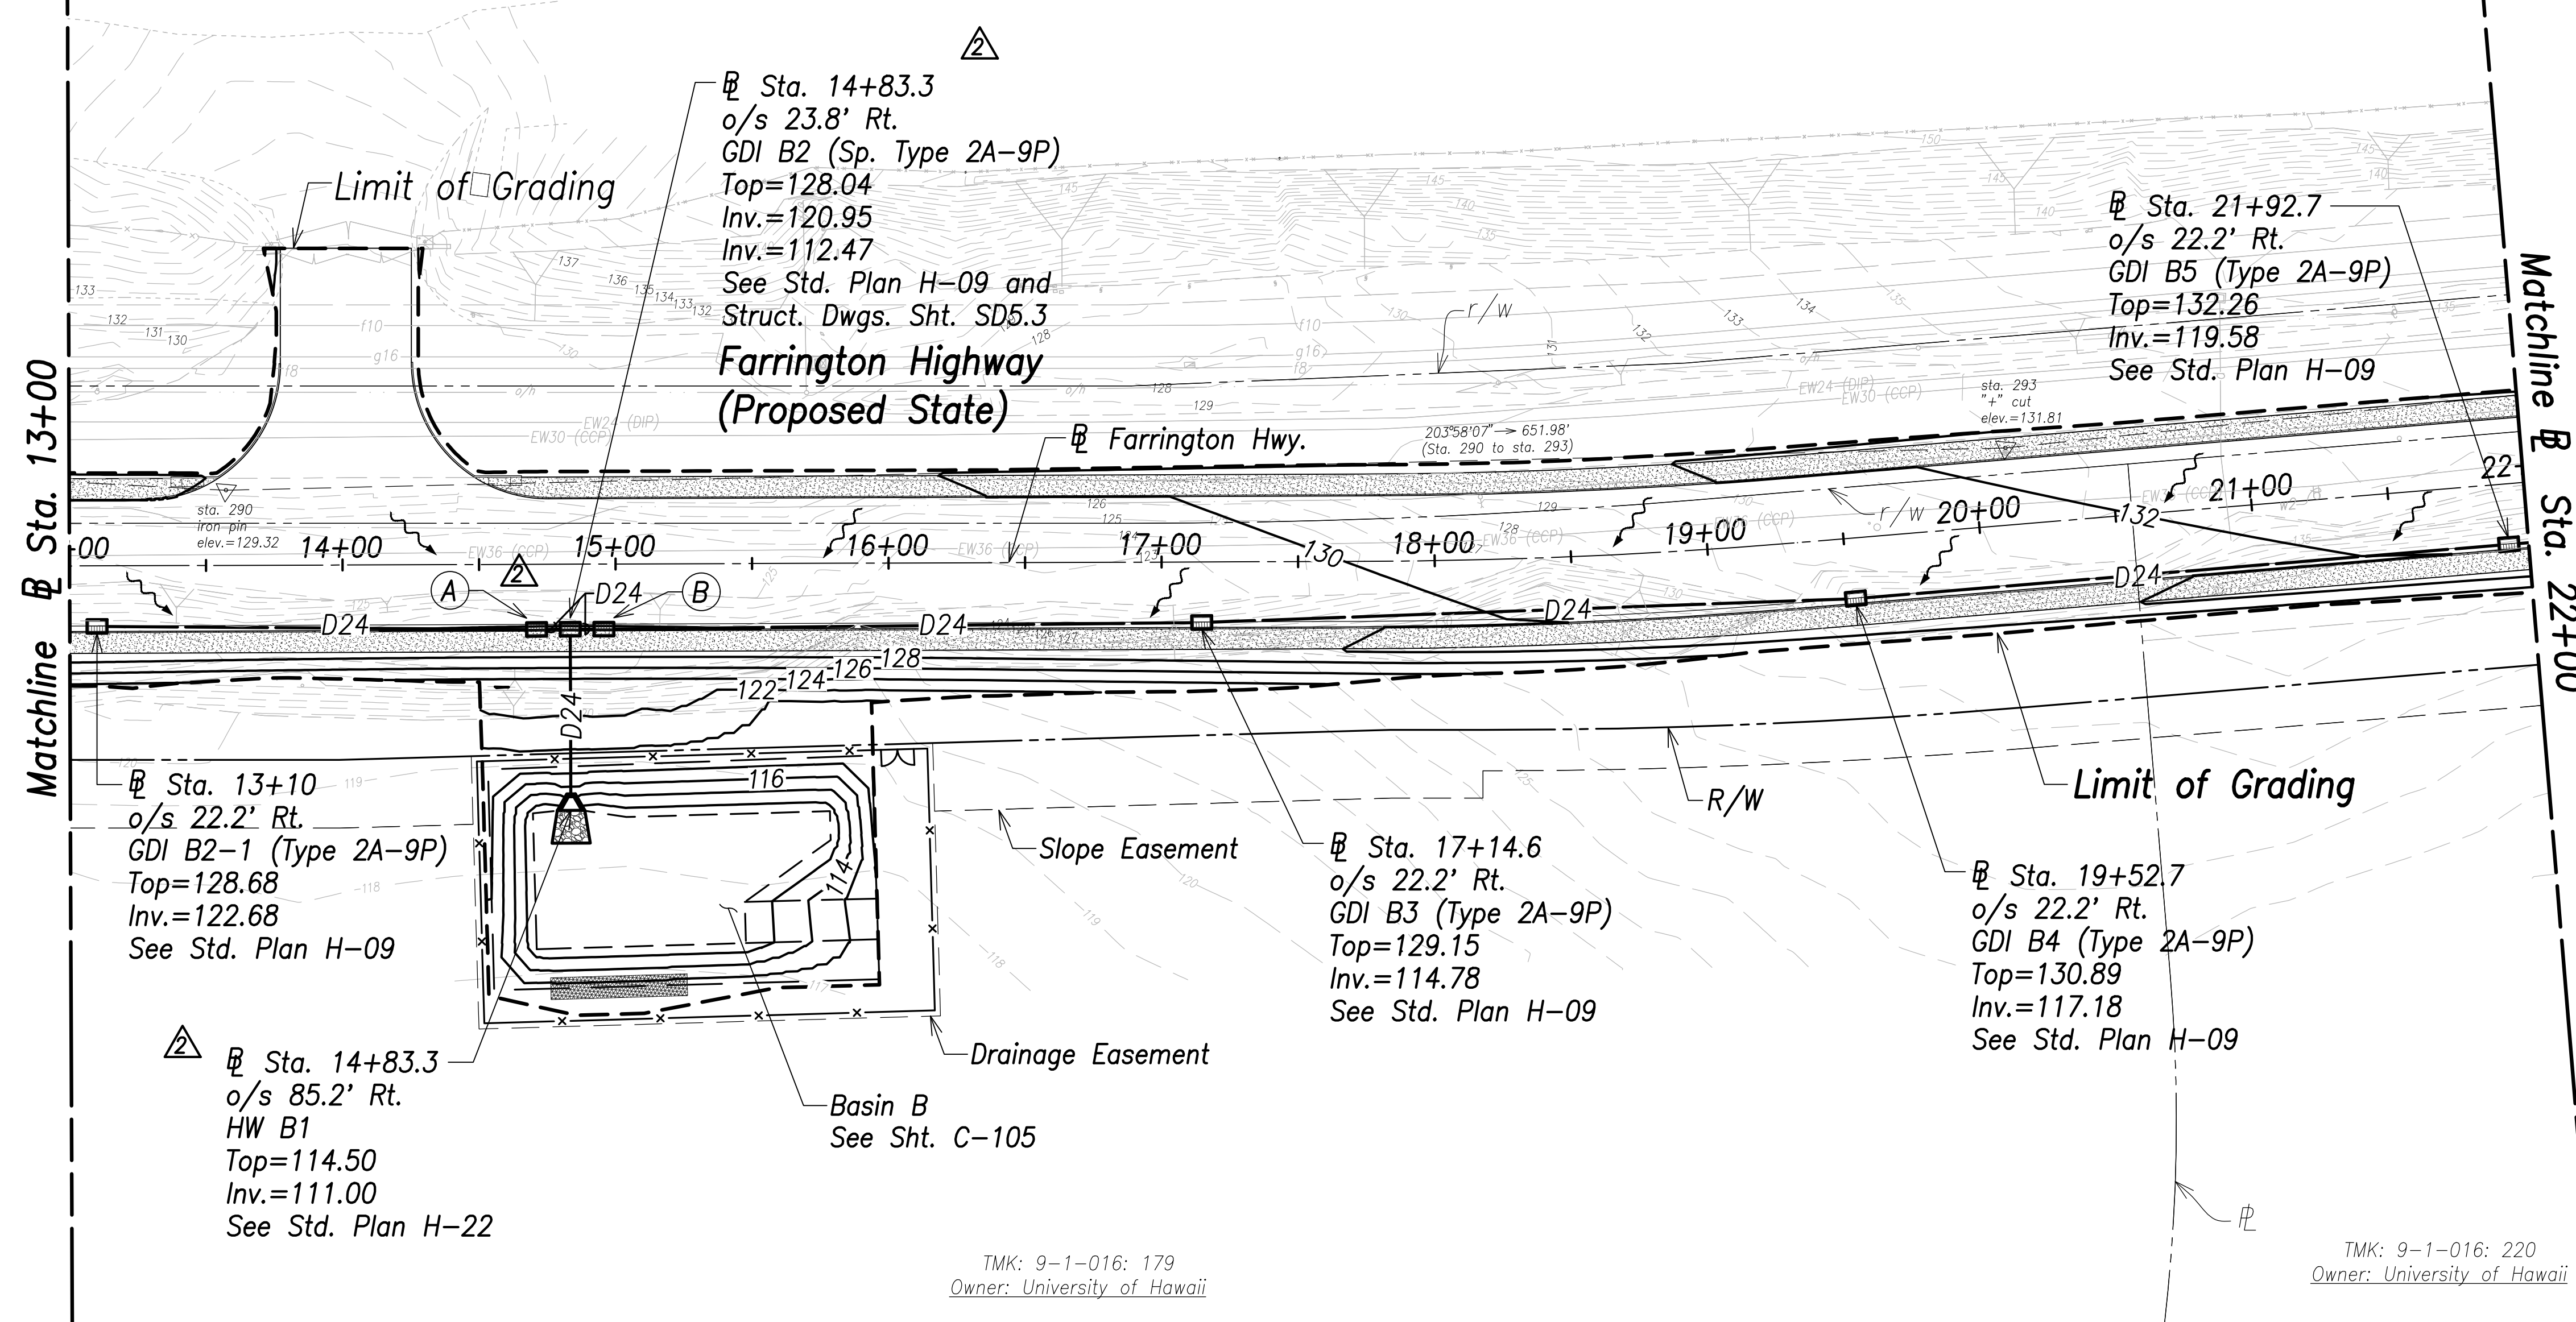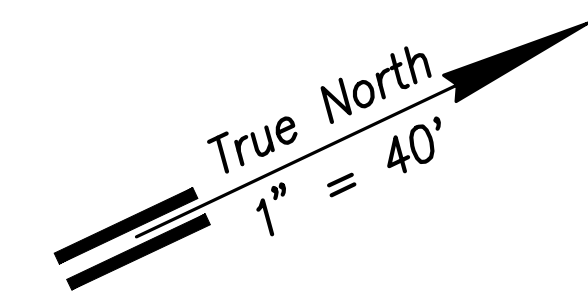

**Legend:**

	Existing Grade Contour
	Finished Grade Contour
	Limit of Grading
	Drainage Flow Direction

- Notes:**
- The Contractor Shall Construct/Phase Drainage Improvements to Avoid Flooding Adjacent Properties and Washout of Roadway.
  - See Access to Farm Lots notes on sheet C-3

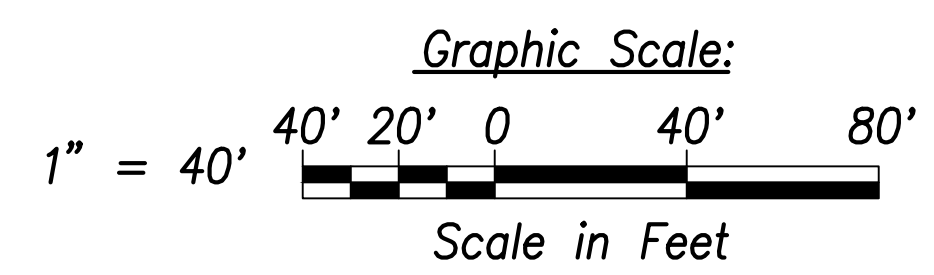

TMK: 9-1-016: 179  
Owner: University of Hawaii

TMK: 9-1-016: 220  
Owner: University of Hawaii

**Grading and Drainage Plan - (Sta. 13+00 to Sta. 22+00)**  
Scale: 1" = 40'

- (A) Sta. 14+71  
o/s 23.8' Rt.  
GDI B2-A (Sp. Type 2A-9P)  
Top=128.05  
Inv.=121.07  
See Std. Plan H-09 and Struct. Dwgs. Sht. SD5.3
- (B) Sta. 14+95.7  
o/s 23.8' Rt.  
GDI B2-B (Sp. Type 2A-9P)  
Top=128.05  
Inv.=112.59  
See Std. Plan H-09 and Struct. Dwgs. Sht. SD5.3

SURVEY PLOTTED BY	DATE
DRAWN BY	
TRACED BY	
DESIGNED BY	
CHECKED BY	
ORIGINAL PLAN	
NOTE BOOK	
No.	



THIS WORK WAS PREPARED BY ME OR UNDER MY SUPERVISION AND CONSTRUCTION OF THIS PROJECT WILL BE UNDER MY OBSERVATION.

Signature: *Craig W. L. Luke*  
April 30, 2024  
EXPIRATION DATE OF THE LICENSE

DATE	REVISION
07/15/22	Revised GDI Type
06/08/22	Revised HW B1; Revised GDI B2, B2-A, and B2-B

STATE OF HAWAII  
DEPARTMENT OF TRANSPORTATION  
HIGHWAYS DIVISION



**Grading and Drainage Plan**  
Sta. 13+00 to Sta. 22+00

FARRINGTON HIGHWAY WIDENING  
Kapolei Golf Course Road to Fort Weaver Road  
Project No. 7101A-01-20

Scale: As Shown Date: April 2022

FED. ROAD DIST. NO.	STATE	PROJ. NO.	FISCAL YEAR	SHEET NO.	TOTAL SHEETS
HAWAII	HAW.	7101A-01-20	2021	96	767

TMK: 9-1-018: 010  
Owner: D.R. Horton

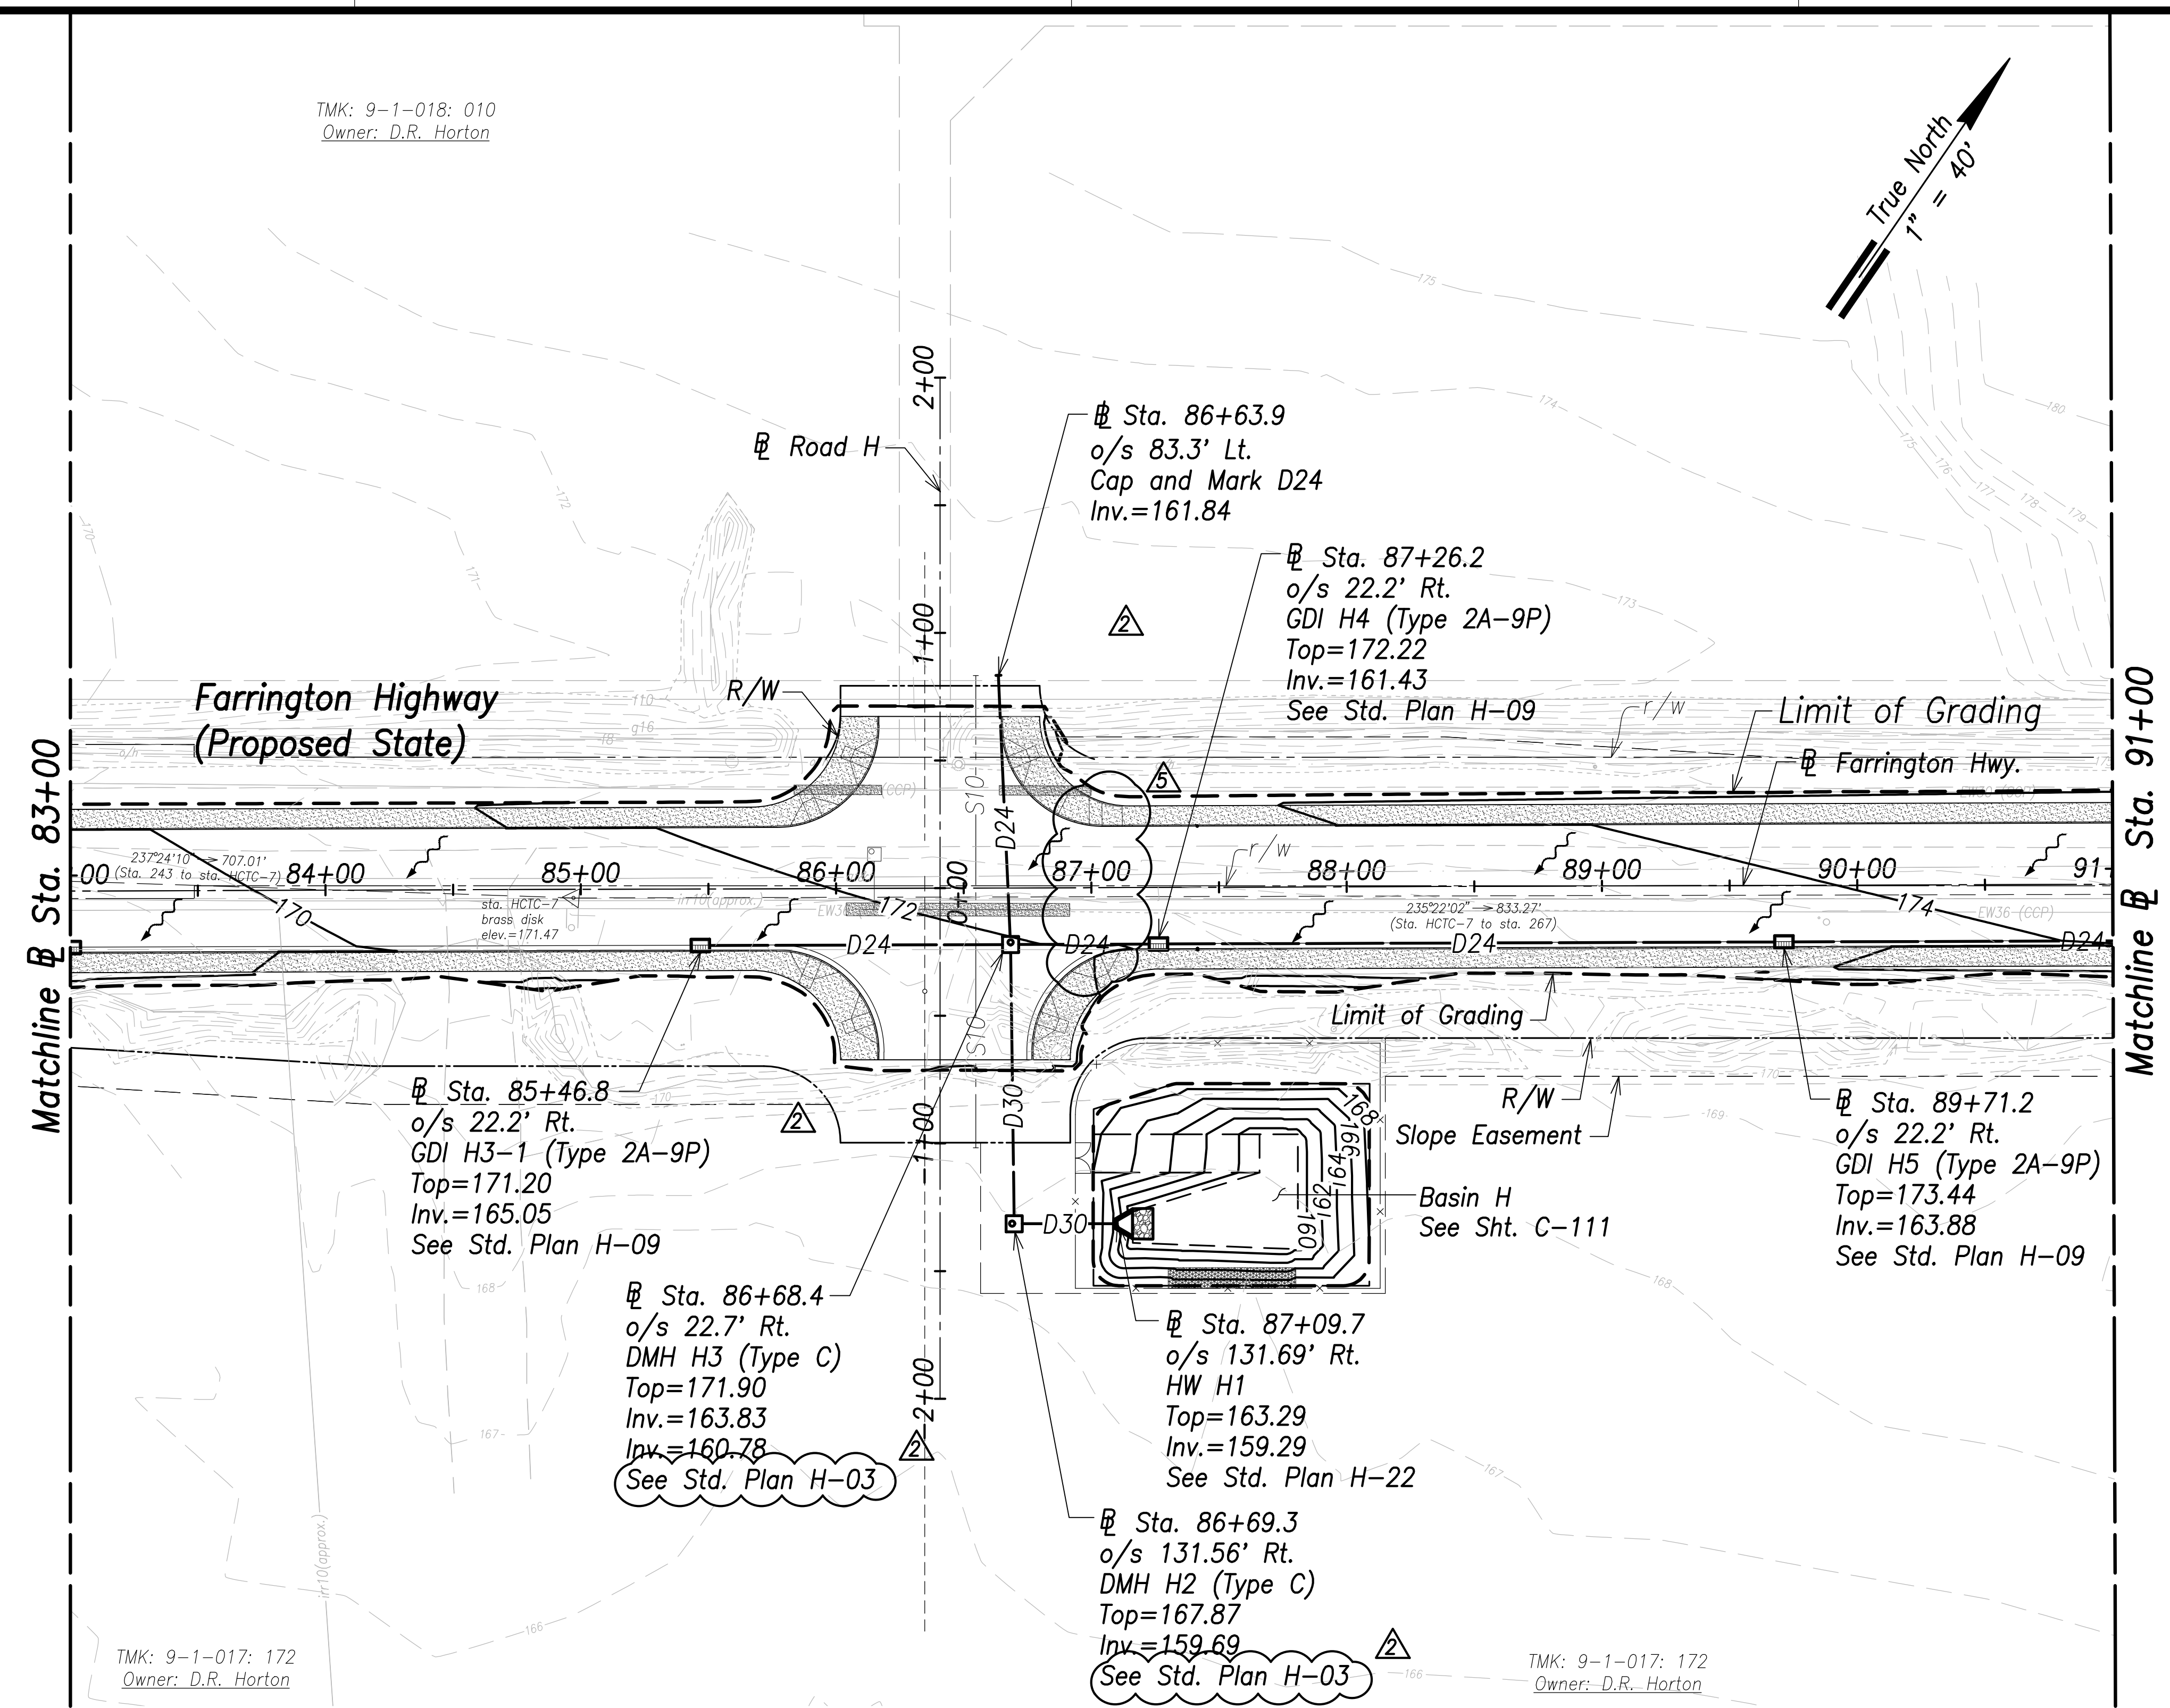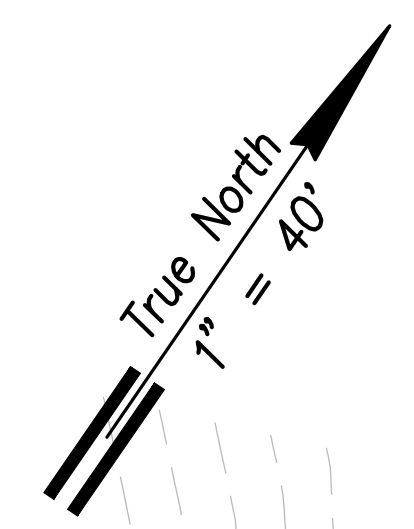


**Legend:**

- 70 Existing Grade Contour
- 100 Finished Grade Contour
- Limit of Grading
- Drainage Flow Direction

**Notes:**

1. The Contractor Shall Construct/Phase Drainage Improvements to Avoid Flooding Adjacent Properties and Washout of Roadway.
2. See Access to Farm Lots notes on sheet C-3.
3. Future HECO Electrical System, Construction Will Occur at the Same as this Project (Farrington Highway Improvements). The Contractor Shall Fully Coordinate Work with HECO and their Contractor. The Cost to Coordinate Work Will be Considered Incidental to the Various Items of Work.

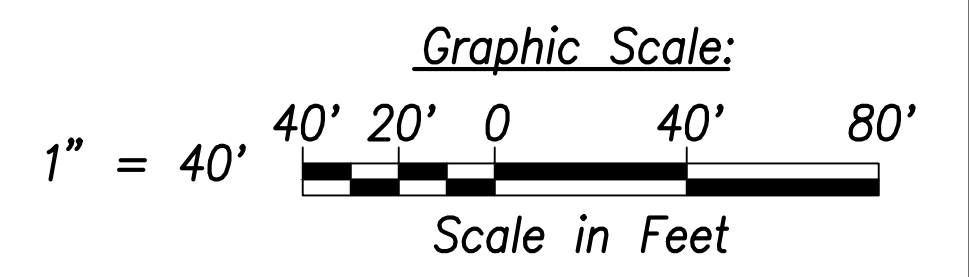

SURVEY PLOTTED BY	DATE
DRAWN BY	
TRACED BY	
DESIGNED BY	
CHECKED BY	
ORIGINAL PLAN	
NOTE BOOK	
No.	

TMK: 9-1-017: 172  
Owner: D.R. Horton

TMK: 9-1-017: 172  
Owner: D.R. Horton

**Grading and Drainage Plan - (Sta. 83+00 to Sta. 91+00)**

Scale: 1" = 40'

07/15/22	Speed Table removed
06/08/22	Revised detail reference; Revised road stub grading
DATE	REVISION



THIS WORK WAS PREPARED BY ME OR UNDER MY SUPERVISION AND CONSTRUCTION OF THIS PROJECT WILL BE UNDER MY OBSERVATION.  
SIGNATURE: *Craig W. Luke* EXPIRATION DATE OF THE LICENSE: April 30, 2024

STATE OF HAWAII  
**DEPARTMENT OF TRANSPORTATION**  
HIGHWAYS DIVISION

**Grading and Drainage Plan**  
**Sta. 83+00 to Sta. 91+00**

FARRINGTON HIGHWAY WIDENING  
Kapolei Golf Course Road to Fort Weaver Road  
Project No. 7101A-01-20


Scale: As Shown Date: April 2022







FED. ROAD DIST. NO.	STATE	PROJ. NO.	FISCAL YEAR	SHEET NO.	TOTAL SHEETS
HAWAII	HAW.	7101A-01-20	2021	102	767

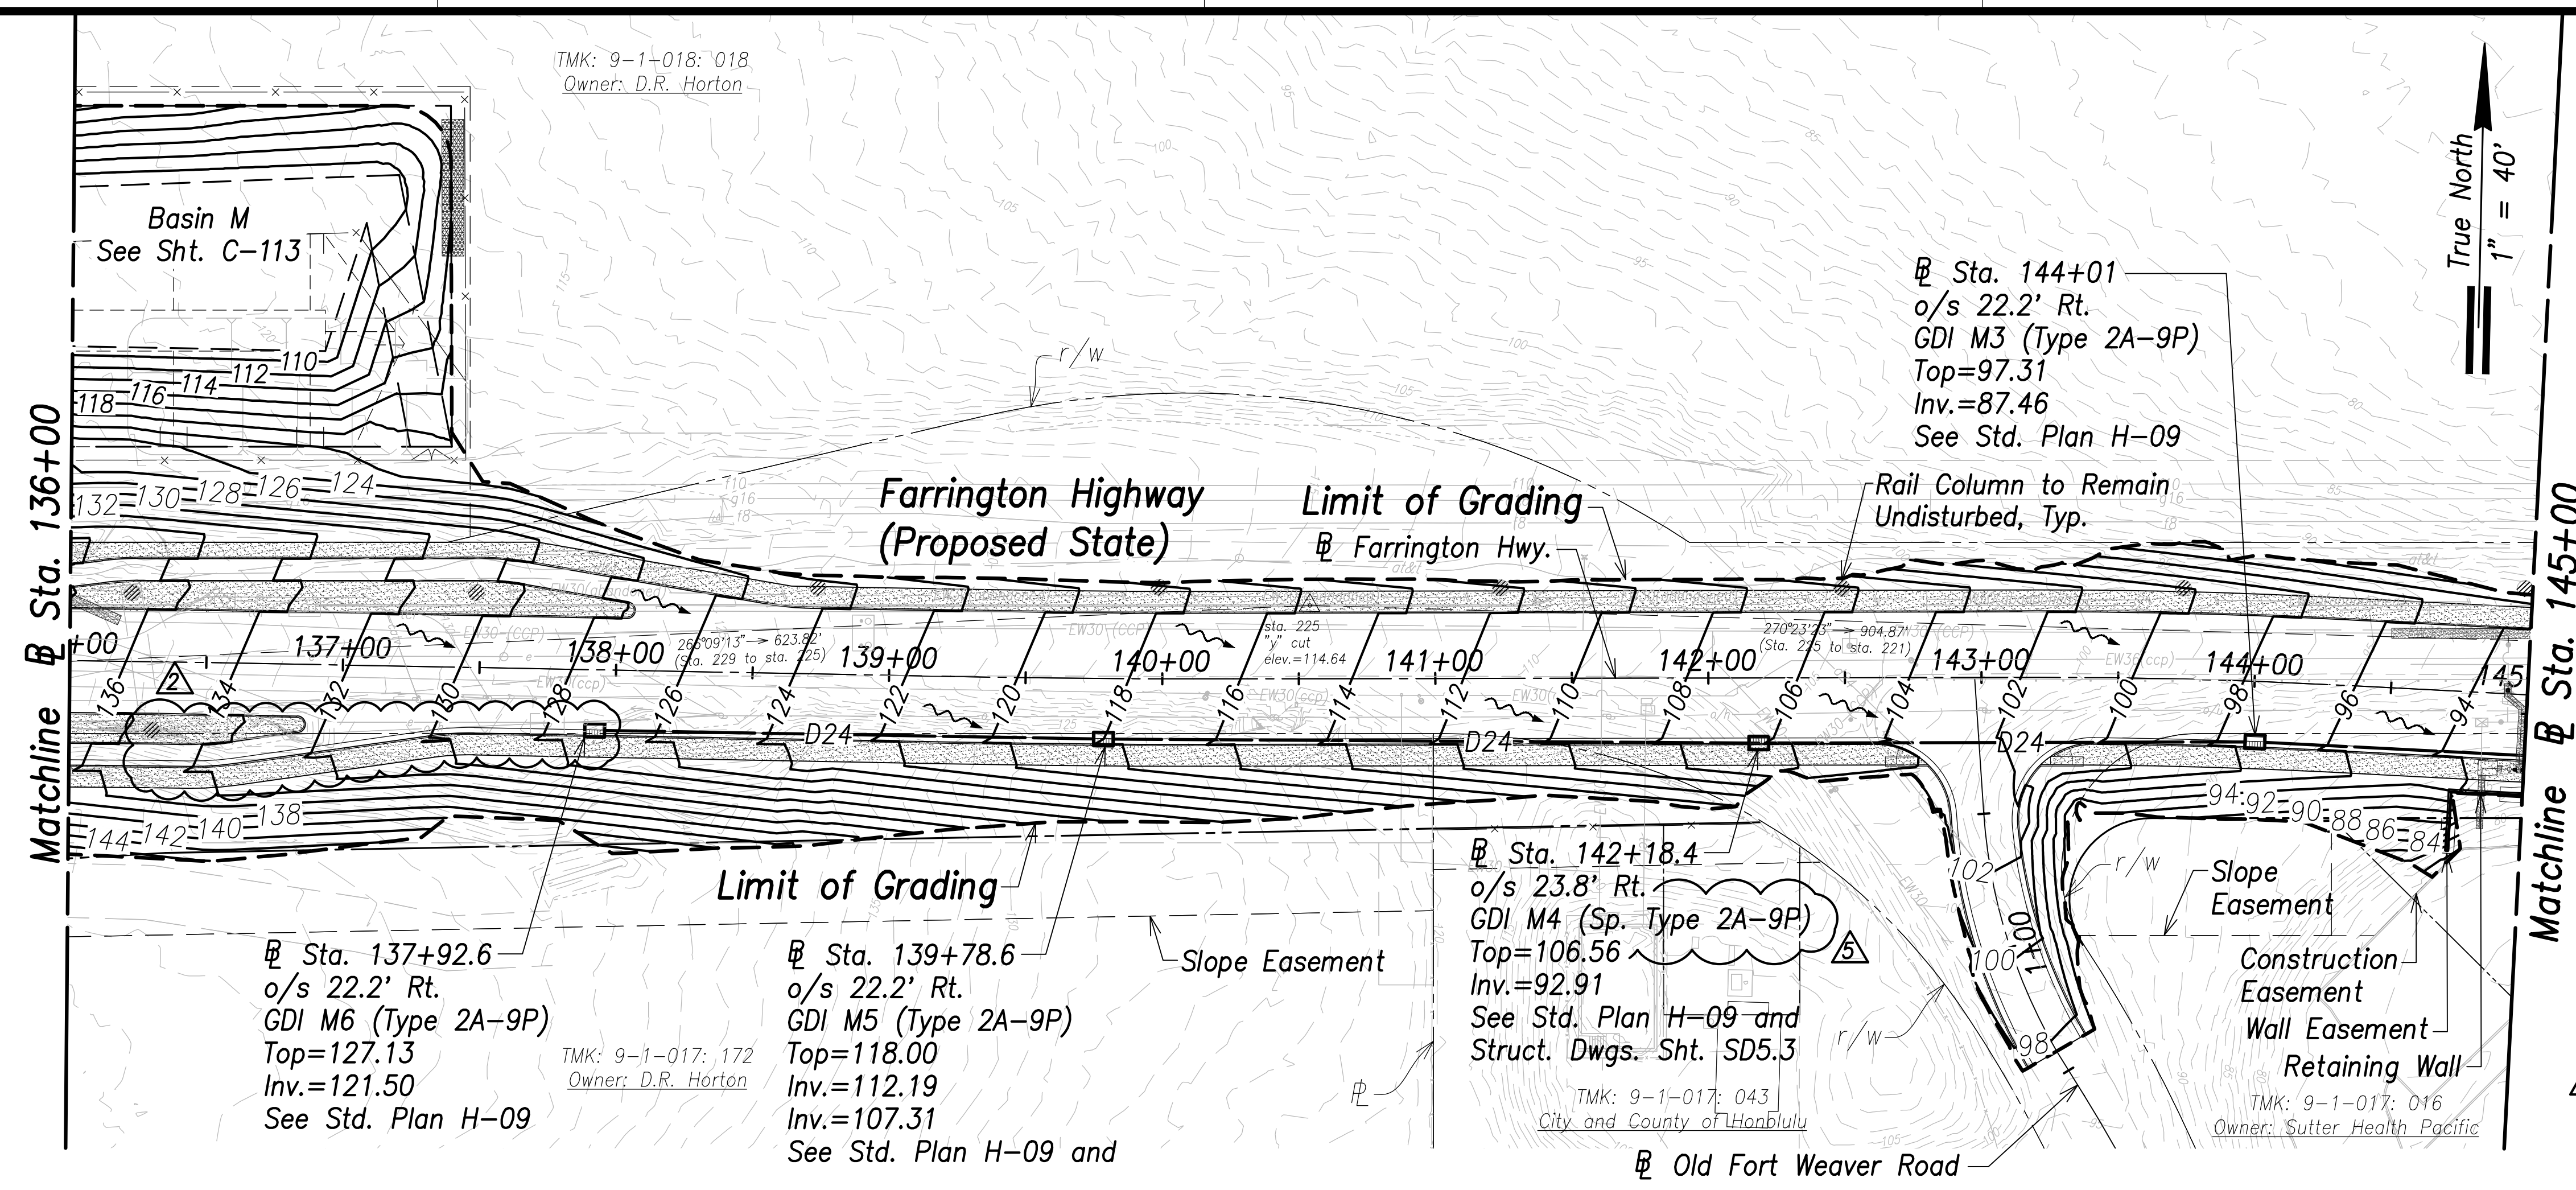

- Note:**
- The Contractor Shall Construct/Phase Drainage Improvements to Avoid Flooding Adjacent Properties and Washout of Roadway.
  - Contractor Shall Locate Guardrail Posts to Provide 2' Min. Clear From Drain Utilities.
  - Grading along the makai shoulder between Old Fort Weaver Road (West) and Honouliuli Stream Bridge, and construction of Retaining Wall must be completed within four months of receiving Notice to Proceed. The Contractor shall coordinate work with HECO.

**Grading and Drainage Plan - (Sta. 136+00 to Sta. 145+00)**  
Scale: 1" = 40'

**Legend:**

- - - - -70- - - - - Existing Grade Contour
- 100————— Finished Grade Contour
- - - - - Limit of Grading
- ~~~~~ Drainage Flow Direction

**Graphic Scale:**  
1" = 40'    40' 20' 0 40' 80'  
Scale in Feet

SURVEY PLOTTED BY	DATE
DRAWN BY	
TRACED BY	
QUANTIFIED BY	
CHECKED BY	
ORIGINAL PLAN NOTE BOOK No.	



THIS WORK WAS PREPARED BY ME OR UNDER MY SUPERVISION AND CONSTRUCTION OF THIS PROJECT WILL BE UNDER MY OBSERVATION.

Signature: *Craig W. Luke*  
April 30, 2024  
EXPIRATION DATE OF THE LICENSE

DATE	REVISION
07/15/22	Revised GDI Type
06/08/22	Removed drain line and blocks, added notes

STATE OF HAWAII  
**DEPARTMENT OF TRANSPORTATION**  
HIGHWAYS DIVISION

**Grading and Drainage Plan**  
Sta. 136+00 to Sta. 145+00


FARRINGTON HIGHWAY WIDENING  
Kapolei Golf Course Road to Fort Weaver Road  
Project No. 7101A-01-20

Scale: As Shown      Date: April 2022

**SHEET No. C-101 OF 767 SHEETS**



FED. ROAD DIST. NO.	STATE	PROJ. NO.	FISCAL YEAR	SHEET NO.	TOTAL SHEETS
HAWAII	HAW.	7101A-01-20	2021		767

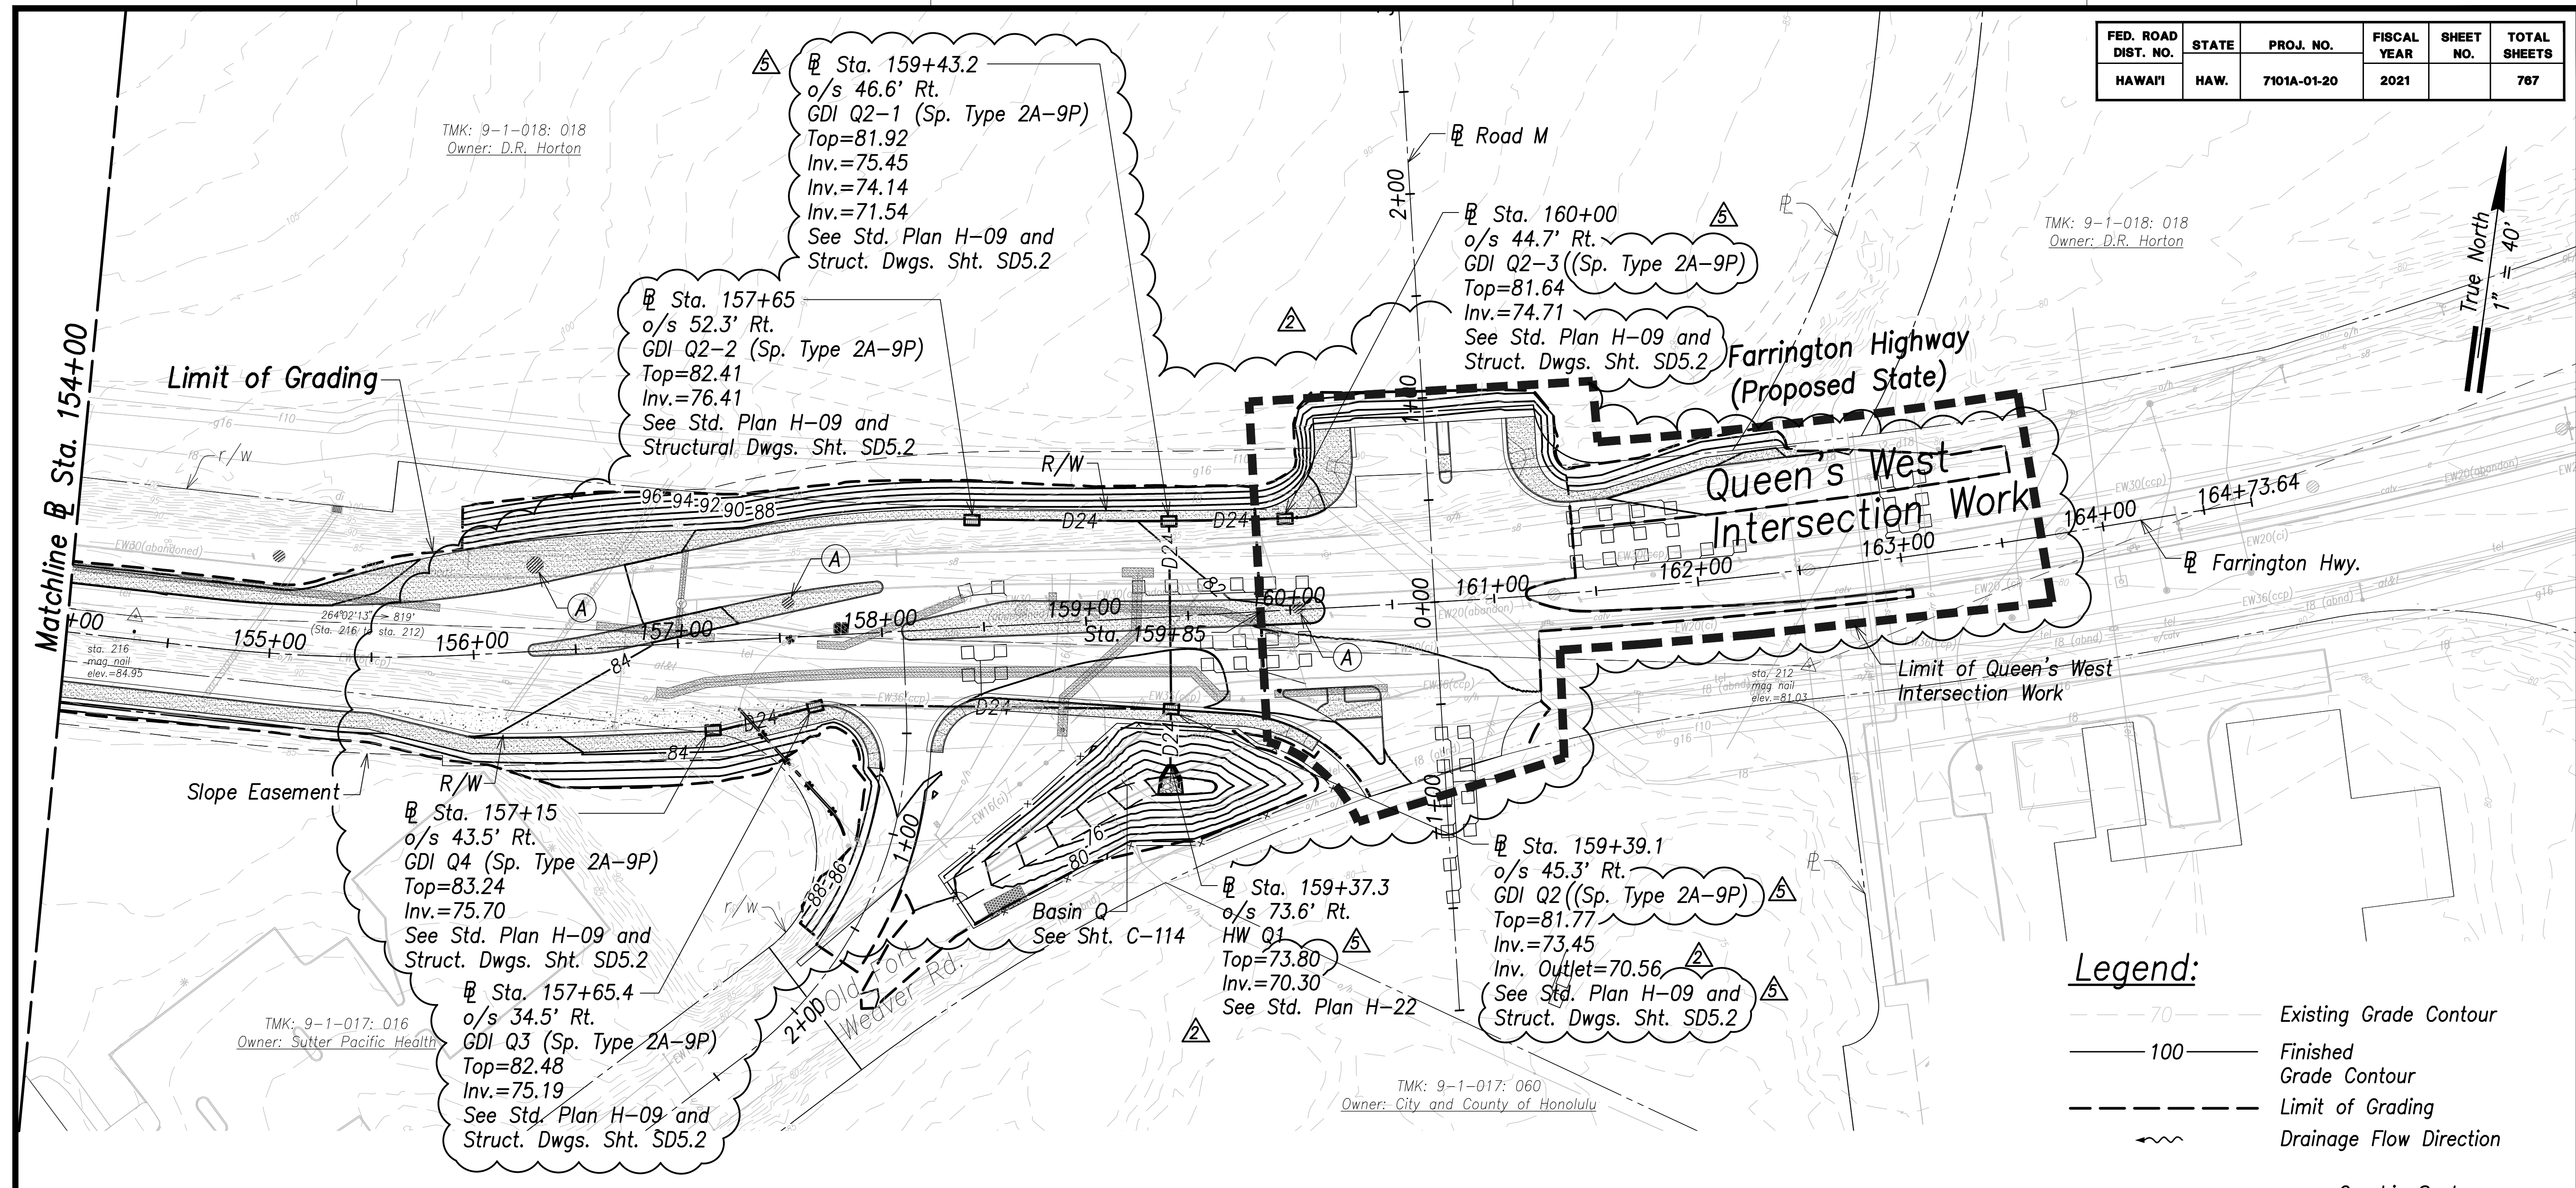

TMK: 9-1-018: 018  
Owner: D.R. Horton


True North  
1" = 40'

TMK: 9-1-017: 016  
Owner: Sutter Pacific Health

TMK: 9-1-017: 060  
Owner: City and County of Honolulu

**Legend:**

	Existing Grade Contour
	Finished Grade Contour
	Limit of Grading
	Drainage Flow Direction

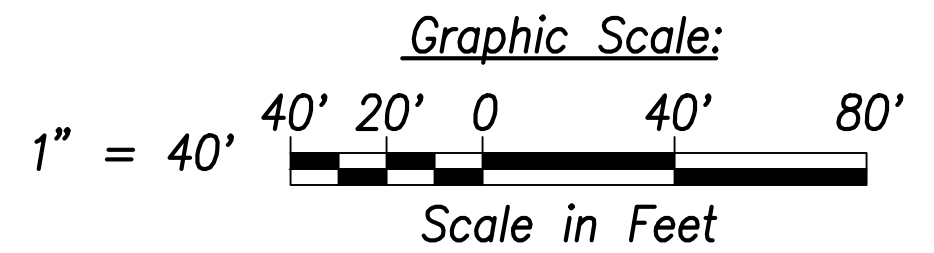

(A)  
Construct Splash Block  
See Det., Sht. C-205

**Grading and Drainage Plan - (Sta. 154+00 to Sta. 165+00)**  
Scale: 1" = 40'

**Notes:**

- The Contractor Shall Construct/Phase Drainage Improvements to Avoid Flooding Adjacent Properties and Washout of Roadway.
- Contractor Shall Locate Guardrail Posts to Provide 2' Min. Clear From Drain Utilities and Cleanout.
- See Access to Farm Lots notes on sheet C-3.

SURVEY PLOTTED BY	DATE
DRAWN BY	
TRACED BY	
QUANTITIES BY	
CHECKED BY	
ORIGINAL PLAN NOTE BOOK No.	



THIS WORK WAS PREPARED BY ME OR UNDER MY SUPERVISION AND CONSTRUCTION OF THIS PROJECT WILL BE UNDER MY OBSERVATION.  
SIGNATURE: *Craig W. Luke*  
EXPIRATION DATE OF THE LICENSE: April 30, 2024

DATE	REVISION
07/15/22	Added bus pullouts; Revised drain structures and headwall height
06/08/22	Revised HW Q1 and GDI Q2

STATE OF HAWAII  
DEPARTMENT OF TRANSPORTATION  
HIGHWAYS DIVISION

**Grading and Drainage Plan**  
Sta. 154+00 to Sta. 165+00


FARRINGTON HIGHWAY WIDENING  
Kapolei Golf Course Road to Fort Weaver Road  
Project No. 7101A-01-20

Scale: As Shown Date: April 2022

SHEET No. C-103 OF 767 SHEETS



FED. ROAD DIST. NO.	STATE	PROJ. NO.	FISCAL YEAR	SHEET NO.	TOTAL SHEETS
HAWAII	HAW.	7101A-01-20	2021	117	767

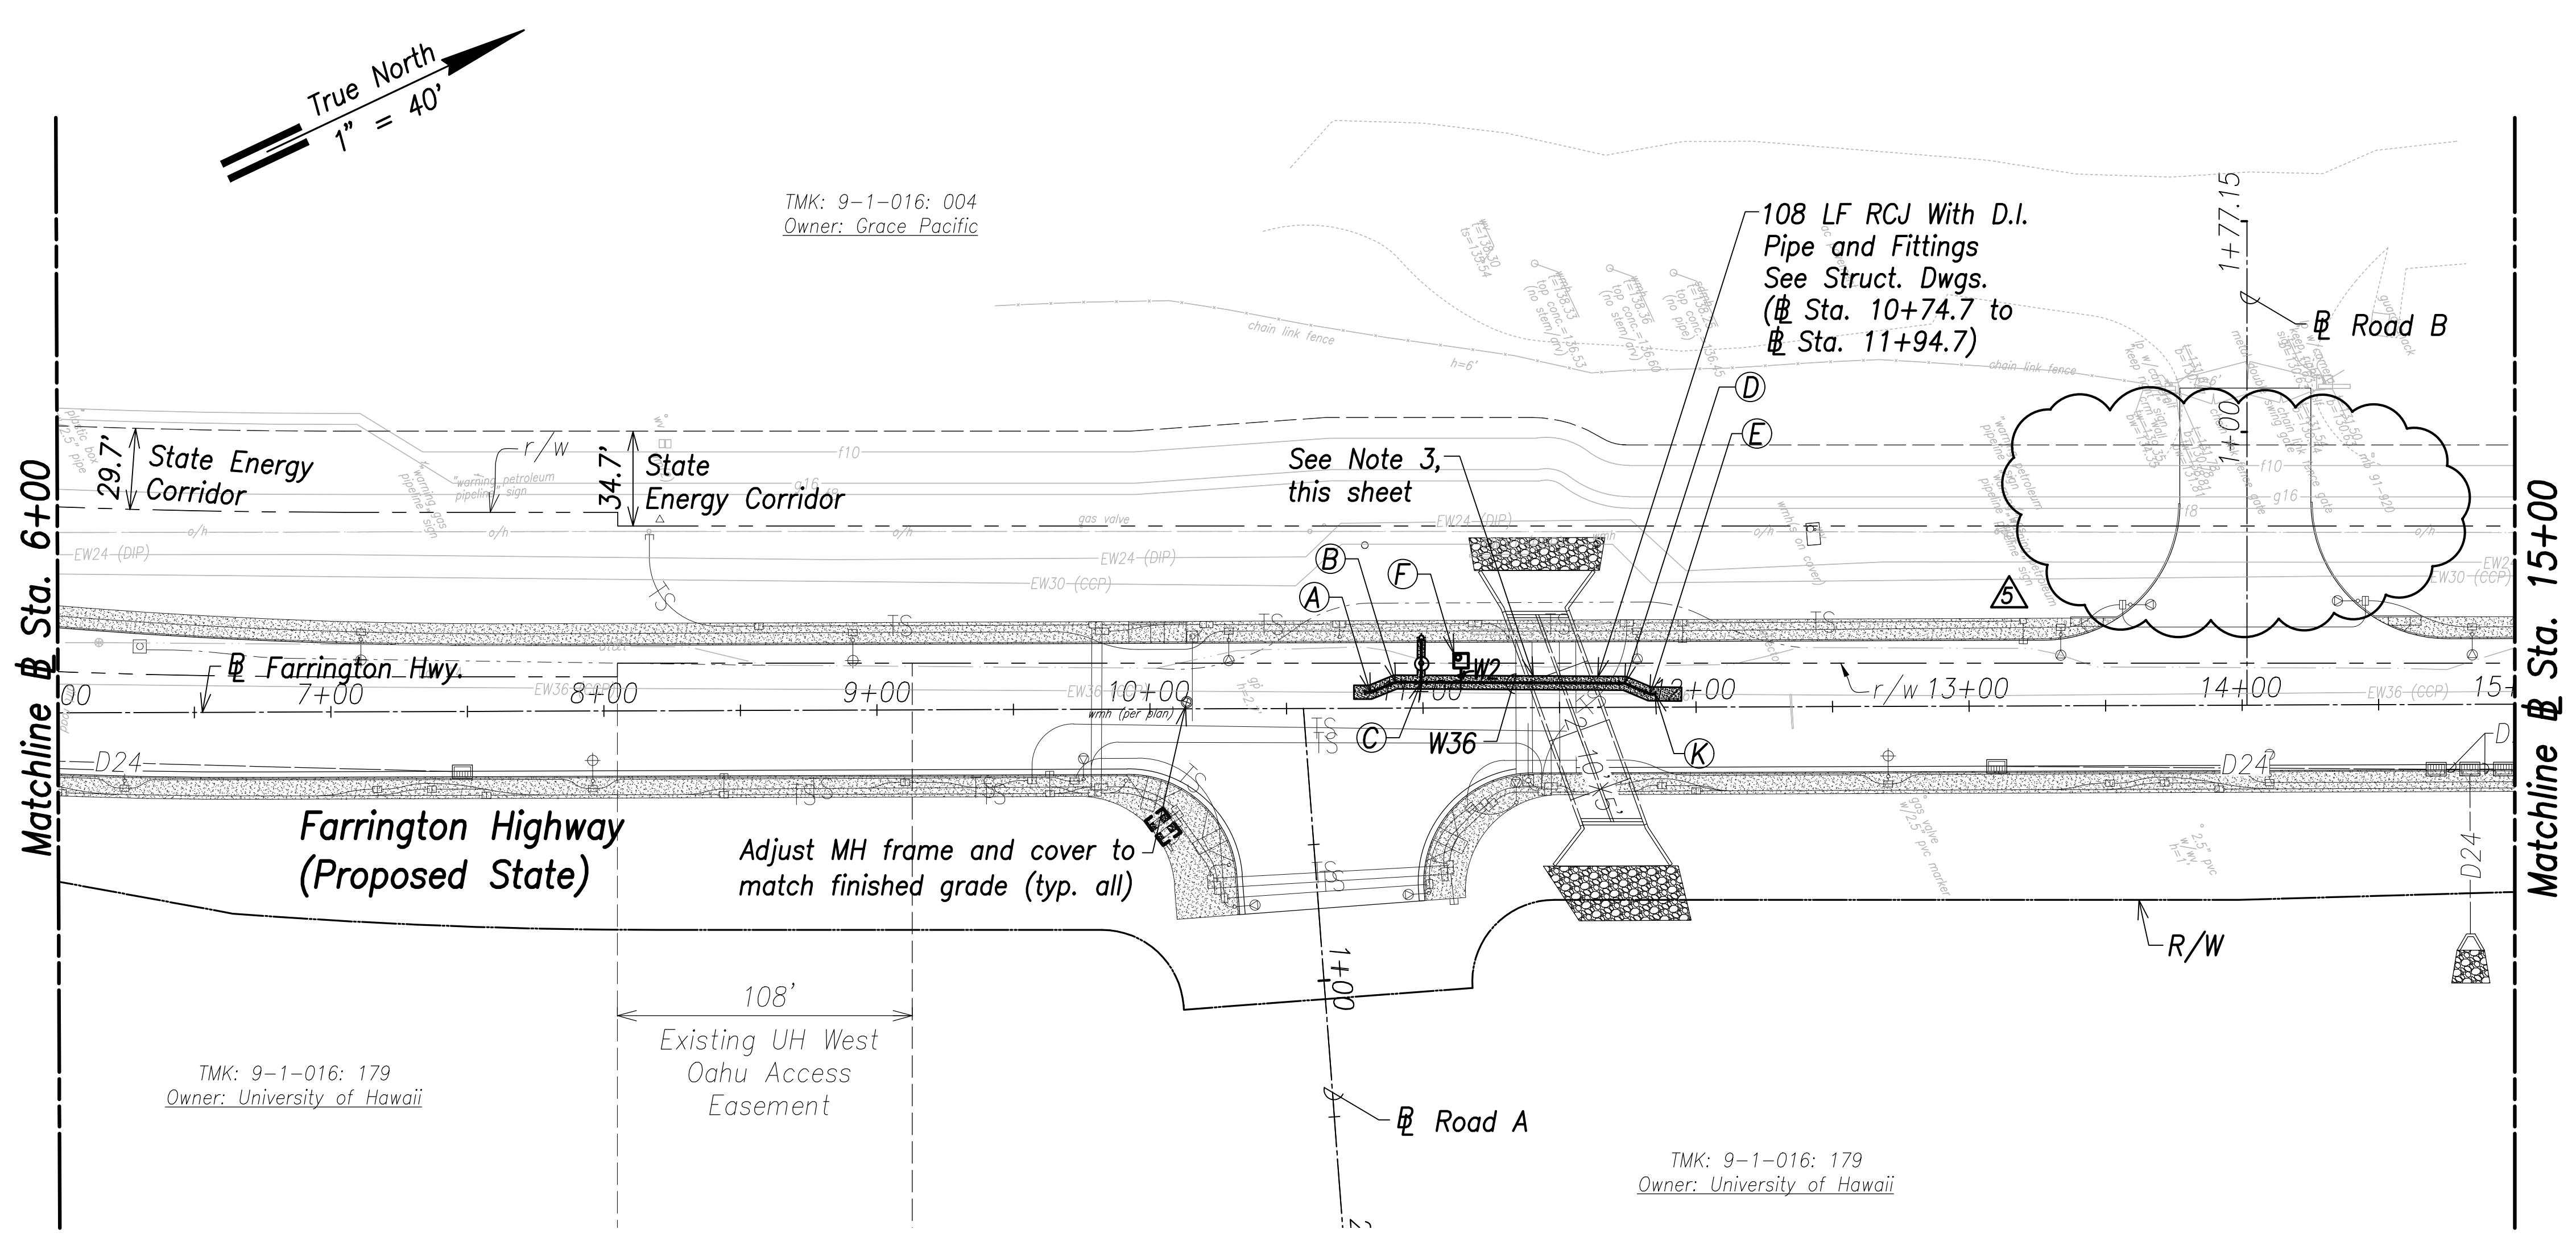

- Notes:**
1. Location of existing utilities are from "as-built" drawings. The Contractor shall verify tie-in connection points prior to the ordering of materials and the start of construction.
  2. The Contractor shall coordinate construction with utility companies.
  3. All waterlines shall be ductile iron pipe, class 53 with ductile iron fittings and shall be in accordance with the STANDARD SPECIFICATIONS FOR ROAD AND BRIDGE CONSTRUCTION, dated 2005, as amended, of the Hawaii Highways Division, Department of Transportation, and the City and County of Honolulu Board of Water Supply's "WATER SYSTEM STANDARDS", DATED 2002, THE "WATER SYSTEM EXTERNAL CORROSION CONTROL STANDARDS", VOLUME 3, DATED 2021, and all subsequent amendment and additions.
  4. For electrical relocations, see electrical drawings.
  5. For the portions of the water main to be concrete jacketed, a bell is to be installed in case there is a break on the line. This allows the removal of the compromised portion of the line without affecting the reinforced concrete jacketed segment of the existing water line. The installation of the bell shall be incidental to the various pay items under Section 624.

**Utility Plan - (# Sta. 6+00 to # Sta. 15+00)**  
Scale: 1" = 40'

**(A)**  
# Sta. 10+80.7, o/s 5.7' Lt.  
Conn. to e/w36  
Contractor to verify location and invert  
**Materials for Connection:**  
1-36" 1/16 Bend (H)  
1-36" CCPxD.I. Adapter  
1-36" Sleeve, 15" Long  
8± LF 36" D.I.P., Cl. 53  
**Temp for Testing:**  
1-36" Cap Tapped for 6" I.P.T.  
1-6" C.O.  
1-Conc. Block  
See Sht. C-168 For Temporary By-Pass Plan and Profile - 1

**(B)**  
# Sta. 10+90, o/s 9.4' Lt.  
1-36" 1/16 Bend (H)

**(C)**  
**FH 1**  
# Sta. 10+99.4, o/s 9.4' Lt.  
1-36"x6" Tee, D.I.  
1-6" G.V., 200#  
1-Type "C" Manhole and Cover, See BWS Std. Det. MH19  
1-FH (Ht.=9.5')  
1-FH Elbow  
1-Conc. Block  
16 LF 6" D.I.P., Cl. 53  
1-Blue Type F FH Marker  
See Profile, Sht. C-162  
See BWS Std. Det. FH4

**(D)**  
# Sta. 11+73.9 o/s 8.7' Lt.  
1-36" 1/16 Bend (H)

**(E)**  
# Sta. 11+83.0, o/s 4.8' Lt.  
1-36" 1/16 Bend (H)

**(F)**  
# Sta. 11+14, o/s 17.2' Lt.  
Center MH  
2-2" Offset ARV, 200#  
1-Type "D" MH  
See BWS Std. Det. V5, MH20-MH21, and Water Details on Sht. C-207

**(K)**  
# Sta. 11+87.1, o/s 4.8' Lt.  
Conn. to e/w36  
Contractor to verify location and invert  
**Materials for Connection:**  
1-36" 1/16 Bend (H)  
1-36" CCPxD.I. Adapter  
1-36" Sleeve, 15" Long  
8± LF 36" D.I.P., Cl. 53  
**Temp for Testing:**  
1-36" Cap Tapped for 6" I.P.T.  
1-6" C.O.  
1-Conc. Block  
See Sht. C-168 For Temporary By-Pass Plan and Profile - 1


SURVEY PLOTTED BY	DATE
DRAWN BY	
TRACED BY	
QUANTITIES BY	
CHECKED BY	
ORIGINAL PLAN	
NOTE BOOK	
No.	

APPROVED:  
\_\_\_\_\_  
Manager and Chief Engineer, BWS  
(for work affecting BWS facilities in City/State R/W & BWS easements only)

\_\_\_\_\_  
DATE



THIS WORK WAS PREPARED BY ME OR UNDER MY SUPERVISION AND CONSTRUCTION OF THIS PROJECT WILL BE UNDER MY OBSERVATION.  
\_\_\_\_\_  
SIGNATURE  
April 30, 2024  
EXPIRATION DATE OF THE LICENSE

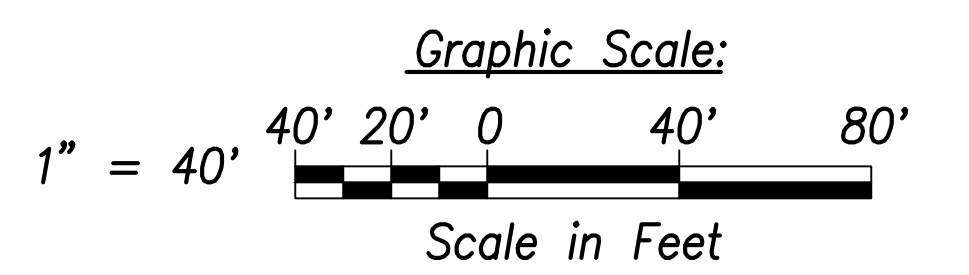

07/15/22	△ Revised callouts and RCJ
06/08/22	△ Deleted note; Revised callout
DATE	REVISION


STATE OF HAWAII  
DEPARTMENT OF TRANSPORTATION  
HIGHWAYS DIVISION

**Utility Plan**  
# Sta. 6+00 to # Sta. 15+00

FARRINGTON HIGHWAY WIDENING  
Kapolei Golf Course Road to Fort Weaver Road  
Project No. 7101A-01-20

Scale: As Shown Date: April 2022

FED. ROAD DIST. NO.	STATE	PROJ. NO.	FISCAL YEAR	SHEET NO.	TOTAL SHEETS
HAWAII	HAW.	7101A-01-20	2021	118	767

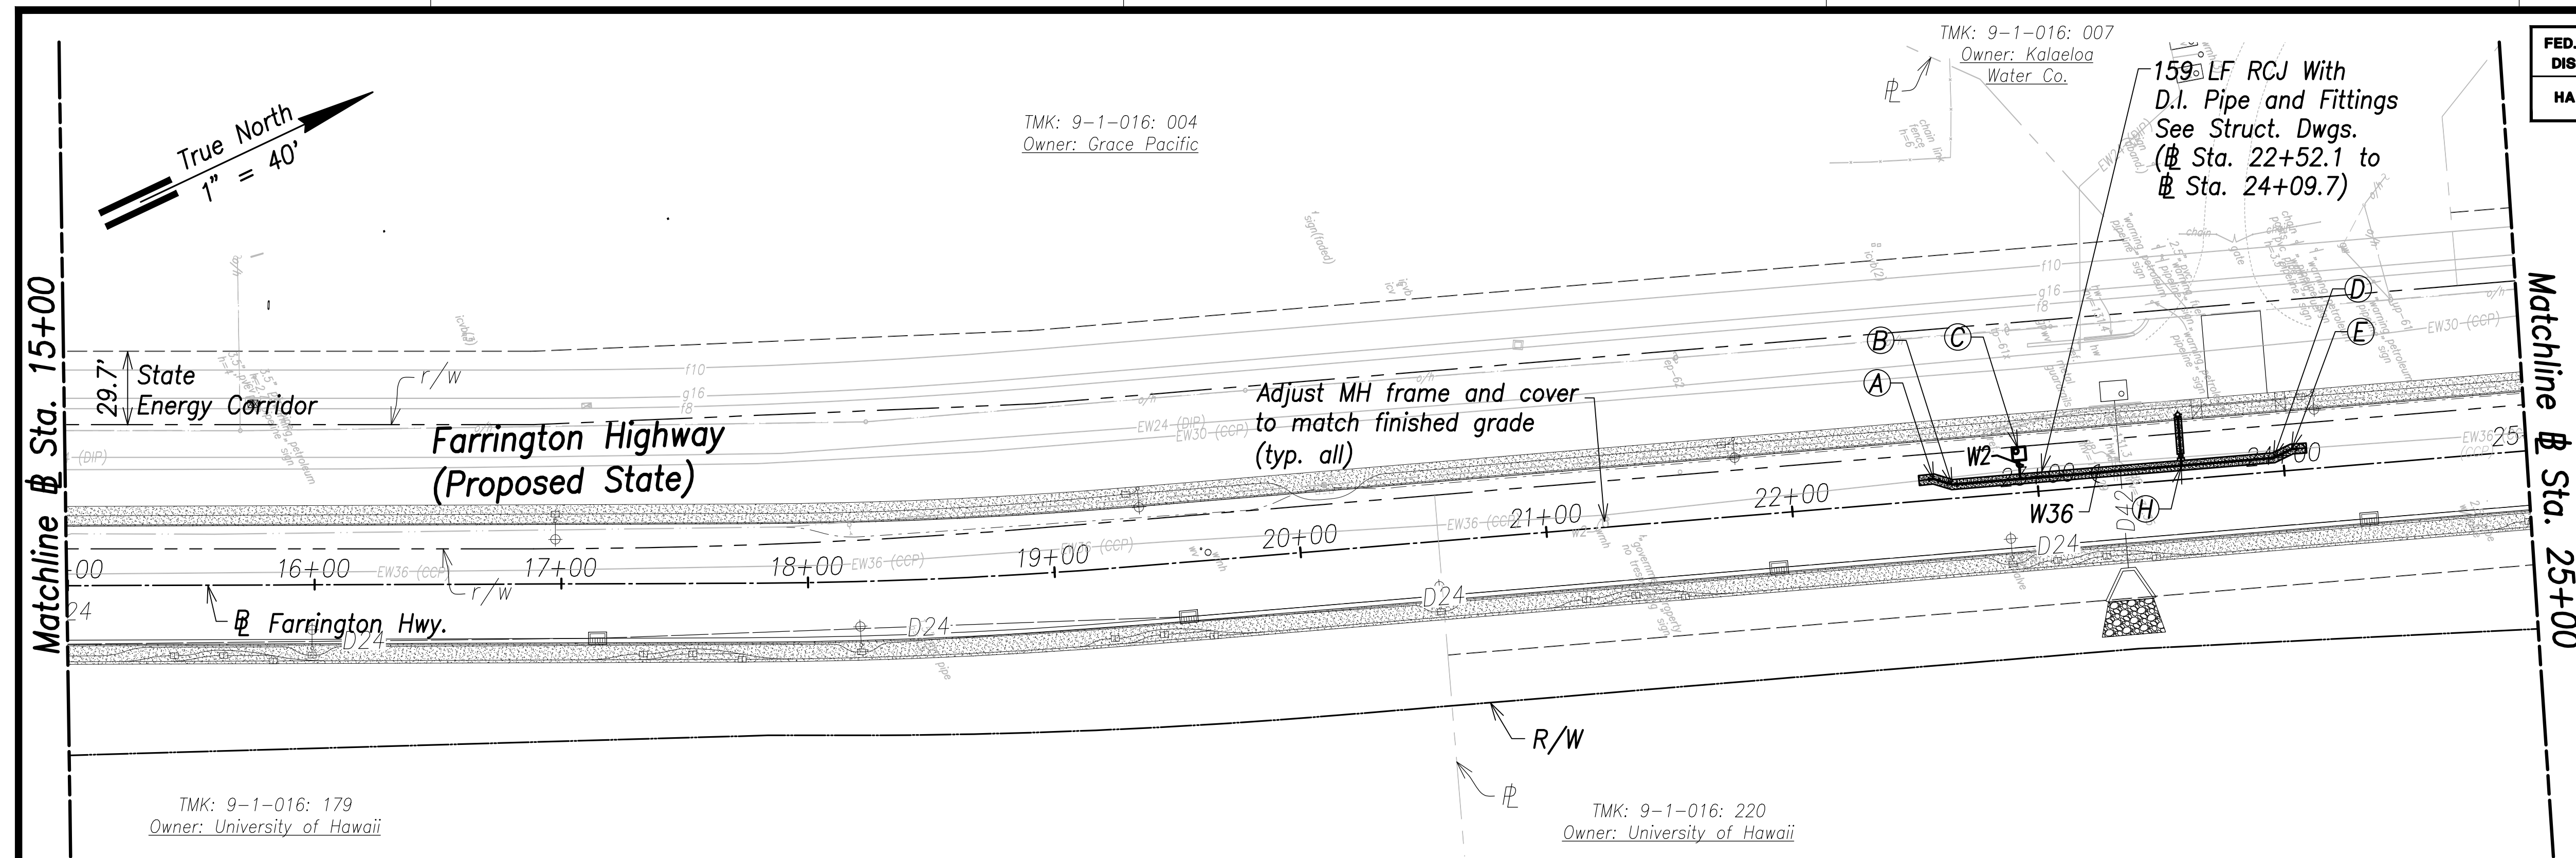

**Utility Plan - (# Sta. 15+00 to # Sta. 25+00)**  
Scale: 1" = 40'

**Notes:**

1. Location of existing utilities are from "as-built" drawings. The Contractor shall verify tie-in connection points prior to the ordering of materials and the start of construction.
2. The Contractor shall coordinate construction with utility companies.
3. All waterlines shall be ductile iron pipe, class 53 with ductile iron fittings and shall be in accordance with the STANDARD SPECIFICATIONS FOR ROAD AND BRIDGE CONSTRUCTION, dated 2005, as amended, of the Hawaii Highways Division, Department of Transportation, and the City and County of Honolulu Board of Water Supply's "WATER SYSTEM STANDARDS", DATED 2002, THE "WATER SYSTEM EXTERNAL CORROSION CONTROL STANDARDS", VOLUME 3, DATED 2021, and all subsequent amendment and additions.
4. For electrical relocations, see electrical drawings.
5. For the portions of the water main to be concrete jacketed, a bell is to be installed in case there is a break on the line. This allows the removal of the compromised portion of the line without affecting the reinforced concrete jacketed segment of the existing water line. The installation of the bell shall be incidental to the various pay items under Section 624.

**(A)**  
# Sta. 22+58.1, o/s 7.9' Lt.  
Conn. to e/w36  
Contractor to verify location and invert  
Materials for Connection:  
1-36" 1/16 Bend (H)  
1-36" CCPxD.I. Adapter  
1-36" Sleeve, 15" Long  
8± LF 36" D.I.P., Cl. 53  
Temp. for Testing:  
1-36" Cap Tapped for 6" I.P.T.  
1-6" C.O.  
1-Conc. Block  
See Sht. C-168 For Temporary By-Pass Plan and Profile - 2


**(B)**  
# Sta. 22+65.4, o/s 5.5' Lt.  
1-36" 1/16 Bend (H)

**(C)**  
# Sta. 22+93.4, o/s 15.8' Lt.  
Center MH  
2-2" Offset ARV, 200#  
1-Type "D" MH  
See BWS Std. Det. V5 and MH20-MH21

**(D)**  
# Sta. 23+97.5, o/s 30.5' Lt.  
1-36" 1/16 Bend (H)

**(E)**  
# Sta. 24+05, o/s 33.6' Lt.  
Conn. to e/w36  
Contractor to verify location and invert  
Materials for Connection:  
1-36" 1/16 Bend (H)  
1-36" CCPxD.I. Adapter  
1-36" Sleeve, 15" Long  
8± LF 36" D.I.P., Cl. 53  
Temp. for Testing:  
1-36" Cap Tapped for 6" I.P.T.  
1-6" C.O.  
1-Conc. Block  
See Sht. C-168 For Temporary By-Pass Plan and Profile - 2

**(H)**  
**FH 2**  
# Sta. 23+58.6, o/s 29.7' Lt.  
1-36"x6" Tee, D.I.  
1-6" G.V., 200#  
1-Valve Box  
1-FH (Ht.=7.5')  
1-FH Elbow  
1-Conc. Block  
21 LF 6" D.I.P., Cl. 53  
1-Blue Type F FH Marker  
See Profile, Sht. C-162  
See BWS Std. Det. FH4

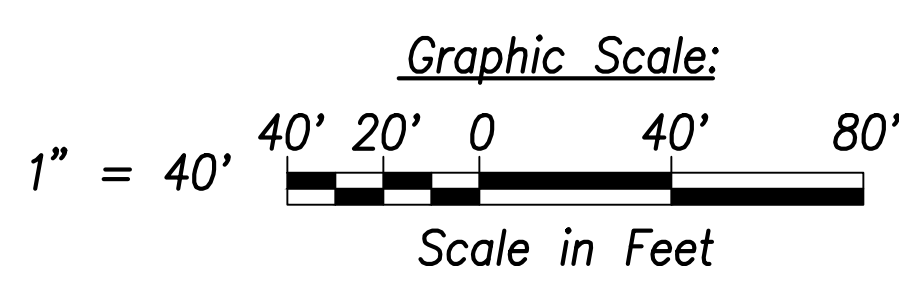

SURVEY PLOTTED BY	DATE
DRAWN BY	
TRACED BY	
QUANTITIES BY	
CHECKED BY	
ORIGINAL PLAN	
NOTE BOOK	
No.	

APPROVED:  
\_\_\_\_\_  
Manager and Chief Engineer, BWS  
(for work affecting BWS facilities in City/State R/W & BWS easements only)

DATE \_\_\_\_\_



THIS WORK WAS PREPARED BY ME OR UNDER MY SUPERVISION AND CONSTRUCTION OF THIS PROJECT WILL BE UNDER MY OBSERVATION.  
Signature: \_\_\_\_\_  
APRIL 30, 2024  
EXPIRATION DATE OF THE LICENSE

DATE	REVISION
07/15/22	Revised callout
06/08/22	Deleted note

STATE OF HAWAII  
DEPARTMENT OF TRANSPORTATION  
HIGHWAYS DIVISION


**Utility Plan**  
# Sta. 15+00 to # Sta. 25+00

FARRINGTON HIGHWAY WIDENING  
Kapolei Golf Course Road to Fort Weaver Road  
Project No. 7101A-01-20

Scale: As Shown Date: April 2022



FED. ROAD DIST. NO.	STATE	PROJ. NO.	FISCAL YEAR	SHEET NO.	TOTAL SHEETS
HAWAII	HAW.	7101A-01-20	2021	121	767

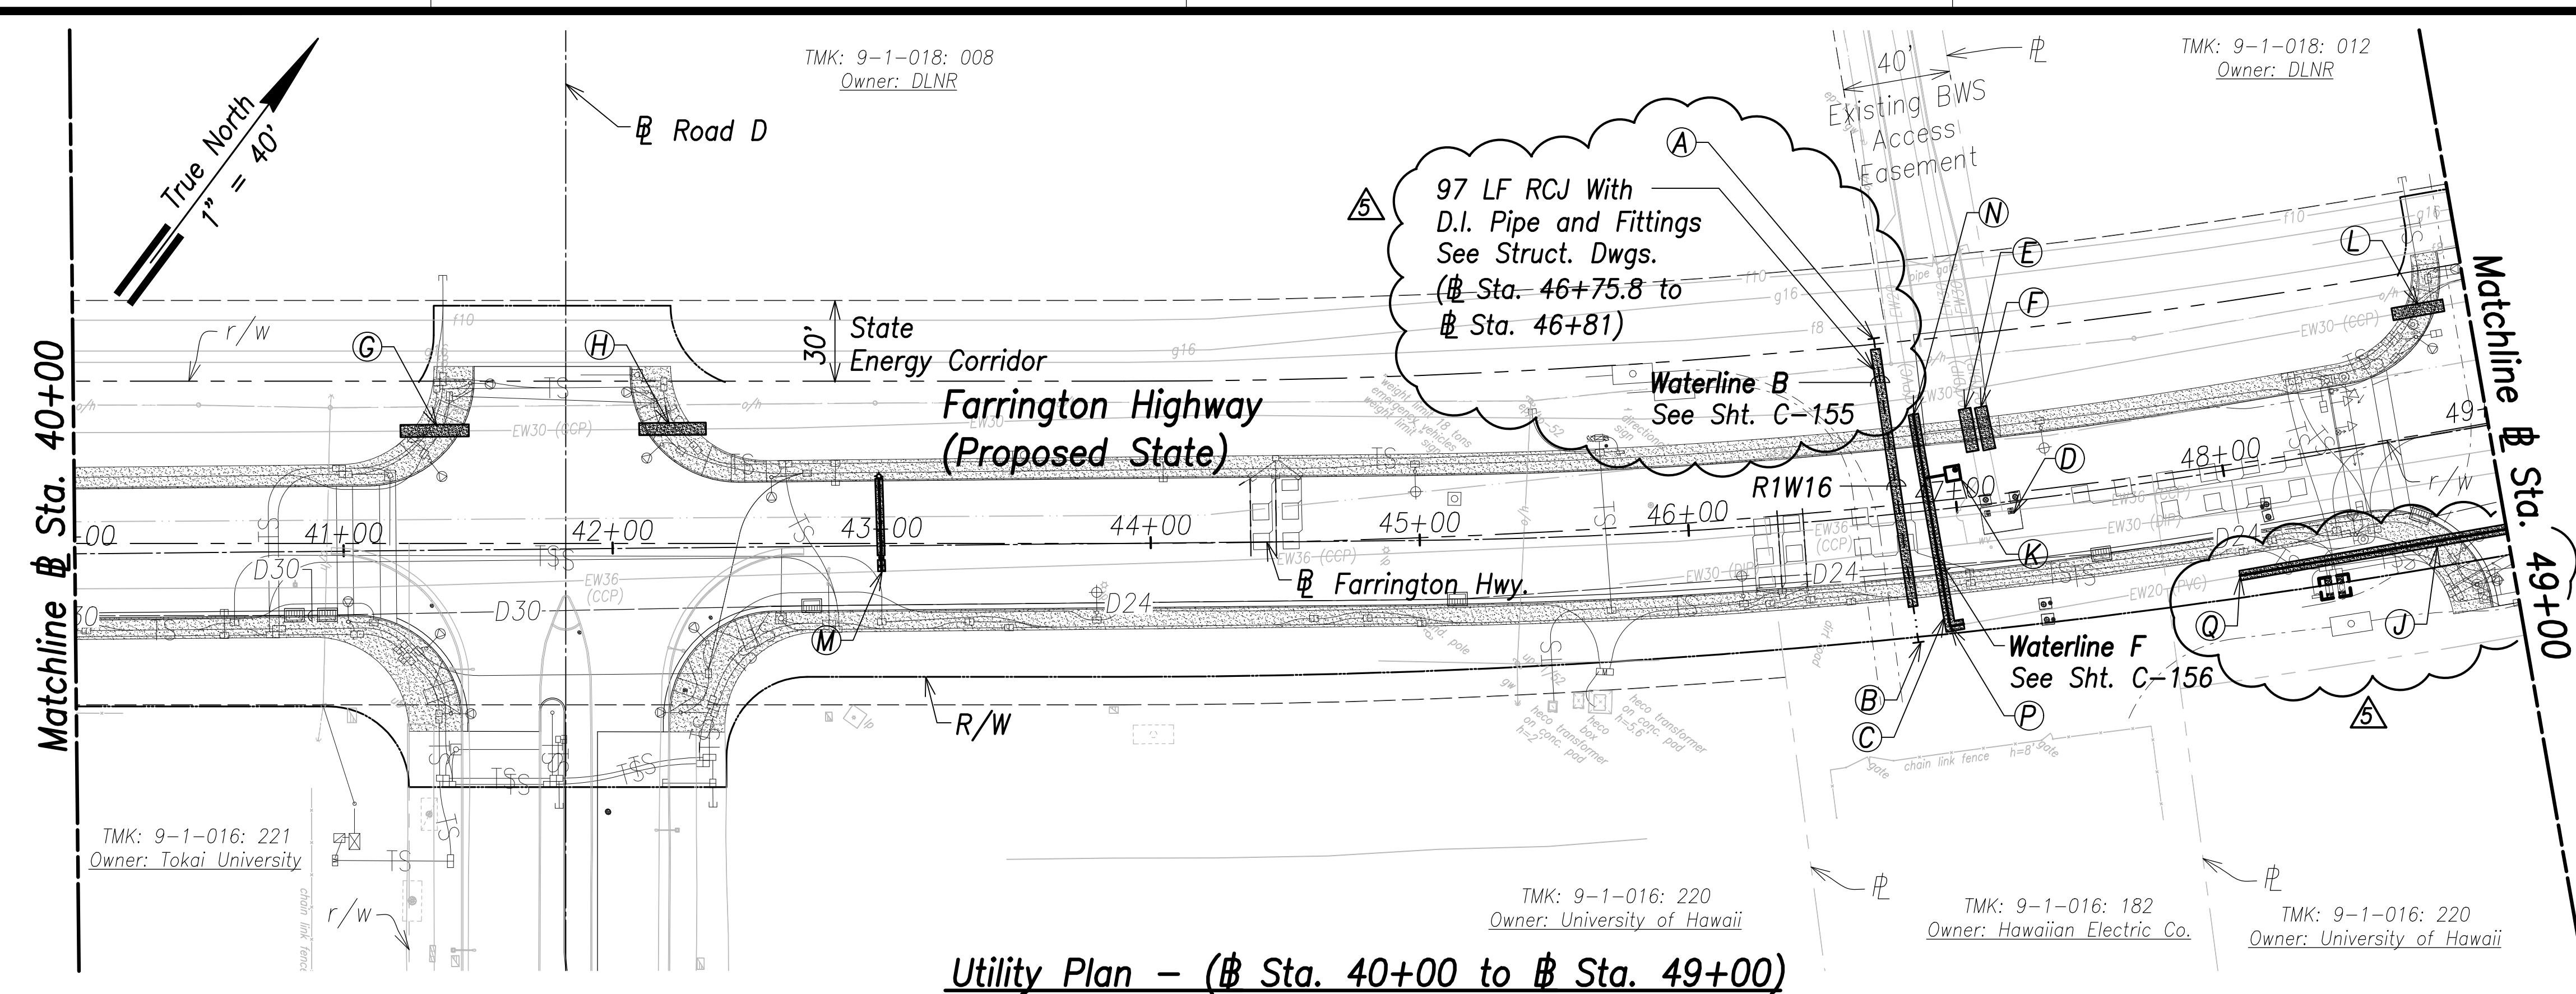

**Utility Plan - (Sta. 40+00 to Sta. 49+00)**  
Scale: 1" = 40'

- Notes:**
1. Location of existing utilities are from "as-built" drawings. The Contractor shall verify tie-in connection points prior to the ordering of materials and the start of construction.
  2. The Contractor shall coordinate construction with utility companies.
  3. All waterlines shall be ductile iron pipe, class 53 with ductile iron fittings and shall be in accordance with the STANDARD SPECIFICATIONS FOR ROAD AND BRIDGE CONSTRUCTION, dated 2005, as amended, of the Hawaii Highways Division, Department of Transportation, and the City and County of Honolulu Board of Water Supply's "WATER SYSTEM STANDARDS", DATED 2002, THE "WATER SYSTEM EXTERNAL CORROSION CONTROL STANDARDS", VOLUME 3, DATED 2021, and all subsequent amendment and additions.
  4. For electrical relocations, see electrical drawings.
  5. For the portions of the water main to be concrete jacketed, a bell is to be installed in case there is a break on the line. This allows the removal of the compromised portion of the line without affecting the reinforced concrete jacketed segment of the existing water line. The installation of the bell shall be incidental to the various pay items under Section 624.

**A**  
Sta. 46+75.4, o/s 65.5' Lt.  
= Sta. 1+12.7 WL B  
1-16" Cap w/4" Clean out  
1- 4'x4' Square Concrete Slab  
1-Valve Marker (Marked R1W16)

**B**  
Sta. 46+81.7, o/s 48.5' Rt.  
= Sta. 0+00 WL B  
1-16" Cap w/4" Clean out  
1- 4'x4' Square Concrete Slab  
1-Valve Marker (Marked R1W16)

**C**  
77 LF RCJ With D.I. Pipe and Fittings  
See Struct. Dwgs.  
(Sta. 46+87.6 to Sta. 46+92.5)

**D**  
Adjust MH frame and cover to match finished grade (typ. all)

**E**  
16 LF RCJ on Exist. Waterline  
See BWS Std. Det. B1  
(Sta. 47+07.1 to Sta. 47+08.3)  
See BWS RCJ Notes, Sht. C-15

**F**  
16 LF RCJ on Exist. Waterline  
See BWS Std. Det. B1  
(Sta. 47+13.3 to Sta. 47+14.7)  
See BWS RCJ Notes, Sht. C-15

**G**  
26 LF RCJ on Exist. Waterline  
See BWS Std. Det. B1  
(Sta. 41+21.6 to Sta. 41+47)  
See BWS RCJ Notes, Sht. C-15

**H**  
25 LF RCJ on Exist. Waterline  
See BWS Std. Det. B1  
(Sta. 42+10.3 to Sta. 42+35.1)  
See BWS RCJ Notes, Sht. C-15

**J**  
200 LF RCJ With D.I. Pipe and Fittings  
See Struct. Dwgs.  
(Sta. 48+00 to Sta. 50+00)

**K**  
Sta. 47+00, o/s 12.6' Lt.  
Center MH  
1-2" Offset ARV, 200#  
1-Type "D" MH  
See Bws Std. Det. V5 and MH20-MH21

**L**  
19 LF RCJ on Exist. Waterline  
See BWS Std. Det. B1  
(Sta. 48+72.1 to Sta. 48+91.3)  
See Note 6, This Sht.


**M**  
FH 3  
Sta. 43+00, o/s 9.4' Lt.  
1-36"x6" Tapping Tee  
1-6" Tapping Valve, 200#  
1-Valve Box & Cover  
1-6" Sleeve, 12" Long  
1-Conc. Block w/ Struct. Struts  
8± LF 6" D.I.P., Cl. 53  
1-FH (Ht.=8.5')  
1-FH Elbow  
1-Conc. Block  
16 LF 6" D.I.P., Cl. 53  
1-Blue Type F FH Marker  
See Profile, Sht. C-162  
Temp. for Testing:  
1-6" Cap Tapped for 2-1/2" I.P.T.  
1-2-1/2" C.O.  
1-Conc. Block

**N**  
Sta. 46+87.6, o/s 36' Lt.  
Conn. to e/w20  
Contractor to verify location and invert  
**Materials for Connection:**  
1-20" Sleeve, 15" Long  
8± LF 20" D.I.P., Cl. 53  
**Temp. for Testing:**  
1-20" Cap Tapped for 4" I.P.T.  
1-4" C.O.  
1-Conc. Block  
See Sht. C-178 For Temporary By-Pass Plan and Profile - 20

**P**  
Sta. 46+92.8, o/s 43.8' Rt.  
Conn. to e/w20  
Contractor to verify location and invert  
**Materials for Connection:**  
1-20" Sleeve, 15" Long  
8± LF 20" D.I.P., Cl. 53  
**Temp. for Testing:**  
1-20" Cap Tapped for 4" I.P.T.  
1-4" C.O.  
1-Conc. Block  
See Sht. C-178 For Temporary By-Pass Plan and Profile - 20

**Q**  
Sta. 48+00, o/s 39.6' Rt.  
Conn. to e/w20  
Contractor to verify location and invert  
**Materials for Connection:**  
1-20" Sleeve, 15" Long  
8± LF 20" D.I.P., Cl. 53  
**Temp. for Testing:**  
1-20" Cap Tapped for 4" I.P.T.  
1-4" C.O.  
1-Conc. Block  
See Sht. C-179 For Temporary By-Pass Plan and Profile - 23

APPROVED:  
\_\_\_\_\_  
Manager and Chief Engineer, BWS  
(for work affecting BWS facilities in City/State R/W & BWS easements only)

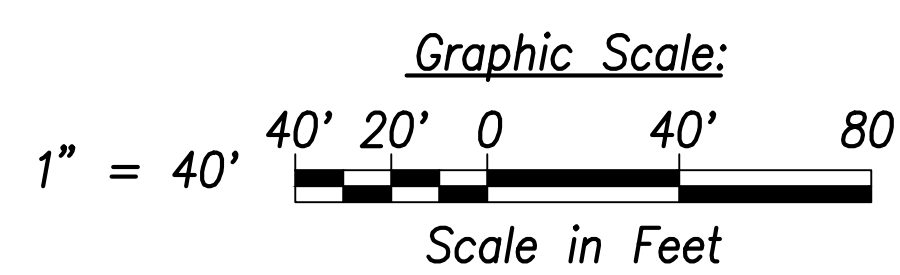

DATE	REVISION
07/15/22	Revised callouts
06/08/22	Added new W20; Revised callouts



THIS WORK WAS PREPARED BY ME OR UNDER MY SUPERVISION AND CONSTRUCTION OF THIS PROJECT WILL BE UNDER MY OBSERVATION.  
Signature: \_\_\_\_\_  
April 30, 2024  
EXPIRATION DATE OF THE LICENSE

STATE OF HAWAII  
DEPARTMENT OF TRANSPORTATION  
HIGHWAYS DIVISION


**Utility Plan**  
Sta. 40+00 to Sta. 49+00  
FARRINGTON HIGHWAY WIDENING  
Kapolei Golf Course Road to Fort Weaver Road  
Project No. 7101A-01-20

Scale: As Shown Date: April 2022

SHEET No. C-120 OF 767 SHEETS

SURVEY PLOTTED BY	DATE
DRAWN BY	
TRACED BY	
INSTRUMENTED BY	
QUANTITIES BY	
CHECKED BY	
ORIGINAL PLAN	
NOTE BOOK	
No.	

FED. ROAD DIST. NO.	STATE	PROJ. NO.	FISCAL YEAR	SHEET NO.	TOTAL SHEETS
HAWAII	HAW.	7101A-01-20	2021	122	767

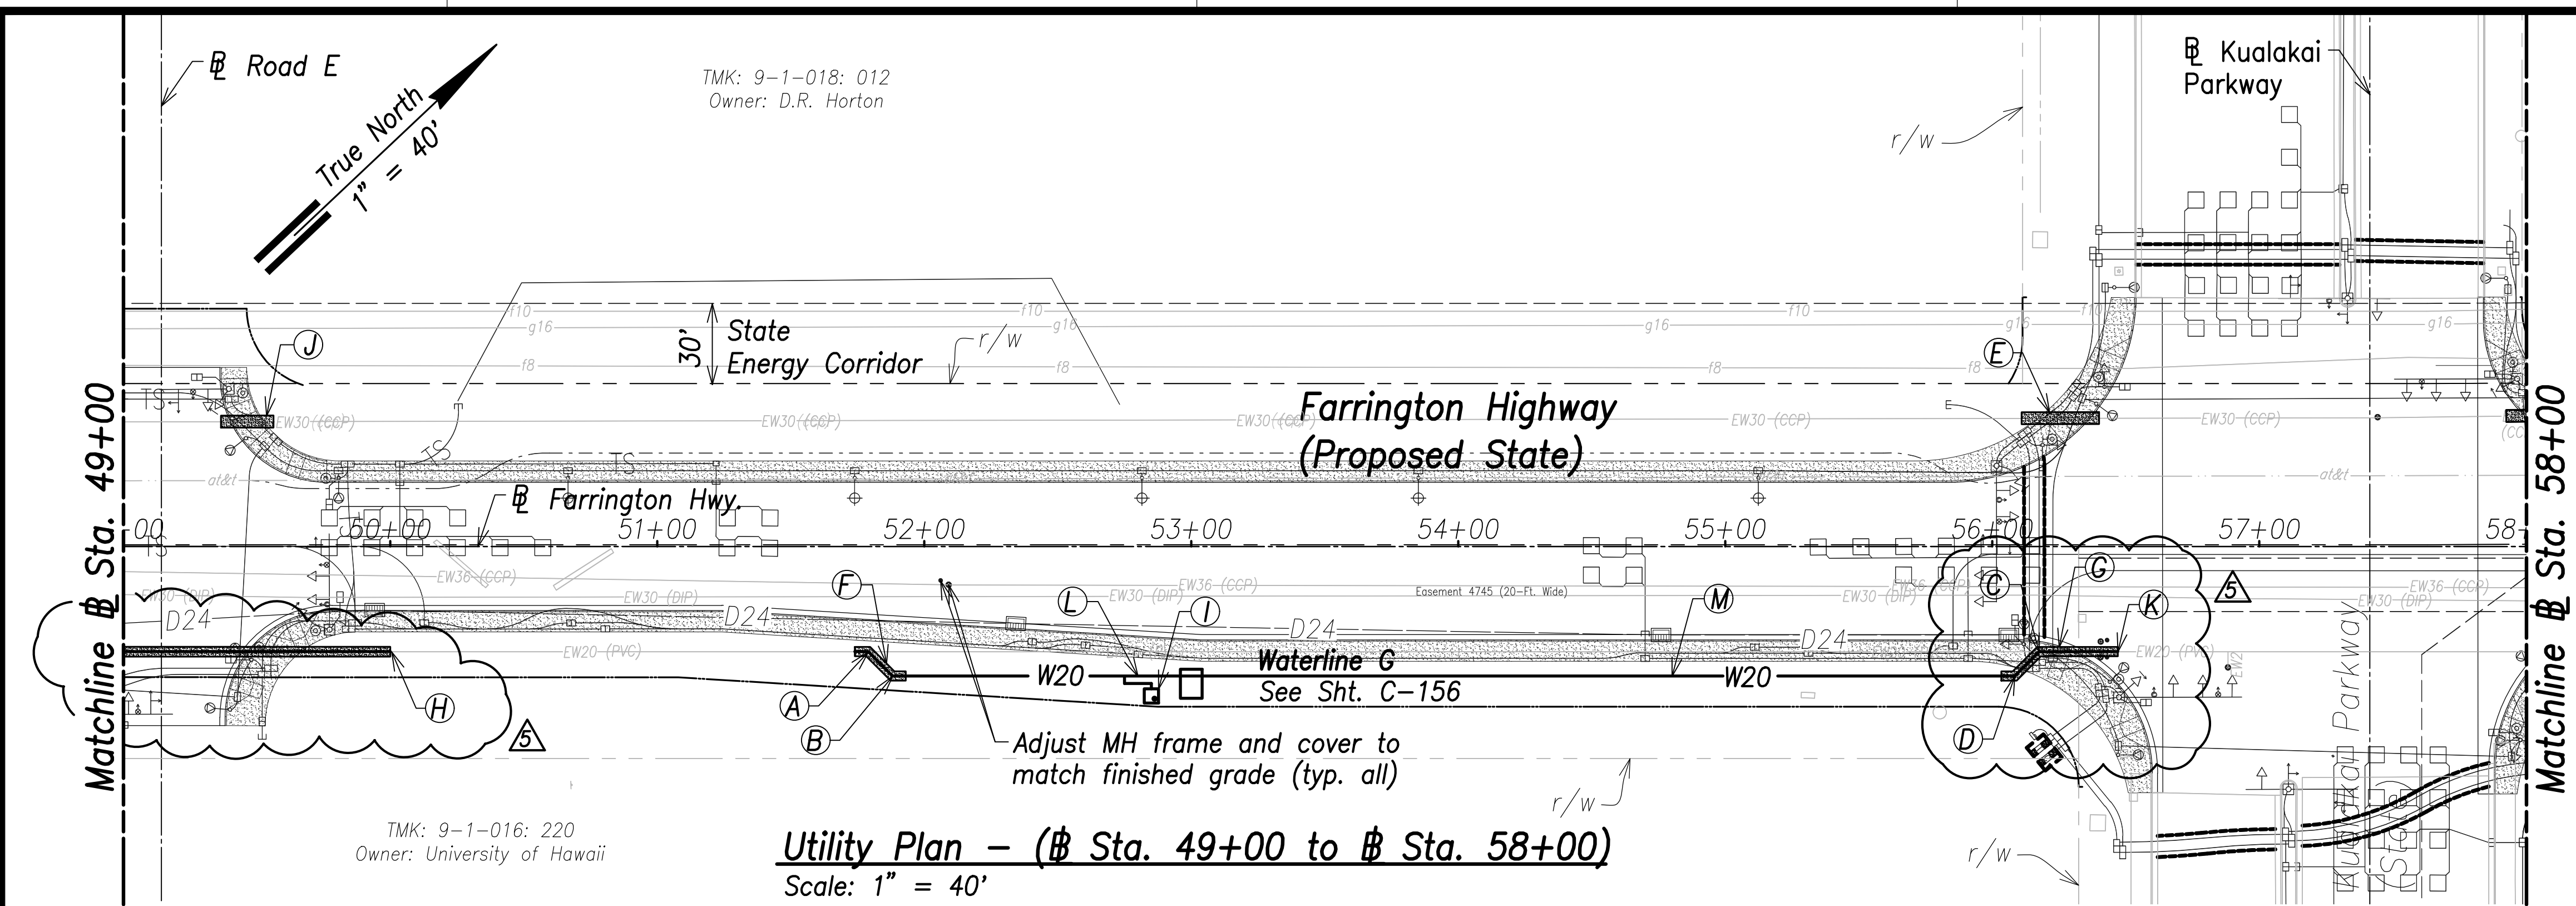

- Notes:**
1. Location of existing utilities are from "as-built" drawings. The Contractor shall verify tie-in connection points prior to the ordering of materials and the start of construction.
  2. The Contractor shall coordinate construction with utility companies.
  3. All waterlines shall be ductile iron pipe, class 53 with ductile iron fittings and shall be in accordance with the STANDARD SPECIFICATIONS FOR ROAD AND BRIDGE CONSTRUCTION, dated 2005, as amended, of the Hawaii Highways Division, Department of Transportation, and the City and County of Honolulu Board of Water Supply's "WATER SYSTEM STANDARDS", DATED 2002, THE "WATER SYSTEM EXTERNAL CORROSION CONTROL STANDARDS", VOLUME 3, DATED 2021, and all subsequent amendment and additions.
  4. For electrical relocations, see electrical drawings.
  5. For the portions of the water main to be concrete jacketed, a bell is to be installed in case there is a break on the line. This allows the removal of the compromised portion of the line without affecting the reinforced concrete jacketed segment of the existing water line. The installation of the bell shall be incidental to the various pay items under Section 624.

**(A)**  
 Sta. 51+79, o/s 39.4' Rt.  
 Conn. to e/w20  
 Contractor to verify location and invert  
Materials for Connection:  
 1-20" 1/8 Bend (H)  
 1-20" Sleeve, 15" Long  
 1-20" B.G.V., 200#  
 1-Type "A" MH  
 1-Conc. Block w/ Struct. Struts  
 8± LF 20" D.I.P., Cl. 53  
 Provide Insulating Joint Test Station  
 See Shts. CP-1 to CP-4  
Temp. for Testing:  
 1-20" Cap Tapped for 4" I.P.T.  
 1-4" C.O.  
 1-Conc. Block  
 See Sht. C-176 For Temporary By-Pass  
 Plan and Profile - 16

**(B)**  
 Sta. 51+88.1, o/s 48.5' Rt.  
 1-20" 1/8 Bend (H)

**(C)**  
 Sta. 56+17.5, o/s 39.4' Rt.  
 1-20" 1/8 Bend (H)

**(D)**  
 Sta. 56+08.4, o/s 48.5' Rt.  
 1-20" 1/8 Bend (H)  
 Provide Insulating Joint Test Station  
 See Shts. CP-1 to CP-4

**(E)**  
 32 LF RCJ on Exist. Waterline  
 See BWS Std. Det. B1  
 (Sta. 56+11 to Sta. 56+40)  
 See BWS RCJ Notes, Sht. C-15

**(F)**  
 23 LF RCJ With  
 D.I. Pipe and Fittings  
 See Struct. Dwg.  
 (Sta. 51+74 to  
 Sta. 51+93.1)

**(G)**  
 48 LF RCJ With  
 D.I. Pipe and Fittings  
 See Struct. Dwg.  
 (Sta. 56+03.4 to  
 Sta. 56+47)

**(H)**  
 Sta. 50+00, o/s 39.4' Rt.  
 Conn. to e/w20  
 Contractor to verify location and invert  
Materials for Connection:  
 1-20" Sleeve, 15" Long  
 8± LF 20" D.I.P., Cl. 53  
Temp. for Testing:  
 1-20" Cap Tapped for 4" I.P.T.  
 1-4" C.O.  
 1-Conc. Block  
 See Sht. C-179 For Temporary  
 By-Pass Plan and Profile - 23


**(I)**  
 Sta. 52+85, o/s 56' Rt.  
 Center MH  
 1-2" Offset ARV, 200#  
 1-Type "D" MH  
 See BWS Std. Det. V5 and MH20-MH21

**(J)**  
 20 LF RCJ on Exist. Waterline  
 See BWS Std. Det. B1  
 (Sta. 49+36.6 to Sta. 49+56.3)  
 See BWS RCJ Notes, Sht. C-15

**(K)**  
 Sta. 56+47, o/s 39.4' Rt.  
 Conn. to e/w20  
 Contractor to verify location and invert  
 Demolish and remove exist. WMH, frame,  
 cover, and valve  
Materials for Connection:  
 1-20" Sleeve, 15" Long  
 1-Conc. Block w/ Struct. Struts  
 8± LF 20" D.I.P., Cl. 53  
Temp. for Testing:  
 1-20" Cap Tapped for 4" I.P.T.  
 1-4" C.O.  
 1-Conc. Block  
 See Sht. C-176 For Temporary By-Pass  
 Plan and Profile - 17

**(L)**  
 Sta. 52+80, o/s 48.5' Rt.  
 Provide Anode Test Station  
 See Shts. CP-1 to CP-4


**(M)**  
 Sta. 54+80, o/s 48.5' Rt.  
 Provide Anode Test Station  
 See Shts. CP-1 to CP-4

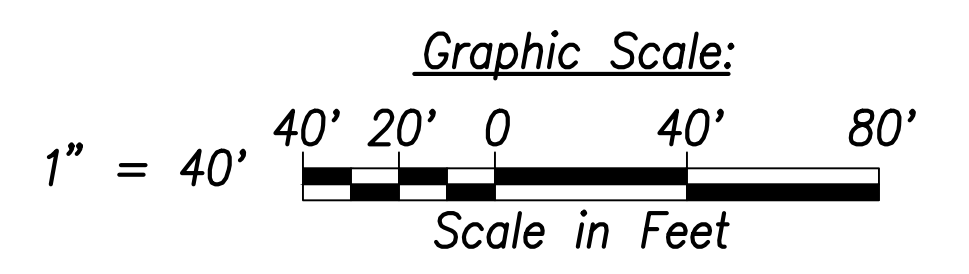

SURVEY PLOTTED BY	DATE
DRAWN BY	
TRACED BY	
INSTRUMENTED BY	
QUANTIFIED BY	
CHECKED BY	
ORIGINAL PLAN	
NOTE BOOK	
No.	

APPROVED:  
 Manager and Chief Engineer, BWS  
 (for work affecting BWS facilities in  
 City/State R/W & BWS easements only)

DATE

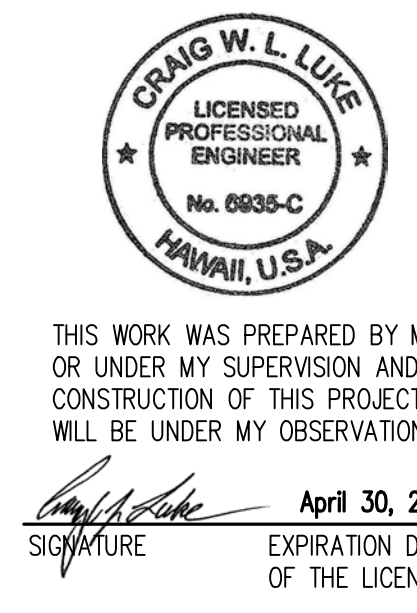

THIS WORK WAS PREPARED BY ME  
 OR UNDER MY SUPERVISION AND  
 CONSTRUCTION OF THIS PROJECT  
 WILL BE UNDER MY OBSERVATION.  
 SIGNATURE: *Craig W. Luke*  
 EXPIRATION DATE OF THE LICENSE: April 30, 2024

DATE	REVISION
07/15/22	Revised Waterline G and connection point
06/08/22	Revised Callouts; Profile Sheet References Revised; Deleted note

STATE OF HAWAII  
 DEPARTMENT OF TRANSPORTATION  
 HIGHWAYS DIVISION


Utility Plan  
 Sta. 49+00 to Sta. 58+00  
 FARRINGTON HIGHWAY WIDENING  
 Kapolei Golf Course Road to Fort Weaver Road  
 Project No. 7101A-01-20

Scale: As Shown Date: April 2022

SHEET No. C-121 OF 767 SHEETS



FED. ROAD DIST. NO.	STATE	PROJ. NO.	FISCAL YEAR	SHEET NO.	TOTAL SHEETS
HAWAII	HAW.	7101A-01-20	2021	123	767

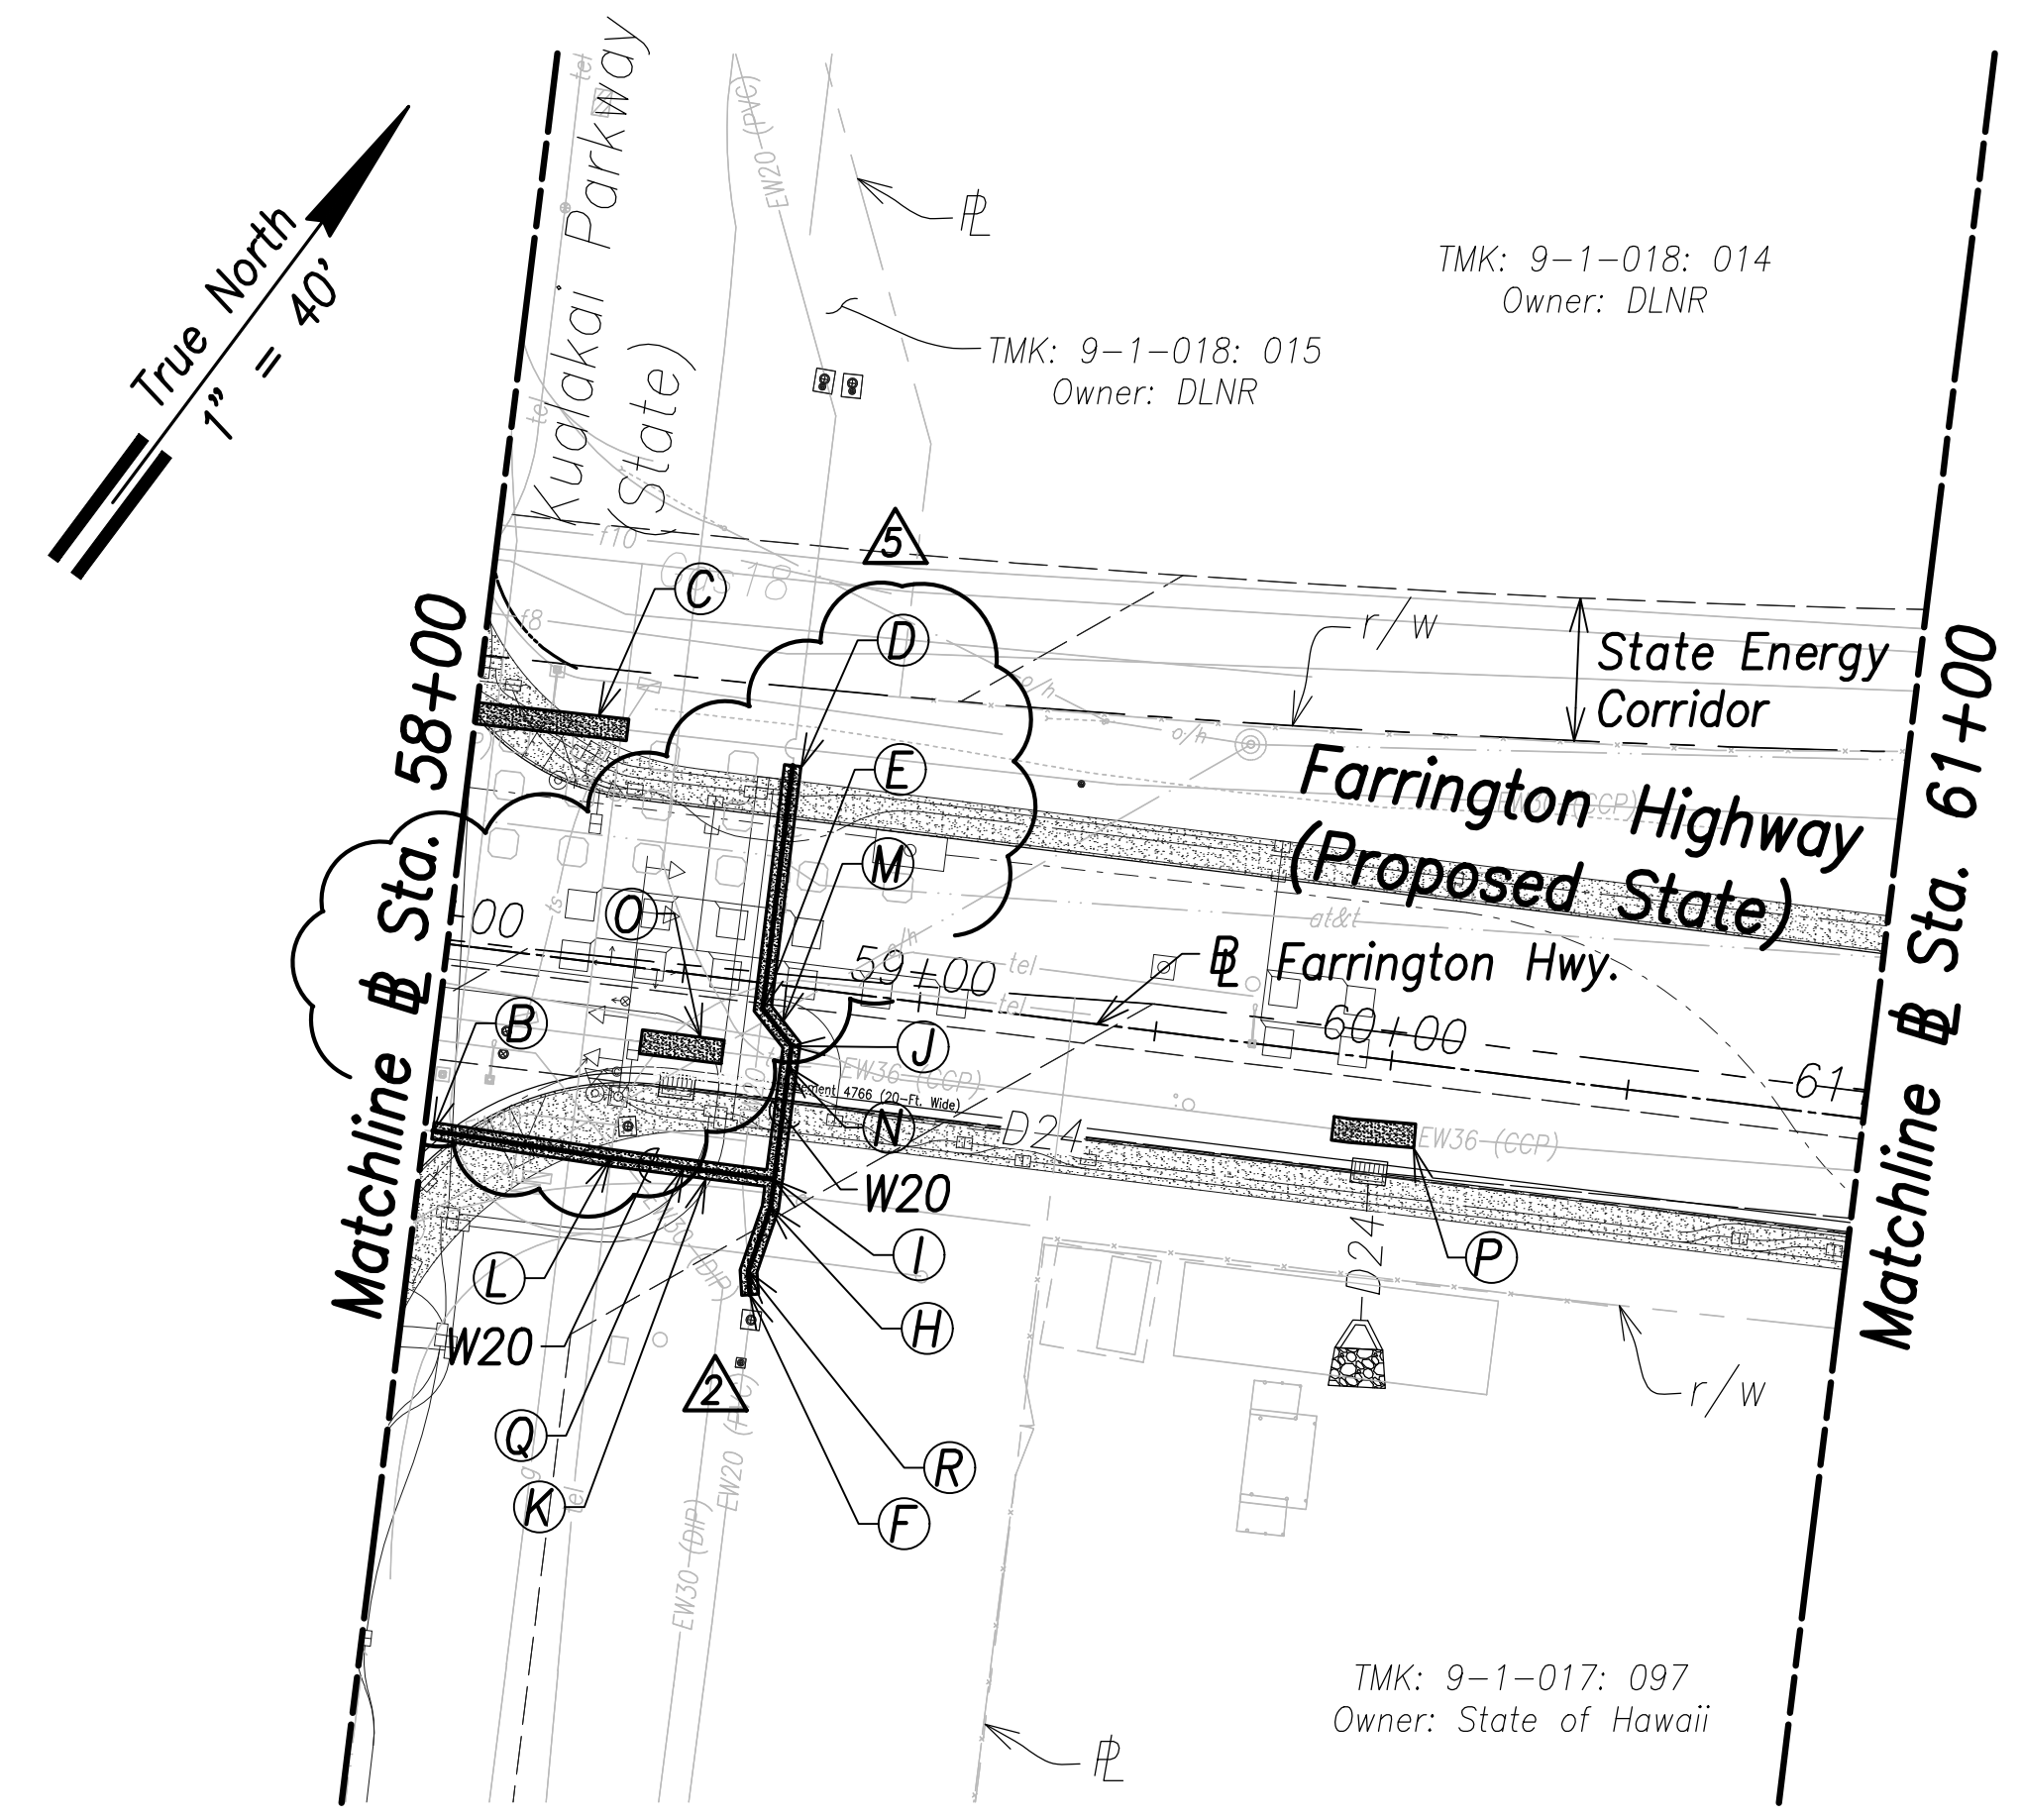

**Utility Plan - (# Sta. 58+00 to # Sta. 61+00)**  
Scale: 1" = 40'

**(B)**  
# Sta. 58+01.8, o/s 39.4' Rt.  
=# Sta. 0+00 Waterline N  
Conn. to e/w20  
Contractor to verify location and invert  
Materials for Connection:  
1-20" Sleeve, 15" Long  
8± LF 20" D.I.P., Cl. 53  
Temp. for Testing:  
1-20" Cap Tapped for 4" I.P.T.  
1-4" C.O.  
1-Conc. Block  
See Sht. C-177 For Temporary By-Pass Plan and Profile - 18

**(D)**  
# Sta. 58+67.5, o/s 46.1' Lt.  
=# Sta. 0+00 Waterline P  
Conn. to e/w20  
Contractor to verify location and invert  
Materials for Connection:  
1-20" Sleeve, 15" Long  
8± LF 20" D.I.P., Cl. 53  
Temp. for Testing:  
1-20" Cap Tapped for 4" I.P.T.  
1-4" C.O.  
1-Conc. Block  
See Sht. C-177 For Temporary By-Pass Plan and Profile - 19

**(E)**  
# Sta. 58+67.5, o/s 5.4' Lt.  
1-20" 1/8 Bend (H)

**(C)**  
40 LF RCJ on Exist. Waterline  
See BWS Std. Det. B1  
(# Sta. 57+92.4 to # Sta. 58+32.1)  
See BWS RCJ Notes, Sht. C-15

**(F)**  
# Sta. 58+72.2, o/s 65.5' Rt.  
=# Sta. 1+14.8 Waterline P  
Conn. to e/w20  
Contractor to verify location and invert  
Contractor to verify pipe size prior to the start of construction  
Materials for Connection:  
1-Conc. Block w/ Struct. Struts  
5± LF 20" D.I.P., Cl. 53  
Temp. for Testing:  
1-12" Cap Tapped for 4" I.P.T.  
1-4" C.O.  
1-Conc. Block  
See Sht. C-177 For Temporary By-Pass Plan and Profile - 19

**(H)**  
# Sta. 58+74.2, o/s 46.7' Rt.  
1-20" 1/32 Bend (H)

**(I)**  
# Sta. 58+74.2, o/s 40.7' Rt.  
=# Sta. 0+44.8 Waterline N  
=# Sta. 0+38.2 Waterline P  
1-20"x20" Tee

**(J)**  
# Sta. 58+74.4, o/s 12.4' Rt.  
1-20" 1/8 Bend (H)

**(K)**  
73 LF RCJ With D.I. Pipe and Fittings  
See Struct. Dwgs.  
(# Sta. 58+01.8 to # Sta. 58+74.2)

**(L)**  
# Sta. 58+39.5, o/s 40.5' Rt.  
Deflect 1°

**(M)**  
115 LF RCJ With D.I. Pipe and Fittings  
See Struct. Dwgs.  
(# Sta. 58+67.5 to # Sta. 58+72.2)

**(N)**  
**Waterline P**  
See Profile  
Sht. C-159

**(O)**  
17 LF RCJ on Exist. Waterline  
See BWS Std. Det. B1  
(# Sta. 58+42.9 to # Sta. 58+60.2)  
See BWS RCJ Notes, Sht. C-15


**(P)**  
17 LF RCJ on Exist. Waterline  
See BWS Std. Det. B1  
(# Sta. 59+89.5 to # Sta. 60+06.8)  
See BWS RCJ Notes, Sht. C-15

**(Q)**  
**Waterline N**  
See Profile  
Sht. C-159


**(R)**  
# Sta. 58+71.3, o/s 52.7' Rt.  
1-20" 1/16 Bend (H)

- Notes:**
- Location of existing utilities are from "as-built" drawings. The Contractor shall verify tie-in connection points prior to the ordering of materials and the start of construction.
  - The Contractor shall coordinate construction with utility companies.
  - All waterlines shall be ductile iron pipe, class 53 with ductile iron fittings and shall be in accordance with the STANDARD SPECIFICATIONS FOR ROAD AND BRIDGE CONSTRUCTION, dated 2005, as amended, of the Hawaii Highways Division, Department of Transportation, and the City and County of Honolulu Board of Water Supply's "WATER SYSTEM STANDARDS", DATED 2002, THE "WATER SYSTEM EXTERNAL CORROSION CONTROL STANDARDS", VOLUME 3, DATED 2021, and all subsequent amendment and additions.
  - For electrical relocations, see electrical drawings.
  - For the portions of the water main to be concrete jacketed, a bell is to be installed in case there is a break on the line. This allows the removal of the compromised portion of the line without affecting the reinforced concrete jacketed segment of the existing water line. The installation of the bell shall be incidental to the various pay items under Section 624.

SURVEY PLOTTED BY	DATE
DRAWN BY	
TRACED BY	
CHECKED BY	
ORIGINAL PLAN	
NOTE BOOK	
No.	

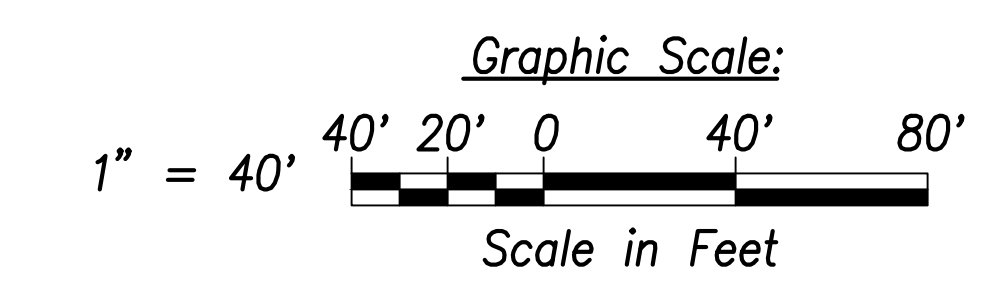

APPROVED:  
\_\_\_\_\_  
Manager and Chief Engineer, BWS DATE  
(for work affecting BWS facilities in City/State R/W & BWS easements only)

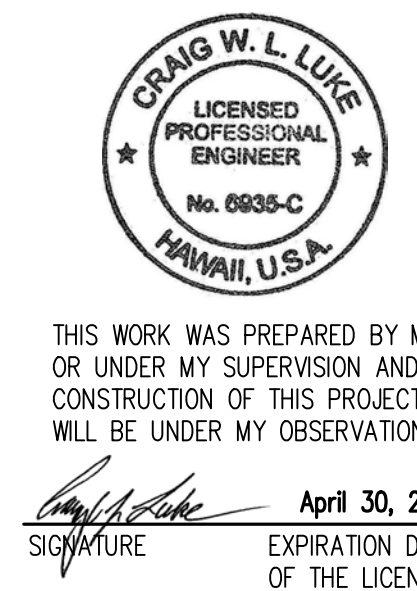

THIS WORK WAS PREPARED BY ME OR UNDER MY SUPERVISION AND CONSTRUCTION OF THIS PROJECT WILL BE UNDER MY OBSERVATION.  
Signature: \_\_\_\_\_  
EXPIRATION DATE OF THE LICENSE: April 30, 2024

DATE	REVISION
07/15/22	5 Revised waterlines and callouts
06/08/22	2 Revised Callouts; Profile Sheet References Revised; Deleted Note


STATE OF HAWAII  
**DEPARTMENT OF TRANSPORTATION**  
HIGHWAYS DIVISION

**Utility Plan**  
# Sta. 58+00 to # Sta. 61+00  
FARRINGTON HIGHWAY WIDENING  
Kapolei Golf Course Road to Fort Weaver Road  
Project No. 7101A-01-20

Scale: As Shown Date: April 2022




FED. ROAD DIST. NO.	STATE	PROJ. NO.	FISCAL YEAR	SHEET NO.	TOTAL SHEETS
HAWAII	HAW.	7101A-01-20	2021	124	767

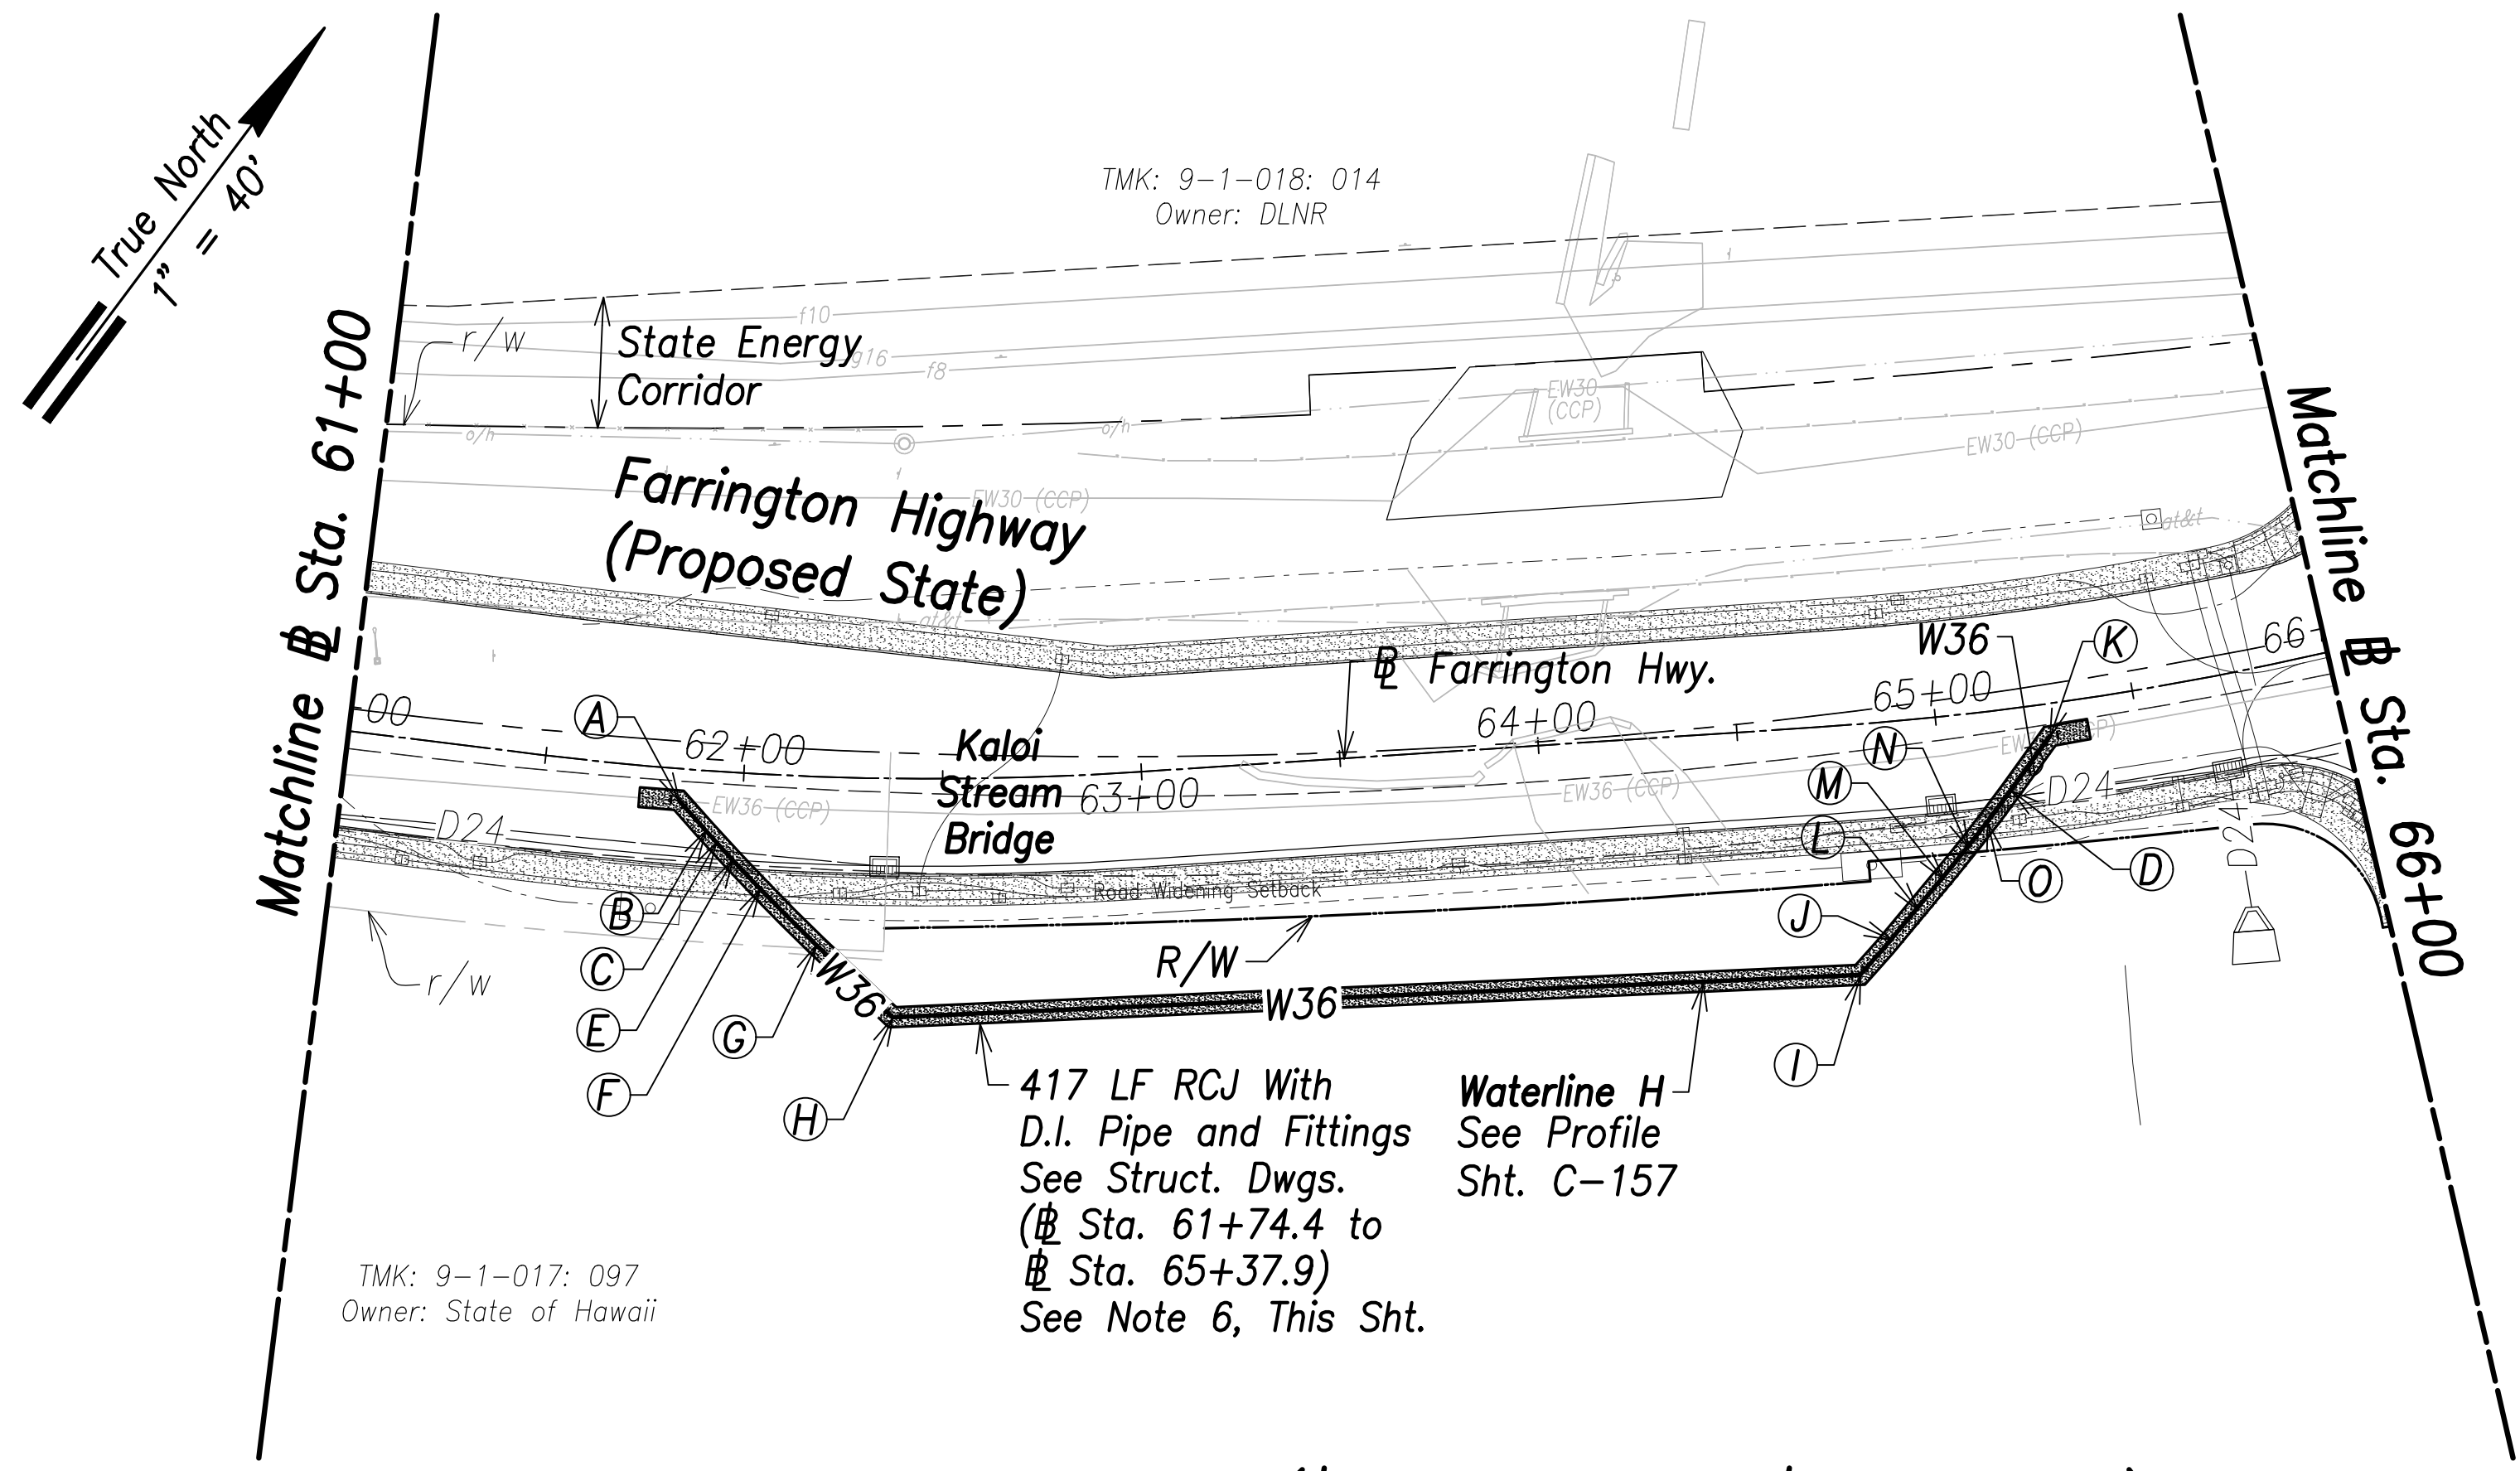

**Utility Plan - (Sta. 61+00 to Sta. 66+00)**  
Scale: 1" = 40'

- Notes:**
1. Location of existing utilities are from "as-built" drawings. The Contractor shall verify tie-in connection points prior to the ordering of materials and the start of construction.
  2. The Contractor shall coordinate construction with utility companies.
  3. All waterlines shall be ductile iron pipe, class 53 with ductile iron fittings and shall be in accordance with the STANDARD SPECIFICATIONS FOR ROAD AND BRIDGE CONSTRUCTION, dated 2005, as amended, of the Hawaii Highways Division, Department of Transportation, and the City and County of Honolulu Board of Water Supply's "WATER SYSTEM STANDARDS", DATED 2002, THE "WATER SYSTEM EXTERNAL CORROSION CONTROL STANDARDS", VOLUME 3, DATED 2021, and all subsequent amendment and additions.
  4. For electrical relocations, see electrical drawings.
  5. For the portions of the water main to be concrete jacketed, a bell is to be installed in case there is a break on the line. This allows the removal of the compromised portion of the line without affecting the reinforced concrete jacketed segment of the existing water line. The installation of the bell shall be incidental to the various pay items under Section 624.

- |  |  |   |   |
|--|--|---|---|
| <p><b>A</b><br/>Sta. 61+84.3, o/s 8' Rt.<br/>= Sta. 0+00 WL H<br/>Conn. to e/w36<br/>Contractor to verify location and invert<br/><u>Materials for Connection:</u><br/>1-36" 1/8 Bend (H)<br/>1-36" CCPxD.I. Adapter<br/>1-36" Sleeve, 15" Long<br/>8± LF 36" D.I.P., Cl. 53<br/><u>Temp for Testing:</u><br/>1-36" Cap Tapped for 6" I.P.T.<br/>1-6" C.O.<br/>1-Conc. Block<br/>See Sht. C-169 For Temporary By-Pass Plan and Profile - 3</p> <p><b>B</b><br/>Sta. 61+91.4, o/s 15' Rt.<br/>Deflect 1° (H)</p> <p><b>C</b><br/>Sta. 61+94.3, o/s 18' Rt.<br/>Deflect 1° (H)</p> | <p><b>D</b><br/>Sta. 65+16.8, o/s 20.4' Rt.<br/>Deflect 1° (H)</p> <p><b>E</b><br/>Sta. 61+98.5, o/s 21.9' Rt.<br/>Deflect 1° (H)</p> <p><b>F</b><br/>Sta. 62+05.5, o/s 28.7' Rt.<br/>Deflect 1° (H)</p> <p><b>G</b><br/>Sta. 62+19.6 o/s 42.3' Rt.<br/>Deflect 1° (H)</p> <p><b>H</b><br/>Sta. 62+38.1, o/s 60.1' Rt.<br/>1-36" 1/8 Bend (H)</p> <p><b>I</b><br/>Sta. 64+76.6, o/s 62.9' Rt.<br/>1-36" 1/8 Bend (H)</p> | <p><b>J</b><br/>Sta. 64+84.6, o/s 54.7' Rt.<br/>Deflect 1° (H)</p> <p><b>K</b><br/>Sta. 65+28.2, o/s 8.3' Rt.<br/>= Sta. 3+96.7 WL H<br/>Conn. to e/w36<br/>Contractor to verify location and invert<br/><u>Materials for Connection:</u><br/>1-36" 1/8 Bend (H)<br/>1-36" CCPxD.I. Adapter<br/>1-36" Sleeve, 15" Long<br/>8± LF 36" D.I.P., Cl. 53<br/><u>Temp for Testing:</u><br/>1-36" Cap Tapped for 6" I.P.T.<br/>1-6" C.O.<br/>1-Conc. Block<br/>See Sht. C-169 For Temporary By-Pass Plan and Profile - 4</p> <p><b>L</b><br/>Sta. 64+91.4, o/s 47.7' Rt.<br/>Deflect 1° (H)</p> <p><b>M</b><br/>Sta. 64+98.1, o/s 40.7' Rt.<br/>Deflect 1° (H)</p> | <p><b>N</b><br/>Sta. 65+04.8, o/s 33.6' Rt.<br/>Deflect 1° (H)</p> <p><b>O</b><br/>Sta. (65+10.1, o/s 27.6') Rt.<br/>Deflect 1° (H)</p> |
|--|--|---|---|

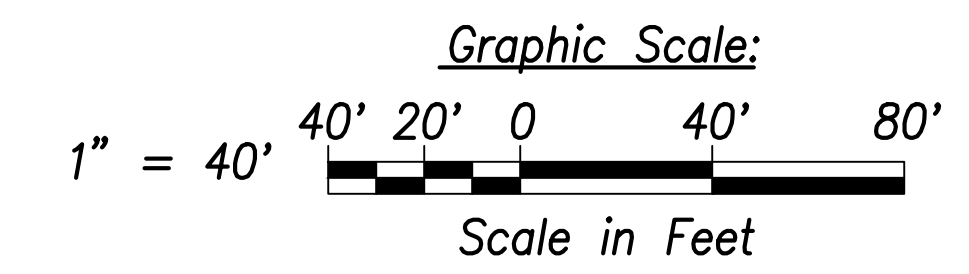

APPROVED:  
\_\_\_\_\_  
Manager and Chief Engineer, BWS DATE  
(for work affecting BWS facilities in City/State R/W & BWS easements only)



THIS WORK WAS PREPARED BY ME OR UNDER MY SUPERVISION AND CONSTRUCTION OF THIS PROJECT WILL BE UNDER MY OBSERVATION.  
\_\_\_\_\_  
SIGNATURE  
April 30, 2024  
EXPIRATION DATE OF THE LICENSE

DATE	REVISION
07/15/22	Callout "O" Revised; Callout "P" Removed
06/08/22	Callout Revised; Deleted Note

STATE OF HAWAII  
**DEPARTMENT OF TRANSPORTATION**  
HIGHWAYS DIVISION


**Utility Plan**  
Sta. 61+00 to Sta. 66+00  
FARRINGTON HIGHWAY WIDENING  
Kapolei Golf Course Road to Fort Weaver Road  
Project No. 7101A-01-20

Scale: As Shown Date: April 2022

SURVEY PLOTTED BY: _____	DATE: _____
DRAWN BY: _____	DATE: _____
TRACED BY: _____	DATE: _____
CHECKED BY: _____	DATE: _____
ORIGINAL PLAN	NOTE BOOK
No. _____	No. _____

FILE: K:\civil\23146 Farrington Hwy Widening\Drawings\Construction\Drawings\C-123 Utility Plan - Sta. 61+00 to 66+00.dwg saved June 30, 2022


FED. ROAD DIST. NO.	STATE	PROJ. NO.	FISCAL YEAR	SHEET NO.	TOTAL SHEETS
HAWAII	HAW.	7101A-01-20	2021	125	767

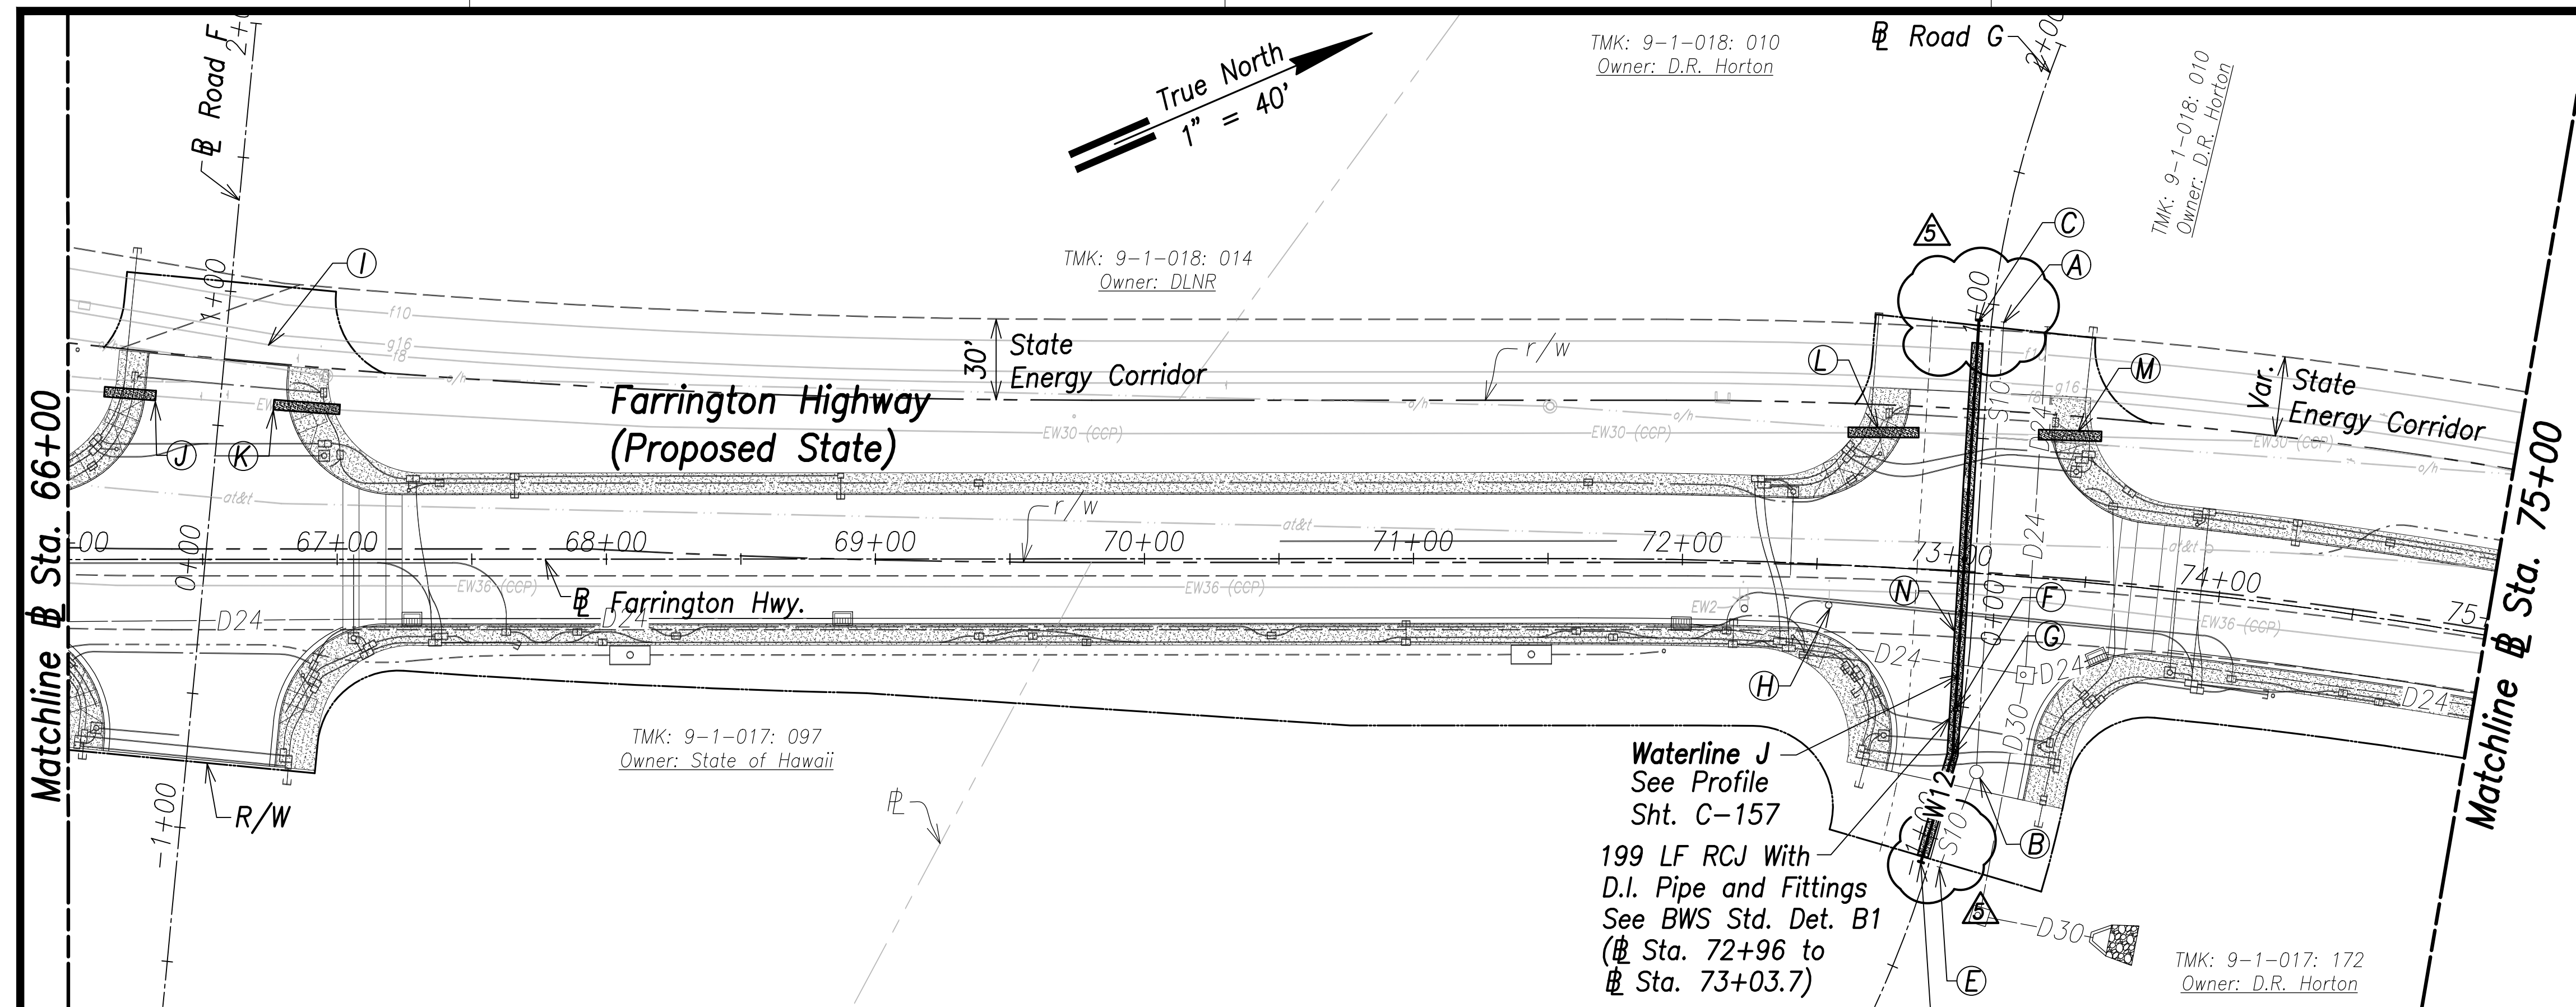

**Utility Plan - (# Sta. 66+00 to # Sta. 75+00)**  
Scale: 1" = 40'

- Notes:**
1. Location of existing utilities are from "as-built" drawings. The Contractor shall verify tie-in connection points prior to the ordering of materials and the start of construction.
  2. The Contractor shall coordinate construction with utility companies.
  3. All waterlines shall be ductile iron pipe, class 53 with ductile iron fittings and shall be in accordance with the STANDARD SPECIFICATIONS FOR ROAD AND BRIDGE CONSTRUCTION, dated 2005, as amended, of the Hawaii Highways Division, Department of Transportation, and the City and County of Honolulu Board of Water Supply's "WATER SYSTEM STANDARDS", DATED 2002, THE "WATER SYSTEM EXTERNAL CORROSION CONTROL STANDARDS", VOLUME 3, DATED 2021, and all subsequent amendment and additions.
  4. For electrical relocations, see electrical drawings.
  5. For the portions of the water main to be concrete jacketed, a bell is to be installed in case there is a break on the line. This allows the removal of the compromised portion of the line without affecting the reinforced concrete jacketed segment of the existing water line. The installation of the bell shall be incidental to the various pay items under Section 624.

- A** # Sta. 73+12.5, o/s 93.8' Lt. Cap and Mark S10 Inv.=153.62
- B** SMH 1 # Sta. 73+14.9 o/s 73.7' Rt. Top=166.93 Inv.=152.28 See City and County of Honolulu Std. Det. S-11
- C** # Sta. 73+03.7, o/s 93.8' Lt. = # Sta. 0+00 WL J End W12 1-12" G.V., 200# 1-12" Cap Tapped for 4" I.P.T. 1-4" C.O. 1-G.V. Box & Cover 1-Conc. Block See BWS Std. Det. B16, V2, V14, and V22
- D** # Sta. 72+96, o/s 108.6' Rt. = # Sta. 2+03.2 WL J End W12 1-12" G.V., 200# 1-12" Cap Tapped for 4" I.P.T. 1-4" C.O. 1-G.V. Box & Cover 1-Conc. Block See BWS Std. Det. B16, V2, V14, and V22
- E** # Sta. 73+03.4 o/s 110' Rt. Cap and Mark S10 Inv.=151.78 See Profile, Sht. C-167
- F** # Sta. 73+05.2, o/s 51.2' Rt. 1-3/4 ARV, 200# (WP=121.0 PSI) 1-ARV Box & Cover
- G** # Sta. 73+05.3, o/s 67.9' Rt. 1-12" 1/32 Bend (H)
- H** Adjust MH frame and cover to match finished grade (typ.)
- I** Assist HECO with the relocation of Test Station TS-10W. The Contractor shall coordinate all work with HECO and grade down to expose the 8" fuel pipeline and zinc ribbon. HECO will install new Test Station and conductors to pipeline and zinc ribbon. The contractor shall backfill to finished grade. All work shall be considered incidental to the various items of work.
- J** 19 LF RCJ on Exist. Waterline See BWS Std. Det. B1 (# Sta. 66+13.6 to # Sta. 66+32.6) See BWS RCJ Notes, Sht. C-15
- K** 25 LF RCJ on Exist. Waterline See BWS Std. Det. B1 (# Sta. 66+76.5 to # Sta. 67+01) See BWS RCJ Notes, Sht. C-15
- L** 26 LF RCJ on Exist. Waterline See BWS Std. Det. B1 (# Sta. 72+59.3 to # Sta. 72+84.8) See BWS RCJ Notes, Sht. C-15
- M** 23 LF RCJ on Exist. Waterline See BWS Std. Det. B1 (# Sta. 73+28.2 to # Sta. 73+50.9) See BWS RCJ Notes, Sht. C-15
- N** See Note 3, this sheet

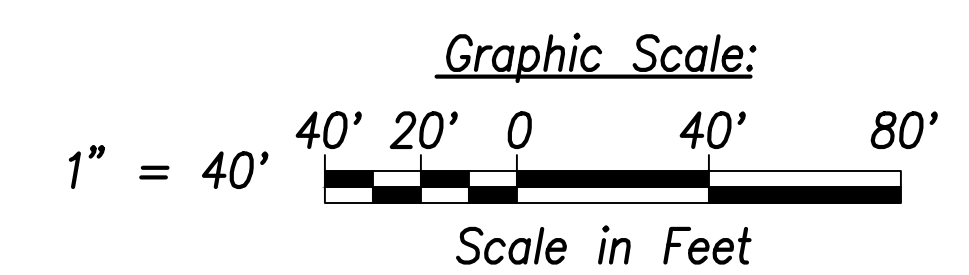

SURVEY PLOTTED BY	DATE
DRAWN BY	
TRACED BY	
QUANTITIES BY	
CHECKED BY	
ORIGINAL PLAN	
NOTE BOOK	
No.	

APPROVED:  
\_\_\_\_\_  
Manager and Chief Engineer, BWS DATE  
(for work affecting BWS facilities in City/State R/W & BWS easements only)

**ORANG W. L. LUKE**  
LICENSED PROFESSIONAL ENGINEER  
No. 6935-C  
HAWAII, U.S.A.  
THIS WORK WAS PREPARED BY ME OR UNDER MY SUPERVISION AND CONSTRUCTION OF THIS PROJECT WILL BE UNDER MY OBSERVATION.  
Signature: \_\_\_\_\_  
EXPIRATION DATE OF THE LICENSE: April 30, 2024

DATE	REVISION
07/15/22	Revised callouts; Revised RCJ
06/08/22	Revised W.L. naming; added callout; Deleted note; Revised callout


STATE OF HAWAII  
**DEPARTMENT OF TRANSPORTATION**  
HIGHWAYS DIVISION

**Utility Plan**  
# Sta. 66+00 to # Sta. 75+00  
FARRINGTON HIGHWAY WIDENING  
Kapolei Golf Course Road to Fort Weaver Road  
Project No. 7101A-01-20

Scale: As Shown Date: April 2022



FED. ROAD DIST. NO.	STATE	PROJ. NO.	FISCAL YEAR	SHEET NO.	TOTAL SHEETS
HAWAII	HAW.	7101A-01-20	2021	128	767

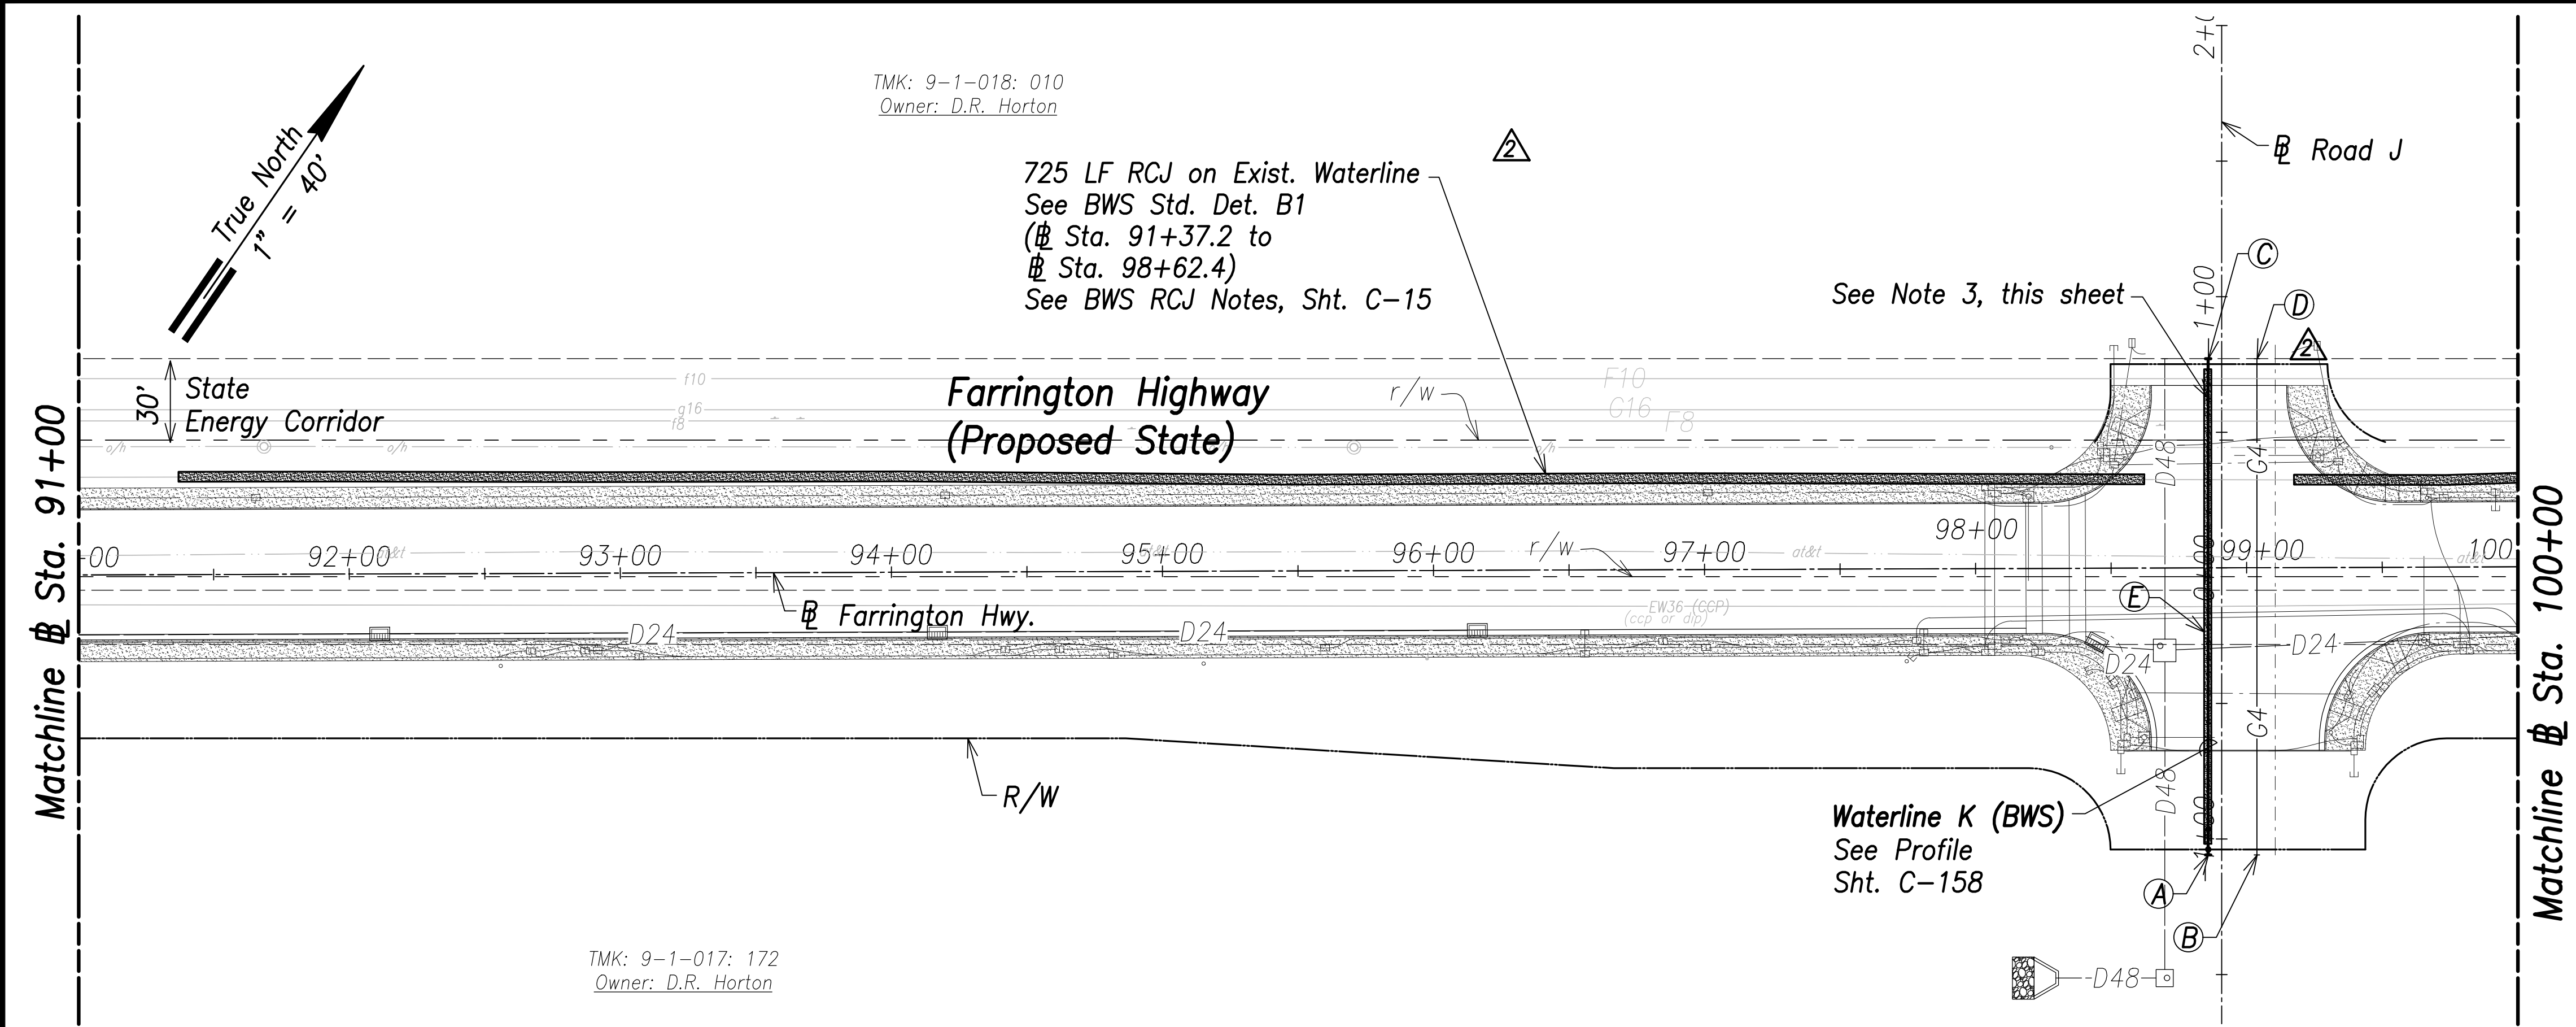

TMK: 9-1-018: 010  
Owner: D.R. Horton

725 LF RCJ on Exist. Waterline  
See BWS Std. Det. B1  
(Sta. 91+37.2 to  
Sta. 98+62.4)  
See BWS RCJ Notes, Sht. C-15

See Note 3, this sheet

TMK: 9-1-017: 172  
Owner: D.R. Horton

**Utility Plan - (Sta. 91+00 to Sta. 100+00)**  
Scale: 1" = 40'

- Notes:**
1. Location of existing utilities are from "as-built" drawings. The Contractor shall verify tie-in connection points prior to the ordering of materials and the start of construction.
  2. The Contractor shall coordinate construction with utility companies.
  3. All waterlines shall be ductile iron pipe, class 53 with ductile iron fittings and shall be in accordance with the STANDARD SPECIFICATIONS FOR ROAD AND BRIDGE CONSTRUCTION, dated 2005, as amended, of the Hawaii Highways Division, Department of Transportation, and the City and County of Honolulu Board of Water Supply's "WATER SYSTEM STANDARDS", DATED 2002, THE "WATER SYSTEM EXTERNAL CORROSION CONTROL STANDARDS", VOLUME 3, DATED 2021, and all subsequent amendment and additions.
  4. For electrical relocations, see electrical drawings.
  5. For the portions of the water main to be concrete jacketed, a bell is to be installed in case there is a break on the line. This allows the removal of the compromised portion of the line without affecting the reinforced concrete jacketed segment of the existing water line. The installation of the bell shall be incidental to the various pay items under Section 624.


**(A)**  
Sta. 98+85.4, o/s 105.9' Rt.  
= Sta. 1+83 WL K  
End W12  
1-12" G.V., 200#  
1-3/4" ARV, 200#  
1-12" Cap Tapped for 4" I.P.T.  
1-4" C.O.  
1-G.V. Box & Cover  
1-ARV Box & Cover  
1-Conc. Block  
1-Conc. Thrust Beam w/ Reverse Bell Pipe  
See BWS Std. Det. B16, V2, V14, and V22

**(C)**  
Sta. 98+86, o/s 77.1' Lt.  
= Sta. 0+00 WL K  
End W12  
1-12" Cap Tapped for 4" I.P.T.  
1-4" C.O.  
1-Valve Box  
1-Conc. Block  
See BWS Std. Det. V2 and V22

**(E)**  
175 LF RCJ With D.I. Pipe and Fittings  
See BWS Std. Det. B1  
(Sta. 98+85.4 to Sta. 98+86)


**(D)**  
Sta. 99+04, o/s 77.1' Lt.  
Cap and Mark G2  
Provide 3' Min. Cover

**(B)**  
Sta. 99+03.4, o/s 105.9 Rt.  
Cap and Mark G2  
Provide 3' Min. Cover  
See Profile, Sht. C-166

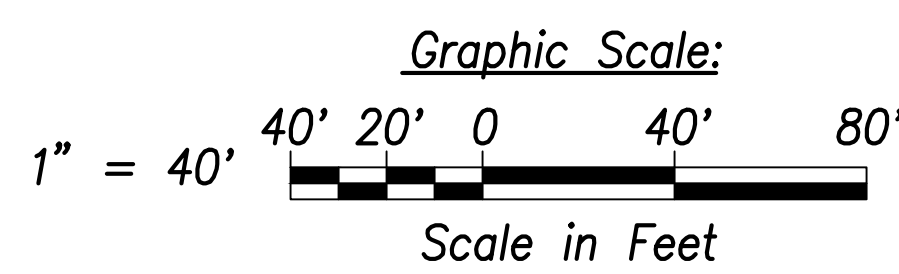

APPROVED:  
\_\_\_\_\_  
Manager and Chief Engineer, BWS  
(for work affecting BWS facilities in  
City/State R/W & BWS easements only)

DATE \_\_\_\_\_

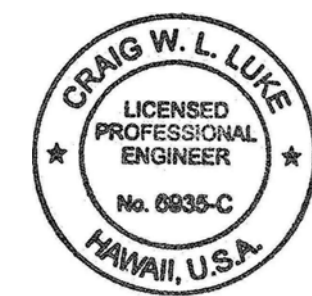

THIS WORK WAS PREPARED BY ME  
OR UNDER MY SUPERVISION AND  
CONSTRUCTION OF THIS PROJECT  
WILL BE UNDER MY OBSERVATION.  
\_\_\_\_\_  
SIGNATURE  
April 30, 2024  
EXPIRATION DATE  
OF THE LICENSE

DATE	REVISION
07/15/22	Revised callout
06/08/22	Revised callouts; removed gate valve; Deleted note

STATE OF HAWAII  
**DEPARTMENT OF TRANSPORTATION**  
HIGHWAYS DIVISION

**Utility Plan**  
Sta. 91+00 to Sta. 100+00



FARRINGTON HIGHWAY WIDENING  
Kapolei Golf Course Road to Fort Weaver Road  
Project No. 7101A-01-20

Scale: As Shown Date: April 2022

SURVEY PLOTTED BY _____	DATE _____
DRAWN BY _____	
TRACED BY _____	
CHECKED BY _____	
ORIGINAL PLAN	NOTE BOOK
No. _____	

FILE: K:\civil\23146 Farrington Hwy Widening\Drawings\Construction\Drawings\C-127 Utility Plan - Sta. 91+00 to 100+00.dwg saved July 11, 2022

FED. ROAD DIST. NO.	STATE	PROJ. NO.	FISCAL YEAR	SHEET NO.	TOTAL SHEETS
HAWAII	HAW.	7101A-01-20	2021	130	767

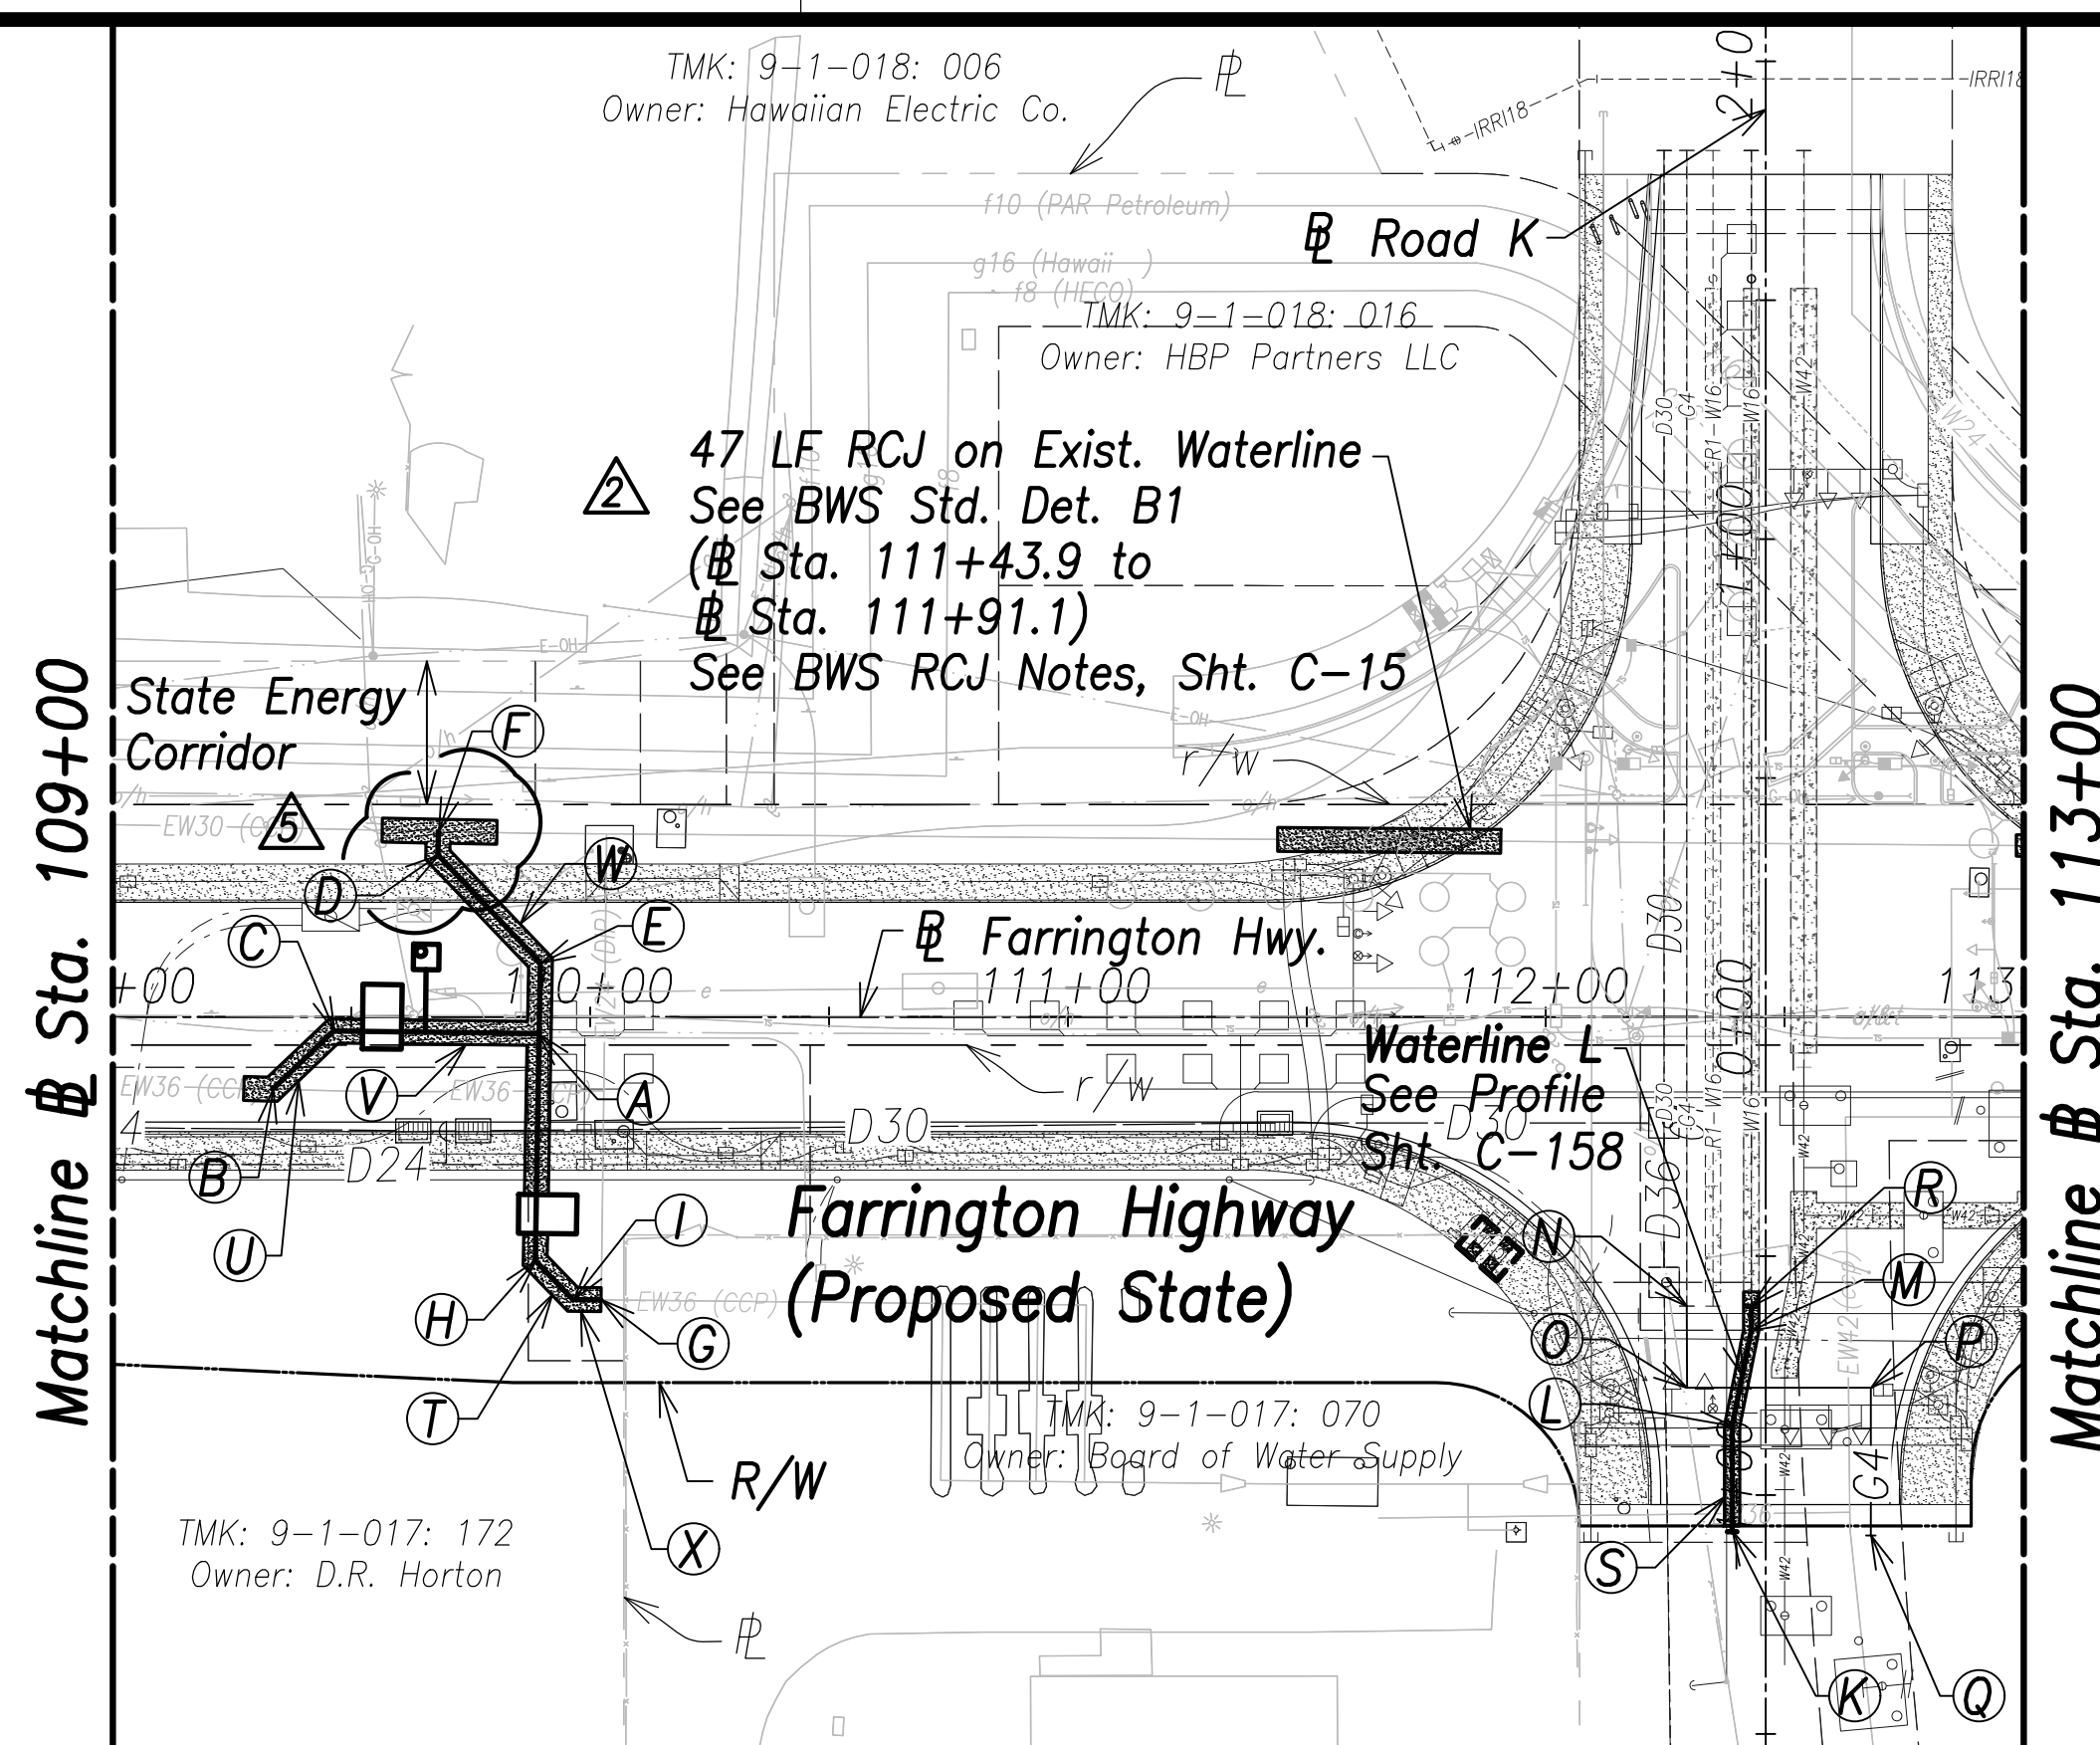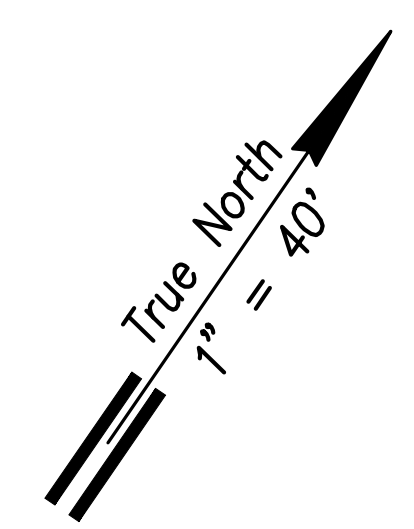

**Utility Plan - (Sta. 109+00 to Sta. 113+00)**  
Scale: 1" = 40'

**(A)**  
Sta. 109+89.1, o/s 3.4' Rt.  
1-36"x36" Tee  
1-36"x24" Reducer  
2-36" B.G.G.V., 200#  
2-Type "A" MH  
See BWS Std. Det. MH1-MH5

**(B)**  
Sta. 109+33.6, o/s 15.1' Rt.  
Conn. to e/w36  
Contractor to verify location and invert  
(Contractor to verify pipe size prior to the start of construction)  
**Materials for Connection:**  
1-36" CCPxD.I. Adapter  
1-36" Sleeve  
1-36" 1/8 Bend (H)  
8± LF 36" D.I.P., Cl. 53  
**Temp for Testing:**  
1-36" Cap Tapped for 6" I.P.T.  
1-6" C.O.  
1-Conc. Block  
See Sht. C-170 For Temporary By-Pass Plan and Profile - 6

**(C)**  
Sta. 109+46.4, o/s 2.9' Rt.  
1-36" 1/8 Bend (H)

**(D)**  
Sta. 109+68.2, o/s 33.9' Lt.  
1-24" 1/8 Bend (H)

**(E)**  
Sta. 109+89.6, o/s 11.4' Lt.  
1-24" 1/8 Bend (H)

**(F)**  
Sta. 109+68.3, o/s 38.9' Lt.  
= Sta. 0+00 WL Q  
Conn. to e/w30  
Contractor to verify location and invert  
**Materials for Connection:**  
1-30"x24" Tee  
2-30" CCPxD.I. Adapter  
1-24" Sleeve, 15" Long  
8± LF 24" D.I.P., Cl. 53  
8± LF 30" D.I.P., Cl. 53  
**Temp for Testing:**  
1-24" Cap Tapped for 6" I.P.T.  
1-6" C.O.  
1-Conc. Block  
See Sht. C-171 For Temporary By-Pass Plan and Profile - 7

**(G)**  
Sta. 110+02.3, o/s 59.2' Rt.  
= Sta. 1+15.7 WL Q  
Conn. to e/w36  
Remove exist. 1/4 bend  
Contractor to verify location and invert  
**Materials for Connection:**  
1-36" CCPxD.I. Adapter  
1-36" Sleeve, 15" Long  
8± LF 36" D.I.P., Cl. 53  
**Temp for Testing:**  
1-36" Cap Tapped for 6" I.P.T.  
1-6" C.O.  
1-Conc. Block  
See Sht. C-171 For Temporary By-Pass Plan and Profile - 8

**(H)**  
Sta. 109+88.5, o/s 51' Rt.  
1-36" 1/8 Bend (H)

**(I)**  
Sta. 109+96+4, o/s 59.1' Rt.  
1-36" 1/8 Bend (H)

**(J)**  
Sta. 109+65.7, o/s 12.6' Lt.  
Center MH  
2-2" Offset ARV, 200#  
1-Type "D" MH  
See BWS Std. Det. V5 and MH20-MH21

**(K)**  
Sta. 112+39, o/s 107.7' Rt.  
= Sta. 0+48.4 WL L  
End W16  
1-16" Cap Tapped for 4" I.P.T.  
1-4" C.O.  
1-Valve Box for C.O.  
1-Conc. Block  
See BWS Std. Det. V2 and V22

**(L)**  
Sta. 112+39, o/s 85.6' Rt.  
1-16" 1/32 Bend (W16), H

**(M)**  
Sta. 112+43, o/s 65.6' Rt.  
1-16" 1/32 Bend (W16), H

**(N)**  
Sta. 112+29.5, o/s 60.5' Rt.  
Conn. to e/g4  
Match exist. slope and invert  
Remove exist. cap and marker  
Provide 3' Min. Cover  
See Profile, Sht. C-166

**(O)**  
Sta. 112+29.6, o/s 77.6' Rt.  
1-4" Gas 1/4 Bend

**(P)**  
Sta. 112+68, o/s 77.6' Rt.  
1-4" Gas 1/4 Bend

**(Q)**  
Sta. 112+68, o/s 108.5' Rt.  
Cap and Mark G4  
Provide 3' Min. Cover

**(R)**  
Sta. 112+43, o/s 60.5' Rt.  
= Sta. 0+00 WL L  
Conn. to e/w16  
Remove exist. cap, cleanout, and conc. block  
Match exist. slope and invert  
**Materials for Connection:**  
1-16" Sleeve, 15" Long  
8± LF 16" D.I.P., Cl. 53  
**Temp. for Testing:**  
1-16" Cap Tapped for 4" I.P.T.  
1-4" C.O.  
1-Conc. Block  
Contractor to verify location and invert

**(S)**  
50 LF RCJ With D.I. Pipe and Fittings  
See Struct. Dwgs.  
(Sta. 112+39 to Sta. 112+43)

**(T)**  
**Waterline Q**  
See Sht. C-160


**(U)**  
30 LF RCJ With D.I. Pipe and Fittings  
See Struct. Dwgs.  
(Sta. 109+27.6 to Sta. 109+52.4)

**(V)**  
28 LF RCJ With D.I. Pipe and Fittings  
See Struct. Dwgs.  
(Sta. 109+60.6 to Sta. 109+89.1)

**(W)**  
83 LF RCJ With D.I. Pipe and Fittings  
See Struct. Dwgs.  
(Sta. 109+73.3 to Sta. 109+88.8)

**(X)**  
23 LF RCJ With D.I. Pipe and Fittings  
See Struct. Dwgs.  
(Sta. 109+88.6 to Sta. 110+02.3)


- Notes:**
- Location of existing utilities are from "as-built" drawings. The Contractor shall verify tie-in connection points prior to the ordering of materials and the start of construction.
  - The Contractor shall coordinate construction with utility companies.
  - All waterlines shall be ductile iron pipe, class 53 with ductile iron fittings and shall be in accordance with the STANDARD SPECIFICATIONS FOR ROAD AND BRIDGE CONSTRUCTION, dated 2005, as amended, of the Hawaii Highways Division, Department of Transportation, and the City and County of Honolulu Board of Water Supply's "WATER SYSTEM STANDARDS", DATED 2002, THE "WATER SYSTEM EXTERNAL CORROSION CONTROL STANDARDS", VOLUME 3, DATED 2021, and all subsequent amendment and additions.
  - For electrical relocations, see electrical drawings.
  - For the portions of the water main to be concrete jacketed, a bell is to be installed in case there is a break on the line. This allows the removal of the compromised portion of the line without affecting the reinforced concrete jacketed segment of the existing water line. The installation of the bell shall be incidental to the various pay items under Section 624.

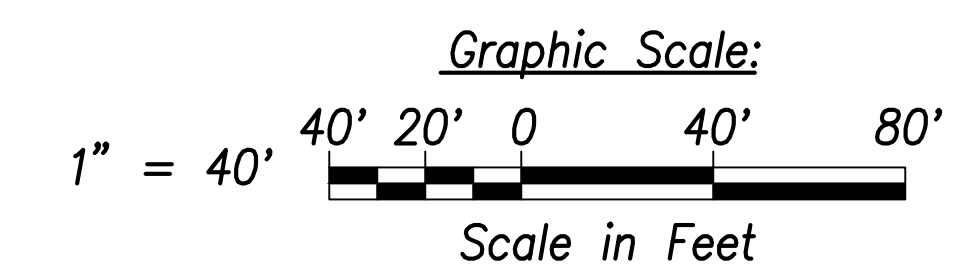

SURVEY PLOTTED BY	DATE
DRAWN BY	
TRACED BY	
QUANTITIES BY	
CHECKED BY	
ORIGINAL PLAN	
NOTE BOOK	
No.	

APPROVED:  
\_\_\_\_\_  
Manager and Chief Engineer, BWS  
(for work affecting BWS facilities in City/State R/W & BWS easements only)

DATE \_\_\_\_\_

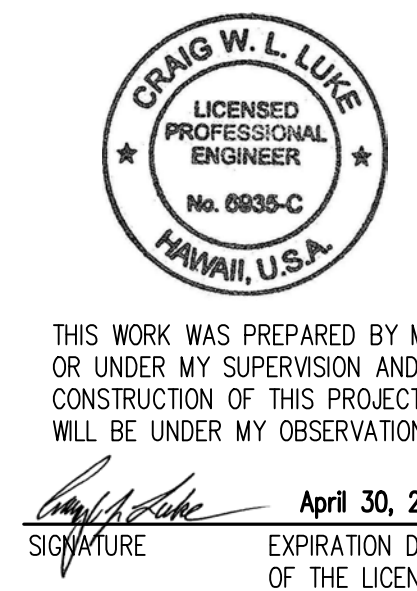

THIS WORK WAS PREPARED BY ME OR UNDER MY SUPERVISION AND CONSTRUCTION OF THIS PROJECT WILL BE UNDER MY OBSERVATION.  
Signature: \_\_\_\_\_  
April 30, 2024  
EXPIRATION DATE OF THE LICENSE

DATE	REVISION
07/15/22	Revised callouts; RCJ added; Revised Waterline Q
06/08/22	Removed thrust beam; Added callouts; Revised callouts; Deleted note

STATE OF HAWAII  
**DEPARTMENT OF TRANSPORTATION**  
HIGHWAYS DIVISION


**Utility Plan**  
Sta. 109+00 to Sta. 113+00

FARRINGTON HIGHWAY WIDENING  
Kapolei Golf Course Road to Fort Weaver Road  
Project No. 7101A-01-20

Scale: As Shown Date: April 2022




FED. ROAD DIST. NO.	STATE	PROJ. NO.	FISCAL YEAR	SHEET NO.	TOTAL SHEETS
HAWAII	HAW.	7101A-01-20	2021	131	767

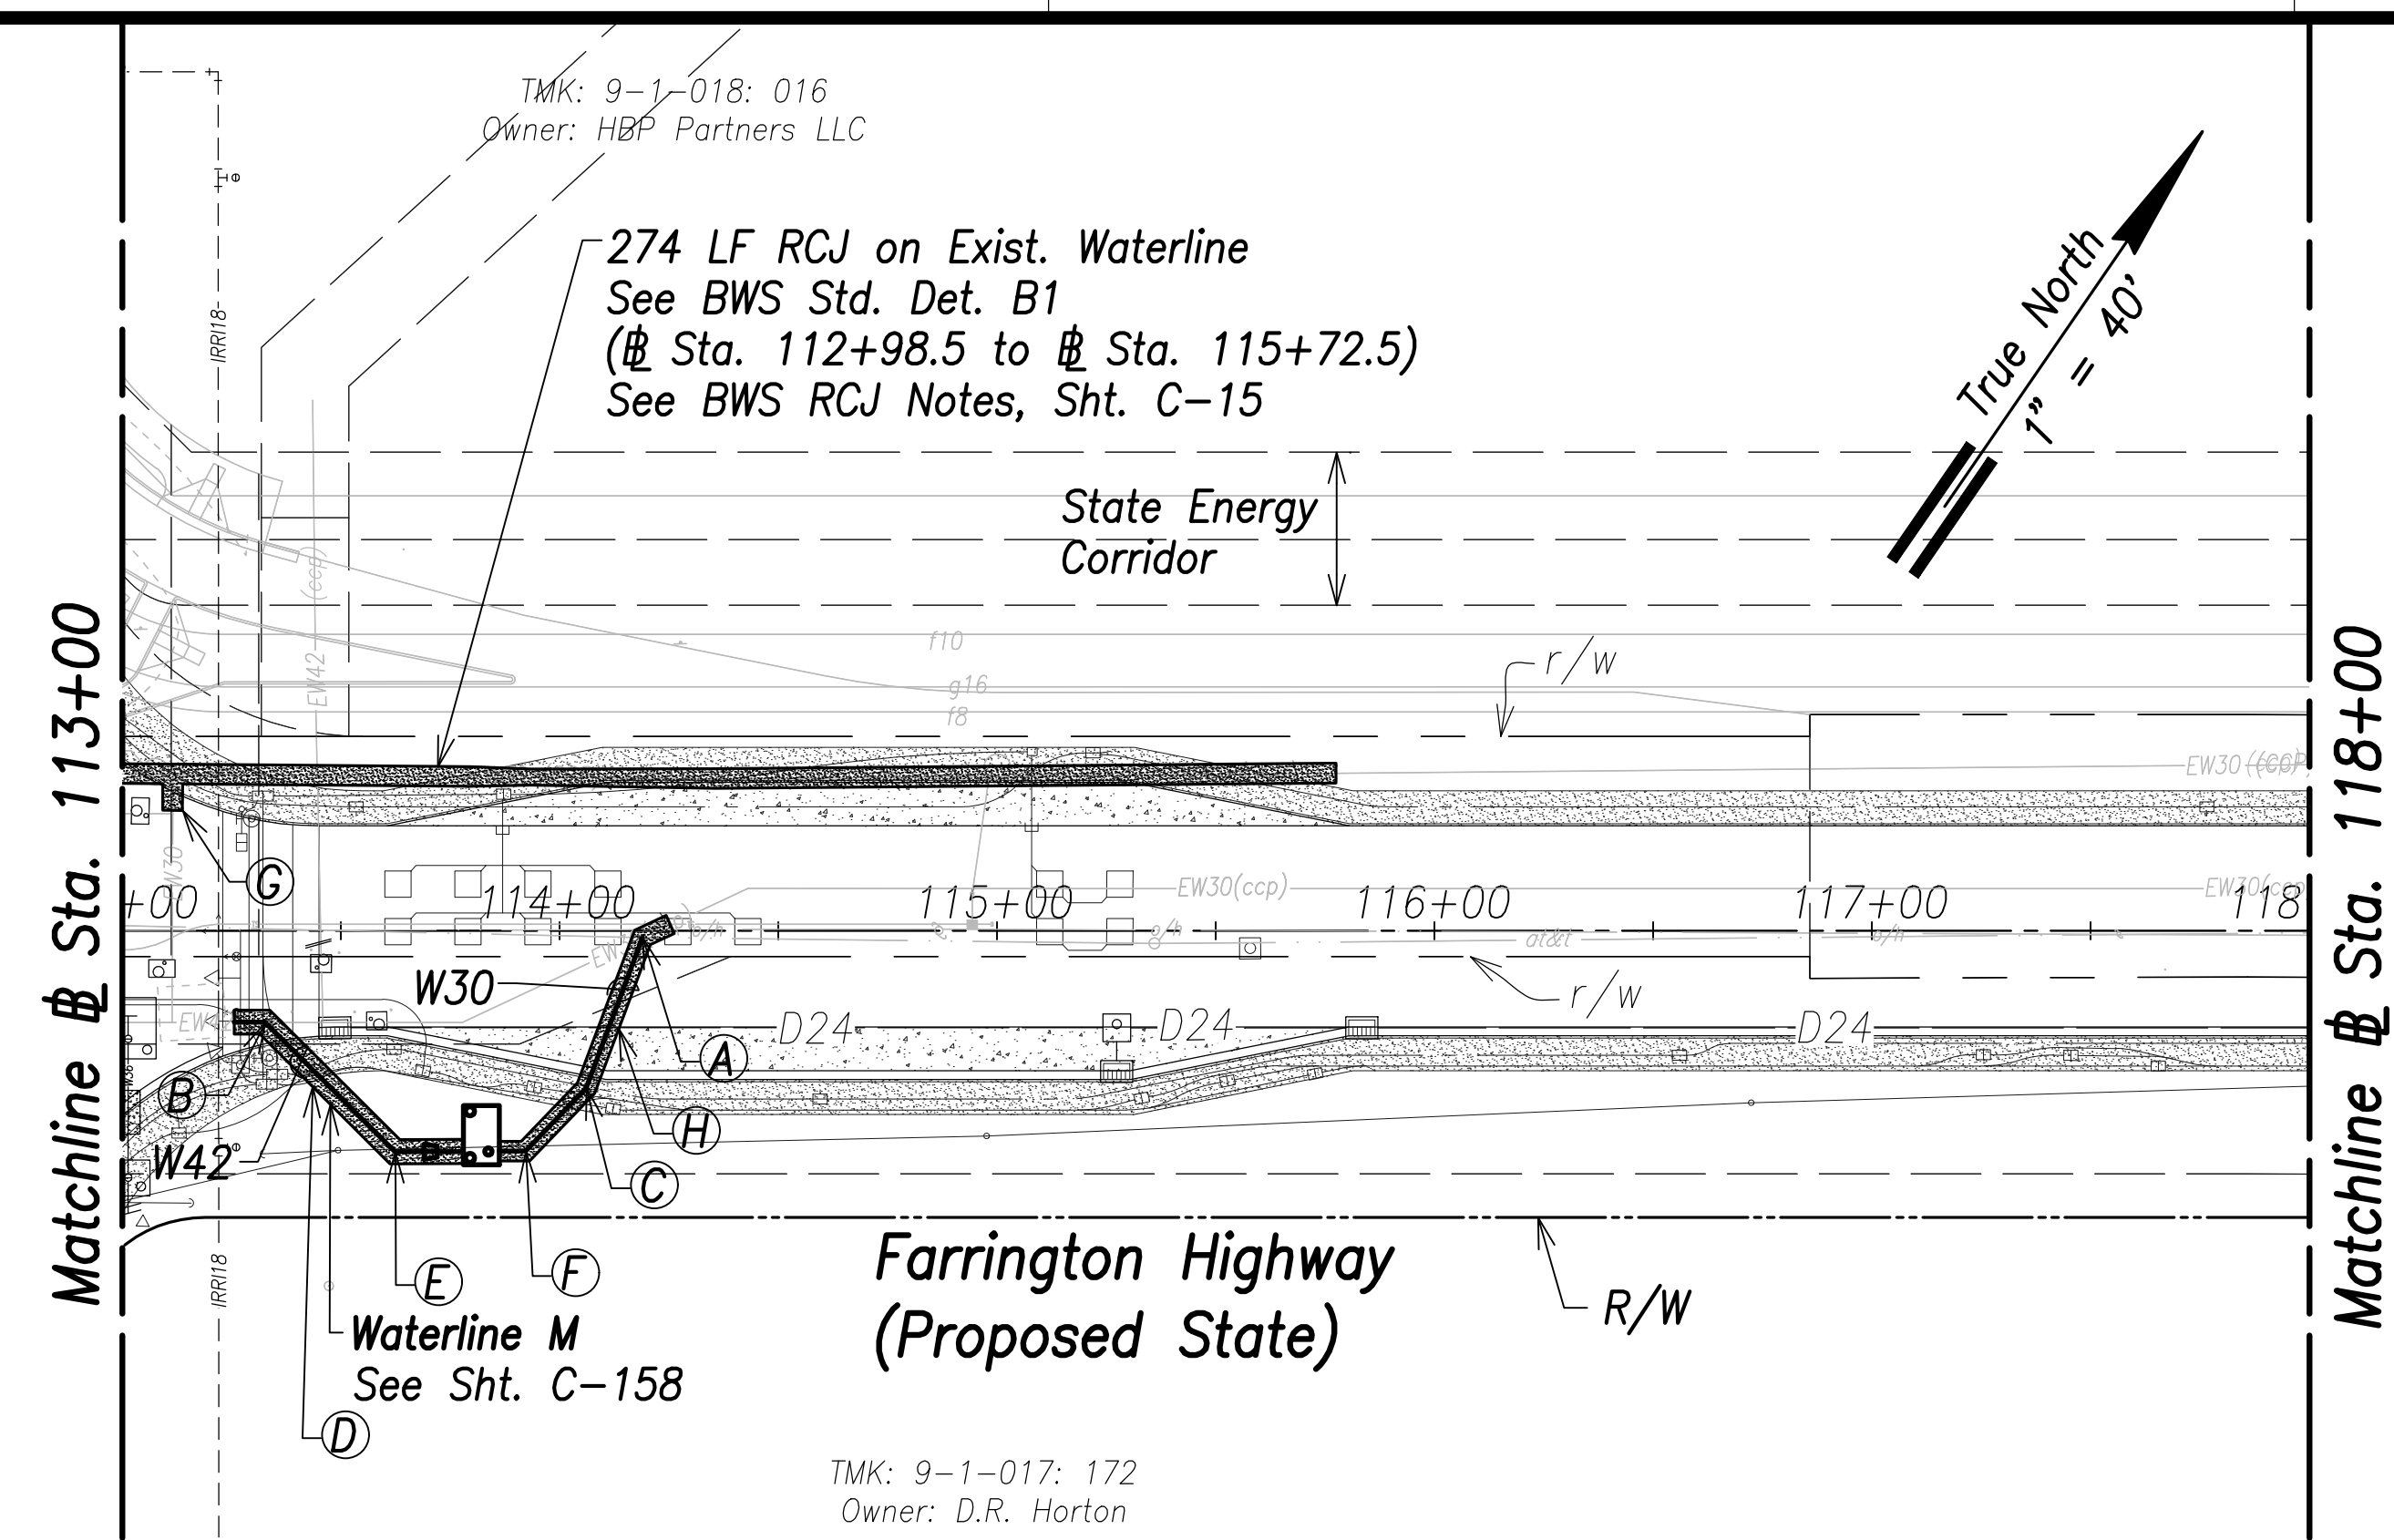

**Utility Plan - (Sta. 113+00 to Sta. 118+00)**  
Scale: 1" = 40'

- (A)** Sta. 114+19, o/s 1.6' Rt.  
= Sta. 1+08.5 WL M  
Conn. to e/w30  
Contractor to verify location and invert  
Materials for Connection:  
1-30" CCPx D.I. Adapter  
1-30" 1/8 Bend (H)  
1-Concrete Block with Struct. Struts  
Rotate bend to match exist. pipe slope  
8± LF 30" D.I.P., Cl. 53  
Temp. for Testing:  
1-30" Cap Tapped for 6" I.P.T.  
1-6" C.O.  
1-Conc. Block  
See Sht. C-172 For Temporary By-Pass Plan and Profile - 10
- (B)** Sta. 113+32.7, o/s 20.9' Rt.  
= Sta. 0+00 WL M  
Conn. to e/w42  
Contractor to verify location and invert  
Materials for Connection:  
1-42" CCPx D.I. Adapter  
1-42" Sleeve, 24" Long  
1-42" 1/8 Bend (H)  
1-42"x30" Reducer  
1-30" B.G.G.V., 200#  
1-Type "A" MH  
8± LF 42" D.I.P., Cl. 53  
See BWS Std. Det. MH1-MH5  
Temp. for Testing:  
1-42" Cap Tapped for 6" I.P.T.  
1-6" C.O.  
1-Conc. Block  
See Sht. C-172 For Temporary By-Pass Plan and Profile - 9
- (C)** Sta. 114+06.1, o/s 36' Rt.  
= Sta. 0+91.8 WL M  
1-30" 1/16 Bend (H)
- (D)** 65 LF RCJ With D.I. Pipe and Fittings  
See Struct. Dwgs.  
(Sta. 113+25.7 to Sta. 113+72.1)
- (E)** Sta. 113+62.4, o/s 50.5' Rt.  
1-42" 1/8 Bend (H)
- (F)** Sta. 113+92.3, o/s 50.4' Rt.  
1-30" 1/8 Bend (H)
- (G)** 9 LF RCJ on Exist. Waterline  
See BWS Std. Det. B1  
(Sta. 113+11.6 to Sta. 113+11.7)  
See BWS RCJ Notes, Sht. C-15
- (H)** 63 LF RCJ With D.I. Pipe and Fittings  
See BWS Std. Det. B1  
(Sta. 113+80.3 to Sta. 114+15.3)

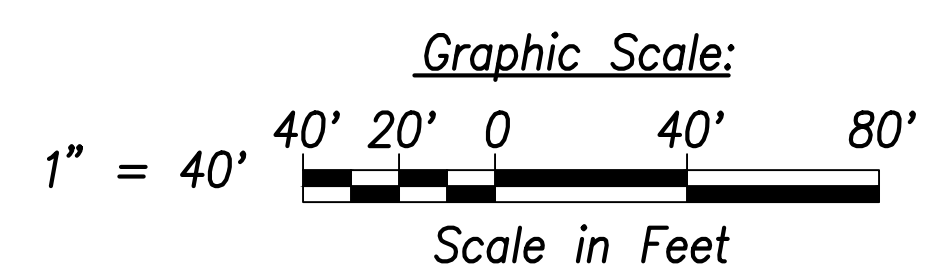


- Notes:**
- Location of existing utilities are from "as-built" drawings. The Contractor shall verify tie-in connection points prior to the ordering of materials and the start of construction.
  - The Contractor shall coordinate construction with utility companies.
  - All waterlines shall be ductile iron pipe, class 53 with ductile iron fittings and shall be in accordance with the STANDARD SPECIFICATIONS FOR ROAD AND BRIDGE CONSTRUCTION, dated 2005, as amended, of the Hawaii Highways Division, Department of Transportation, and the City and County of Honolulu Board of Water Supply's "WATER SYSTEM STANDARDS", DATED 2002, THE "WATER SYSTEM EXTERNAL CORROSION CONTROL STANDARDS", VOLUME 3, DATED 2021, and all subsequent amendment and additions.
  - For electrical relocations, see electrical drawings.
  - For the portions of the water main to be concrete jacketed, a bell is to be installed in case there is a break on the line. This allows the removal of the compromised portion of the line without affecting the reinforced concrete jacketed segment of the existing water line. The installation of the bell shall be incidental to the various pay items under Section 624.

SURVEY PLOTTED BY	DATE
DRAWN BY	
TRACED BY	
CHECKED BY	
ORIGINAL PLAN	
NOTE BOOK	
NO.	

APPROVED:  
\_\_\_\_\_  
Manager and Chief Engineer, BWS  
(for work affecting BWS facilities in City/State R/W & BWS easements only)

DATE \_\_\_\_\_

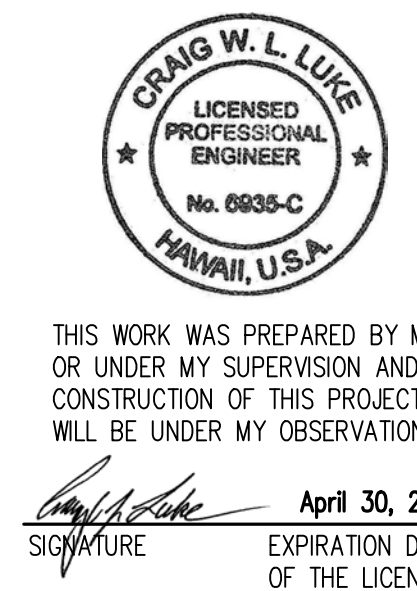

THIS WORK WAS PREPARED BY ME OR UNDER MY SUPERVISION AND CONSTRUCTION OF THIS PROJECT WILL BE UNDER MY OBSERVATION.

Signature: \_\_\_\_\_  
April 30, 2024  
EXPIRATION DATE OF THE LICENSE

DATE	REVISION
07/15/22	Revised callouts
06/08/22	Deleted note; Revised callouts; Revised waterline


STATE OF HAWAII  
**DEPARTMENT OF TRANSPORTATION**  
HIGHWAYS DIVISION

**Utility Plan**  
Sta. 113+00 to Sta. 118+00

FARRINGTON HIGHWAY WIDENING  
Kapolei Golf Course Road to Fort Weaver Road  
Project No. 7101A-01-20

Scale: As Shown Date: April 2022


FED. ROAD DIST. NO.	STATE	PROJ. NO.	FISCAL YEAR	SHEET NO.	TOTAL SHEETS
HAWAII	HAW.	7101A-01-20	2021	132	767

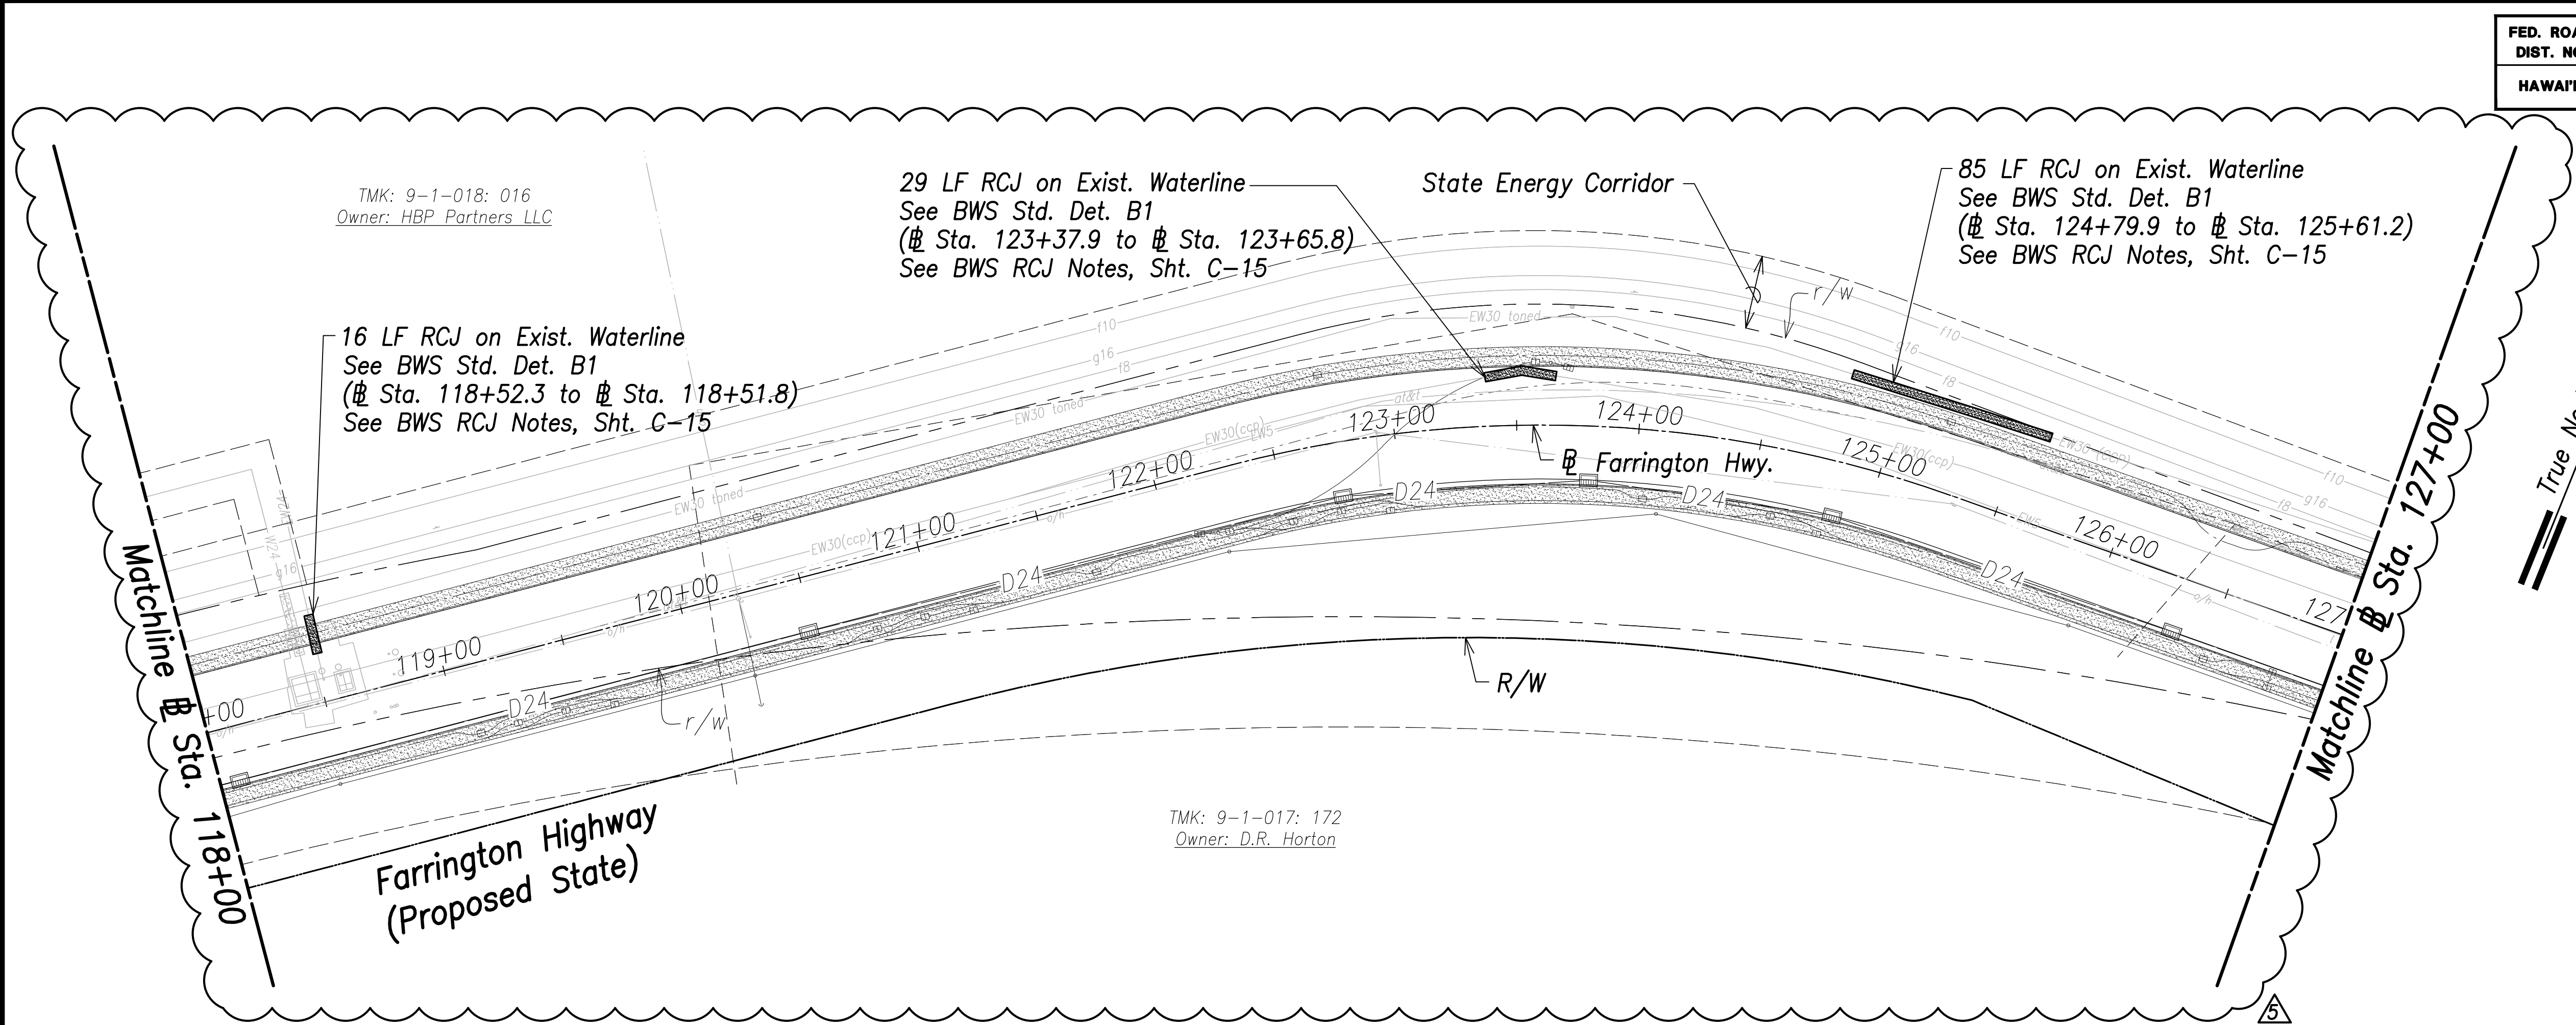

**Utility Plan - (Sta. 118+00 to Sta. 127+00)**  
Scale: 1" = 40'

**Notes:**

1. Location of existing utilities are from "as-built" drawings. The Contractor shall verify tie-in connection points prior to the ordering of materials and the start of construction.
2. The Contractor shall coordinate construction with utility companies.
3. All waterlines shall be ductile iron pipe, class 53 with ductile iron fittings and shall be in accordance with the STANDARD SPECIFICATIONS FOR ROAD AND BRIDGE CONSTRUCTION, dated 2005, as amended, of the Hawaii Highways Division, Department of Transportation, and the City and County of Honolulu Board of Water Supply's "WATER SYSTEM STANDARDS", DATED 2002, THE "WATER SYSTEM EXTERNAL CORROSION CONTROL STANDARDS", VOLUME 3, DATED 2021, and all subsequent amendment and additions.
4. For electrical relocations, see electrical drawings.
5. For the portions of the water main to be concrete jacketed, a bell is to be installed in case there is a break on the line. This allows the removal of the compromised portion of the line without affecting the reinforced concrete jacketed segment of the existing water line. The installation of the bell shall be incidental to the various pay items under Section 624.

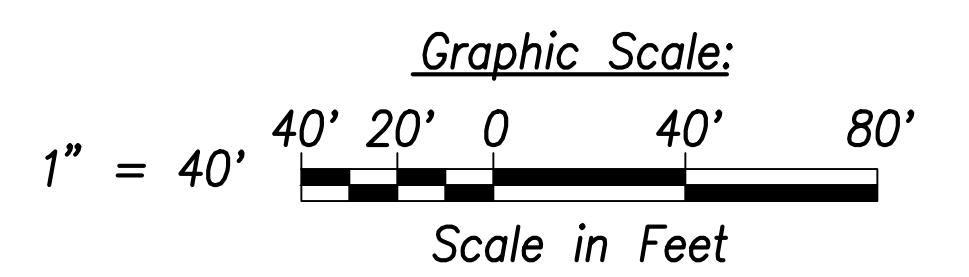

SURVEY PLOTTED BY	DATE
DRAWN BY	
TRACED BY	
DESIGNED BY	
CHECKED BY	
ORIGINAL PLAN	
NOTE BOOK	
No.	

APPROVED:  
\_\_\_\_\_  
Manager and Chief Engineer, BWS DATE  
(for work affecting BWS facilities in City/State R/W & BWS easements only)



THIS WORK WAS PREPARED BY ME OR UNDER MY SUPERVISION AND CONSTRUCTION OF THIS PROJECT WILL BE UNDER MY OBSERVATION.  
Signature: \_\_\_\_\_  
April 30, 2024  
EXPIRATION DATE OF THE LICENSE

07/15/22	Added electrical
06/08/22	Deleted note; Revised callout
DATE	REVISION

STATE OF HAWAII  
DEPARTMENT OF TRANSPORTATION  
HIGHWAYS DIVISION


**Utility Plan**  
Sta. 118+00 to Sta. 127+00

FARRINGTON HIGHWAY WIDENING  
Kapolei Golf Course Road to Fort Weaver Road  
Project No. 7101A-01-20

Scale: As Shown Date: April 2022



FED. ROAD DIST. NO.	STATE	PROJ. NO.	FISCAL YEAR	SHEET NO.	TOTAL SHEETS
HAWAII	HAW.	7101A-01-20	2021	133	767

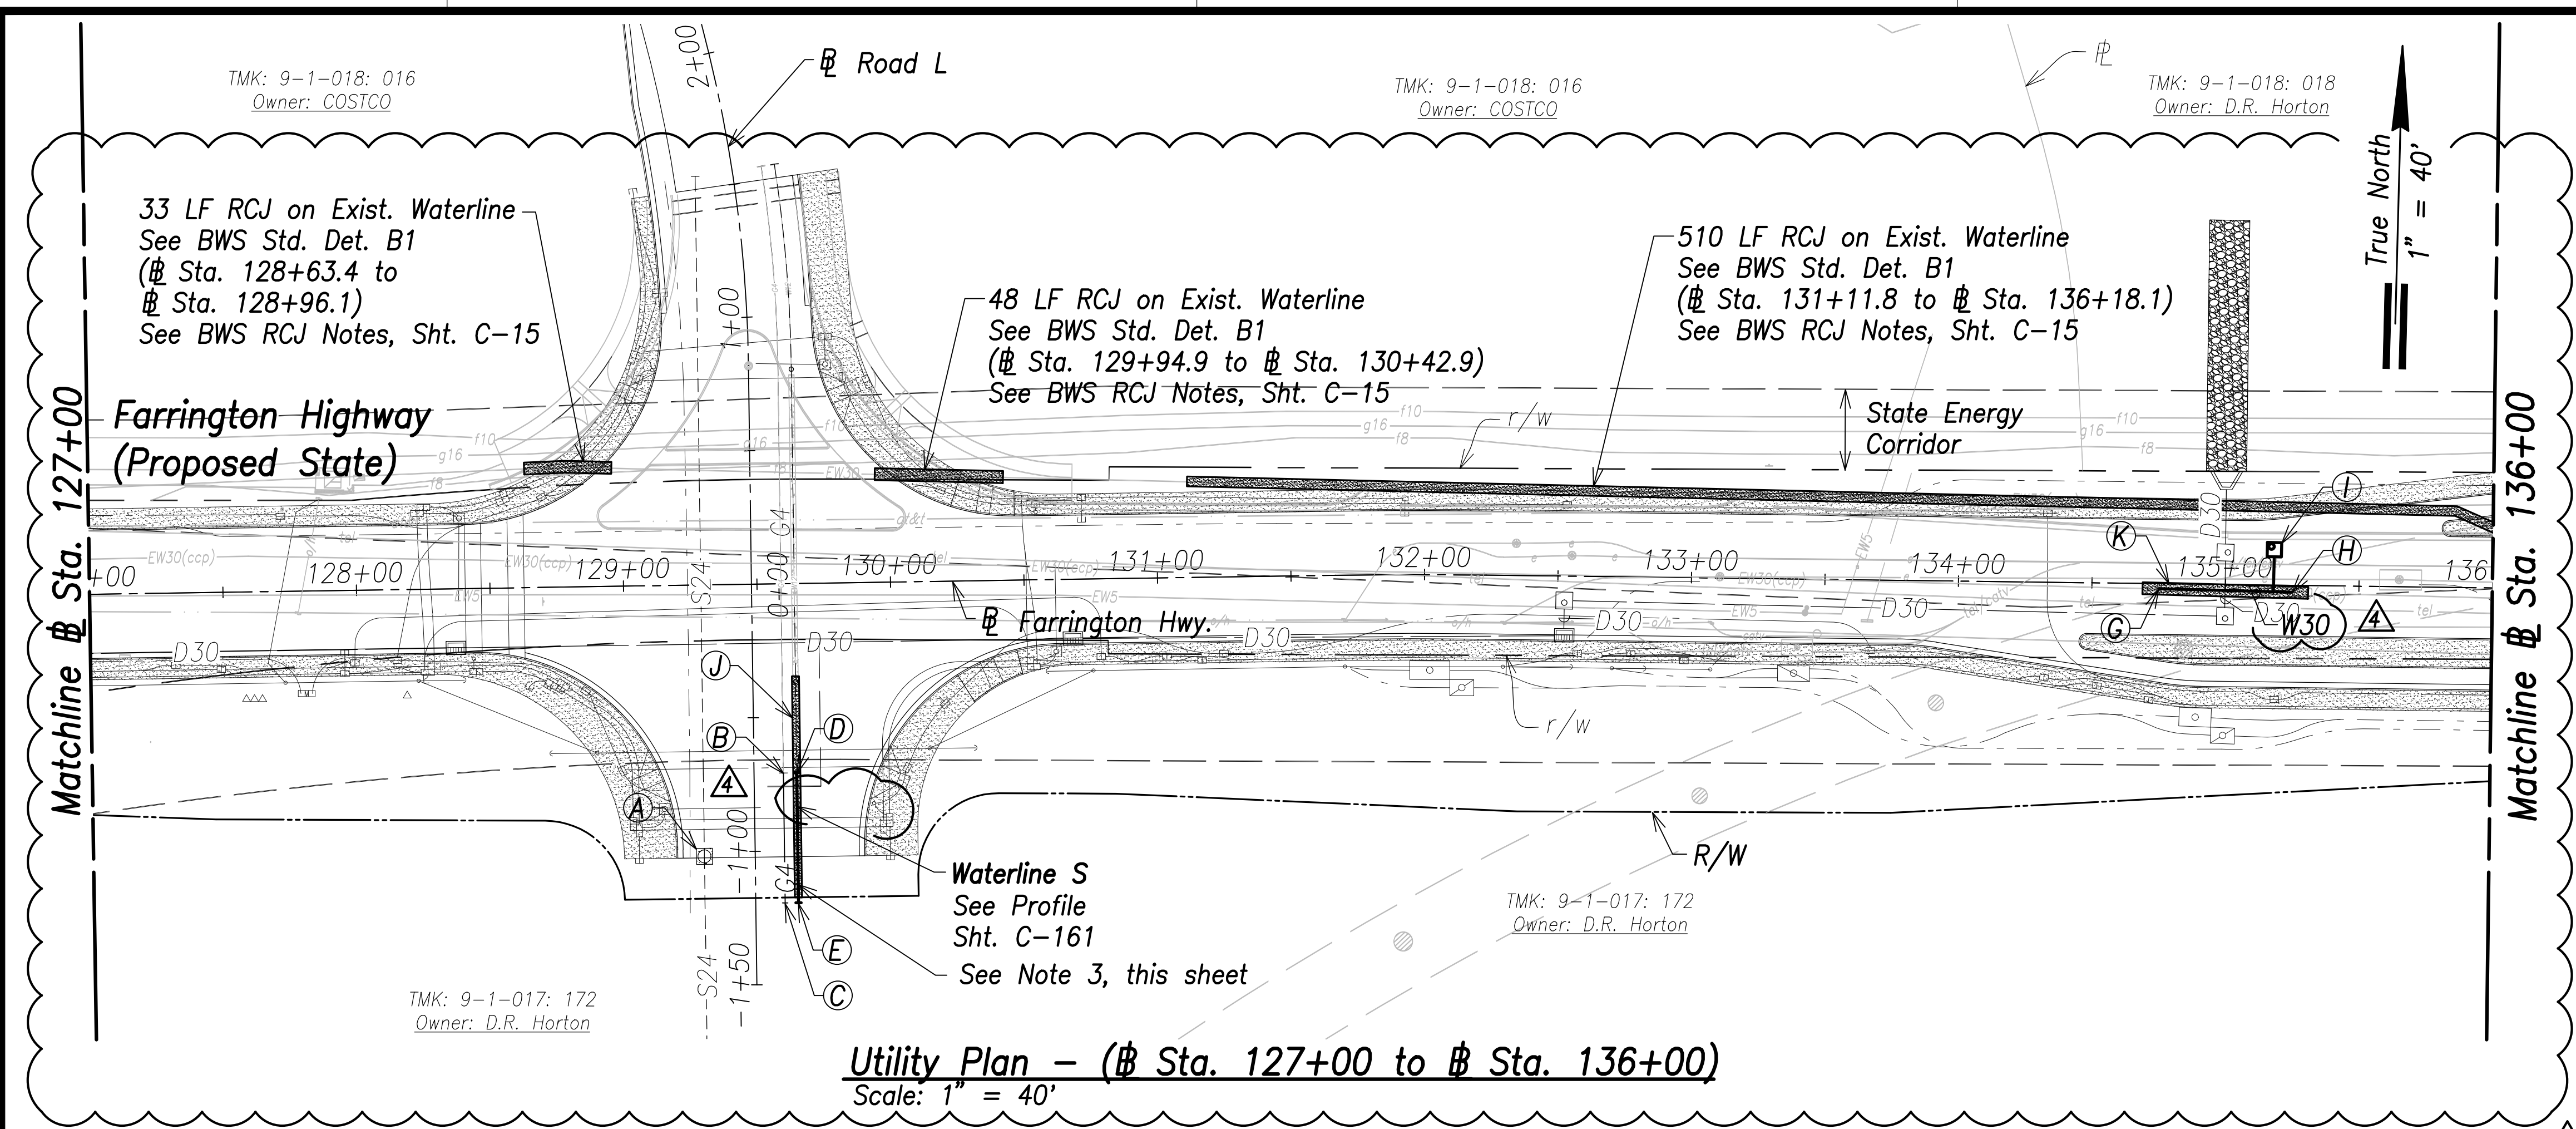


- Notes:**
1. Location of existing utilities are from "as-built" drawings. The Contractor shall verify tie-in connection points prior to the ordering of materials and the start of construction.
  2. The Contractor shall coordinate construction with utility companies.
  3. All waterlines shall be ductile iron pipe, class 53 with ductile iron fittings and shall be in accordance with the STANDARD SPECIFICATIONS FOR ROAD AND BRIDGE CONSTRUCTION, dated 2005, as amended, of the Hawaii Highways Division, Department of Transportation, and the City and County of Honolulu Board of Water Supply's "WATER SYSTEM STANDARDS", DATED 2002, THE "WATER SYSTEM EXTERNAL CORROSION CONTROL STANDARDS", VOLUME 3, DATED 2021, and all subsequent amendment and additions.
  4. For electrical relocations, see electrical drawings.
  5. For the portions of the water main to be concrete jacketed, a bell is to be installed in case there is a break on the line. This allows the removal of the compromised portion of the line without affecting the reinforced concrete jacketed segment of the existing water line. The installation of the bell shall be incidental to the various pay items under Section 624.

**Utility Plan - (Sta. 127+00 to Sta. 136+00)**  
Scale: 1" = 40'

- A**  
Sta. 129+28.8, o/s 101.6' Rt.  
Remove exist. conc. collar  
Adjust top to match roadway finished grade
- B**  
Sta. 129+58.8, o/s 70.8' Rt.  
Conn. to e/g4  
Match exist. slope and invert  
Remove exist. cap and marker  
Provide 3' Min. Cover
- C**  
Sta. 129+58.7, o/s 119.5' Rt.  
Cap and Mark G4  
Provide 3' Min. Cover  
See Profile, Sht. C-166
- D**  
Sta. 129+63.8, o/s 70.8' Rt.  
= Sta. 0+00 WL S  
Conn. to e/w12  
Remove exist. cap, cleanout, and conc. block  
Match exist. slope and invert  
**Materials for Connection:**  
1-12" Sleeve, 12" Long  
8± LF 12" D.I.P., Cl. 53  
**Temp. for Testing:**  
1-12" Cap Tapped for 4" I.P.T.  
1-4" C.O.  
1-Conc. Block  
Contractor to verify location and invert


- E**  
Sta. 129+63.7, o/s 119.5' Rt.  
= Sta. 0+48.7 WL G  
End W12  
1-12" Cap Tapped for 4" I.P.T.  
1-4" C.O.  
1-Valve Box for C.O.  
See BWS Std. Det. V2, and V22
- G**  
Sta. 134+75, o/s 1.9' Rt.  
Conn. to (e/w30)  
Contractor to verify location and invert  
**Materials for Connection:**  
1-CCPxD.I. Adapter  
1-30" Sleeve, 15" Long  
8± LF 30" D.I.P., Cl. 53  
**Temp. for Testing:**  
1-30" Cap Tapped for 6" I.P.T.  
1-6" C.O.  
1-Conc. Block  
See Sht. C-175 For Temporary By-Pass Plan and Profile - 15

- H**  
Sta. 135+24.9, o/s 2.5' Rt.  
Conn. to (e/w30)  
Contractor to verify location and invert  
**Materials for Connection:**  
1-CCPxD.I. Adapter  
1-30" Sleeve, 15" Long  
8± LF 30" D.I.P., Cl. 53  
**Temp. for Testing:**  
1-30" Cap Tapped for 6" I.P.T.  
1-6" C.O.  
1-Conc. Block  
See Sht. C-175 For Temporary By-Pass Plan and Profile - 15
- I**  
Sta. 135+18.2, o/s 13.3' Lt.  
Center MH  
2-2" Offset ARV, 200#  
1-Type "D" MH  
See BWS Std. Det. V5 and MH20-MH21
- J**  
83 LF RCJ With D.I. Pipe and Fittings  
See BWS Std. Det. B1  
(Sta. 129+63.7 to Sta. 129+63.9)
- K**  
62 LF RCJ With D.I. Pipe and Fittings  
See Struct. Dwgs.  
(Sta. 134+69 to Sta. 135+30.9)

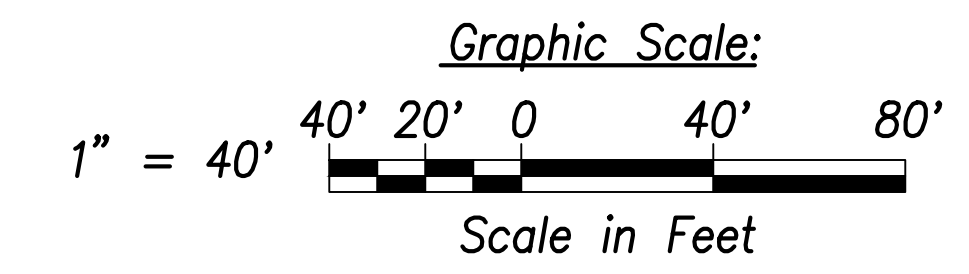

SURVEY PLOTTED BY	DATE
DRAWN BY	
TRACED BY	
CHECKED BY	
NOTE BOOK	
No.	

APPROVED: \_\_\_\_\_ DATE \_\_\_\_\_  
Manager and Chief Engineer, BWS  
(for work affecting BWS facilities in City/State R/W & BWS easements only)

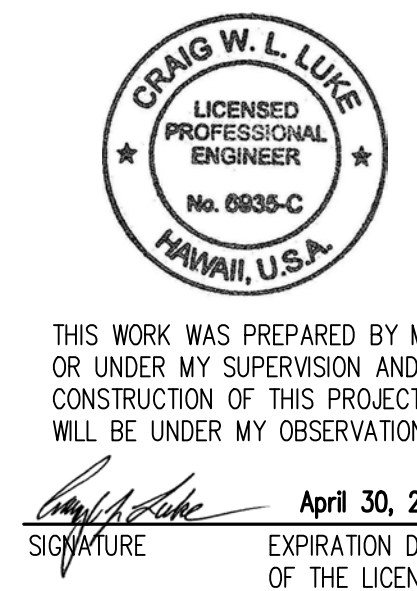

DATE	REVISION
07/15/22	Removed GV from Waterline S; Revised waterline size; Added electrical
06/08/22	Revised waterline; Revised callouts; Deleted note

STATE OF HAWAII  
**DEPARTMENT OF TRANSPORTATION**  
HIGHWAYS DIVISION


**Utility Plan**  
Sta. 127+00 to Sta. 136+00  
FARRINGTON HIGHWAY WIDENING  
Kapolei Golf Course Road to Fort Weaver Road  
Project No. 7101A-01-20

Scale: As Shown Date: April 2022

**SHEET No. C-132 OF 767 SHEETS**




FED. ROAD DIST. NO.	STATE	PROJ. NO.	FISCAL YEAR	SHEET NO.	TOTAL SHEETS
HAWAII	HAW.	7101A-01-20	2021	134	767

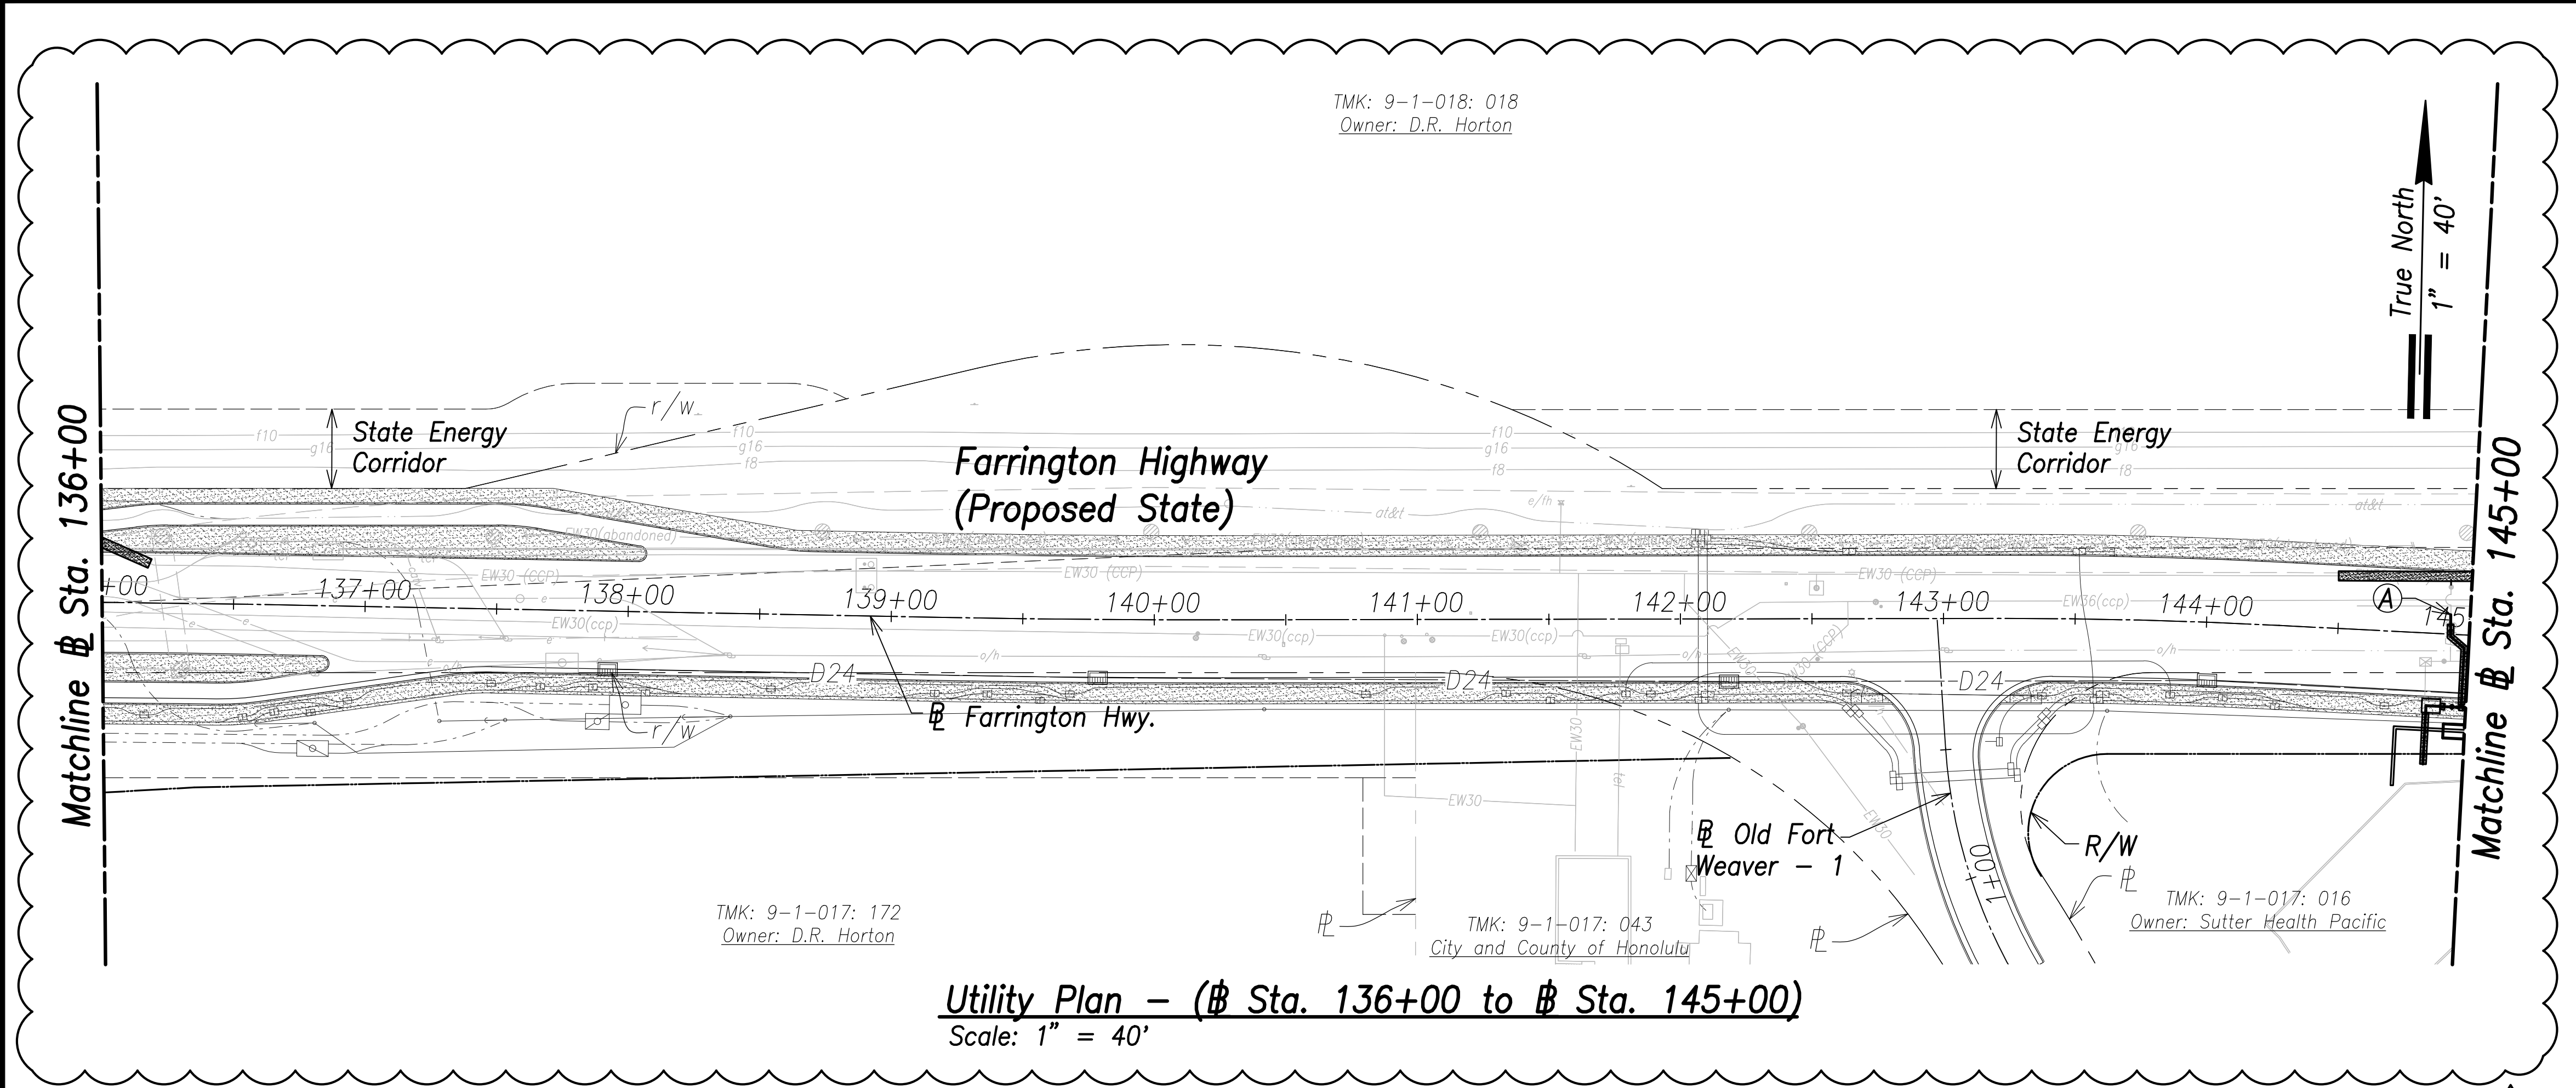


- Notes:**
1. Location of existing utilities are from "as-built" drawings. The Contractor shall verify tie-in connection points prior to the ordering of materials and the start of construction.
  2. The Contractor shall coordinate construction with utility companies.
  3. All waterlines shall be ductile iron pipe, class 53 with ductile iron fittings and shall be in accordance with the STANDARD SPECIFICATIONS FOR ROAD AND BRIDGE CONSTRUCTION, dated 2005, as amended, of the Hawaii Highways Division, Department of Transportation, and the City and County of Honolulu Board of Water Supply's "WATER SYSTEM STANDARDS", DATED 2002, THE "WATER SYSTEM EXTERNAL CORROSION CONTROL STANDARDS", VOLUME 3, DATED 2021, and all subsequent amendment and additions.
  4. For electrical relocations, see electrical drawings.
  5. For the portions of the water main to be concrete jacketed, a bell is to be installed in case there is a break on the line. This allows the removal of the compromised portion of the line without affecting the reinforced concrete jacketed segment of the existing water line. The installation of the bell shall be incidental to the various pay items under Section 624.

**(A)**  
 Sta. 144+92.6, o/s 7.5' Lt.  
 = Sta. 0+00 DC Meter  
 Construct 12" Water Lateral Connection  
 Relocate exist. water meters and provide replacement water meter boxes.  
 Contractor shall connect to the existing water lateral and provide continuous water service to affected users.  
 See BWS Det. L16 and L22  
 Premise I/D: 7675805060  
 Meter No.: 11099411 (3" Compound)  
 Meter No.: 81189630 (8" Detector Check)  
 See Plan & Profile Sht. C-136  
Materials for Connection:  
 1-12" Sleeve, 15" Long  
 1-12"x8" Reducer  
 1-Conc. Block w/ Struct. Struts  
Temp. for Testing:  
 1-12" Cap Tapped for 4" I.P.T.  
 1-4" C.O.  
 1-Conc. Block

SURVEY PLOTTED BY	DATE
DRAWN BY	
TRACED BY	
QUANTITIES BY	
CHECKED BY	
ORIGINAL PLAN	
NOTE BOOK	
No.	

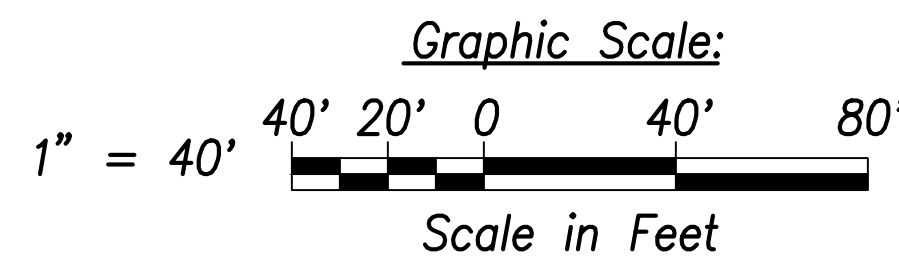

APPROVED:  
 \_\_\_\_\_ DATE \_\_\_\_\_  
 Manager and Chief Engineer, BWS  
 (for work affecting BWS facilities in City/State R/W & BWS easements only)

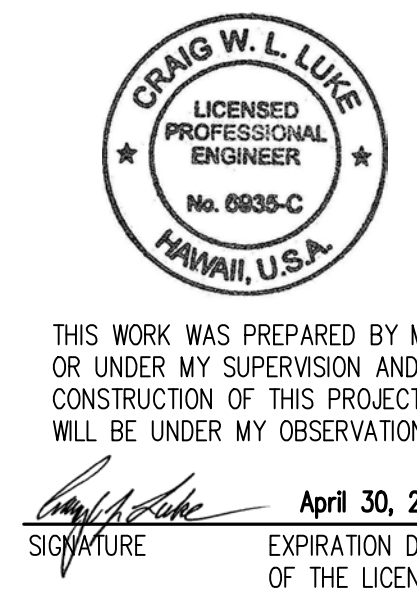

07/15/22	Added electrical; Revised connection
06/08/22	Deleted note
DATE	REVISION

STATE OF HAWAII  
 DEPARTMENT OF TRANSPORTATION  
 HIGHWAYS DIVISION

**Utility Plan**  
 Sta. 136+00 to Sta. 145+00


FARRINGTON HIGHWAY WIDENING  
 Kapolei Golf Course Road to Fort Weaver Road  
 Project No. 7101A-01-20

Scale: As Shown Date: April 2022





FED. ROAD DIST. NO.	STATE	PROJ. NO.	FISCAL YEAR	SHEET NO.	TOTAL SHEETS
HAWAII	HAW.	7101A-01-20	2021	136	767

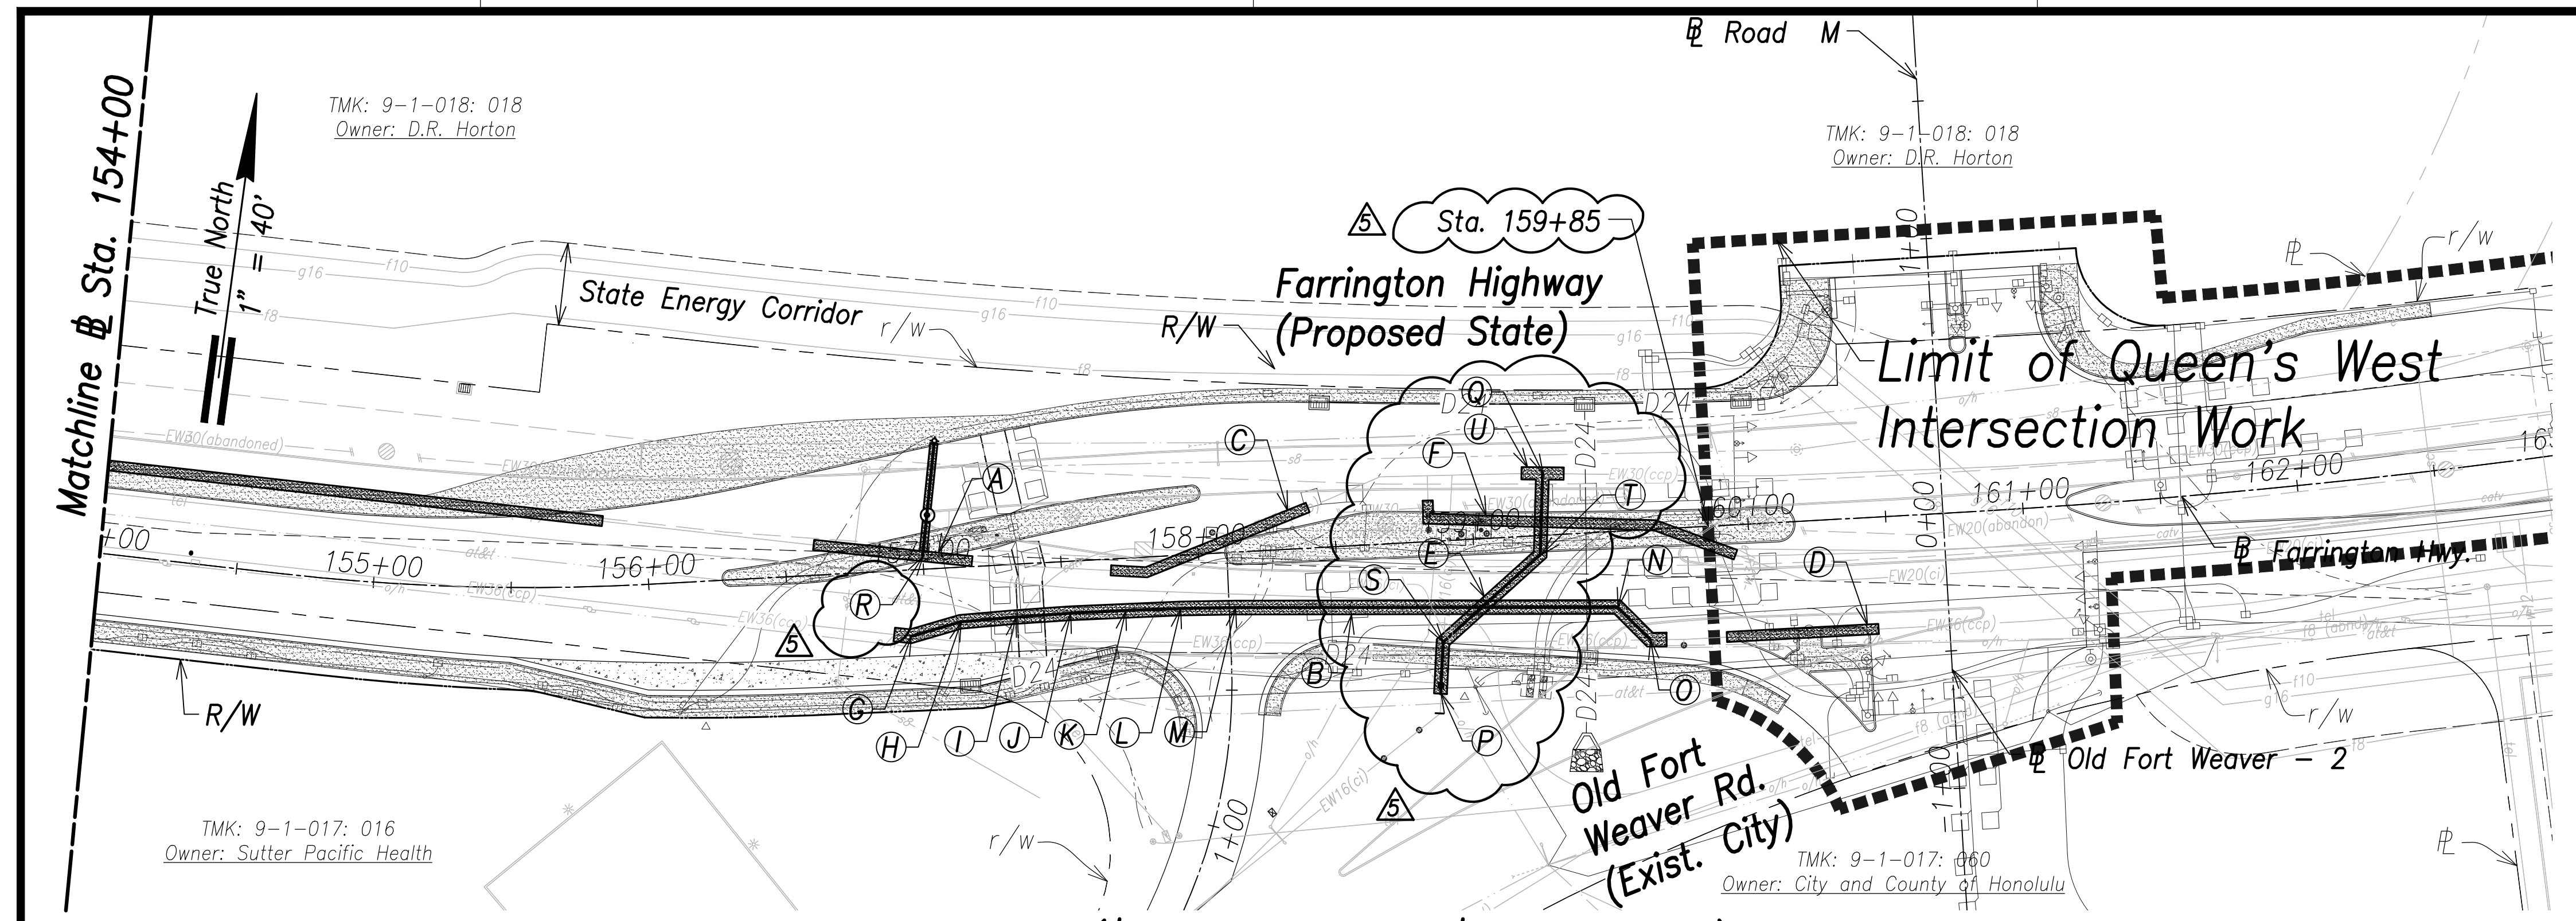

**Utility Plan - (# Sta. 154+00 to # Sta. 165+00)**  
Scale: 1" = 40'


- A**  
58 LF RCJ on Exist. Waterline  
See BWS Std. Det. B1  
(# Sta. 156+60 to # Sta. 157+17.3)  
See BWS RCJ Notes, Sht. C-15
- B**  
286 LF RCJ With D.I. Pipe and Fittings  
See Struct. Dwg.  
(# Sta. 156+87.9 to # Sta. 159+67.8)
- C**  
76 LF RCJ on Exist. Waterline  
See BWS Std. Det. B1  
(# Sta. 157+67.5 to # Sta. 158+40.1)  
See BWS RCJ Notes, Sht. C-15
- D**  
55 LF RCJ on Exist. Waterline  
See BWS Std. Det. B1  
(# Sta. 159+90.1 to # Sta. 160+45.3)  
See BWS RCJ Notes, Sht. C-15
- E**  
96 LF RCJ With D.I. Pipe and Fittings  
See Struct. Dwg.  
(# Sta. 158+85.3 to # Sta. 159+26.6)
- F**  
120 LF RCJ on Exist. Waterline  
See BWS Std. Det. B1  
(# Sta. 158+83.9 to # Sta. 159+94.4)  
See BWS RCJ Notes, Sht. C-15

- G**  
# Sta. 156+94.2, o/s 24.1' Rt.  
Conn. to e/w36  
Contractor to verify location and invert  
**Materials for Connection:**  
1-36" 1/8 Bend (H)  
1-36" CCPxDI Adapter  
1-36" Sleeve, 15" Long  
8± LF 36" D.I.P., Cl. 53  
**Temp. for Testing:**  
1-36" Cap Tapped for 6" I.P.T.  
1-6" C.O.
- H**  
# Sta. 157+12, o/s 19.8' Rt.  
1-36" 1/32 Bend (H)
- I**  
# Sta. 157+32, o/s 19.2' Rt.  
Deflect 1°
- J**  
# Sta. 157+52, o/s 18.9' Rt.  
Deflect 1°
- K**  
# Sta. 157+72, o/s 19' Rt.  
Deflect 1°
- L**  
# Sta. 157+92, o/s 19.4' Rt.  
Deflect 1°
- M**  
# Sta. 158+12, o/s 20.1' Rt.  
Deflect 1°

- N**  
# Sta. 159+50.6, o/s 27.5' Rt.  
1-36" 1/8 Bend (H)
- O**  
# Sta. 159+62.3, o/s 40.0' Rt.  
Conn. to e/w36  
Contractor to verify location and invert  
**Materials for Connection:**  
1-36" 1/16 Bend (H)  
1-36" CCPxDI Adapter  
1-36" Sleeve, 15" Long  
8± LF 36" D.I.P., Cl. 53  
**Temp. for Testing:**  
1-36" Cap Tapped for 6" I.P.T.  
1-6" C.O.
- P**  
# Sta. 158+85.3, o/s 54.3' Rt.  
=# Sta. 0+00 Waterline R  
Conn. to e/w16  
Contractor to verify location and invert  
**Materials for Connection:**  
1-16" Sleeve, 12" Long  
1-3/4" ARV, 200#  
1-ARV Box & Cover  
1-30"x16" Reducer  
8± LF 16" D.I.P., Cl. 53  
**Temp. for Testing:**  
1-16" Cap Tapped for 4" I.P.T.  
1-4" C.O.
- Q**  
# Sta. 159+26.6, o/s 5.8' Rt.  
=# Sta. 0+95.8 Waterline R  
Conn. to e/w16  
Contractor to verify location and invert  
**Materials for Connection:**  
1-16" Sleeve, 12" Long  
8± LF 16" D.I.P., Cl. 53  
**Temp. for Testing:**  
1-16" Cap Tapped for 4" I.P.T.  
1-4" C.O.
- R**  
FH 4  
# Sta. 157+00, o/s 4.7' Lt.  
1-30"x6" Tapping Tee  
1-6" Tapping Valve, 200#  
1-Type "C" Manhole and Cover,  
See BWS Std. Det. MH19  
1-6" Sleeve, 12" Long  
1-Conc. Block w/ Struct. Struts  
1-FH (Ht.=9')  
1-FH Elbow  
1-Conc. Block  
42 LF 6" D.I.P., Cl. 53  
42 LF RCJ  
1-Blue Type F FH Marker  
See Profile, Sht. C-162  
See BWS Std. Det. FH4.  
**Temp. for Testing:**  
1-6" Cap Tapped for 2-1/2" I.P.T.  
1-2-1/2" C.O.  
1- Conc. Block

- S**  
# Sta. 158+87.2, o/s 36.8' Rt.  
1-16" 1/8 Bend (H)
- T**  
# Sta. 159+29.4, o/s 6.9' Rt.  
1-30" 1/8 Bend (H)
- U**  
16 LF RCJ on Exist. Waterline  
See BWS Std. Det. B1  
(# Sta. 159+19 to # Sta. 159+34.3)  
See BWS RCJ Notes, Sht. C-15
- V**  
**Waterline R**  
See Profile  
Sht. C-160

- Notes:**
- Location of existing utilities are from "as-built" drawings. The Contractor shall verify tie-in connection points prior to the ordering of materials and the start of construction.
  - The Contractor shall coordinate construction with utility companies.
  - All waterlines shall be ductile iron pipe, class 53 with ductile iron fittings and shall be in accordance with the STANDARD SPECIFICATIONS FOR ROAD AND BRIDGE CONSTRUCTION, dated 2005, as amended, of the Hawaii Highways Division, Department of Transportation, and the City and County of Honolulu Board of Water Supply's "WATER SYSTEM STANDARDS", DATED 2002, THE "WATER SYSTEM EXTERNAL CORROSION CONTROL STANDARDS", VOLUME 3, DATED 2021, and all subsequent amendment and additions.
  - For electrical relocations, see electrical drawings.
  - For the portions of the water main to be concrete jacketed, a bell is to be installed in case there is a break on the line. This allows the removal of the compromised portion of the line without affecting the reinforced concrete jacketed segment of the existing water line. The installation of the bell shall be incidental to the various pay items under Section 624.

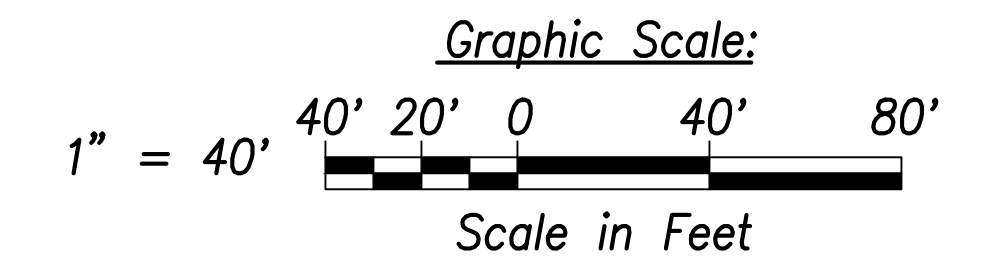

SURVEY PLOTTED BY:	DATE:
DRAWN BY:	DATE:
CHECKED BY:	DATE:
ORIGINAL PLAN:	
NOTE BOOK:	
NO.:	

APPROVED: \_\_\_\_\_ DATE \_\_\_\_\_  
Manager and Chief Engineer, BWS  
(for work affecting BWS facilities in City/State R/W & BWS easements only)

DATE	REVISION
07/15/22	Revised callouts; Revised Water Line
06/08/22	Added Type "C" Manhole; Revised Callouts; Deleted Note


**ORANG W. L. LUKE**  
LICENSED PROFESSIONAL ENGINEER  
No. 6935-C  
HAWAII, U.S.A.  
THIS WORK WAS PREPARED BY ME OR UNDER MY SUPERVISION AND CONSTRUCTION OF THIS PROJECT WILL BE UNDER MY OBSERVATION.  
SIGNATURE: \_\_\_\_\_ EXPIRATION DATE OF THE LICENSE: April 30, 2024

STATE OF HAWAII  
DEPARTMENT OF TRANSPORTATION  
HIGHWAYS DIVISION  
**Utility Plan**  
# Sta. 154+00 to # Sta. 165+00  
FARRINGTON HIGHWAY WIDENING  
Kapolei Golf Course Road to Fort Weaver Road  
Project No. 7101A-01-20  
Scale: As Shown Date: April 2022  
**SHEET No. C-135 OF 767 SHEETS**





FED. ROAD DIST. NO.	STATE	PROJ. NO.	FISCAL YEAR	SHEET NO.	TOTAL SHEETS
HAWAII	HAW.	7101A-01-20	2021	137S-1	767

- Notes:**
1. Location of existing utilities are from "as-built" drawings. The Contractor shall verify tie-in connection points prior to the ordering of materials and the start of construction.
  2. The Contractor shall coordinate construction with utility companies.
  3. All waterlines shall be ductile iron pipe, class 53 with ductile iron fittings and shall be in accordance with the STANDARD SPECIFICATIONS FOR ROAD AND BRIDGE CONSTRUCTION, dated 2005, as amended, of the Hawaii Highways Division, Department of Transportation, and the City and County of Honolulu Board of Water Supply's "WATER SYSTEM STANDARDS", DATED 2002, THE "WATER SYSTEM EXTERNAL CORROSION CONTROL STANDARDS", VOLUME 3, DATED 2021, and all subsequent amendment and additions.
  4. For electrical relocations, see electrical drawings.
  5. For the portions of the water main to be concrete jacketed, a bell is to be installed in case there is a break on the line. This allows the removal of the compromised portion of the line without affecting the reinforced concrete jacketed segment of the existing water line. The installation of the bell shall be incidental to the various pay items under Section 624.
  6. Reinforced concrete jackets on existing waterlines are based upon the as-built location of the pipe joints. The Contractor shall verify the pipe joint locations in the field and shall extend the reinforced concrete jackets as necessary to comply with BWS Std. Det. B1. Shortening of the reinforced concrete jacket is not allowed.
  7. The Contractor shall connect to the existing water lateral and provide continuous water service to affected users.

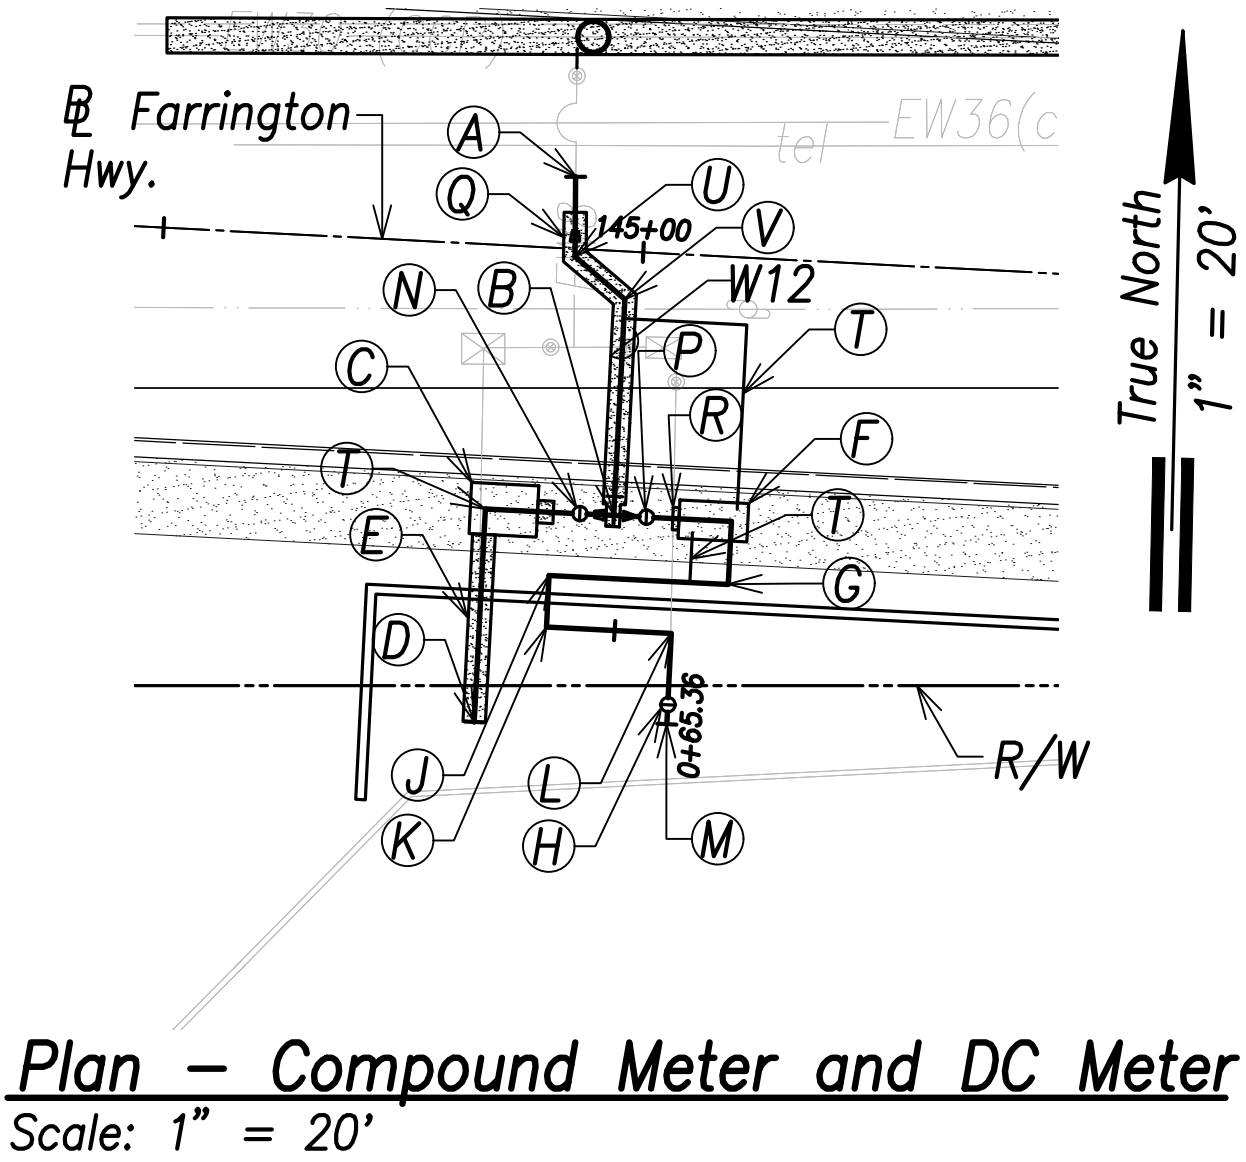


- (A)** Sta. 144+92.6, o/s 7.5' Lt.  
= Sta. 0+00 DC Meter  
Conn. to Exist. Water Lateral  
For Callouts, See Sht. C-133
- (B)** Sta. 144+98.4, o/s 27.5' Rt.  
= Sta. 0+37.7 DC Meter  
= Sta. 0+00 Compound Meter  
1-12"x12" Tee, Fl.  
1-12"x8" Reducer, Fl.  
1-12"x4" Reducer, Fl.
- (C)** 8" Detector Check Meter  
Provide Meter Box and Install  
Piping and Appurtenances Per  
BWS Std. Det. M9, M19, M26,  
M30, and M31.
- (D)** Sta. 144+84.9, o/s 49.8' Rt.  
= Sta. 0+73.3 DC Meter  
Conn. to Exist. W8  
Contractor to Verify  
Location and Invert
- (E)** 11.8 LF RCJ With D.I. Pipe and Fittings  
See Struct. Dwgs.  
(Sta. 144+84.9 to Sta. 144+84.9)
- (F)** 3" Compound Meter  
Provide Meter Box and Install  
Piping and Appurtenances Per  
BWS Std. Det. M9, M25-M31
- (G)** Sta. 145+10.6, o/s 34.1' Rt.  
= Sta. 0+18.8 Compound Meter  
1-4" 1/4 Bend (H)
- (H)** Sta. 145+05, o/s 47.0' Rt.  
= Sta. 0+63.4 Compound Meter  
1-4" G.V., 200#  
1-Valve Box & Cover  
1-Conc. Block
- (J)** Sta. 144+91.9, o/s 34.1' Rt.  
= Sta. 0+37.5 Compound Meter  
1-4" 1/4 Bend (H)
- (K)** Sta. 144+91.9, o/s 39.5' Rt.  
= Sta. 0+42.9 Compound Meter  
1-4" 1/4 Bend (H)
- (L)** Sta. 145+04.9, o/s 39.5' Rt.  
= Sta. 0+55.8 Compound Meter  
1-4" 1/4 Bend (H)
- (M)** Sta. 145+05, o/s 49.0' Rt.  
= Sta. 0+65.4 Compound Meter  
Conn. to Exist. W4  
Contractor to Verify Location and Invert
- (N)** Sta. 144+94.8, o/s 27.5' Rt.  
= Sta. 0+41.3 DC Meter  
1-8" G.V., Fl., 200#  
1-Valve Box & Cover
- (P)** Sta. 145+01.7, o/s 27.5' Rt.  
= Sta. 0+03.4 Compound Meter  
1-4" G.V., Fl., 200#  
1-Valve Box & Cover
- (Q)** 34 LF RCJ With D.I. Pipe and Fittings  
See Struct. Dwgs.  
(Sta. 144+92.7 to Sta. 144+98.4)
- (R)** 14.7 LF RCJ With D.I. Pipe and Fittings  
See Struct. Dwgs.  
(Sta. 144+90.4 to Sta. 145+05.1)
- (S)** 2" Copper Bypass Line
- (T)** Sta. 144+84.9, o/s 27.5' Rt.  
= Sta. 0+51.1 DC Meter  
1-8" 1/4 Bend, Fl. (H)
- (U)** Sta. 144+92.9, o/s 0.8' Rt.  
= Sta. 0+08.3 DC Meter  
1-12" 1/8 Bend (H)
- (V)** Sta. 145+98.4, o/s 45.0' Rt.  
= Sta. 0+15.2 DC Meter  
1-12" 1/8 Bend (H)

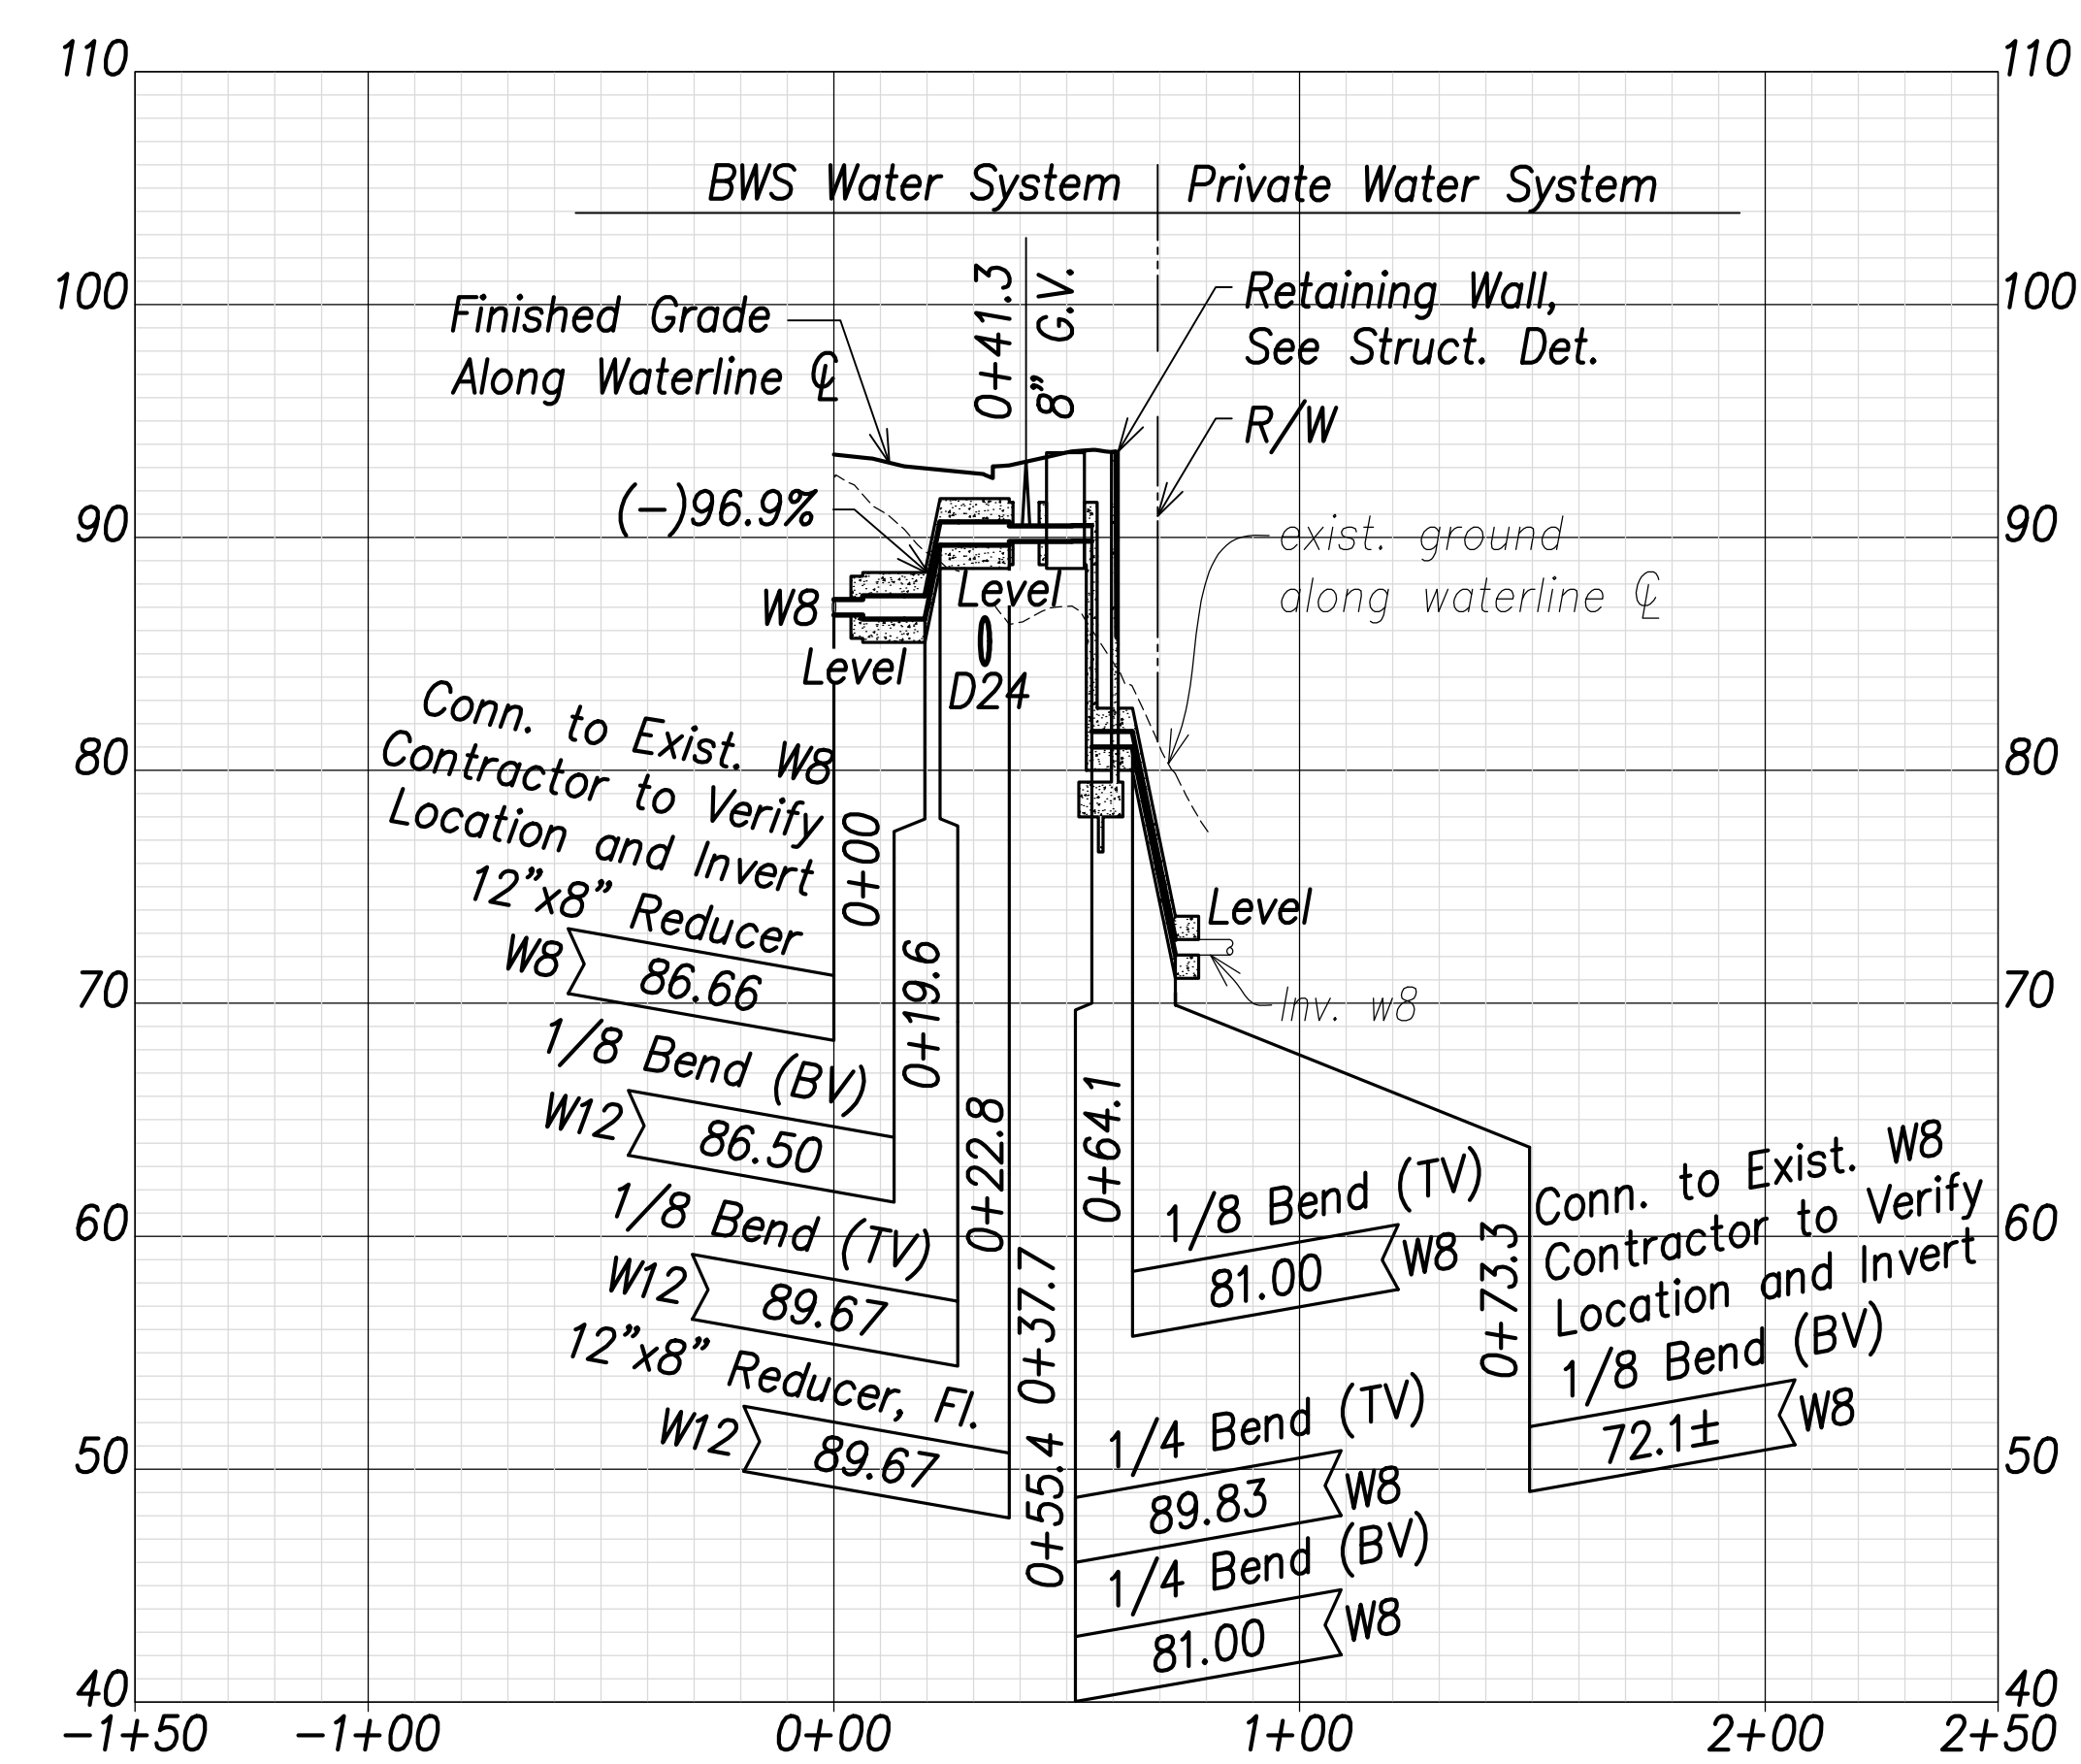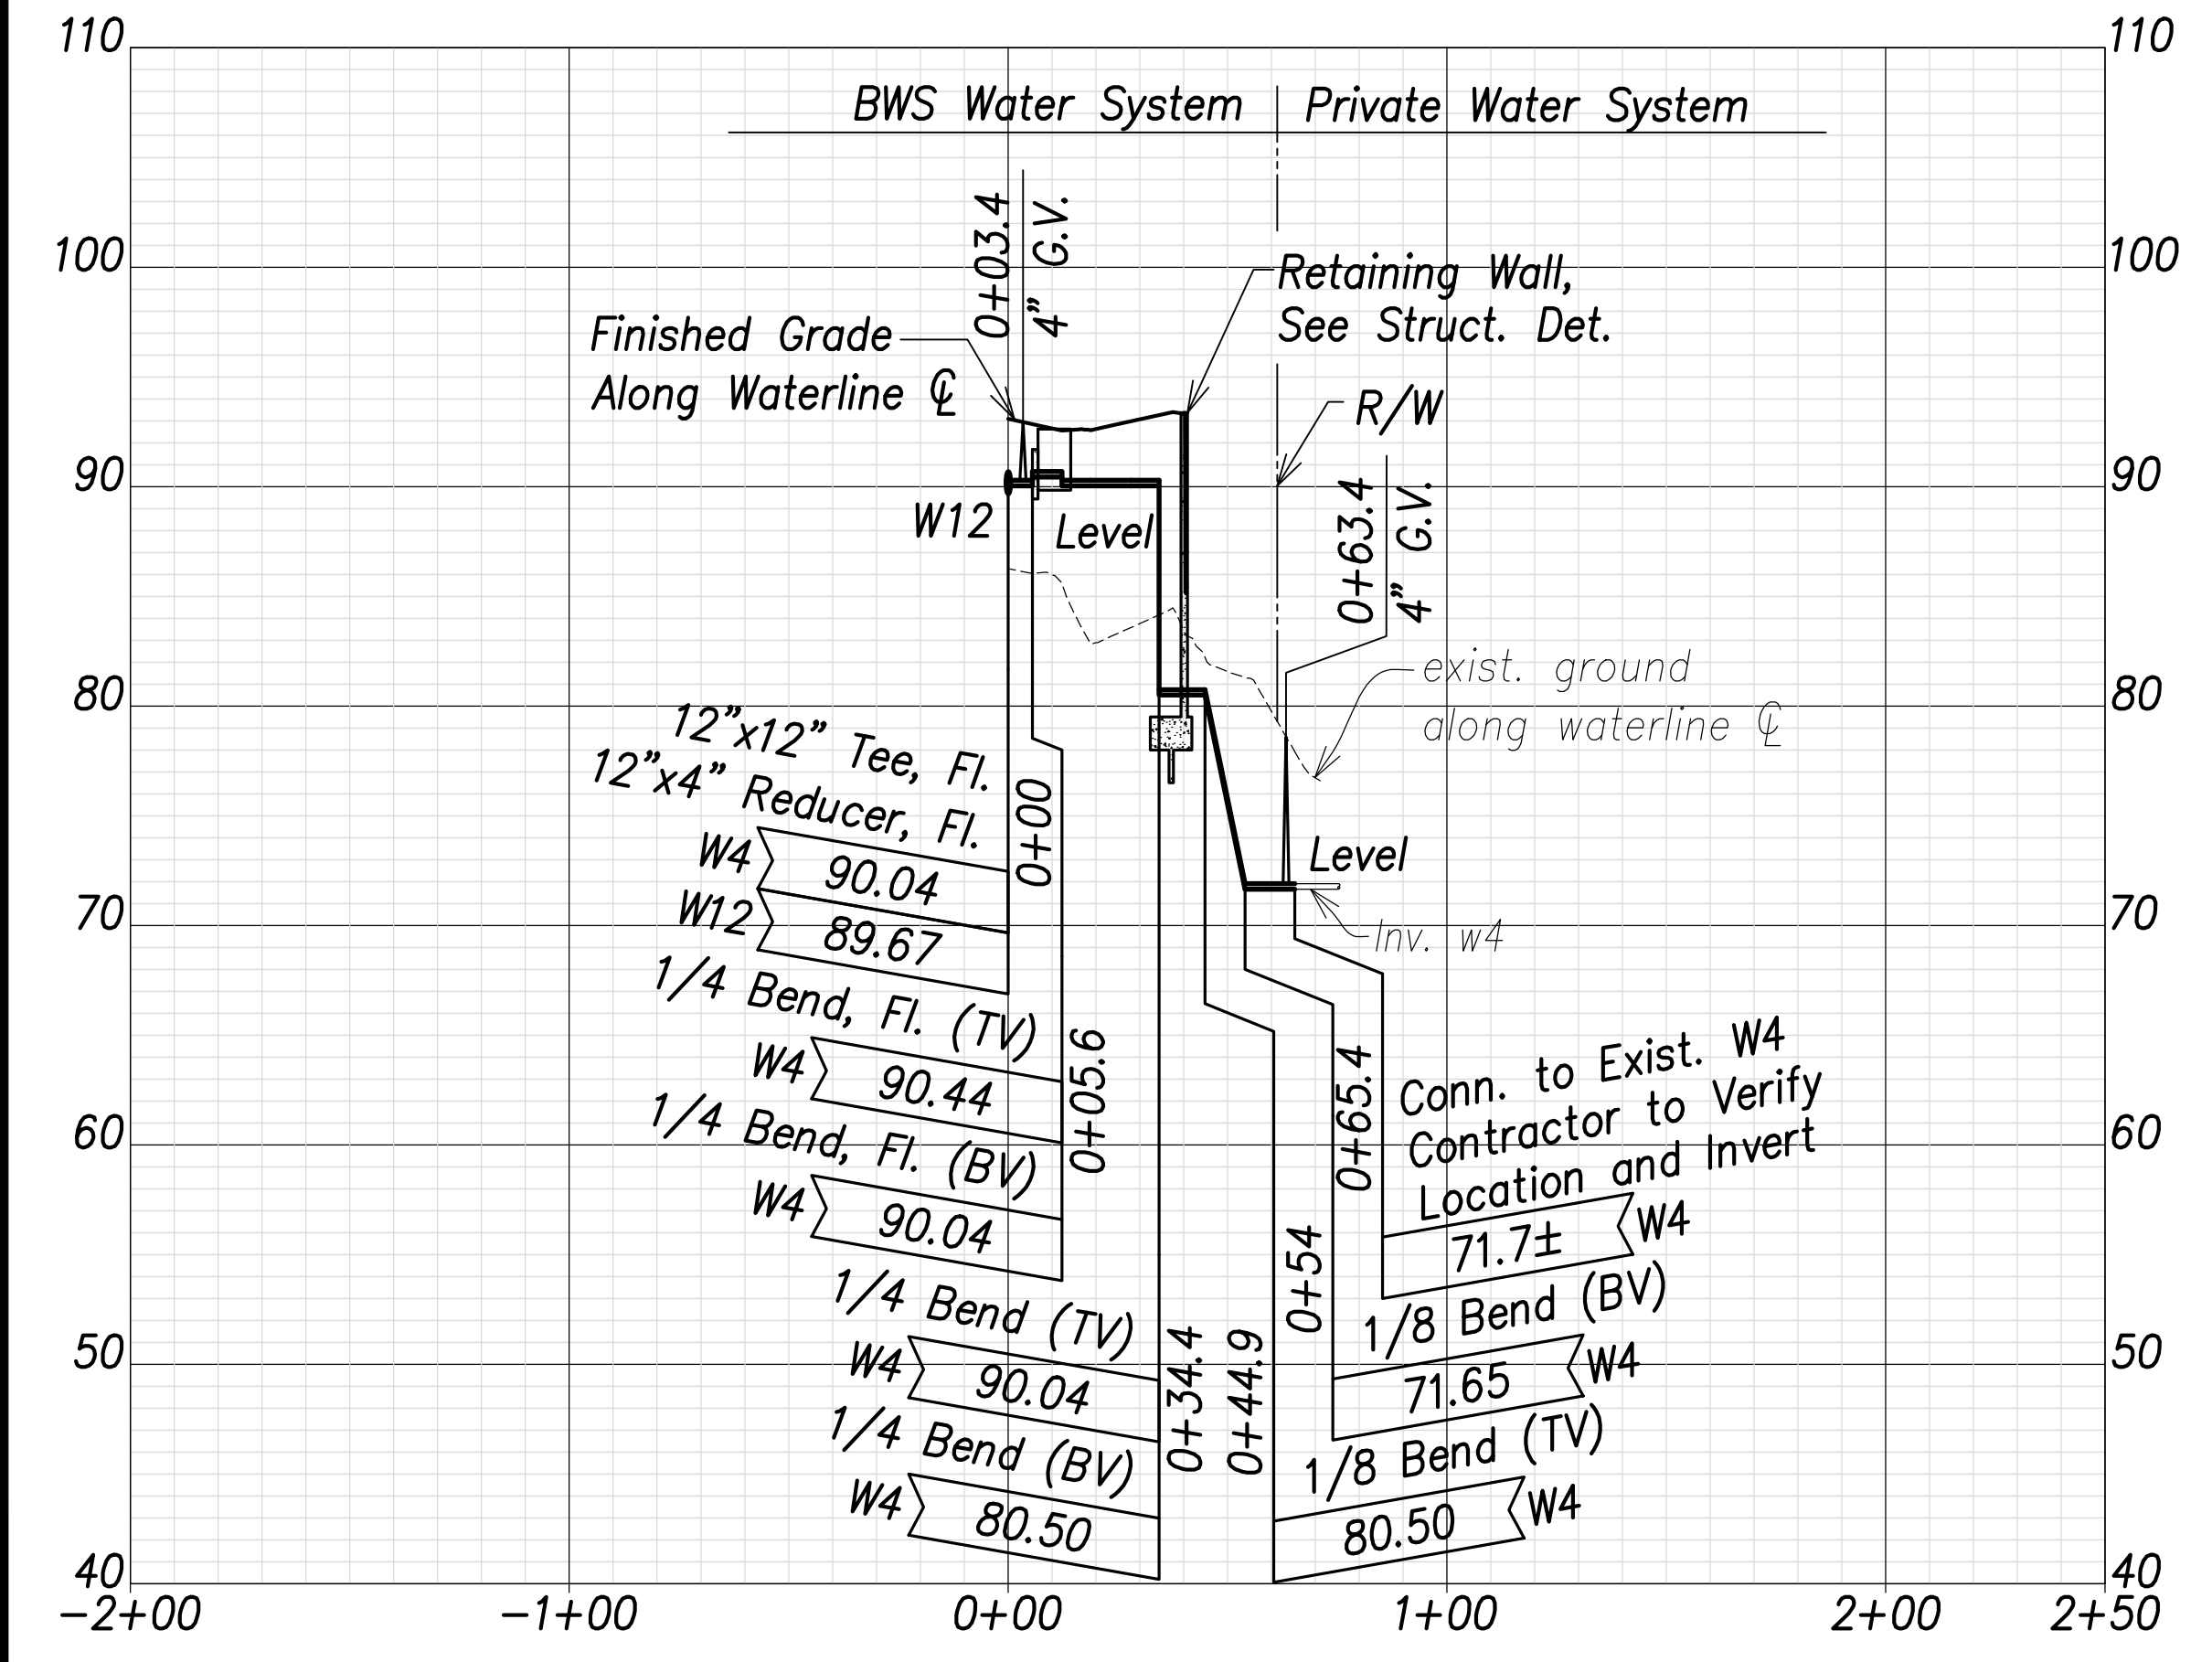

SURVEY PLOTTED BY	DATE
DRAWN BY	
TRACED BY	
QUANTITIES BY	
CHECKED BY	
ORIGINAL PLAN	
NOTE BOOK	
No.	

APPROVED: \_\_\_\_\_ DATE \_\_\_\_\_  
Manager and Chief Engineer, BWS  
(for work affecting BWS facilities in  
City/State R/W & BWS easements only)

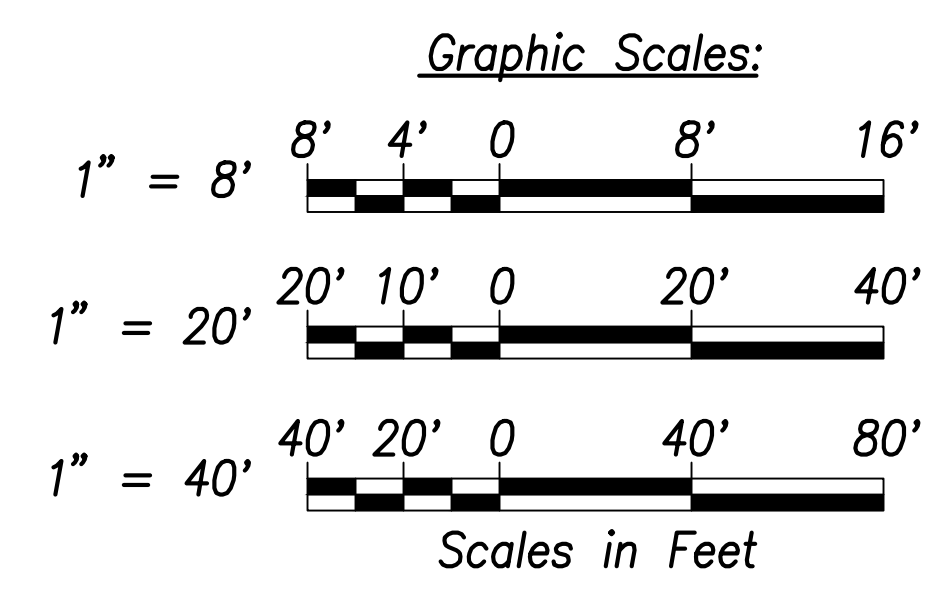

**CRAIG W. L. LUKE**  
LICENSED PROFESSIONAL ENGINEER  
No. 6935-C  
HAWAII, U.S.A.

THIS WORK WAS PREPARED BY ME OR UNDER MY SUPERVISION AND CONSTRUCTION OF THIS PROJECT WILL BE UNDER MY OBSERVATION.

Signature: \_\_\_\_\_  
APR 30, 2024  
EXPIRATION DATE OF THE LICENSE

07/15/22    Replace Sheet

DATE    REVISION

STATE OF HAWAII  
**DEPARTMENT OF TRANSPORTATION**  
HIGHWAYS DIVISION


**Plan & Profile**  
**Compound Meter and DC Meter**

FARRINGTON HIGHWAY WIDENING  
Kapolei Golf Course Road to Fort Weaver Road  
Project No. 7101A-01-20

Scale: As Shown    Date: April 2022


**SHEET No. C-136 OF 767 SHEETS**

FED. ROAD DIST. NO.	STATE	PROJ. NO.	FISCAL YEAR	SHEET NO.	TOTAL SHEETS
HAWAII	HAW.	7101A-01-20	2021	141	767

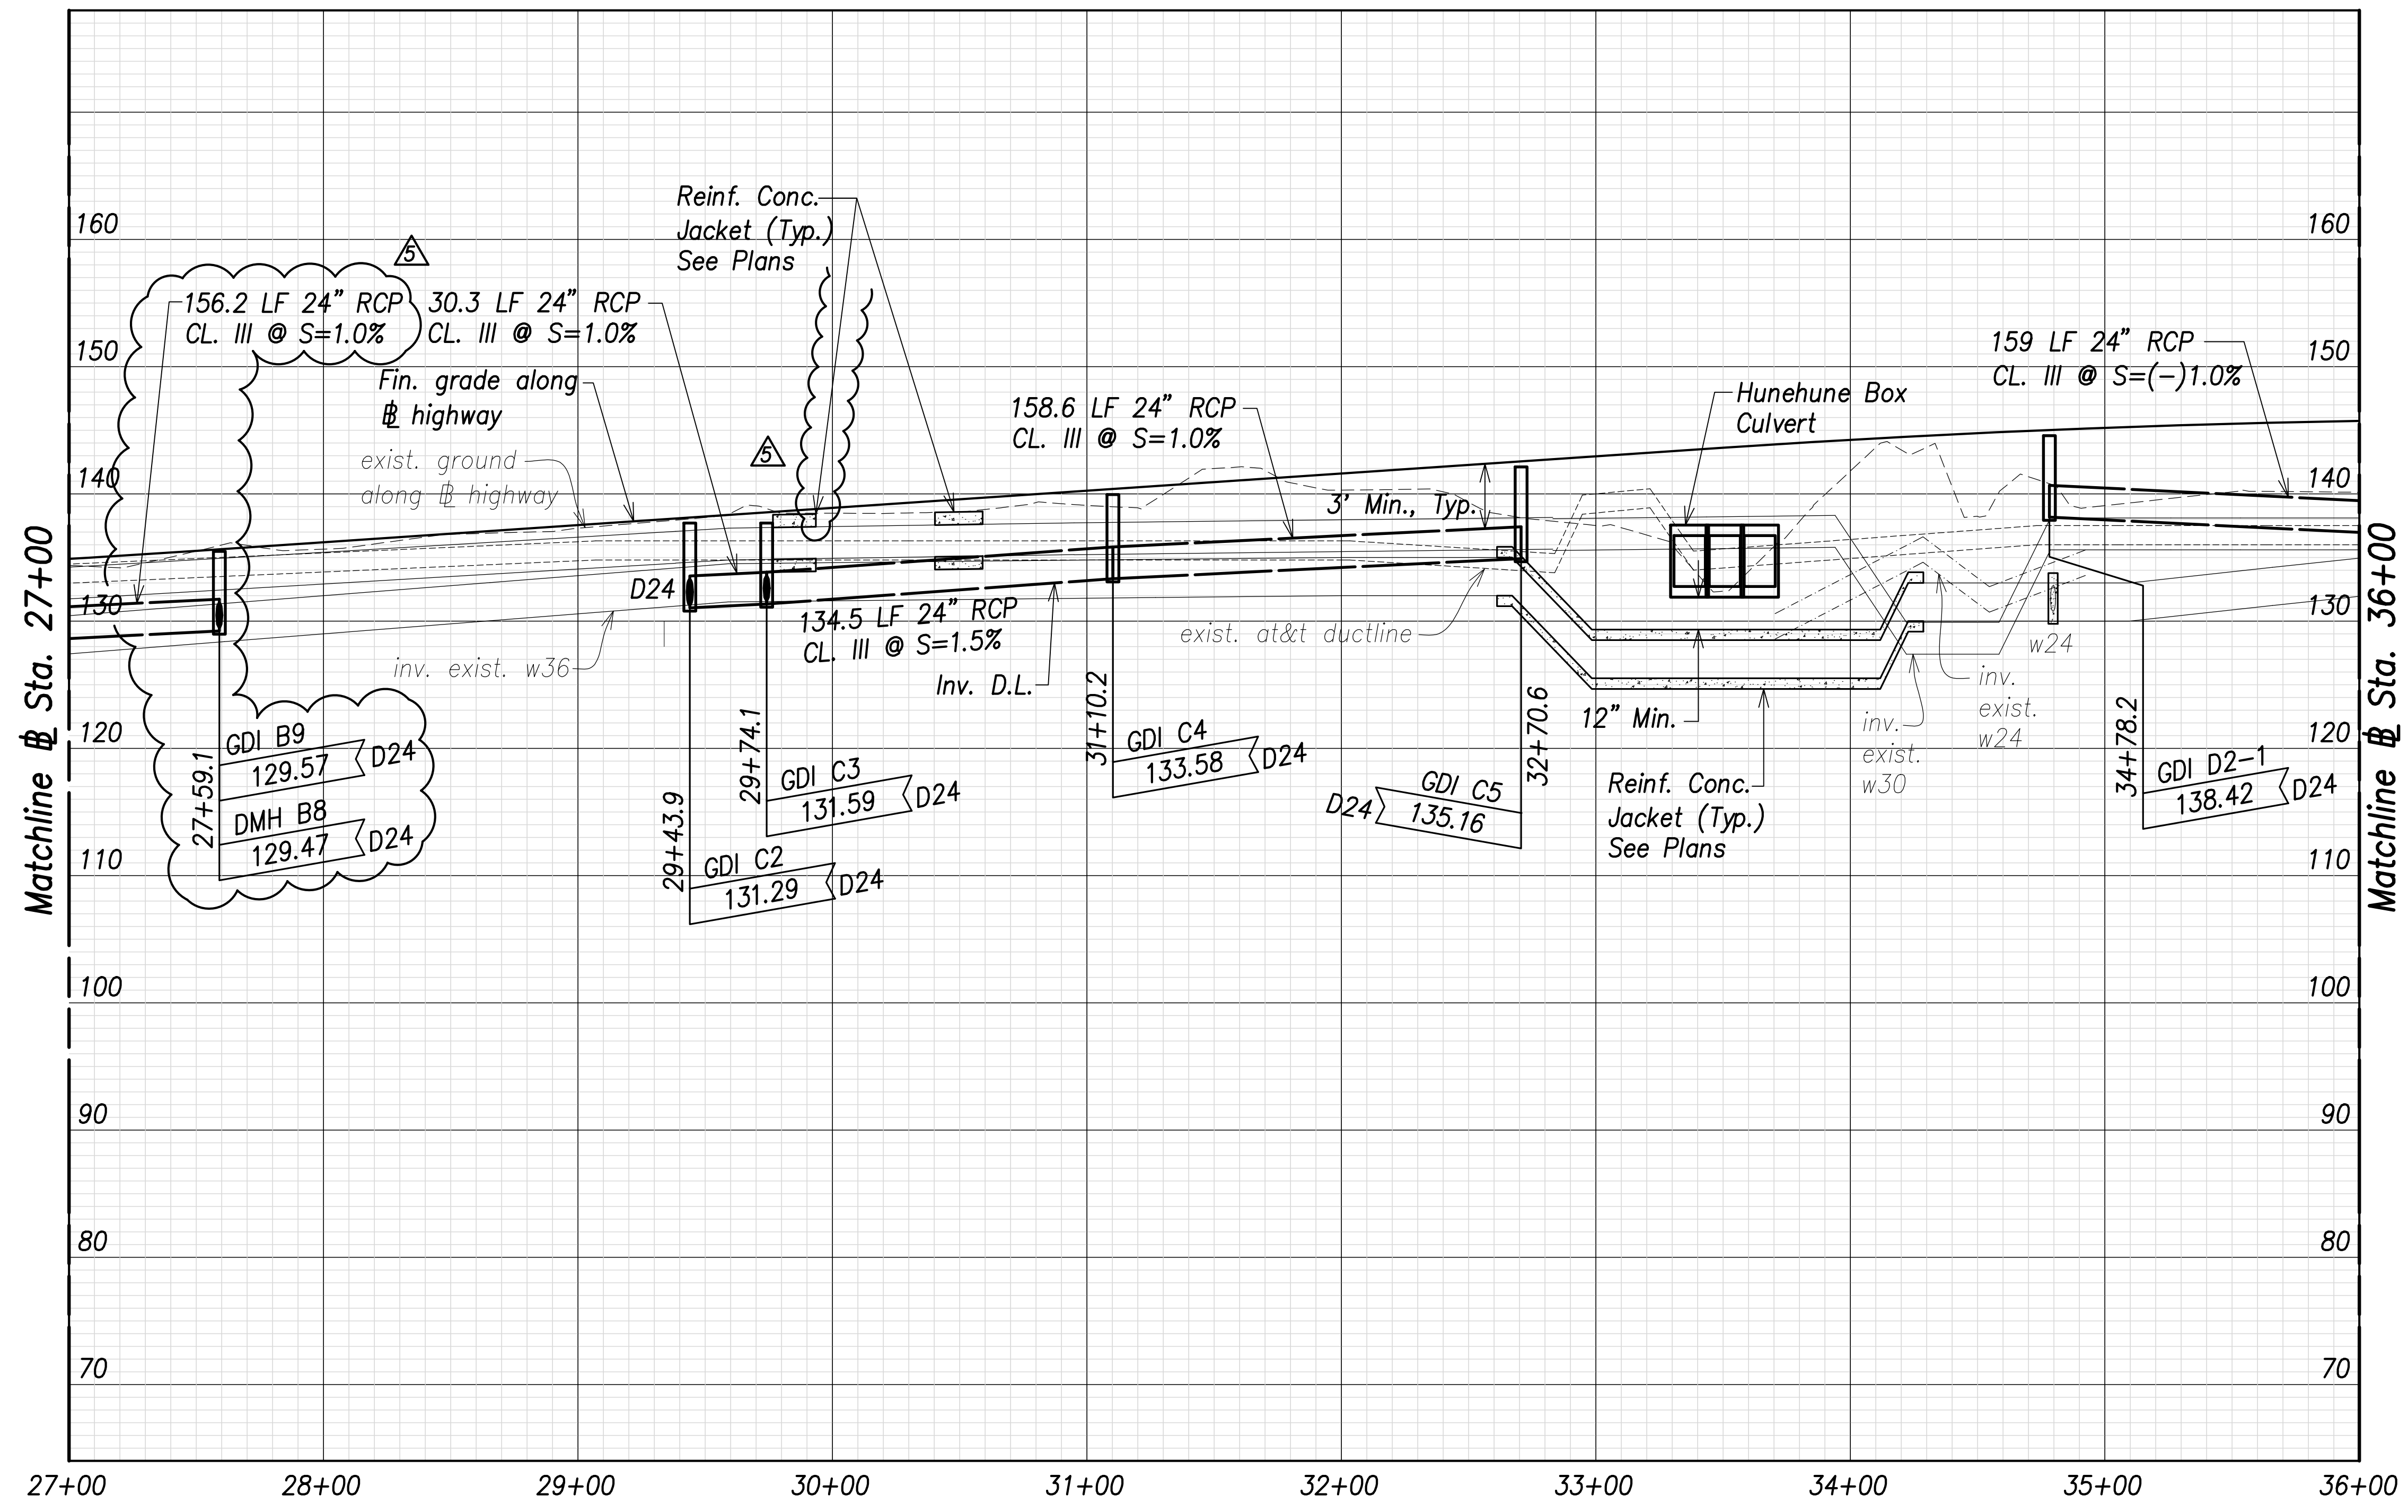

**Note:**

Drain pipe lengths and slopes shown on profiles are calculated from the center of structures.

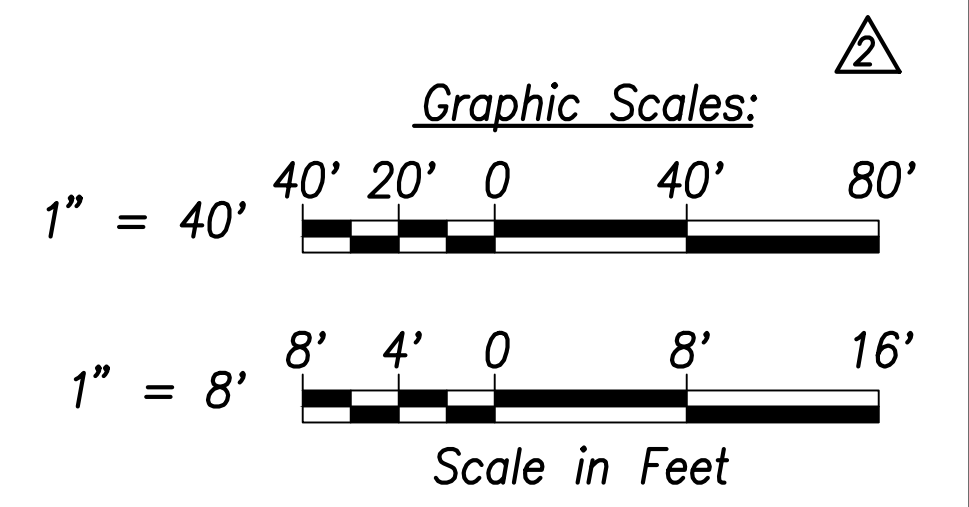

**Utility and Drain Profiles - (Sta. 27+00 to Sta. 36+00)**

Scales: Hor.: 1" = 40'  
Vert.: 1" = 8'

SURVEY PLOTTED BY	DATE
DRAWN BY	
TRACED BY	
CHECKED BY	
ORIGINAL PLAN	
NOTE BOOK	
No.	

APPROVED:

\_\_\_\_\_  
 Manager and Chief Engineer, BWS      DATE  
 (for work affecting BWS facilities in  
 City/State R/W & BWS easements only)

**CRAIG W. L. LUKE**  
 LICENSED PROFESSIONAL ENGINEER  
 No. 6935-C  
 HAWAII, U.S.A.

THIS WORK WAS PREPARED BY ME OR UNDER MY SUPERVISION AND CONSTRUCTION OF THIS PROJECT WILL BE UNDER MY OBSERVATION.

\_\_\_\_\_  
 SIGNATURE      April 30, 2024  
 EXPIRATION DATE OF THE LICENSE

07/15/22	Added callout arrow; Revised GDI's and Drain Line
06/08/22	Added note
DATE	REVISION


STATE OF HAWAII  
 DEPARTMENT OF TRANSPORTATION  
 HIGHWAYS DIVISION

**Utility and Drain Profiles**  
 Sta. 27+00 to  
 Sta. 36+00

FARRINGTON HIGHWAY WIDENING  
 Kapolei Golf Course Road to Fort Weaver Road  
 Project No. 7101A-01-20


Scale: As Shown      Date: April 2022

FED. ROAD DIST. NO.	STATE	PROJ. NO.	FISCAL YEAR	SHEET NO.	TOTAL SHEETS
HAWAII	HAW.	7101A-01-20	2021	143	767

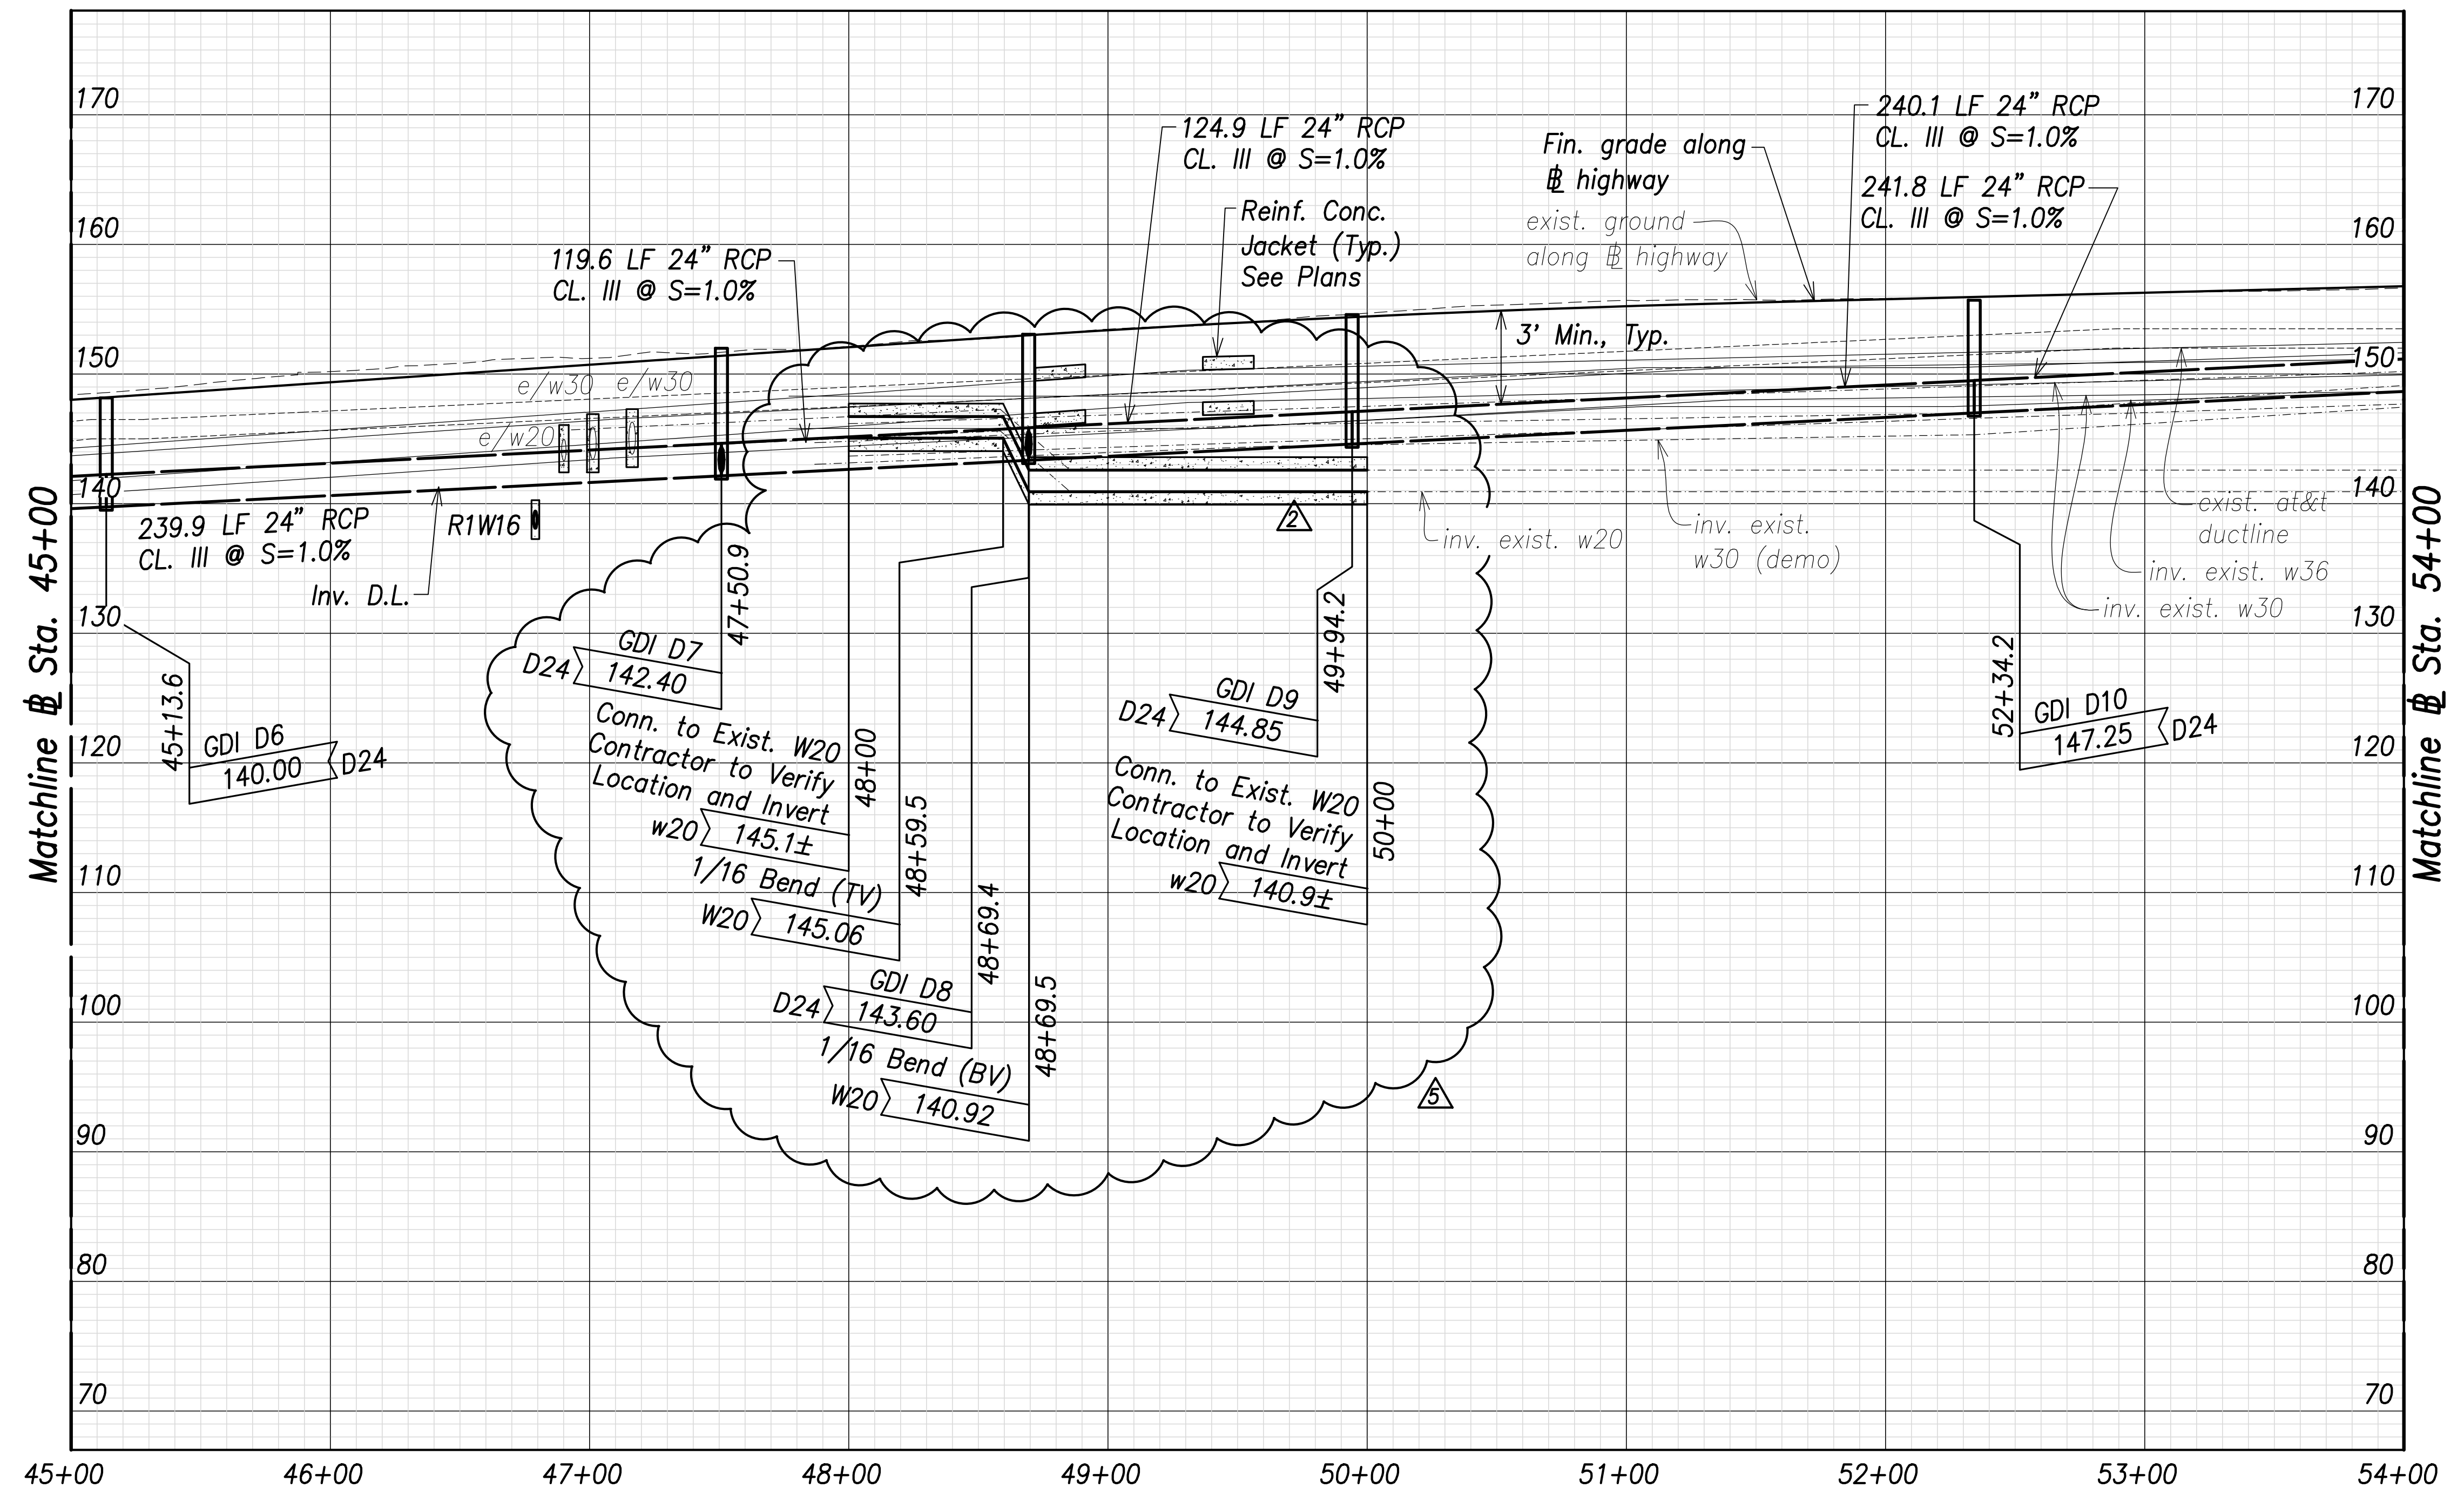


**Utility and Drain Profiles - (Sta. 45+00 to Sta. 54+00)**  
 Scales: Hor.: 1" = 40'  
 Vert.: 1" = 8'

**Note:**  
 Drain pipe lengths and slopes shown on profiles are calculated from the center of structures.

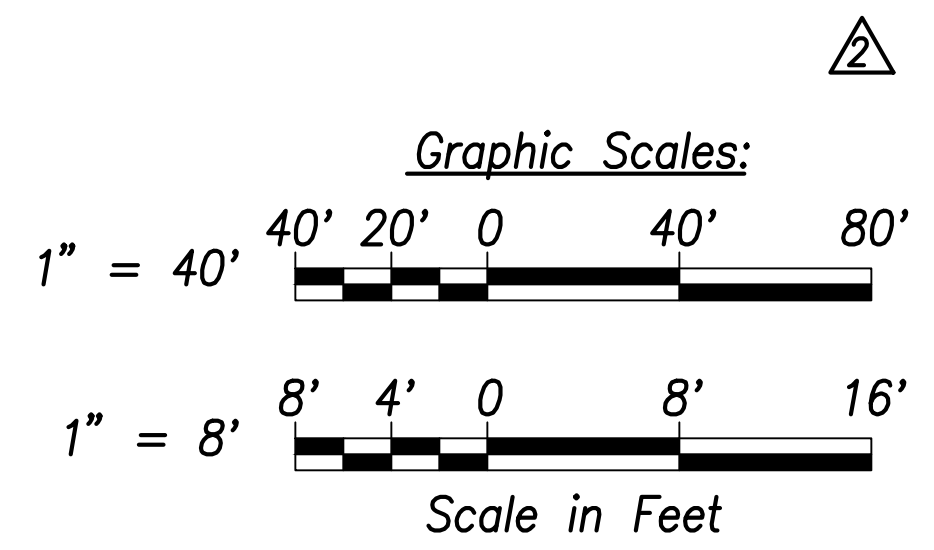

SURVEY PLOTTED BY	DATE
DRAWN BY	
TRACED BY	
QUANTITIES BY	
CHECKED BY	
ORIGINAL PLAN	
NOTE BOOK	
No.	

APPROVED:  
 \_\_\_\_\_ DATE \_\_\_\_\_  
 Manager and Chief Engineer, BWS  
 (for work affecting BWS facilities in City/State R/W & BWS easements only)

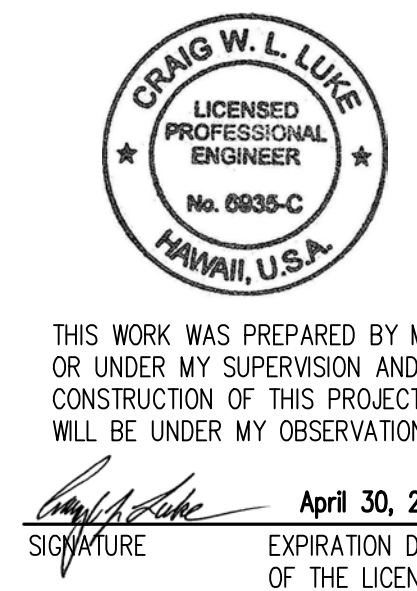


07/15/22	Added waterline
06/08/22	Sta. 49+65 Waterline and Jacket Removed, Added Note
DATE	REVISION

STATE OF HAWAII  
 DEPARTMENT OF TRANSPORTATION  
 HIGHWAYS DIVISION  
**Utility and Drain Profiles**  
 Sta. 45+00 to Sta. 54+00  
 FARRINGTON HIGHWAY WIDENING  
 Kapolei Golf Course Road to Fort Weaver Road  
 Project No. 7101A-01-20  
 Scale: As Shown Date: April 2022




FED. ROAD DIST. NO.	STATE	PROJ. NO.	FISCAL YEAR	SHEET NO.	TOTAL SHEETS
HAWAII	HAW.	7101A-01-20	2021	147	767

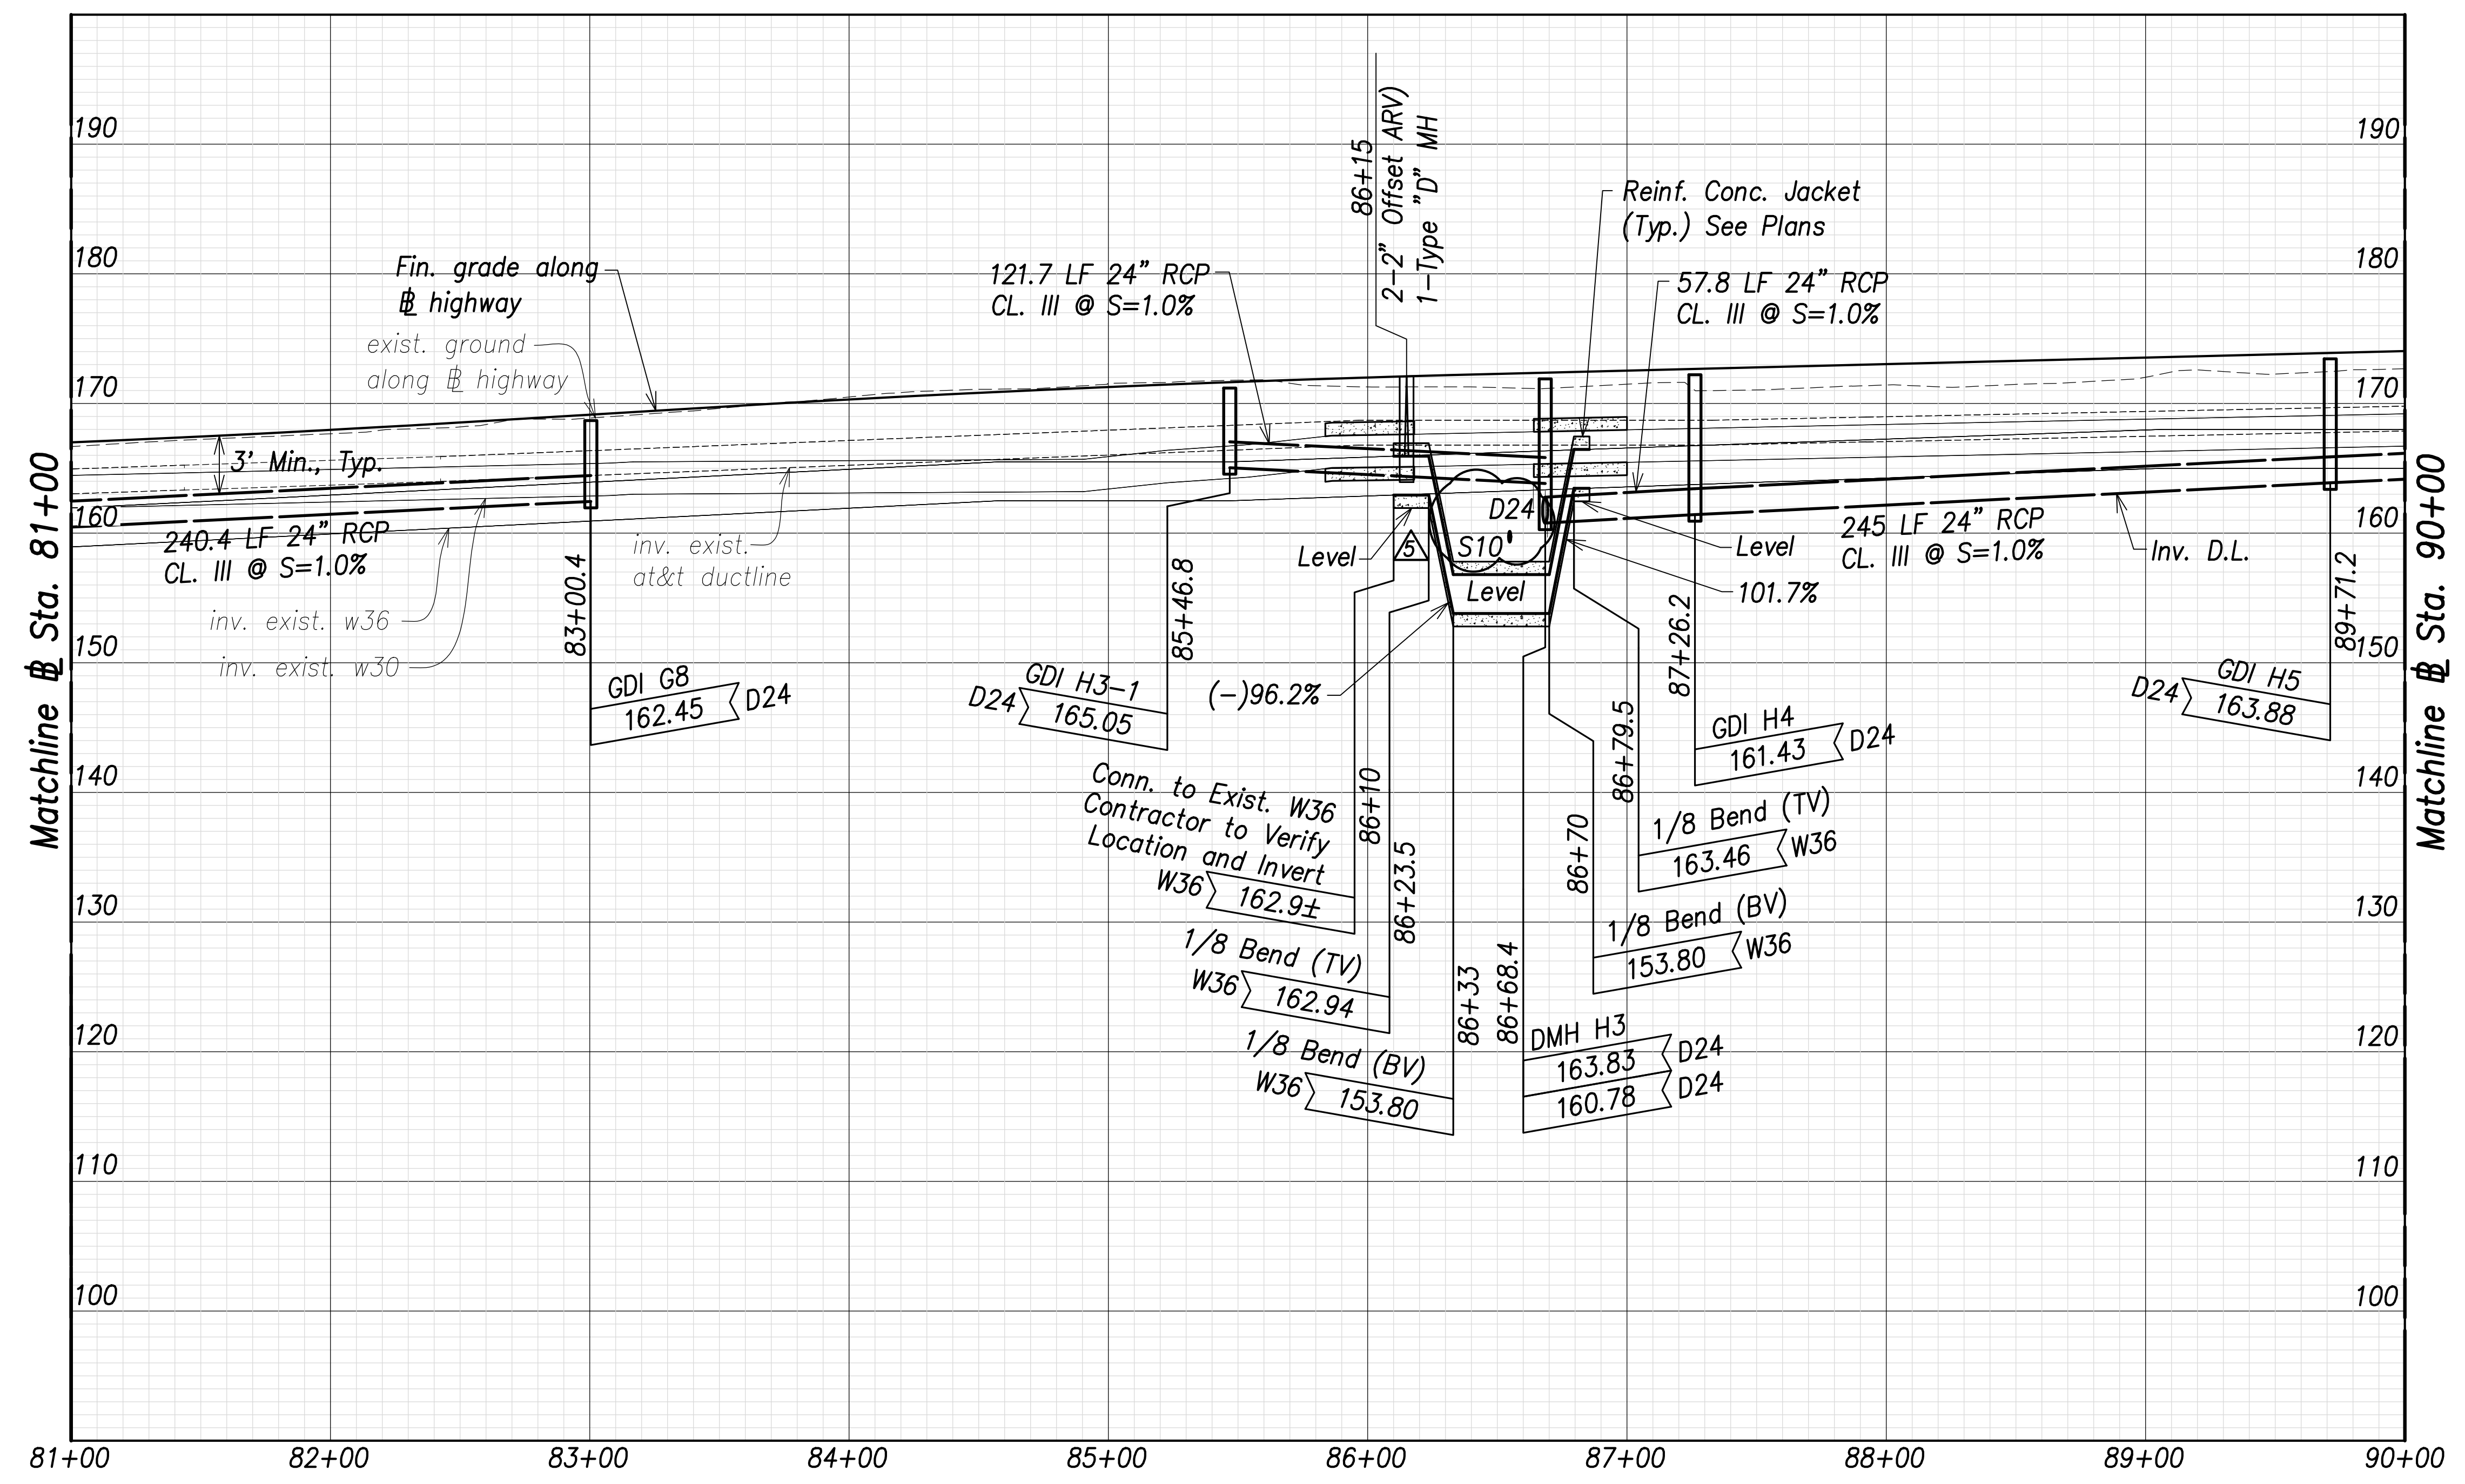


**Utility and Drain Profiles - (Sta. 81+00 to Sta. 90+00)**  
 Scales: Hor.: 1" = 40'  
 Vert.: 1" = 8'

**Note:**  
 Drain pipe lengths and slopes shown on profiles are calculated from the center of structures.

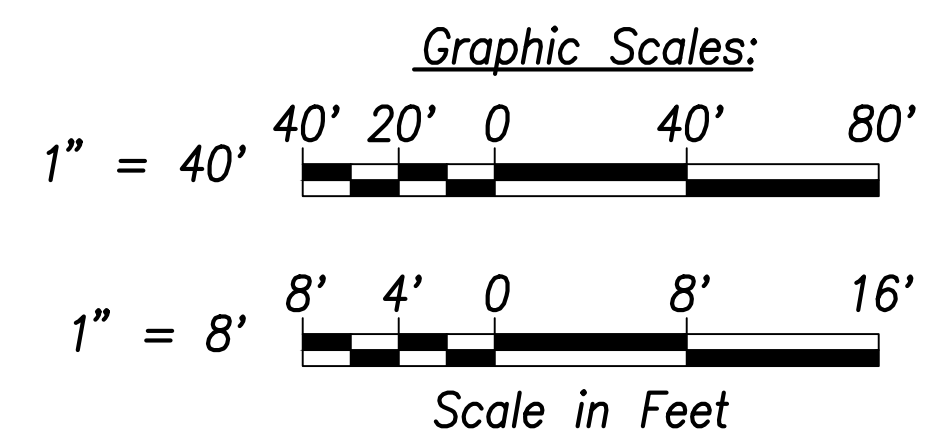

SURVEY PLOTTED BY	DATE
DRAWN BY	
TRACED BY	
CHECKED BY	
ORIGINAL PLAN	
NOTE BOOK	
No.	

APPROVED:  
 \_\_\_\_\_ DATE \_\_\_\_\_  
 Manager and Chief Engineer, BWS  
 (for work affecting BWS facilities in  
 City/State R/W & BWS easements only)

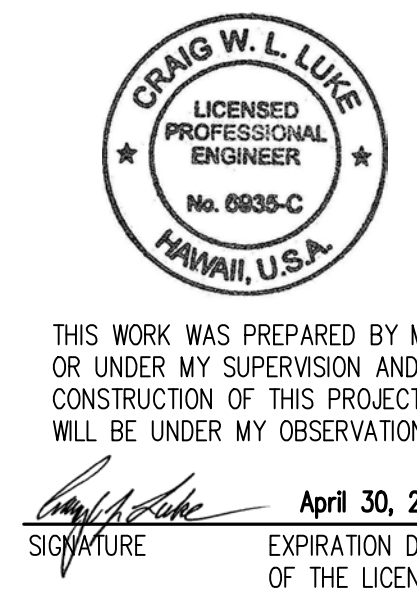

07/15/22	Removed G4 crossing from profile
06/08/22	Added note
DATE	REVISION

STATE OF HAWAII  
 DEPARTMENT OF TRANSPORTATION  
 HIGHWAYS DIVISION


**Utility and Drain Profiles**  
 Sta. 81+00 to Sta. 90+00

FARRINGTON HIGHWAY WIDENING  
 Kapolei Golf Course Road to Fort Weaver Road  
 Project No. 7101A-01-20

Scale: As Shown Date: April 2022




FED. ROAD DIST. NO.	STATE	PROJ. NO.	FISCAL YEAR	SHEET NO.	TOTAL SHEETS
HAWAII	HAW.	7101A-01-20	2021	150	767

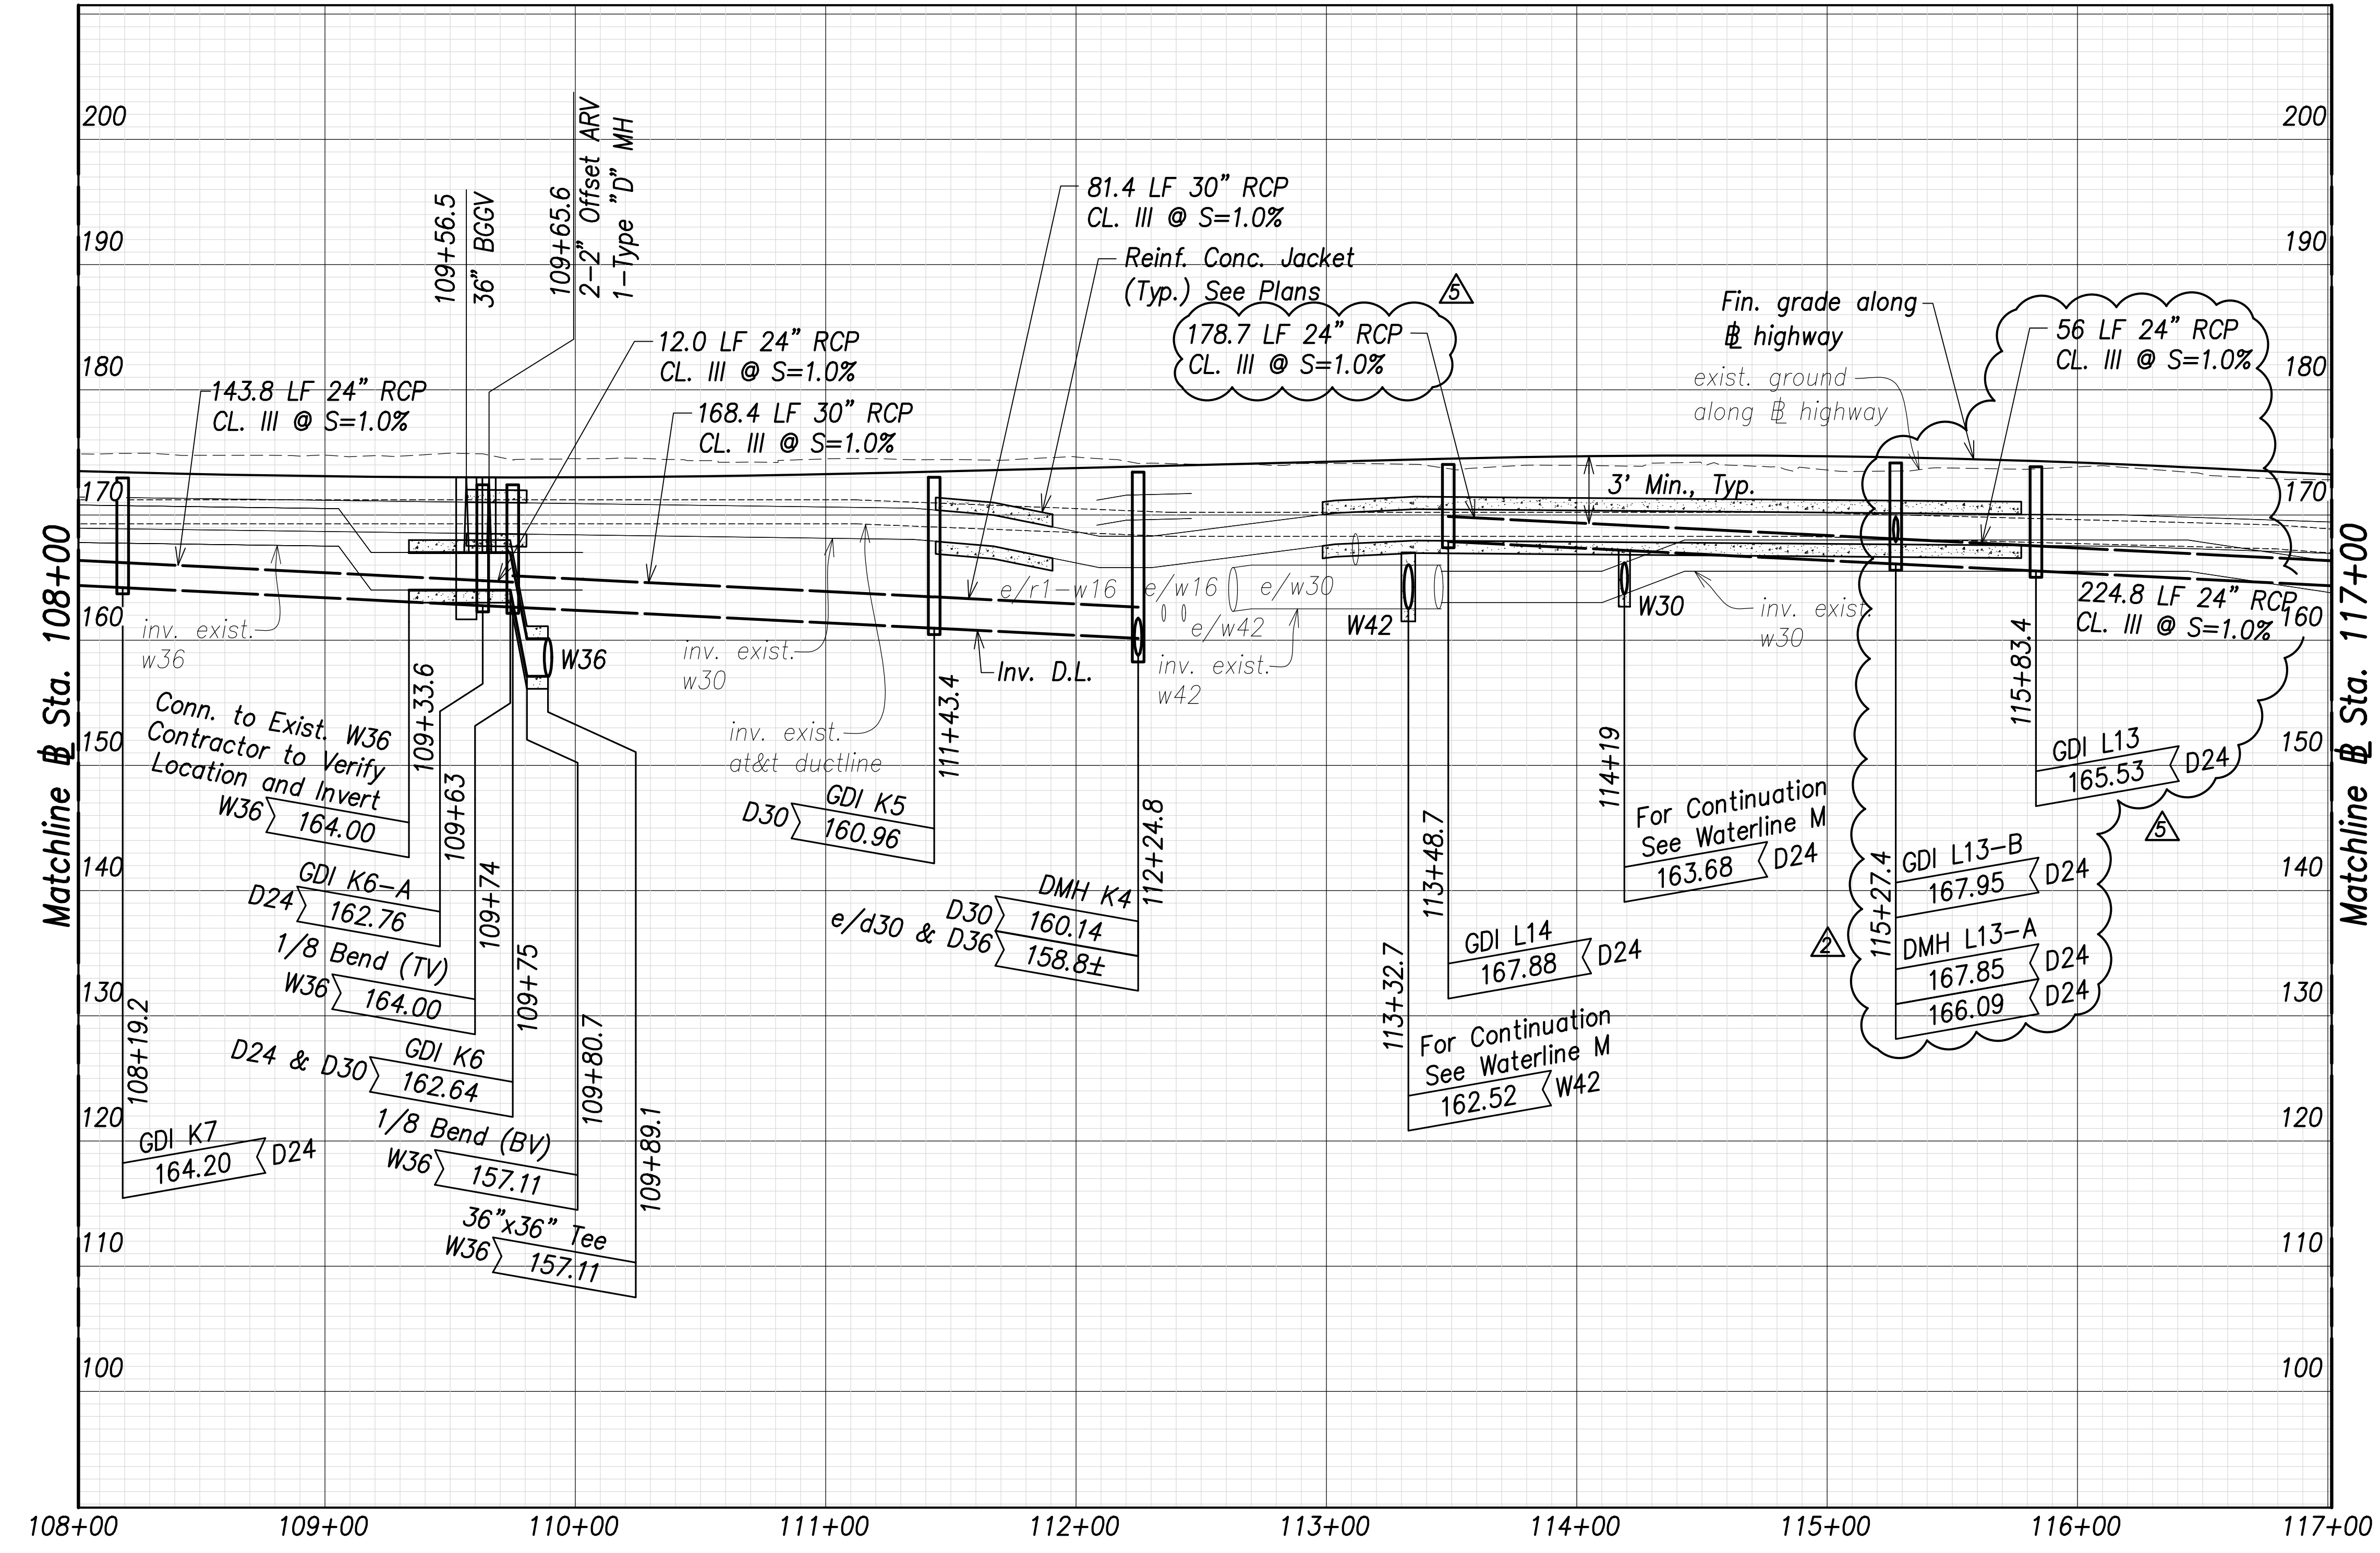

**Utility and Drain Profiles (Sta. 108+00 to Sta. 117+00)**  
 Scales: Hor.: 1" = 40'  
 Vert.: 1" = 8'

**Note:**  
 Drain pipe lengths and slopes shown on profiles are calculated from the center of structures.

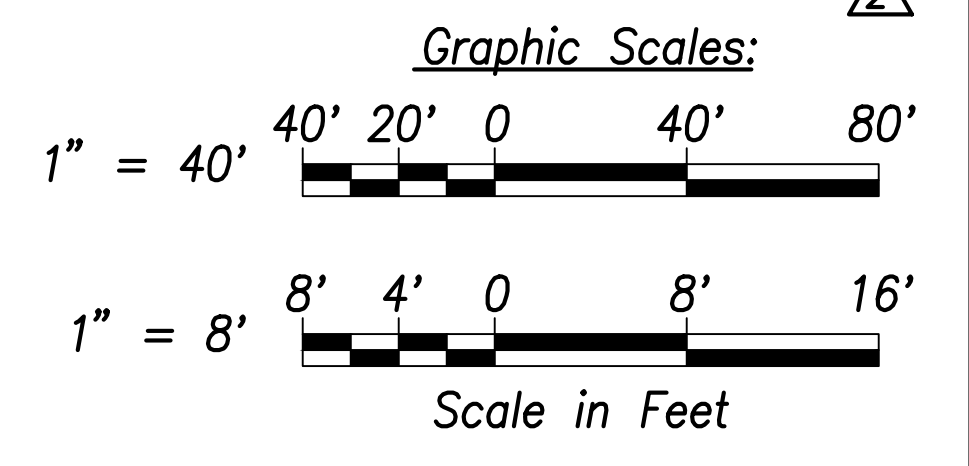

SURVEY PLOTTED BY	DATE
DRAWN BY	
TRACED BY	
CHECKED BY	
ORIGINAL PLAN	
NOTE BOOK	
No.	

APPROVED:  
 Manager and Chief Engineer, BWS  
 (for work affecting BWS facilities in City/State R/W & BWS easements only)

CRAIG W. L. LUKE  
 LICENSED PROFESSIONAL ENGINEER  
 No. 6935-C  
 HAWAII, U.S.A.  
 THIS WORK WAS PREPARED BY ME OR UNDER MY SUPERVISION AND CONSTRUCTION OF THIS PROJECT WILL BE UNDER MY OBSERVATION.  
 SIGNATURE: [Signature]  
 EXPIRATION DATE OF THE LICENSE: April 30, 2024

07/15/22	Revised GDI's and Drain Lines
06/08/22	Added note; Revised connection
DATE	REVISION


STATE OF HAWAII  
 DEPARTMENT OF TRANSPORTATION  
 HIGHWAYS DIVISION

**Utility and Drain Profiles**  
 Sta. 108+00 to Sta. 117+00


FARRINGTON HIGHWAY WIDENING  
 Kapolei Golf Course Road to Fort Weaver Road  
 Project No. 7101A-01-20

Scale: As Shown Date: April 2022

FED. ROAD DIST. NO.	STATE	PROJ. NO.	FISCAL YEAR	SHEET NO.	TOTAL SHEETS
HAWAII	HAW.	7101A-01-20	2021	152	767

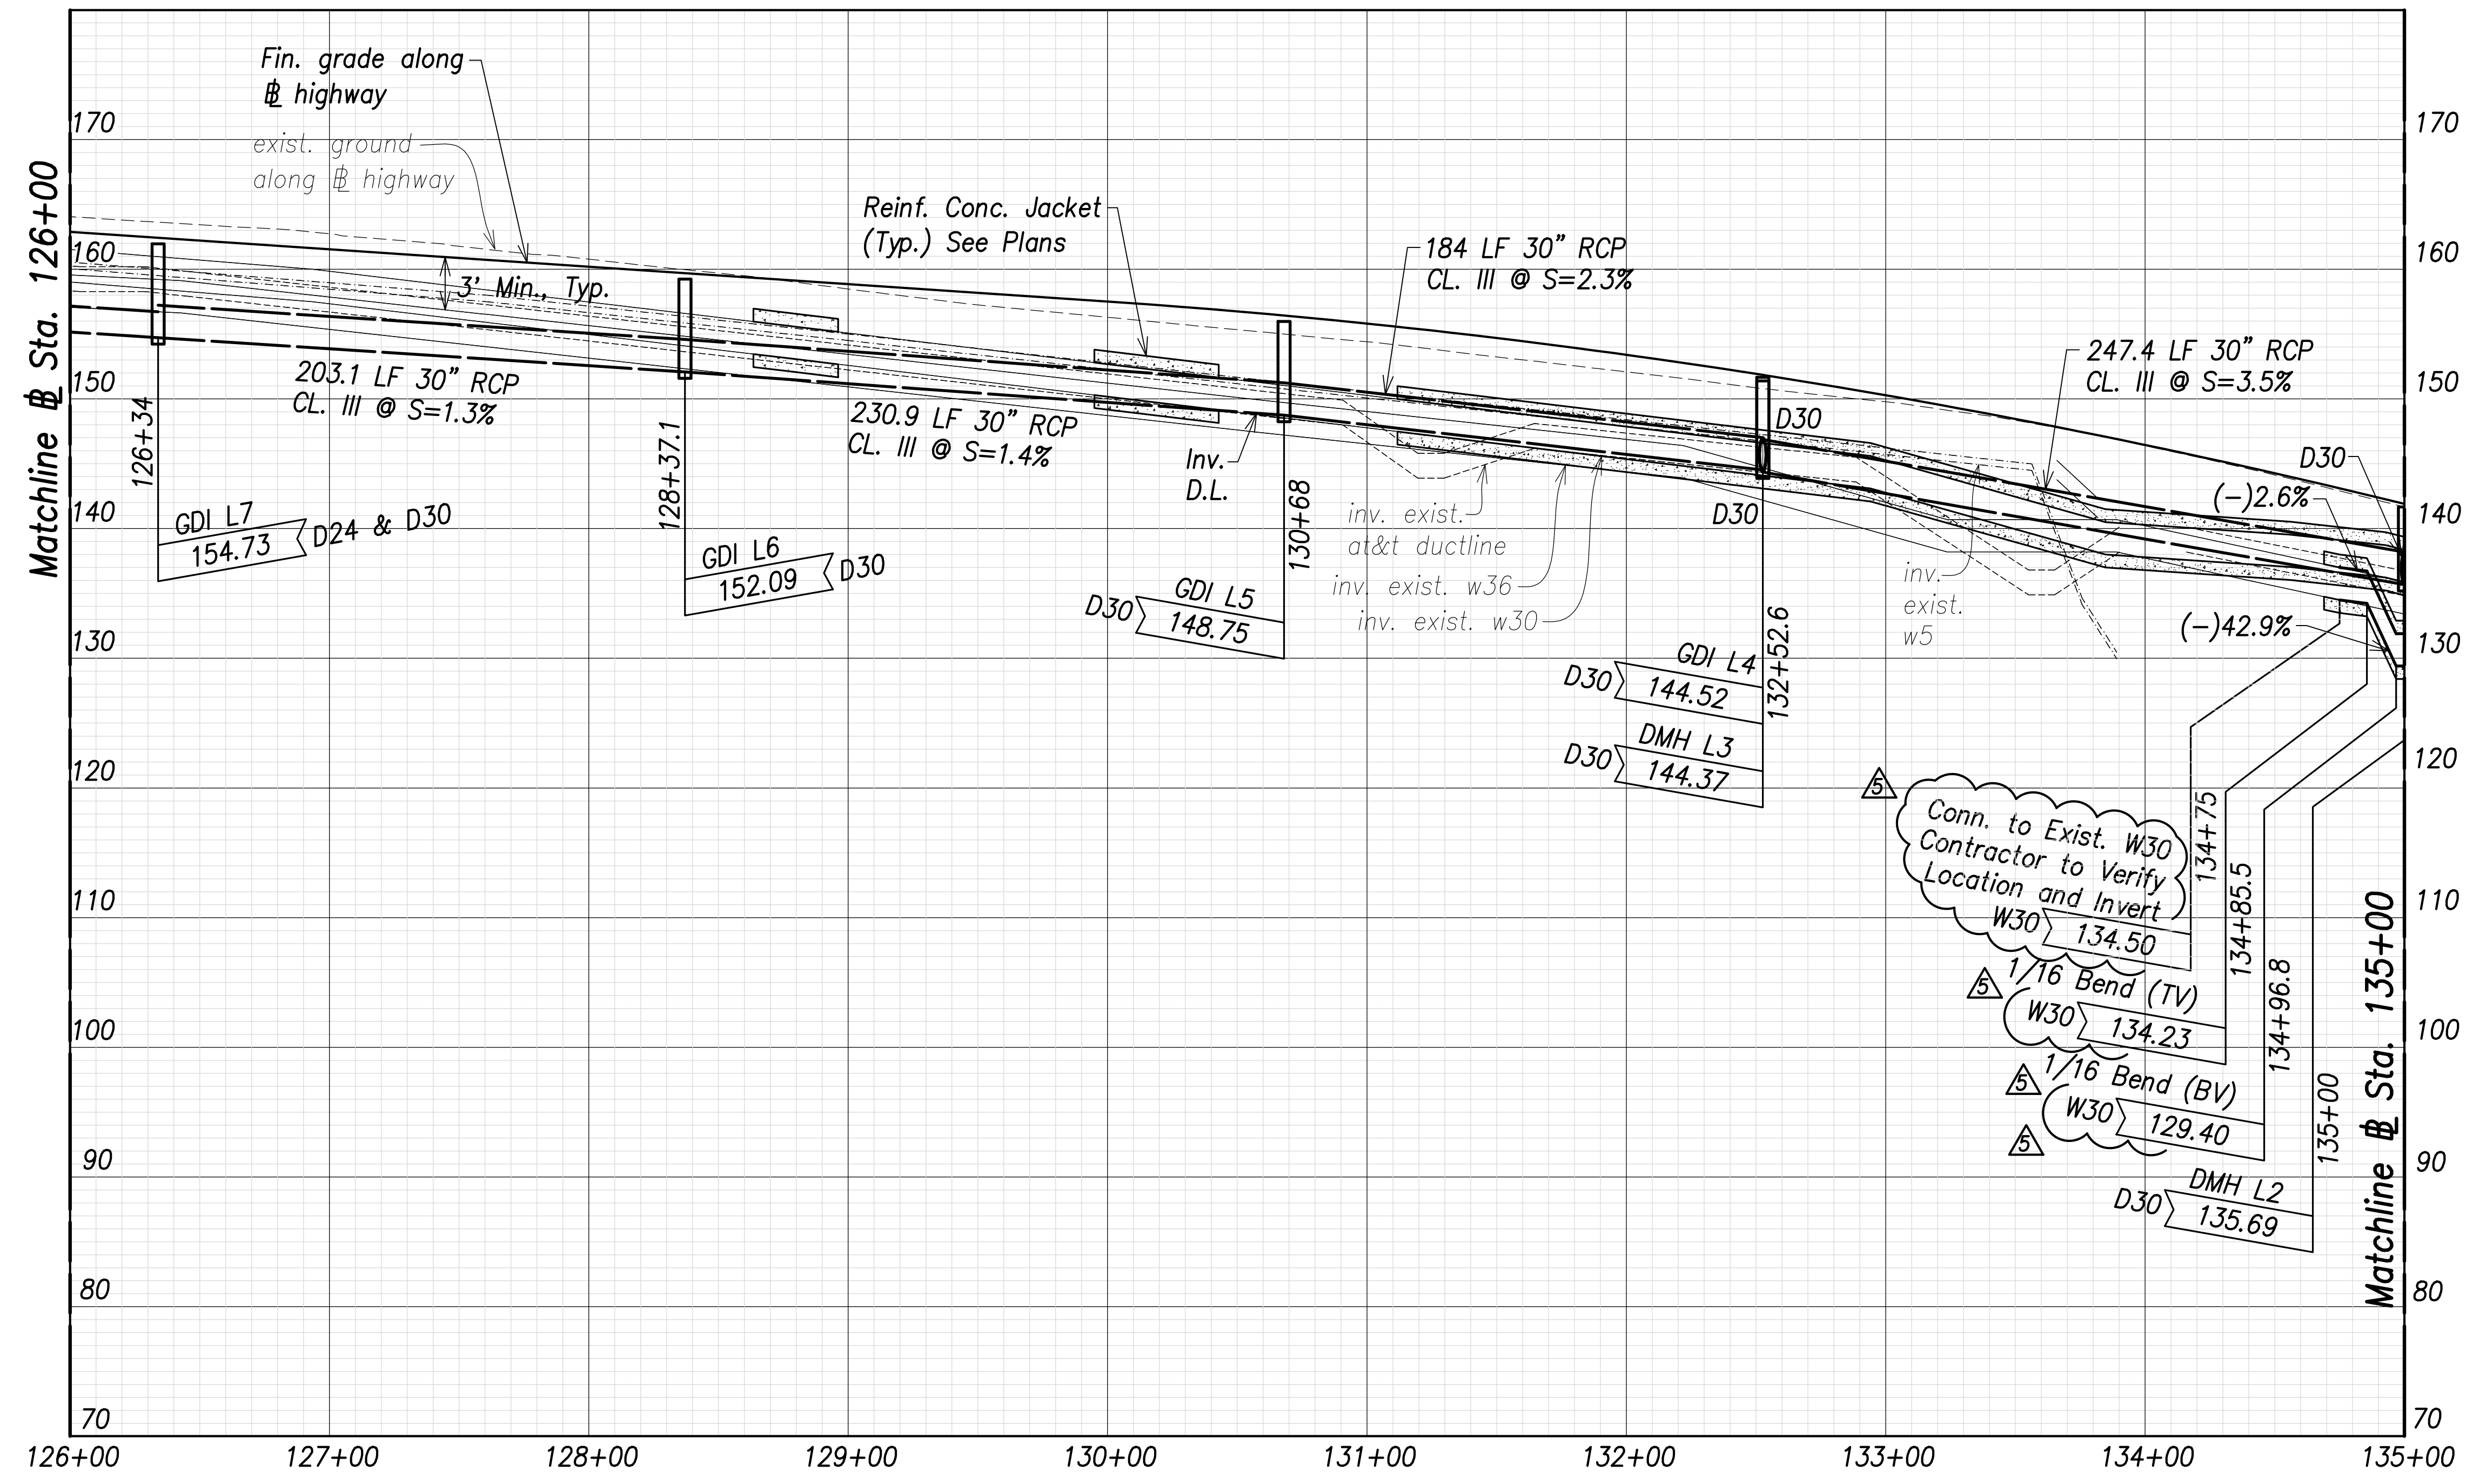

**Utility and Drain Profiles – (Sta. 126+00 to Sta. 135+00)**  
 Scales: Hor.: 1" = 40'  
 Vert.: 1" = 8'

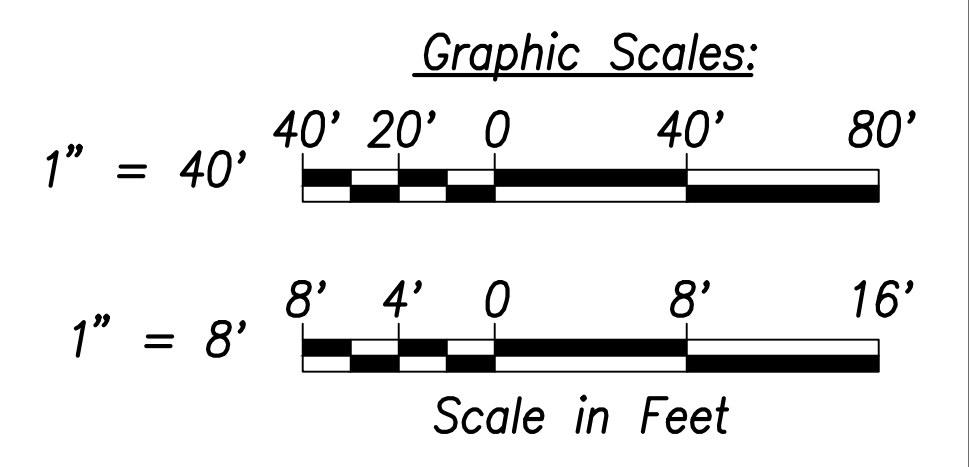

SURVEY PLOTTED BY	DATE
DRAWN BY	
TRACED BY	
QUANTITIES BY	
CHECKED BY	
ORIGINAL PLAN	
NOTE BOOK	
No.	

**Note:**  
 Drain pipe lengths and slopes shown on profiles are calculated from the center of structures.

APPROVED:  
 \_\_\_\_\_ DATE \_\_\_\_\_  
 Manager and Chief Engineer, BWS  
 (for work affecting BWS facilities in City/State R/W & BWS easements only)

**CRAIG W. L. LUKE**  
 LICENSED PROFESSIONAL ENGINEER  
 No. 6935-C  
 HAWAII, U.S.A.  
 THIS WORK WAS PREPARED BY ME OR UNDER MY SUPERVISION AND CONSTRUCTION OF THIS PROJECT WILL BE UNDER MY OBSERVATION.  
 SIGNATURE: \_\_\_\_\_ EXPIRATION DATE OF THE LICENSE: April 30, 2024

07/15/22	Revised waterline size
06/08/22	Revised bend callouts, added note
DATE	REVISION

STATE OF HAWAII  
**DEPARTMENT OF TRANSPORTATION**  
 HIGHWAYS DIVISION


**Utility and Drain Profiles**  
 Sta. 126+00 to Sta. 135+00

FARRINGTON HIGHWAY WIDENING  
 Kapolei Golf Course Road to Fort Weaver Road  
 Project No. 7101A-01-20

Scale: As Shown Date: April 2022


FILE: K:\civil\23146 Farrington Hwy Widening\Drawings\Construction\Drawings\C-151 Utility and Drain Profiles - Sta. 126+00 to 135+00 - PLAN.dwg saved July 8, 2022

FED. ROAD DIST. NO.	STATE	PROJ. NO.	FISCAL YEAR	SHEET NO.	TOTAL SHEETS
HAWAII	HAW.	7101A-01-20	2021	153	767

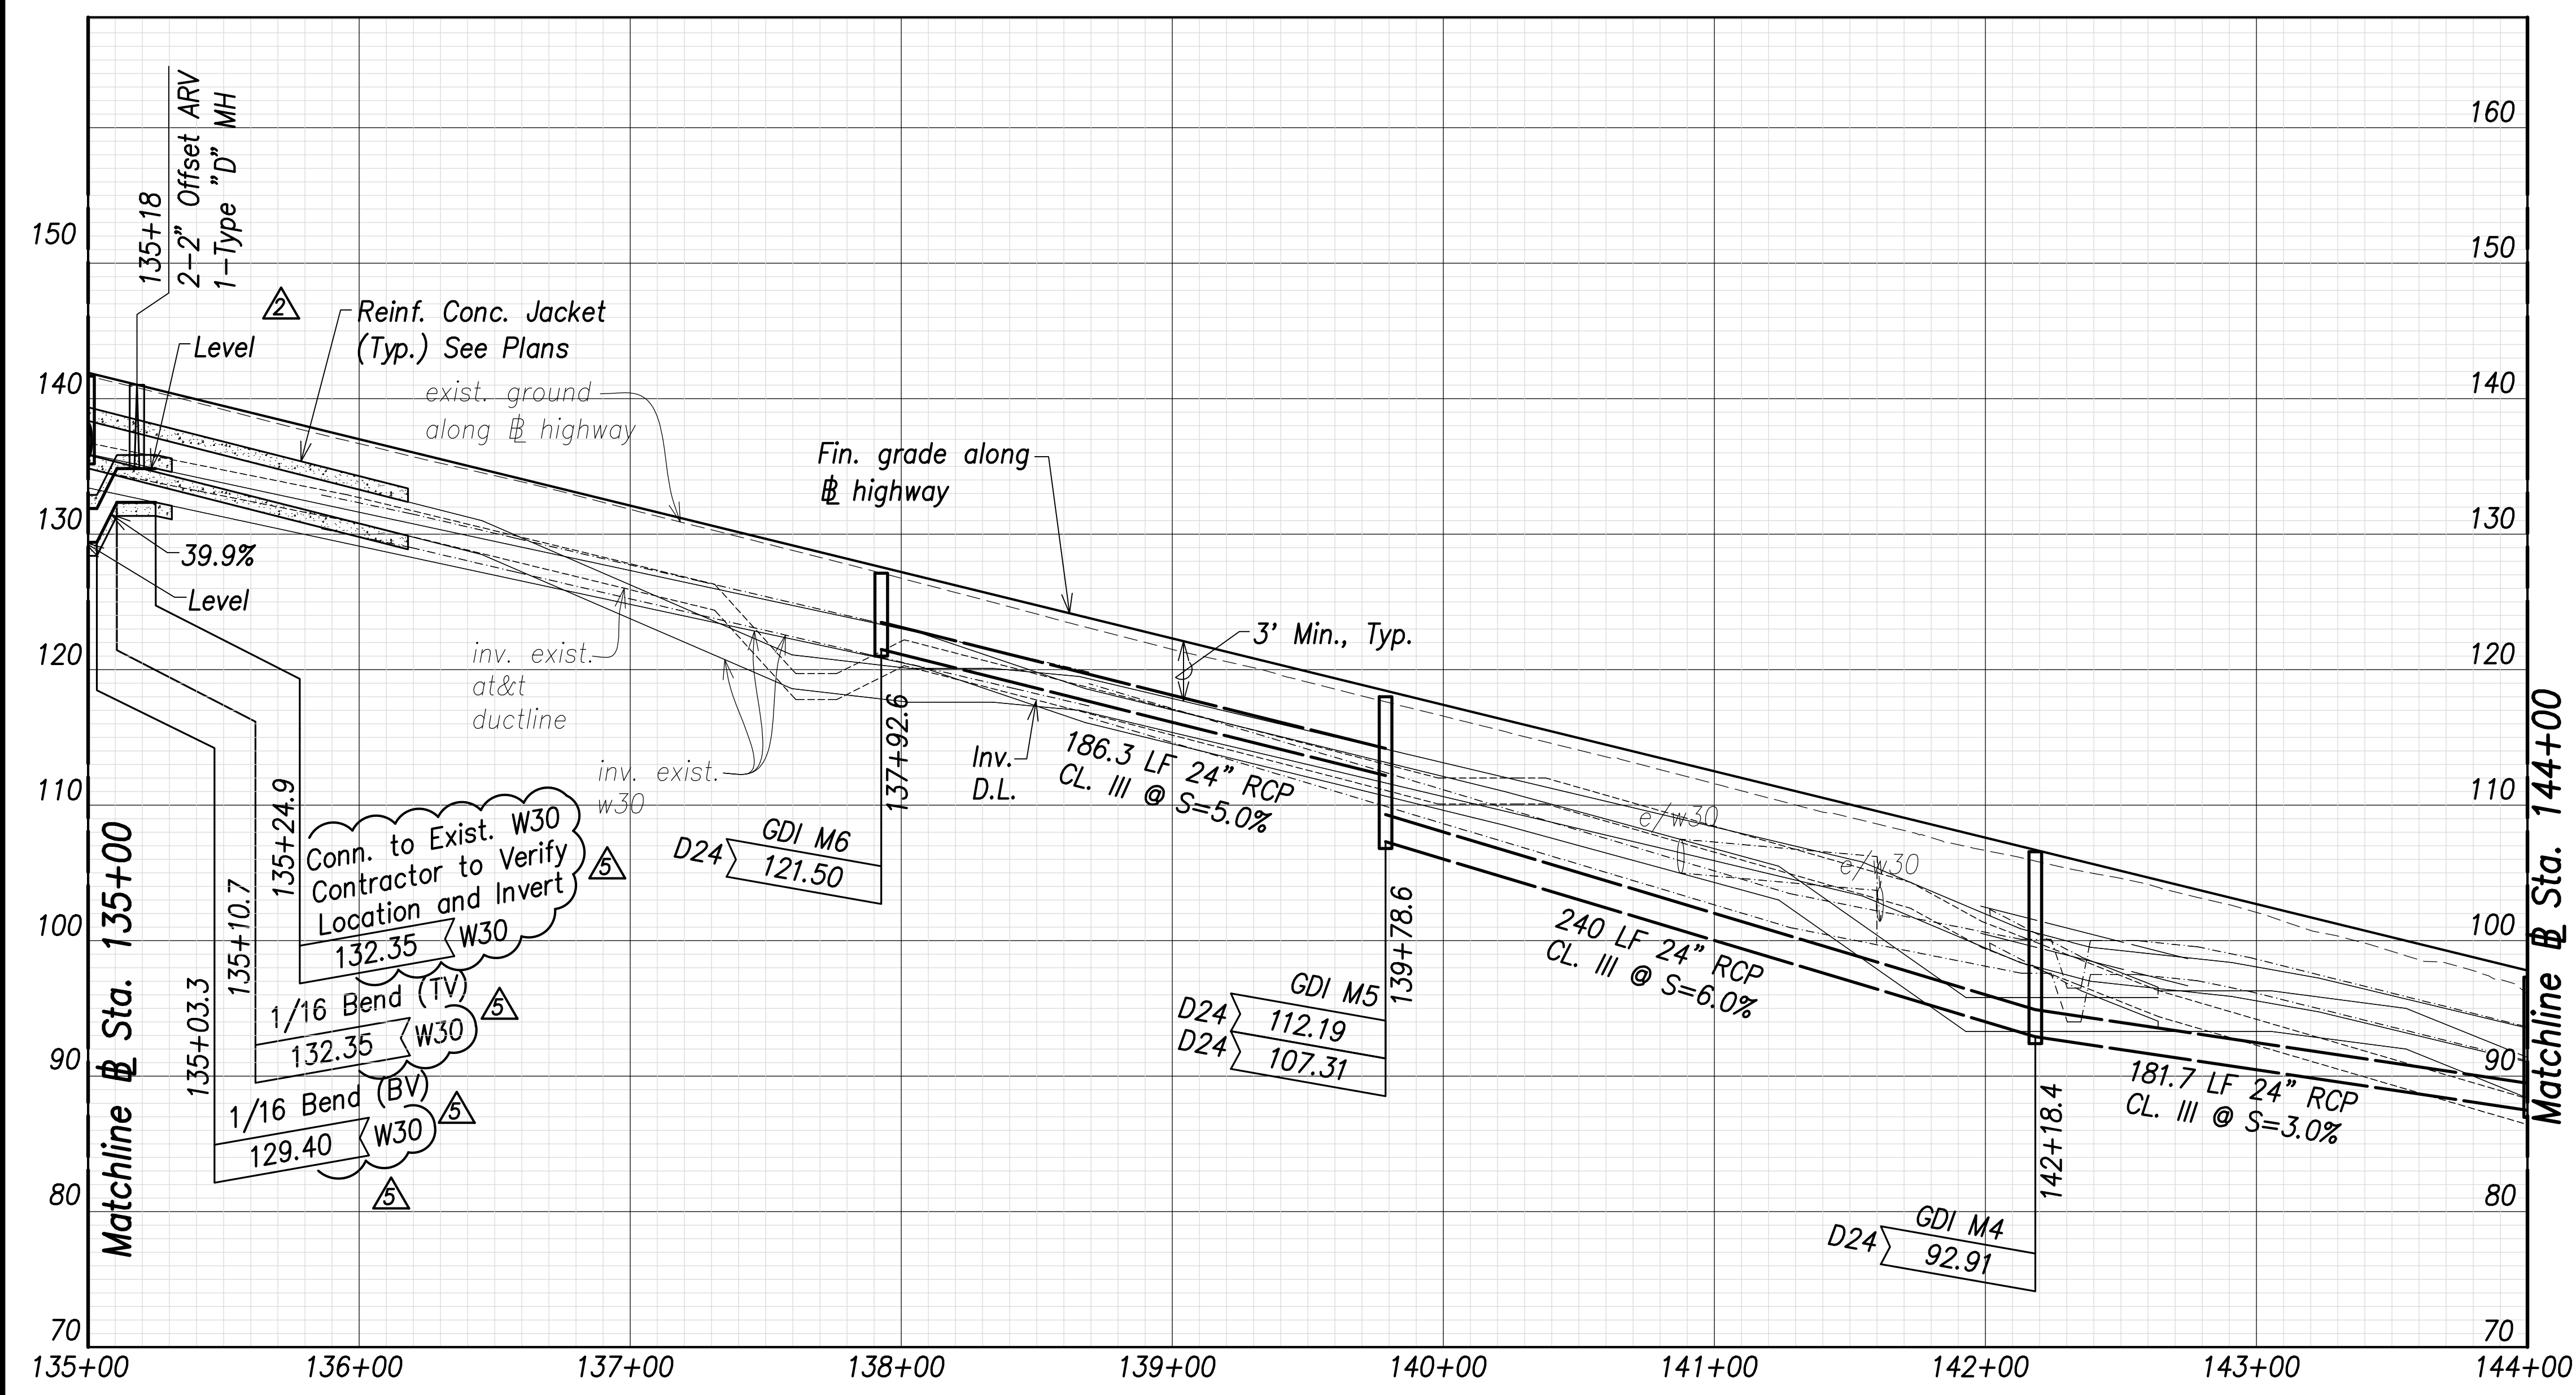

**Utility and Drain Profiles - (Sta. 135+00 to Sta. 144+00)**  
 Scales: Hor.: 1" = 40'  
 Vert.: 1" = 8'

**Note:**  
 Drain pipe lengths and slopes shown on profiles are calculated from the center of structures.

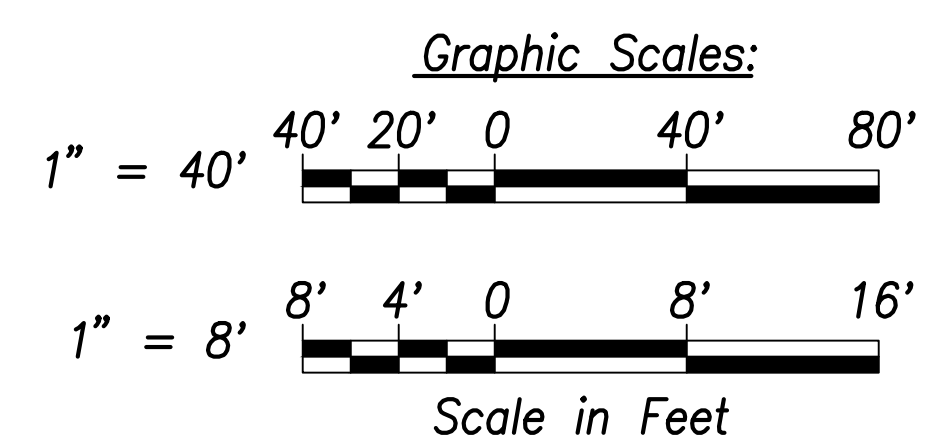

SURVEY PLOTTED BY	DATE
DRAWN BY	
TRACED BY	
QUANTITIES BY	
CHECKED BY	
ORIGINAL PLAN	
NOTE BOOK	
No.	

APPROVED:  
 \_\_\_\_\_ DATE \_\_\_\_\_  
 Manager and Chief Engineer, BWS  
 (for work affecting BWS facilities in  
 City/State R/W & BWS easements only)



THIS WORK WAS PREPARED BY ME OR UNDER MY SUPERVISION AND CONSTRUCTION OF THIS PROJECT WILL BE UNDER MY OBSERVATION.  
 SIGNATURE: \_\_\_\_\_ DATE: April 30, 2024  
 EXPIRATION DATE OF THE LICENSE

07/15/22	Revised wateline size
06/08/22	Revised bend callouts, grid, and pipe layout, added note
DATE	REVISION


STATE OF HAWAII  
 DEPARTMENT OF TRANSPORTATION  
 HIGHWAYS DIVISION

**Utility and Drain Profiles**  
 Sta. 135+00 to Sta. 144+00

FARRINGTON HIGHWAY WIDENING  
 Kapolei Golf Course Road to Fort Weaver Road  
 Project No. 7101A-01-20

Scale: As Shown Date: April 2022


FED. ROAD DIST. NO.	STATE	PROJ. NO.	FISCAL YEAR	SHEET NO.	TOTAL SHEETS
HAWAII	HAW.	7101A-01-20	2021	155	767

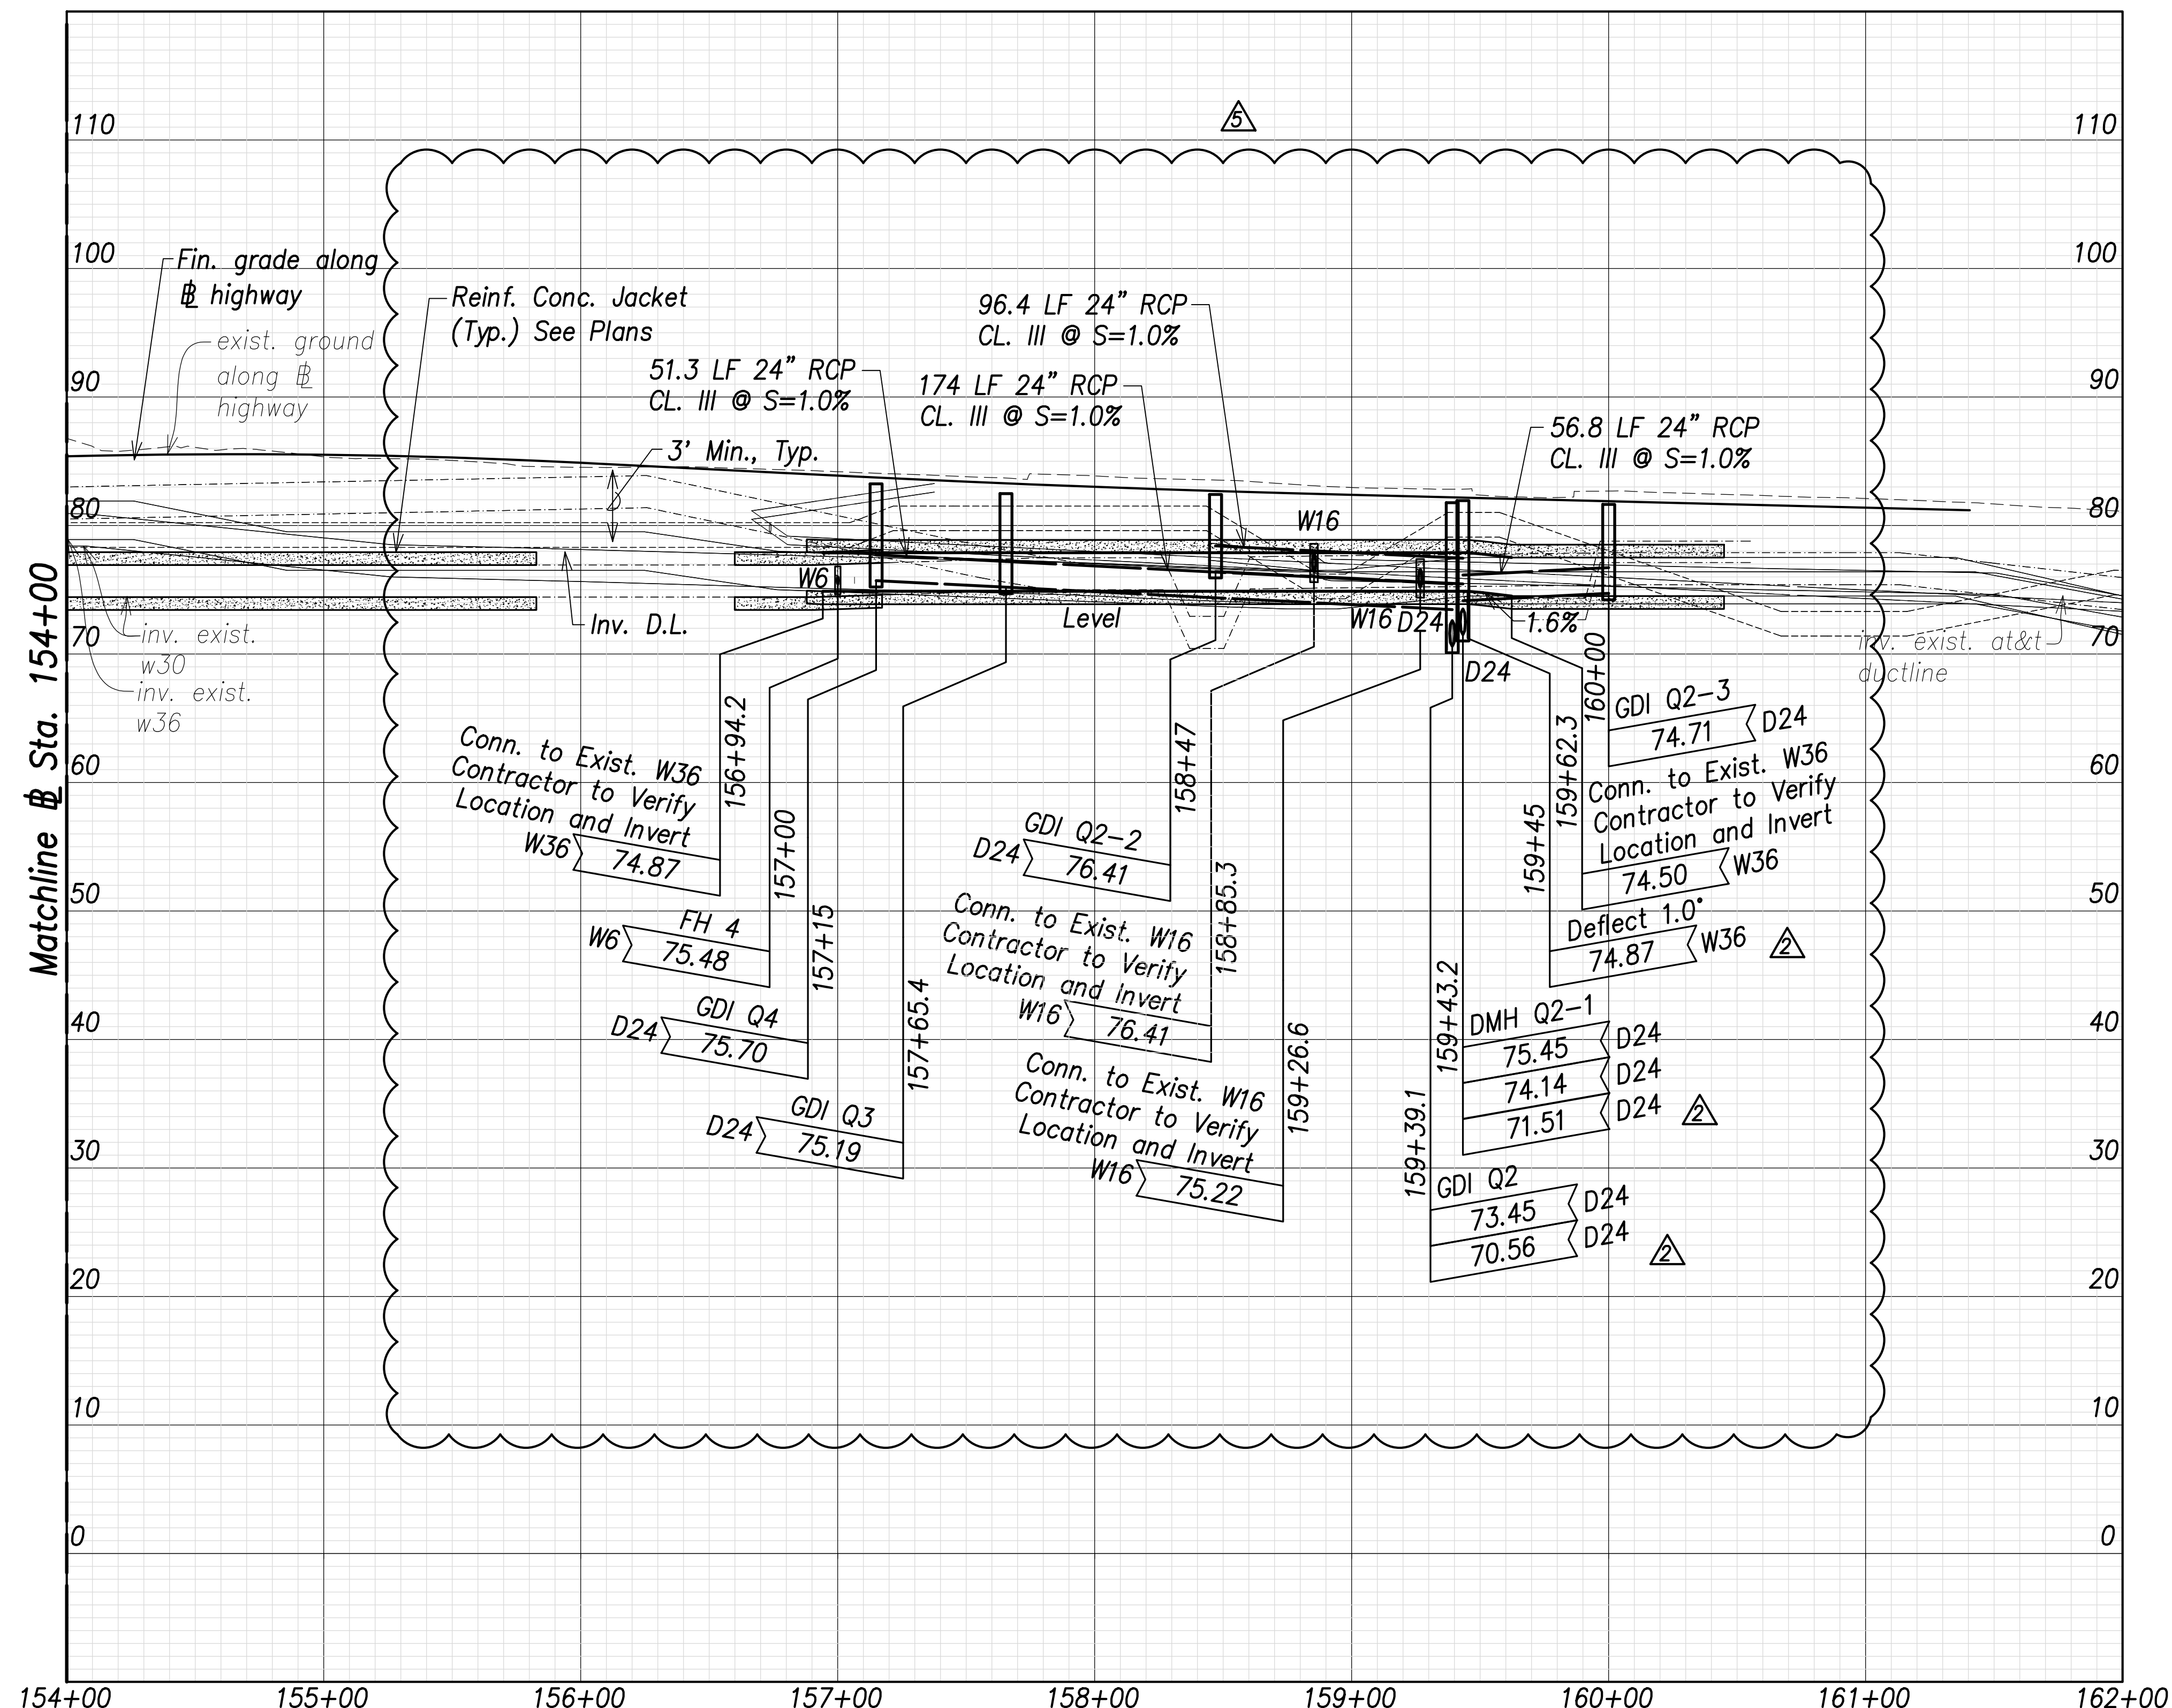

**Utility and Drain Profiles - (Sta. 154+00 to Sta. 162+00)**  
 Scales: Hor.: 1" = 40'  
 Vert.: 1" = 8'

**Note:**

Drain pipe lengths and slopes shown on profiles are calculated from the center of structures.

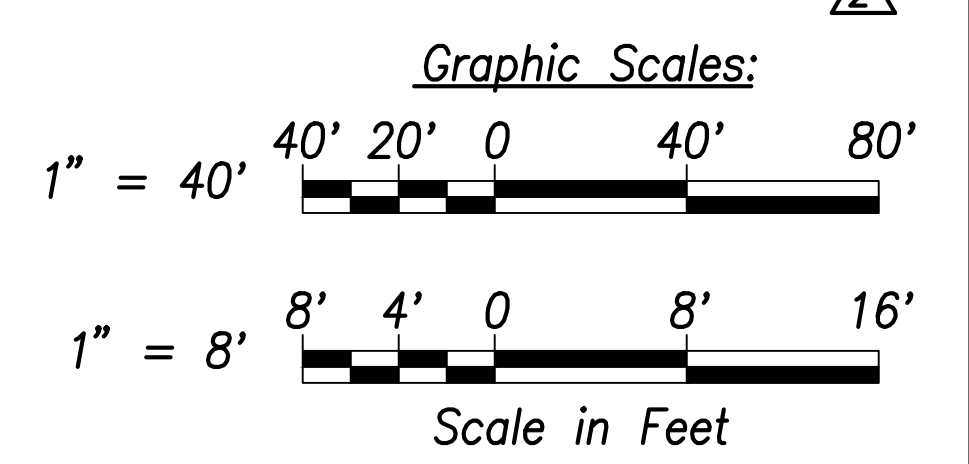


SURVEY PLOTTED BY	DATE
DRAWN BY	
TRACED BY	
CHECKED BY	
NO. _____	

APPROVED:

\_\_\_\_\_  
 Manager and Chief Engineer, BWS  
 (for work affecting BWS facilities in City/State R/W & BWS easements only)

DATE \_\_\_\_\_

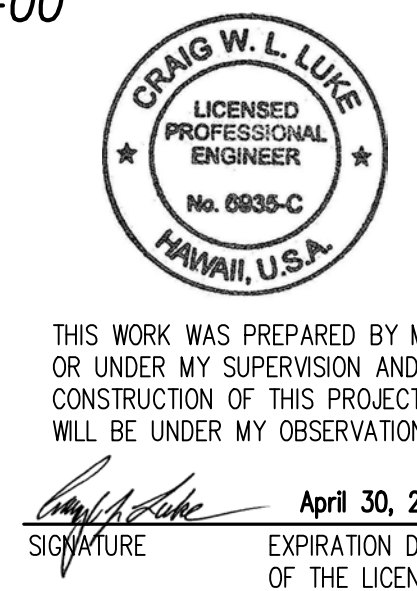

07/15/22	Revised Profiles
06/08/22	Revised inverts and water line, added note
DATE	REVISION

STATE OF HAWAII  
 DEPARTMENT OF TRANSPORTATION  
 HIGHWAYS DIVISION


**Utility and Drain Profiles**  
 Sta. 154+00 to Sta. 162+00

FARRINGTON HIGHWAY WIDENING  
 Kapolei Golf Course Road to Fort Weaver Road  
 Project No. 7101A-01-20


Scale: As Shown Date: April 2022



FED. ROAD DIST. NO.	STATE	PROJ. NO.	FISCAL YEAR	SHEET NO.	TOTAL SHEETS
HAWAII	HAW.	7101A-01-20	2021	156	767

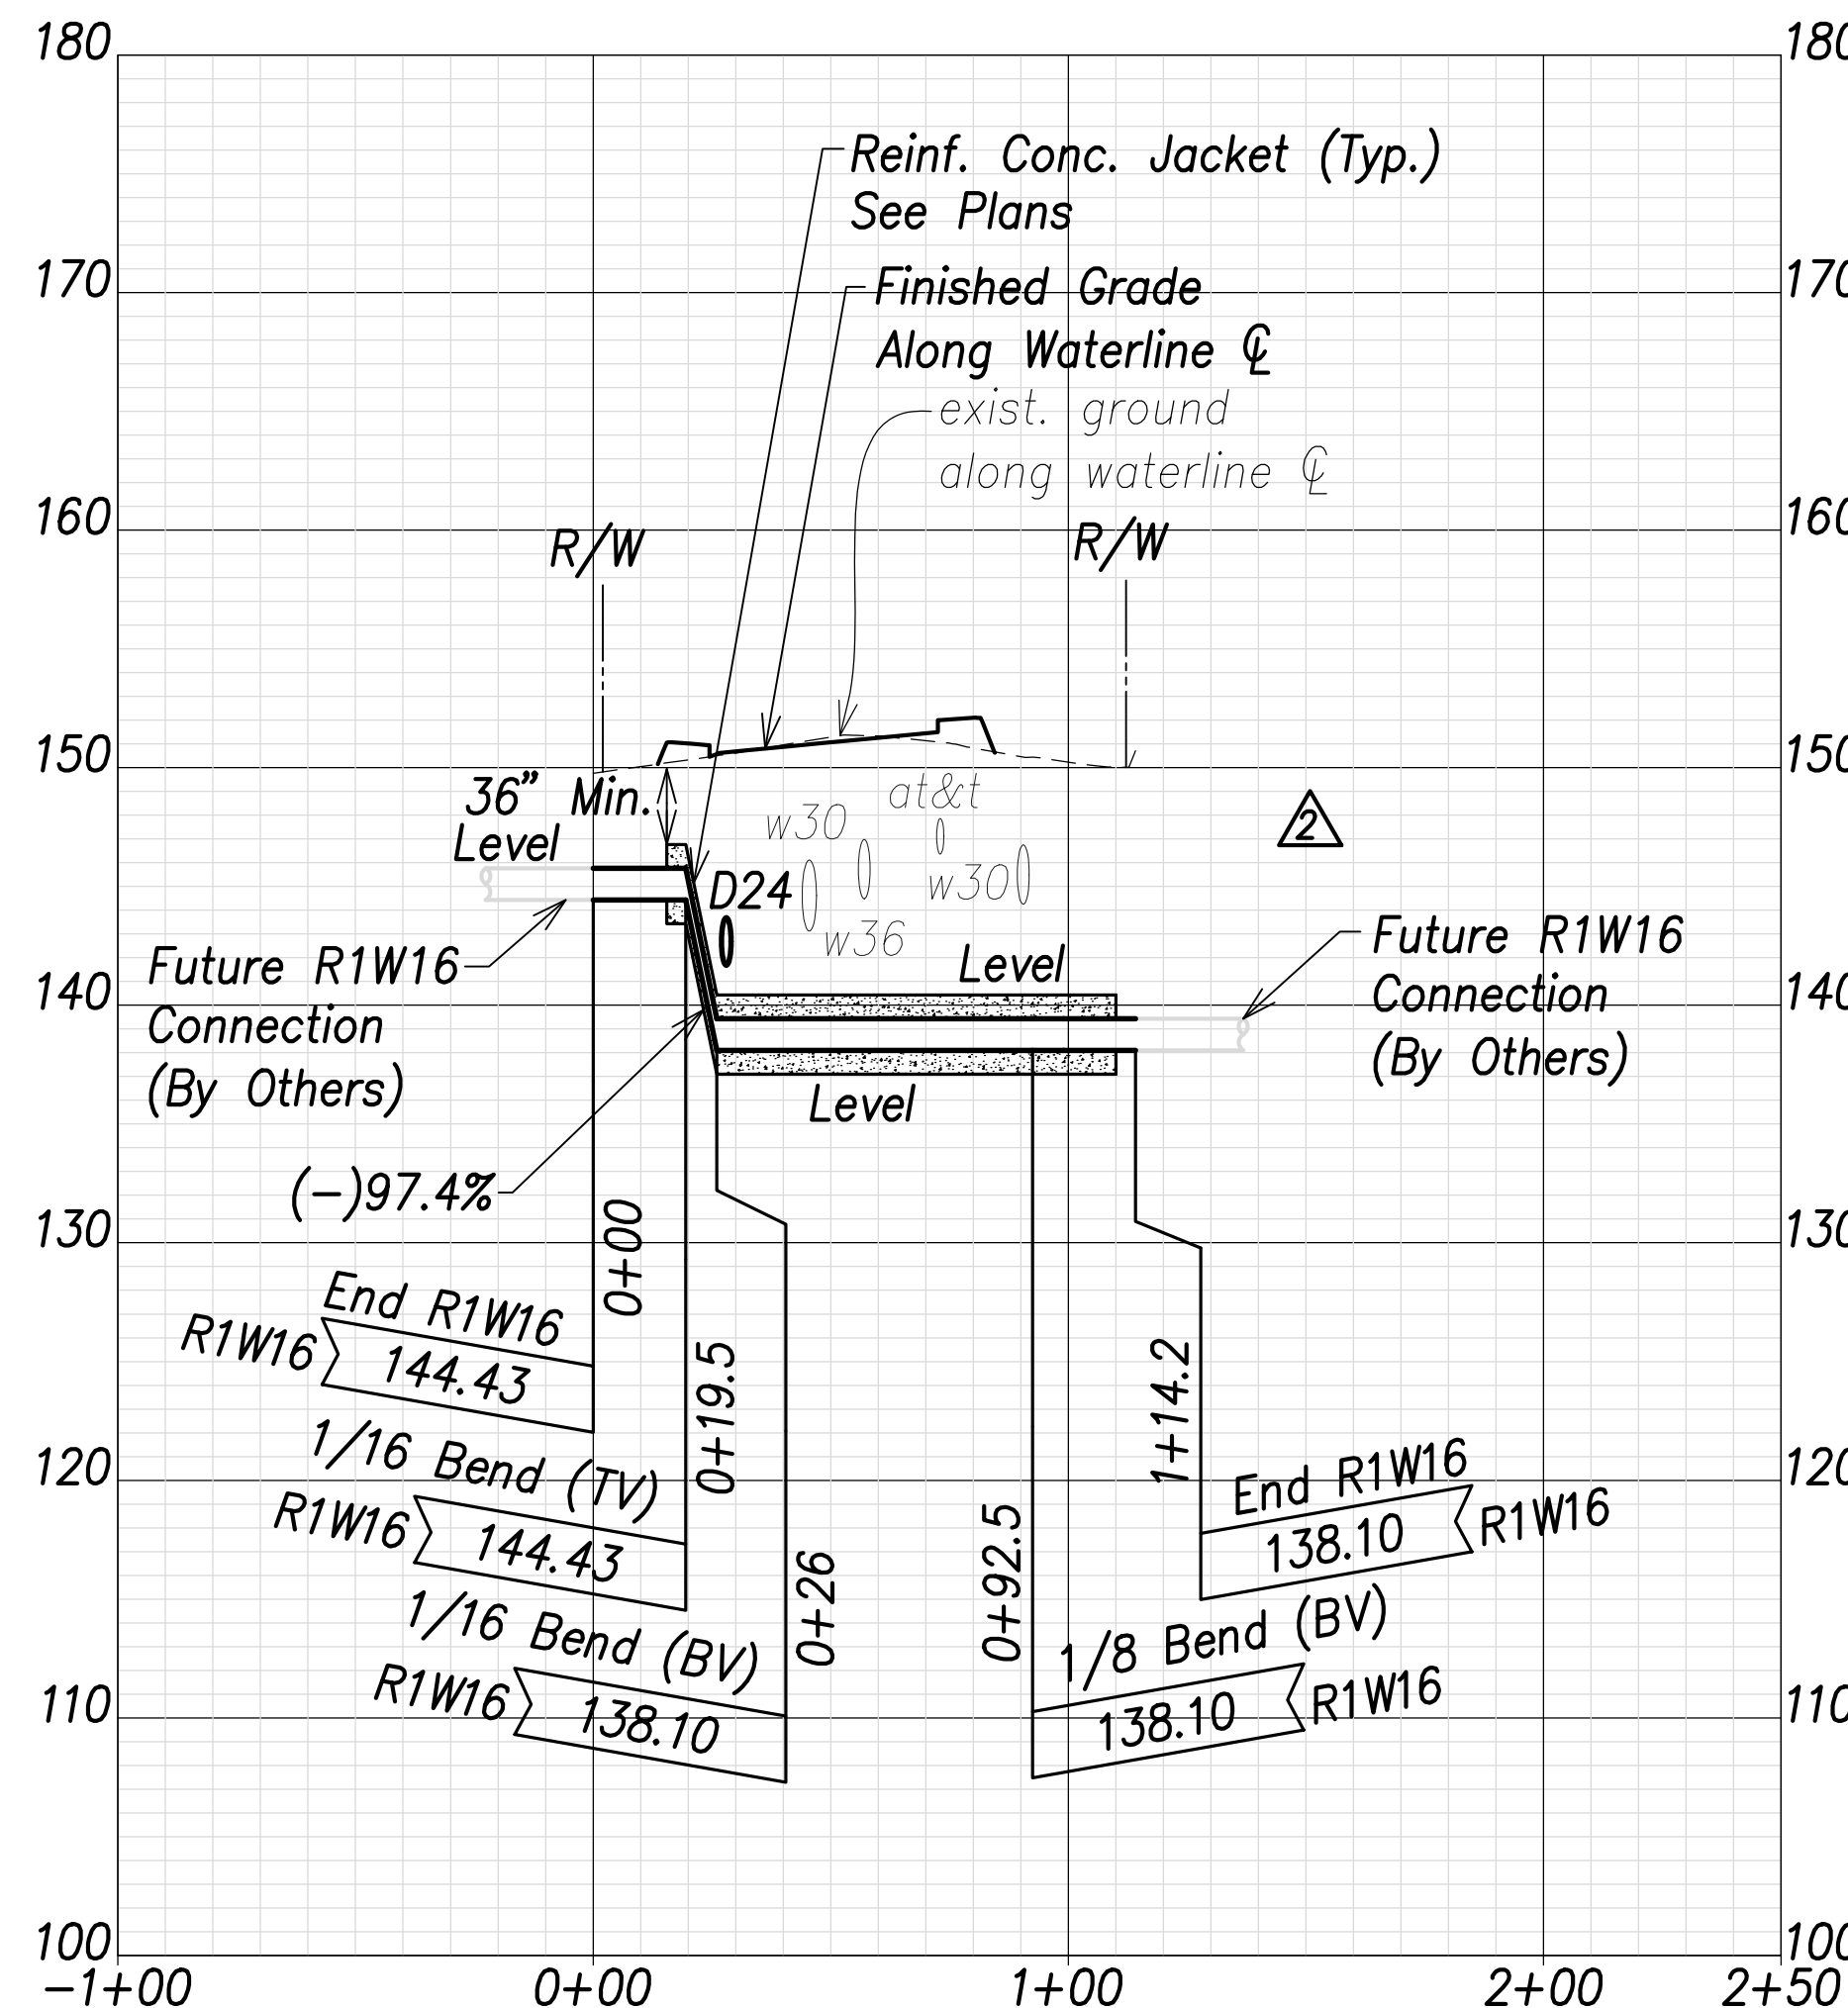


**Waterline B Profile**  
**(Sta. 46+71 Farrington Highway)**  
 Scales: Hor.: 1" = 40'  
 Vert.: 1" = 8'

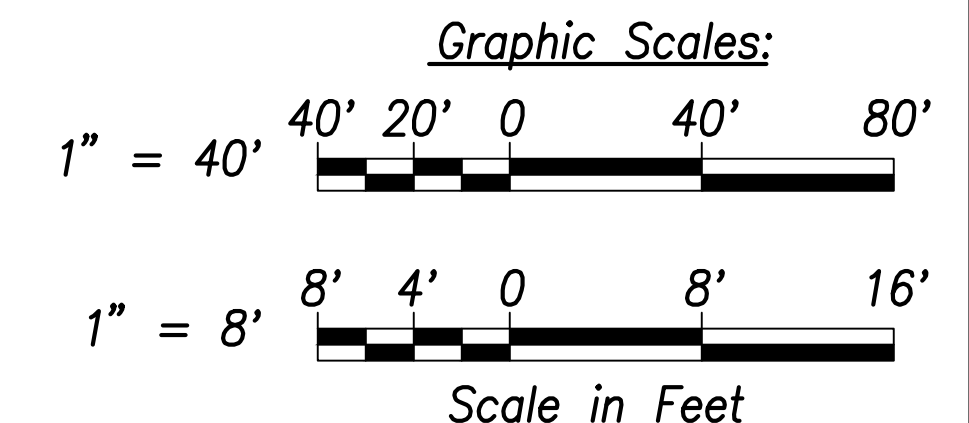

SURVEY PLOTTED BY	DATE
DRAWN BY	
TRACED BY	
DESIGNED BY	
CHECKED BY	
ORIGINAL PLAN	
NOTE BOOK	
No.	

**Note:**  
 The Contractor shall provide Controlled Low Strength Material (CLSM) in areas where required compaction cannot be met. CLSM shall be extend a minimum of 2' beyond the waterline at the crossing and shall extend to the top of the crossing pipe

APPROVED:  
 \_\_\_\_\_ DATE \_\_\_\_\_  
 Manager and Chief Engineer, BWS  
 (for work affecting BWS facilities in  
 City/State R/W & BWS easements only)

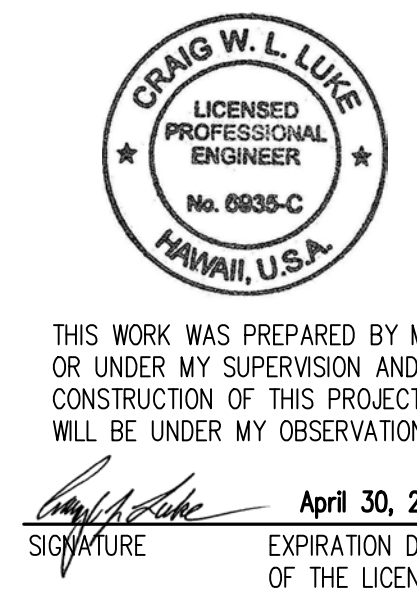

DATE	REVISION
07/15/22	5 CLSM Note Added
06/08/22	2 Min. Cover Callout Added


STATE OF HAWAII  
 DEPARTMENT OF TRANSPORTATION  
 HIGHWAYS DIVISION

**Waterlines Profile - 1**


FARRINGTON HIGHWAY WIDENING  
 Kapolei Golf Course Road to Fort Weaver Road  
 Project No. 7101A-01-20

Scale: As Shown Date: April 2022


FED. ROAD DIST. NO.	STATE	PROJ. NO.	FISCAL YEAR	SHEET NO.	TOTAL SHEETS
HAWAII	HAW.	7101A-01-20	2021	157	767

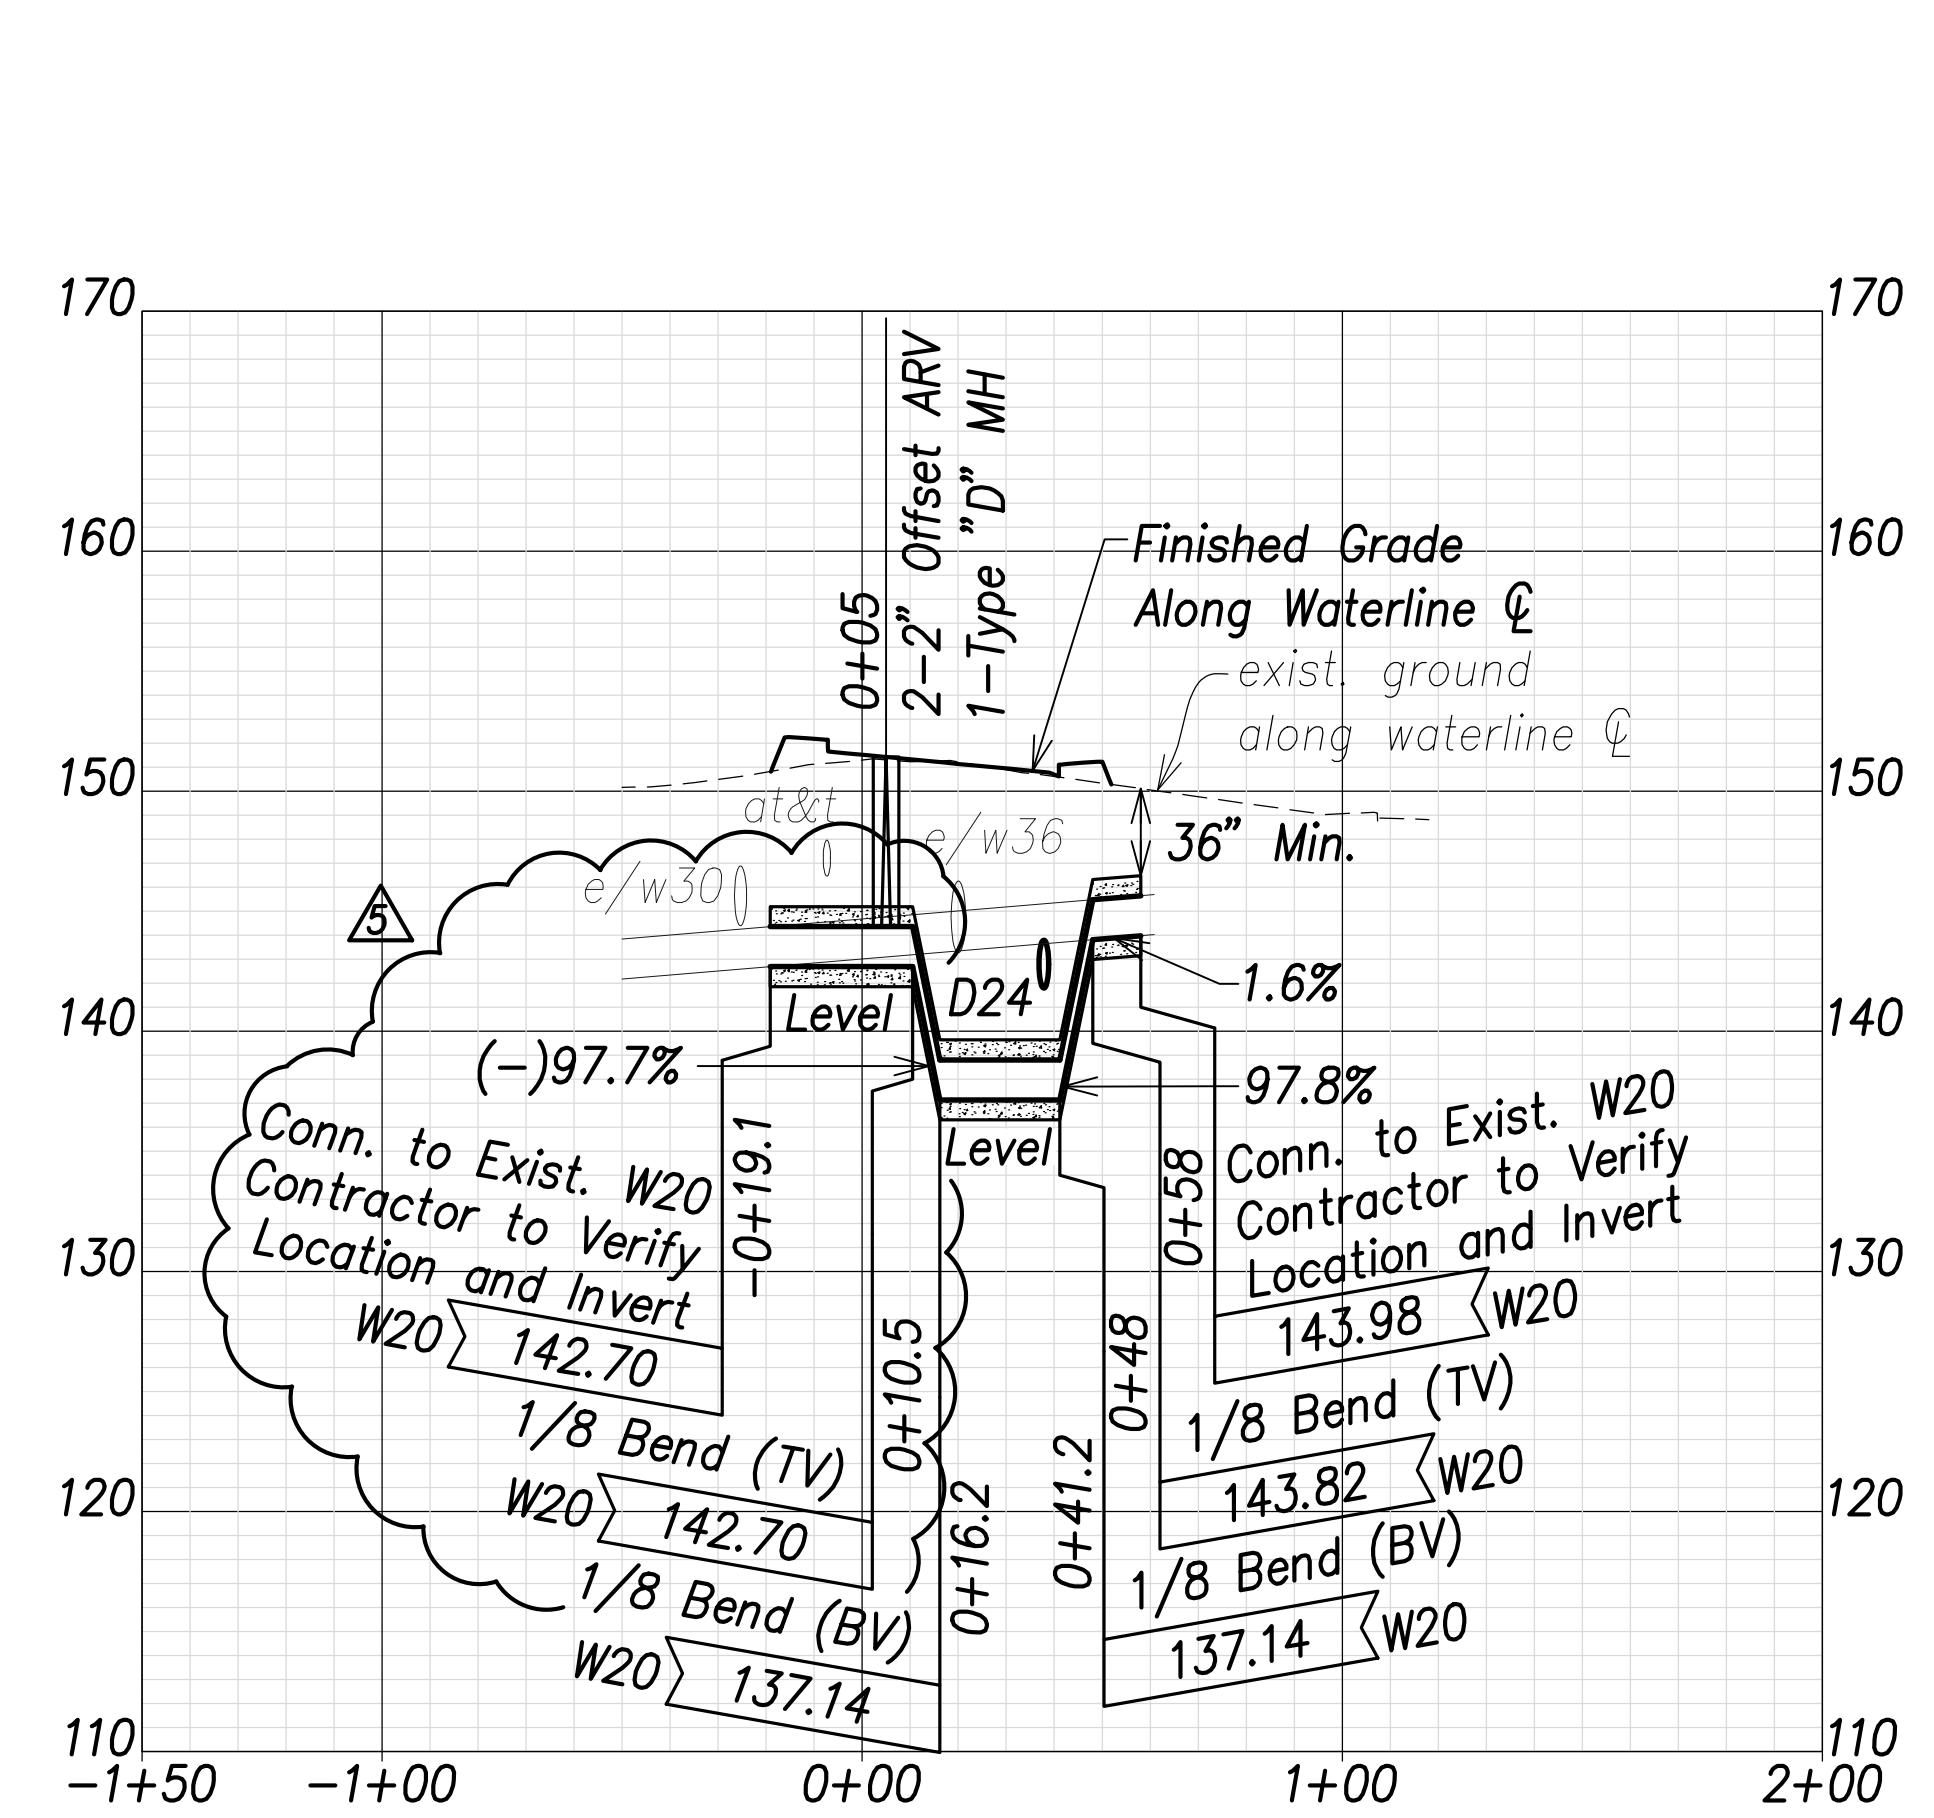

**Waterline F Profile**  
 (Sta. 46+87.6 Farrington Highway)  
 Scales: Hor.: 1" = 40'  
 Vert.: 1" = 8'

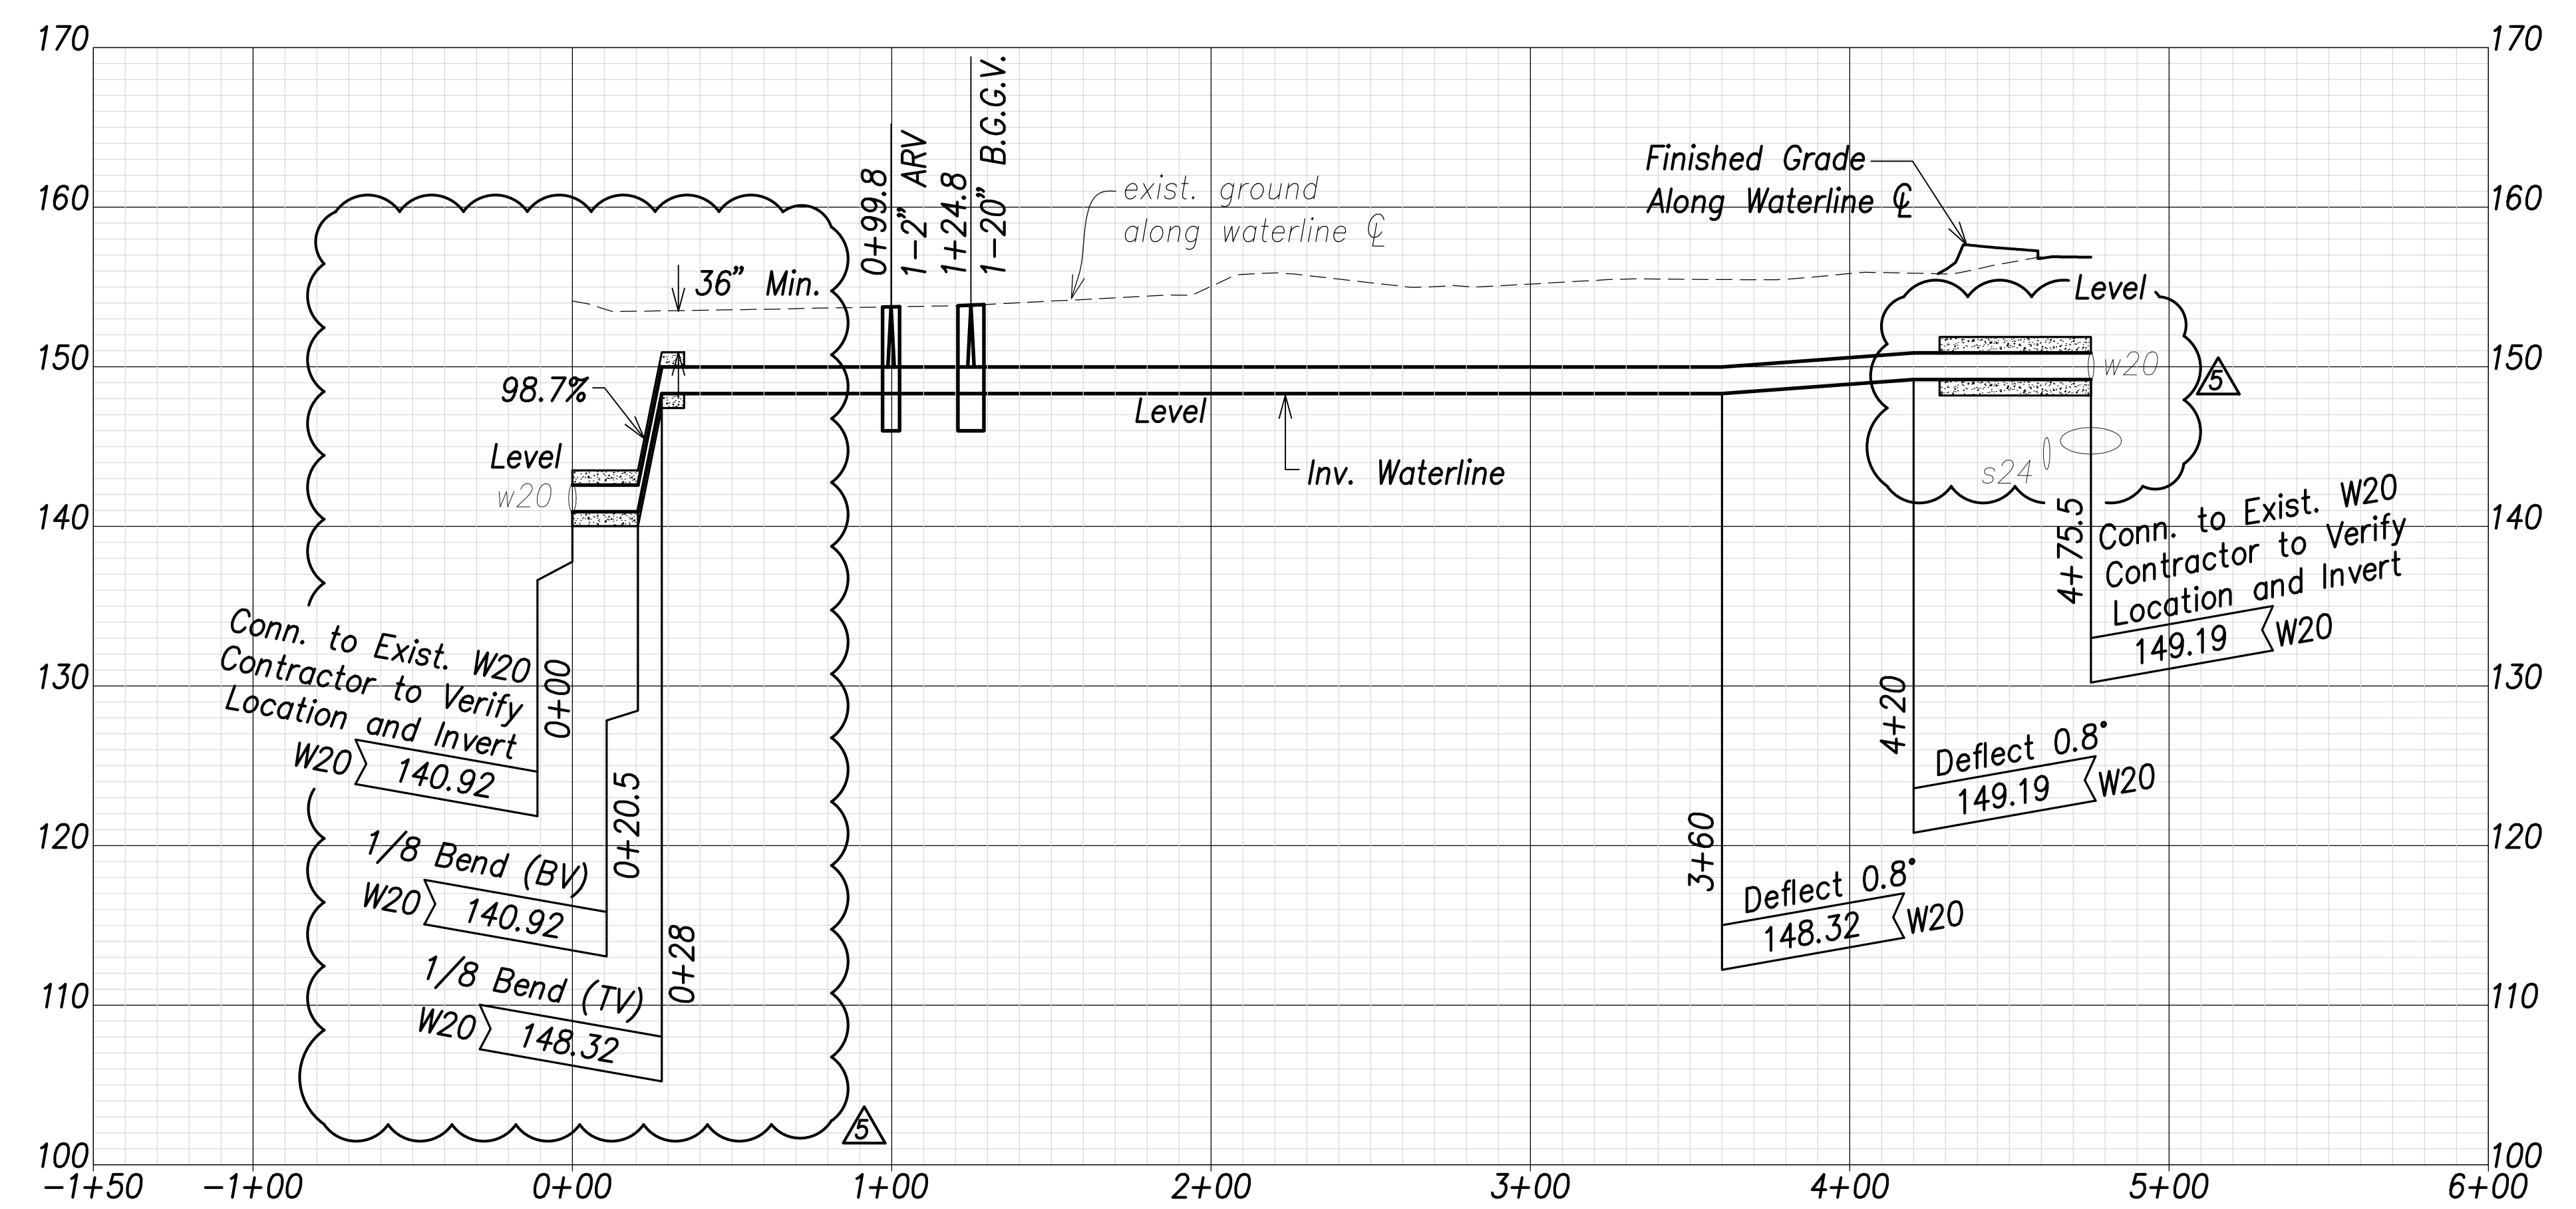


**Waterline G Profile**  
 (Sta. 51+89 Farrington Highway)  
 Scales: Hor.: 1" = 40'  
 Vert.: 1" = 8'

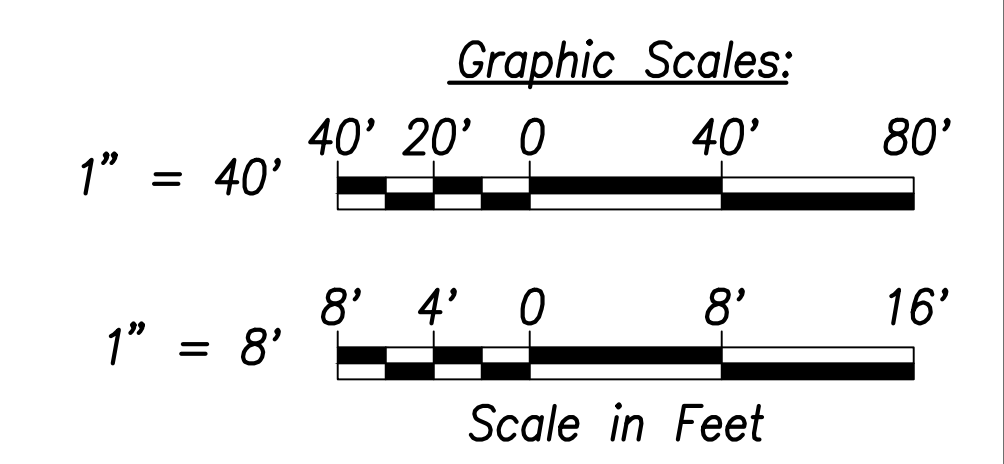

SURVEY PLOTTED BY	DATE
DRAWN BY	
TRACED BY	
DESIGNED BY	
CHECKED BY	
ORIGINAL PLAN	
NOTE BOOK	
No.	

**Note:**  
 The Contractor shall provide Controlled Low Strength Material (CLSM) in areas where required compaction cannot be met. CLSM shall be extend a minimum of 2' beyond the waterline at the crossing and shall extend to the top of the crossing pipe

APPROVED:  
 \_\_\_\_\_ DATE \_\_\_\_\_  
 Manager and Chief Engineer, BWS  
 (for work affecting BWS facilities in City/State R/W & BWS easements only)

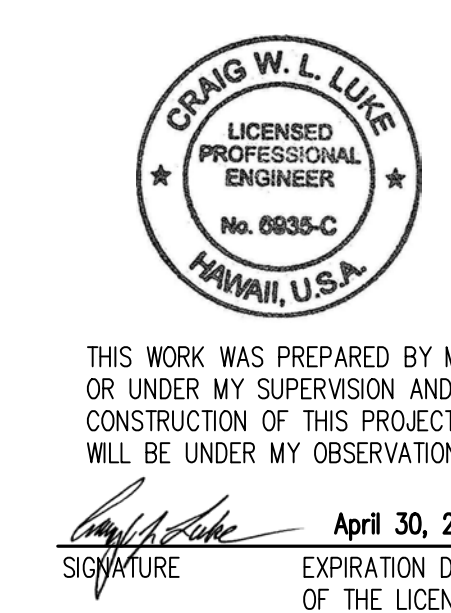

THIS WORK WAS PREPARED BY ME OR UNDER MY SUPERVISION AND CONSTRUCTION OF THIS PROJECT WILL BE UNDER MY OBSERVATION.  
 SIGNATURE: \_\_\_\_\_ EXPIRATION DATE OF THE LICENSE: April 30, 2024

07/15/22	Revised profiles
06/08/22	Revised profiles
DATE	REVISION

STATE OF HAWAII  
 DEPARTMENT OF TRANSPORTATION  
 HIGHWAYS DIVISION

**Waterlines Profile - 2**


FARRINGTON HIGHWAY WIDENING  
 Kapolei Golf Course Road to Fort Weaver Road  
 Project No. 7101A-01-20

Scale: As Shown Date: April 2022


SHEET NO. C-156 OF 767 SHEETS




FED. ROAD DIST. NO.	STATE	PROJ. NO.	FISCAL YEAR	SHEET NO.	TOTAL SHEETS
HAWAII	HAW.	7101A-01-20	2021	158	767

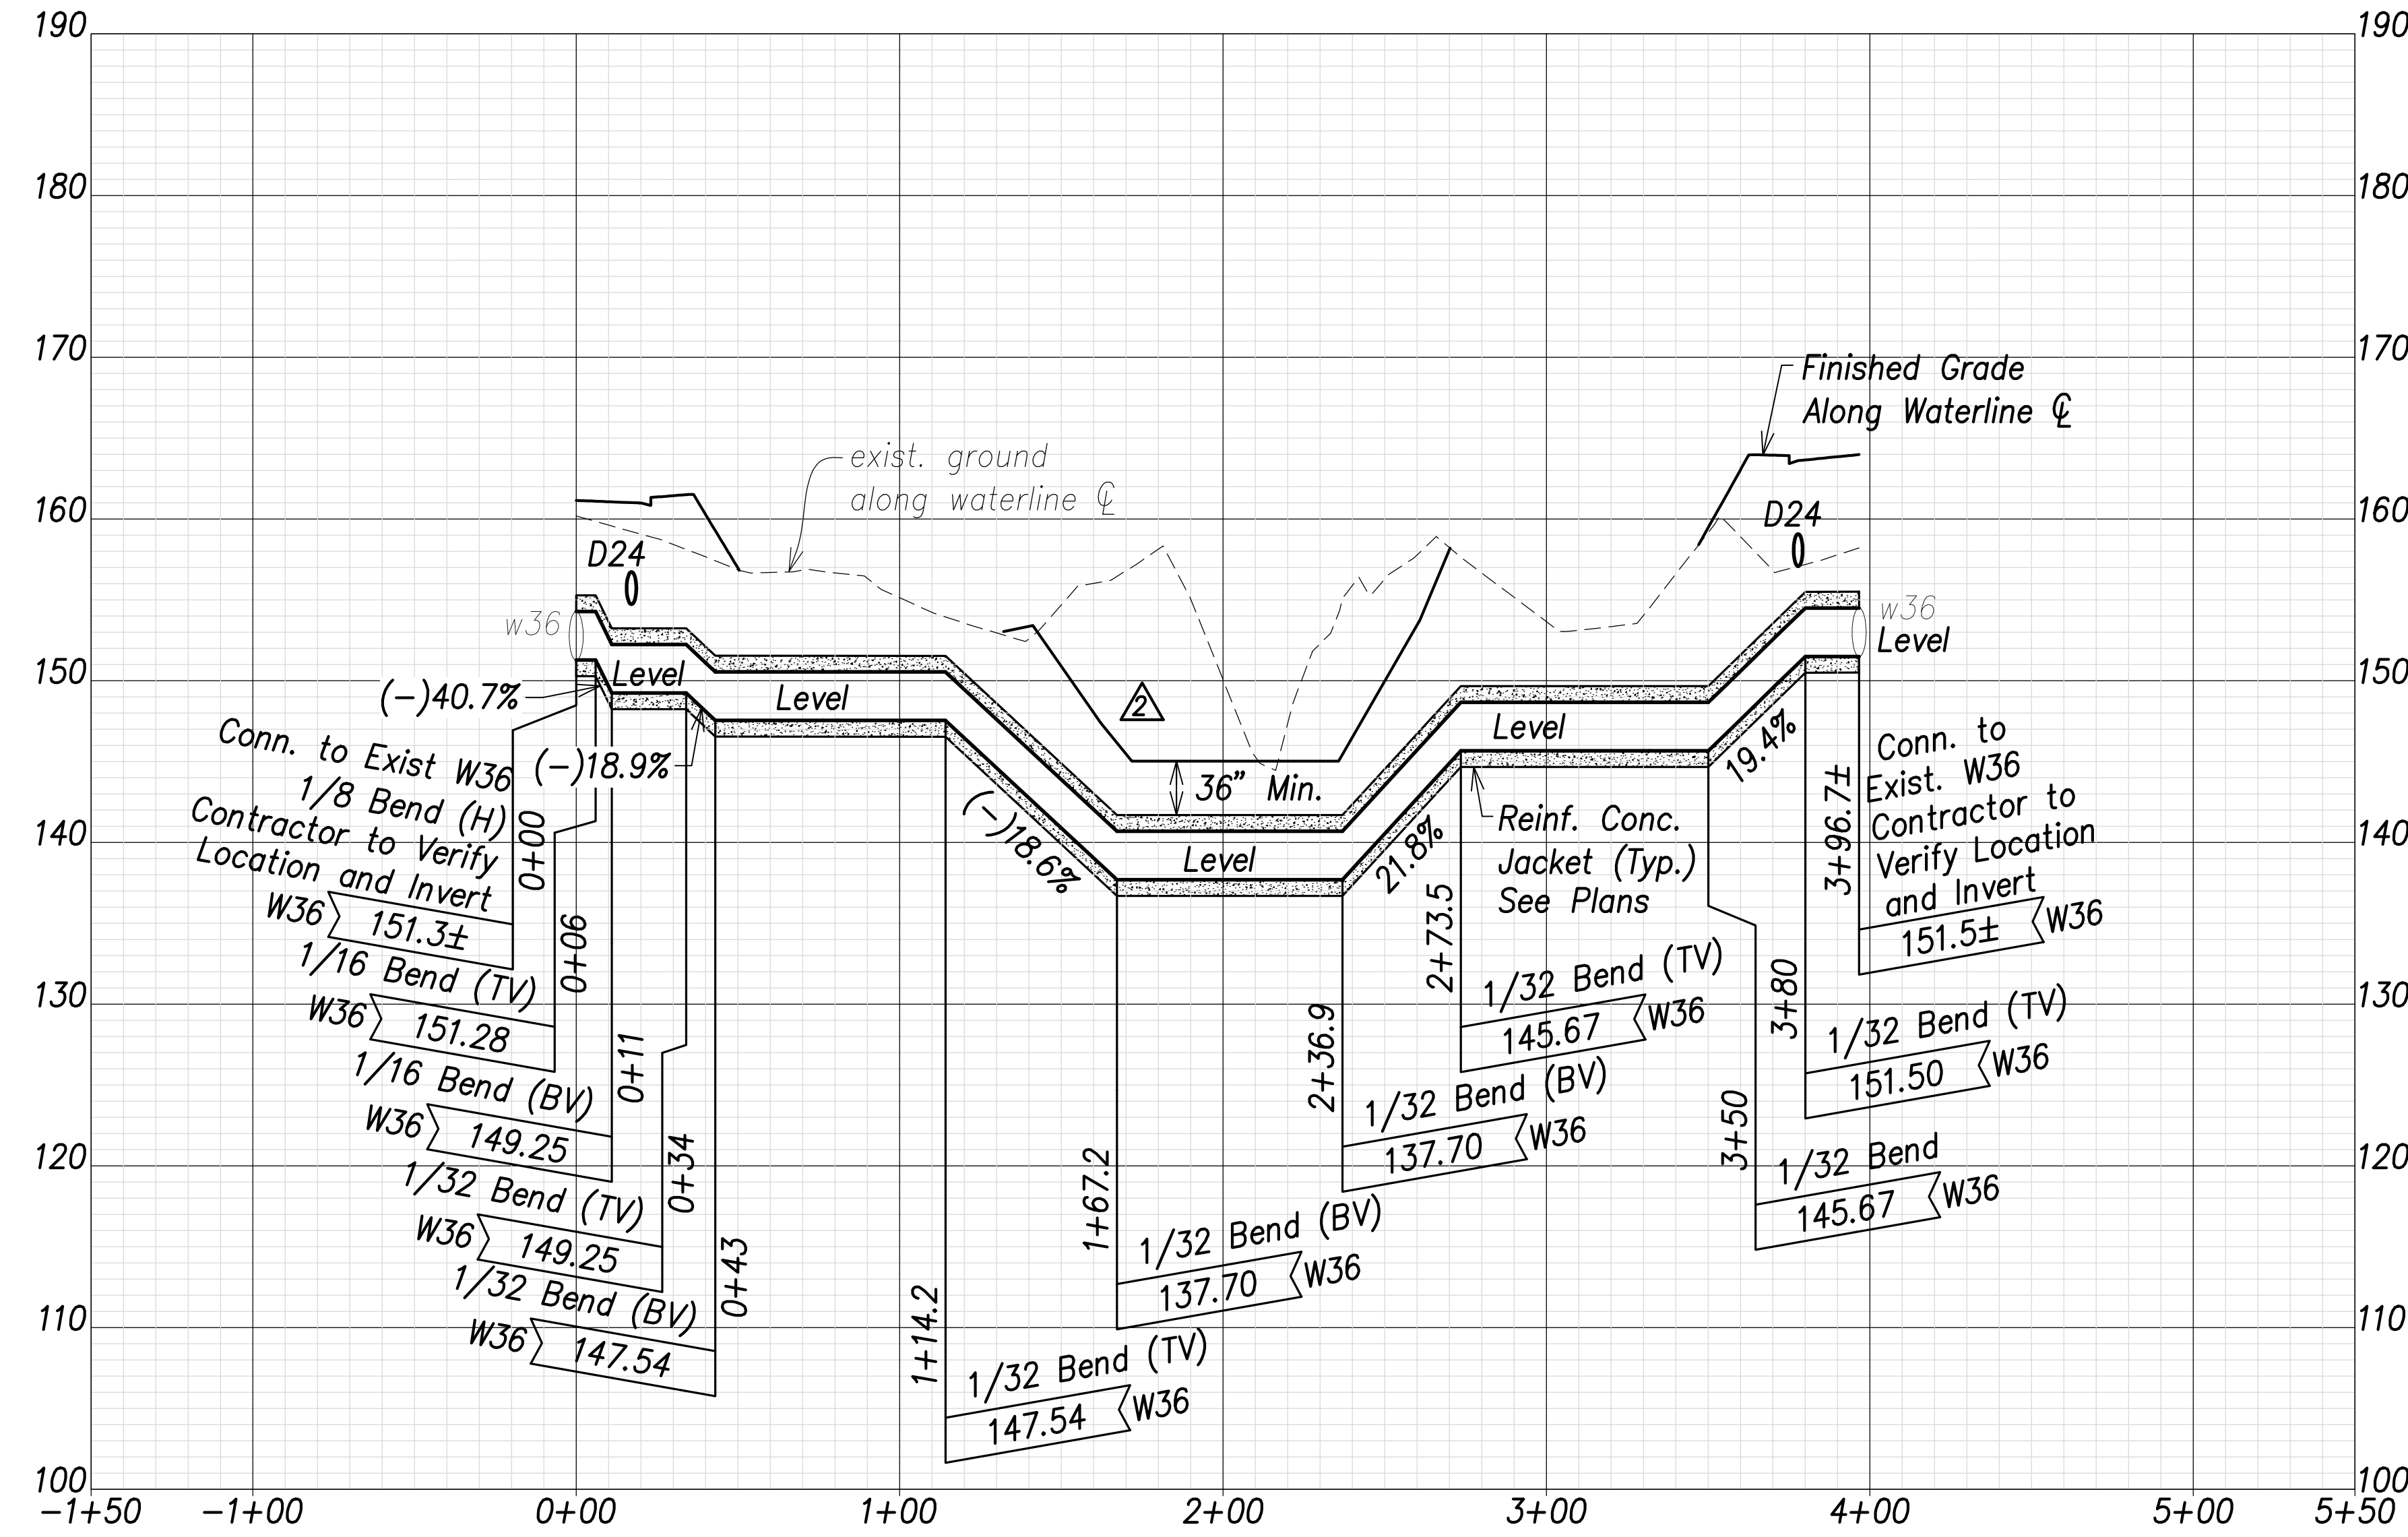

**Waterline H Profile**  
 (Sta. 61+78.5 Farrington Highway)  
 Scales: Hor.: 1" = 40'  
 Vert.: 1" = 8'

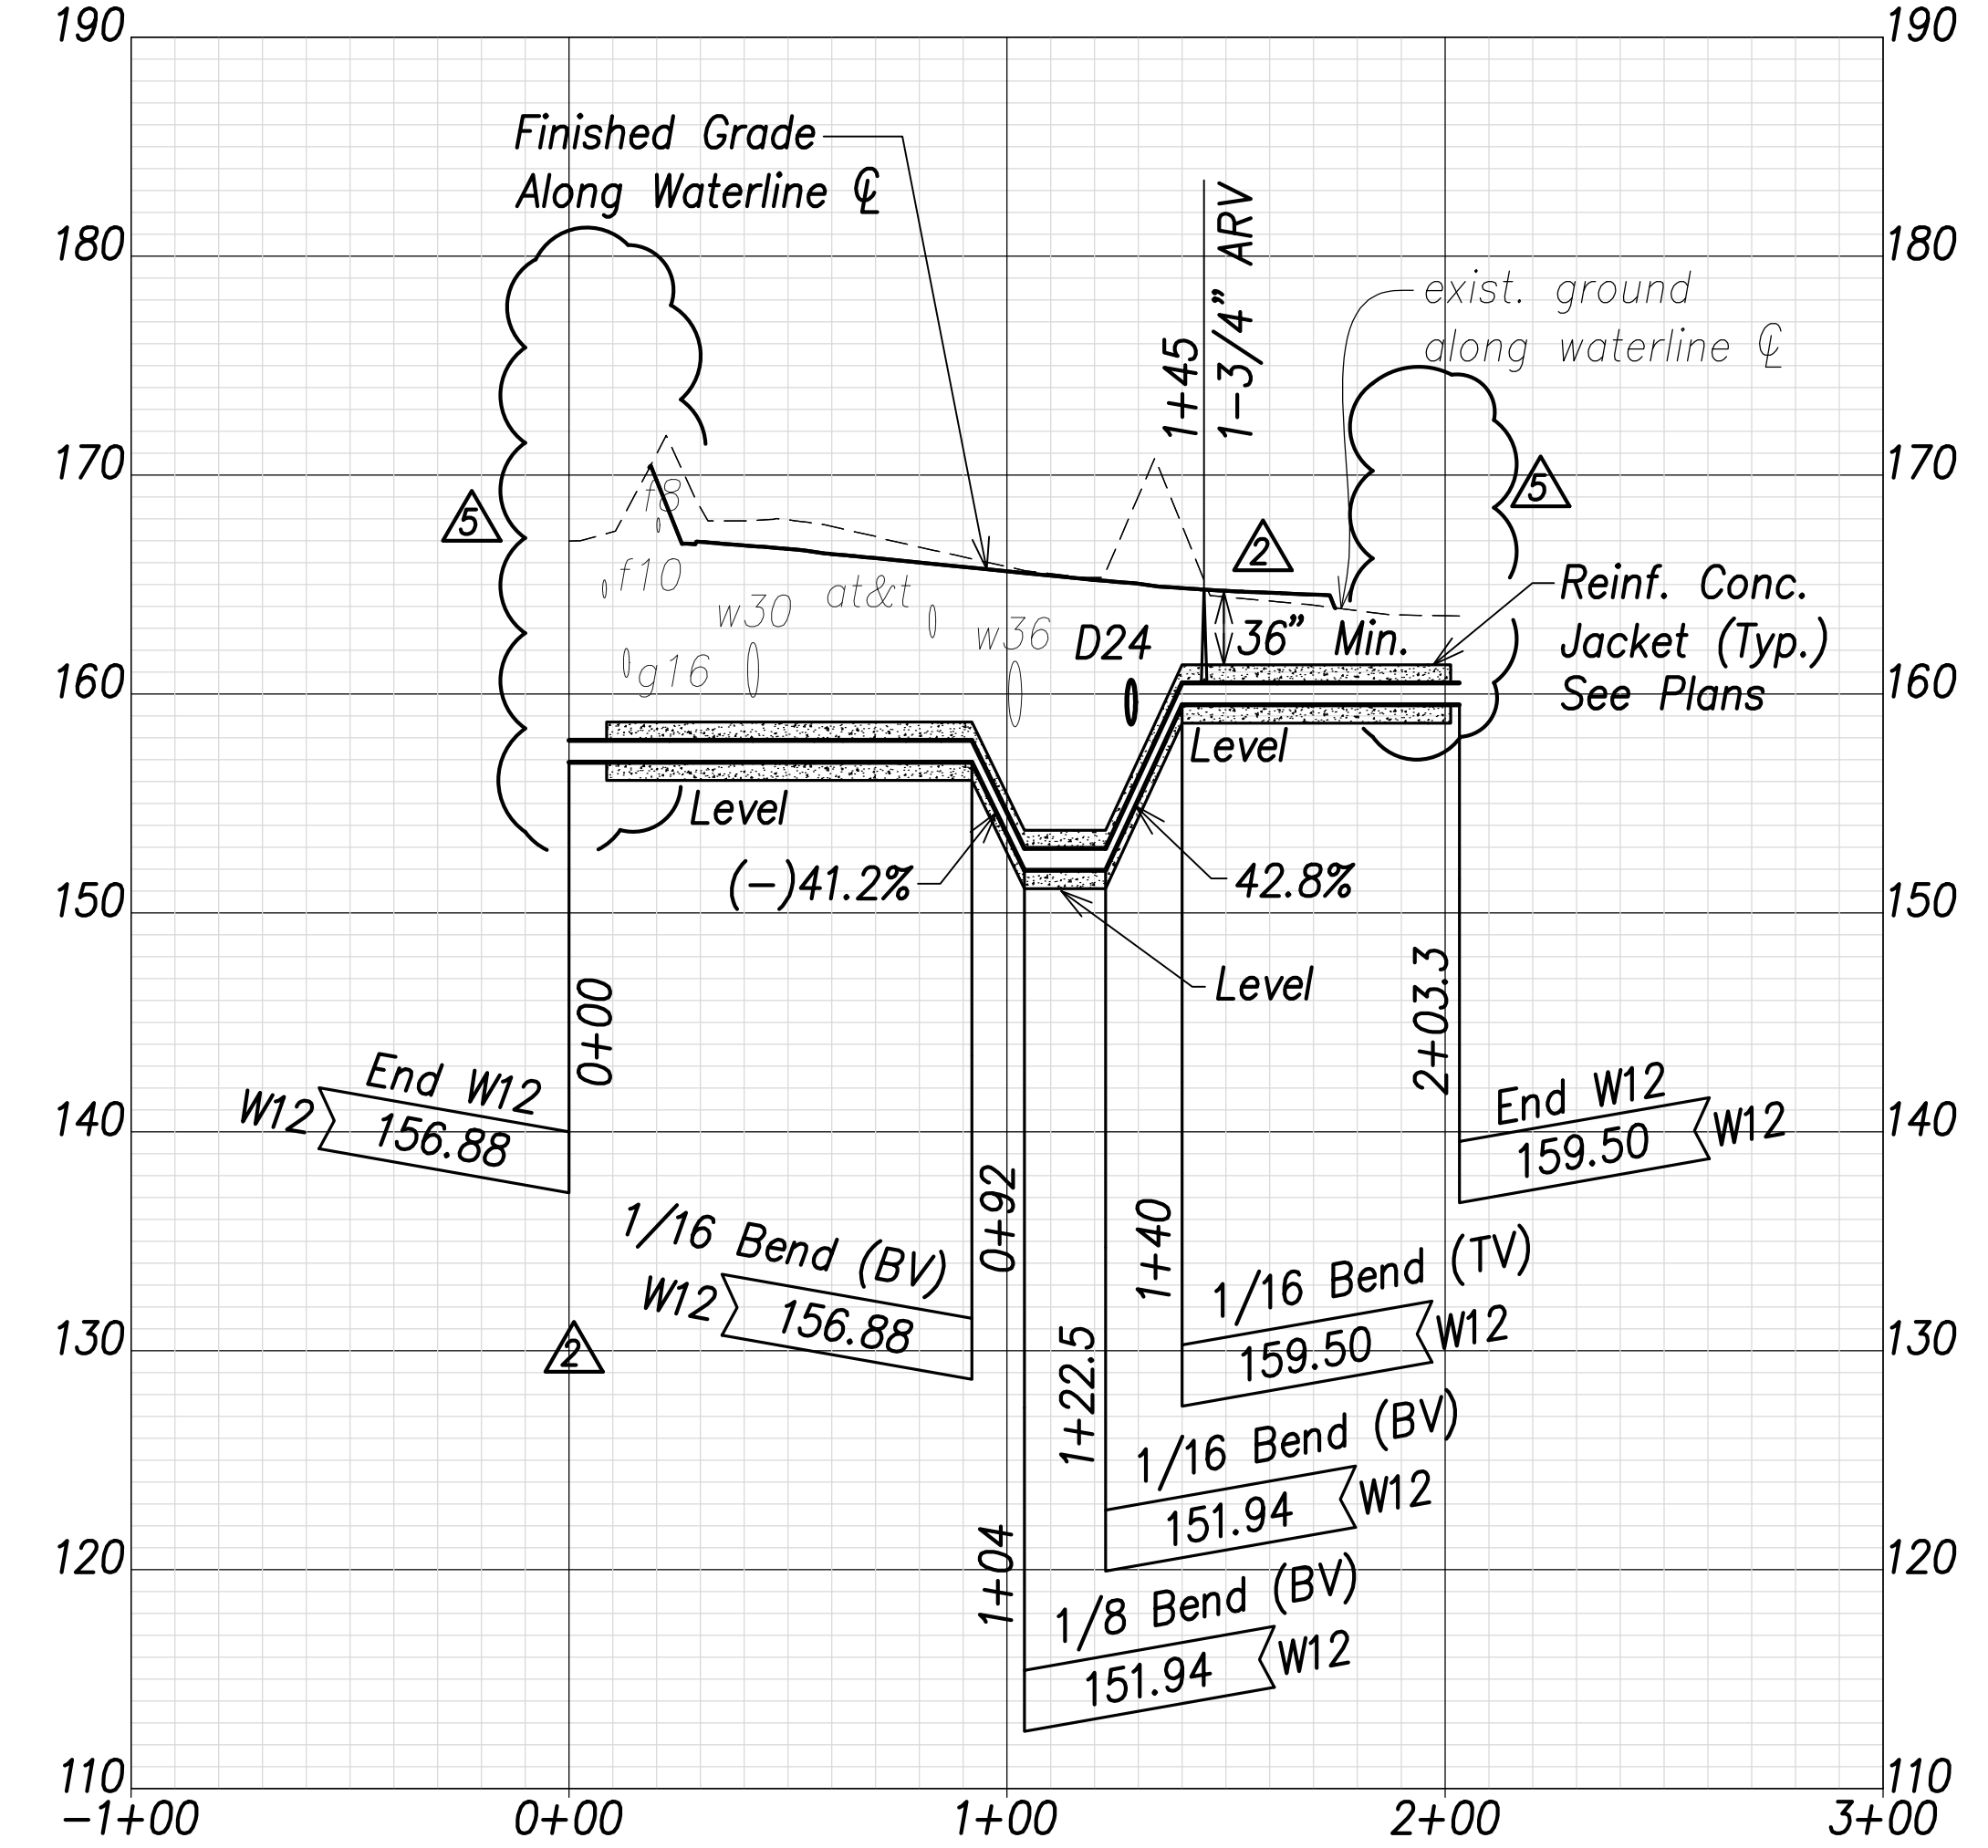

**Waterline J Profile**  
 (Sta. 72+91 Farrington Highway)  
 Scales: Hor.: 1" = 40'  
 Vert.: 1" = 8'

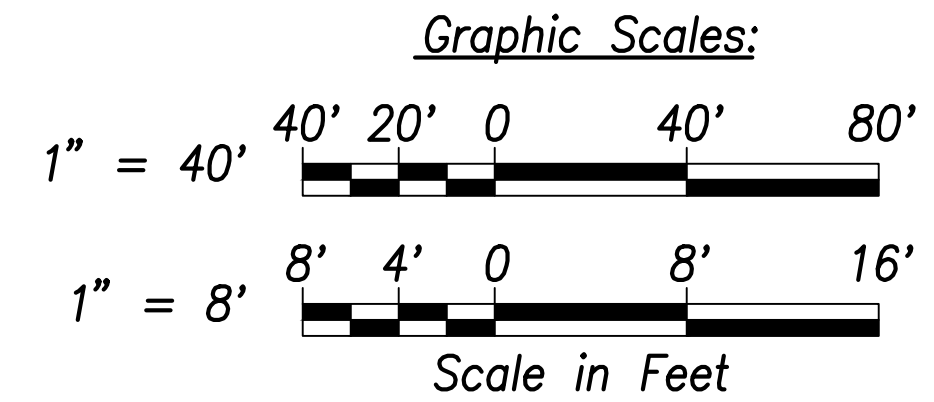

SURVEY PLOTTED BY	DATE
DRAWN BY	
TRACED BY	
QUANTITIES BY	
CHECKED BY	
ORIGINAL PLAN	
NOTE BOOK	
No.	

**Note:**  
 The Contractor shall provide Controlled Low Strength Material (CLSM) in areas where required compaction cannot be met. CLSM shall be extend a minimum of 2' beyond the waterline at the crossing and shall extend to the top of the crossing pipe

APPROVED:  
 \_\_\_\_\_ DATE \_\_\_\_\_  
 Manager and Chief Engineer, BWS  
 (for work affecting BWS facilities in City/State R/W & BWS easements only)



THIS WORK WAS PREPARED BY ME OR UNDER MY SUPERVISION AND CONSTRUCTION OF THIS PROJECT WILL BE UNDER MY OBSERVATION.  
 SIGNATURE: \_\_\_\_\_ DATE: April 30, 2024  
 EXPIRATION DATE OF THE LICENSE

07/15/22	5 CLSM Note Added, G.V. Removed, Jacket revised
06/08/22	2 Min. Cover Callout Added, revised profile
DATE	REVISION

STATE OF HAWAII  
 DEPARTMENT OF TRANSPORTATION  
 HIGHWAYS DIVISION


**Waterlines Profile - 3**

FARRINGTON HIGHWAY WIDENING  
 Kapolei Golf Course Road to Fort Weaver Road  
 Project No. 7101A-01-20


Scale: As Shown      Date: April 2022

SHEET NO. C-157 OF 767 SHEETS


FED. ROAD DIST. NO.	STATE	PROJ. NO.	FISCAL YEAR	SHEET NO.	TOTAL SHEETS
HAWAII	HAW.	7101A-01-20	2021	159	767

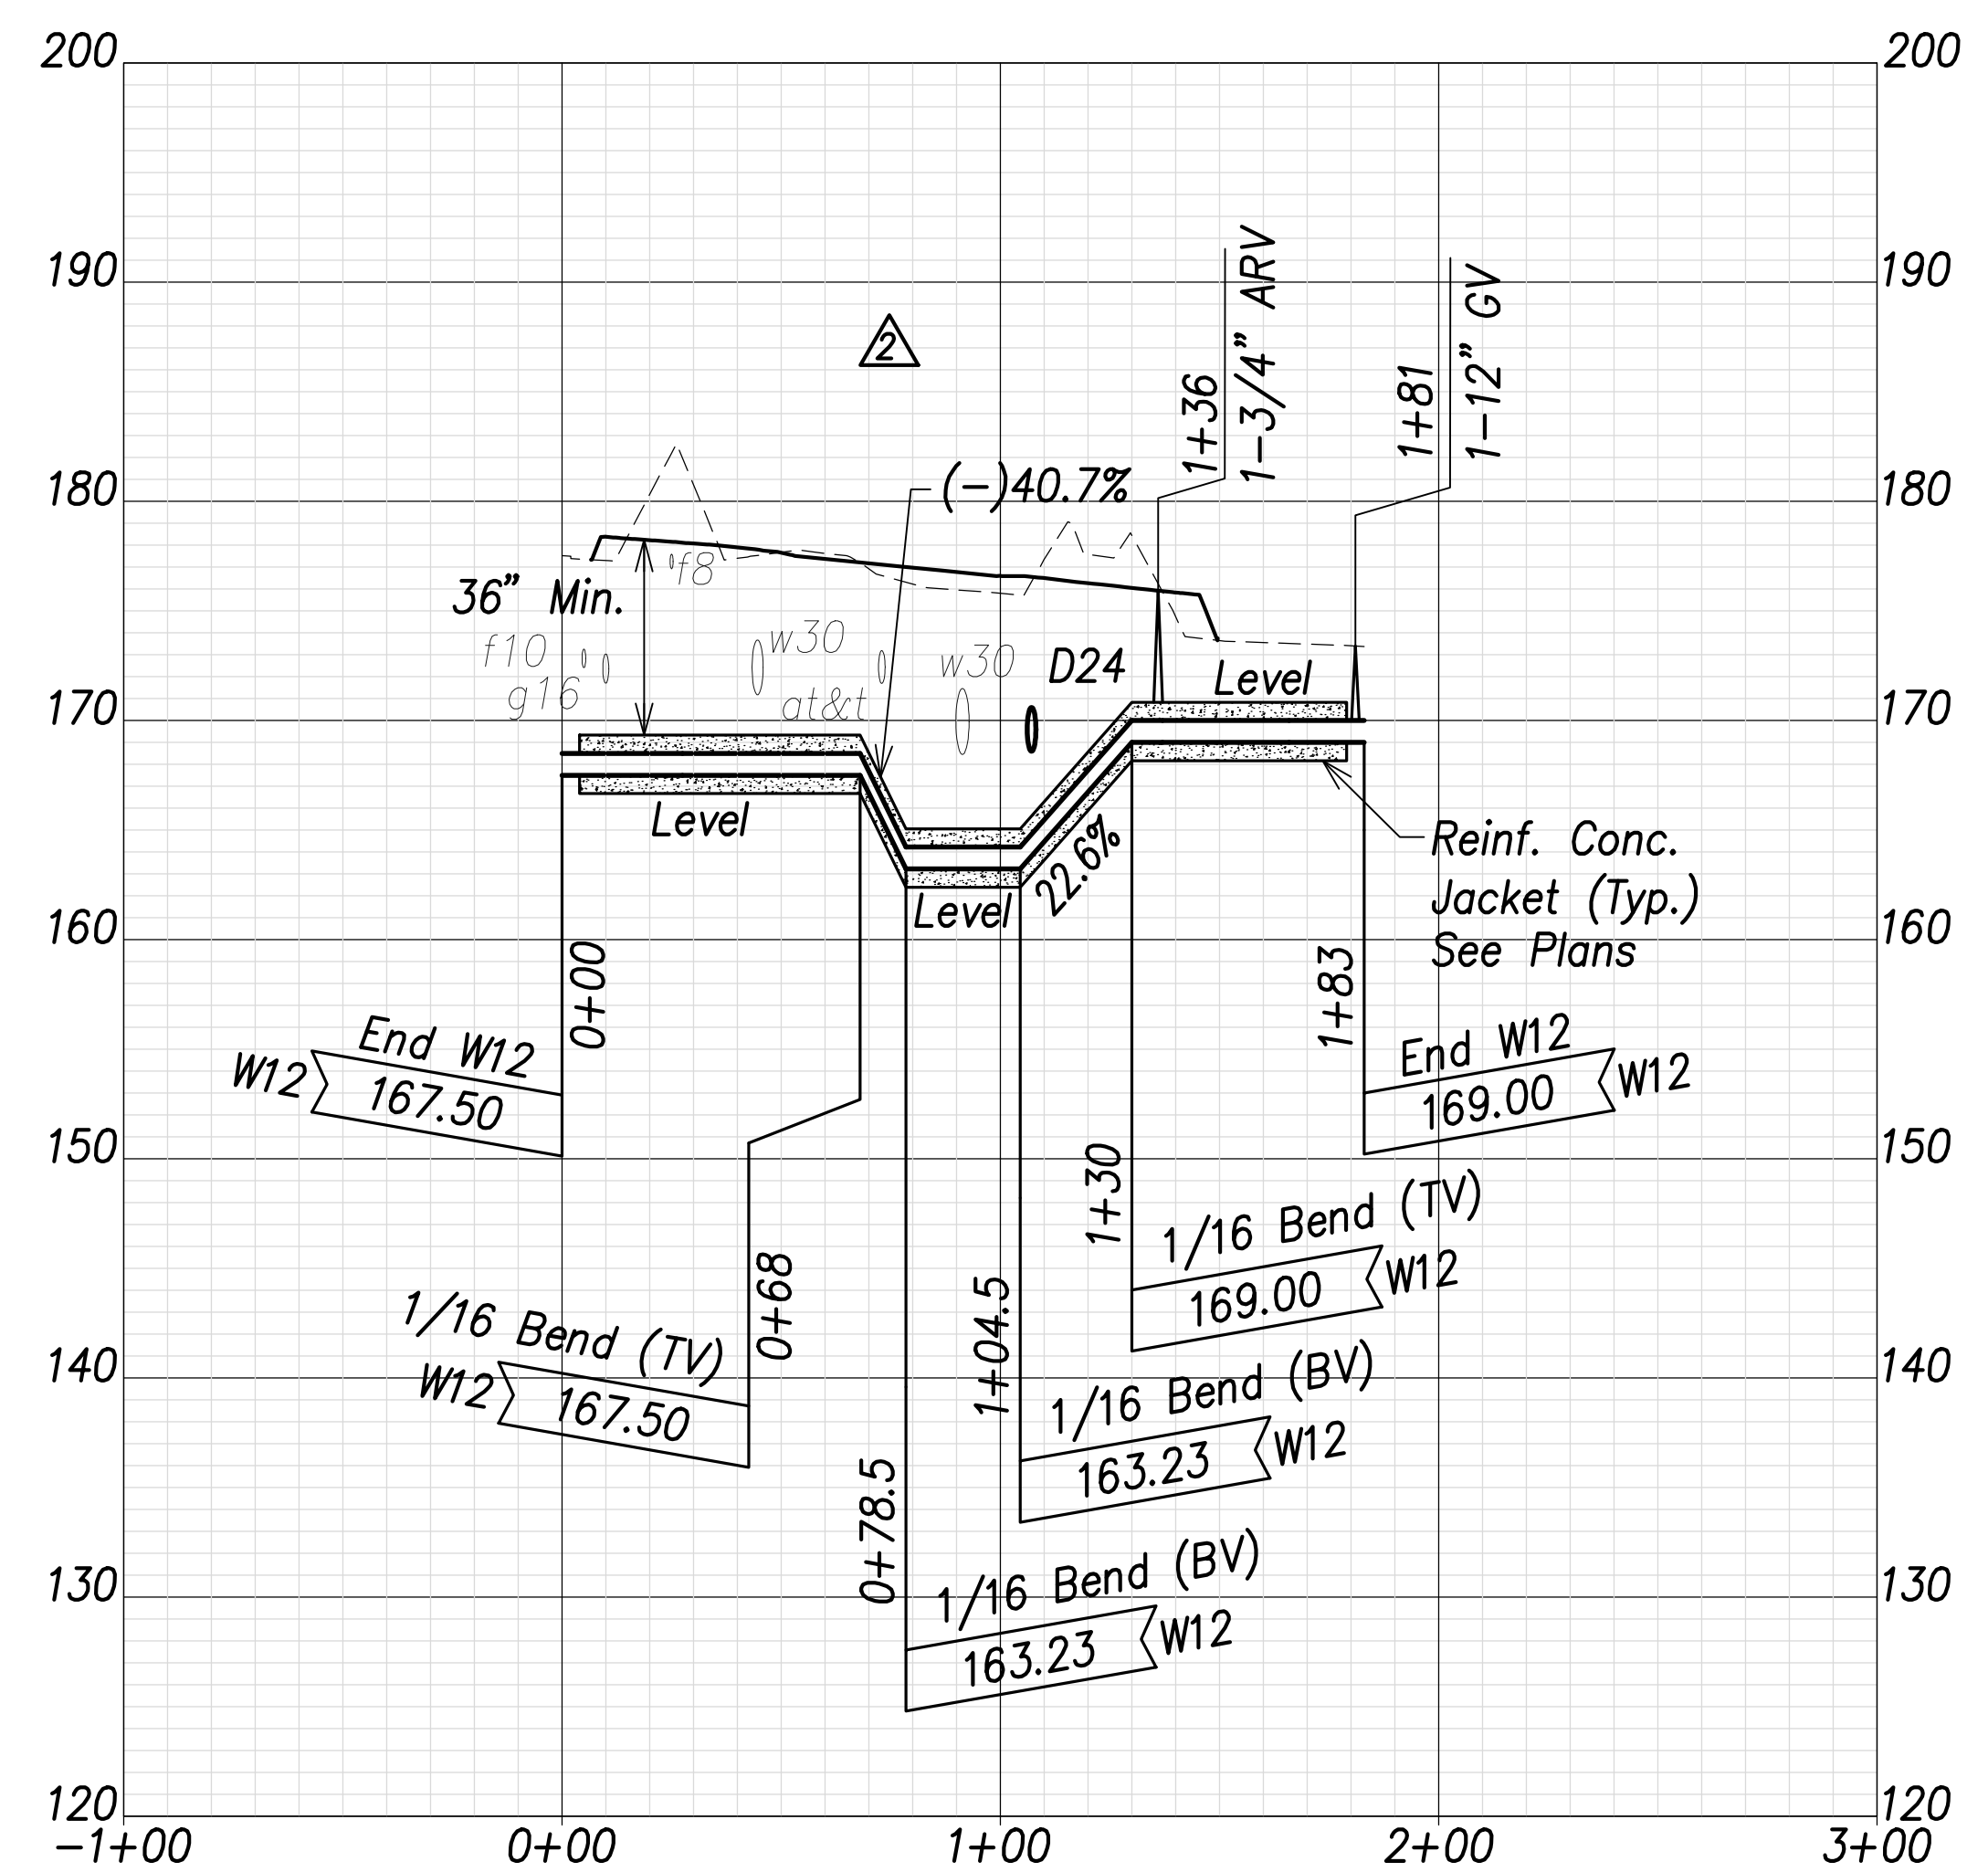


**Waterline K Profile (Sta. 98+71 Farrington Highway)**  
 Scales: Hor.: 1" = 40'  
 Vert.: 1" = 8'

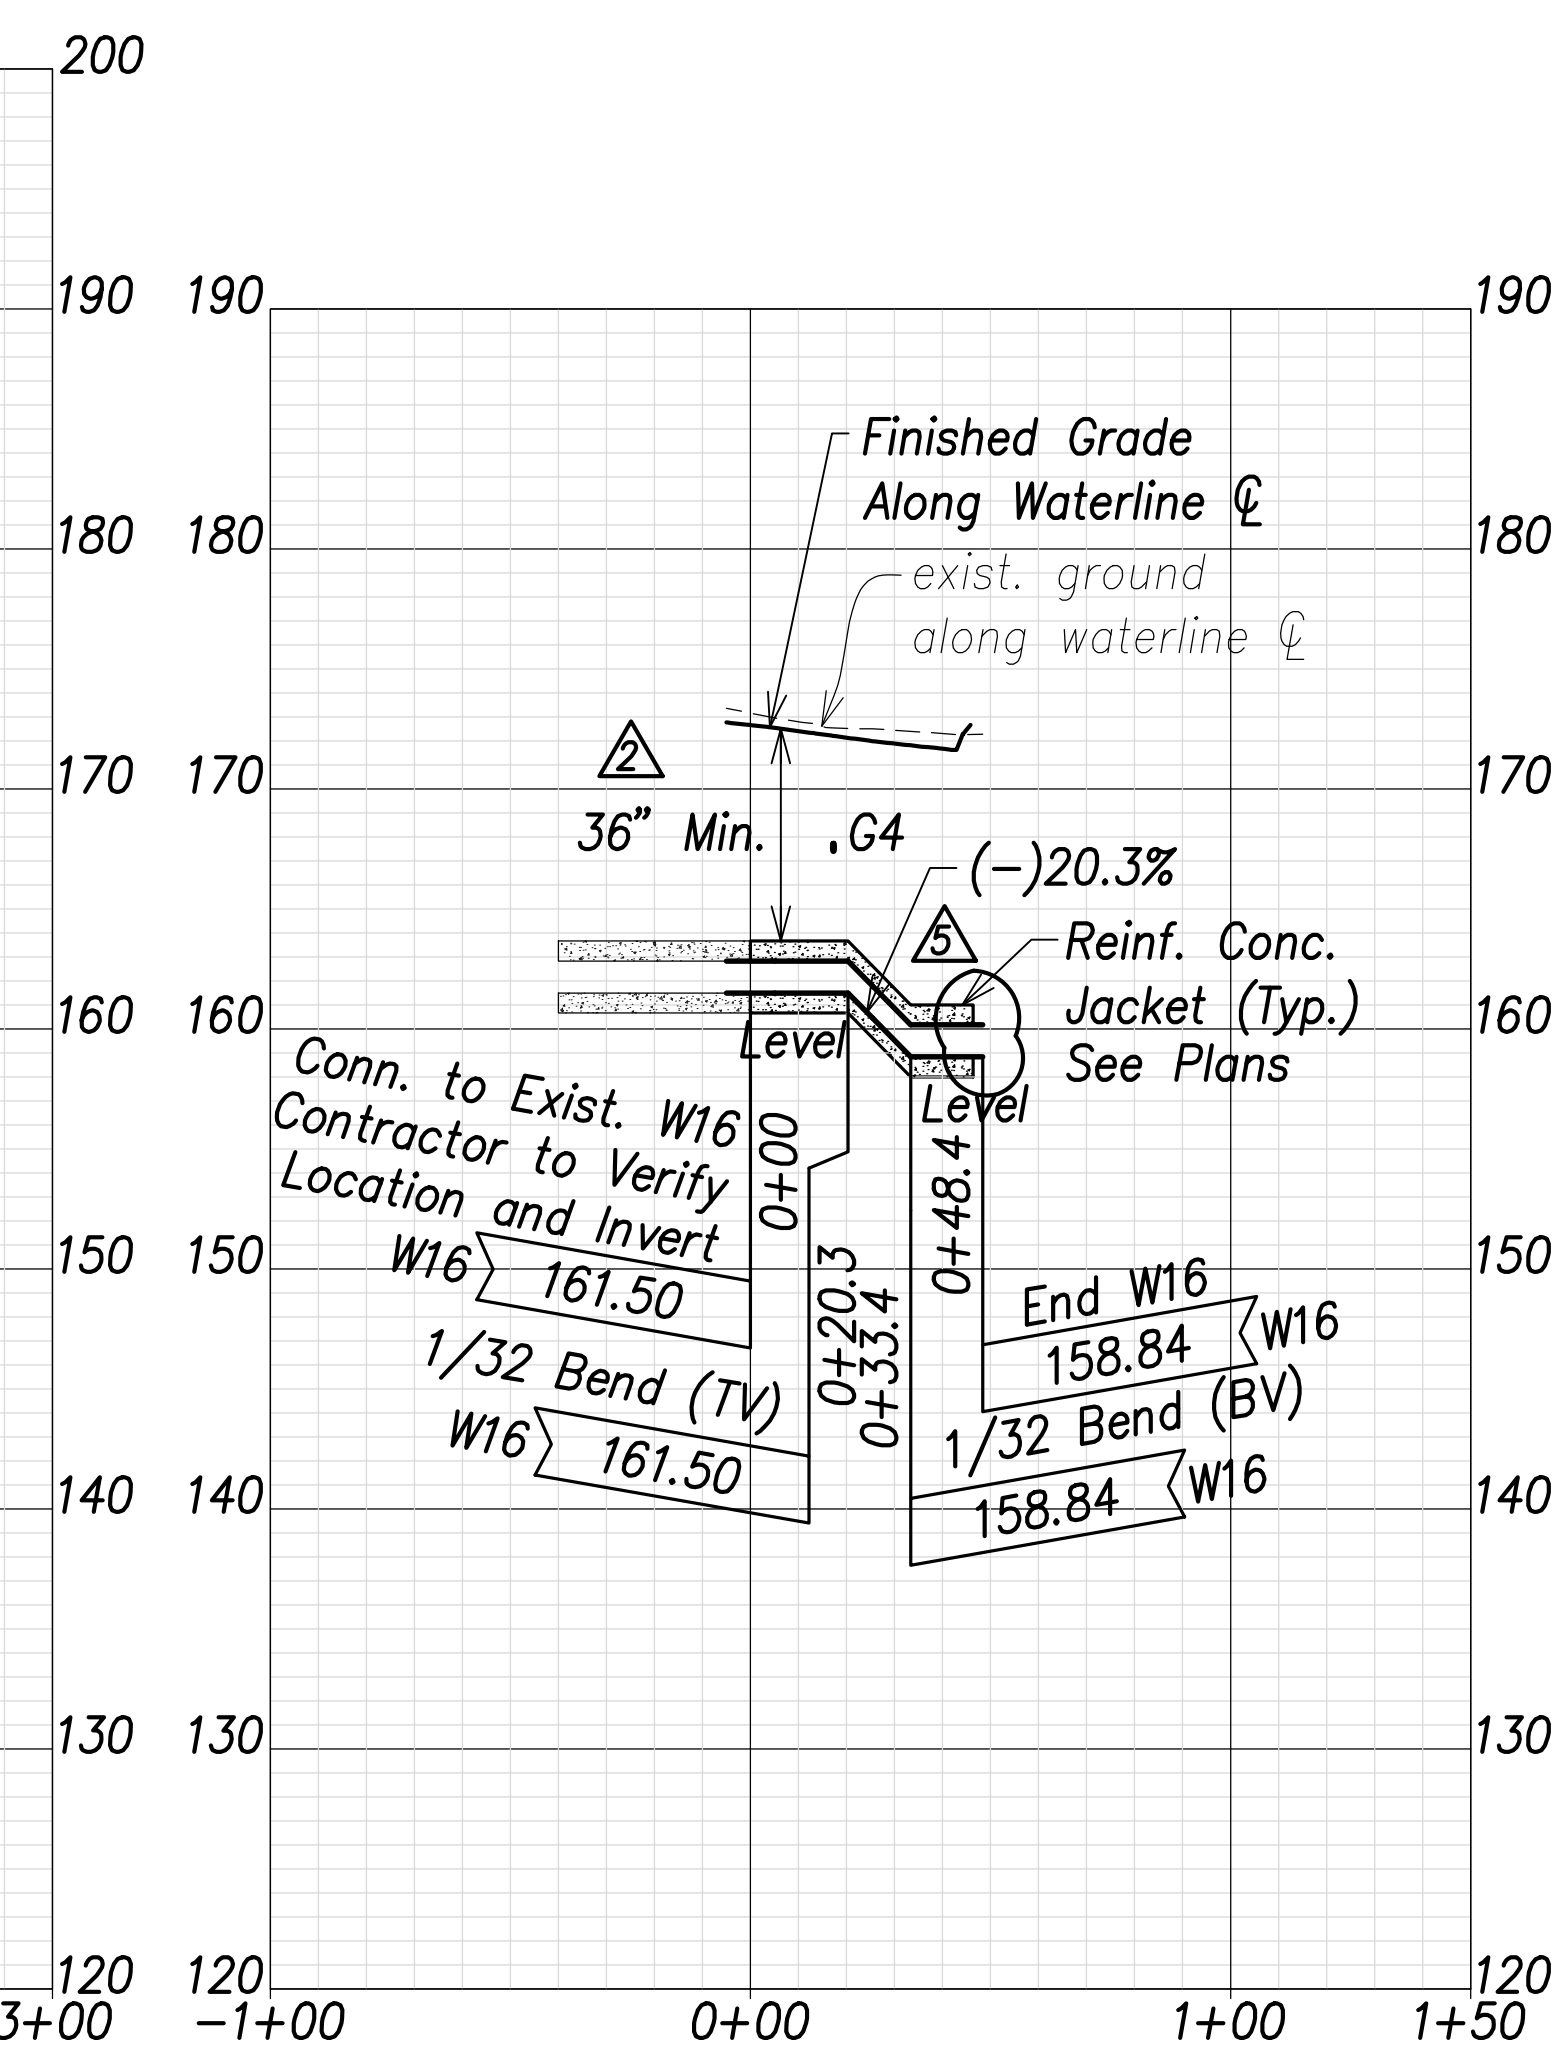

**Waterline L Profile (Sta. 112+29 Farrington Highway)**  
 Scales: Hor.: 1" = 40'  
 Vert.: 1" = 8'

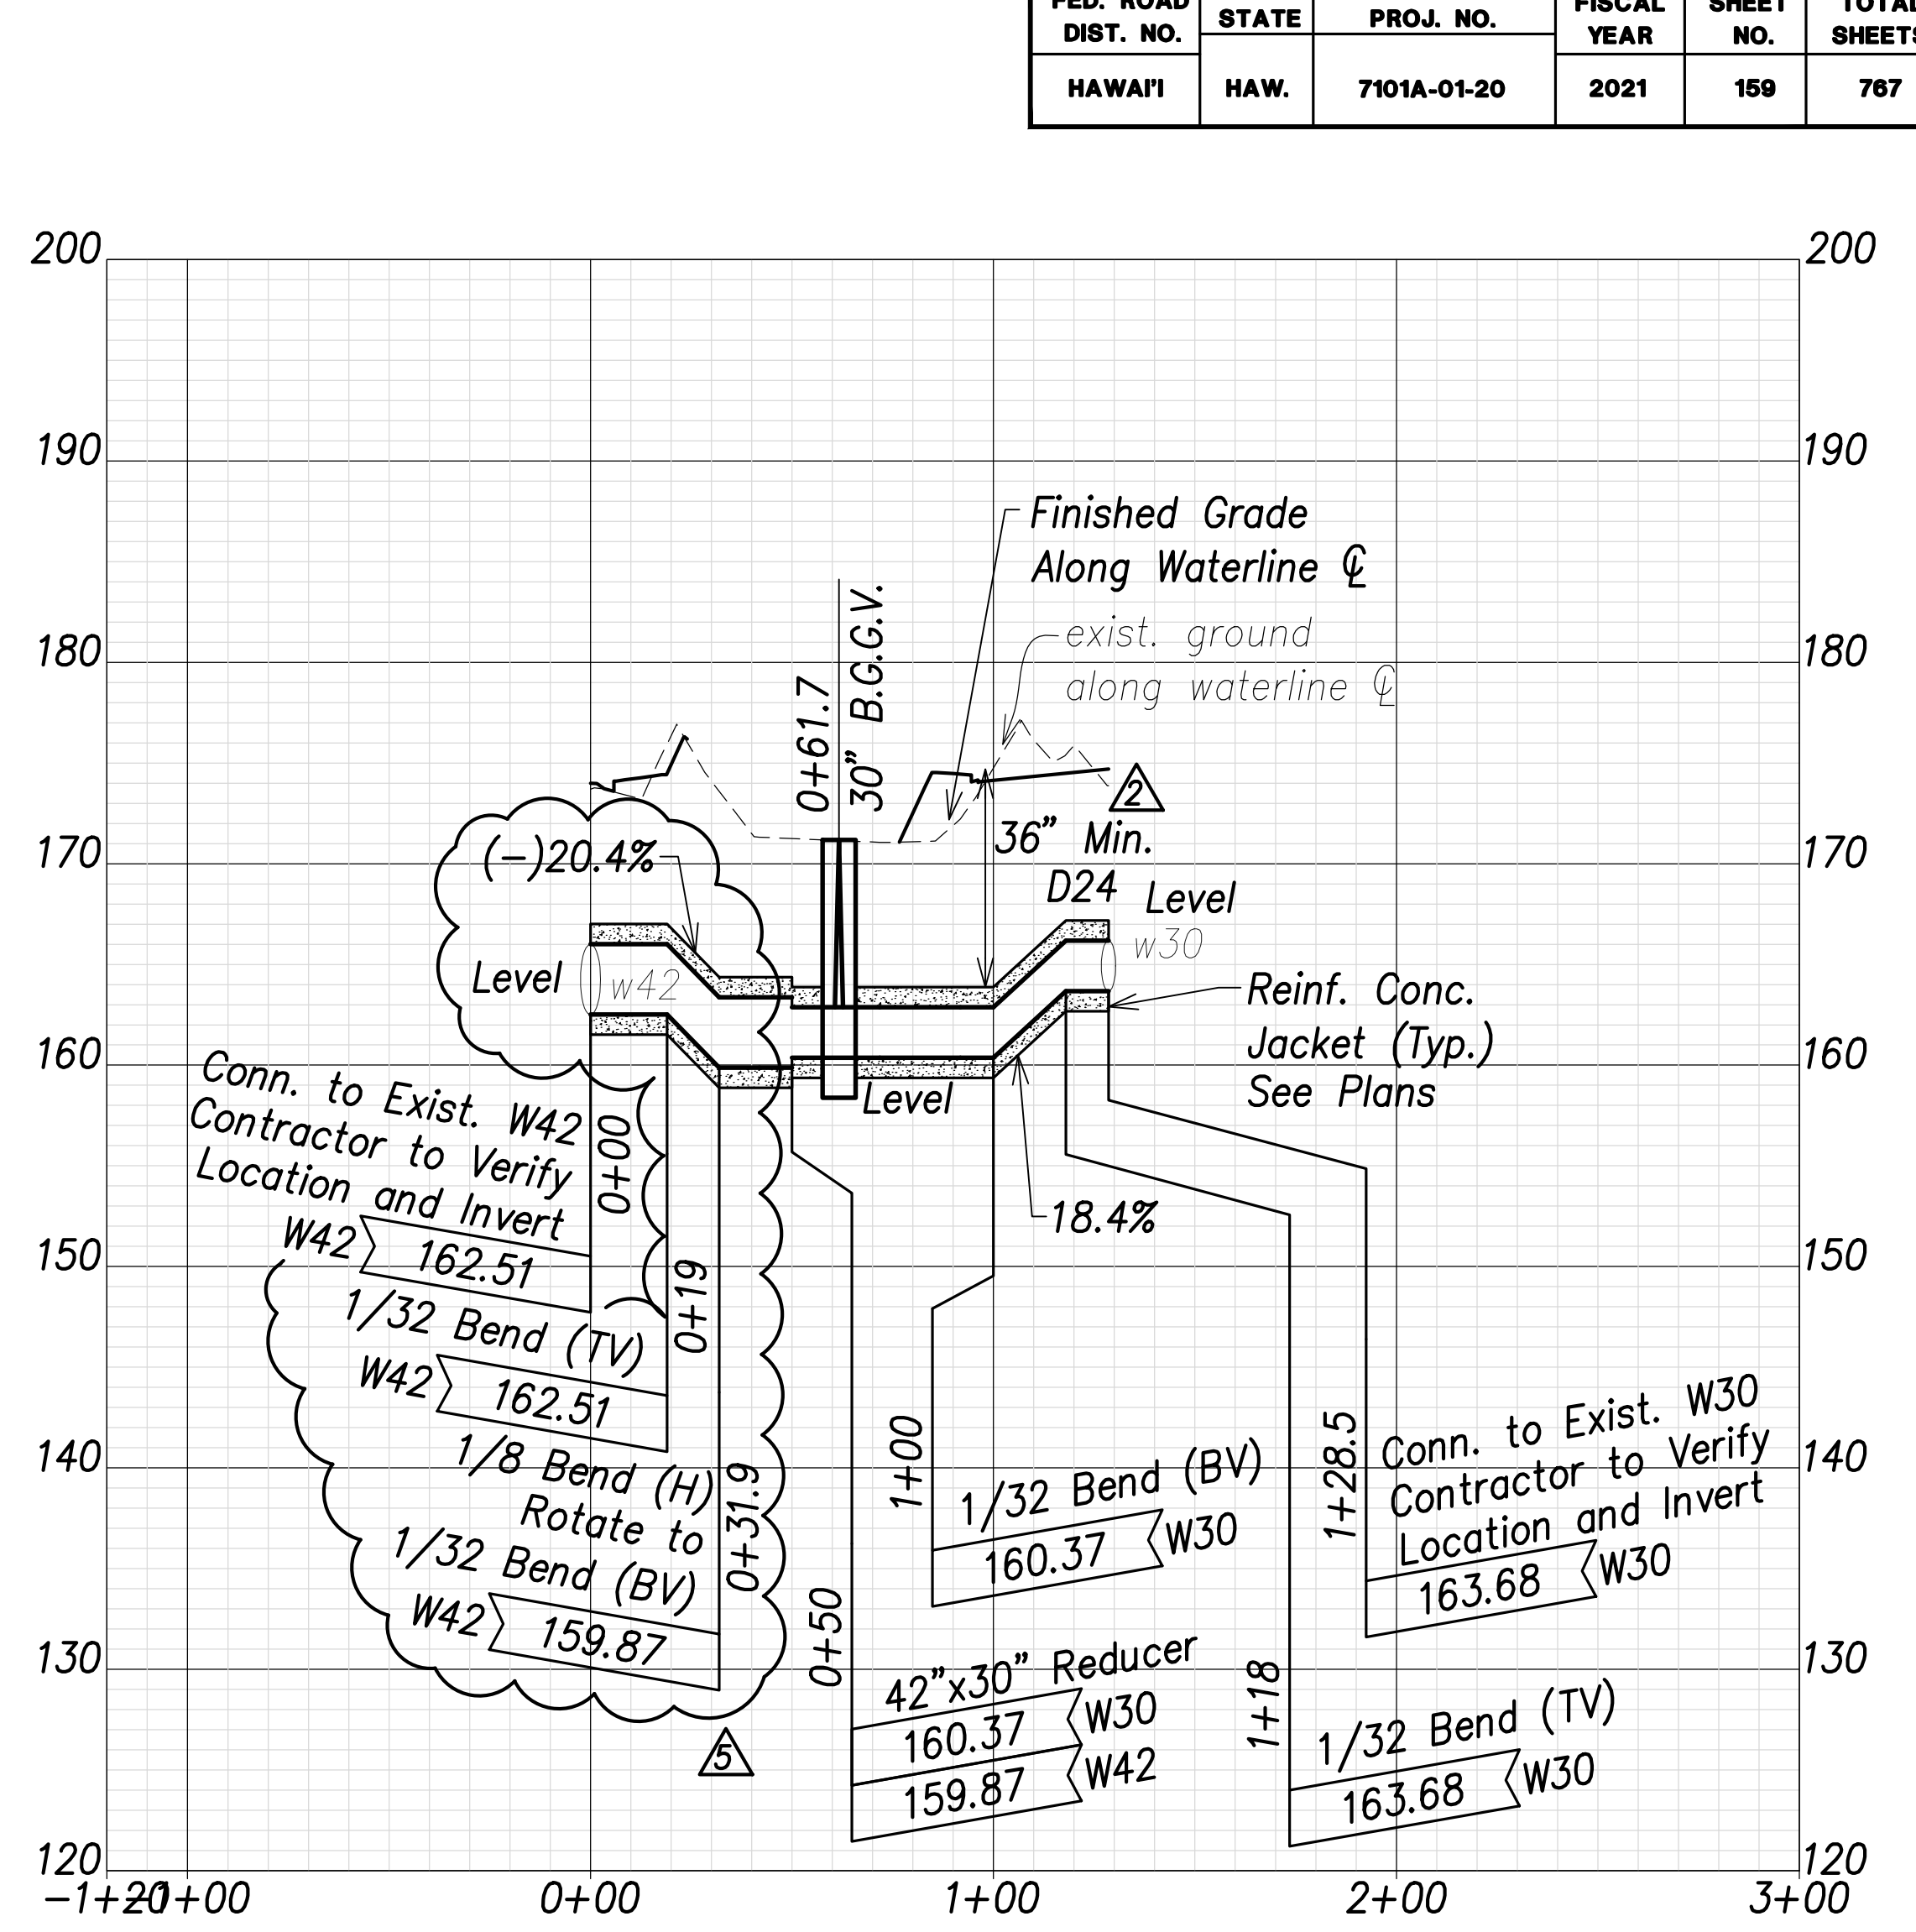

**Waterline M Profile (Sta. 113+32.7 Farrington Highway)**  
 Scales: Hor.: 1" = 40'  
 Vert.: 1" = 8'

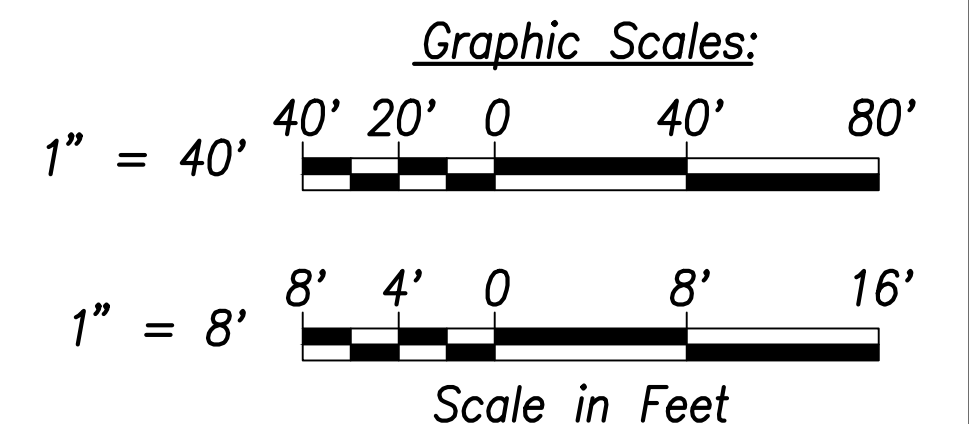

SURVEY PLOTTED BY	DATE
DRAWN BY	
TRACED BY	
QUANTITIES BY	
CHECKED BY	
ORIGINAL PLAN NOTE BOOK No.	

APPROVED:  
 \_\_\_\_\_ DATE \_\_\_\_\_  
 Manager and Chief Engineer, BWS  
 (for work affecting BWS facilities in City/State R/W & BWS easements only)

**Note:**  
 The Contractor shall provide Controlled Low Strength Material (CLSM) in areas where required compaction cannot be met. CLSM shall be extend a minimum of 2' beyond the waterline at the crossing and shall extend to the top of the crossing pipe



THIS WORK WAS PREPARED BY ME OR UNDER MY SUPERVISION AND CONSTRUCTION OF THIS PROJECT WILL BE UNDER MY OBSERVATION.  
 SIGNATURE: \_\_\_\_\_ EXPIRATION DATE OF THE LICENSE: April 30, 2024

DATE	REVISION
07/15/22	5 Reinf. Conc. Jacket pulled back 2'; Revised Waterline M Profile
06/08/22	2 Revised profile


STATE OF HAWAII  
**DEPARTMENT OF TRANSPORTATION**  
 HIGHWAYS DIVISION

**Waterlines Profile - 4**


FARRINGTON HIGHWAY WIDENING  
 Kapolei Golf Course Road to Fort Weaver Road  
 Project No. 7101A-01-20

Scale: As Shown Date: April 2022


FED. ROAD DIST. NO.	STATE	PROJ. NO.	FISCAL YEAR	SHEET NO.	TOTAL SHEETS
HAWAII	HAW.	7101A-01-20	2021	160	767

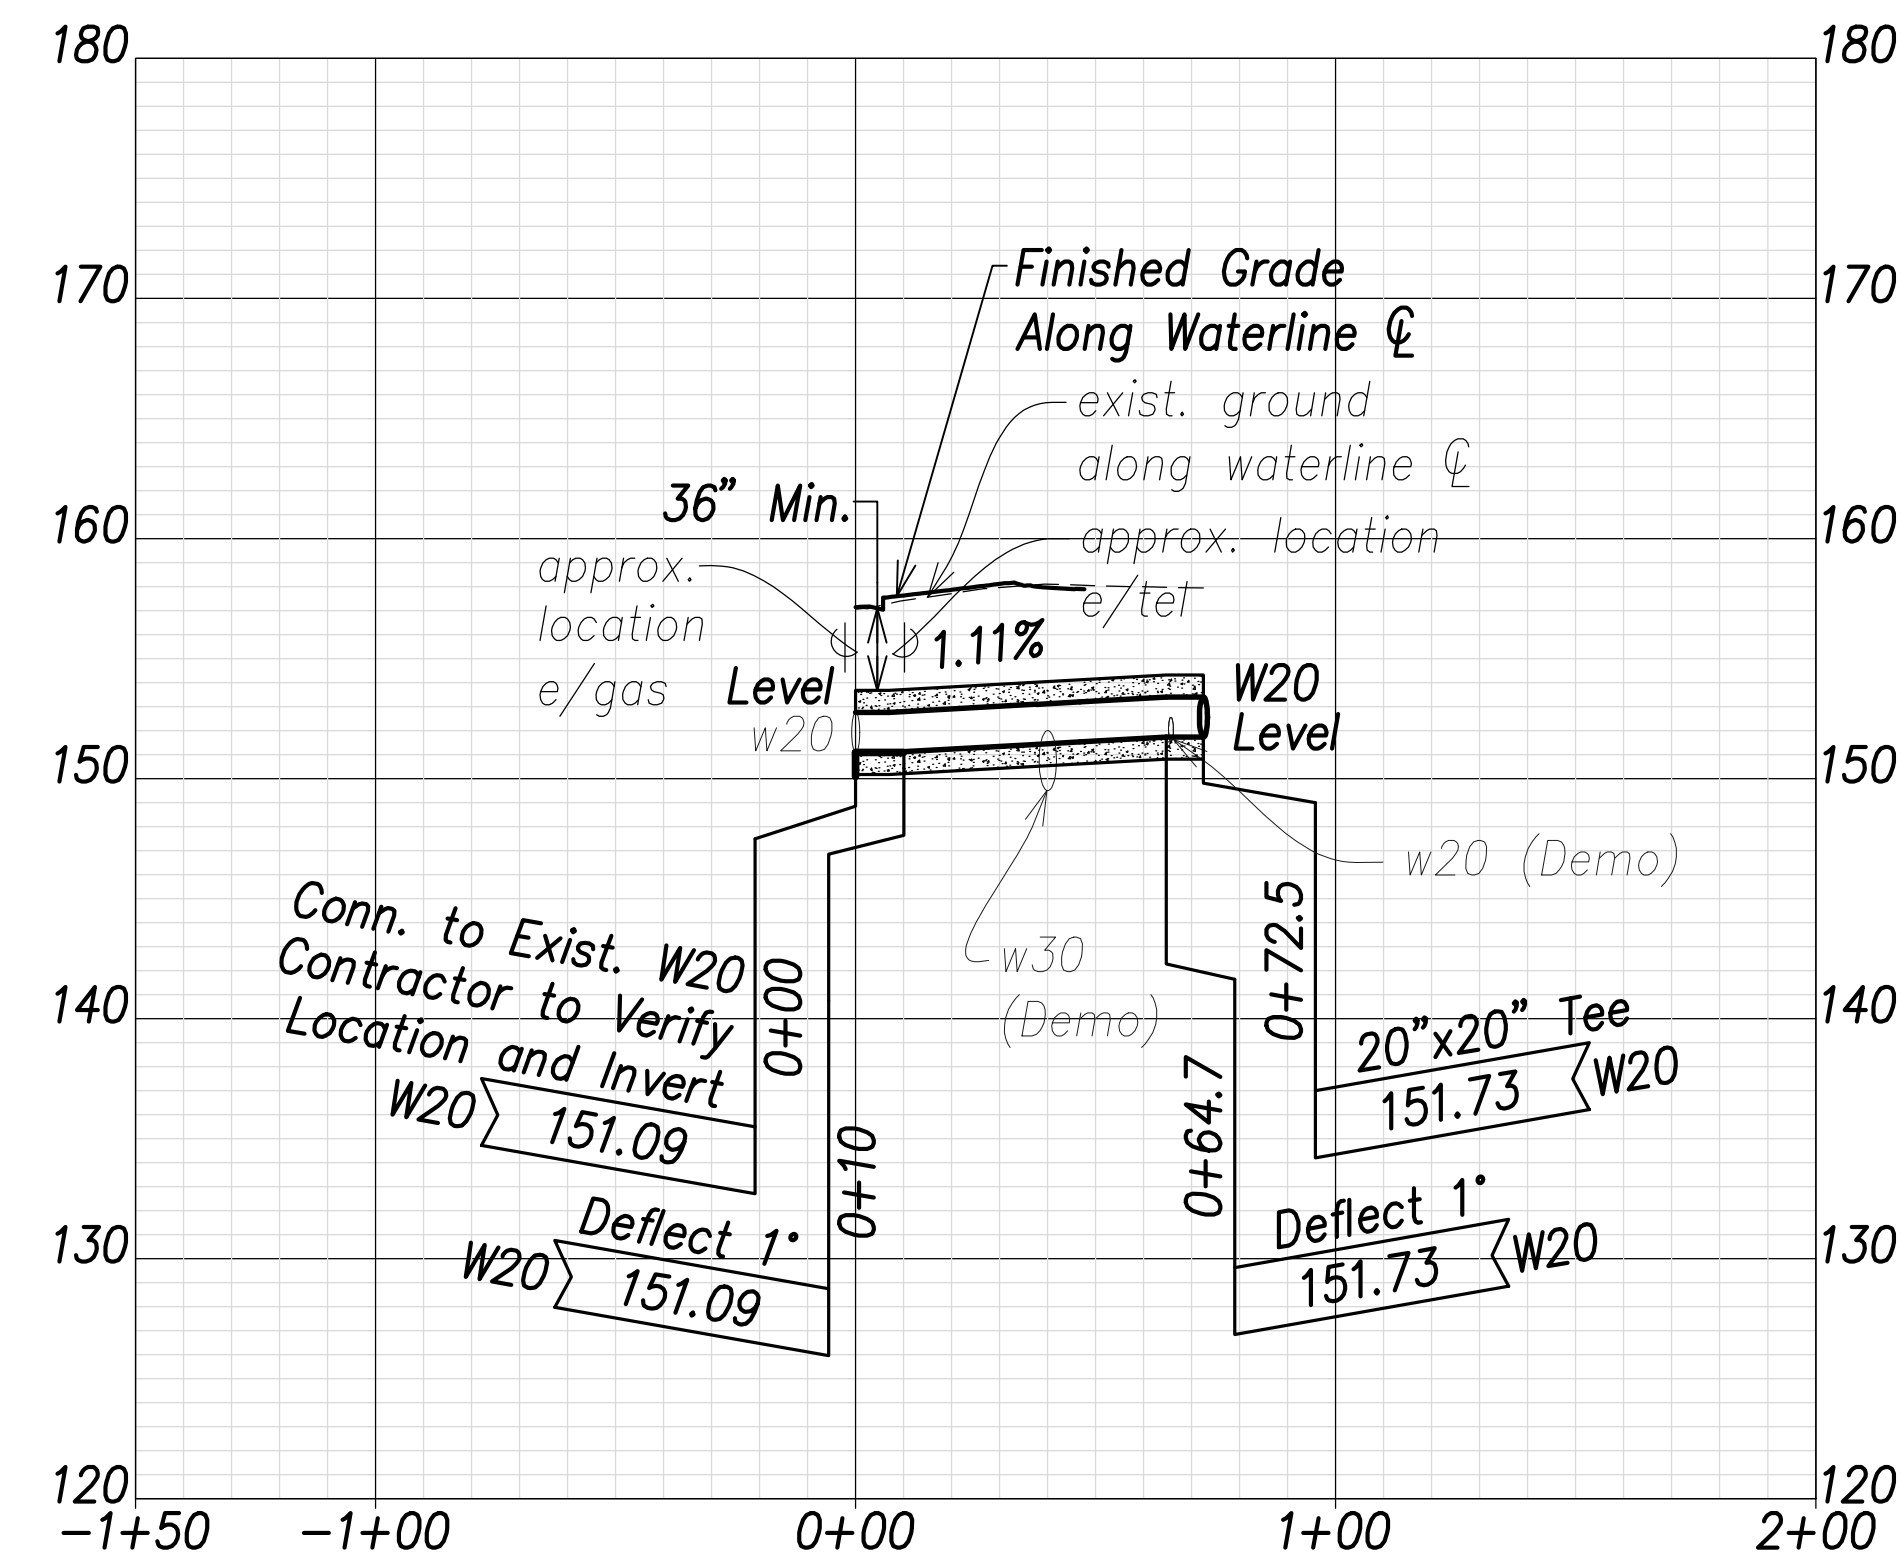

**Waterline N Profile**  
 (Sta. 58+32.4 Farrington Highway)  
 Scales: Hor.: 1" = 40'  
 Vert.: 1" = 8'

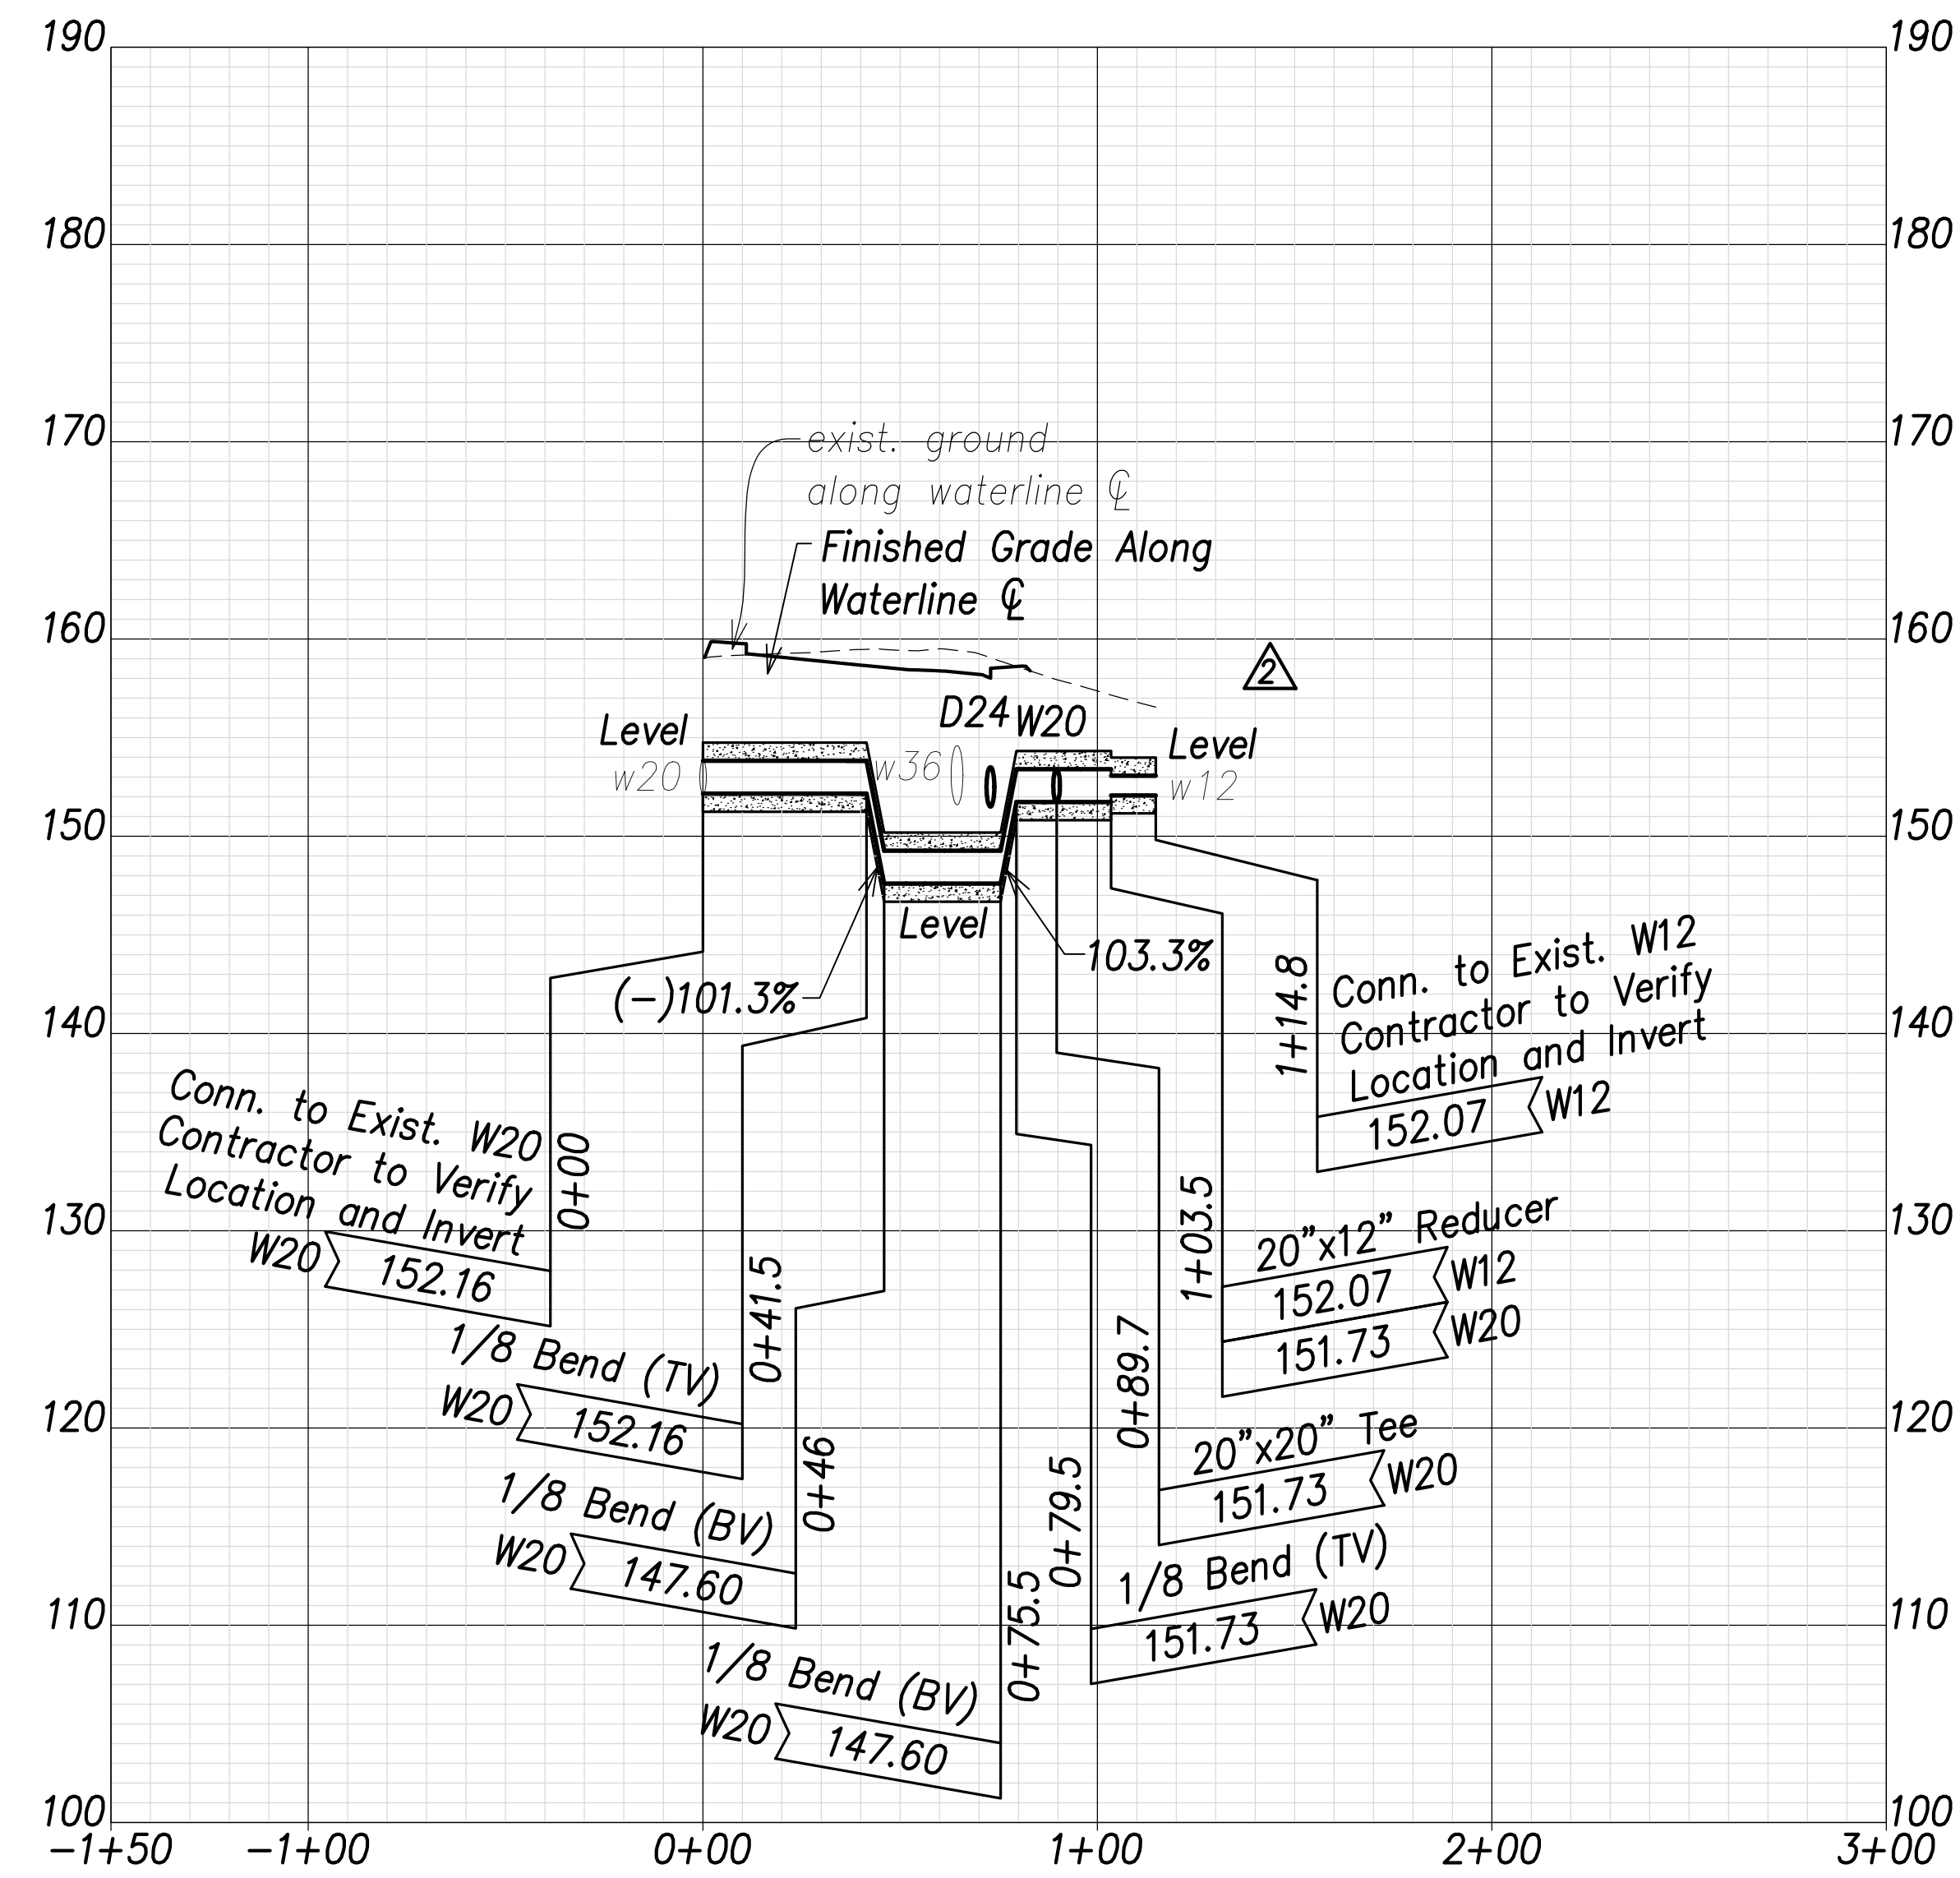


**Waterline P Profile**  
 (Sta. 58+67.5 Farrington Highway)  
 Scales: Hor.: 1" = 40'  
 Vert.: 1" = 8'

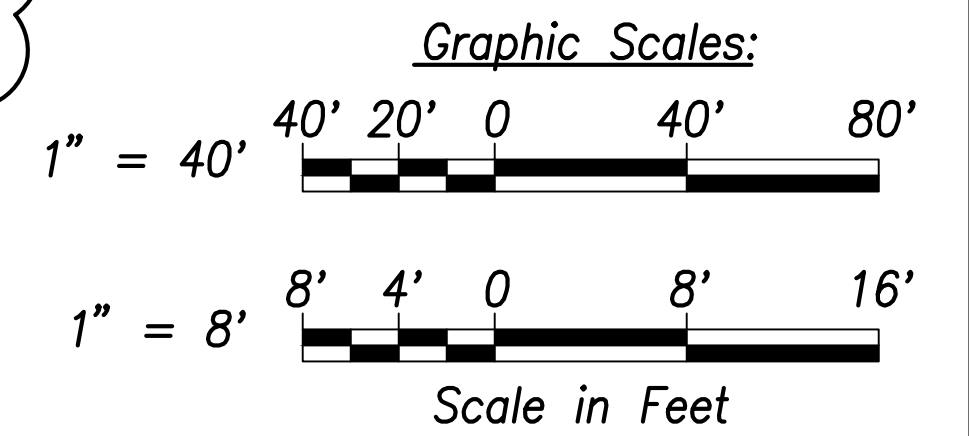

SURVEY PLOTTED BY	DATE
DRAWN BY	
TRACED BY	
CHECKED BY	
ORIGINAL PLAN	
NOTE BOOK	
No.	

**Note:**  
 The Contractor shall provide Controlled Low Strength Material (CLSM) in areas where required compaction cannot be met. CLSM shall be extend a minimum of 2' beyond the waterline at the crossing and shall extend to the top of the crossing pipe

APPROVED:  
 Manager and Chief Engineer, BWS DATE  
 (for work affecting BWS facilities in City/State R/W & BWS easements only)

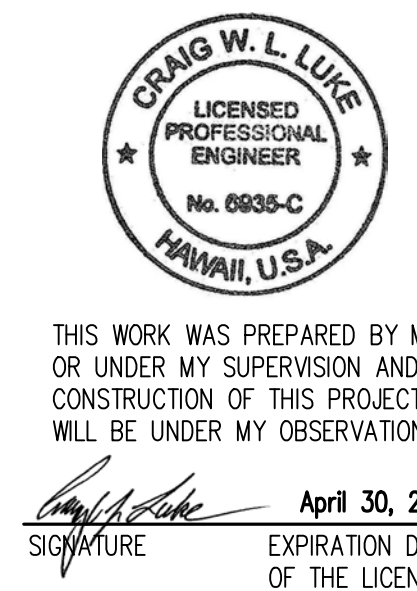

07/15/22	5 Revised profiles
06/08/22	2 Min. Cover Callout Added, Waterline N Profile Added
DATE	REVISION




STATE OF HAWAII  
 DEPARTMENT OF TRANSPORTATION  
 HIGHWAYS DIVISION

**Waterlines Profile - 5**

FARRINGTON HIGHWAY WIDENING  
 Kapolei Golf Course Road to Fort Weaver Road  
 Project No. 7101A-01-20

Scale: As Shown Date: April 2022


FED. ROAD DIST. NO.	STATE	PROJ. NO.	FISCAL YEAR	SHEET NO.	TOTAL SHEETS
HAWAII	HAW.	7101A-01-20	2021	161	767

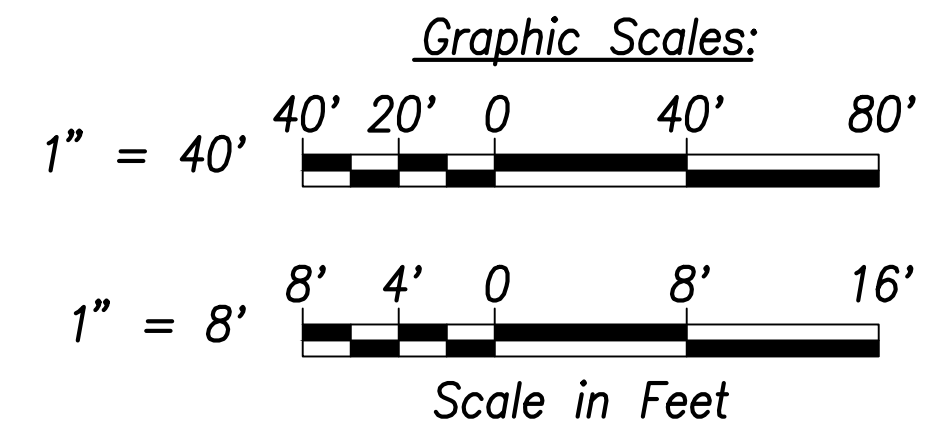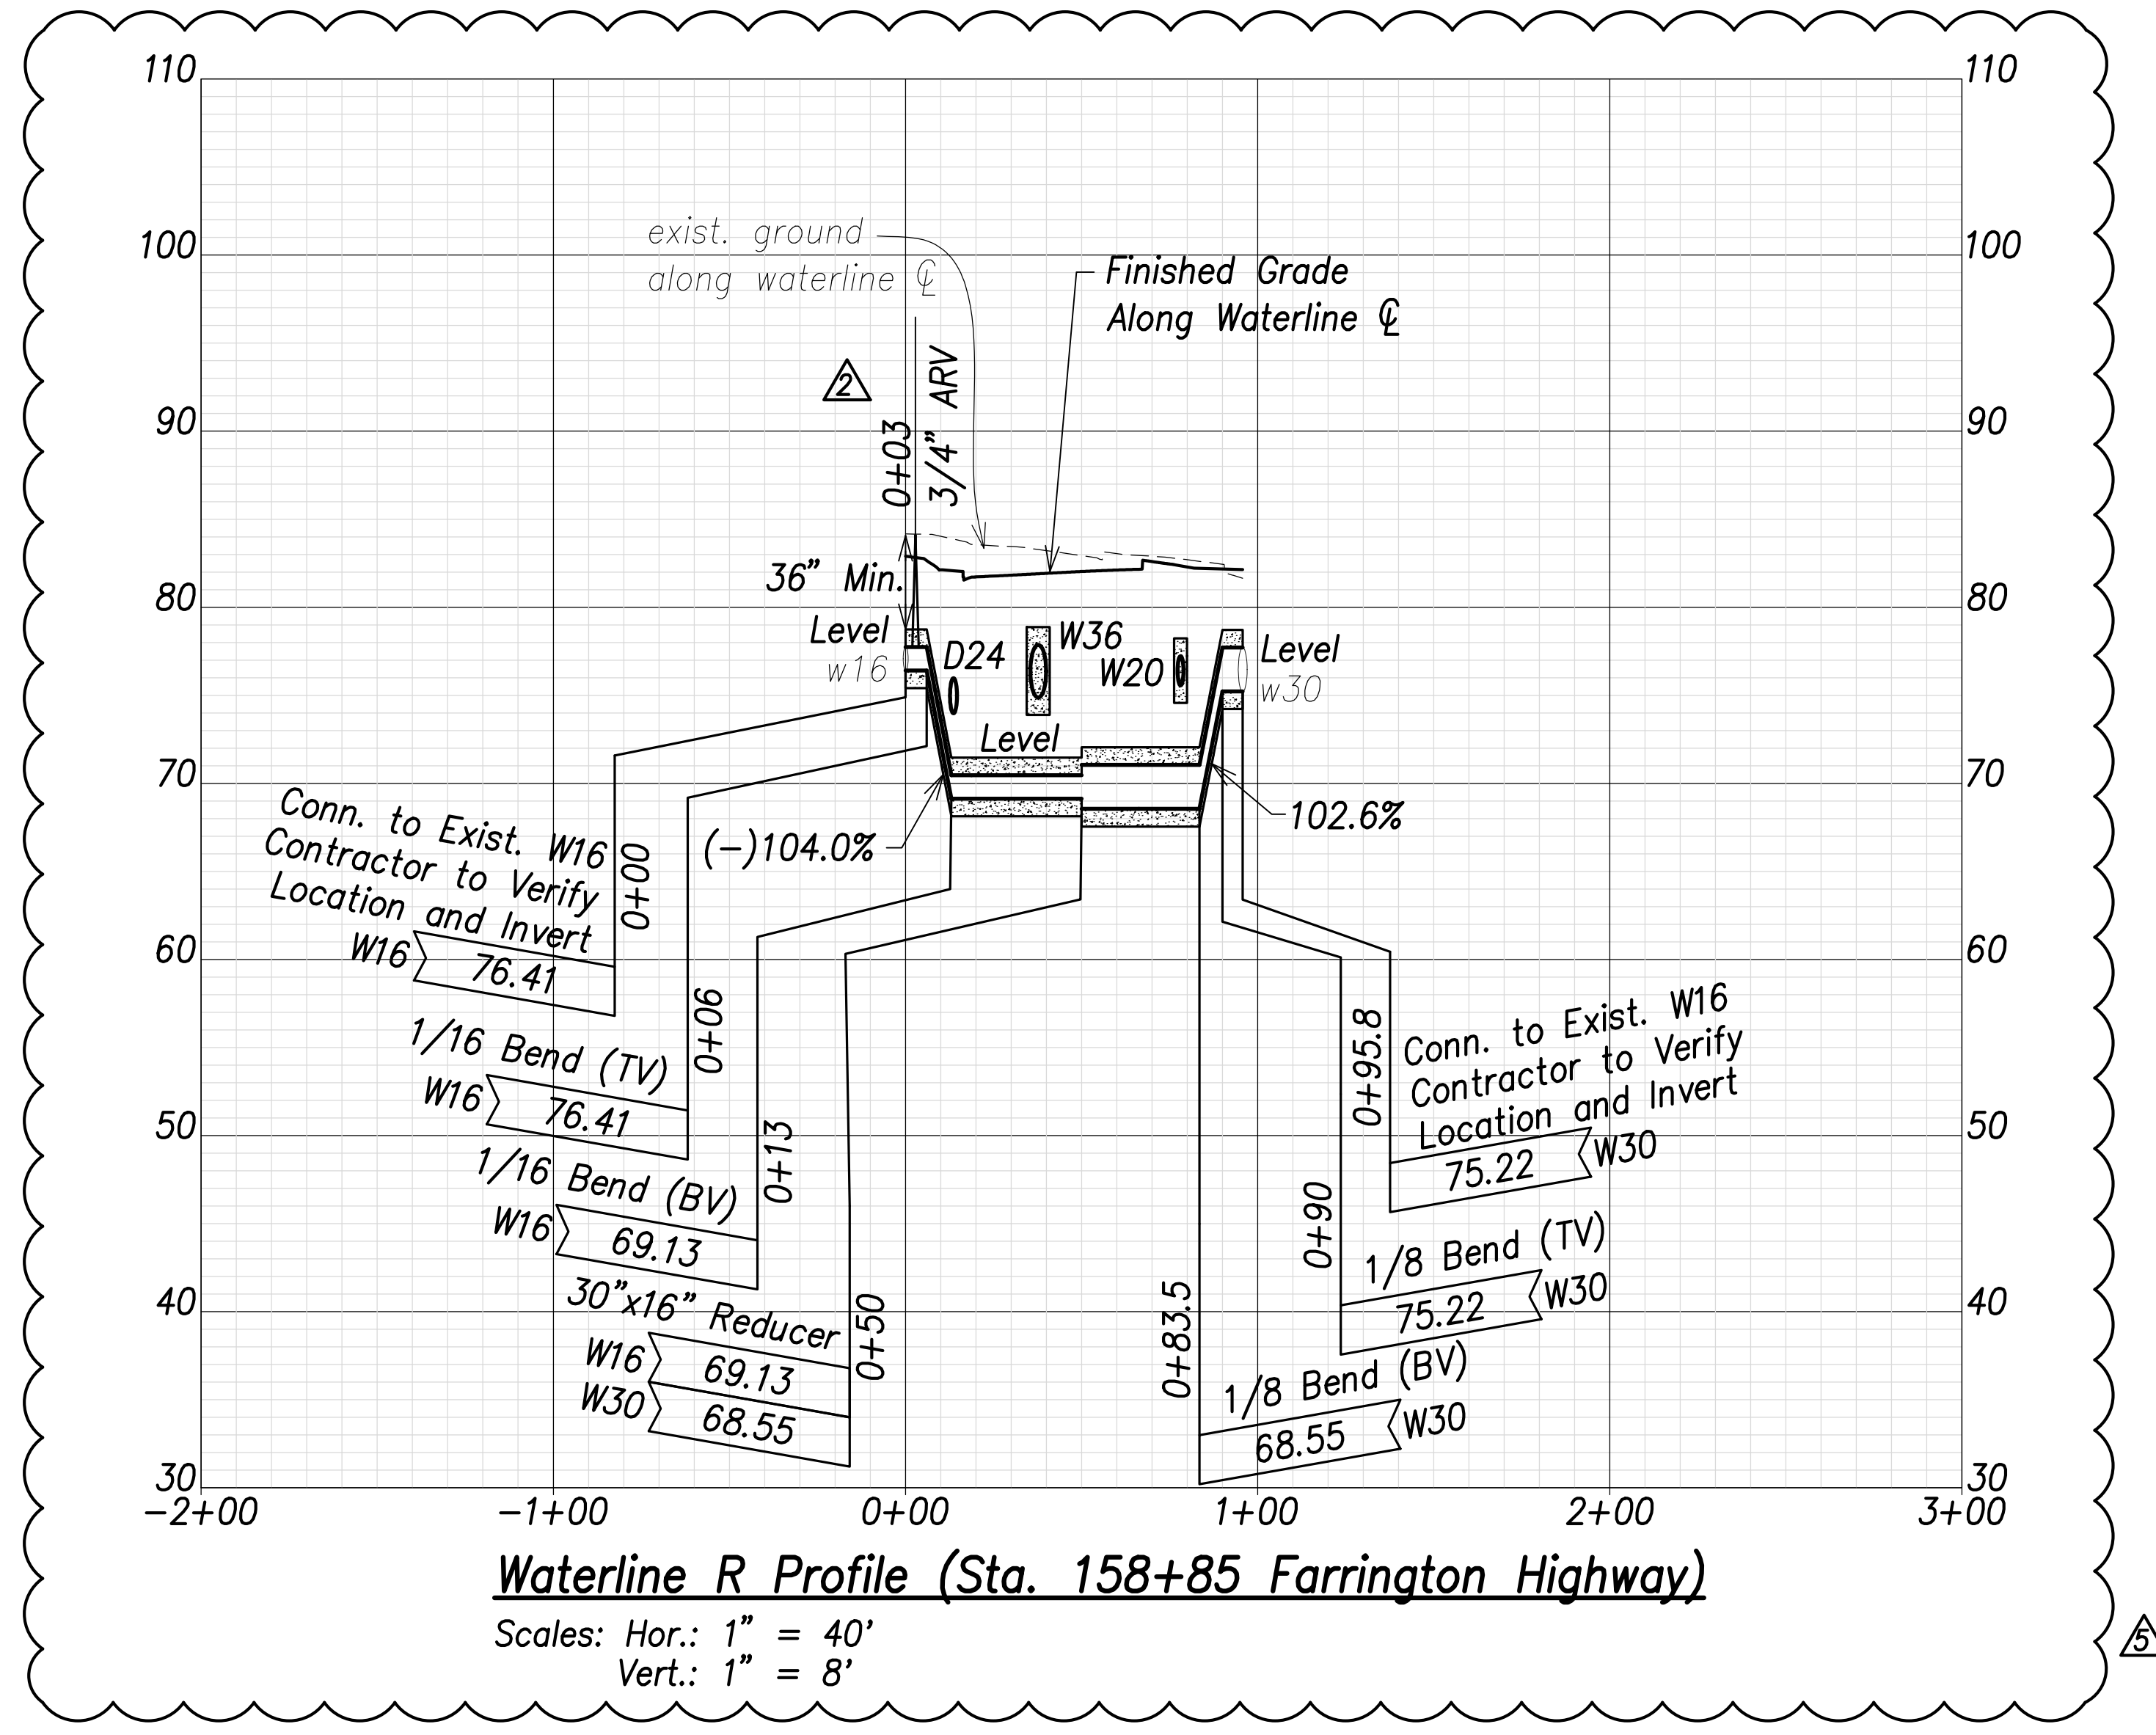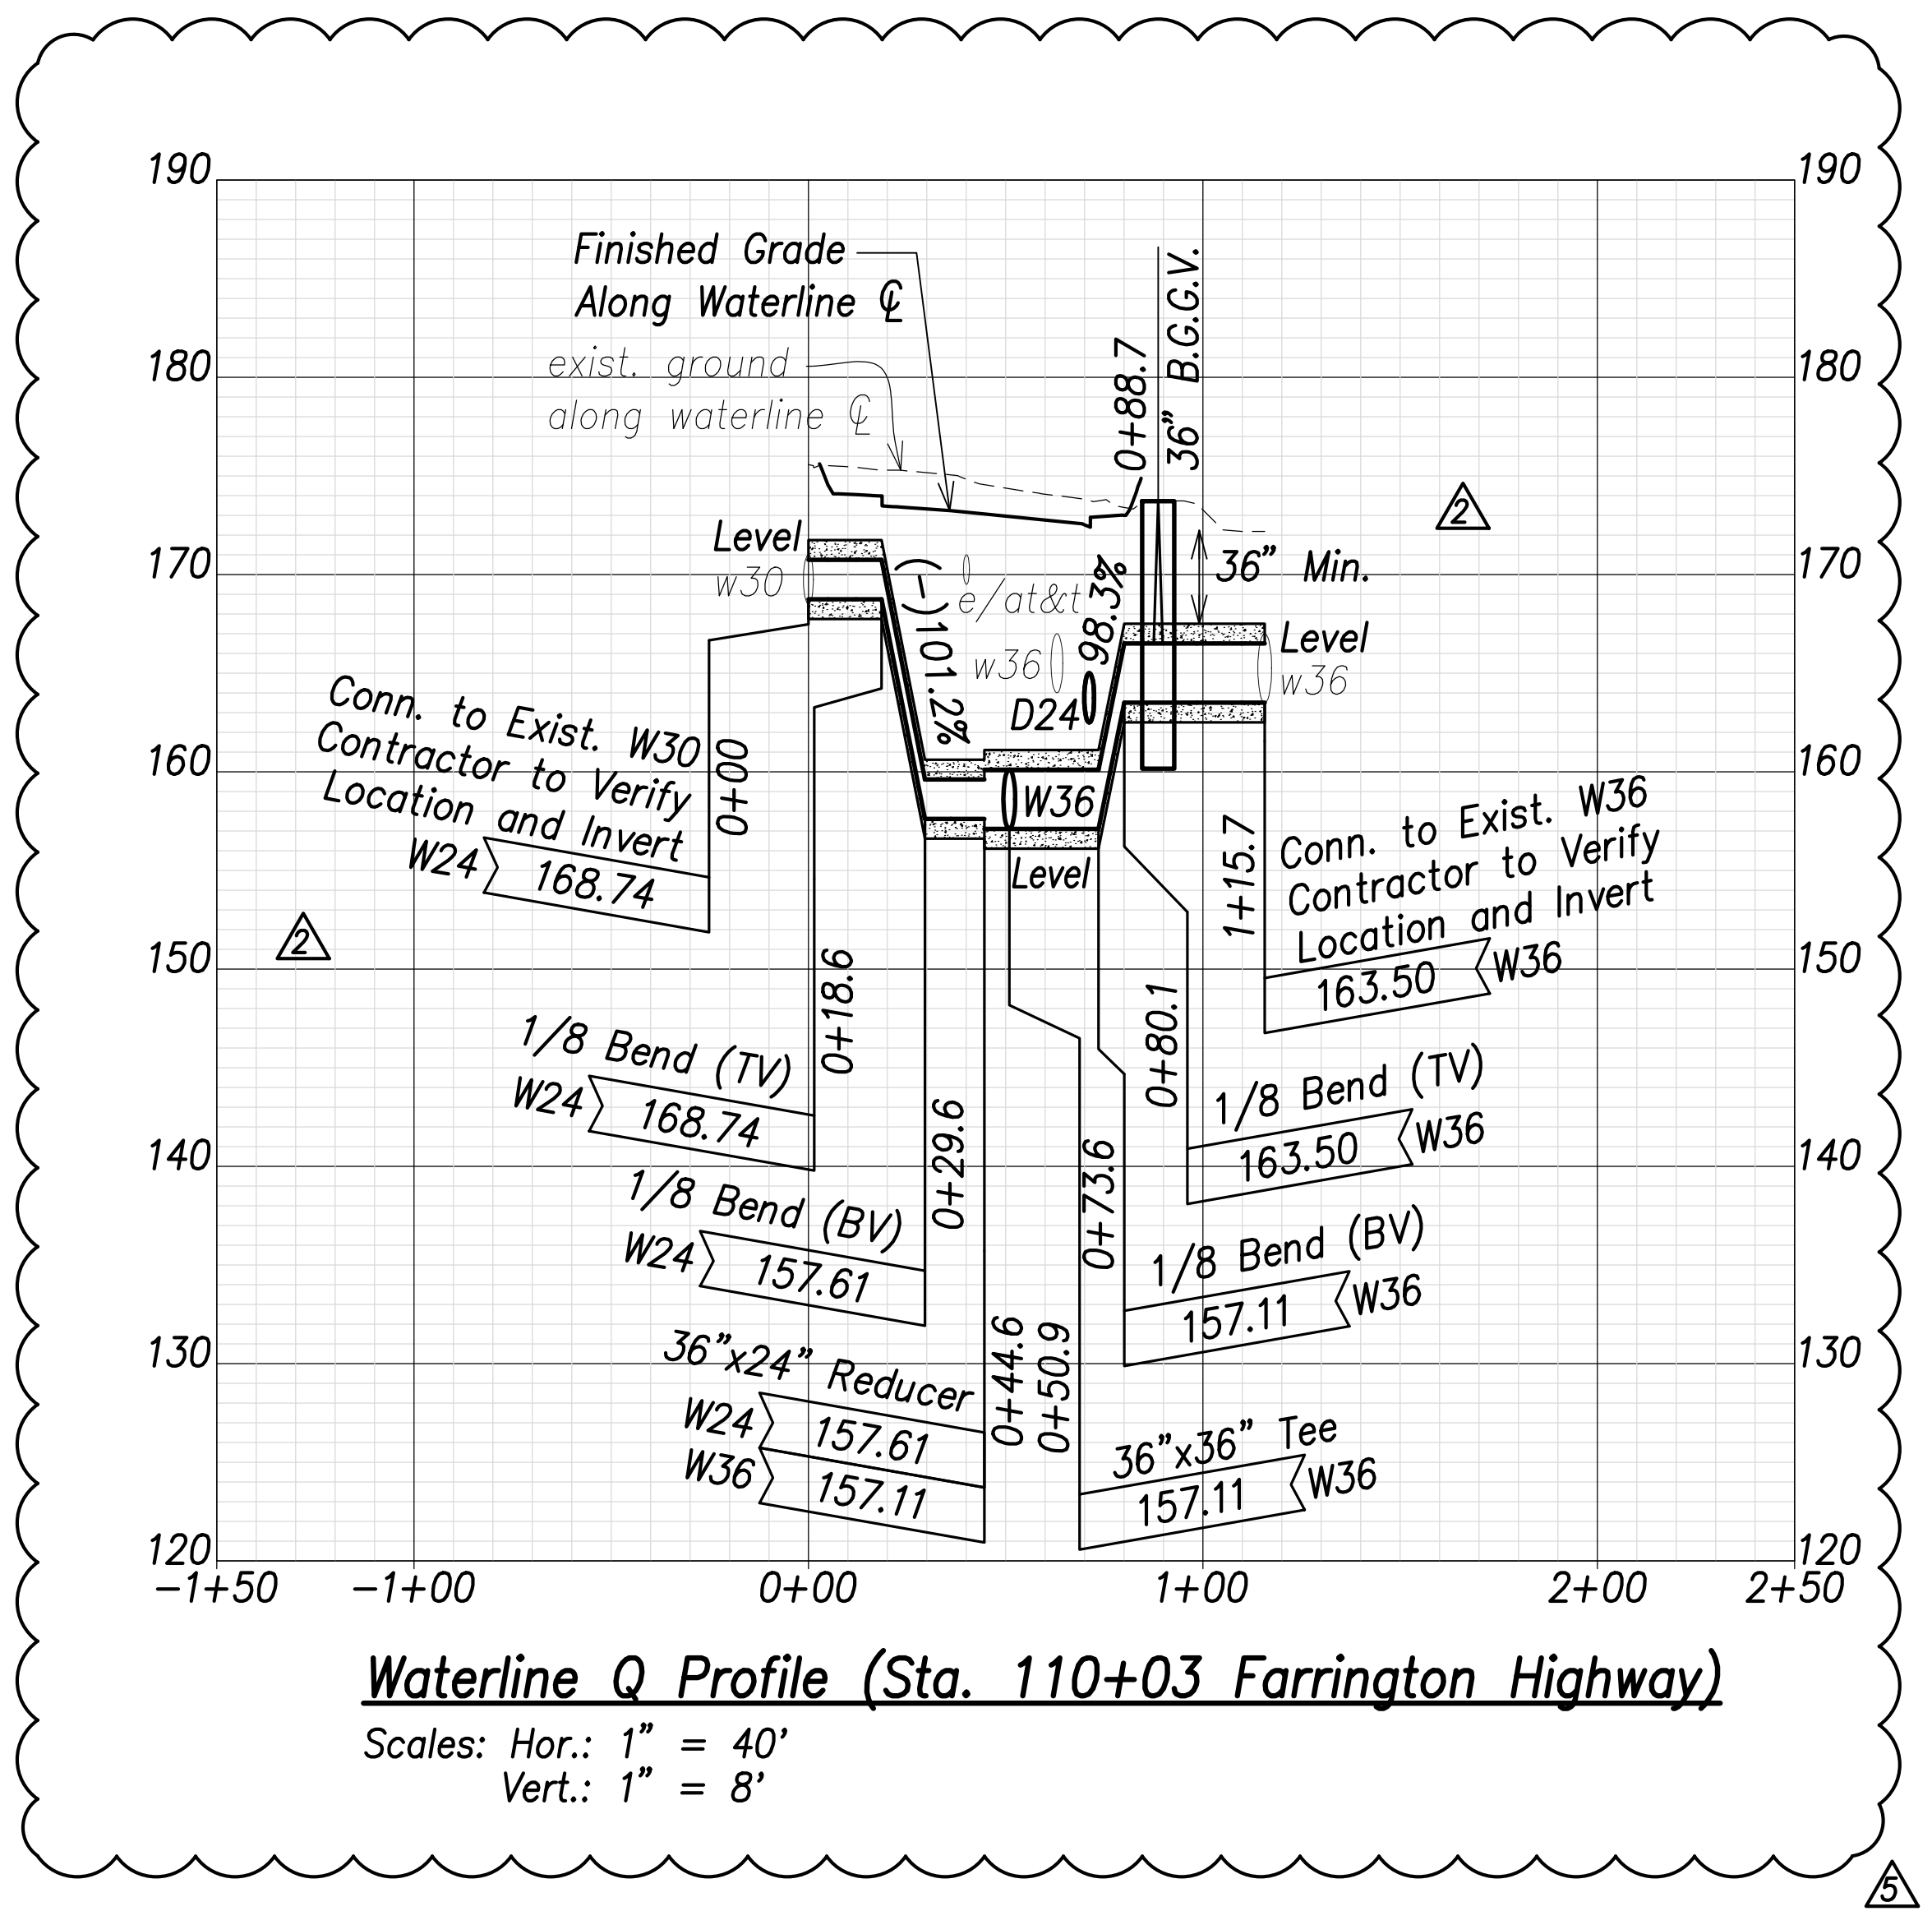

SURVEY PLOTTED BY	DATE
DRAWN BY	
TRACED BY	
QUANTITIES BY	
CHECKED BY	
ORIGINAL PLAN	
NOTE BOOK	
No.	

**Note:**  
 The Contractor shall provide Controlled Low Strength Material (CLSM) in areas where required compaction cannot be met. CLSM shall be extend a minimum of 2' beyond the waterline at the crossing and shall extend to the top of the crossing pipe

APPROVED: \_\_\_\_\_ DATE \_\_\_\_\_  
 Manager and Chief Engineer, BWS  
 (for work affecting BWS facilities in City/State R/W & BWS easements only)

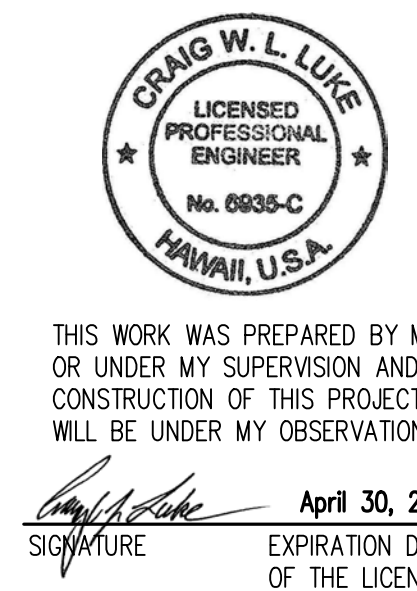

THIS WORK WAS PREPARED BY ME OR UNDER MY SUPERVISION AND CONSTRUCTION OF THIS PROJECT WILL BE UNDER MY OBSERVATION.  
 SIGNATURE: \_\_\_\_\_ EXPIRATION DATE OF THE LICENSE: April 30, 2024

07/15/22	Revised Profiles
06/08/22	Revised Profiles
DATE	REVISION

**STATE OF HAWAII**  
**DEPARTMENT OF TRANSPORTATION**  
**HIGHWAYS DIVISION**

**Waterlines Profile - 6**






*FARRINGTON HIGHWAY WIDENING*  
*Kapolei Golf Course Road to Fort Weaver Road*  
*Project No. 7101A-01-20*

Scale: As Shown      Date: April 2022

**SHEET NO. C-160 OF 767 SHEETS**




FED. ROAD DIST. NO.	STATE	PROJ. NO.	FISCAL YEAR	SHEET NO.	TOTAL SHEETS
HAWAII	HAW.	7101A-01-20	2021	163	767

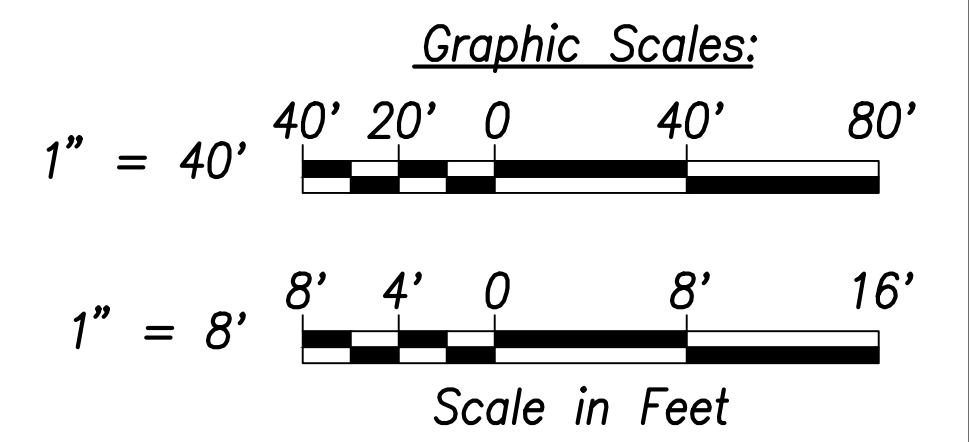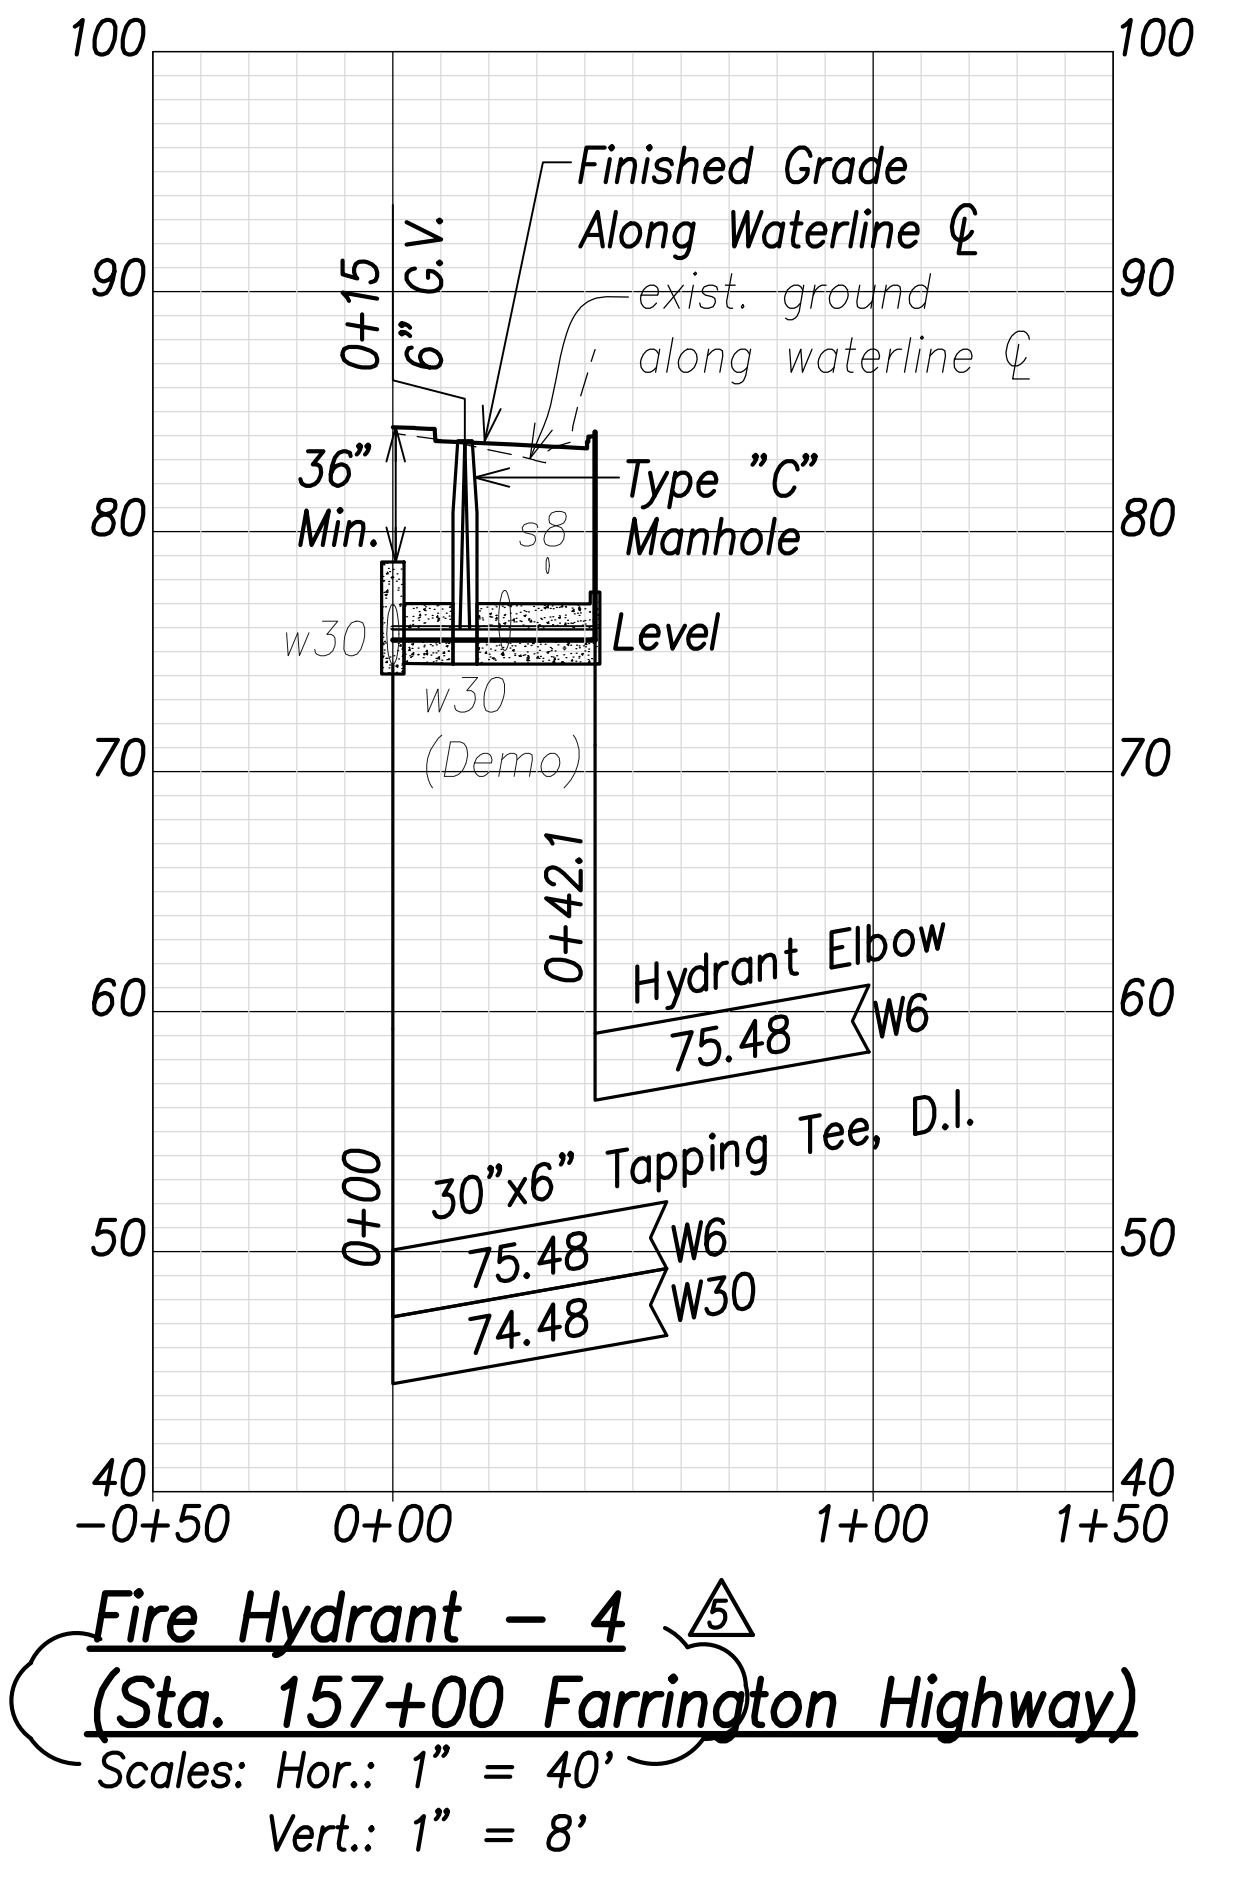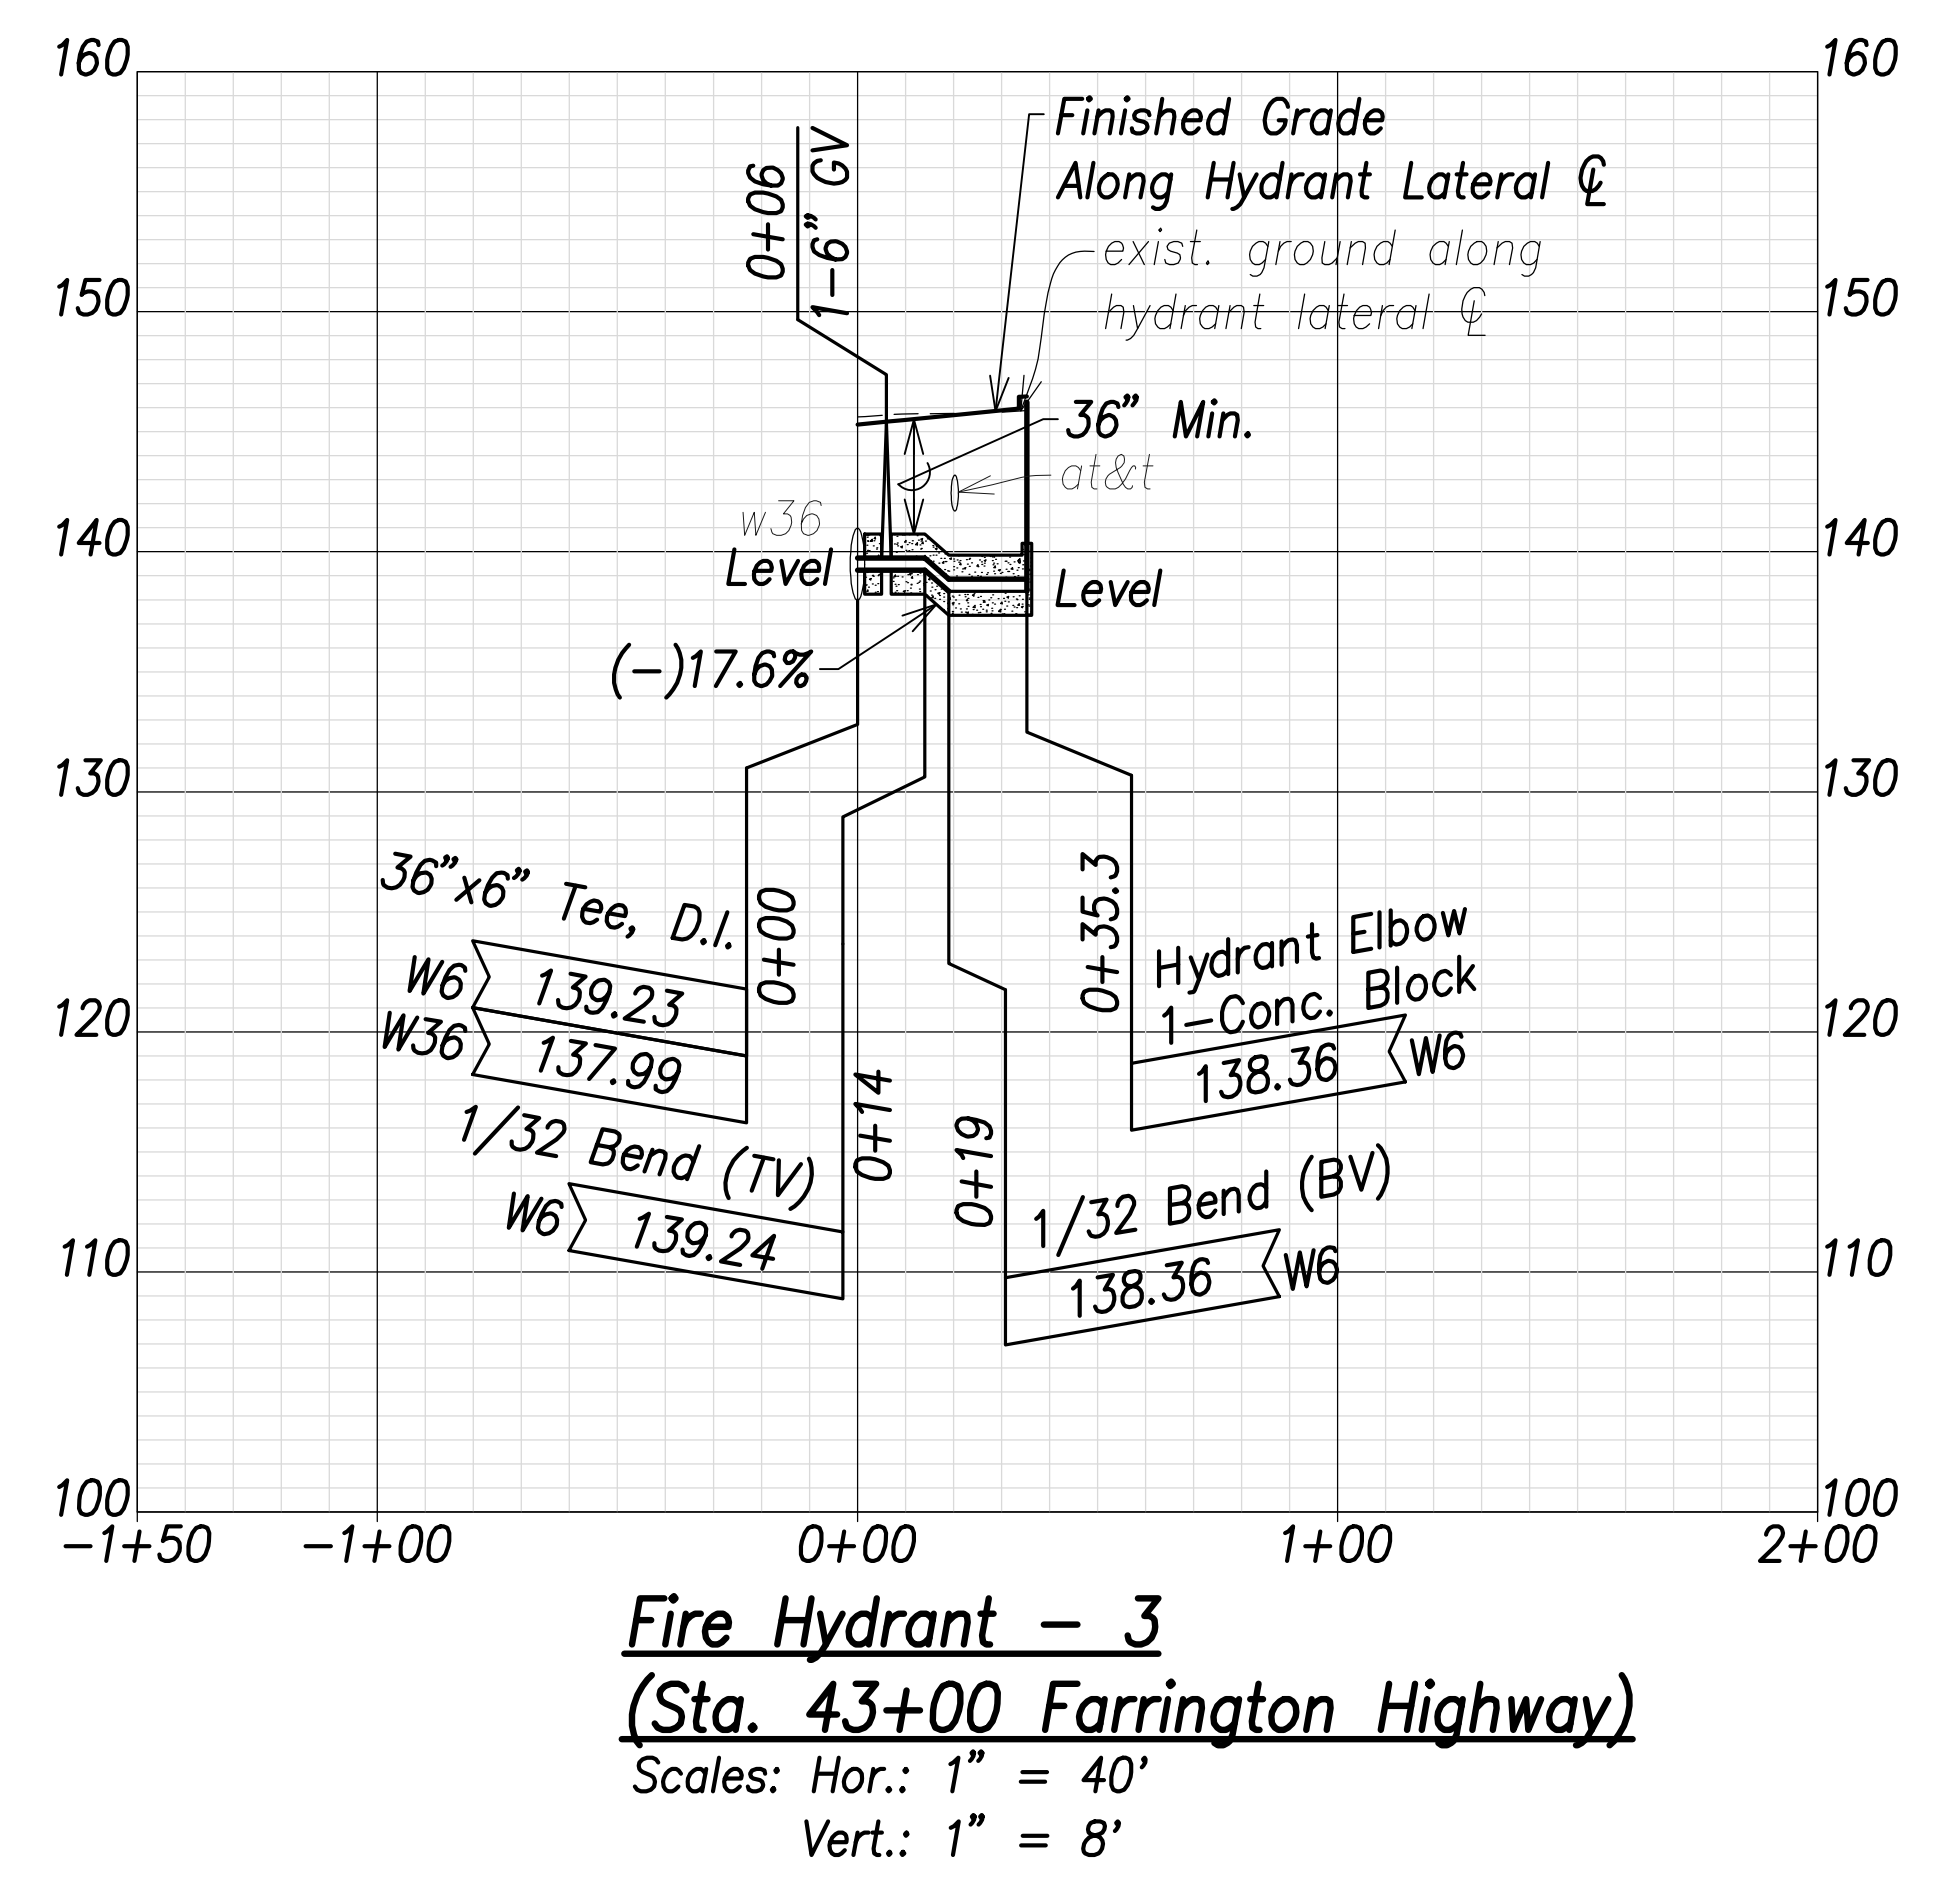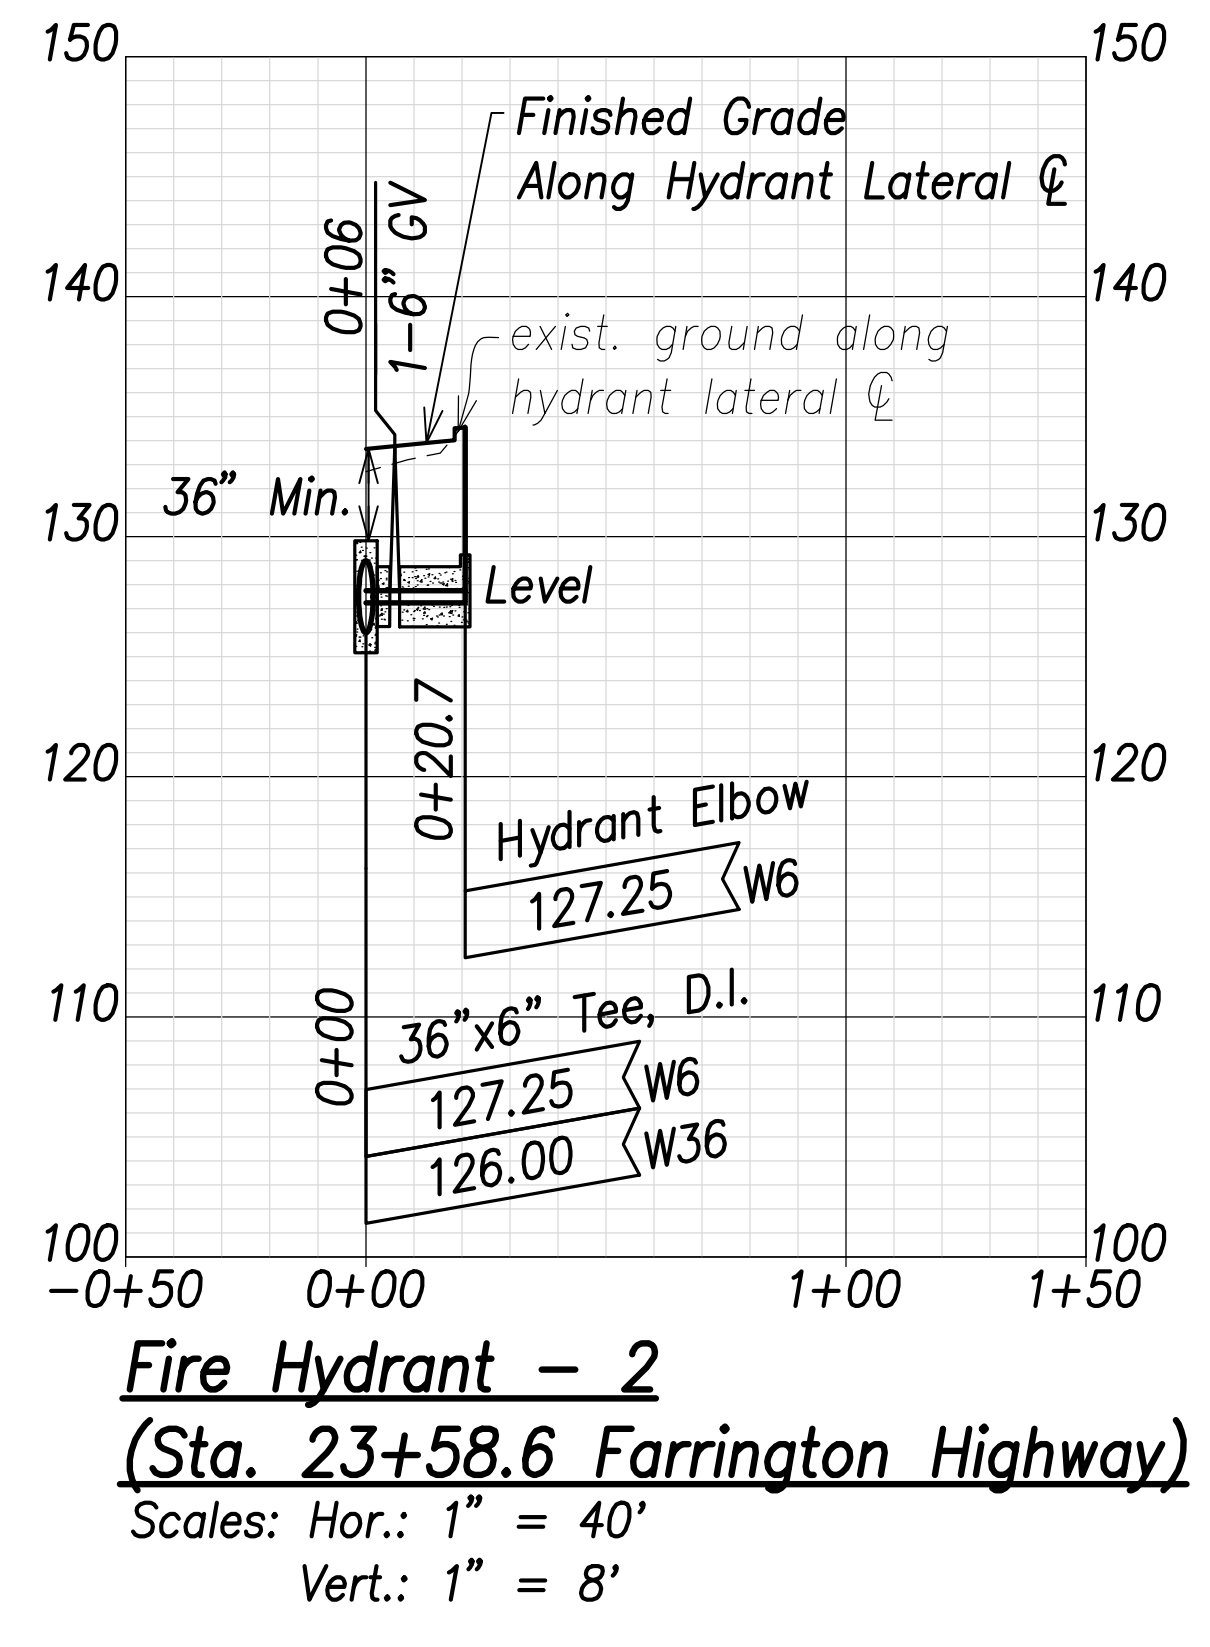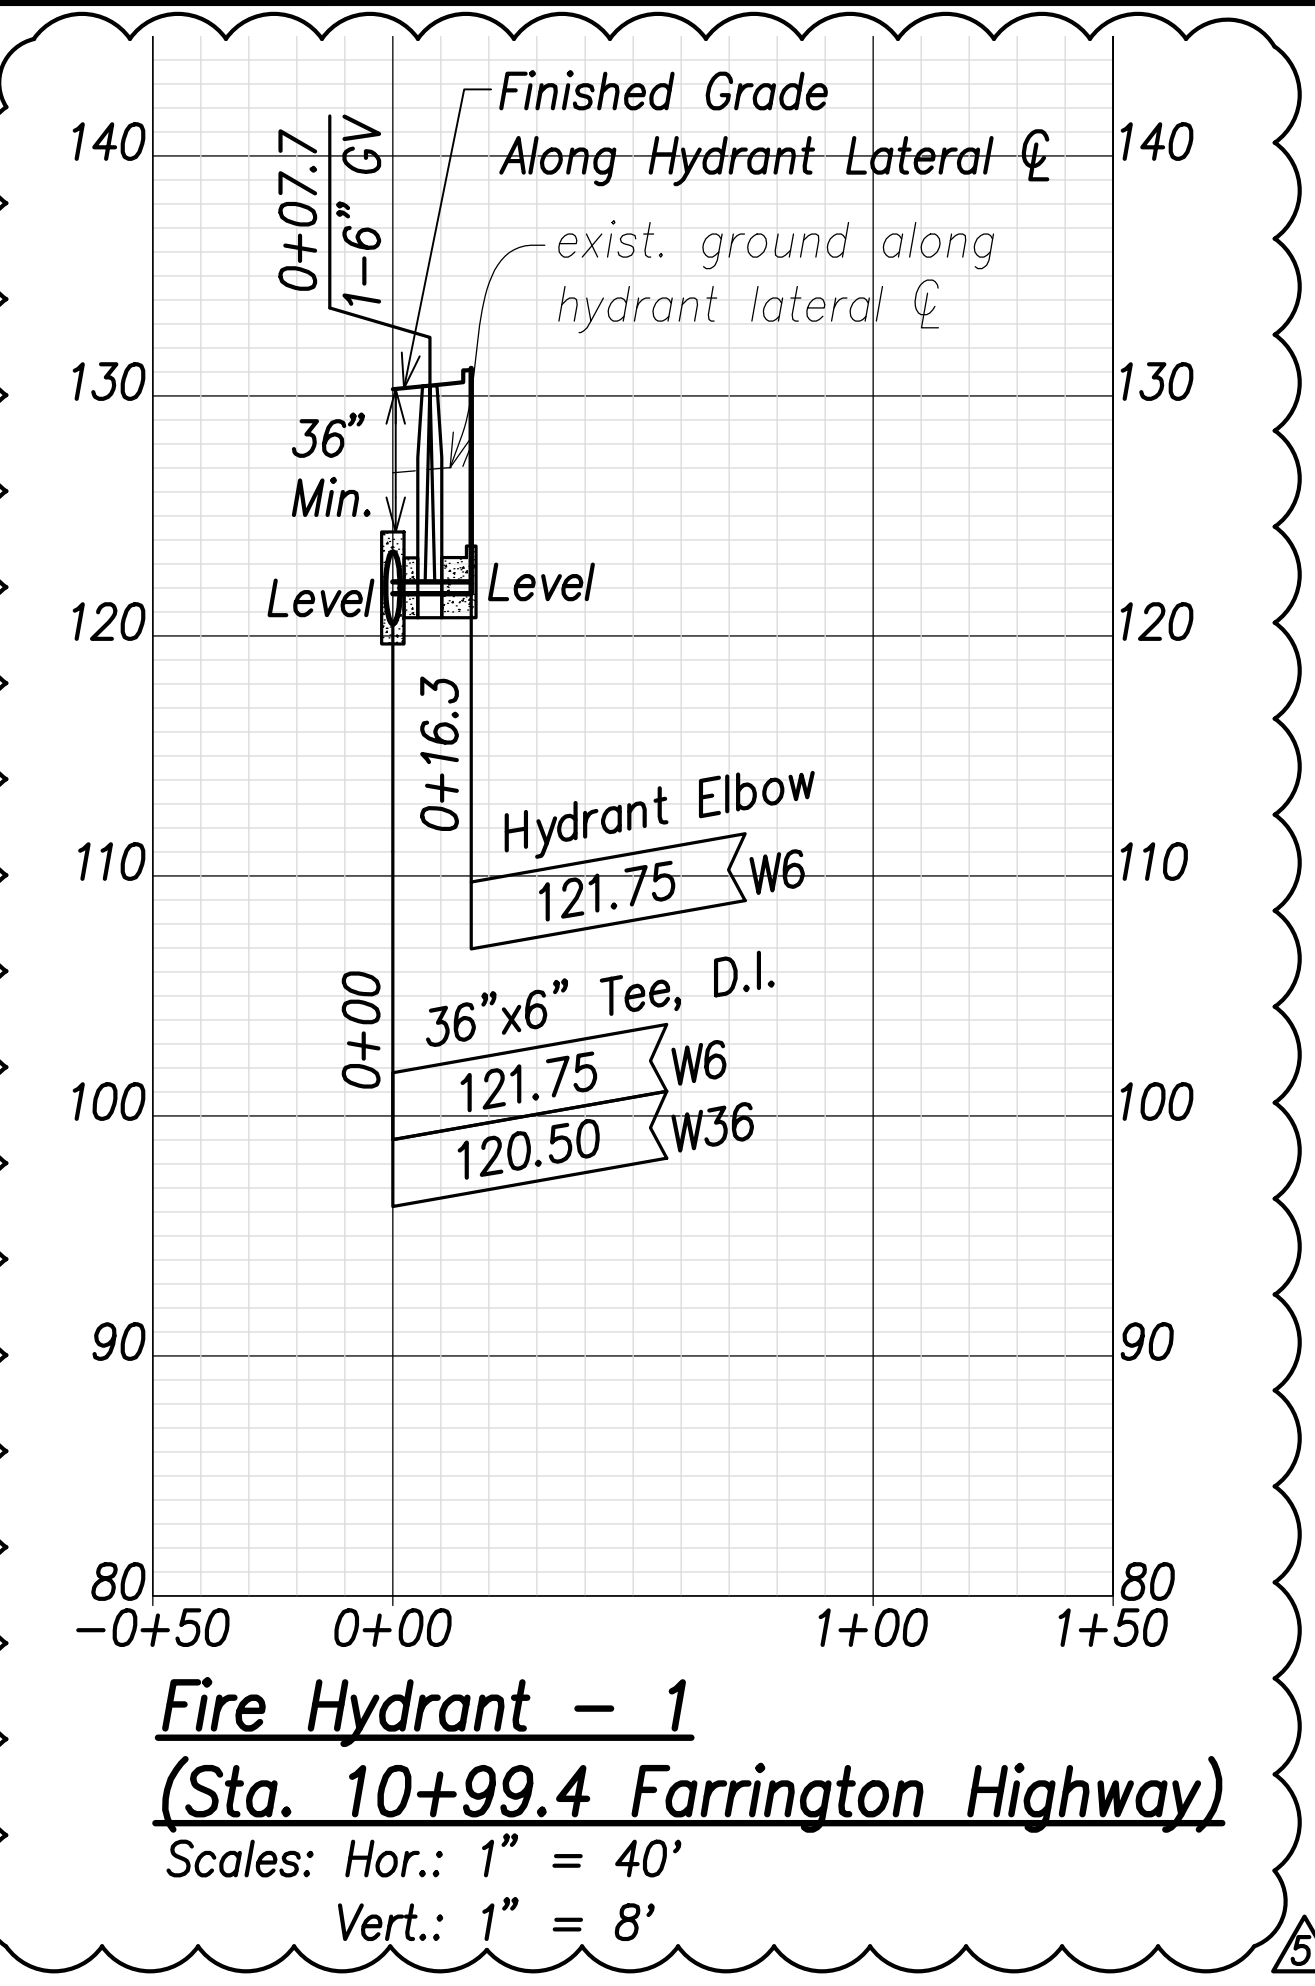

SURVEY PLOTTED BY	DATE
DRAWN BY	
TRACED BY	
QUANTITIES BY	
CHECKED BY	
ORIGINAL PLAN	
NOTE BOOK	
No.	

APPROVED:  
 \_\_\_\_\_ DATE \_\_\_\_\_  
 Manager and Chief Engineer, BWS  
 (for work affecting BWS facilities in  
 City/State R/W & BWS easements only)

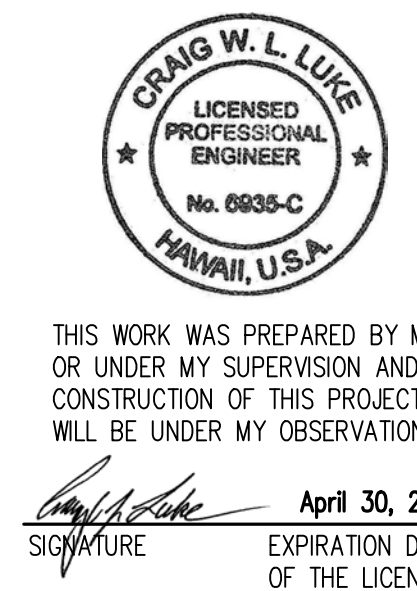

07/15/22	5 Revised profile
06/08/22	2 Min. Cover Callout Added, Revised FH1 Profile, Added MH to FH4
DATE	REVISION


STATE OF HAWAII  
 DEPARTMENT OF TRANSPORTATION  
 HIGHWAYS DIVISION

**Fire Hydrant Profiles**


FARRINGTON HIGHWAY WIDENING  
 Kapolei Golf Course Road to Fort Weaver Road  
 Project No. 7101A-01-20

Scale: As Shown Date: April 2022


FED. ROAD DIST. NO.	STATE	PROJ. NO.	FISCAL YEAR	SHEET NO.	TOTAL SHEETS
HAWAII	HAW.	7101A-01-20	2021	166	767

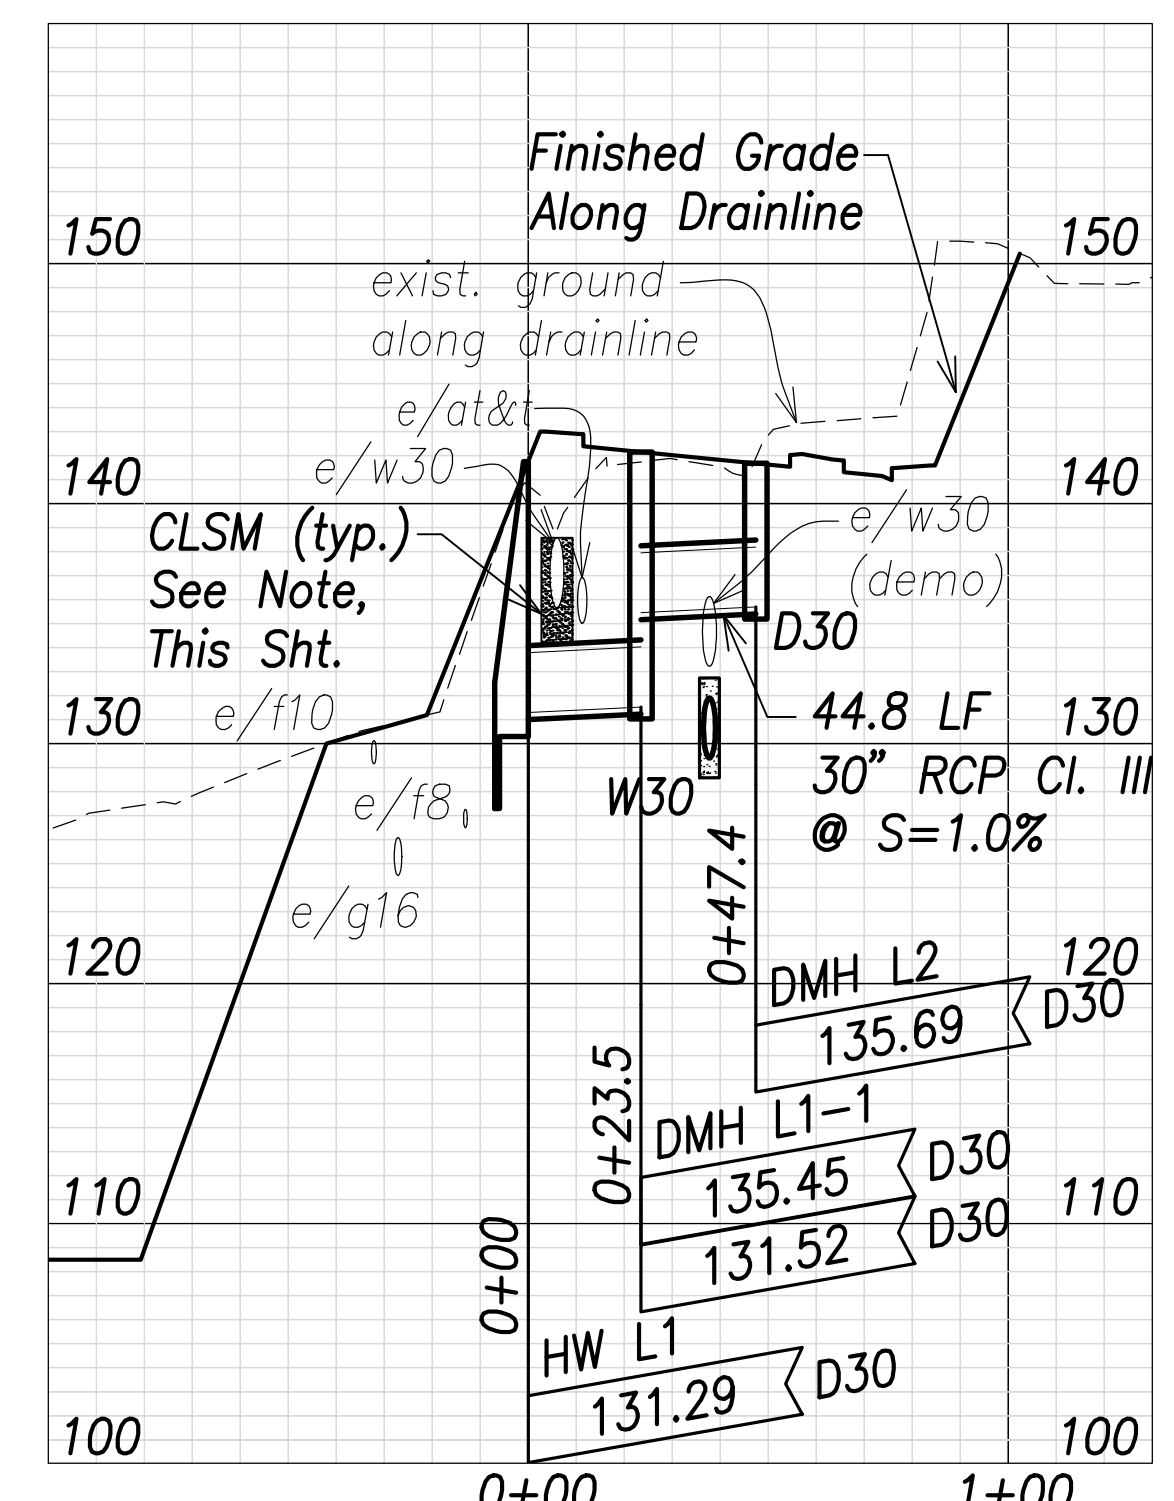


**Drain Profile at 135+00**  
 Scales: Hor.: 1" = 40'  
 Vert.: 1" = 8'

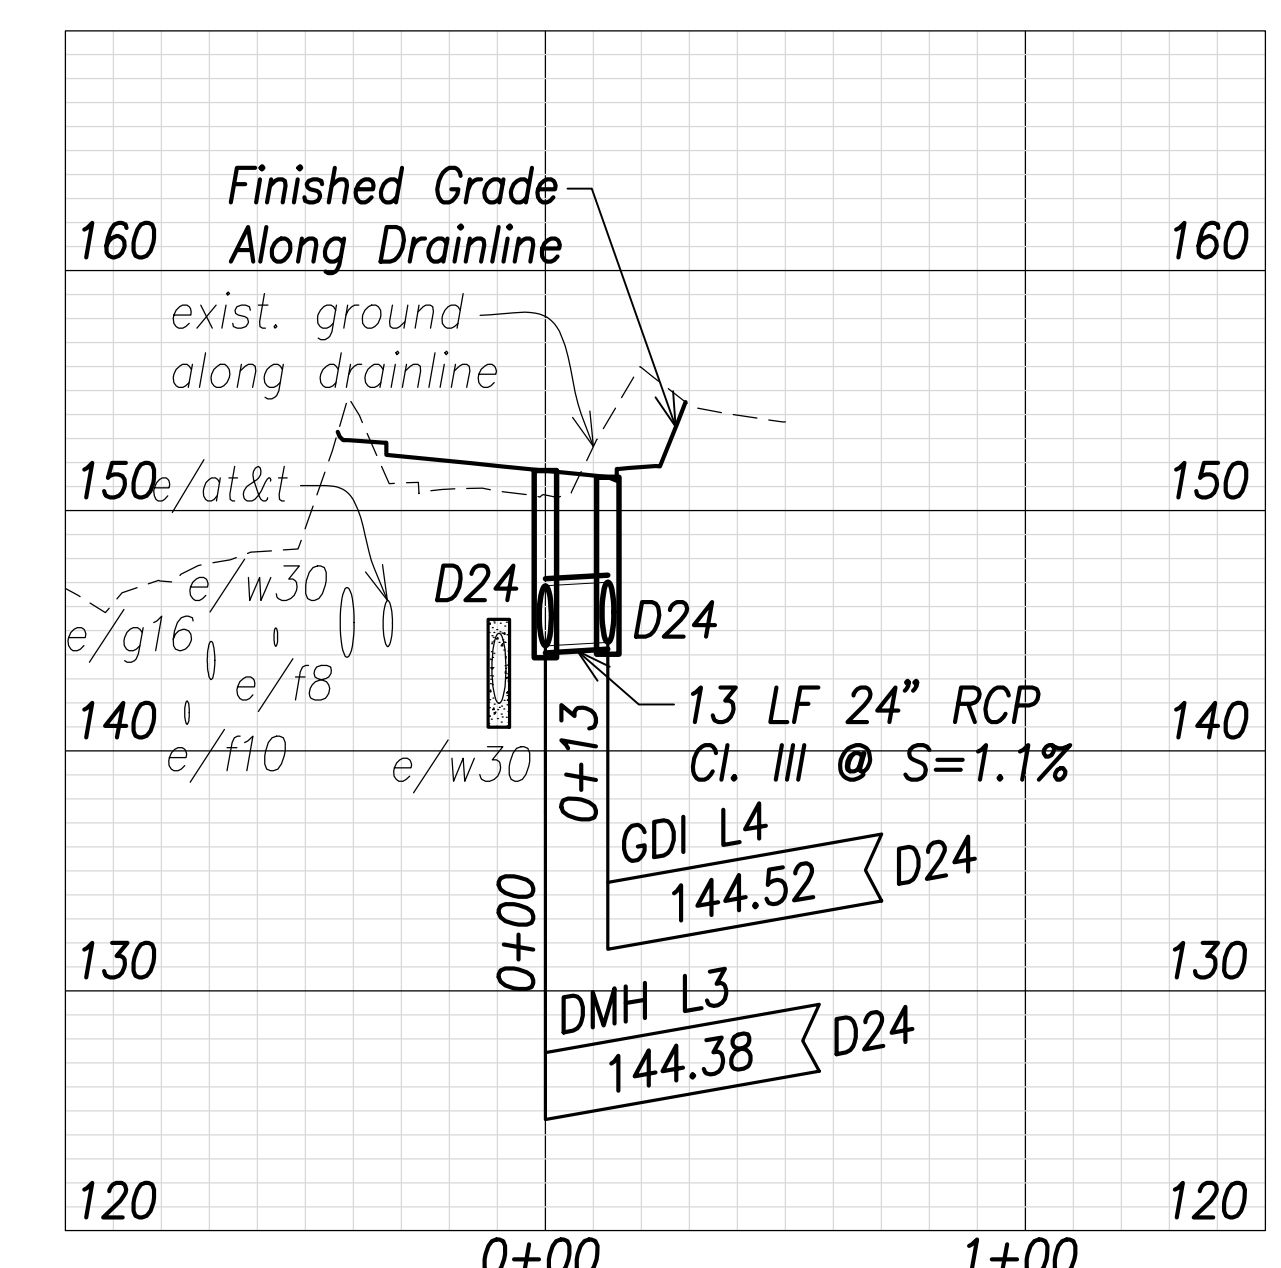


**Drain Profile at 132+52.6**  
 Scales: Hor.: 1" = 40'  
 Vert.: 1" = 8'

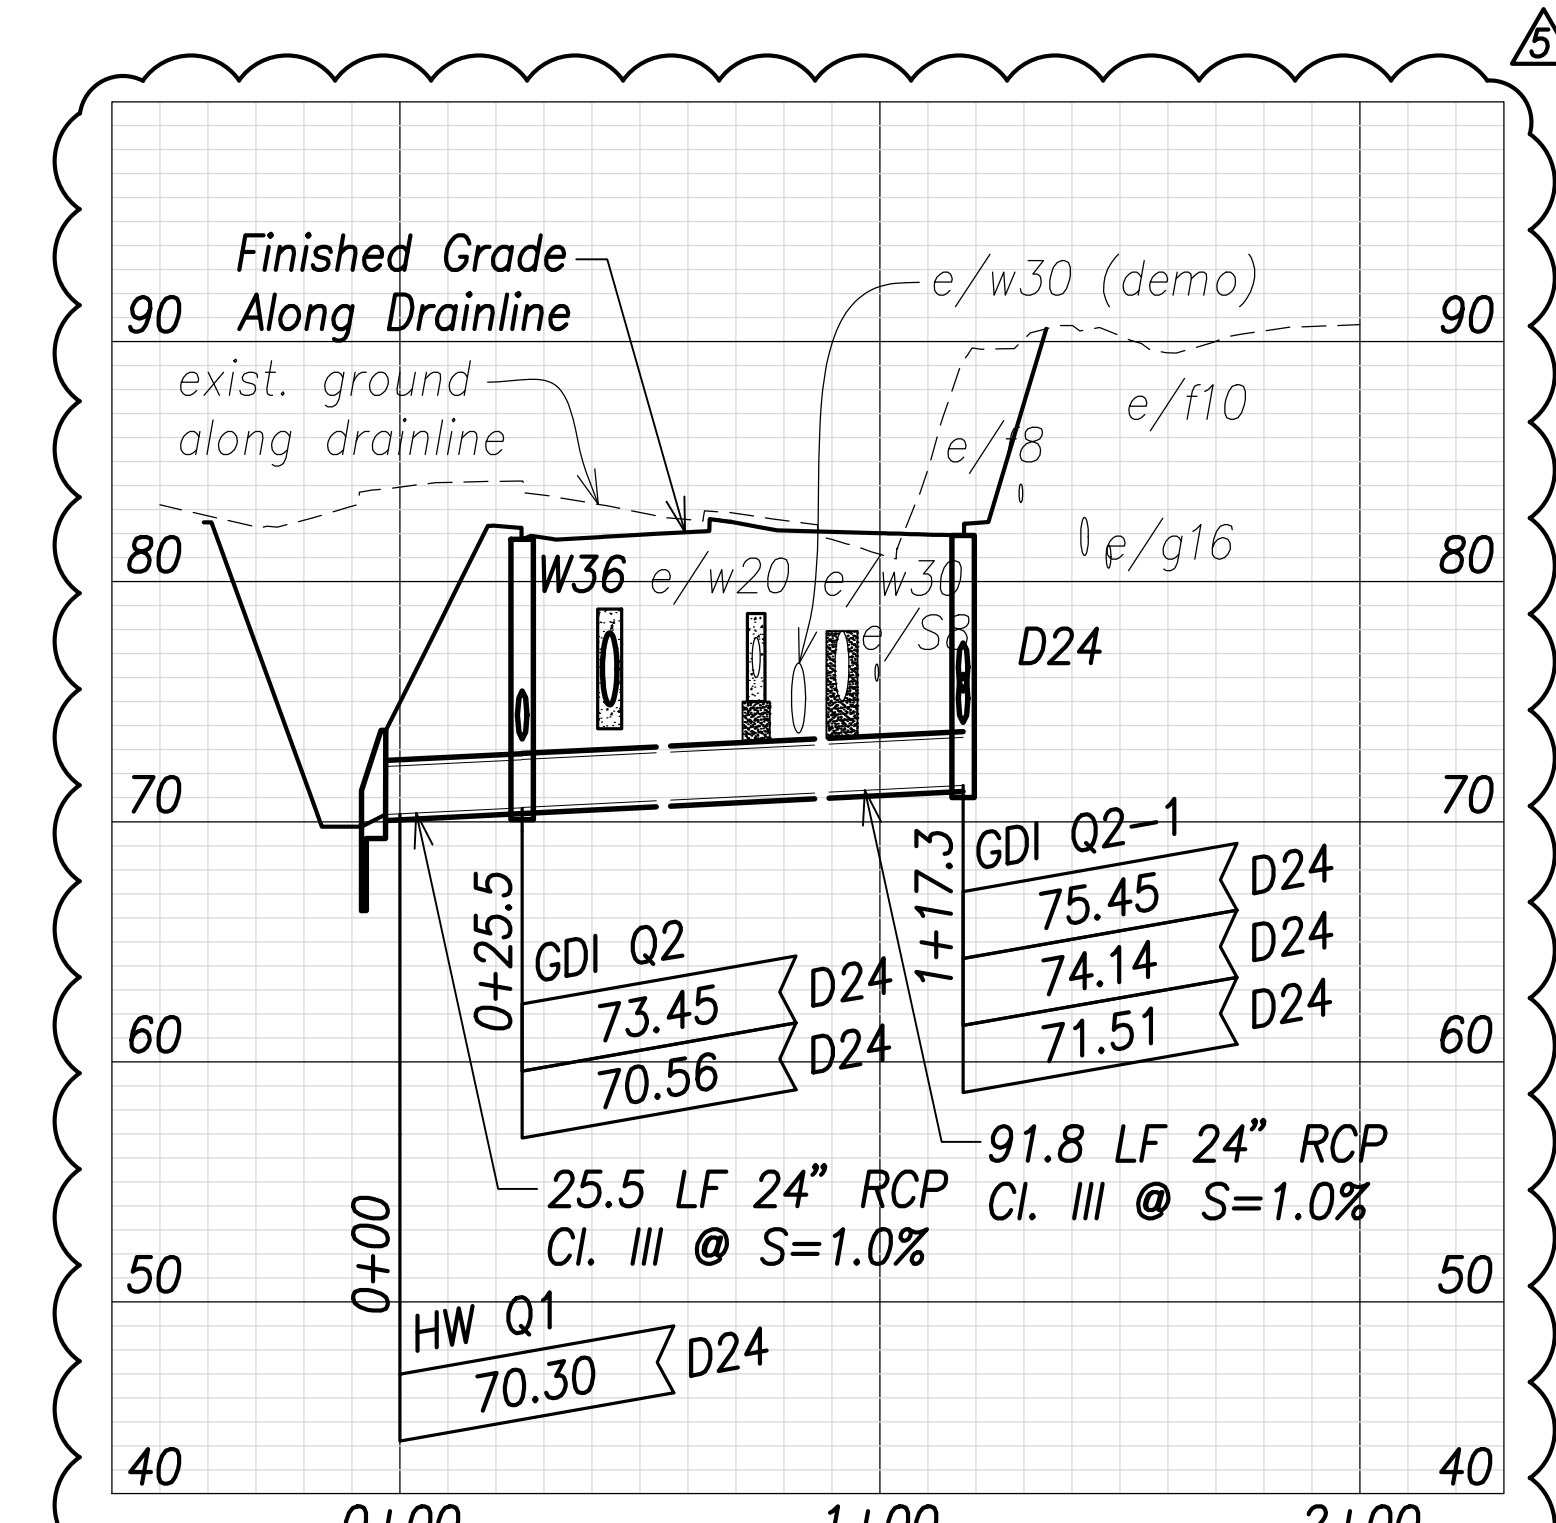


**Drain Profile at HW Q1 to GDI Q2-1**  
 Scales: Hor.: 1" = 40'  
 Vert.: 1" = 8'

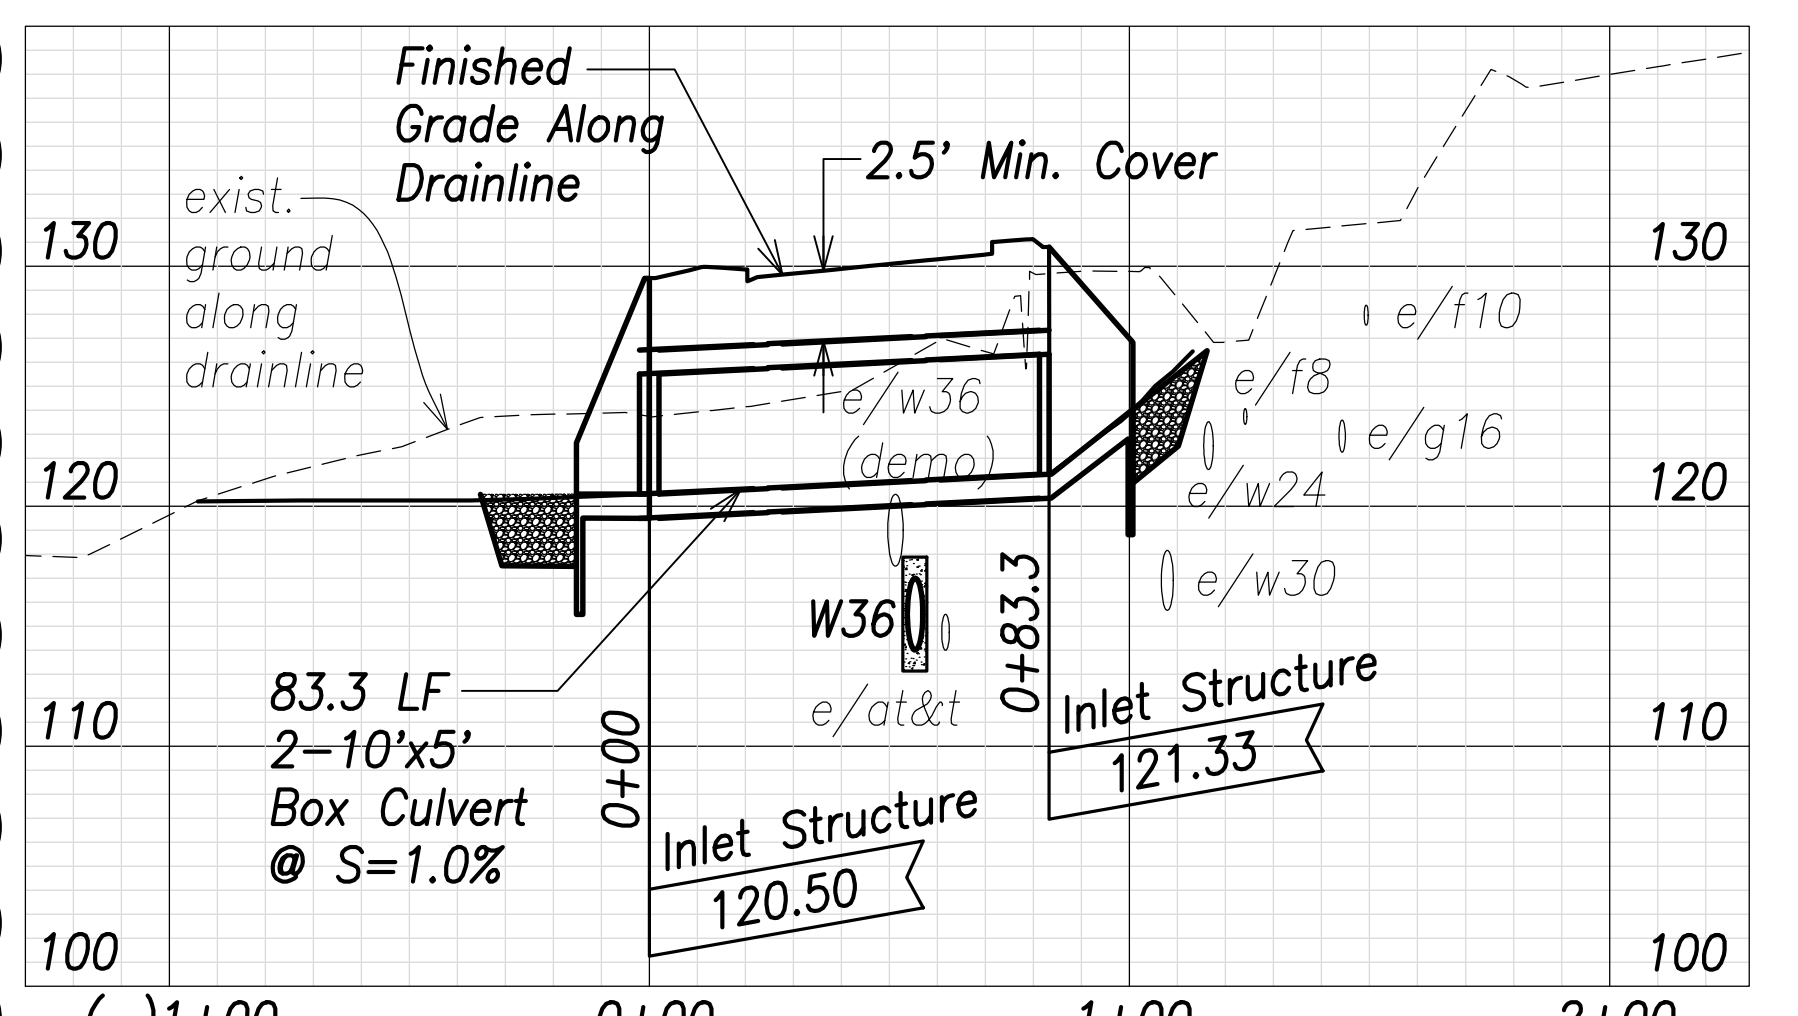

**Box Culvert at 11+46**  
 Scales: Hor.: 1" = 40'  
 Vert.: 1" = 8'

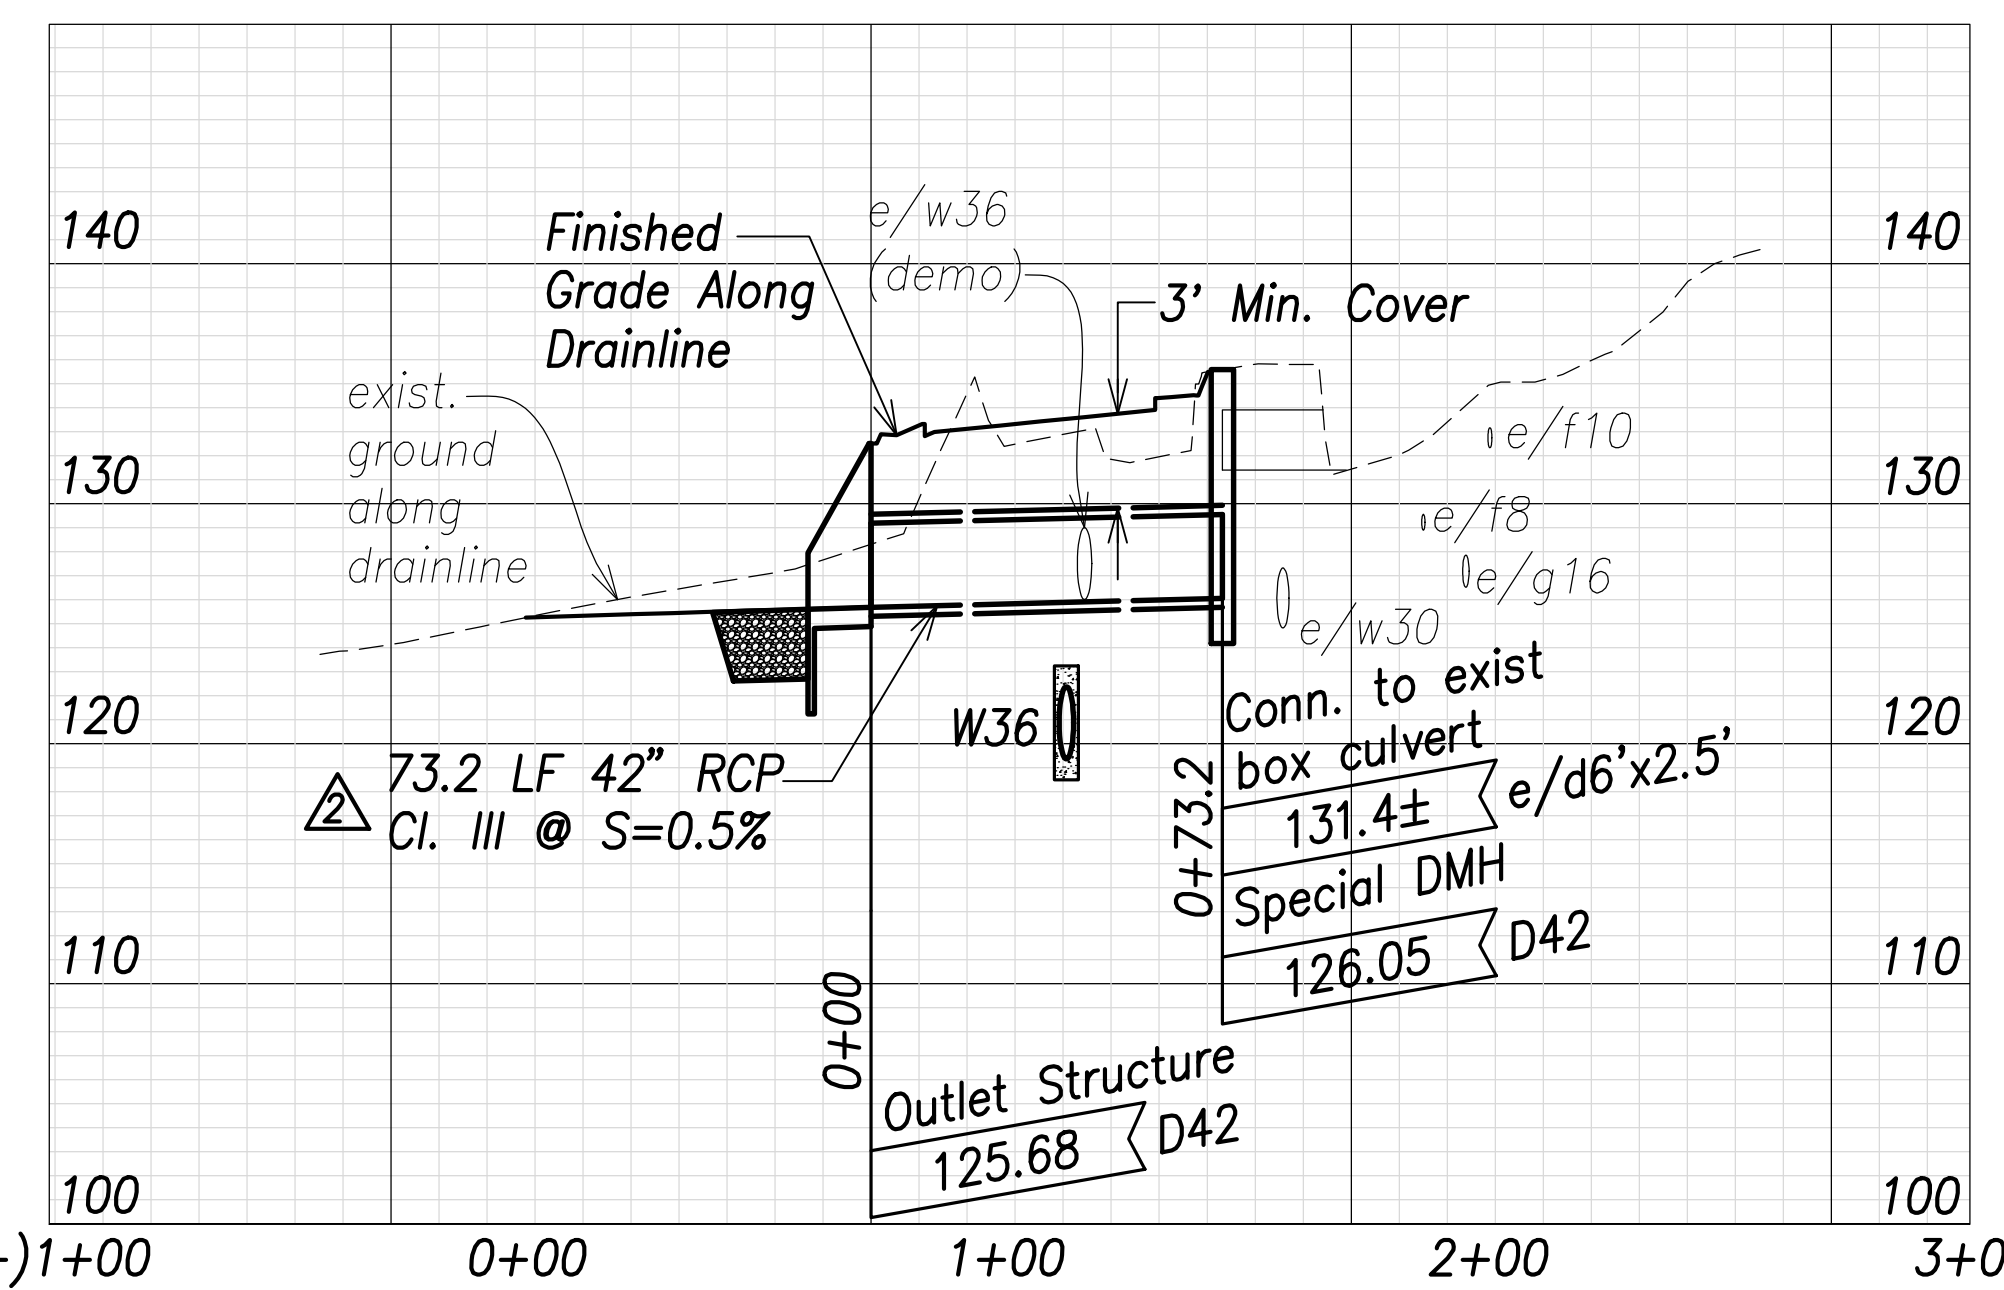


**Drain Profile at 23+36**  
 Scales: Hor.: 1" = 40'  
 Vert.: 1" = 8'

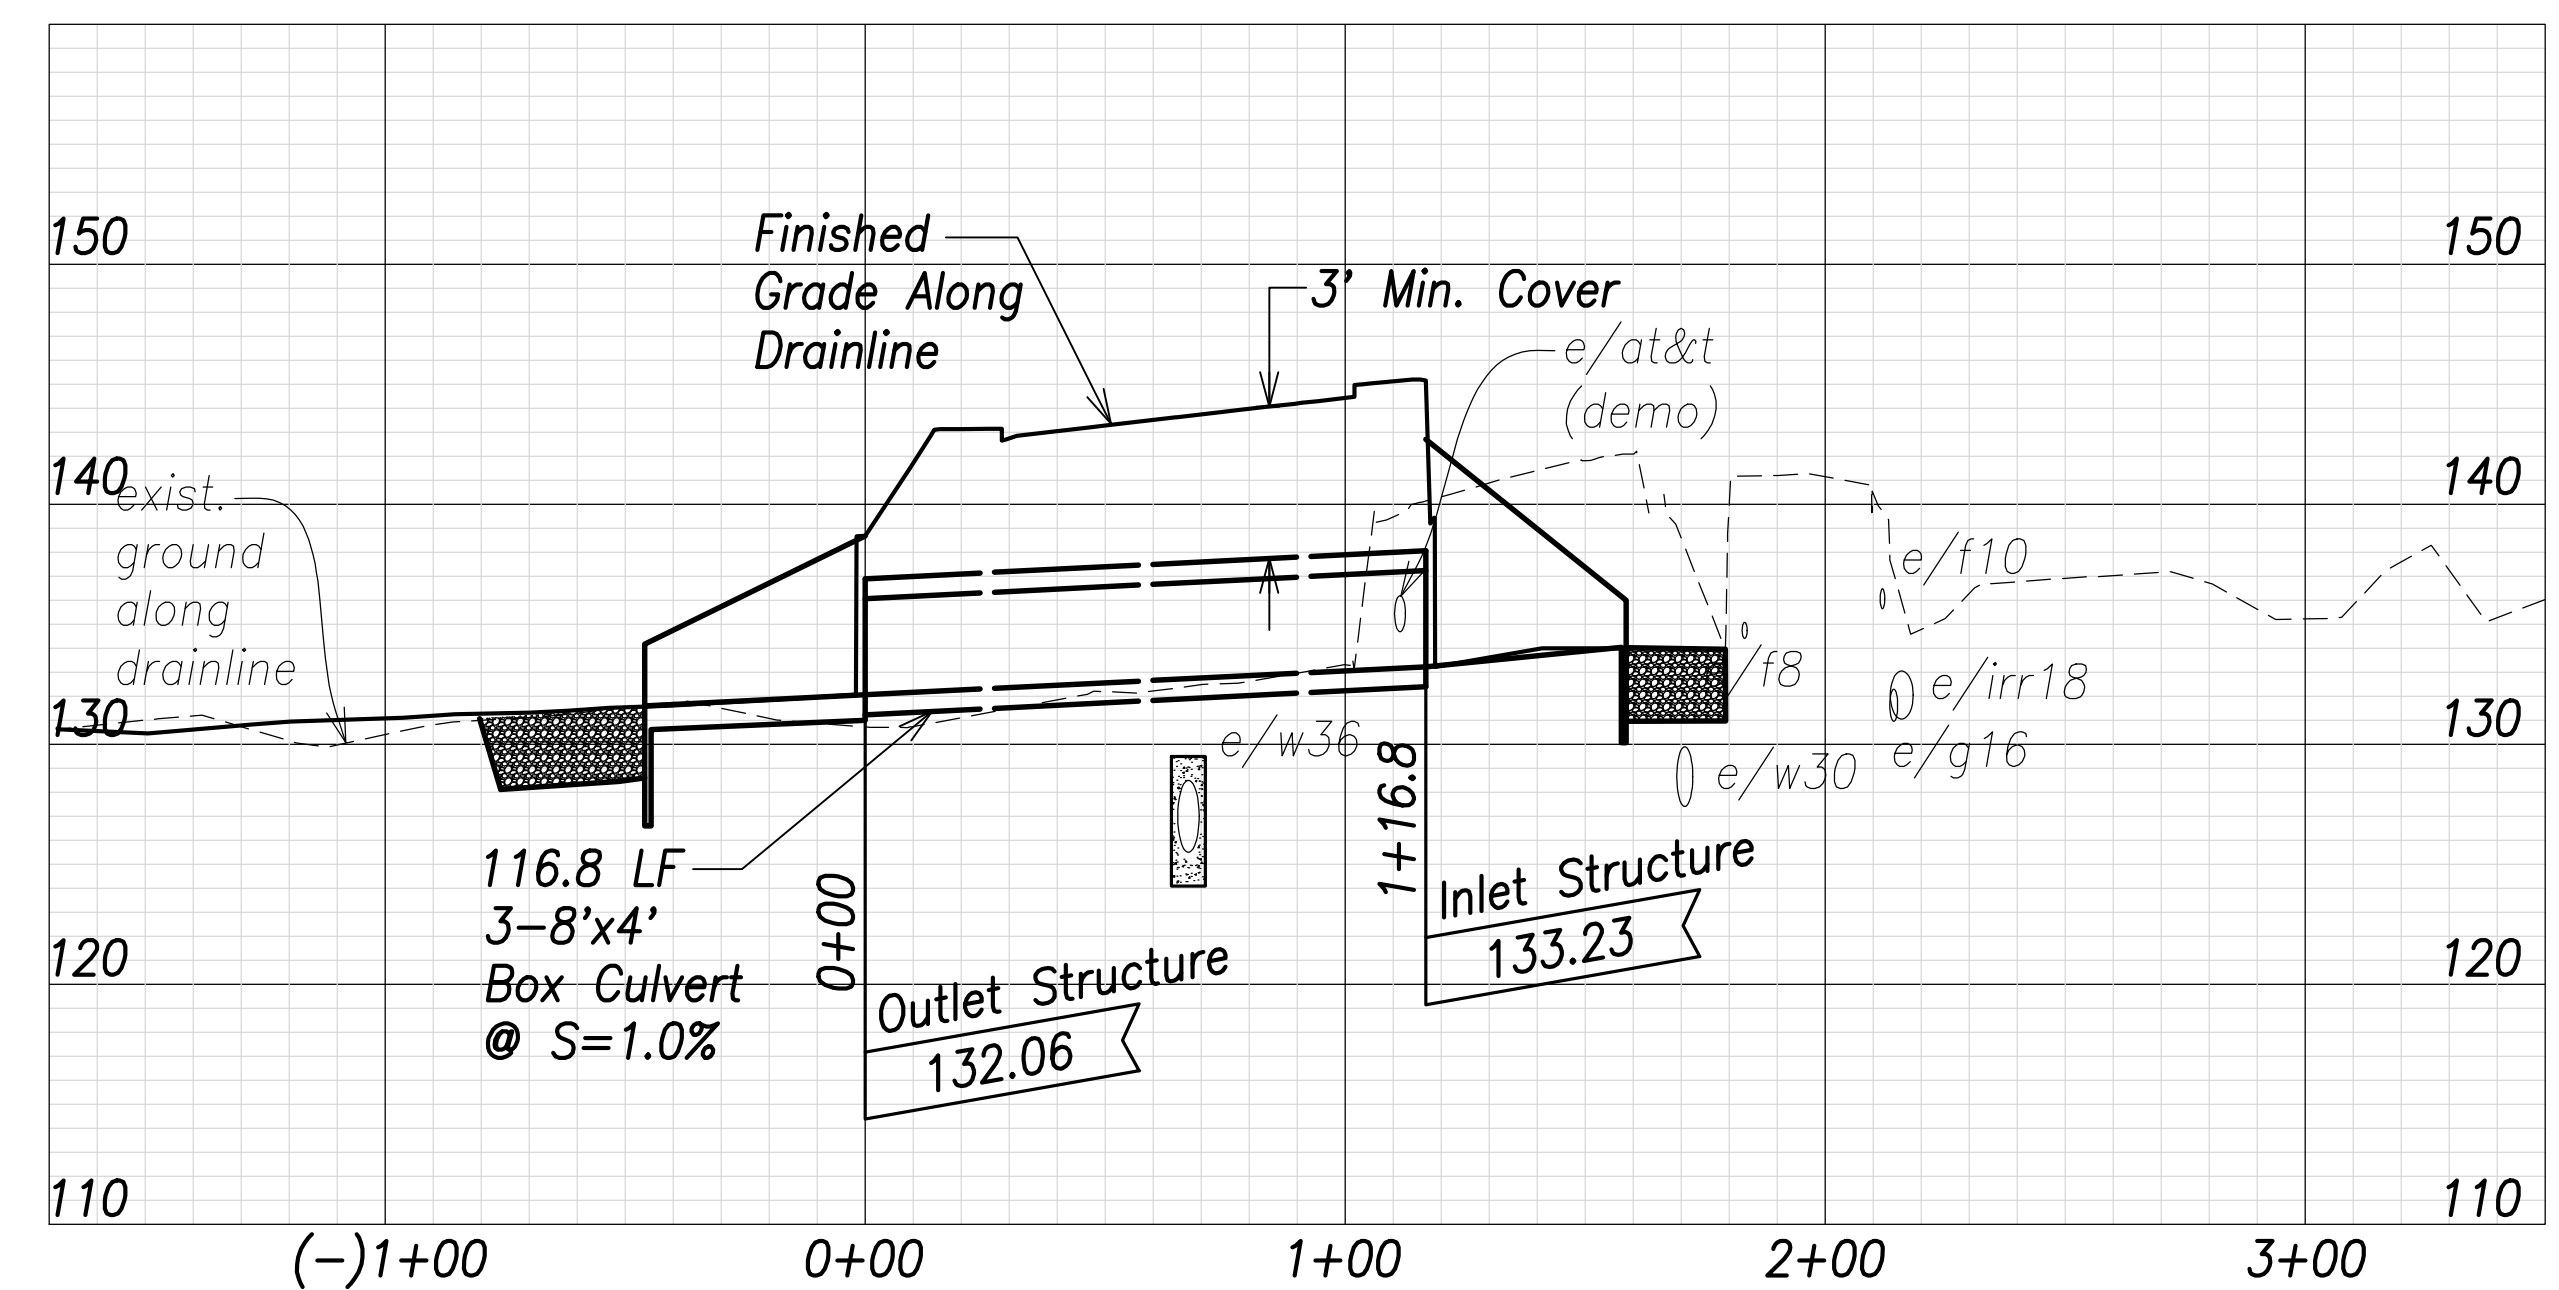

**Box Culvert at 33+90**  
 Scales: Hor.: 1" = 40'  
 Vert.: 1" = 8'

- Notes:**
- The Contractor shall provide Controlled Low Strength Material (CLSM) in areas where required compaction cannot be met. CLSM shall extend a minimum of 2' beyond the waterline at the crossing and shall extend to the top of the crossing pipe.
  - Drain pipe lengths and slopes shown on profiles are calculated from the center of structures.

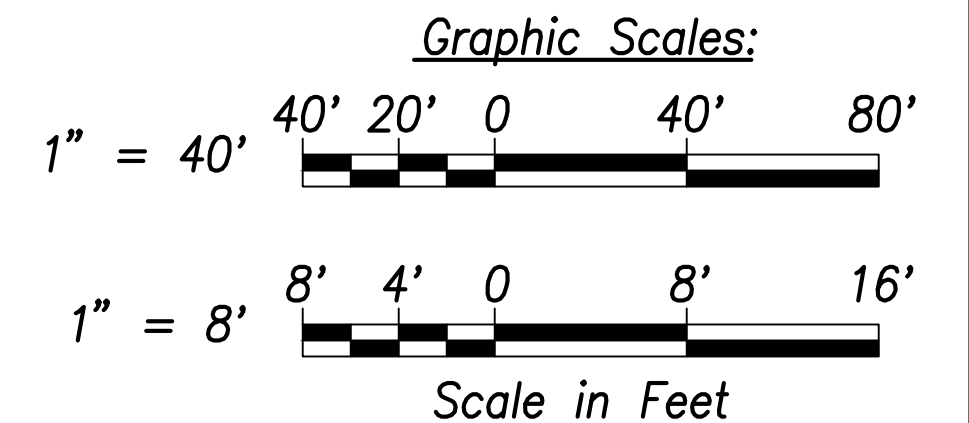

SURVEY PLOTTED BY: _____	DATE: _____
DRAWN BY: _____	TRACED BY: _____
DESIGNED BY: _____	CHECKED BY: _____
NO. _____	



APPROVED:  
 Manager and Chief Engineer, BWS  
 (for work affecting BWS facilities in City/State R/W & BWS easements only)  
 DATE \_\_\_\_\_



THIS WORK WAS PREPARED BY ME OR UNDER MY SUPERVISION AND CONSTRUCTION OF THIS PROJECT WILL BE UNDER MY OBSERVATION.  
 SIGNATURE: \_\_\_\_\_ EXPIRATION DATE OF THE LICENSE: April 30, 2024

07/15/22	Revised Drain Profile
06/08/22	Revised profiles, added note
DATE	REVISION

STATE OF HAWAII  
 DEPARTMENT OF TRANSPORTATION  
 HIGHWAYS DIVISION  
**Drain Profiles - 3**  
 FARRINGTON HIGHWAY WIDENING  
 Kapolei Golf Course Road to Fort Weaver Road  
 Project No. 7101A-01-20  
 Scale: As Shown Date: April 2022





FED. ROAD DIST. NO.	STATE	PROJ. NO.	FISCAL YEAR	SHEET NO.	TOTAL SHEETS
HAWAII	HAW.	7101A-01-20	2021	169	767

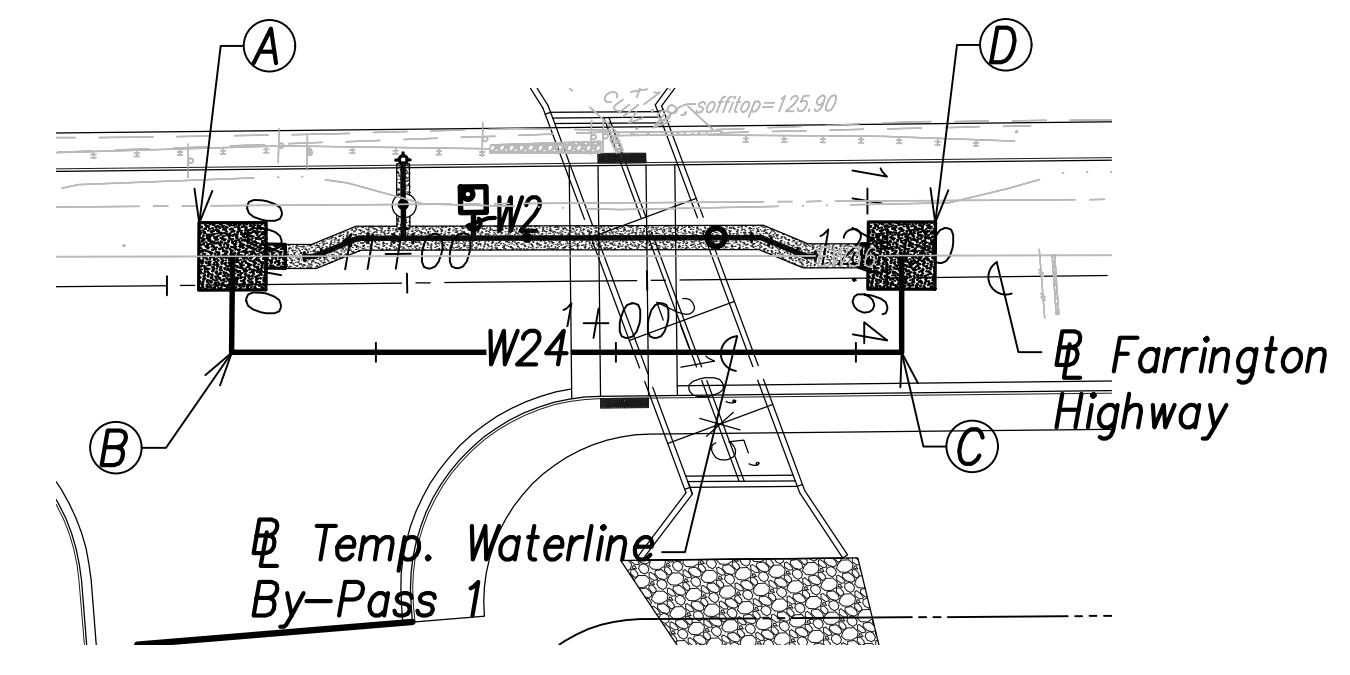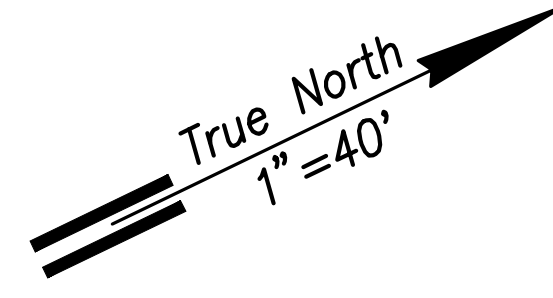


**Temporary Waterline By-Pass 1 Plan**  
 (# Sta. 10+80.7 Farrington Highway)  
 (# Sta. 11+87.1 Farrington Highway)  
 Scale: 1" = 40'

- (A) # Sta. 10+63.7, o/s 5.9' Lt. Farrington Highway  
 =# Sta. 0+00 By-Pass  
 Temporary By-Pass Connection  
 See Detail Shts. C-208 to C-211 (Typ.)
- (B) # Sta. 10+63.3, o/s 14' Rt. Farrington Highway  
 =# Sta. 0+20 By-Pass  
 1-24" 1/4 Bend
- (C) # Sta. 12+02.9, o/s 15.5' Rt. Farrington Highway  
 =# Sta. 1+59.5 By-Pass  
 1-24" 1/4 Bend
- (D) # Sta. 12+03, o/s 4.6' Lt. Farrington Highway  
 =# Sta. 1+79.6 By-Pass  
 Temporary By-Pass Connection  
 See Detail Shts. C-208 to C-211 (Typ.)

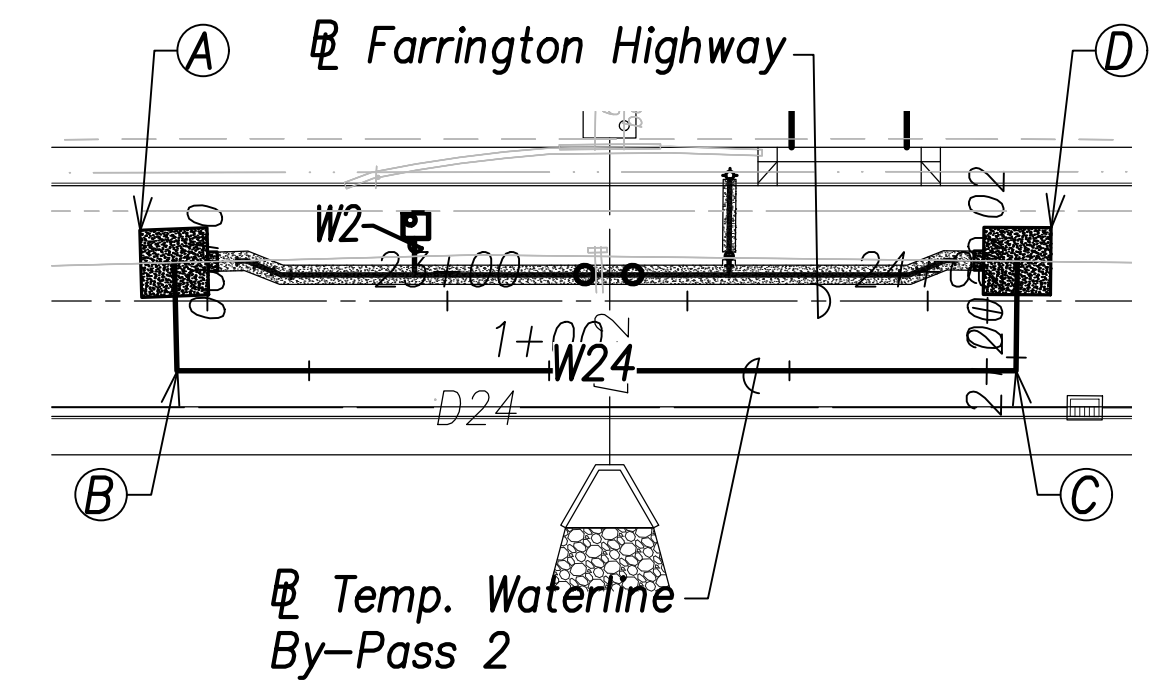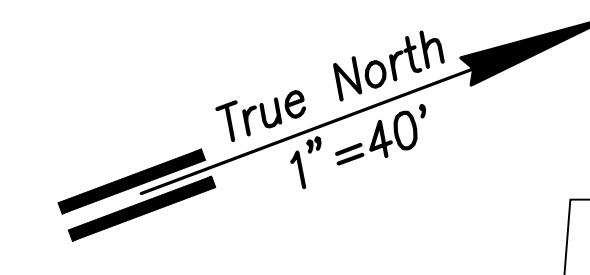


**Temporary Waterline By-Pass 2 Plan**  
 (# Sta. 22+58.1 Farrington Highway)  
 (# Sta. 24+05 Farrington Highway)  
 Scale: 1" = 40'

- (A) # Sta. 22+43.1, o/s 8' Lt. Farrington Highway  
 =# Sta. 0+00 By-Pass  
 Temporary By-Pass Connection  
 See Detail Shts. C-208 to C-211 (Typ.)
- (B) # Sta. 22+43.7, o/s 14.5' Rt. Farrington Highway  
 =# Sta. 0+22.5 By-Pass  
 1-24" 1/4 Bend
- (C) # Sta. 24+18.4, o/s 14.5' Rt. Farrington Highway  
 =# Sta. 1+97.2 By-Pass  
 1-24" 1/4 Bend
- (D) # Sta. 24+18.7, o/s 8.3' Lt. Farrington Highway  
 =# Sta. 2+20 By-Pass  
 Temporary By-Pass Connection  
 See Detail Shts. C-208 to C-211 (Typ.)

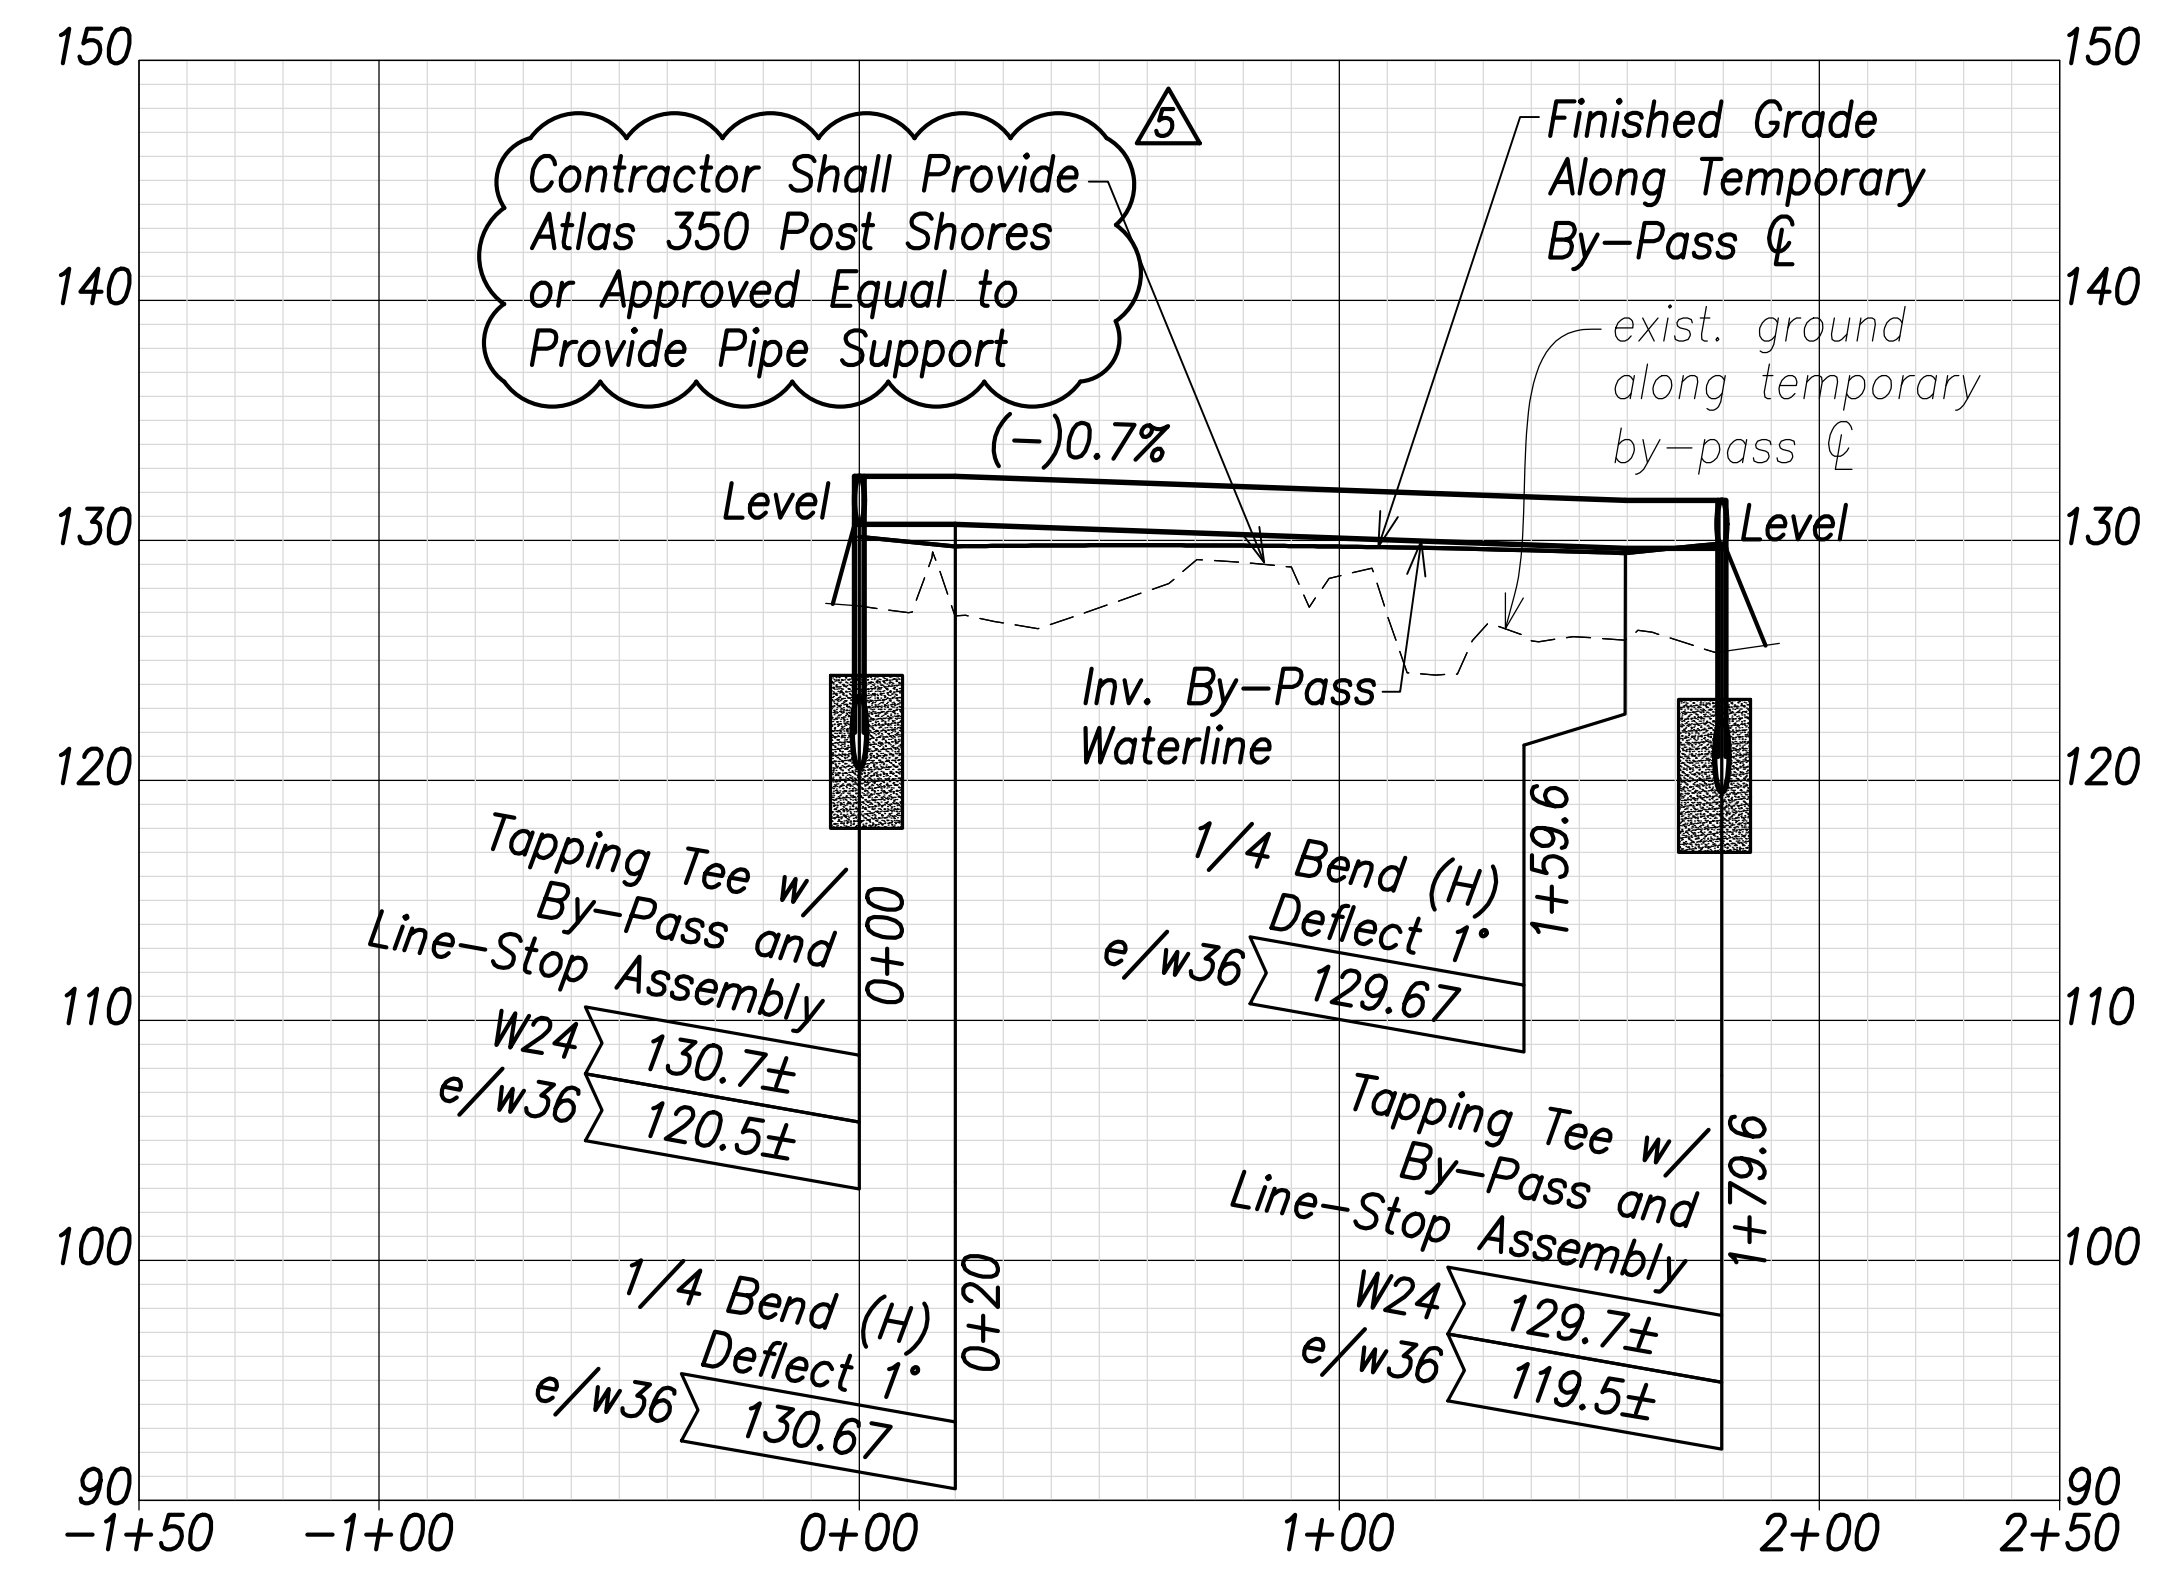



**Temporary Waterline By-Pass 1 Profile**  
 Scales: Hor.: 1" = 40'  
 Vert.: 1" = 8'

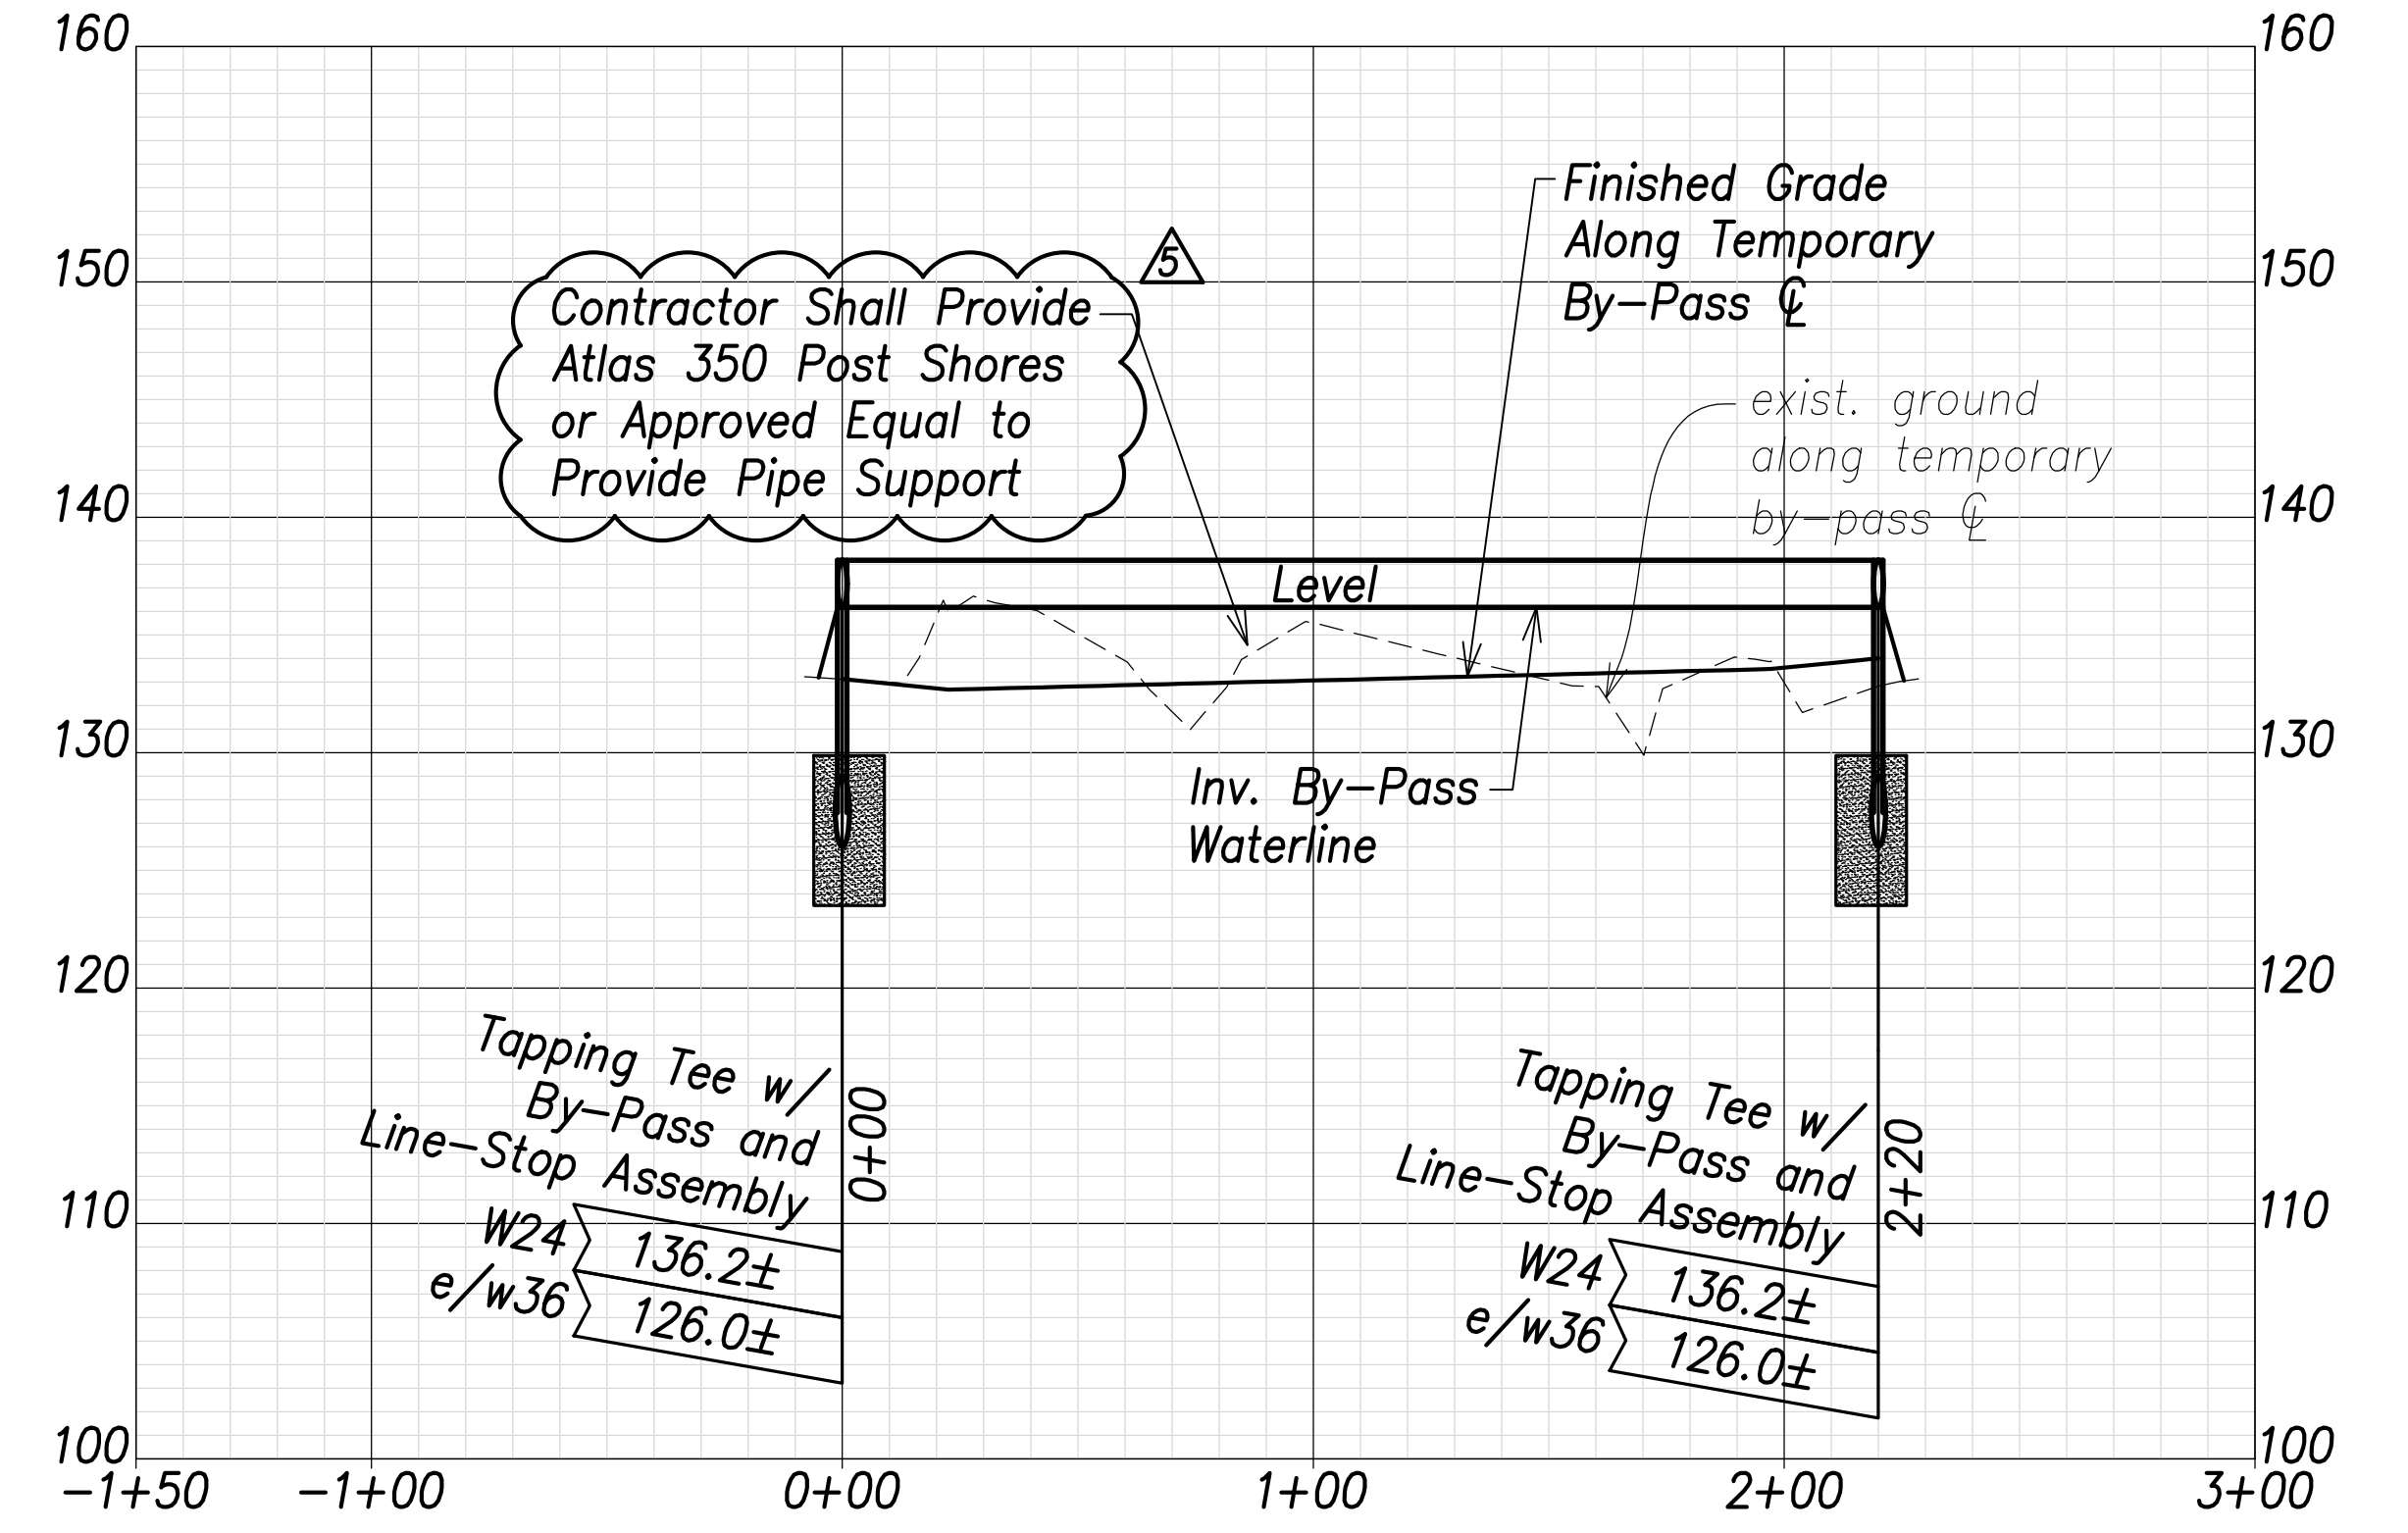

**Temporary Waterline By-Pass 2 Profile**  
 Scales: Hor.: 1" = 40'  
 Vert.: 1" = 8'

- Notes:**
- Contractor shall provide mechanical joint pipes and fittings with retainer glands and/or flanged pipes and fittings to construct the temporary by-passes
  - The Contractor shall submit the construction schedule and construction phasing for the temporary by-passes to BWS for review and approval. The Contractor shall not commence work on the temporary by-passes until approval is obtained by BWS.

APPROVED: \_\_\_\_\_ DATE \_\_\_\_\_  
 Manager and Chief Engineer, BWS  
 (for work affecting BWS facilities in City/State R/W & BWS easements only)

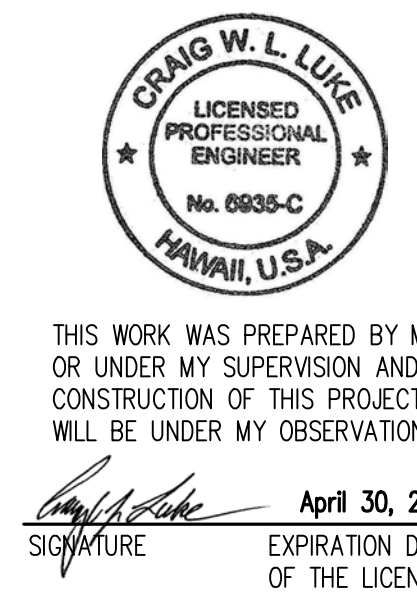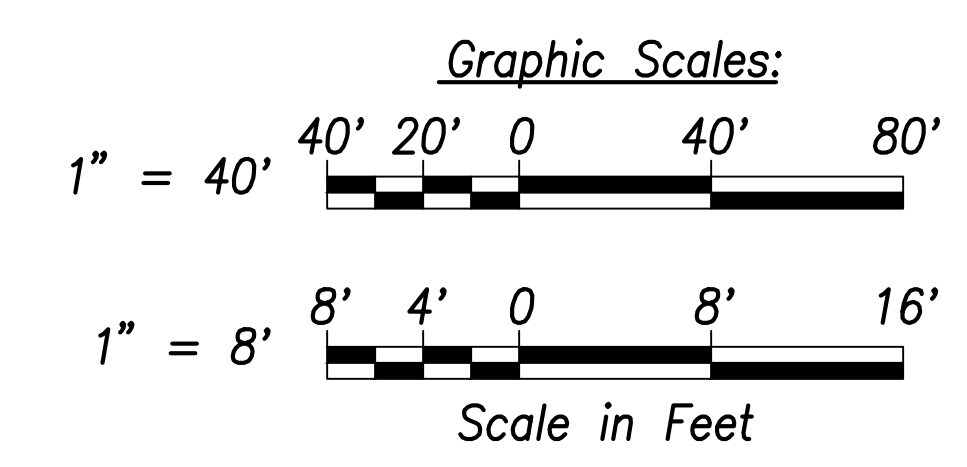

07/15/22	Revised callouts; Added note
DATE	REVISION

STATE OF HAWAII  
 DEPARTMENT OF TRANSPORTATION  
 HIGHWAYS DIVISION

**Waterline Connection and Temporary By-Pass - 1**


FARRINGTON HIGHWAY WIDENING  
 Kapolei Golf Course Road to Fort Weaver Road  
 Project No. 7101A-01-20

Scale: As Shown    Date: April 2022

SHEET No. C-168 OF 767 SHEETS


SURVEY PLOTTED BY: _____	DATE: _____
DRAWN BY: _____	TRACED BY: _____
DESIGNED BY: _____	CHECKED BY: _____
NOTE BOOK No. _____	

FED. ROAD DIST. NO.	STATE	PROJ. NO.	FISCAL YEAR	SHEET NO.	TOTAL SHEETS
HAWAII	HAW.	7101A-01-20	2021	170	767

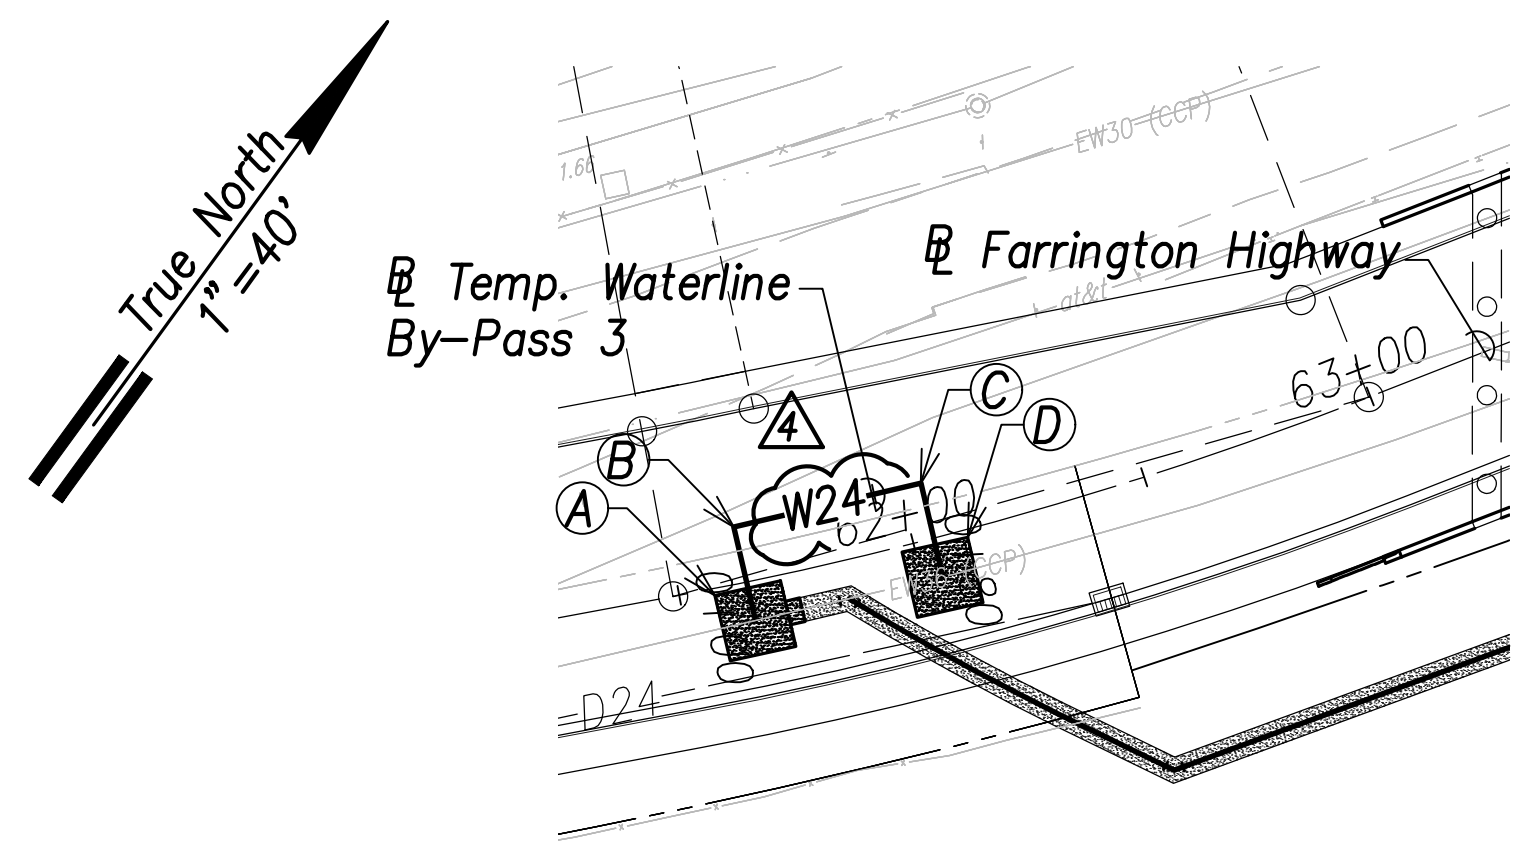


**Temporary Waterline By-Pass 3 Plan**  
 (# Sta. 61+84.3 Farrington Highway)  
 Scale: 1" = 40'

- (A) Sta. 61+64.6, o/s 8.2' Rt. Farrington Highway  
 = Sta. 0+00 By-Pass  
 Temporary By-Pass Connection  
 See Detail Shts. C-208 to C-211 (Typ.)
- (B) Sta. 61+6.0, o/s 11.8' Lt. Farrington Highway  
 = Sta. 0+20 By-Pass  
 1-24" 1/4 Bend
- (C) Sta. 62+04.7, o/s 11.8' Lt. Farrington Highway  
 = Sta. 0+60 By-Pass  
 1-24" 1/4 Bend
- (D) Sta. 62+04.1, o/s 8.2' Rt. Farrington Highway  
 = Sta. 0+80 By-Pass  
 Temporary By-Pass Connection  
 See Detail Shts. C-208 to C-211 (Typ.)

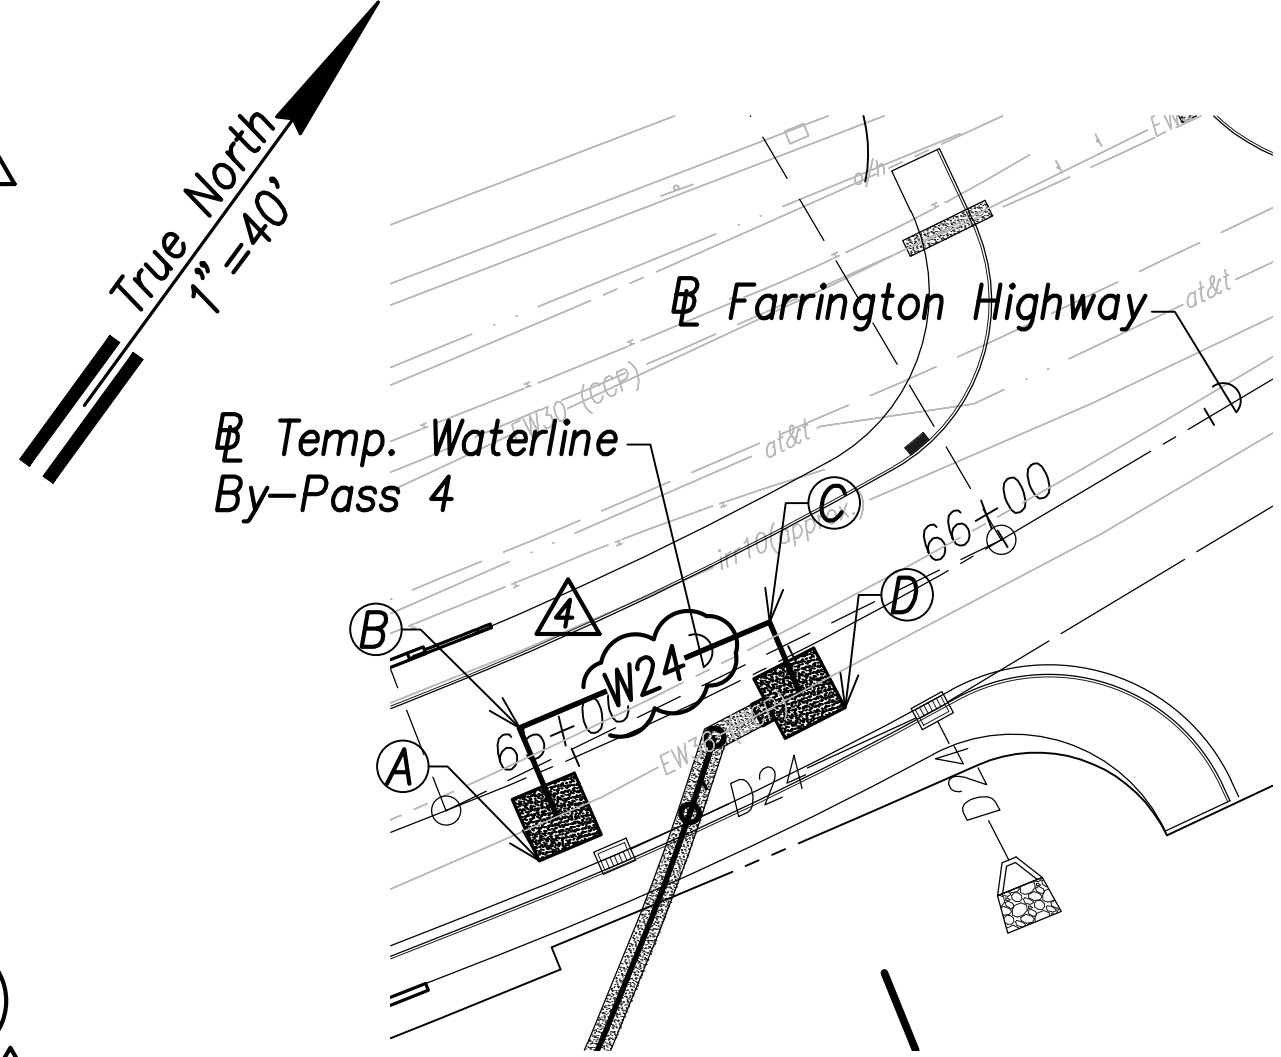


**Temporary Waterline By-Pass 4 Plan**  
 (# Sta. 65+28.2 Farrington Highway)  
 Scale: 1" = 40'

- (A) Sta. 64+91.7, o/s 9.9' Rt. Farrington Highway  
 = Sta. 0+00 By-Pass  
 Temporary By-Pass Connection  
 See Detail Shts. C-208 to C-211 (Typ.)
- (B) Sta. 64+91.6, o/s 10.1' Lt. Farrington Highway  
 = Sta. 0+20 By-Pass  
 1-24" 1/4 Bend
- (C) Sta. 65+48.9, o/s 8.2' Lt. Farrington Highway  
 = Sta. 0+76.6 By-Pass  
 1-24" 1/4 Bend
- (D) Sta. 65+47.8, o/s 7.7' Rt. Farrington Highway  
 = Sta. 0+92.6 By-Pass  
 Temporary By-Pass Connection  
 See Detail Shts. C-208 to C-211 (Typ.)

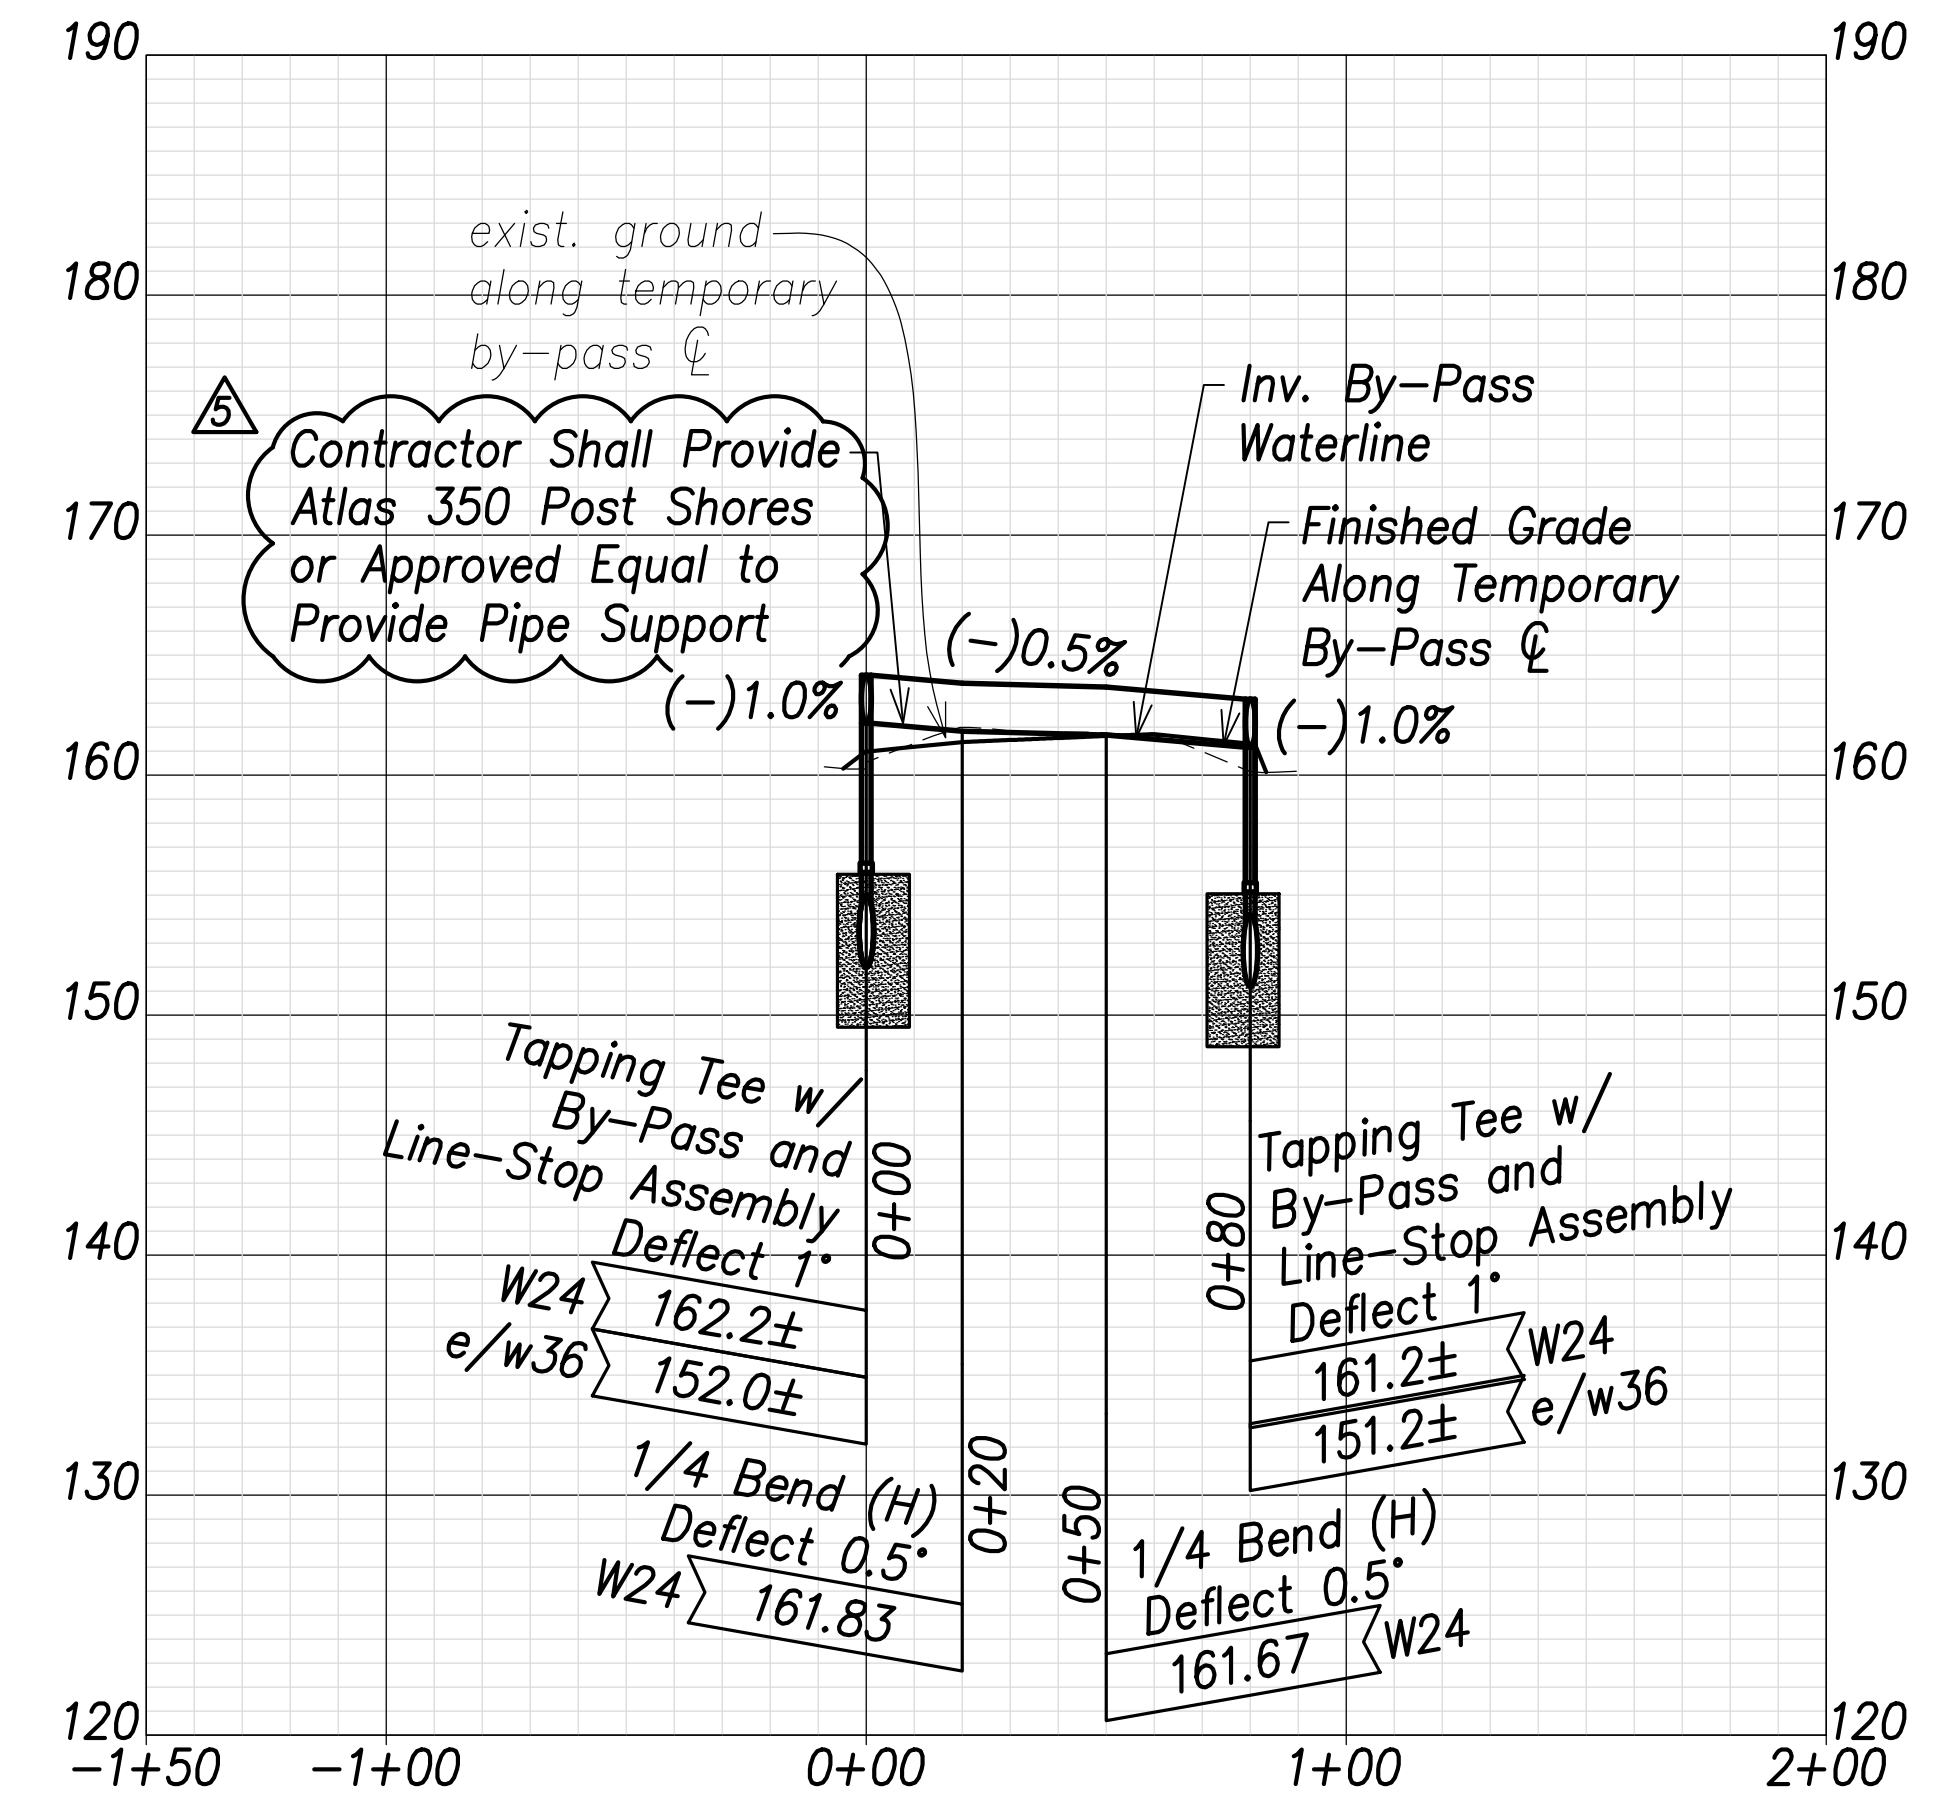

**Temporary Waterline By-Pass 3 Profile**  
 Scales: Hor.: 1" = 40'  
 Vert.: 1" = 8'

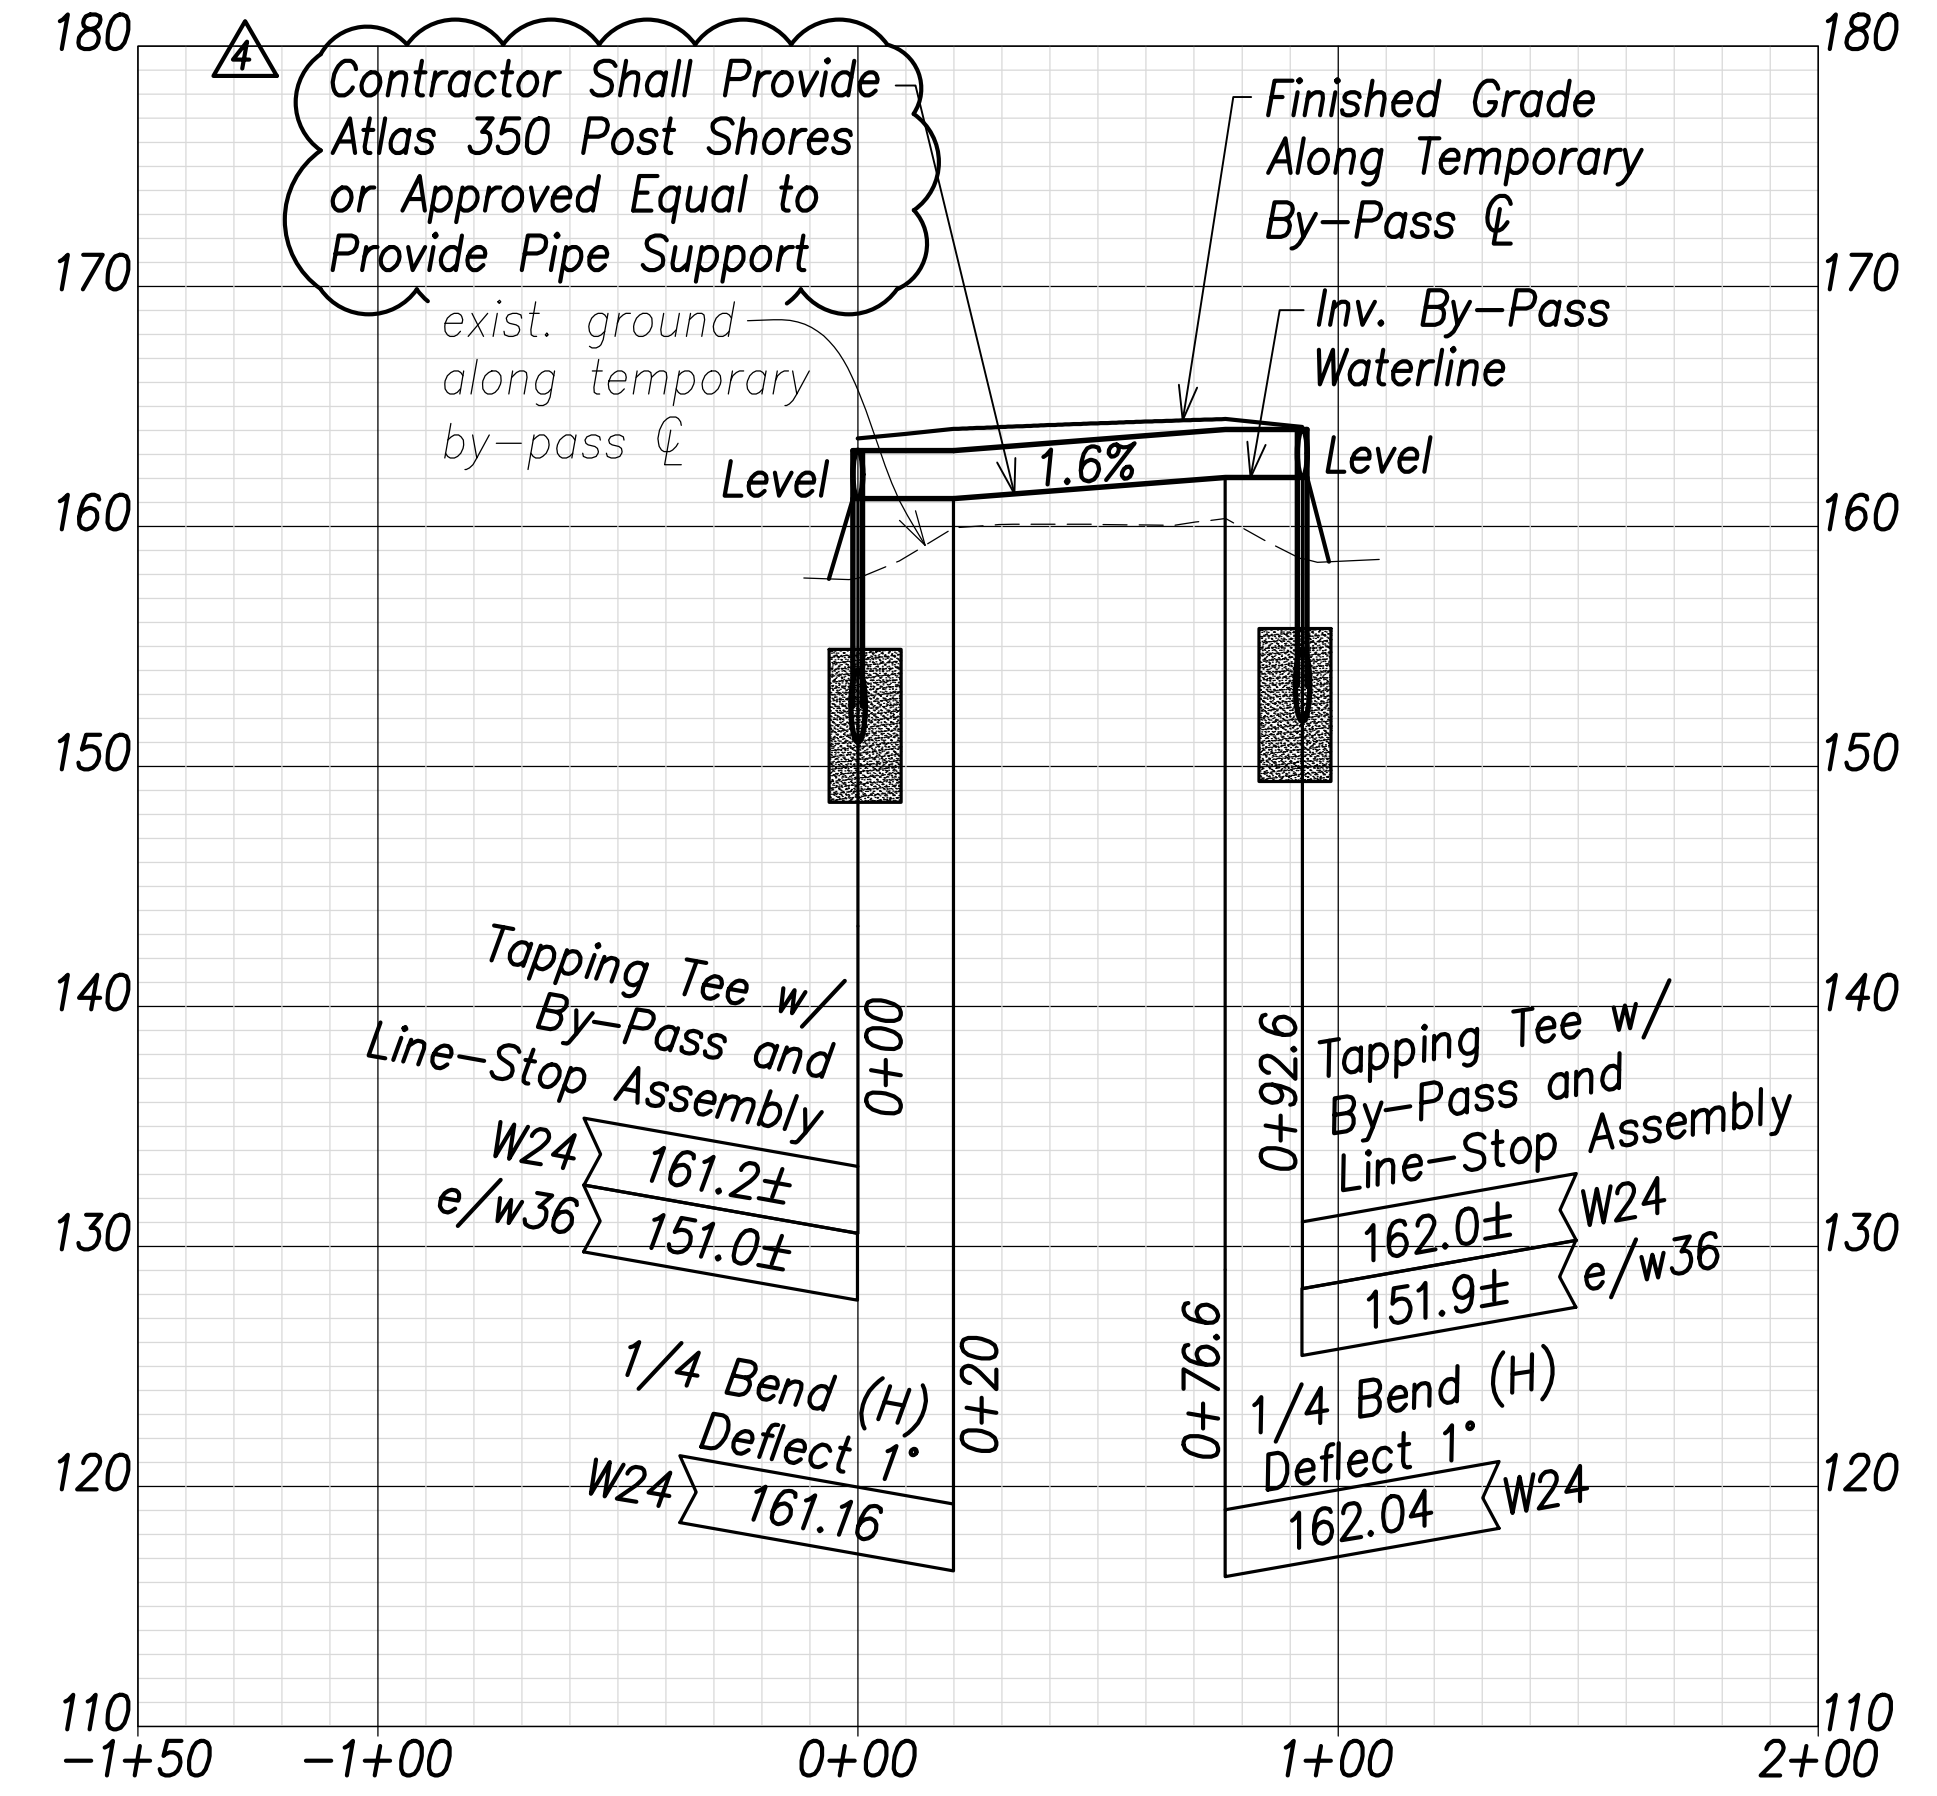


**Temporary Waterline By-Pass 4 Profile**  
 Scales: Hor.: 1" = 40'  
 Vert.: 1" = 8'

**Notes:**

- Contractor shall provide mechanical joint pipes and fittings with retainer glands and/or flanged pipes and fittings to construct the temporary by-passes
- The Contractor shall submit the construction schedule and construction phasing for the temporary by-passes to BWS for review and approval. The Contractor shall not commence work on the temporary by-passes until approval is obtained by BWS.

SURVEY PLOTTED BY:	DATE:
DRAWN BY:	
TRACED BY:	
CHECKED BY:	
ORIGINAL PLAN NO.:	
NOTE BOOK NO.:	

APPROVED: \_\_\_\_\_ DATE \_\_\_\_\_  
 Manager and Chief Engineer, BWS  
 (for work affecting BWS facilities in City/State R/W & BWS easements only)

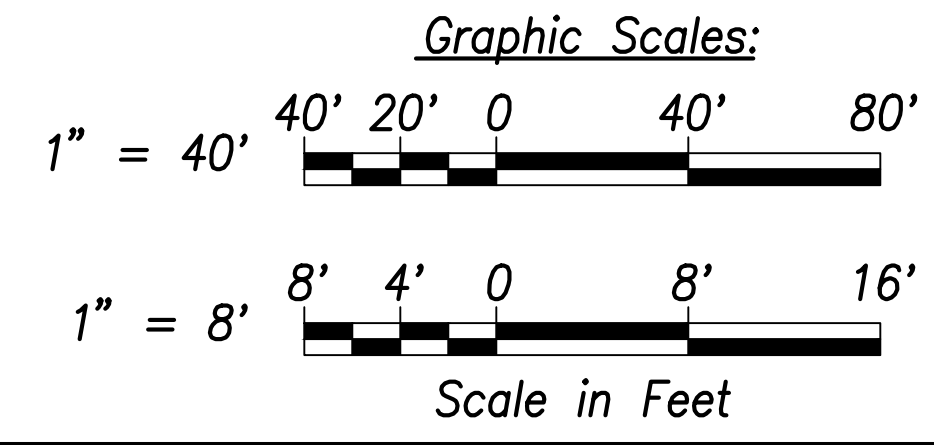

THIS WORK WAS PREPARED BY ME OR UNDER MY SUPERVISION AND CONSTRUCTION OF THIS PROJECT WILL BE UNDER MY OBSERVATION.  
 SIGNATURE: \_\_\_\_\_ EXPIRATION DATE OF LICENSE: April 30, 2024

DATE	REVISION
07/15/22	Revised callouts; Added note; Added waterline labels
06/08/22	Callout Revised

STATE OF HAWAII  
 DEPARTMENT OF TRANSPORTATION  
 HIGHWAYS DIVISION

**Waterline Connection and Temporary By-Pass - 2**



FARRINGTON HIGHWAY WIDENING  
 Kapolei Golf Course Road to Fort Weaver Road  
 Project No. 7101A-01-20

Scale: As Shown Date: April 2022

SHEET NO. C-169 OF 767 SHEETS





FED. ROAD DIST. NO.	STATE	PROJ. NO.	FISCAL YEAR	SHEET NO.	TOTAL SHEETS
HAWAII	HAW.	7101A-01-20	2021	171	767

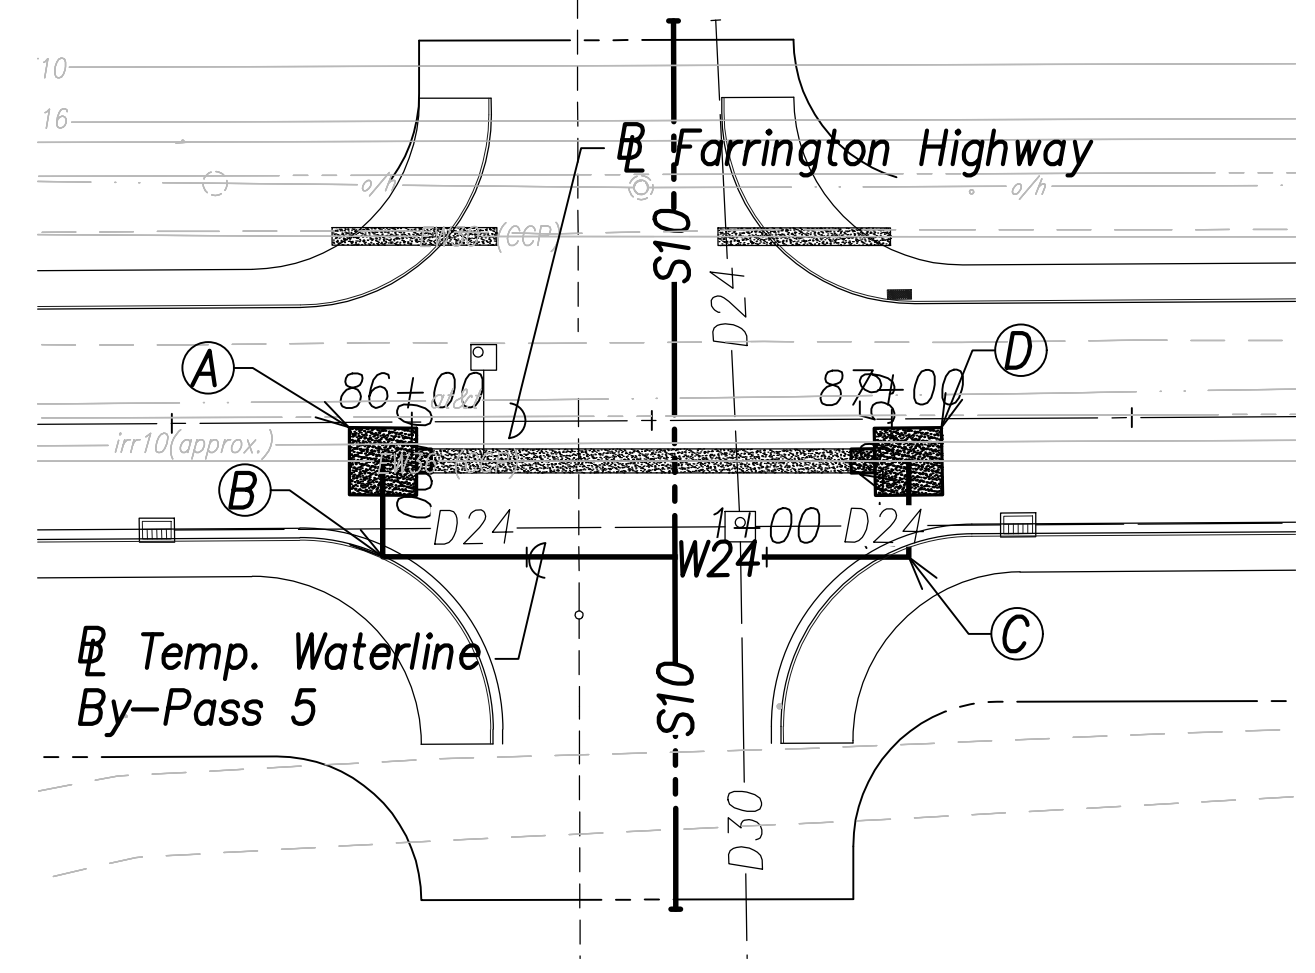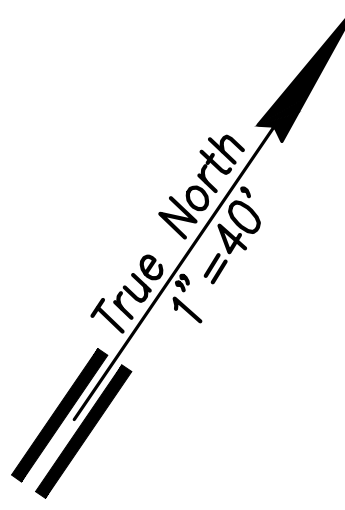


**Temporary Waterline By-Pass 5 Plan**  
 (Sta. 86+10 Farrington Highway)  
 (Sta. 86+85.5 Farrington Highway)  
 Scale: 1" = 40'

- (A) Sta. 85+93.9, o/s 8.1' Rt. Farrington Highway  
 = Sta. 0+00 By-Pass  
 Temporary By-Pass Connection  
 See Detail Shts. C-208 to C-211 (Typ.)
- (B) Sta. 85+93.8, o/s 28.0' Rt. Farrington Highway  
 = Sta. 0+20 By-Pass  
 1-24" 1/4 Bend
- (C) Sta. 87+03.4, o/s 28.8' Rt. Farrington Highway  
 = Sta. 1+29.6 By-Pass  
 1-24" 1/4 Bend
- (D) Sta. 87+15, o/s 8.8' Rt. Farrington Highway  
 = Sta. 1+49.6 By-Pass  
 Temporary By-Pass Connection  
 See Detail Shts. C-208 to C-211 (Typ.)

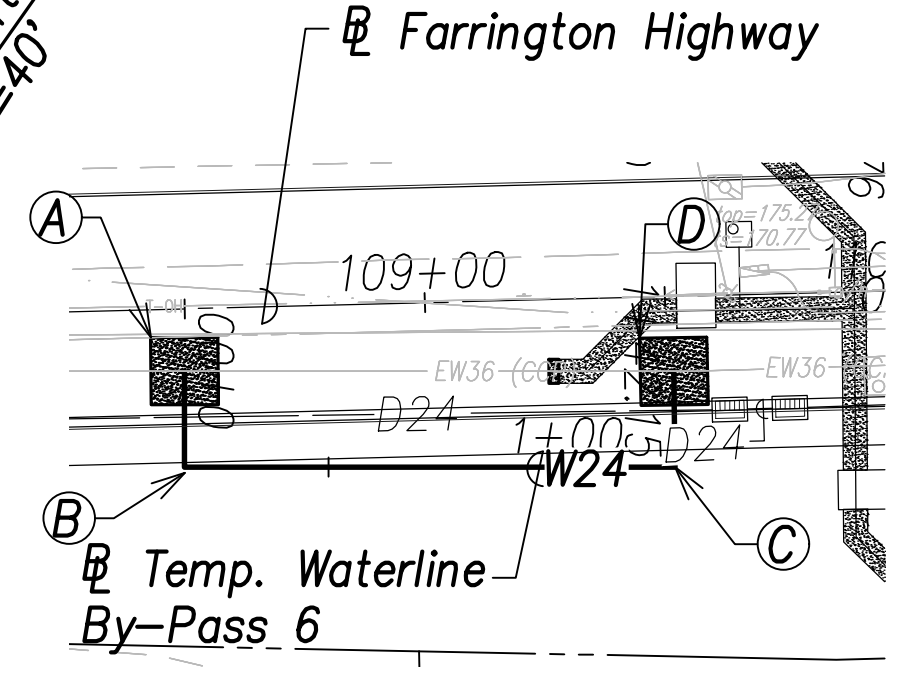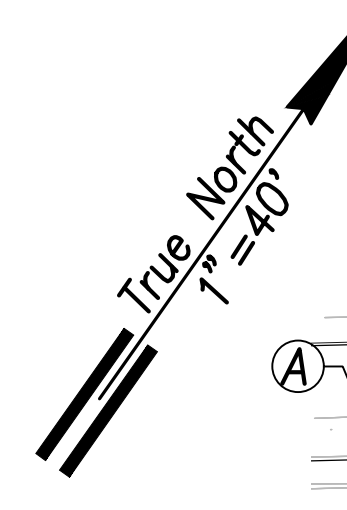


**Temporary Waterline By-Pass 6 Plan**  
 (Sta. 109+33.6 Farrington Highway)  
 Scale: 1" = 40'

- (A) Sta. 108+49.6, o/s 13' Rt. Farrington Highway  
 = Sta. 0+00 By-Pass  
 Temporary By-Pass Connection  
 See Detail Shts. C-208 to C-211 (Typ.)
- (B) Sta. 108+49.1, o/s 34.1' Rt. Farrington Highway  
 = Sta. 0+20 By-Pass  
 1-24" 1/4 Bend
- (C) Sta. 109+51.2, o/s 35.6' Rt. Farrington Highway  
 = Sta. 1+22.15 By-Pass  
 1-24" 1/4 Bend
- (D) Sta. 109+51.5, o/s 15.6' Rt. Farrington Highway  
 = Sta. 1+42.15 By-Pass  
 Temporary By-Pass Connection  
 See Detail Shts. C-208 to C-211 (Typ.)

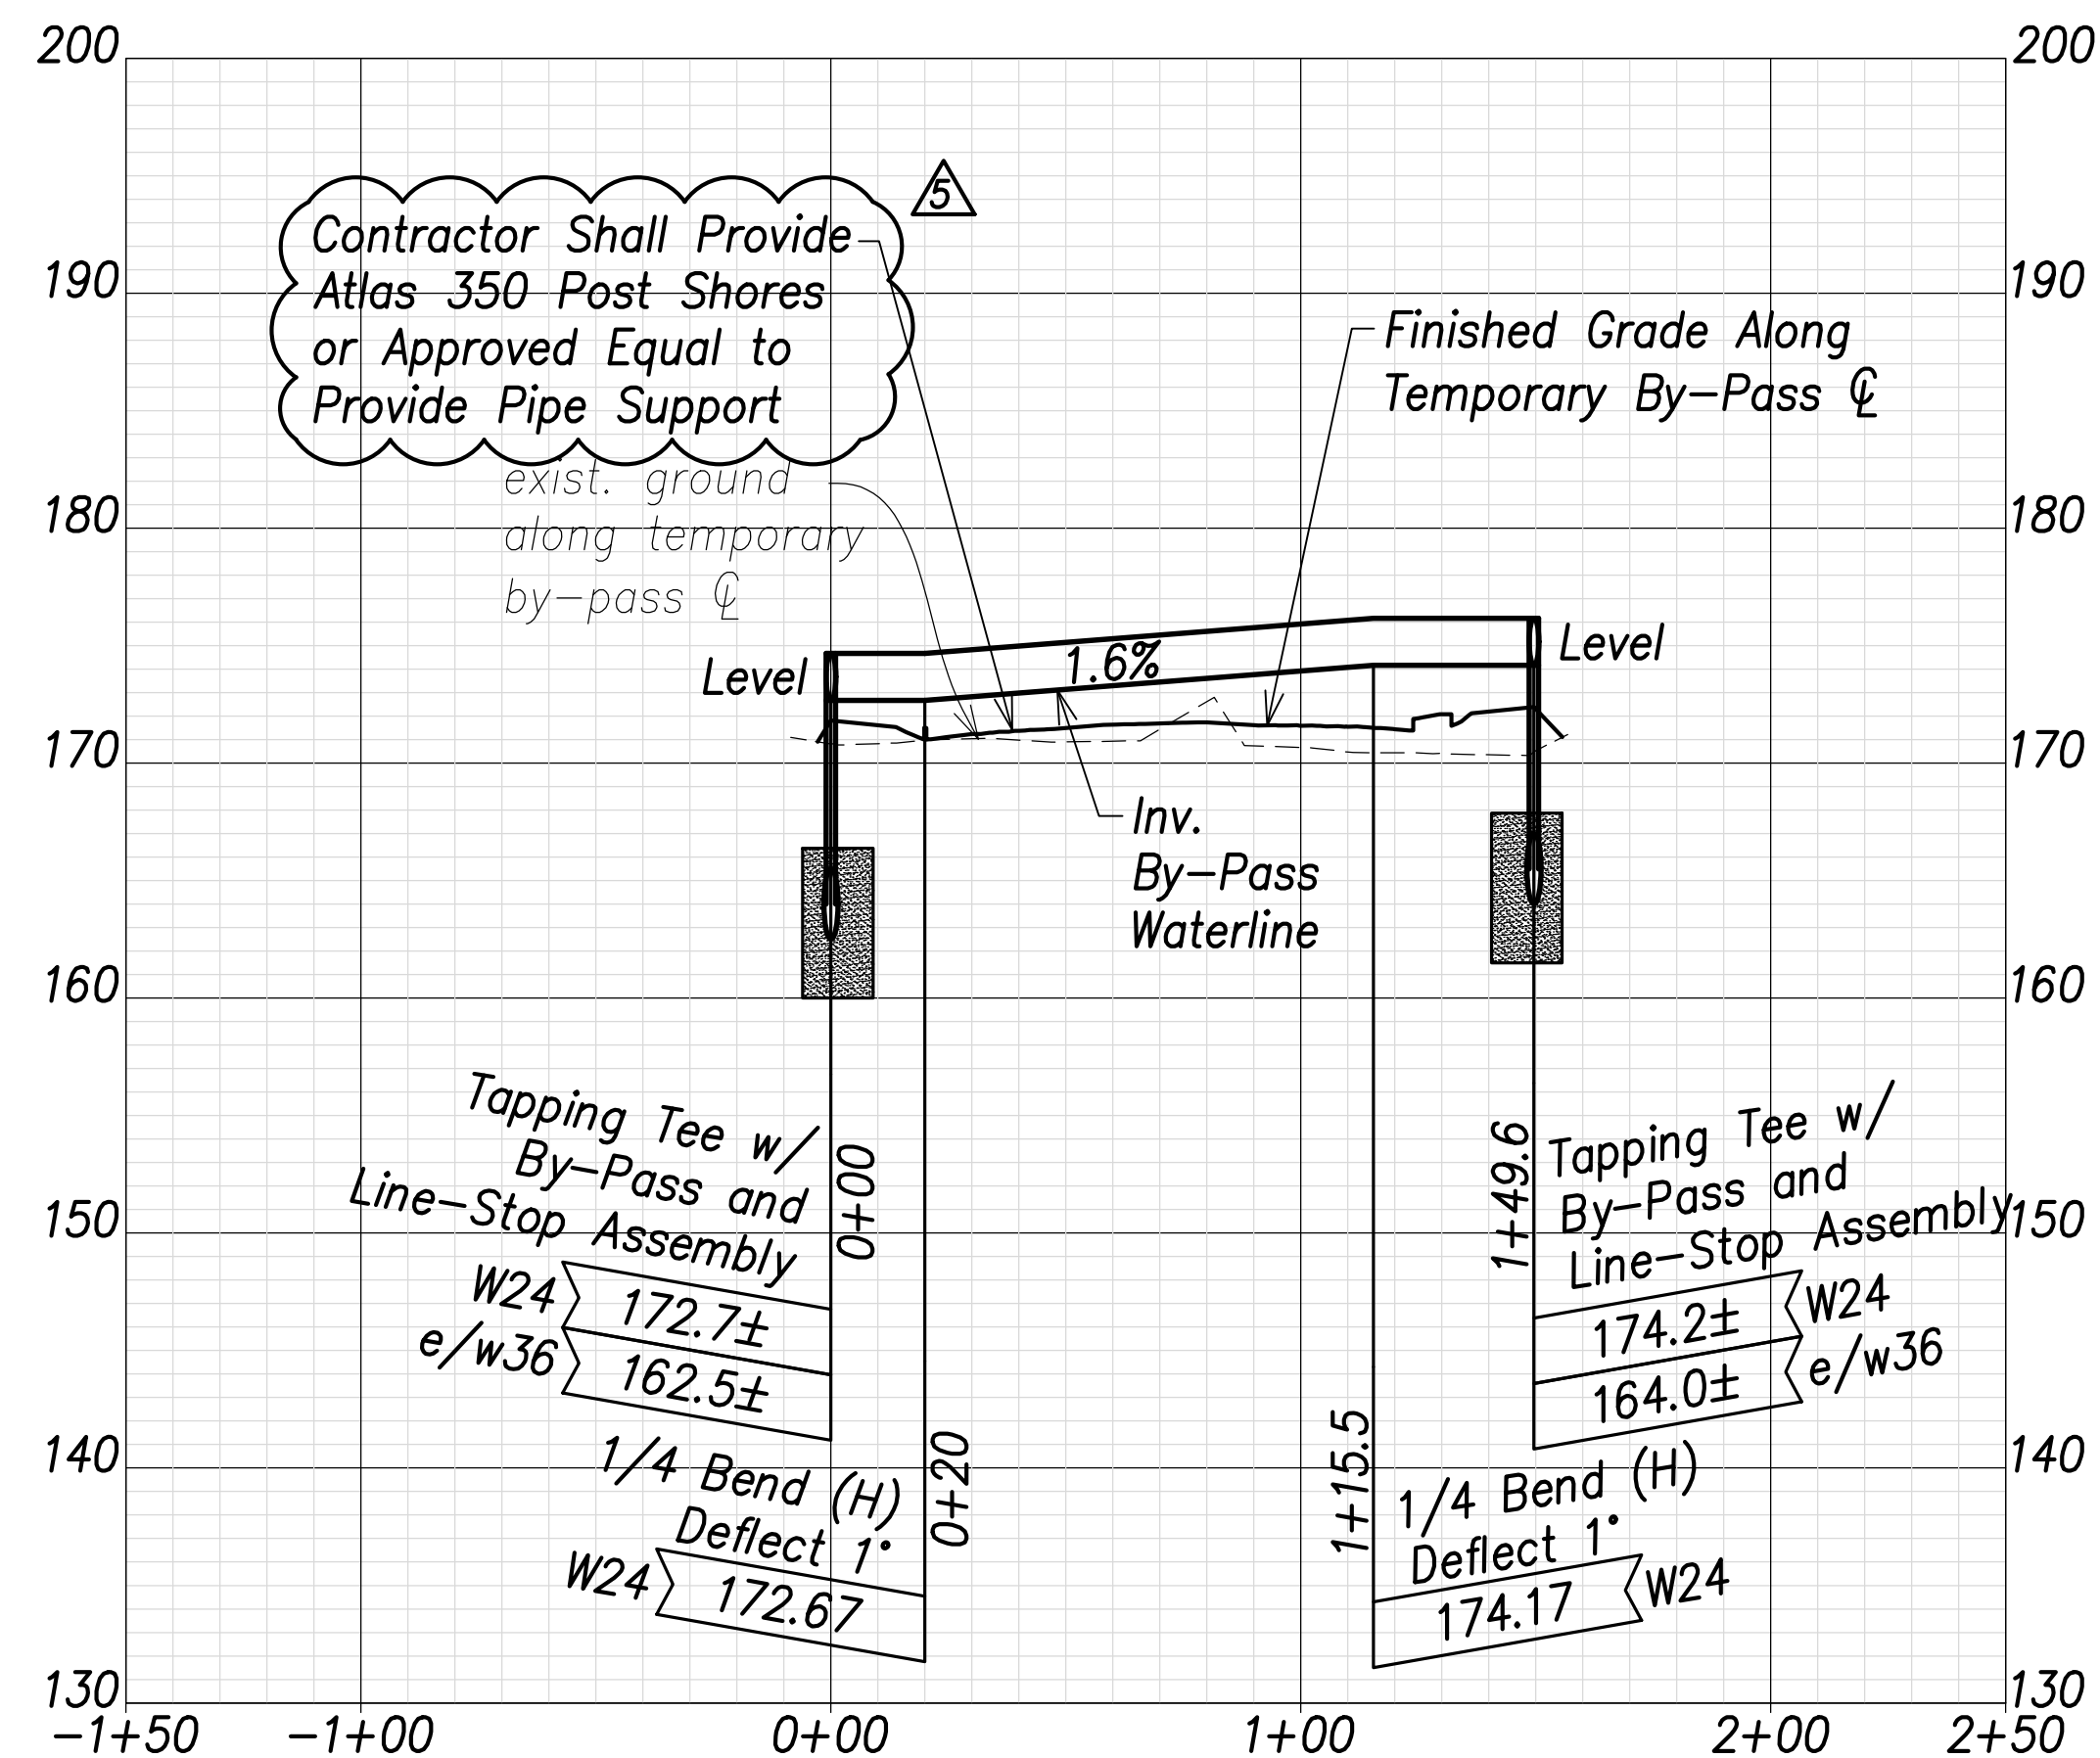

**Temporary Waterline By-Pass 5 Profile**  
 Scales: Hor.: 1" = 40'  
 Vert.: 1" = 8'

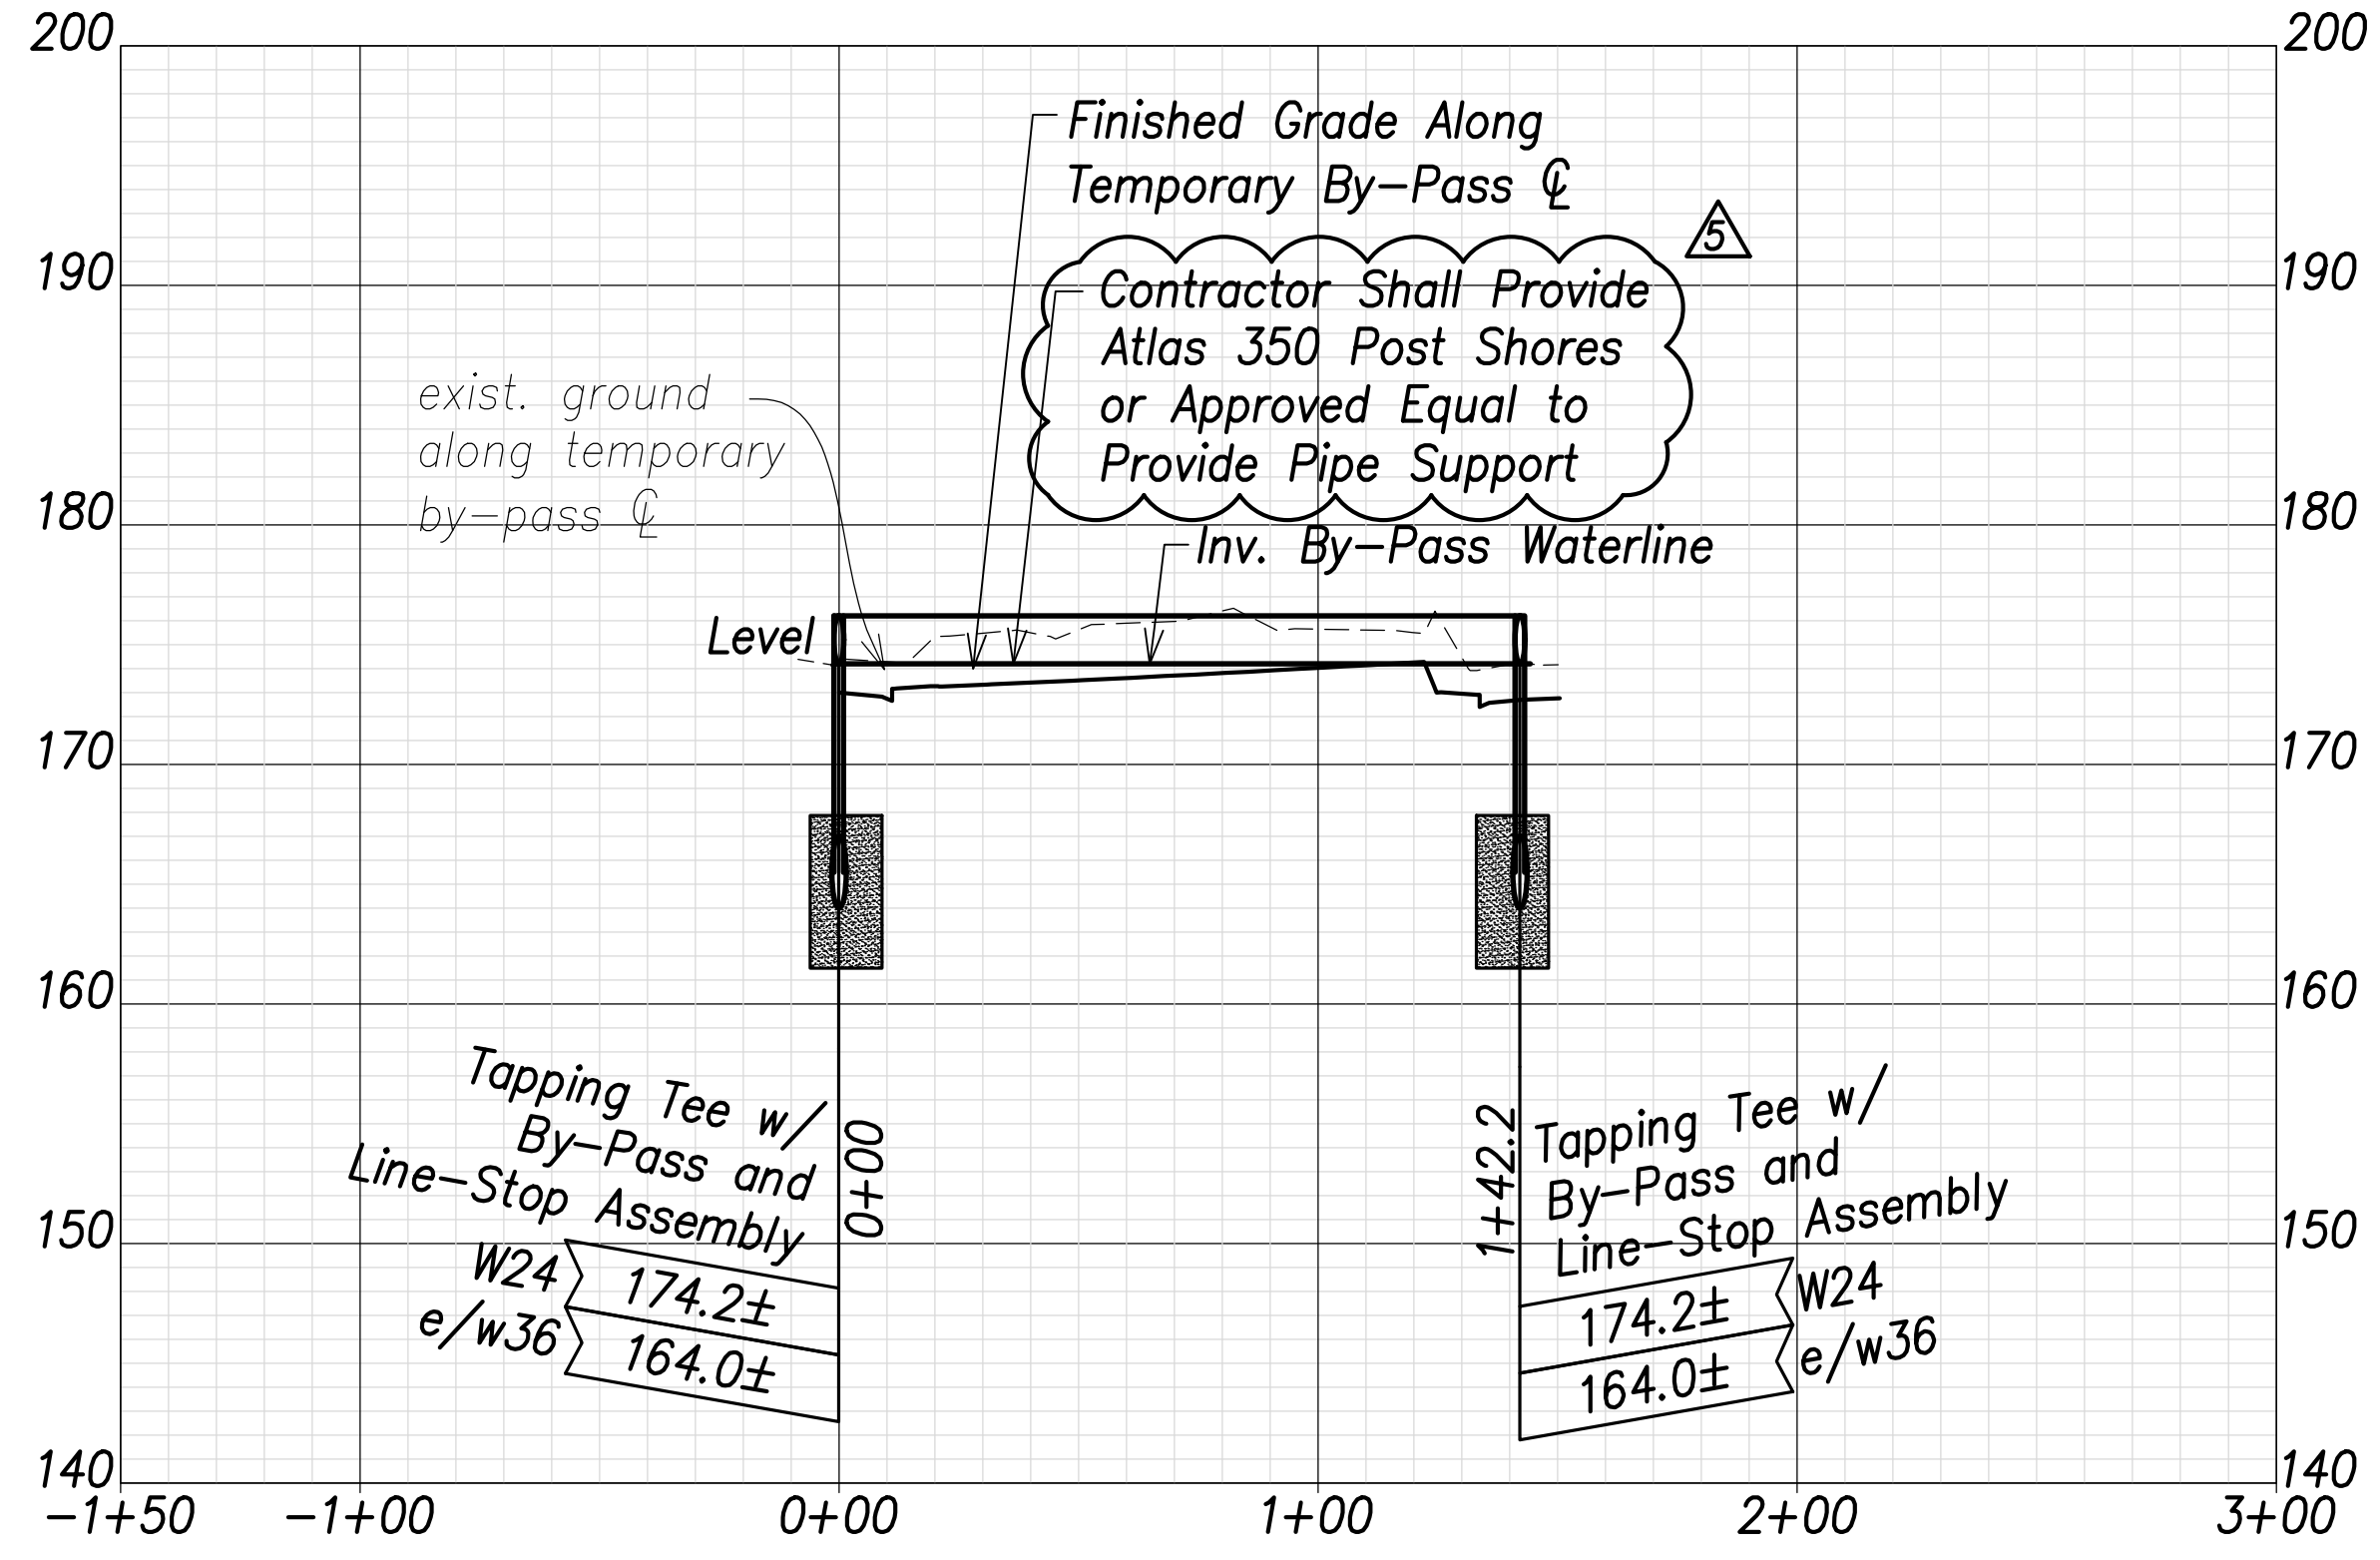



**Temporary Waterline By-Pass 6 Profile**  
 Scales: Hor.: 1" = 40'  
 Vert.: 1" = 8'

- Notes:**
- Contractor shall provide mechanical joint pipes and fittings with retainer glands and/or flanged pipes and fittings to construct the temporary by-passes
  - The Contractor shall submit the construction schedule and construction phasing for the temporary by-passes to BWS for review and approval. The Contractor shall not commence work on the temporary by-passes until approval is obtained by BWS.
  - Contractor to probe and layout manhole and bypass block prior to block construction.

DATE	REVISION
07/15/22	Revised callouts; added note
06/08/22	Revised By-Pass Alignment & Profile

SURVEY PLOTTED BY	DATE
DRAWN BY	
TRACED BY	
QUANTITIES BY	
CHECKED BY	
ORIGINAL PLAN	
NOTE BOOK	
No.	

APPROVED:  
 Manager and Chief Engineer, BWS  
 (for work affecting BWS facilities in City/State R/W & BWS easements only)

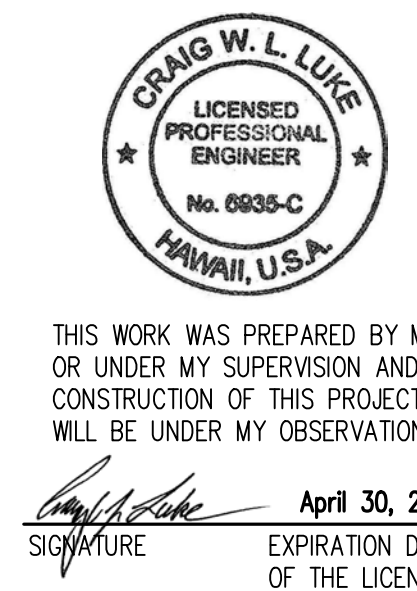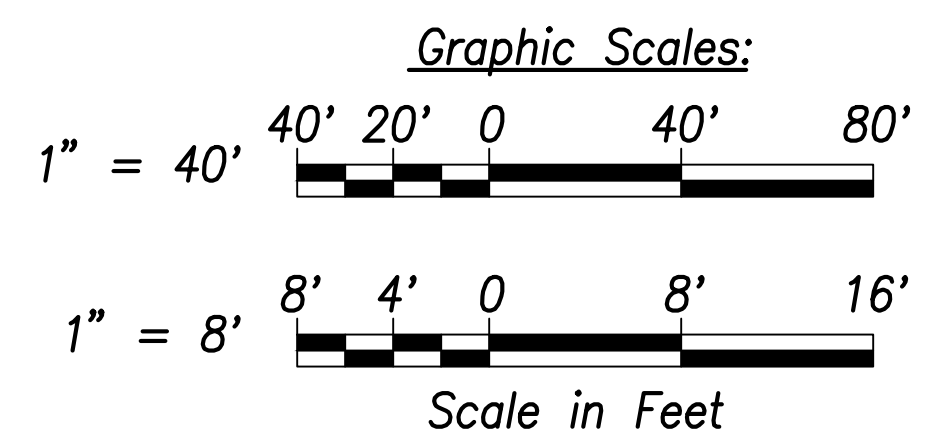

STATE OF HAWAII  
 DEPARTMENT OF TRANSPORTATION  
 HIGHWAYS DIVISION


**Waterline Connection and Temporary By-Pass - 3**

FARRINGTON HIGHWAY WIDENING  
 Kapolei Golf Course Road to Fort Weaver Road  
 Project No. 7101A-01-20

Scale: As Shown    Date: April 2022


SHEET NO. C-170 OF 767 SHEETS

FED. ROAD DIST. NO.	STATE	PROJ. NO.	FISCAL YEAR	SHEET NO.	TOTAL SHEETS
HAWAII	HAW.	7101A-01-20	2021	172	767

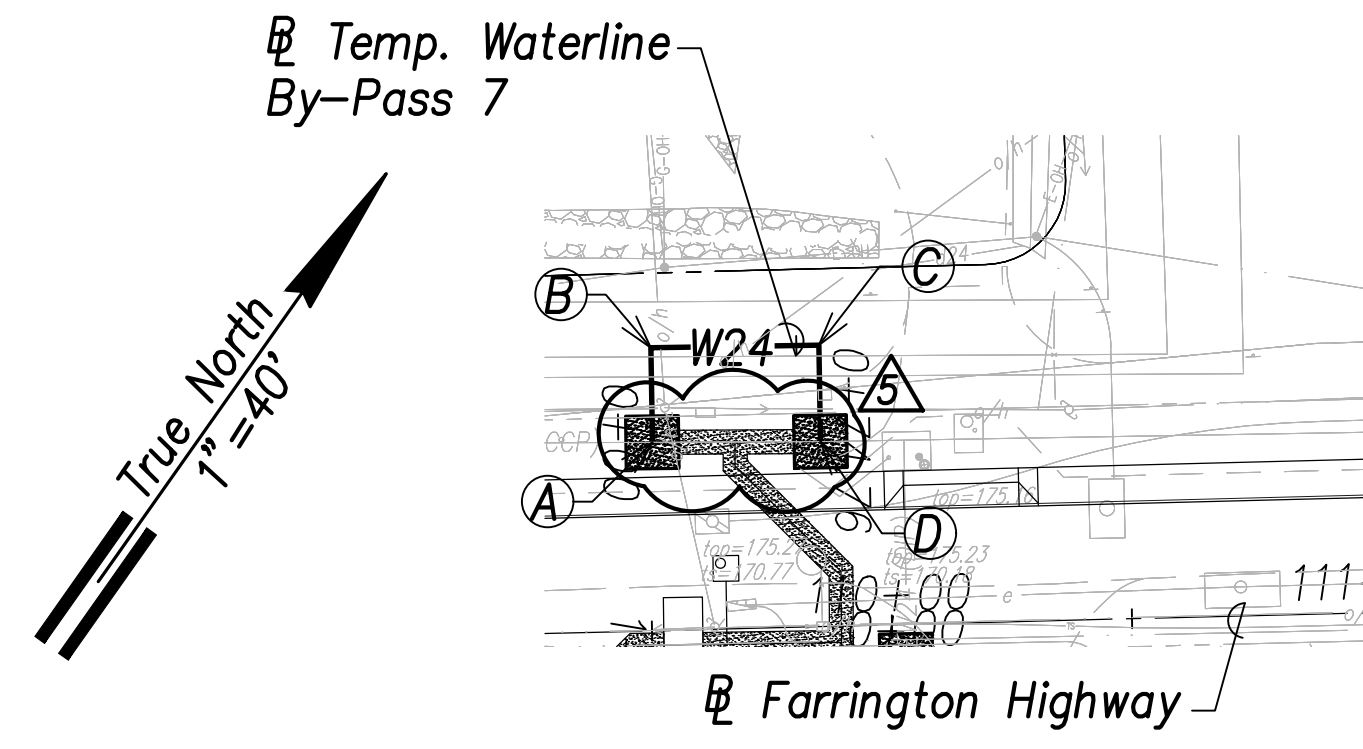


**Temporary Waterline By-Pass 7 Plan**  
 (# Sta. 109+68.3) Farrington Highway  
 Scale: 1" = 40'

- (A) # Sta. 109+51.1, o/s 39.3' Lt. Farrington Highway  
 =# Sta. 0+00 By-Pass  
 Temporary By-Pass Connection  
 See Detail Shts. C-208 to C-211 (Typ.)
- (B) # Sta. 109+51.3, o/s 59' Lt. Farrington Highway  
 =# Sta. 0+19.7 By-Pass  
 1-24" 1/4 Bend, Fl.
- (C) # Sta. 109+86.3, o/s 58.6' Lt. Farrington Highway  
 =# Sta. 0+35 By-Pass  
 1-24" 1/4 Bend, Fl.
- (D) # Sta. 109+86.1, o/s 38.5' Lt. Farrington Highway  
 =# Sta. 0+74.8 By-Pass  
 Temporary By-Pass Connection  
 See Detail Shts. C-208 to C-211 (Typ.)

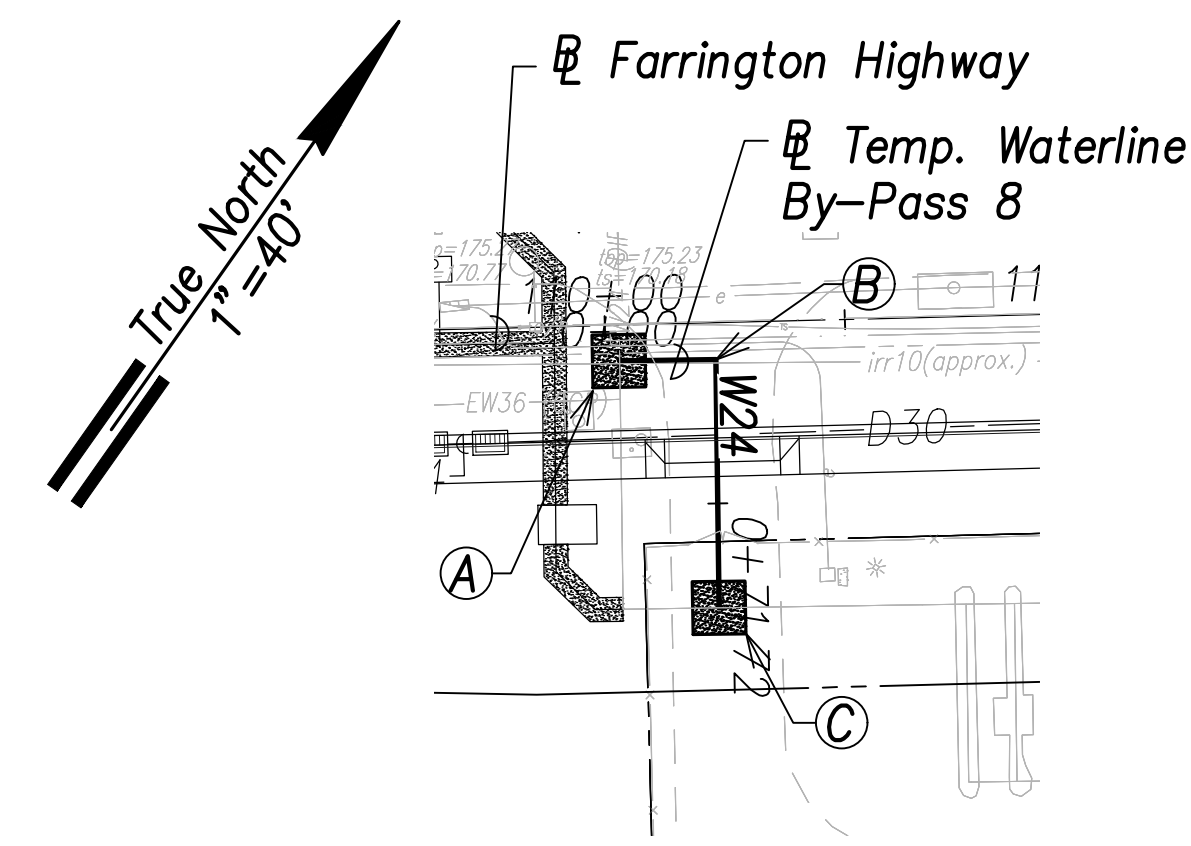


**Temporary Waterline By-Pass 8 Plan**  
 (# Sta. 110+02.3) Farrington Highway  
 Scale: 1" = 40'

- (A) # Sta. 110+02.9, o/s 7.4' Rt. Farrington Highway  
 =# Sta. 0+00 By-Pass  
 Temporary By-Pass Connection  
 See Detail Shts. C-208 to C-211 (Typ.)
- (B) # Sta. 110+22.9, o/s 7.7' Rt. Farrington Highway  
 =# Sta. 0+20 By-Pass  
 1-24" 1/4 Bend, Fl.
- (C) # Sta. 110+22.3, o/s 59.4' Rt. Farrington Highway  
 =# Sta. 0+71.7 By-Pass  
 Temporary By-Pass Connection  
 See Detail Shts. C-208 to C-211 (Typ.)

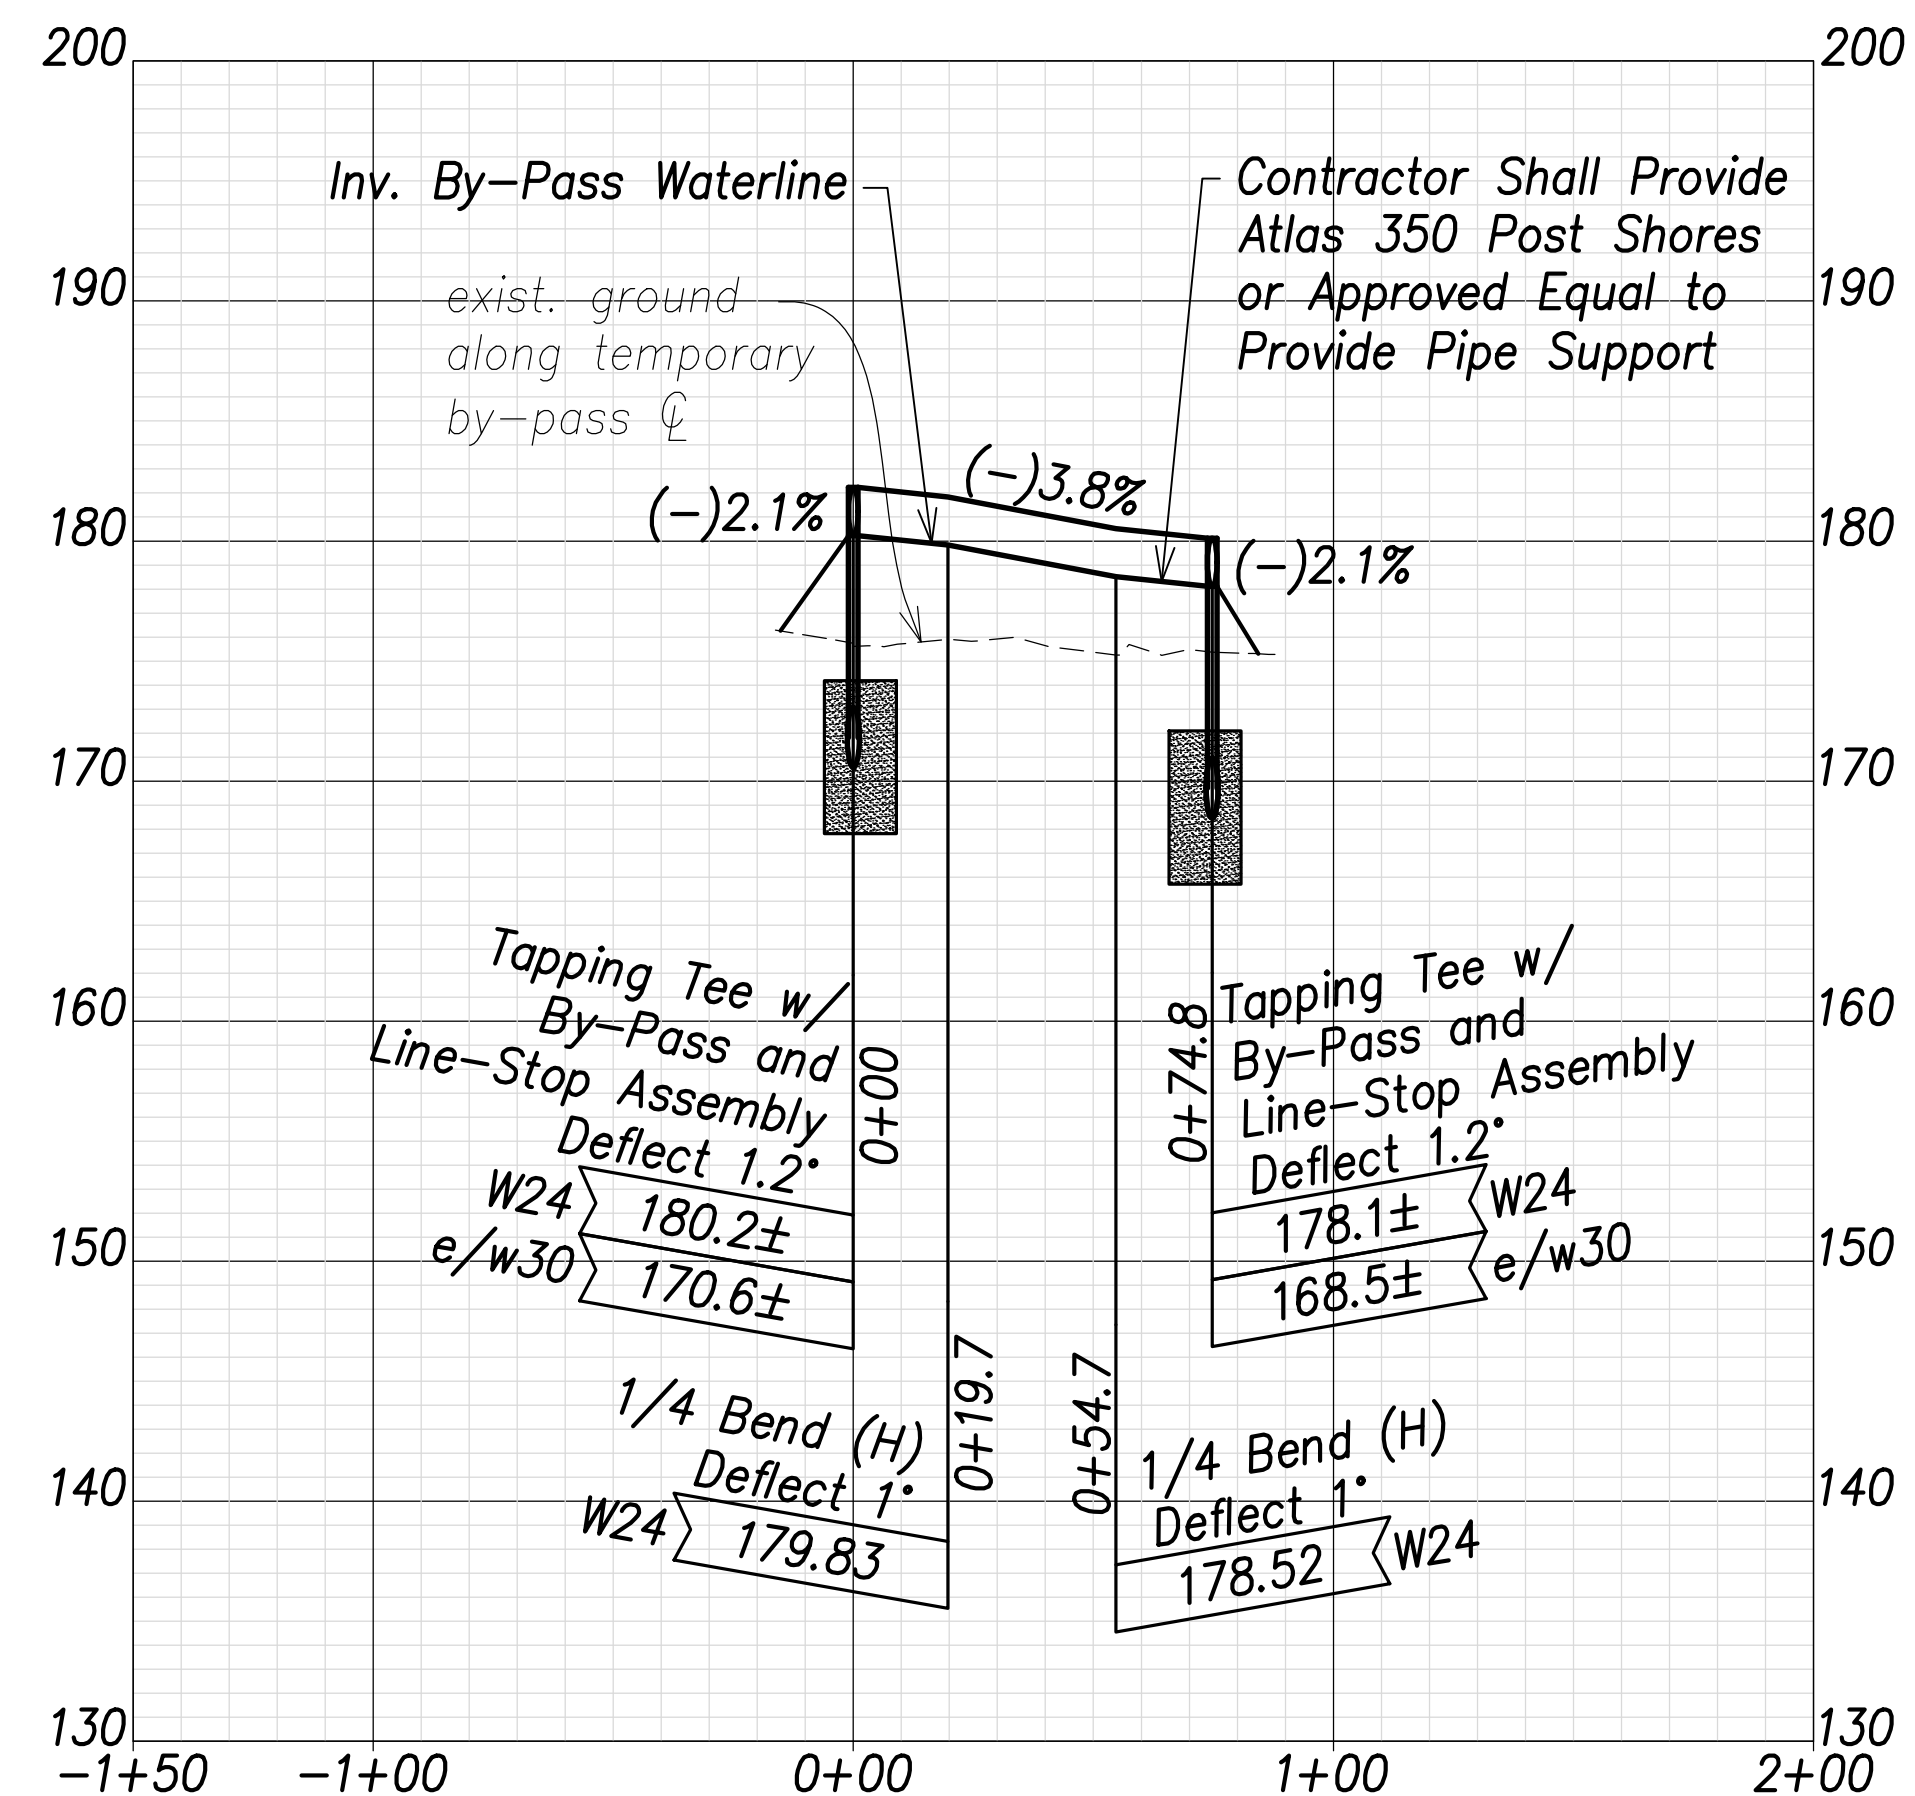

**Temporary Waterline By-Pass 7 Profile**  
 Scales: Hor.: 1" = 40'  
 Vert.: 1" = 8'

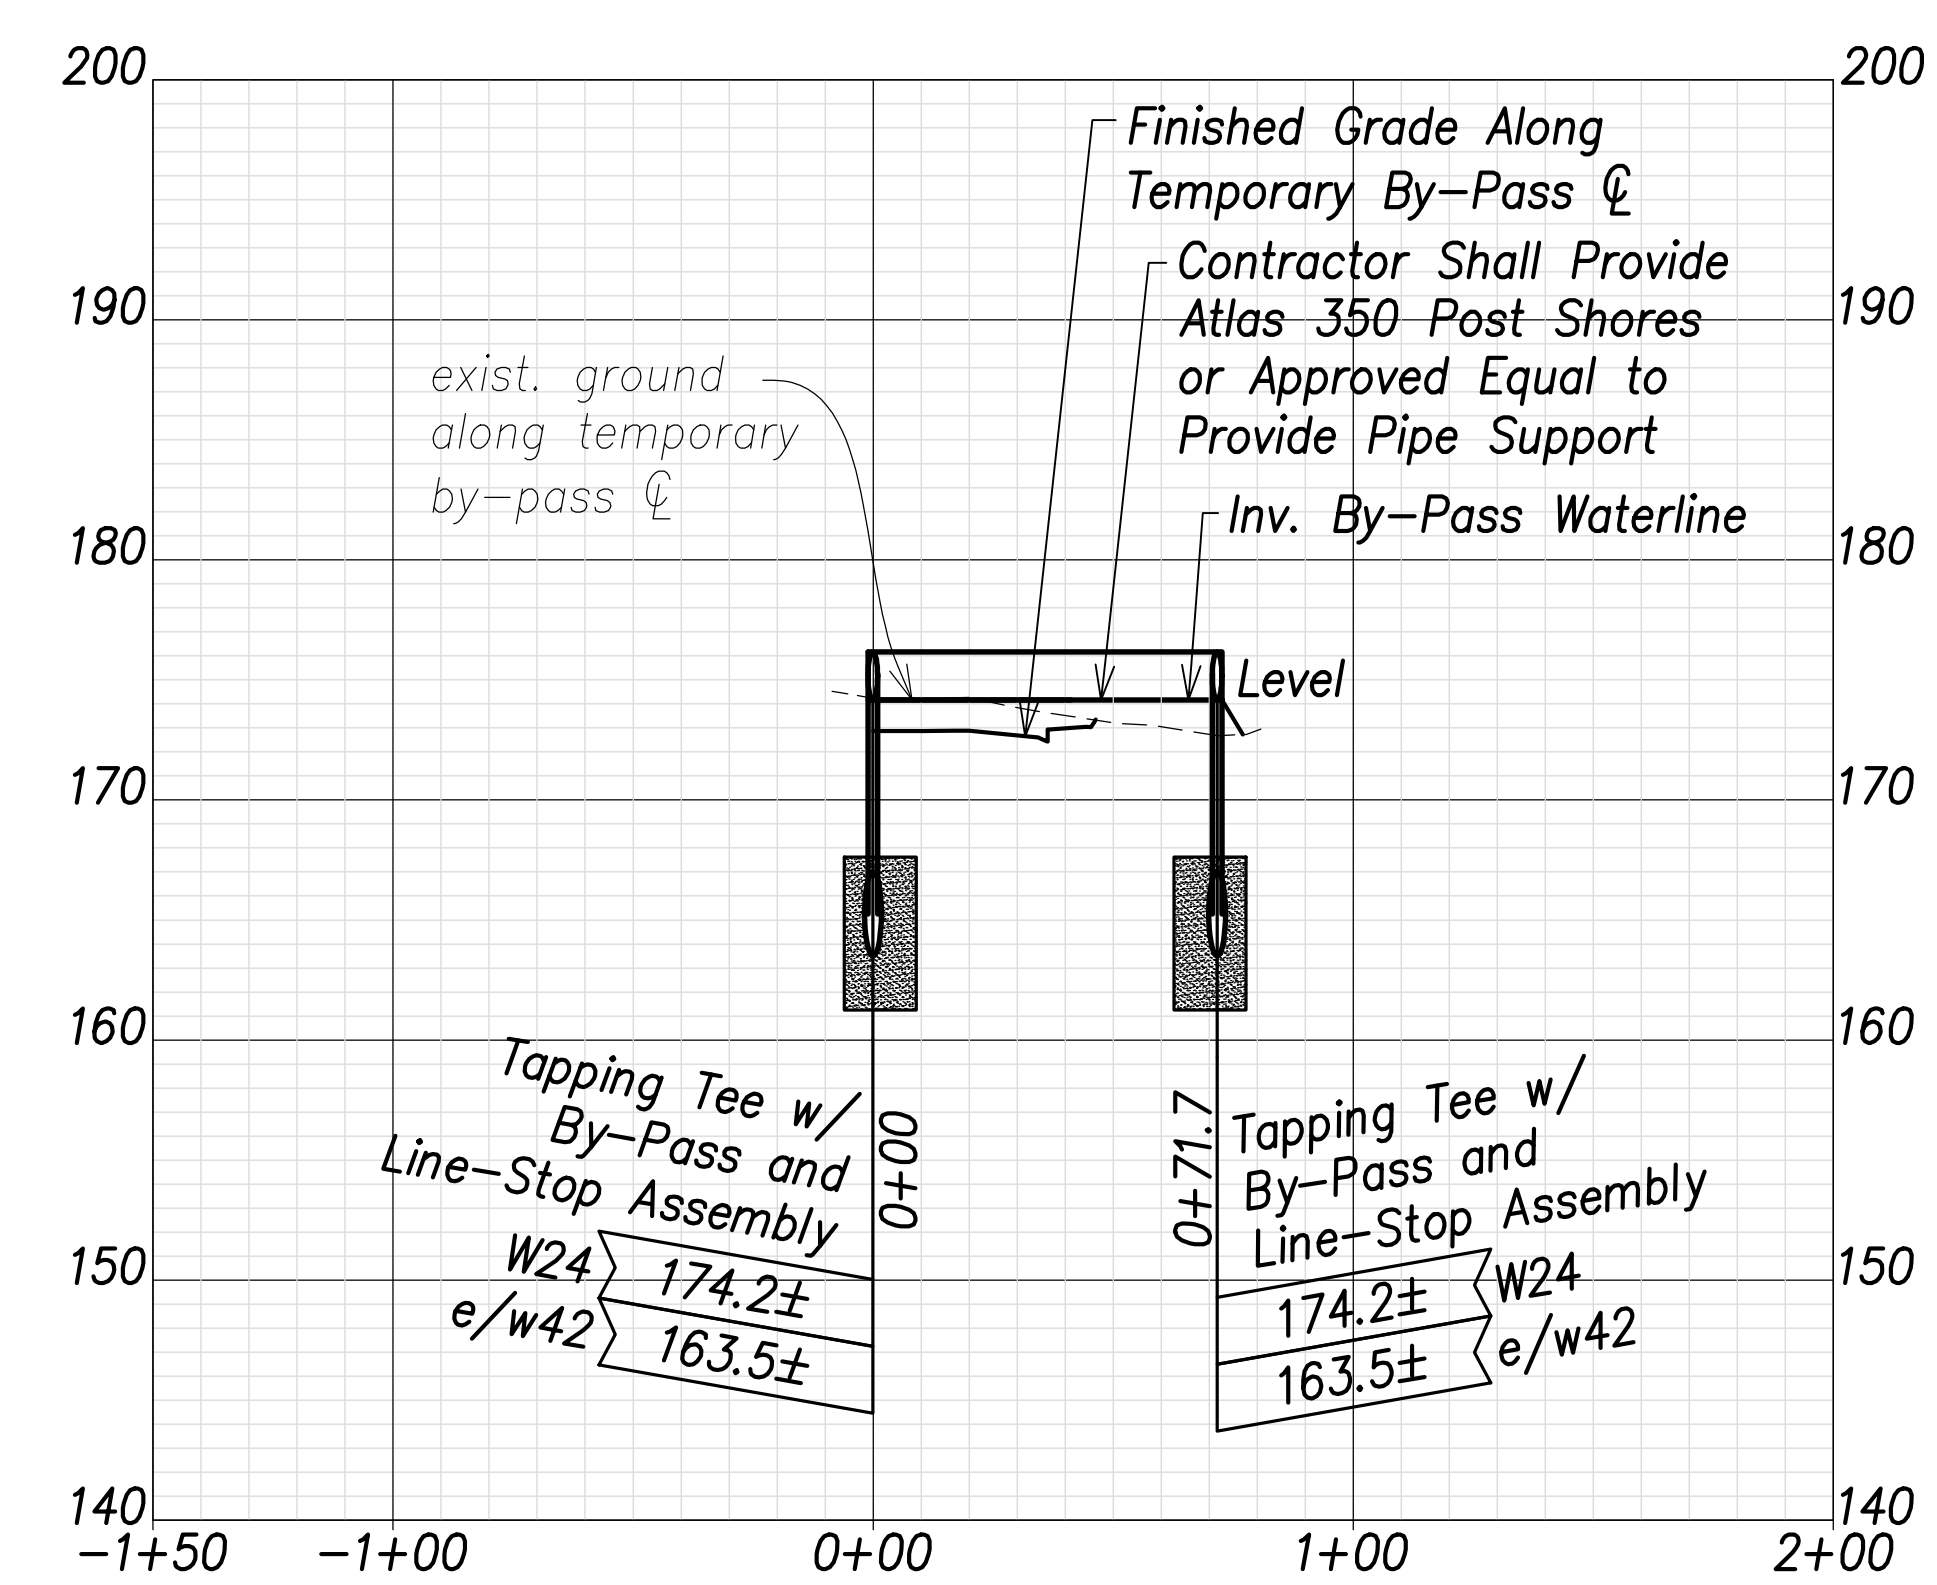

**Temporary Waterline By-Pass 8 Profile**  
 Scales: Hor.: 1" = 40'  
 Vert.: 1" = 8'


**Notes:**

- Contractor shall provide mechanical joint pipes and fittings with retainers glands and/or flanged pipes and fittings to construct the temporary by-passes
- The Contractor shall submit the construction schedule and construction phasing for the temporary by-passes to BWS for review and approval. The Contractor shall not commence work on the temporary by-passes until approval is obtained by BWS.

**Schedule Note:**  
 The construction working period for Temporary By-Passes 7 and 8 shall be limited to November to February, as approved by BWS.

DATE	_____
SURVEY PLOTTED BY	_____
DRAWN BY	_____
TRACED BY	_____
CHECKED BY	_____
ORIGINAL PLAN	_____
NOTE BOOK	_____
No.	_____

APPROVED: \_\_\_\_\_ DATE \_\_\_\_\_  
 Manager and Chief Engineer, BWS  
 (for work affecting BWS facilities in City/State R/W & BWS easements only)

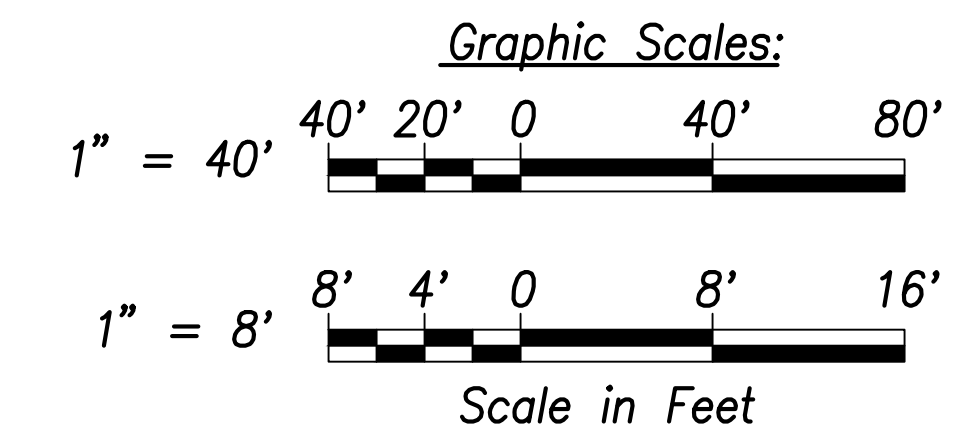

**CRAIG W. L. LUKE**  
 LICENSED PROFESSIONAL ENGINEER  
 No. 6935-C  
 HAWAII, U.S.A.

THIS WORK WAS PREPARED BY ME OR UNDER MY SUPERVISION AND CONSTRUCTION OF THIS PROJECT WILL BE UNDER MY OBSERVATION.

Signature: \_\_\_\_\_ April 30, 2024  
 EXPIRATION DATE OF THE LICENSE

07/15/22	5 Revised callouts; added notes
06/08/22	2 Revised By-Pass Alignment & Profile
DATE	REVISION

STATE OF HAWAII  
 DEPARTMENT OF TRANSPORTATION  
 HIGHWAYS DIVISION

**Waterline Connection and Temporary By-Pass - 4**


FARRINGTON HIGHWAY WIDENING  
 Kapolei Golf Course Road to Fort Weaver Road  
 Project No. 7101A-01-20

Scale: As Shown Date: April 2022

SHEET No. C-171 OF 767 SHEETS




FED. ROAD DIST. NO.	STATE	PROJ. NO.	FISCAL YEAR	SHEET NO.	TOTAL SHEETS
HAWAII	HAW.	7101A-01-20	2021	173	767

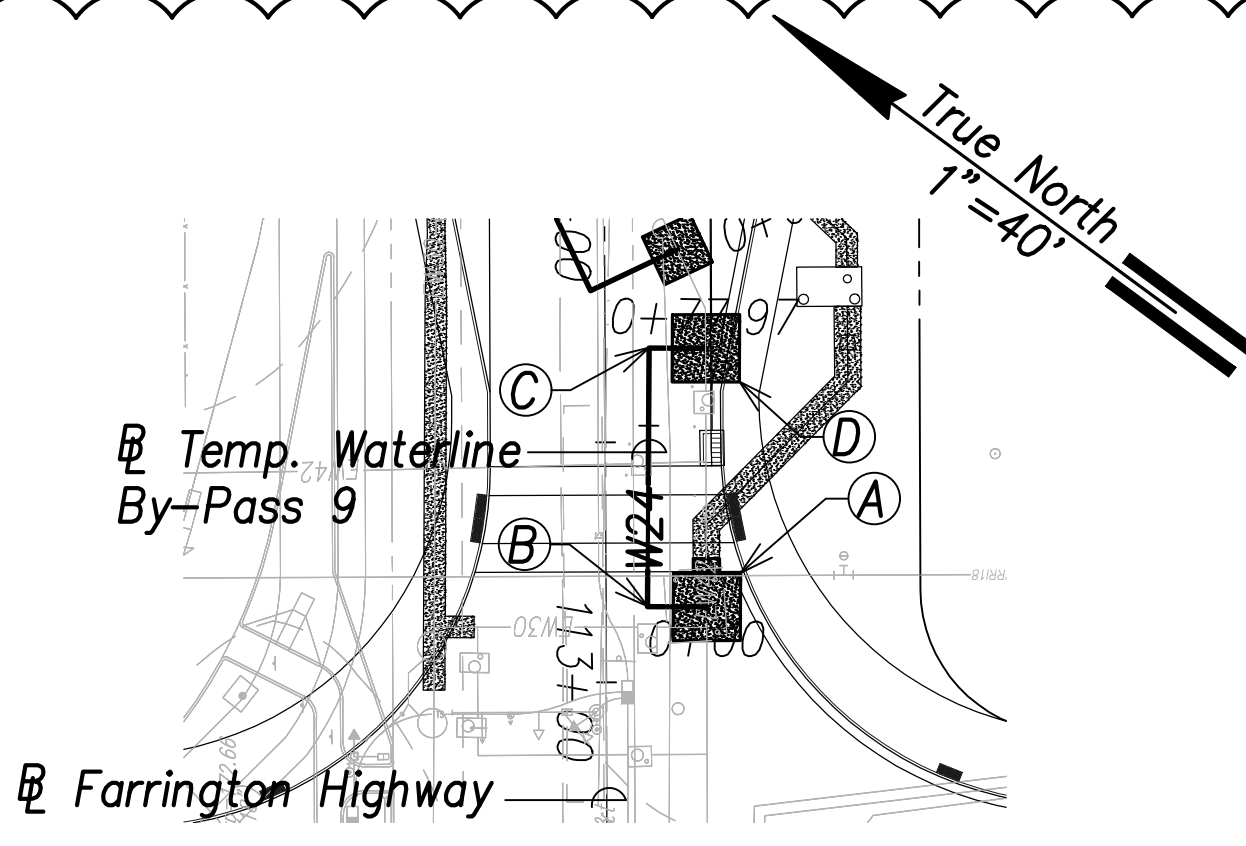


**Temporary Waterline By-Pass 9 Plan**  
 (Sta. 113+32.7 Farrington Highway)  
 Scale: 1" = 40'

- (A) Sta. 113+15.6, o/s 21' Rt. Farrington Highway  
 = Sta. 0+00 By-Pass  
 Temporary By-Pass Connection  
 See Detail Shts. C-208 to C-211 (Typ.)
- (B) Sta. 113+15.8, o/s 8.2' Rt. Farrington Highway  
 = Sta. 0+12.3 By-Pass  
 1-24" 1/4 Bend
- (C) Sta. 113+69.6, o/s 9.2' Rt. Farrington Highway  
 = Sta. 0+66.2 By-Pass  
 1-24" 1/4 Bend
- (D) Sta. 113+69.5, o/s 20.9' Rt. Farrington Highway  
 = Sta. 0+78 By-Pass  
 Temporary By-Pass Connection  
 See Detail Shts. C-208 to C-211 (Typ.)

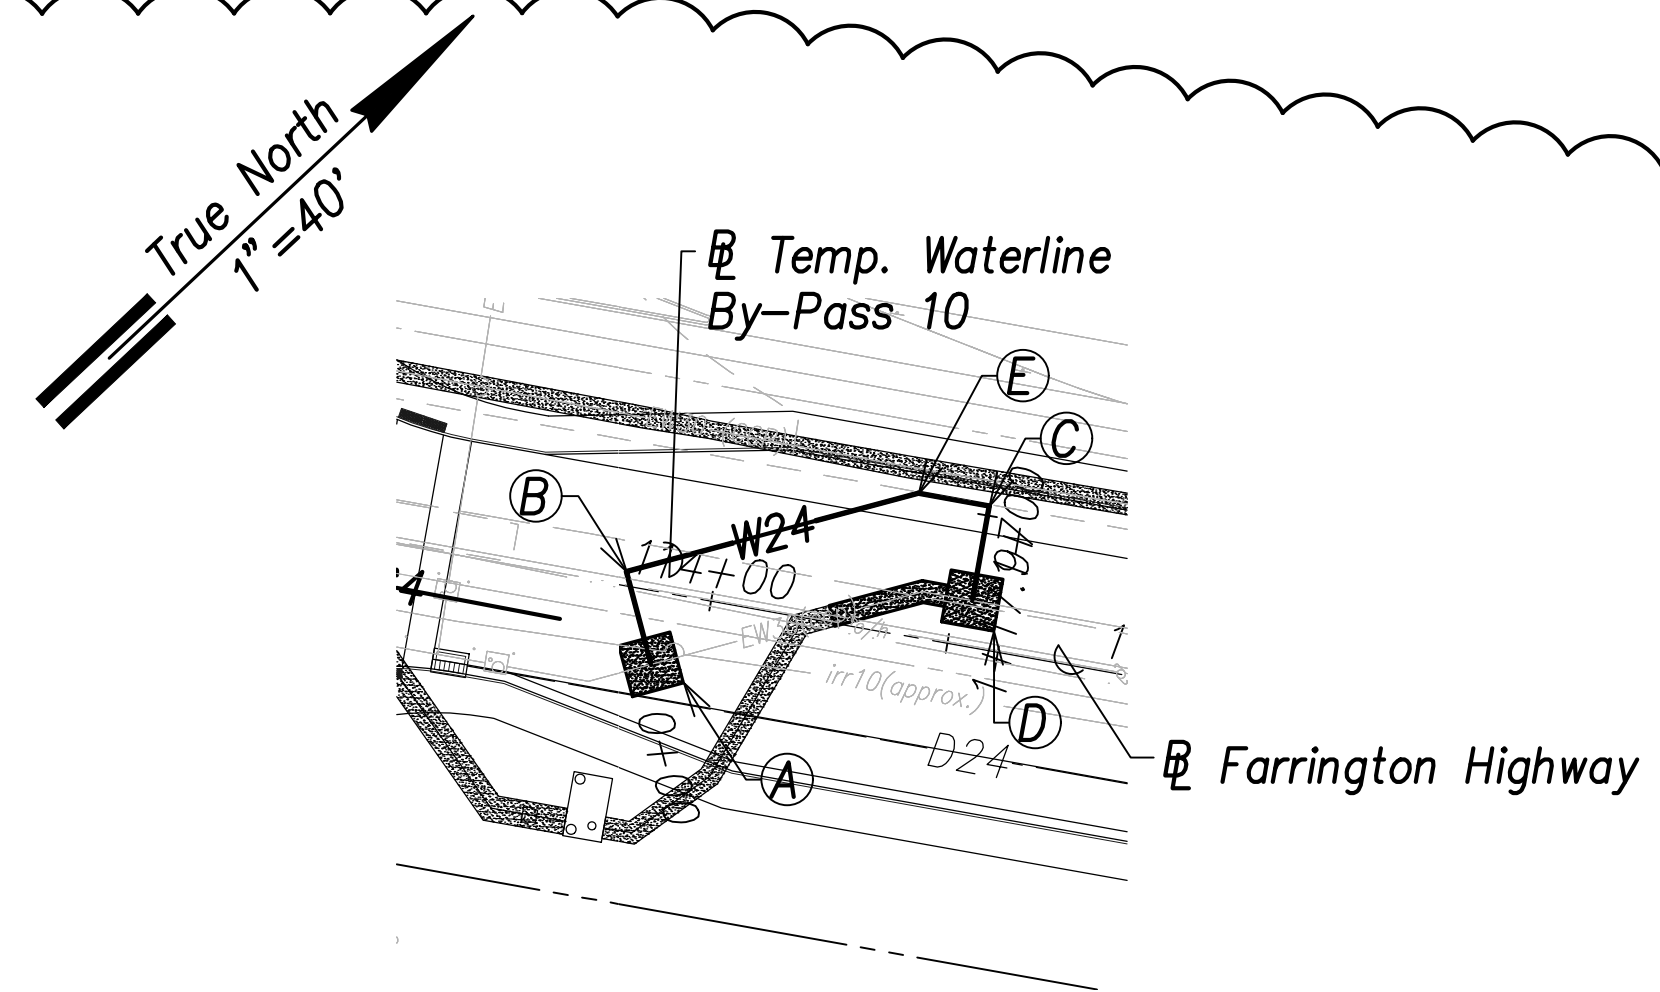


**Temporary Waterline By-Pass 10 Plan**  
 (Sta. 114+09 Farrington Highway)  
 Scale: 1" = 40'

- (A) Sta. 113+90.1, o/s 15.2' Lt. Farrington Highway  
 = Sta. 0+00 By-Pass  
 Temporary By-Pass Connection  
 See Detail Shts. C-208 to C-211 (Typ.)
- (B) Sta. 113+81.6, o/s 3' Lt. Farrington Highway  
 = Sta. 0+20 By-Pass  
 1-24" 1/4 Bend
- (C) Sta. 114+53.6, o/s 29.7' Lt. Farrington Highway  
 = Sta. 0+98 By-Pass  
 1-24" 1/4 Bend
- (D) Sta. 114+53.6, o/s 9.7' Lt. Farrington Highway  
 = Sta. 1+18 By-Pass  
 Temporary By-Pass Connection  
 See Detail Shts. C-208 to C-211 (Typ.)
- (E) Sta. 114+38.6, o/s 29.7' Lt. Farrington Highway  
 = Sta. 0+83 By-Pass  
 1-24" 1/8 Bend

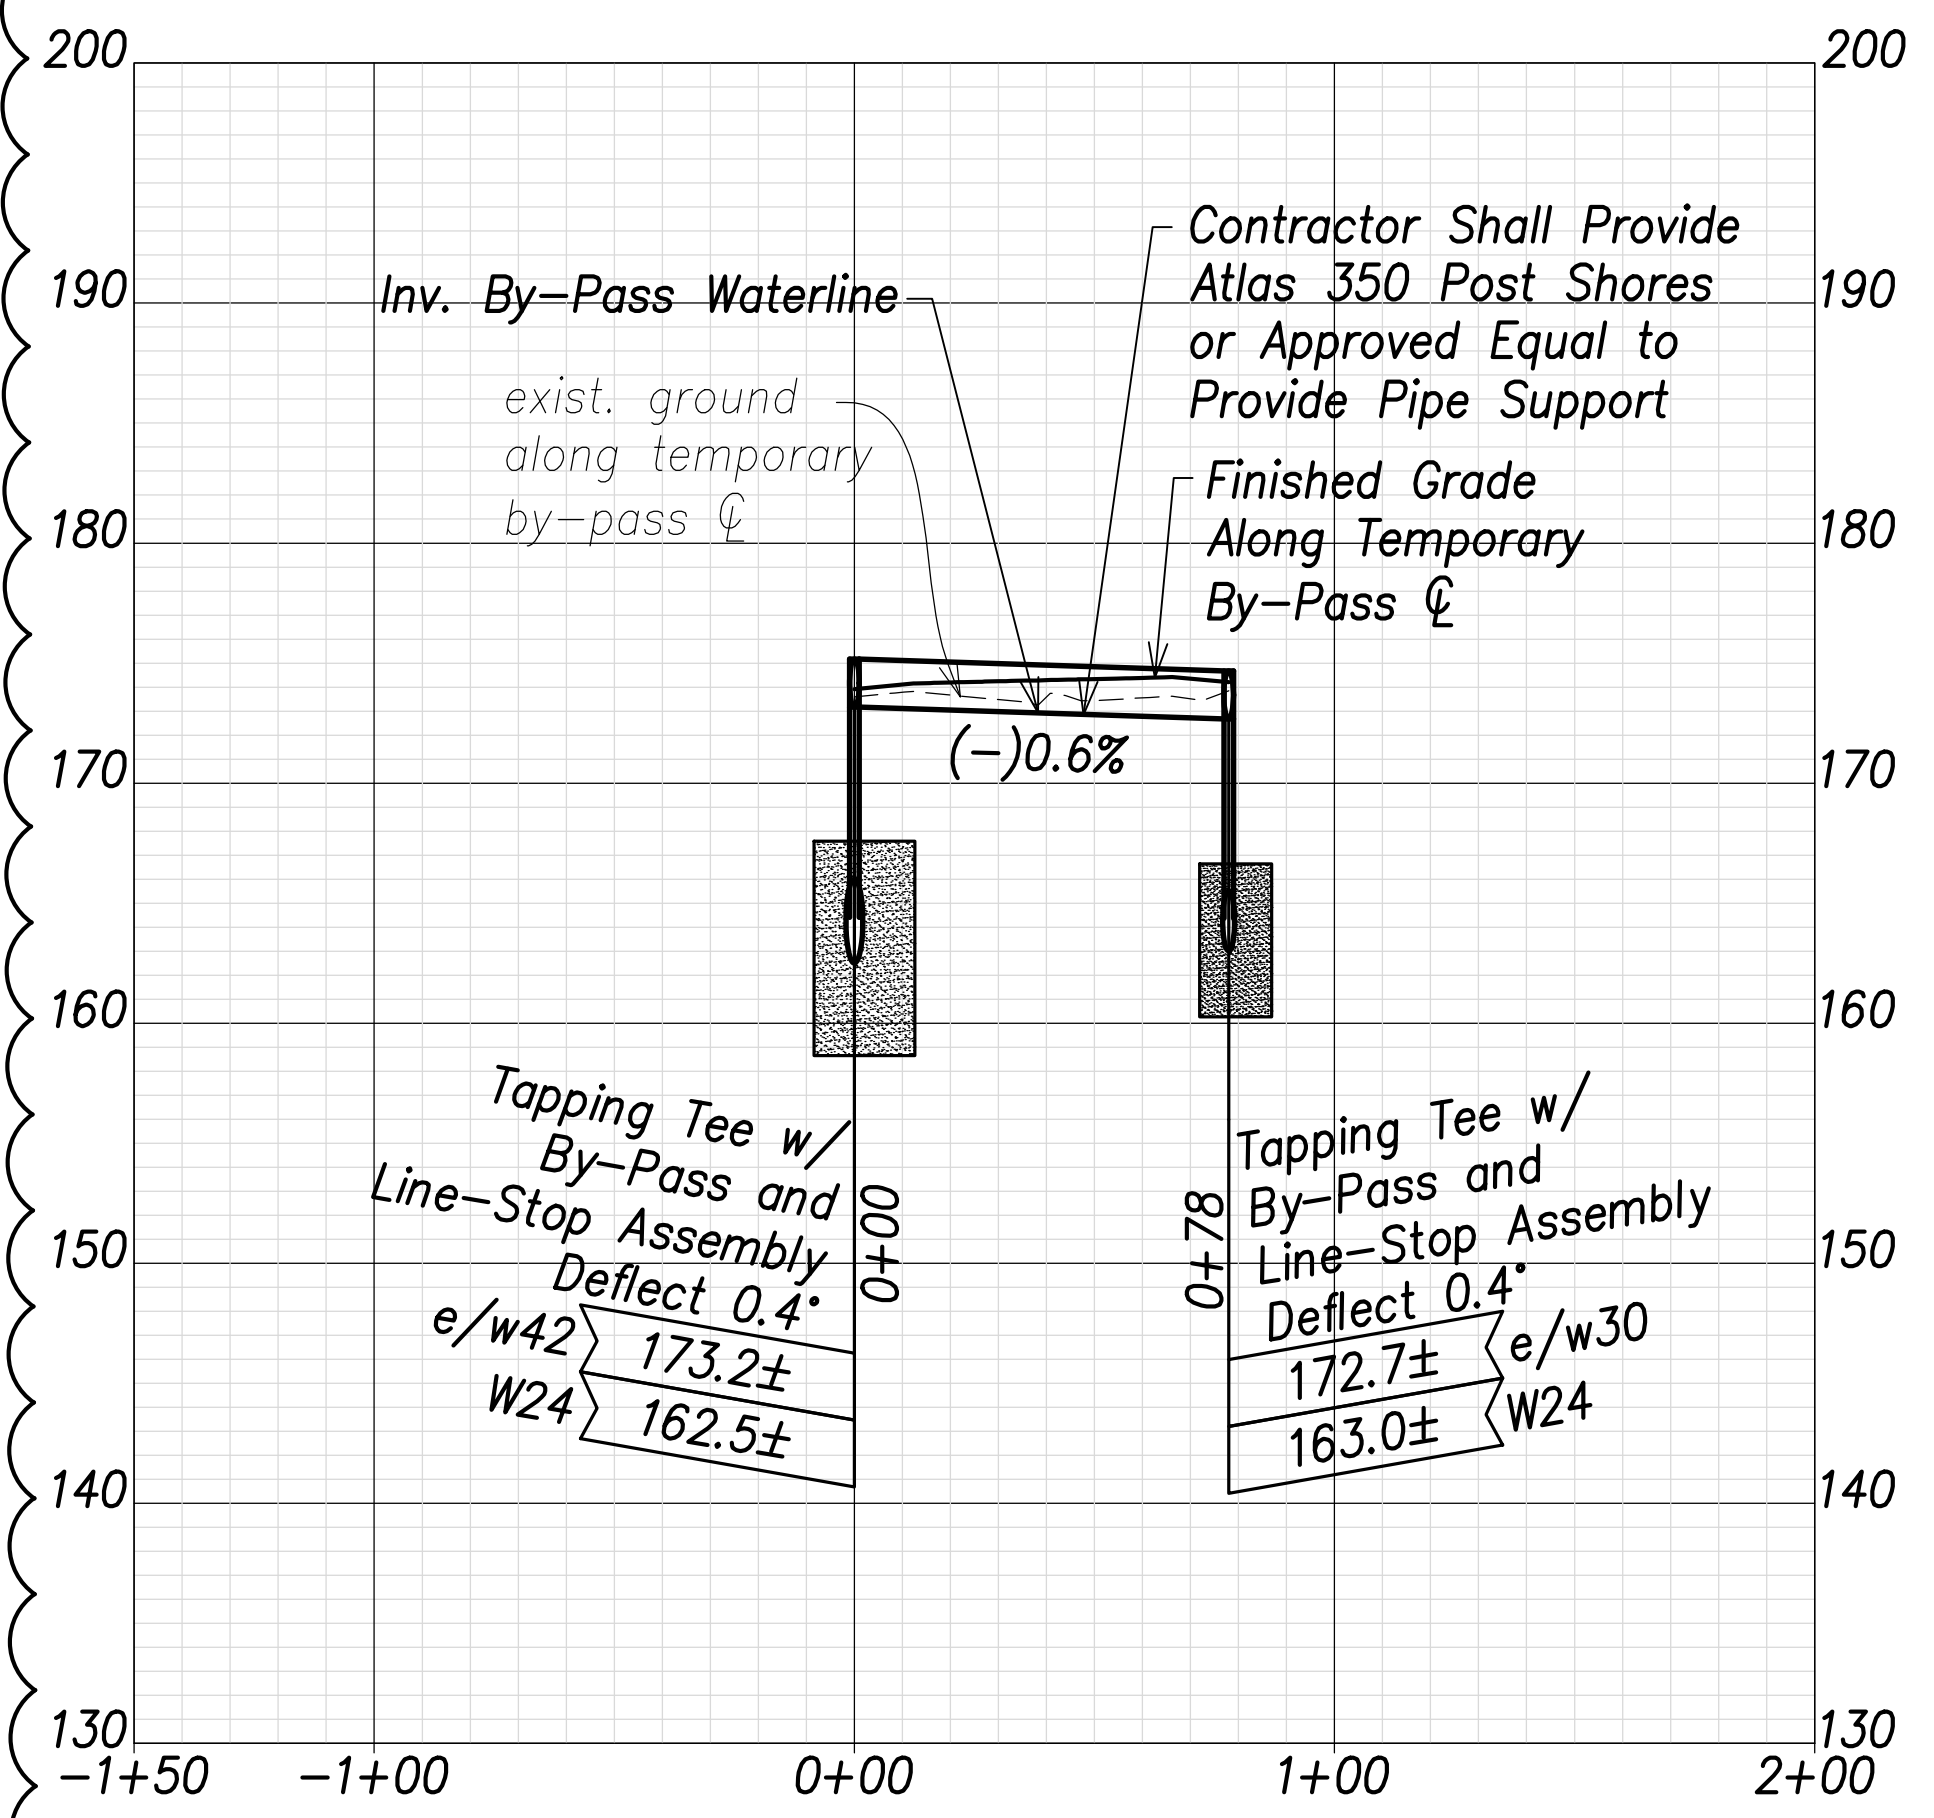

**Temporary Waterline By-Pass 9 Profile**  
 Scales: Hor.: 1" = 40'  
 Vert.: 1" = 8'


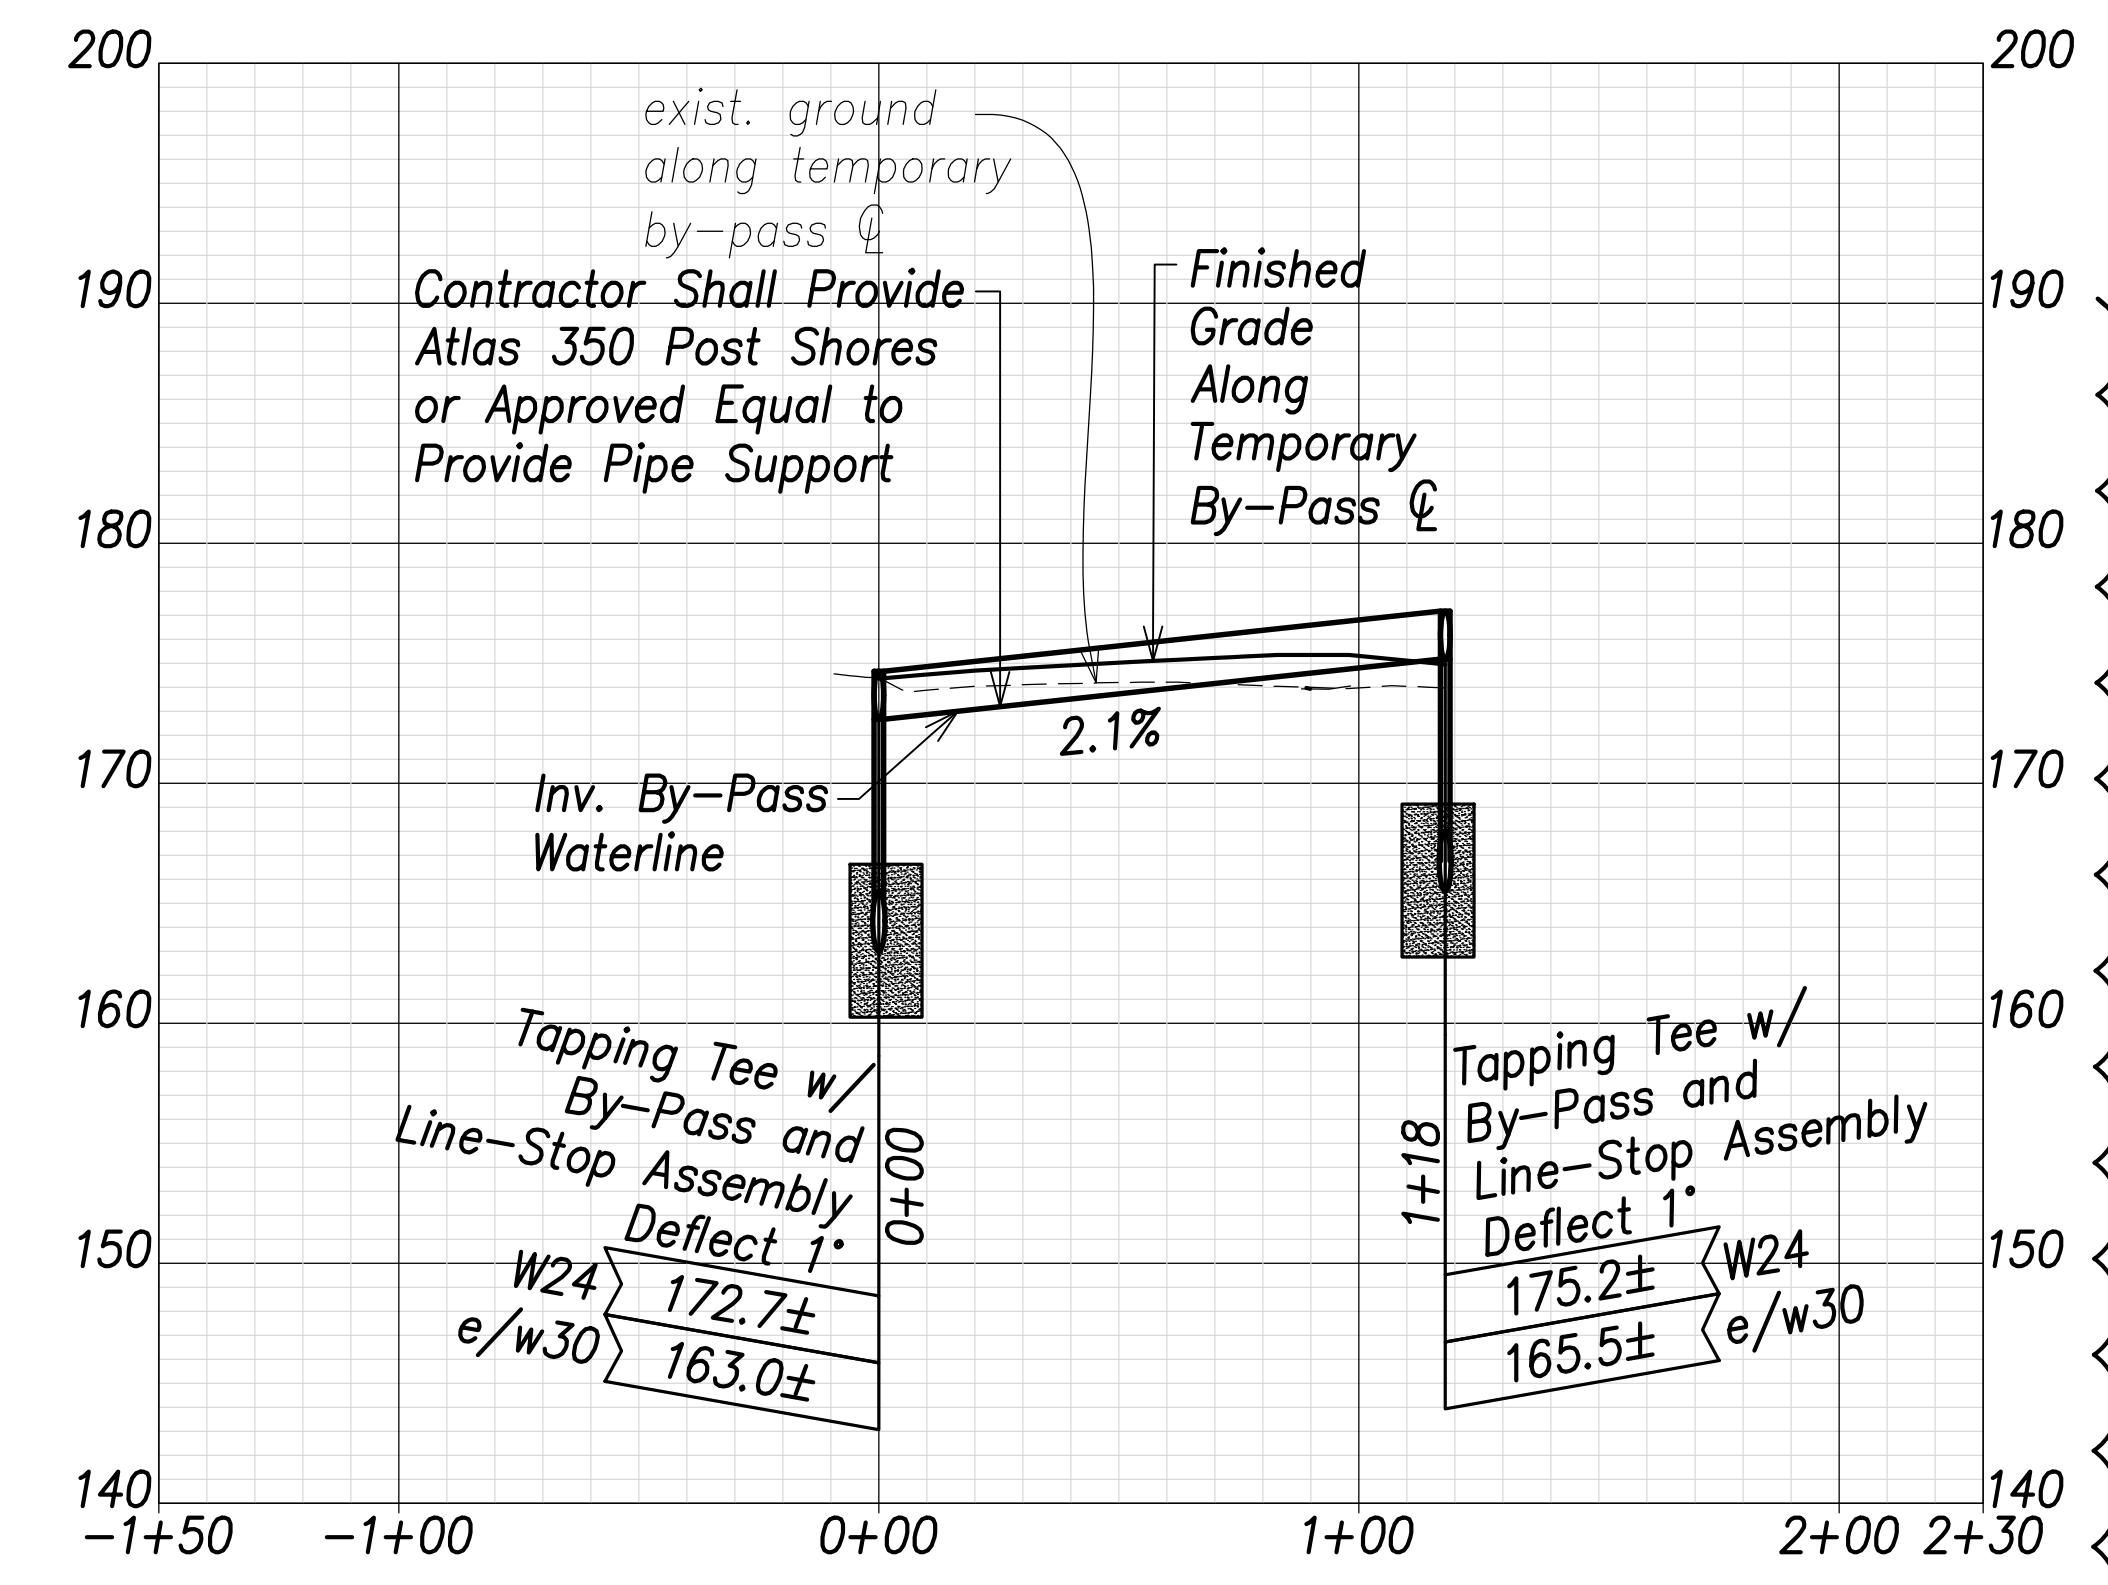


**Temporary Waterline By-Pass 10 Profile**  
 Scales: Hor.: 1" = 40'  
 Vert.: 1" = 8'

- Notes:**
- Contractor shall provide mechanical joint pipes and fittings with retainer glands and/or flanged pipes and fittings to construct the temporary by-passes
  - The Contractor shall submit the construction schedule and construction phasing for the temporary by-passes to BWS for review and approval. The Contractor shall not commence work on the temporary by-passes until approval is obtained by BWS.

DATE	_____
SURVEY PLOTTED BY	_____
DRAWN BY	_____
TRACED BY	_____
CHECKED BY	_____
APPROVED BY	_____
ORIGINAL PLAN	_____
NOTE BOOK	_____
No.	_____


APPROVED: \_\_\_\_\_ DATE \_\_\_\_\_  
 Manager and Chief Engineer, BWS  
 (for work affecting BWS facilities in  
 City/State R/W & BWS easements only)

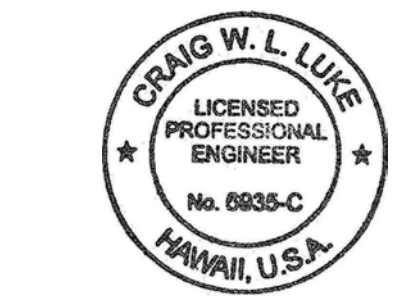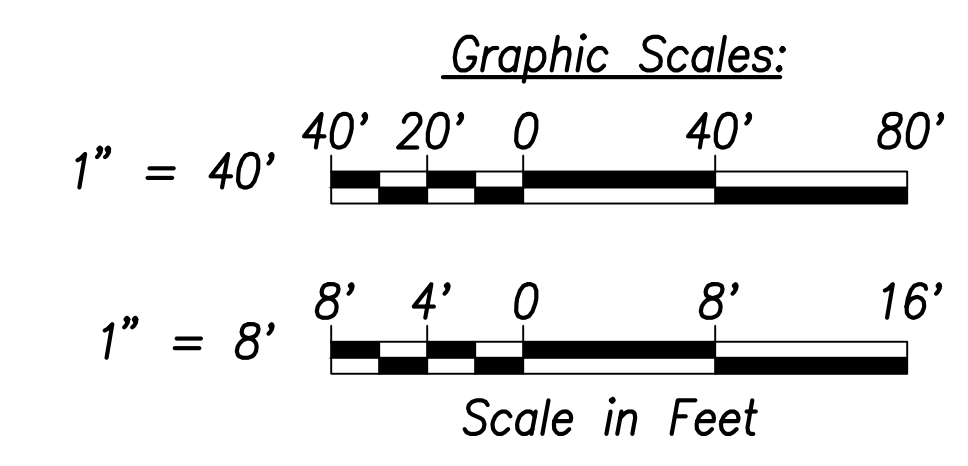

THIS WORK WAS PREPARED BY ME OR UNDER MY SUPERVISION AND CONSTRUCTION OF THIS PROJECT WILL BE UNDER MY OBSERVATION.  
 SIGNATURE: \_\_\_\_\_ DATE: April 30, 2024  
 EXPIRATION DATE OF THE LICENSE: \_\_\_\_\_


07/15/22	Revised By-Passes; Added note
DATE	REVISION
STATE OF HAWAII DEPARTMENT OF TRANSPORTATION HIGHWAYS DIVISION	
<b>Waterline Connection and Temporary By-Pass - 5</b>	
FARRINGTON HIGHWAY WIDENING Kapolei Golf Course Road to Fort Weaver Road Project No. 7101A-01-20	
Scale: As Shown	Date: April 2022
SHEET No. C-172 OF 767 SHEETS	

FED. ROAD DIST. NO.	STATE	PROJ. NO.	FISCAL YEAR	SHEET NO.	TOTAL SHEETS
HAWAII	HAW.	7101A-01-20	2021	174	767

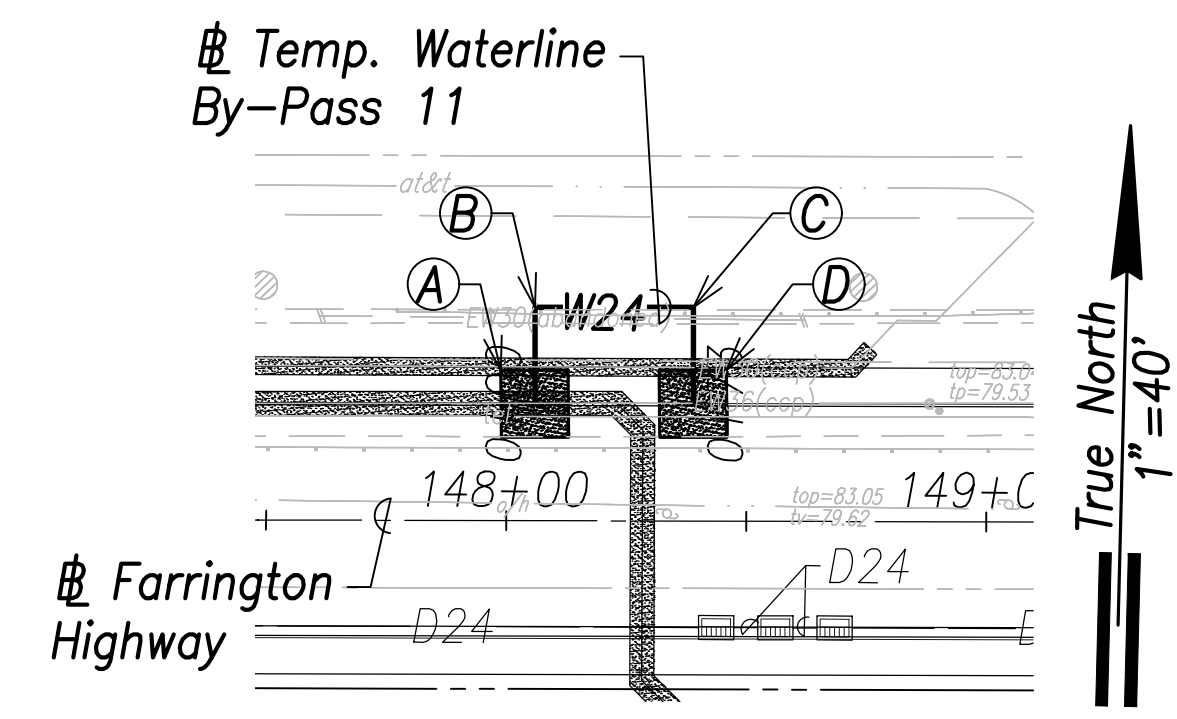


**Temporary Waterline By-Pass 11 Plan**  
 (# Sta. 148+22.9 Farrington Highway)  
 Scale: 1" = 40'

- (A) # Sta. 148+05.9, o/s 24.4' Lt. Farrington Highway  
 =# Sta. 0+00 By-Pass  
 Temporary By-Pass Connection  
 See Detail Shts. C-208 to C-211 (Typ.)
- (B) # Sta. 148+05.9, o/s 44.4' Lt. Farrington Highway  
 =# Sta. 0+20 By-Pass  
 1-24" 1/4 Bend
- (C) # Sta. 148+38.9, o/s 44.5' Lt. Farrington Highway  
 =# Sta. 0+53 By-Pass  
 1-24" 1/4 Bend
- (D) # Sta. 148+38.9, o/s 24.5' Lt. Farrington Highway  
 =# Sta. 0+73 By-Pass  
 Temporary By-Pass Connection  
 See Detail Shts. C-208 to C-211 (Typ.)

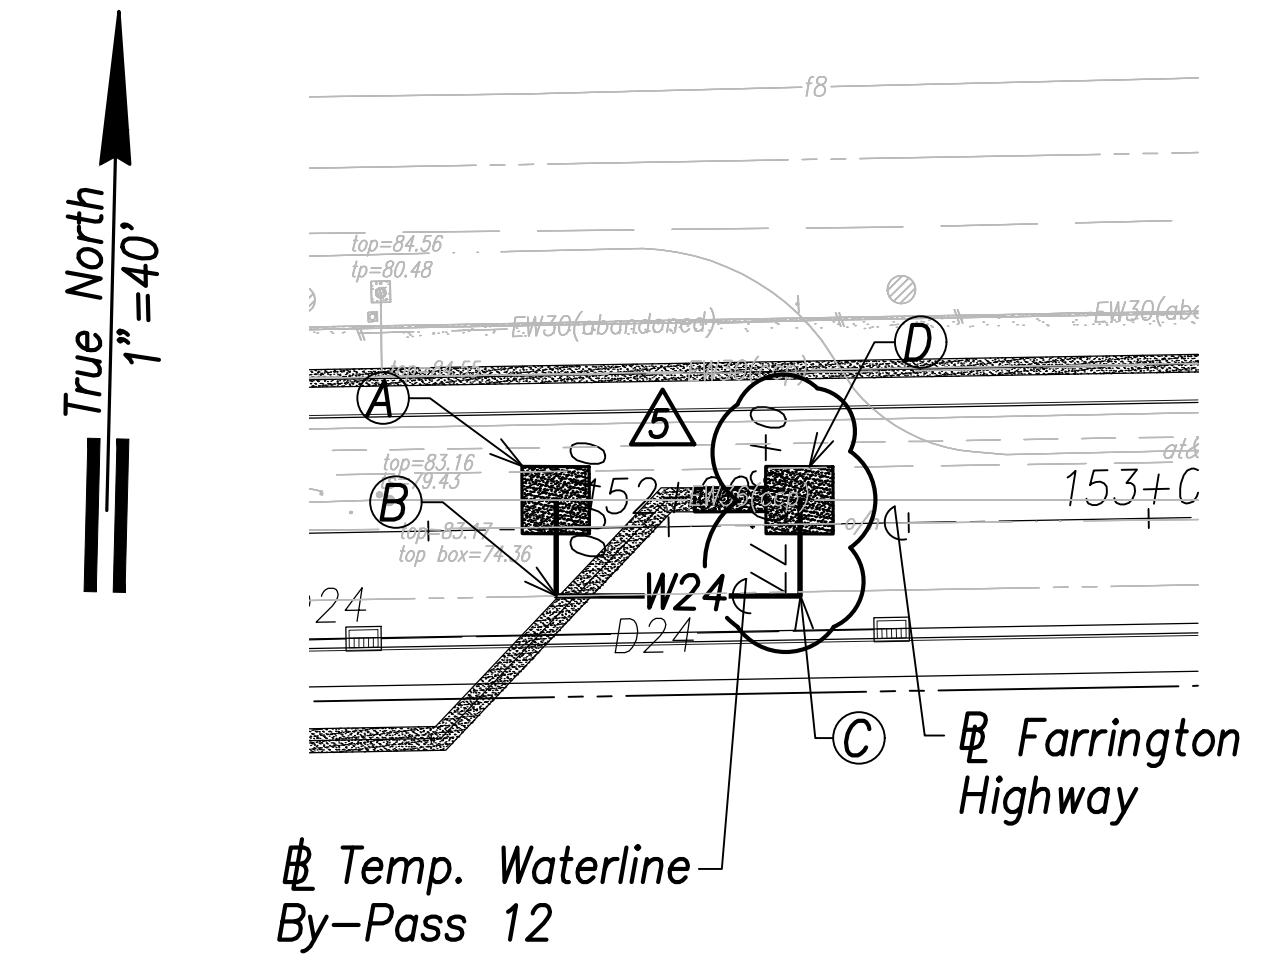


**Temporary Waterline By-Pass 12 Plan**  
 (# Sta. 152+05.6 Farrington Highway)  
 Scale: 1" = 40'

- (A) # Sta. 151+76.7, o/s 6.1' Lt. Farrington Highway  
 =# Sta. 0+00 By-Pass  
 Temporary By-Pass Connection  
 See Detail Shts. C-208 to C-211 (Typ.)
- (B) # Sta. 157+76.3, o/s 14' Rt. Farrington Highway  
 =# Sta. 0+20 By-Pass  
 1-24" 1/4 Bend
- (C) # Sta. 152+27.1, o/s 14.8' Rt. Farrington Highway  
 =# Sta. 0+65.8 By-Pass  
 1-24" 1/4 Bend
- (D) # Sta. 152+27.5, o/s 5.2' Lt. Farrington Highway  
 =# Sta. 0+90.8 By-Pass  
 Temporary By-Pass Connection  
 See Detail Shts. C-208 to C-211 (Typ.)

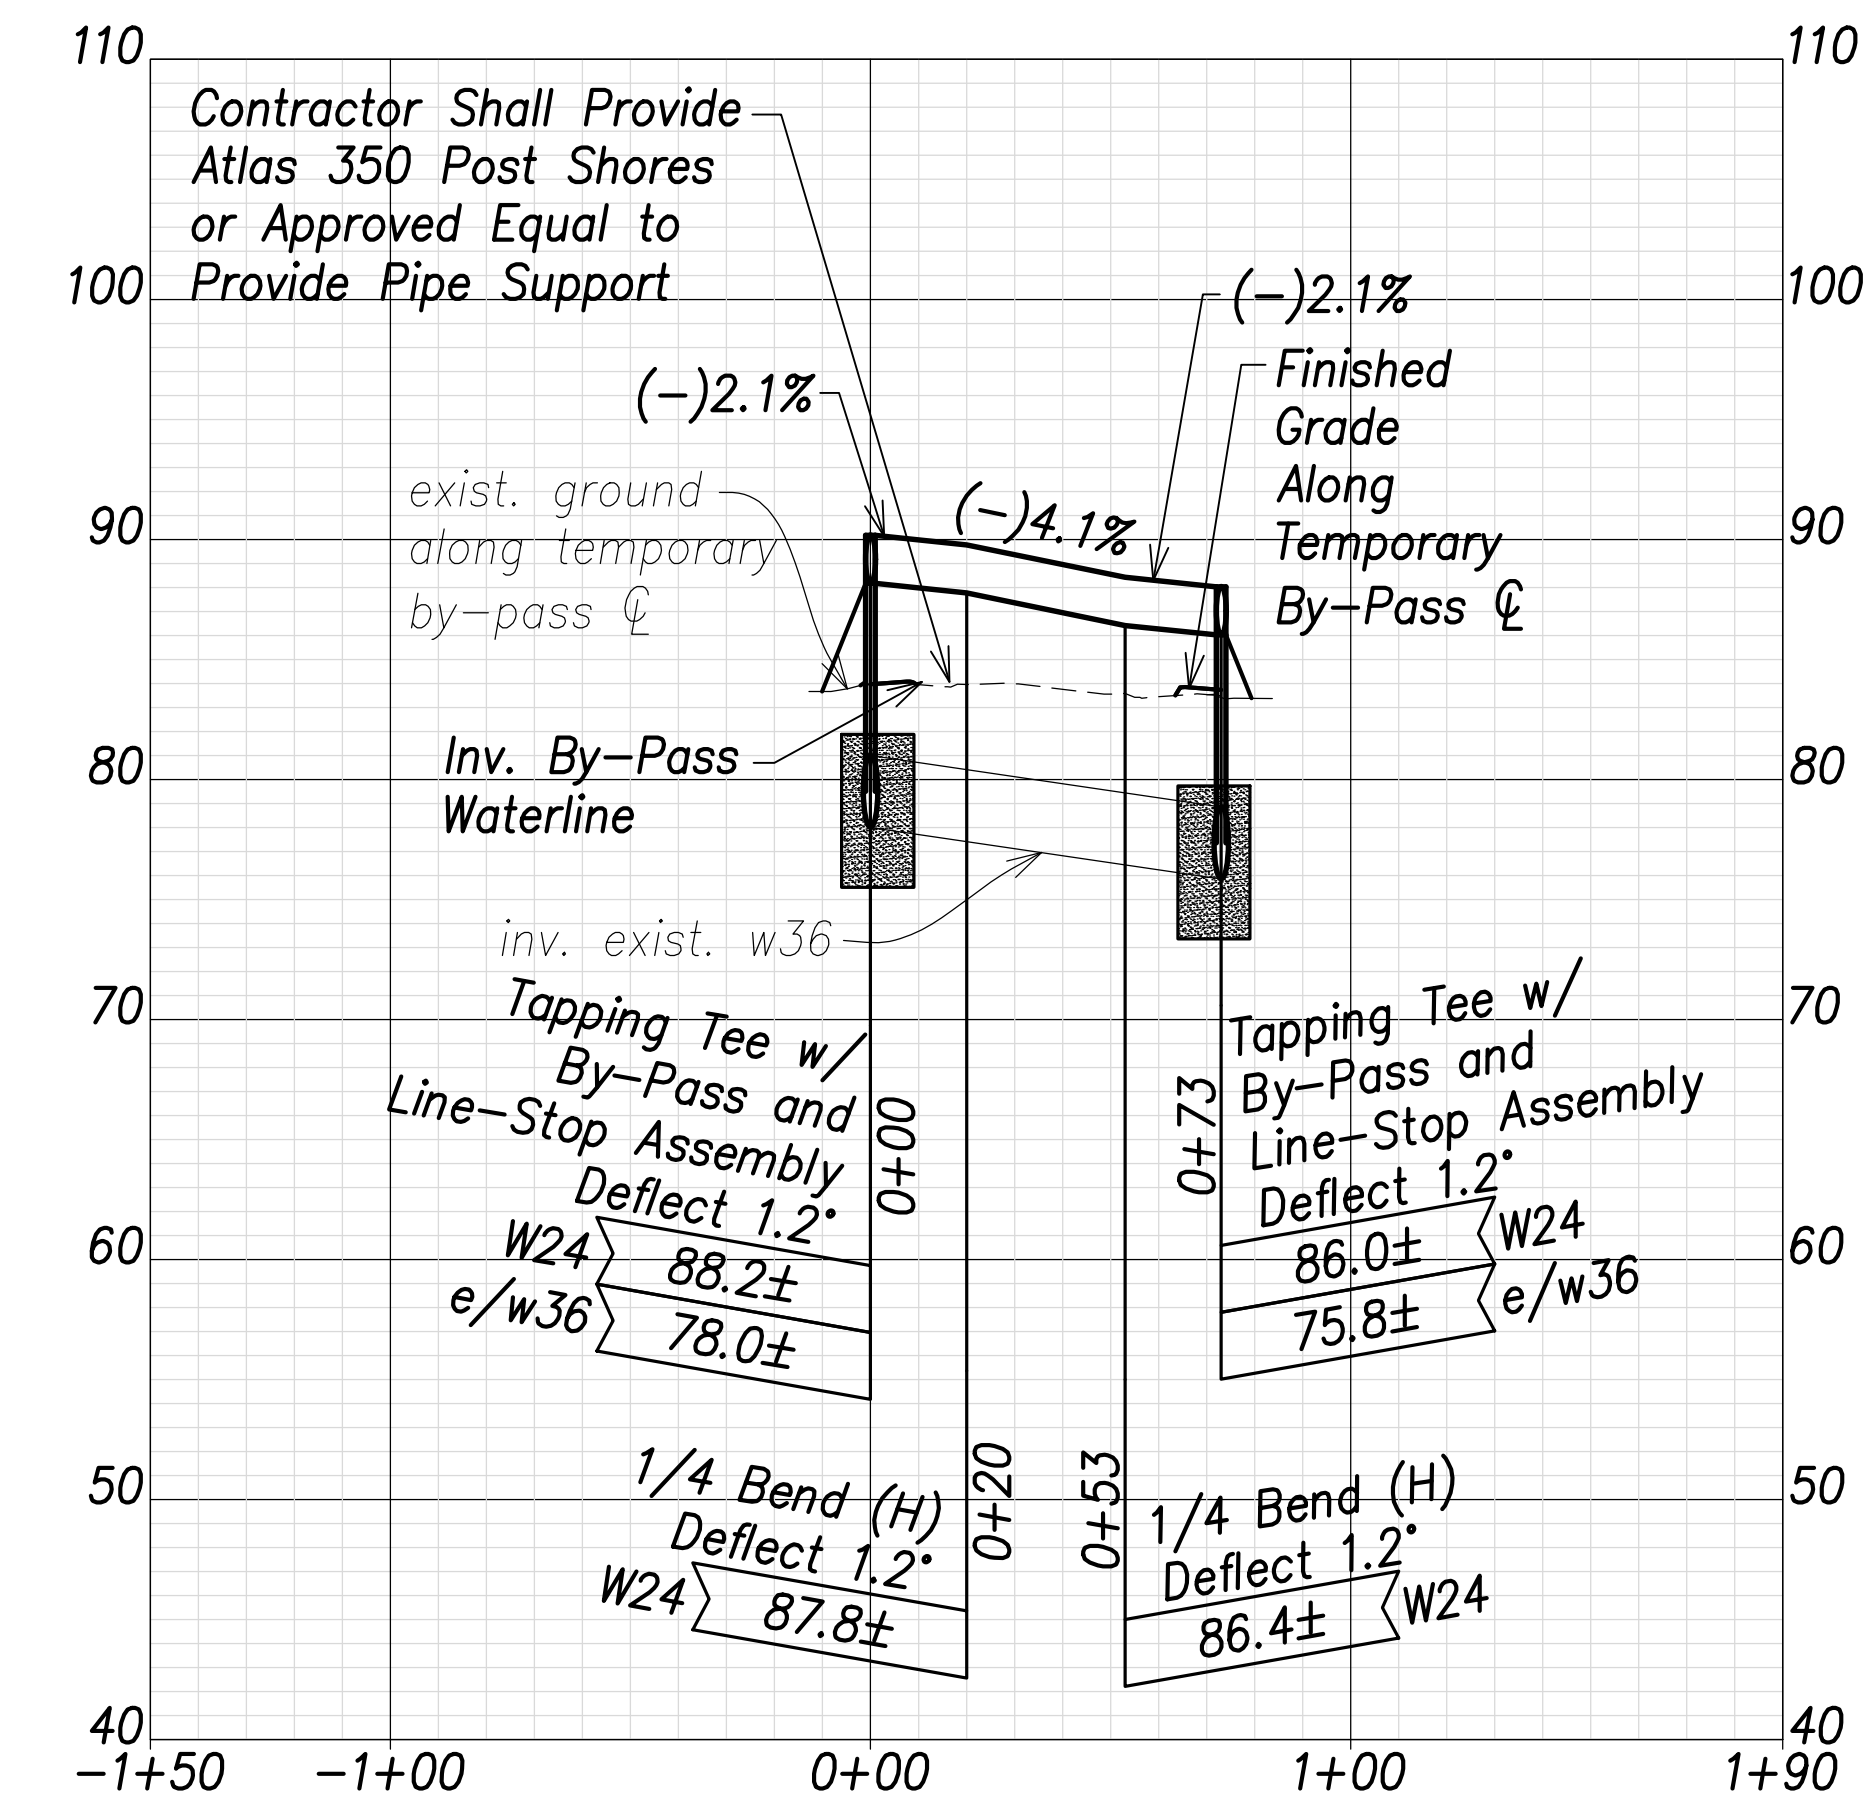

**Temporary Waterline By-Pass 11 Profile**  
 Scales: Hor.: 1" = 40'  
 Vert.: 1" = 8'

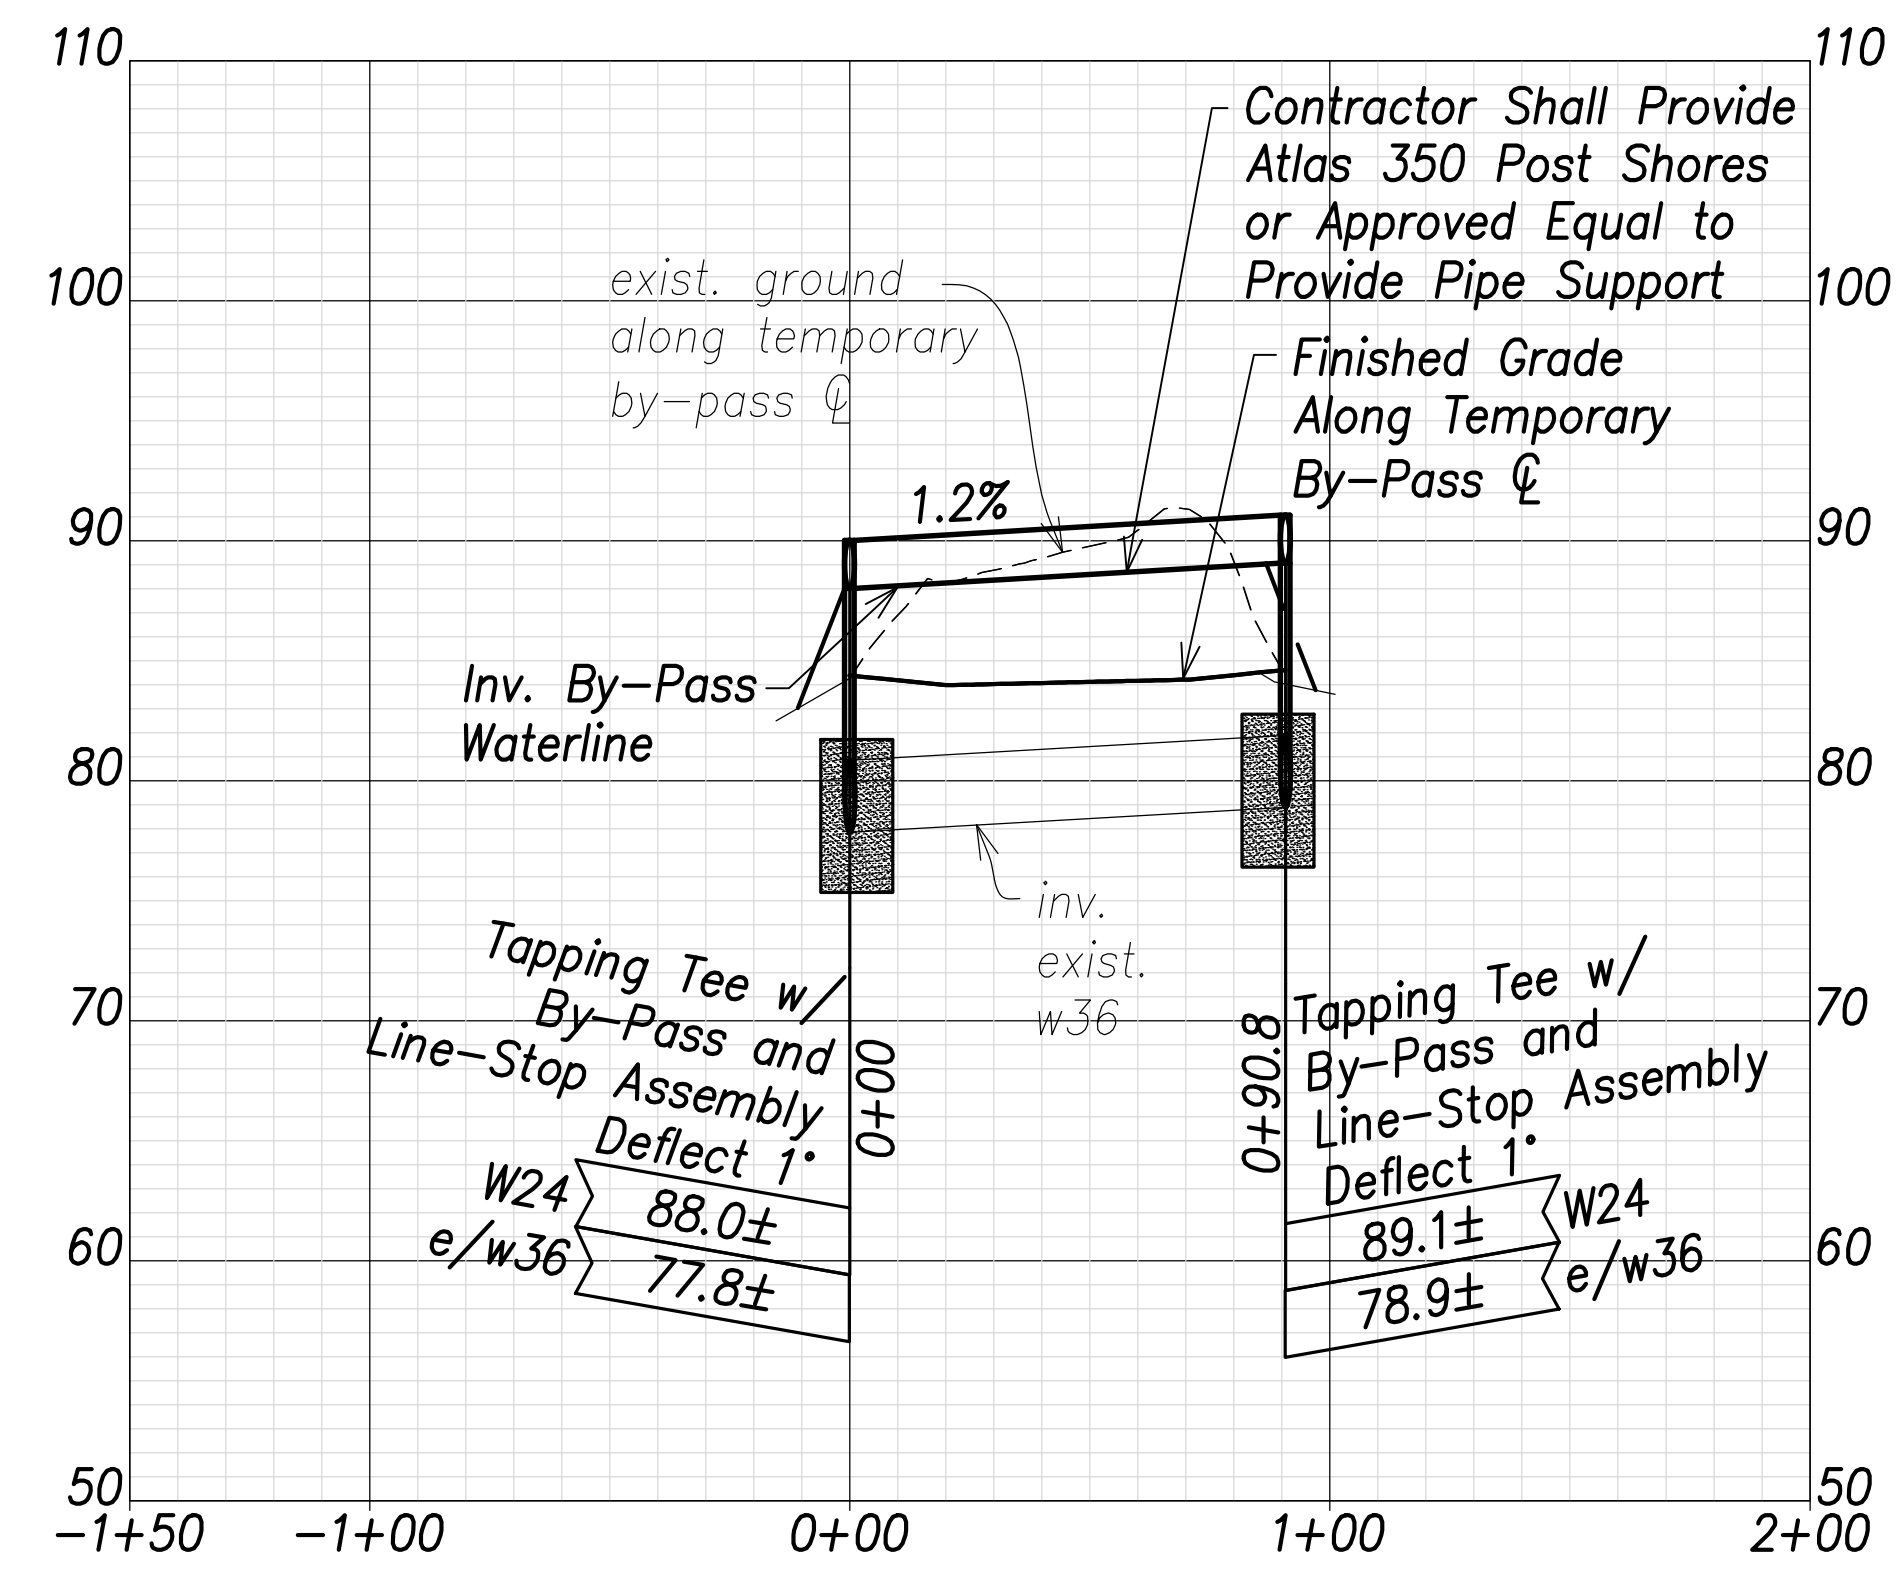


**Temporary Waterline By-Pass 12 Profile**  
 Scales: Hor.: 1" = 40'  
 Vert.: 1" = 8'

- Notes:**
- Contractor shall provide mechanical joint pipes and fittings with retainer glands and/or flanged pipes and fittings to construct the temporary by-passes
  - The Contractor shall submit the construction schedule and construction phasing for the temporary by-passes to BWS for review and approval. The Contractor shall not commence work on the temporary by-passes until approval is obtained by BWS.

DATE	REVISION
07/15/22	Revised callouts; added note; Revised Temp. Bypass 12 layout
06/08/22	Revised By-Pass Alignment & Profile

SURVEY PLOTTED BY:	DATE:
DRAWN BY:	
TRACED BY:	
CHECKED BY:	
ORIGINAL PLAN:	
NOTE BOOK:	
NO.:	

APPROVED: \_\_\_\_\_ DATE \_\_\_\_\_  
 Manager and Chief Engineer, BWS  
 (for work affecting BWS facilities in City/State R/W & BWS easements only)

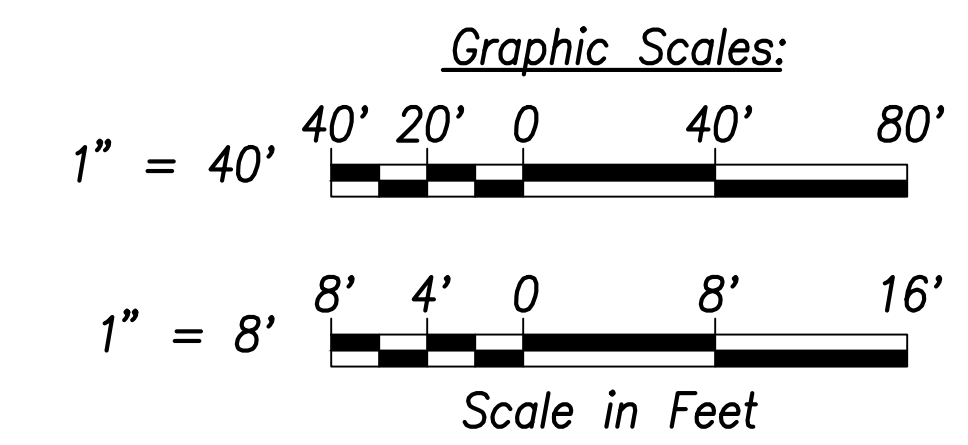

**CRAIG W. L. LUKE**  
 LICENSED PROFESSIONAL ENGINEER  
 No. 6935-C  
 HAWAII, U.S.A.

THIS WORK WAS PREPARED BY ME OR UNDER MY SUPERVISION AND CONSTRUCTION OF THIS PROJECT WILL BE UNDER MY OBSERVATION.

Signature: \_\_\_\_\_  
 EXPIRATION DATE OF THE LICENSE: April 30, 2024

STATE OF HAWAII  
 DEPARTMENT OF TRANSPORTATION  
 HIGHWAYS DIVISION

**Waterline Connection and Temporary By-Pass - 6**


FARRINGTON HIGHWAY WIDENING  
 Kapolei Golf Course Road to Fort Weaver Road  
 Project No. 7101A-01-20

Scale: As Shown    Date: April 2022

**SHEET NO. C-173 OF 767 SHEETS**




FED. ROAD DIST. NO.	STATE	PROJ. NO.	FISCAL YEAR	SHEET NO.	TOTAL SHEETS
HAWAII	HAW.	7101A-01-20	2021	175	767

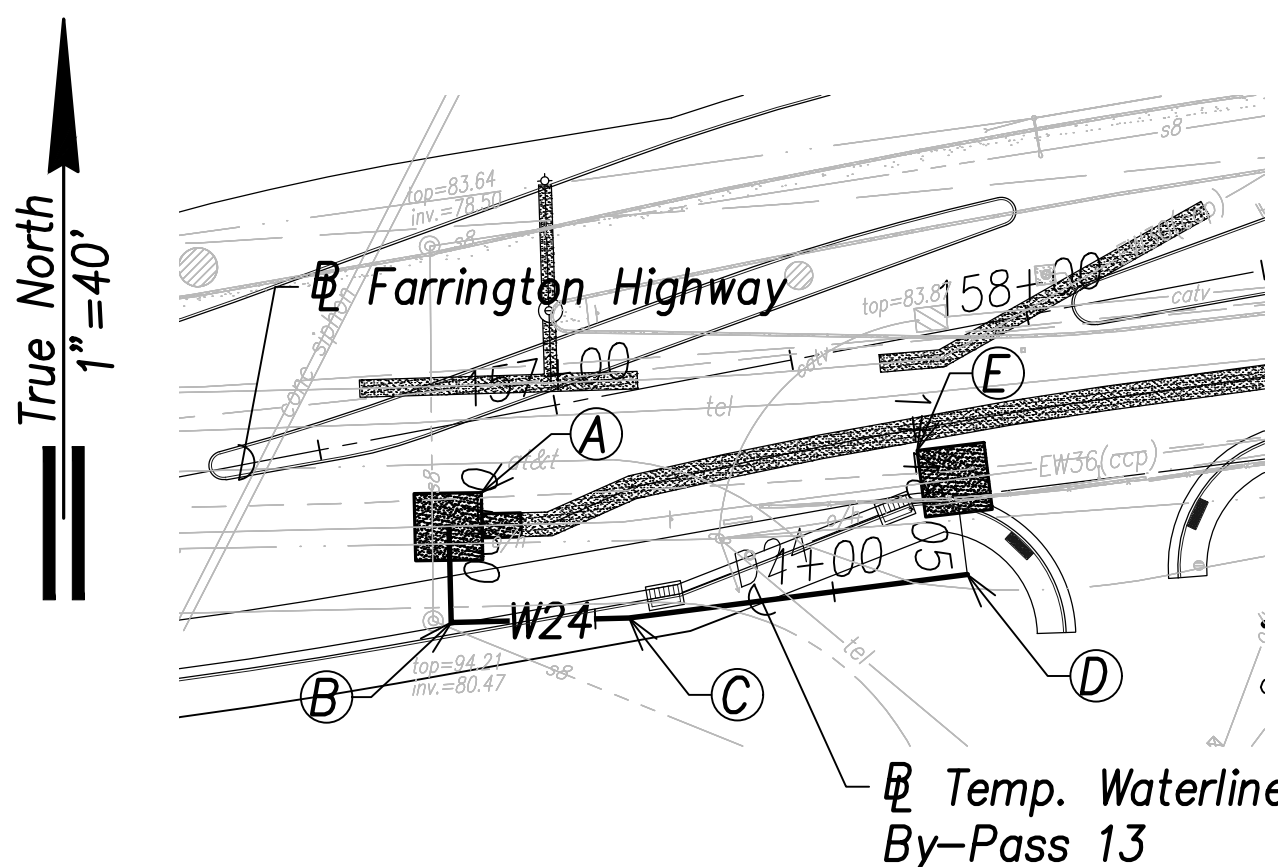


**Temporary Waterline By-Pass 13 Plan**  
 (# Sta. 156+94.2 Farrington Highway)  
 Scale: 1" = 40'

- (A) Sta. 156+73.5, o/s 20.7' Rt. Farrington Highway  
 =# Sta. 0+00 By-Pass  
 Temporary By-Pass Connection  
 See Detail Shts. C-208 to C-211 (Typ.)
- (B) Sta. 156+70.2, o/s 40.4' Rt. Farrington Highway  
 =# Sta. 0+20 By-Pass  
 1-24" 1/4 Bend
- (C) Sta. 157+06.7, o/s 46.5' Rt. Farrington Highway  
 =# Sta. 0+57 By-Pass  
 1-24" 1/16 Bend
- (D) Sta. 157+77.6, o/s 50.8' Rt. Farrington Highway  
 =# Sta. 1+28.1 By-Pass  
 1-24" 1/4 Bend
- (E) Sta. 157+78.8, o/s 30.8' Rt. Farrington Highway  
 =# Sta. 1+48.1 By-Pass  
 Temporary By-Pass Connection  
 See Detail Shts. C-208 to C-211 (Typ.)

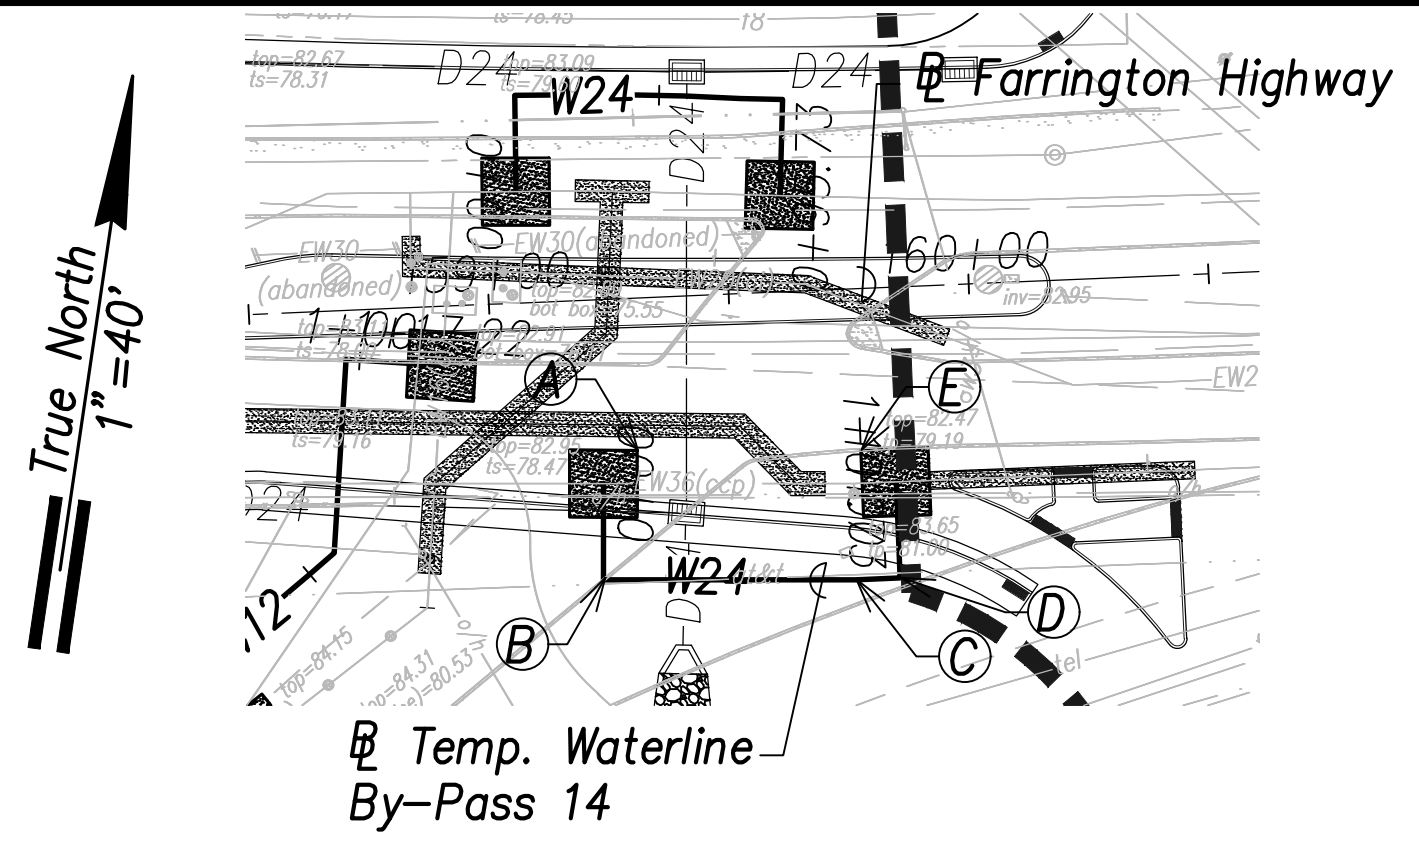


**Temporary Waterline By-Pass 14 Plan**  
 (# Sta. 159+62.3 Farrington Highway)  
 Scale: 1" = 40'

- (A) Sta. 159+22.3, o/s 38.3' Rt. Farrington Highway  
 =# Sta. 0+00 By-Pass  
 Temporary By-Pass Connection  
 See Detail Shts. C-208 to C-211 (Typ.)
- (B) Sta. 159+21.5, o/s 58.3' Rt. Farrington Highway  
 =# Sta. 0+20 By-Pass  
 1-24" 1/4 Bend
- (C) Sta. 159+73.9, o/s 60.5' Rt. Farrington Highway  
 =# Sta. 0+72.5 By-Pass  
 1-24" Deflection
- (D) Sta. 159+83.2, o/s 60.5' Rt. Farrington Highway  
 =# Sta. 0+81.7 By-Pass  
 1-24" 1/4 Bend
- (E) Sta. 159+83.2, o/s 40.5' Rt. Farrington Highway  
 =# Sta. 1+01.7 By-Pass  
 Temporary By-Pass Connection  
 See Detail Shts. C-208 to C-211 (Typ.)

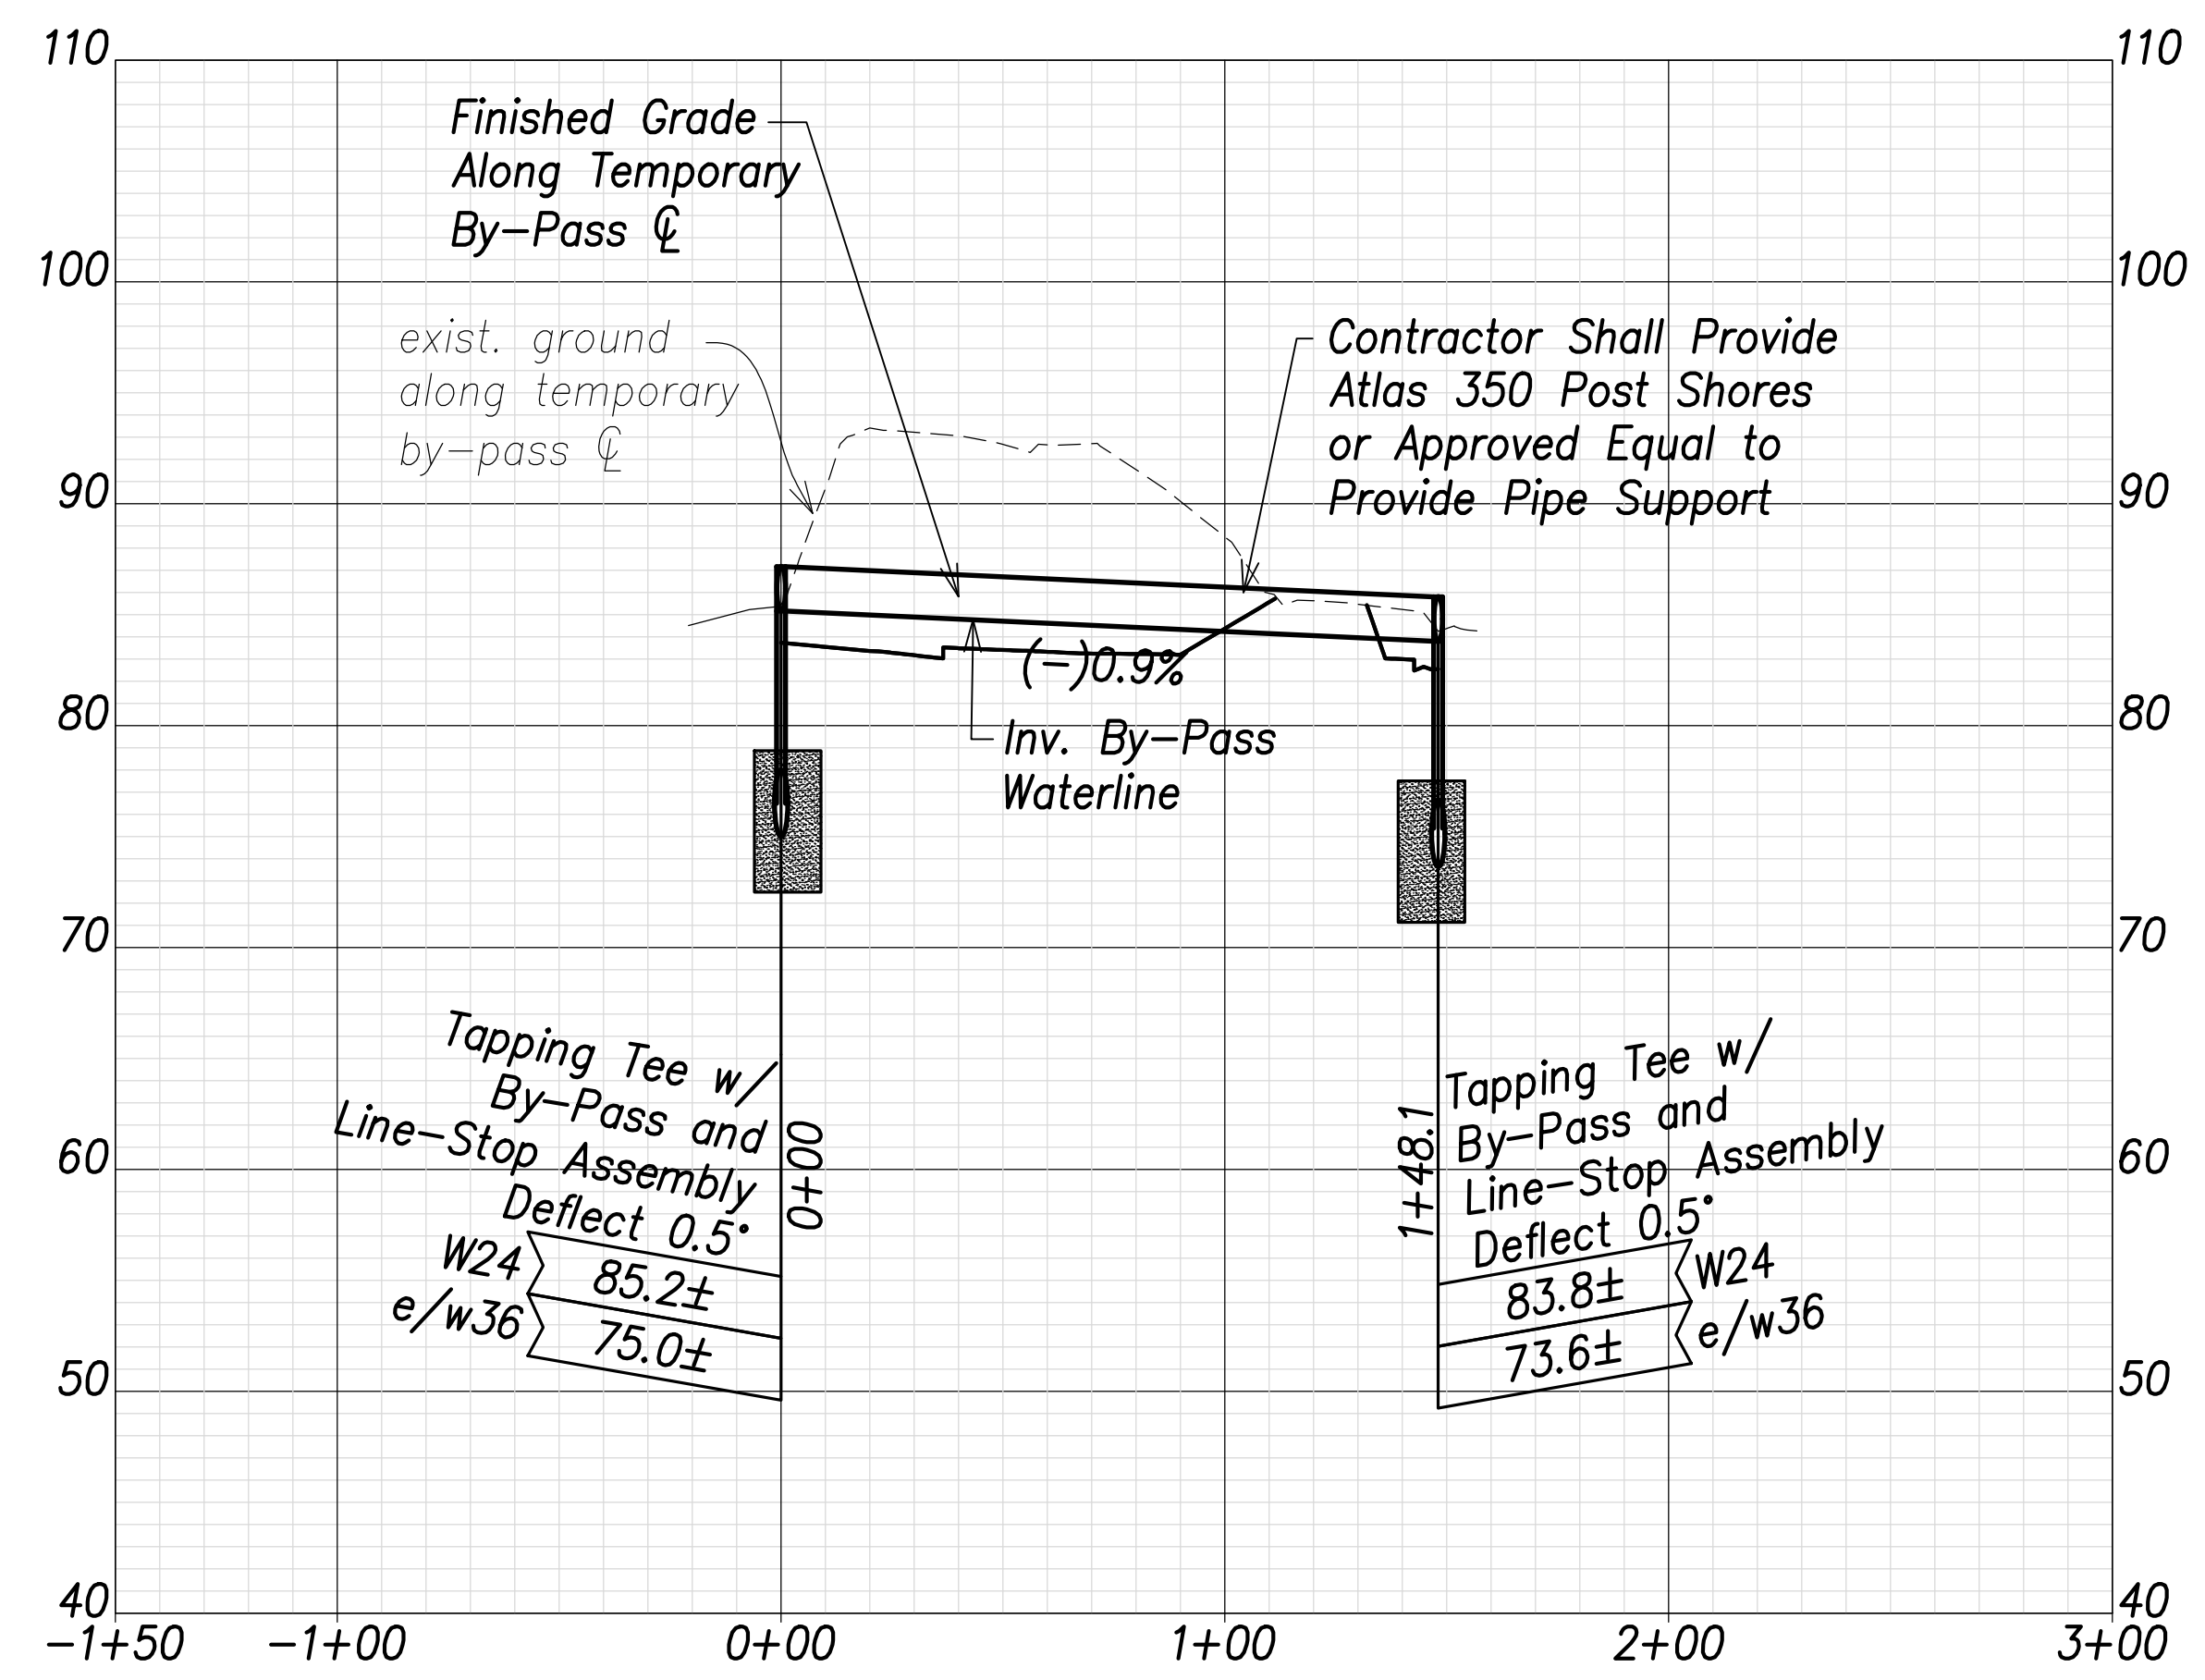

**Temporary Waterline By-Pass 13 Profile**  
 Scales: Hor.: 1" = 40'  
 Vert.: 1" = 8'

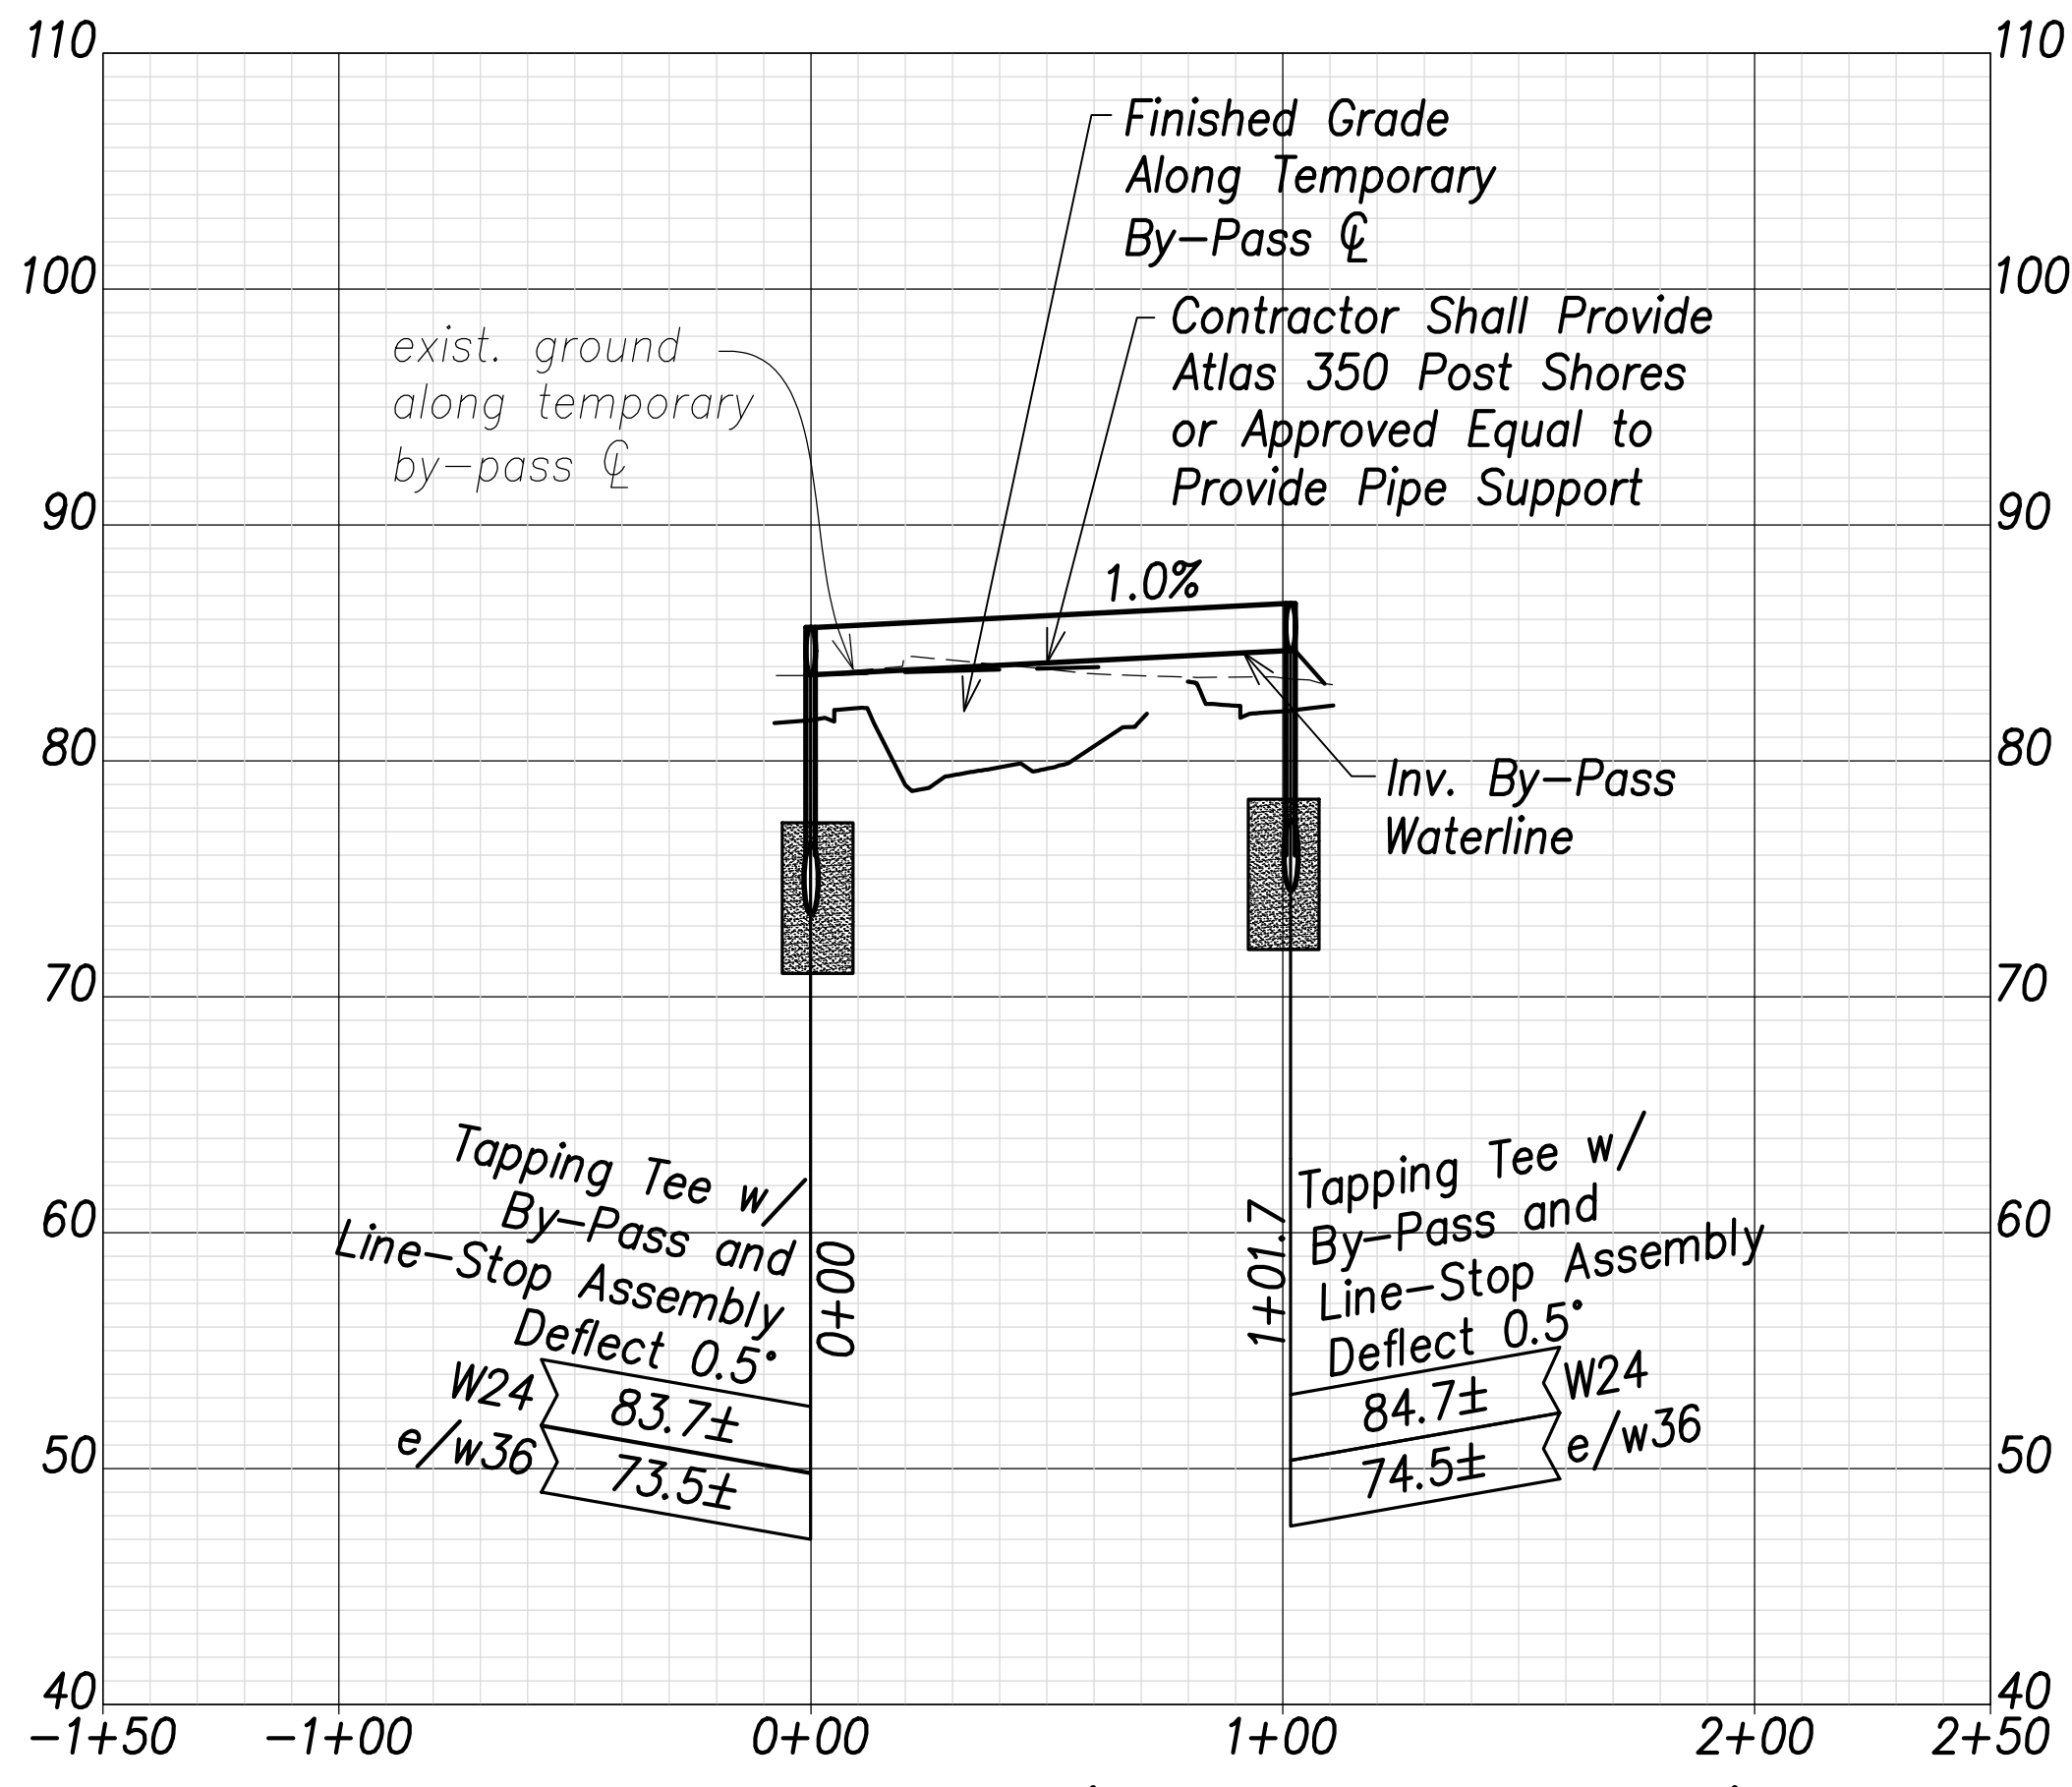


**Temporary Waterline By-Pass 14 Profile**  
 Scales: Hor.: 1" = 40'  
 Vert.: 1" = 8'

- Notes:**
- Contractor shall provide mechanical joint pipes and fittings with retainer glands and/or flanged pipes and fittings to construct the temporary by-passes
  - The Contractor shall submit the construction schedule and construction phasing for the temporary by-passes to BWS for review and approval. The Contractor shall not commence work on the temporary by-passes until approval is obtained by BWS.

DATE	REVISION
07/15/22	Revised callouts; added note
06/08/22	Revised By-Pass Alignment & Profile

SURVEY PLOTTED BY:	DATE:
DRAWN BY:	DATE:
TRACED BY:	DATE:
QUANTITIES BY:	DATE:
CHECKED BY:	DATE:
ORIGINAL PLAN:	
NOTE BOOK:	
No.:	

APPROVED: \_\_\_\_\_ DATE \_\_\_\_\_  
 Manager and Chief Engineer, BWS  
 (for work affecting BWS facilities in City/State R/W & BWS easements only)

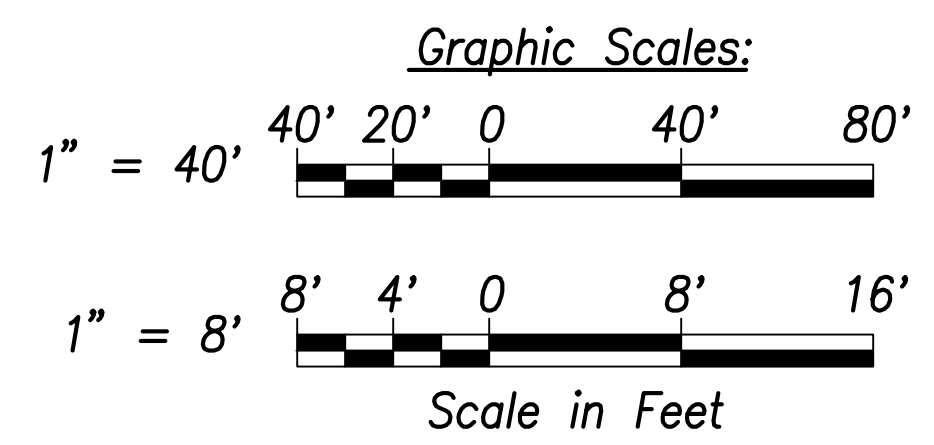

THIS WORK WAS PREPARED BY ME OR UNDER MY SUPERVISION AND CONSTRUCTION OF THIS PROJECT WILL BE UNDER MY OBSERVATION.  
 SIGNATURE: \_\_\_\_\_ EXPIRATION DATE OF THE LICENSE: April 30, 2024

STATE OF HAWAII  
 DEPARTMENT OF TRANSPORTATION  
 HIGHWAYS DIVISION

**Waterline Connection and Temporary By-Pass - 7**


FARRINGTON HIGHWAY WIDENING  
 Kapolei Golf Course Road to Fort Weaver Road  
 Project No. 7101A-01-20

Scale: As Shown Date: April 2022

SHEET NO. C-174 OF 767 SHEETS


FED. ROAD DIST. NO.	STATE	PROJ. NO.	FISCAL YEAR	SHEET NO.	TOTAL SHEETS
HAWAII	HAW.	7101A-01-20	2021	176	767

True North  
1" = 40'

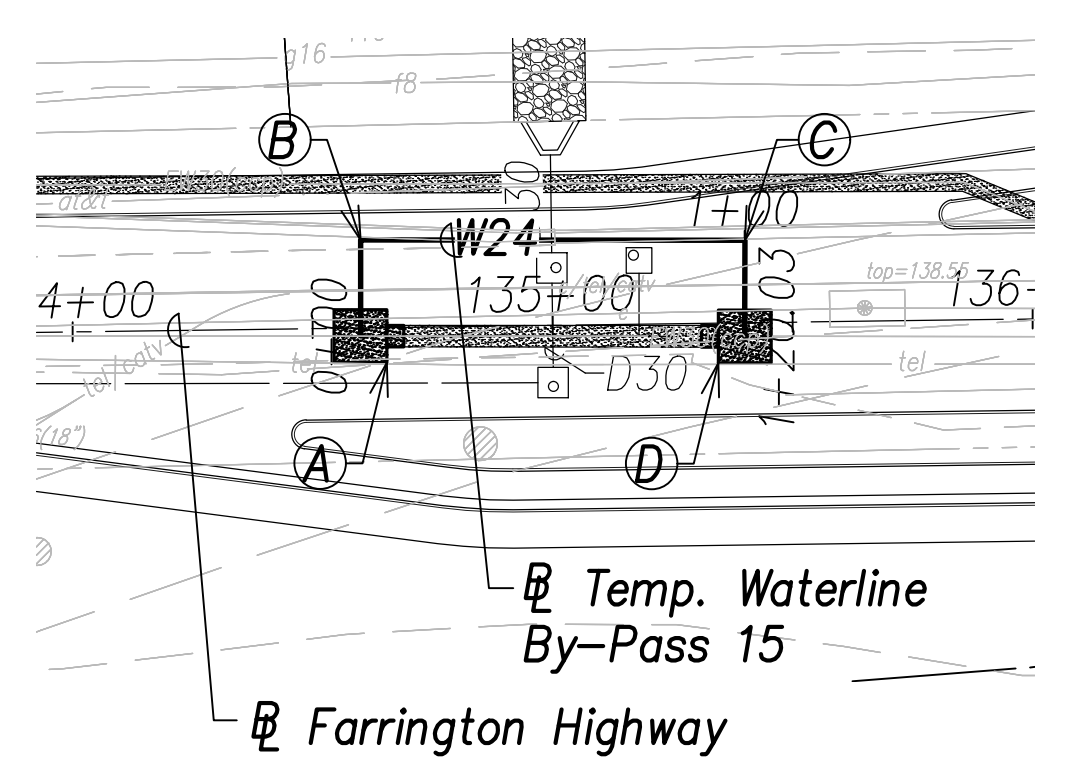


**Temporary Waterline By-Pass 15 Plan**  
 (# Sta. 134+75 Farrington Highway)  
 (# Sta. 135+24.9 Farrington Highway)  
 Scale: 1" = 40'

- (A) # Sta. 134+60, o/s 1.7' Rt. Farrington Highway  
 =# Sta. 0+00 By-Pass  
 Temporary By-Pass Connection  
 See Detail Shts. C-208 to C-211 (Typ.)
- (B) # Sta. 134+60.3, o/s 18.3' Lt. Farrington Highway  
 (=# Sta. 0+20 By-Pass)  
 1-24" 1/4 Bend
- (C) # Sta. 135+40.3, o/s 17.2' Lt. Farrington Highway  
 =# Sta. 1+00 By-Pass  
 1-24" 1/4 Bend
- (D) # Sta. 135+40, o/s 2.8' Rt. Farrington Highway  
 =# Sta. 1+20 By-Pass  
 Temporary By-Pass Connection  
 See Detail Shts. C-208 to C-211 (Typ.)

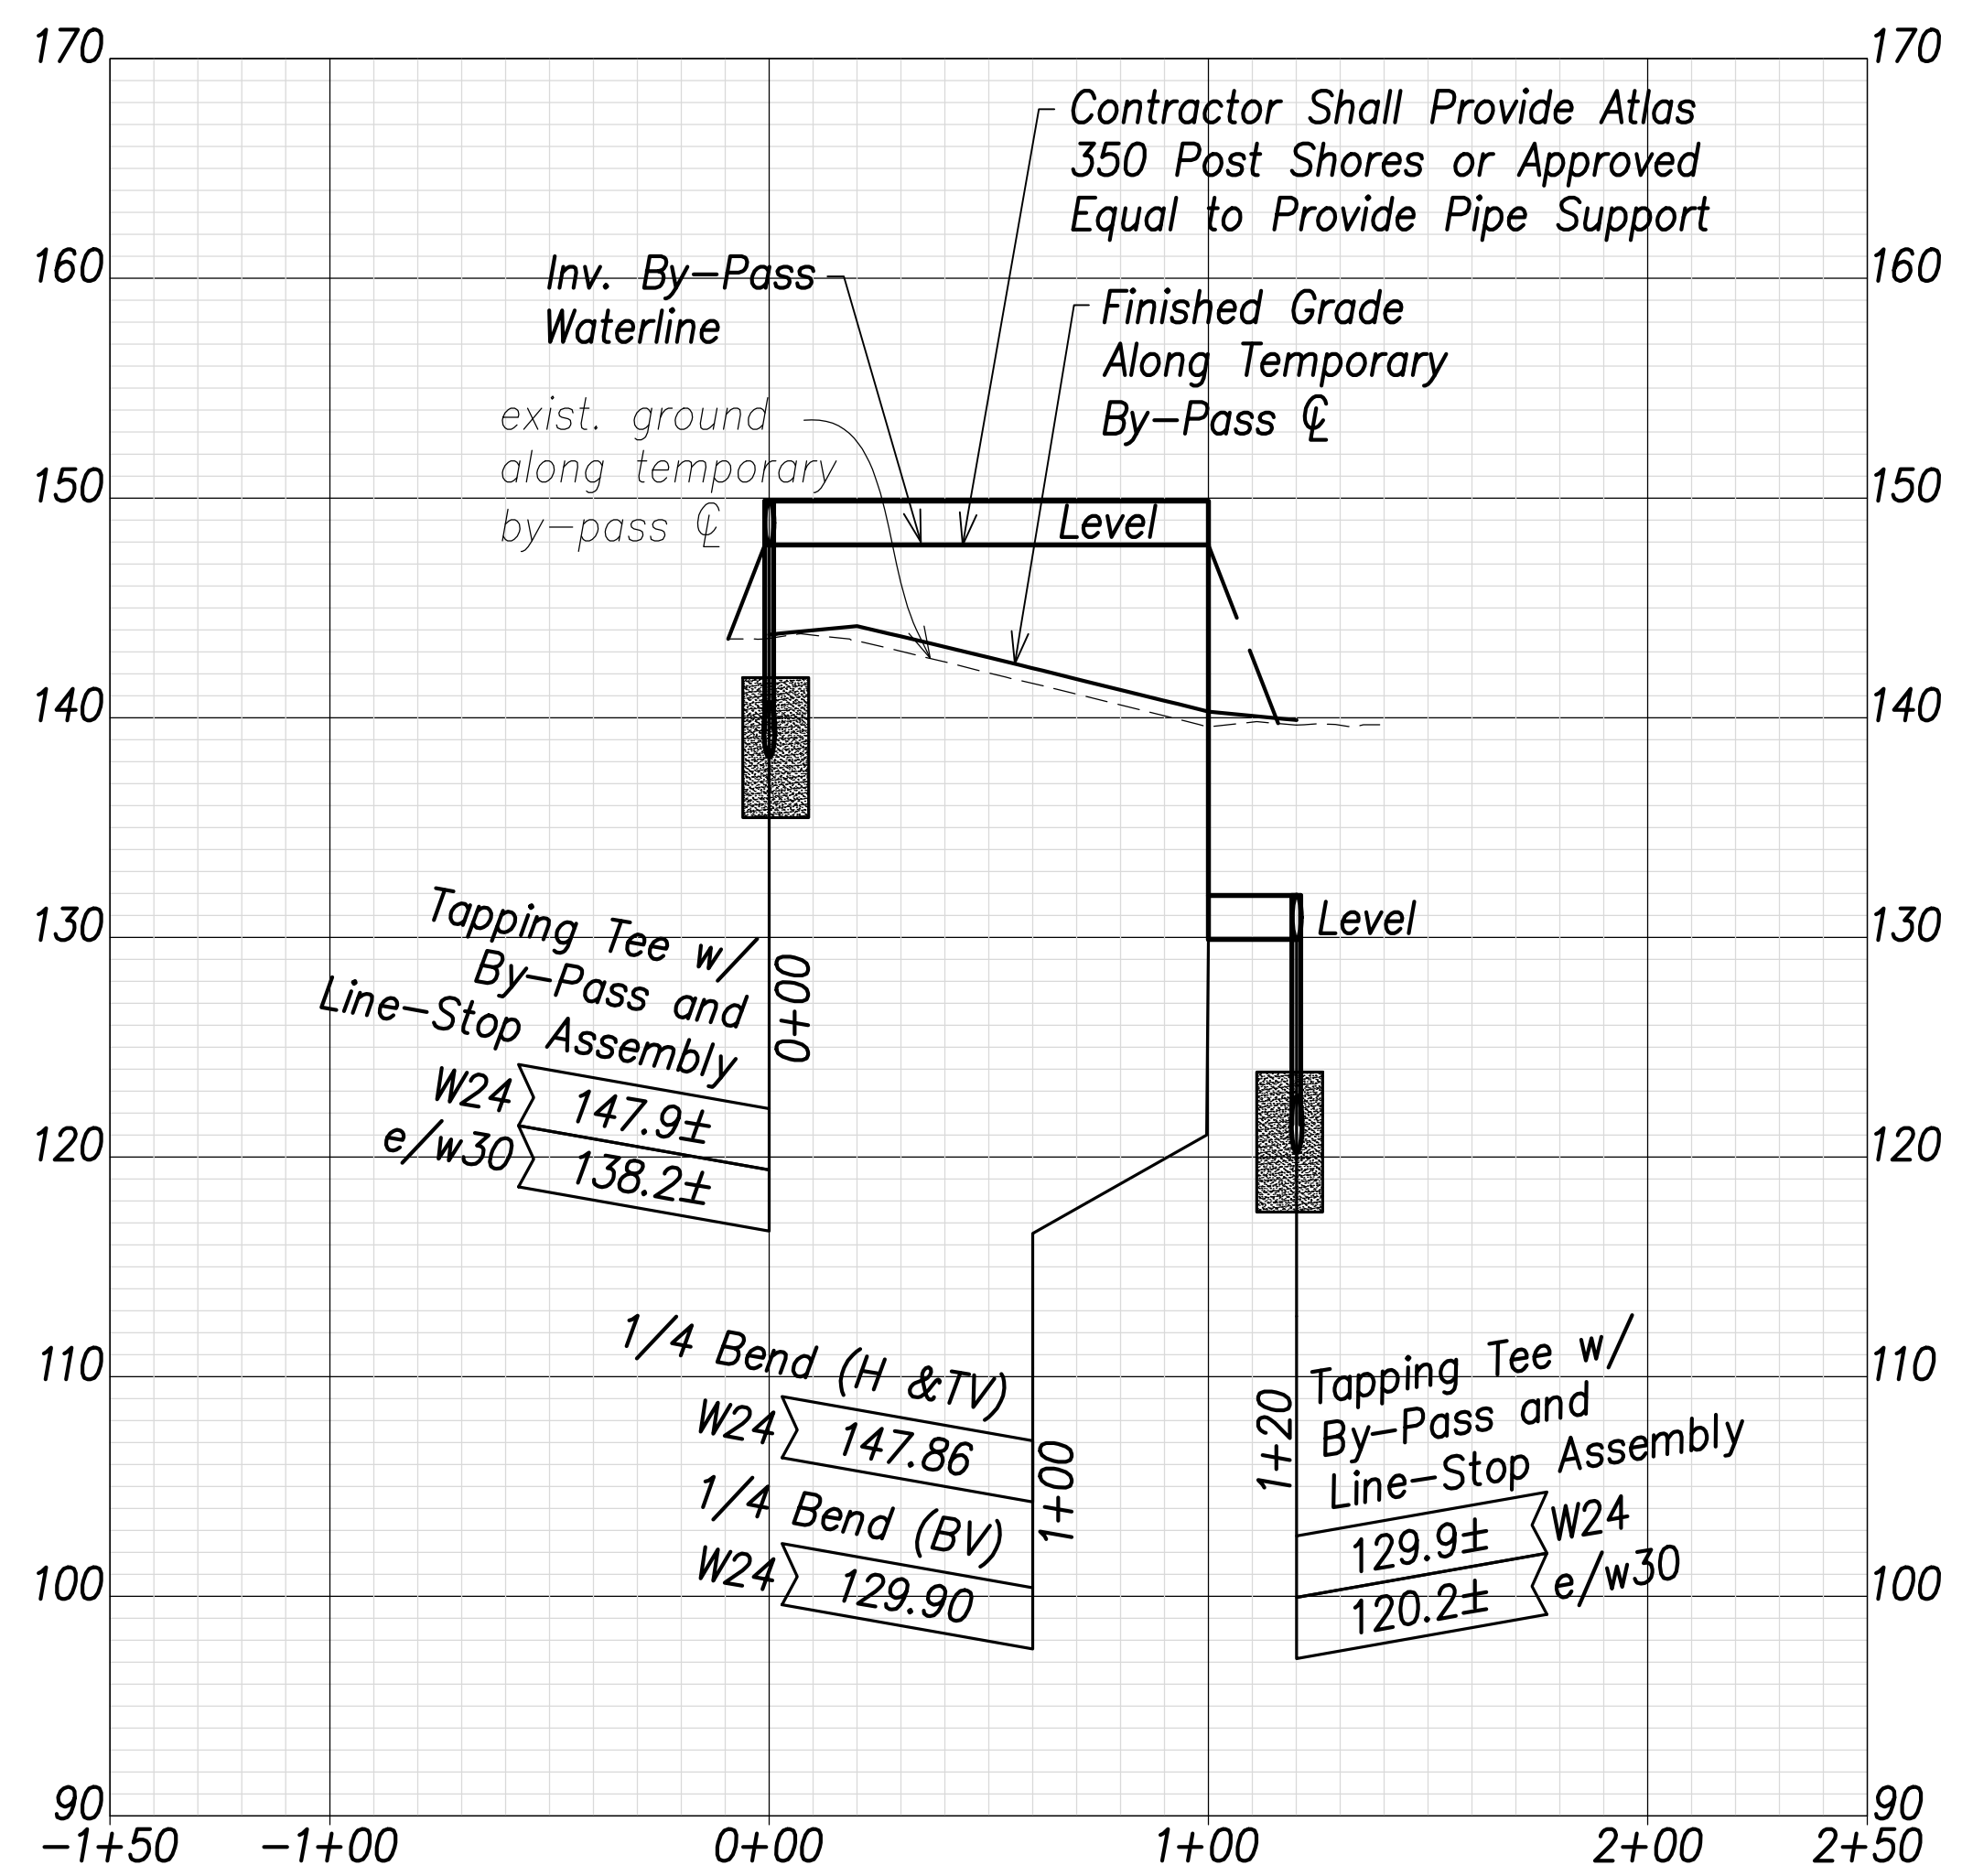



**Temporary Waterline By-Pass 15 Profile**  
 Scales: Hor.: 1" = 40'  
 Vert.: 1" = 8'

- Notes:**
- Contractor shall provide mechanical joint pipes and fittings with retainer glands and/or flanged pipes and fittings to construct the temporary by-passes
  - The Contractor shall submit the construction schedule and construction phasing for the temporary by-passes to BWS for review and approval. The Contractor shall not commence work on the temporary by-passes until approval is obtained by BWS.

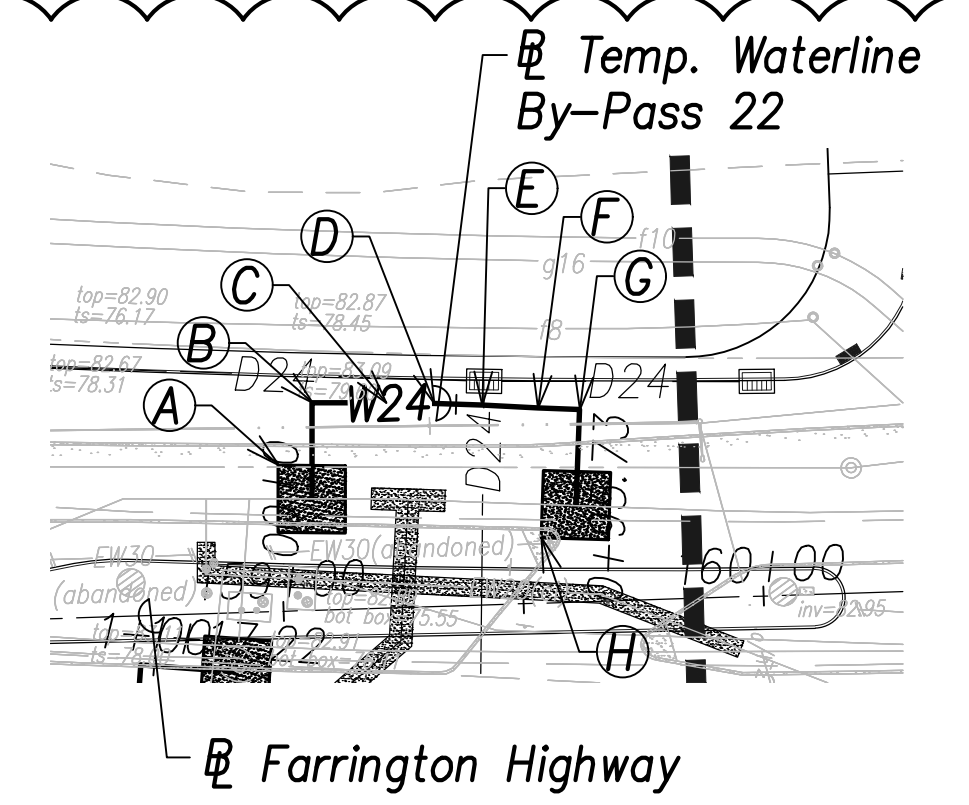

**Temporary Waterline By-Pass 22 Plan**  
 (# Sta. 150+07.3 Farrington Highway)  
 (# Sta. 159+61.6 Farrington Highway)  
 Scale: 1" = 40'

- (A) # Sta. 159+06.7, o/s 2.3' Lt. Farrington Highway  
 =# Sta. 0+00 By-Pass  
 Temporary By-Pass Connection  
 See Detail Shts. C-208 to C-211 (Typ.)
- (B) # Sta. 159+07.3, o/s 43.3' Lt. Farrington Highway  
 =# Sta. 0+20 By-Pass  
 1-12" 1/4 Bend
- (C) # Sta. 159+22.7, o/s 42.7' Lt. Farrington Highway  
 =# Sta. 0+35.3 By-Pass  
 1-12" Deflection
- (D) # Sta. 159+32.6, o/s 42.3' Lt. Farrington Highway  
 =# Sta. 0+45.3 By-Pass  
 1-12" Deflection
- (E) # Sta. 159+42.6, o/s 41.6' Lt. Farrington Highway  
 =# Sta. 0+55.3 By-Pass  
 1-12" Deflection
- (F) # Sta. 159+54.2, o/s 40.6' Lt. Farrington Highway  
 =# Sta. 0+67.0 By-Pass  
 1-12" Deflection
- (G) # Sta. 159+62.9, o/s 40.0' Lt. Farrington Highway  
 =# Sta. 0+75.7 By-Pass  
 1-12" 1/4 Bend
- (H) # Sta. 159+73.6, o/s 19.3' Lt. Farrington Highway  
 =# Sta. 0+95.7 By-Pass  
 Temporary By-Pass Connection  
 See Detail Shts. C-208 to C-211 (Typ.)

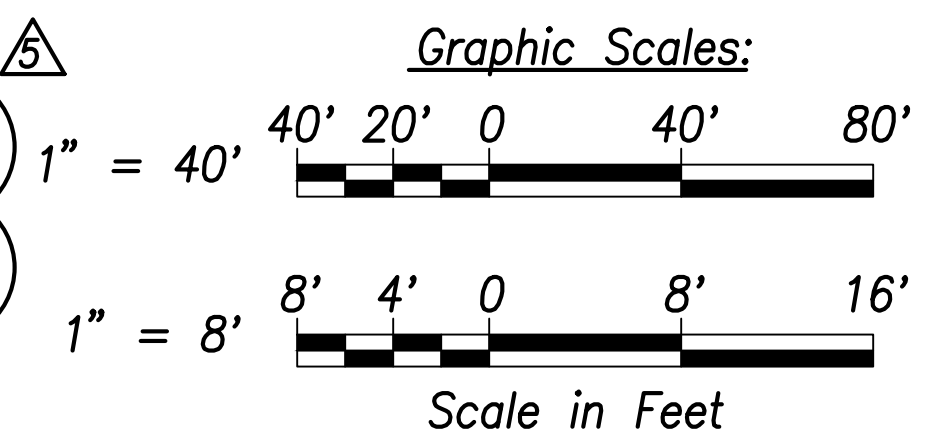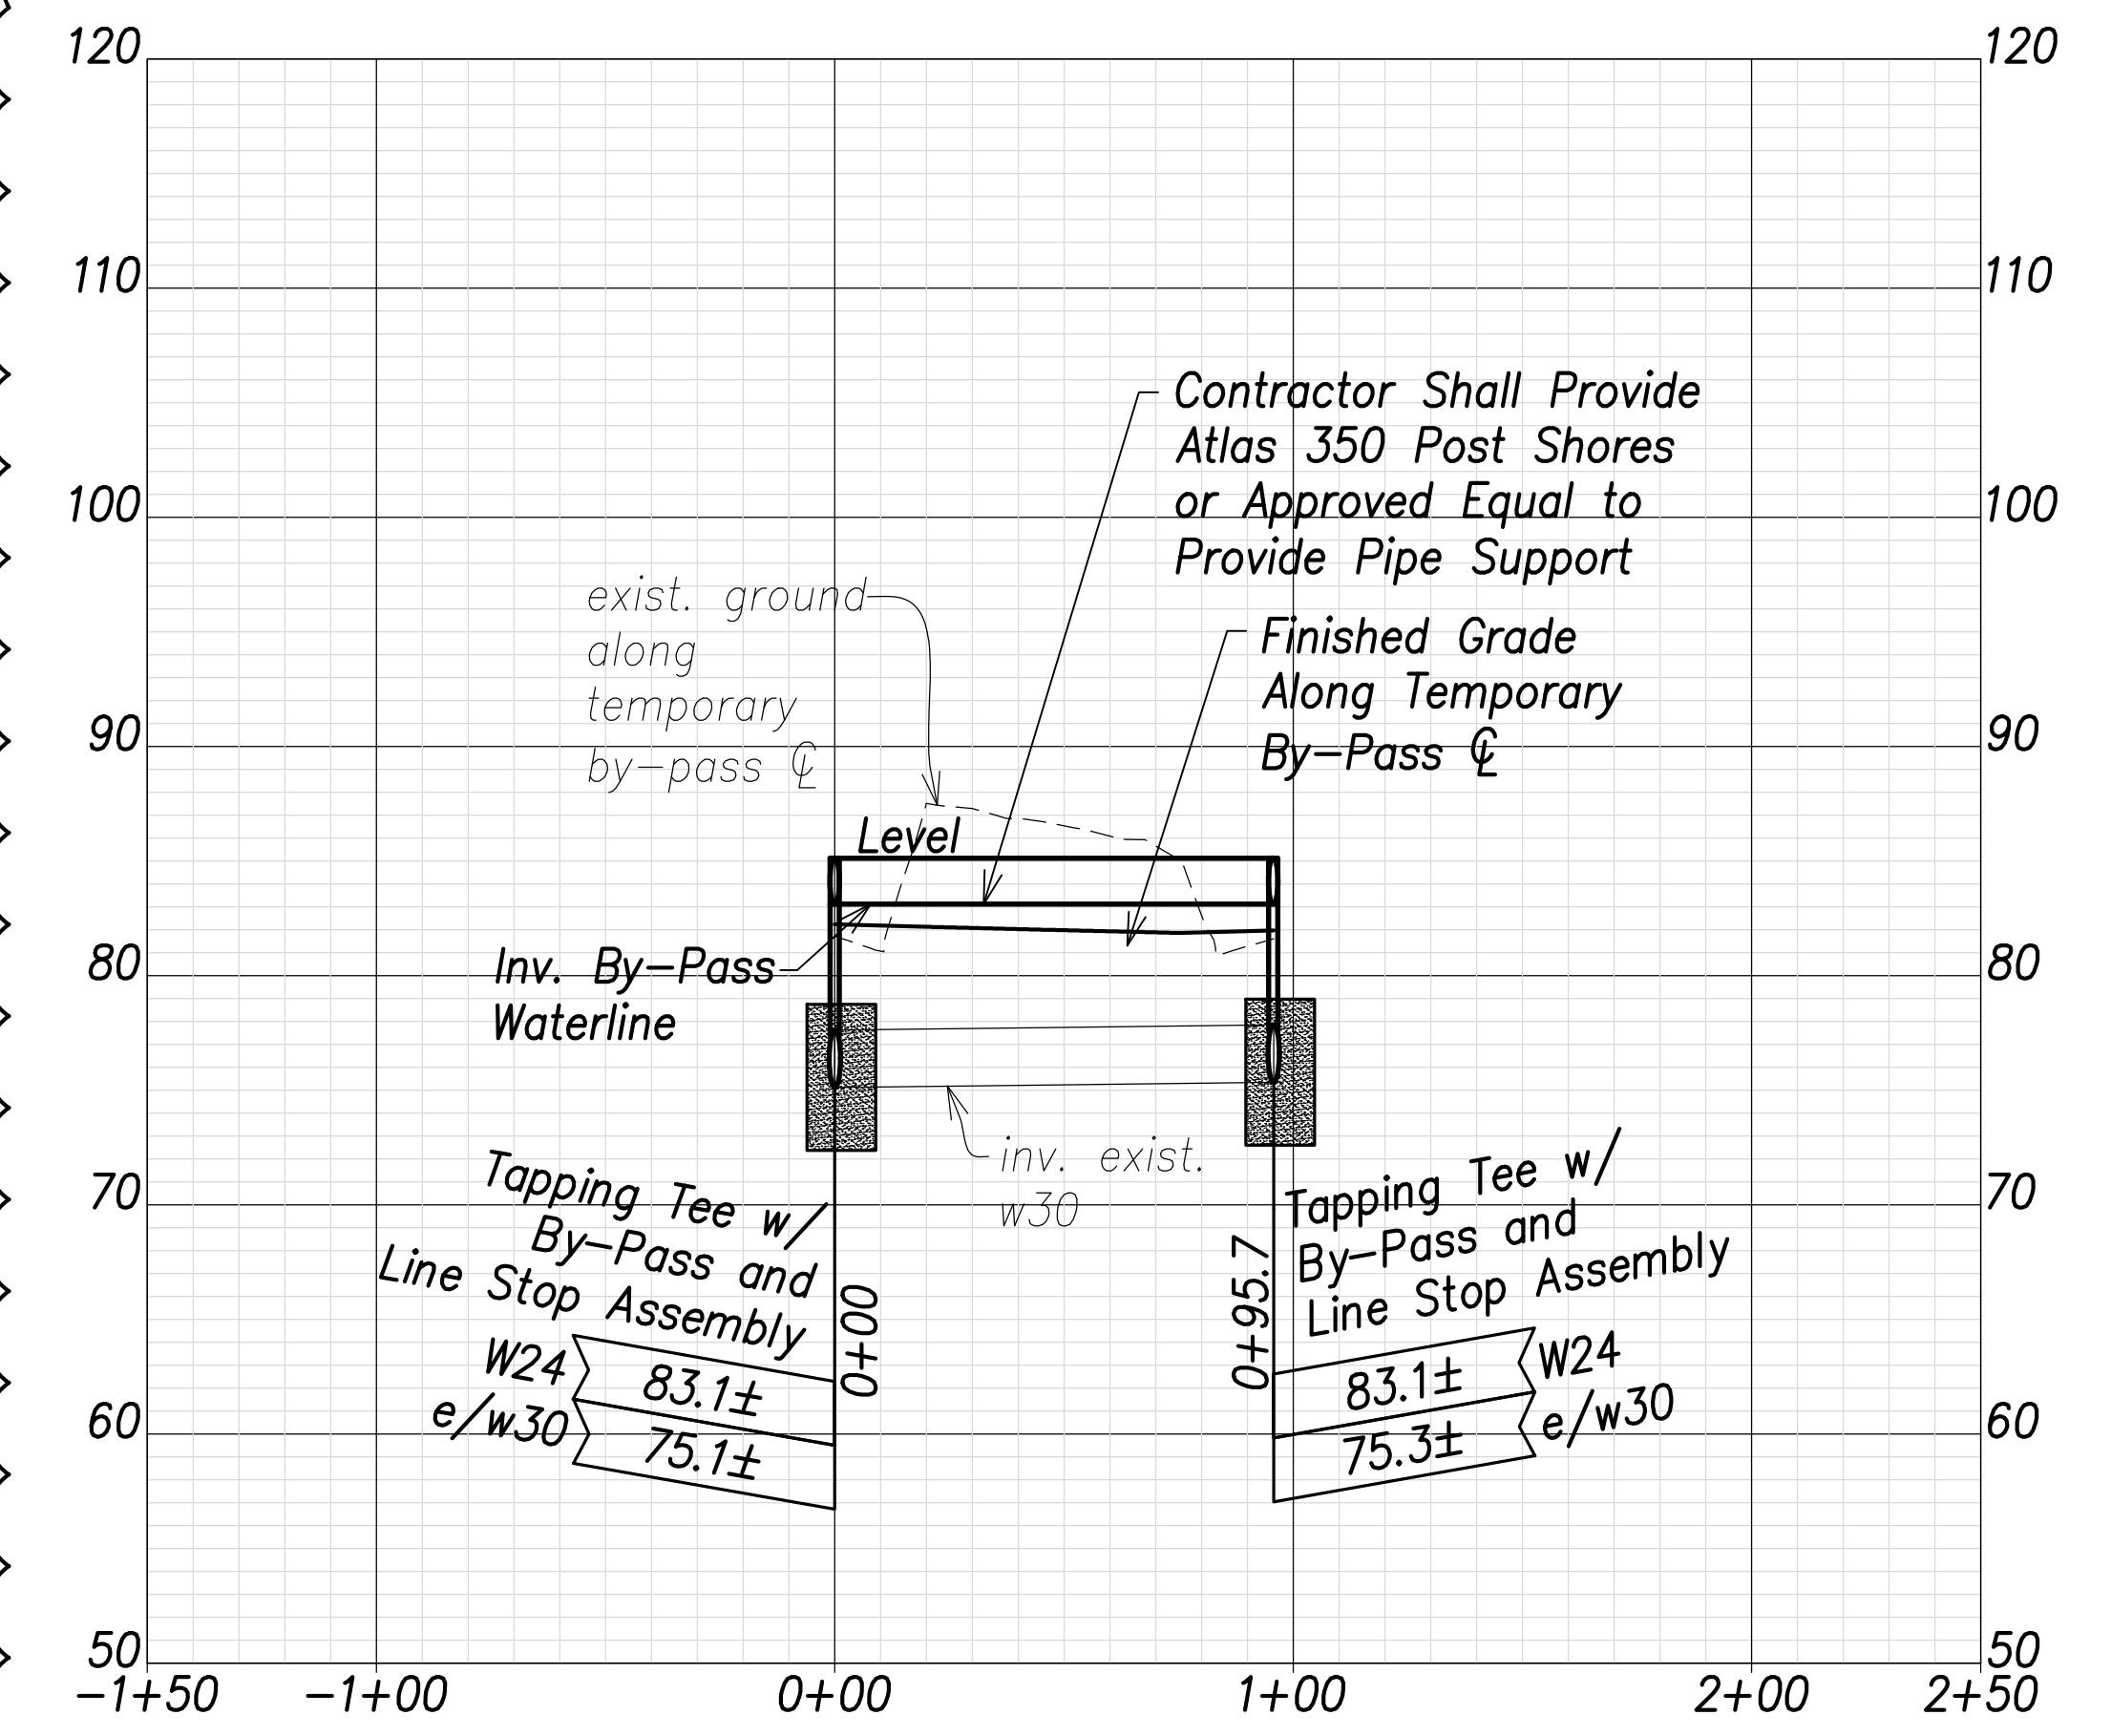


SURVEY PLOTTED BY:	DATE
DRAWN BY:	
TRACED BY:	
QUANTITIES BY:	
CHECKED BY:	
ORIGINAL PLAN	
NOTE BOOK	
No.	

APPROVED:

Manager and Chief Engineer, BWS \_\_\_\_\_ DATE \_\_\_\_\_  
 (for work affecting BWS facilities in City/State R/W & BWS easements only)

DATE	REVISION
07/15/22	Revised callouts; added note
06/08/22	Revised By-Pass Alignment & Profile

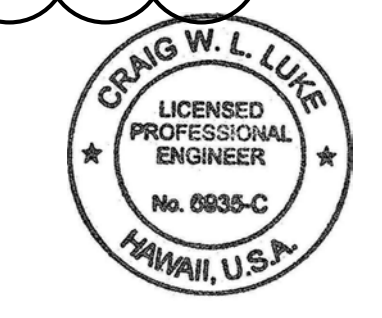

THIS WORK WAS PREPARED BY ME OR UNDER MY SUPERVISION AND CONSTRUCTION OF THIS PROJECT WILL BE UNDER MY OBSERVATION.

Signature: \_\_\_\_\_  
 EXPIRATION DATE OF THE LICENSE: April 30, 2024

STATE OF HAWAII  
 DEPARTMENT OF TRANSPORTATION  
 HIGHWAYS DIVISION

**Waterline Connection and Temporary By-Pass - 8**


FARRINGTON HIGHWAY WIDENING  
 Kapolei Golf Course Road to Fort Weaver Road  
 Project No. 7101A-01-20

Scale: As Shown Date: April 2022

SHEET NO. C-175 OF 767 SHEETS




FED. ROAD DIST. NO.	STATE	PROJ. NO.	FISCAL YEAR	SHEET NO.	TOTAL SHEETS
HAWAII	HAW.	7101A-01-20	2021	177	767

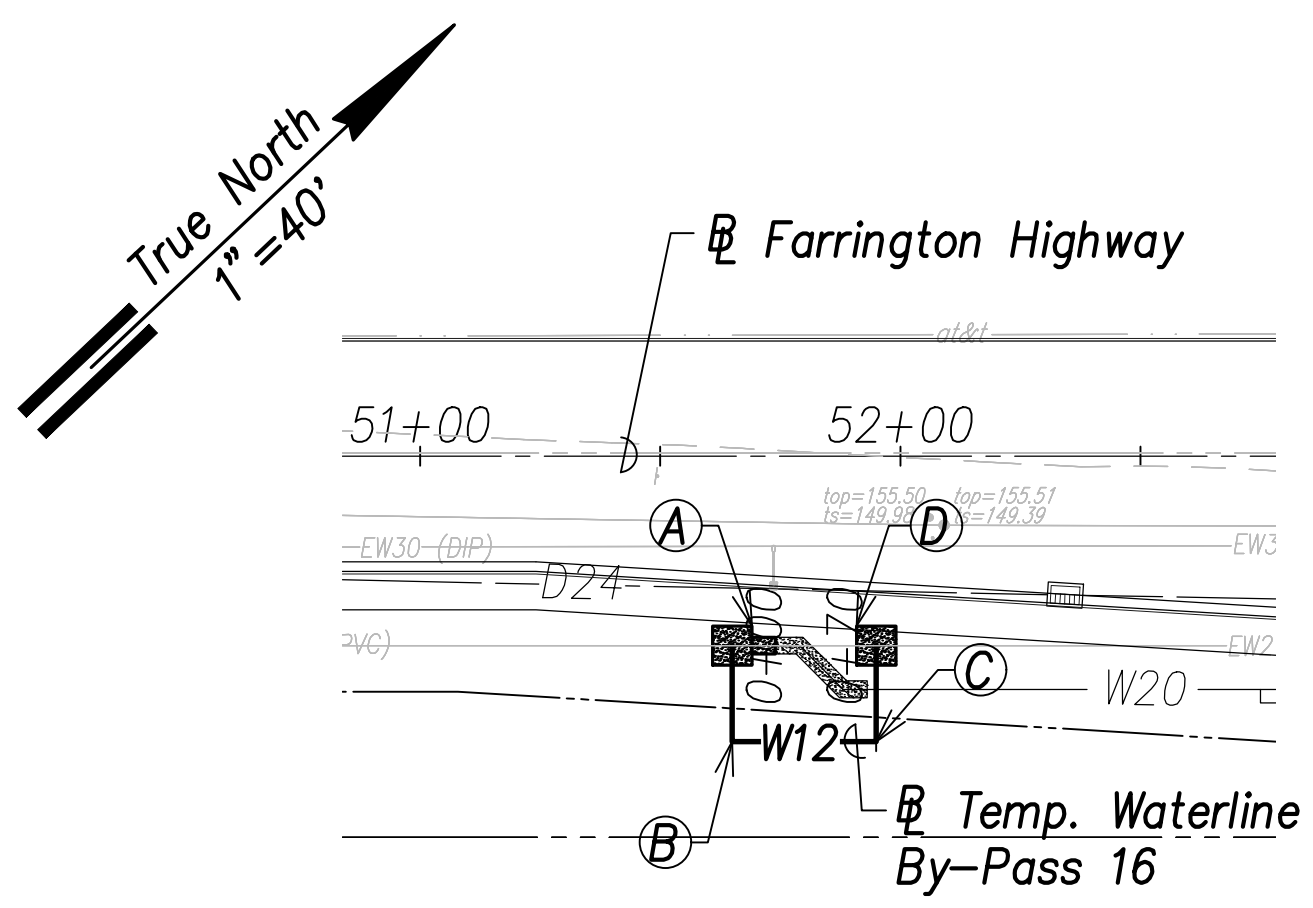


**Temporary Waterline By-Pass 16 Plan**  
 (Sta. 51+79 Farrington Highway)  
 Scale: 1" = 40'

- (A) Sta. 51+65, o/s 39.4' Rt. Farrington Highway  
 = Sta. 0+00 By-Pass  
 Temporary By-Pass Connection  
 See Detail Shts. C-208 to C-211 (Typ.)
- (B) Sta. 51+65, o/s 59.4' Rt. Farrington Highway  
 = Sta. 0+20 By-Pass  
 1-12" 1/4 Bend
- (C) Sta. 51+95, o/s 59.4' Rt. Farrington Highway  
 = Sta. 0+50 By-Pass  
 1-12" 1/4 Bend
- (D) Sta. 51+95, o/s 39.4' Rt. Farrington Highway  
 = Sta. 0+70 By-Pass  
 Temporary By-Pass Connection  
 See Detail Shts. C-208 to C-211 (Typ.)

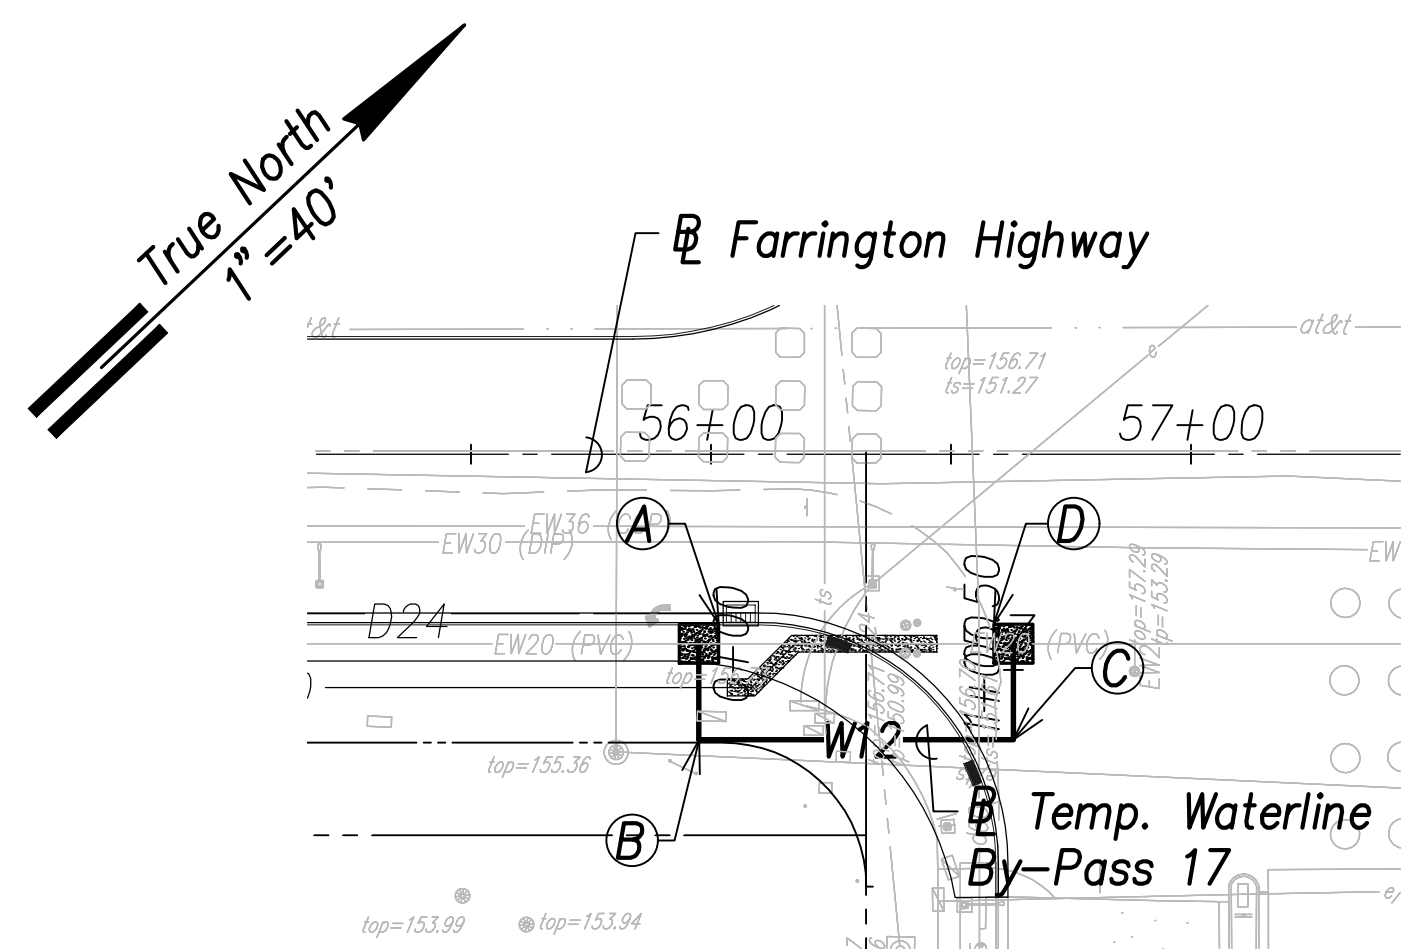

**Temporary Waterline By-Pass 17 Plan**  
 (Sta. 56+37 Farrington Highway)  
 Scale: 1" = 40'


- (A) Sta. 55+97.5, o/s 39.4' Rt. Farrington Highway  
 = Sta. 0+00 By-Pass  
 Temporary By-Pass Connection  
 See Detail Shts. C-208 to C-211 (Typ.)
- (B) Sta. 55+97.5, o/s 59.4' Rt. Farrington Highway  
 = Sta. 0+20 By-Pass  
 1-12" 1/4 Bend
- (C) Sta. 56+63, o/s 59.4' Rt. Farrington Highway  
 = Sta. 0+85.5 By-Pass  
 1-12" 1/4 Bend
- (D) Sta. 56+63, o/s 39.4' Rt. Farrington Highway  
 = Sta. 1+05.5 By-Pass  
 Temporary By-Pass Connection  
 See Detail Shts. C-208 to C-211 (Typ.)

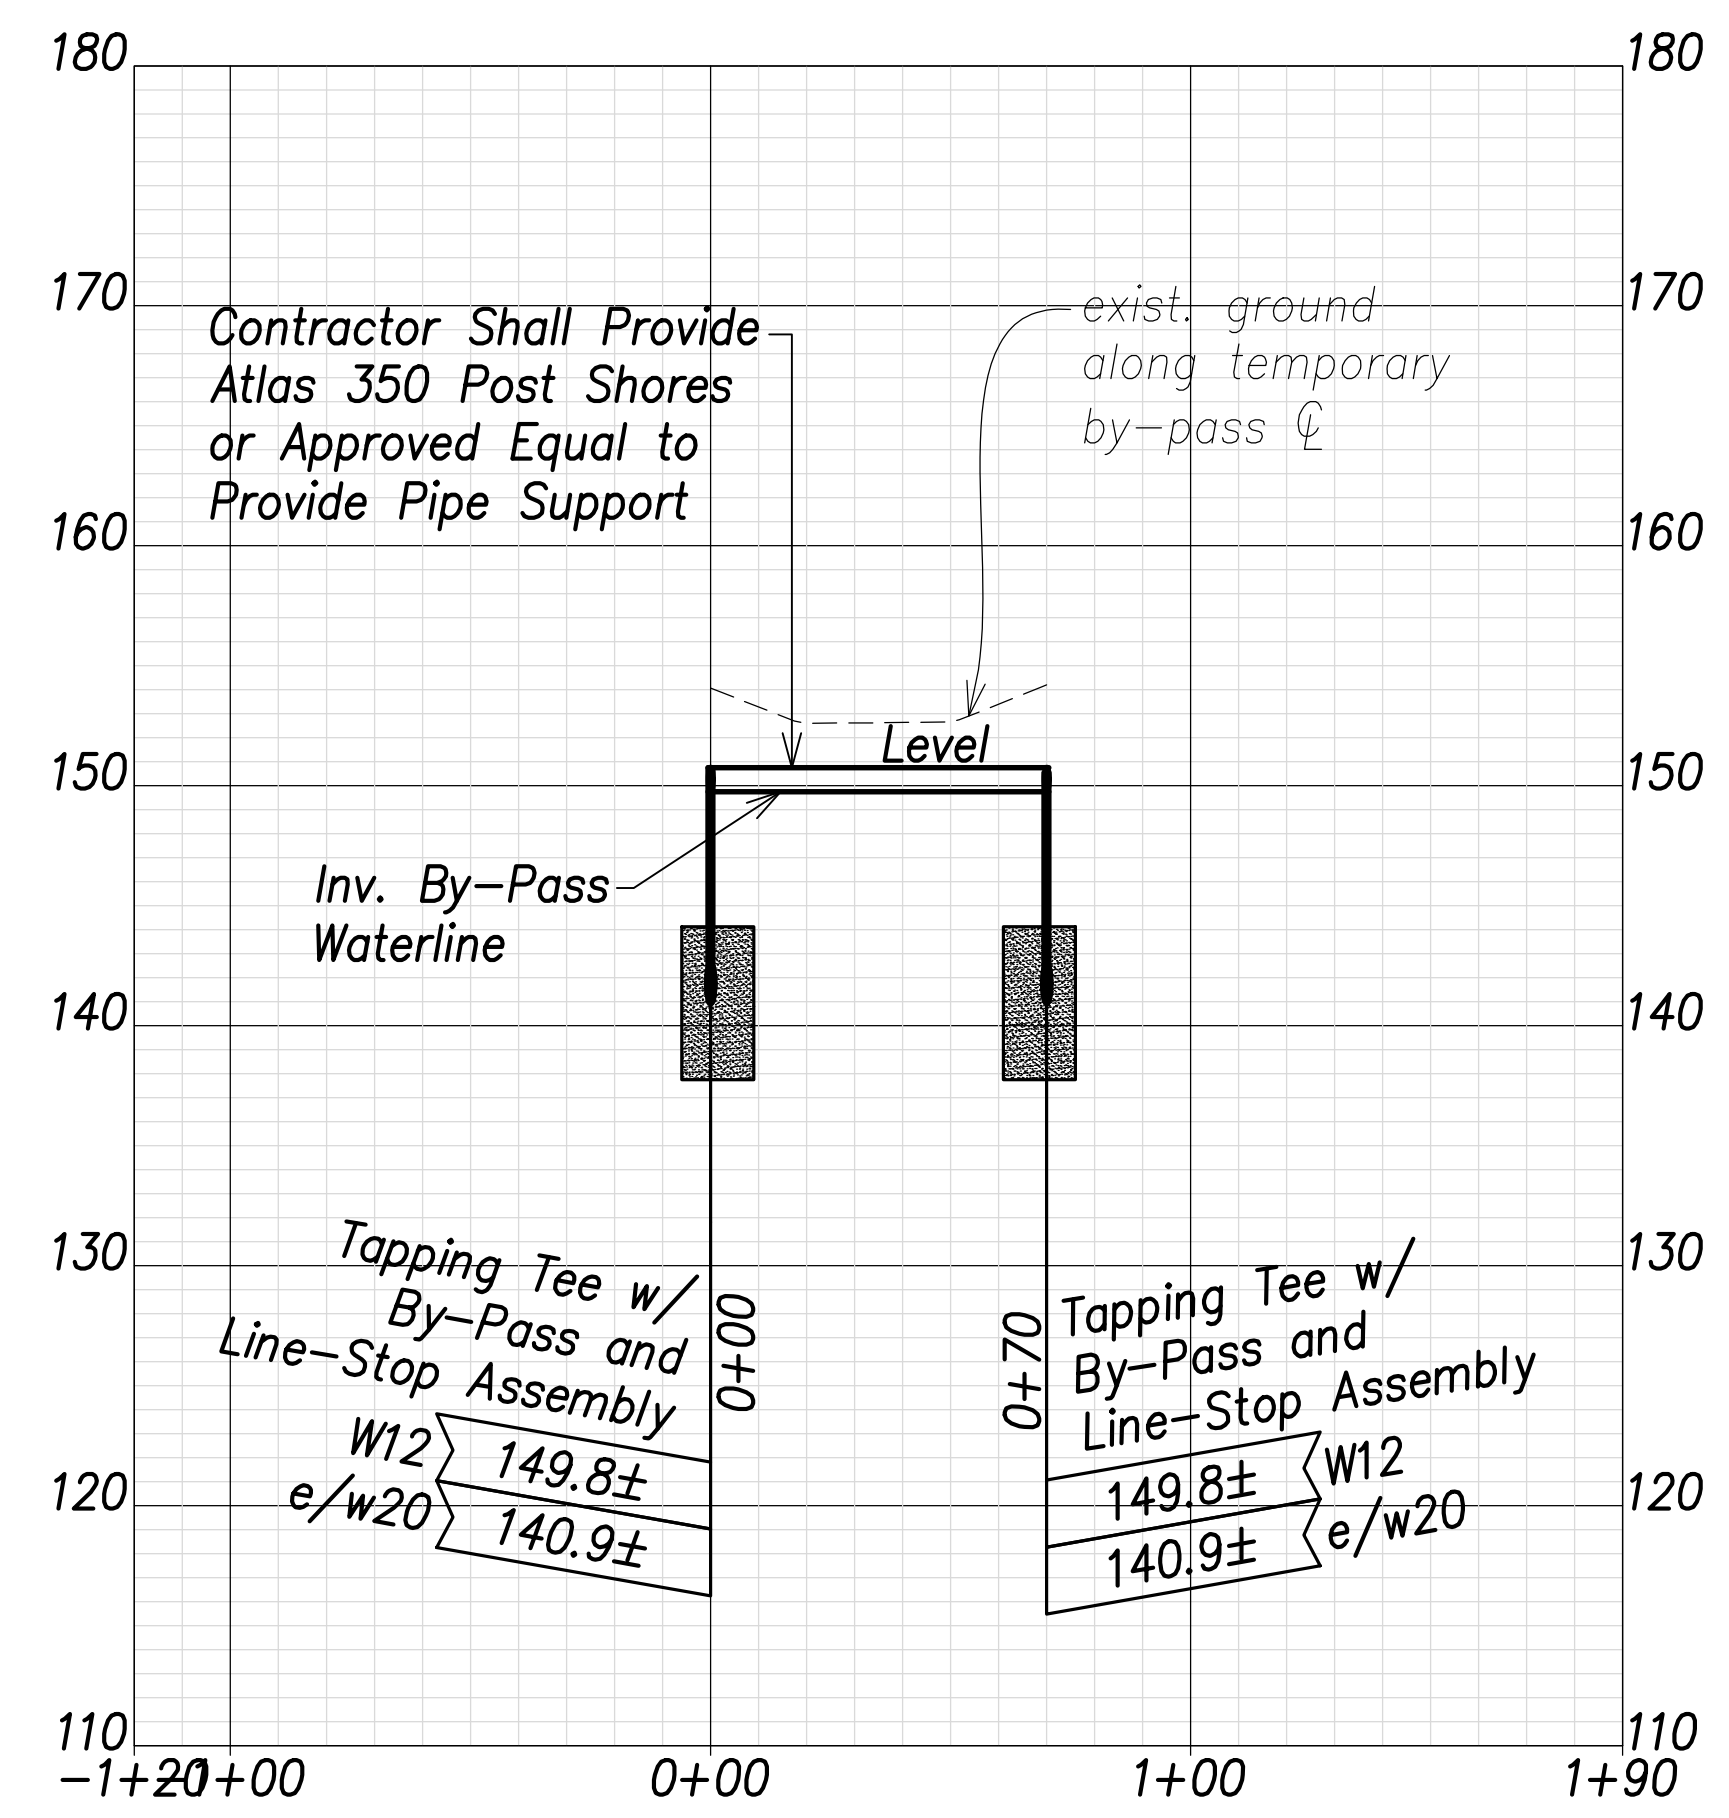


**Temporary Waterline By-Pass 16 Profile**  
 Scales: Hor.: 1" = 40'  
 Vert.: 1" = 8'

**Schedule Note:**  
 The construction working period for Temporary By-Passes 16 and 17 shall be limited to November to February, as approved by BWS.

APPROVED:  
 Manager and Chief Engineer, BWS  
 (for work affecting BWS facilities in City/State R/W & BWS easements only)

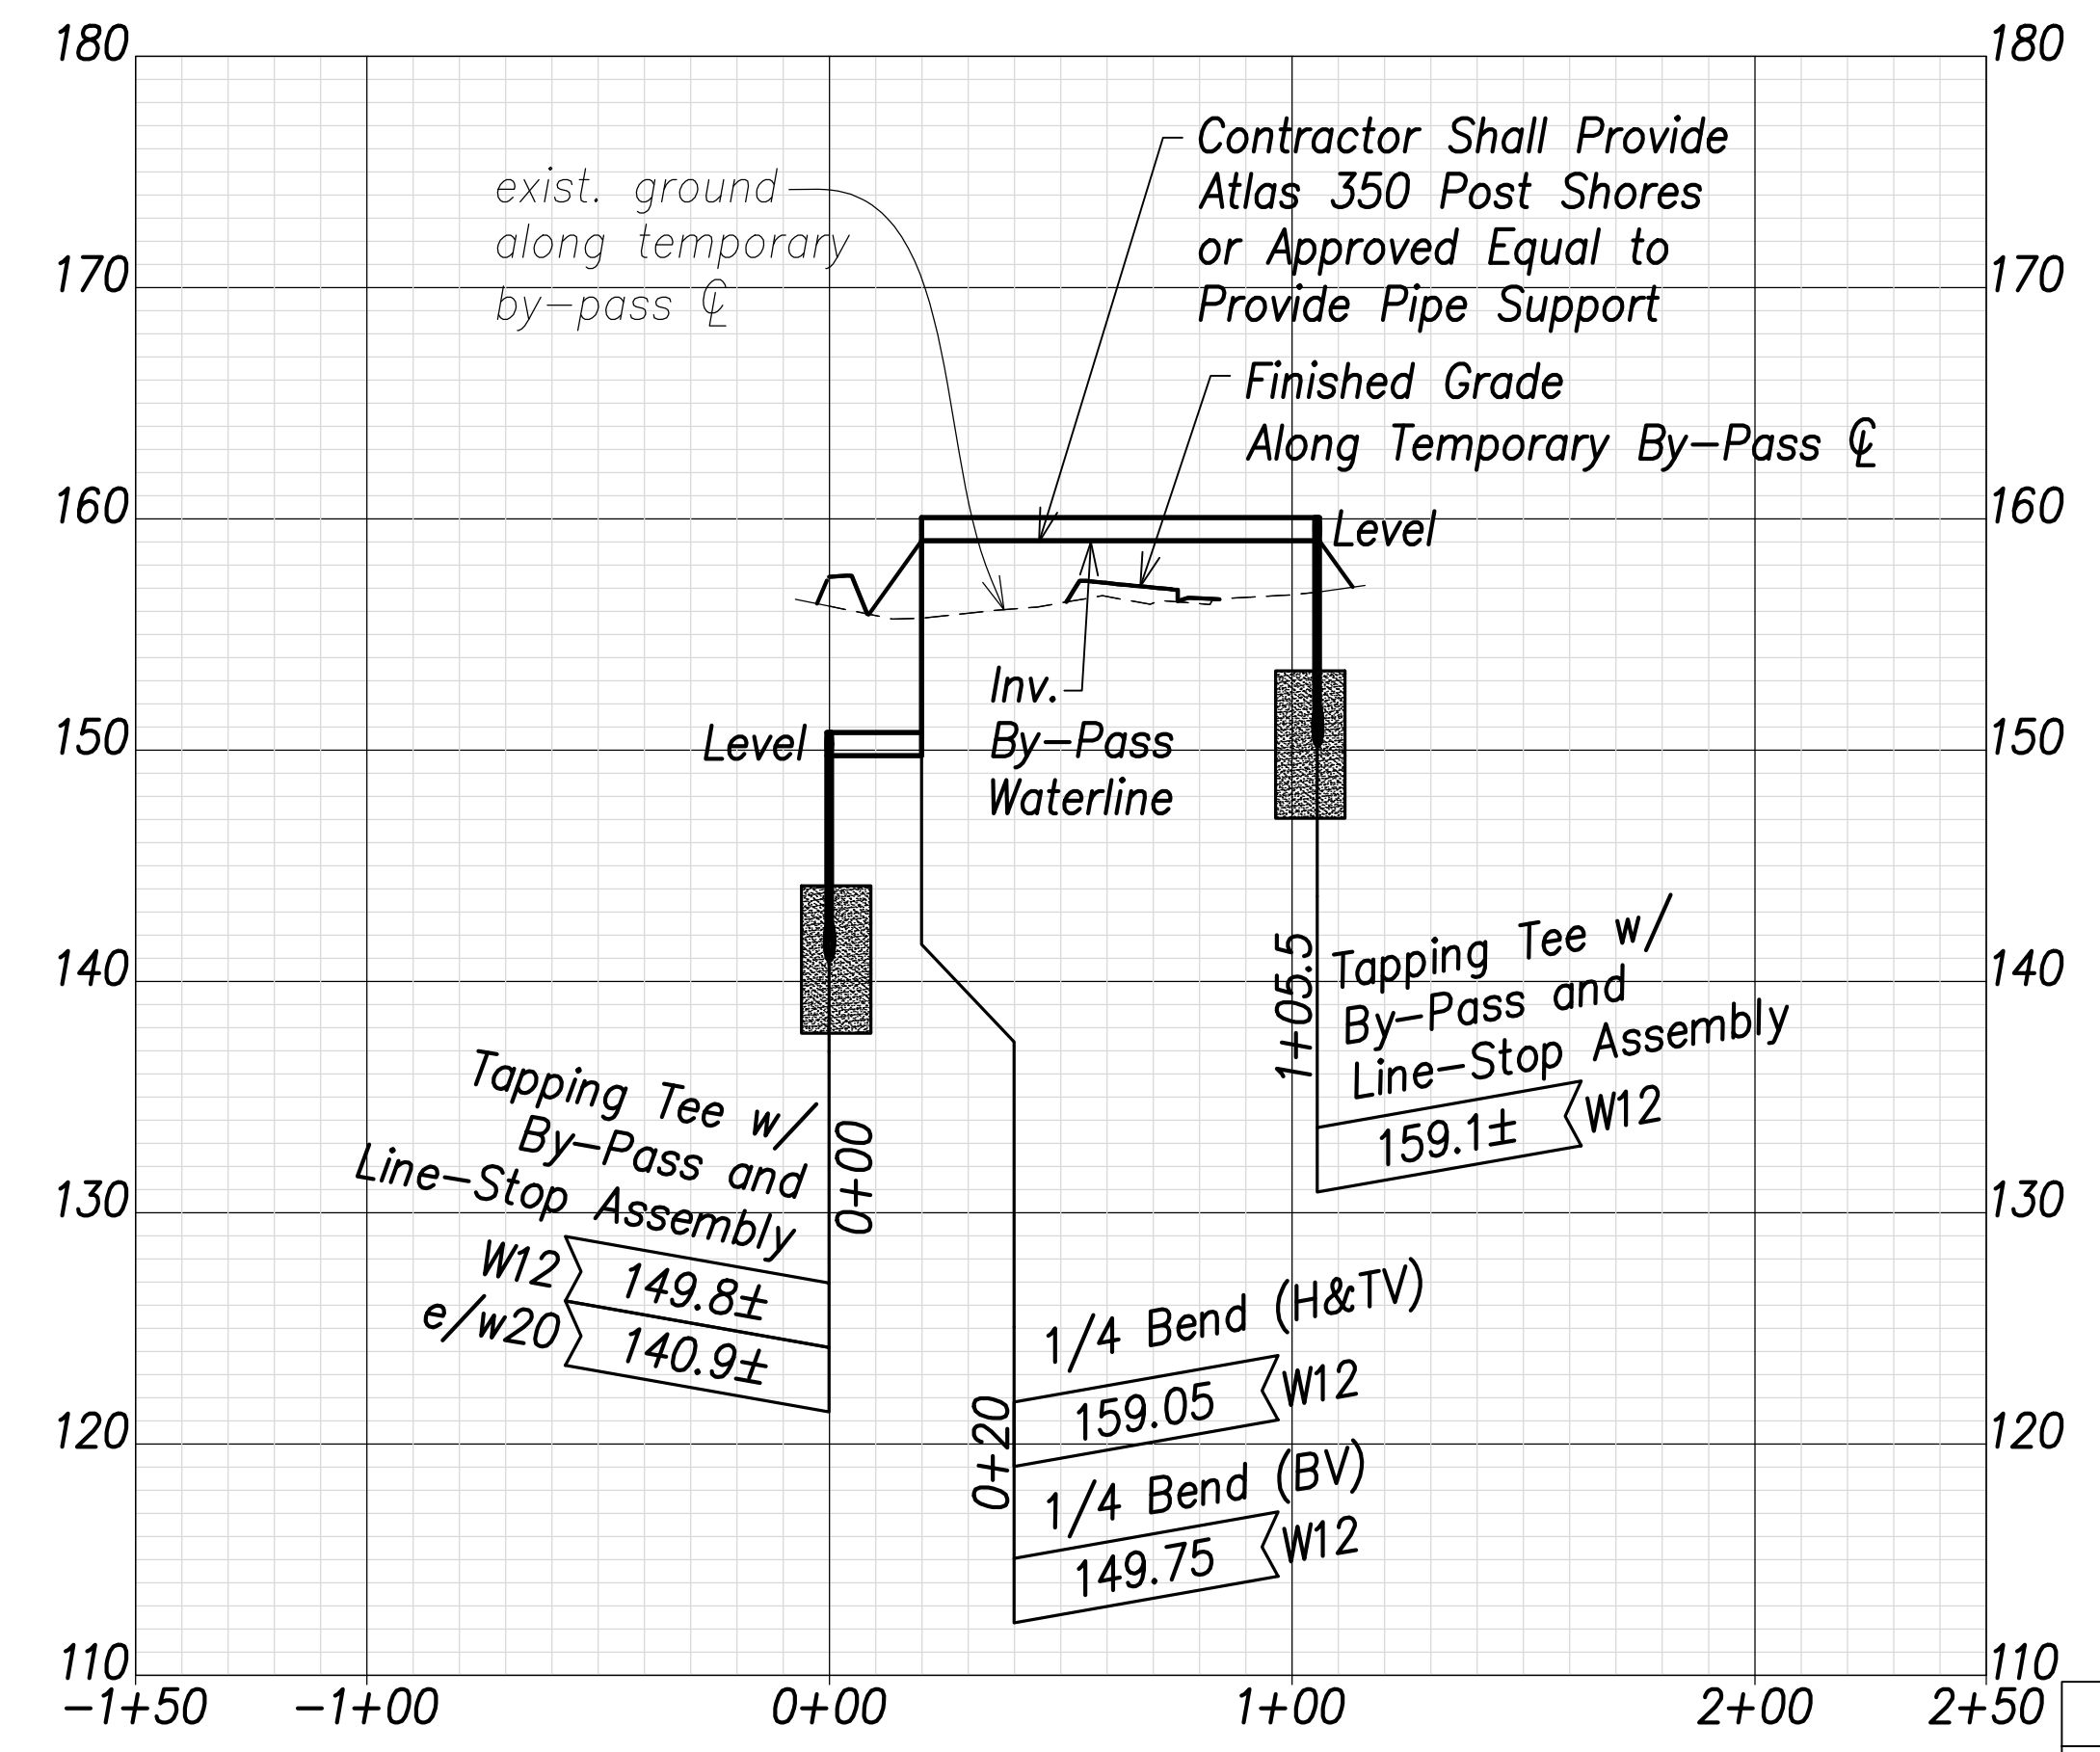

**Temporary Waterline By-Pass 17 Profile**  
 Scales: Hor.: 1" = 40'  
 Vert.: 1" = 8'

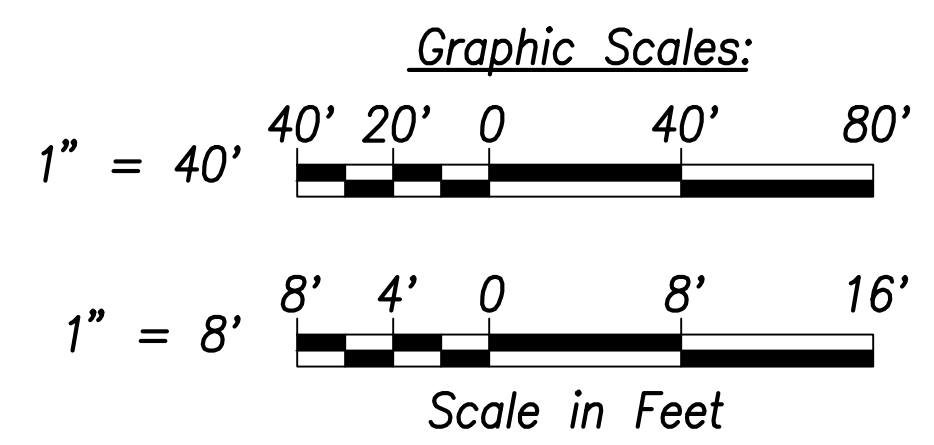

- Notes:**
- Contractor shall provide mechanical joint pipes and fittings with retainer glands and/or flanged pipes and fittings to construct the temporary by-passes
  - The Contractor shall submit the construction schedule and construction phasing for the temporary by-passes to BWS for review and approval. The Contractor shall not commence work on the temporary by-passes until approval is obtained by BWS.

DATE	REVISION
07/15/22	Revised callouts; added notes

SURVEY PLOTTED BY:	DATE
DRAWN BY:	
TRACED BY:	
QUANTITIES BY:	
CHECKED BY:	
ORIGINAL PLAN NO.	
NOTE BOOK No.	

**CRAIG W. L. LUKE**  
 LICENSED PROFESSIONAL ENGINEER  
 No. 6935-C  
 HAWAII, U.S.A.  
 THIS WORK WAS PREPARED BY ME OR UNDER MY SUPERVISION AND CONSTRUCTION OF THIS PROJECT WILL BE UNDER MY OBSERVATION.  
 SIGNATURE: [Signature] EXPIRATION DATE OF THE LICENSE: April 30, 2024

STATE OF HAWAII  
 DEPARTMENT OF TRANSPORTATION  
 HIGHWAYS DIVISION


**Waterline Connection and Temporary By-Pass - 9**

FARRINGTON HIGHWAY WIDENING  
 Kapolei Golf Course Road to Fort Weaver Road  
 Project No. 7101A-01-20


Scale: As Shown Date: April 2022

**SHEET NO. C-176 OF 767 SHEETS**

FED. ROAD DIST. NO.	STATE	PROJ. NO.	FISCAL YEAR	SHEET NO.	TOTAL SHEETS
HAWAII	HAW.	7101A-01-20	2021	178	767

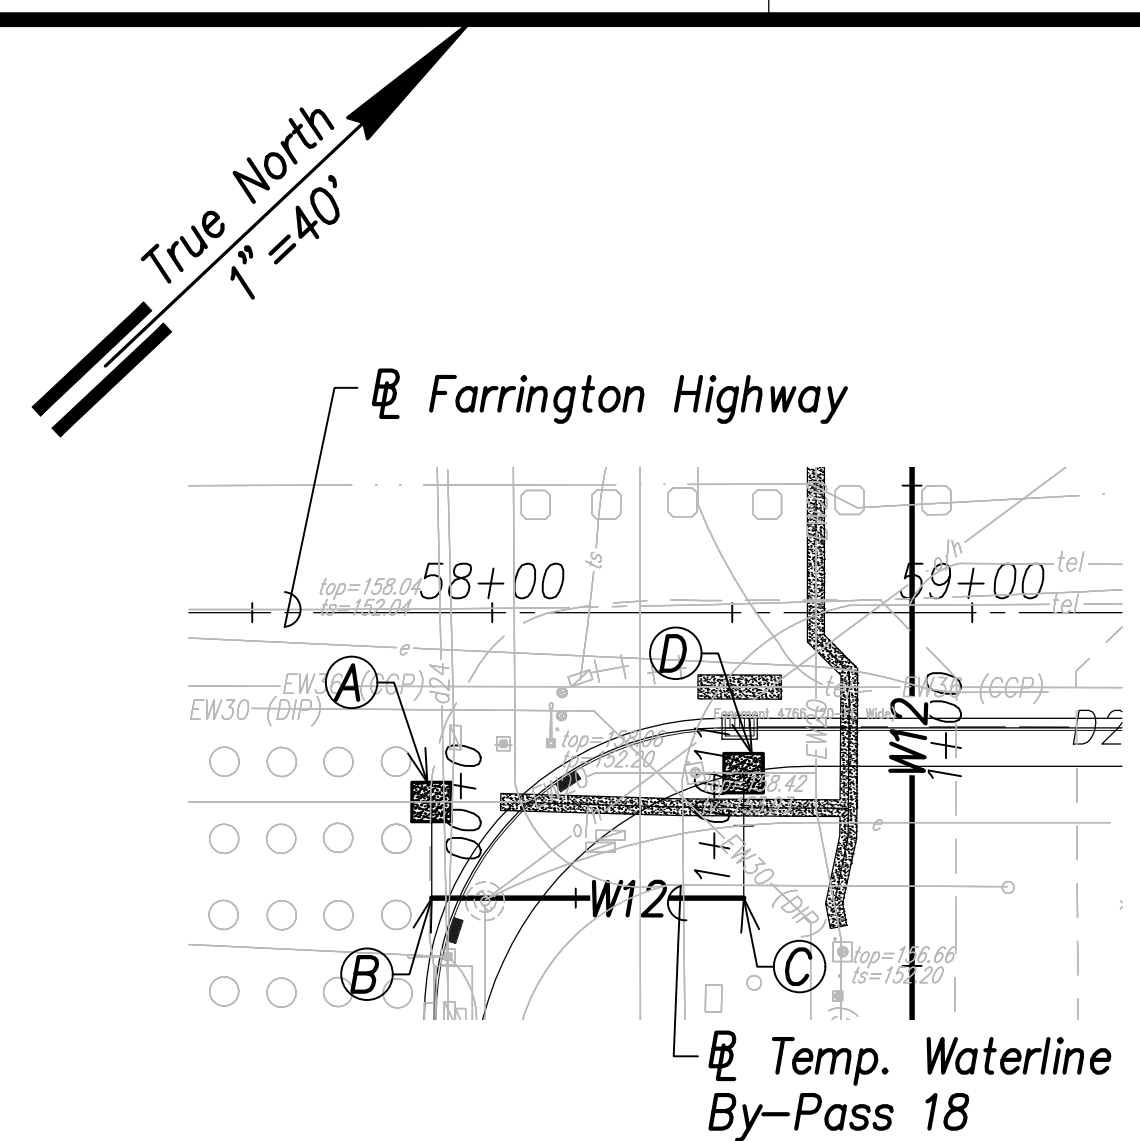


**Temporary Waterline By-Pass 18 Plan**  
 (# Sta. 58+67.5 Farrington Highway)  
 (# Sta. 58+70.7 Farrington Highway)  
 Scale: 1" = 40'

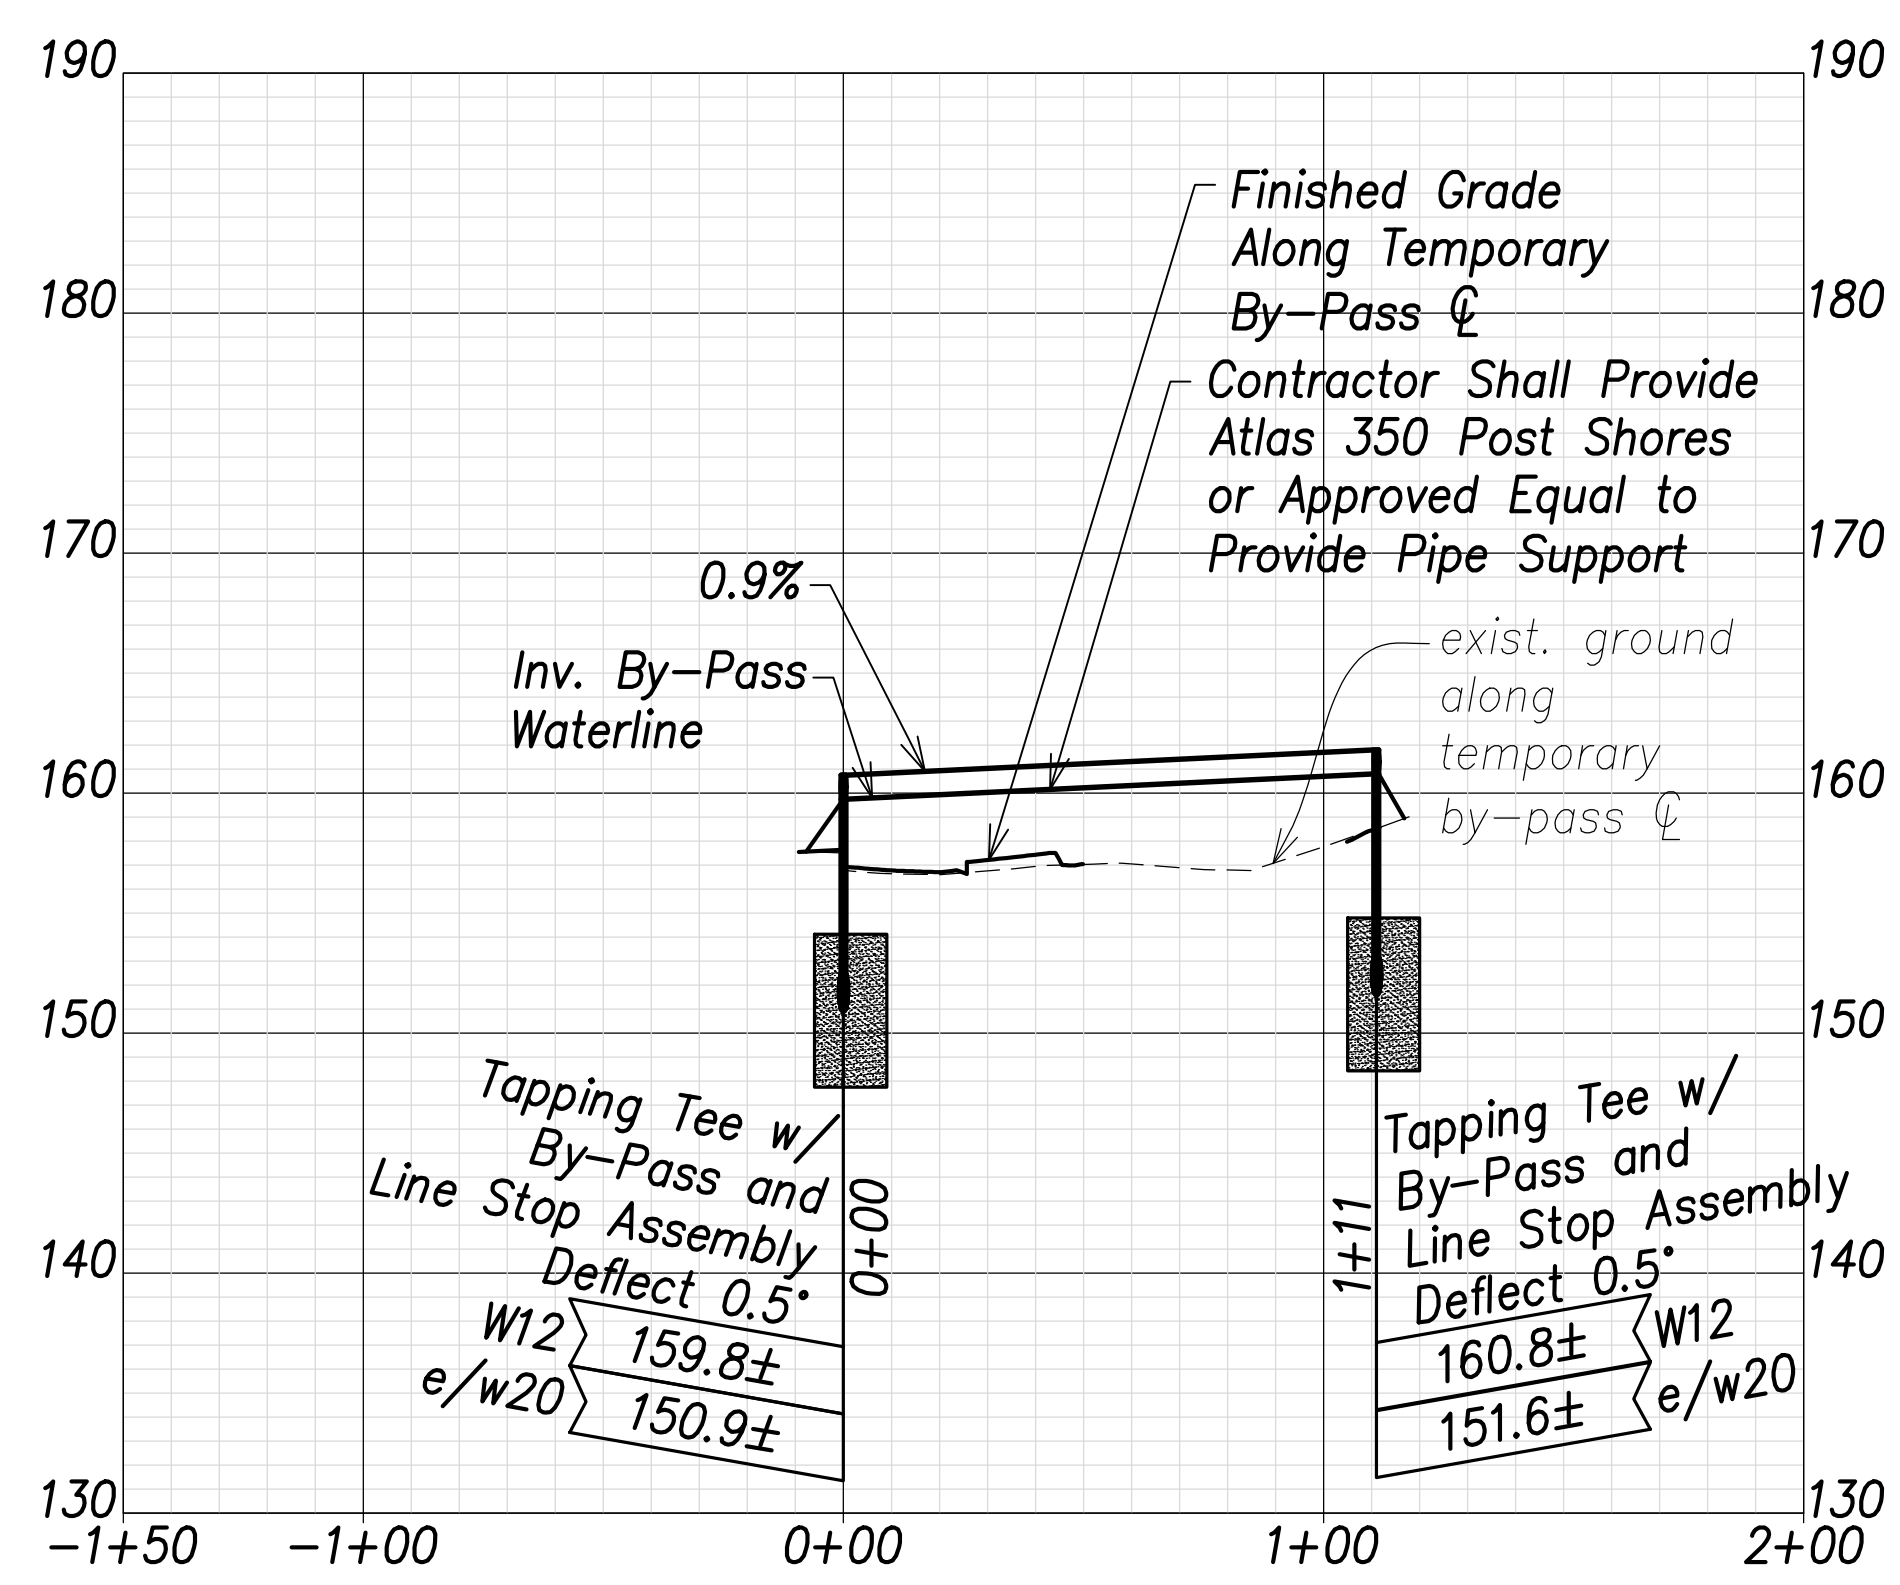


**Temporary Waterline By-Pass 18 Profile**  
 Scales: Hor.: 1" = 40'  
 Vert.: 1" = 8'

**Schedule Note:**  
 The construction working period for Temporary By-Passes 18 and 19 shall be limited to November to February, as approved by BWS.

- (A) # Sta. 57+87.4, o/s 39.4' Rt. Farrington Highway  
 =# Sta. 0+00 By-Pass  
 Temporary By-Pass Connection  
 See Detail Shts. C-208 to C-211 (Typ.)
- (B) # Sta. 58+20.2, o/s 55.7' Rt. Farrington Highway  
 =# Sta. 0+20 By-Pass  
 1-12" 1/4 Bend
- (C) # Sta. 58+52.4, o/s 59.4' Rt. Farrington Highway  
 =# Sta. 0+65 By-Pass  
 1-12" 1/4 Bend
- (D) # Sta. 58+52.4, o/s 33.4' Rt. Farrington Highway  
 =# Sta. 1+11 By-Pass  
 Temporary By-Pass Connection  
 See Detail Shts. C-208 to C-211 (Typ.)

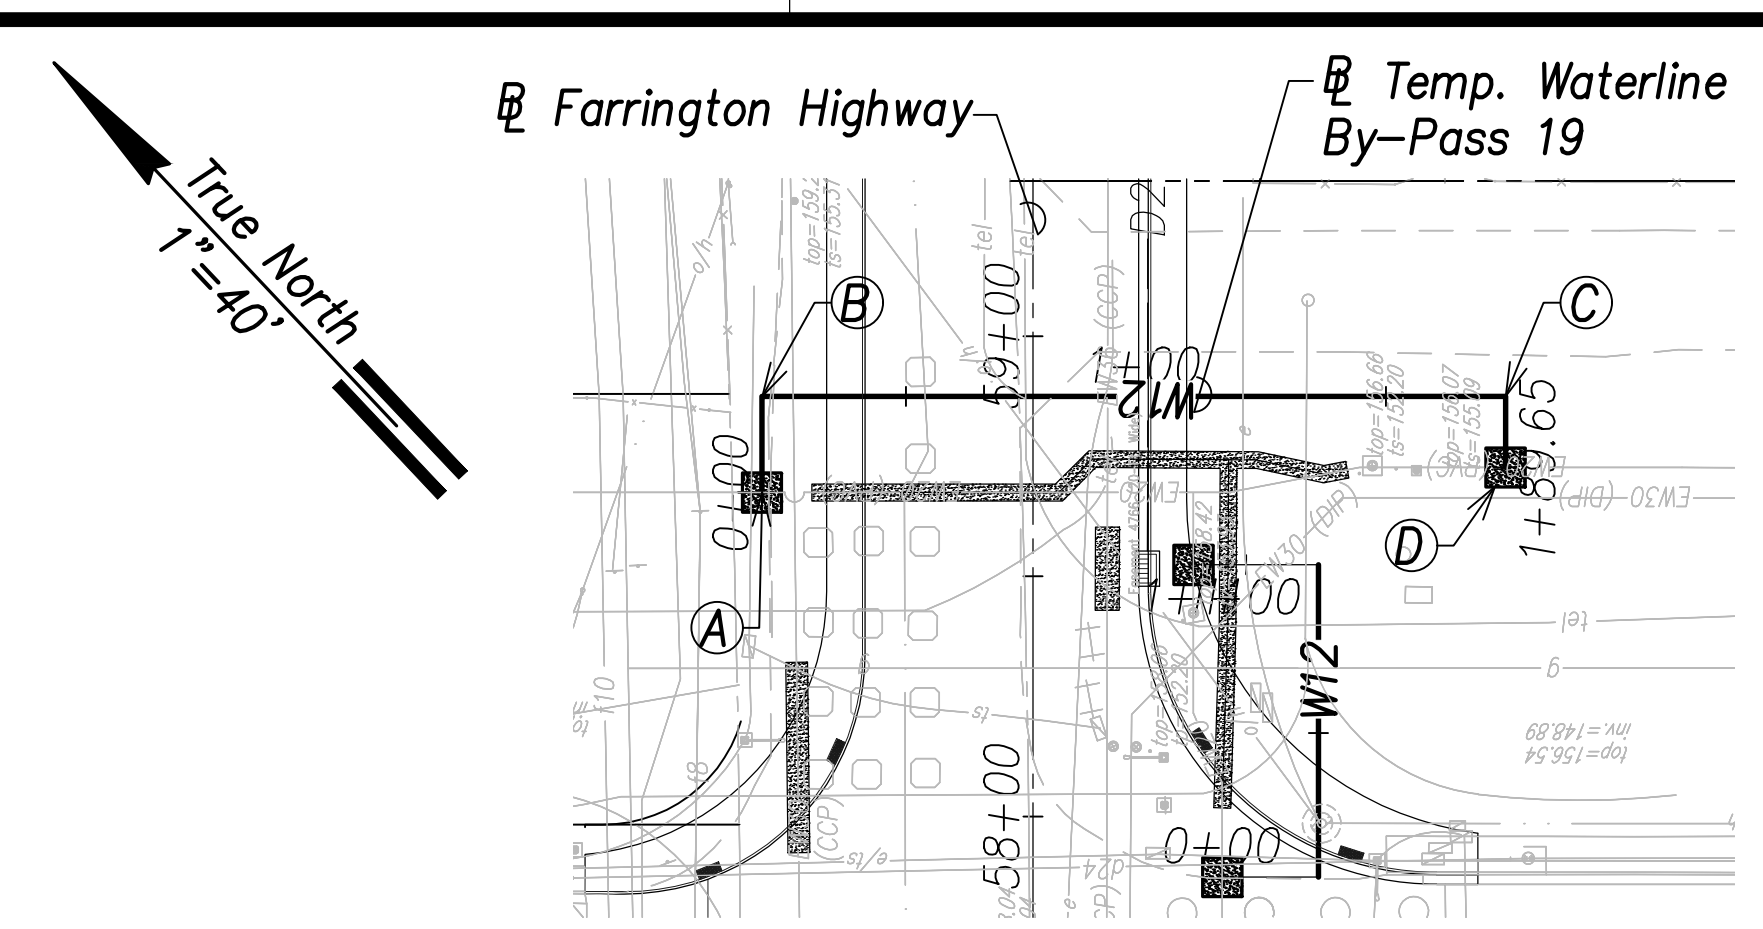

**Temporary Waterline By-Pass 19 Plan**  
 (# Sta. 58+32.4 Farrington Highway)  
 Scale: 1" = 40'

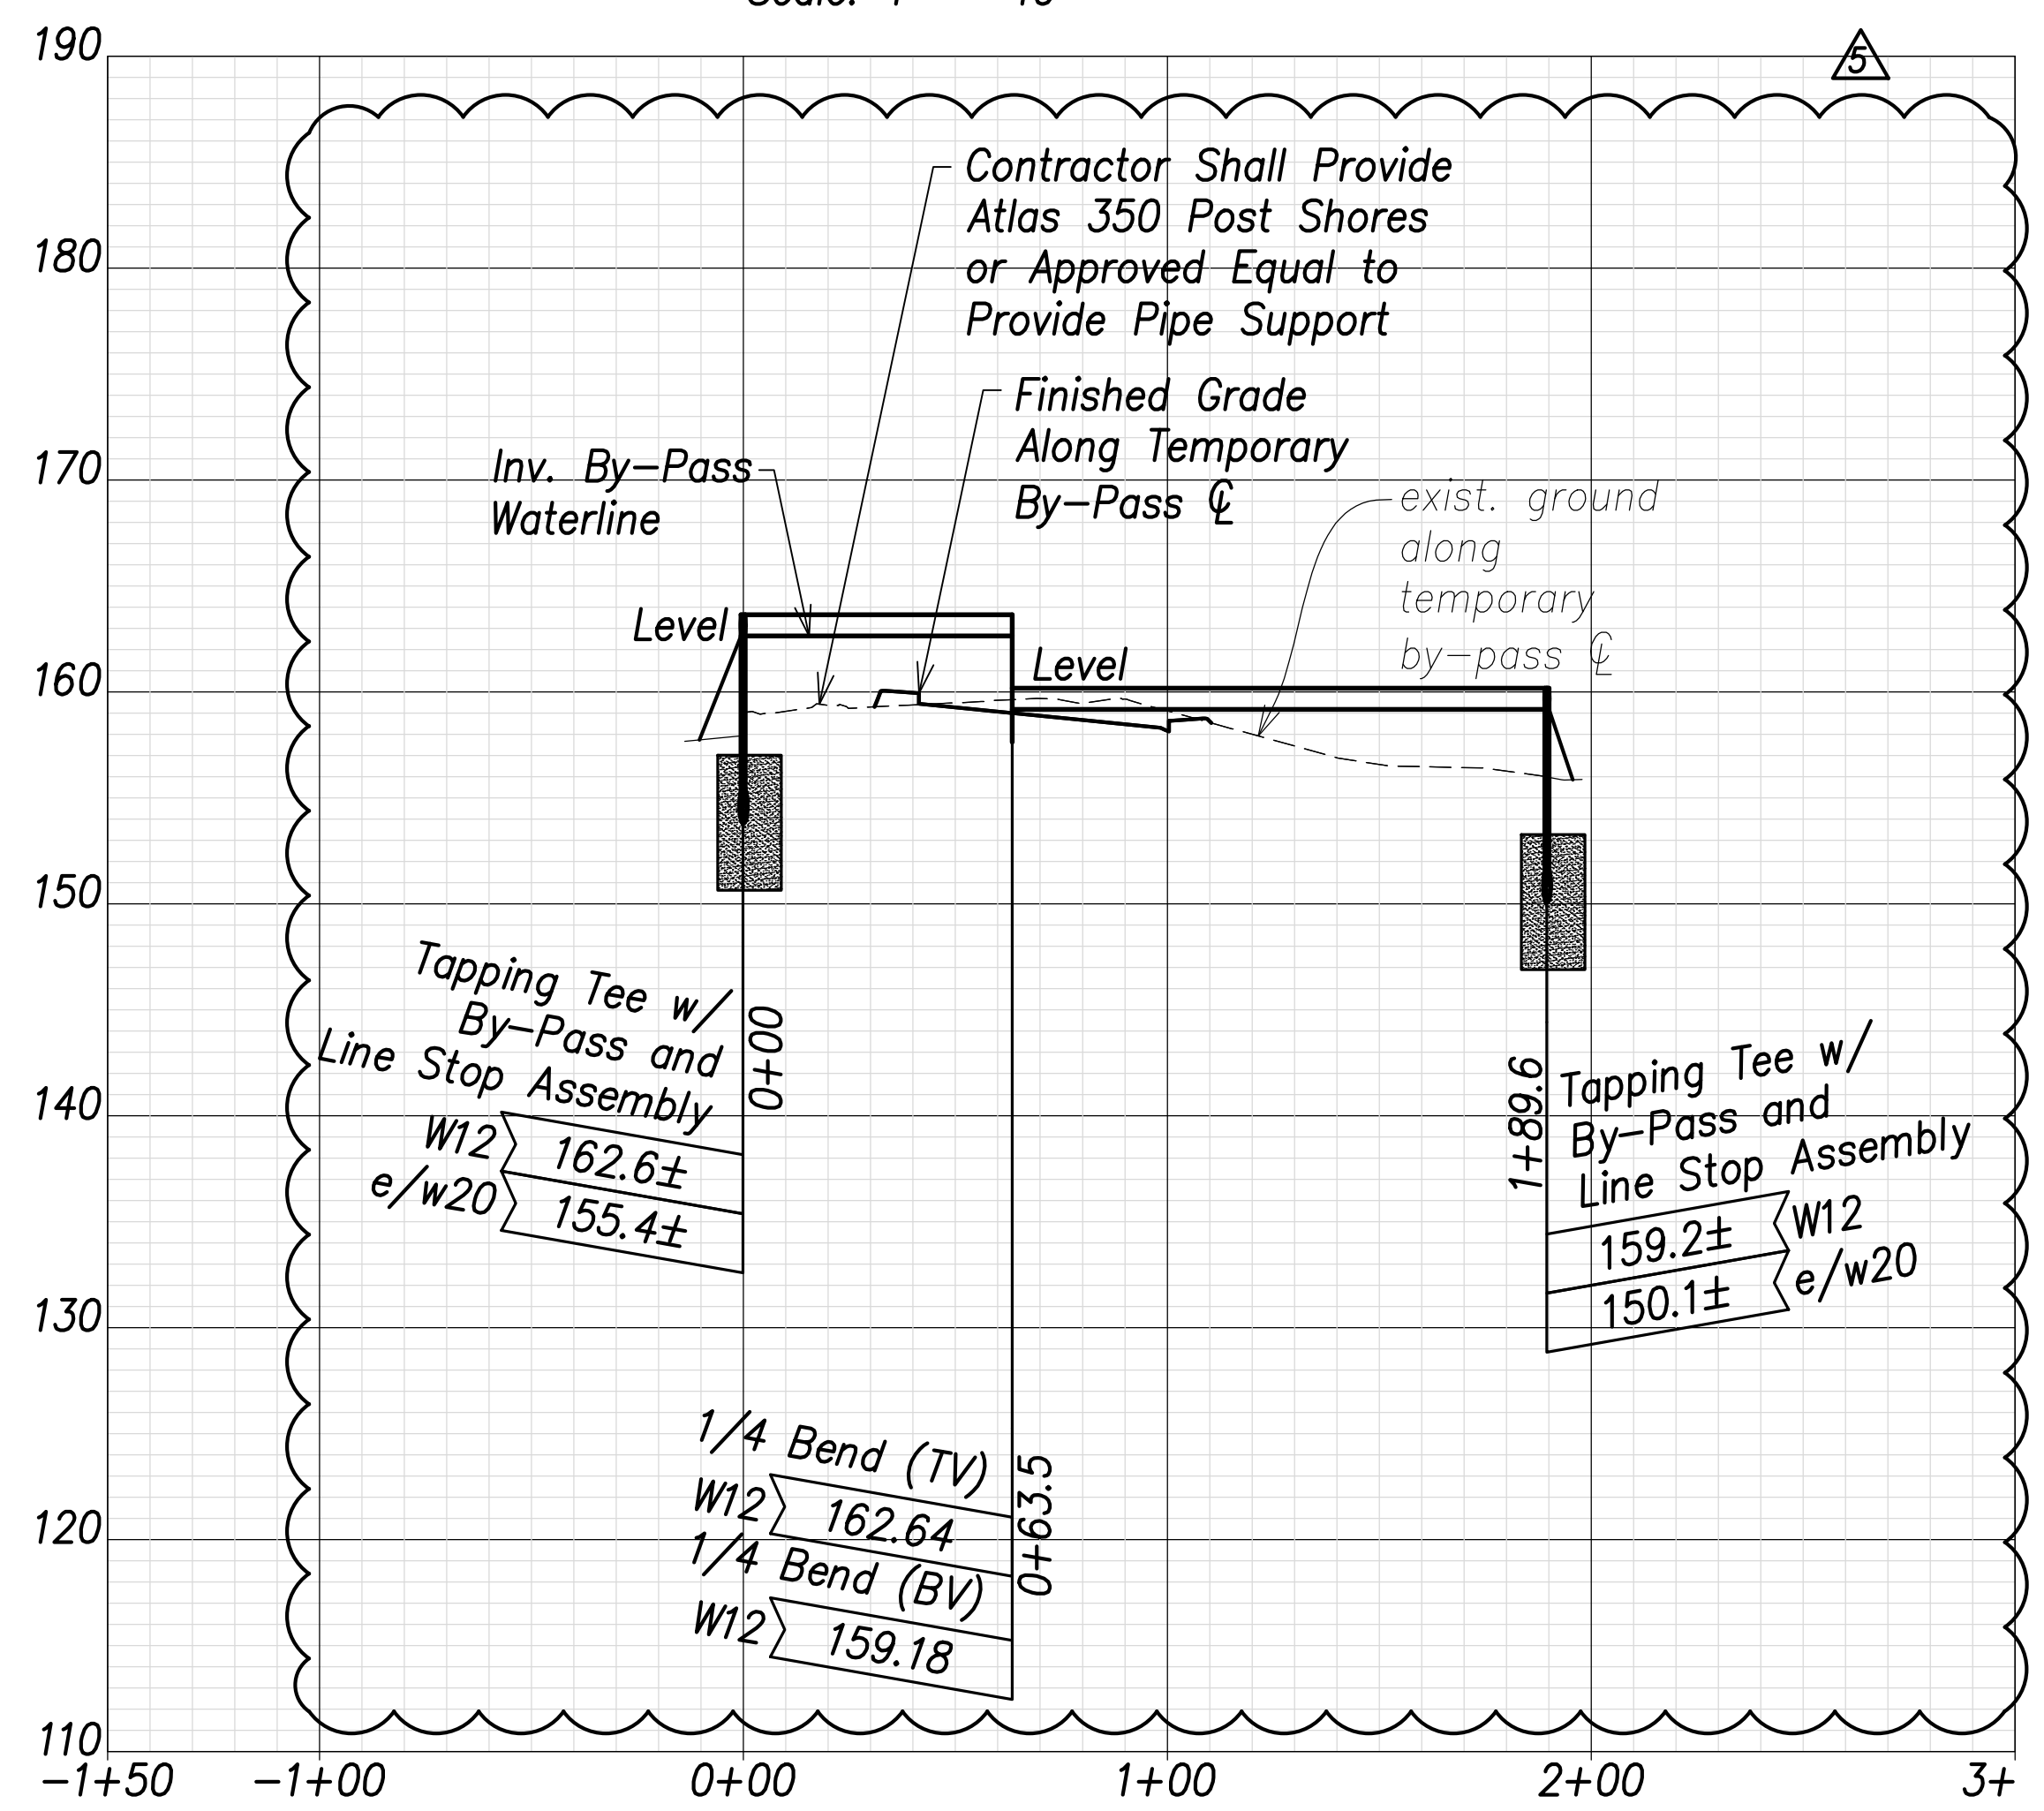

**Temporary Waterline By-Pass 19 Profile**  
 Scales: Hor.: 1" = 40'  
 Vert.: 1" = 8'

- (A) # Sta. 58+67.5, o/s 56.5' Lt. Farrington Highway  
 =# Sta. 0+00 By-Pass  
 Temporary By-Pass Connection  
 See Detail Shts. C-208 to C-211 (Typ.)
- (B) # Sta. 58+87.5, o/s 56.5' Lt. Farrington Highway  
 =# Sta. 0+20 By-Pass  
 1-12" 1/4 Bend
- (C) # Sta. 58+87.5, o/s 98.4' Rt. Farrington Highway  
 =# Sta. 1+74.9 By-Pass  
 1-12" 1/4 Bend
- (D) # Sta. 58+72.7, o/s 98.4' Rt. Farrington Highway  
 =# Sta. 1+89.7 By-Pass  
 Temporary By-Pass Connection  
 See Detail Shts. C-208 to C-211 (Typ.)

- Notes:**
- Contractor shall provide mechanical joint pipes and fittings with retainer glands and/or flanged pipes and fittings to construct the temporary by-passes
  - The Contractor shall submit the construction schedule and construction phasing for the temporary by-passes to BWS for review and approval. The Contractor shall not commence work on the temporary by-passes until approval is obtained by BWS.

DATE	REVISION
07/15/22	Revised callouts; Added notes; Revised by-pass

STATE OF HAWAII  
 DEPARTMENT OF TRANSPORTATION  
 HIGHWAYS DIVISION

**Waterline Connection and Temporary By-Pass - 10**

FARRINGTON HIGHWAY WIDENING  
 Kapolei Golf Course Road to Fort Weaver Road  
 Project No. 7101A-01-20


Scale: As Shown Date: April 2022



THIS WORK WAS PREPARED BY ME OR UNDER MY SUPERVISION AND CONSTRUCTION OF THIS PROJECT WILL BE UNDER MY OBSERVATION.

Signature: *Craig W. Luke*  
 EXPIRATION DATE OF THE LICENSE: April 30, 2024

APPROVED: \_\_\_\_\_ DATE \_\_\_\_\_  
 Manager and Chief Engineer, BWS  
 (for work affecting BWS facilities in City/State R/W & BWS easements only)

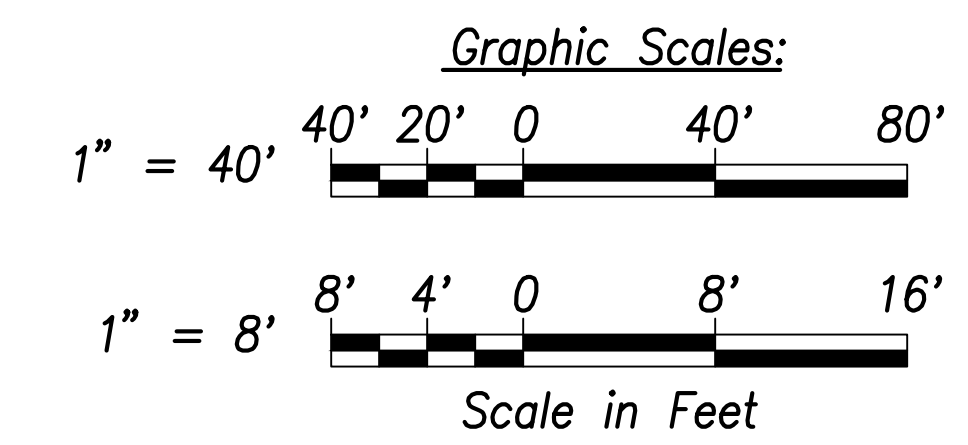


SURVEY PLOTTED BY: _____	DATE: _____
DRAWN BY: _____	TRACED BY: _____
DESIGNED BY: _____	CHECKED BY: _____
NOTE BOOK No. _____	

FILE: K:\civil\23146 Farrington Hwy Widening\Draw\Construction\Draw\177 Waterline Connection and Temporary By-Pass - 10.dwg saved July 20, 2022



FED. ROAD DIST. NO.	STATE	PROJ. NO.	FISCAL YEAR	SHEET NO.	TOTAL SHEETS
HAWAII	HAW.	7101A-01-20	2021	179	767

True North  
1"=40'

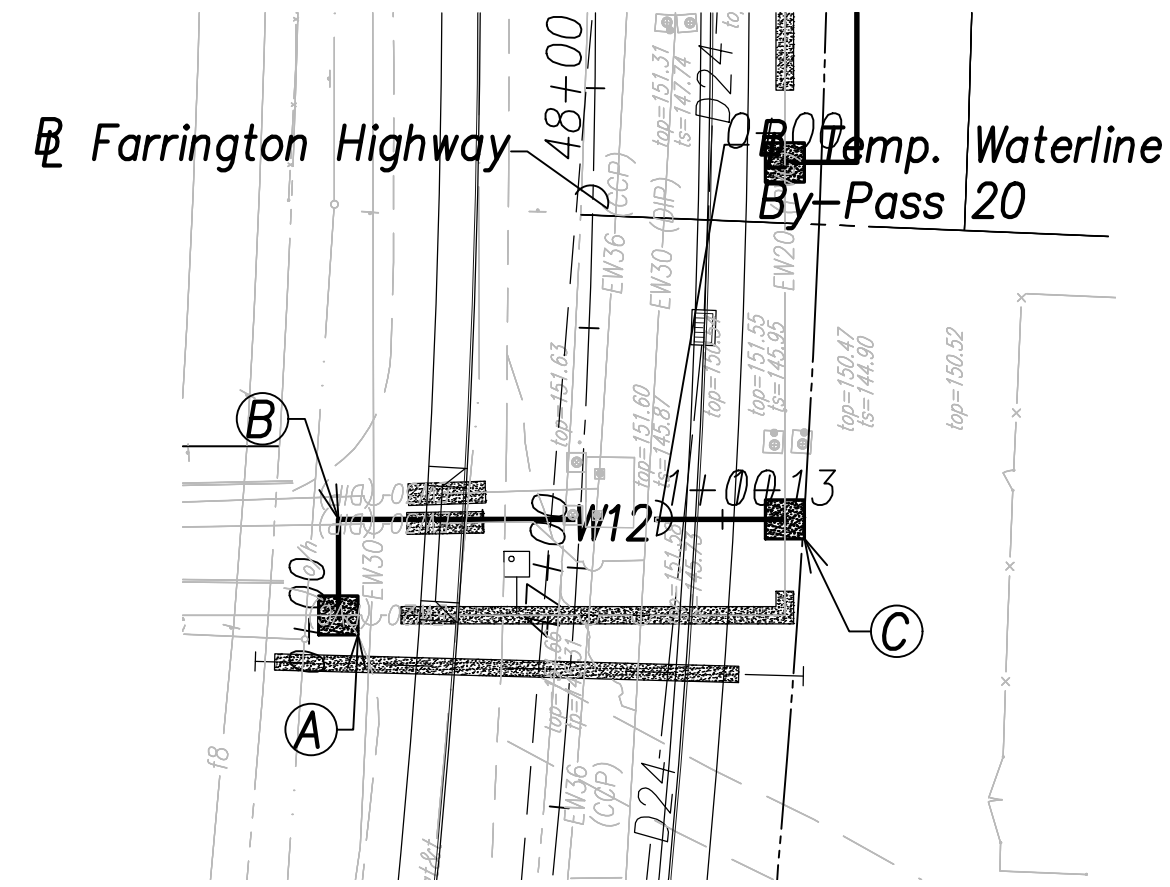

**Temporary Waterline By-Pass 20 Plan**  
(# Sta. 46+87.6 Farrington Highway)  
(# Sta. 46+92.8 Farrington Highway)  
Scale: 1" = 40'


(A) # Sta. 46+63.0, o/s 41.5' Lt. Farrington Highway  
=# Sta. 0+00 By-Pass  
Temporary By-Pass Connection  
See Detail Shts. C-208 to C-211 (Typ.)

(B) # Sta. 47+07.2, o/s 50.3' Lt. Farrington Highway  
(=# Sta. 0+20 By-Pass)  
1-24" 1/4 Bend

(C) # Sta. 47+12.5, o/s 42.6' Rt. Farrington Highway  
=# Sta. 1+13 By-Pass  
Temporary By-Pass Connection  
See Detail Shts. C-208 to C-211 (Typ.)

**Notes:**  
1. Contractor shall provide mechanical joint pipes and fittings with retainer glands and/or flanged pipes and fittings to construct the temporary by-passes

True North  
1"=40'

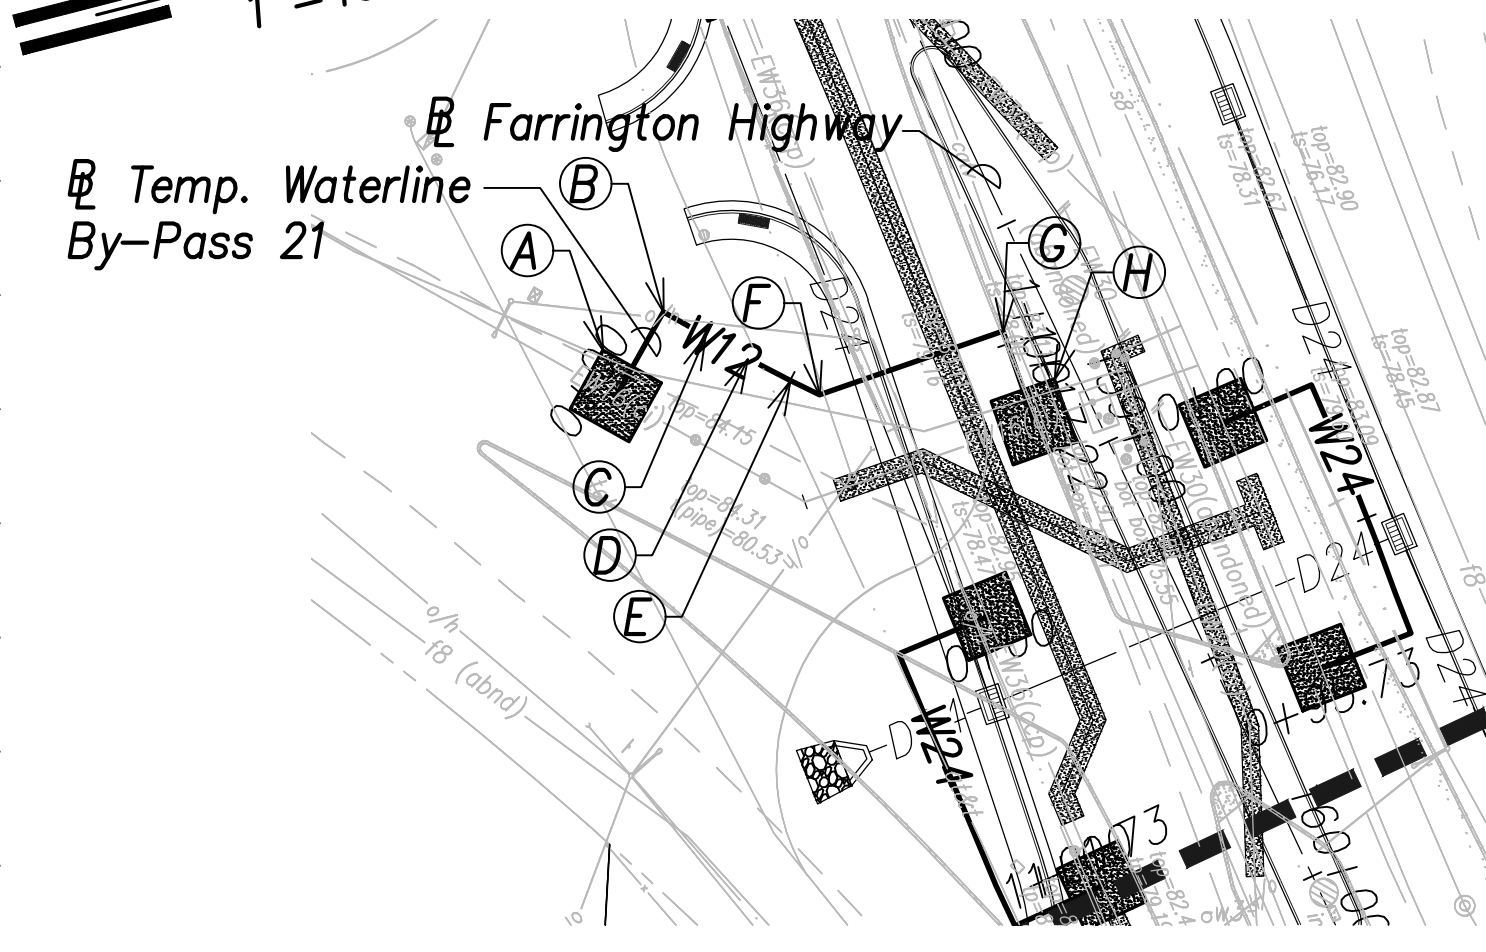

**Temporary Waterline By-Pass 21 Plan**  
(# Sta. 158+47.9 Farrington Highway)  
(# Sta. 158+89.8 Farrington Highway)  
Scale: 1" = 40'

(A) # Sta. 158+47.9, o/s 88.7' Rt. Farrington Highway  
=# Sta. 0+00 By-Pass  
Temporary By-Pass Connection  
See Detail Shts. C-208 to C-211 (Typ.)

(B) # Sta. 158+36.2, o/s 72.5' Rt. Farrington Highway  
=# Sta. 0+20 By-Pass  
1-12" 1/4 Bend

(C) # Sta. 158+44.4, o/s 66.6' Rt. Farrington Highway  
=# Sta. 0+30 By-Pass  
1-12" Deflection

(D) # Sta. 158+60.4, o/s 54.6' Rt. Farrington Highway  
=# Sta. 0+40 By-Pass  
1-12" Deflection


(E) # Sta. 158+52.4, o/s 60.7' Rt. Farrington Highway  
=# Sta. 0+50 By-Pass  
1-12" 1/8 Bend

(F) # Sta. 158+65.7, o/s 50.4' Rt. Farrington Highway  
=# Sta. 0+50 By-Pass  
1-12" Deflection

(G) # Sta. 158+69.9, o/s 10.2' Rt. Farrington Highway  
=# Sta. 0+97.2 By-Pass  
1-12" 1/4 Bend


(H) # Sta. 158+89.8, o/s 12.3' Rt. Farrington Highway  
=# Sta. 1+17.2 By-Pass  
Temporary By-Pass Connection  
See Detail Shts. C-208 to C-211 (Typ.)

**Schedule Note:**  
The construction working period for Temporary By-Passes 20 and 21 shall be limited to November to February, as approved by BWS.

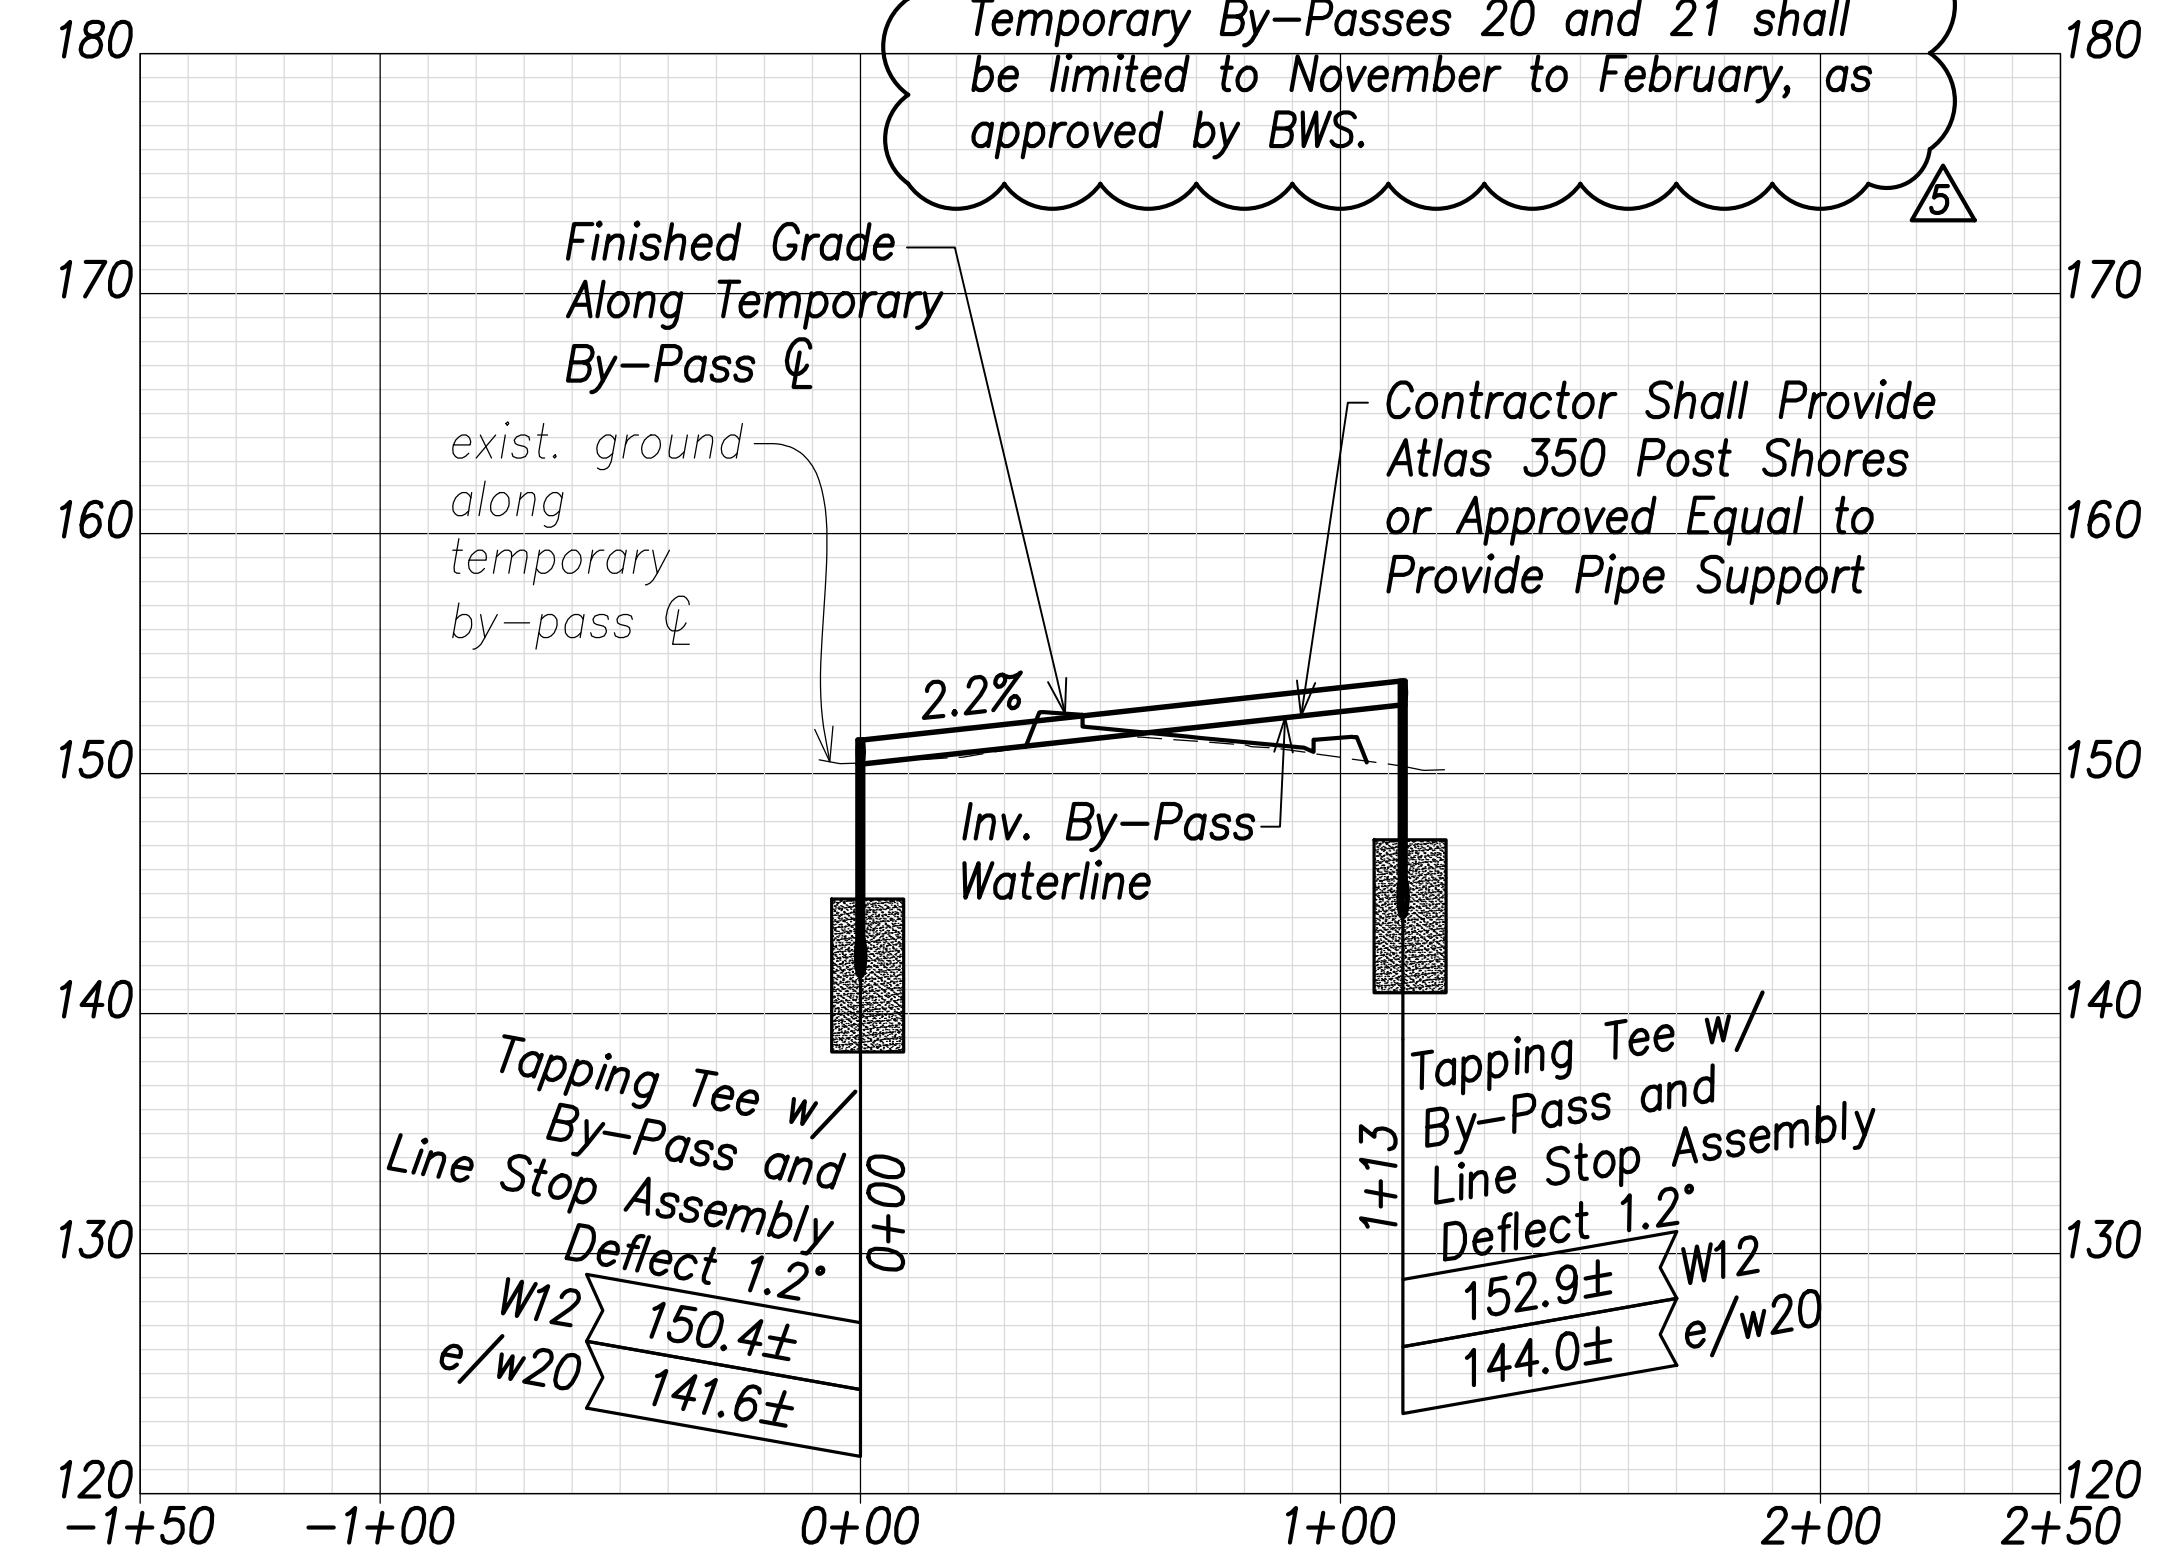



**Temporary Waterline By-Pass 20 Profile**  
Scales: Hor.: 1" = 40'  
Vert.: 1" = 8'

**Notes:**  
2. The Contractor shall submit the construction schedule and construction phasing for the temporary by-passes to BWS for review and approval. The Contractor shall not commence work on the temporary by-passes until approval is obtained by BWS.

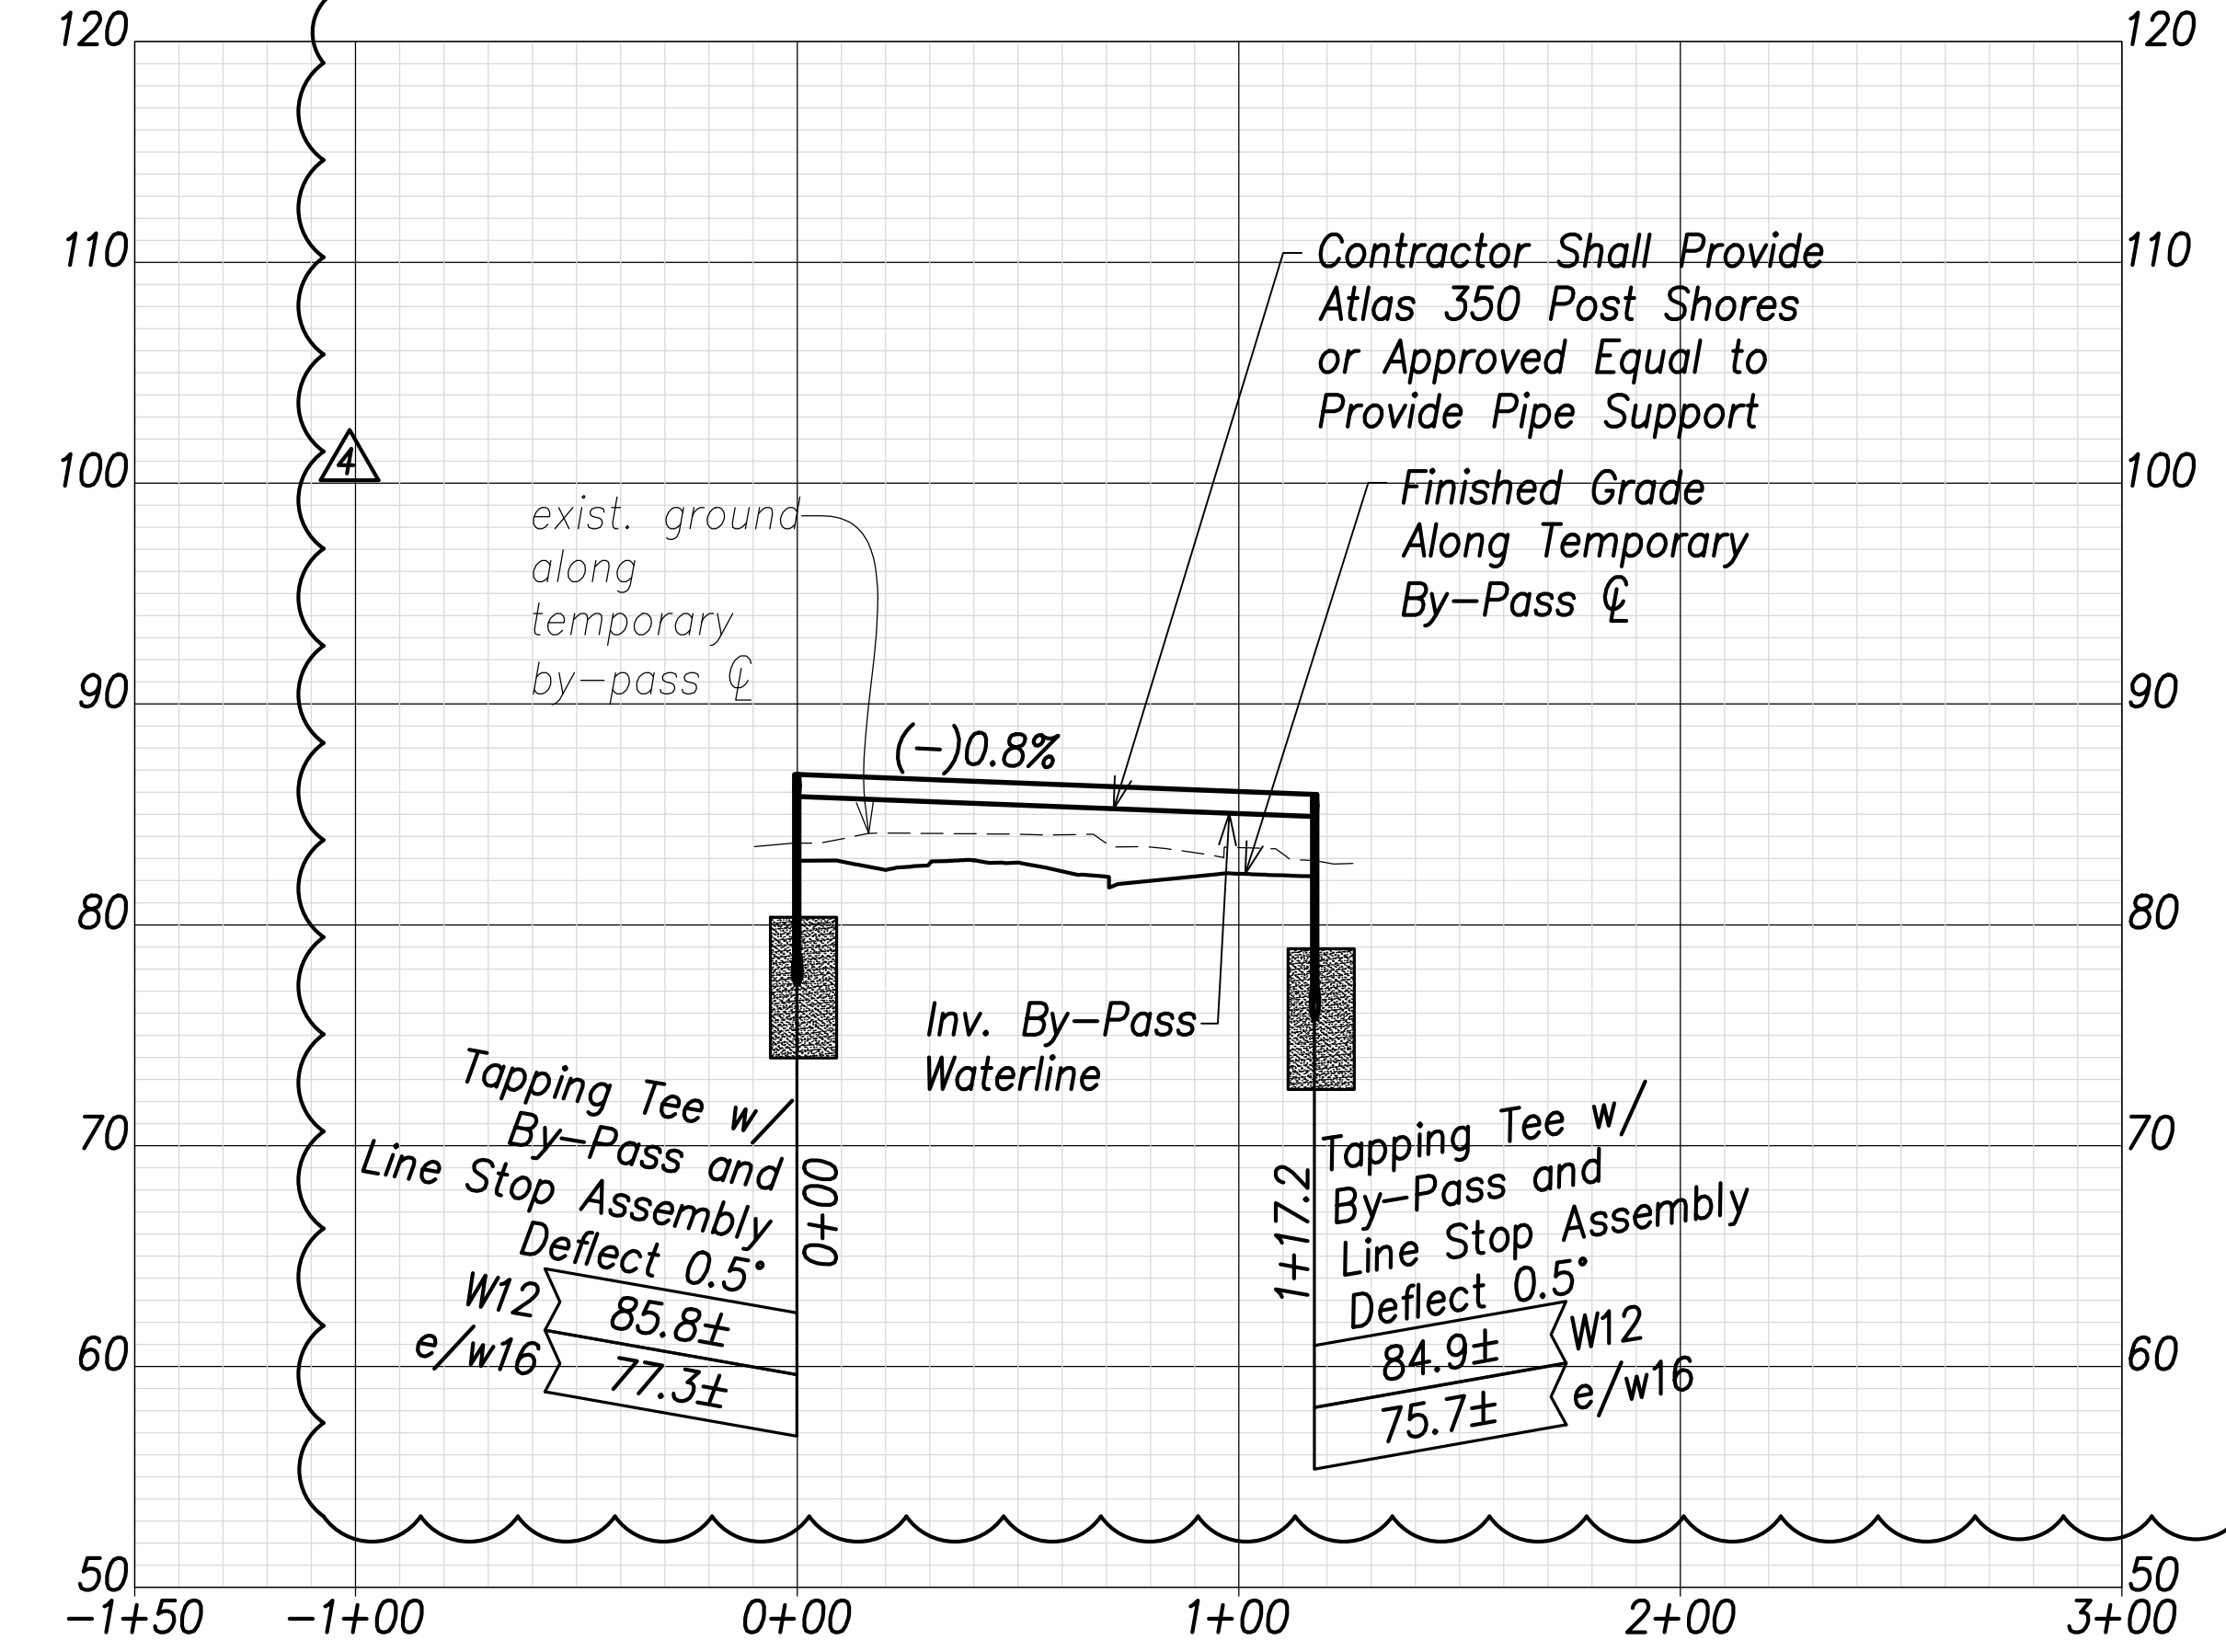

**Temporary Waterline By-Pass 21 Profile**  
Scales: Hor.: 1" = 40'  
Vert.: 1" = 8'

APPROVED:  
Manager and Chief Engineer, BWS  
(for work affecting BWS facilities in City/State R/W & BWS easements only)

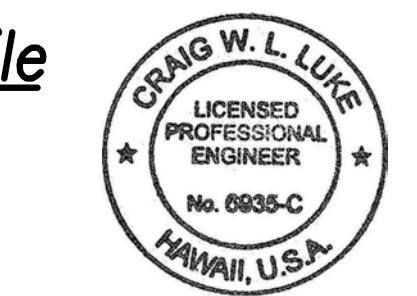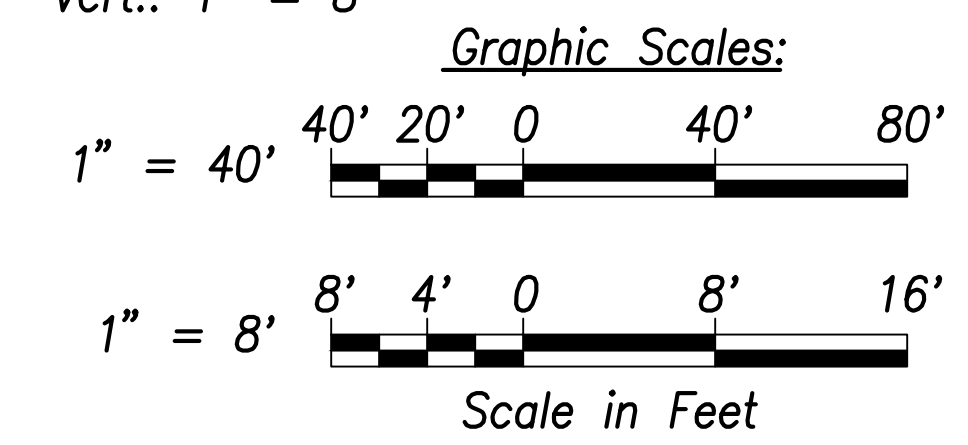

THIS WORK WAS PREPARED BY ME OR UNDER MY SUPERVISION AND CONSTRUCTION OF THIS PROJECT WILL BE UNDER MY OBSERVATION.  
Signature: Craig W. L. Luke  
EXPIRATION DATE OF THE LICENSE: April 30, 2024

DATE	REVISION
07/15/22	Revised callouts; added note



STATE OF HAWAII  
DEPARTMENT OF TRANSPORTATION  
HIGHWAYS DIVISION

**Waterline Connection and Temporary By-Pass - 11**

FARRINGTON HIGHWAY WIDENING  
Kapolei Golf Course Road to Fort Weaver Road  
Project No. 7101A-01-20


Scale: As Shown Date: April 2022

FED. ROAD DIST. NO.	STATE	PROJ. NO.	FISCAL YEAR	SHEET NO.	TOTAL SHEETS
HAWAII	HAW.	7101A-01-20	2021	180S-1	767

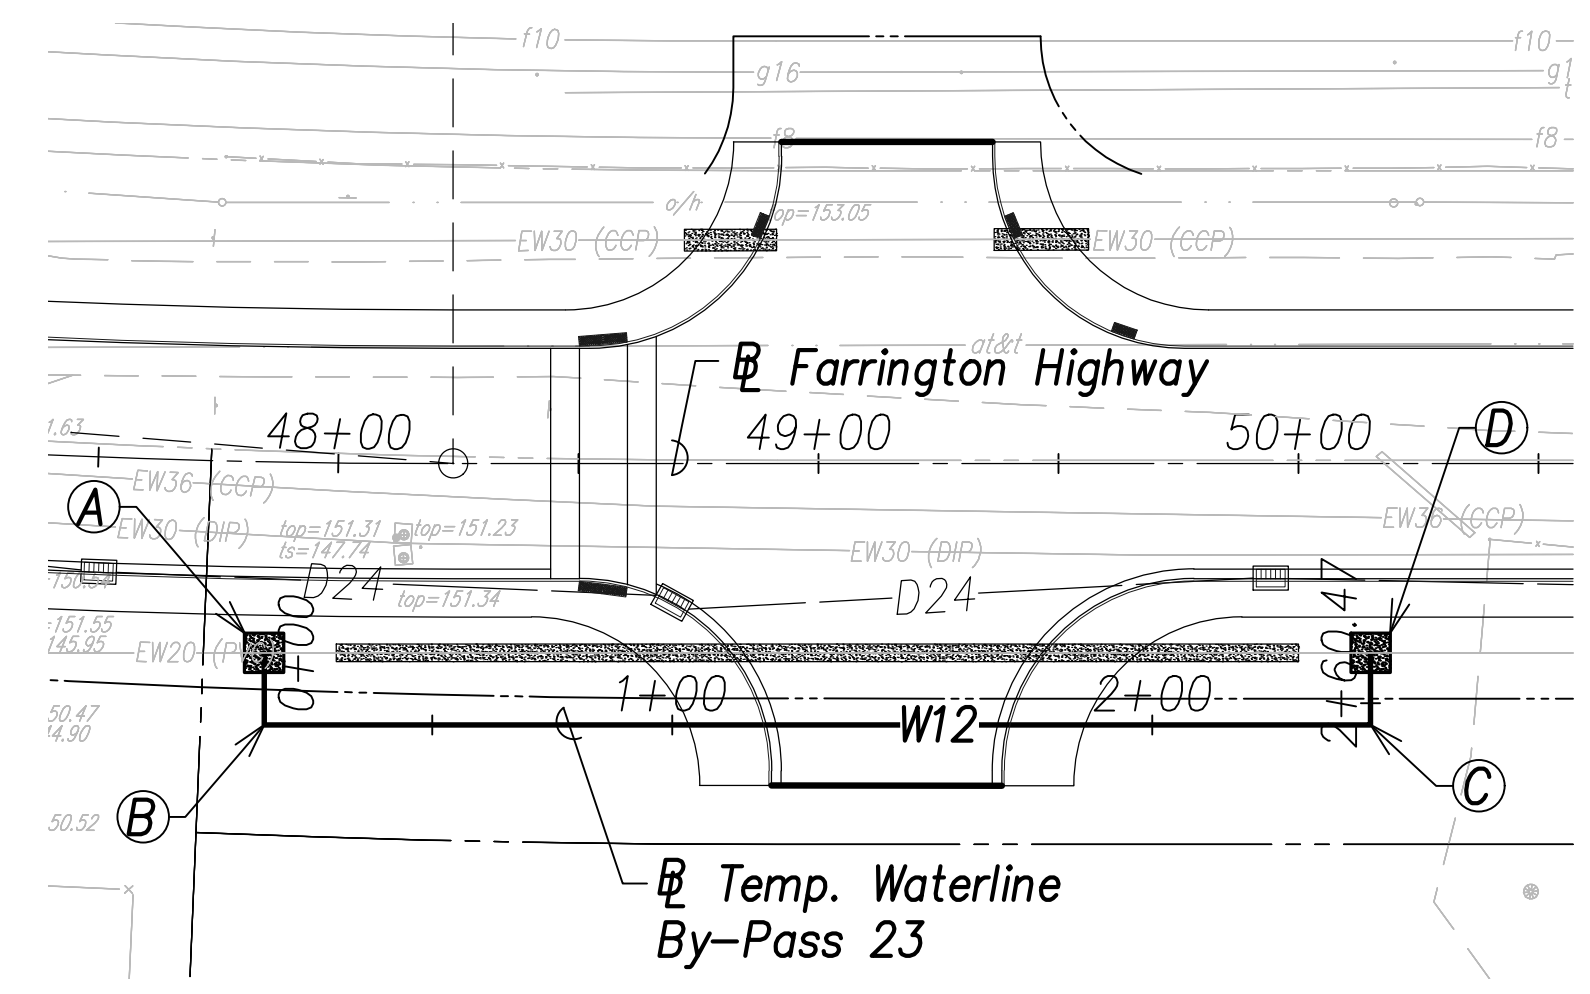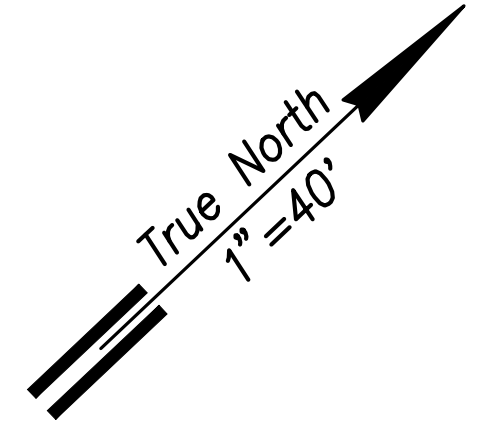

**Temporary Waterline By-Pass 23 Plan**  
 (# Sta. 47+85.3 Farrington Highway)  
 (# Sta. 50+15 Farrington Highway)  
 Scale: 1" = 40'

- Ⓐ # Sta. 47+85.3, o/s 39.8' Rt. Farrington Highway  
 =# Sta. 0+00 By-Pass  
 Temporary By-Pass Connection  
 See Detail Shts. C-208 to C-211 (Typ.)
- Ⓑ # Sta. 47+85.6, o/s 54.8' Rt. Farrington Highway  
 =# Sta. 0+15 By-Pass  
 1-12" 1/4 Bend, Fl.
- Ⓒ # Sta. 51+15, o/s 54.4' Rt. Farrington Highway  
 =# Sta. 2+45.5 By-Pass  
 1-12" 1/4 Bend, Fl.
- Ⓓ # Sta. 50+15, o/s 39.4' Rt. Farrington Highway  
 =# Sta. 2+60.5 By-Pass  
 Temporary By-Pass Connection  
 See Detail Shts. C-208 to C-211 (Typ.)

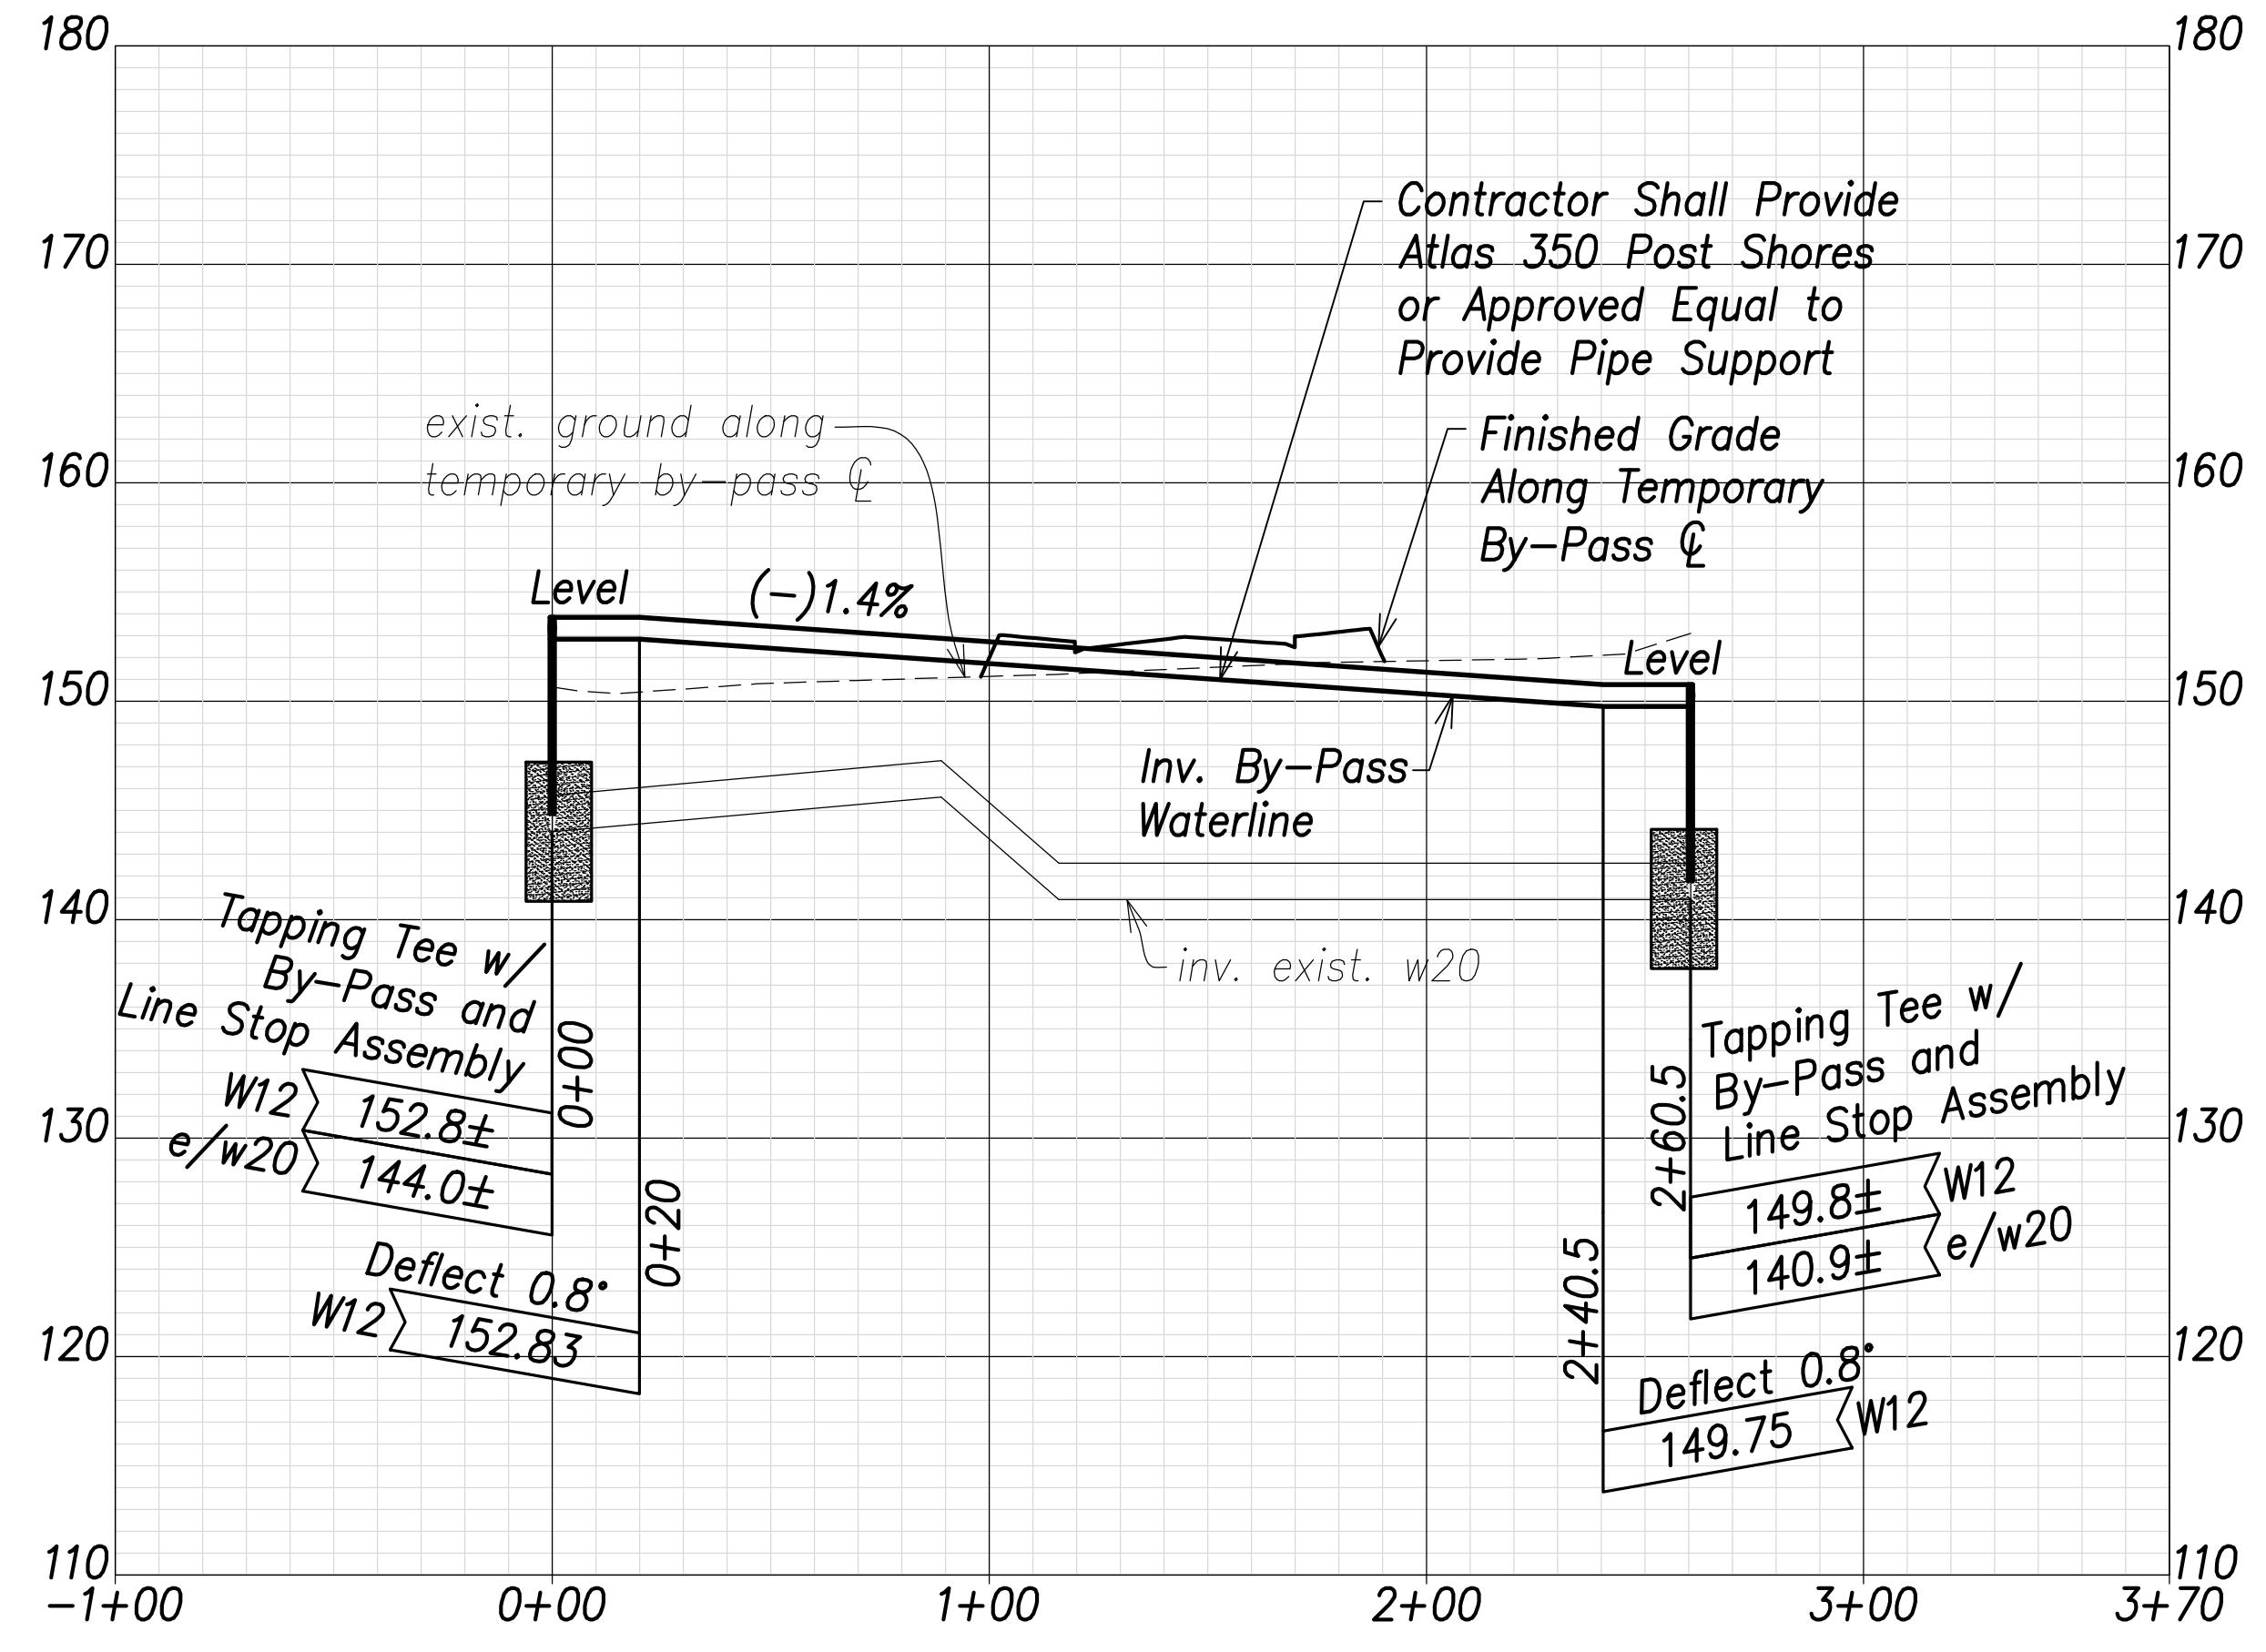


**Temporary Waterline By-Pass 23 Profile**  
 Scale: 1" = 40'

**Schedule Note:**  
 The construction working period for Temporary By-Pass 23 shall be limited to November to February, as approved by BWS.

SURVEY PLOTTED BY	DATE
DRAWN BY	
TRACED BY	
QUANTITIES BY	
CHECKED BY	
ORIGINAL PLAN	
NOTE BOOK	
No.	

APPROVED:  
 Manager and Chief Engineer, BWS  
 (for work affecting BWS facilities  
 State R/W & BWS easements only)

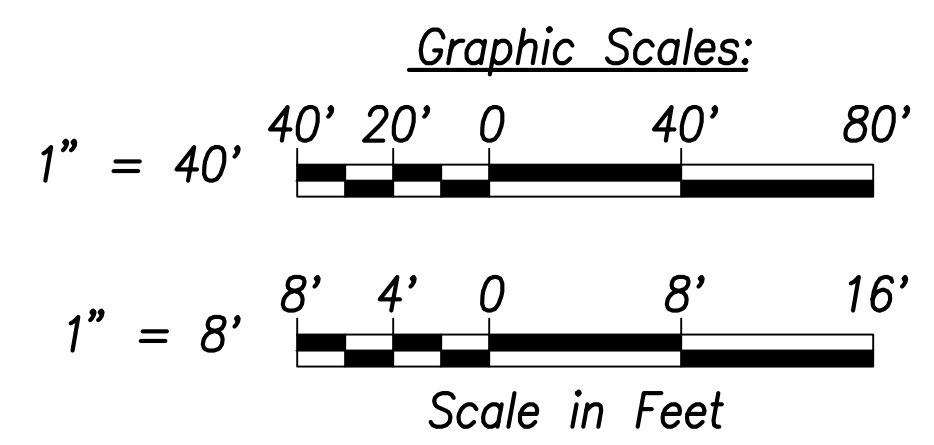

THIS WORK WAS PREPARED BY ME OR UNDER MY SUPERVISION AND CONSTRUCTION OF THIS PROJECT WILL BE UNDER MY OBSERVATION.  
 SIGNATURE: *Craig W. Luke* EXPIRATION DATE OF THE LICENSE: April 30, 2024

07/15/22	New Sheet
DATE	REVISION

STATE OF HAWAII  
 DEPARTMENT OF TRANSPORTATION  
 HIGHWAYS DIVISION

**Waterline Connection and Temporary By-Pass - 12**

FARRINGTON HIGHWAY WIDENING  
 Kapolei Golf Course Road to Fort Weaver Road  
 Project No. 7101A-01-20


Scale: As Shown Date: April 2022

SHEET NO. C-179 OF 767 SHEETS



FED. ROAD DIST. NO.	STATE	PROJ. NO.	FISCAL YEAR	SHEET NO.	TOTAL SHEETS
HAWAII	HAW.	7101A-01-20	2021	182	767


True North  
1" = 40'

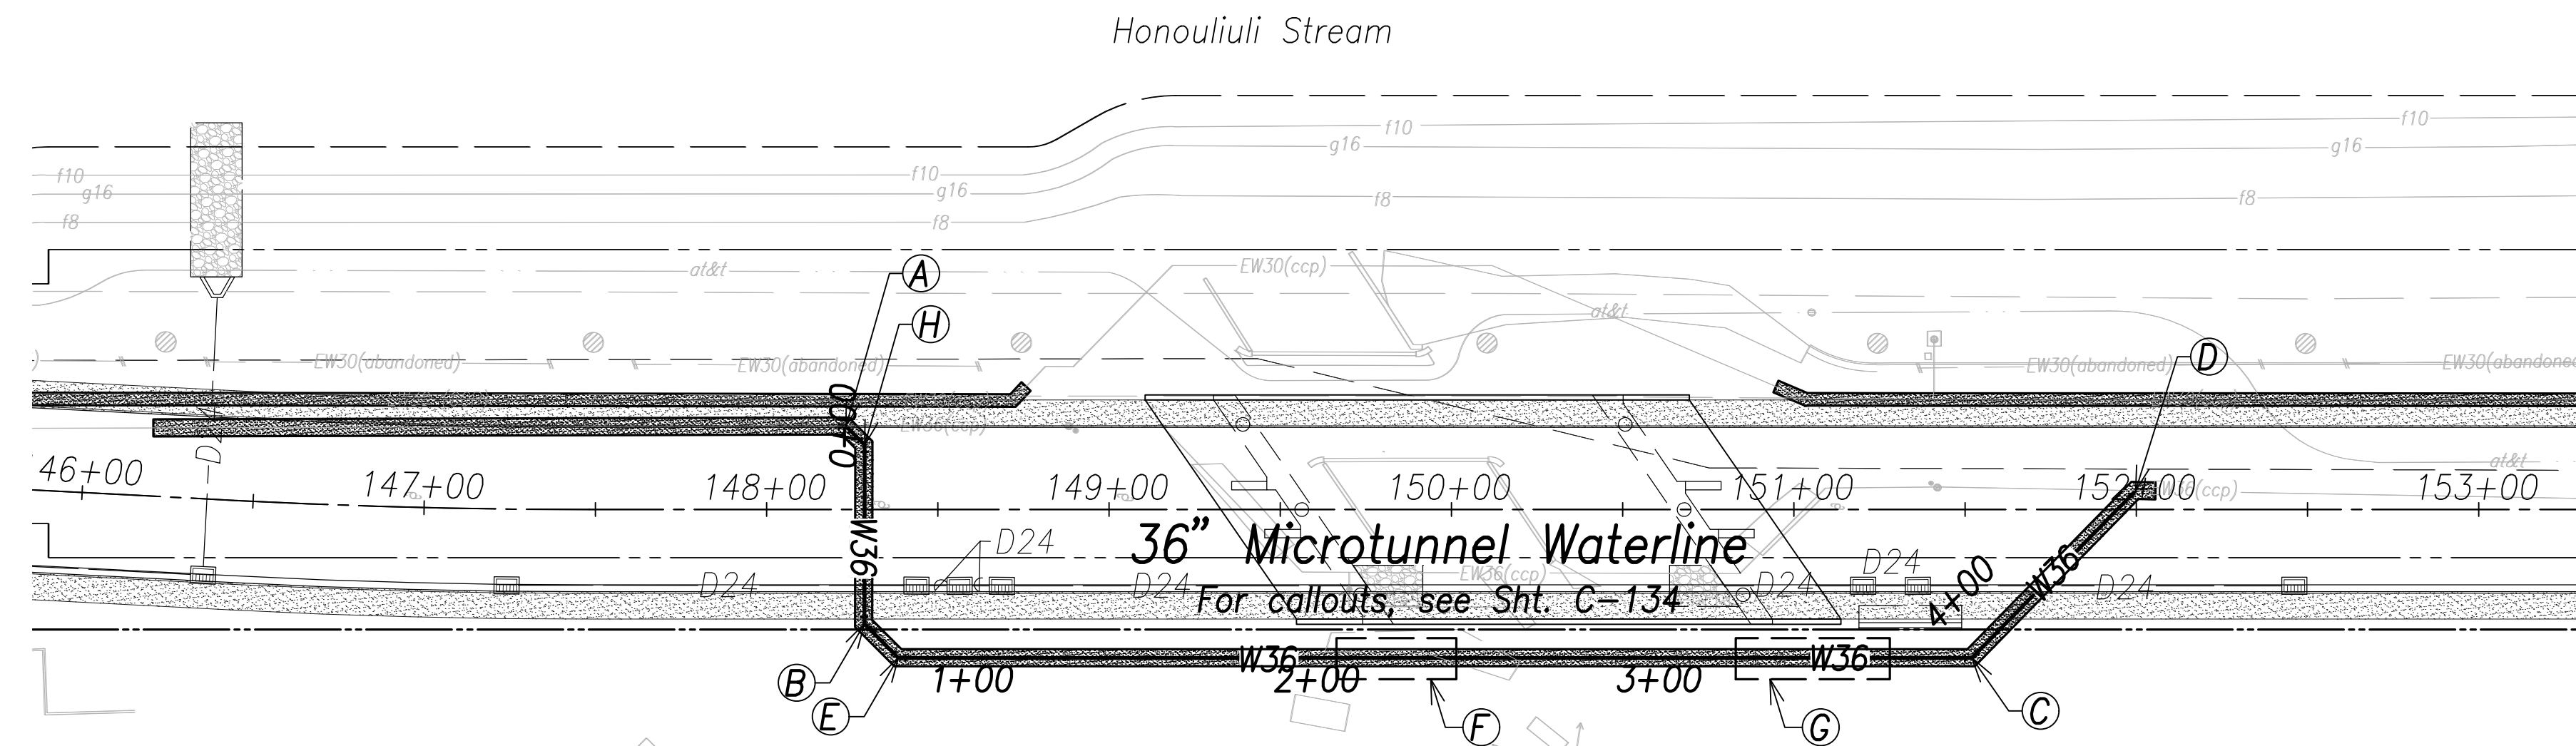


**36" Waterline Microtunneling Plan**  
Scale: 1" = 40'

**Note:**  
Contractor shall be responsible for the design, construction, maintenance, and restoration of the jacking and receiving pits and operational areas

- (A) Sta. 0+00 36" Microtunnel Waterline  
= Sta. 148+22.9, o/s 24.5' Lt. Farrington Highway Open Trench
- (B) Sta. 0+60 36" Microtunnel Waterline  
= Sta. 148+28.3, o/s 33.2' Rt. Farrington Highway Open Trench
- (C) Sta. 3+87.5 36" Microtunnel Waterline  
= Sta. 151+51.7, o/s 43.2' Rt. Farrington Highway Open Trench
- (D) Sta. 4+55.9 36" Microtunnel Waterline  
= Sta. 152+05.6, o/s 5.7' Lt. Farrington Highway Open Trench
- (E) Sta. 0+74.1 36" Microtunnel Waterline  
= Sta. 148+38.3, o/s 43.2' Rt. Farrington Highway Open Trench
- (F) 12' Wide x 35' Long Microtunnel Pit
- (G) 12' Wide x 45' Long Microtunnel Pit
- (H) Sta. 0+07.7 36" Microtunnel Waterline  
= Sta. 148+28.4, o/s 19' Lt. Farrington Highway Open Trench

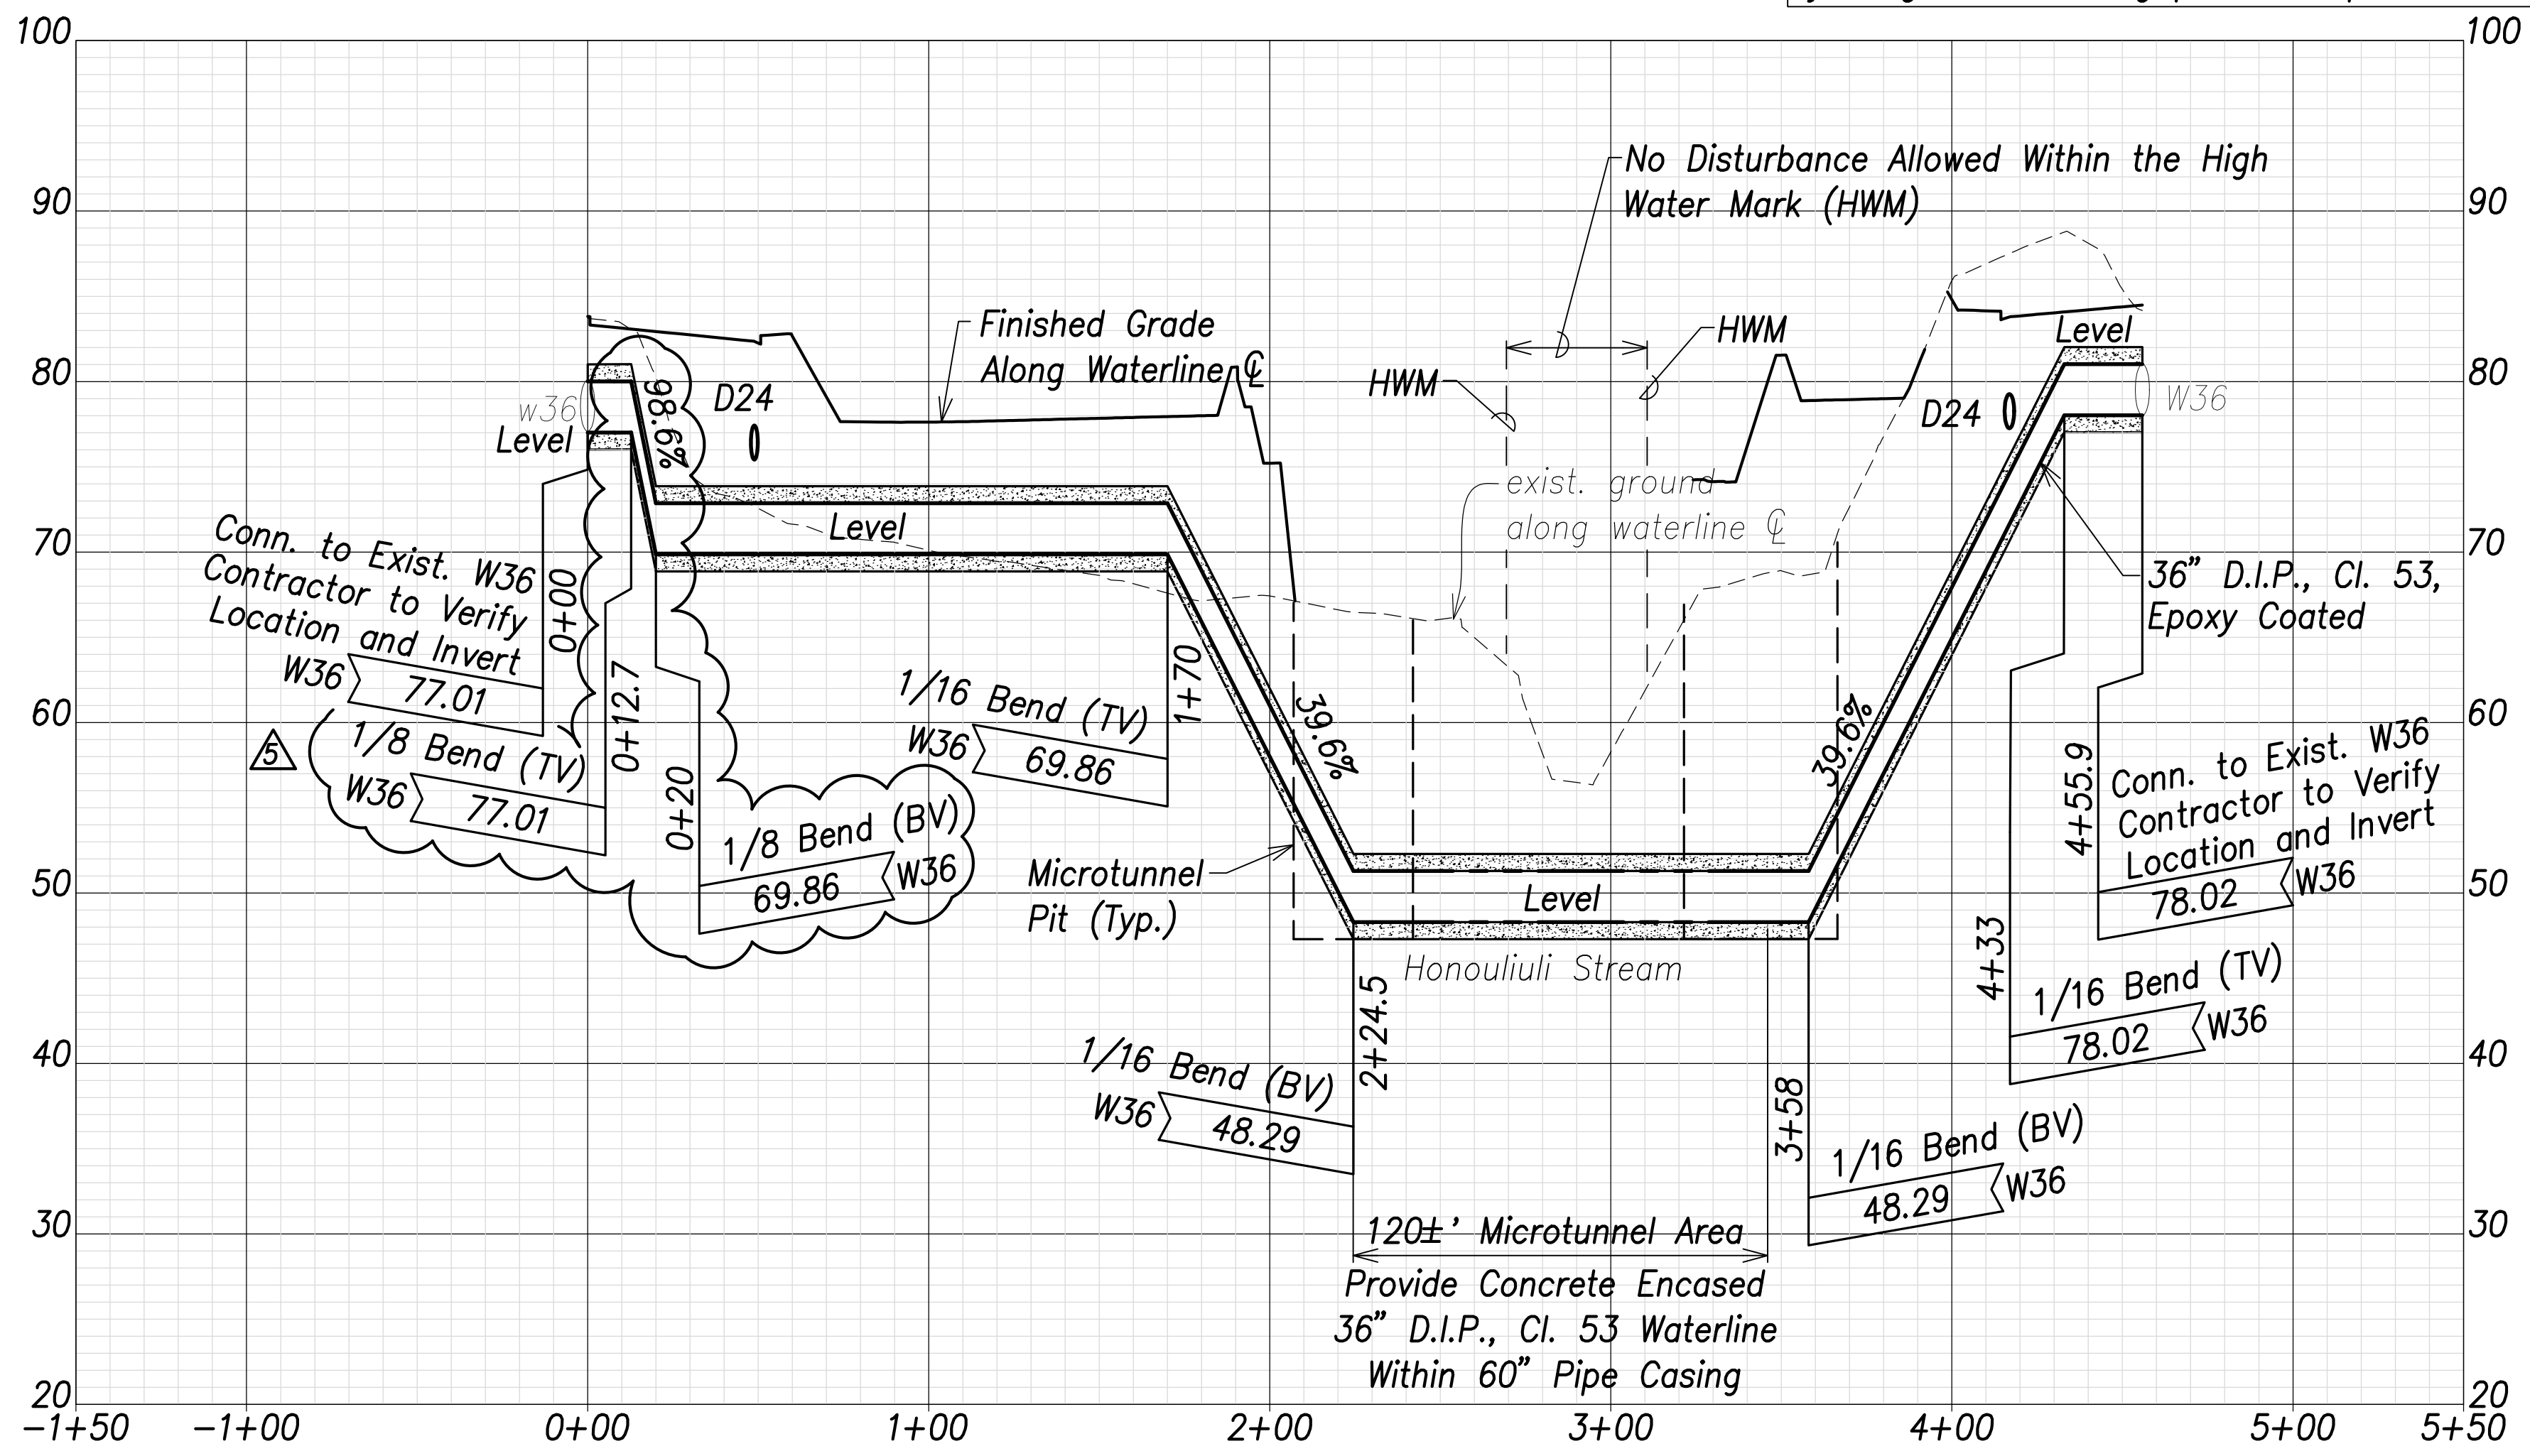

**36" Waterline Microtunneling Profile**  
Scales: Hor.: 1" = 40'  
Vert.: 1" = 8'

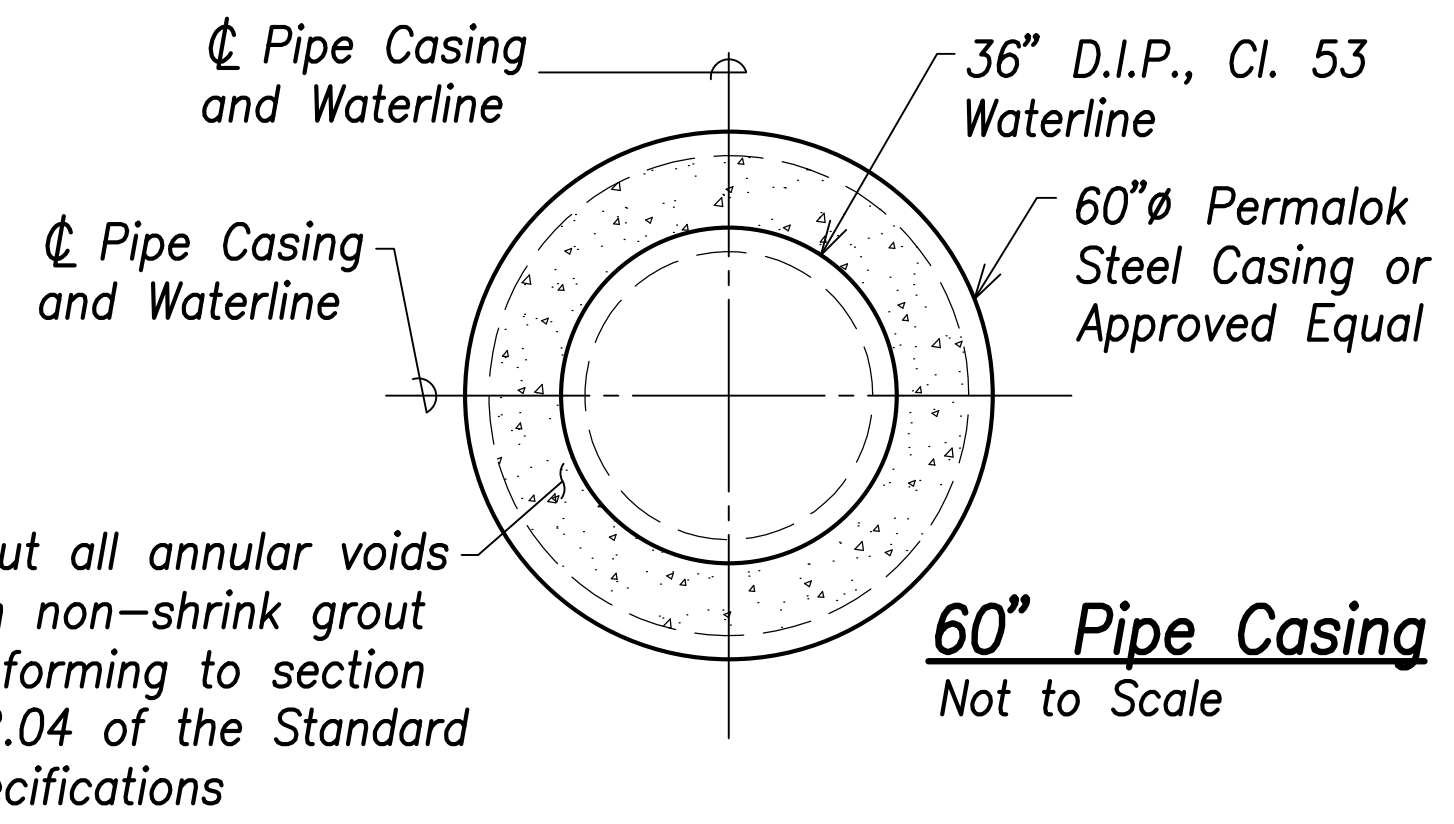

DATE	_____
SURVEY PLOTTED BY	_____
DRAWN BY	_____
TRACED BY	_____
CHECKED BY	_____
ORIGINAL PLAN	_____
NOTE BOOK	_____
No.	_____

APPROVED:  
Manager and Chief Engineer, BWS  
(for work affecting BWS facilities in City/State R/W & BWS easements only)

DATE \_\_\_\_\_

CRAG W. L. LUKE  
LICENSED PROFESSIONAL ENGINEER  
No. 6935-C  
HAWAII, U.S.A.

THIS WORK WAS PREPARED BY ME OR UNDER MY SUPERVISION AND CONSTRUCTION OF THIS PROJECT WILL BE UNDER MY OBSERVATION.

APRIL 30, 2024  
EXPIRATION DATE OF THE LICENSE

07/15/22 Revised Waterline Profile

DATE REVISION

STATE OF HAWAII  
DEPARTMENT OF TRANSPORTATION  
HIGHWAYS DIVISION


**36" Waterline Microtunneling Plan & Profile at Honouliuli Stream**

FARRINGTON HIGHWAY WIDENING  
Kapolei Golf Course Road to Fort Weaver Road  
Project No. 7101A-01-20

Scale: As Shown Date: April 2022


SHEET No. C-181 OF 767 SHEETS

FED. ROAD DIST. NO.	STATE	PROJ. NO.	FISCAL YEAR	SHEET NO.	TOTAL SHEETS
HAWAII	HAW.	7101A-01-20	2021	183	767

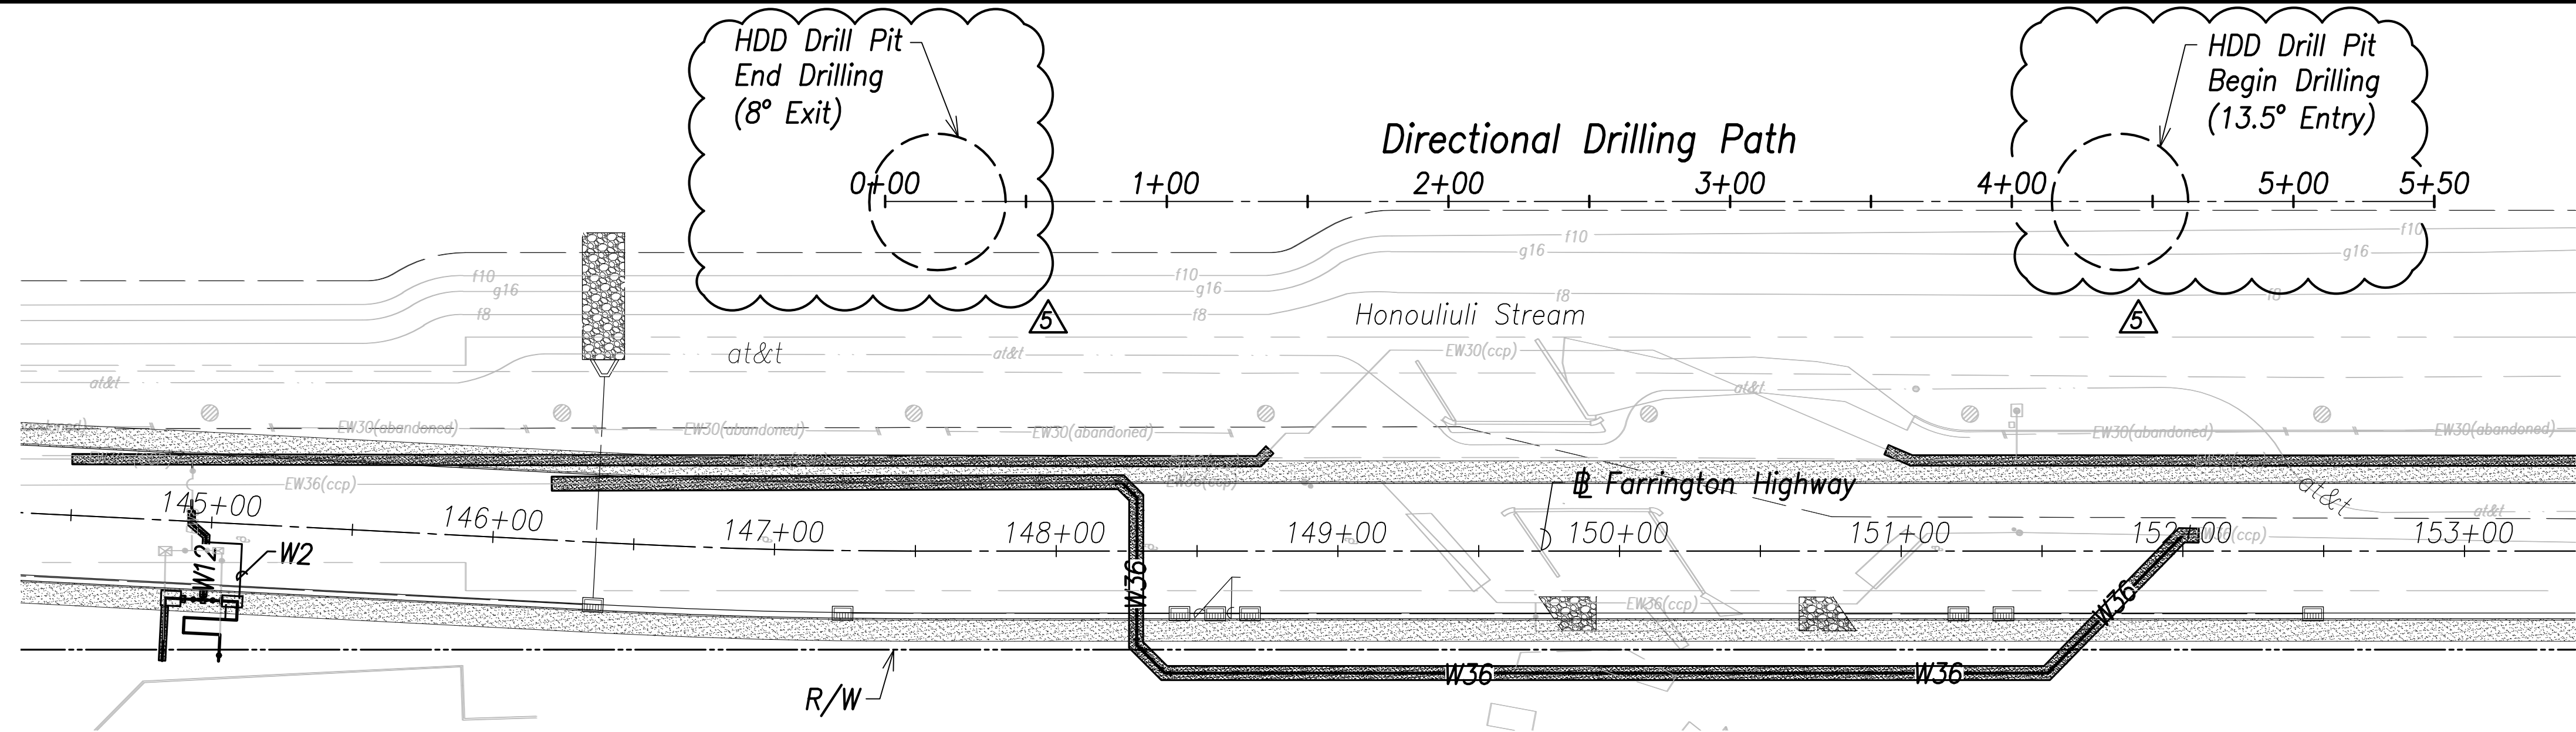

**AT&T Directional Drilling Plan**  
Scale: 1" = 40'

**Note:**  
Contractor shall be responsible for the design, construction, maintenance, and restoration of the HDD drill pits and operational areas

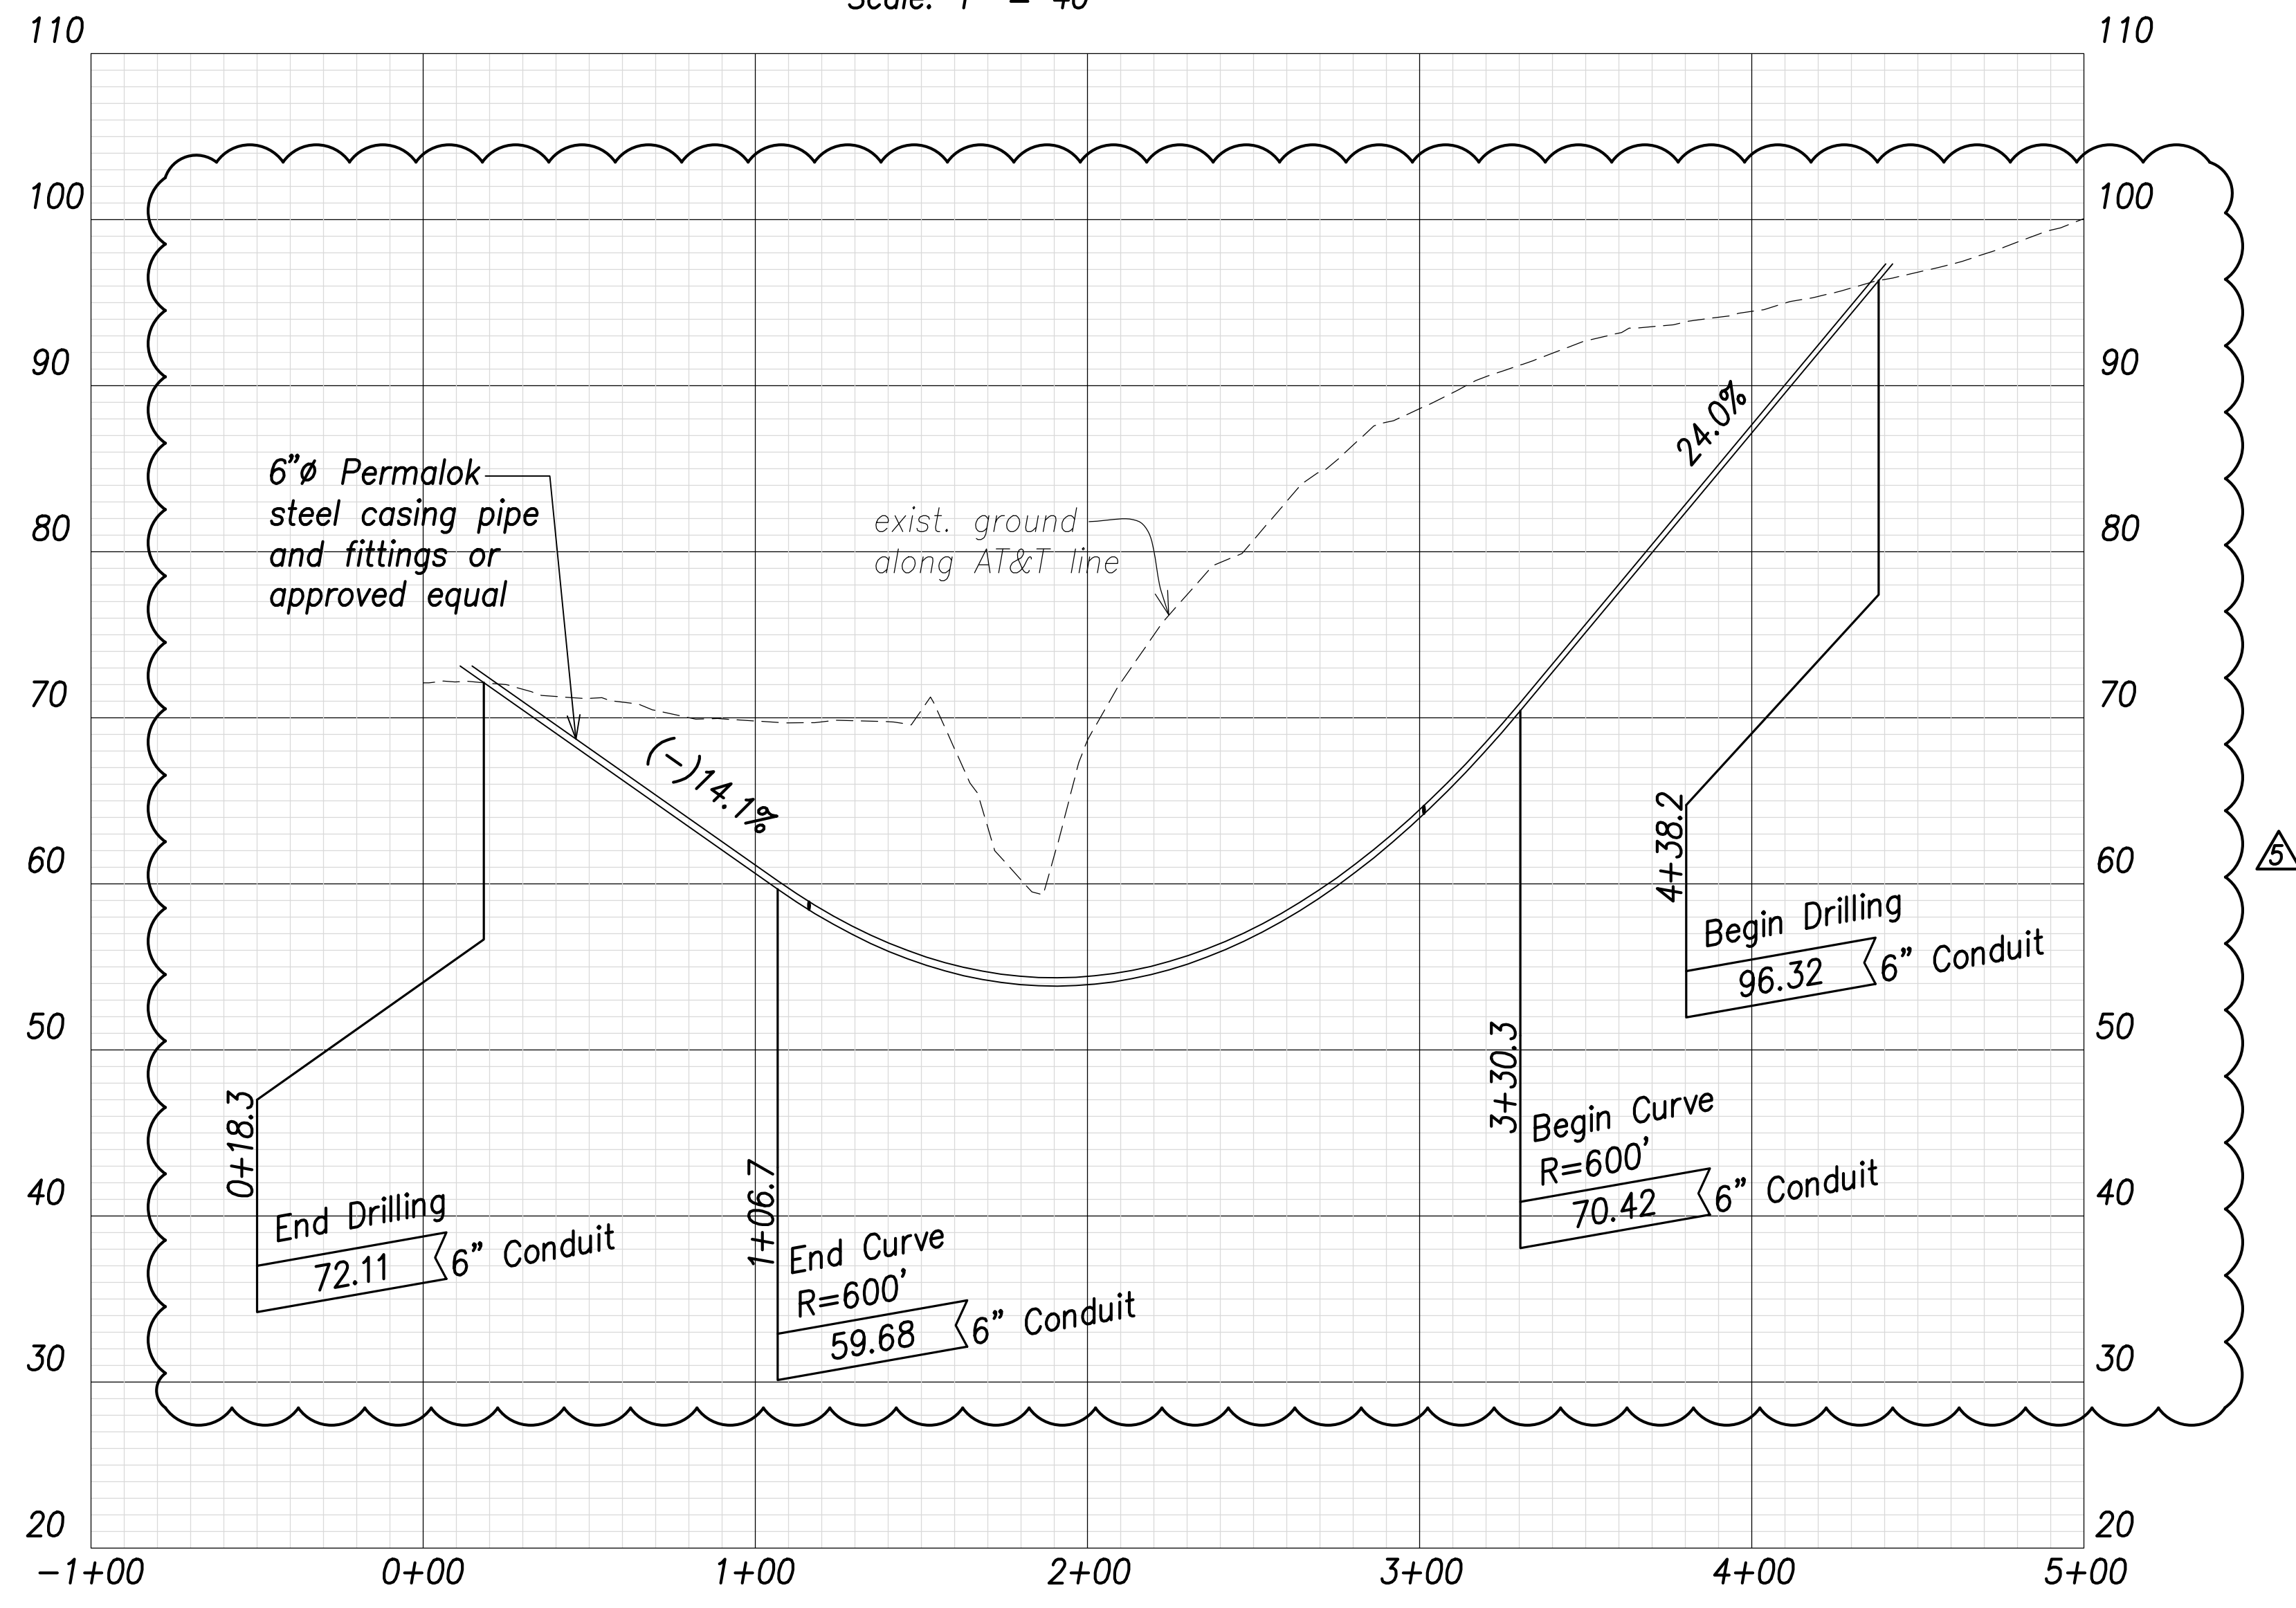

**AT&T Directional Drilling Profile**  
Scales: Hor.: 1" = 40'  
Vert.: 1" = 8'


SURVEY PLOTTED BY	DATE
DRAWN BY	
TRACED BY	
DESIGNED BY	
CHECKED BY	
NO. _____	




THIS WORK WAS PREPARED BY ME OR UNDER MY SUPERVISION AND CONSTRUCTION OF THIS PROJECT WILL BE UNDER MY OBSERVATION.  
SIGNATURE: *Craig W. Luke* EXPIRATION DATE OF THE LICENSE: April 30, 2024

07/15/22	Revised directional drilling
DATE	REVISION
STATE OF HAWAII <b>DEPARTMENT OF TRANSPORTATION</b> HIGHWAYS DIVISION	
<b>AT&amp;T Directional Drilling</b> <b>Plan &amp; Profile</b>	
FARRINGTON HIGHWAY WIDENING Kapolei Golf Course Road to Fort Weaver Road Project No. 7101A-01-20	
Scale: As Shown	Date: April 2022
<b>SHEET No. C-182 OF 767 SHEETS</b>	


FED. ROAD DIST. NO.	STATE	PROJ. NO.	FISCAL YEAR	SHEET NO.	TOTAL SHEETS
HAWAII	HAW.	7101A-01-20	2021		767

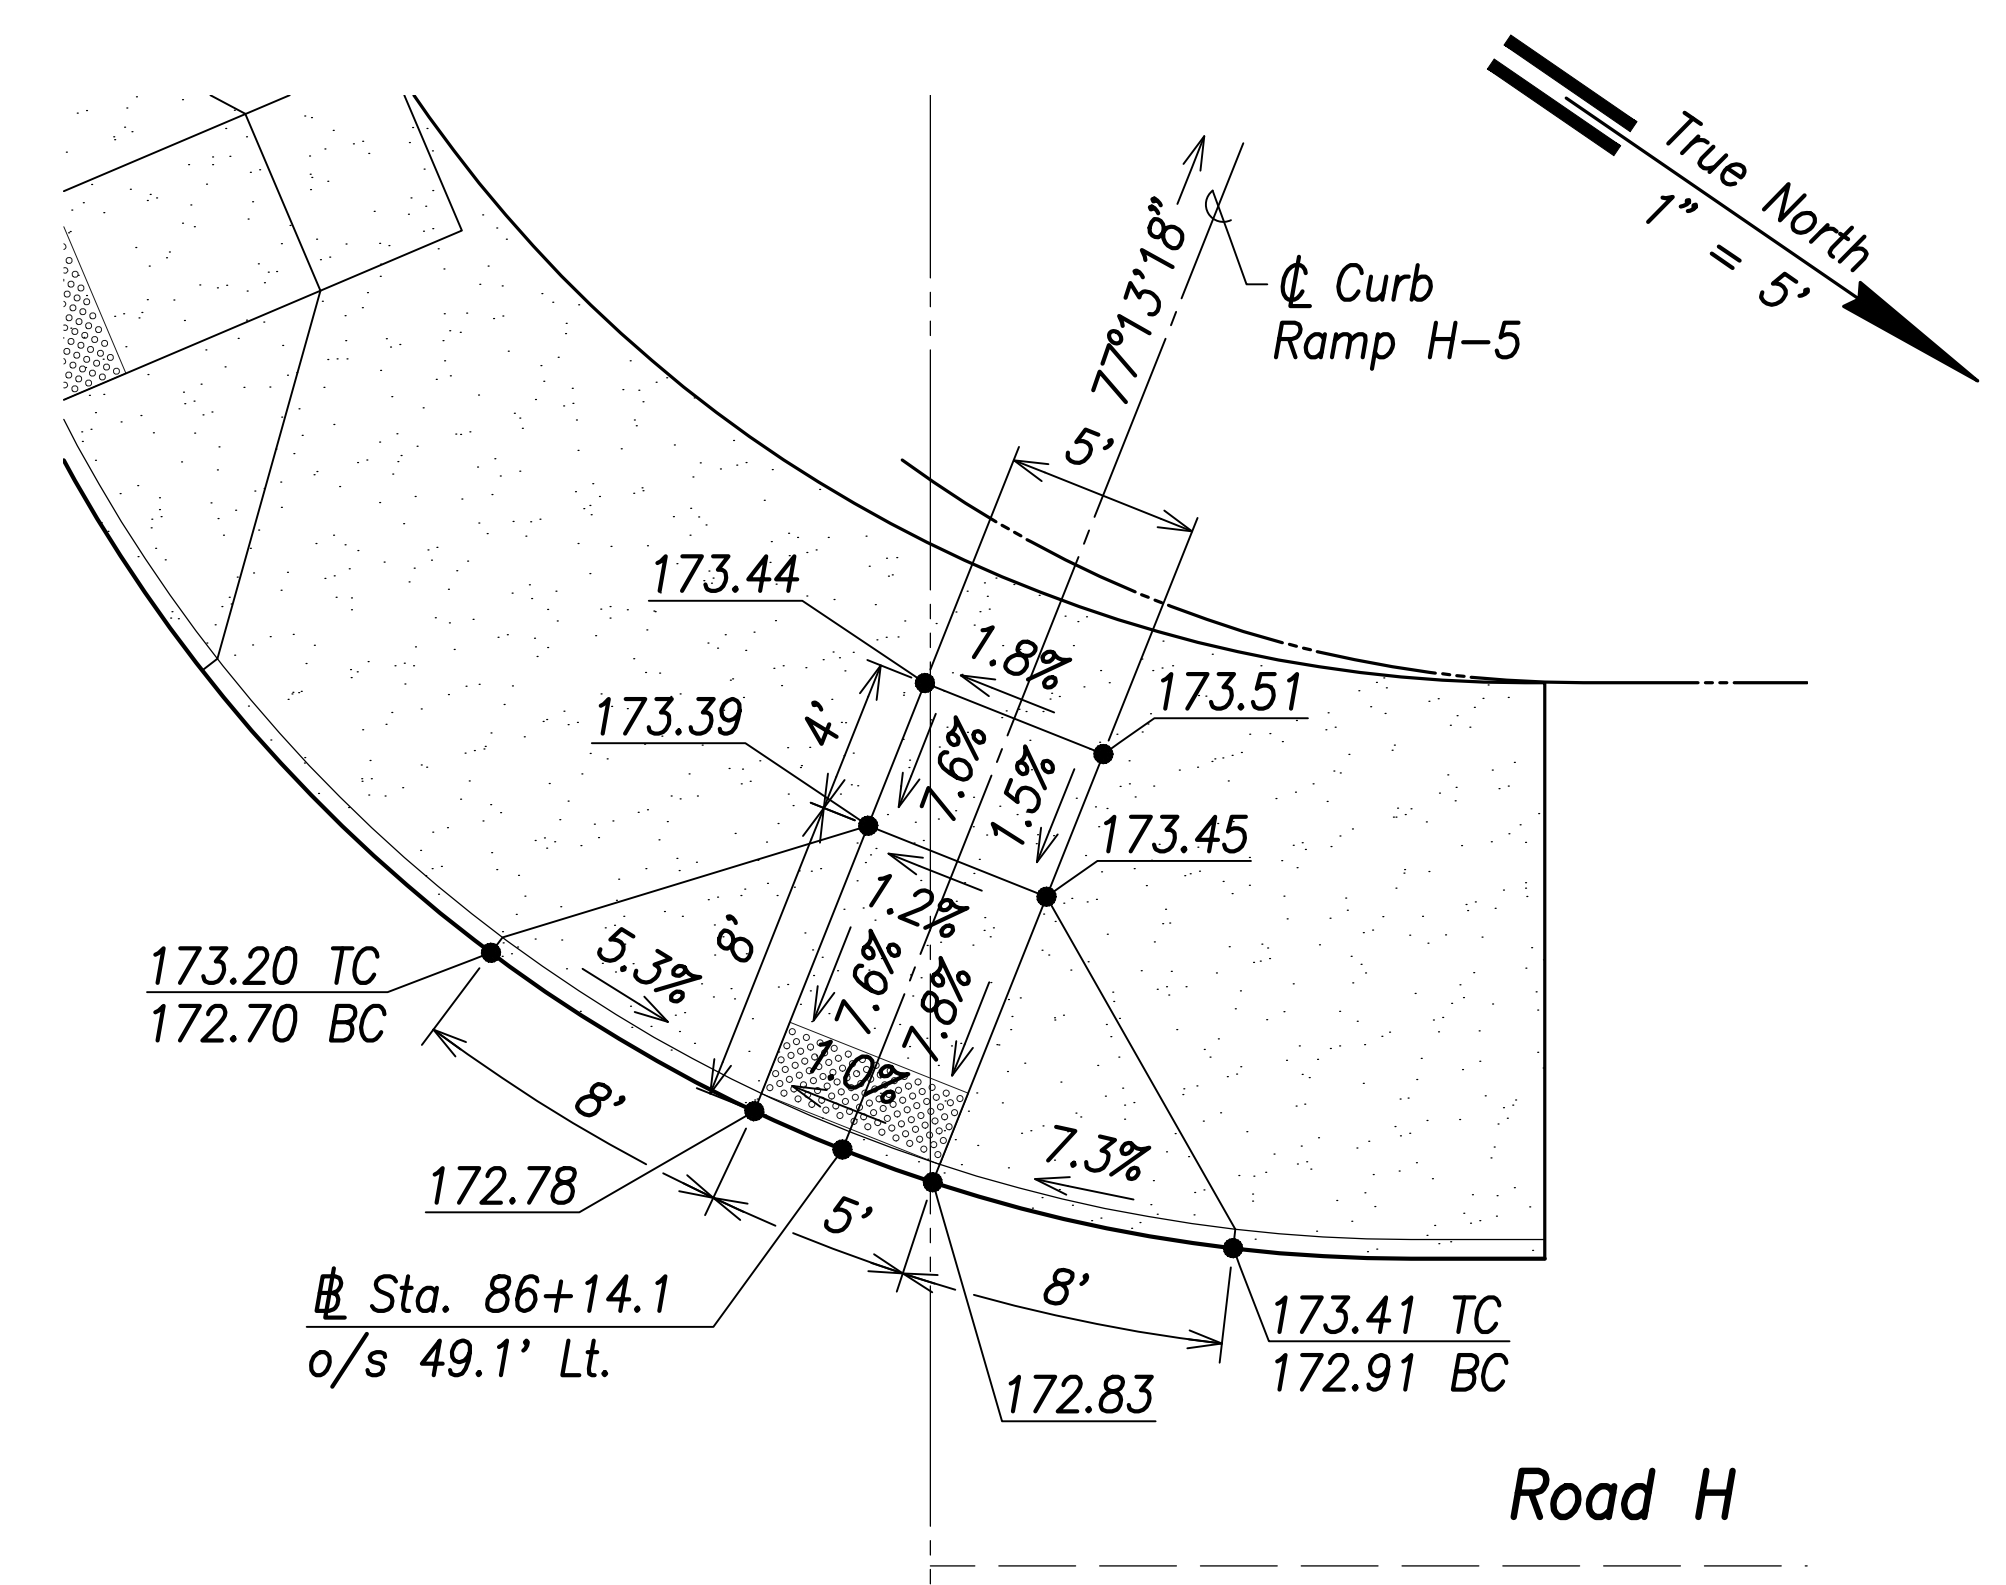


**Curb Ramp H-5**  
Scale: 1" = 5'

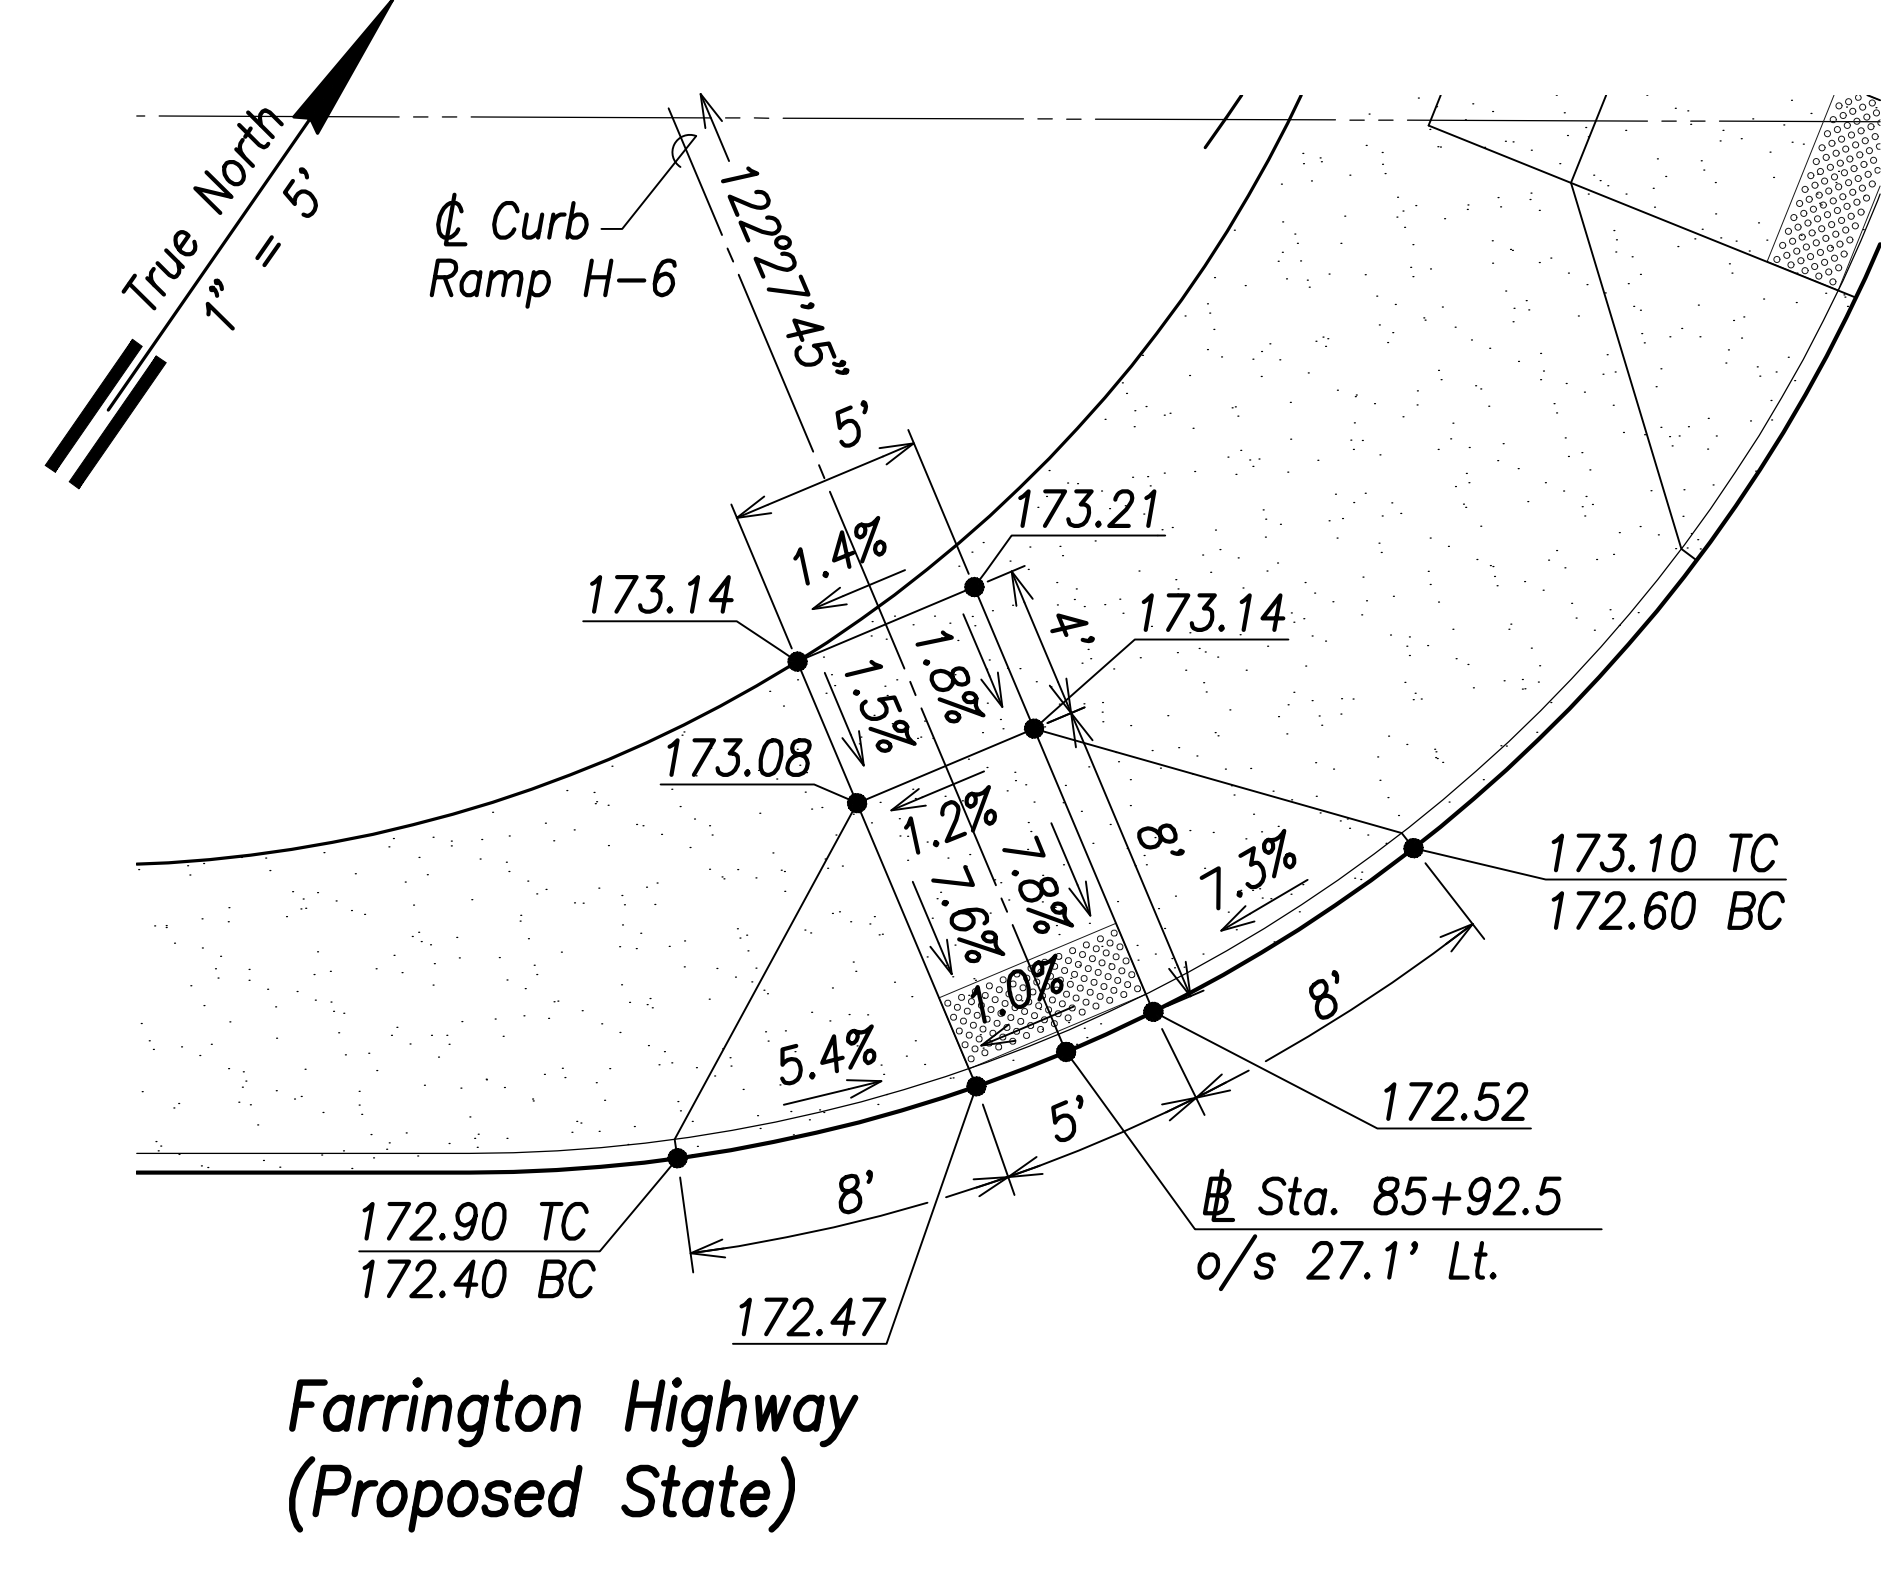


**Curb Ramp H-6**  
Scale: 1" = 5'

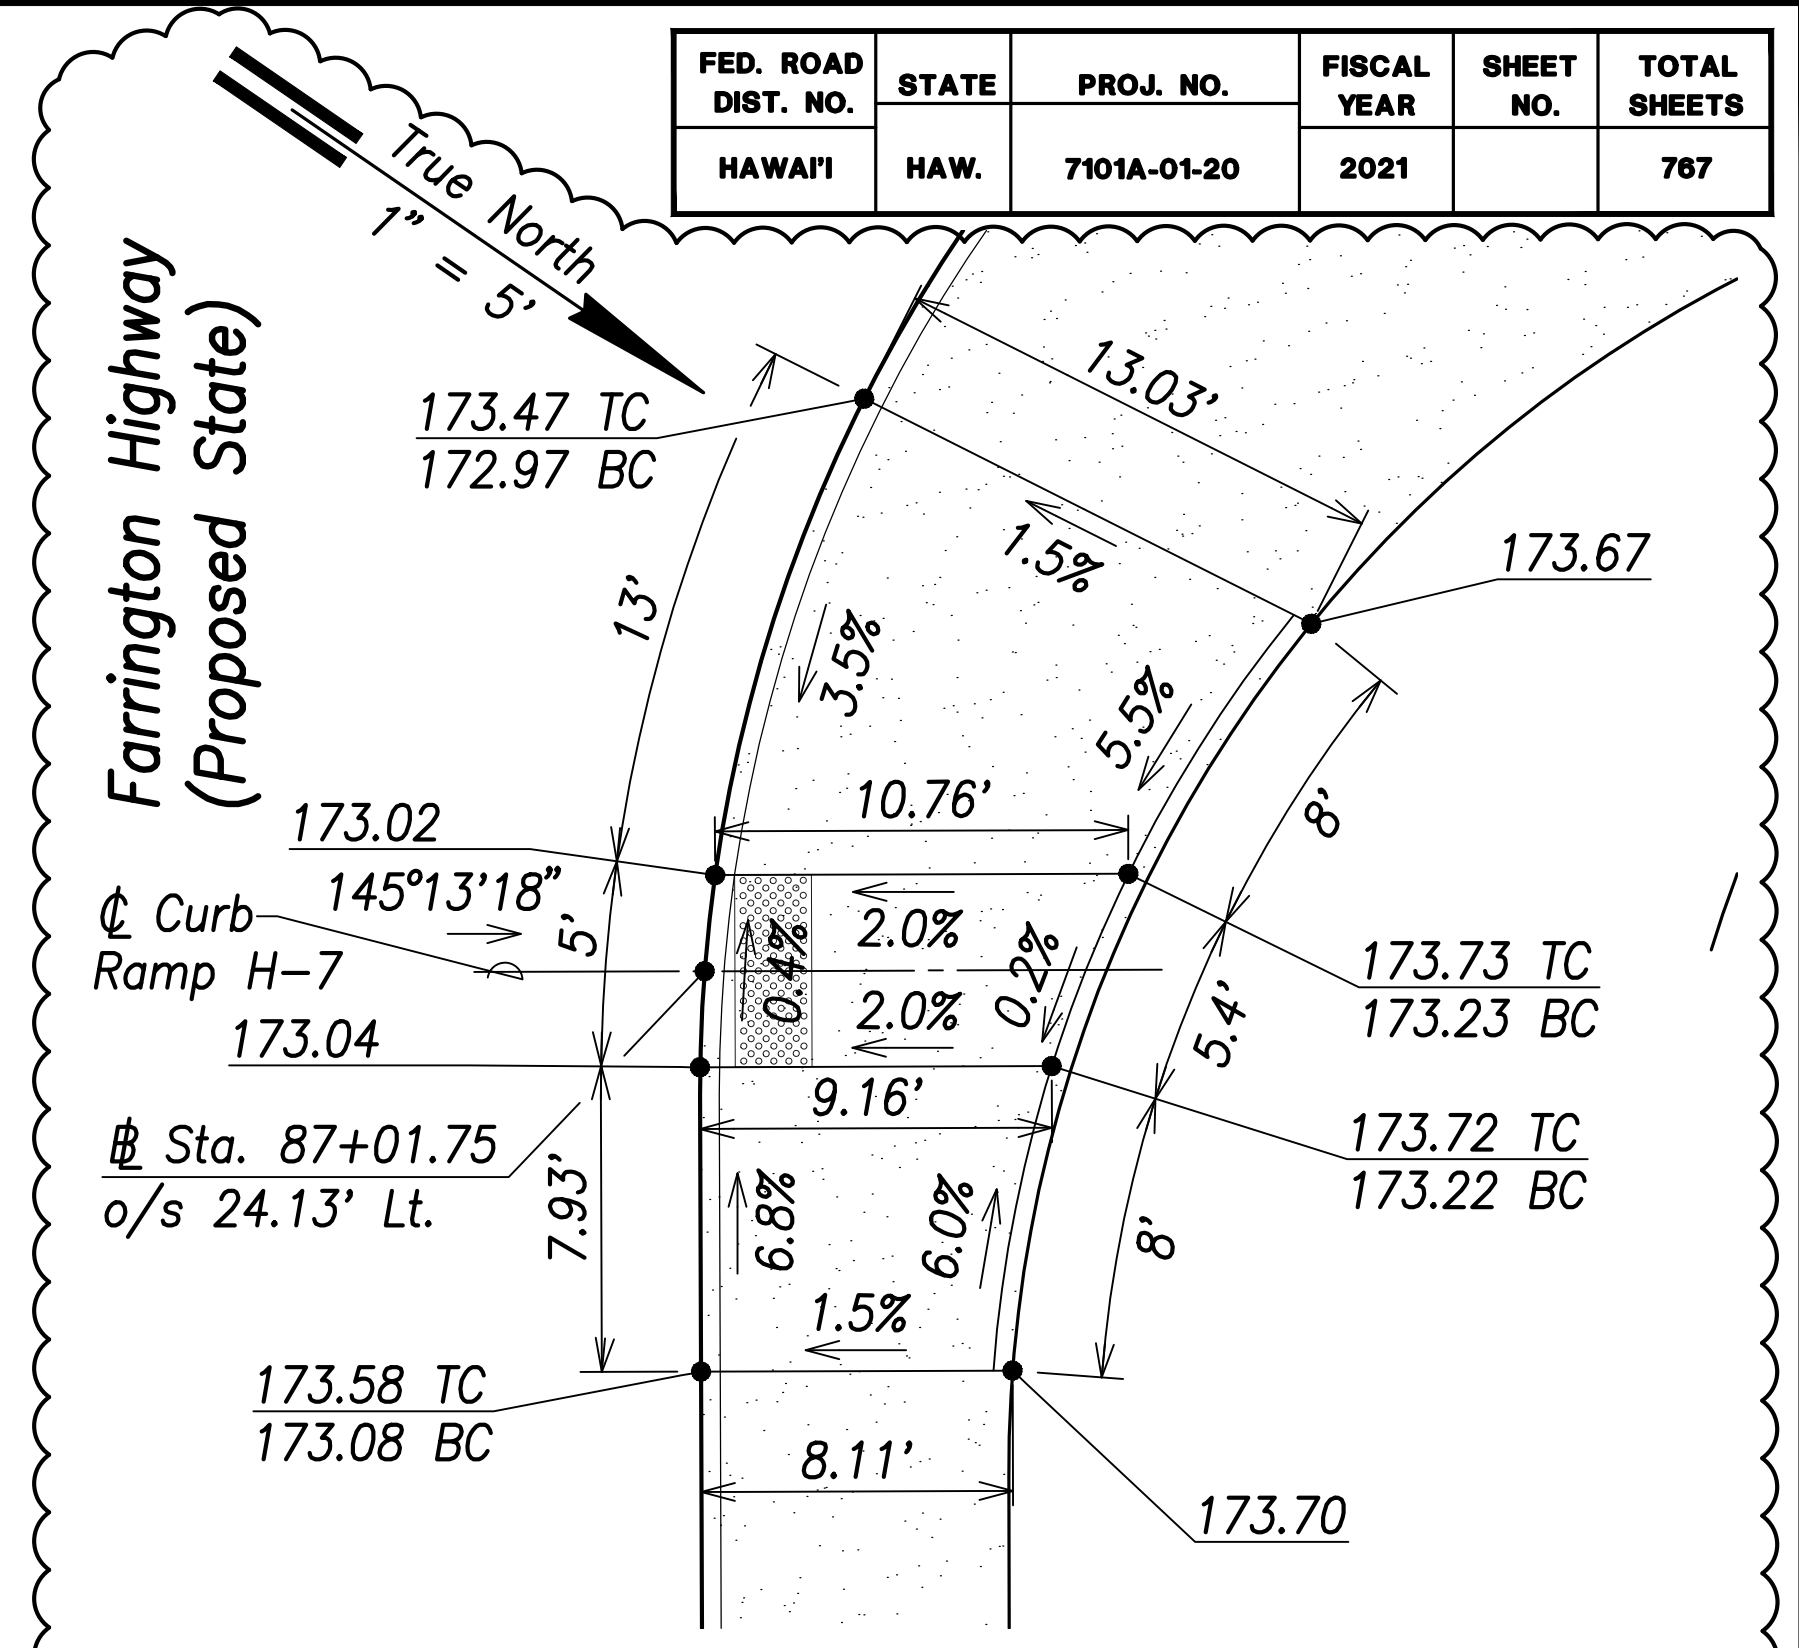


**Curb Ramp H-7**  
Scale: 1" = 5'

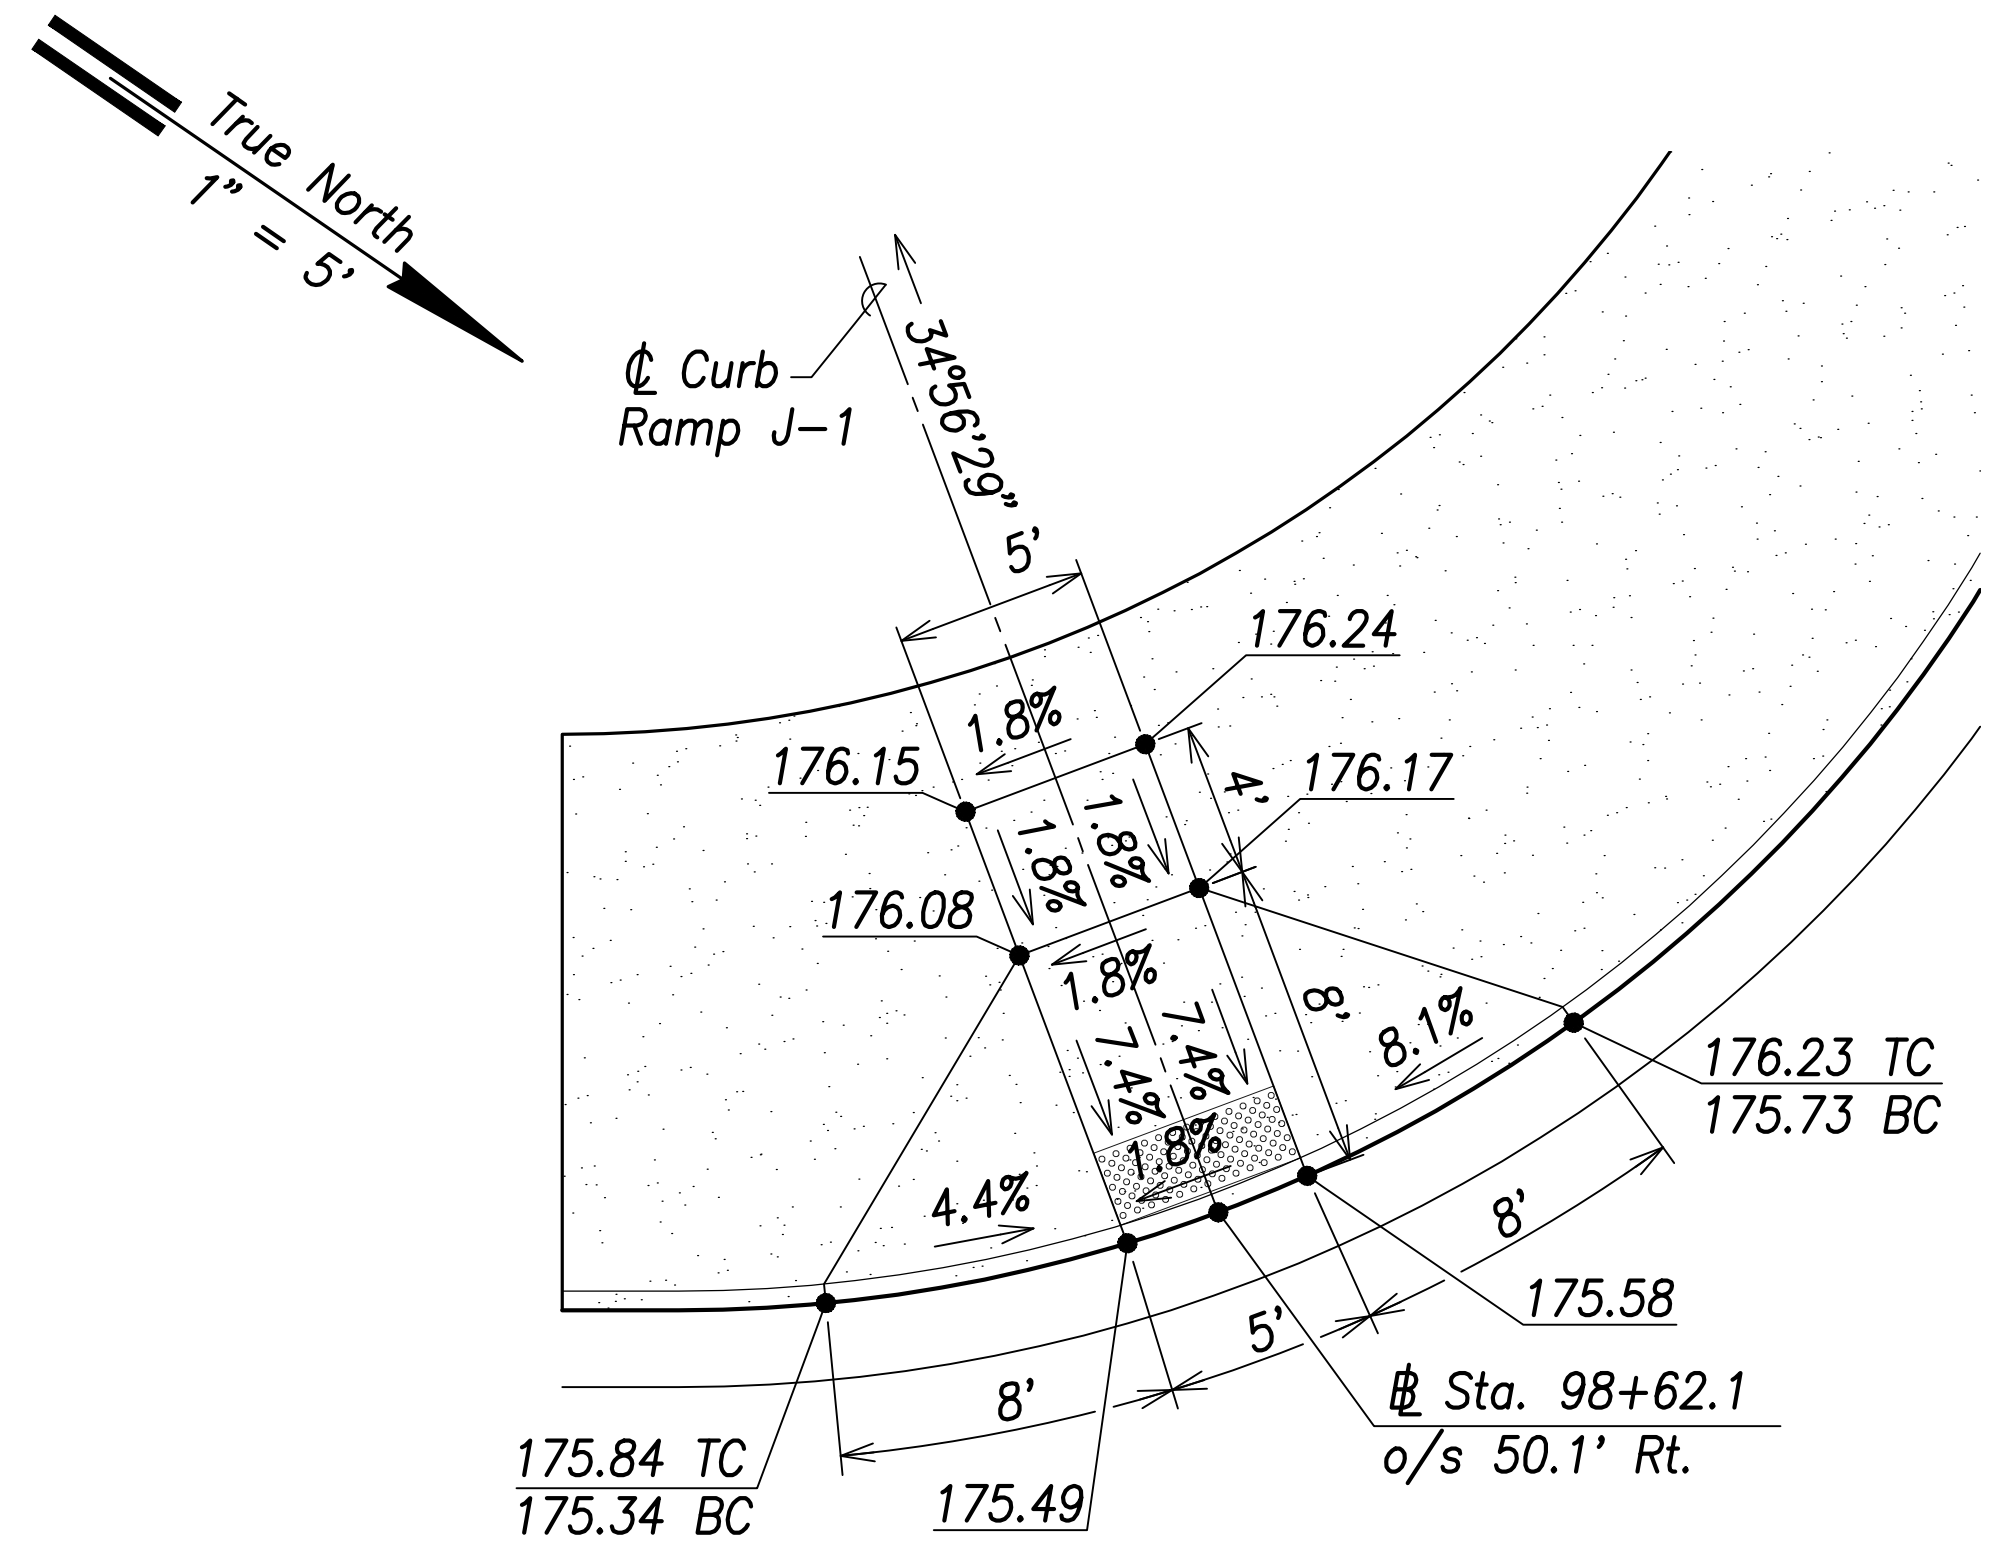

**Curb Ramp J-1**  
Scale: 1" = 5'

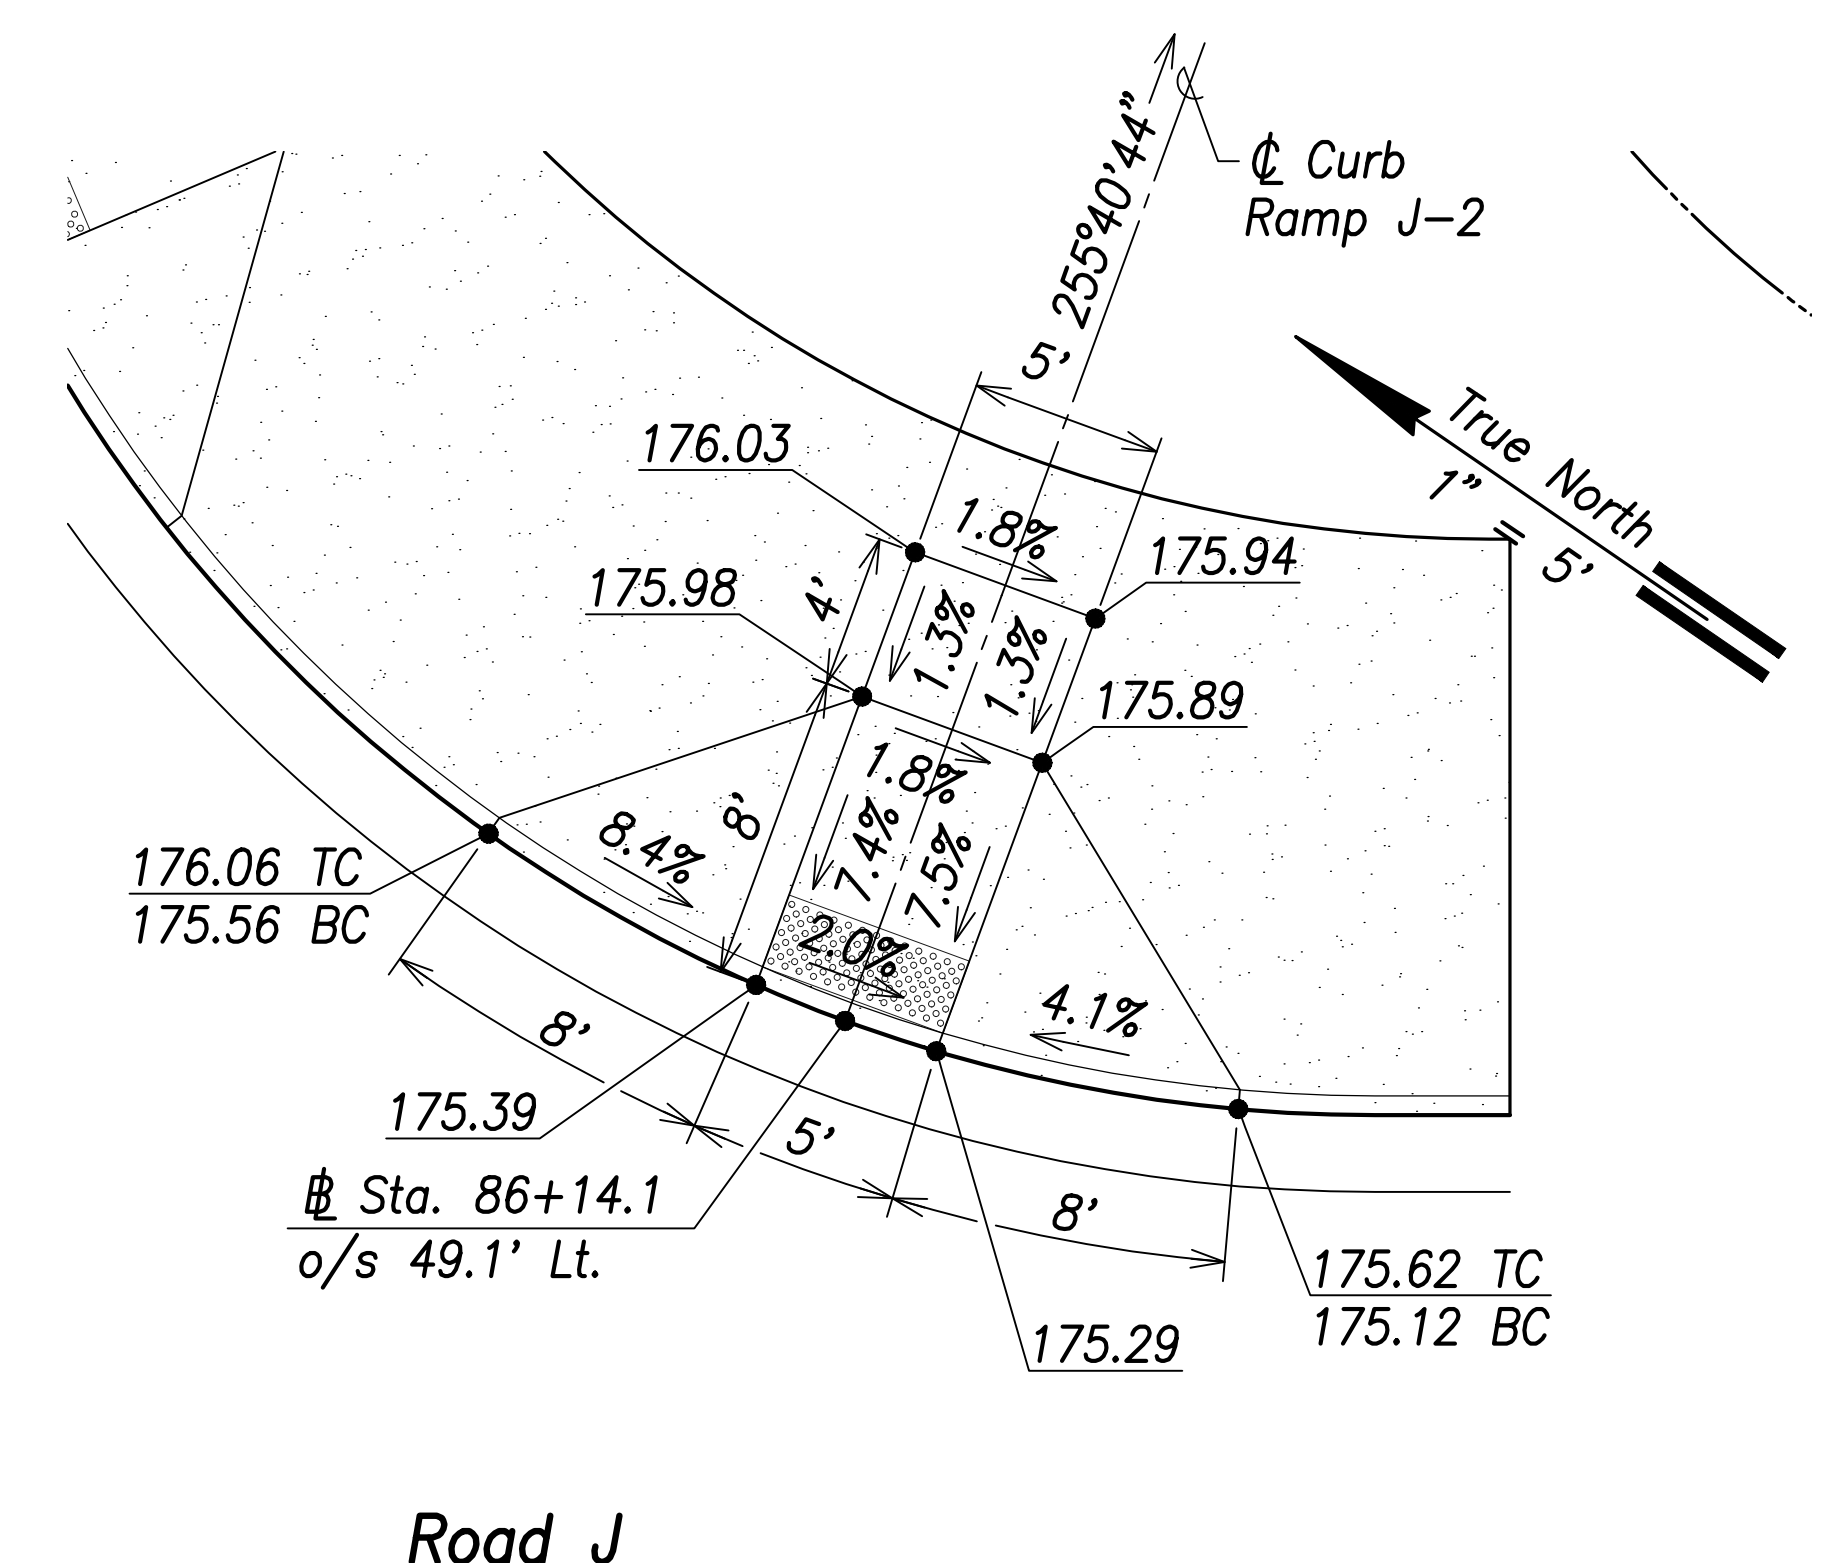


**Curb Ramp J-2**  
Scale: 1" = 5'

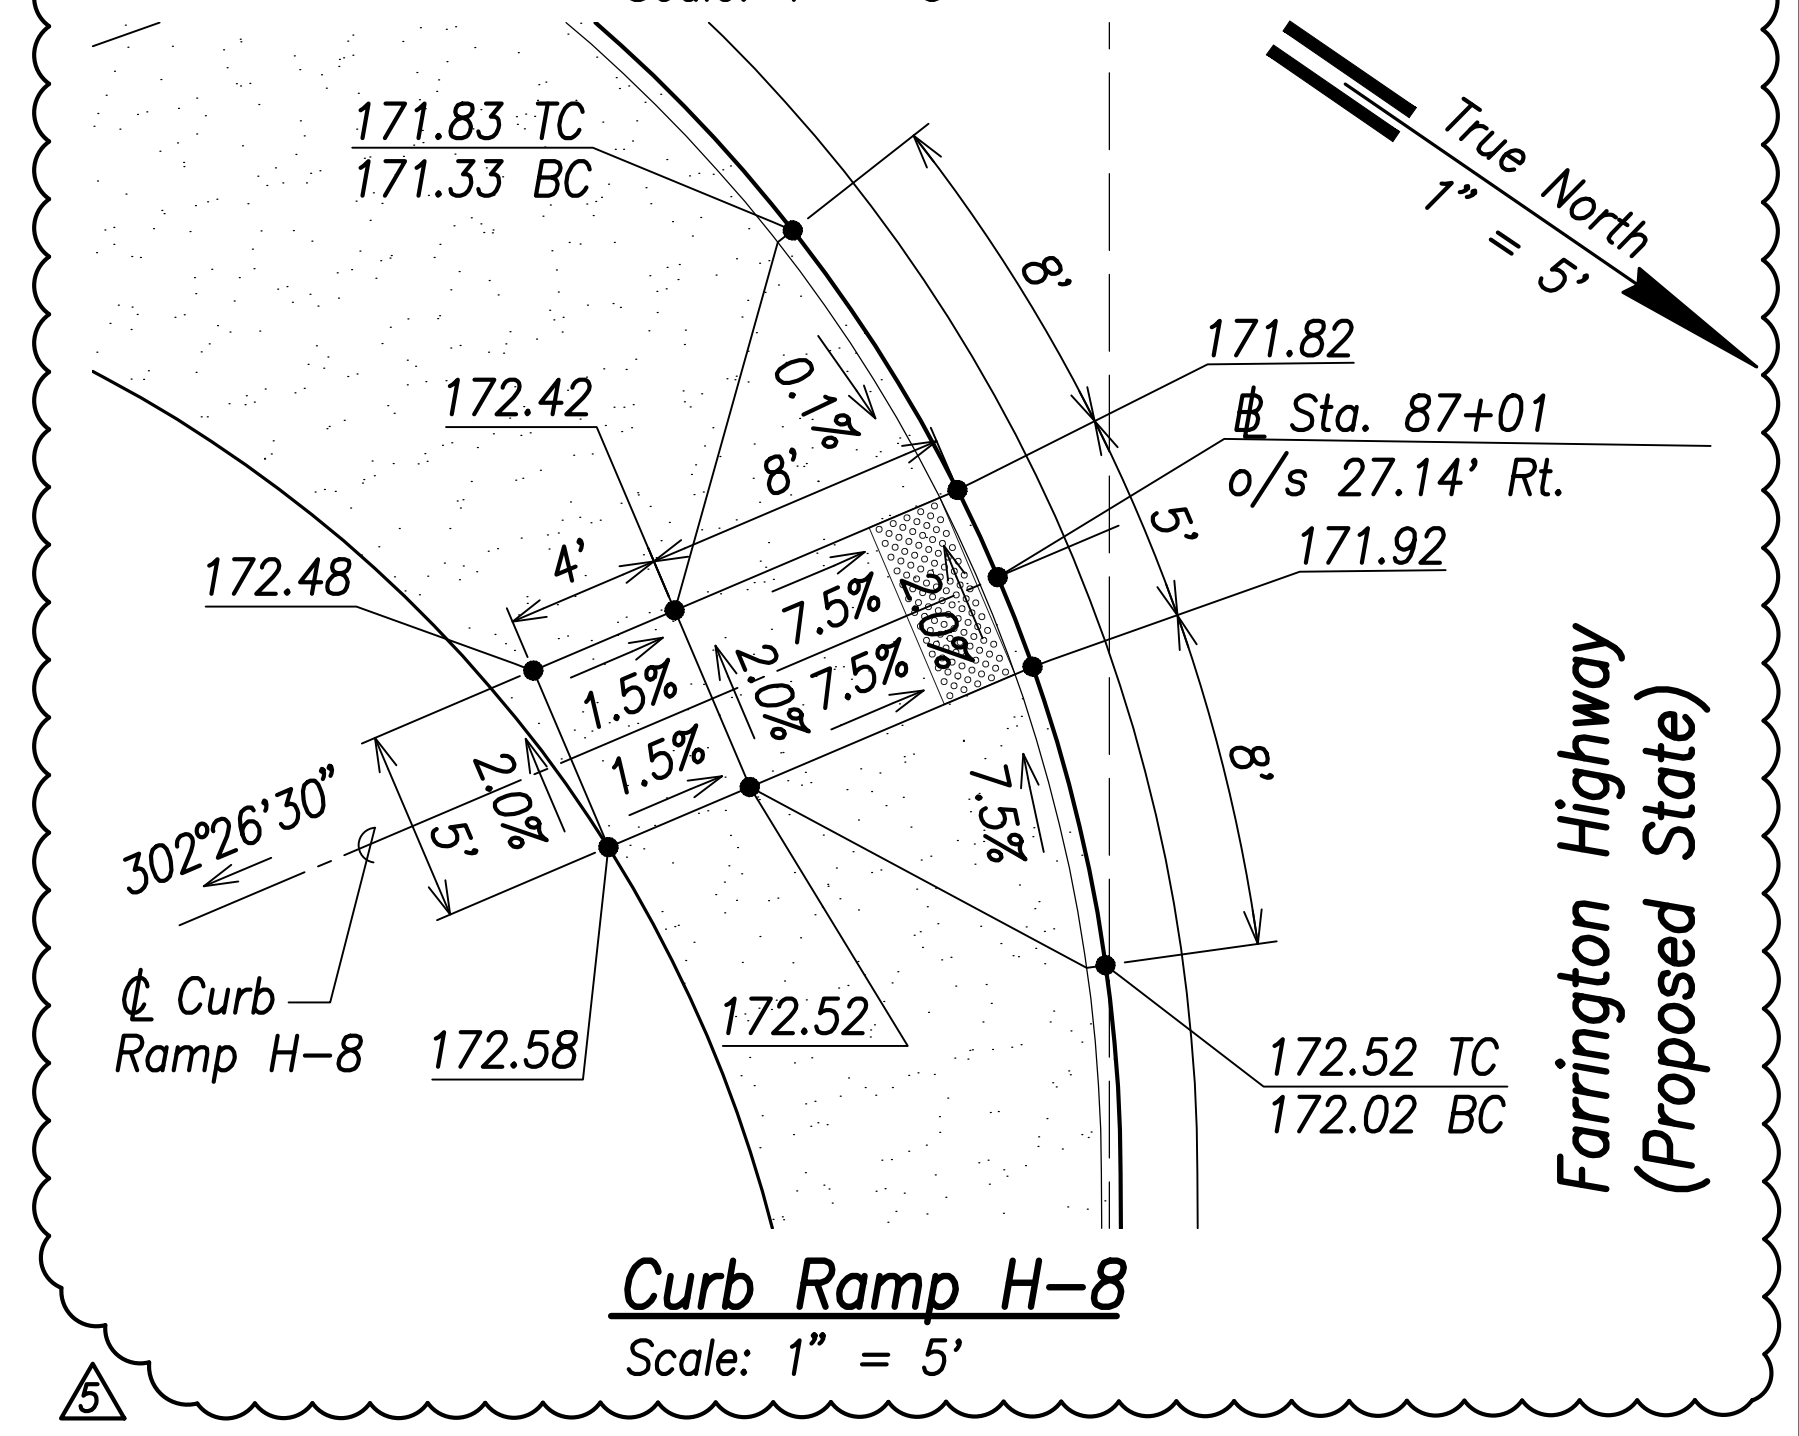

**Curb Ramp H-8**  
Scale: 1" = 5'

SURVEY PLOTTED BY:	DATE:
DRAWN BY:	
TRACED BY:	
QUANTITIES BY:	
CHECKED BY:	
ORIGINAL PLAN NO.:	
NOTE BOOK No.:	

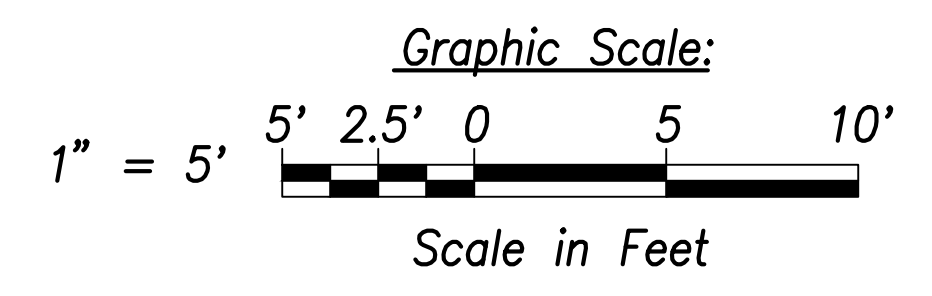

THIS WORK WAS PREPARED BY ME OR UNDER MY SUPERVISION AND CONSTRUCTION OF THIS PROJECT WILL BE UNDER MY OBSERVATION.  
 SIGNATURE: *Craig W. L. Luke*  
 EXPIRATION DATE OF THE LICENSE: April 30, 2024

07/15/22 Added curb ramps

STATE OF HAWAII  
 DEPARTMENT OF TRANSPORTATION  
 HIGHWAYS DIVISION

**Curb Ramp Layout & Grading Plan - 13**


FARRINGTON HIGHWAY WIDENING  
 Kapolei Golf Course Road to Fort Weaver Road  
 Project No. 7101A-01-20

Scale: As Shown Date: April 2022

SHEET NO. C-195 OF 767 SHEETS



FED. ROAD DIST. NO.	STATE	PROJ. NO.	FISCAL YEAR	SHEET NO.	TOTAL SHEETS
HAWAII	HAW.	7101A-01-20	2021	208	767

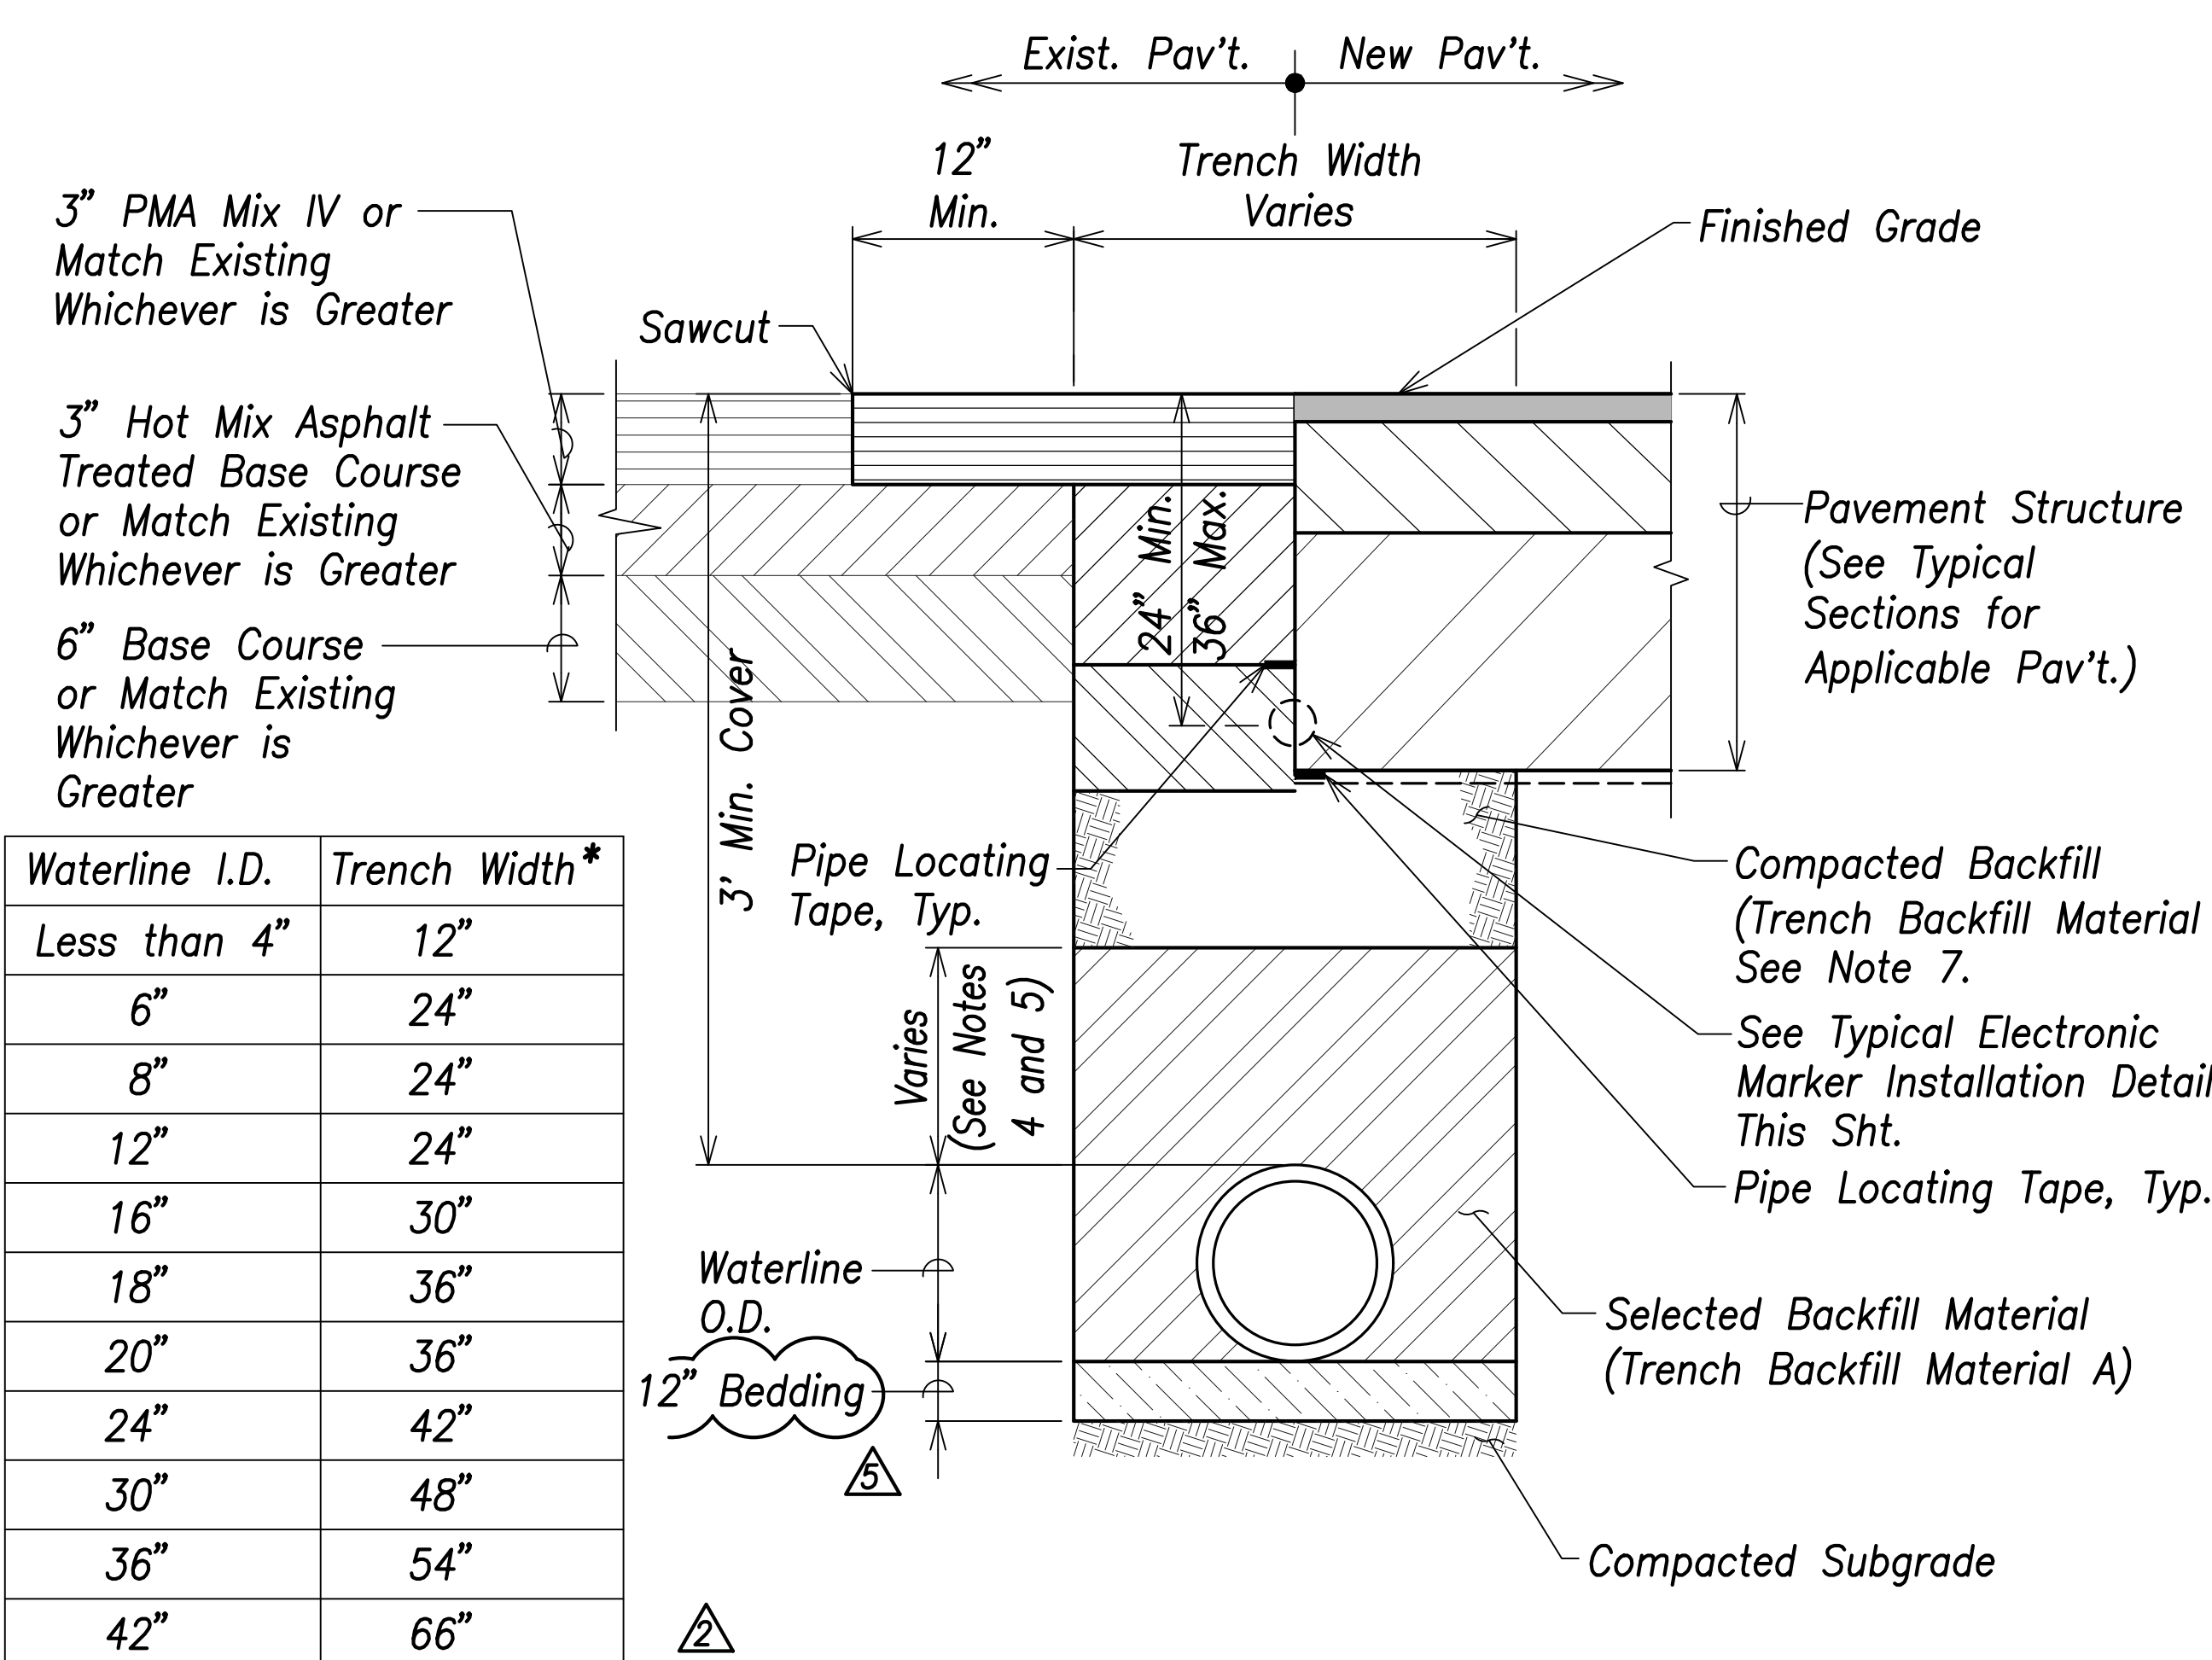


Waterline I.D.	Trench Width*
Less than 4"	12"
6"	24"
8"	24"
12"	24"
16"	30"
18"	36"
20"	36"
24"	42"
30"	48"
36"	54"
42"	66"

\*Trench widths for concrete encased portions of the water system shall conform to Section 624.03(B) of the Standard Specifications


**Waterline Trench Detail**  
Not to Scale

**Notes:**


1. A min. of 3-feet of cover shall be maintained at all times within the State R/W.
2. All other conditions for pipeline installations remain as specified.
3. Contractor shall provide minimum pavement structure as shown or match the existing pavement structure for trench restoration of existing pavement in the State R/W.
4. 12" of Cushion Material above the top of the pipe for Pipes 16" or Larger. 6" Cushion Material above the top of the pipe for Pipes 12" or Smaller at Locations Where Invert is Above 4-Foot Elevation.
5. 12" of Cushion Material above the top of the pipe for All Pipe Sizes at Locations Where the Invert is at or Below the 4-Foot Elevation.
6. In Areas Where Soft and/or Loose Soils are Encountered Near the Proposed Drain Line, the Contractor Shall Remove the Unsuitable Materials as Required by the Project Soils Engineer and Provide a Subgrade Stabilization Layer with a Thickness to be Determined by the Project Soils Engineer.
7. Where existing utilities under the new waterline cannot achieve the required compaction, Controlled Low Strength Material (CLSM) with a 28-day unconfined compressive strength between 50 and 150 pounds per square inch (psi) shall be used in place of compacted backfill.

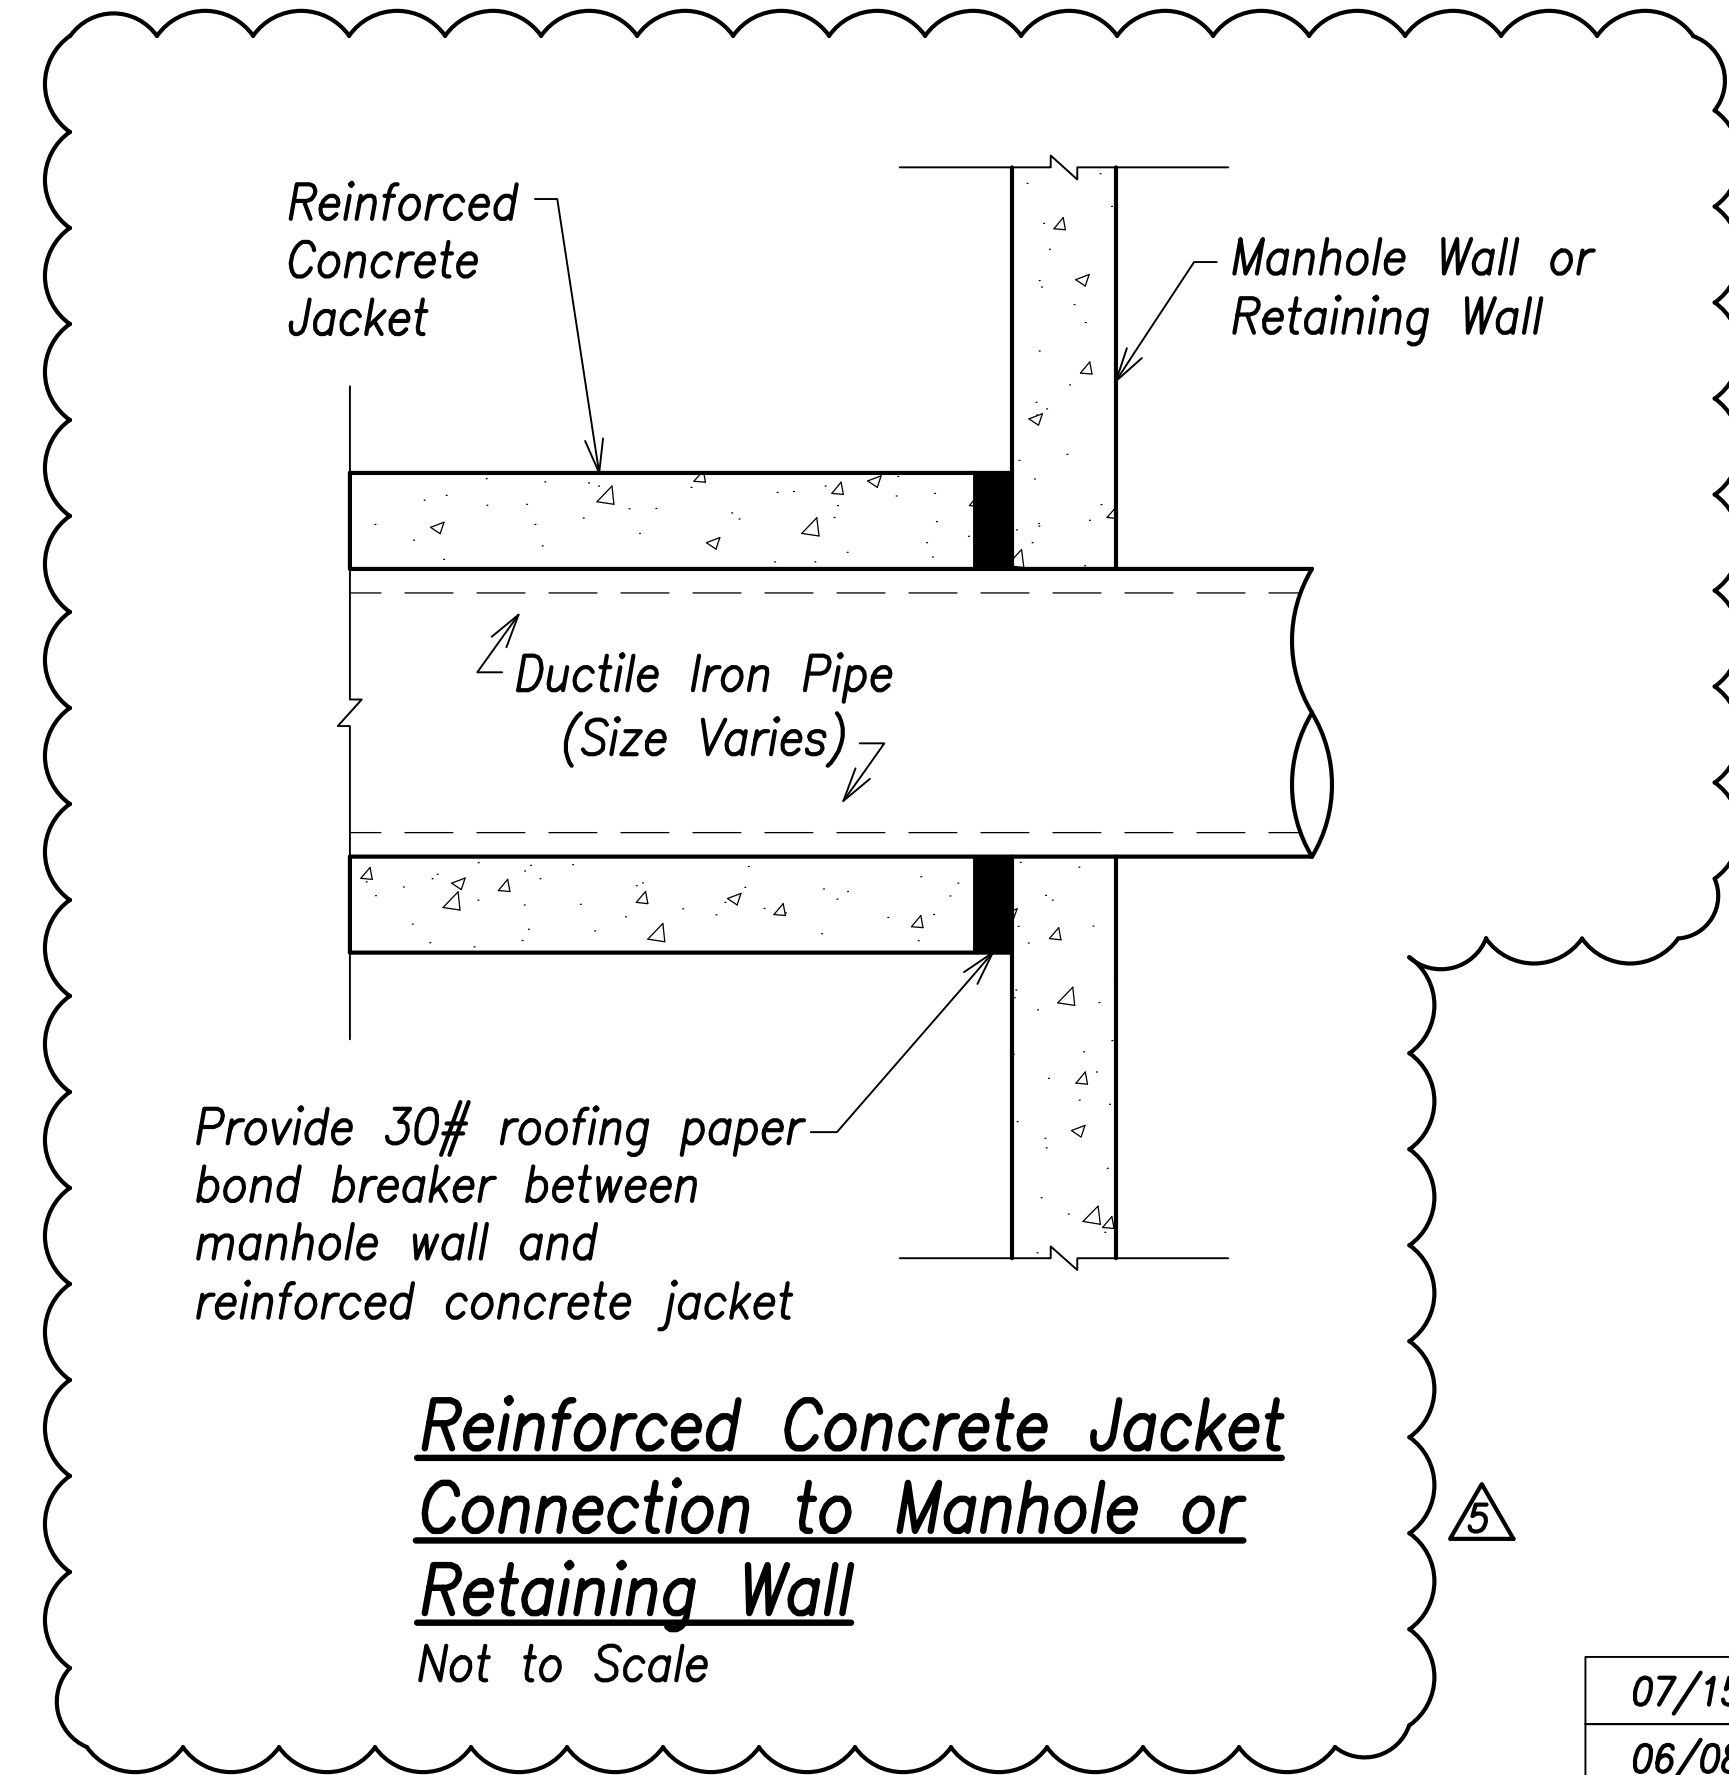

**Reinforced Concrete Jacket Connection to Manhole or Retaining Wall**  
Not to Scale

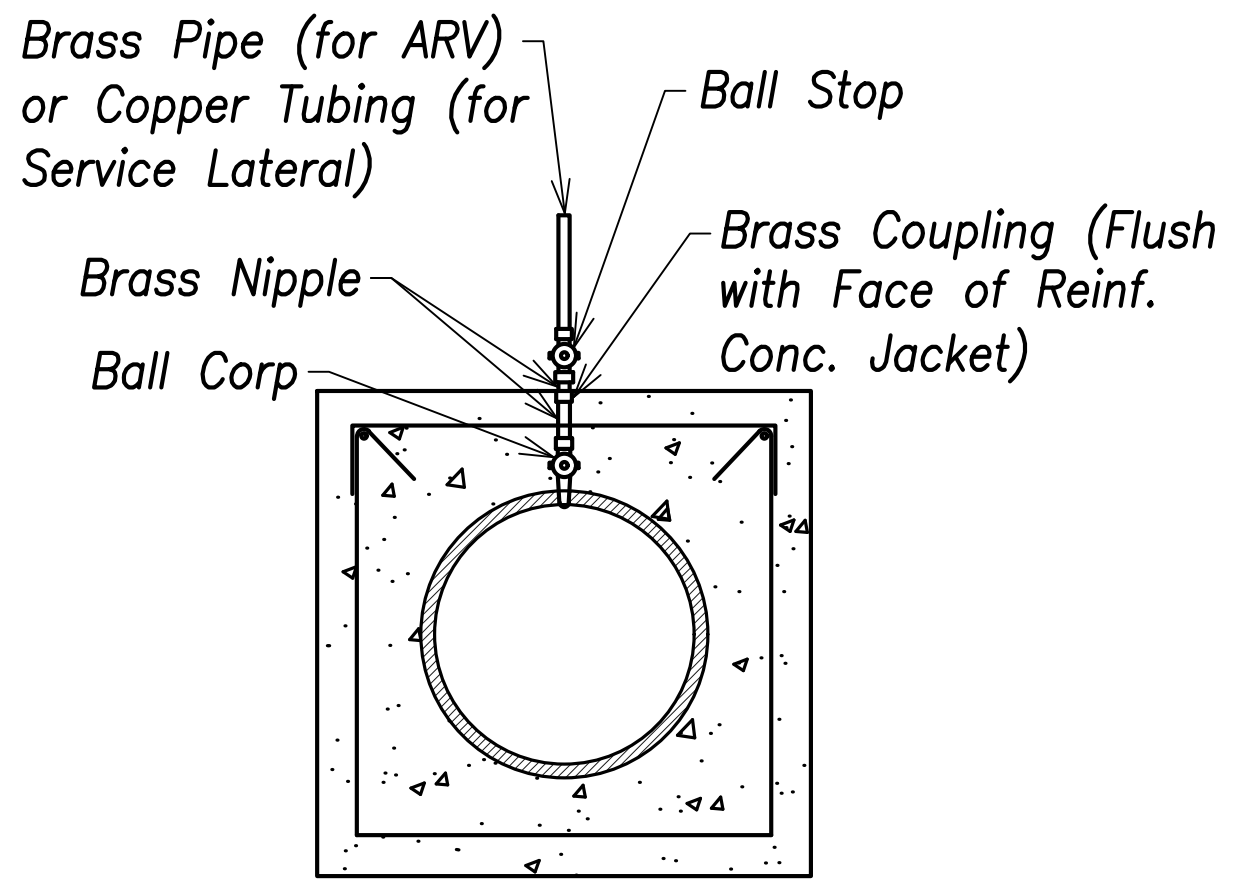

**Service Lateral or ARV Connection Through Reinforced Concrete Detail**  
Not to Scale

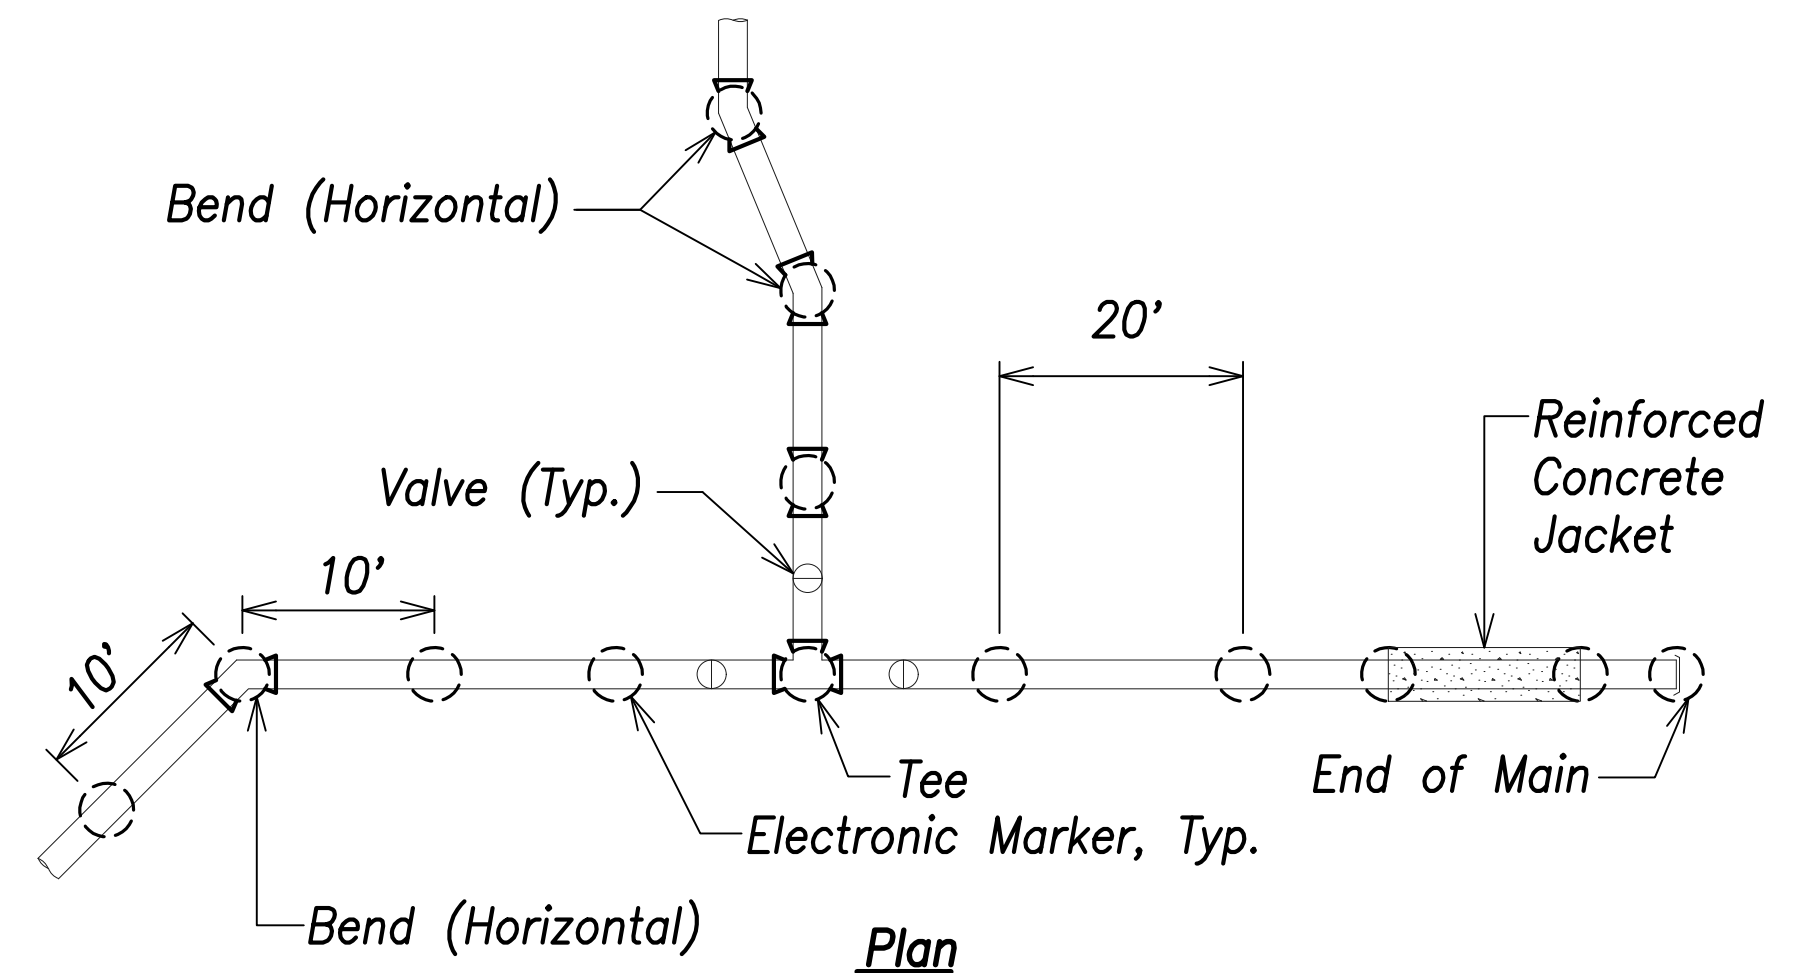

**Notes:**

1. Install electronic marker over center line of pipe at a minimum depth of 2 feet and a maximum depth of 3 feet from finished grade.
2. Install trench backfill and pipe cushion material in accordance to the plans and specifications.
3. Install electronic markers at a minimum clearance of 6-inches, where possible. Install markers above the pipe or concrete jackets.

**Typical Electronic Marker Installation**  
Not to Scale

SURVEY PLOTTED BY	DATE
DRAWN BY	
TRACED BY	
DESIGNED BY	
CHECKED BY	
ORIGINAL PLAN	
NOTE BOOK	
No.	

APPROVED:  
 Manager and Chief Engineer, BWS \_\_\_\_\_ DATE \_\_\_\_\_  
 (for work affecting BWS facilities in City/State R/W & BWS easements only)



THIS WORK WAS PREPARED BY ME OR UNDER MY SUPERVISION AND CONSTRUCTION OF THIS PROJECT WILL BE UNDER MY OBSERVATION.  
 SIGNATURE: \_\_\_\_\_ EXPIRATION DATE OF THE LICENSE: April 30, 2024

07/15/22	Revised details
06/08/22	Revised trench width table
DATE	REVISION


STATE OF HAWAII  
 DEPARTMENT OF TRANSPORTATION  
 HIGHWAYS DIVISION

**Water Details**


FARRINGTON HIGHWAY WIDENING  
 Kapolei Golf Course Road to Fort Weaver Road  
 Project No. 7101A-01-20

Scale: As Shown Date: April 2022


FED. ROAD DIST. NO.	STATE	PROJ. NO.	FISCAL YEAR	SHEET NO.	TOTAL SHEETS
HAWAII	HAW.	7101A-01-20	2021	209	767

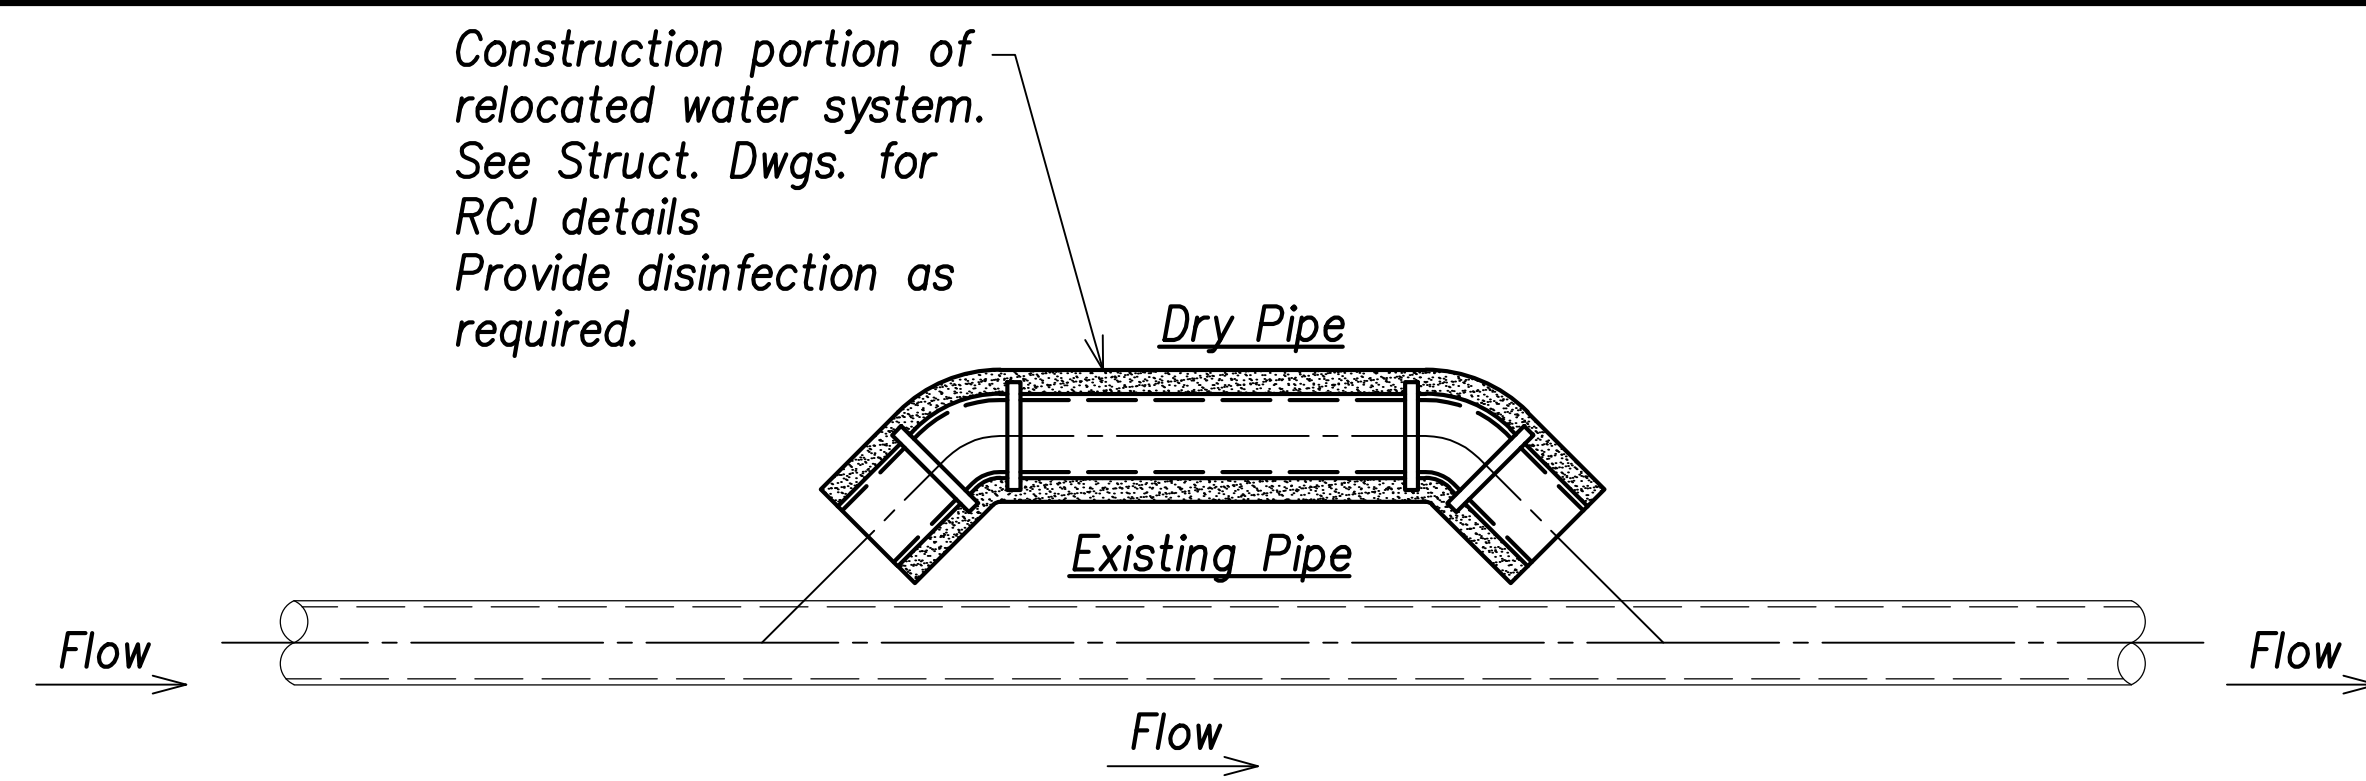


**Step 1: Construct Portion of Relocated Water System and Chlorinate**

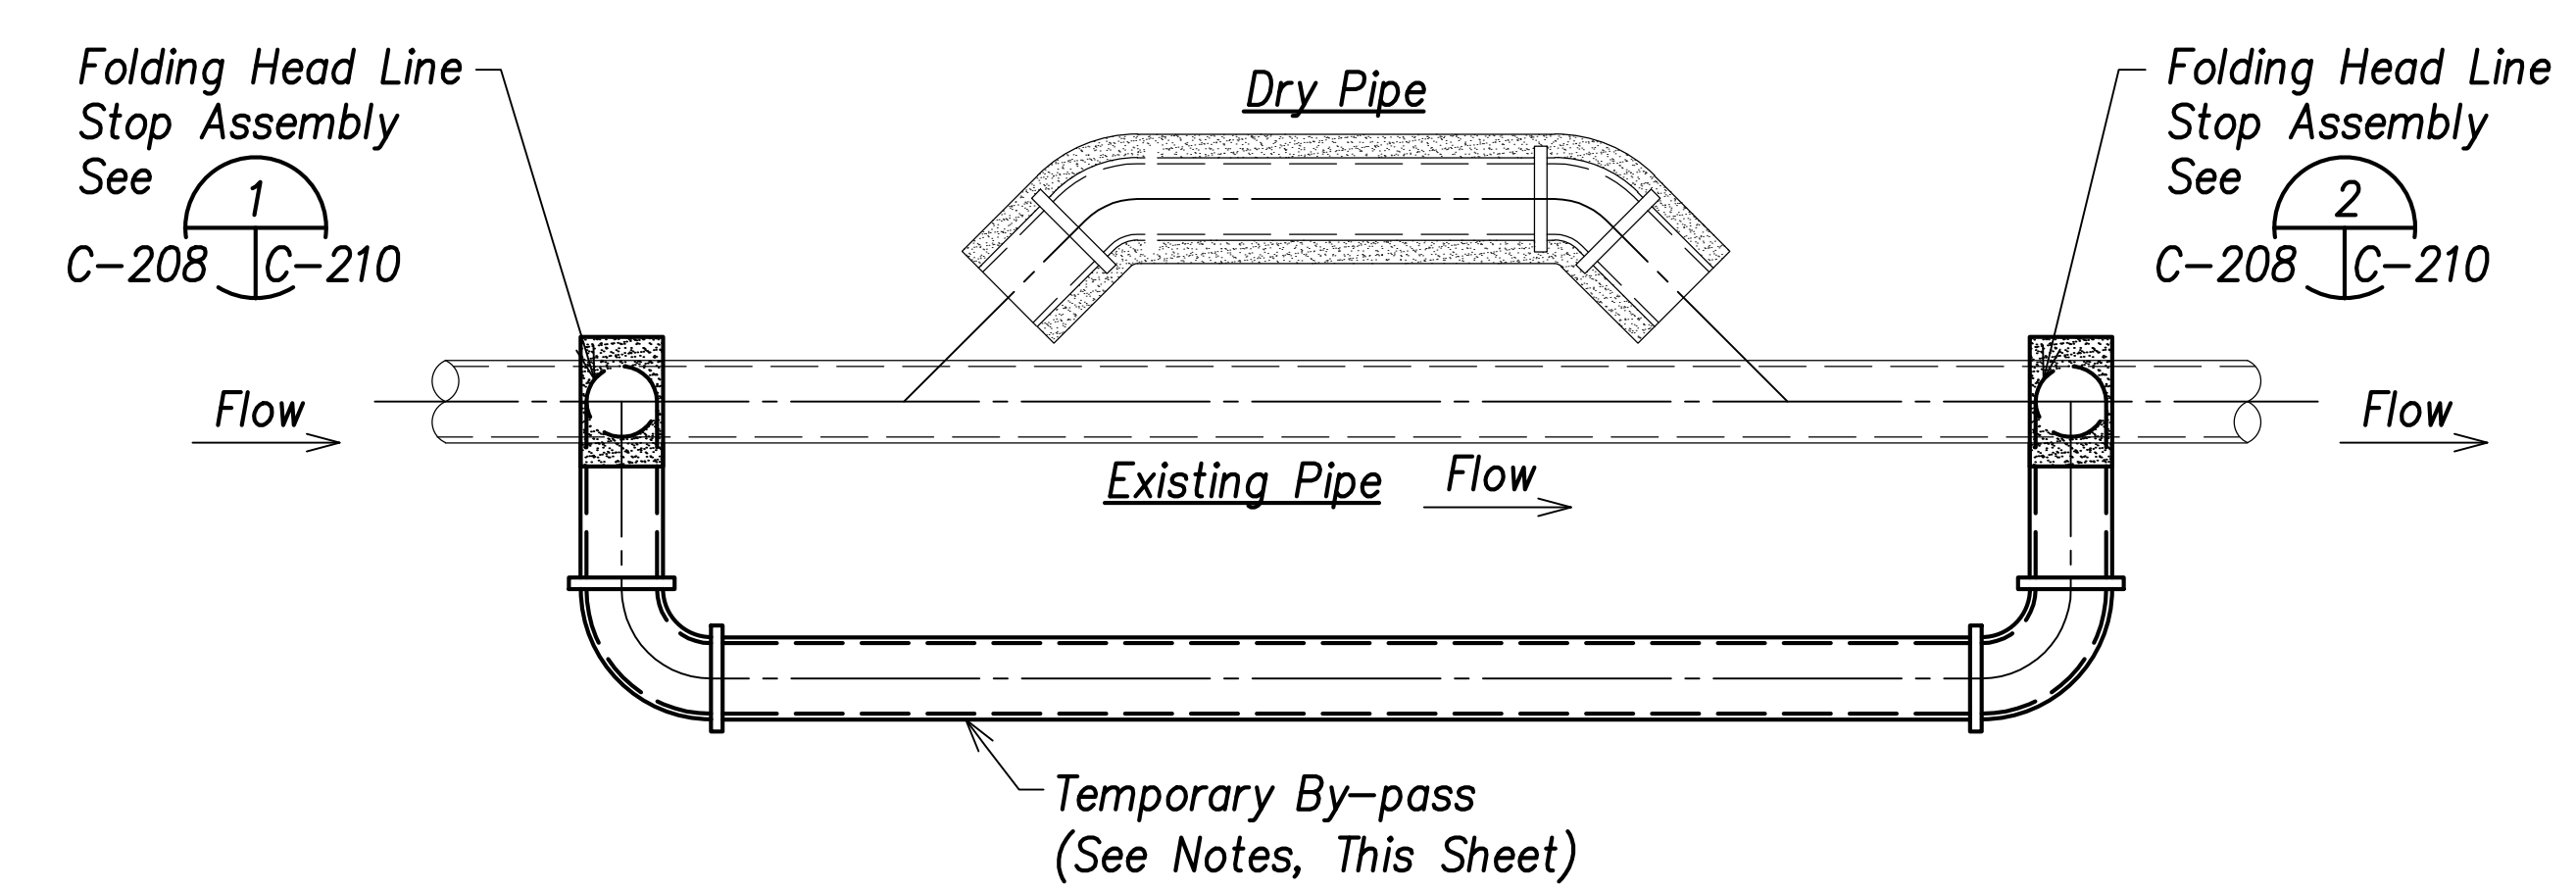

**Step 2: Construct Folding Head Line Stop Assembly and Temporary By-pass**

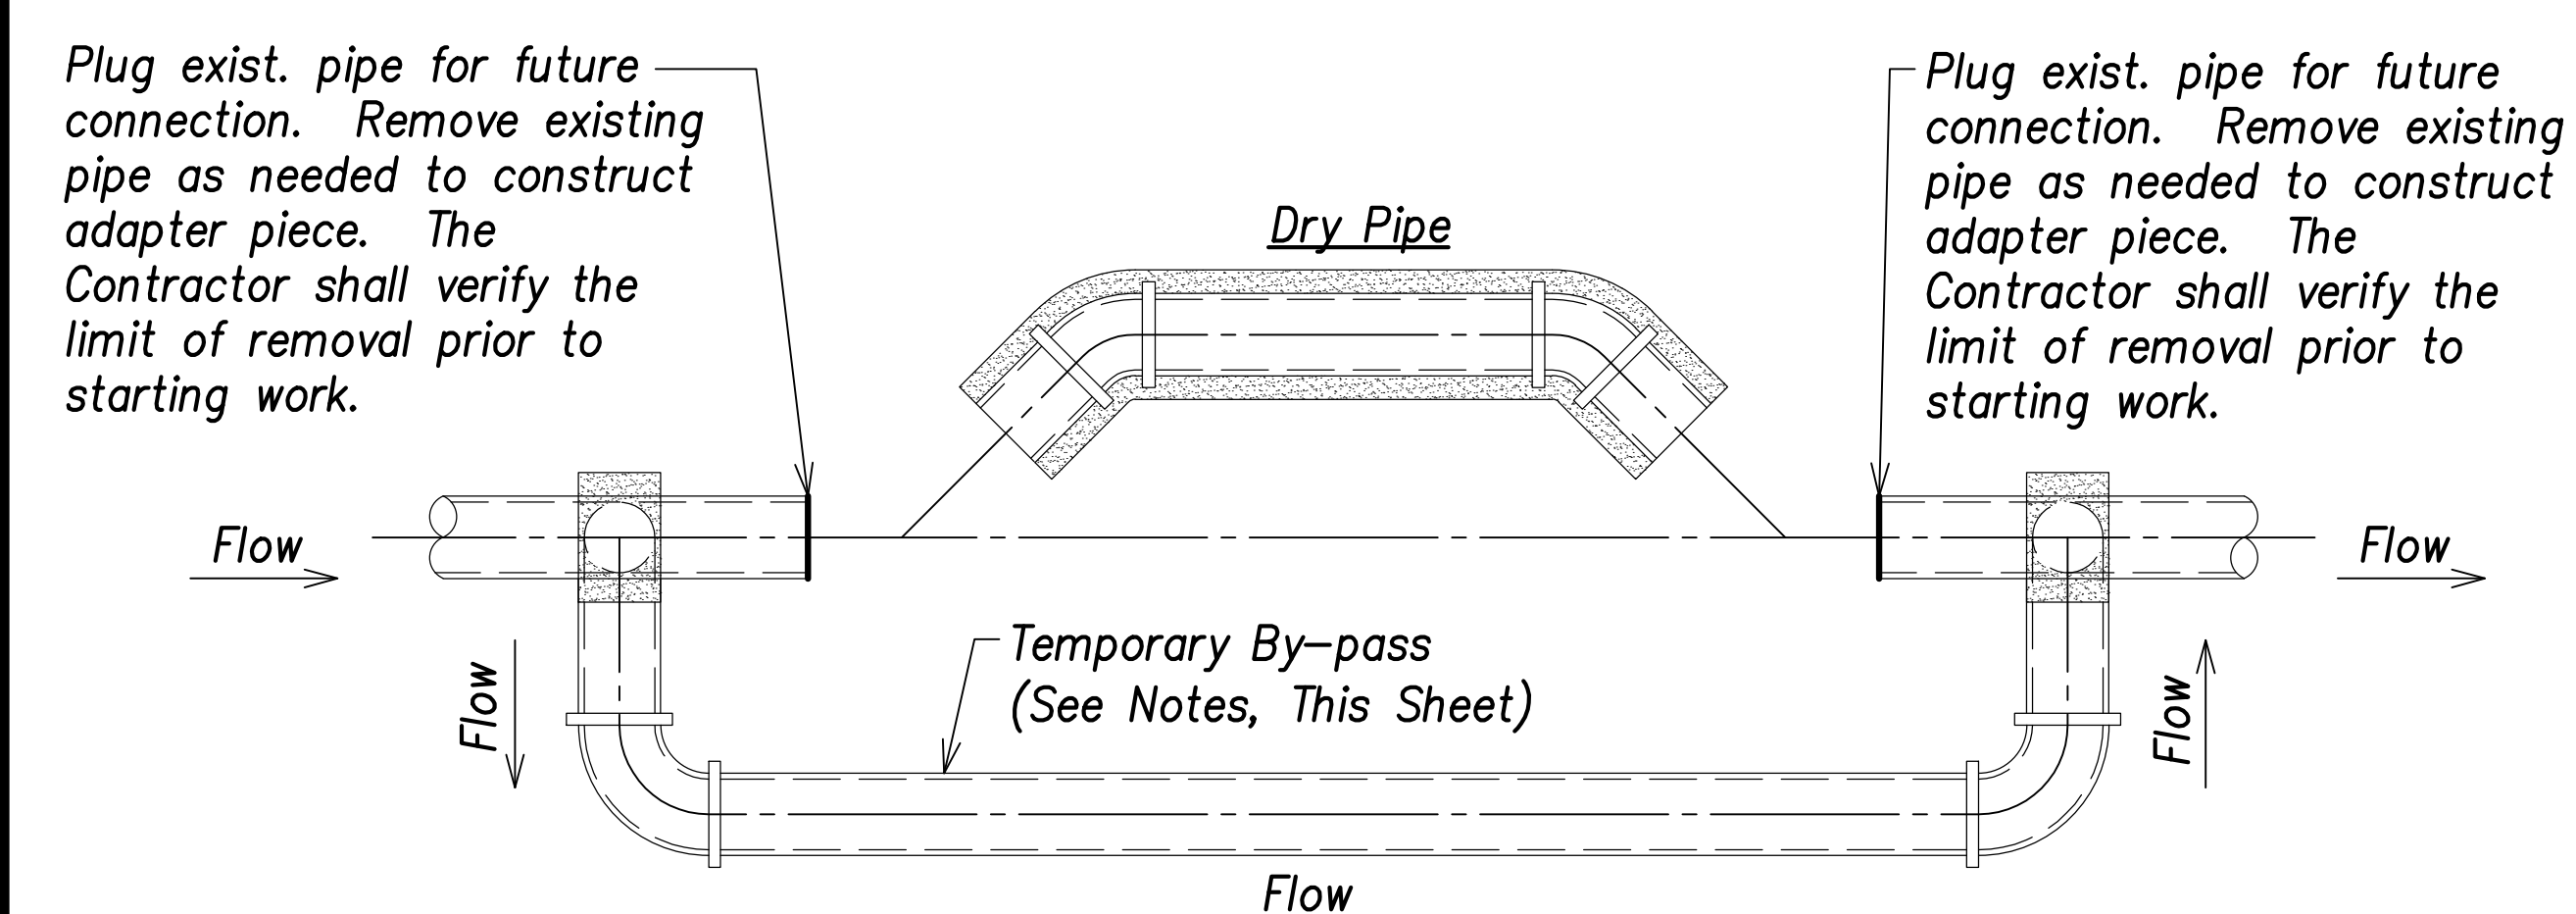

**Step 3: Divert Flow to Temporary By-Pass and Demolish and Remove Portions of the Existing Water System as Required to Construct the Waterline Connection**

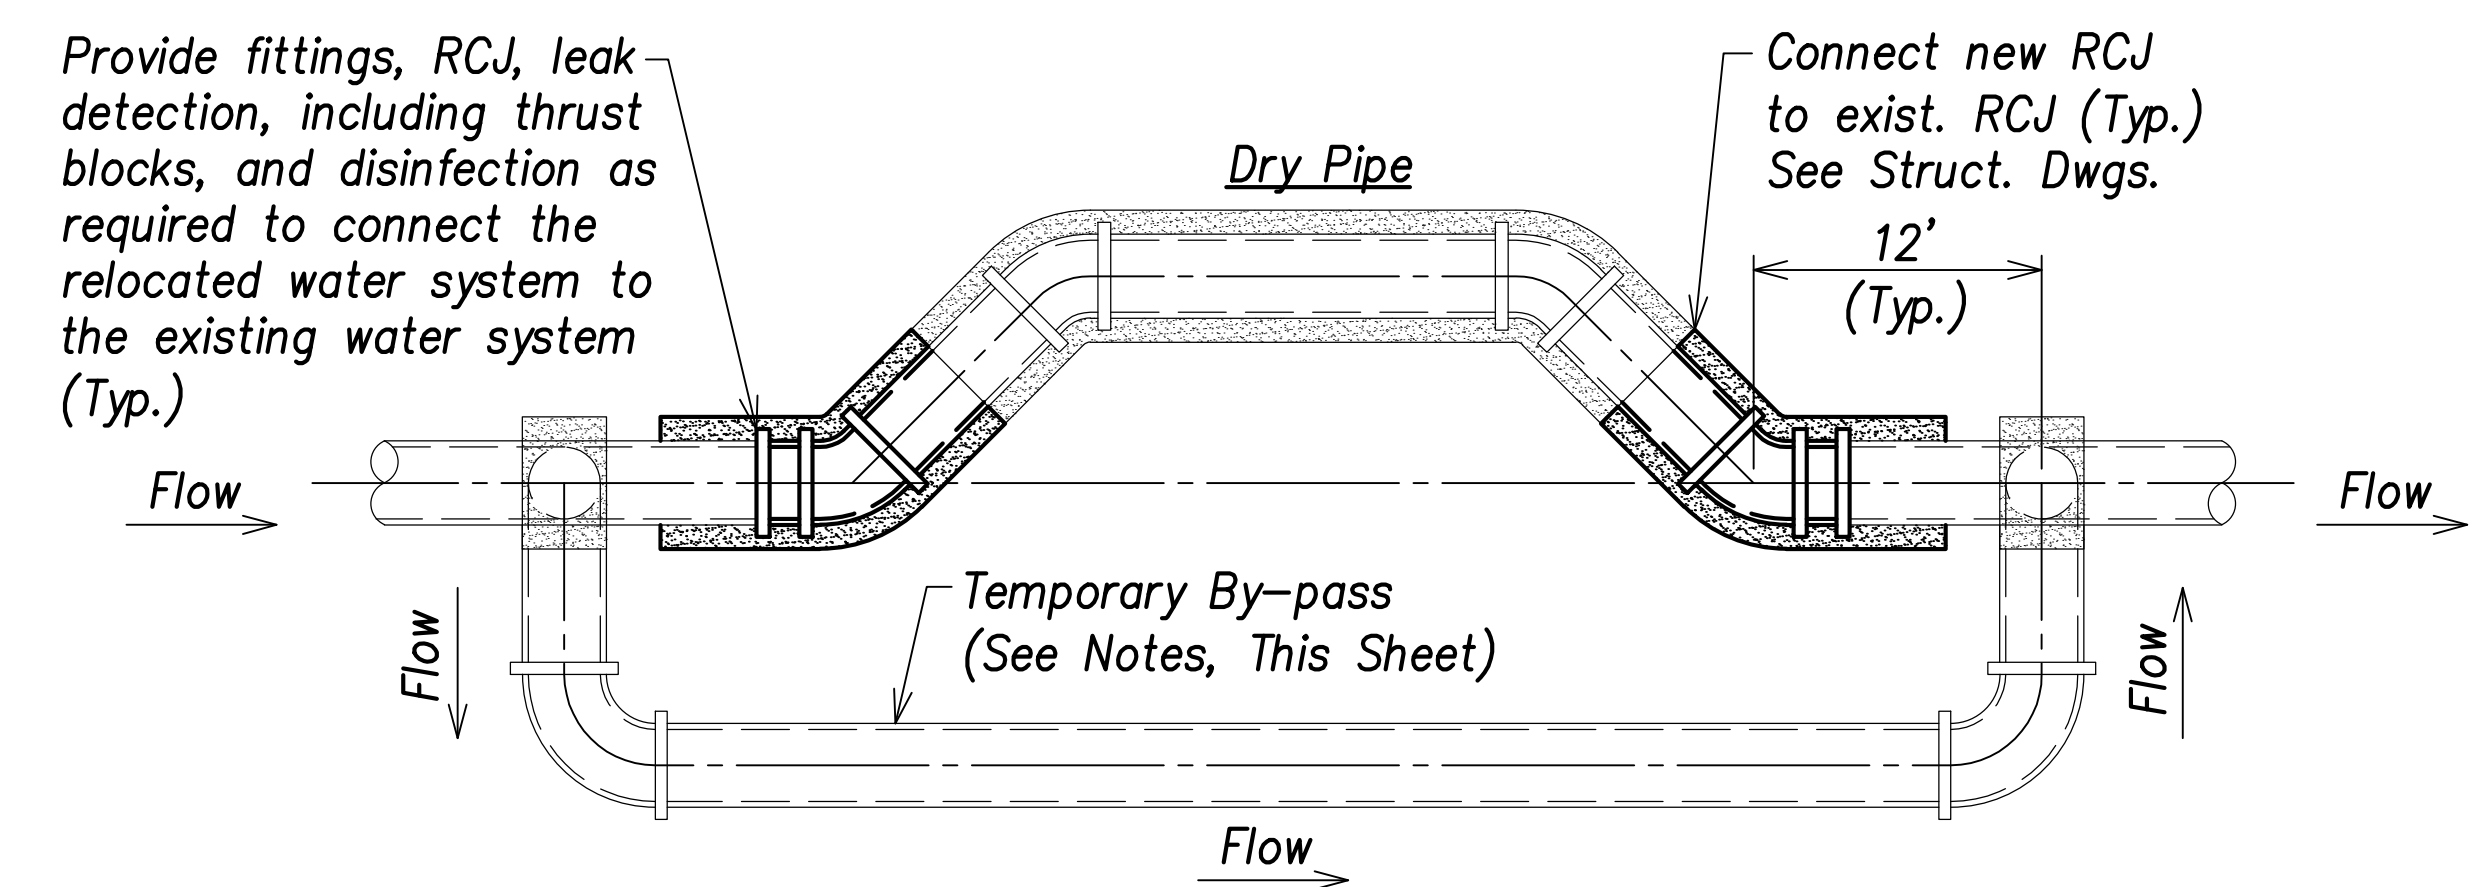

**Step 4: Connect Relocated Water System to Existing Water System**

**Typical Temporary By-Pass Procedure (Step 1 to Step 4)**  
Not to Scale

- Temporary By-pass Notes:**
- All pipes and fittings shall be Ductile Iron Pipe, Cl. 53, Fl.
  - When shutting down or opening water flow in pipe, the Contractor shall slowly close valve at a rate of 6" of diameter per minute to avoid any abrupt water flow stoppage or opening and resulting water hammer effect. The closure of the valve shall be monitored by the Board of Water Supply. The Contractor shall be responsible for any damages to the water system and impacts to the regional water system if the water system is not shut down slowly and any damages arise due to the Contractor's carelessness.
  - Contractor shall provide Atlas 350 Post Shores or approved equal to support the temporary by-pass throughout construction.
  - The water pipe velocities are critical to the construction of the temporary water system. The Contractor shall construct and remove the temporary water system folding head line stop assembly during the period of low water system use between the hours of midnight to 4:00 A.M.
  - Construction of the additional reinforced concrete jacket to connect the existing reinforced concrete jacket and concrete support block shall be incidental to the temporary bypass work.
  - The Contractor shall provide shop drawings for the by-pass procedures, including the proposed means and methods for connections and chlorination.

SURVEY PLOTTED BY	DATE
DRAWN BY	
TRACED BY	
DESIGNED BY	
CHECKED BY	
ORIGINAL PLAN	
NOTE BOOK	
No.	

APPROVED:  
 Manager and Chief Engineer, BWS  
 (for work affecting BWS facilities in City/State R/W & BWS easements only)

DATE



THIS WORK WAS PREPARED BY ME OR UNDER MY SUPERVISION AND CONSTRUCTION OF THIS PROJECT WILL BE UNDER MY OBSERVATION.

Signature: *Craig W. Luke*  
 EXPIRATION DATE OF THE LICENSE: April 30, 2024

DATE	REVISION
07/15/22	Revised Notes
06/08/22	Note Added


STATE OF HAWAII  
 DEPARTMENT OF TRANSPORTATION  
 HIGHWAYS DIVISION

**Typical Temporary By-Pass Procedures (Step 1 to Step 4)**  
 FARRINGTON HIGHWAY WIDENING  
 Kapolei Golf Course Road to Fort Weaver Road  
 Project No. 7101A-01-20


Scale: As Shown Date: April 2022

SHEET No. C-208 OF 767 SHEETS


FED. ROAD DIST. NO.	STATE	PROJ. NO.	FISCAL YEAR	SHEET NO.	TOTAL SHEETS
HAWAII	HAW.	7101A-01-20	2021	210	767

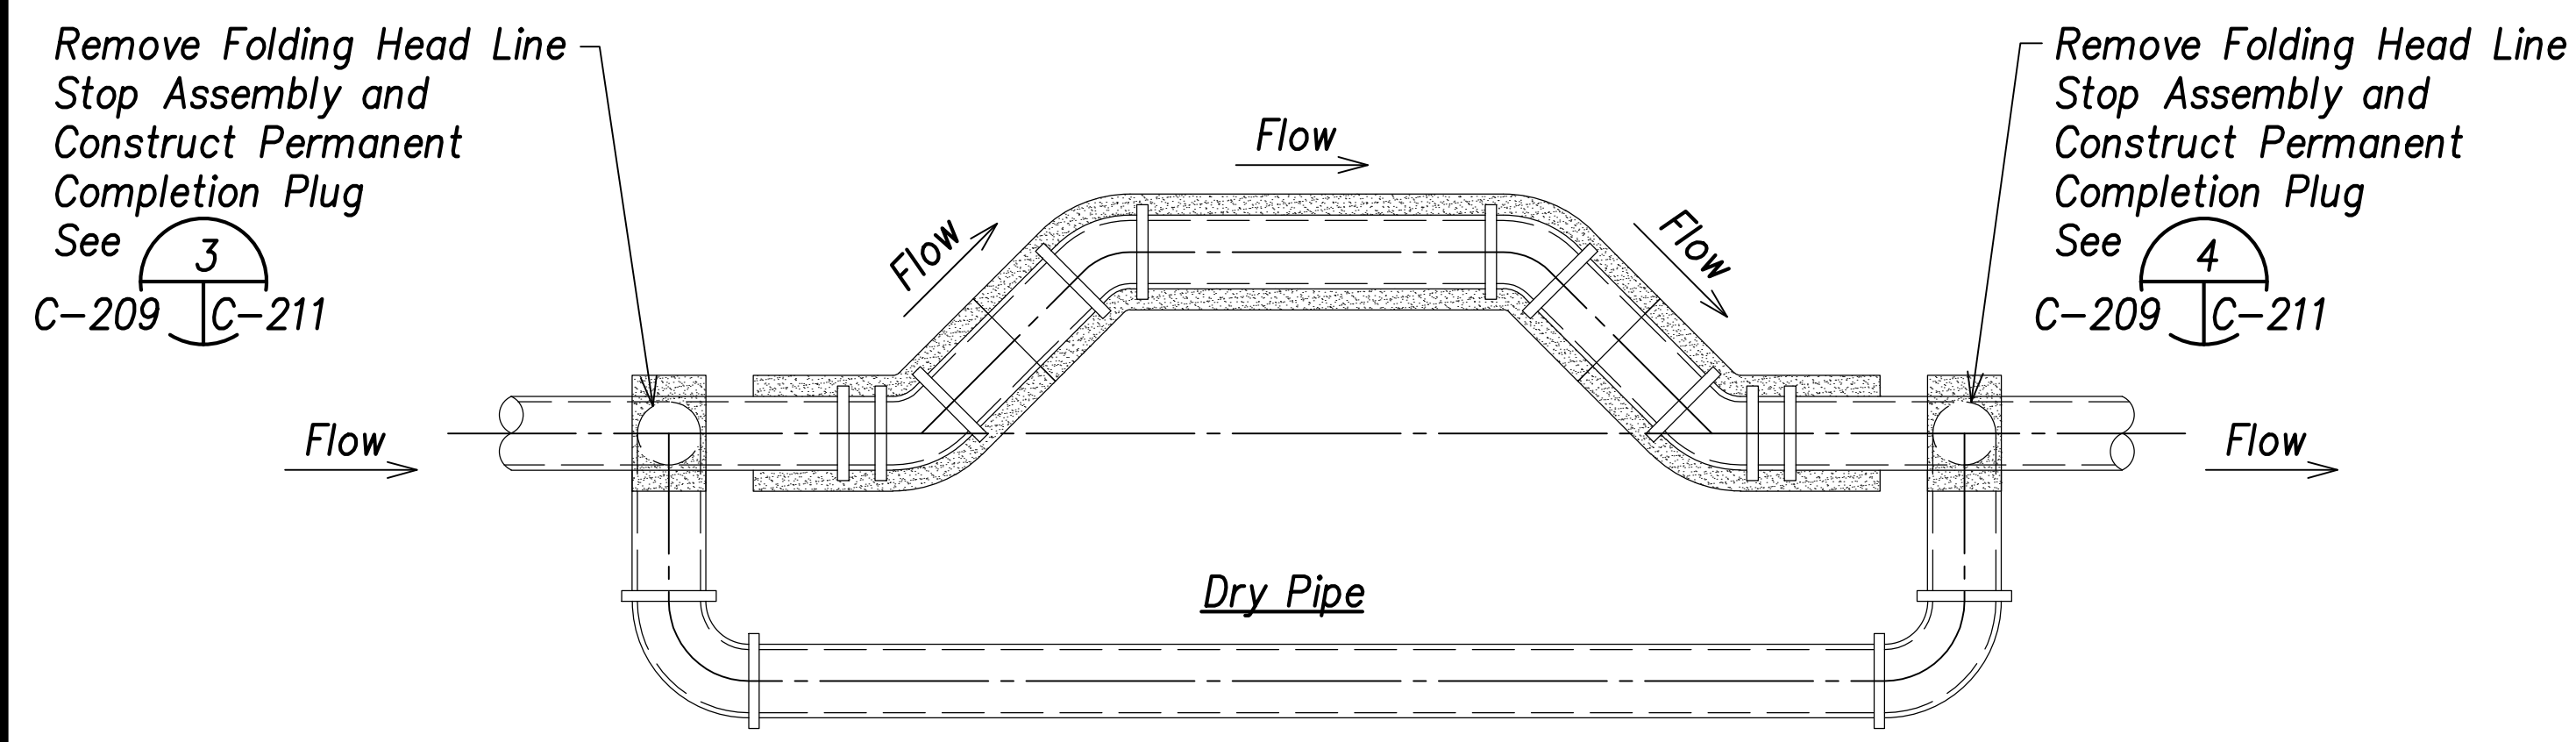

**Step 5: Divert Flow to Relocated Waterline, Remove Folding Head Line Stop Assembly, and Construct Permanent Completion Plug**

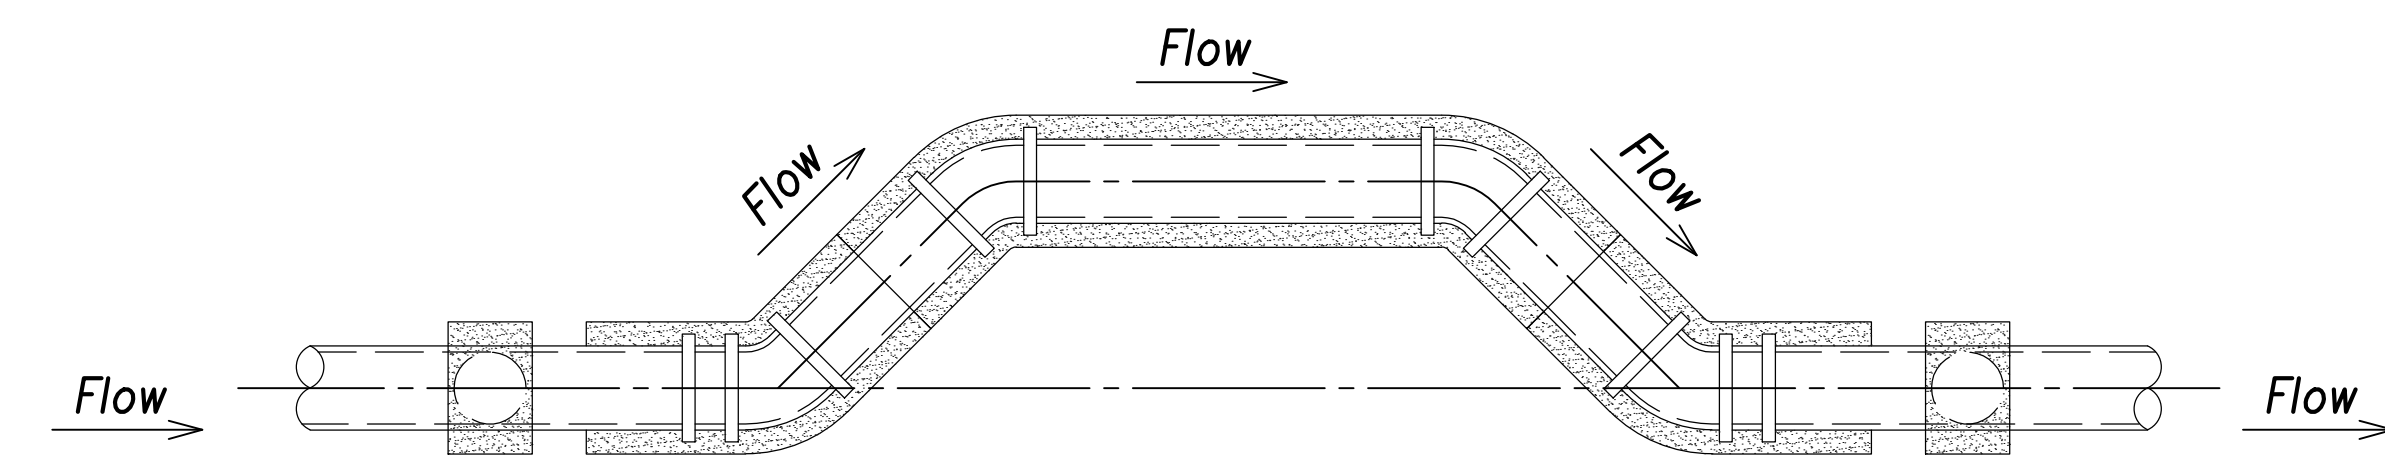

**Step 6: Remove Temporary By-Pass**

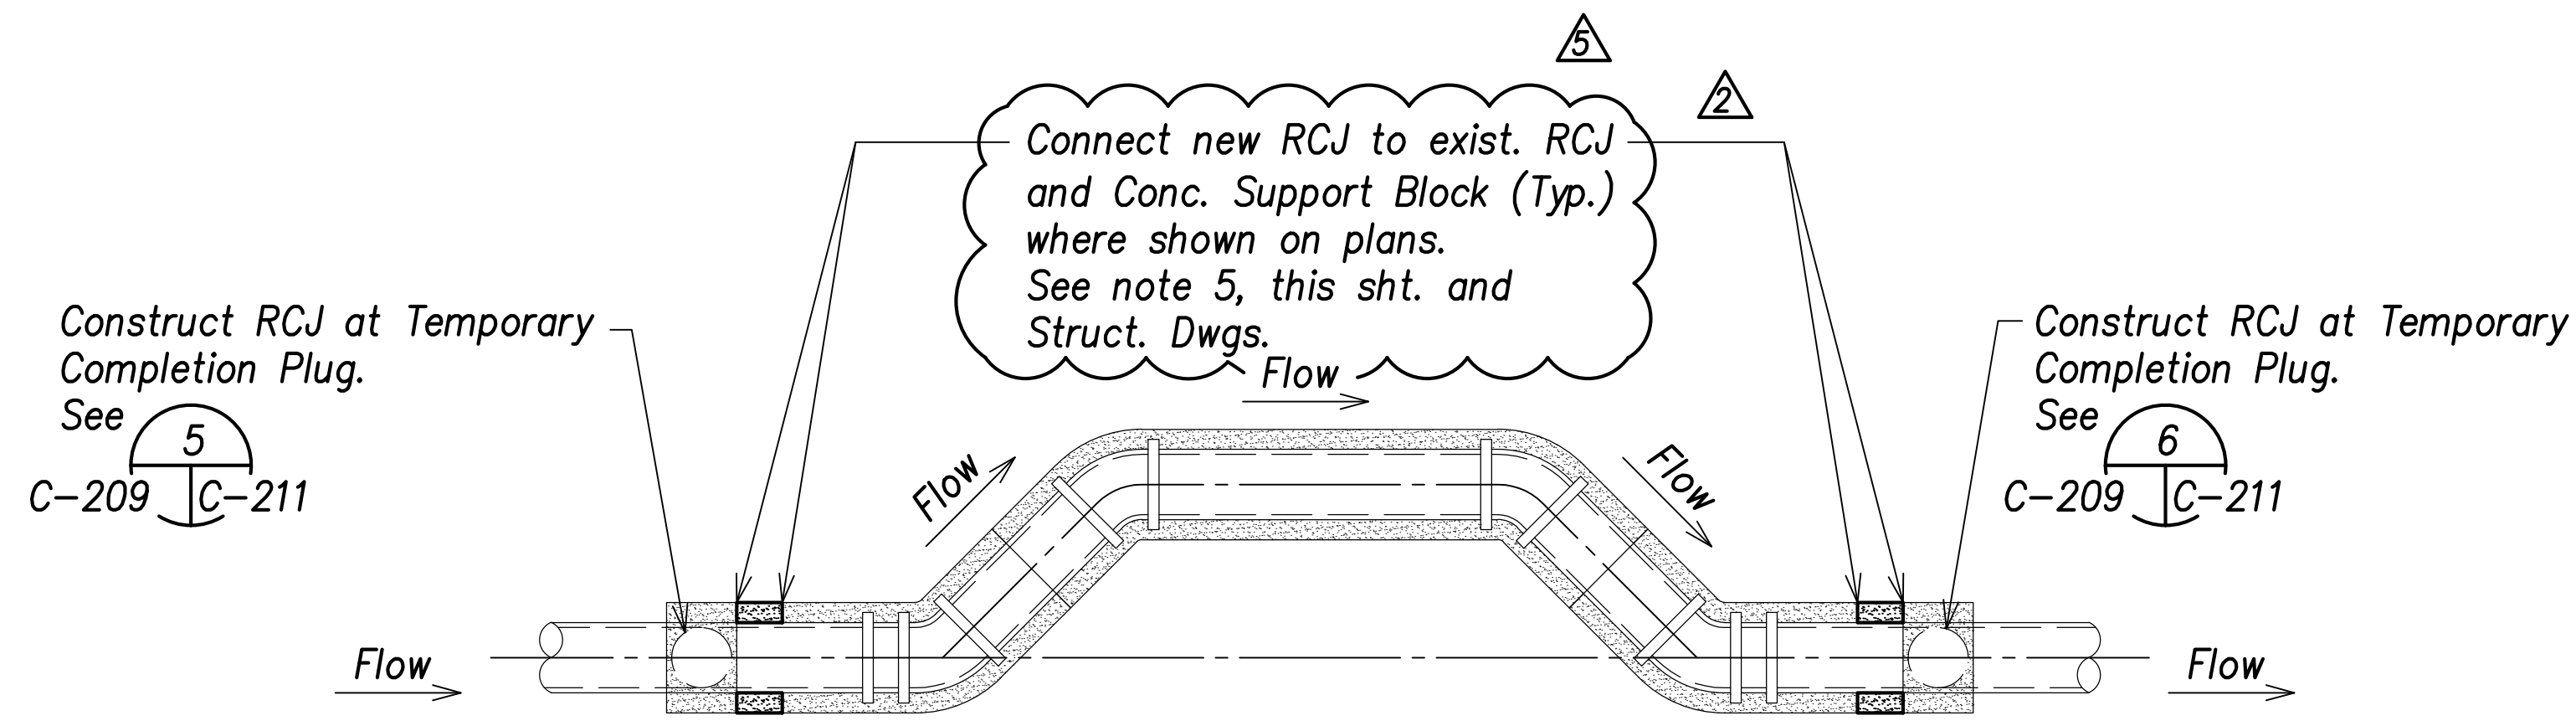

**Step 7: Construct RCJ at Permanent Completion Plug**

**Typical Temporary By-Pass Procedure (Step 5 to Step 7)**

Not to Scale

**Temporary By-pass Notes:**

- All pipes and fittings shall be Ductile Iron Pipe, Cl. 53, FI.
- When shutting down or opening water flow in pipe, the Contractor shall slowly close valve at a rate of 6" of diameter per minute to avoid any abrupt water flow stoppage or opening and resulting water hammer effect. The closure of the valve shall be monitored by the Board of Water Supply. The Contractor shall be responsible for any damages to the water system and impacts to the regional water system if the water system is not shut down slowly and any damages arise due to the Contractor's carelessness.
- Contractor shall provide Atlas 350 Post Shores or approved equal to support the temporary by-pass throughout construction.
- The water pipe velocities are critical to the construction of the temporary water system. The Contractor shall construct and remove the temporary water system folding head line stop assembly during the period of low water system use between the hours of midnight to 4:00 A.M.
- Construction of the additional reinforced concrete jacket to connect the existing reinforced concrete jacket and concrete support block shall be incidental to the temporary bypass work.
- The Contractor shall provide shop drawings for the by-pass procedures, including the proposed means and methods for connections and chlorination.

SURVEY PLOTTED BY	DATE
DRAWN BY	
TRACED BY	
DESIGNED BY	
CHECKED BY	
ORIGINAL PLAN	
NOTE BOOK	
No.	

APPROVED: \_\_\_\_\_ DATE \_\_\_\_\_  
 Manager and Chief Engineer, BWS  
 (for work affecting BWS facilities in  
 City/State R/W & BWS easements only)





**CRAIG W. L. LUKE**  
 LICENSED PROFESSIONAL ENGINEER  
 No. 6935-C  
 HAWAII, U.S.A.  
 THIS WORK WAS PREPARED BY ME OR UNDER MY SUPERVISION AND CONSTRUCTION OF THIS PROJECT WILL BE UNDER MY OBSERVATION.  
 SIGNATURE: \_\_\_\_\_ EXPIRATION DATE OF THE LICENSE: April 30, 2024

07/15/22	Revised callout; Revised Notes
06/08/22	Notes Added; Revised callout
DATE	REVISION

STATE OF HAWAII  
 DEPARTMENT OF TRANSPORTATION  
 HIGHWAYS DIVISION  
**Typical Temporary By-Pass Procedures (Step 5 to Step 7)**  
 FARRINGTON HIGHWAY WIDENING  
 Kapolei Golf Course Road to Fort Weaver Road  
 Project No. 7101A-01-20



FED. ROAD DIST. NO.	STATE	PROJ. NO.	FISCAL YEAR	SHEET NO.	TOTAL SHEETS
HAWAII	HAW.	7101A-01-20	2021	211	767

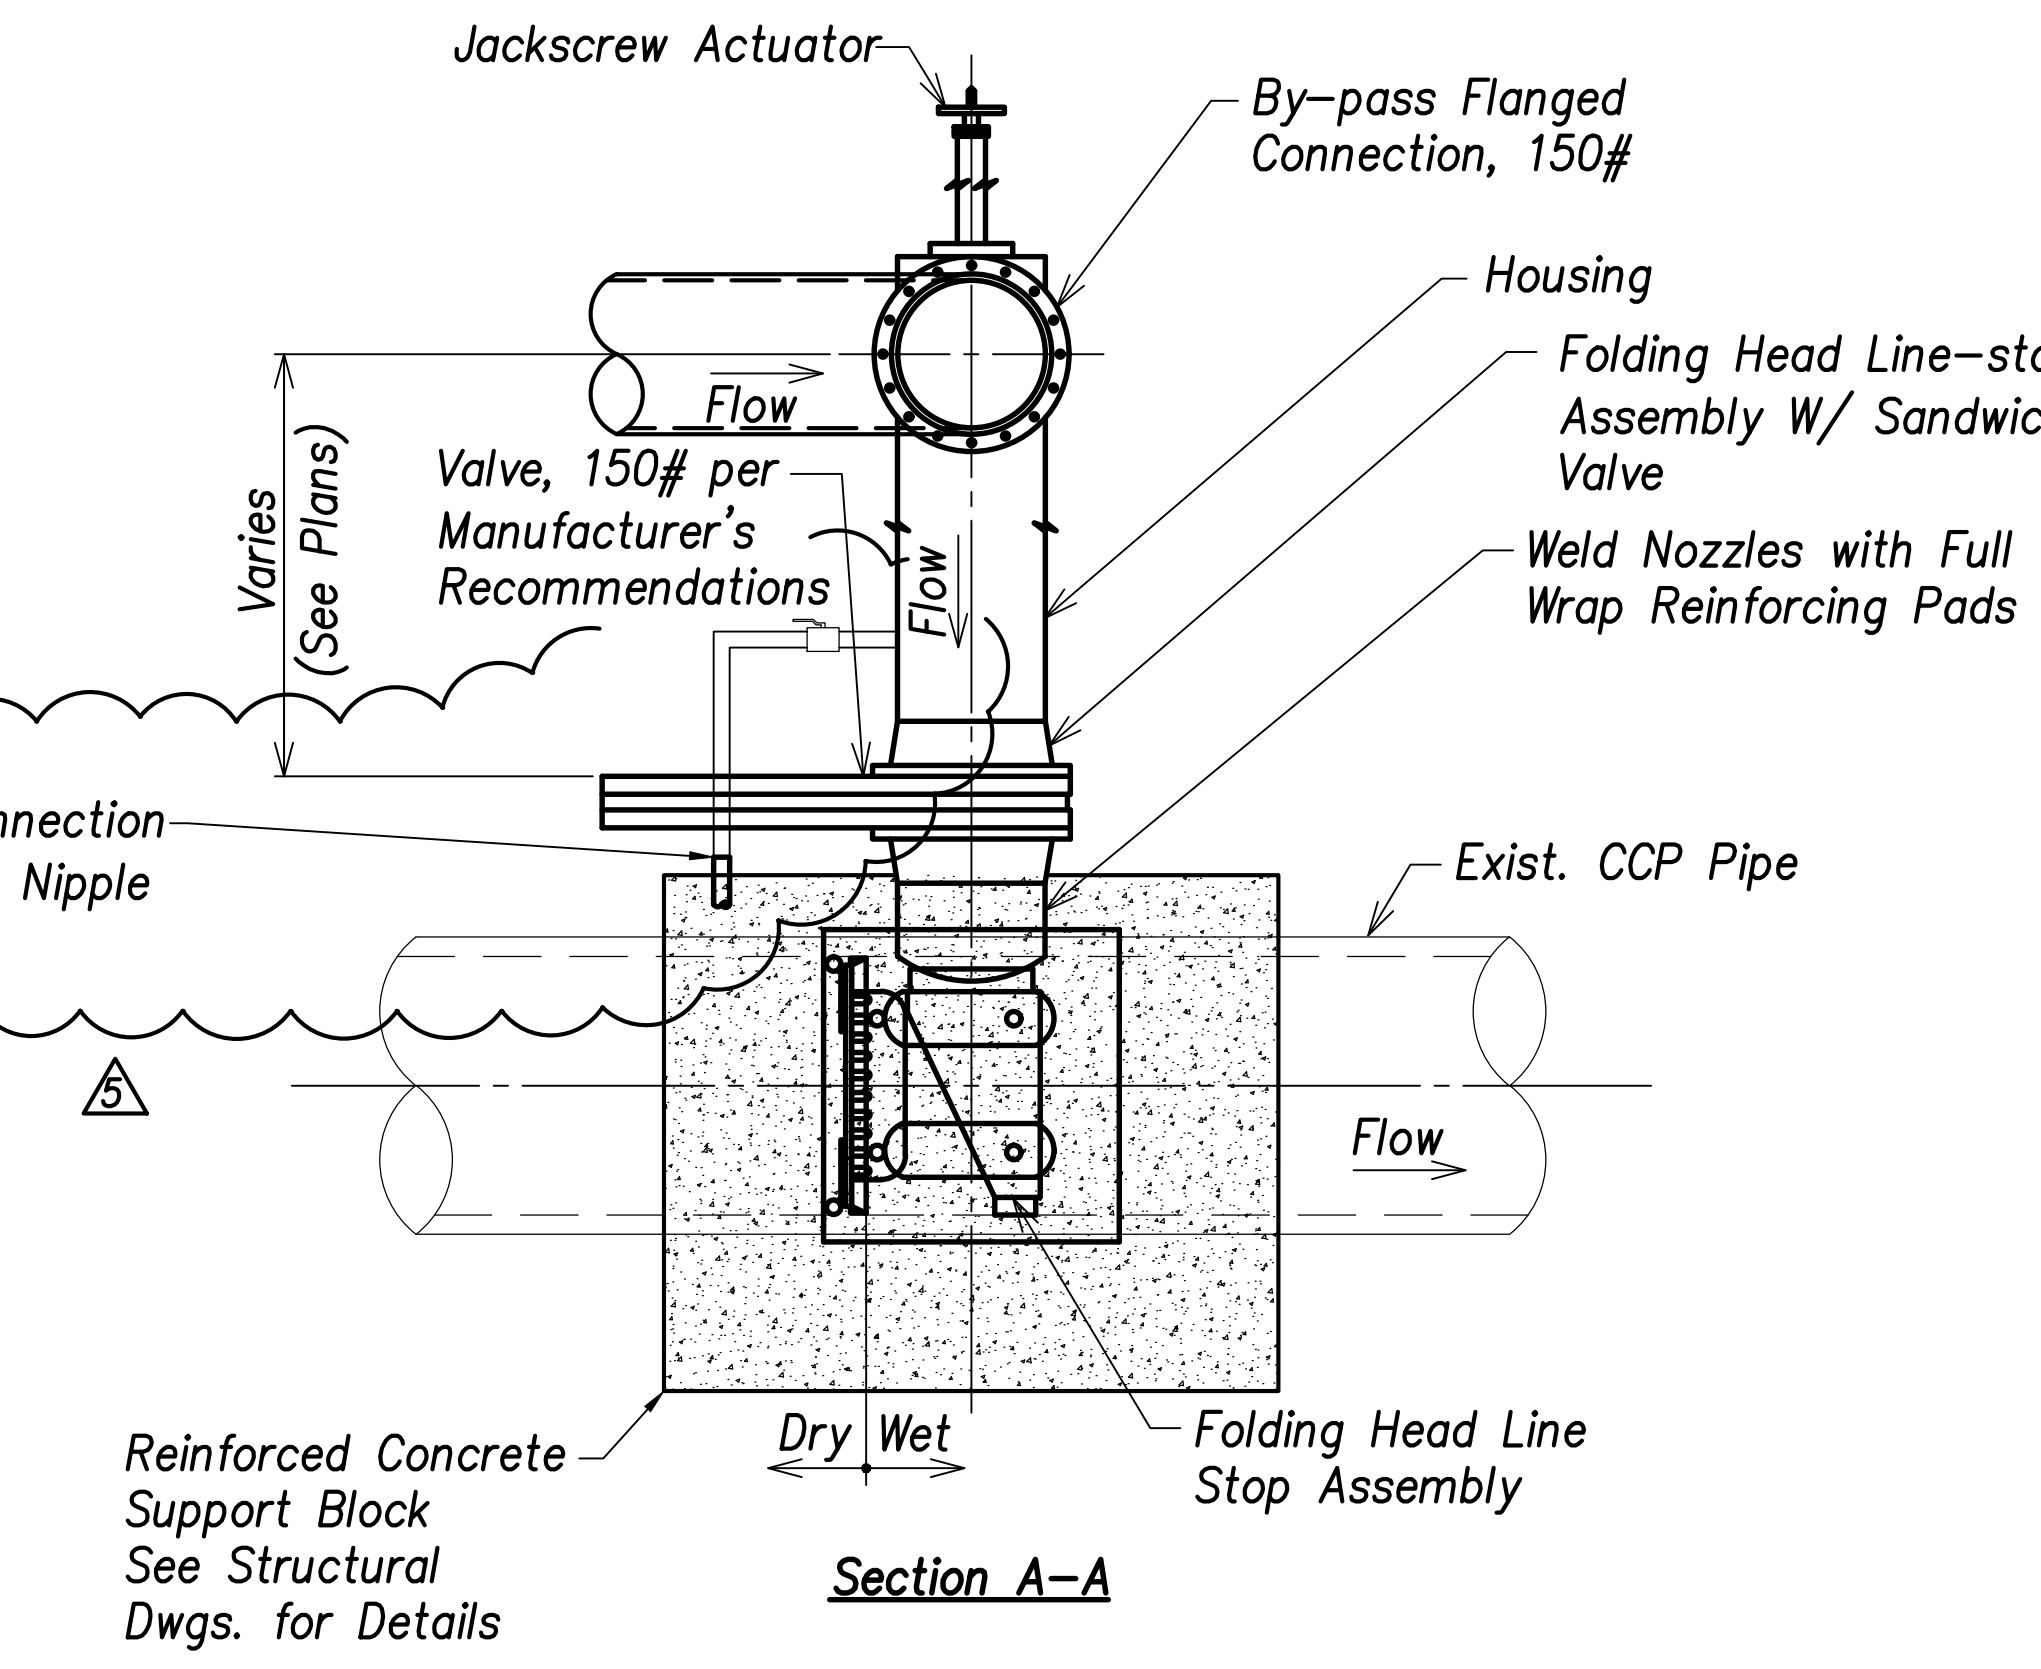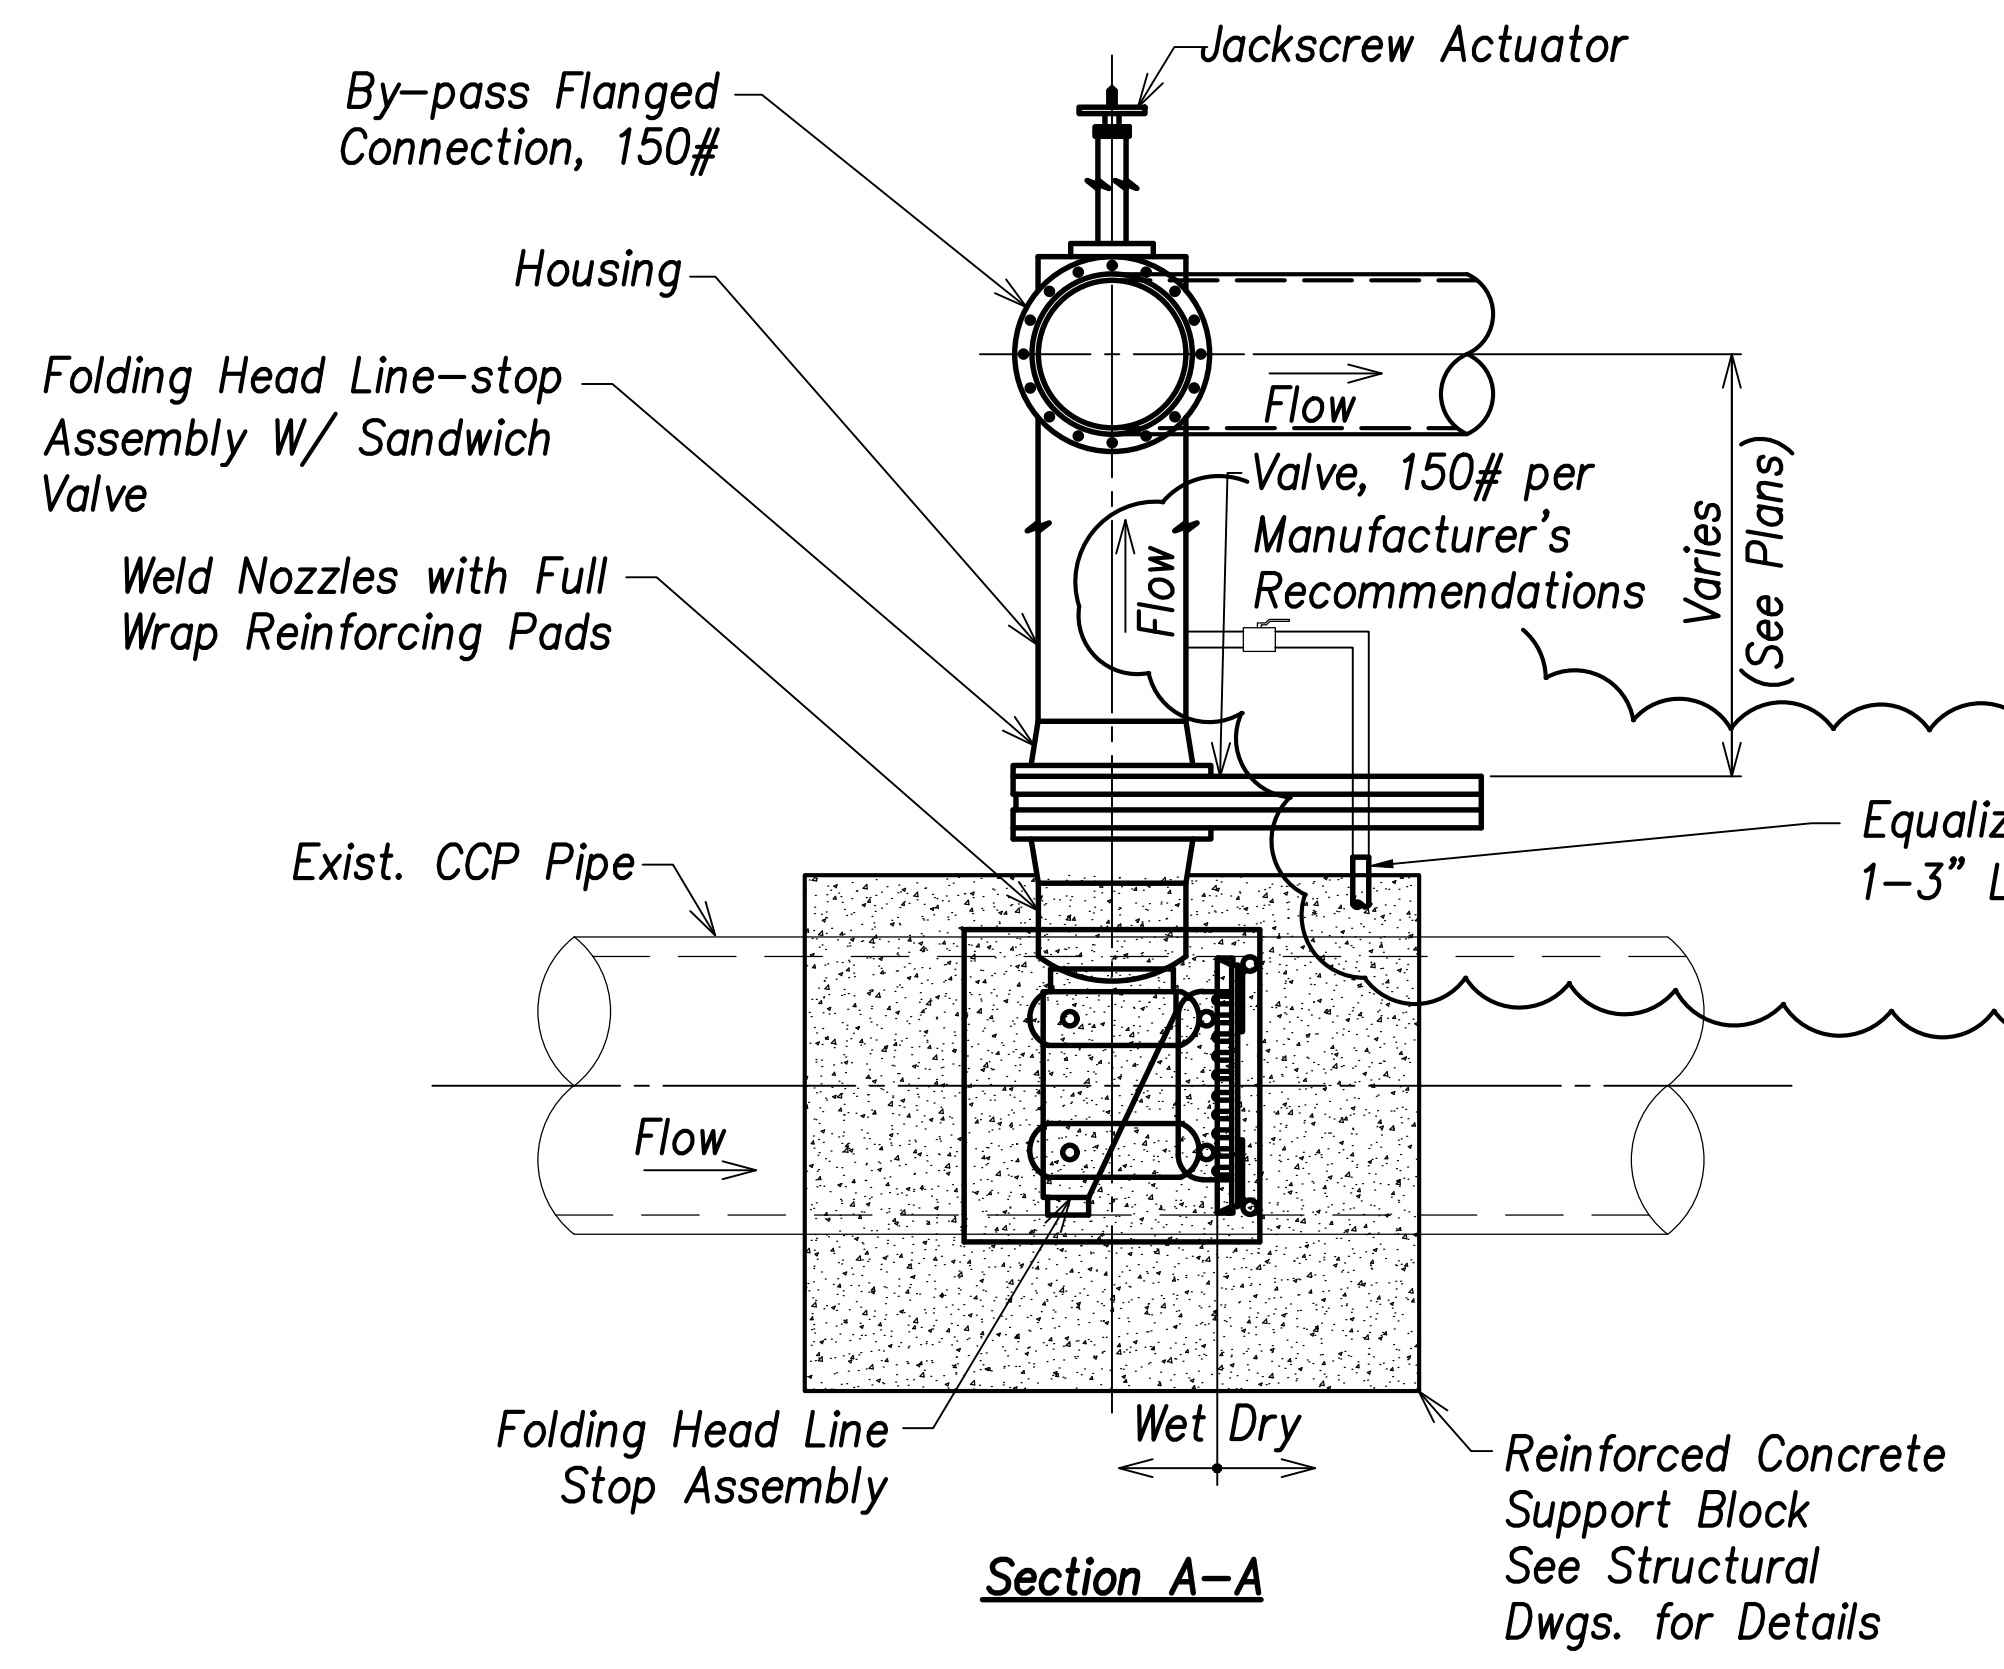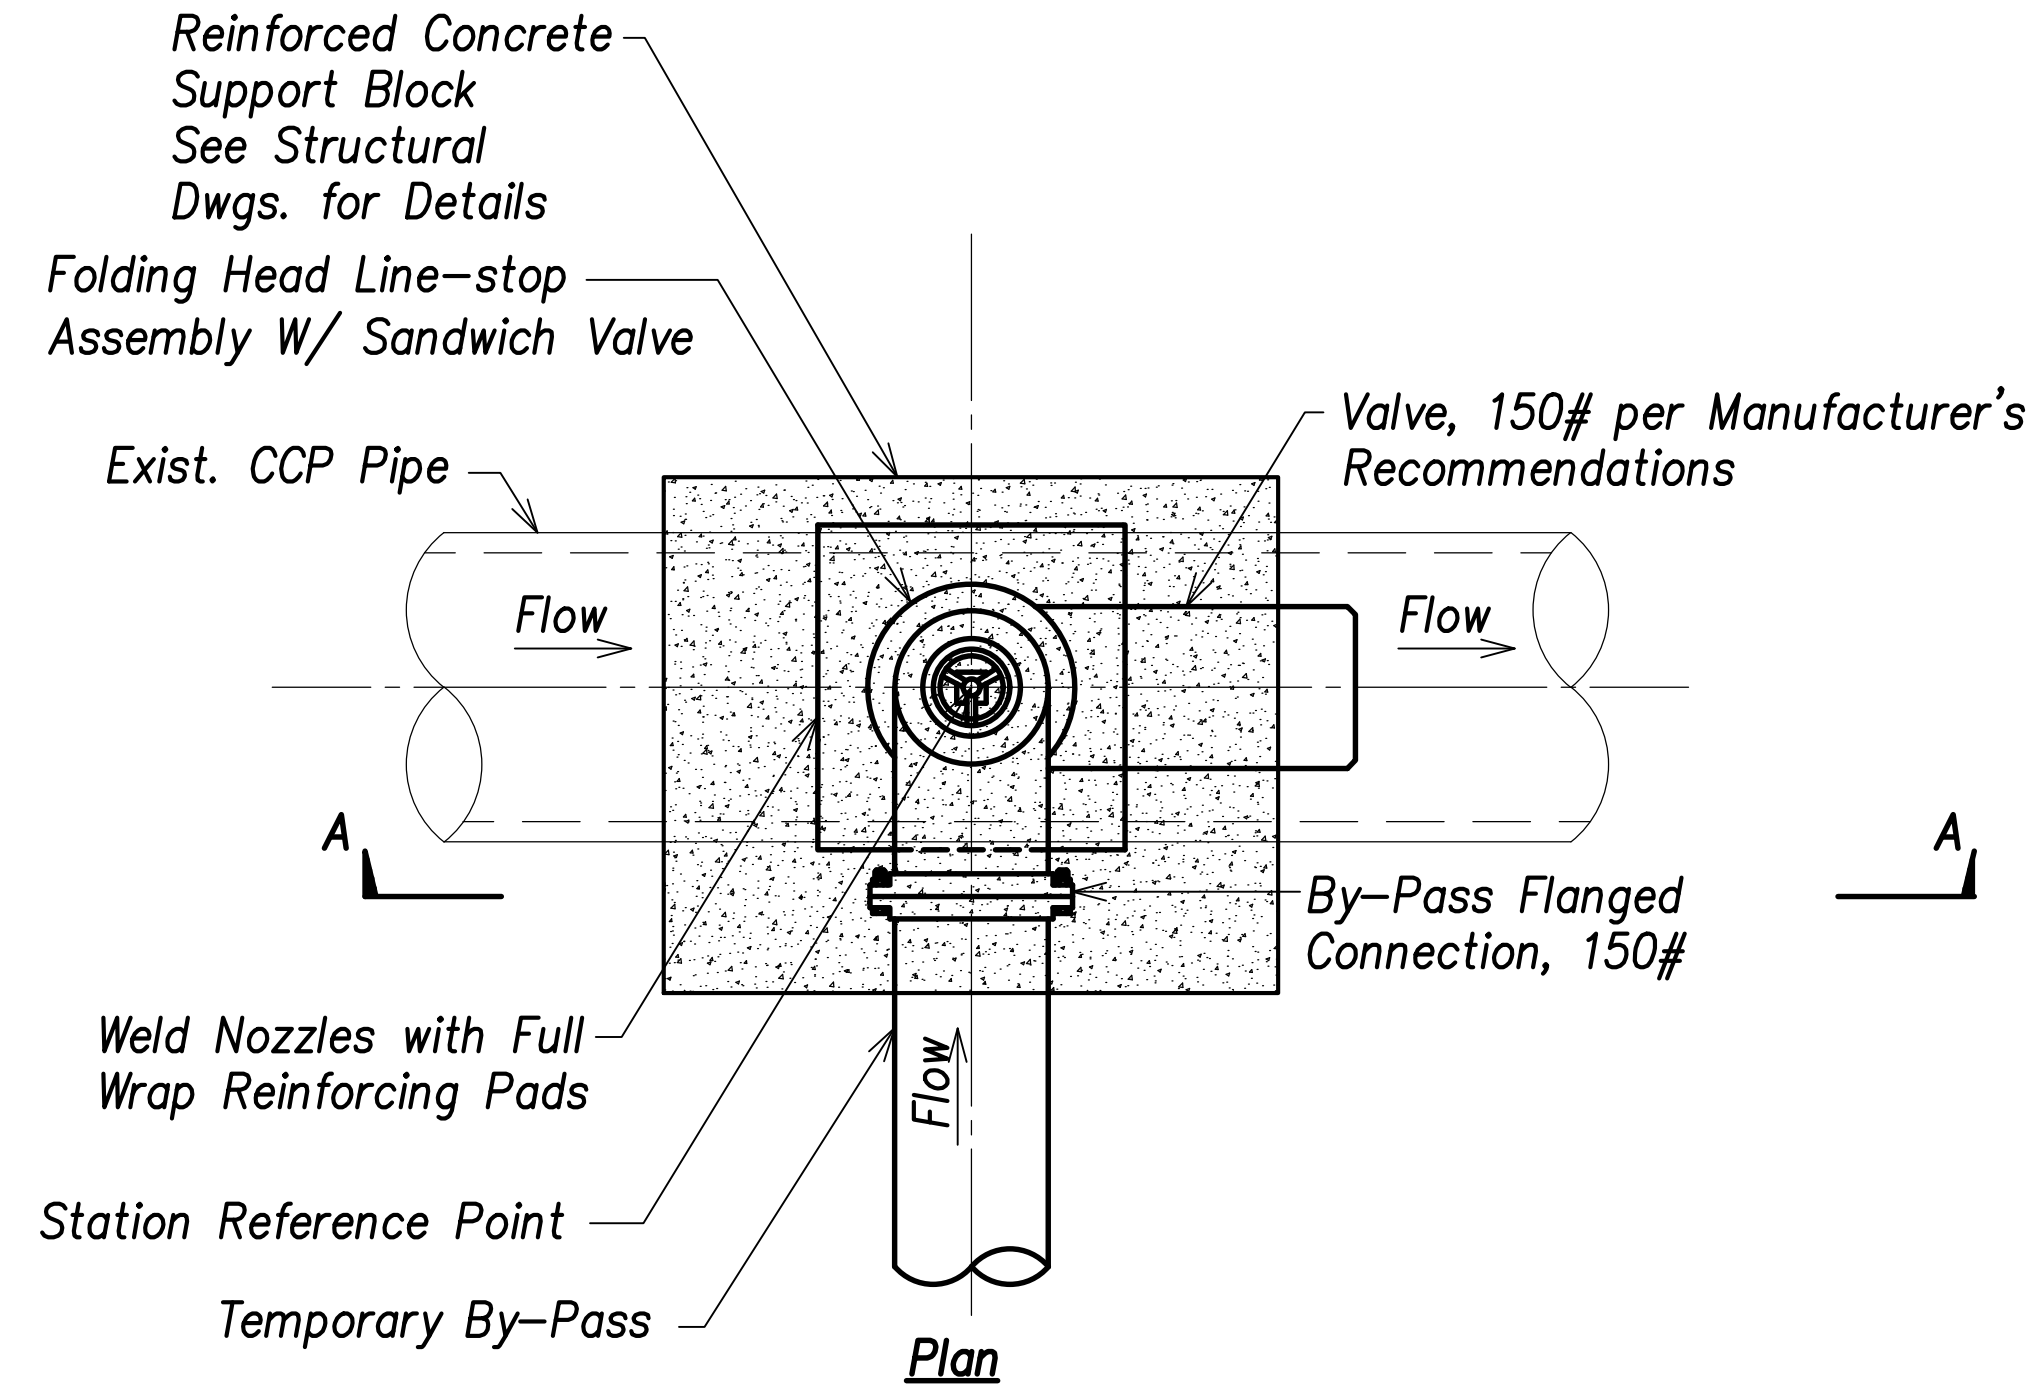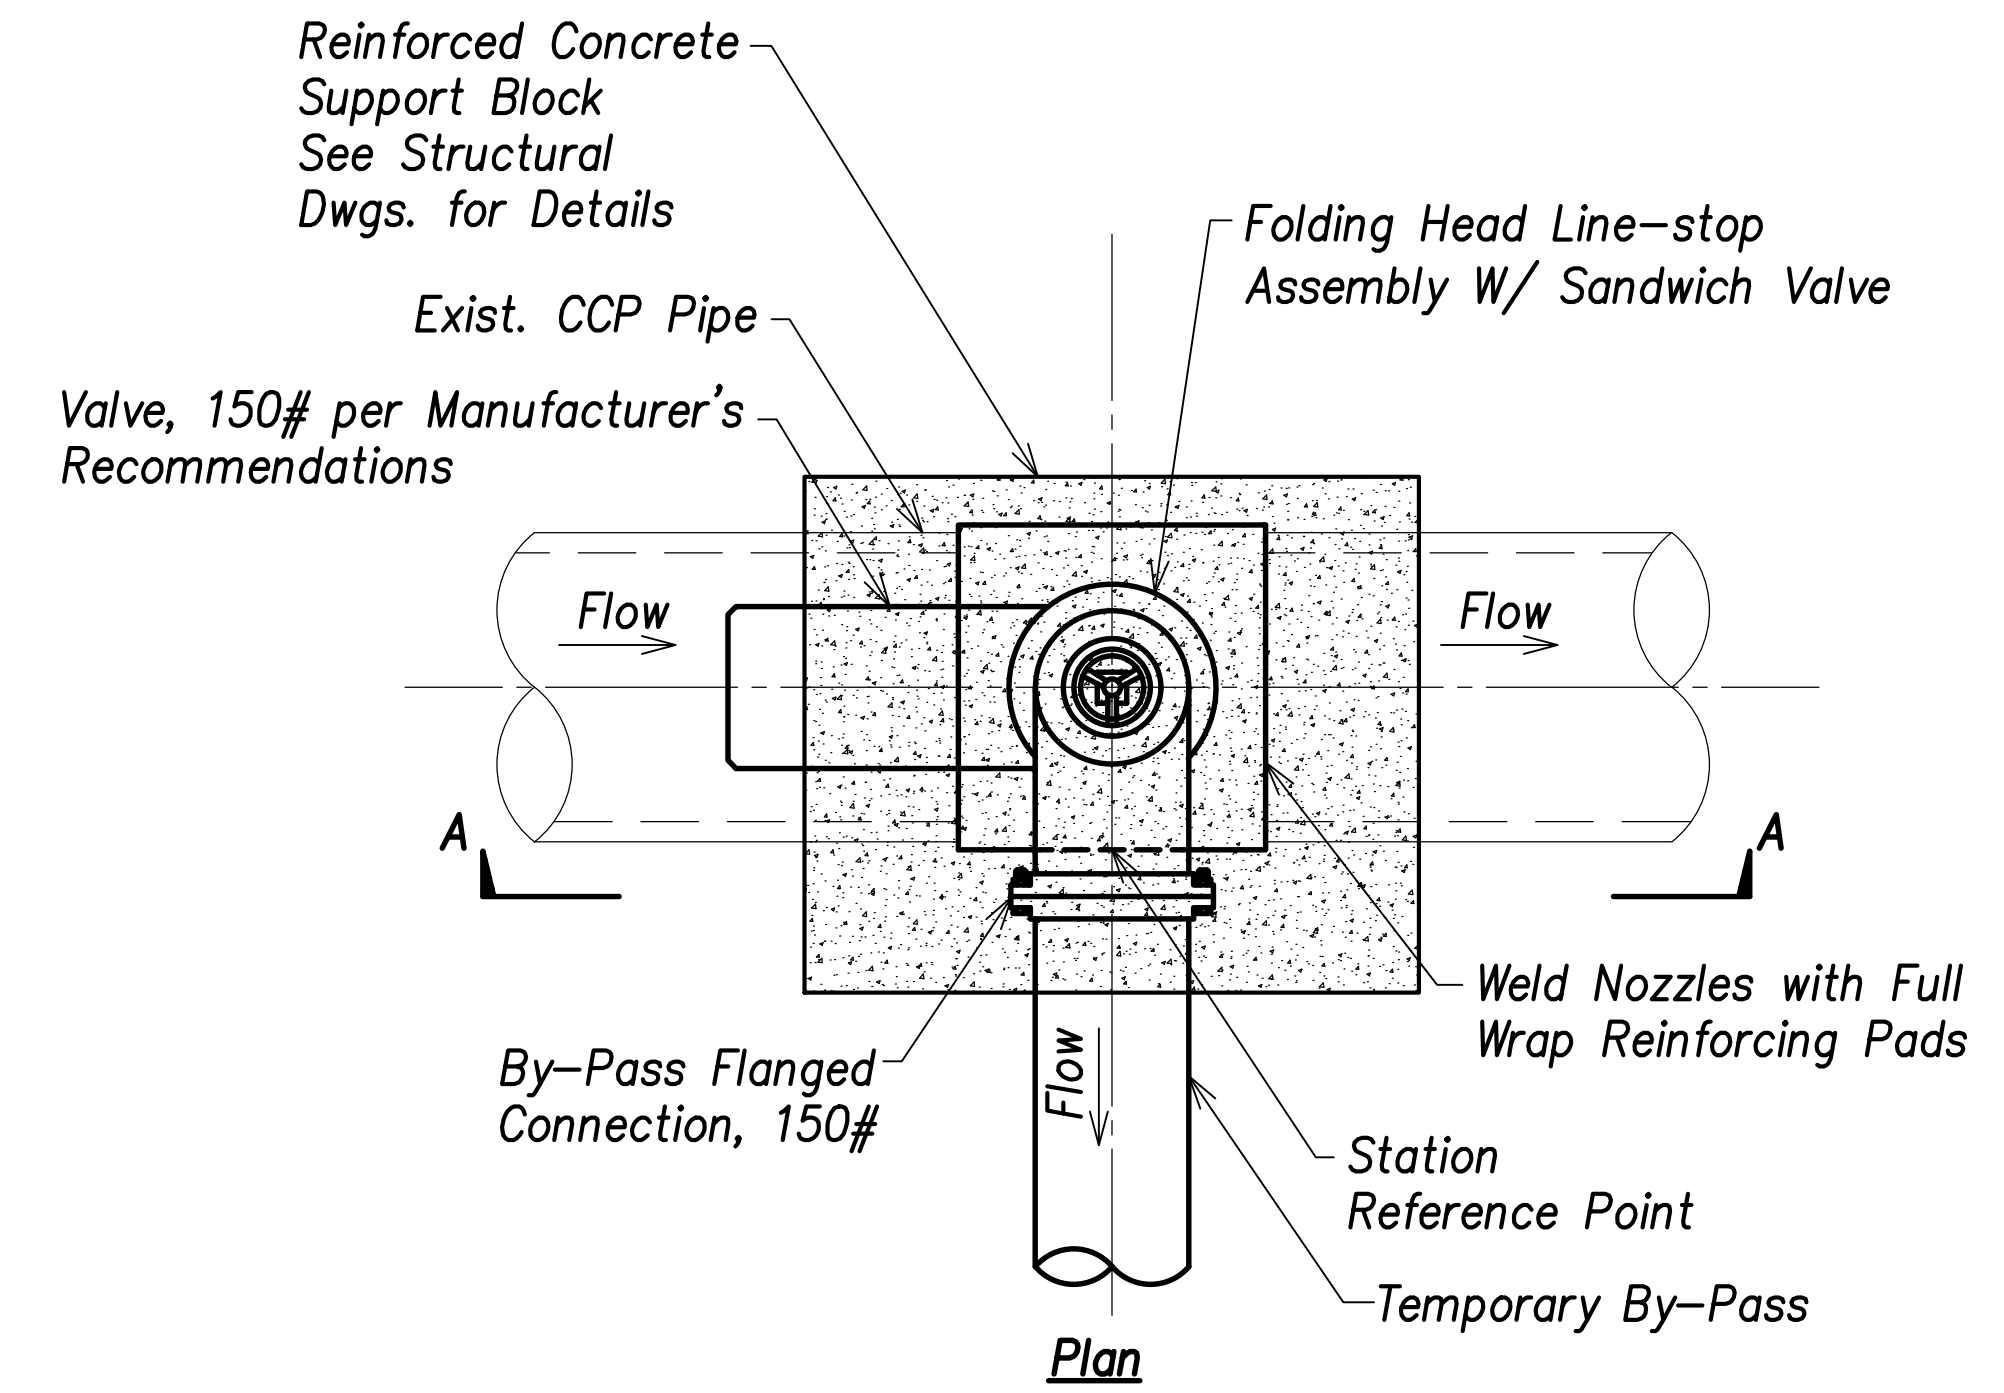


- Notes:**
- Prior to start of Construction, Contractor shall submit shop drawings for approval of the tapping tee w/ anchor full wrap steel plate, the temporary by-pass unit with folding head line-stop assembly w/ sandwich valve, the 3" line-stop nipple, the permanent completion plug, and the CCPxDIP adapter.
  - See sheets C-208 to C-209 for Temporary Bypass Procedures.
  - See Struct. Dwg. for Reinforced Concrete Support Block details.
  - Upon completion of the permanent connection, testing, and approval of the connection by BWS, portions of the existing water system that are no longer in use shall be demolished and removed.

1 Typical Temporary By-Pass and Line-Stop Details  
C-208 | C-210 (Upstream of Connection)  
Not to Scale

2 Typical Temporary By-Pass and Line-Stop Details  
C-208 | C-210 (Downstream of Connection)  
Not to Scale

DATE	.....
SURVEY PLOTTED BY	.....
DRAWN BY	.....
TRACED BY	.....
QUANTITIES BY	.....
CHECKED BY	.....
ORIGINAL PLAN	.....
NOTE BOOK	.....
No.	.....


APPROVED: \_\_\_\_\_ DATE \_\_\_\_\_  
Manager and Chief Engineer, BWS  
(for work affecting BWS facilities in  
City/State R/W & BWS easements only)

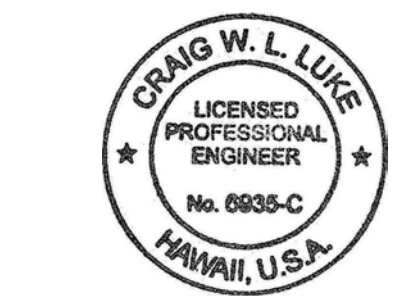

THIS WORK WAS PREPARED BY ME OR UNDER MY SUPERVISION AND CONSTRUCTION OF THIS PROJECT WILL BE UNDER MY OBSERVATION.  
Signature: \_\_\_\_\_  
EXPIRATION DATE OF THE LICENSE: April 30, 2024


07/15/22	Revised connection
DATE	REVISION
STATE OF HAWAII DEPARTMENT OF TRANSPORTATION HIGHWAYS DIVISION	
Waterline Connection and Temporary By-Pass Typical Details - 1 FARRINGTON HIGHWAY WIDENING Kapolei Golf Course Road to Fort Weaver Road Project No. 7101A-01-20	
Scale: As Shown	Date: April 2022
SHEET No. C-210 OF 767 SHEETS	

FED. ROAD DIST. NO.	STATE	PROJ. NO.	FISCAL YEAR	SHEET NO.	TOTAL SHEETS
HAWAII	HAW.	7101A-01-20	2021	212	767

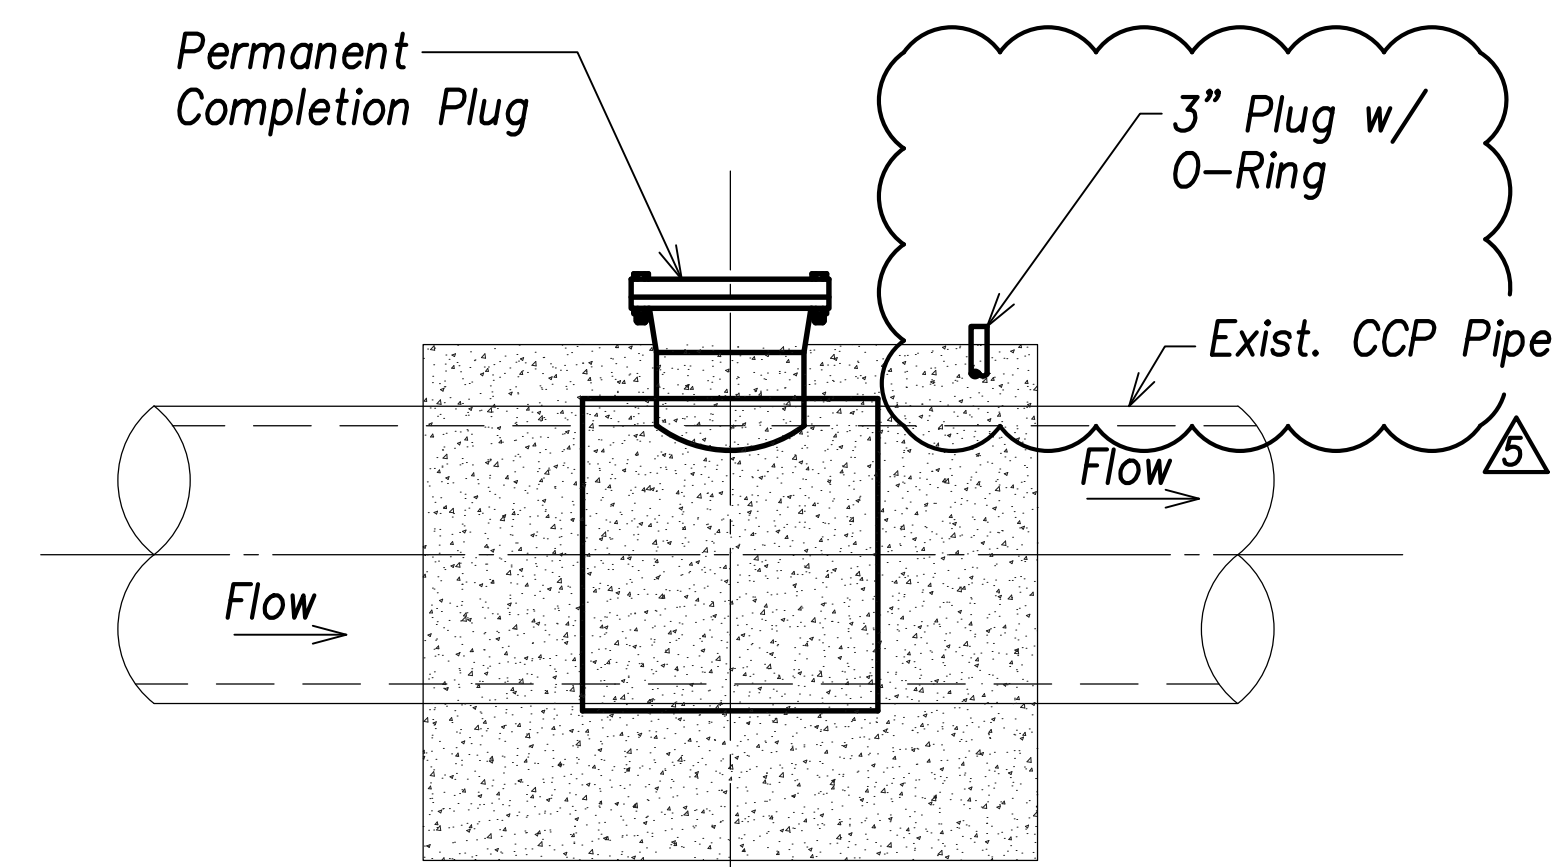


**Note:**  
For plan view, see  $\frac{1}{C-208 \quad C-211}$

$\frac{3}{C-209 \quad C-211}$  **Typical Permanent Completion Plug (Upstream of Connection)**  
Not to Scale

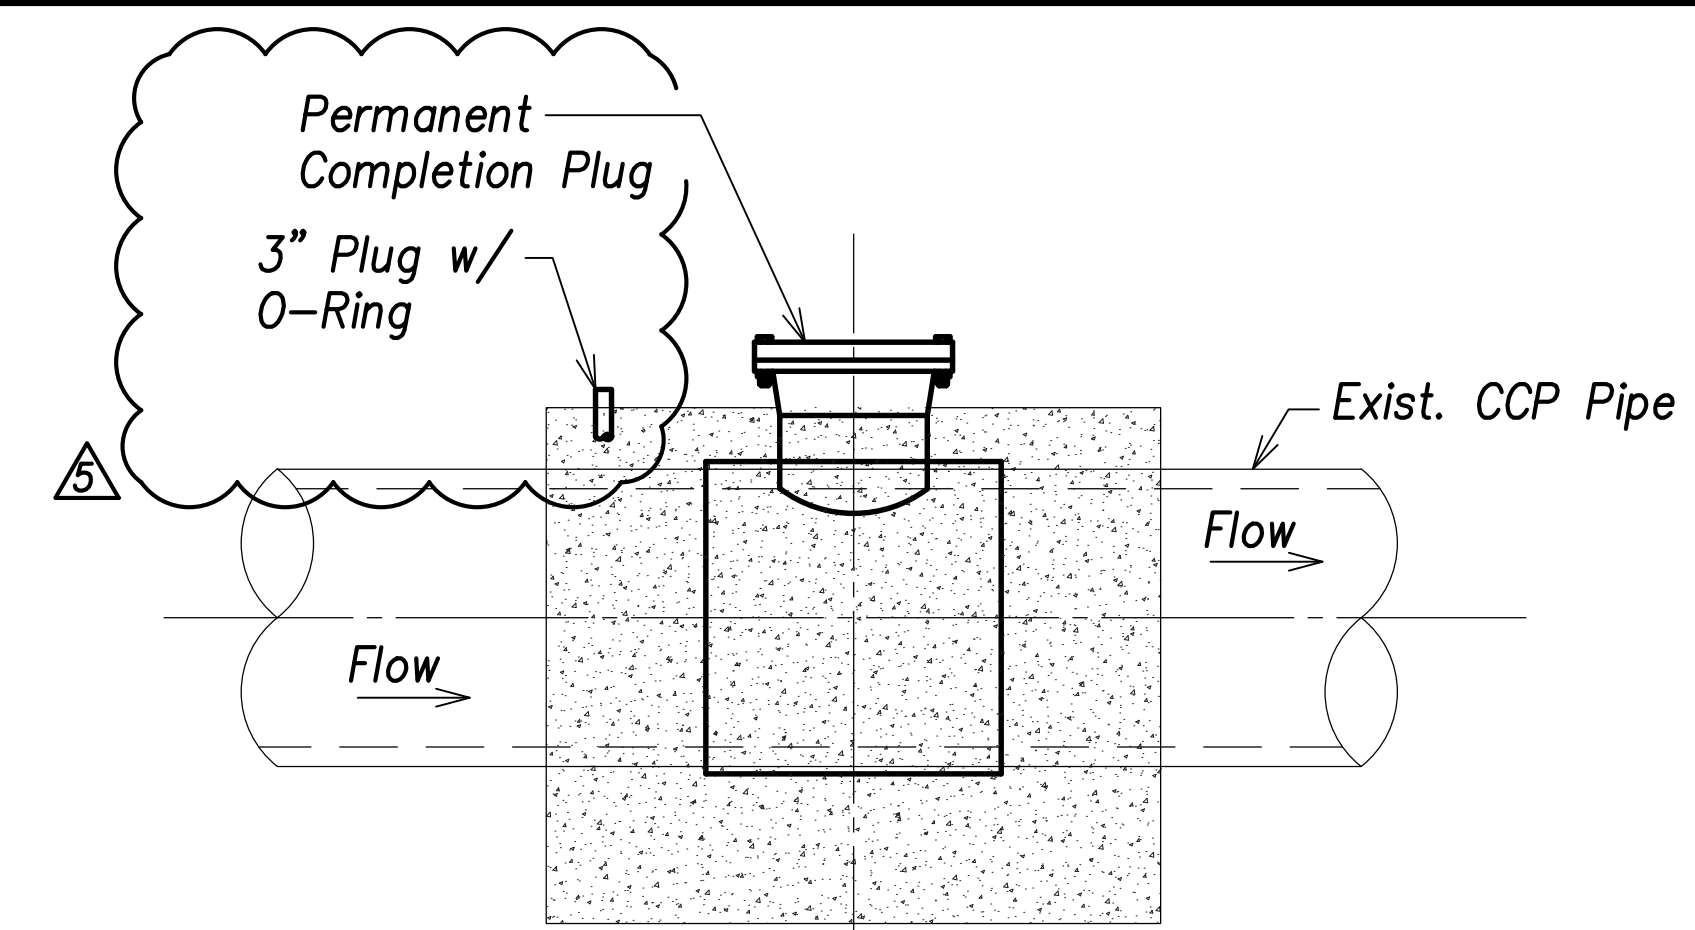


**Note:**  
For plan view, see  $\frac{2}{C-208 \quad C-211}$

$\frac{4}{C-209 \quad C-211}$  **Typical Permanent Completion Plug (Downstream of Connection)**  
Not to Scale

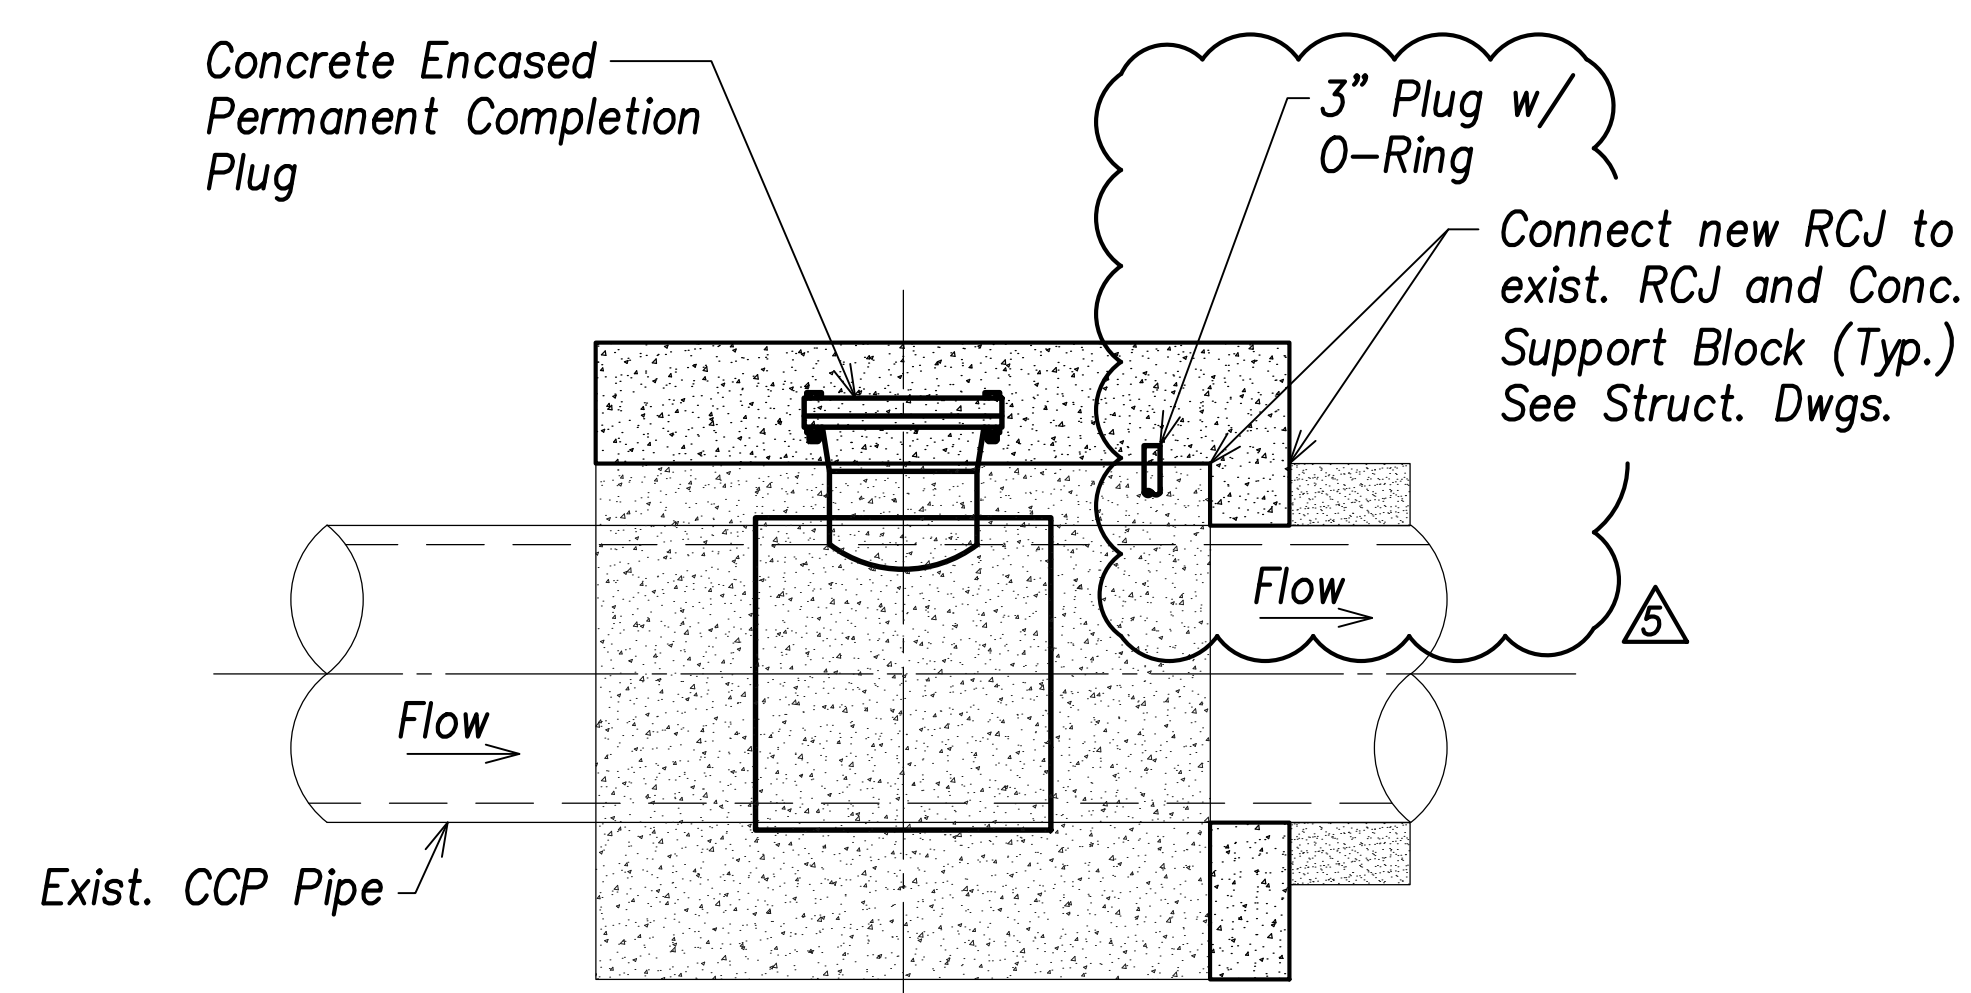

**Note:**  
For plan view, see  $\frac{1}{C-208 \quad C-211}$

$\frac{5}{C-209 \quad C-211}$  **Typical RCJ at Permanent Completion Plug (Upstream of Connection)**  
Not to Scale

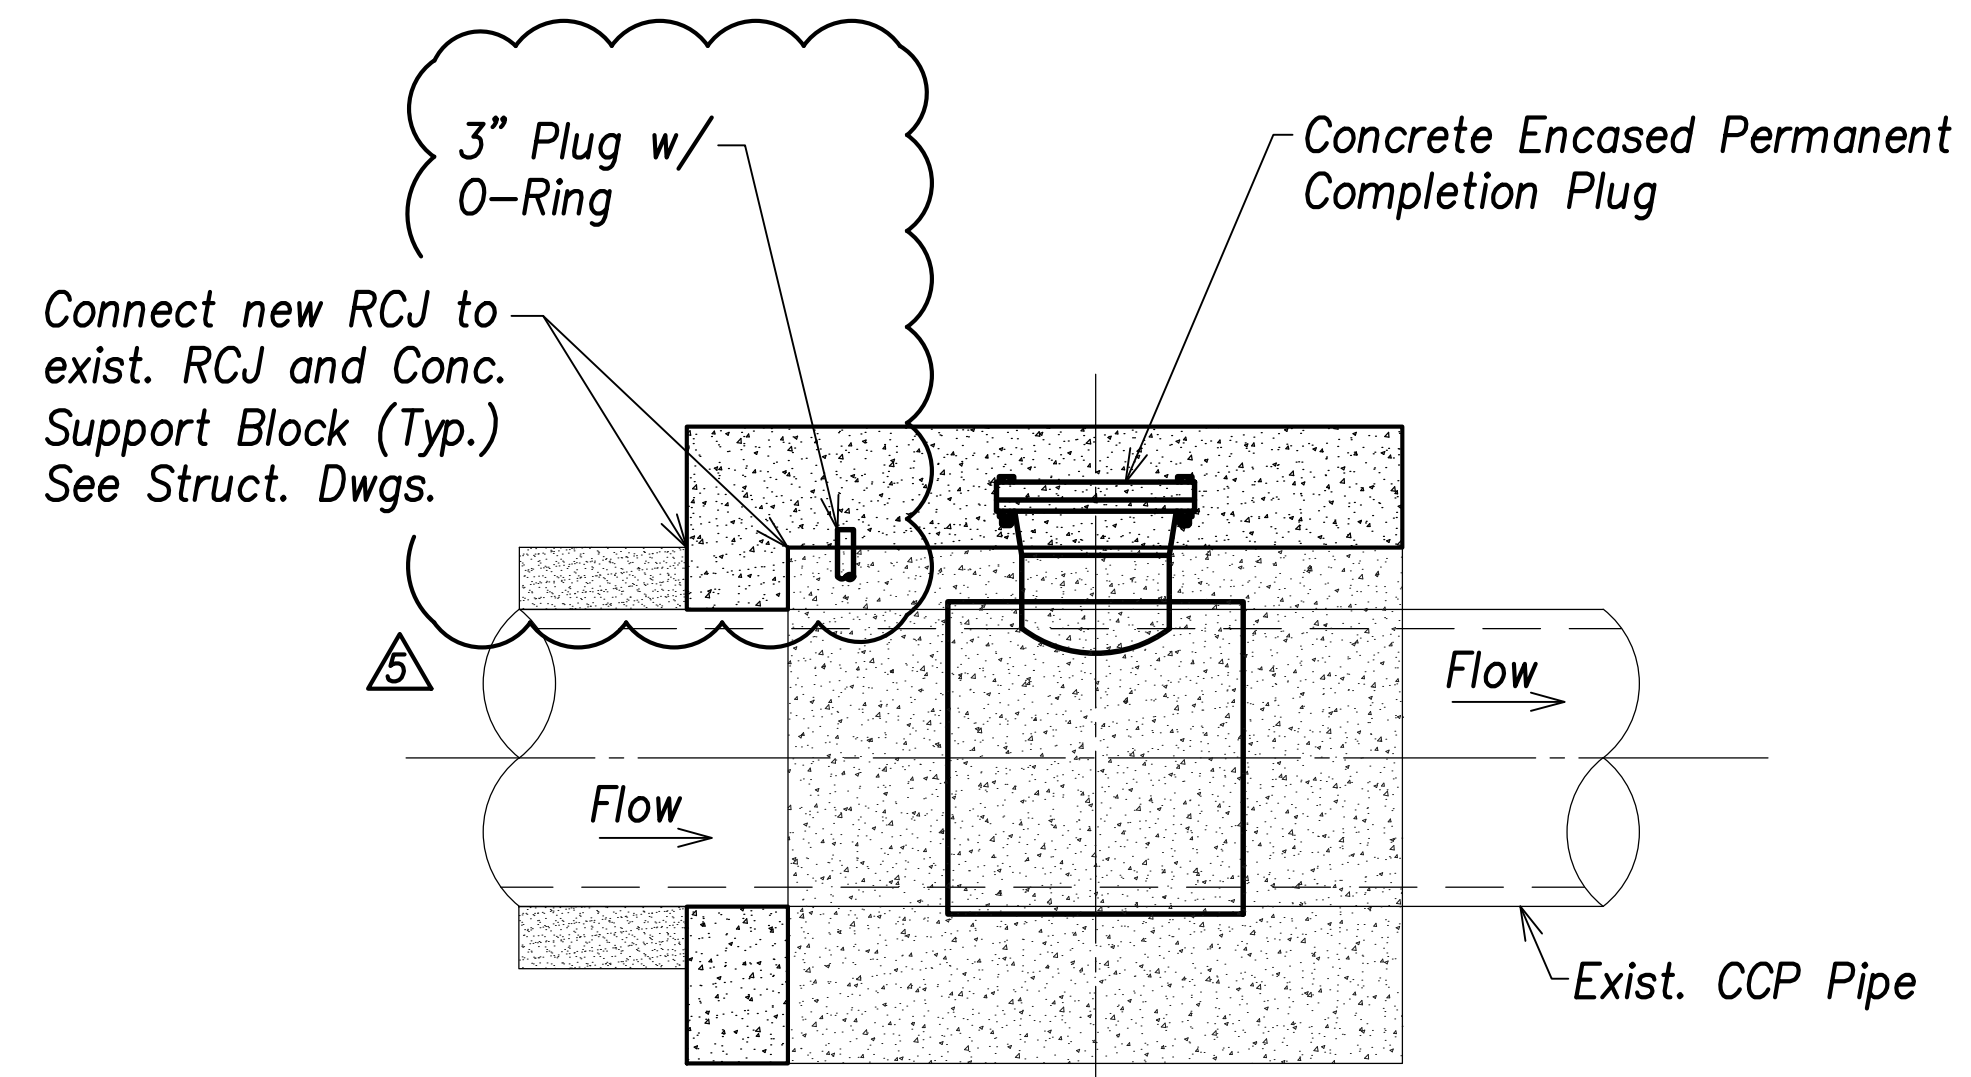

**Note:**  
For plan view, see  $\frac{2}{C-208 \quad C-211}$

$\frac{6}{C-209 \quad C-211}$  **Typical RCJ at Permanent Completion Plug (Downstream of Connection)**  
Not to Scale


**Notes:**

- Prior to start of Construction, Contractor shall submit shop drawings for approval of the tapping tee w/ anchor full wrap steel plate, the temporary by-pass unit with folding head line-stop assembly w/ sandwich valve, the 3" line-stop nipple, the permanent completion plug, and the CCPxDIP adapter.
- See sheets C-208 to C-209 for Temporary Bypass Procedures.
- See Struct. Dwgs. for Reinforced Concrete Support Block details.
- Upon completion of the permanent connection, testing, and approval of the connection by BWS, portions of the existing water system that are no longer in use shall be demolished and removed.

SURVEY PLOTTED BY	DATE
DRAWN BY	
TRACED BY	
QUANTIFIED BY	
CHECKED BY	
ORIGINAL PLAN	
NOTE BOOK	
No.	

APPROVED:  
\_\_\_\_\_  
Manager and Chief Engineer, BWS  
(for work affecting BWS facilities in City/State R/W & BWS easements only)

DATE \_\_\_\_\_

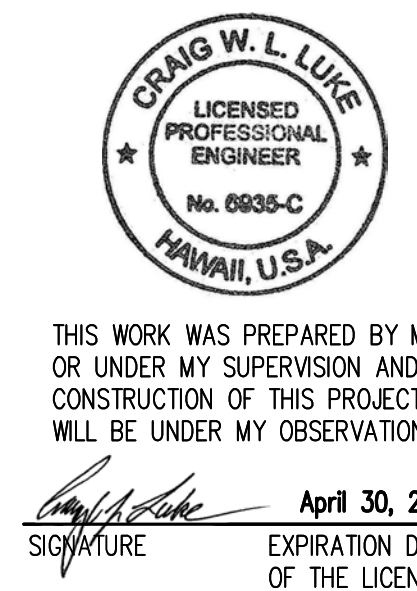


07/15/22	Revised connections
DATE	REVISION
STATE OF HAWAII <b>DEPARTMENT OF TRANSPORTATION</b> HIGHWAYS DIVISION <b>Waterline Connection and Temporary By-Pass</b> <b>Typical Details - 2</b> FARRINGTON HIGHWAY WIDENING Kapolei Golf Course Road to Fort Weaver Road Project No. 7101A-01-20	
Scale: As Shown	Date: April 2022
<b>SHEET No. C-211 OF 767 SHEETS</b>	

FILE: K:\civil\23146 Farrington Hwy Widening\Drawings\Construction Drawings\C-211 Waterline Connection and Temporary By-Pass Typ Detail - 2.dwg saved July 19, 2022



FED. ROAD DIST. NO.	STATE	PROJ. NO.	FISCAL YEAR	SHEET NO.	TOTAL SHEETS
HAWAII	HAW.	7101A-01-20	2021	223	767

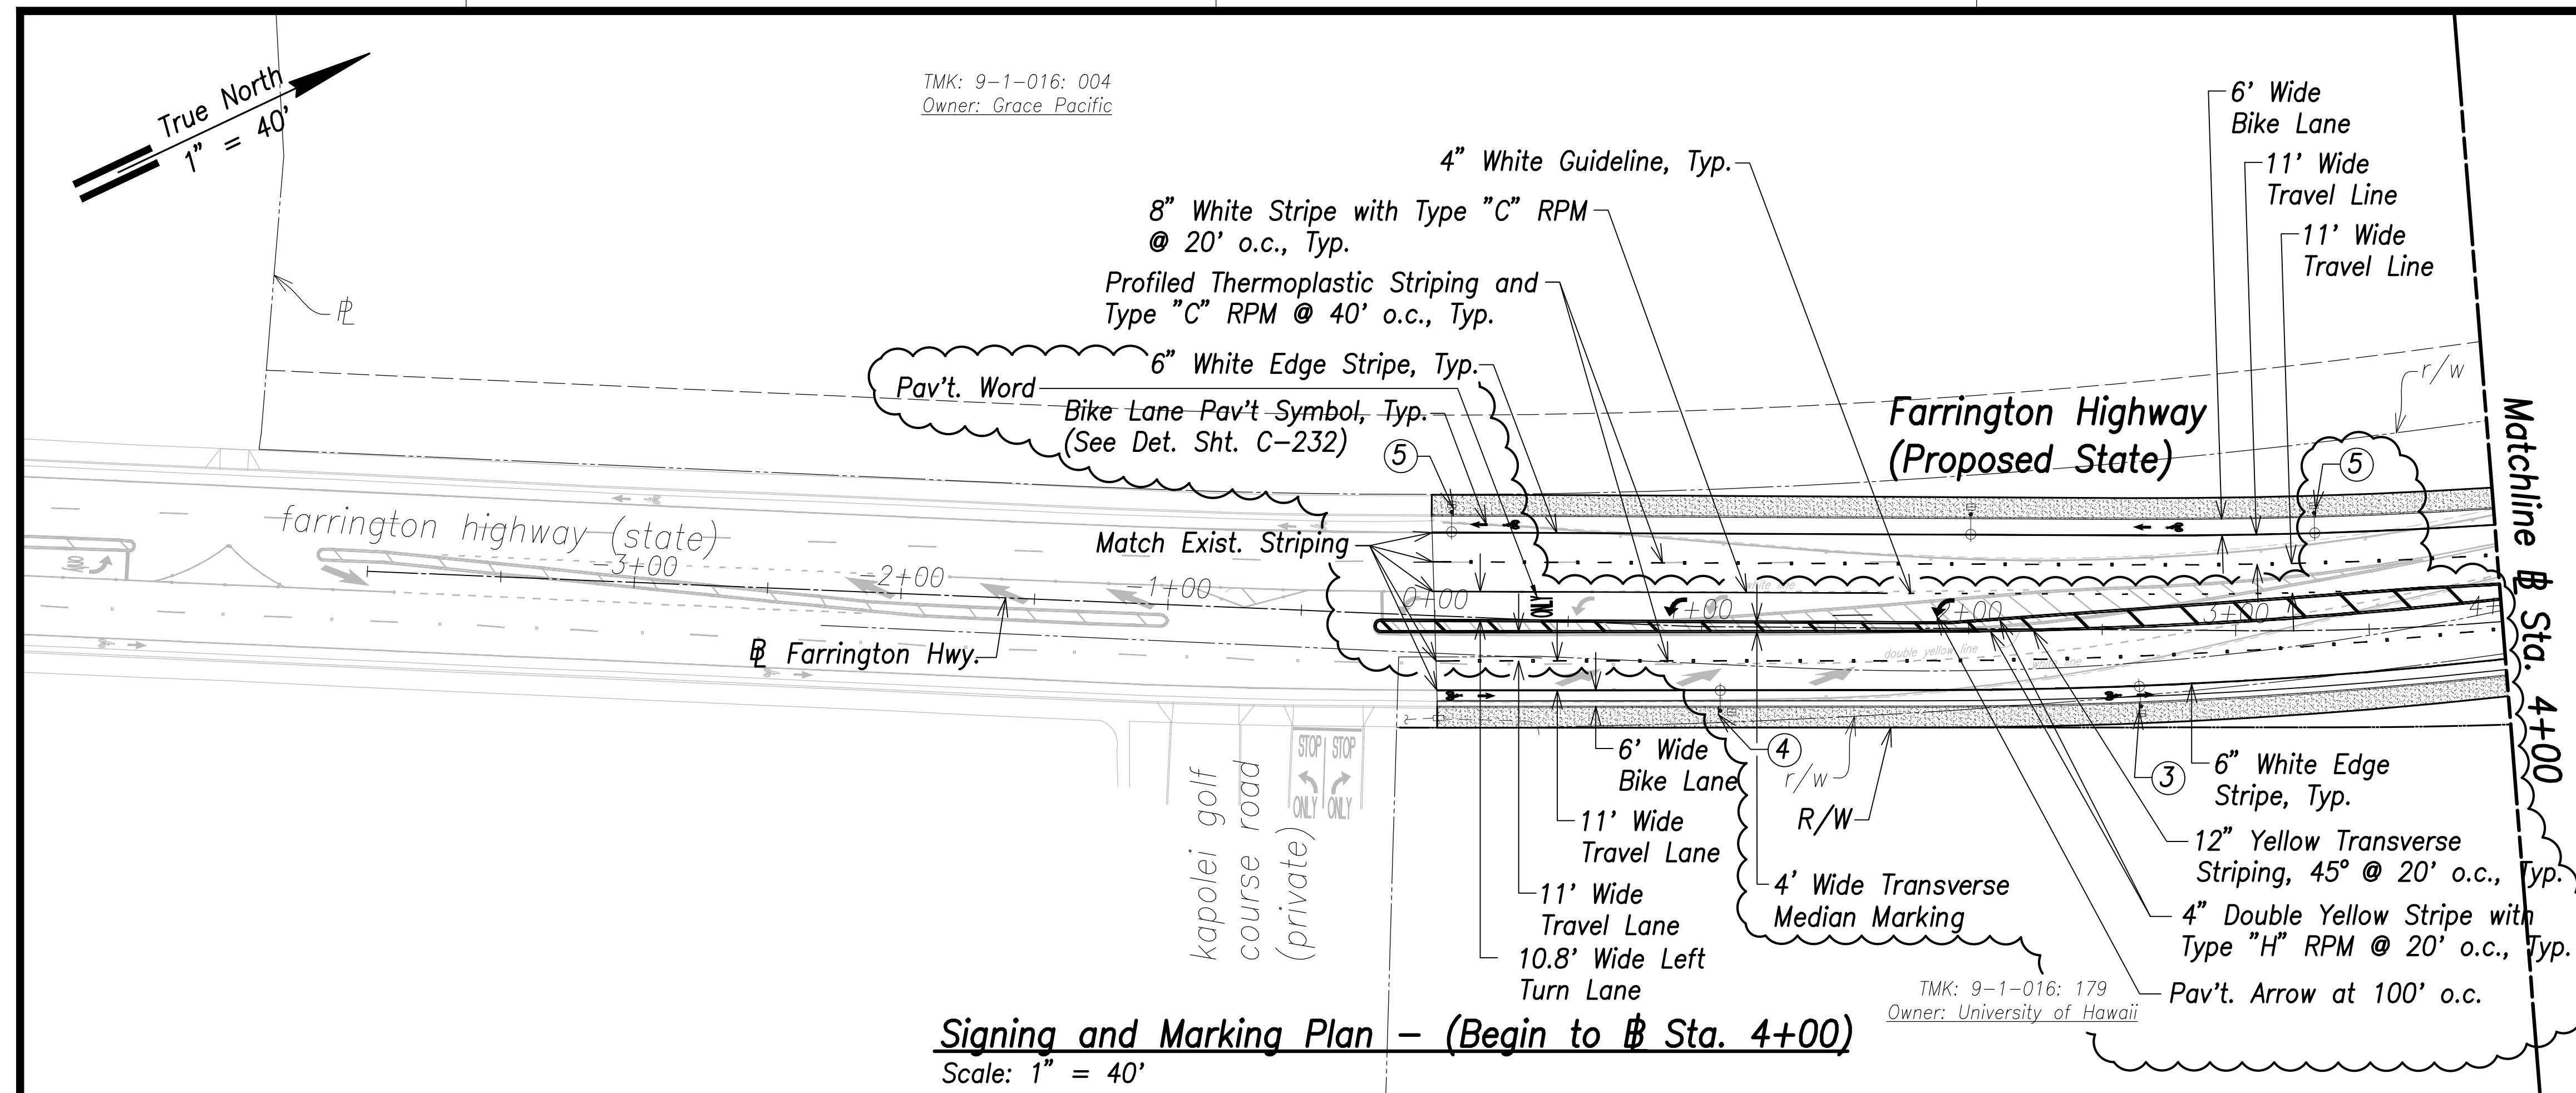

③

**SPEED LIMIT 25**  
R2-1(25)  
24"x30"

④

**BIKE ROUTE**  
D11-1  
24"x18"  
Mount on St. Lt. Pole



⑤

**R8-3a**  
24"x24"  
Mount on St. Lt. Pole

②

W11-2  
36"x36"

W16-7pL  
24"x12"

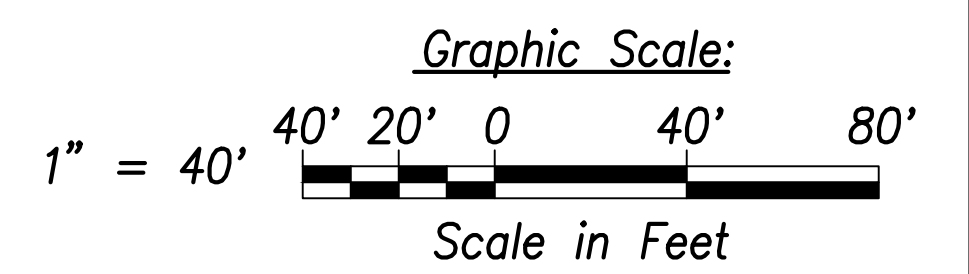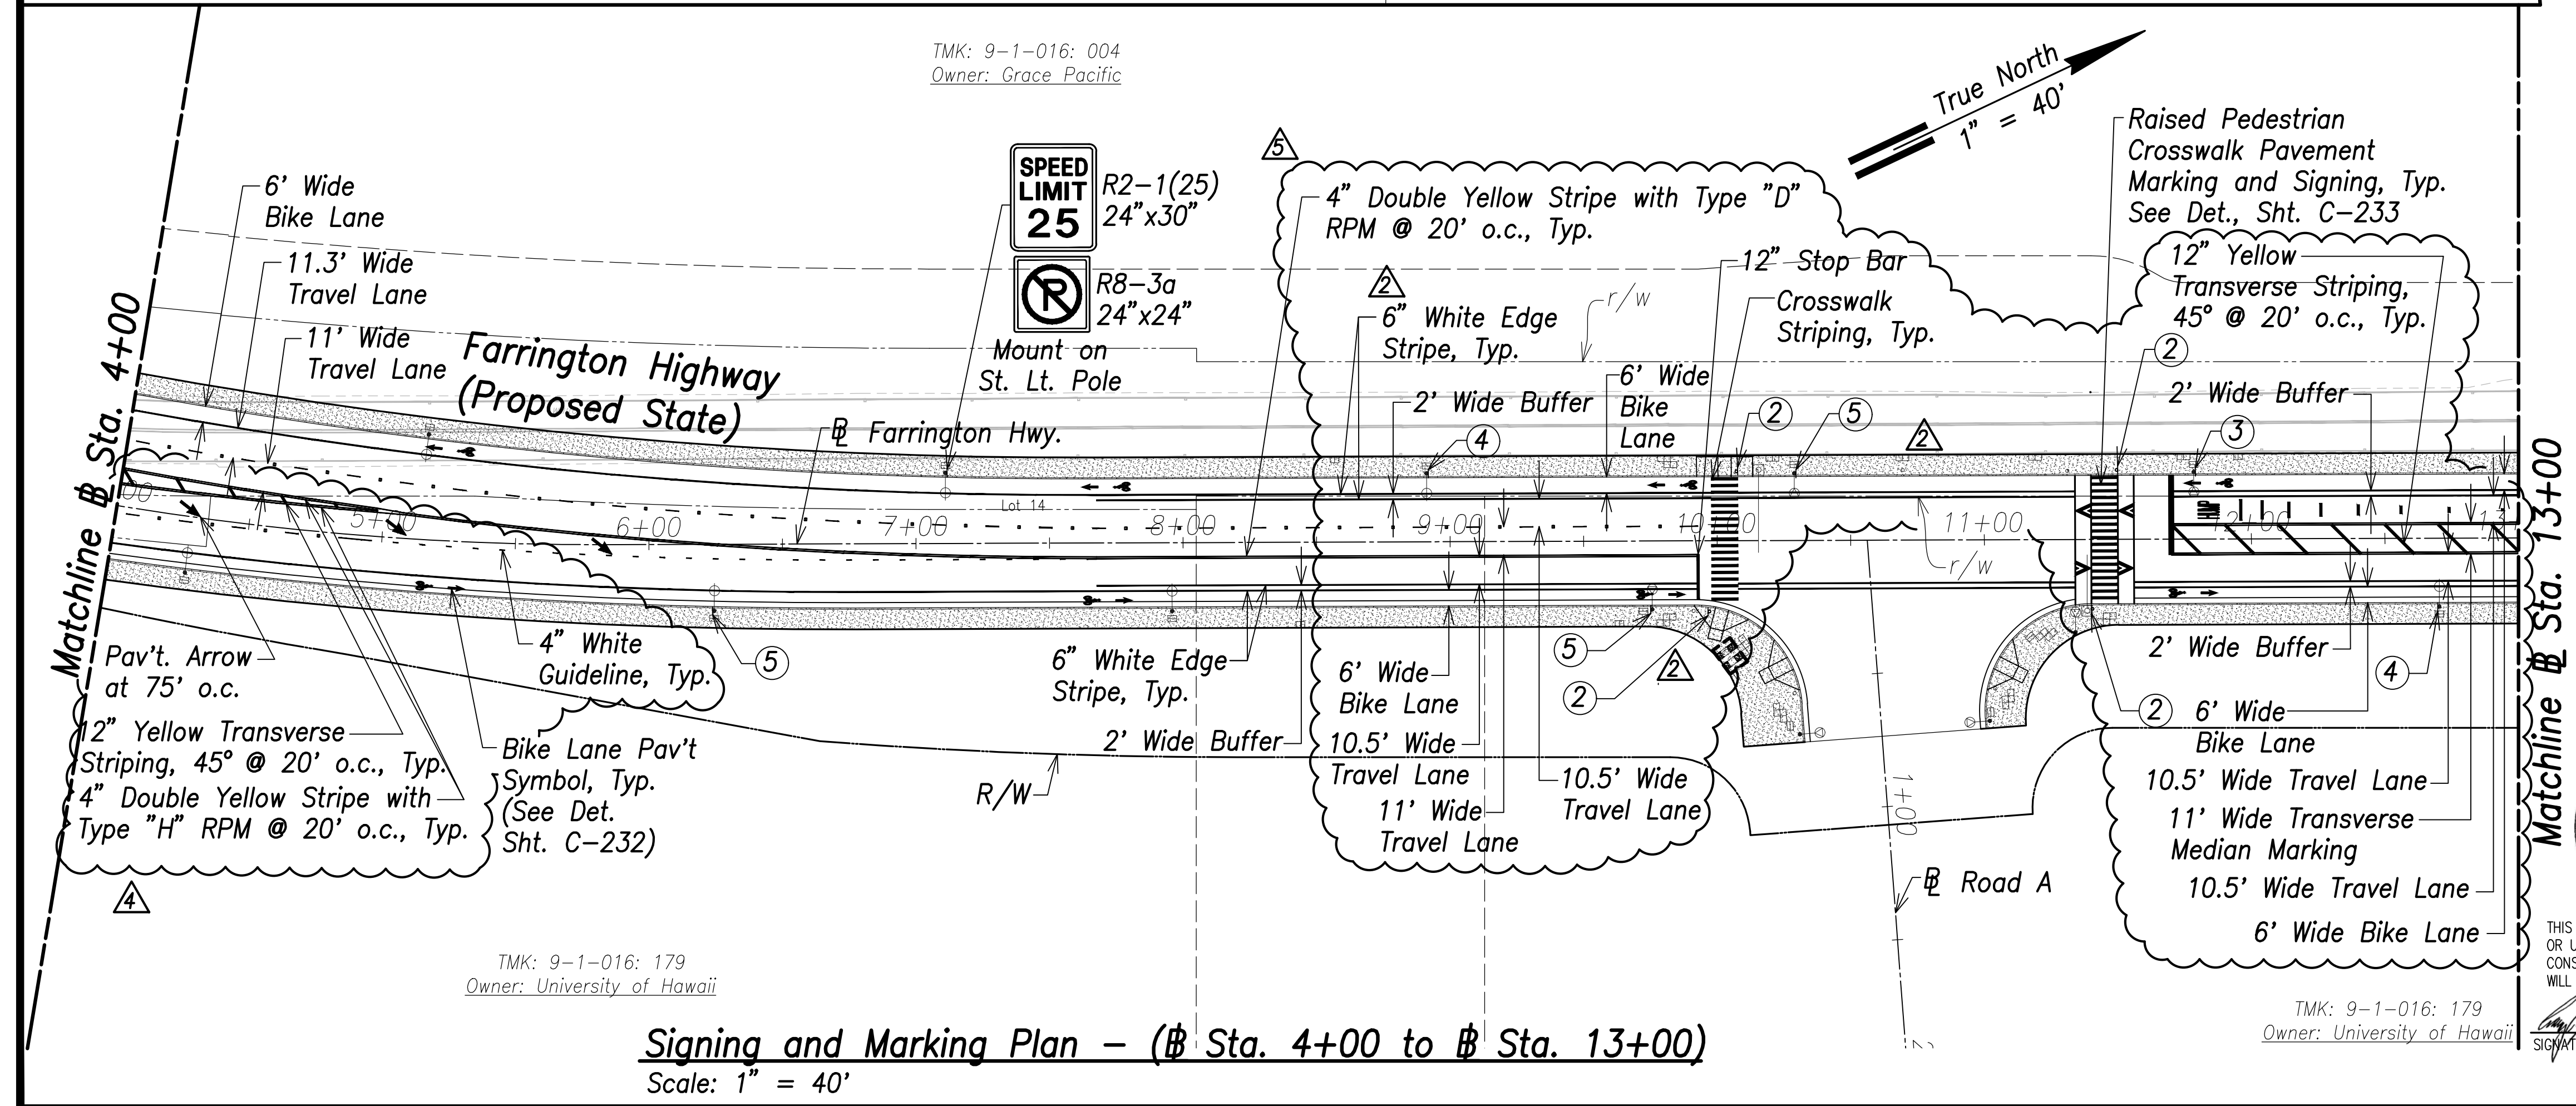

DATE	REVISION
07/15/22	Rev. Signing, Striping, Add callouts
06/08/22	Pav't. Arrow Revised, Crosswalk Signage Added, Label Added, Stripe Added

DATE	DESCRIPTION



THIS WORK WAS PREPARED BY ME OR UNDER MY SUPERVISION AND CONSTRUCTION OF THIS PROJECT WILL BE UNDER MY OBSERVATION.

Signature: *Craig W. L. Luke*  
EXPIRATION DATE OF THE LICENSE: April 30, 2024

STATE OF HAWAII  
DEPARTMENT OF TRANSPORTATION  
HIGHWAYS DIVISION


**Signing and Marking Plan**  
Sta. 0+00 to Sta. 13+00

FARRINGTON HIGHWAY WIDENING  
Kapolei Golf Course Road to Fort Weaver Road  
Project No. 7101A-01-20


Scale: As Shown Date: April 2022

SHEET NO. C-222 OF 767 SHEETS



FED. ROAD DIST. NO.	STATE	PROJ. NO.	FISCAL YEAR	SHEET NO.	TOTAL SHEETS
HAWAII	HAW.	7101A-01-20	2021	224	767

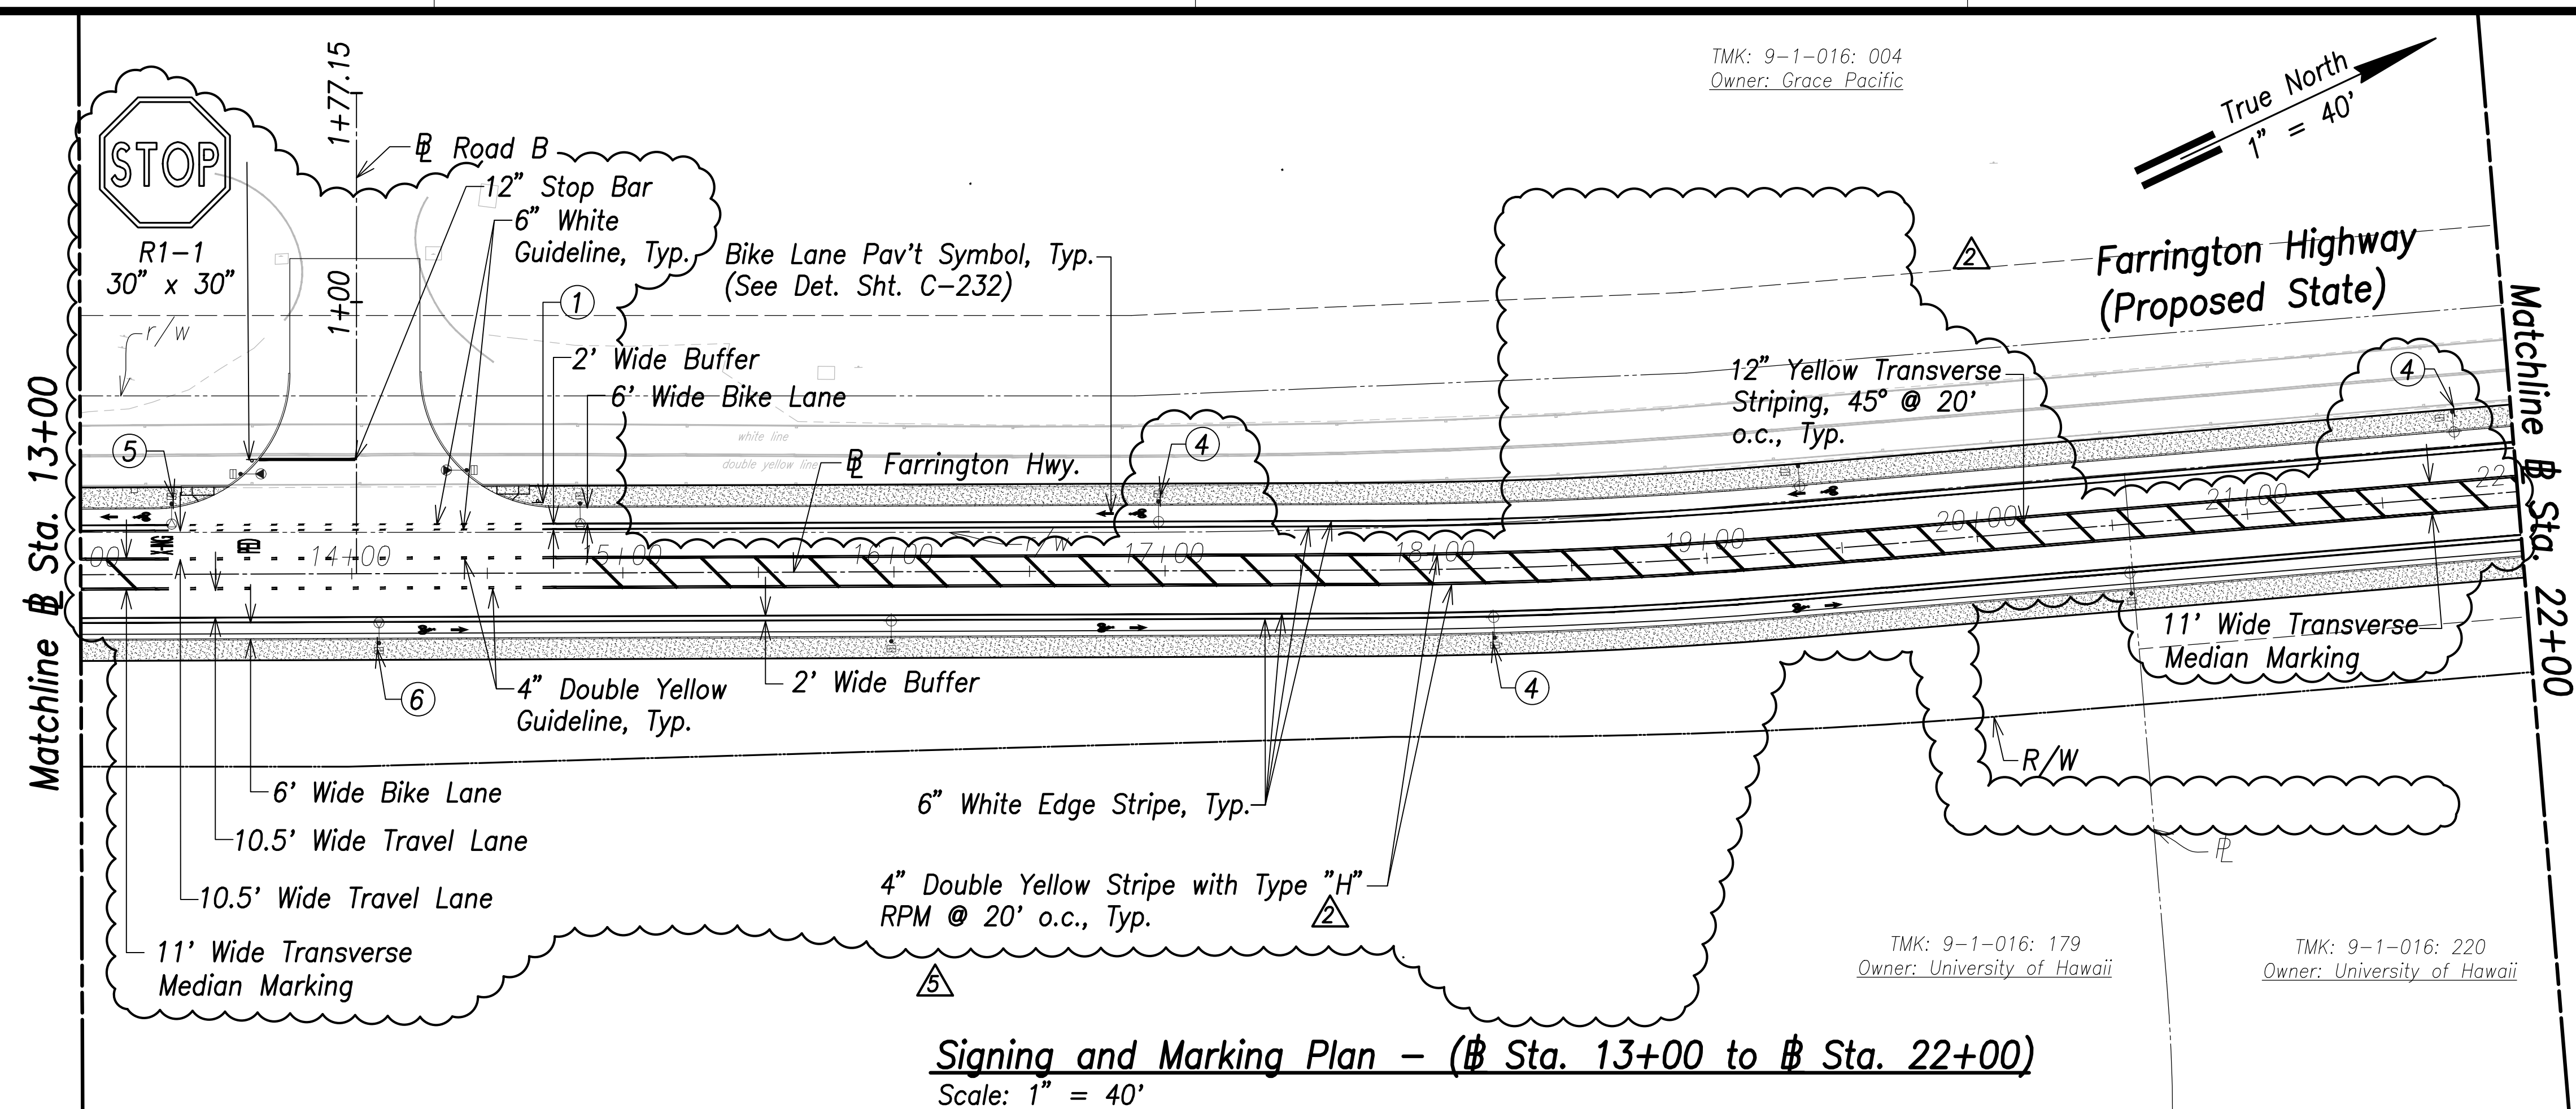

**Signing and Marking Plan - (Sta. 13+00 to Sta. 22+00)**  
Scale: 1" = 40'

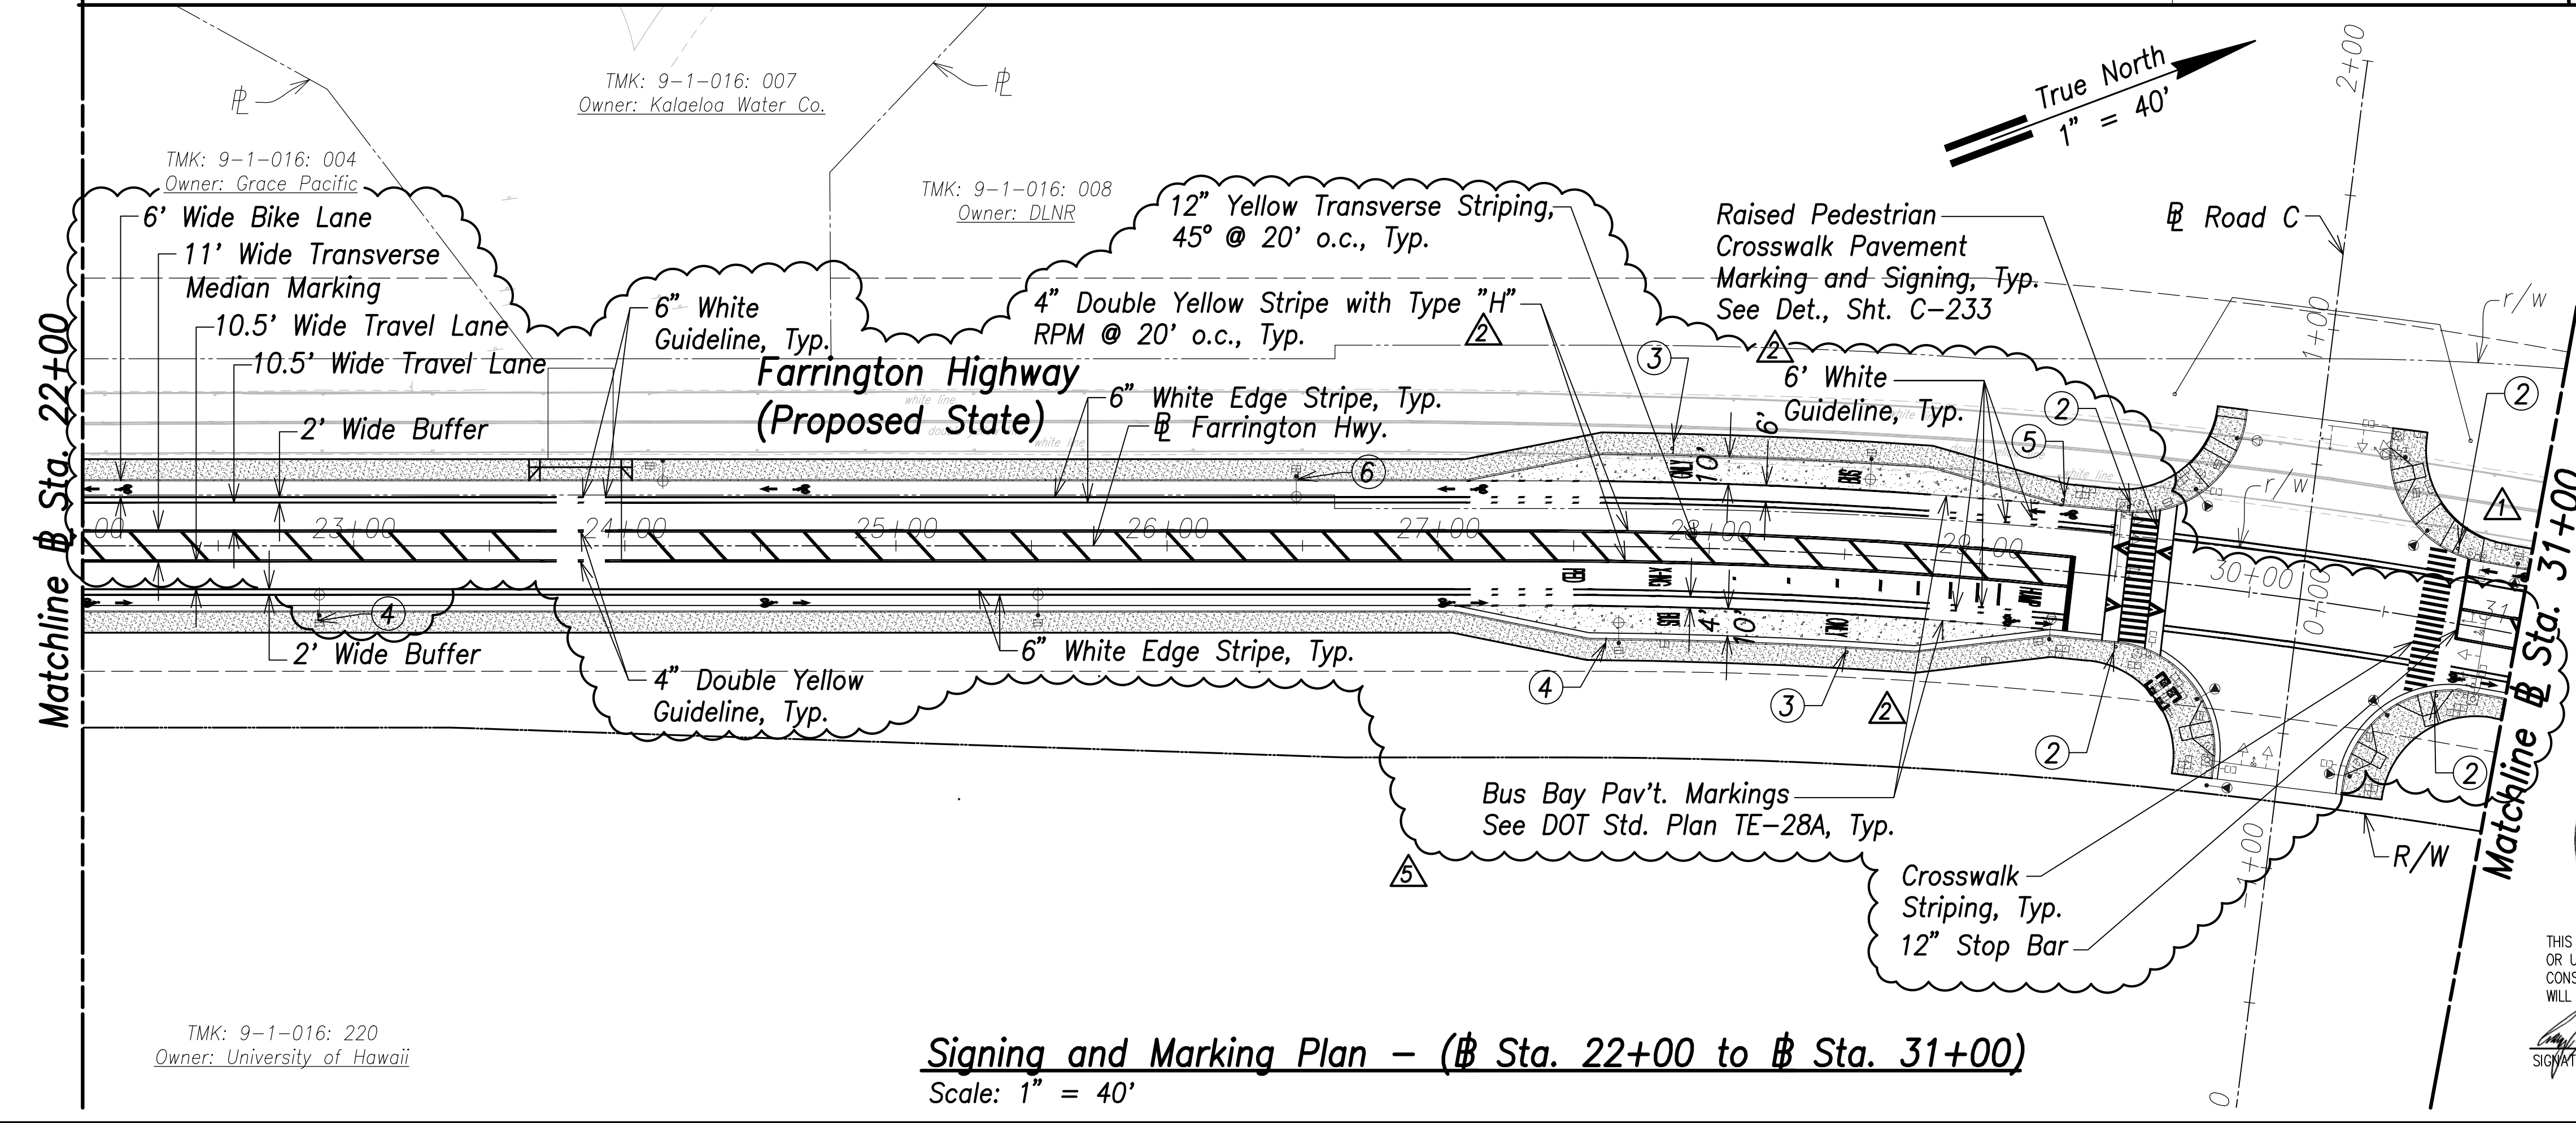

**Signing and Marking Plan - (Sta. 22+00 to Sta. 31+00)**  
Scale: 1" = 40'

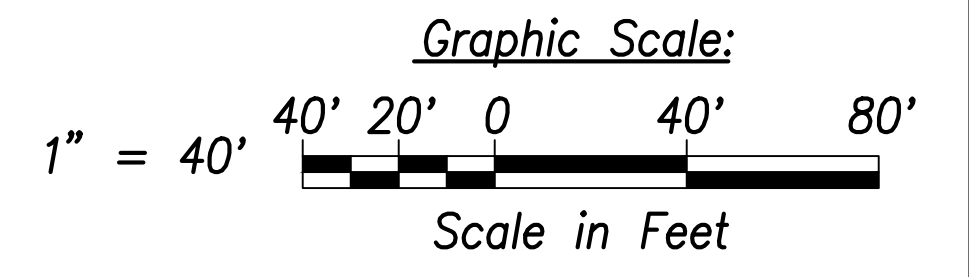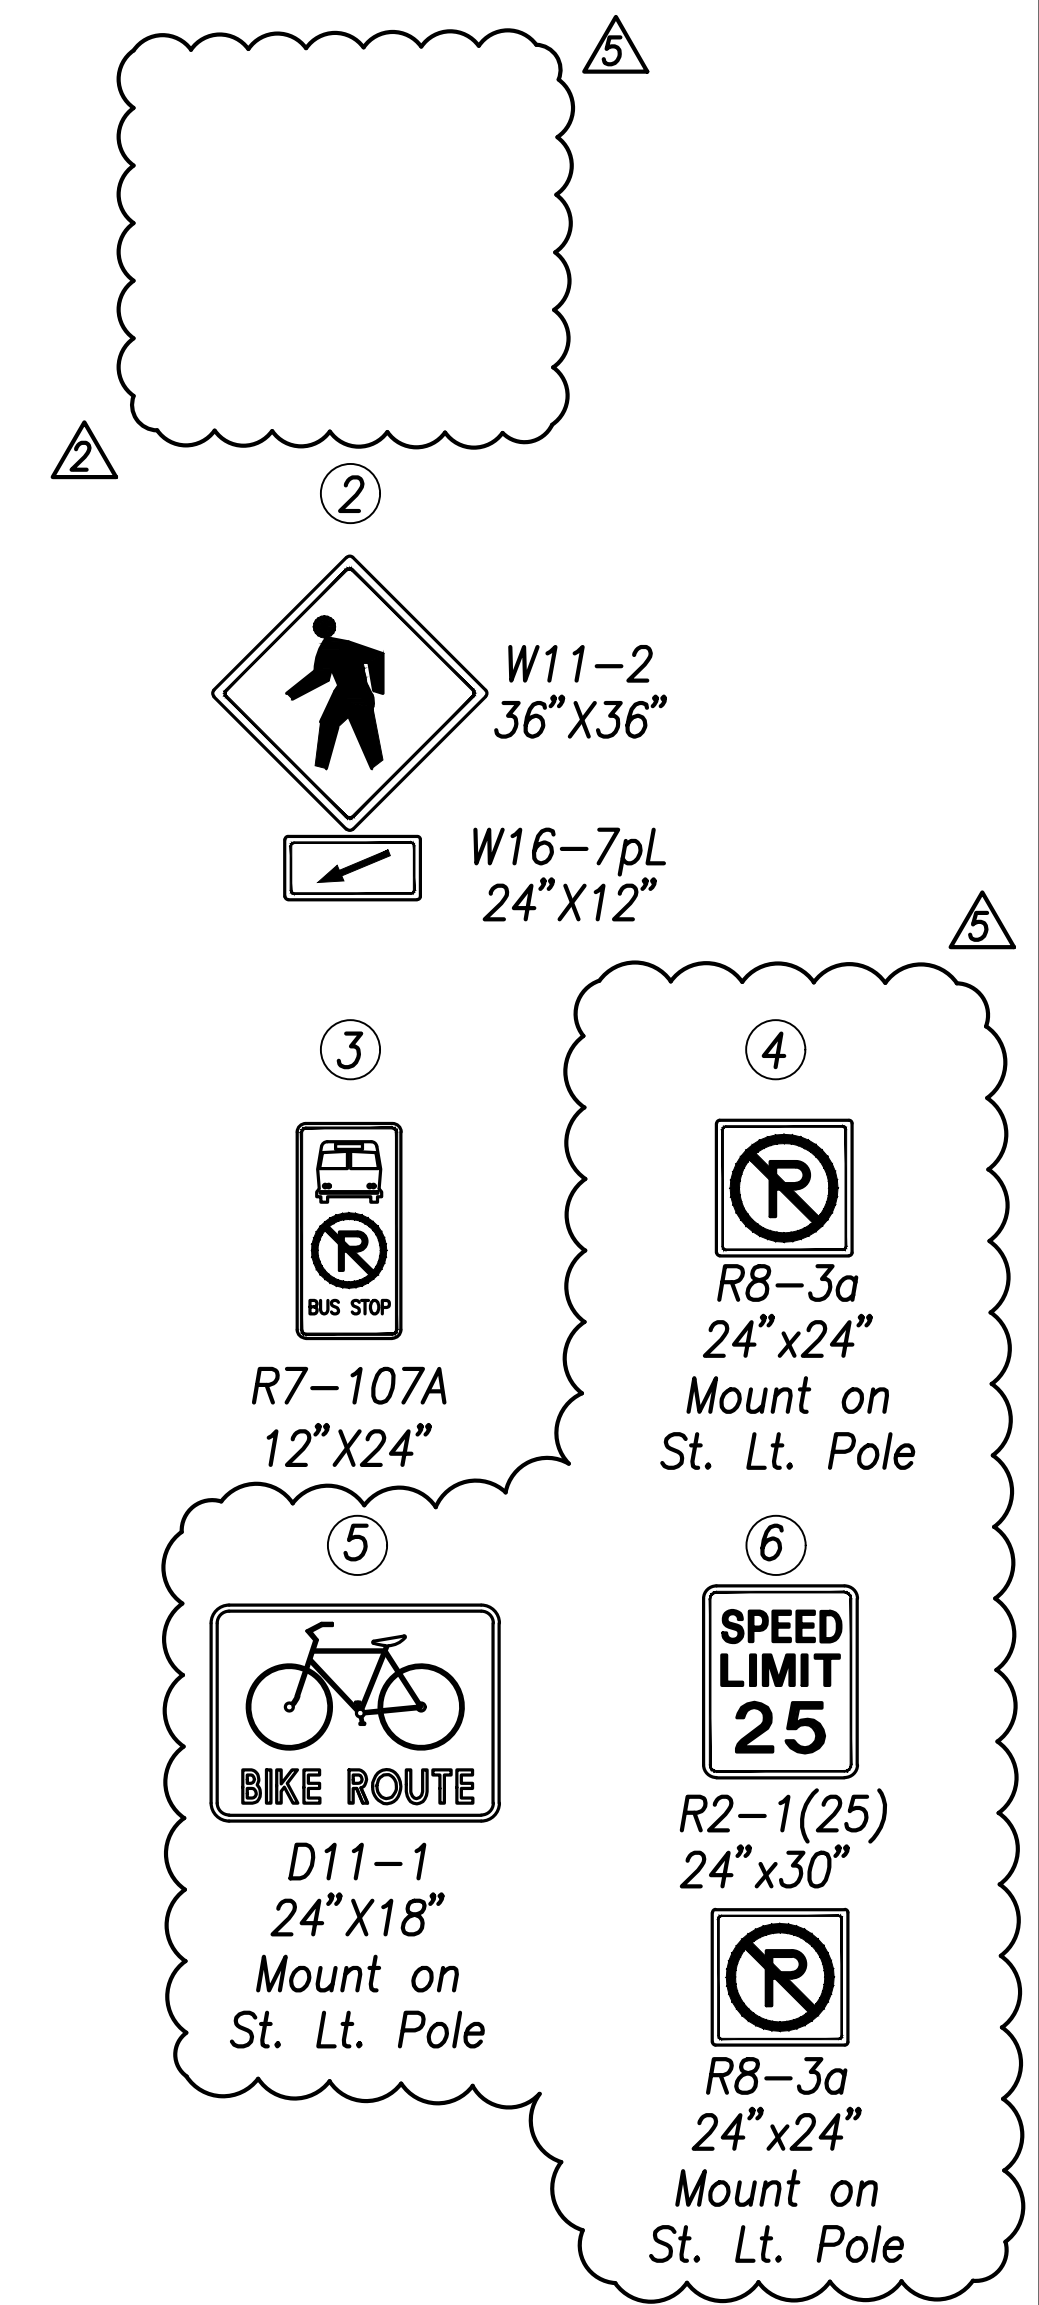

DATE	REVISION
07/15/22	Rev. Signing, Striping, Add callouts
06/08/22	Pav't. Arrow Revised, Crosswalk Signage Added, Turning Vehicles Yield to Pedestrians Sign Removed, Stripe Labels Added

DATE	_____
SURVEY PLOTTED BY	_____
DRAWN BY	_____
TRACED BY	_____
QUANTITIES BY	_____
CHECKED BY	_____
ORIGINAL PLAN	_____
NOTE BOOK	_____
No.	_____



THIS WORK WAS PREPARED BY ME OR UNDER MY SUPERVISION AND CONSTRUCTION OF THIS PROJECT WILL BE UNDER MY OBSERVATION.  
 SIGNATURE: *Craig W. Luke* EXPIRATION DATE OF LICENSE: April 30, 2024

STATE OF HAWAII  
 DEPARTMENT OF TRANSPORTATION  
 HIGHWAYS DIVISION

**Signing and Marking Plan**  
 Sta. 13+00 to Sta. 31+00

FARRINGTON HIGHWAY WIDENING  
 Kapolei Golf Course Road to Fort Weaver Road  
 Project No. 7101A-01-20

Scale: As Shown Date: April 2022


SHEET NO. C-223 OF 767 SHEETS








FED. ROAD DIST. NO.	STATE	PROJ. NO.	FISCAL YEAR	SHEET NO.	TOTAL SHEETS
HAWAII	HAW.	7101A-01-20	2021	226	767

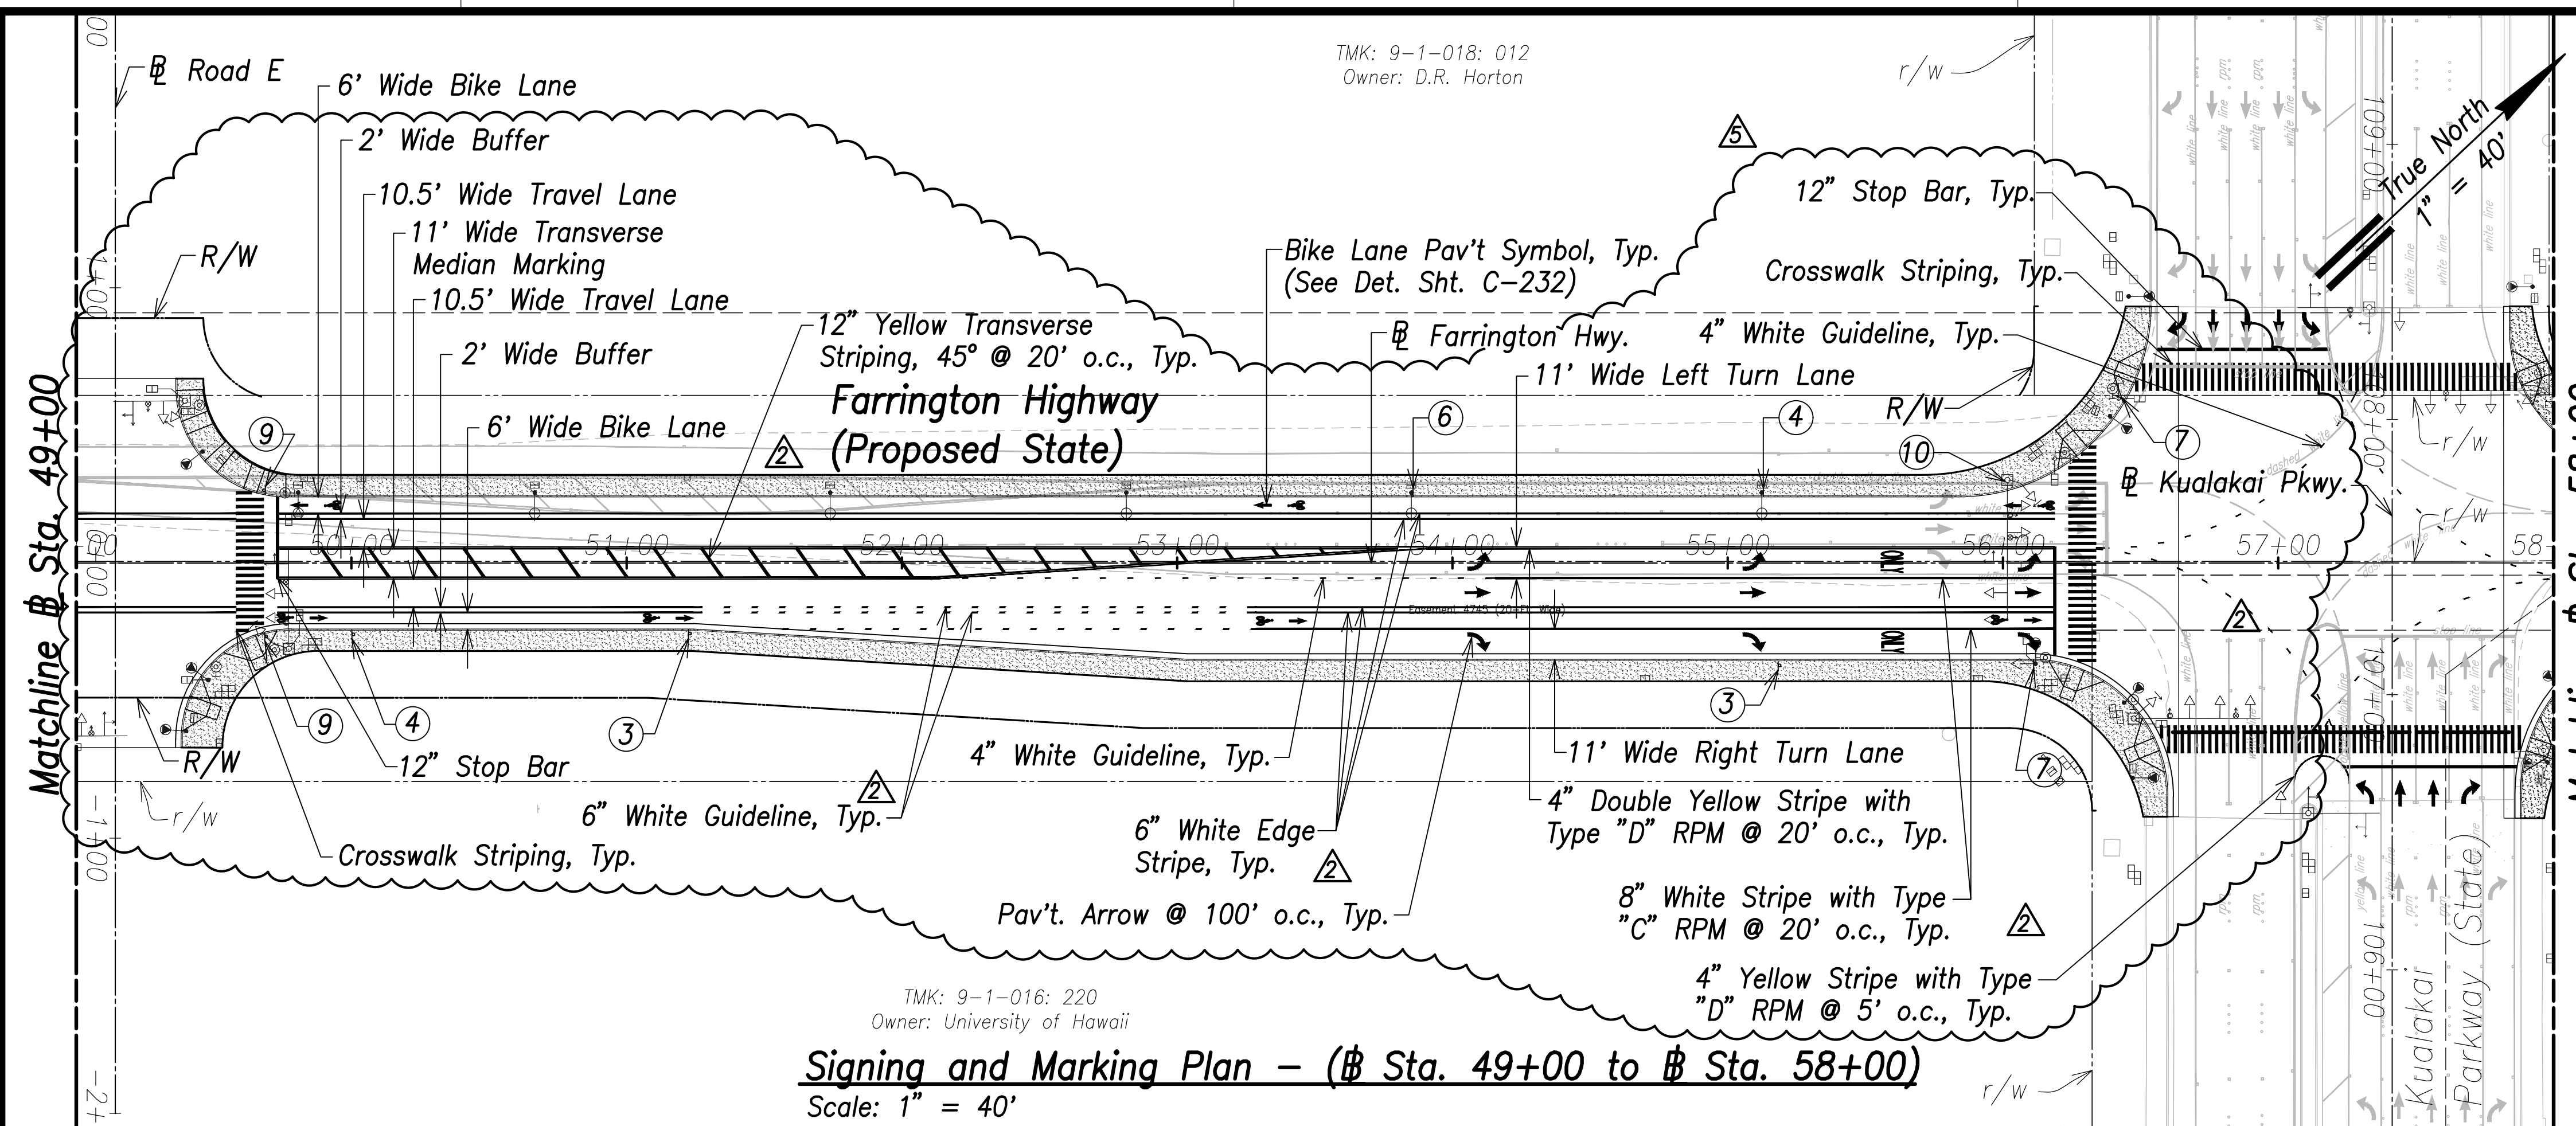

TMK: 9-1-016: 220  
Owner: University of Hawaii  
**Signing and Marking Plan - (# Sta. 49+00 to # Sta. 58+00)**  
Scale: 1" = 40'

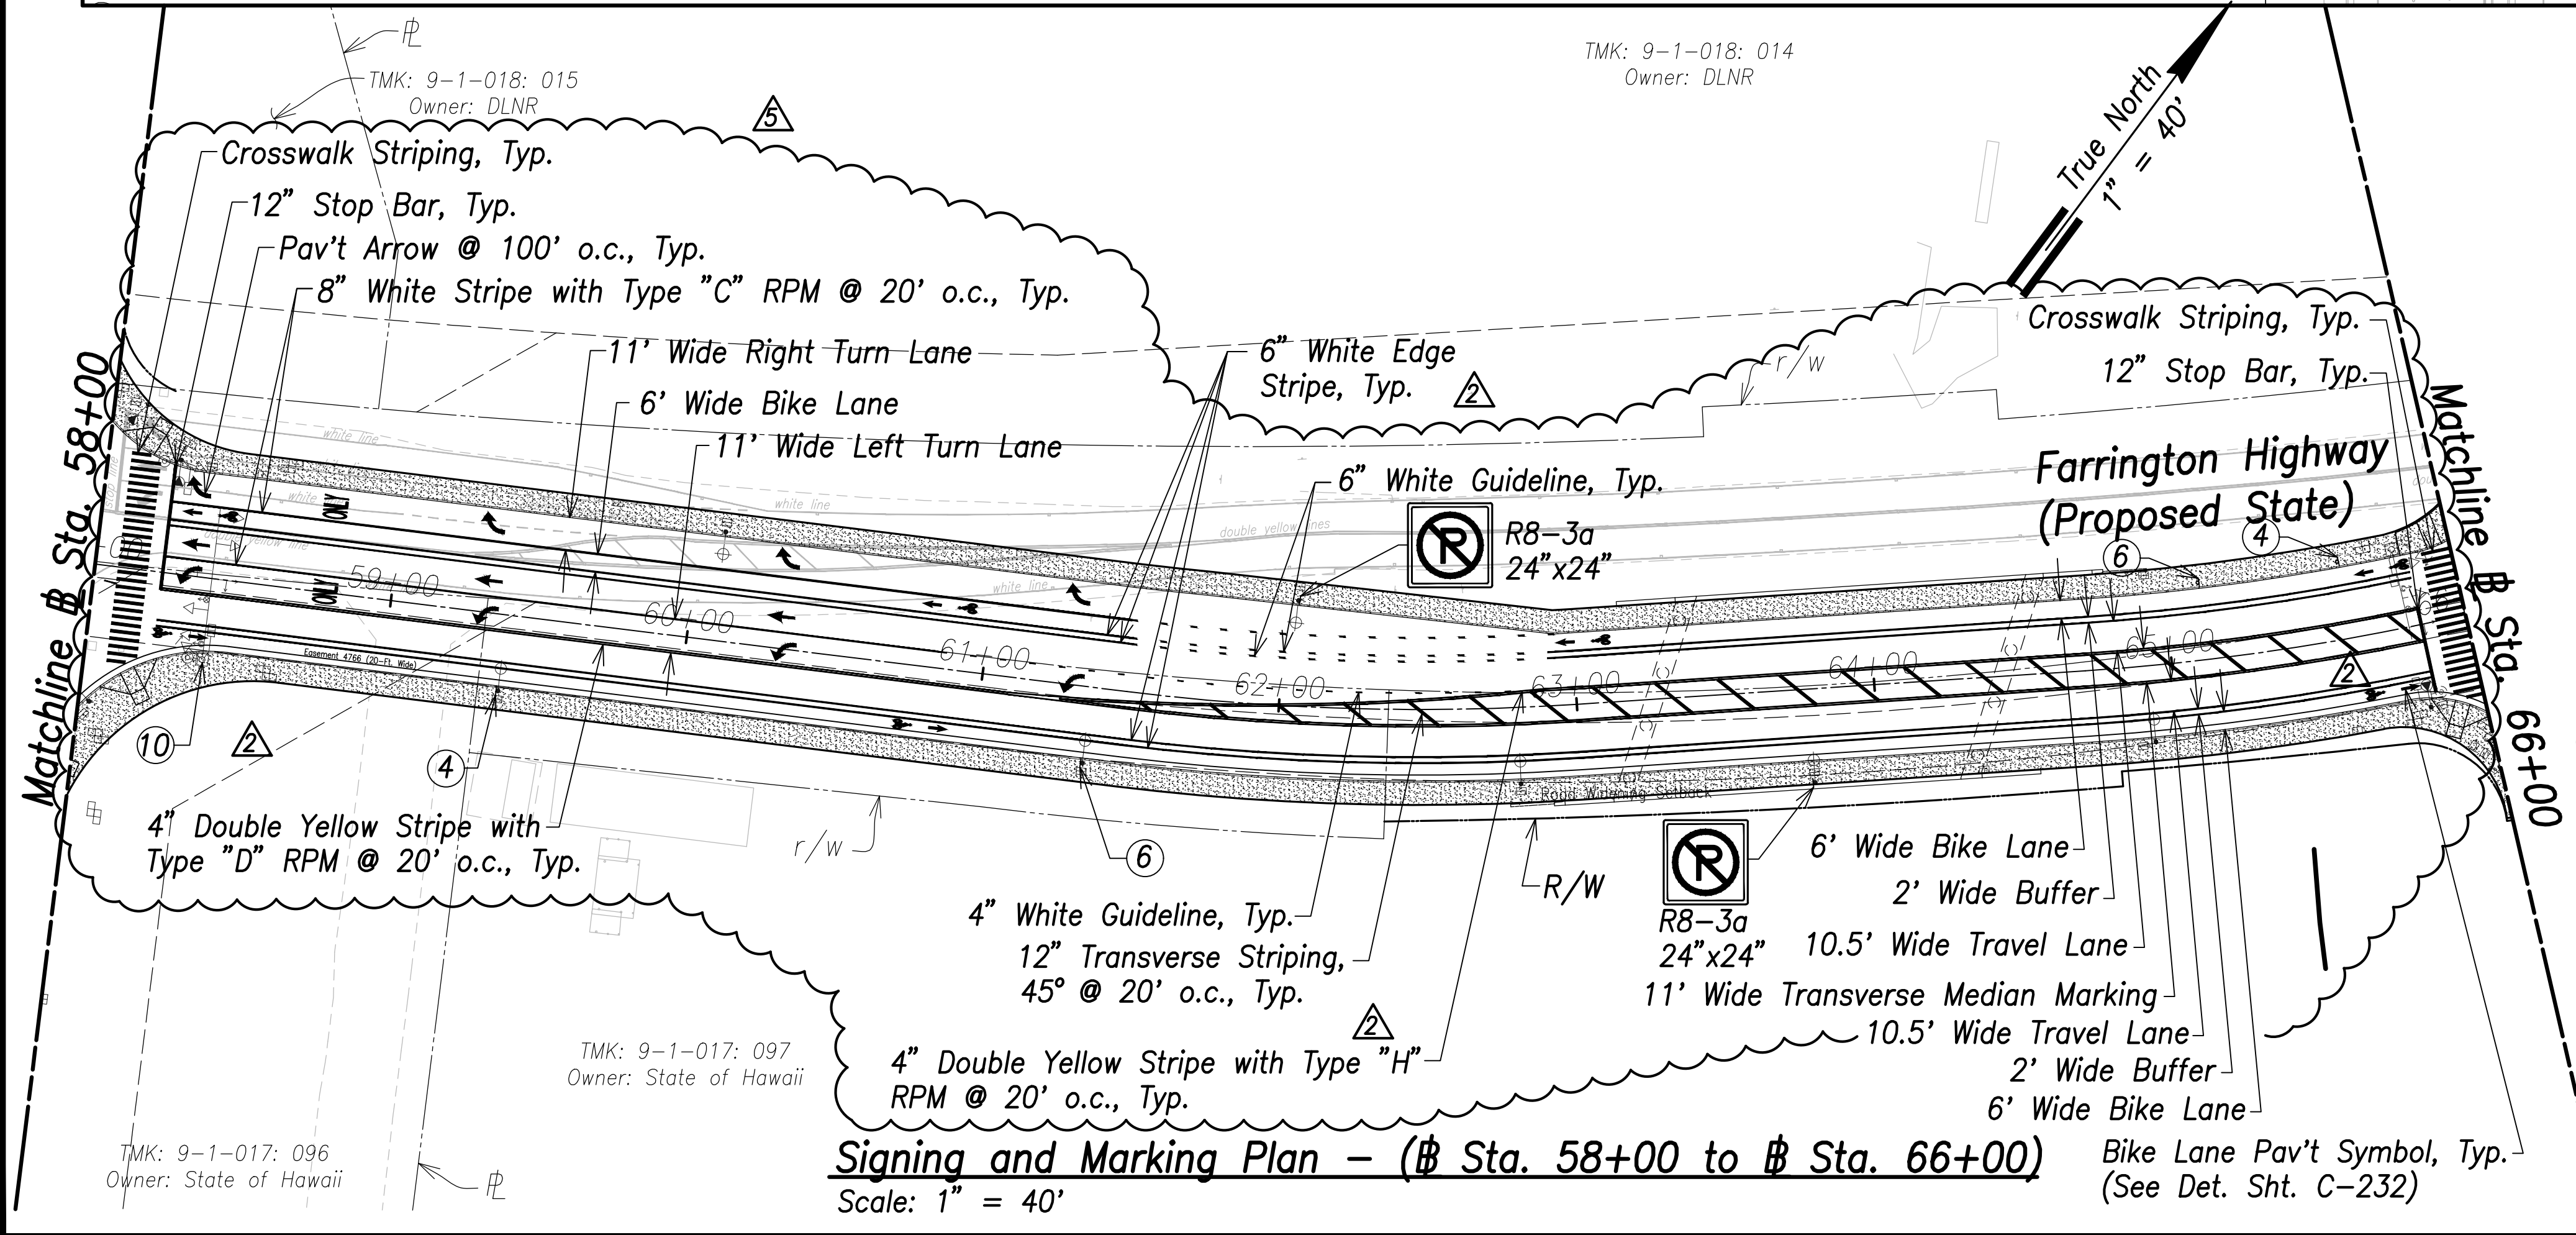

TMK: 9-1-017: 097  
Owner: State of Hawaii  
**Signing and Marking Plan - (# Sta. 58+00 to # Sta. 66+00)**  
Scale: 1" = 40'

**6**

**SPEED LIMIT 25**  
R2-1(25)  
24"x30"

**R8-3a**  
24"x24"

---

**7**

**RIGHT ON RED ARROW AFTER STOP**  
R10-17a  
24"x30"  
Mount on Traffic Signal Pole

---

**3**

**ONLY** **ONLY**  
R3-8a(MOD.)  
45"x30"

**R8-3a**  
24"x24"  
Mount on St. Lt. Pole

---

**4**

**BIKE ROUTE**  
D11-1  
24"x18"  
Mount on St. Lt. Pole

---

**9**


**W11-2**  
36"x36"

**W16-7pL**  
24"x12"

**10**

**ON LEFT GREEN ARROW ONLY**  
R3-5(MOD.)  
30"x42"  
Mount next to signal

**NO U TURN**  
R3-4(MOD.)  
18"x30"  
Mount next to signal

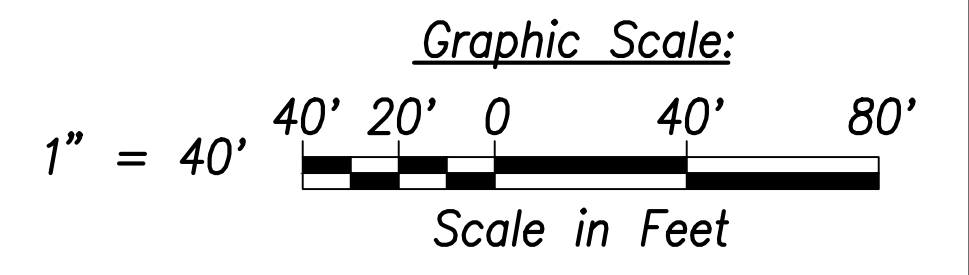

SURVEY PLOTTED BY	DATE
DRAWN BY	
TRACED BY	
QUANTITIES BY	
CHECKED BY	
ORIGINAL PLAN	
NOTE BOOK	
No.	



THIS WORK WAS PREPARED BY ME OR UNDER MY SUPERVISION AND CONSTRUCTION OF THIS PROJECT WILL BE UNDER MY OBSERVATION.  
Signature: *Craig W. Luke*  
April 30, 2024  
EXPIRATION DATE OF THE LICENSE

DATE	REVISION
07/15/22	Rev. Signing, Striping, Add callouts
06/08/22	Turning Vehicles Yield to Pedestrians Sign Removed, Pav't Arrow Revised, Sign Added

STATE OF HAWAII  
DEPARTMENT OF TRANSPORTATION  
HIGHWAYS DIVISION


**Signing and Marking Plan**  
# Sta. 49+00 to # Sta. 66+00  
FARRINGTON HIGHWAY WIDENING  
Kapolei Golf Course Road to Fort Weaver Road  
Project No. 7101A-01-20

Scale: As Shown Date: April 2022


**SHEET NO. C-225 OF 767 SHEETS**



FED. ROAD DIST. NO.	STATE	PROJ. NO.	FISCAL YEAR	SHEET NO.	TOTAL SHEETS
HAWAII	HAW.	7101A-01-20	2021	227	767

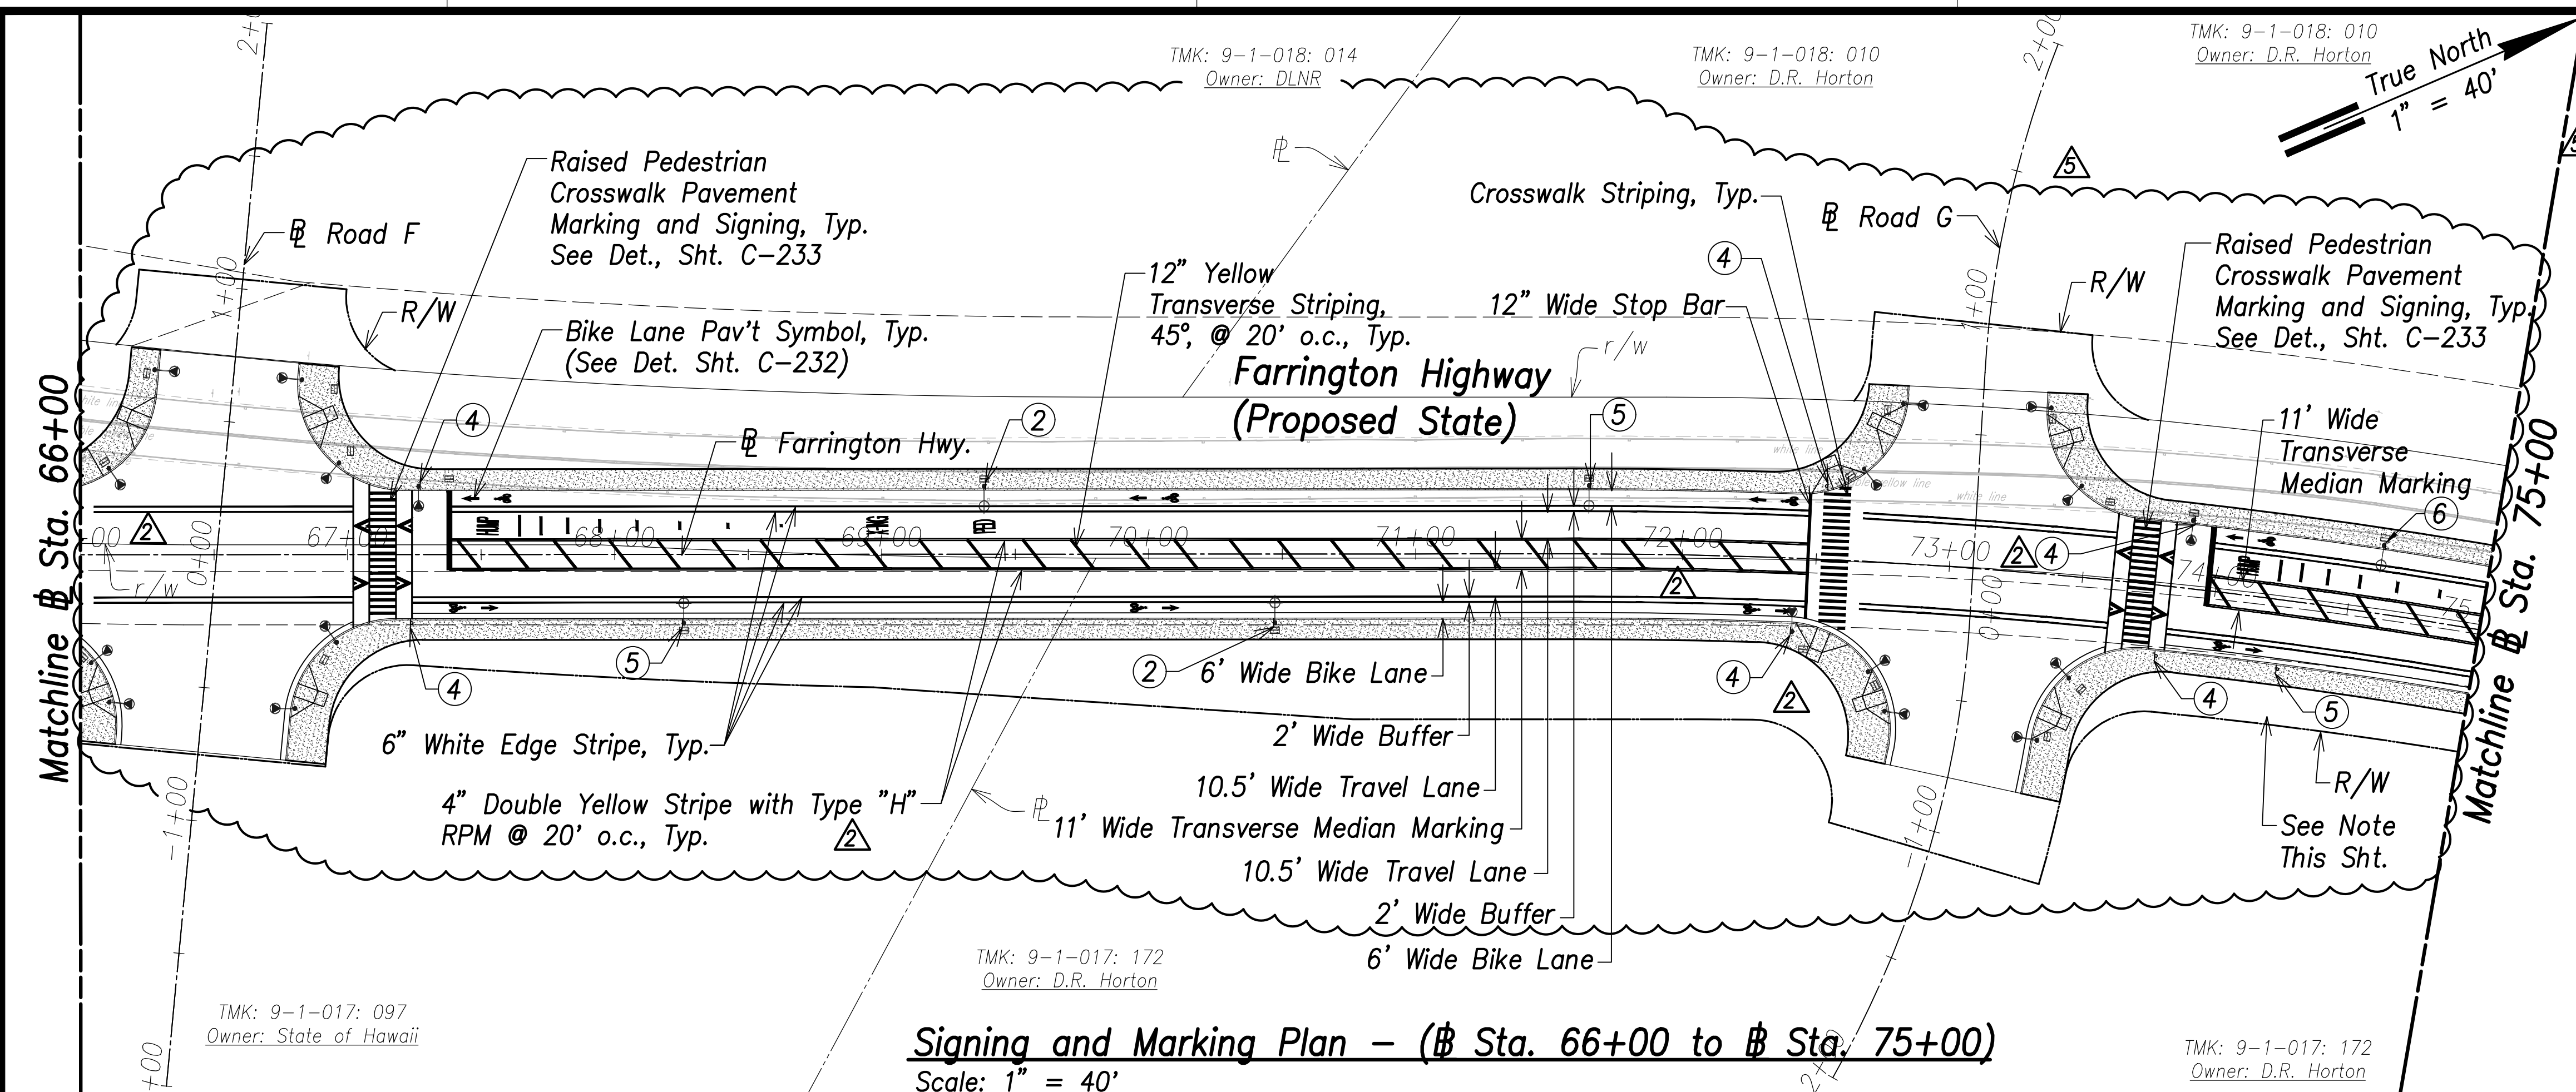

**Signing and Marking Plan - (Sta. 66+00 to Sta. 75+00)**  
Scale: 1" = 40'

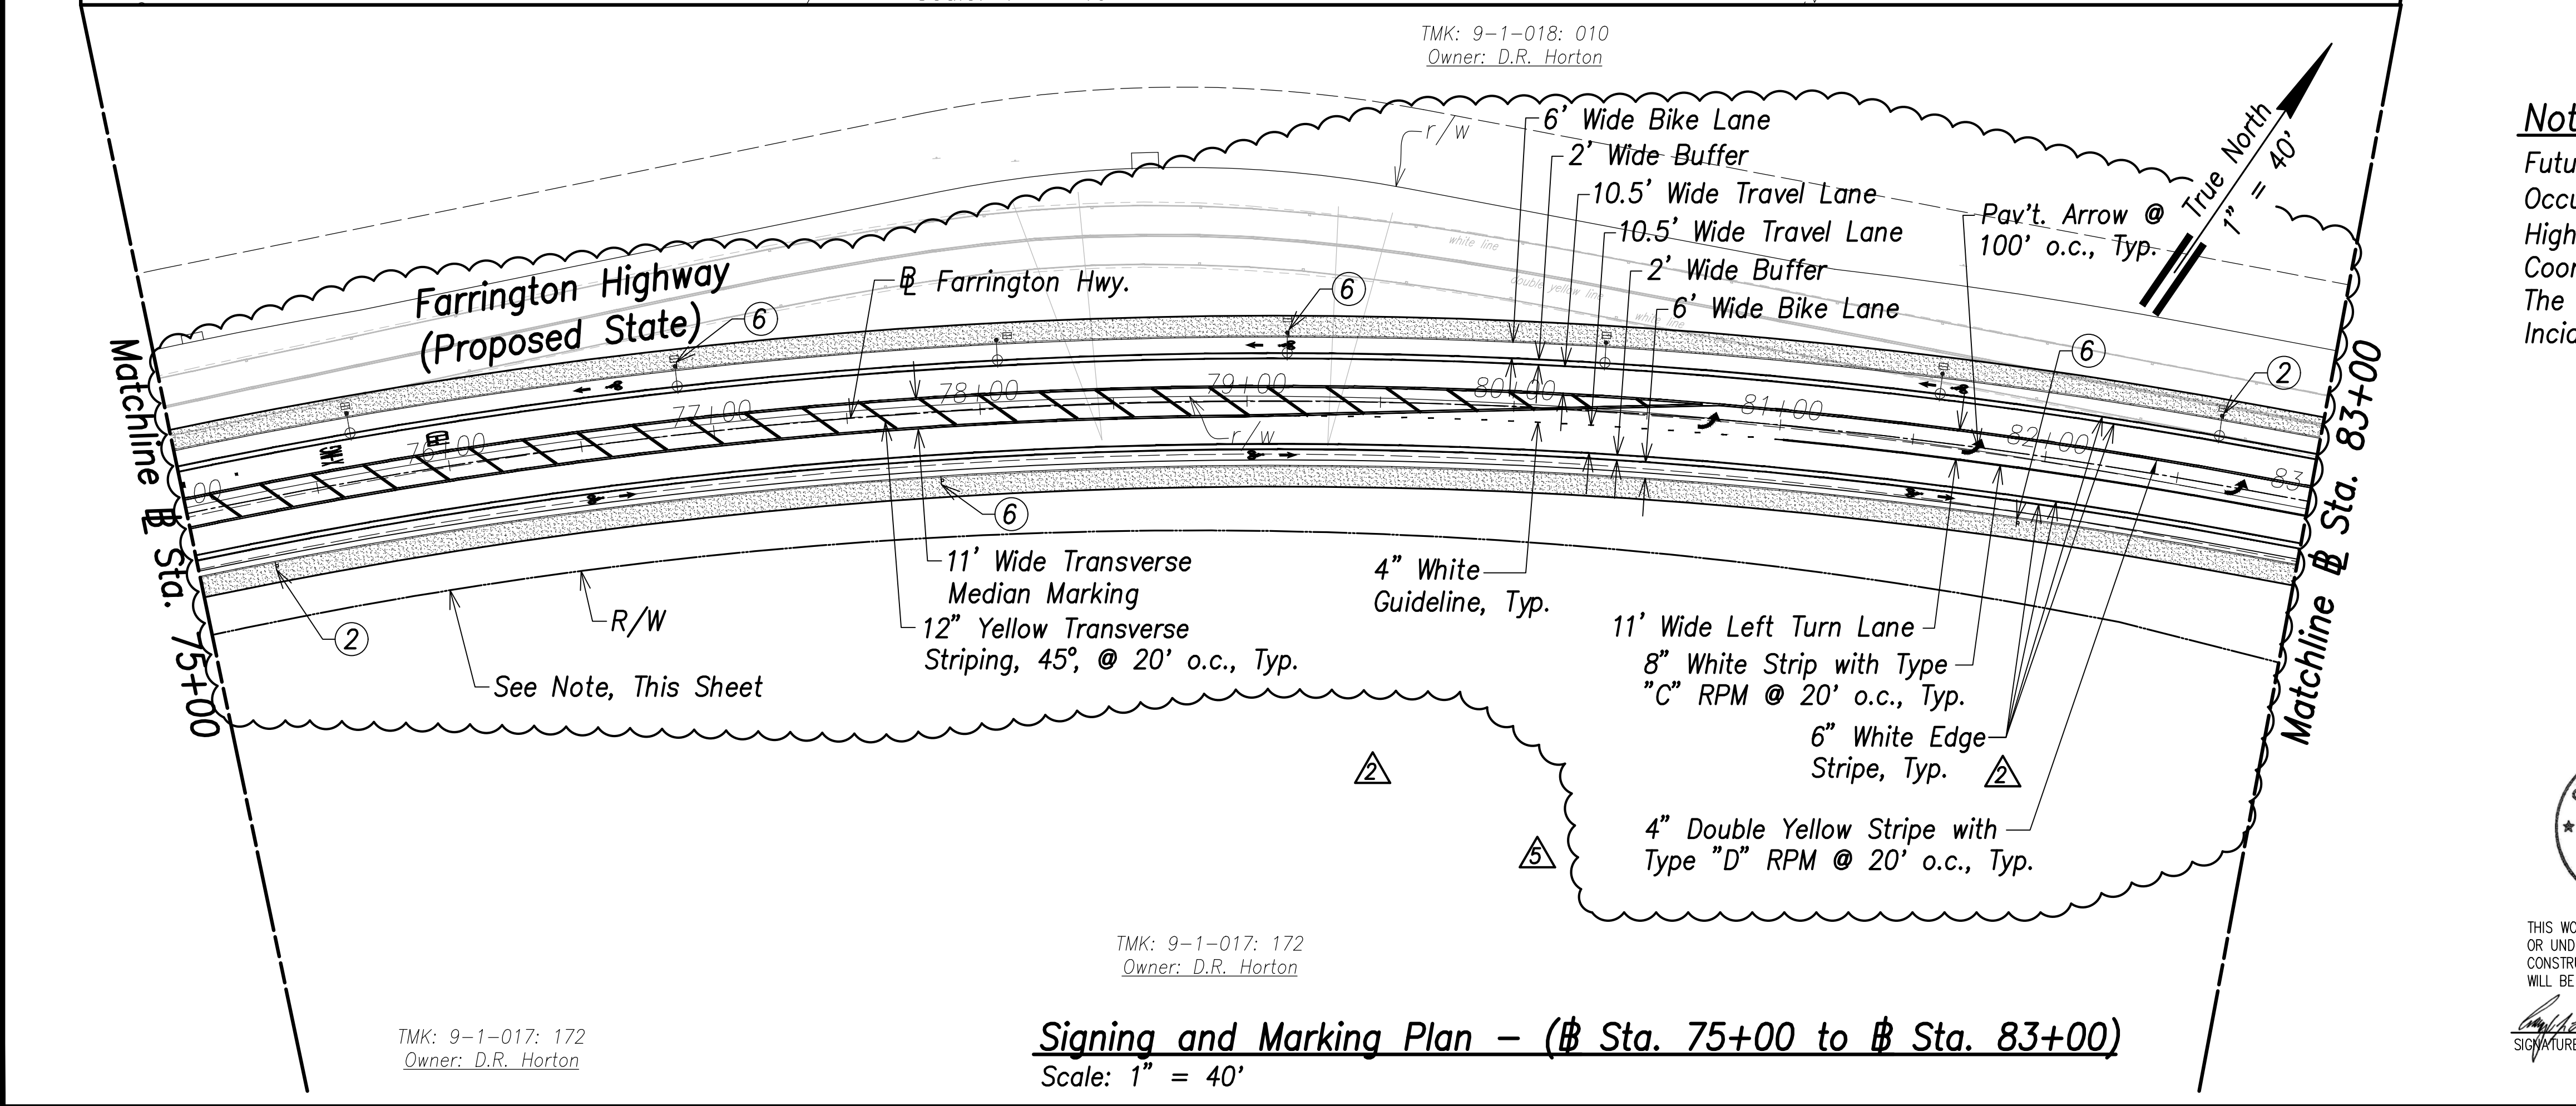

**Signing and Marking Plan - (Sta. 75+00 to Sta. 83+00)**  
Scale: 1" = 40'

True North  
1" = 40'

② SPEED LIMIT 25 R2-1(25) 24"x30"

③ R8-3a 24"x24"


④ W11-2 36"x36"

⑤ W16-7pL 24"x12"

⑤ BIKE ROUTE  
D11-1 24"x18" Mount on St. Lt. Pole

⑥ R8-3a 24"x24" Mount on St. Lt. Pole

**Note:**  
Future HECO Electrical System, Construction Will Occur at the Same as this Project (Farrington Highway Improvements). The Contractor Shall Fully Coordinate Work with HECO and their Contractor. The Cost to Coordinate Work Will be Considered Incidental to the Various Items of Work.

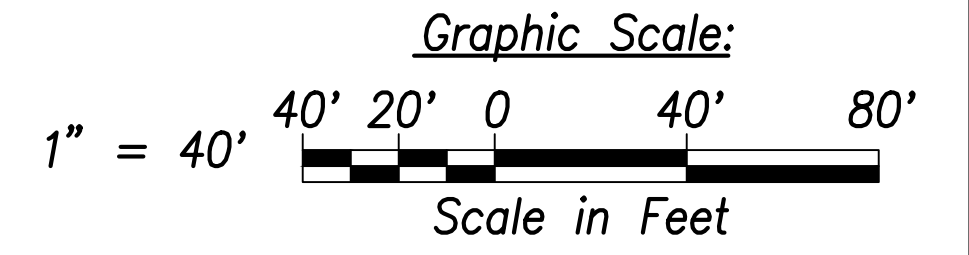

DATE	REVISION
07/15/22	Rev. Signing, Striping, Add callouts
06/08/22	Turning Vehicles Yield to Pedestrians Sign Removed, Pav't Arrow Revised, Stripe Label Added

ORANG W. L. LUKE  
LICENSED PROFESSIONAL ENGINEER  
No. 6935-C  
HAWAII, U.S.A.

THIS WORK WAS PREPARED BY ME OR UNDER MY SUPERVISION AND CONSTRUCTION OF THIS PROJECT WILL BE UNDER MY OBSERVATION.

APR 30, 2024  
EXPIRATION DATE OF THE LICENSE

STATE OF HAWAII  
DEPARTMENT OF TRANSPORTATION  
HIGHWAYS DIVISION

**Signing and Marking Plan**  
Sta. 66+00 to Sta. 83+00

FARRINGTON HIGHWAY WIDENING  
Kapolei Golf Course Road to Fort Weaver Road  
Project No. 7101A-01-20


Scale: As Shown Date: April 2022

SHEET NO. C-226 OF 767 SHEETS

DATE	SURVEY PLOTTED BY
DATE	DRAWN BY
DATE	TRACED BY
DATE	QUANTITIES BY
DATE	CHECKED BY

FILE: K:\civil\23146 Farrington Hwy Widening\Drawings\Construction\Drawings\C-226 Striping Plan - Sta. 66+00 to 83+00.dwg saved July 7, 2022


TMK: 9-1-018: 010  
Owner: D.R. Horton

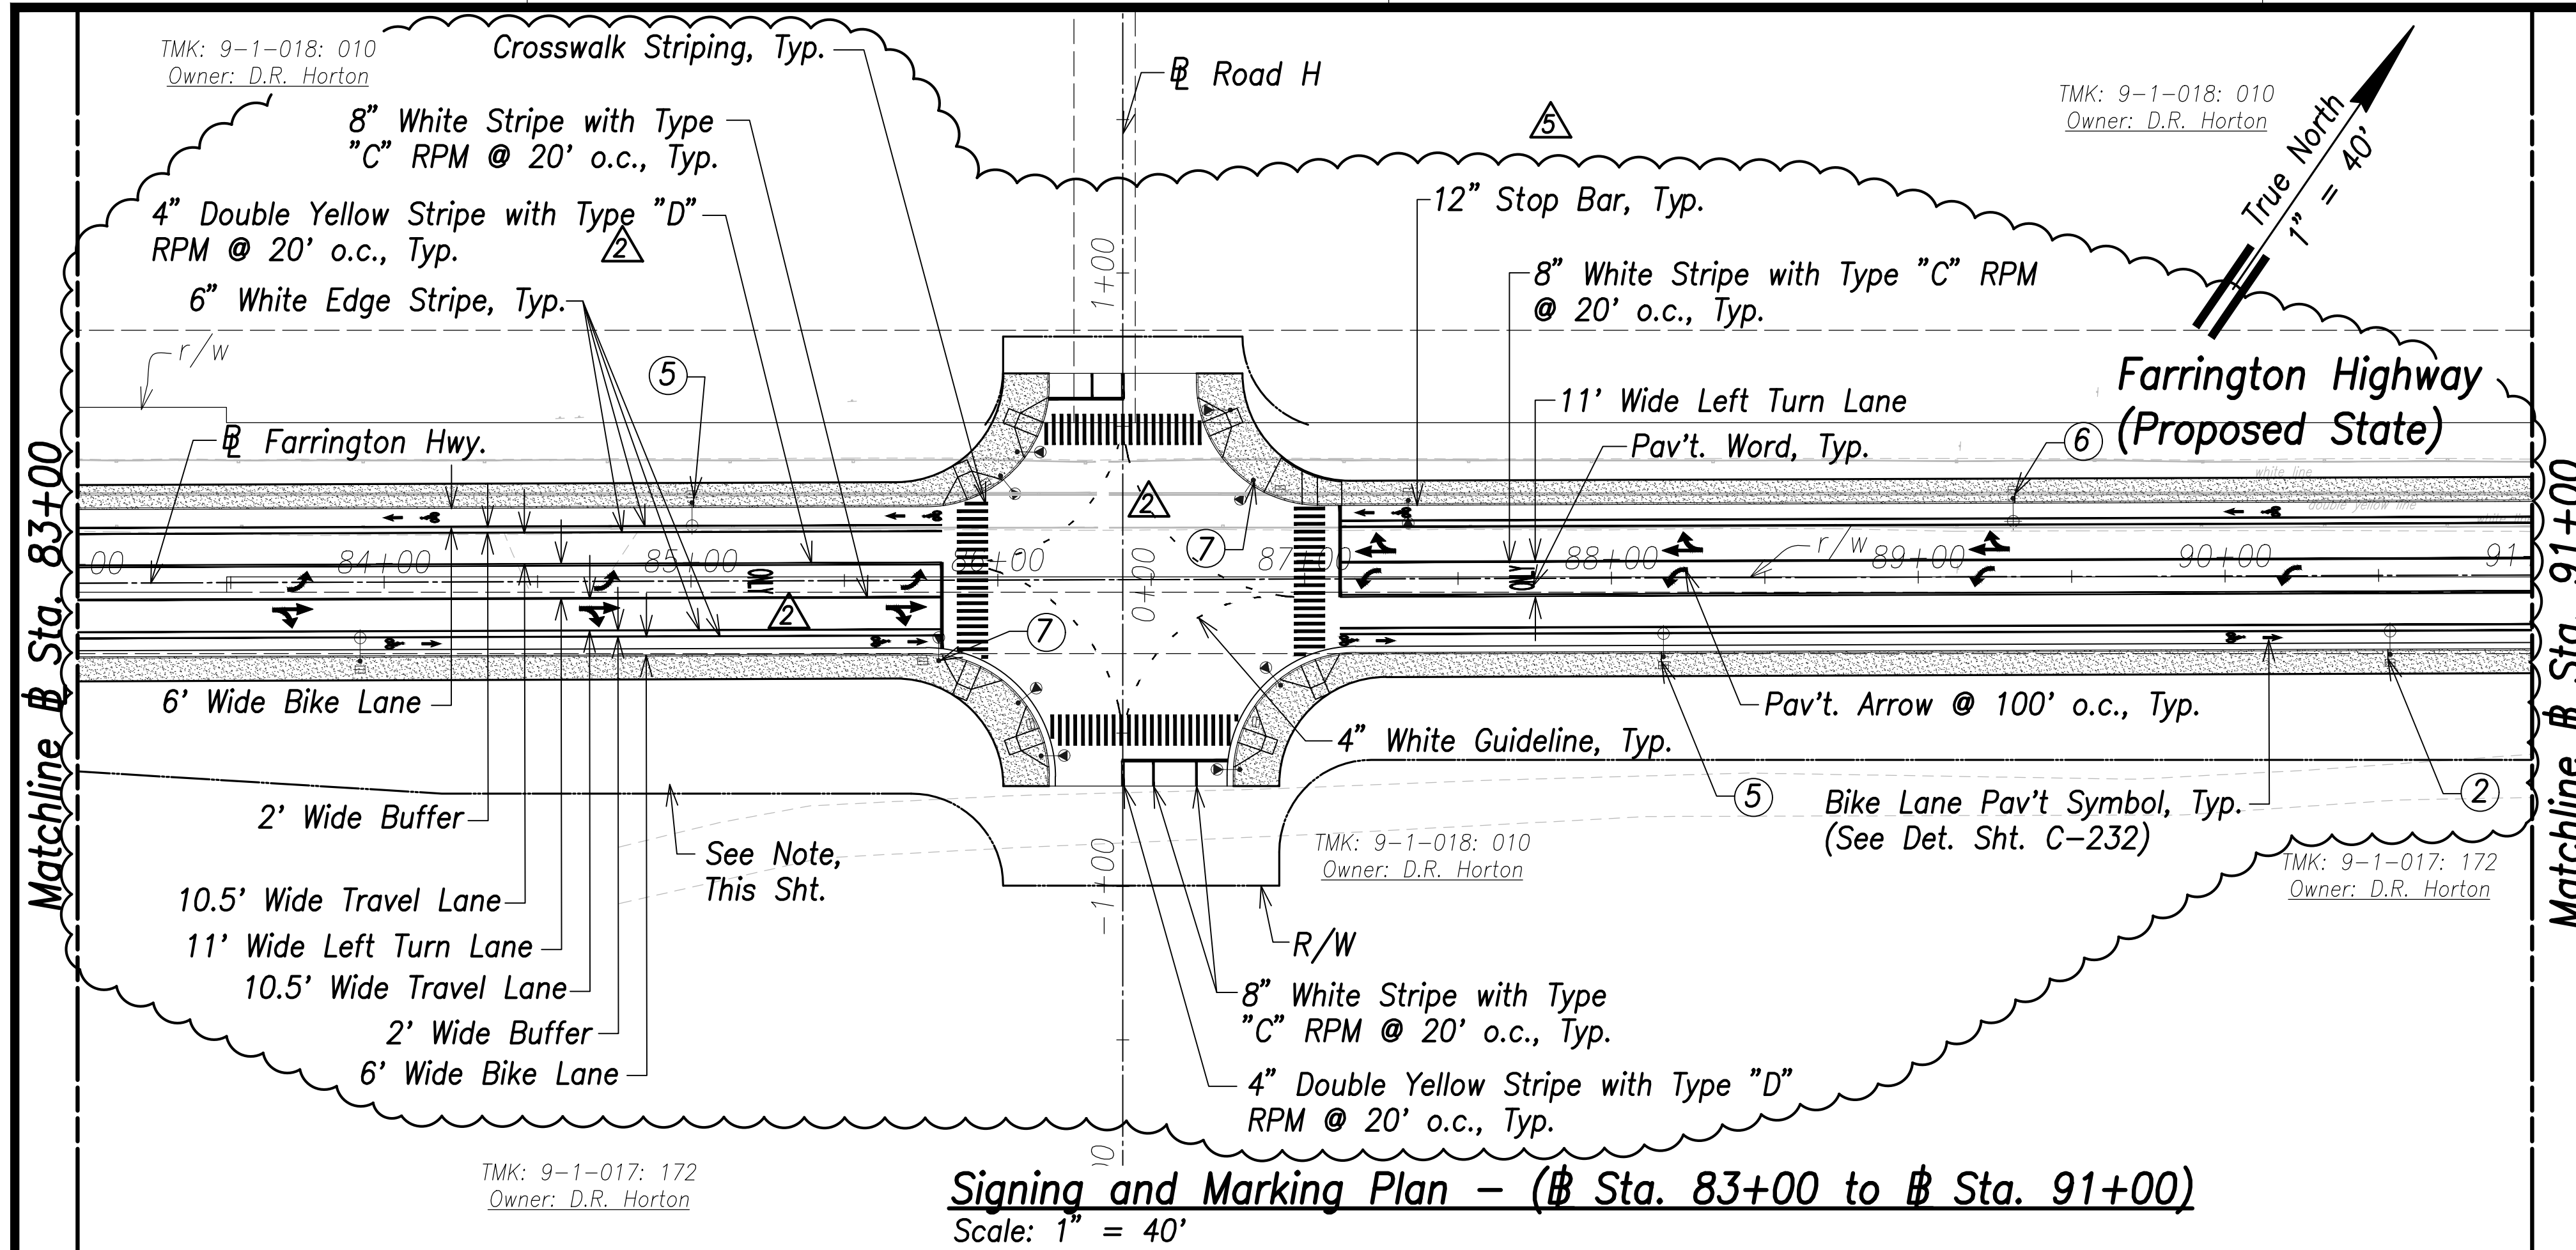

**Signing and Marking Plan - (Sta. 83+00 to Sta. 91+00)**  
Scale: 1" = 40'

TMK: 9-1-017: 172  
Owner: D.R. Horton

TMK: 9-1-018: 010  
Owner: D.R. Horton

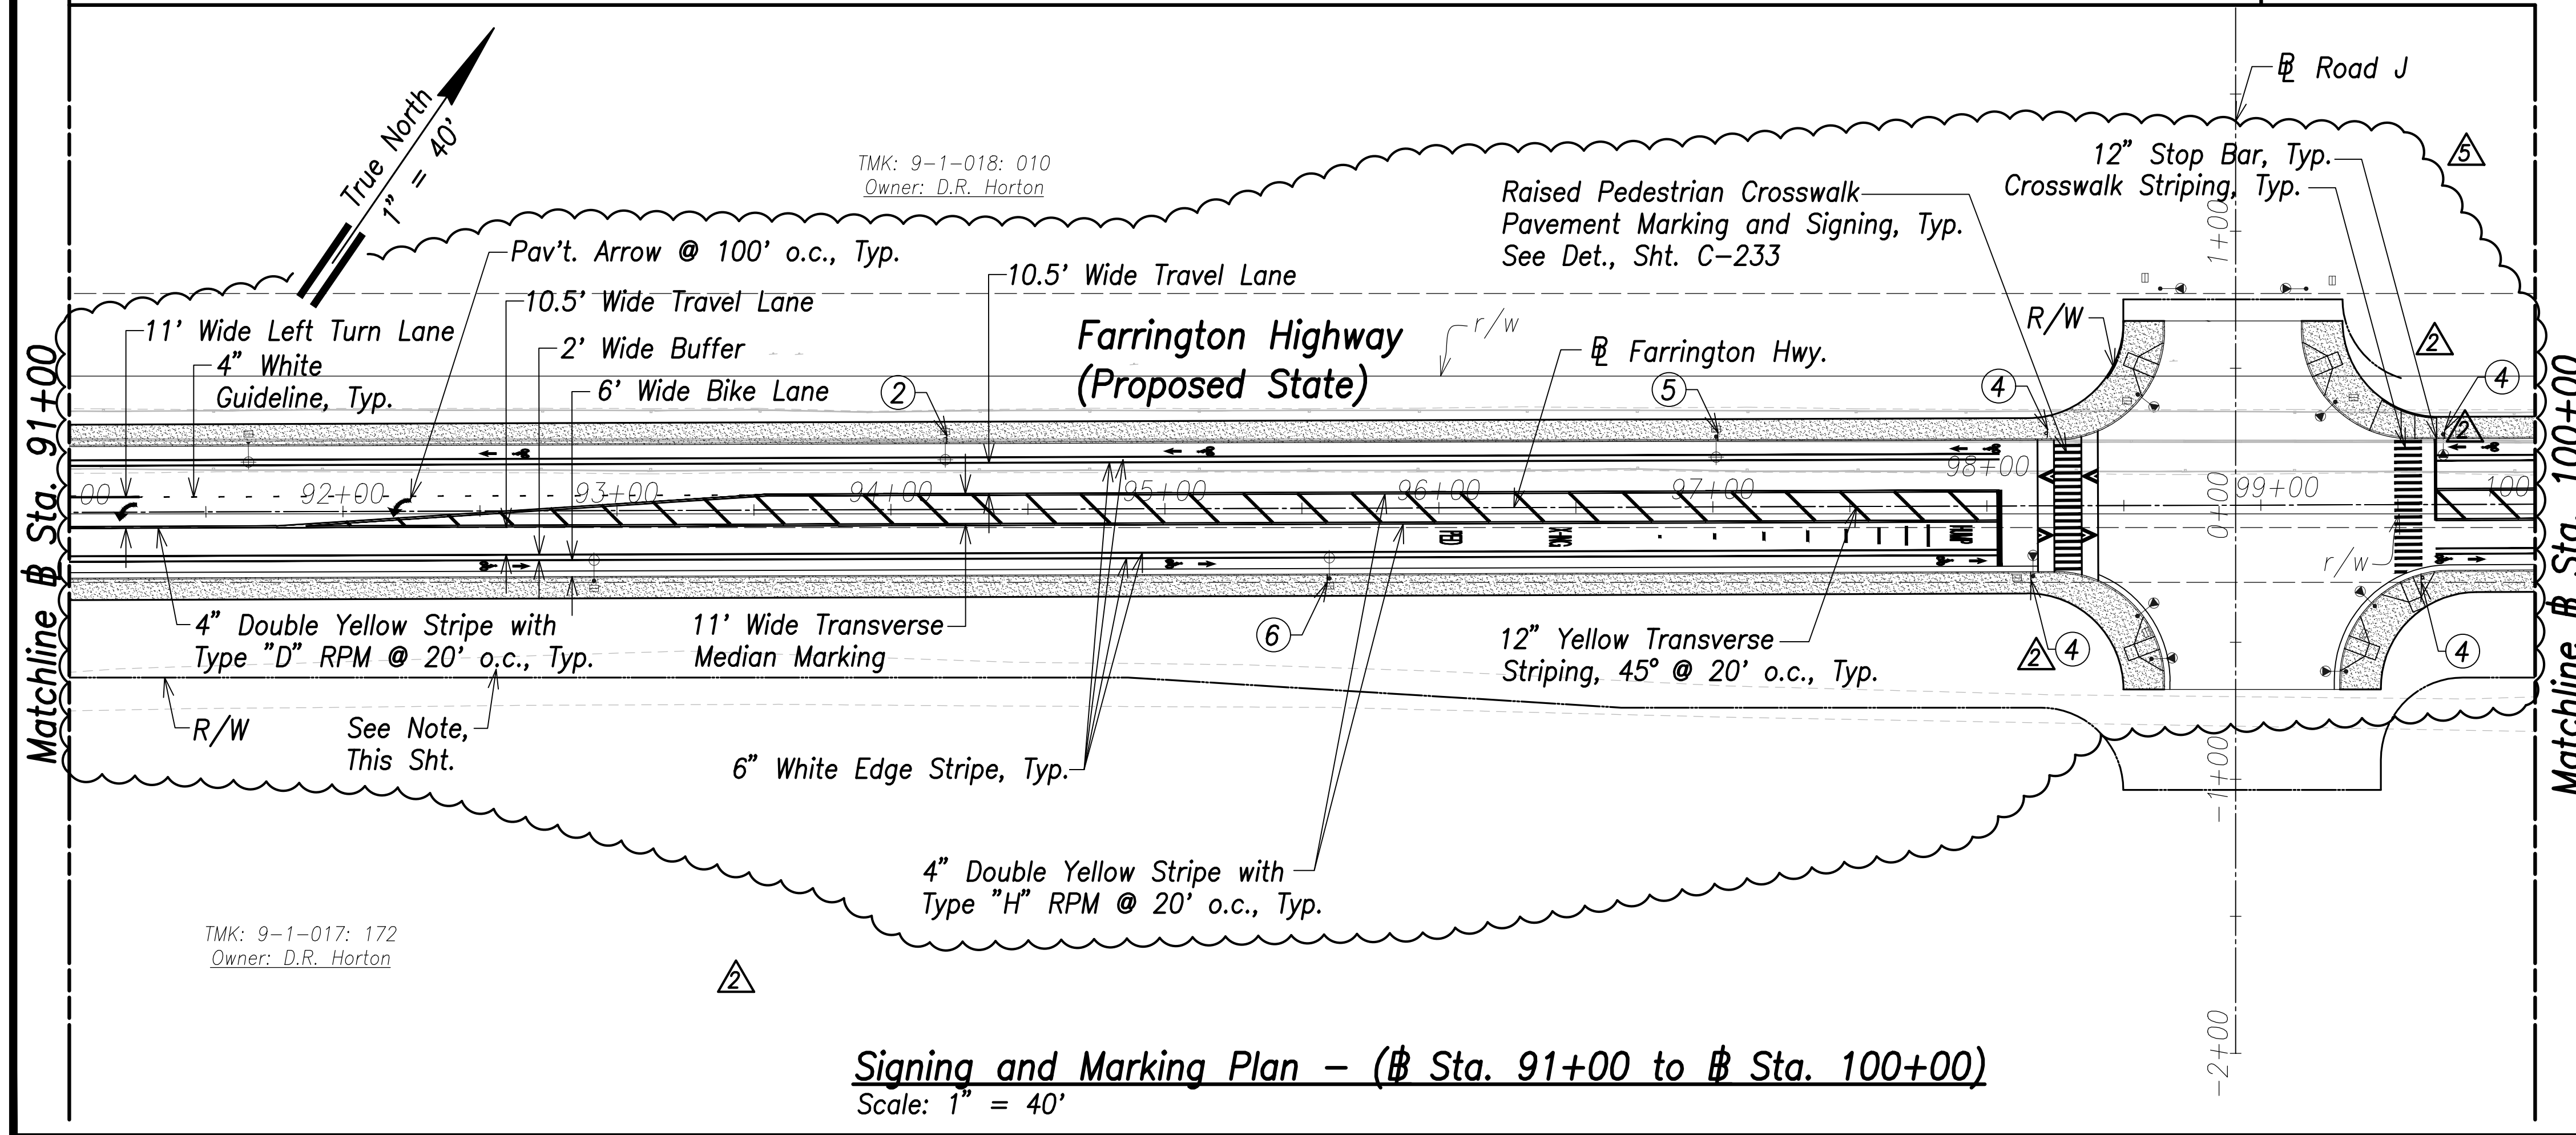

**Signing and Marking Plan - (Sta. 91+00 to Sta. 100+00)**  
Scale: 1" = 40'

TMK: 9-1-017: 172  
Owner: D.R. Horton

FED. ROAD DIST. NO.	STATE	PROJ. NO.	FISCAL YEAR	SHEET NO.	TOTAL SHEETS
HAWAII	HAW.	7101A-01-20	2021	228	767

③

②

④

⑤

⑥

⑦

**BIKE ROUTE**  
D11-1  
24"X18"  
Mount on St. Lt. Pole

**SPEED LIMIT 25**  
R2-1(25)  
24"x30"

**R8-3a**  
24"x24"


**W11-2**  
36"x36"

**W16-7pL**  
24"x12"

**R8-3a**  
24"x24"

**Note:**

Future HECO Electrical System, Construction Will Occur at the Same as this Project (Farrington Highway Improvements). The Contractor Shall Fully Coordinate Work with HECO and their Contractor. The Cost to Coordinate Work Will be Considered Incidental to the Various Items of Work.

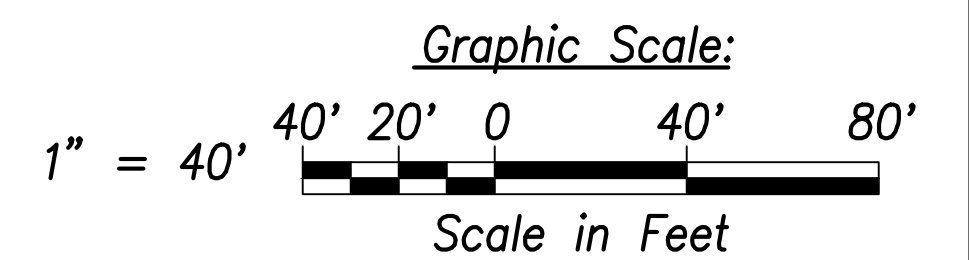

DATE	REVISION
07/15/22	Rev. Signing, Striping, Add callouts
06/08/22	Turning Vehicles Yield to Pedestrians Sign Removed, Stripes Added, Stripe Label Added



THIS WORK WAS PREPARED BY ME OR UNDER MY SUPERVISION AND CONSTRUCTION OF THIS PROJECT WILL BE UNDER MY OBSERVATION.

Signature: *Craig W. Luke*  
April 30, 2024  
EXPIRATION DATE OF THE LICENSE

STATE OF HAWAII  
DEPARTMENT OF TRANSPORTATION  
HIGHWAYS DIVISION

**Signing and Marking Plan**  
Sta. 83+00 to Sta. 100+00

FARRINGTON HIGHWAY WIDENING  
Kapolei Golf Course Road to Fort Weaver Road  
Project No. 7101A-01-20


Scale: As Shown Date: April 2022

SHEET NO. C-227 OF 767 SHEETS


DATE	SURVEY PLOTTED BY
DATE	DRAWN BY
DATE	TRACED BY
DATE	QUANTITIES BY
DATE	CHECKED BY



FED. ROAD DIST. NO.	STATE	PROJ. NO.	FISCAL YEAR	SHEET NO.	TOTAL SHEETS
HAWAII	HAW.	7101A-01-20	2021	229	767

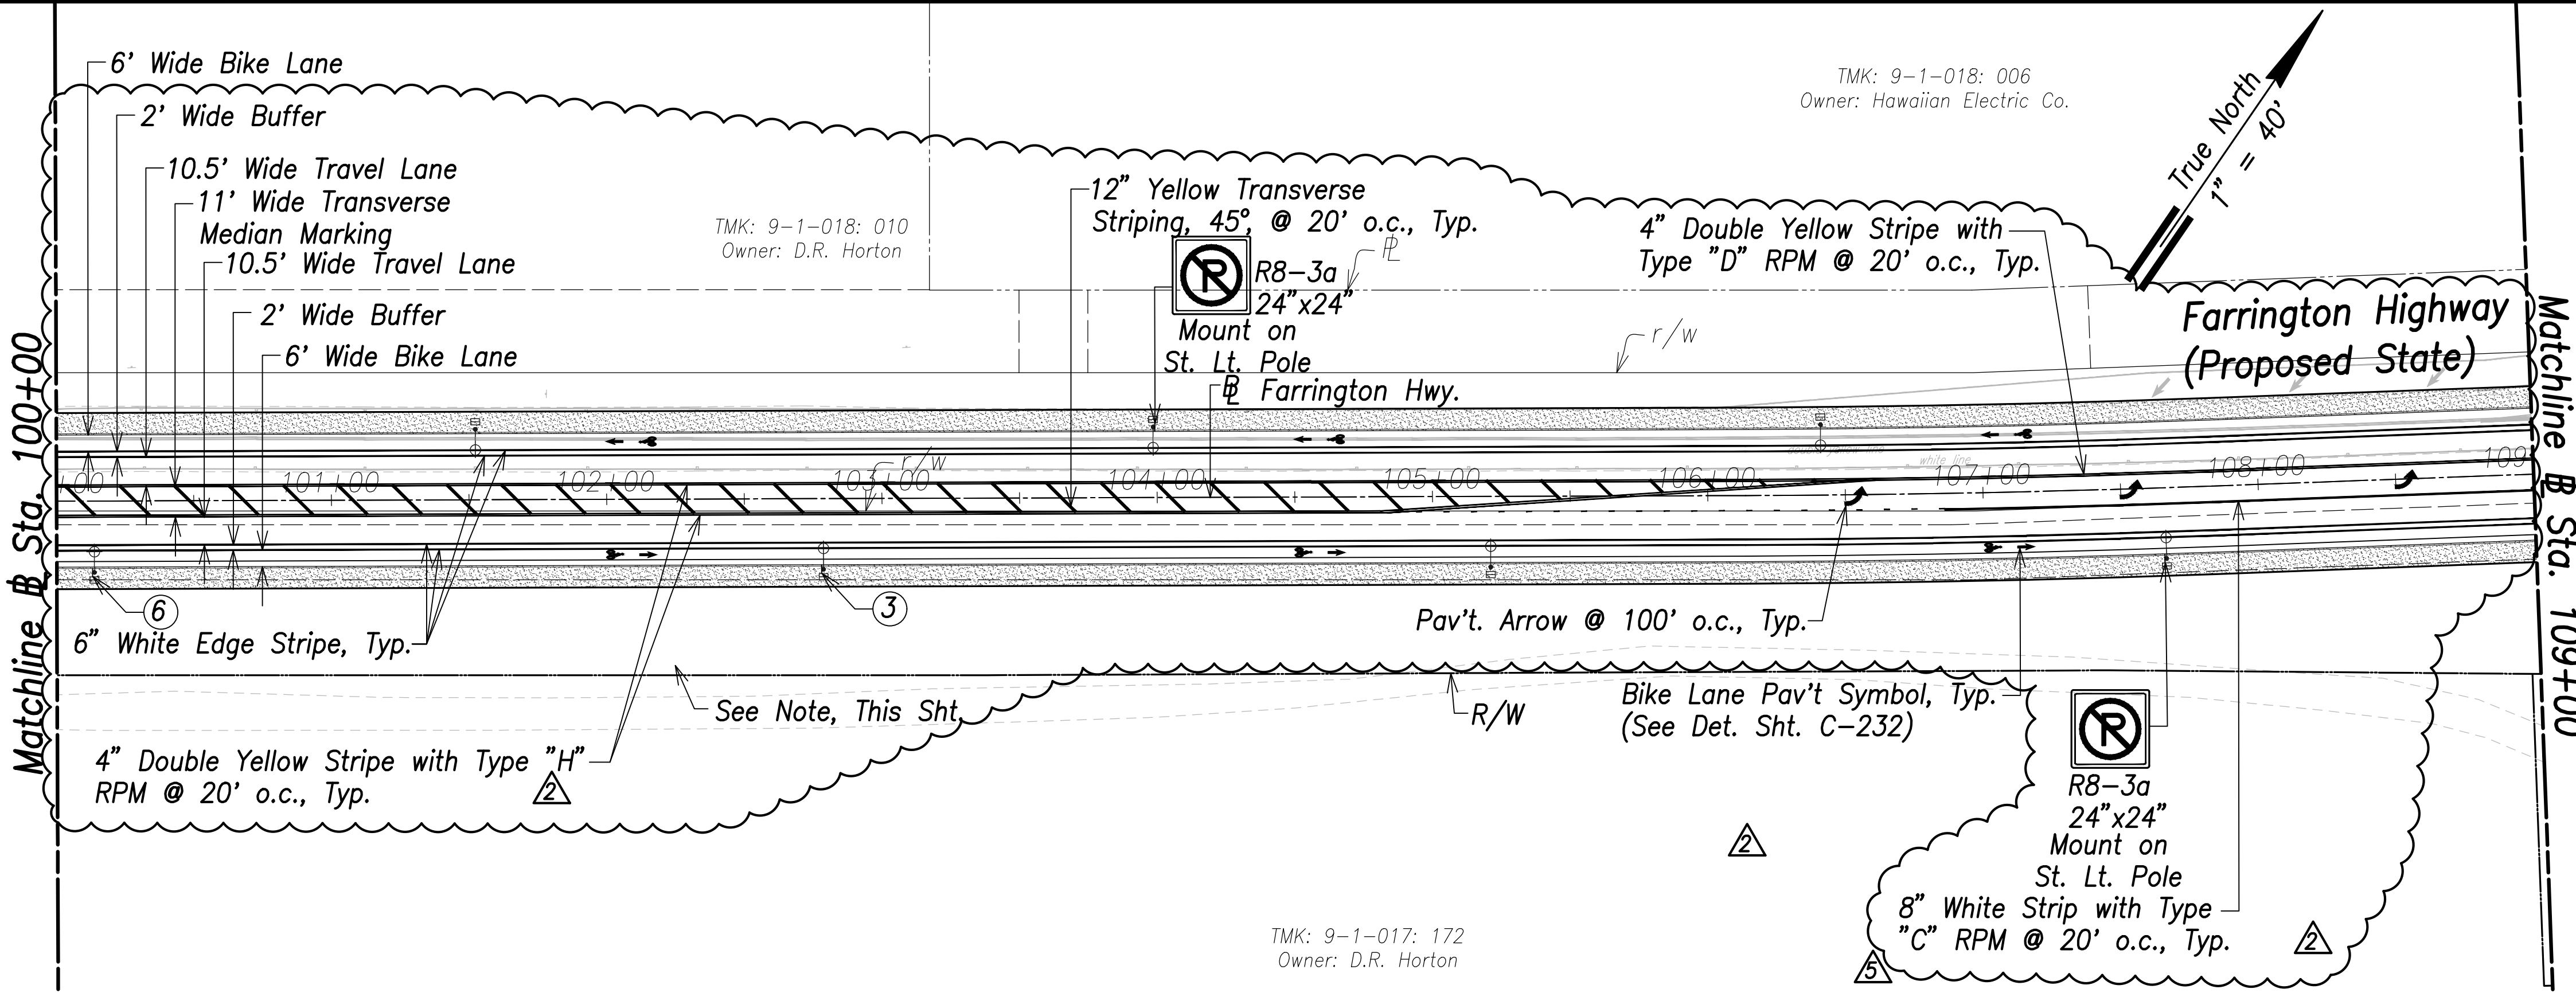

**Signing and Marking Plan - (Sta. 100+00 to Sta. 109+00)**  
Scale: 1" = 40'

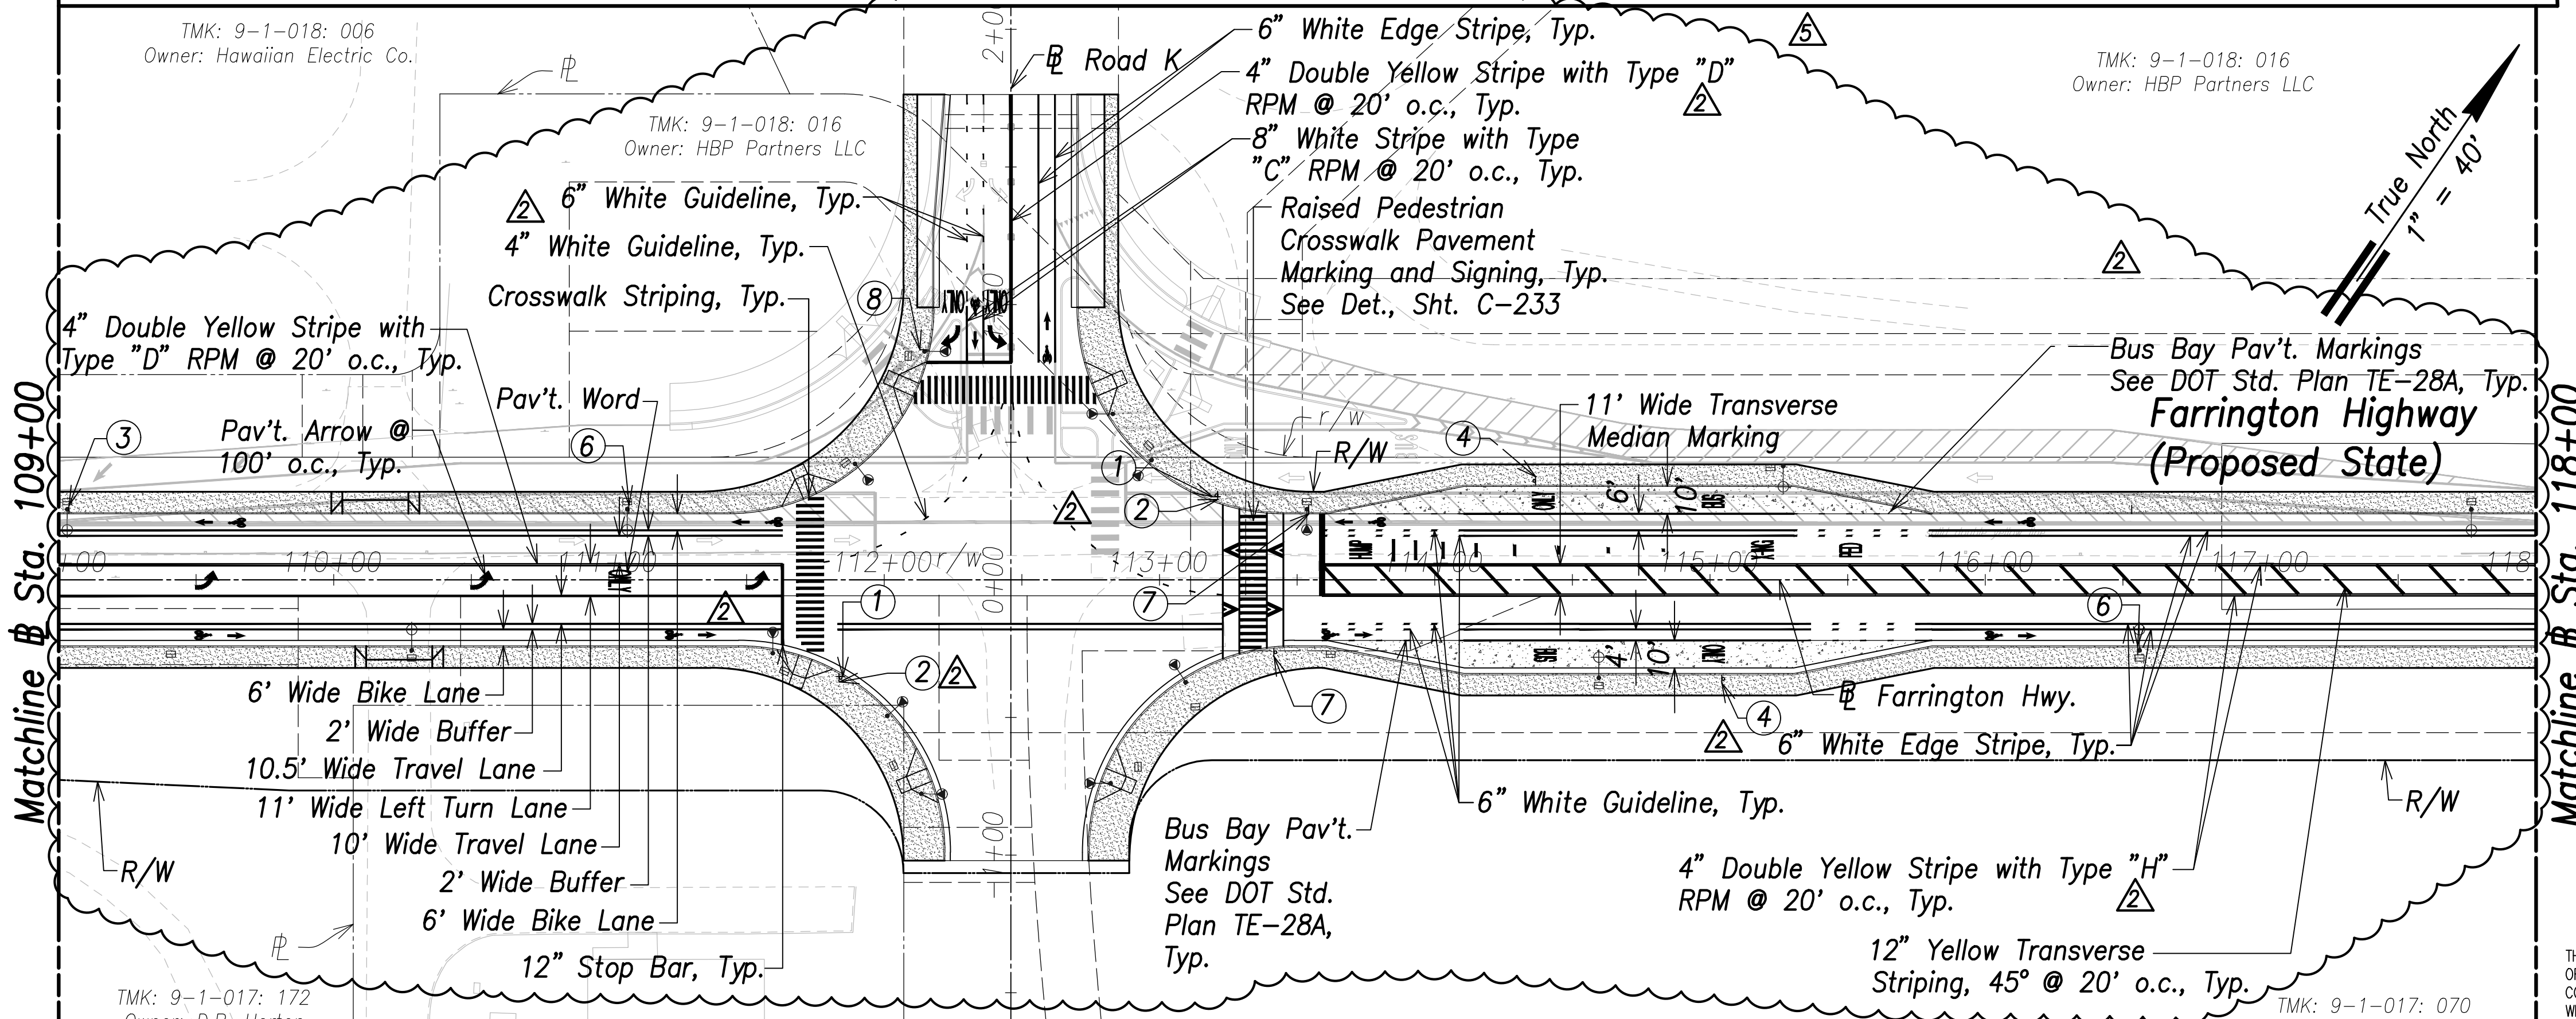

**Signing and Marking Plan - (Sta. 109+00 to Sta. 118+00)**  
Scale: 1" = 40'

**Legend:**

- 1. FARRINGTON HWY. D3-1 Variex12"
- 2. ROAD K D3-1 Variex12"
- 3. SPEED LIMIT 25 R2-1(25) 24"x30"
- 4. R8-3a 24"x24" Mount on St. Lt. Pole
- 5. R7-107A 12"x24"
- 6. BIKE ROUTE D11-1 24"x18" Mount on St. Lt. Pole
- 7. W11-2 36"x36"
- 8. STOP R1-1 30" x 30" Mount on St. Lt. Pole
- 9. W16-7pR 24"x12"

**Note:**  
Future HECO Electrical System, Construction Will Occur at the Same as this Project (Farrington Highway Improvements). The Contractor Shall Fully Coordinate Work with HECO and their Contractor. The Cost to Coordinate Work Will be Considered Incidental to the Various Items of Work.

**Graphic Scale:**  
1" = 40' 40' 20' 0 40' 80'  
Scale in Feet

DATE	REVISION
07/15/22	5 Add Bus Bay, Rev. Sign and Striping
06/08/22	2 Turning Vehicles Yield to Pedestrians Sign Removed, Pav't. Arrow Revised, Stripes Added, Stripe Labels Added



THIS WORK WAS PREPARED BY ME OR UNDER MY SUPERVISION AND CONSTRUCTION OF THIS PROJECT WILL BE UNDER MY OBSERVATION.  
Signature: [Signature] April 30, 2024  
EXPIRATION DATE OF THE LICENSE

STATE OF HAWAII  
DEPARTMENT OF TRANSPORTATION  
HIGHWAYS DIVISION

**Signing and Marking Plan**  
Sta. 100+00 to Sta. 118+00

FARRINGTON HIGHWAY WIDENING  
Kapolei Golf Course Road to Fort Weaver Road  
Project No. 7101A-01-20


Scale: As Shown Date: April 2022

SURVEY PLOTTED BY	DATE
DRAWN BY	
TRACED BY	
DESIGNED BY	
QUANTITIES BY	
CHECKED BY	
ORIGINAL PLAN	
NOTE BOOK	
No.	

FILE: K:\civ\23146 Farrington Hwy Widening\Draw\Construction\Draw\C-228 Striping Plan - Sta. 100+00 to 118+00.dwg saved July 13, 2022




FED. ROAD DIST. NO.	STATE	PROJ. NO.	FISCAL YEAR	SHEET NO.	TOTAL SHEETS
HAWAII	HAW.	7101A-01-20	2021	230	767

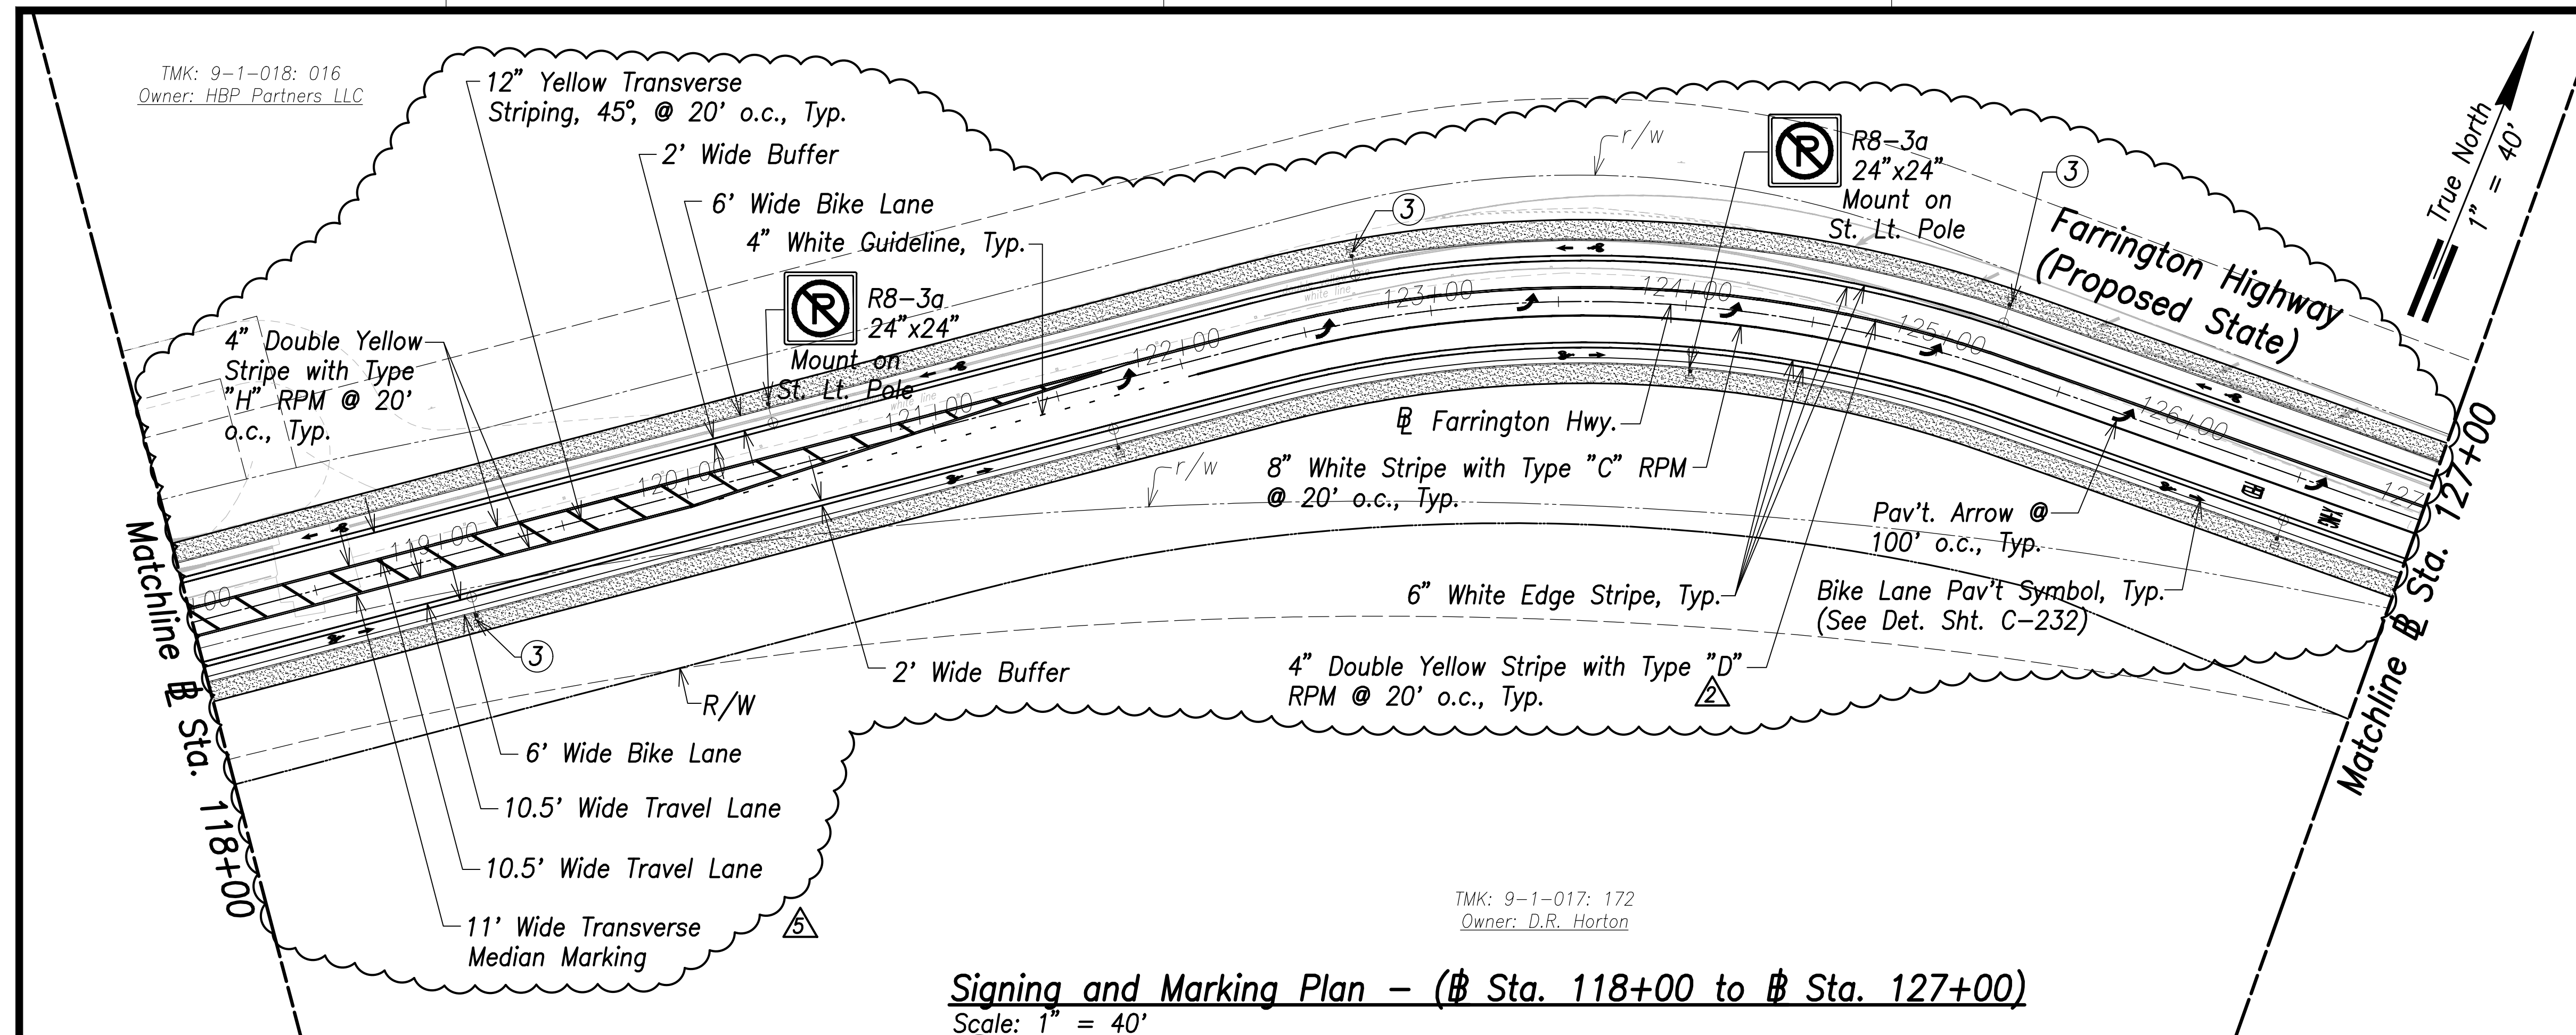


**Signing and Marking Plan - (Sta. 118+00 to Sta. 127+00)**  
Scale: 1" = 40'

①	FARRINGTON HWY. D3-1 Variesx12"	④	
②	ROAD L D3-1 Variesx12"	⑤	BIKE ROUTE D11-1 24"x18"
③	SPEED LIMIT 25 R2-1(25) 24"x30"	⑥	W11-2 36"x36"
	R8-3a 24"x24"		W16-7pL 24"x12"
⑦	STOP R1-1 30" x 30" Mount on St. Lt. Pole		

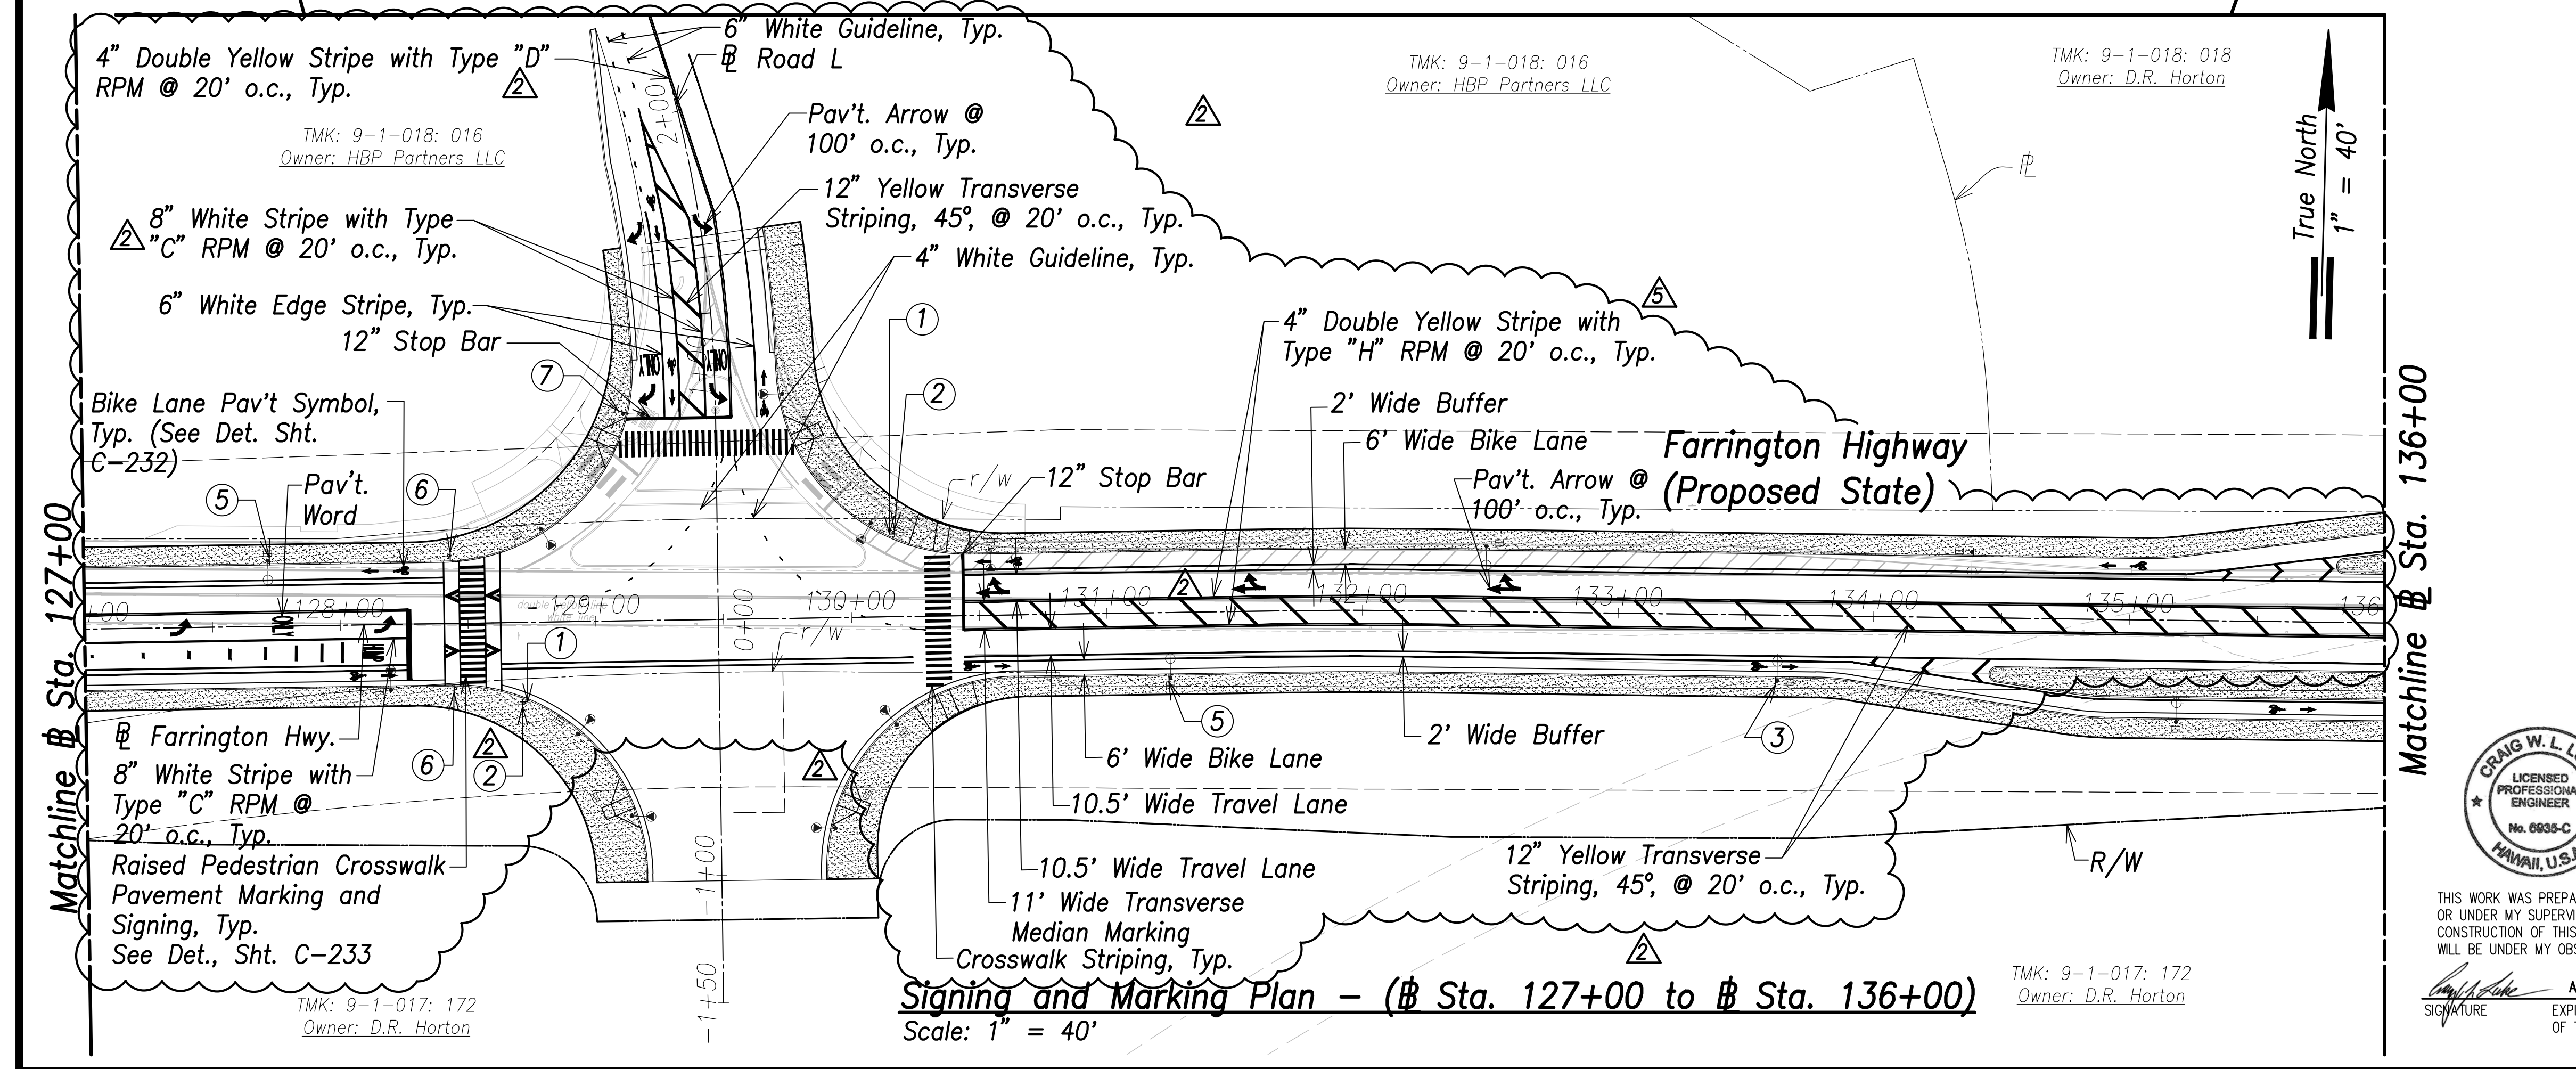

**Signing and Marking Plan - (Sta. 127+00 to Sta. 136+00)**  
Scale: 1" = 40'

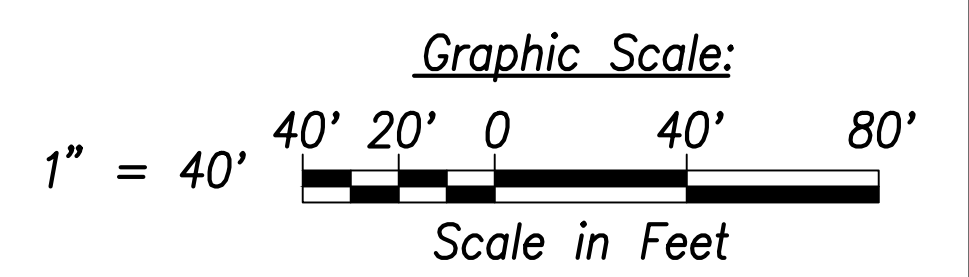

DATE	REVISION
07/15/22	⑤ Rev. Signing, Striping, Add callouts
06/08/22	② Pav't. Arrow Revised, Turn Lane and Median Striping Revised, Turning Vehicles Yield to Pedestrians Sign Removed, Street Sign Removed, Stripe Label Revised and Added



THIS WORK WAS PREPARED BY ME OR UNDER MY SUPERVISION AND CONSTRUCTION OF THIS PROJECT WILL BE UNDER MY OBSERVATION.  
Signature: *Craig W. Luke*  
April 30, 2024  
EXPIRATION DATE OF THE LICENSE

STATE OF HAWAII  
DEPARTMENT OF TRANSPORTATION  
HIGHWAYS DIVISION

**Signing and Marking Plan**  
Sta. 118+00 to Sta. 136+00

FARRINGTON HIGHWAY WIDENING  
Kapolei Golf Course Road to Fort Weaver Road  
Project No. 7101A-01-20

Scale: As Shown Date: April 2022

SHEET No. C-229 OF 767 SHEETS

DATE	SURVEY PLOTTED BY
DATE	DRAWN BY
DATE	TRACED BY
DATE	QUANTITIES BY
DATE	CHECKED BY

TMK: 9-1-017: 172  
Owner: D.R. Horton

TMK: 9-1-017: 172  
Owner: D.R. Horton

TMK: 9-1-018: 016  
Owner: HBP Partners LLC

TMK: 9-1-018: 018  
Owner: D.R. Horton

TMK: 9-1-018: 016  
Owner: HBP Partners LLC


FILE: K:\civil\23146 Farrington Hwy Widening\Draw\Construction\Draw\C-229 Striping Plan - Sta. 118+00 to 136+00.dwg saved July 13, 2022








FED. ROAD DIST. NO.	STATE	PROJ. NO.	FISCAL YEAR	SHEET NO.	TOTAL SHEETS
HAWAII	HAW.	7101A-01-20	2021	232	767

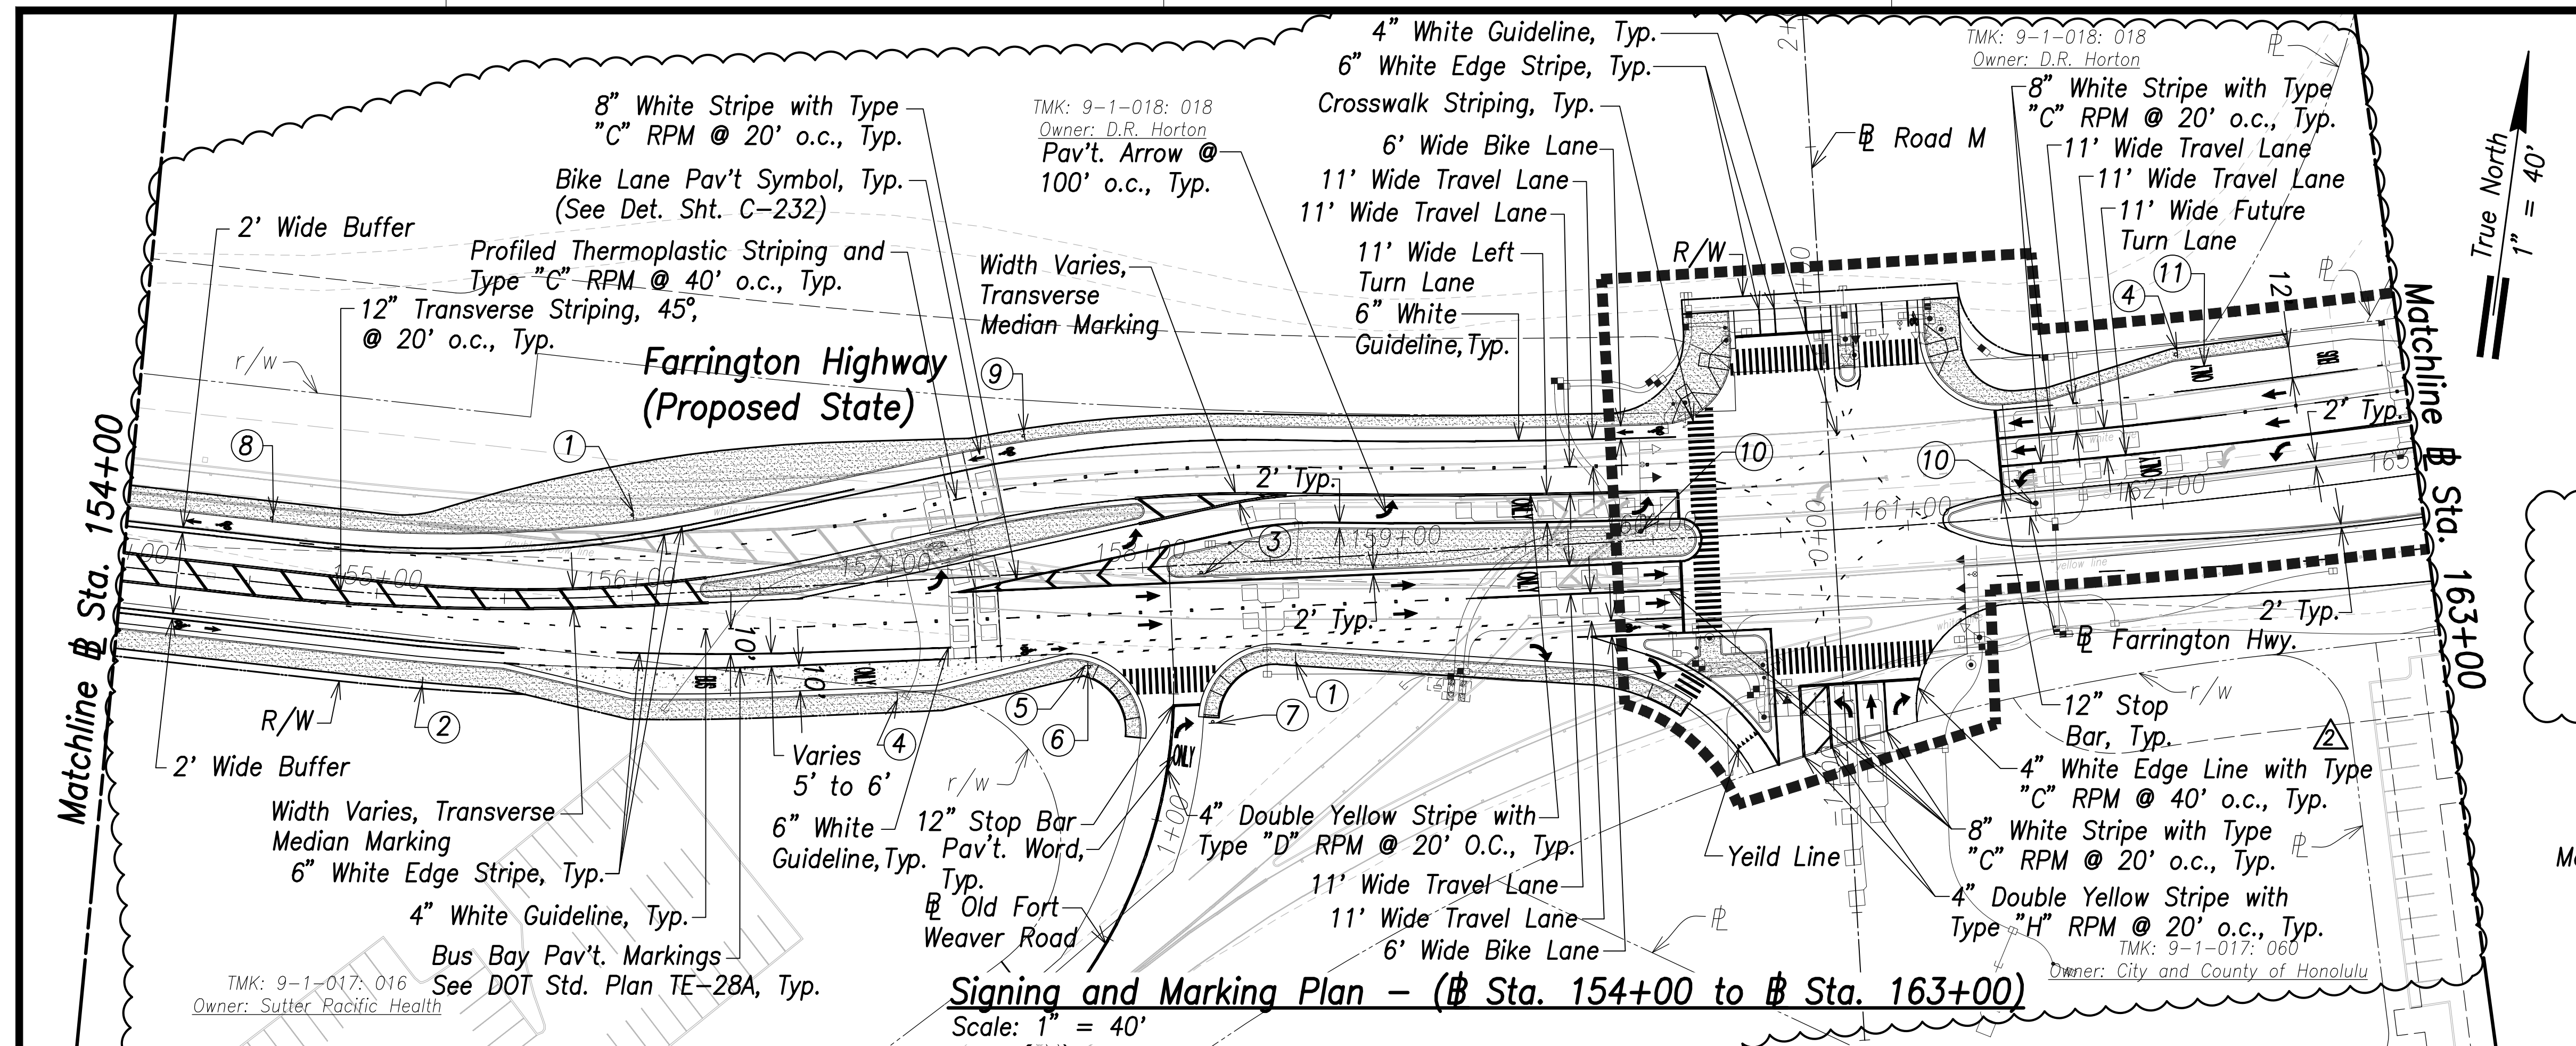

**Signing and Marking Plan - (Sta. 154+00 to Sta. 163+00)**  
Scale: 1" = 40'

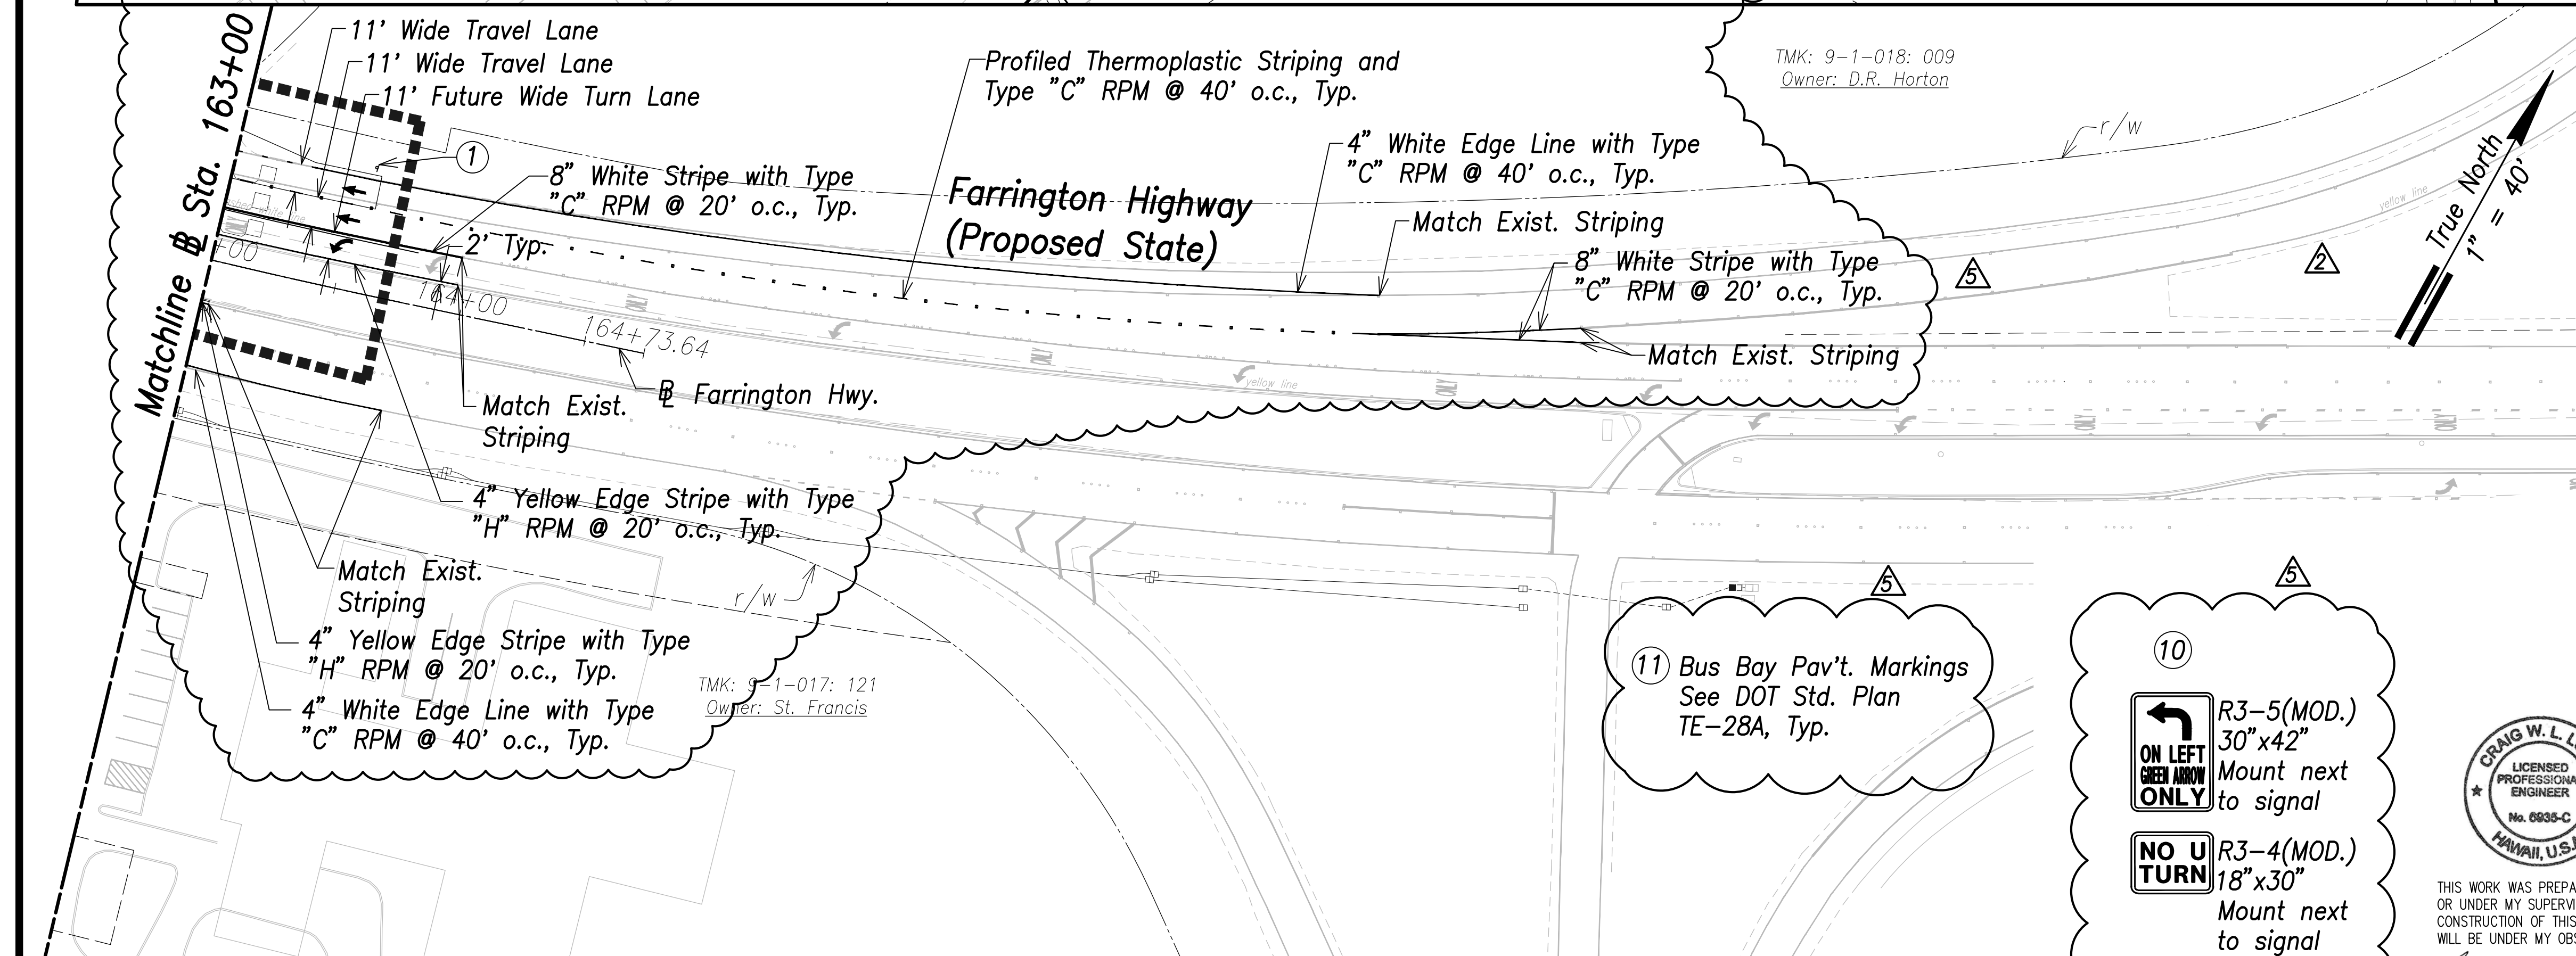


**Signing and Marking Plan - (Sta. 163+00 to End)**  
Scale: 1" = 40'

True North  
1" = 40'

True North  
1" = 40'

①	R2-1(25) 24"x30"	④	R7-107A 12"x24"
②	R3-8a(MOD.) 45"x30"	⑤	FARRINGTON HWY. D3-1 VARIESx12"
③	R8-3a 24"x24"	⑥	OLD FORT WEAVER RD. D3-1 Variesx12"
	Mount on St. Lt. Pole	⑦	R1-1 30" x 30"
	Mount on St. Lt. Pole	⑧	R8-3a 24"x24"
	Mount on St. Lt. Pole	⑨	D11-1 24"x18" Mount on St. Lt. Pole
	Mount on St. Lt. Pole		

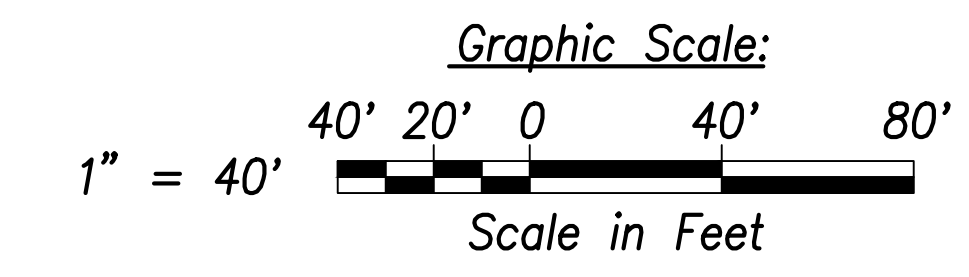

SURVEY PLOTTED BY	DATE
DRAWN BY	
TRACED BY	
QUANTITIES BY	
CHECKED BY	
ORIGINAL PLAN	
NOTE BOOK	
No.	

⑪ Bus Bay Pav't. Markings  
See DOT Std. Plan  
TE-28A, Typ.

⑩

R3-5(MOD.)  
30"x42"  
Mount next to signal

R3-4(MOD.)  
18"x30"  
Mount next to signal



THIS WORK WAS PREPARED BY ME OR UNDER MY SUPERVISION AND CONSTRUCTION OF THIS PROJECT WILL BE UNDER MY OBSERVATION.  
Signature: *Craig W. L. Luke*  
April 30, 2024  
EXPIRATION DATE OF THE LICENSE

DATE	REVISION
07/15/22	⑤ Add Bus Bay, Rev. Sign and Striping
06/08/22	② Revised turn lane striping, removed Intersection M striping

STATE OF HAWAII  
DEPARTMENT OF TRANSPORTATION  
HIGHWAYS DIVISION

**Signing and Marking Plan**  
Sta. 154+00 to End

FARRINGTON HIGHWAY WIDENING  
Kapolei Golf Course Road to Fort Weaver Road  
Project No. 7101A-01-20


Scale: As Shown    Date: April 2022

SHEET NO. C-231 OF 767 SHEETS






FED. ROAD DIST. NO.	STATE	PROJ. NO.	FISCAL YEAR	SHEET NO.	TOTAL SHEETS
HAWAII	HAW.	7101A-01-20	2021	234	767

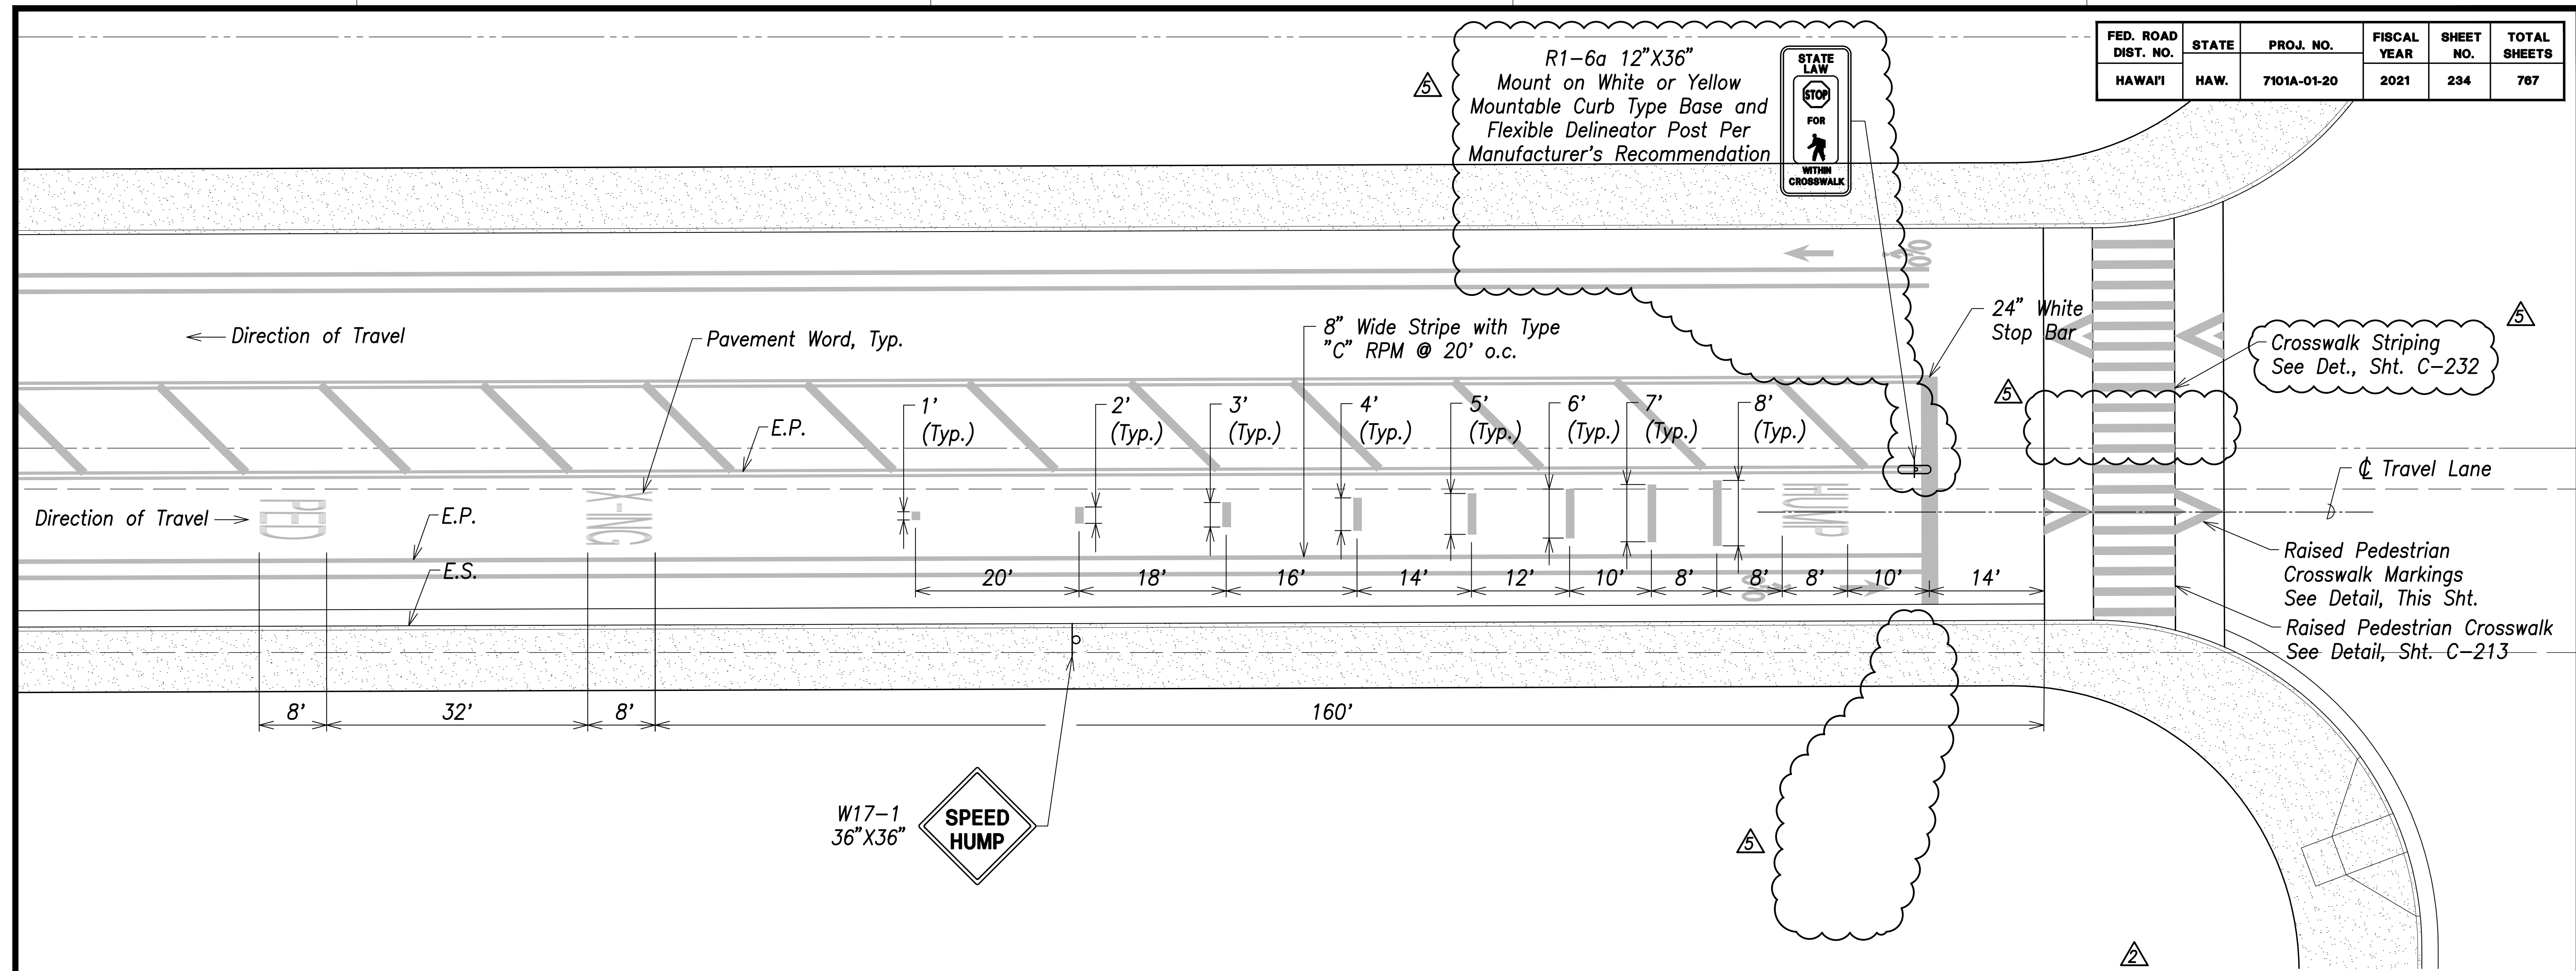

- Notes:**
- For remainder of signing and marking callouts, see Signing and Marking Plans.
  - Raised pedestrian crosswalk markings and words shall be centered on the centerline of the travel lane.

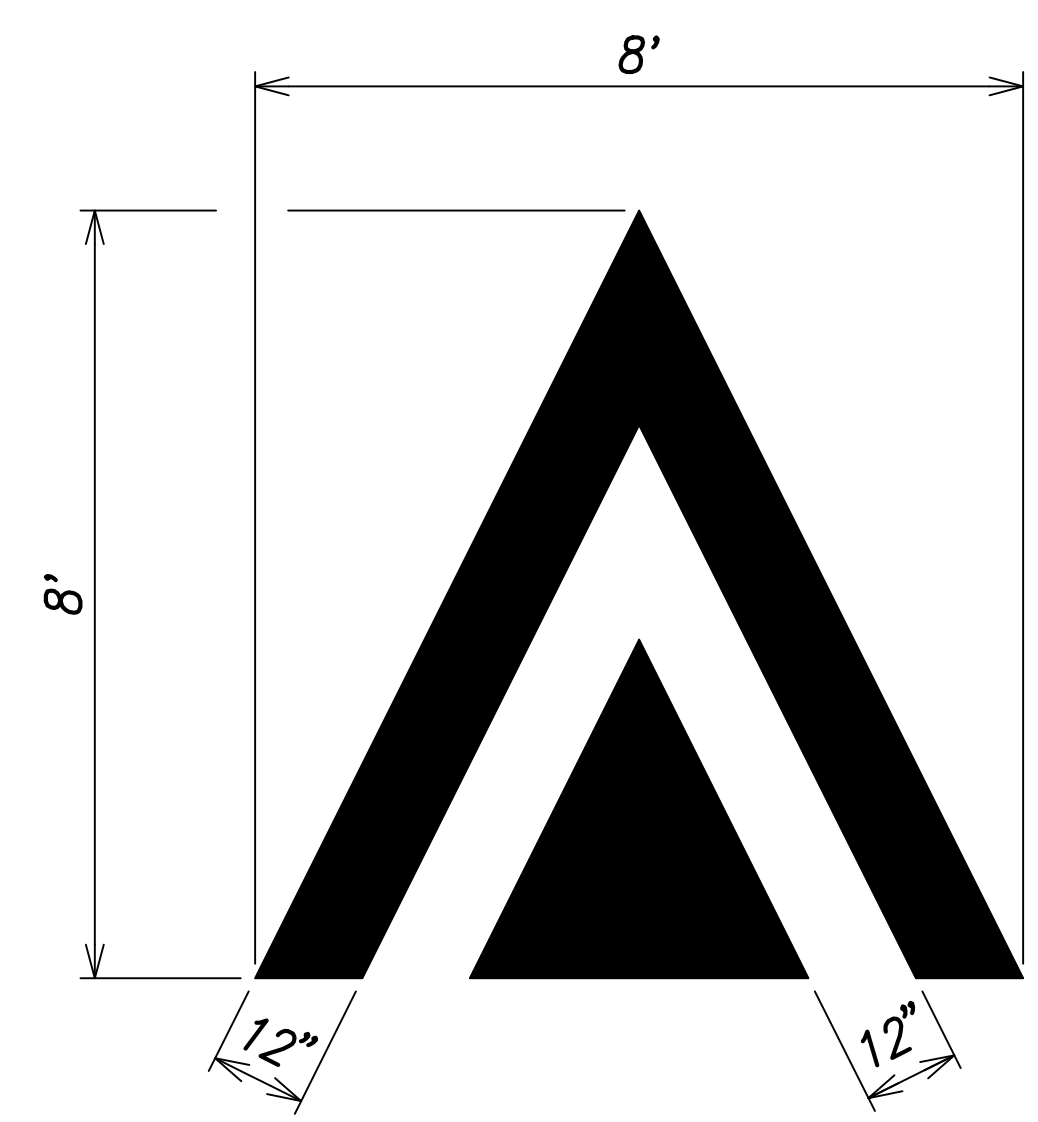

**Raised Pedestrian Crosswalk Markings**  
Not To Scale

**Raised Pedestrian Crosswalk Pavement Marking and Signage Layout Plan**  
Scale: 1"=10'

SURVEY PLOTTED BY	DATE
DRAWN BY	
TRACED BY	
DESIGNED BY	
CHECKED BY	
ORIGINAL PLAN	
NOTE BOOK	
No.	

CRAIG W. L. LUKE  
 LICENSED PROFESSIONAL ENGINEER  
 No. 6935-C  
 HAWAII, U.S.A.

THIS WORK WAS PREPARED BY ME OR UNDER MY SUPERVISION AND CONSTRUCTION OF THIS PROJECT WILL BE UNDER MY OBSERVATION.

SIGNATURE: *Craig W. Luke* EXPIRATION DATE OF THE LICENSE: April 30, 2024

07/15/22	Rev. Sheet Ref., Callout and Sign. Del. Sign and Symbol
06/08/22	Revised Sheet
DATE	REVISION

STATE OF HAWAII  
 DEPARTMENT OF TRANSPORTATION  
 HIGHWAYS DIVISION


**Pavement Marking Details - 2**

FARRINGTON HIGHWAY WIDENING  
 Kapolei Golf Course Road to Fort Weaver Road  
 Project No. 7101A-01-20


Scale: As Shown Date: April 2022

SHEET No. C-233 OF 767 SHEETS

FED. ROAD DIST. NO.	STATE	PROJ. NO.	FISCAL YEAR	SHEET NO.	TOTAL SHEETS
HAWAII	HAW.	7101A-01-20	2021	237	767

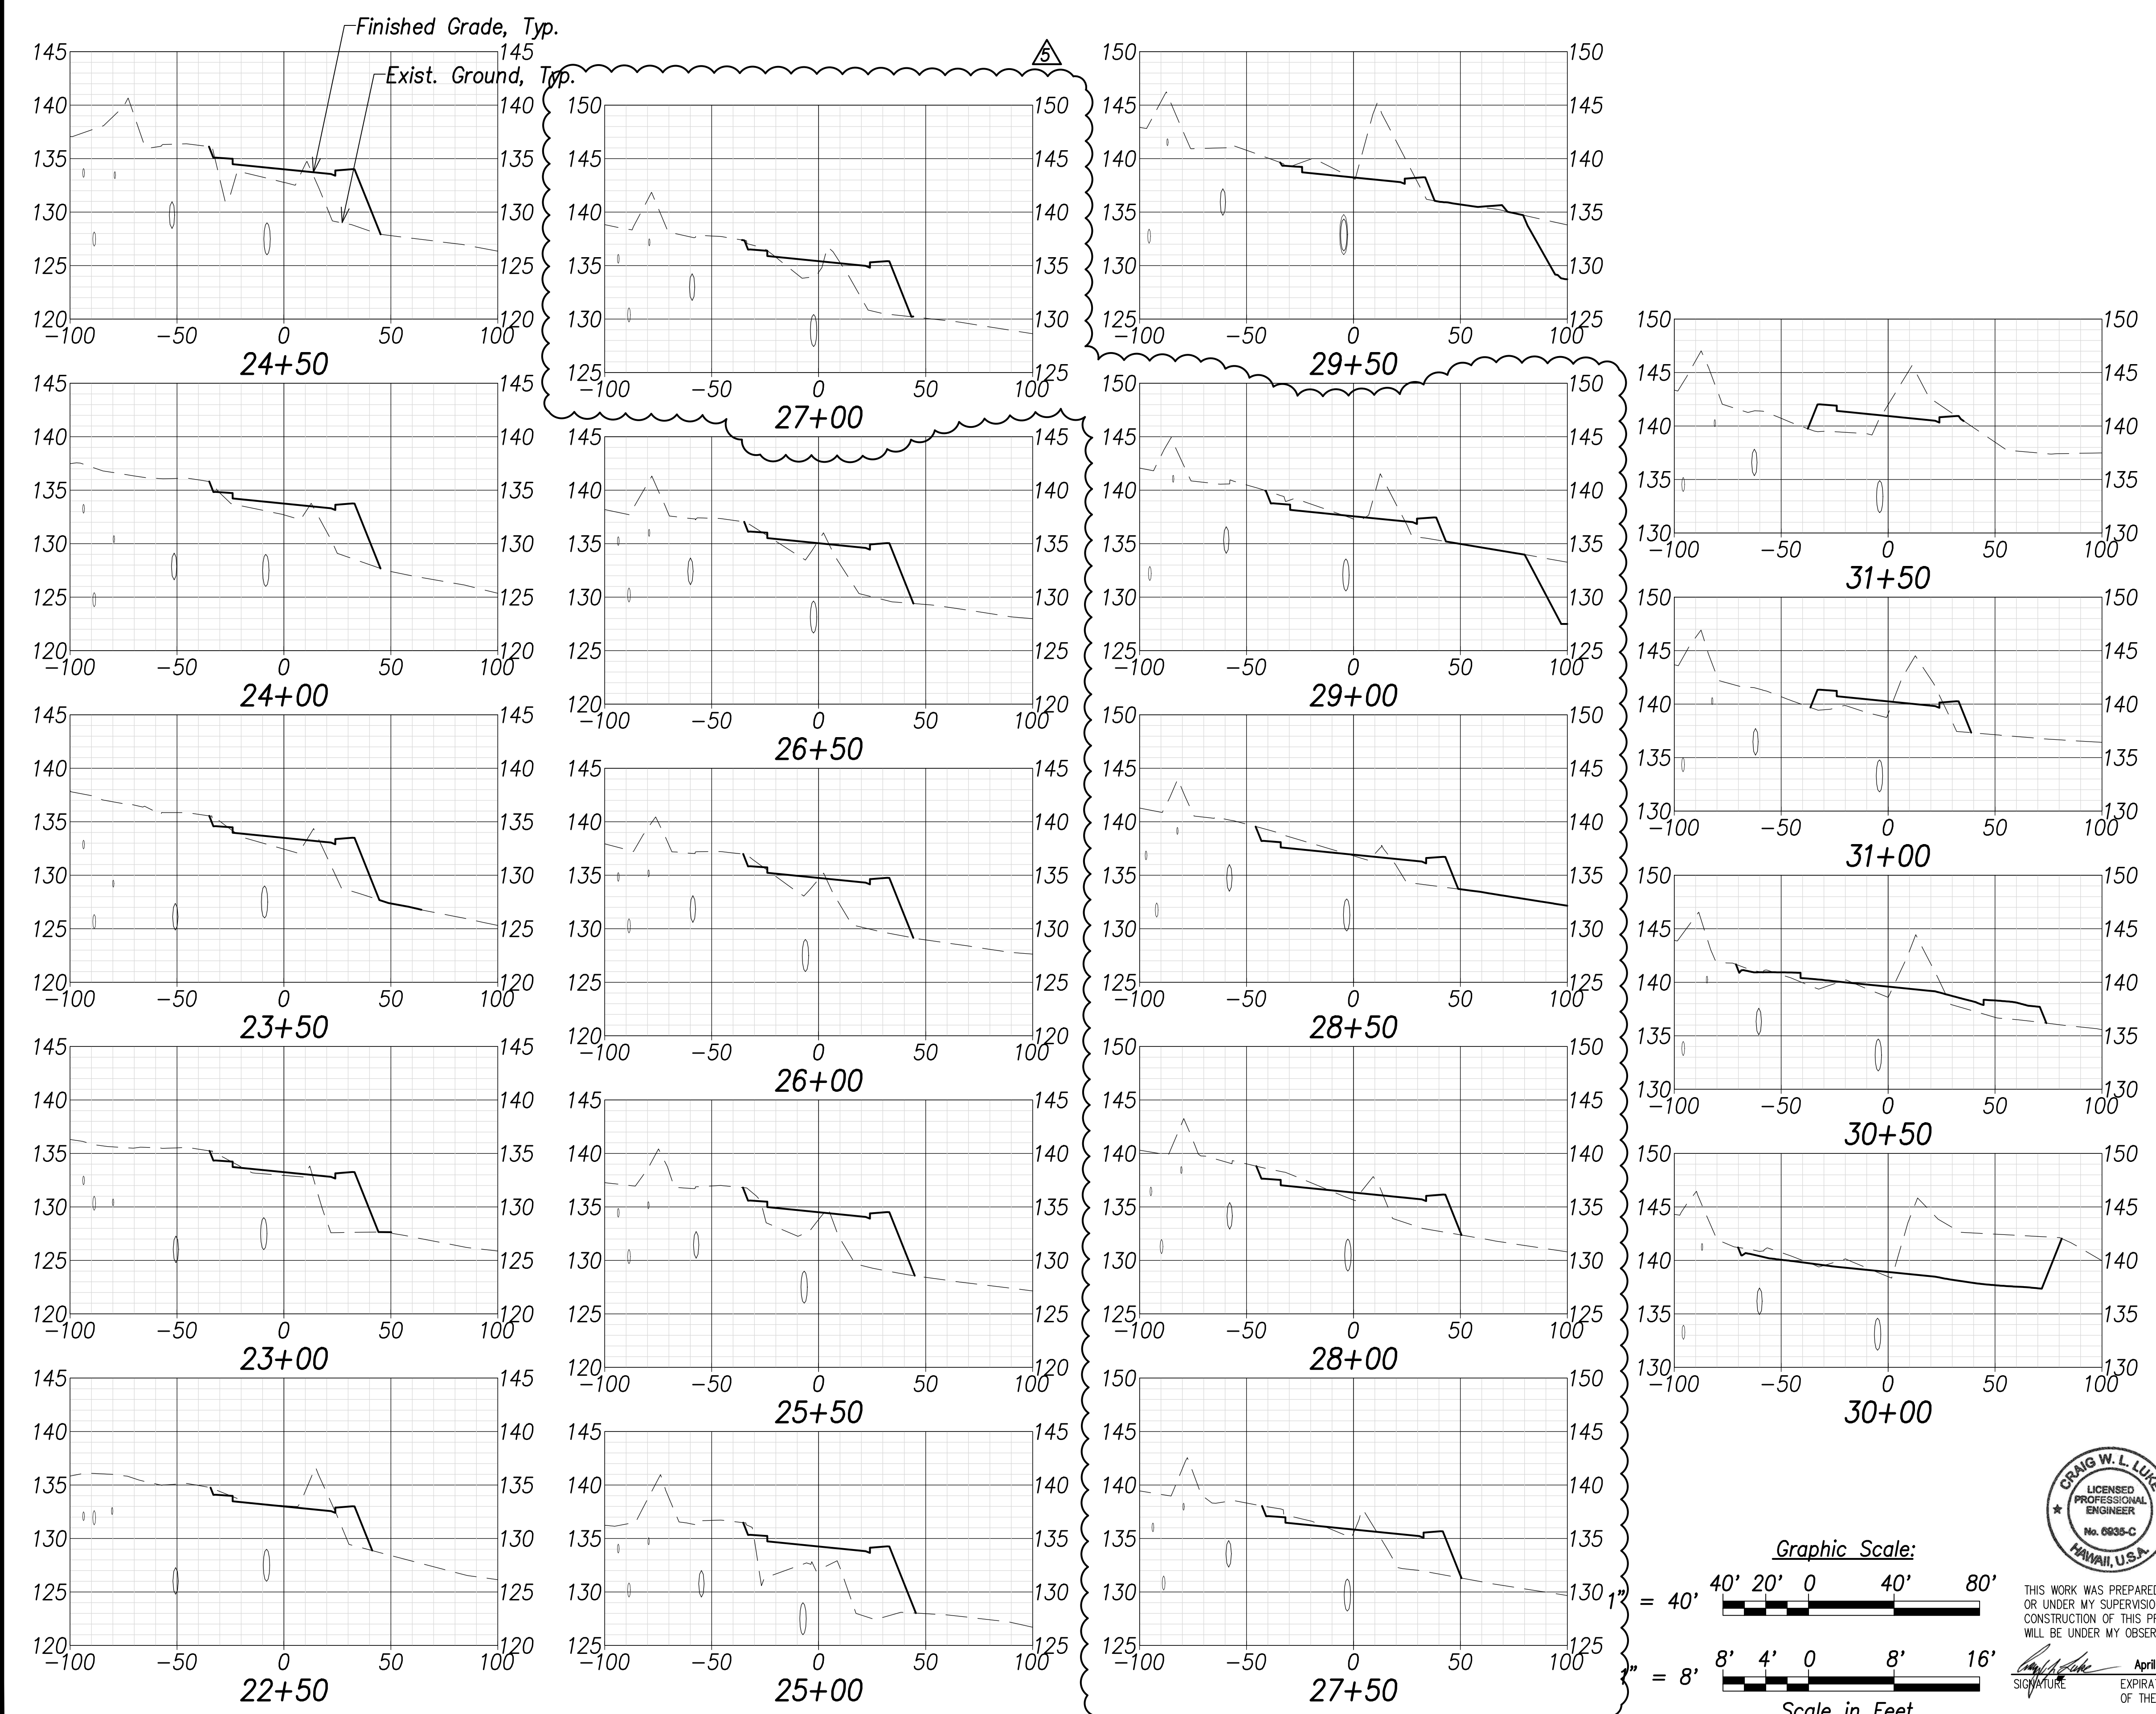


SURVEY PLOTTED BY: _____	DATE: _____
DRAWN BY: _____	TRACED BY: _____
NOTED BY: _____	QUANTIFIED BY: _____
CHECKED BY: _____	No. _____

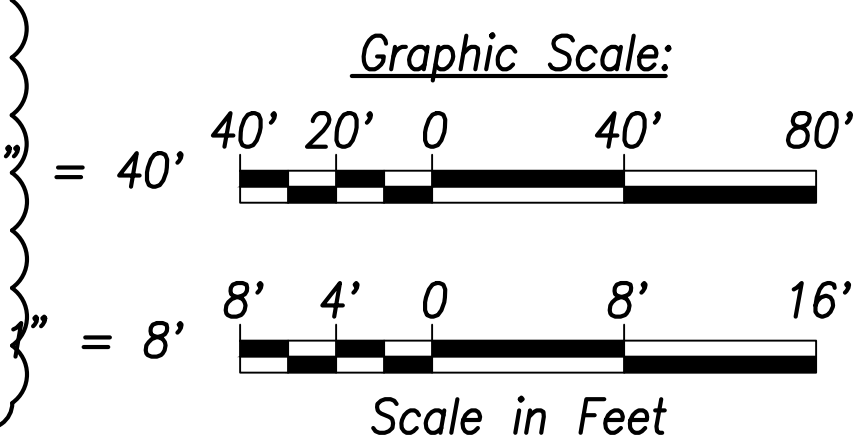

THIS WORK WAS PREPARED BY ME OR UNDER MY SUPERVISION AND CONSTRUCTION OF THIS PROJECT WILL BE UNDER MY OBSERVATION.

Signature: \_\_\_\_\_  
 April 30, 2024  
 EXPIRATION DATE OF THE LICENSE

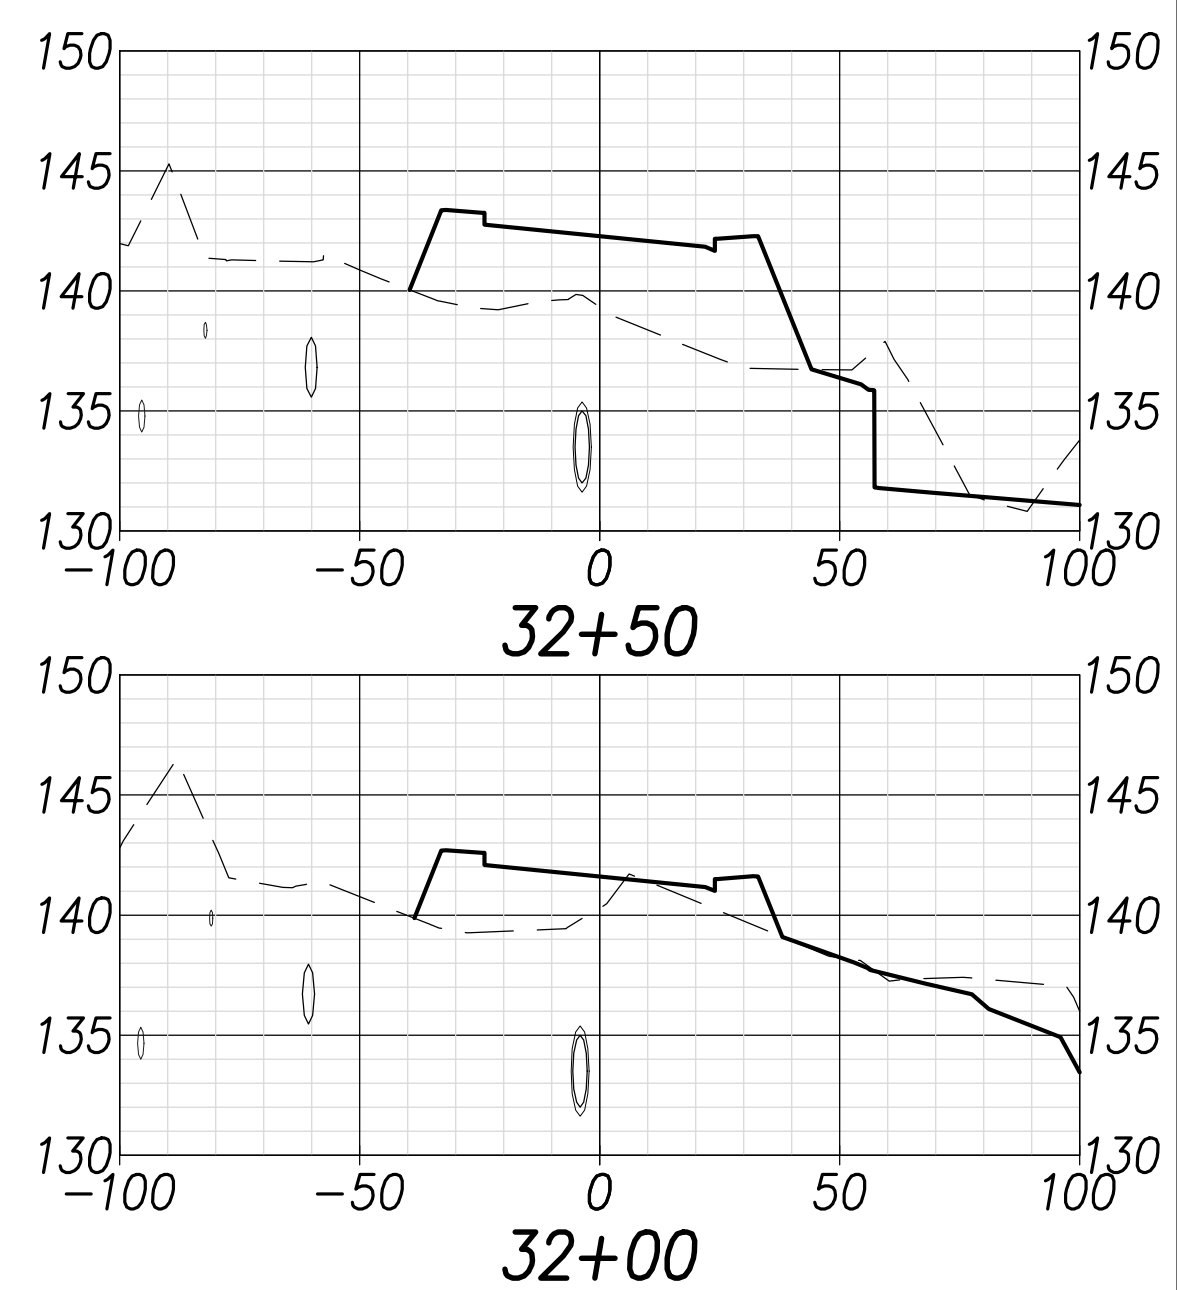

DATE	REVISION
07/15/22	Revise cross sections
06/08/22	Replace sheet

STATE OF HAWAII  
 DEPARTMENT OF TRANSPORTATION  
 HIGHWAYS DIVISION

### Cross Sections - 3

FARRINGTON HIGHWAY WIDENING  
 Kapolei Golf Course Road to Fort Weaver Road  
 Project No. 7101A-01-20


Scale: As Shown      Date: April 2022

SHEET NO. C-236 OF 767 SHEETS


ADD. 237

FILE: K:\civil\23146 Farrington Hwy Widening\Draw\Construction\Draw\C-236 Cross Sections - 3.dwg saved July 8, 2022

FED. ROAD DIST. NO.	STATE	PROJ. NO.	FISCAL YEAR	SHEET NO.	TOTAL SHEETS
HAWAII	HAW.	7101A-01-20	2021	245	767

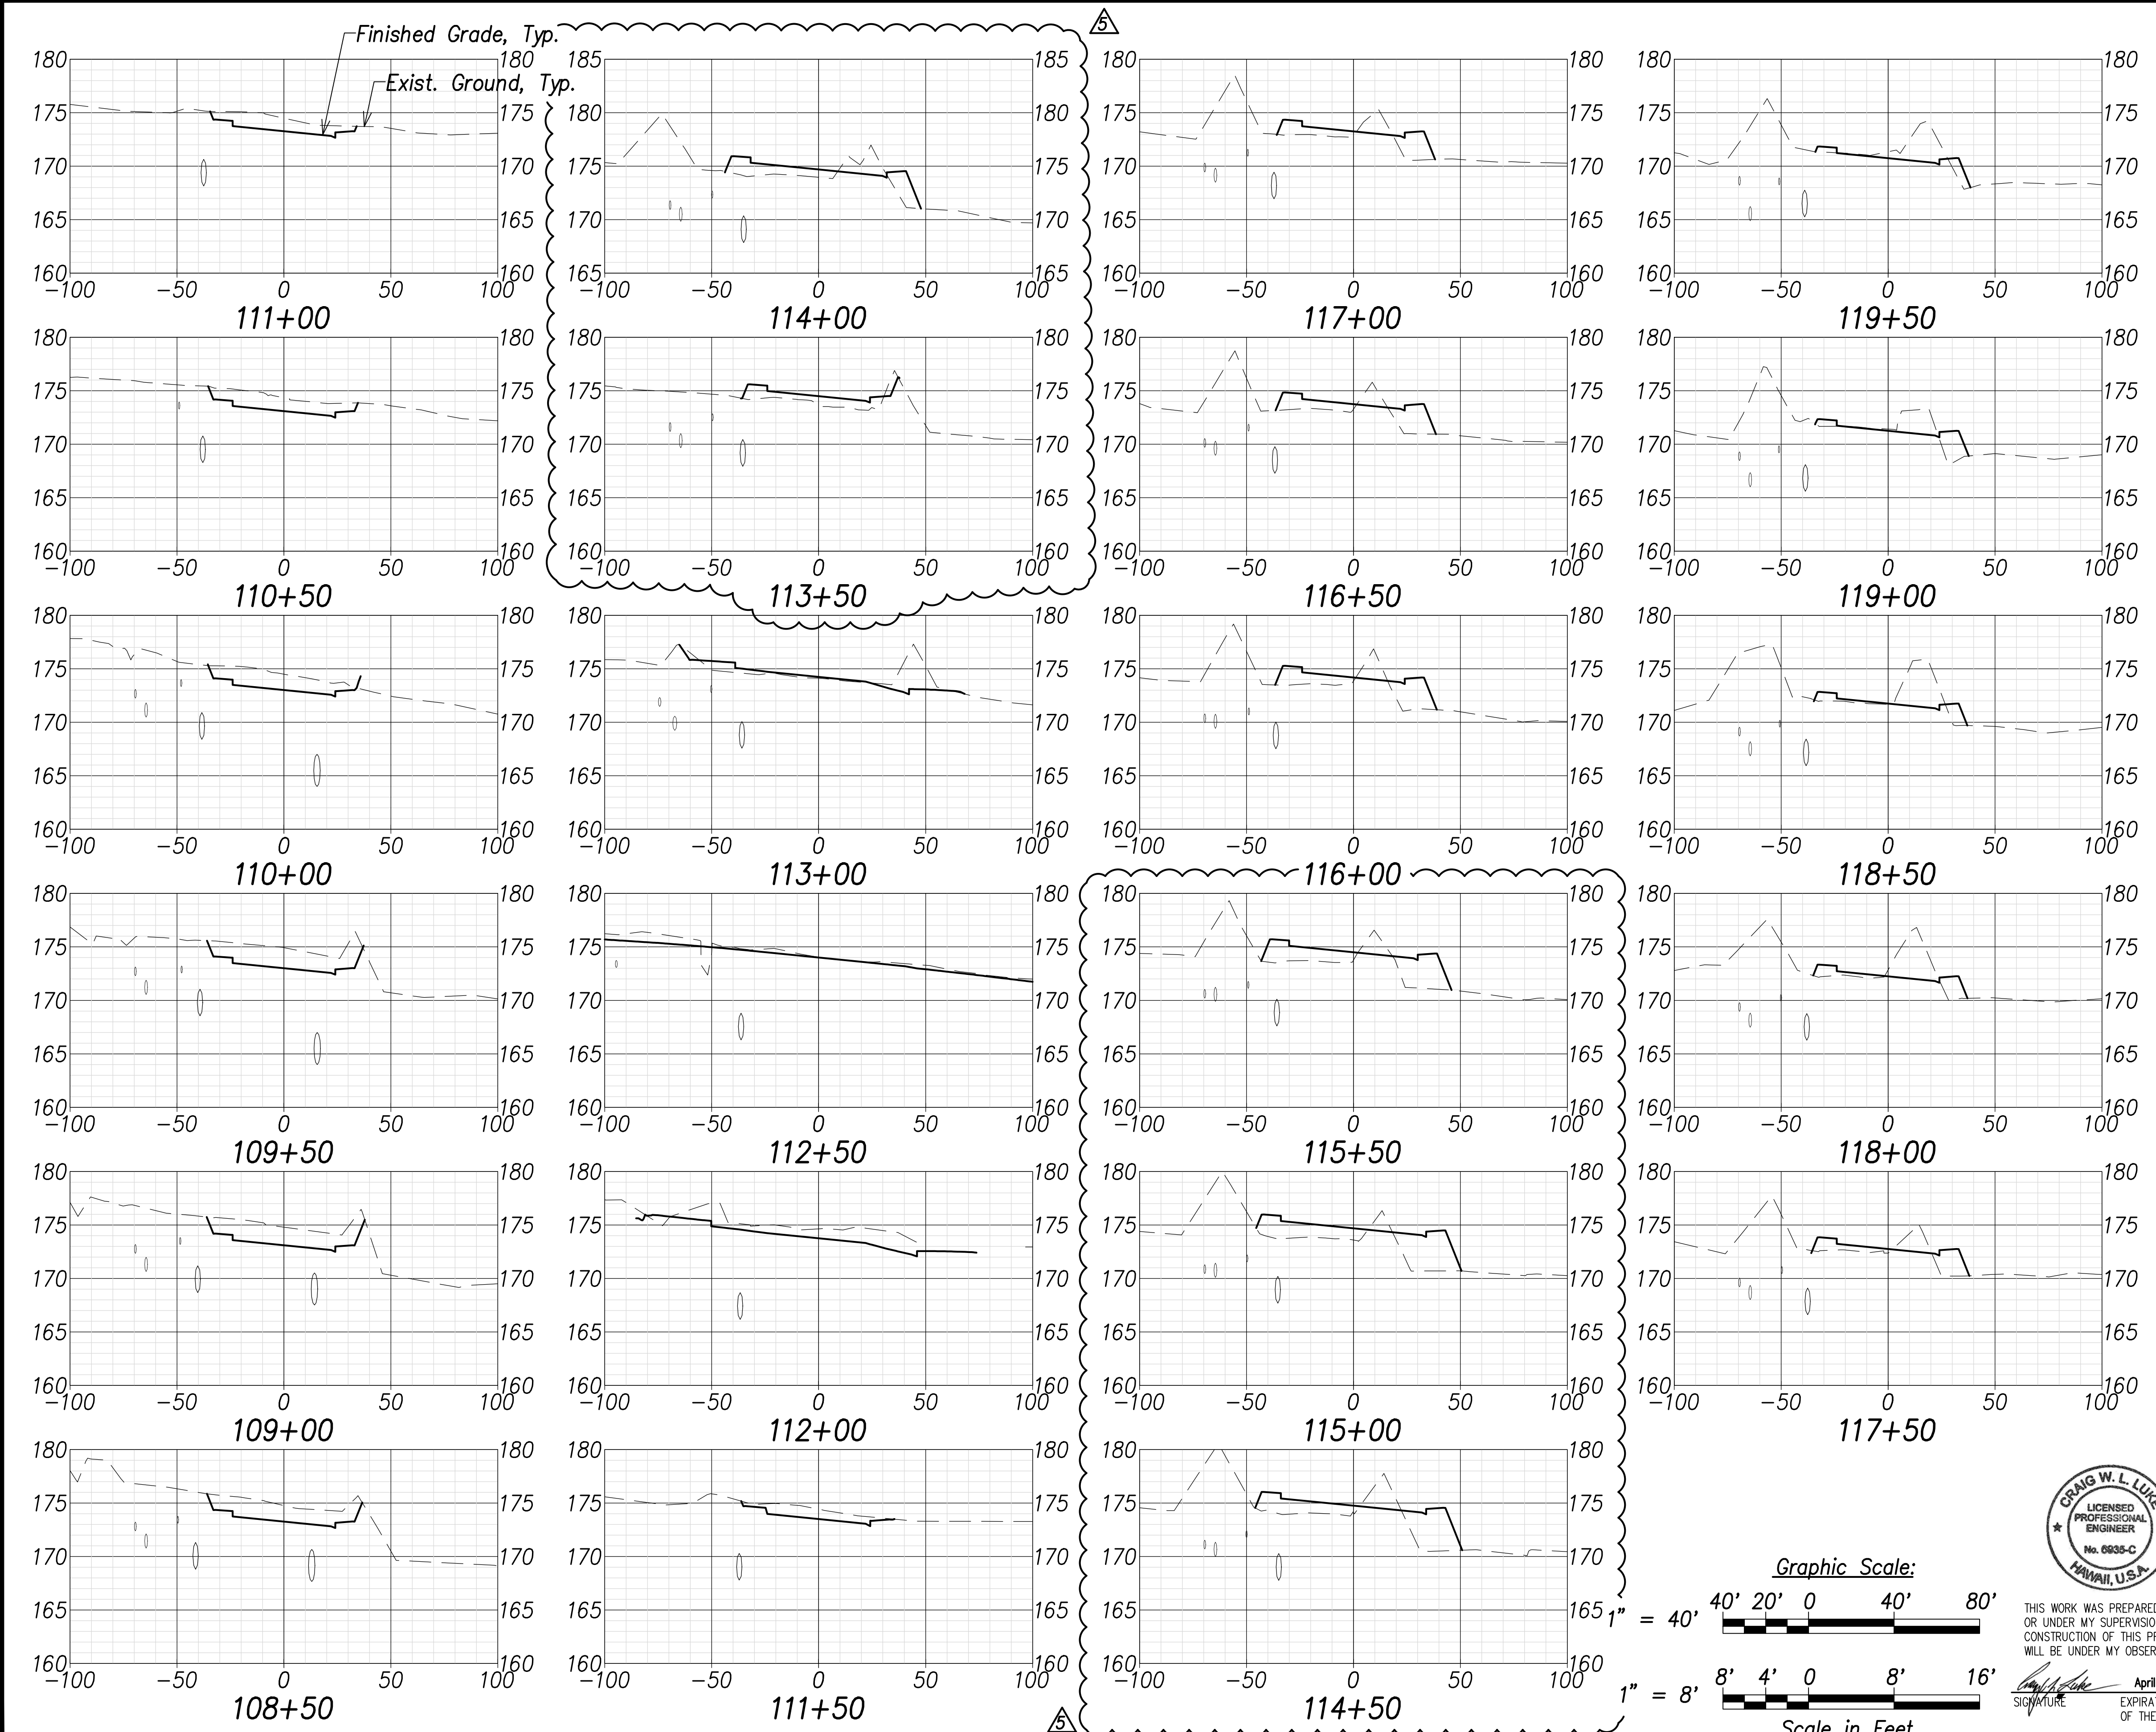

SURVEY PLOTTED BY	DATE
DRAWN BY	
TRACED BY	
CHECKED BY	
DATE	
NOTE BOOK	
NO.	

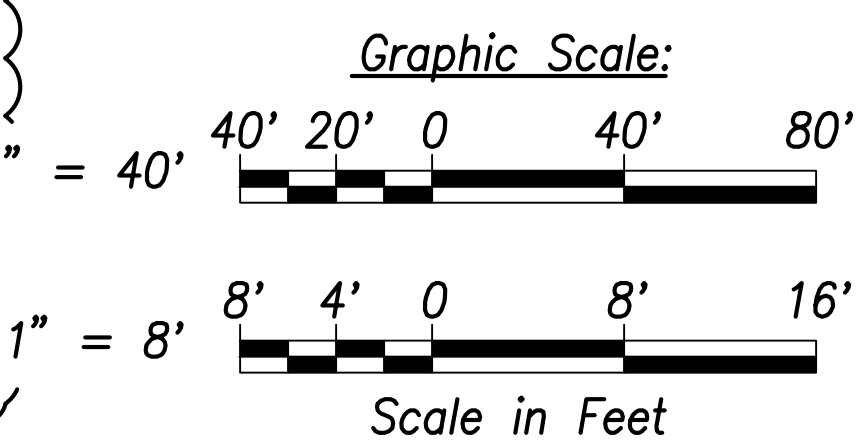

THIS WORK WAS PREPARED BY ME OR UNDER MY SUPERVISION AND CONSTRUCTION OF THIS PROJECT WILL BE UNDER MY OBSERVATION.

*Craig W. Luke*  
 SIGNATURE  
 April 30, 2024  
 EXPIRATION DATE OF THE LICENSE

07/15/22	△ Revise cross sections
06/08/22	△ Replace sheet
DATE	REVISION

STATE OF HAWAII  
 DEPARTMENT OF TRANSPORTATION  
 HIGHWAYS DIVISION

### Cross Sections - 11

FARRINGTON HIGHWAY WIDENING  
 Kapolei Golf Course Road to Fort Weaver Road  
 Project No. 7101A-01-20


Scale: As Shown Date: April 2022

SHEET No. C-244 OF 767 SHEETS


FILE: K:\civil\23146 Farrington Hwy Widening\Draw\Construction\Draw\C-244 Cross Sections - 11.dwg saved July 8, 2022



FED. ROAD DIST. NO.	STATE	PROJ. NO.	FISCAL YEAR	SHEET NO.	TOTAL SHEETS
HAWAII	HAW.	7101A-01-20	2021	250	767

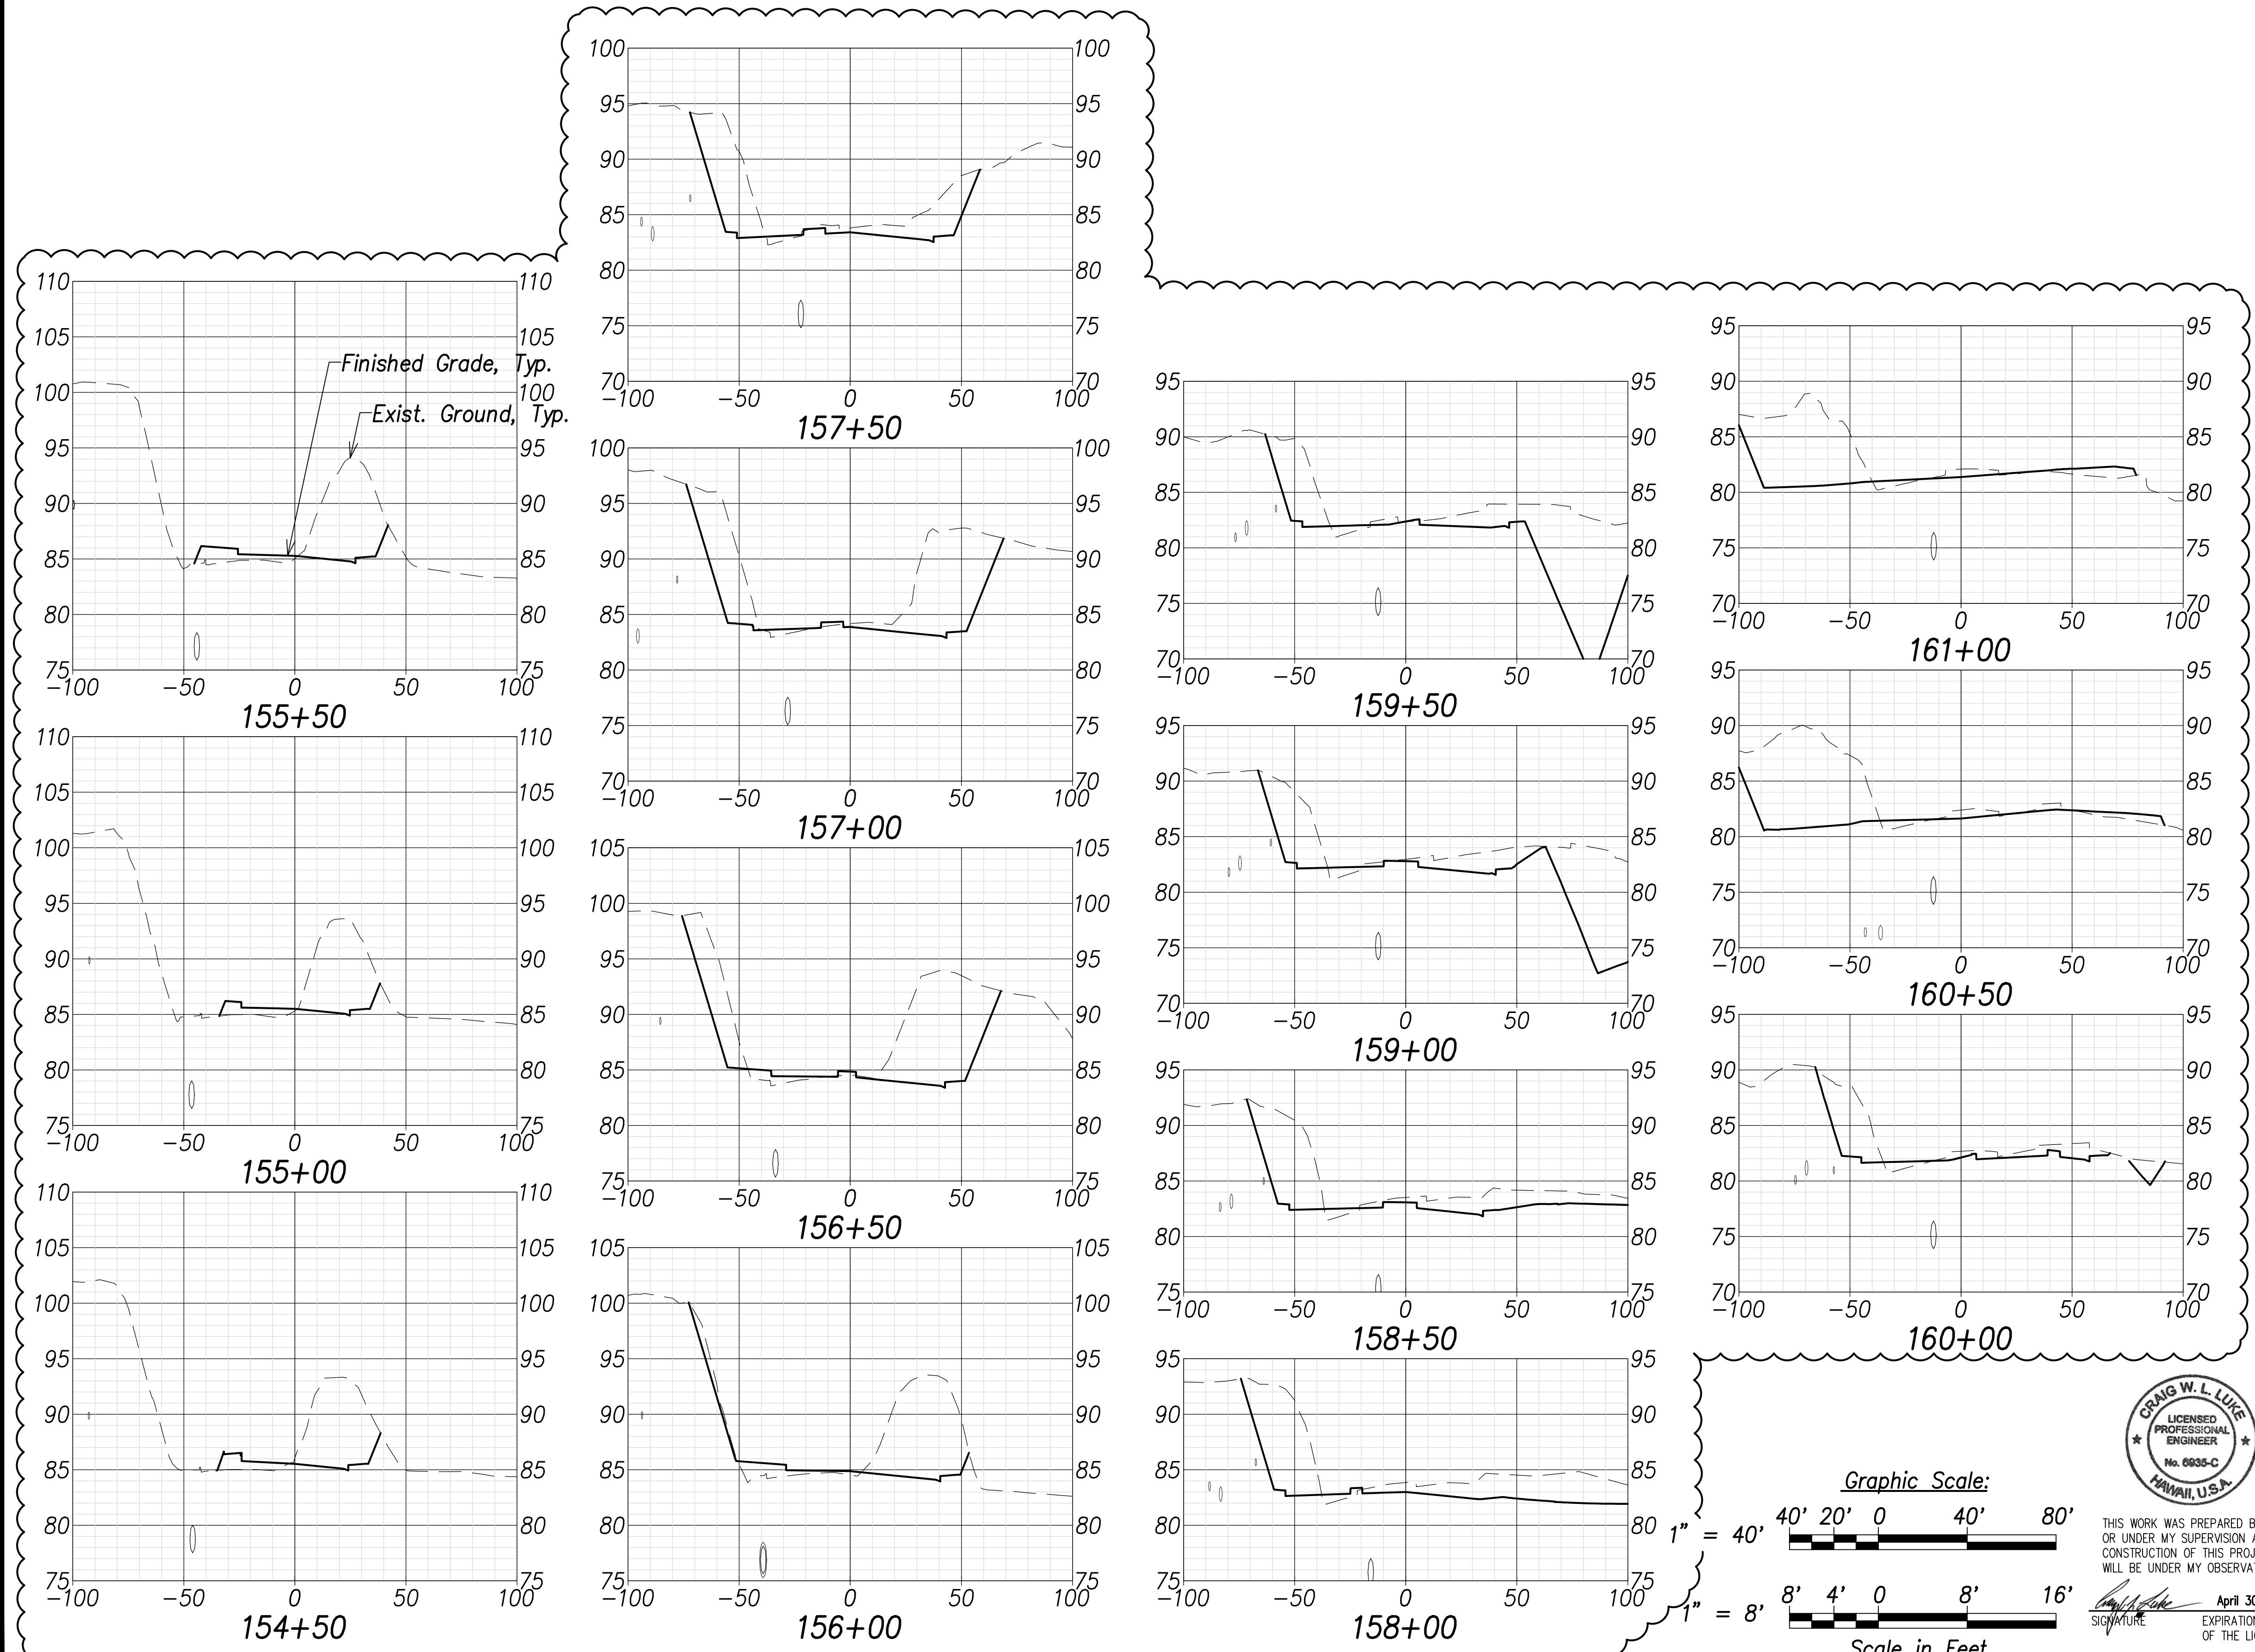

SURVEY PLOTTED BY	DATE
DRAWN BY	
TRACED BY	
DESIGNED BY	
CHECKED BY	
NO. _____	

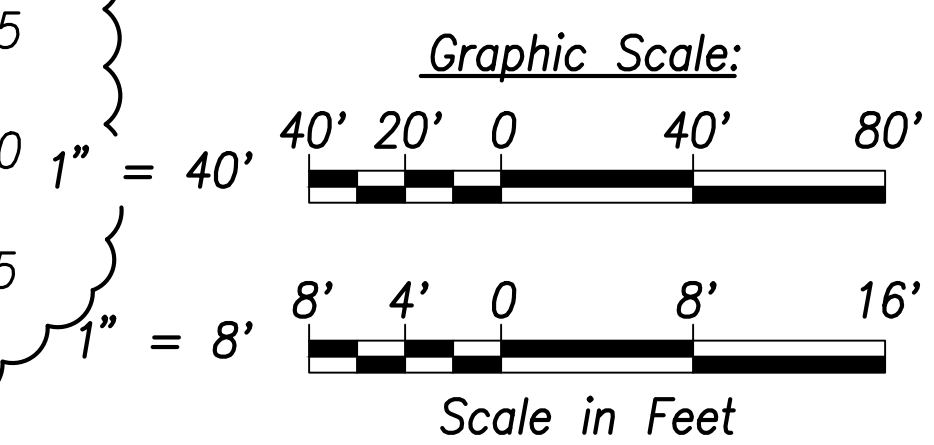

THIS WORK WAS PREPARED BY ME OR UNDER MY SUPERVISION AND CONSTRUCTION OF THIS PROJECT WILL BE UNDER MY OBSERVATION.

Signature: *Craig W. Luke*  
 EXPIRATION DATE OF THE LICENSE: April 30, 2024

07/15/22	Ⓐ Revised cross sections
06/08/22	Ⓐ Replace sheet
DATE	REVISION

STATE OF HAWAII  
 DEPARTMENT OF TRANSPORTATION  
 HIGHWAYS DIVISION

**Cross Sections - 16**

FARRINGTON HIGHWAY WIDENING  
 Kapolei Golf Course Road to Fort Weaver Road  
 Project No. 7101A-01-20


Scale: As Shown      Date: April 2022

SHEET No. C-249 OF 767 SHEETS


ADD. 250

FILE: K:\civil\23146 Farrington Hwy Widening\Draw\Construction\Draw\C-249 Cross Sections - 16.dwg saved July 8, 2022

FED. ROAD DIST. NO.	STATE	PROJ. NO.	FISCAL YEAR	SHEET NO.	TOTAL SHEETS
HAWAII	HAW.	7101A-01-20	2021	251	767

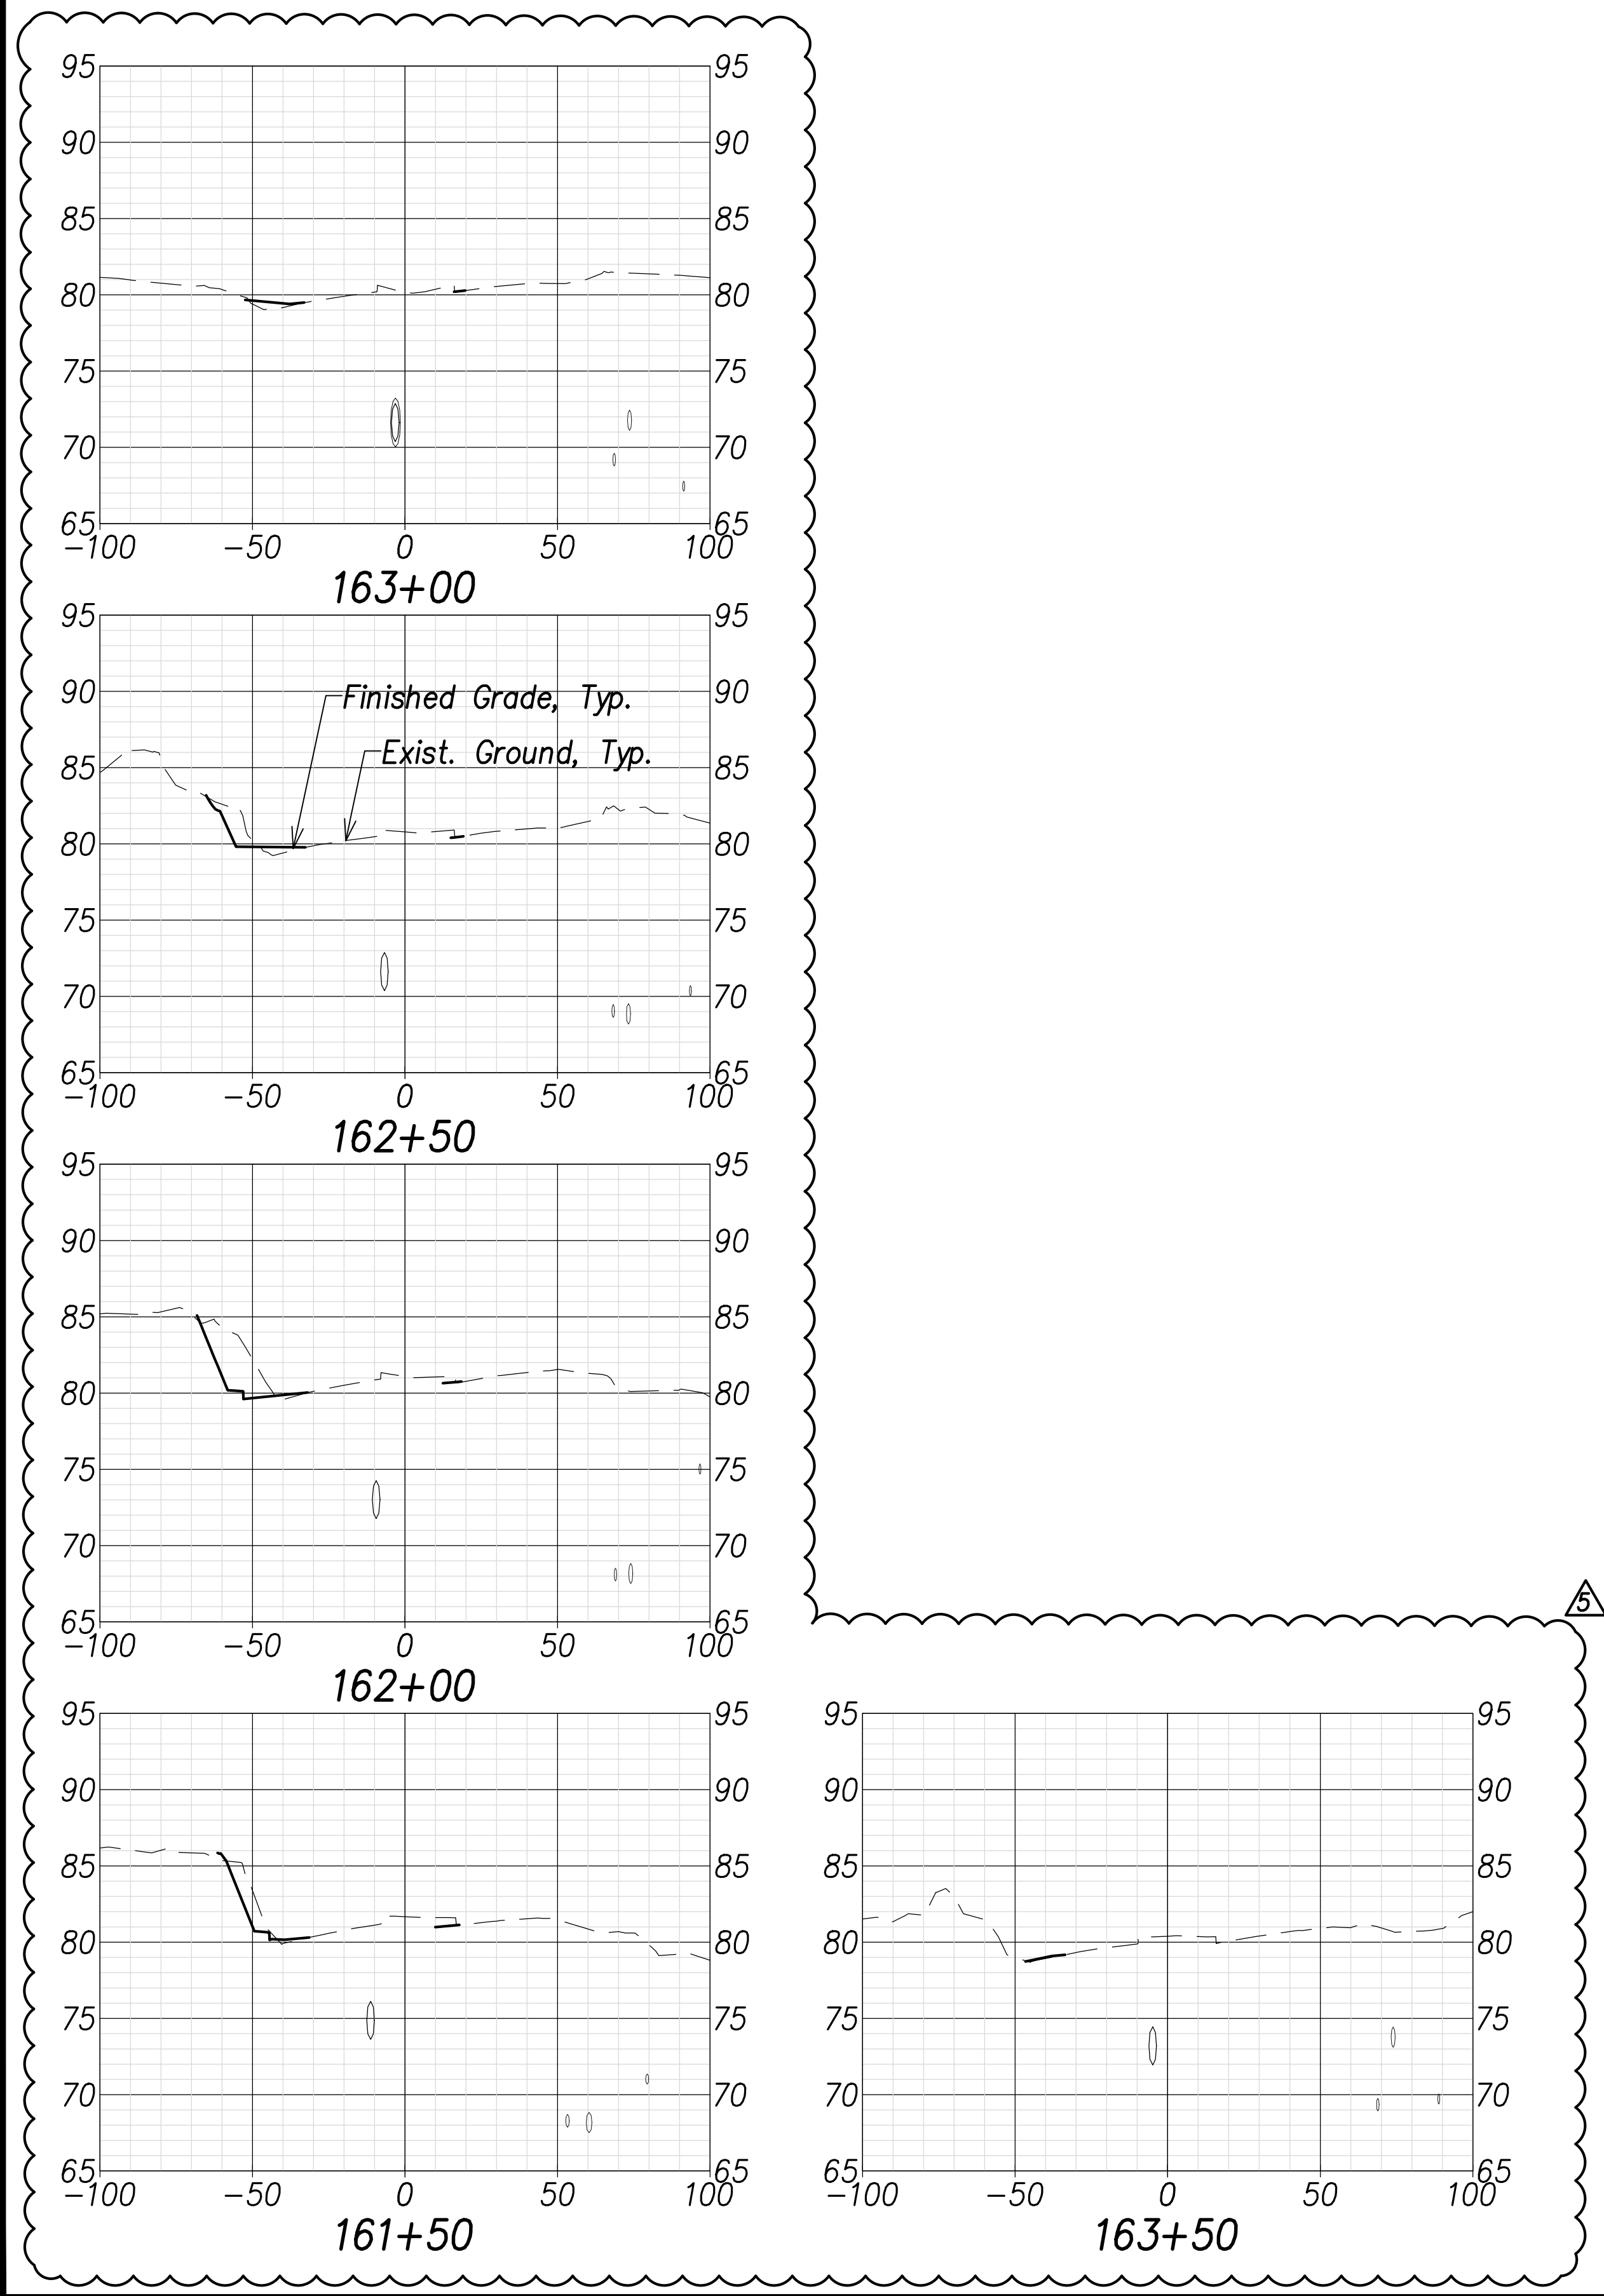

ORIGINAL PLAN	DATE
SURVEY PLOTTED BY	.....
DRAWN BY	.....
TRACED BY	.....
NOTE BOOK	.....
QUANTITIES BY	.....
CHECKED BY	.....
No.	.....

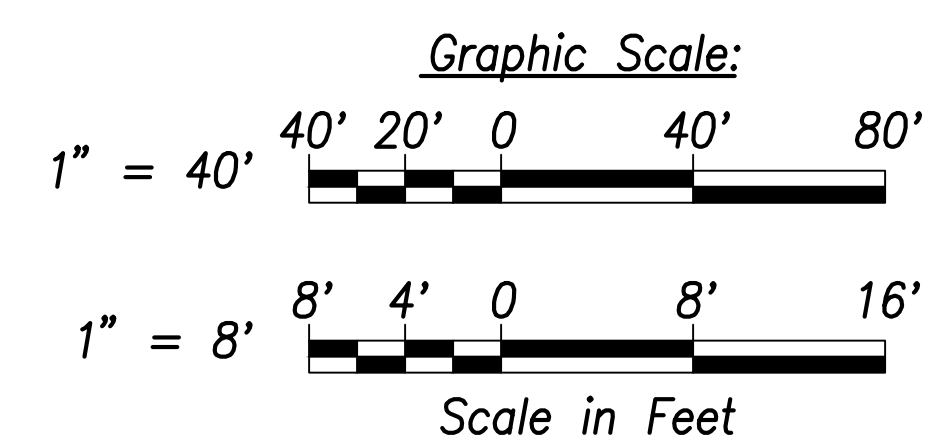

THIS WORK WAS PREPARED BY ME OR UNDER MY SUPERVISION AND CONSTRUCTION OF THIS PROJECT WILL BE UNDER MY OBSERVATION.

Signature: *Craig W. Luke*  
 EXPIRATION DATE OF THE LICENSE: April 30, 2024

07/15/22	5	Revised cross sections
06/08/22	2	Replace sheet
DATE		REVISION

STATE OF HAWAII  
 DEPARTMENT OF TRANSPORTATION  
 HIGHWAYS DIVISION

### Cross Sections - 17

FARRINGTON HIGHWAY WIDENING  
 Kapolei Golf Course Road to Fort Weaver Road  
 Project No. 7101A-01-20

Scale: As Shown      Date: April 2022

**SHEET No. C-250 OF 767 SHEETS**


FILE: K:\civil\23146 Farrington Hwy Widening\Draw\Construction\Draw\C-250 Cross Sections - 17.dwg saved July 11, 2022

FED. ROAD DIST. NO.	STATE	PROJ. NO.	FISCAL YEAR	SHEET NO.	TOTAL SHEETS
HAWAII	HAW.	7101A-01-20	2021		XXX


TEST STATION SCHEDULE						
NO.	PIPELINE/STREET NAME	STATION	TEST STATION TYPE	NUMBER OF ANODES	TYPE OF ANODES	NOTES
1	W20	51+93.1	IJTS	N/A	N/A	INSULATING JOINT BEFORE RCJ
2	W20	52+80.0	ATS	4	HIGH-POTENTIAL MAGNESIUM (60 LB)	
3	W20	54+80.0	ATS	4	HIGH-POTENTIAL MAGNESIUM (60 LB)	
4	W20	56+08.4	IJTS	N/A	N/A	INSULATING JOINT BEFORE RCJ

NOTES:

- TEST STATIONS TO BE LOCATED ON THE FAR EDGE OF THE ROW AND IN AREAS NOT SUBJECT TO VEHICULAR TRAFFIC, SUCH AS SIDEWALKS.
- WHEN AVAILABLE, TEST STATIONS TO BE LOCATED BEHIND NEAREST CURB AND WITHIN 5 FT OF FIRE HYDRANT.
- IJTS STATIONING TAKEN FROM INSULATING JOINT. INSULATING JOINT SHALL BE INSTALLED BETWEEN CONCRETE ENCASED PIPE AND NON-ENCASED PIPE.
- ELECTRICALLY ISOLATE ALL METALLIC LATERAL PIPING (INCLUDING ARVs) FROM PROJECT PIPELINES. IF METALLIC LATERAL PIPING IS NOT PROPERLY ISOLATED FROM THE PROJECT PIPELINES, THEN THE CATHODIC PROTECTION SYSTEM COULD BE PREMATURELY DEPLETED.
- THE CATHODIC PROTECTION SYSTEM DESIGN IS DEPENDENT ON THE DIP HAVING A BONDED DIELECTRIC COATING PER THE BWS WATER SYSTEM EXTERNAL CORROSION CONTROL STANDARDS. IF THE DIP DOES NOT HAVE A BONDED DIELECTRIC COATING, THEN THE CATHODIC PROTECTION SYSTEM COULD BE PREMATURELY DEPLETED.

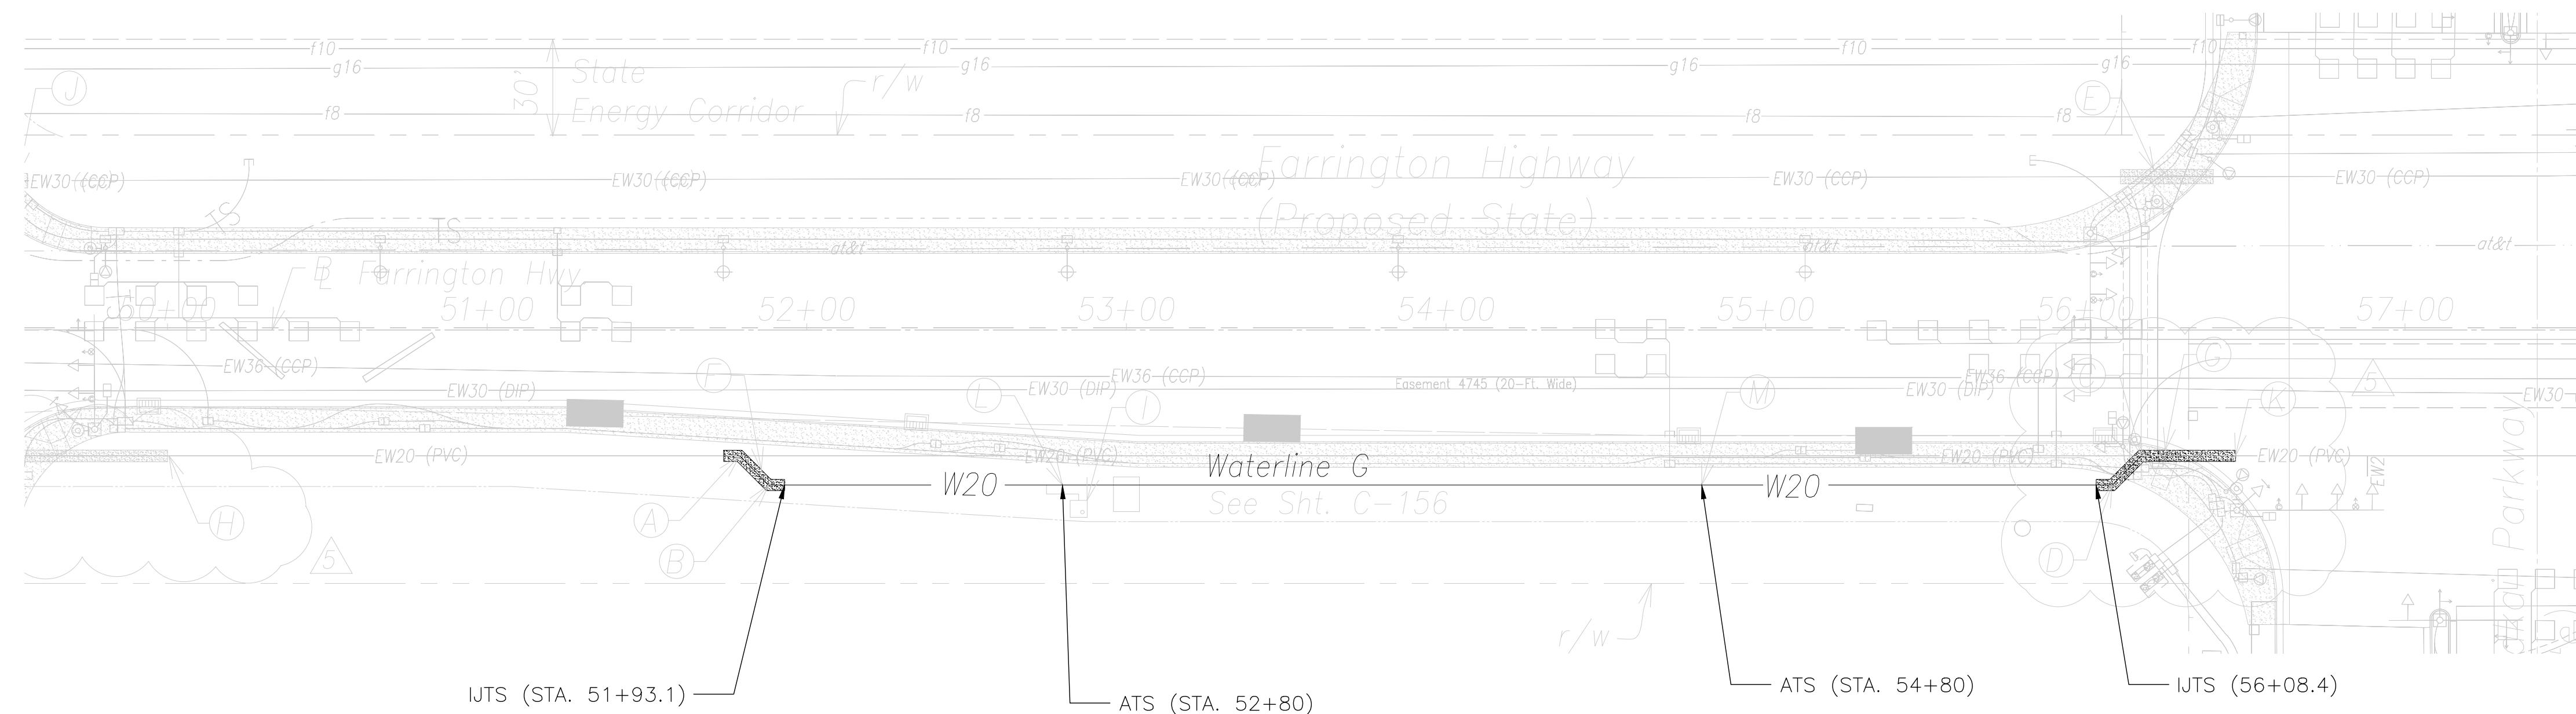

ORIGINAL PLAN	SURVEY PLOTTED BY	DATE
NOTE BOOK	DRAWN BY	
No.	TRACED BY	
	CHECKED BY	
	APPROVED BY	
	CHECKED BY	

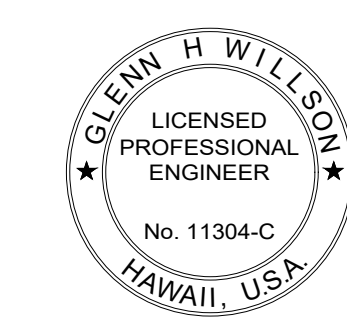

**V&A**  
 1000 Broadway, Suite 320  
 Oakland, CA 94607  
 Tel. (510) 903-6600, Fax (510) 903-6601  
 Project No. 21-0197

THIS WORK WAS PREPARED BY ME OR UNDER MY SUPERVISION AND CONSTRUCTION OF THIS PROJECT WILL BE UNDER MY OBSERVATION.  
 SIGNATURE: *Glenn H. Willson* EXPIRATION DATE OF THE LICENSE: April 30, 2024

07/15/22 Replace Sheet

STATE OF HAWAII  
 DEPARTMENT OF TRANSPORTATION  
 HIGHWAYS DIVISION


**CATHODIC PROTECTION  
 TEST STATION SCHEDULE**

FARRINGTON HIGHWAY WIDENING  
 Kapolei Golf Course Road to Fort Weaver Road  
 Project No. 7101A-01-20


Scale: As Shown Date: April 2022

SHEET No. CP-1 OF 767 SHEETS


FED. ROAD DIST. NO.	STATE	PROJ. NO.	FISCAL YEAR	SHEET NO.	TOTAL SHEETS
HAWAII	HAW.	7101A-01-20	2021		XXX

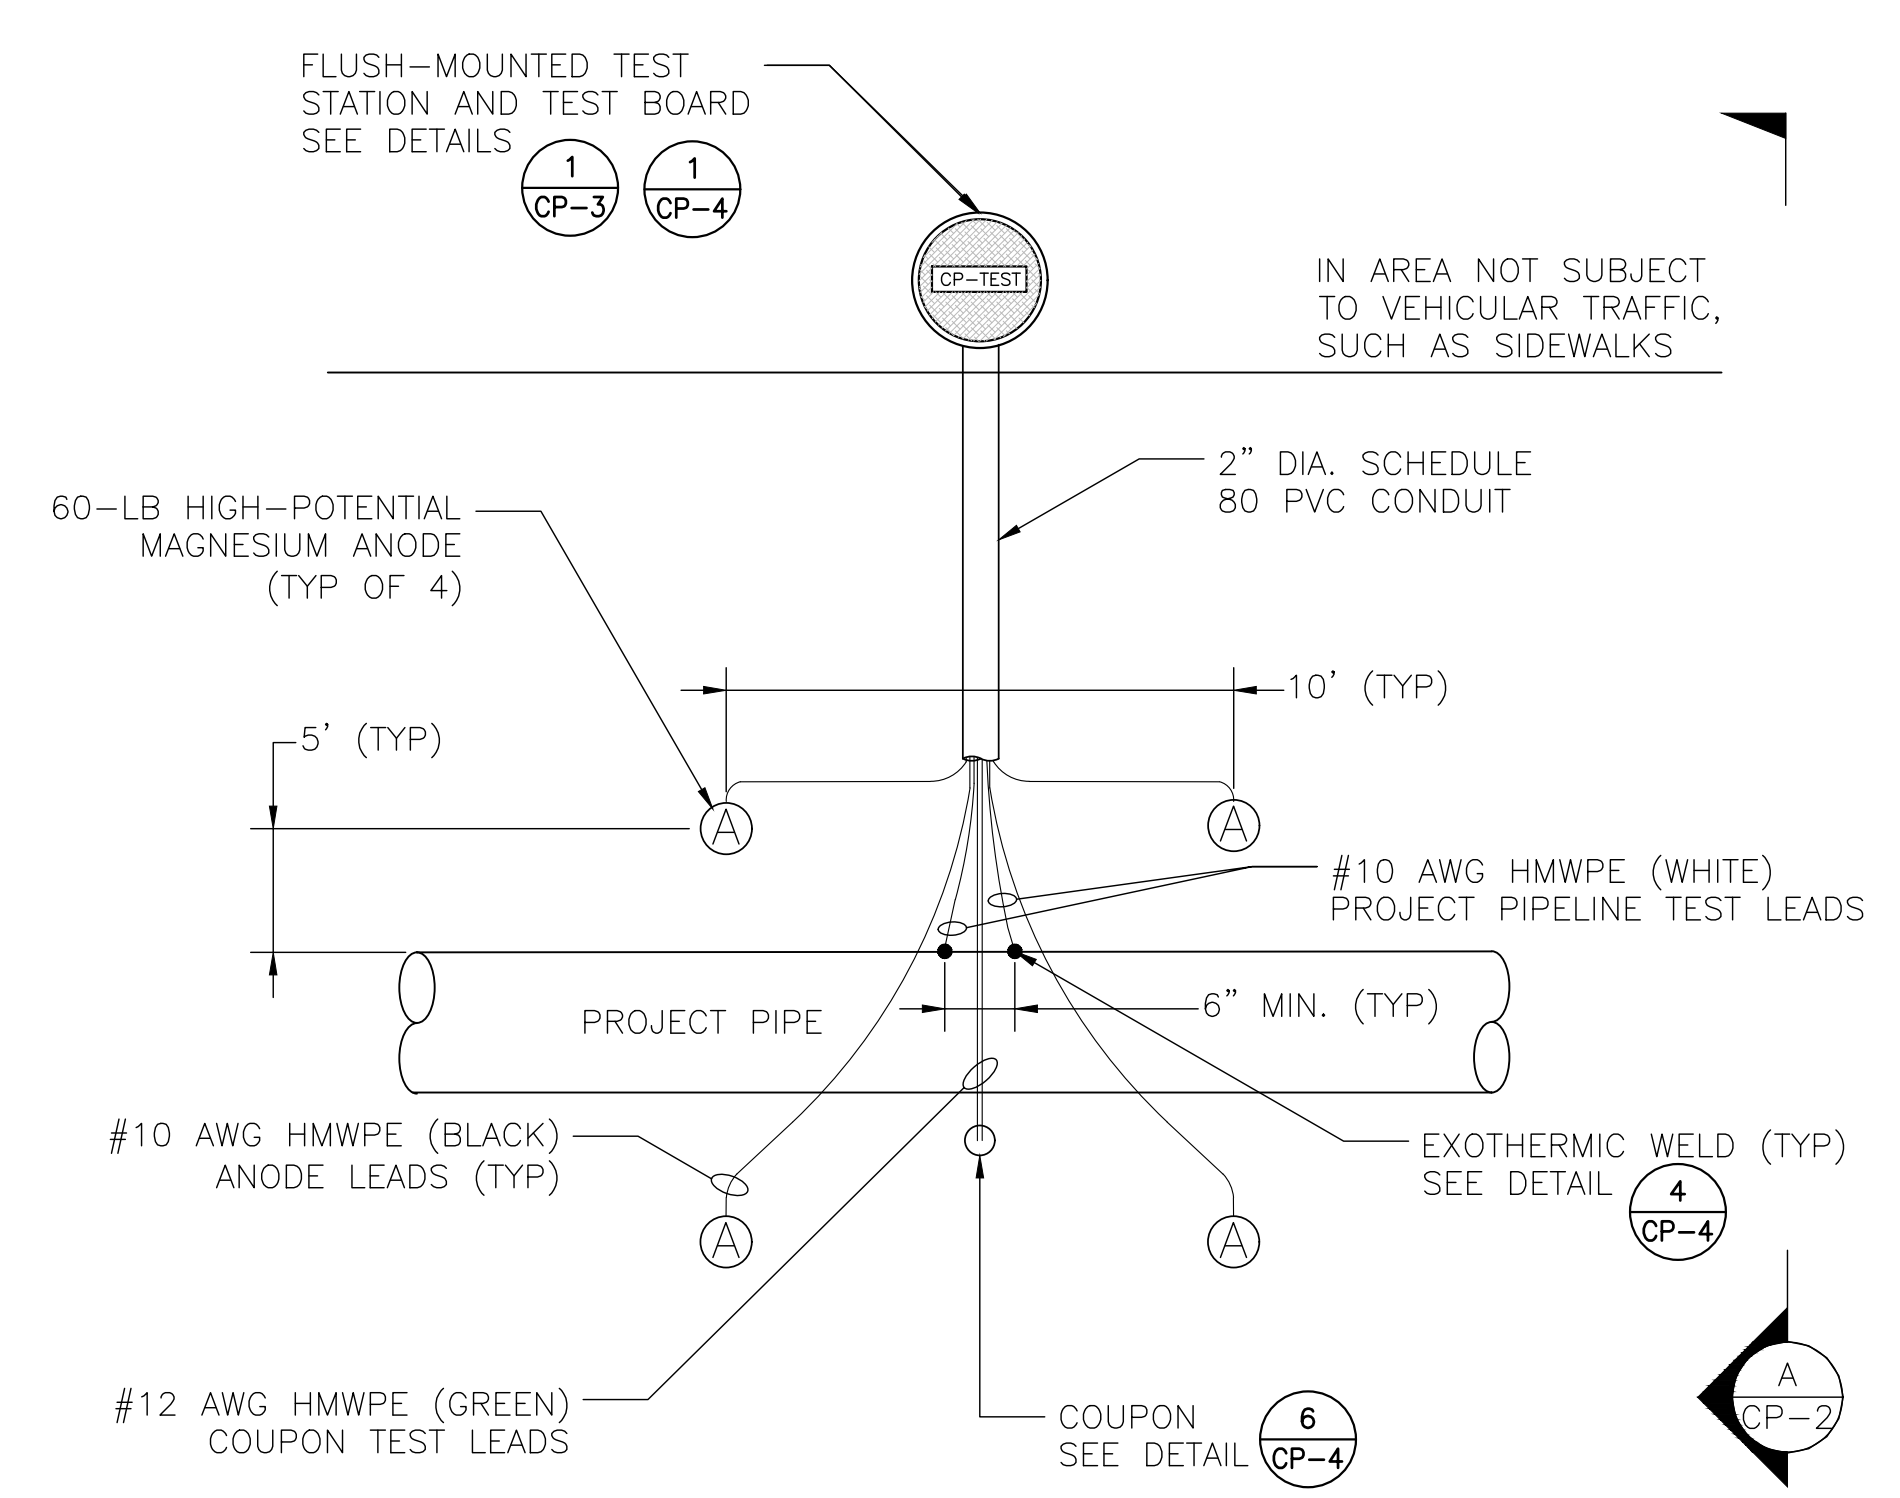

ANODE TEST STATION (ATS)  
PLAN VIEW  
SCALE: NTS

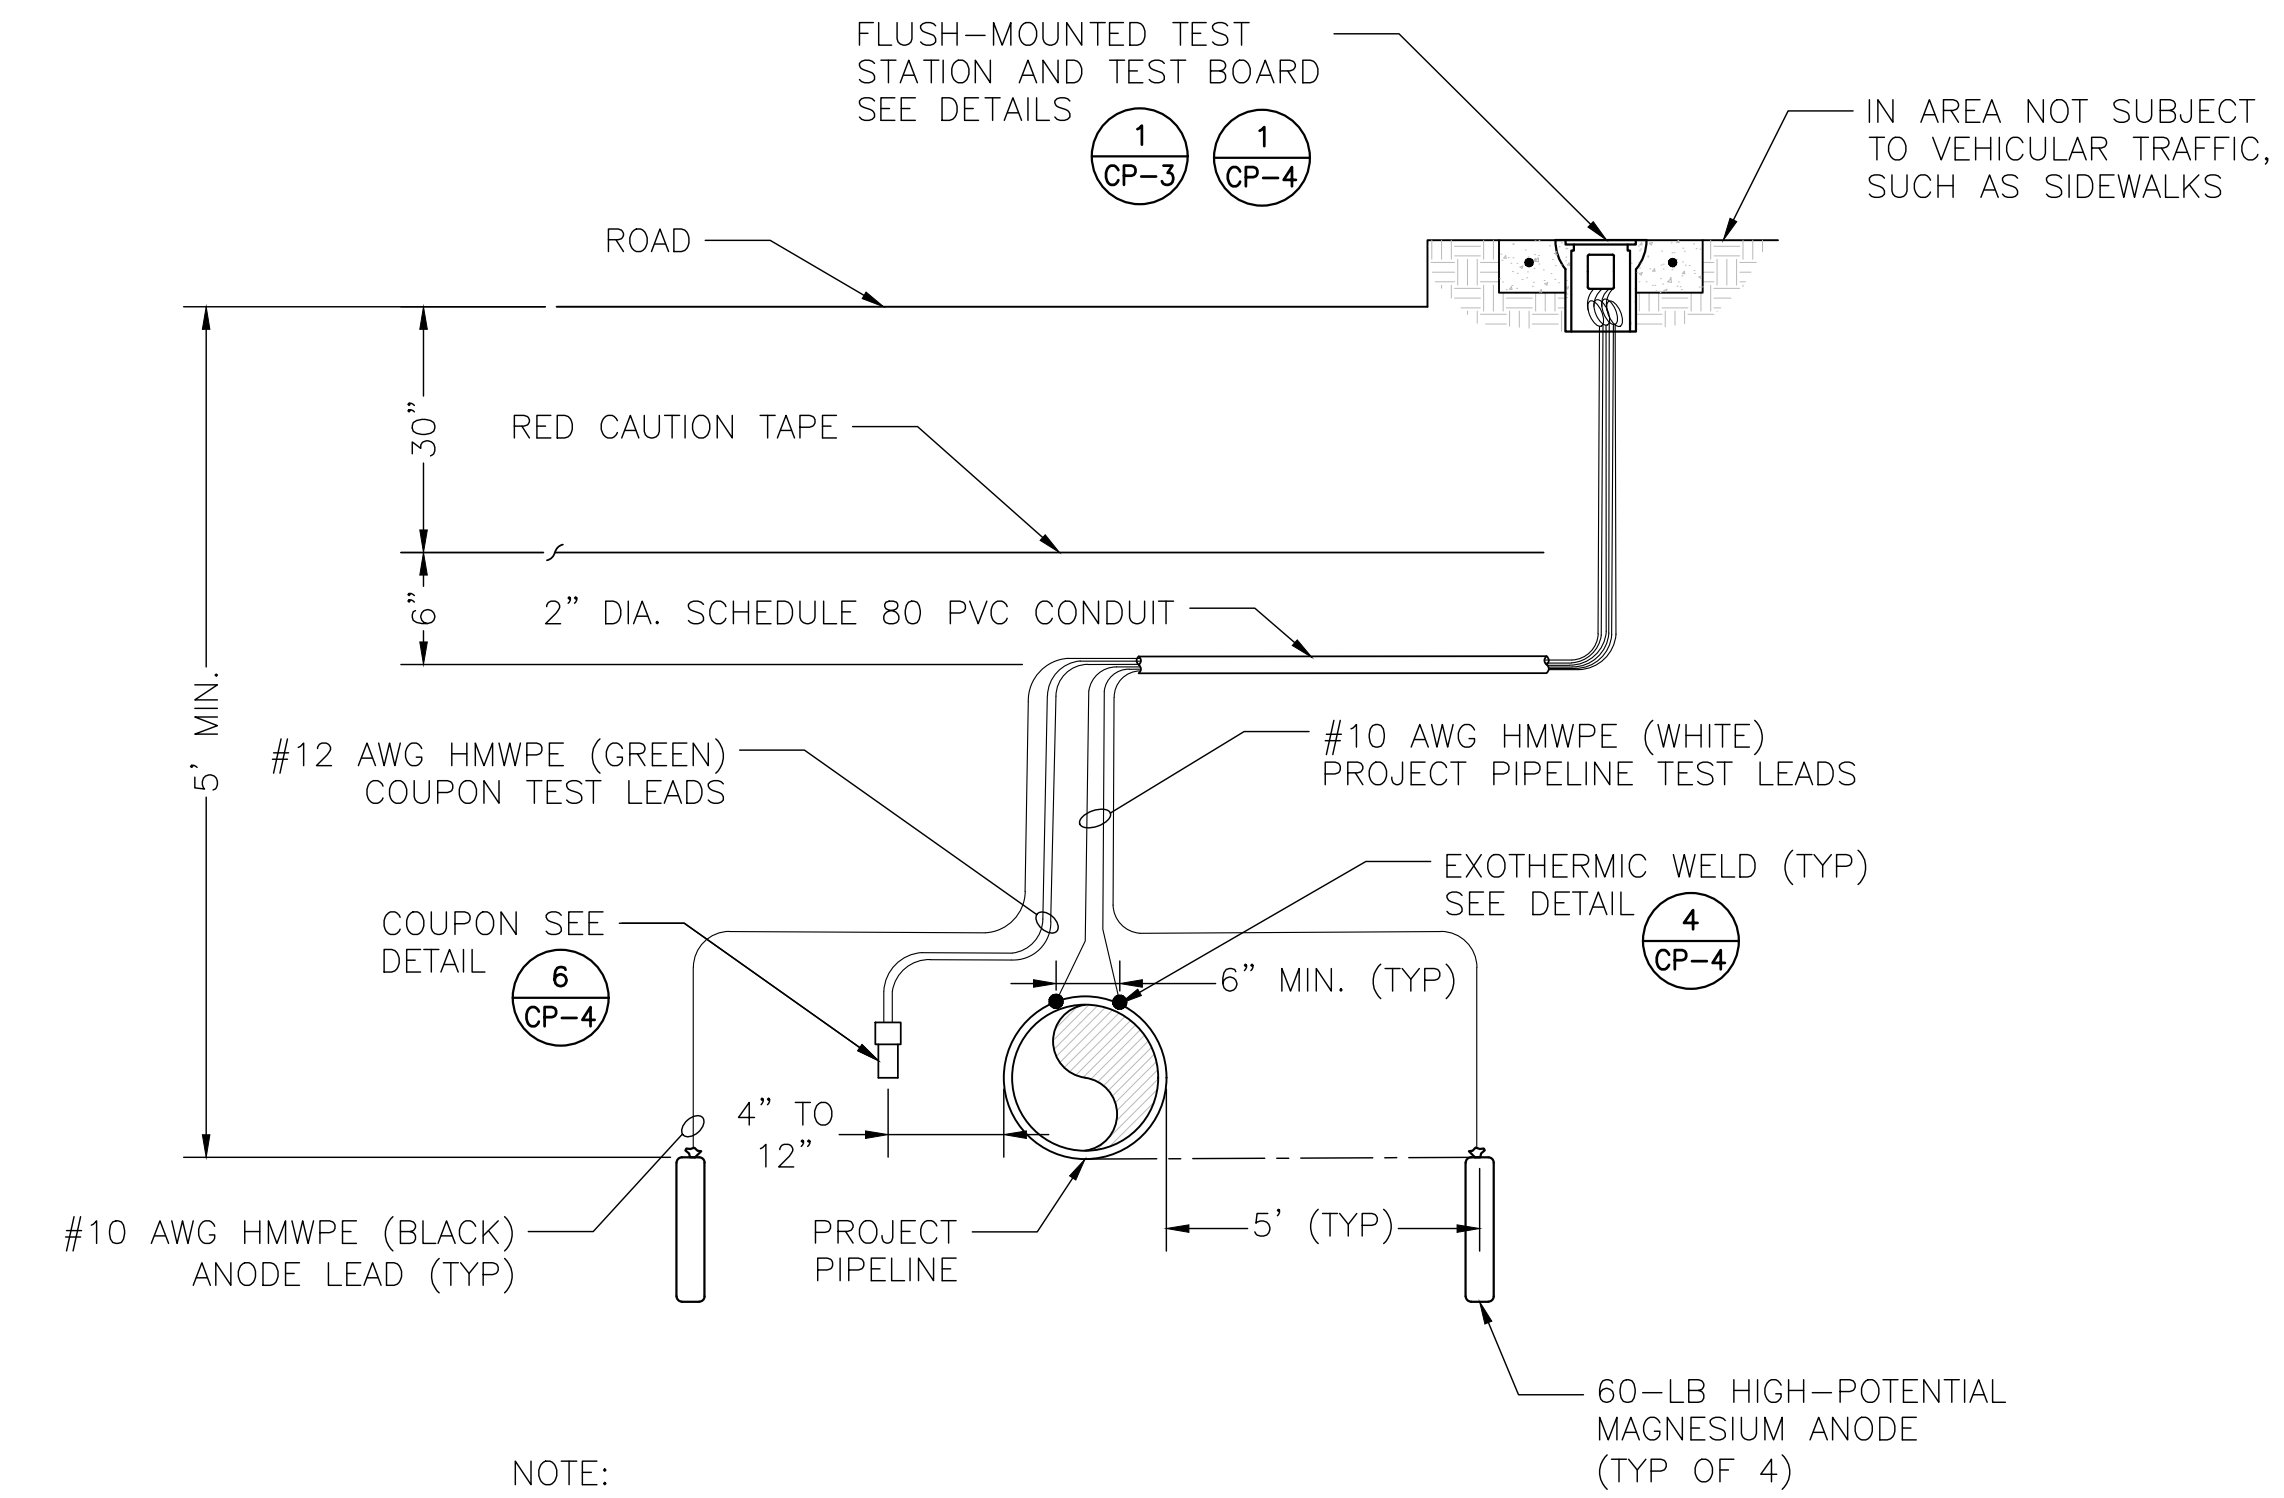


ANODE TEST STATION (ATS)  
SECTION VIEW  
SCALE: NTS

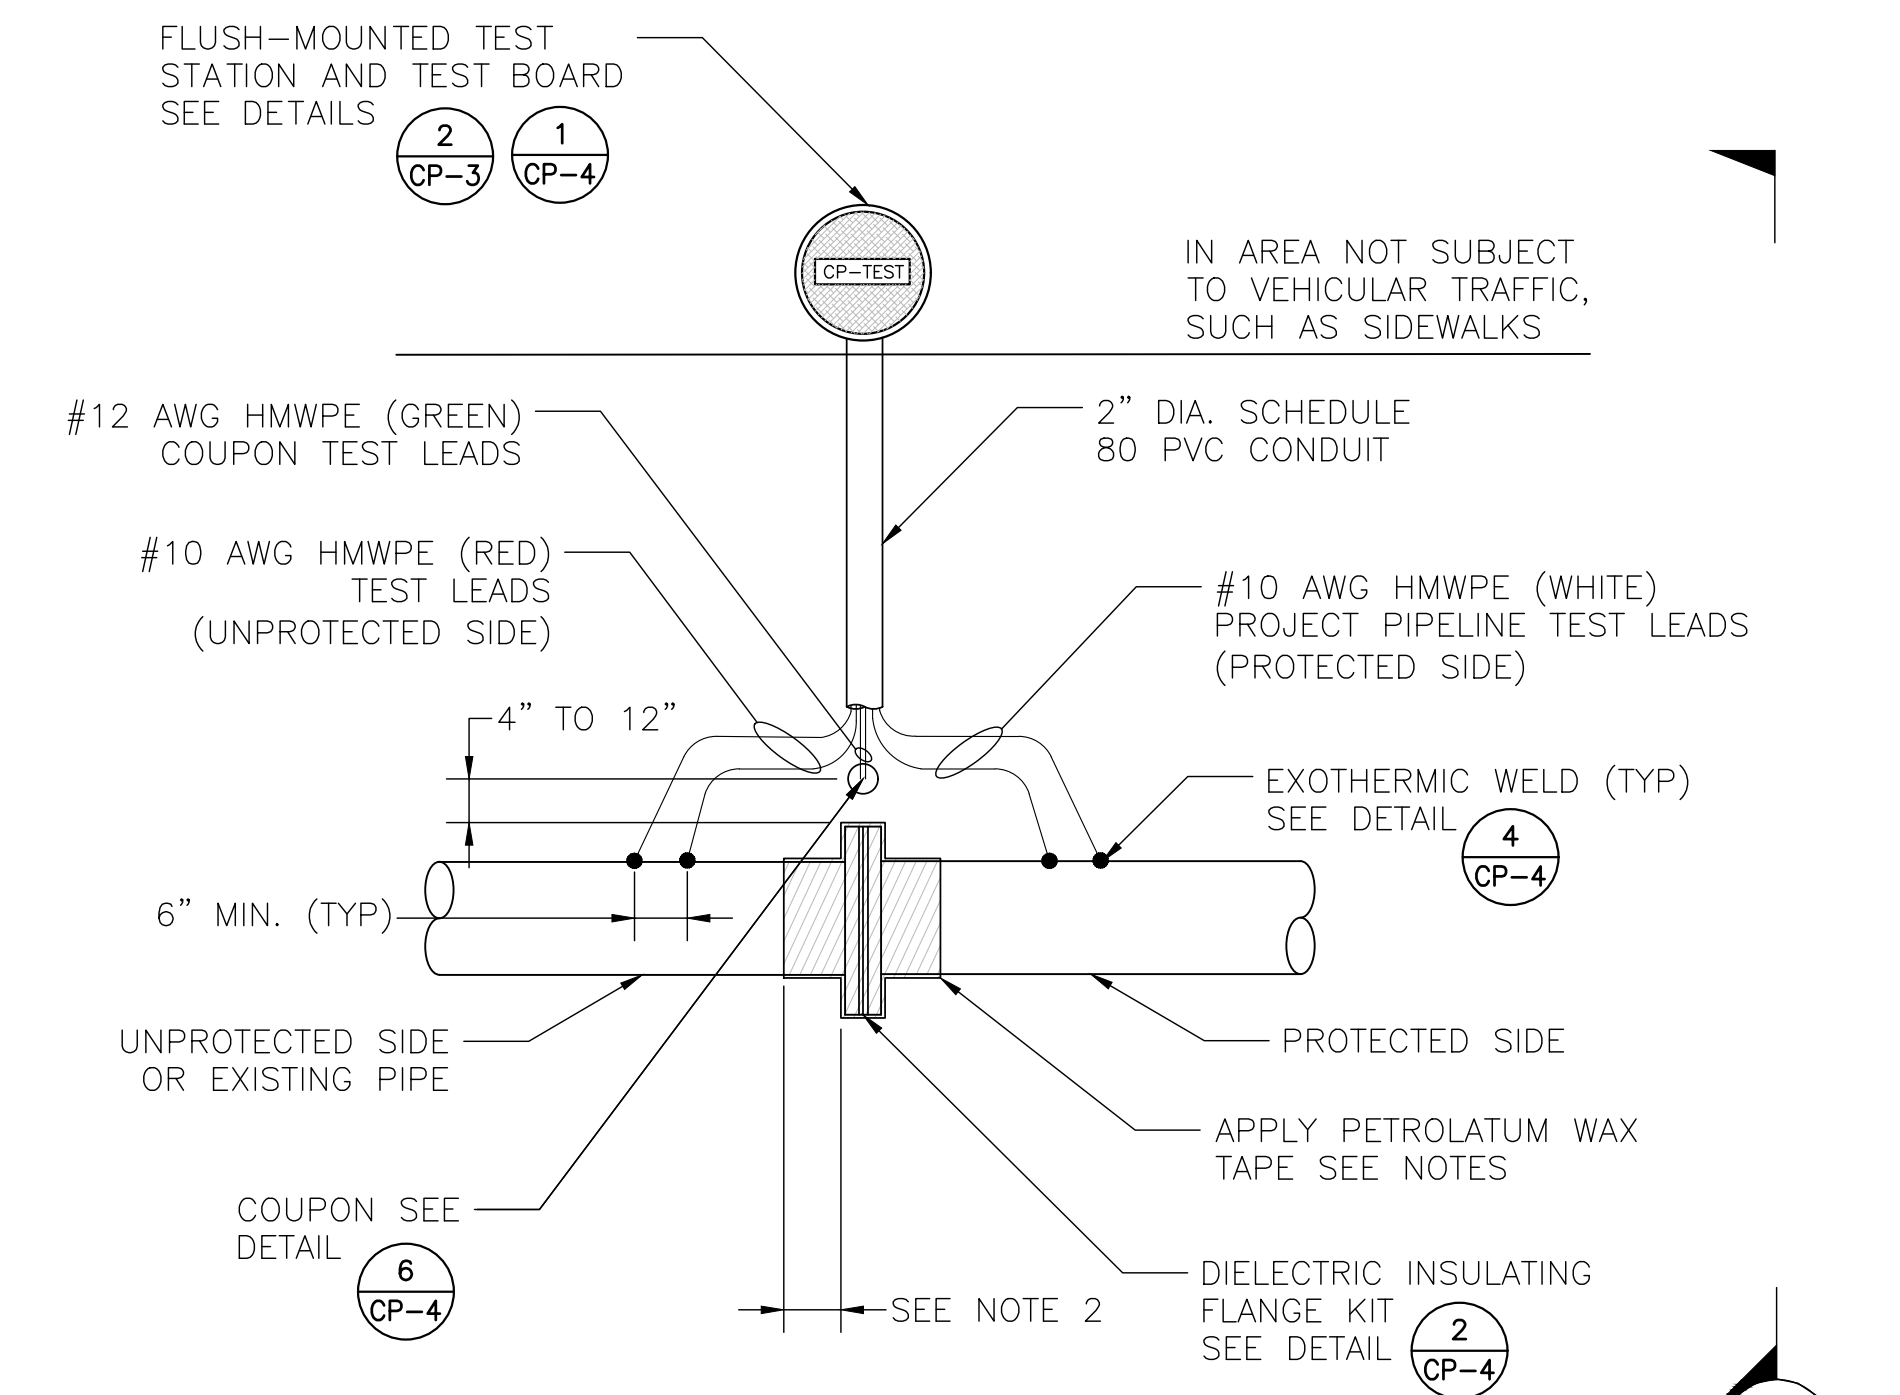


- NOTES:
1. REINFORCED CONCRETE JACKETING NOT SHOWN FOR CLARITY.
  2. COAT THE EXTERIOR OF THE INSULATING FLANGE WITH PETROLATUM WAX TAPE FOR A MINIMUM OF 3 FEET BEYOND THE GASKET WITH A MINIMUM OF 6 INCHES OF OVERLAP WITH THE FACTORY-APPLIED COATING ON THE PIPELINE.

INSULATING JOINT TEST STATION (IJTS)  
PLAN VIEW  
SCALE: NTS

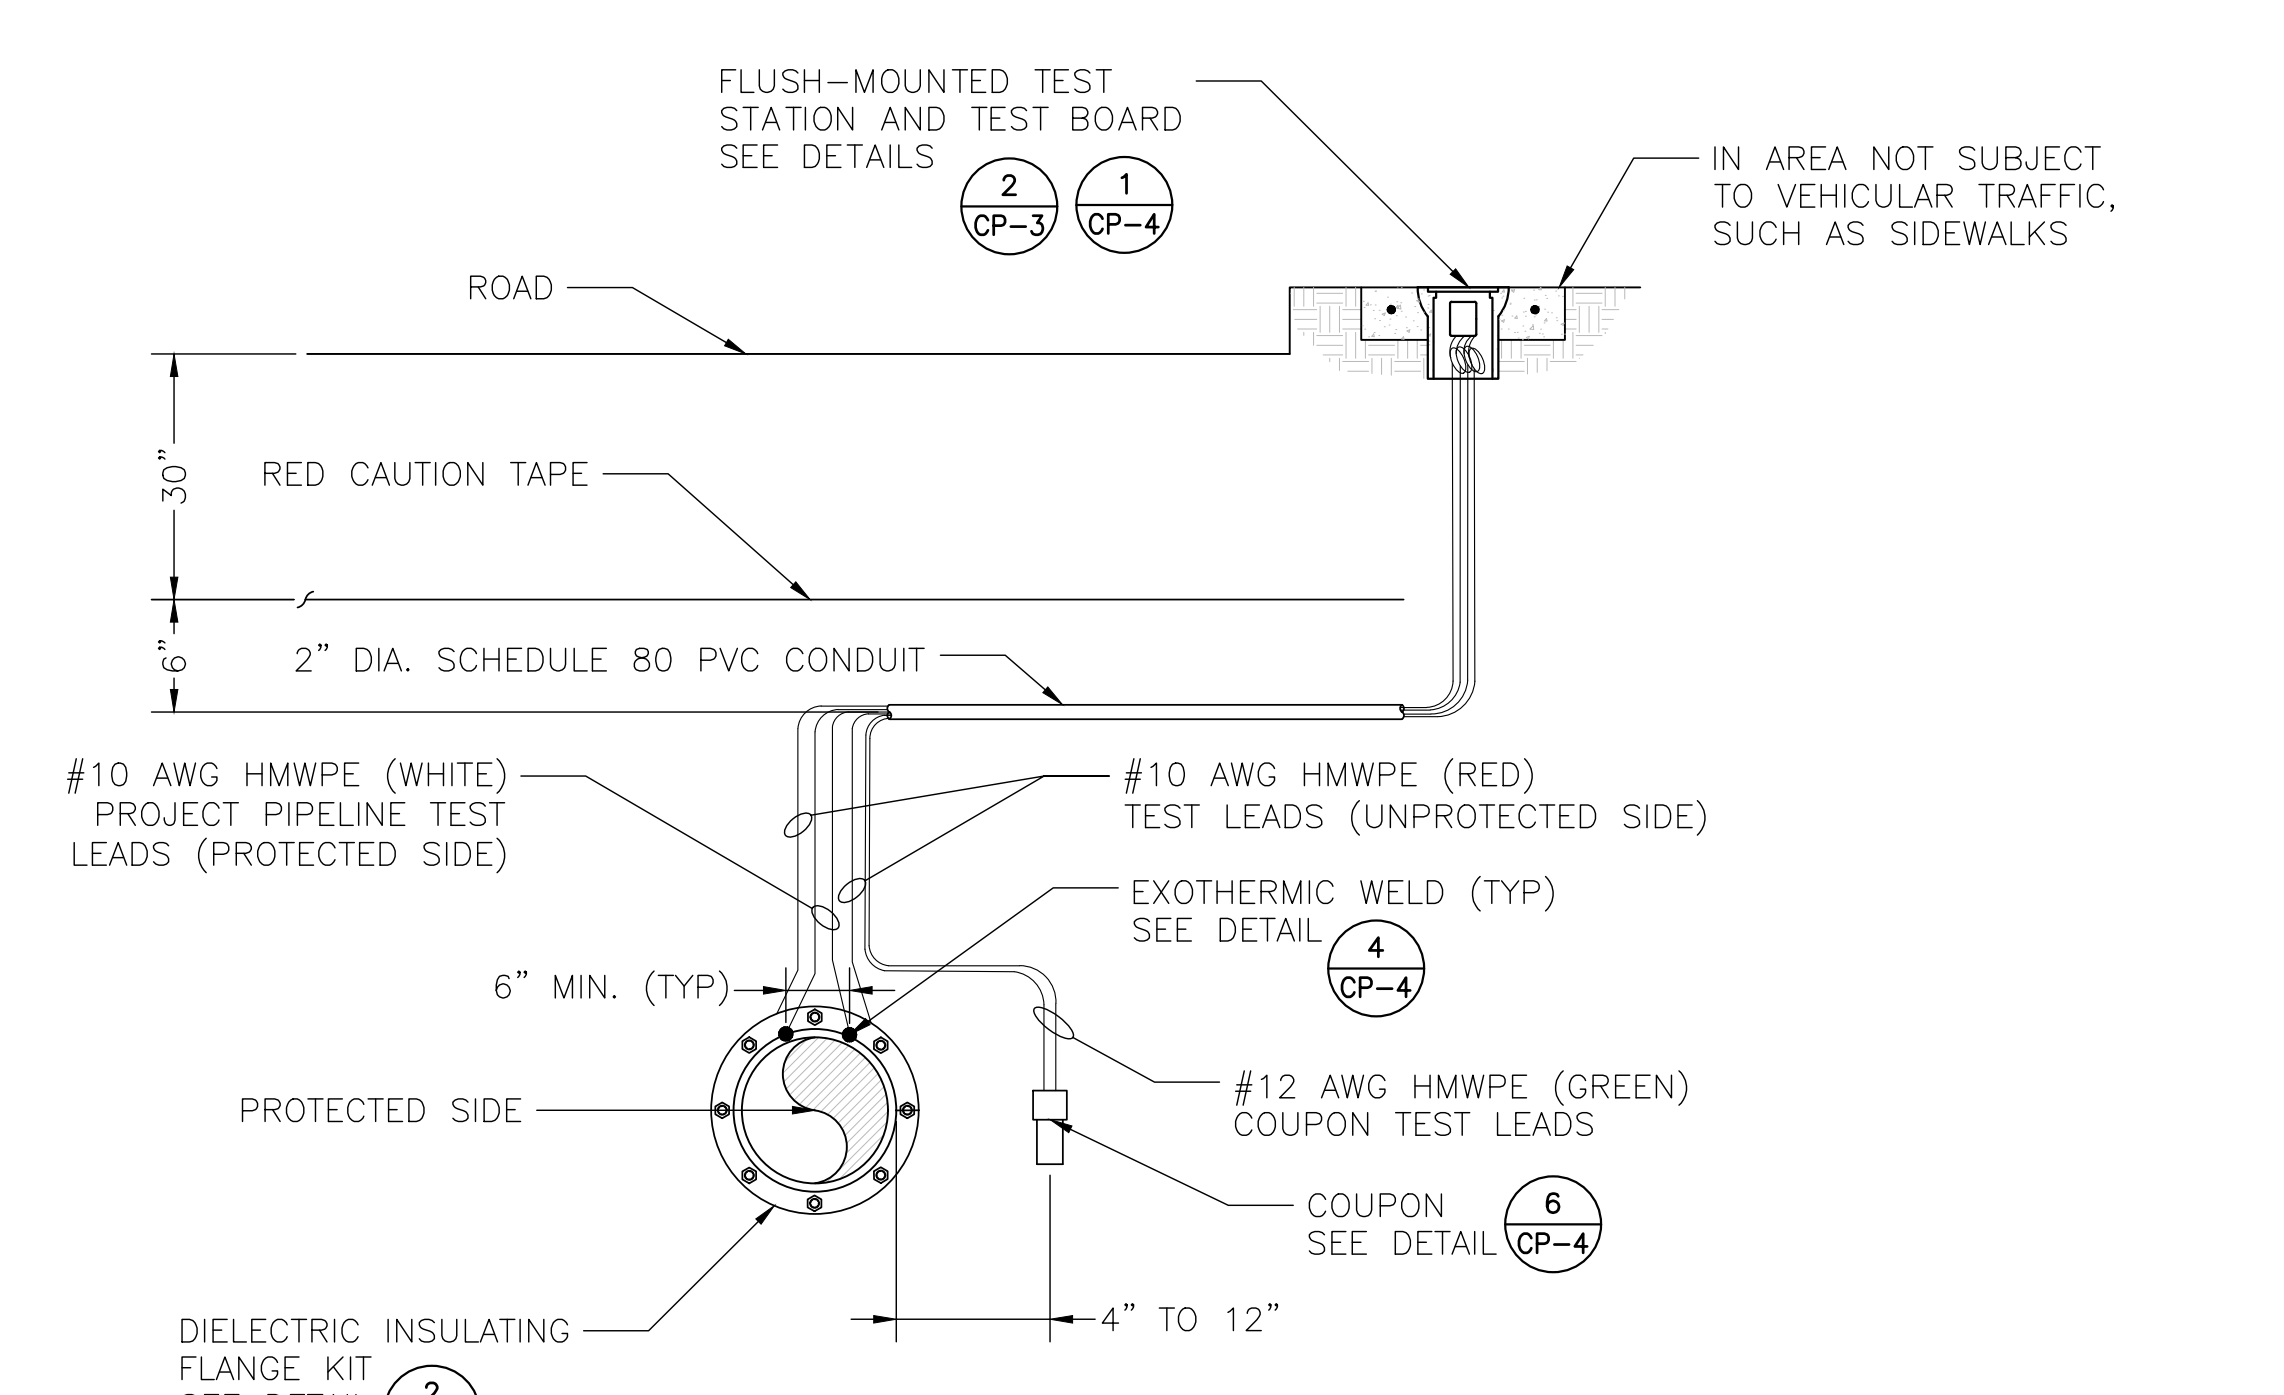

INSULATING JOINT TEST STATION (IJTS)  
SECTION VIEW  
SCALE: NTS

SURVEY PLOTTED BY	DATE
DRAWN BY	
TRACED BY	
NOTED BY	
APPROVED BY	
CHECKED BY	
ORIGINAL PLAN	
NOTE BOOK	
No.	

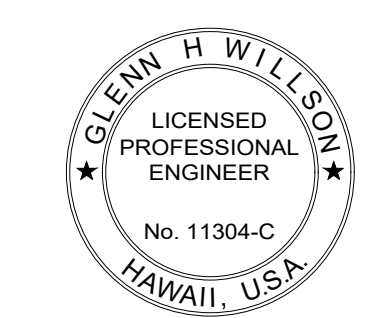


**V&A**  
1000 Broadway, Suite 320  
Oakland, CA 94607  
Tel. (510) 903-6600, Fax (510) 903-6601  
Project No. 21-0197

THIS WORK WAS PREPARED BY ME OR UNDER MY SUPERVISION AND CONSTRUCTION OF THIS PROJECT WILL BE UNDER MY OBSERVATION.  
SIGNATURE: *Glenn H. Willson* EXPIRATION DATE OF THE LICENSE: April 30, 2024


07/15/22 Replace Sheet  
STATE OF HAWAII  
DEPARTMENT OF TRANSPORTATION  
HIGHWAYS DIVISION  
**CATHODIC PROTECTION DETAILS**  
FARRINGTON HIGHWAY WIDENING  
Kapolei Golf Course Road to Fort Weaver Road  
Project No. 7101A-01-20  
Scale: As Shown Date: April 2022  
SHEET No. CP-2 OF 767 SHEETS

FED. ROAD DIST. NO.	STATE	PROJ. NO.	FISCAL YEAR	SHEET NO.	TOTAL SHEETS
HAWAII	HAW.	7101A-01-20	2021		XXX

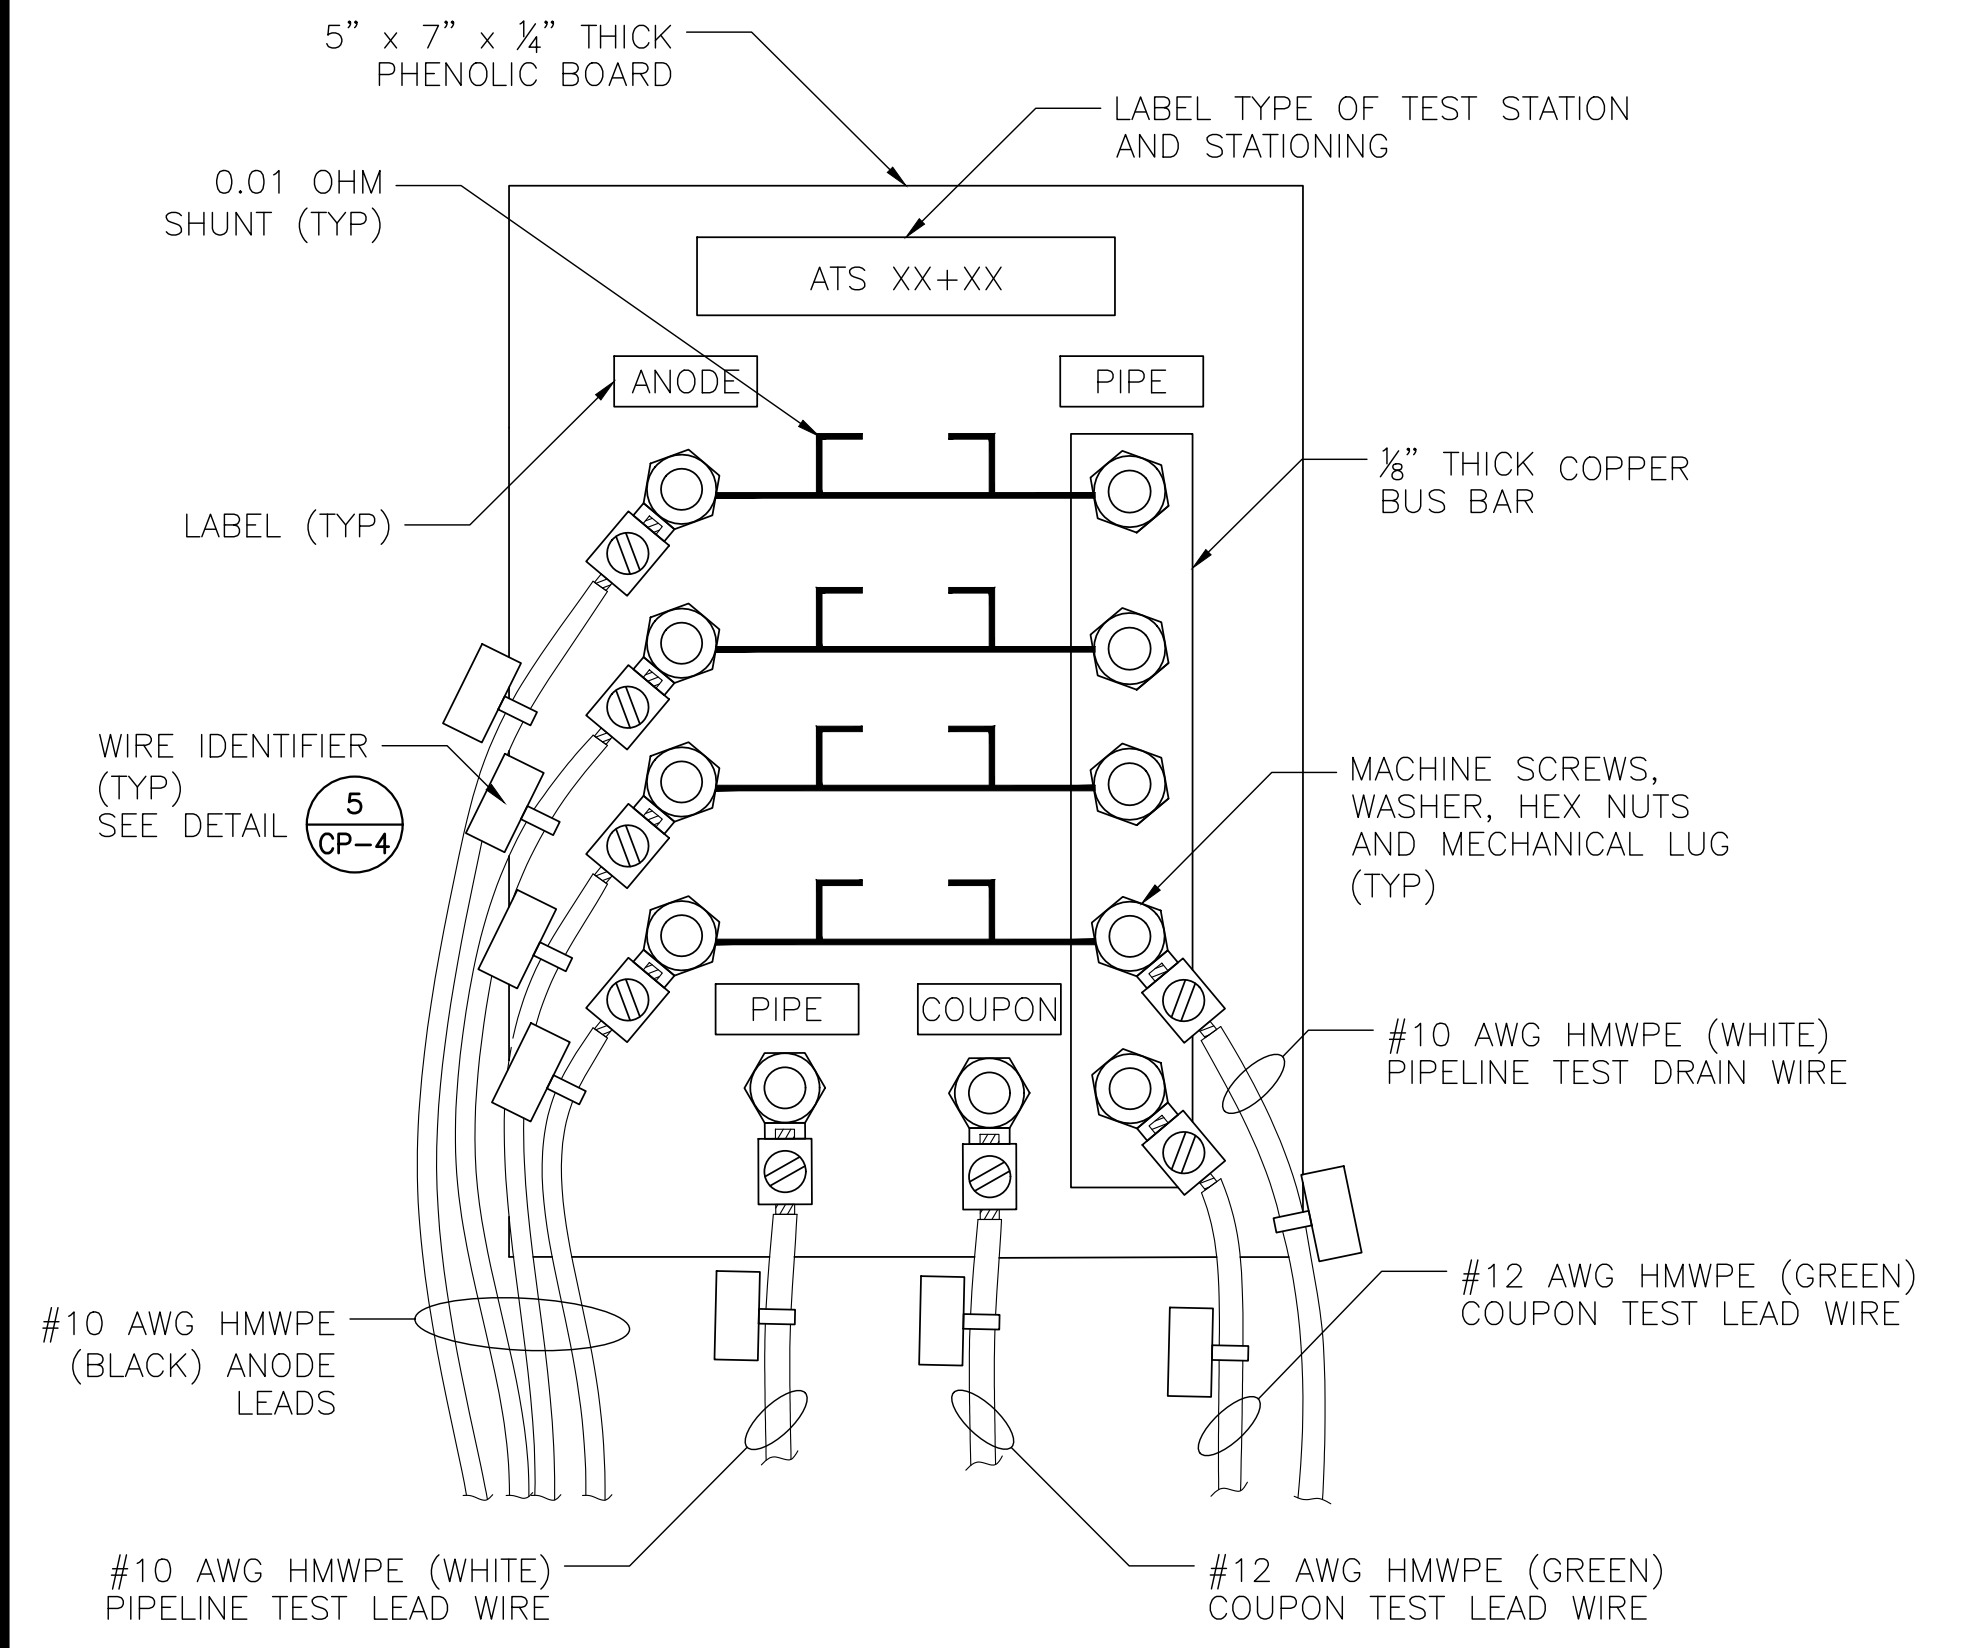


ANODE TEST STATION (ATS)  
TERMINAL BOARD DETAIL  
SCALE: NTS

1  
CP-3

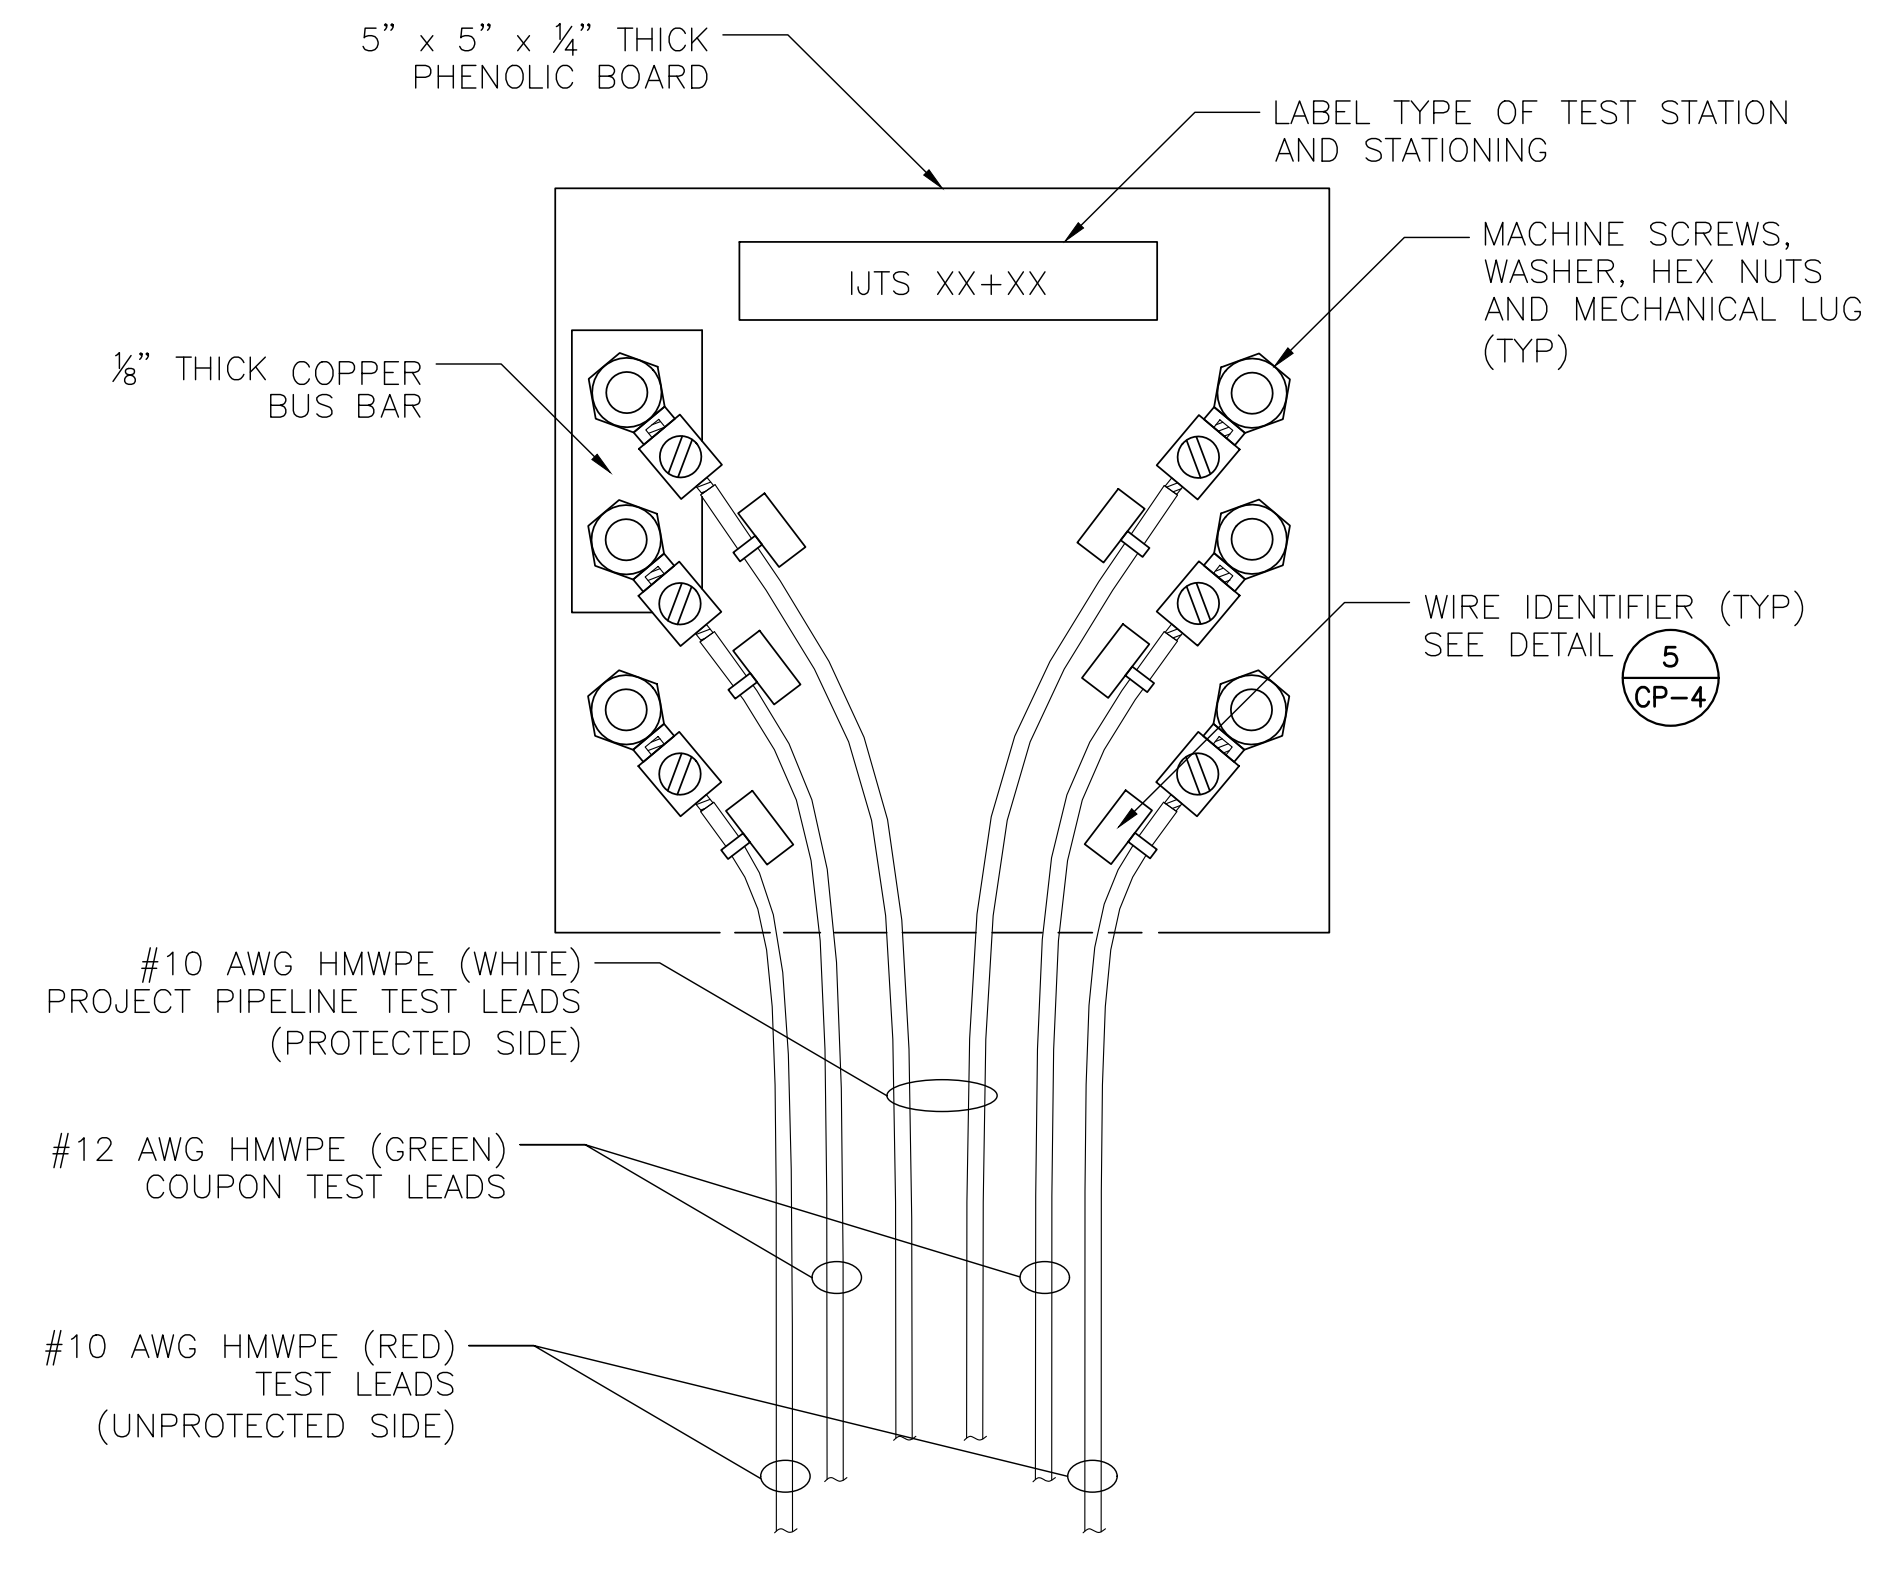

INSULATING JOINT TEST STATION (IJTS)  
TERMINAL BOARD DETAIL  
SCALE: NTS


2  
CP-3

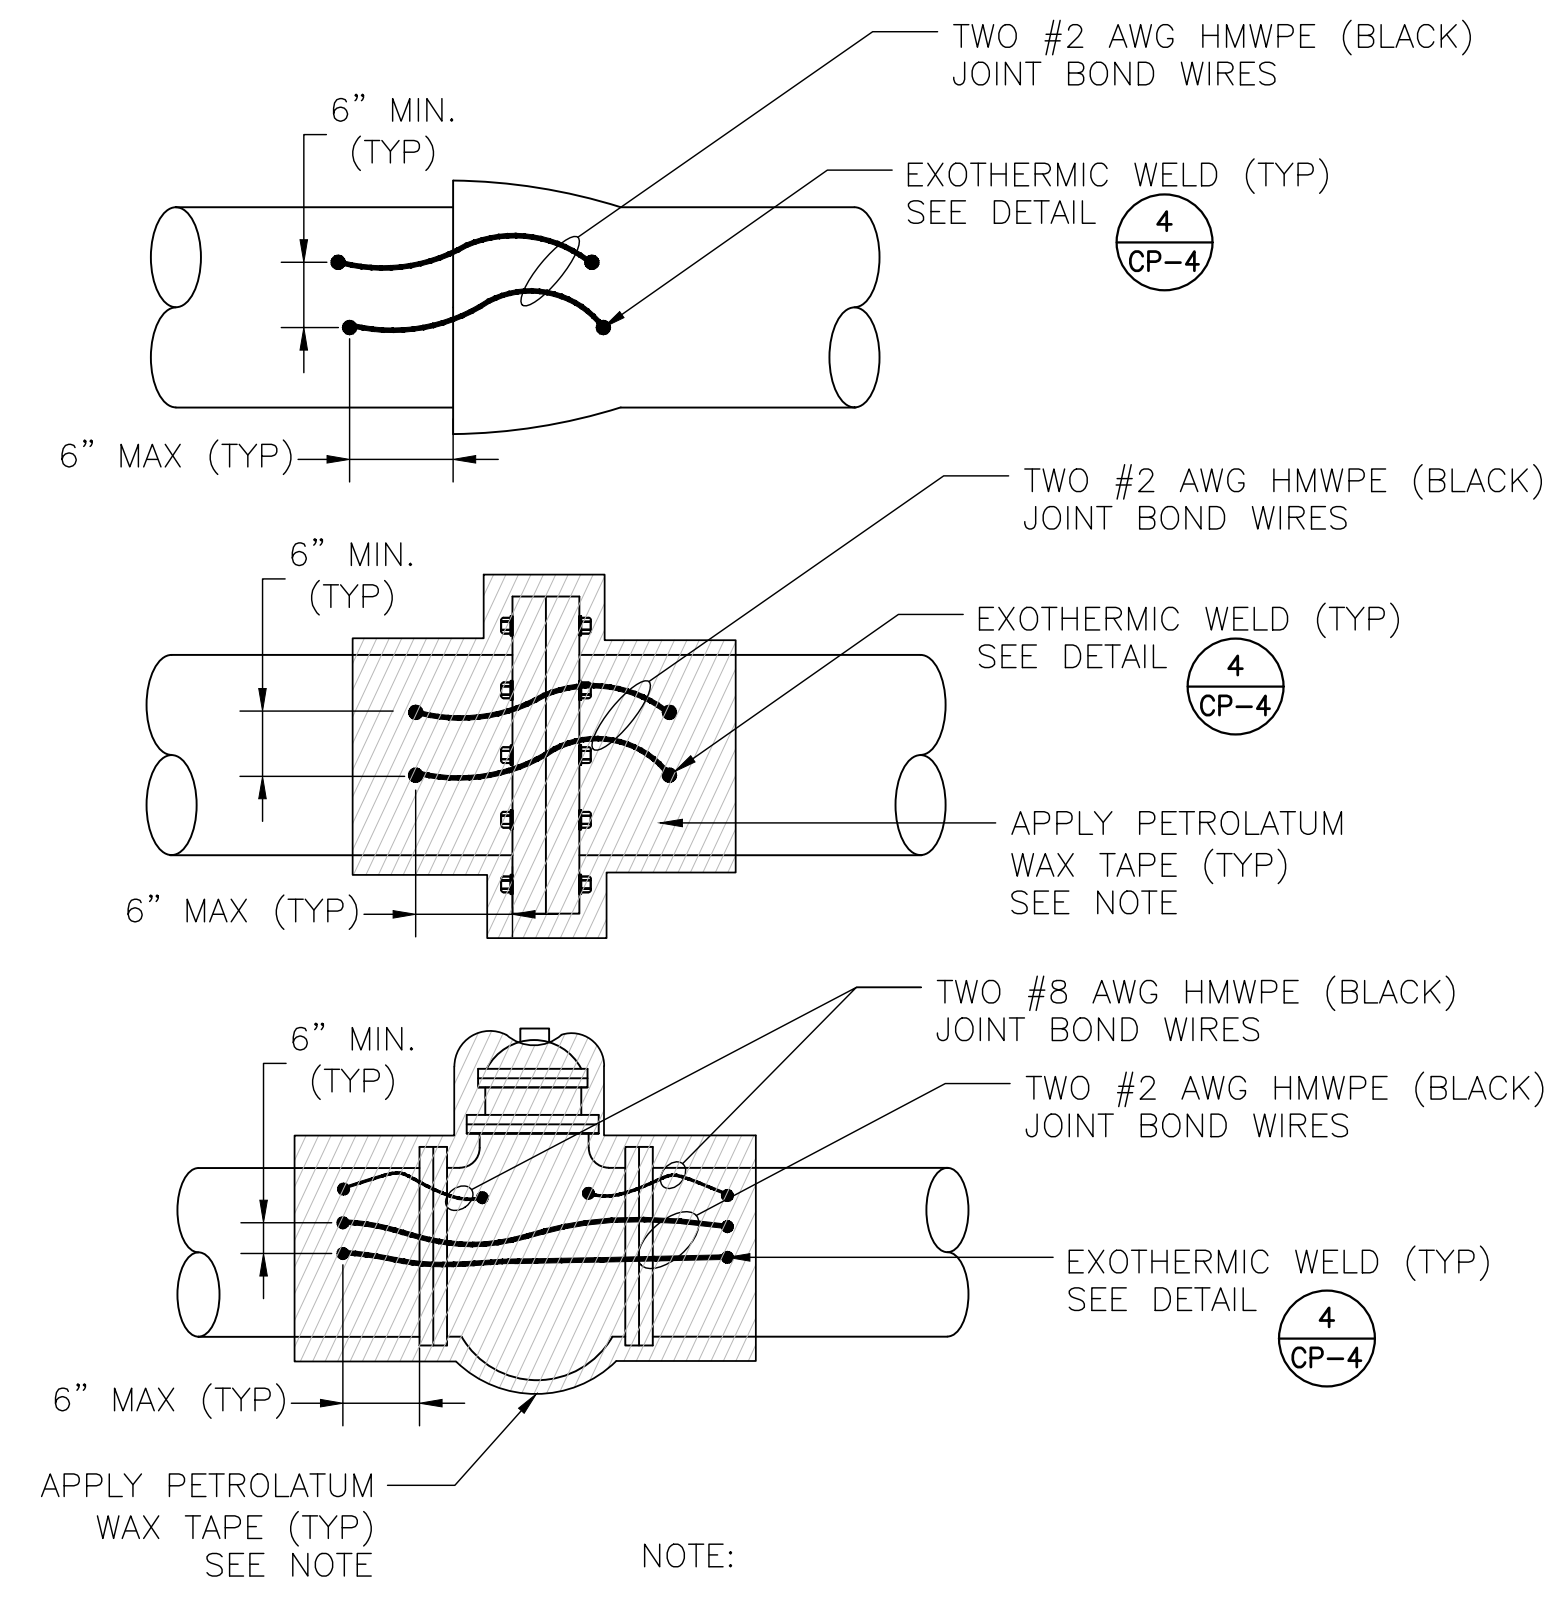

NOTE:  
COAT THE EXTERIOR OF THE JOINT WITH PETROLATUM WAX TAPE FOR A MINIMUM OF 3 FEET BEYOND THE JOINT WITH A MINIMUM OF 6 INCHES OF OVERLAP WITH THE FACTORY-APPLIED COATING ON THE PIPELINE.

PIPE JOINT BONDING DETAILS FOR  
NON-INSULATED JOINTS  
SCALE: NTS

4  
CP-3

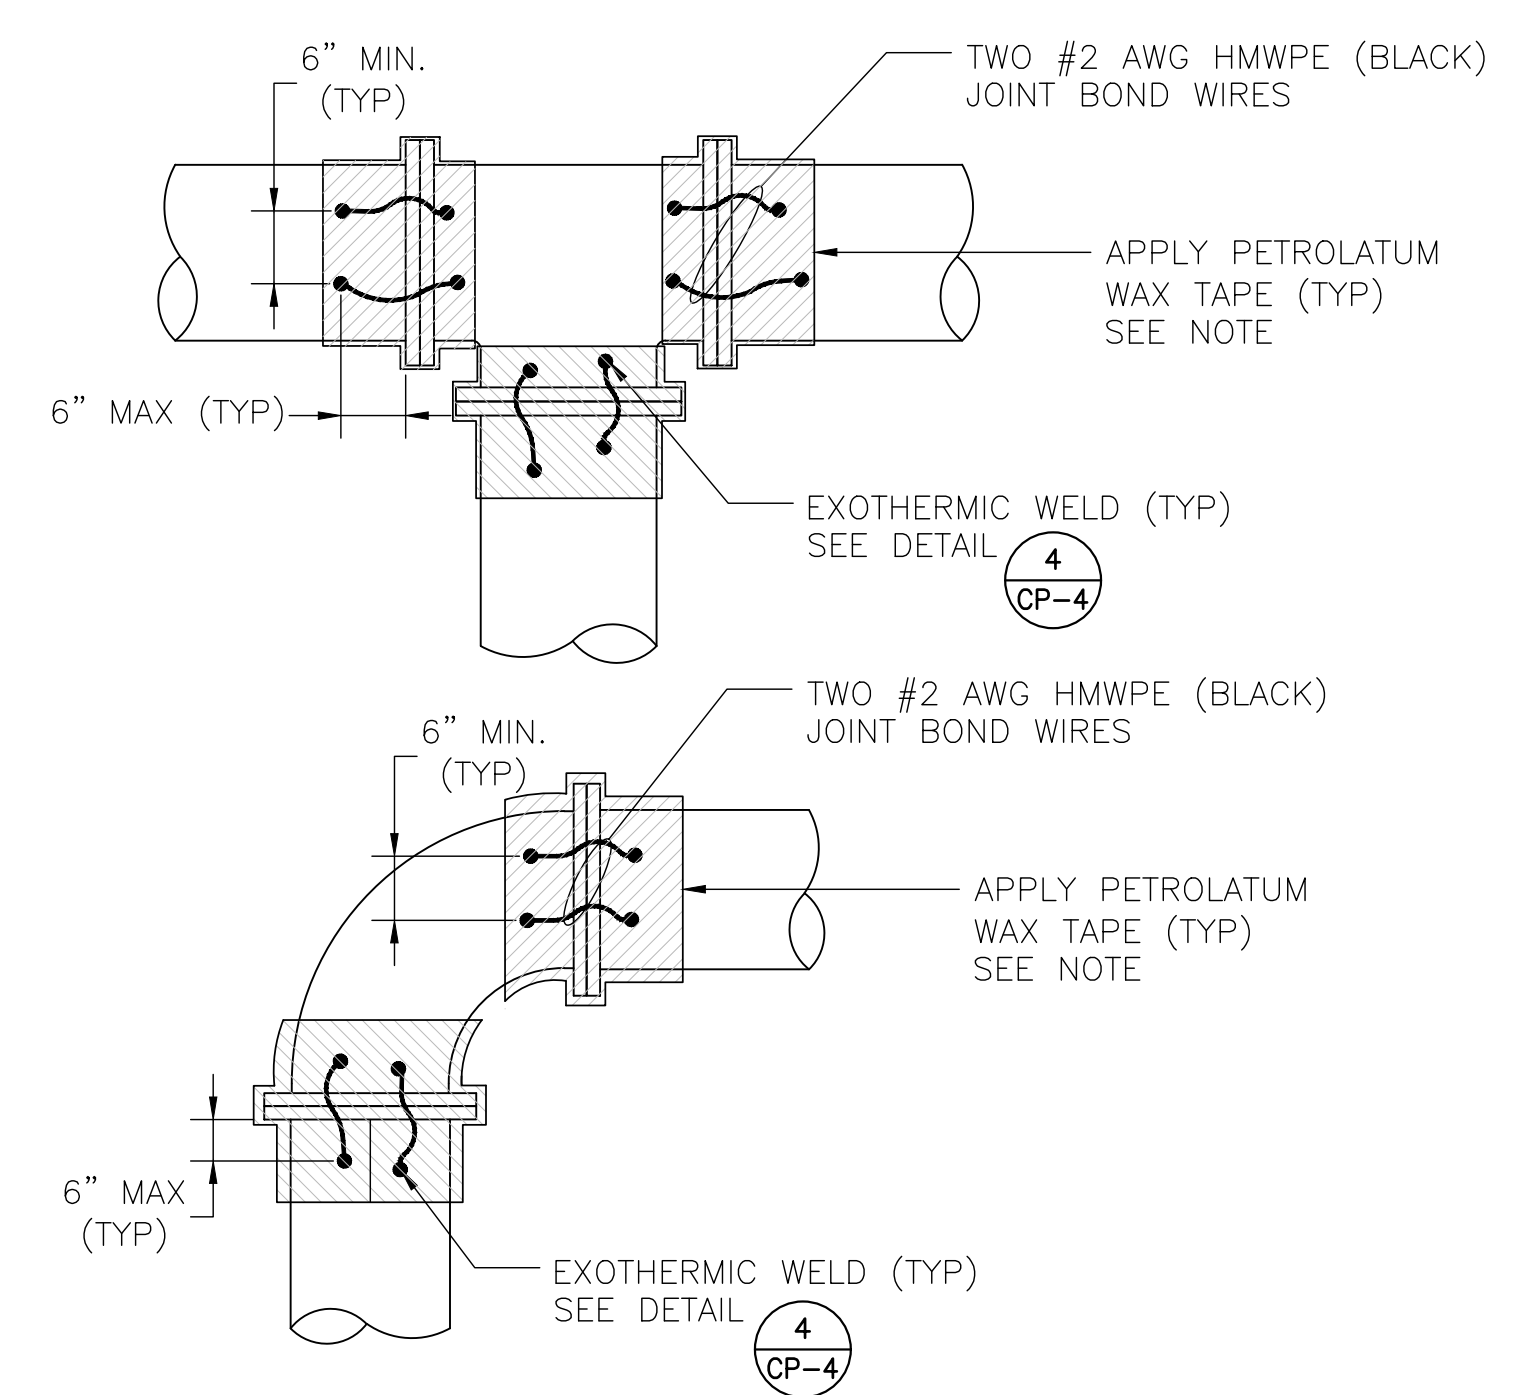

DATE	_____
SURVEY PLOTTED BY	_____
DRAWN BY	_____
TRACED BY	_____
CHECKED BY	_____
APPROVED BY	_____
NO.	_____

1000 Broadway, Suite 320  
Oakland, CA 94607  
Tel. (510) 903-6600, Fax (510) 903-6601  
Project No. 21-0197

GLENN H. WILLSON  
LICENSED PROFESSIONAL ENGINEER  
No. 11304-C  
HAWAII, USA

SIGNATURE: \_\_\_\_\_  
EXPIRATION DATE OF THE LICENSE: April 30, 2024

07/15/22 Replace Sheet

STATE OF HAWAII  
DEPARTMENT OF TRANSPORTATION  
HIGHWAYS DIVISION

CATHODIC PROTECTION  
DETAILS


FARRINGTON HIGHWAY WIDENING  
Kapolei Golf Course Road to Fort Weaver Road  
Project No. 7101A-01-20

Scale: As Shown Date: April 2022


SHEET No. CP-3 OF 767 SHEETS




FED. ROAD DIST. NO.	STATE	PROJ. NO.	FISCAL YEAR	SHEET NO.	TOTAL SHEETS
HAWAII	HAW.	7101A-01-20	2021		XXX

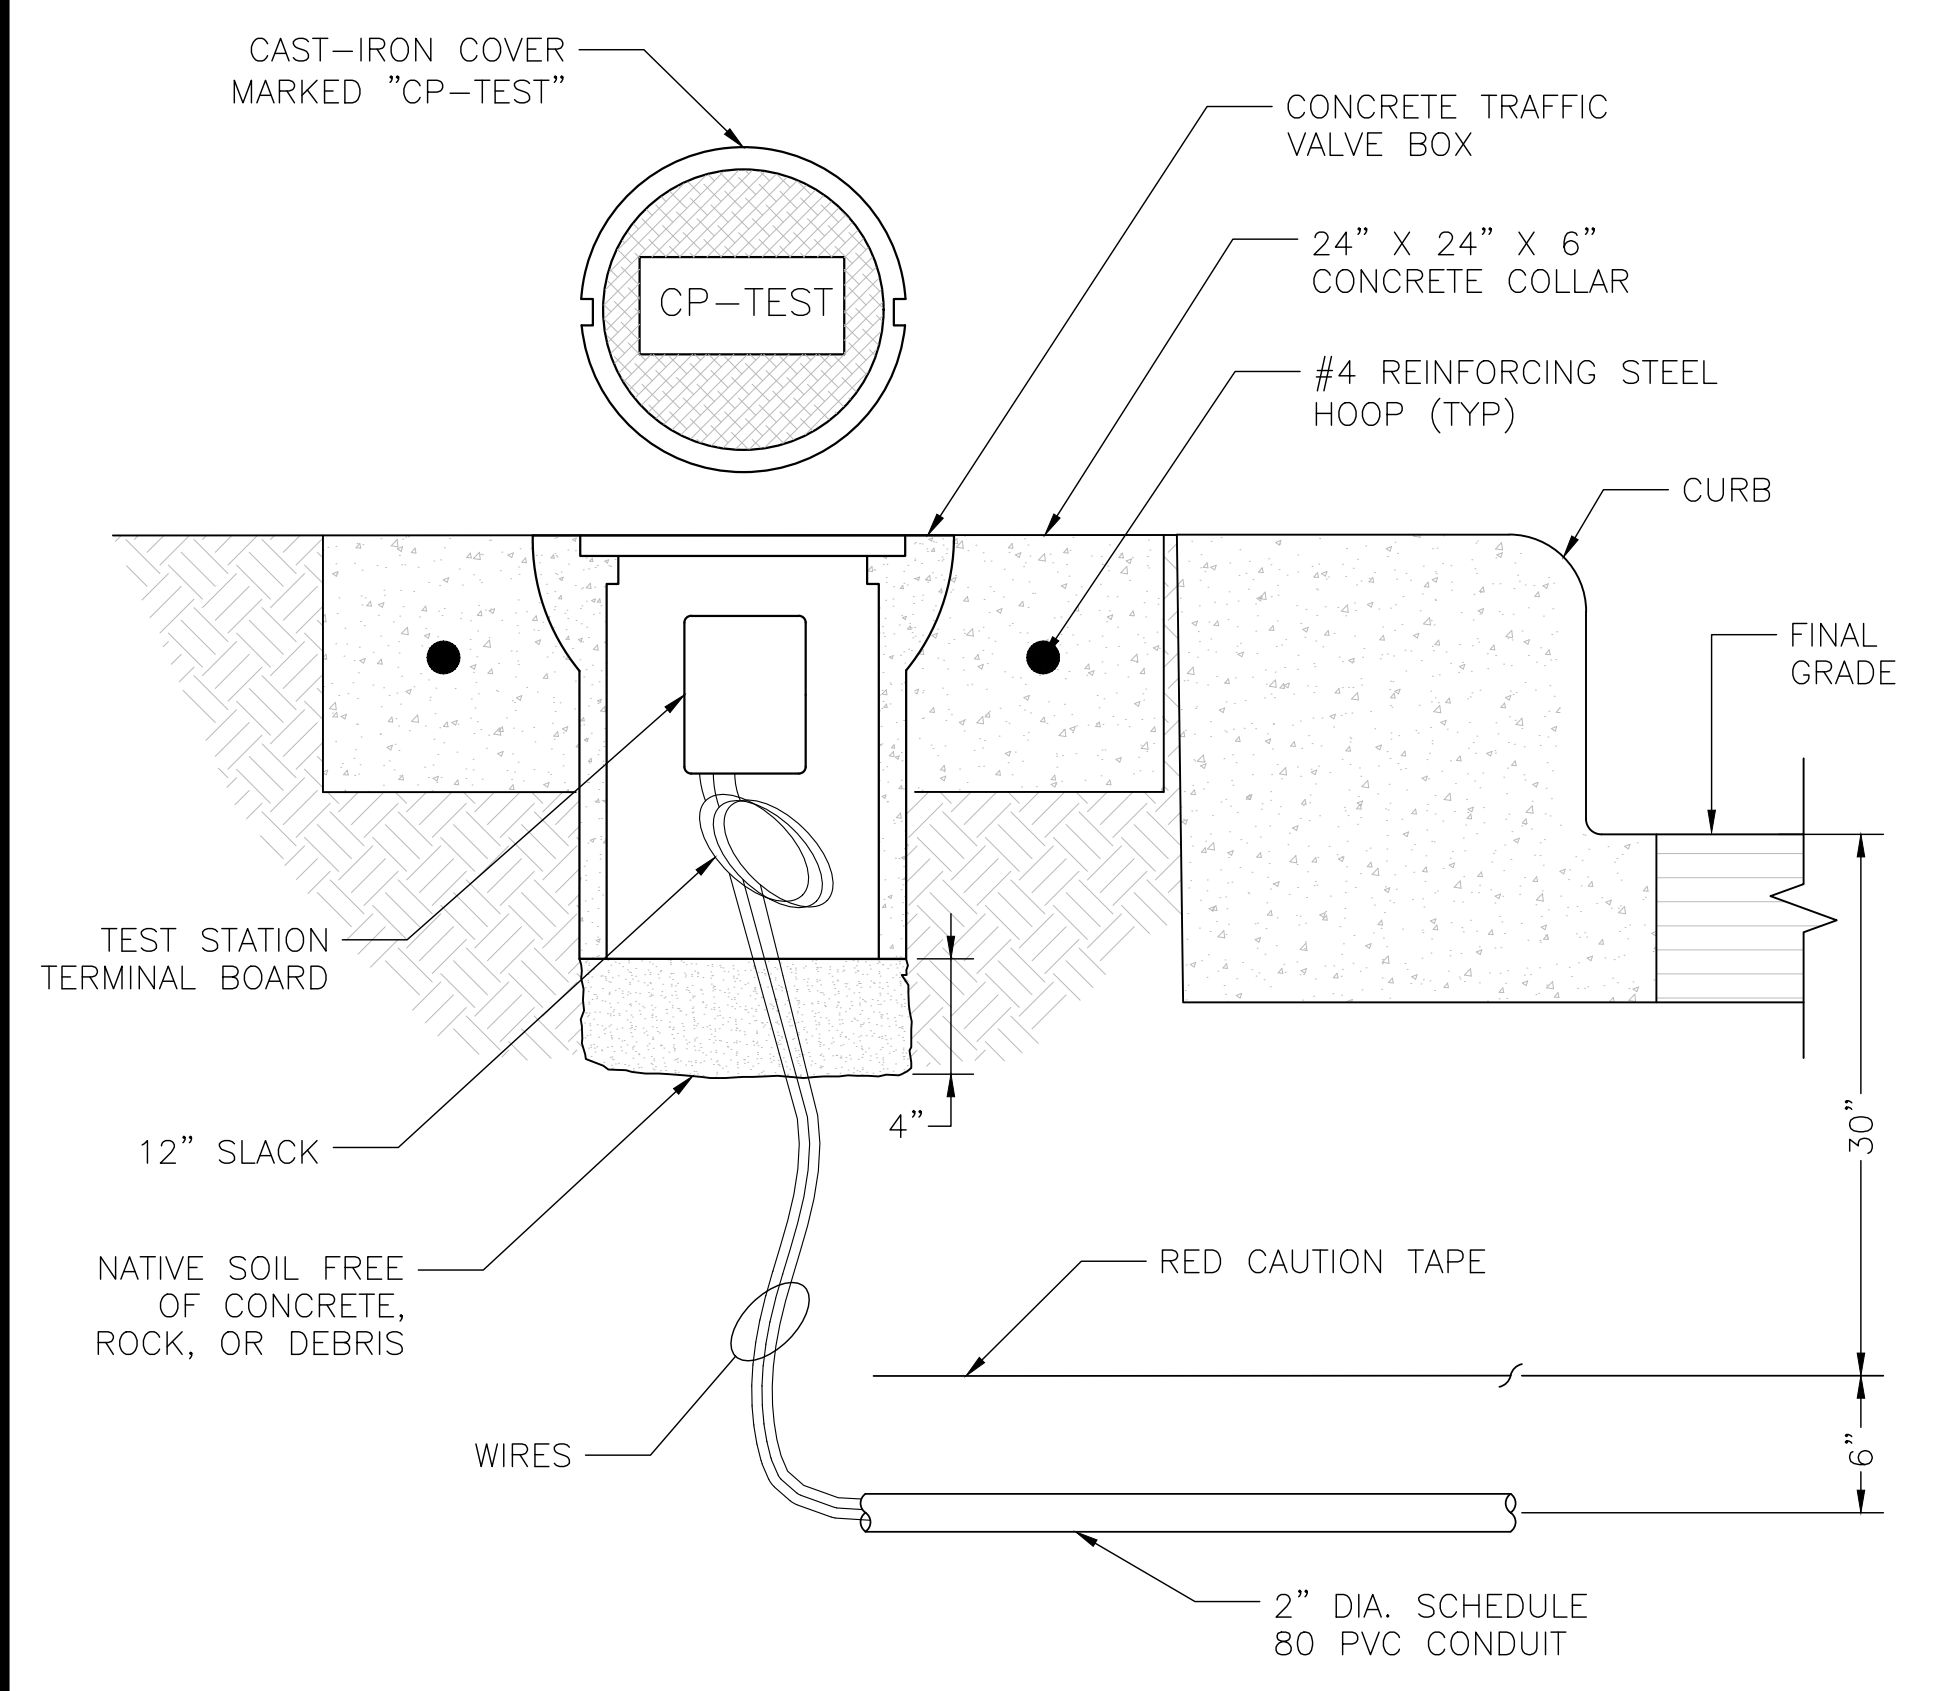


FLUSH-MOUNTED TEST STATION DETAIL  
SCALE: NTS

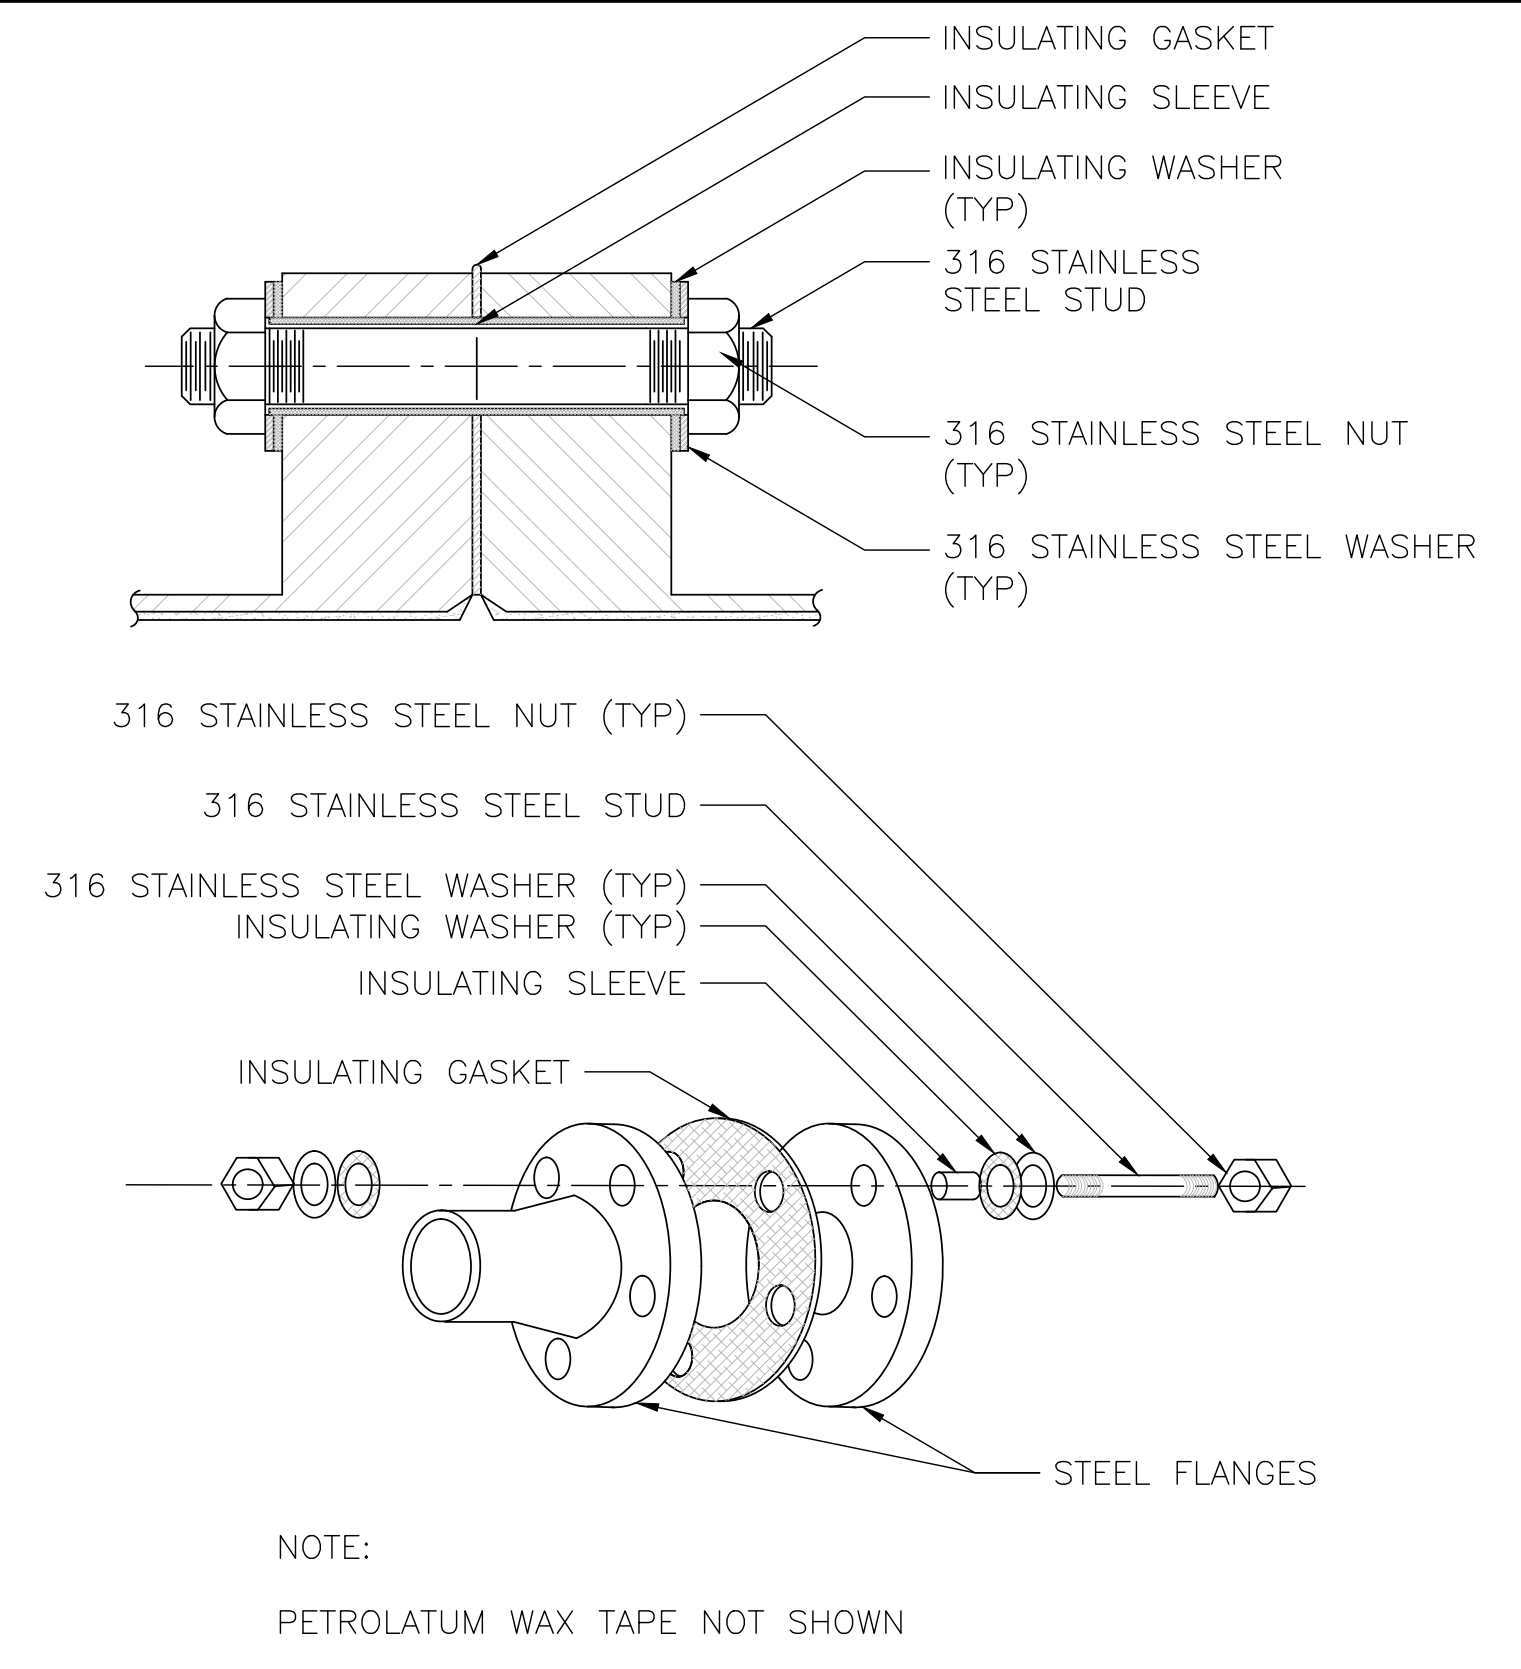

DIELECTRIC INSULATING FLANGE KIT  
DETAIL WITH SECTION VIEW  
SCALE: NTS

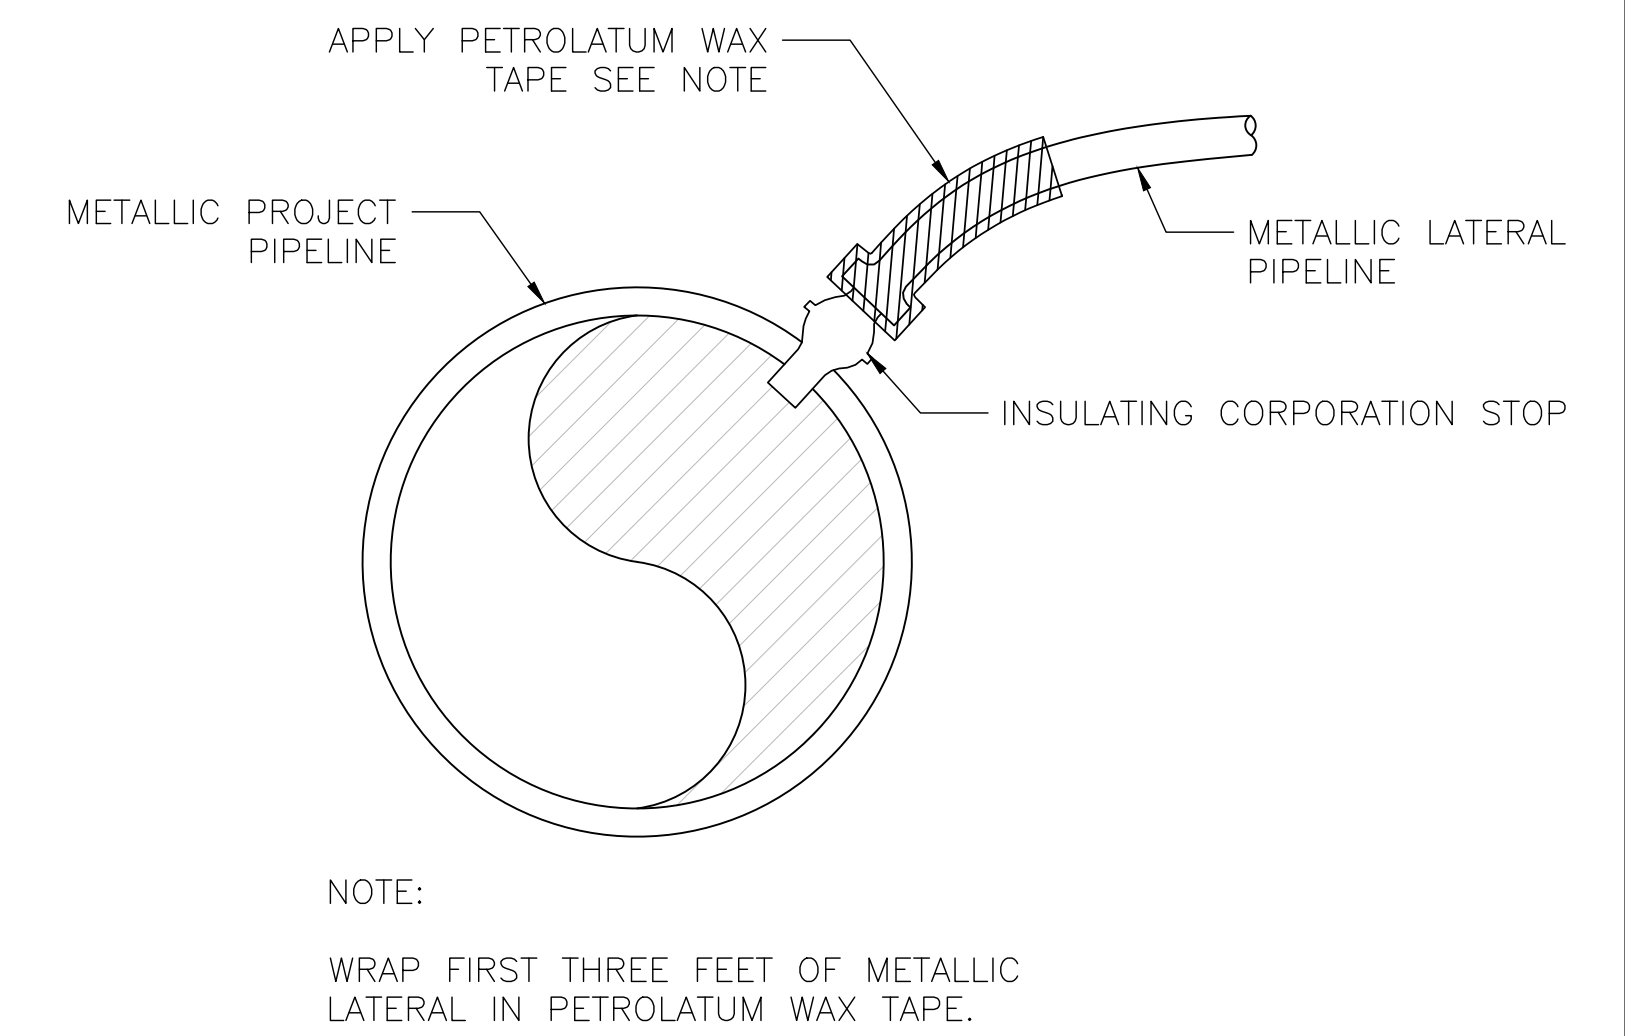


LATERAL CONNECTION DETAIL  
SCALE: NTS

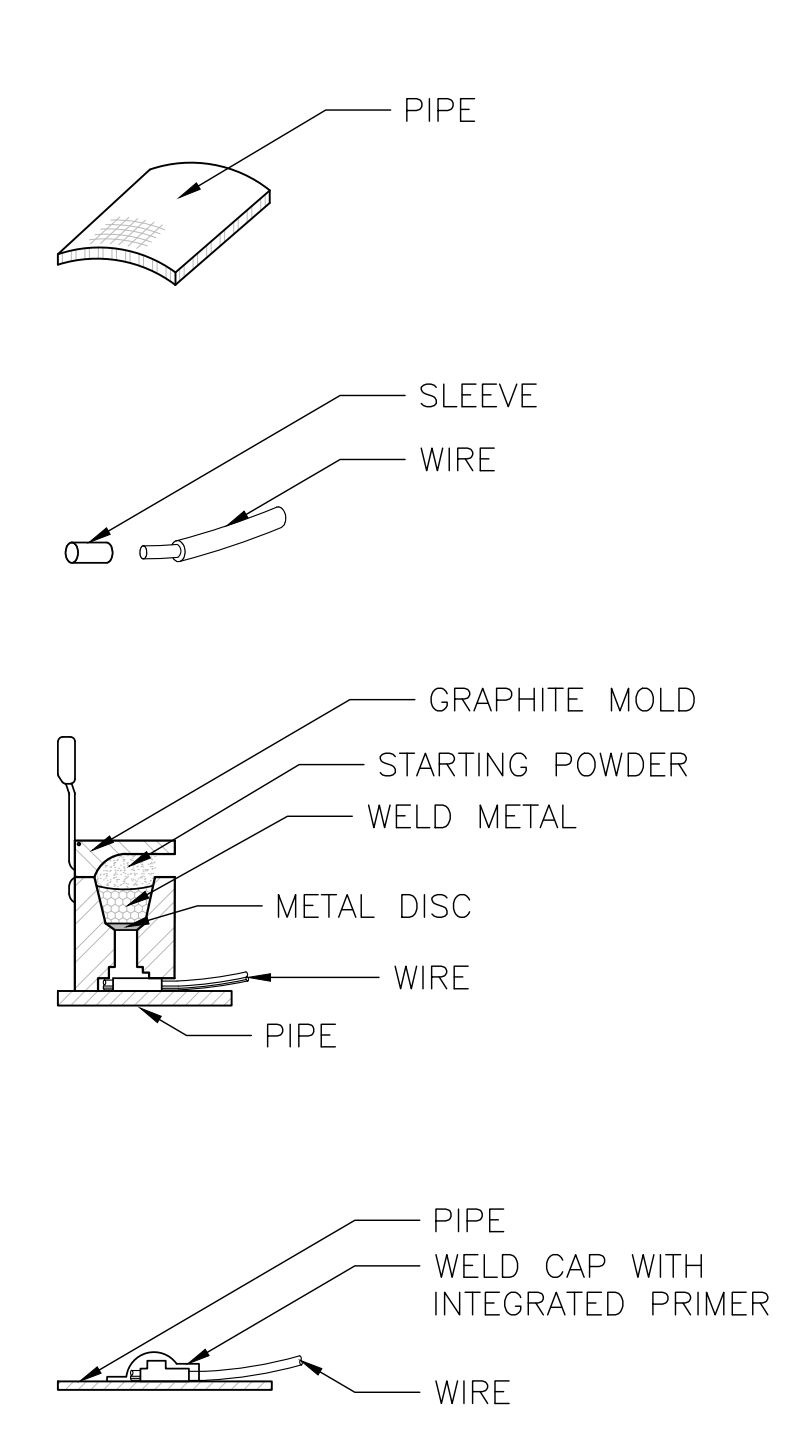


1. ALL WELDS SHALL BE 6" APART AT MINIMUM.
2. GRIND PIPE TO BARE METAL AND CLEAN SURFACE. GROUND AREA SHALL BE LARGE ENOUGH FOR EXOTHERMIC WELD AND SMALL ENOUGH TO BE COMPLETELY COVERED BY WELD CAP.
3. STRIP INSULATION FROM WIRE AND ATTACH SLEEVE.
4. HOLD MOLD FIRMLY WITH OPENING AWAY FROM OPERATOR. IGNITE WITH FLINT GUN. REMOVE SLAG FROM CONNECTION WITH CHIPPING HAMMER. TEST WELD WITH 22 OZ HAMMER.
5. COVER CONNECTION WITH WELD CAP WITH INTEGRATED PRIMER. REPAIR ALL DAMAGE TO COATING AND LINING IN ACCORDANCE WITH COATING AND LINING MANUFACTURER'S RECOMMENDATIONS.

EXOTHERMIC WELD DETAIL FOR  
DUCTILE IRON PIPE  
SCALE: NTS

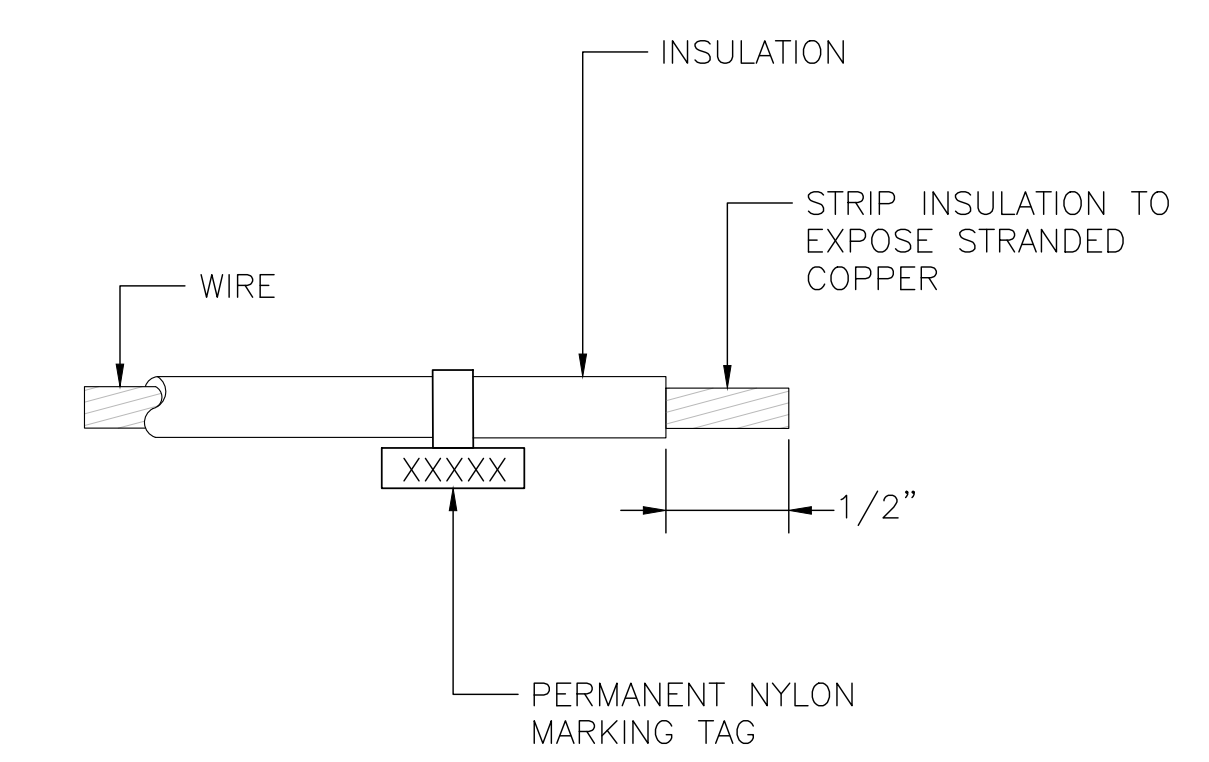

WIRE IDENTIFIER SCHEDULE	
STRUCTURE	LABEL
XX" DIP WATER	XX" DI
GALVANIC ANODE	ANODE
COUPON	COUP

WIRE IDENTIFIER DETAIL  
SCALE: NTS

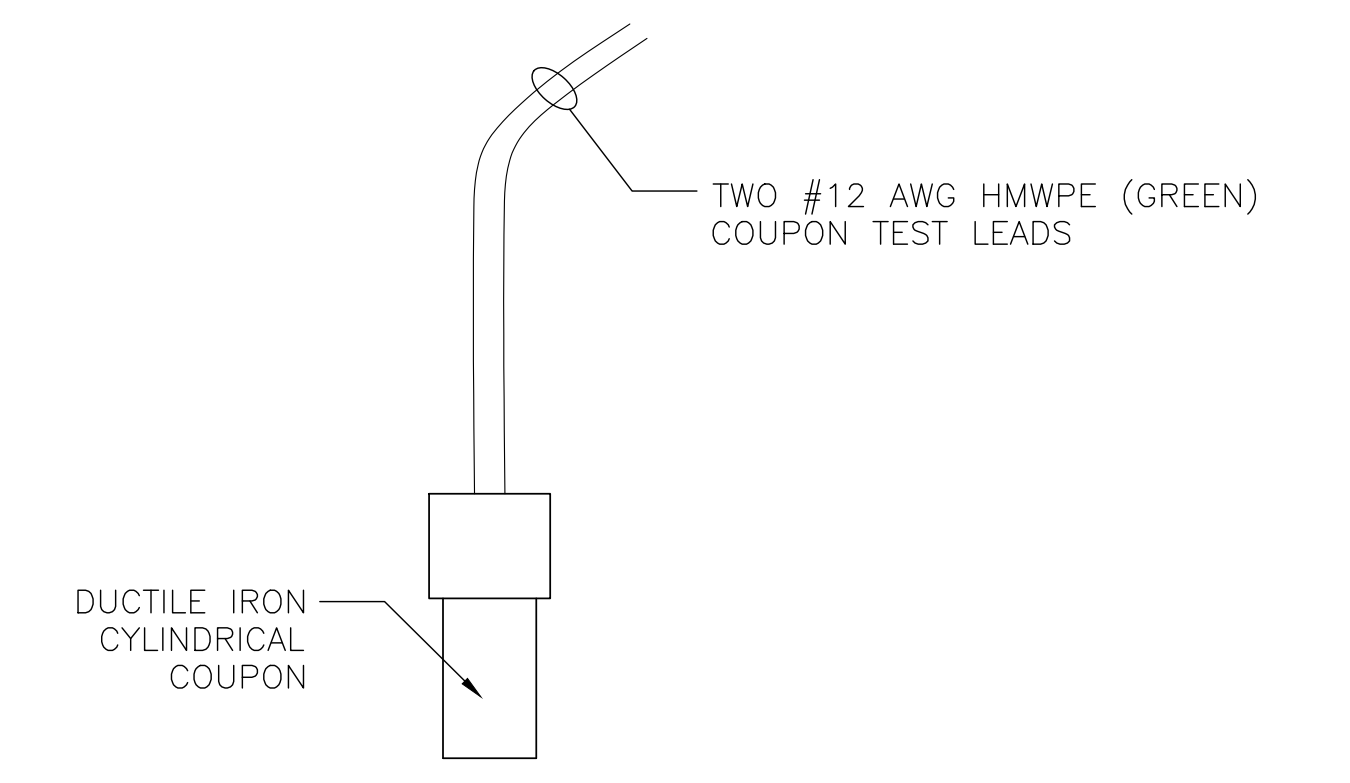

COUPON DETAIL  
SCALE: NTS

DATE	_____
SURVEY PLOTTED BY	_____
DRAWN BY	_____
TRACED BY	_____
NOTED BY	_____
APPROVED BY	_____
CHECKED BY	_____
No.	_____

**V&A**  
1000 Broadway, Suite 320  
Oakland, CA 94607  
Tel. (510) 903-6600, Fax (510) 903-6601  
Project No. 21-0197

GLENN H WILLSON  
LICENSED PROFESSIONAL ENGINEER  
No. 11304-C  
HAWAII, USA

THIS WORK WAS PREPARED BY ME OR UNDER MY SUPERVISION AND CONSTRUCTION OF THIS PROJECT WILL BE UNDER MY OBSERVATION.  
SIGNATURE: *[Signature]* EXPIRATION DATE OF THE LICENSE: April 30, 2024

07/15/22 Replace Sheet

STATE OF HAWAII  
DEPARTMENT OF TRANSPORTATION  
HIGHWAYS DIVISION

CATHODIC PROTECTION  
DETAILS

FARRINGTON HIGHWAY WIDENING  
Kapolei Golf Course Road to Fort Weaver Road  
Project No. 7101A-01-20

Scale: As Shown Date: April 2022

SHEET No. CP-4 OF 767 SHEETS

# INDEX TO STRUCTURAL DRAWINGS


FED. ROAD DIST. NO.	STATE	PROJ. NO.	FISCAL YEAR	SHEET NO.	TOTAL SHEETS
HAWAII	HAW.	7101A-01-20	2021	ADD. 343	

SHEET NO.	DESCRIPTION	SHEET NO.	DESCRIPTION
			<u>DRILLED SHAFT FOUNDATION</u>
SC3.1	PALEHUA STREAM BOX CULVERT LAYOUT PLAN	SD1.1	TRAFFIC SIGNAL FOUNDATION NOTES AND SECTIONS
SC3.2	PALEHUA STREAM BOX CULVERT LONGITUDINAL SECTION	SD1.2	TRAFFIC SIGNAL FOUNDATION SCHEDULE
SC3.3	PALEHUA STREAM BOX CULVERT TYPICAL BOX CULVERT SECTION		
SC3.4	PALEHUA STREAM BOX CULVERT BOX CULVERT SECTION AT SKEW		
SC3.5	PALEHUA STREAM BOX CULVERT INLET BOTTOM SLAB PLAN AND DETAILS		<u>RETAINING WALL</u>
SC3.6	PALEHUA STREAM BOX CULVERT INLET TOP SLAB PLAN AND DETAILS	SD2.1	RETAINING WALL PAY LIMIT
SC3.7	PALEHUA STREAM BOX CULVERT OUTLET BOTTOM SLAB PLAN AND DETAILS	SD2.2	TYPICAL RETAINING WALL JOINT DETAILS
SC3.8	PALEHUA STREAM BOX CULVERT OUTLET TOP SLAB PLAN AND DETAILS	SD2.3	TYPICAL RETAINING WALL DETAILS
SC3.9	PALEHUA STREAM BOX CULVERT HEADWALL PLANS	SD2.4	TYPICAL RETAINING WALL SECTION AND SCHEDULE AT KAHI MOHALA
SC3.10	PALEHUA STREAM BOX CULVERT HEADWALL DETAILS	SD2.5	KAHI MOHALA WALL PROFILE STA 0+00 TO STA 1+83
SC3.11	PALEHUA STREAM BOX CULVERT INLET PLAN AND DETAILS	SD2.6	KAHI MOHALA WALL PROFILE STA 1+83 TO STA 3+75
SC3.12	PALEHUA STREAM BOX CULVERT OUTLET PLAN AND DETAILS		
SC3.13	PALEHUA STREAM BOX CULVERT TYPICAL INLET/OUTLET SECTION		
SC3.14	PALEHUA STREAM BOX CULVERT INLET/OUTLET WALL ELEVATION		<u>CONCRETE JACKETS</u>
SC3.15	PALEHUA STREAM BOX CULVERT INLET/OUTLET LONGITUDINAL SECTION	SD3.1	VERTICAL BEND PIPE JACKETS
SC3.16	PALEHUA STREAM BOX CULVERT DEMOLITION PLAN	SD3.2	HORIZONTAL BEND PIPE JACKETS
SC3.17	PALEHUA STREAM BOX CULVERT DEMOLITION SECTIONS	SD3.3	TEMPORARY LINE STOP CONCRETE SUPPORT BLOCK PLAN AND SECTIONS
SC3.18	PALEHUA STREAM BOX CULVERT CONSTRUCTION SEQUENCE	SD3.4	CONCRETE SUPPORT BLOCK TOPPING PLAN AND SECTIONS
SC3.19	PALEHUA STREAM BOX CULVERT CONSTRUCTION SEQUENCE	SD3.5	CONCRETE SUPPORT BLOCK PLANS AT PVC PIPE <span style="border: 1px dashed black; border-radius: 50%; padding: 2px;">5</span>
SC3.20	PALEHUA STREAM BOX CULVERT CONSTRUCTION SEQUENCE	SD3.6	CONCRETE SUPPORT BLOCK SECTIONS AT PVC PIPE
SC3.21	PALEHUA STREAM BOX CULVERT CONSTRUCTION SEQUENCE		
			<u>MANHOLE ADJUSTMENTS</u>
SC4.1	42-INCH CULVERT INLET PLAN		
SC4.2	42-INCH CULVERT OUTLET PLAN	SD4.1	TYPE "A" MANHOLE ADJUSTMENT SECTION AND DETAIL
SC4.3	42-INCH CULVERT SPECIAL DMH - DETAILS	SD4.2	TYPE "B" MANHOLE ADJUSTMENT SECTION
SC4.4	42-INCH CULVERT SPECIAL DMH - DETAILS		
SC4.5	42-INCH CULVERT SPECIAL DMH - PLAN AND SECTIONS		
SC4.6	42-INCH CULVERT OUTLET SECTION		<u>GRATED DROP INLET</u>
SC4.7	42-INCH CULVERT OUTLET SECTIONS	SD5.1	TYPICAL GRATED DROP INLET DETAILS
SC4.8	42-INCH CULVERT DEMOLITION PLAN	SD5.2	MODIFIED GRATED DROP INLET
		SD5.3	SPECIAL GRATED DROP INLET B2 AND D2

ORIGINAL PLAN	SURVEY PLOTTED BY	DATE
NOTE BOOK	DRAWN BY	
No.	DESIGNED BY	
	QUANTITIES BY	
	CHECKED BY	

DRAWING NAME: Z:\A\00 ONGOING\20-013-FARR-HWY-KAPOLEI GC ID: ET-WP8-EMTC\01-GAD\07-15-22-4001-DEL\AS\THW3-S0001-INDEX.DWG PLOT TIME: 07-15-22 8:39 PM

07/15/22	<span style="border: 1px dashed black; border-radius: 50%; padding: 2px;">5</span> Revised Index
DATE	REVISION

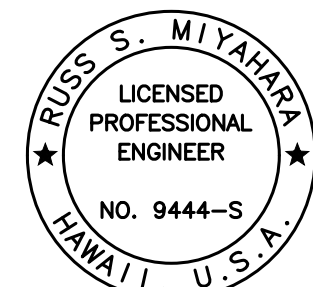

THIS WORK WAS PREPARED BY ME OR UNDER MY SUPERVISION AND CONSTRUCTION OF THIS PROJECT WILL BE UNDER MY OBSERVATION.

*Russ S. Miyahara* April 30, 2024  
SIGNATURE EXPIRATION DATE OF THE LICENSE


**STATE OF HAWAII**  
**DEPARTMENT OF TRANSPORTATION**  
**HIGHWAYS DIVISION**

*Index to Structural Drawings*

FARRINGTON HIGHWAY WIDENING  
Kapolei Golf Course Road to Fort Weaver Road  
Project No. 7101A-01-20

Scale: None Date: Apr. 2022

**SHEET No. S0.4 OF 10 SHEETS**

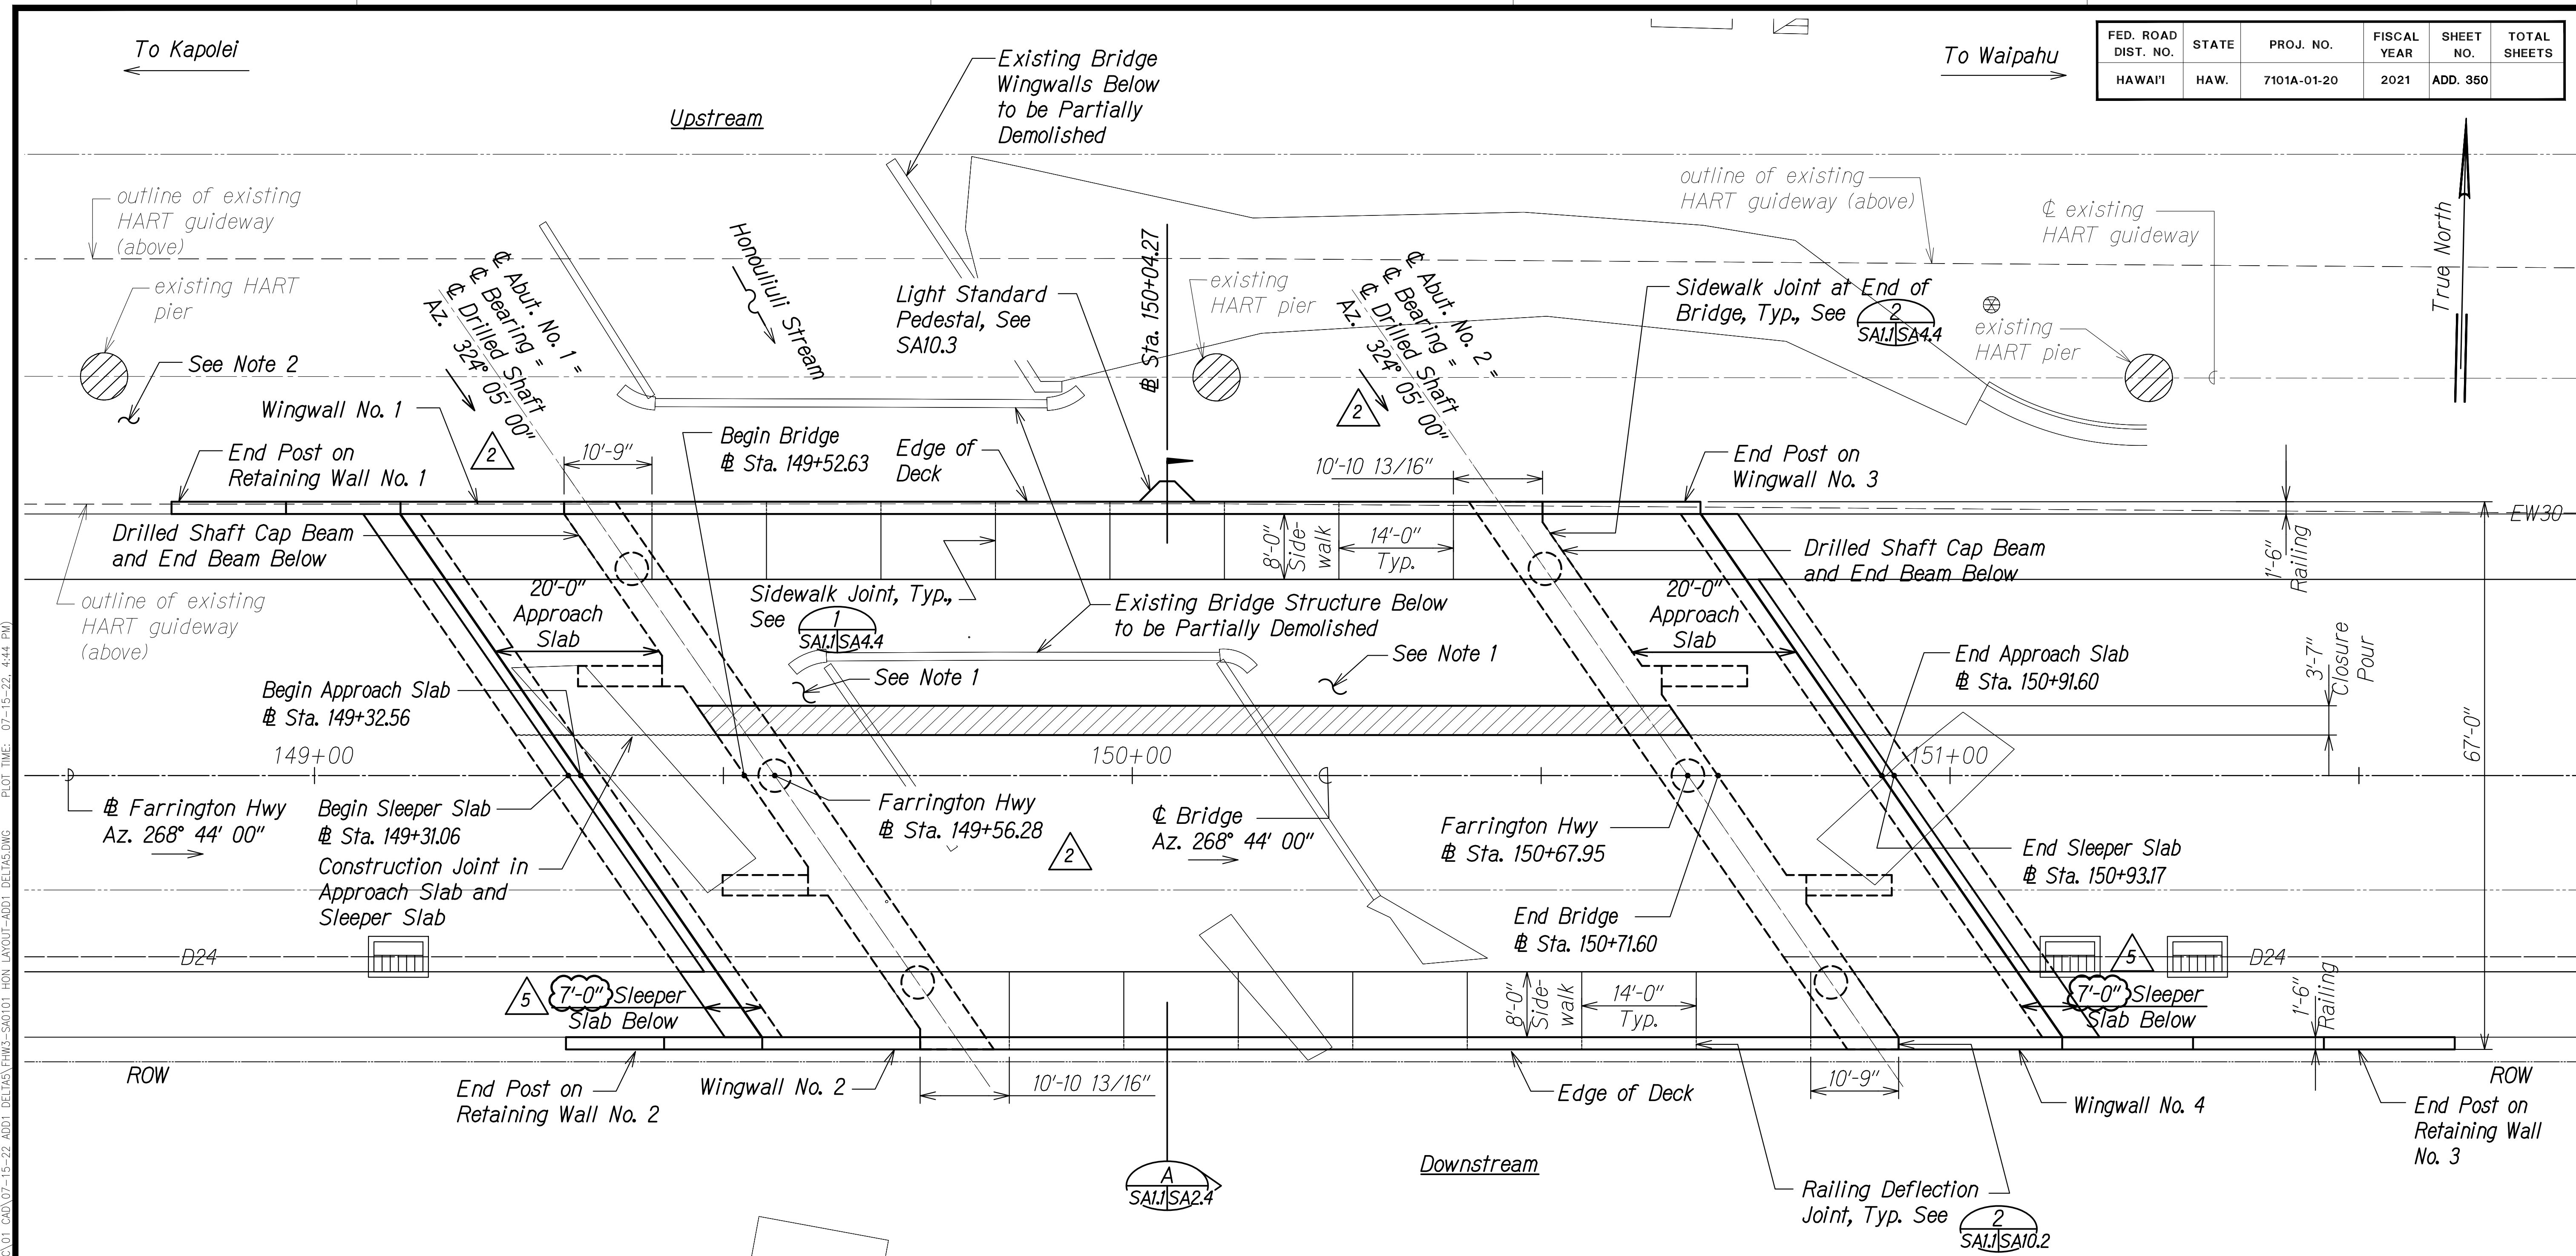


FED. ROAD DIST. NO.	STATE	PROJ. NO.	FISCAL YEAR	SHEET NO.	TOTAL SHEETS
HAWAII	HAW.	7101A-01-20	2021	ADD. 350	

**Notes:**

- Contractor is responsible for determining the limits and providing all necessary earthwork shoring to facilitate the staged construction requirements of the bridge. Shoring design shall take in to account grade differences between the staged backfilling operations as well as the location of and load imposed by the nearby existing metal guardrails.
- Earthwork shoring near existing HART piers may be required during structure excavation work
- The Contractor shall submit drawings and calculations for the shoring design. The drawings and calculations shall be stamped by a licensed Structural Engineer and a licensed Civil Engineer specializing in Geotechnical Engineering in the State of Hawaii. The drawings and calculations shall be reviewed by the Engineer before any construction work is to proceed.
- Dimensions for approach slab and sleeper slab are measured parallel with  $\phi$  bridge.

**LAYOUT PLAN** A  
Scale: 1" = 10'-0"

SURVEY PLOTTED BY	DATE
DRAWN BY	
DESIGNED BY	
QUANTITIES BY	
CHECKED BY	
ORIGINAL PLAN	No.

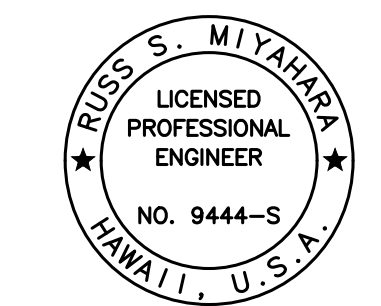

THIS WORK WAS PREPARED BY ME OR UNDER MY SUPERVISION AND CONSTRUCTION OF THIS PROJECT WILL BE UNDER MY OBSERVATION.  
 Signature: *RUCS S. Miyahara*  
 April 30, 2024  
 EXPIRATION DATE OF THE LICENSE

DATE	REVISION
07/15/22	5 Revised Sleeper Slab Width
06/08/22	2 Revised Station and Azimuth

STATE OF HAWAII  
 DEPARTMENT OF TRANSPORTATION  
 HIGHWAYS DIVISION

**Honouliuli Stream Bridge  
 Layout Plan**



FARRINGTON HIGHWAY WIDENING  
 Kapolei Golf Course Road to Fort Weaver Road  
 Project No. 7101A-01-20

Scale: As Shown Date: Apr. 2022





FED. ROAD DIST. NO.	STATE	PROJ. NO.	FISCAL YEAR	SHEET NO.	TOTAL SHEETS
HAWAII	HAW.	7101A-01-20	2021	ADD. 357	

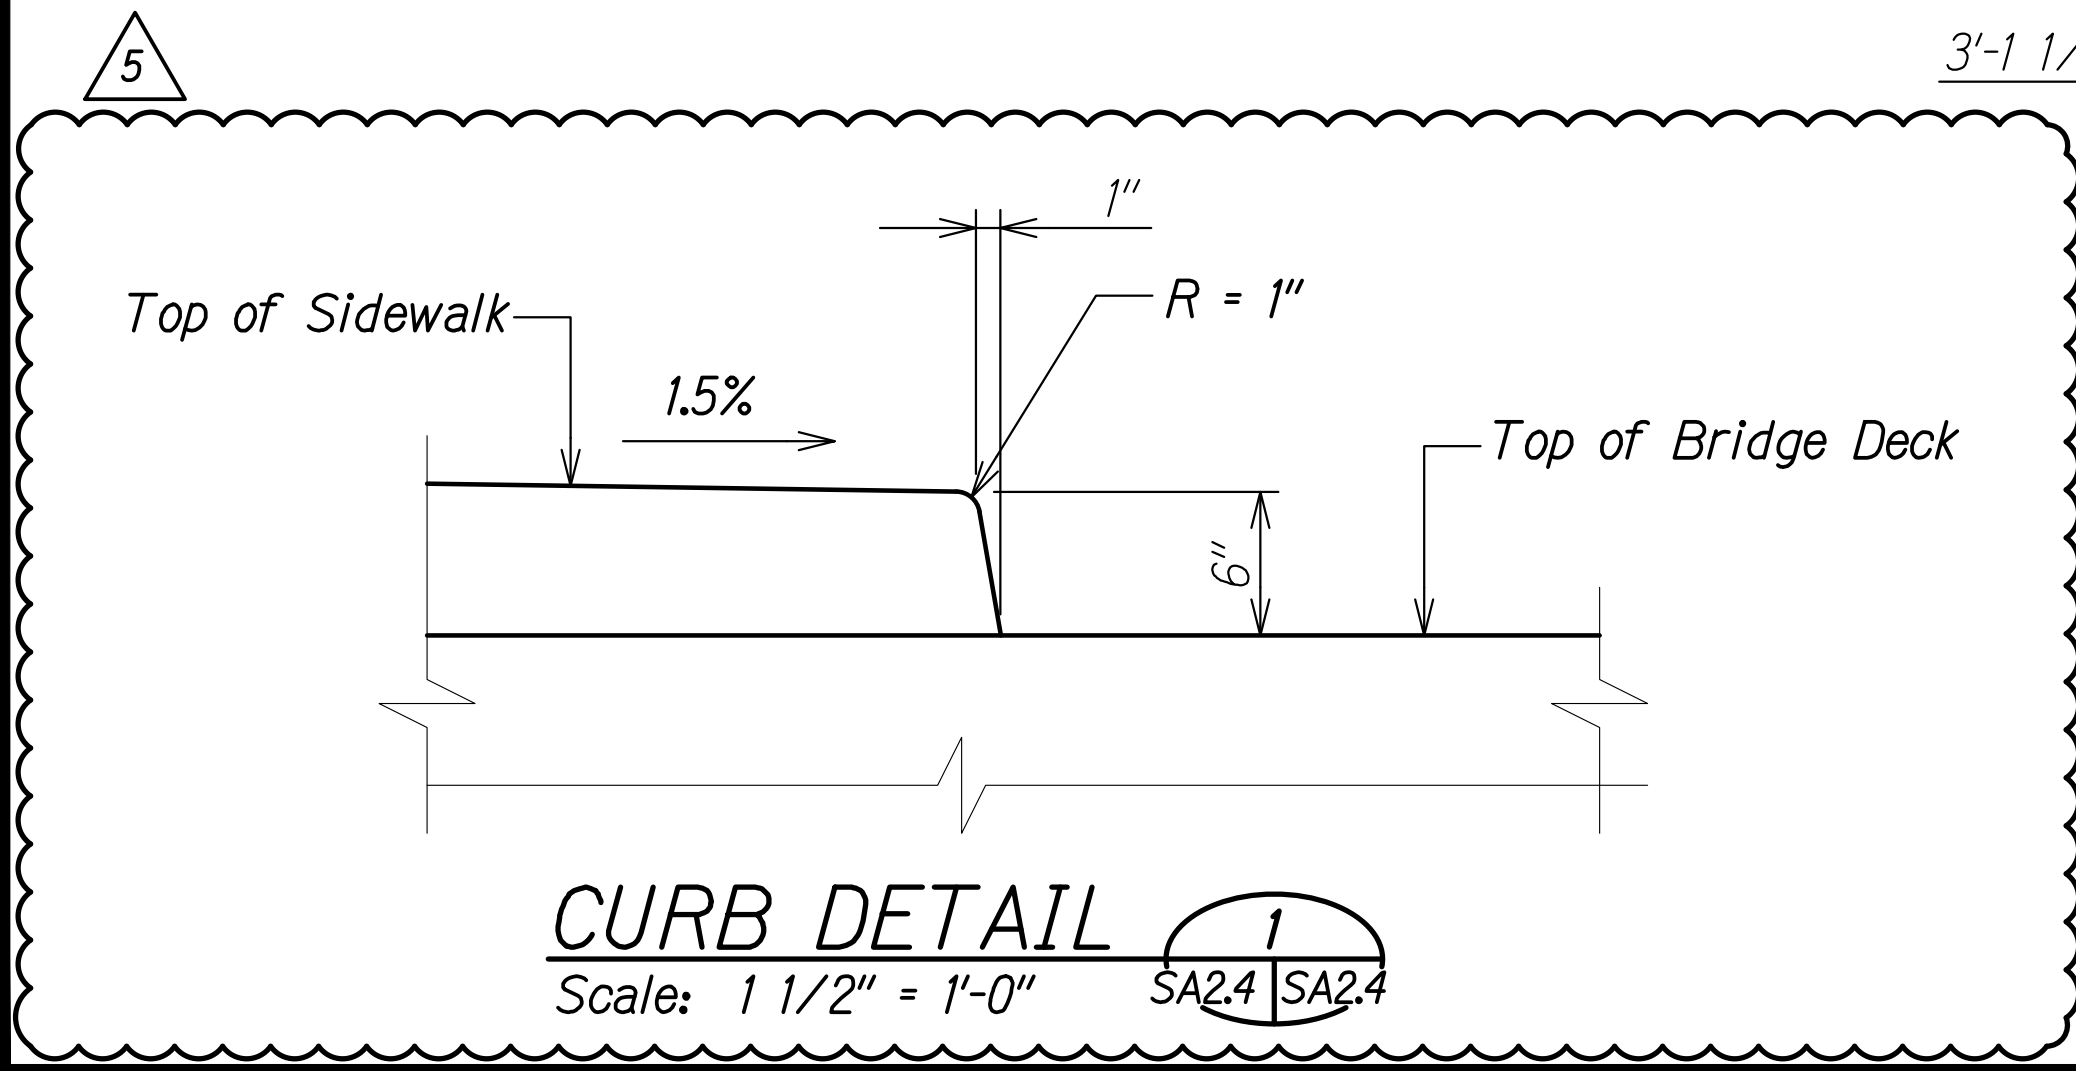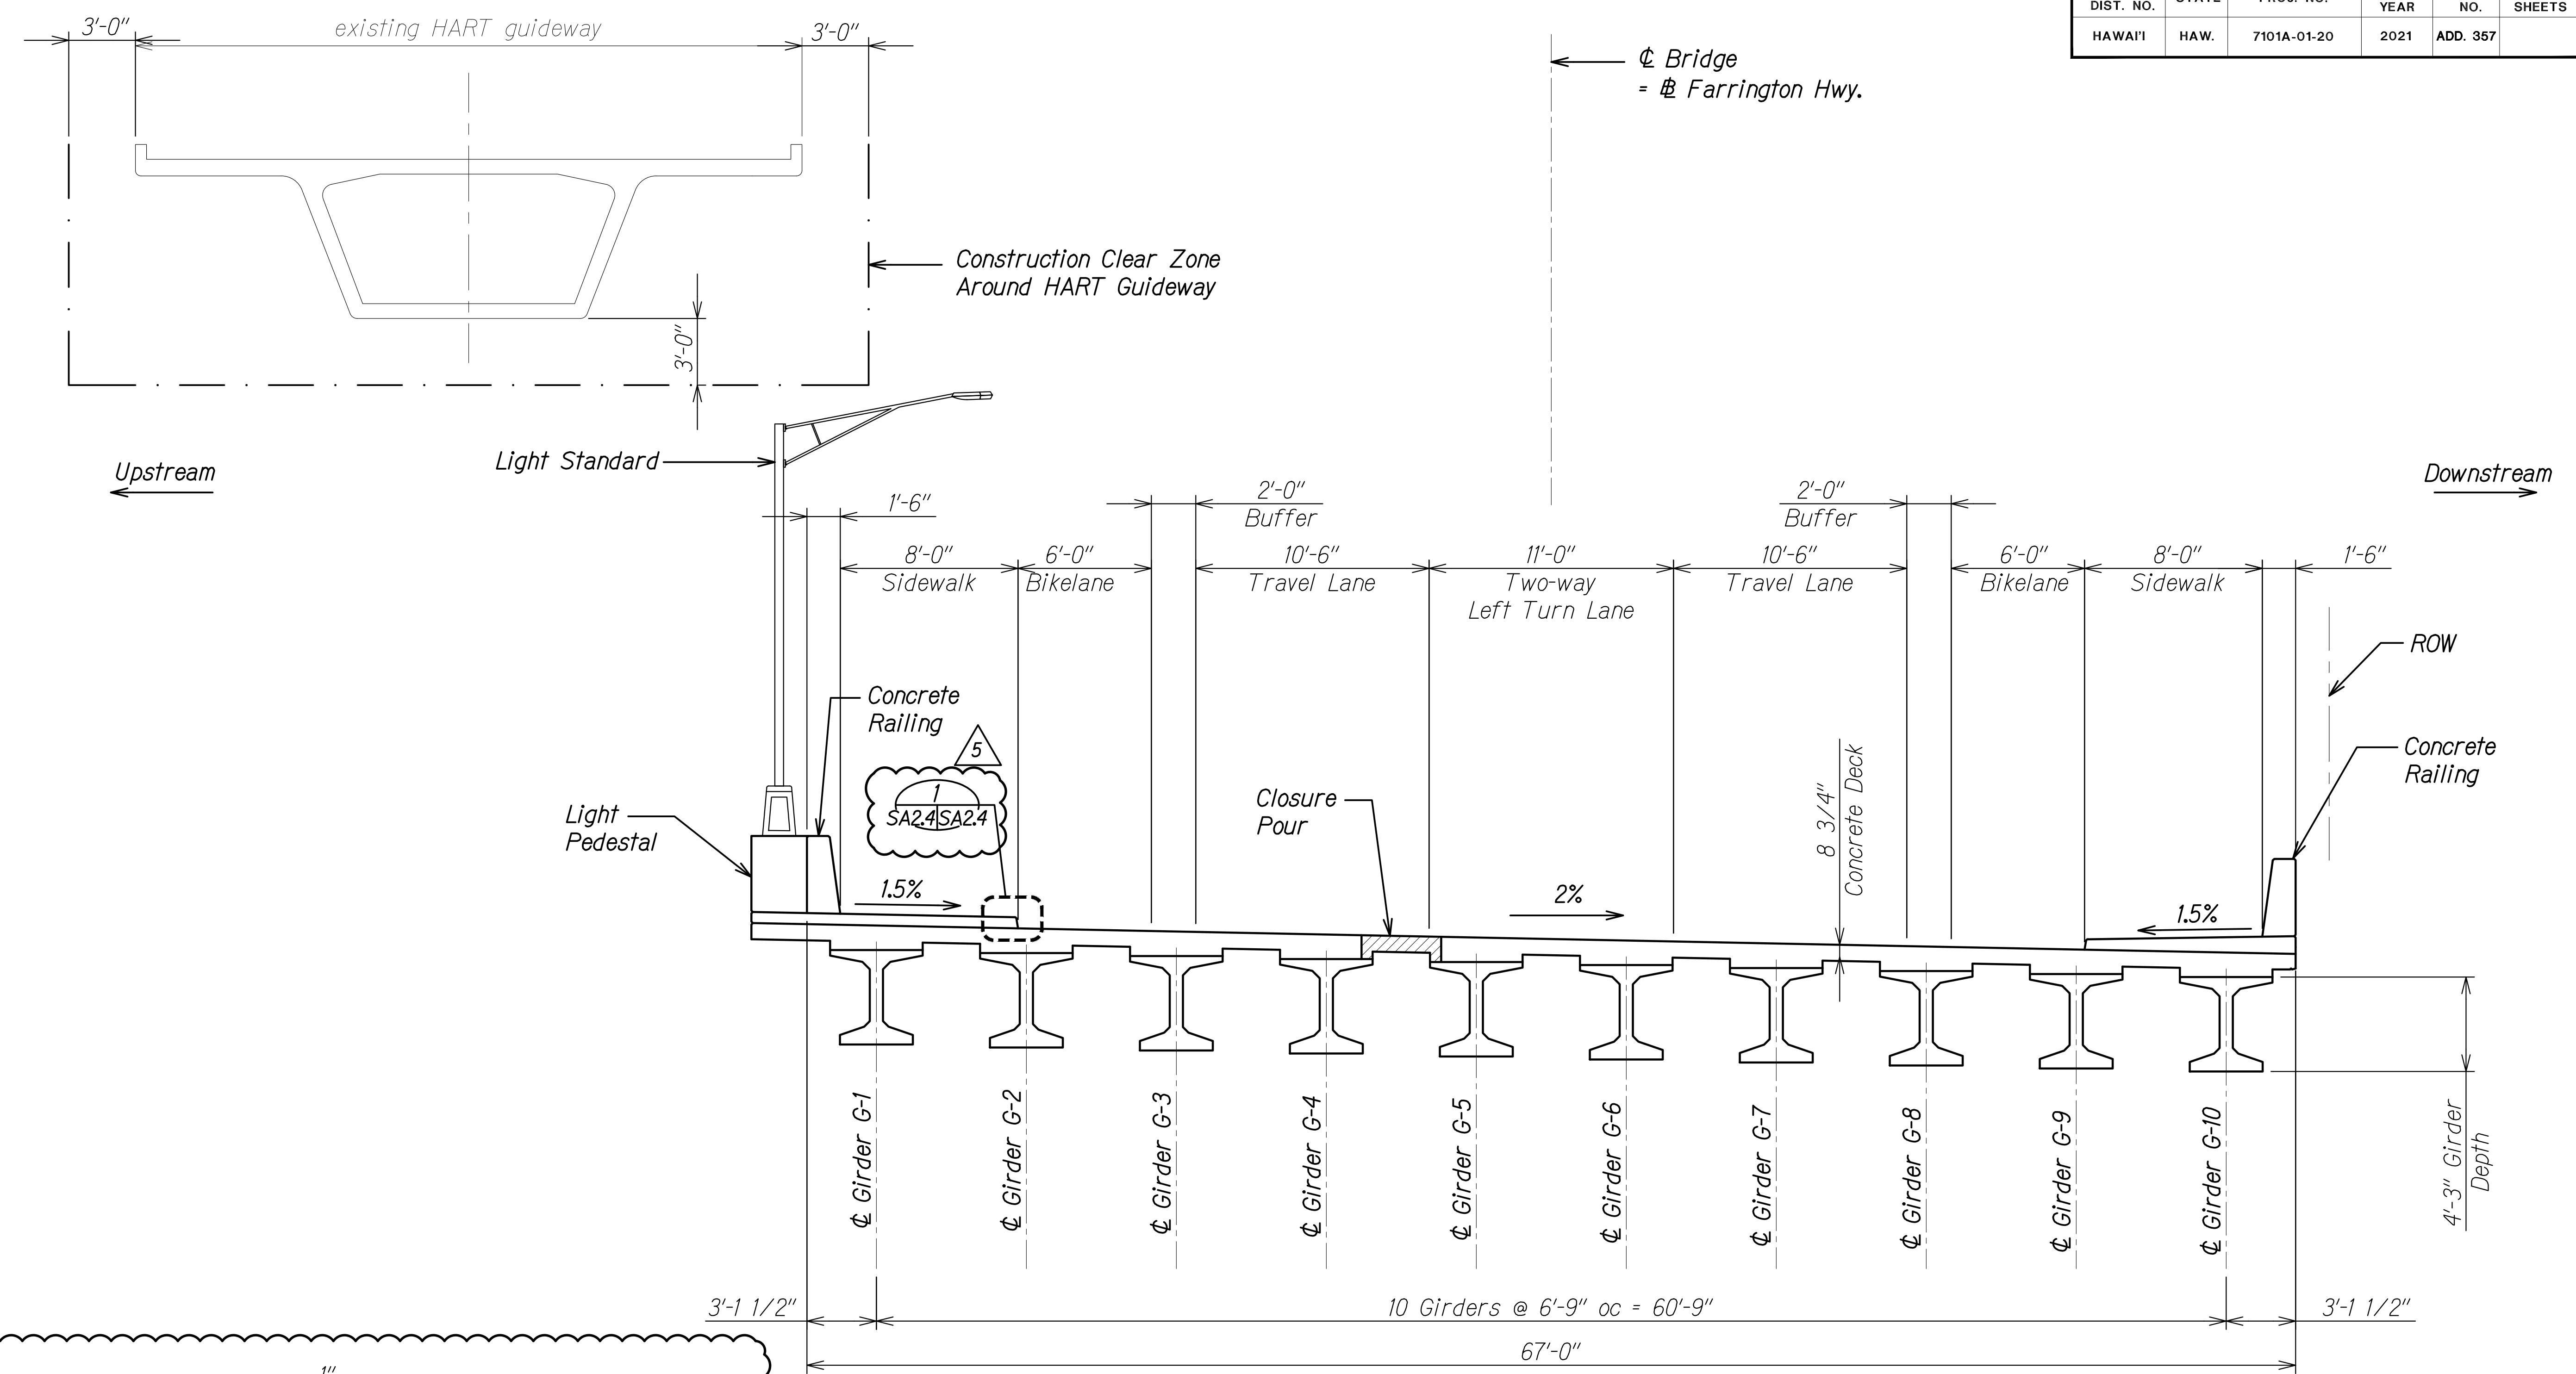

**TYPICAL TRANSVERSE SECTION**  
 Scale: 1/4" = 1'-0"  
 SA1.1 SA2.4

SURVEY PLOTTED BY	DATE
DRAWN BY	
DESIGNED BY	
QUANTITIES BY	
CHECKED BY	
ORIGINAL PLAN	
NOTE BOOK	
No.	

DATE	REVISION
07/15/22	5 Added Curb Detail
06/08/22	2 Revised Sheet Reference

**RUCS S. MIYAKAWA**  
 LICENSED PROFESSIONAL ENGINEER  
 NO. 9444-S  
 HAWAII, U.S.A.  
 THIS WORK WAS PREPARED BY ME OR UNDER MY SUPERVISION AND CONSTRUCTION OF THIS PROJECT WILL BE UNDER MY OBSERVATION.  
 Signature: *RUCS S. Miyakawa*  
 April 30, 2024  
 EXPIRATION DATE OF THE LICENSE

STATE OF HAWAII  
 DEPARTMENT OF TRANSPORTATION  
 HIGHWAYS DIVISION  
**Honouliuli Stream Bridge**  
 Typical Transverse Section  
 FARRINGTON HIGHWAY WIDENING  
 Kapolei Golf Course Road to Fort Weaver Road  
 Project No. 7101A-01-20  
 Scale: As Shown Date: Apr. 2022  
**SHEET No. SA24 OF 6 SHEETS**


DRAWING NAME: ZA100 UNDOINGS-20-013-FARR-HWY-KAPOLEI GC ID: ET-WRP-EMTC(V1-GAD) 07-15-22 ADD1 DELIAS(EHW3-S40204-HON) TRANS SECT-ADD1 DELIAS(DWG) PLOT TIME: 07-15-22, 7:05 PM







FED. ROAD DIST. NO.	STATE	PROJ. NO.	FISCAL YEAR	SHEET NO.	TOTAL SHEETS
HAWAII	HAW.	7101A-01-20	2021	ADD. 372	

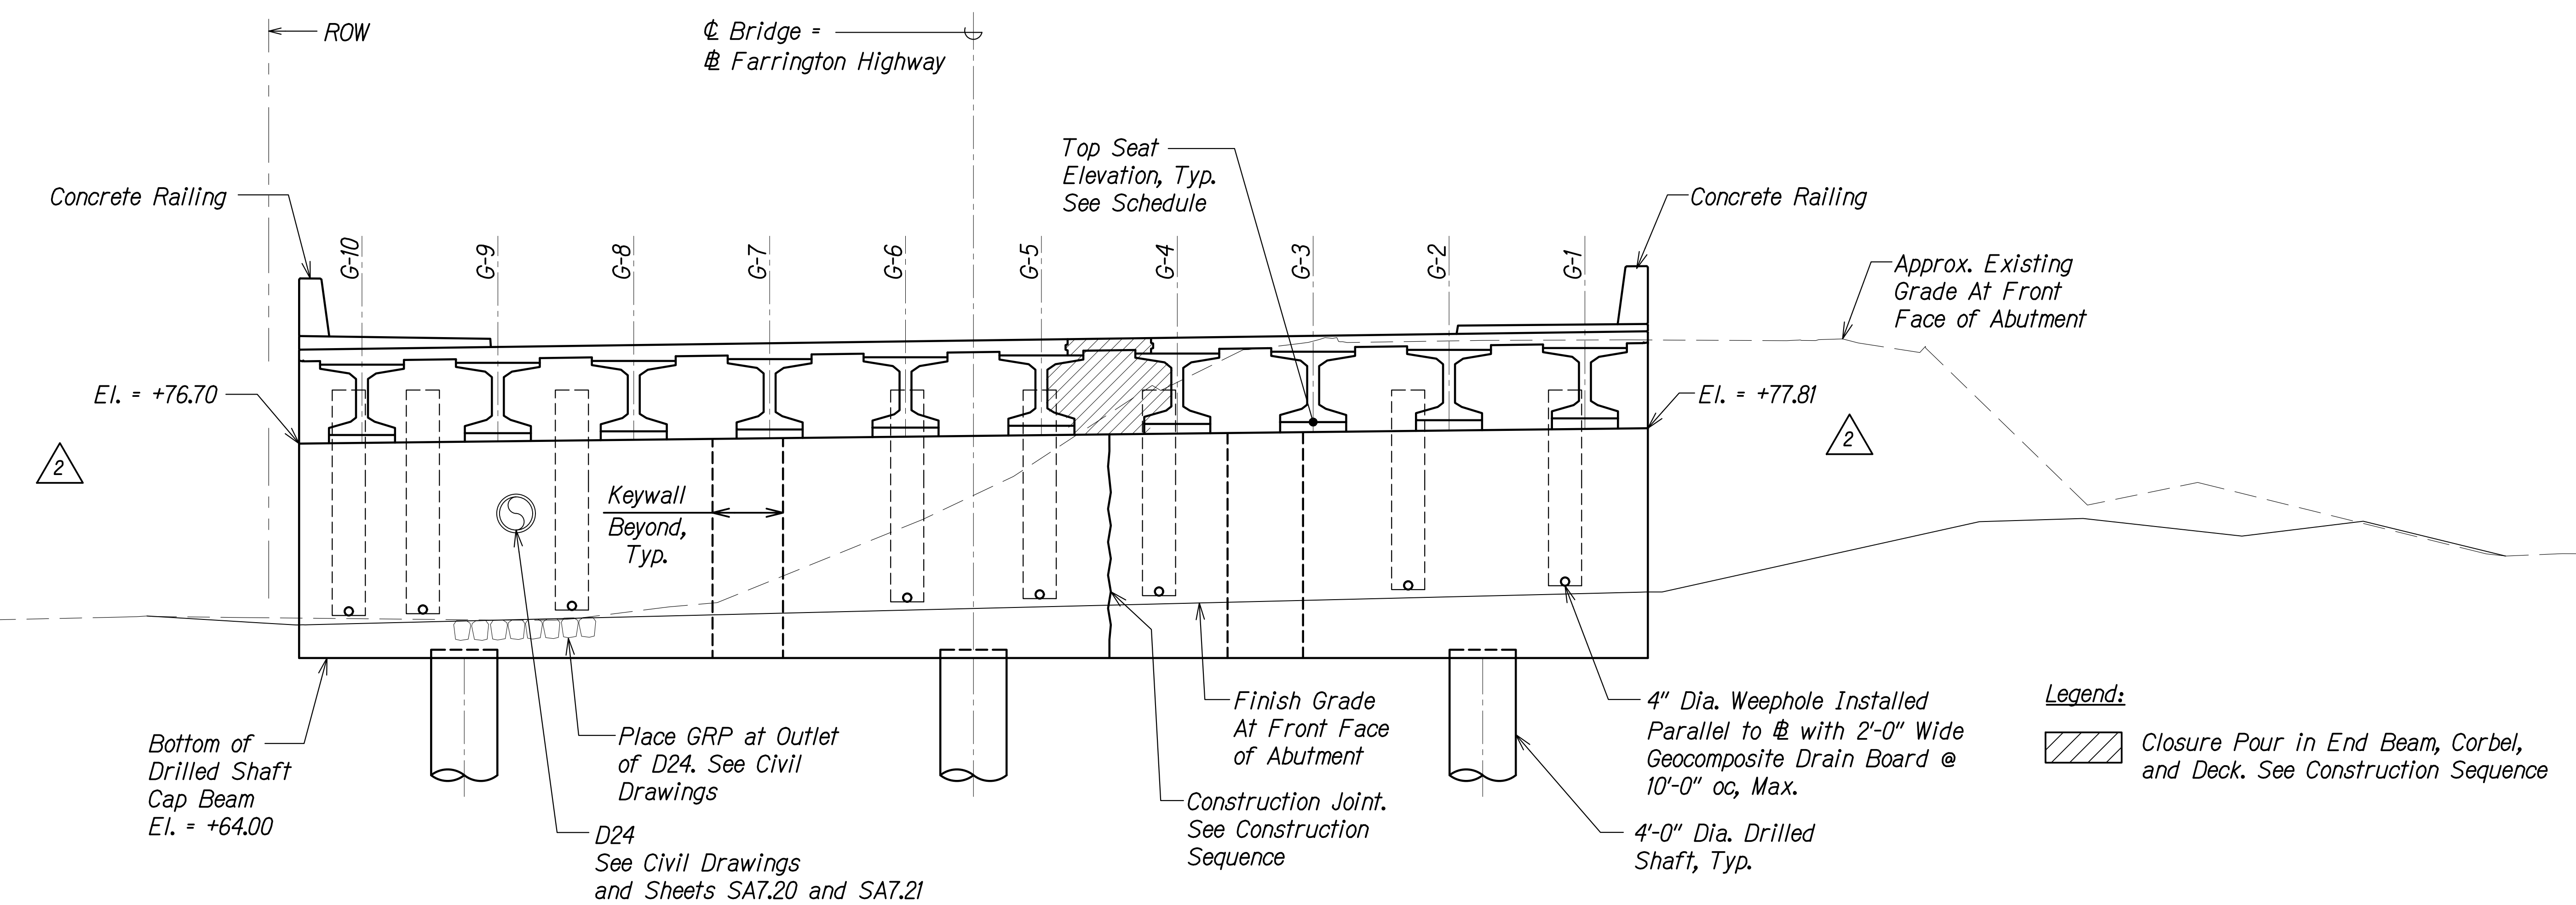

Abutment No. 1										
Girder #	1	2	3	4	5	6	7	8	9	10
Top of Seat Elevation	+78.26	+78.15	+78.03	+77.92	+77.81	+77.70	+77.59	+77.47	+77.36	+77.25

See sheet SA7.19 for concrete seat details.  
Seat Elevations are shown as + MSL

- Notes:
- Contractor shall not encroach within construction clear zone around HART Guideway at any time during construction.
  - Top of Drilled Shaft Cap Elevations are measured at ⊕ of abutment.
  - Geocomposite Drain Boards and Drain Pipes shall be incidental to the measurement and payment for CLSM Backfill for Honouliuli Abutments and Wingwalls.


**ABUTMENT NO. 1 ELEVATION LOOKING TOWARDS KAPOLEI**  
Scale: 3/16" = 1'-0"

SURVEY PLOTTED BY	DATE
DRAWN BY	
DESIGNED BY	
QUANTITIES BY	
CHECKED BY	
ORIGINAL PLAN	
NOTE BOOK	
No.	

DRAWING NAME: SA7.00 BRIDGES/20-013-FARR HWY KAPOLEI GC ID: ET WWP-BRIMC(01-GAD) 07-15-22 ADD1 DELIAS/THMS-S40702 HIGH ABUT1 EL-ADD1-DELIAS.DWG PLOT TIME: 07-15-22 4:47 PM

THIS WORK WAS PREPARED BY ME OR UNDER MY SUPERVISION AND CONSTRUCTION OF THIS PROJECT WILL BE UNDER MY OBSERVATION.

Signature: *Paul S. Miyahara*  
April 30, 2024  
EXPIRATION DATE OF THE LICENSE

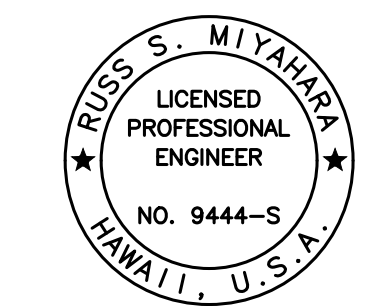

07/15/22	5	Revised Sheet Reference
06/08/22	2	Revised Elevations
DATE		REVISION

STATE OF HAWAII  
DEPARTMENT OF TRANSPORTATION  
HIGHWAYS DIVISION

**Honouliuli Stream Bridge  
Abutment No. 1 Elevation**

FARRINGTON HIGHWAY WIDENING  
Kapolei Golf Course Road to Fort Weaver Road  
Project No. 7101A-01-20



Scale: As Shown Date: Apr. 2022

**SHEET No. SA7.2 OF 20 SHEETS**

FED. ROAD DIST. NO.	STATE	PROJ. NO.	FISCAL YEAR	SHEET NO.	TOTAL SHEETS
HAWAII	HAW.	7101A-01-20	2021	ADD. 373	

← Upstream

Downstream →

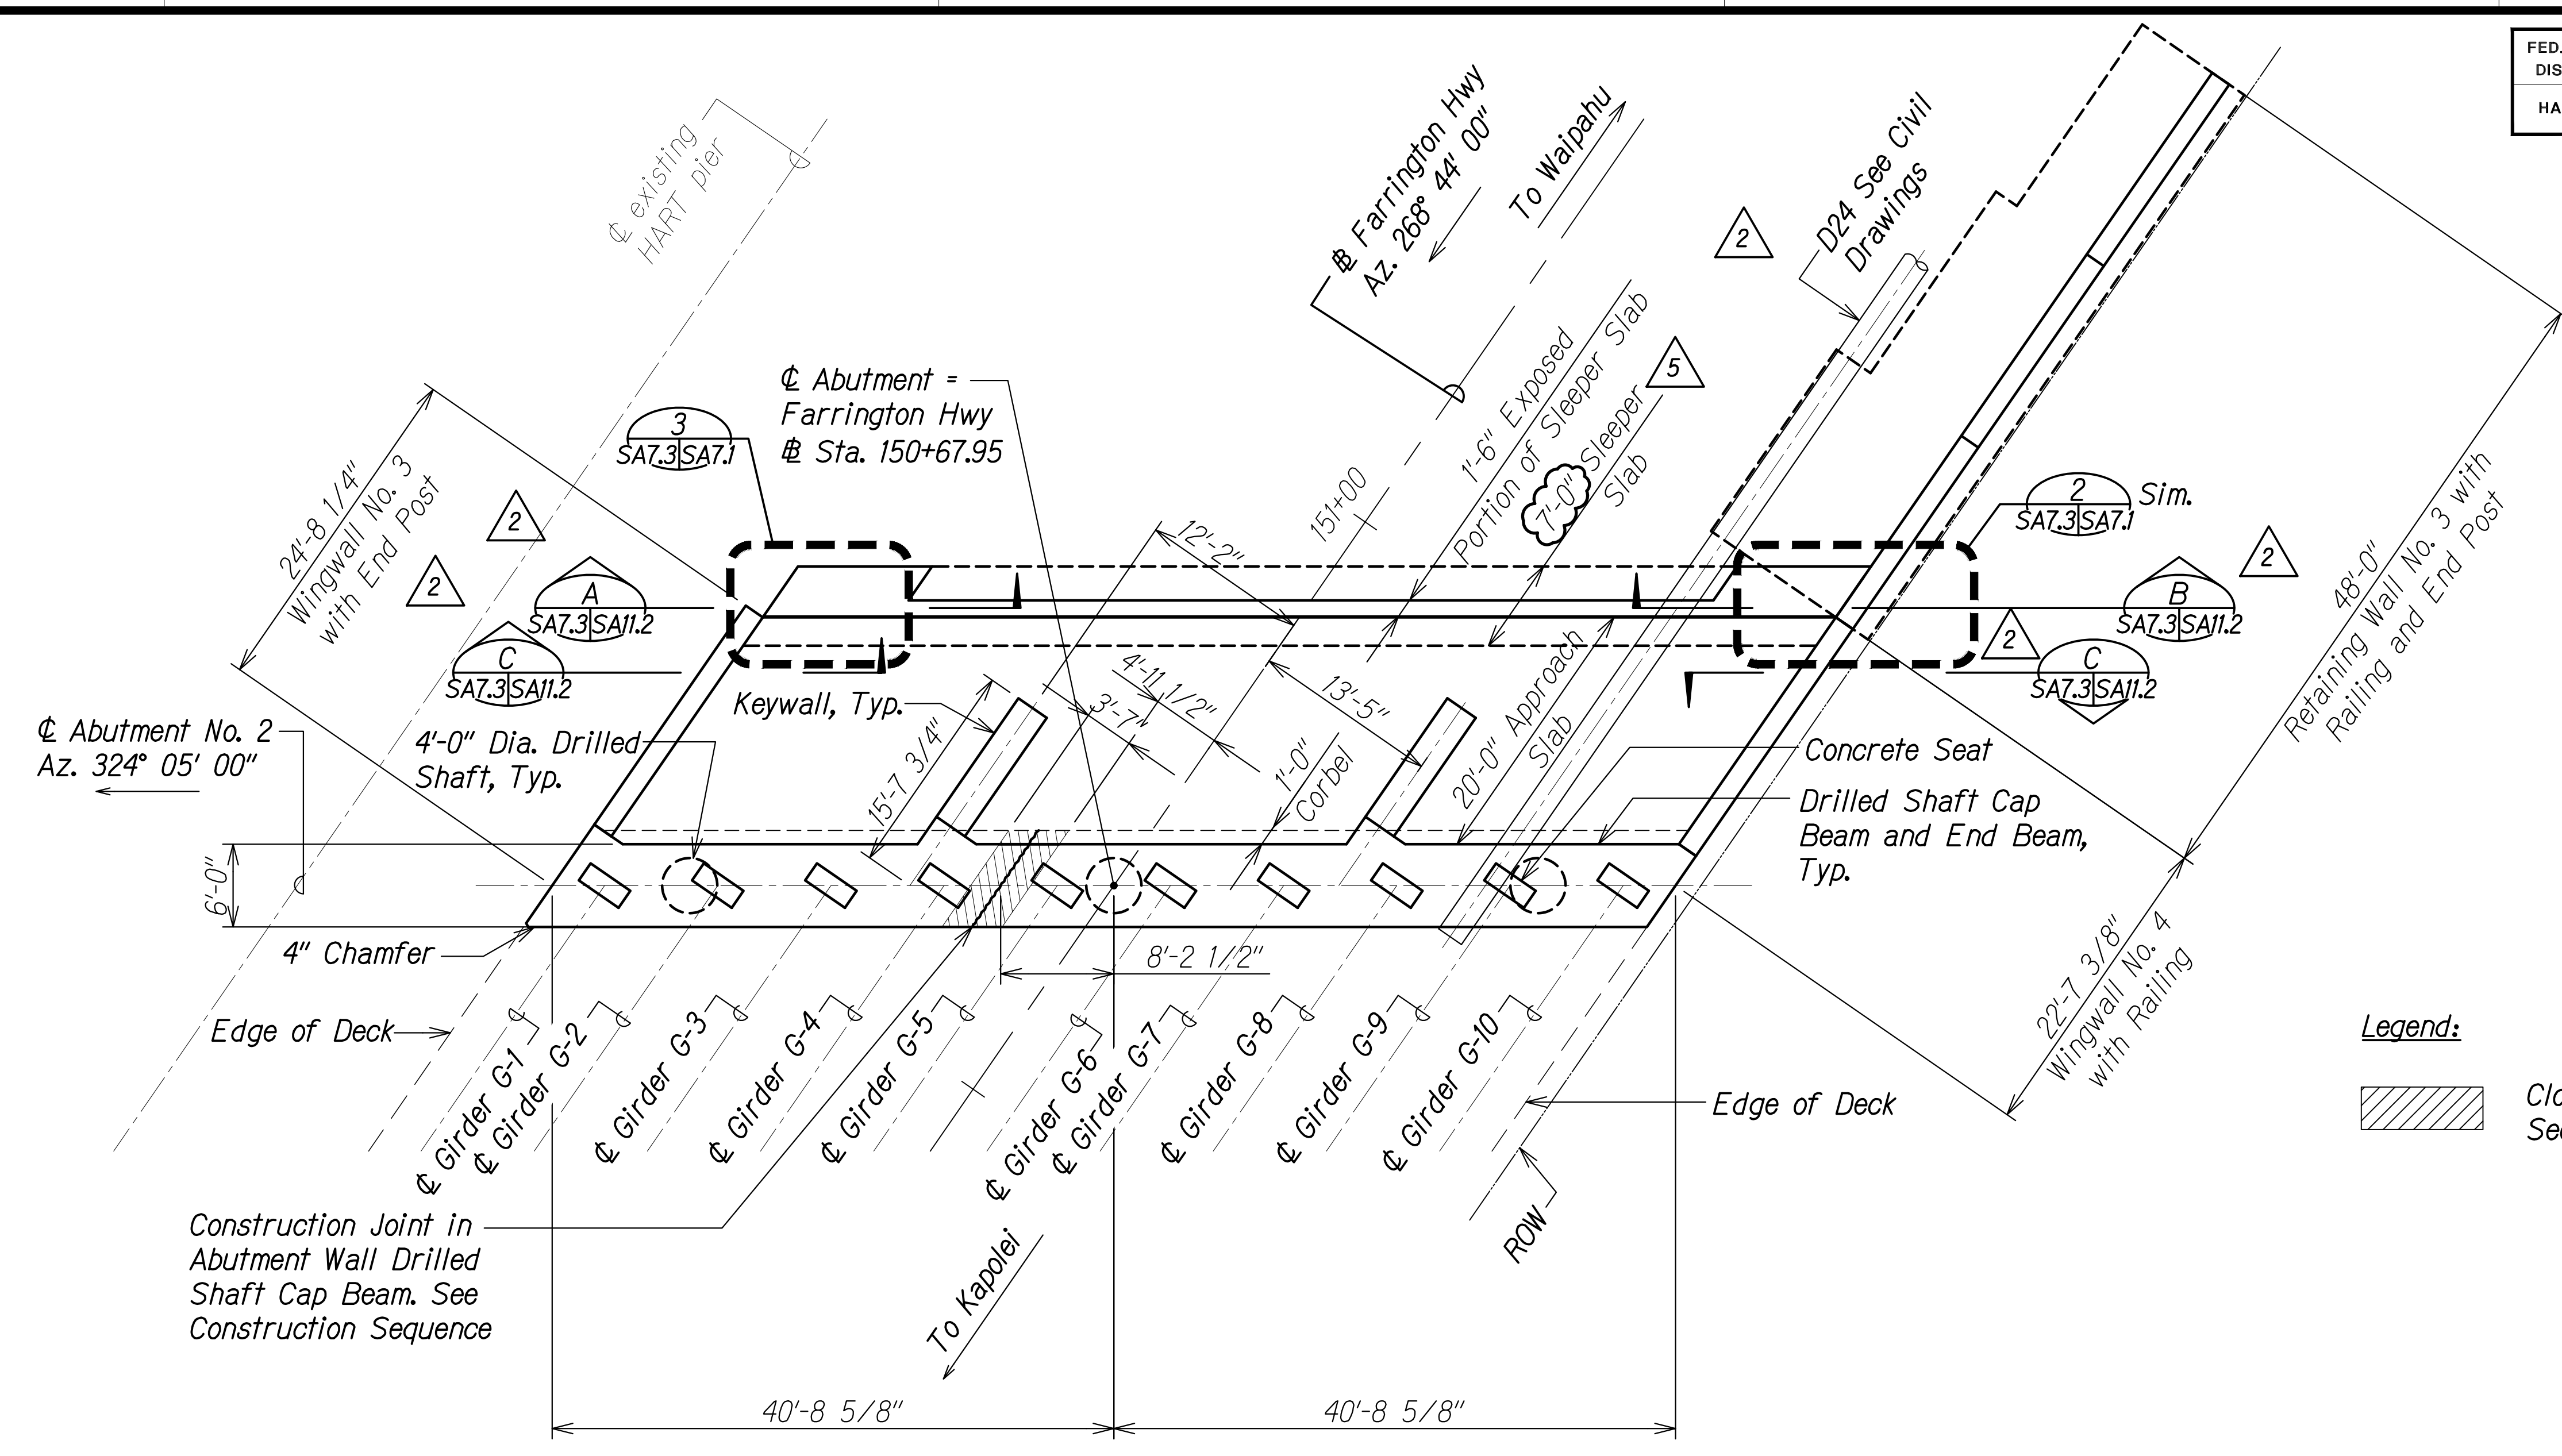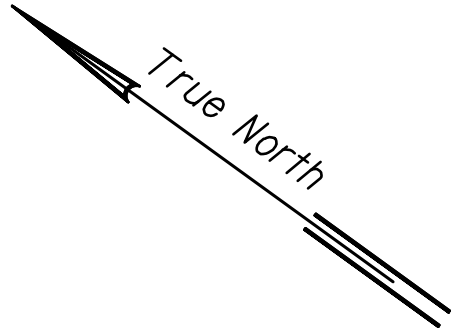

Legend:

Closure Pour in End Beam and Corbel. See Construction Sequence.

**ABUTMENT NO. 2 PLAN**  
 Scale: 1/8" = 1'-0"  
 SA7.3 SA7.3

SURVEY PLOTTED BY	DATE
DRAWN BY	
DESIGNED BY	
QUANTITIES BY	
CHECKED BY	
ORIGINAL PLAN	
NOTE BOOK	
No.	

DRAWING NAME: Z:\100 ONGOING\20-013-FARR-HWY-KAPOLEI GC ID: FT-WRP-EMTC\01-GAD\07-15-22-ADD1-DELAS\EMTS-SAD\703-ABUT2-PLAN-ADD1-DELAS.DWG PLOT TIME: 07-15-22-4:47 PM

DATE	REVISION
07/15/22	5 Revised Sleeper Slab Width
06/08/22	2 Revised Drainline

THIS WORK WAS PREPARED BY ME OR UNDER MY SUPERVISION AND CONSTRUCTION OF THIS PROJECT WILL BE UNDER MY OBSERVATION.  
 Signature: *Rugs S. Miyahara*  
 April 30, 2024  
 EXPIRATION DATE OF THE LICENSE

STATE OF HAWAII  
 DEPARTMENT OF TRANSPORTATION  
 HIGHWAYS DIVISION



**Honouliuli Stream Bridge  
 Abutment No. 2 Plan**

FARRINGTON HIGHWAY WIDENING  
 Kapolei Golf Course Road to Fort Weaver Road  
 Project No. 7101A-01-20

Scale: As Shown Date: Apr. 2022



FED. ROAD DIST. NO.	STATE	PROJ. NO.	FISCAL YEAR	SHEET NO.	TOTAL SHEETS
HAWAII	HAW.	7101A-01-20	2021	ADD. 374	

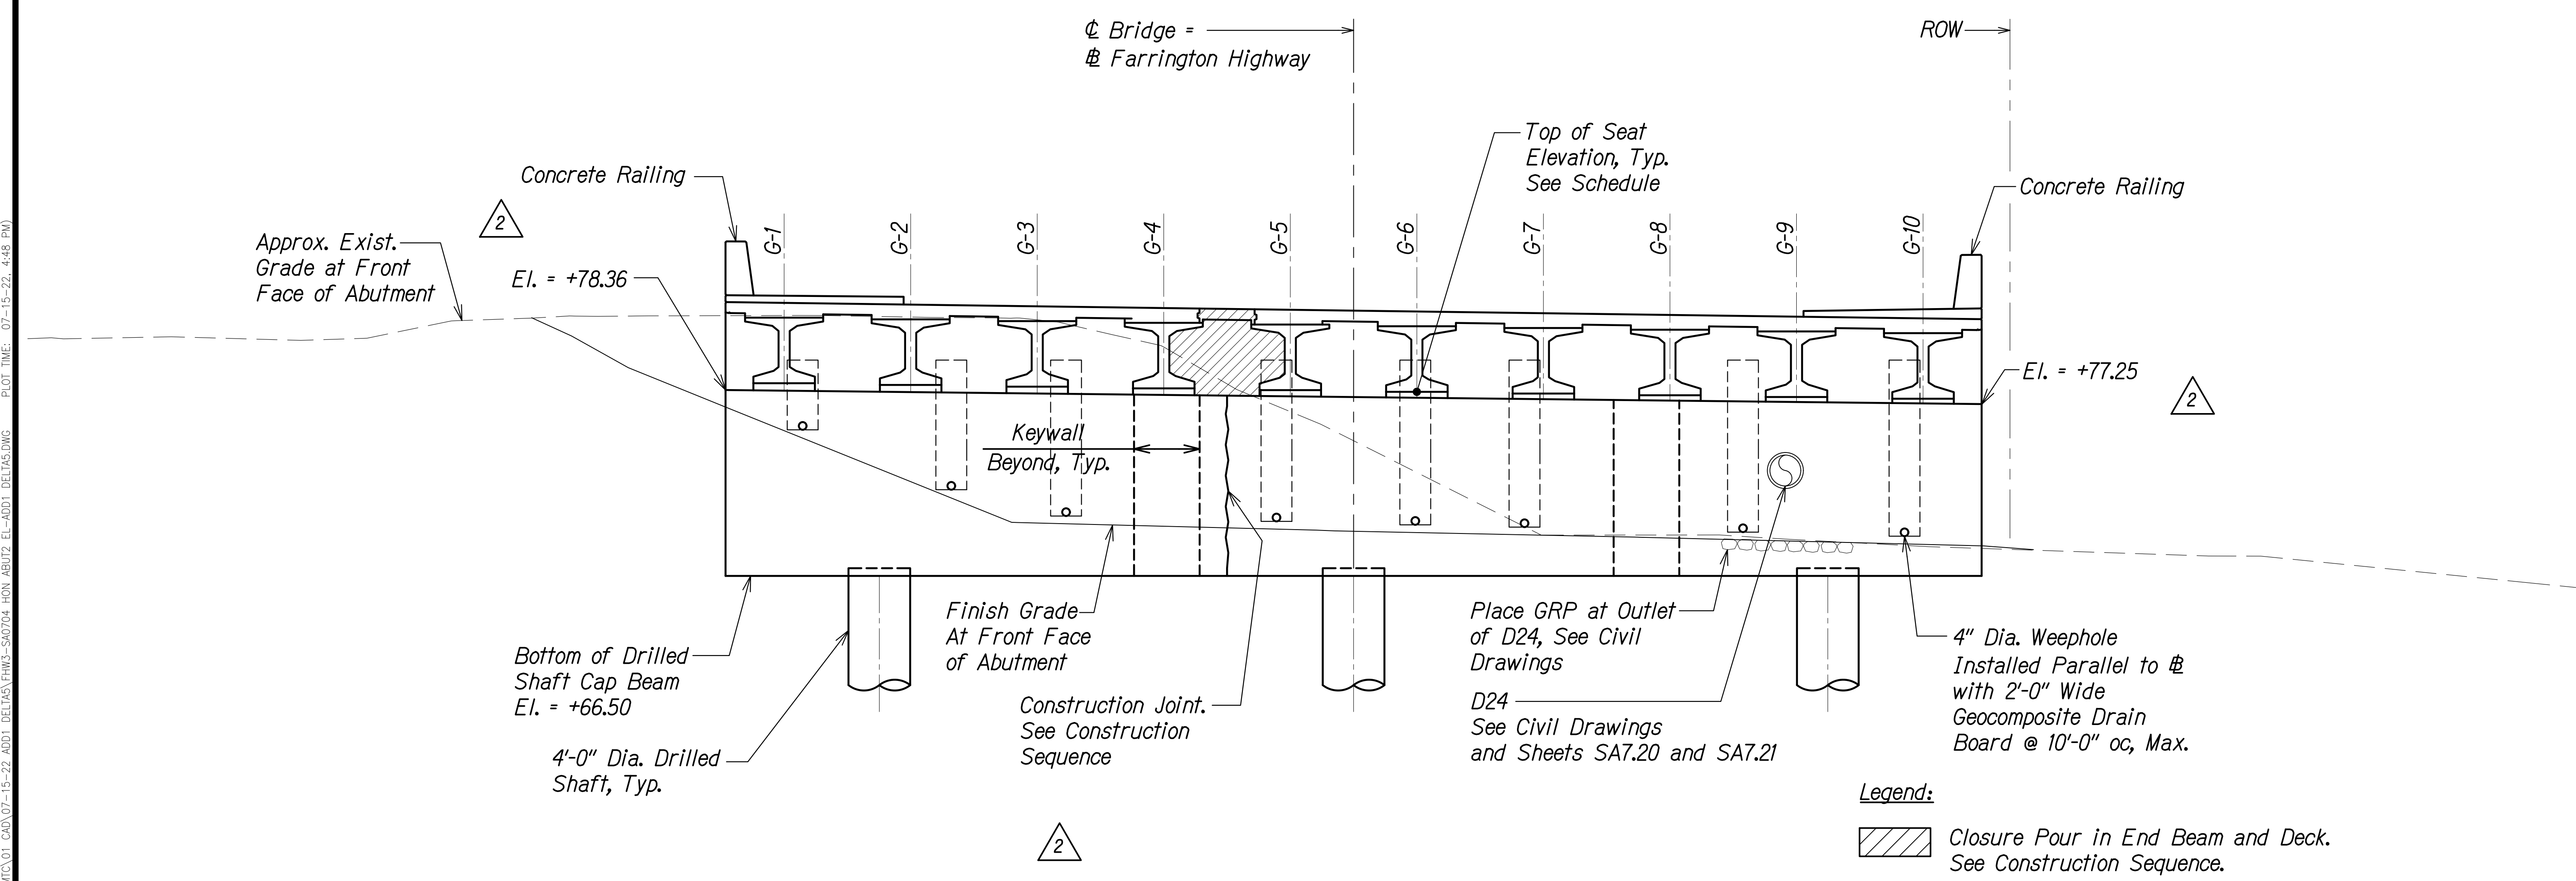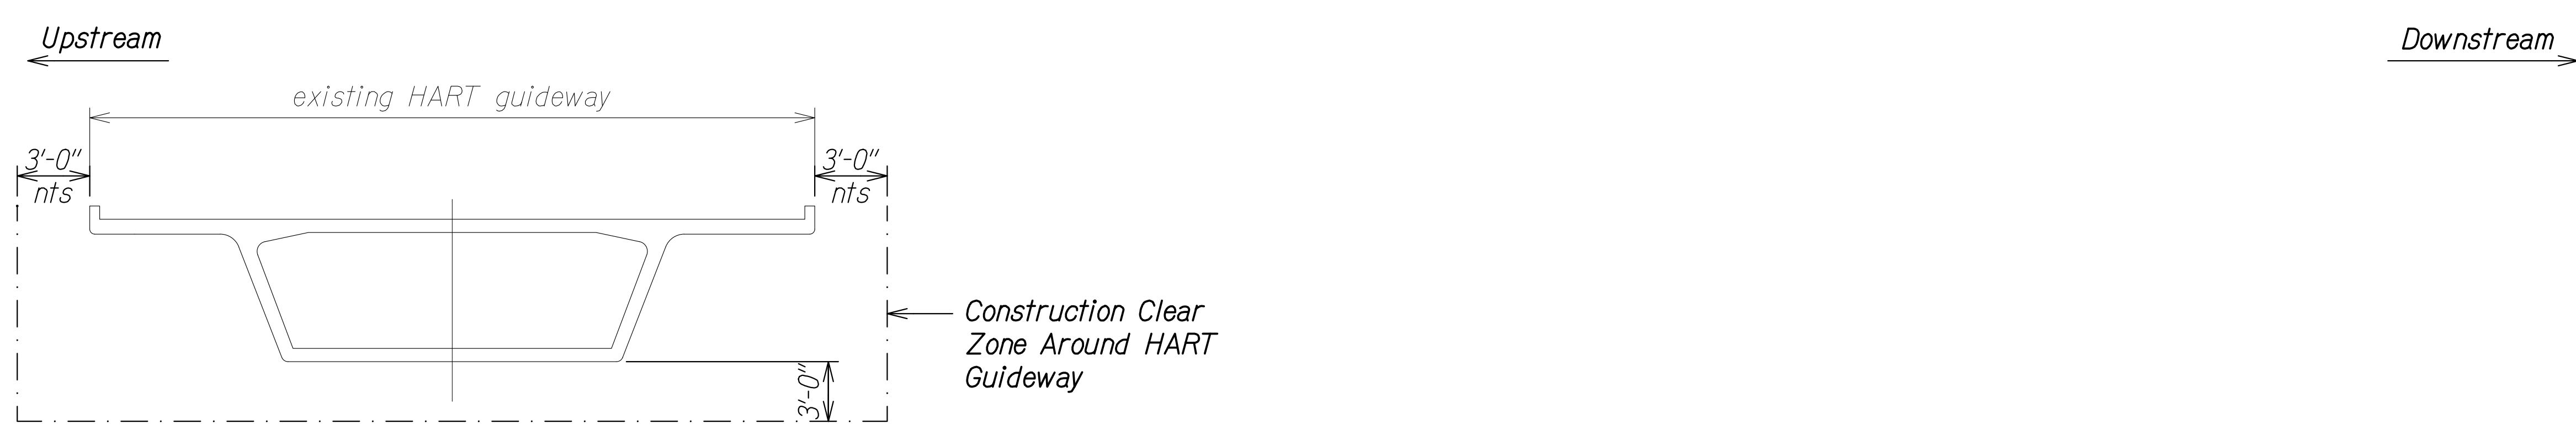

**Legend:**  
 Closure Pour in End Beam and Deck. See Construction Sequence.

Abutment No. 2										
Girder #	1	2	3	4	5	6	7	8	9	10
Top of Seat Elevation	+78.81	+78.69	+78.58	+78.47	+78.36	+78.25	+78.14	+78.02	+77.91	+77.80

See sheet SA7.19 for concrete seat details. Seat Elevations are shown as + MSL

- Notes:**
- Contractor shall not encroach within construction clear zone around HART Guideway at any time during construction.
  - Top of Drilled Shaft Cap Elevations are measured at  $\phi$  of abutment.
  - Geocomposite Drain Boards and Drain Pipes shall be incidental to the measurement and payment for CLSM Backfill for Honouliuli Abutments and Wingwalls.

**ABUTMENT NO. 2 ELEVATION LOOKING TOWARDS WAIPAHA**  
 Scale: 3/16" = 1'-0"

SURVEY PLOTTED BY	DATE
DRAWN BY	
DESIGNED BY	
QUANTITIES BY	
CHECKED BY	
ORIGINAL PLAN	
NOTE BOOK	
No.	


DRAWING NAME: Z:\00 ONGOING\20-013-FARR HWY KAPOLEI GC ID: FT WRP-EMTC\01 CAD\07-15-22 ADD1 DELIAS\EMHS-S40704 HDRI ABUT2 EL-ADD1-DELIAS.DWG PLOT TIME: 07-15-22 4:48 PM

**RUGO S. MIYAHARA**  
 LICENSED PROFESSIONAL ENGINEER  
 NO. 9444-S  
 HAWAII, U.S.A.  
 THIS WORK WAS PREPARED BY ME OR UNDER MY SUPERVISION AND CONSTRUCTION OF THIS PROJECT WILL BE UNDER MY OBSERVATION.  
 SIGNATURE: *Rugo S. Miyahara* April 30, 2024  
 EXPIRATION DATE OF THE LICENSE

07/15/22	5	Revised Sheet Reference
06/08/22	2	Revised Elevations
DATE	REVISION	
STATE OF HAWAII DEPARTMENT OF TRANSPORTATION HIGHWAYS DIVISION <b>Honouliuli Stream Bridge</b> <b>Abutment No. 2 Elevation</b> FARRINGTON HIGHWAY WIDENING Kapolei Golf Course Road to Fort Weaver Road Project No. 7101A-01-20 Scale: As Shown Date: Apr. 2022 <b>SHEET No. SA7.4 OF 20 SHEETS</b>		



FED. ROAD DIST. NO.	STATE	PROJ. NO.	FISCAL YEAR	SHEET NO.	TOTAL SHEETS
HAWAII	HAW.	7101A-01-20	2021	ADD. 375	

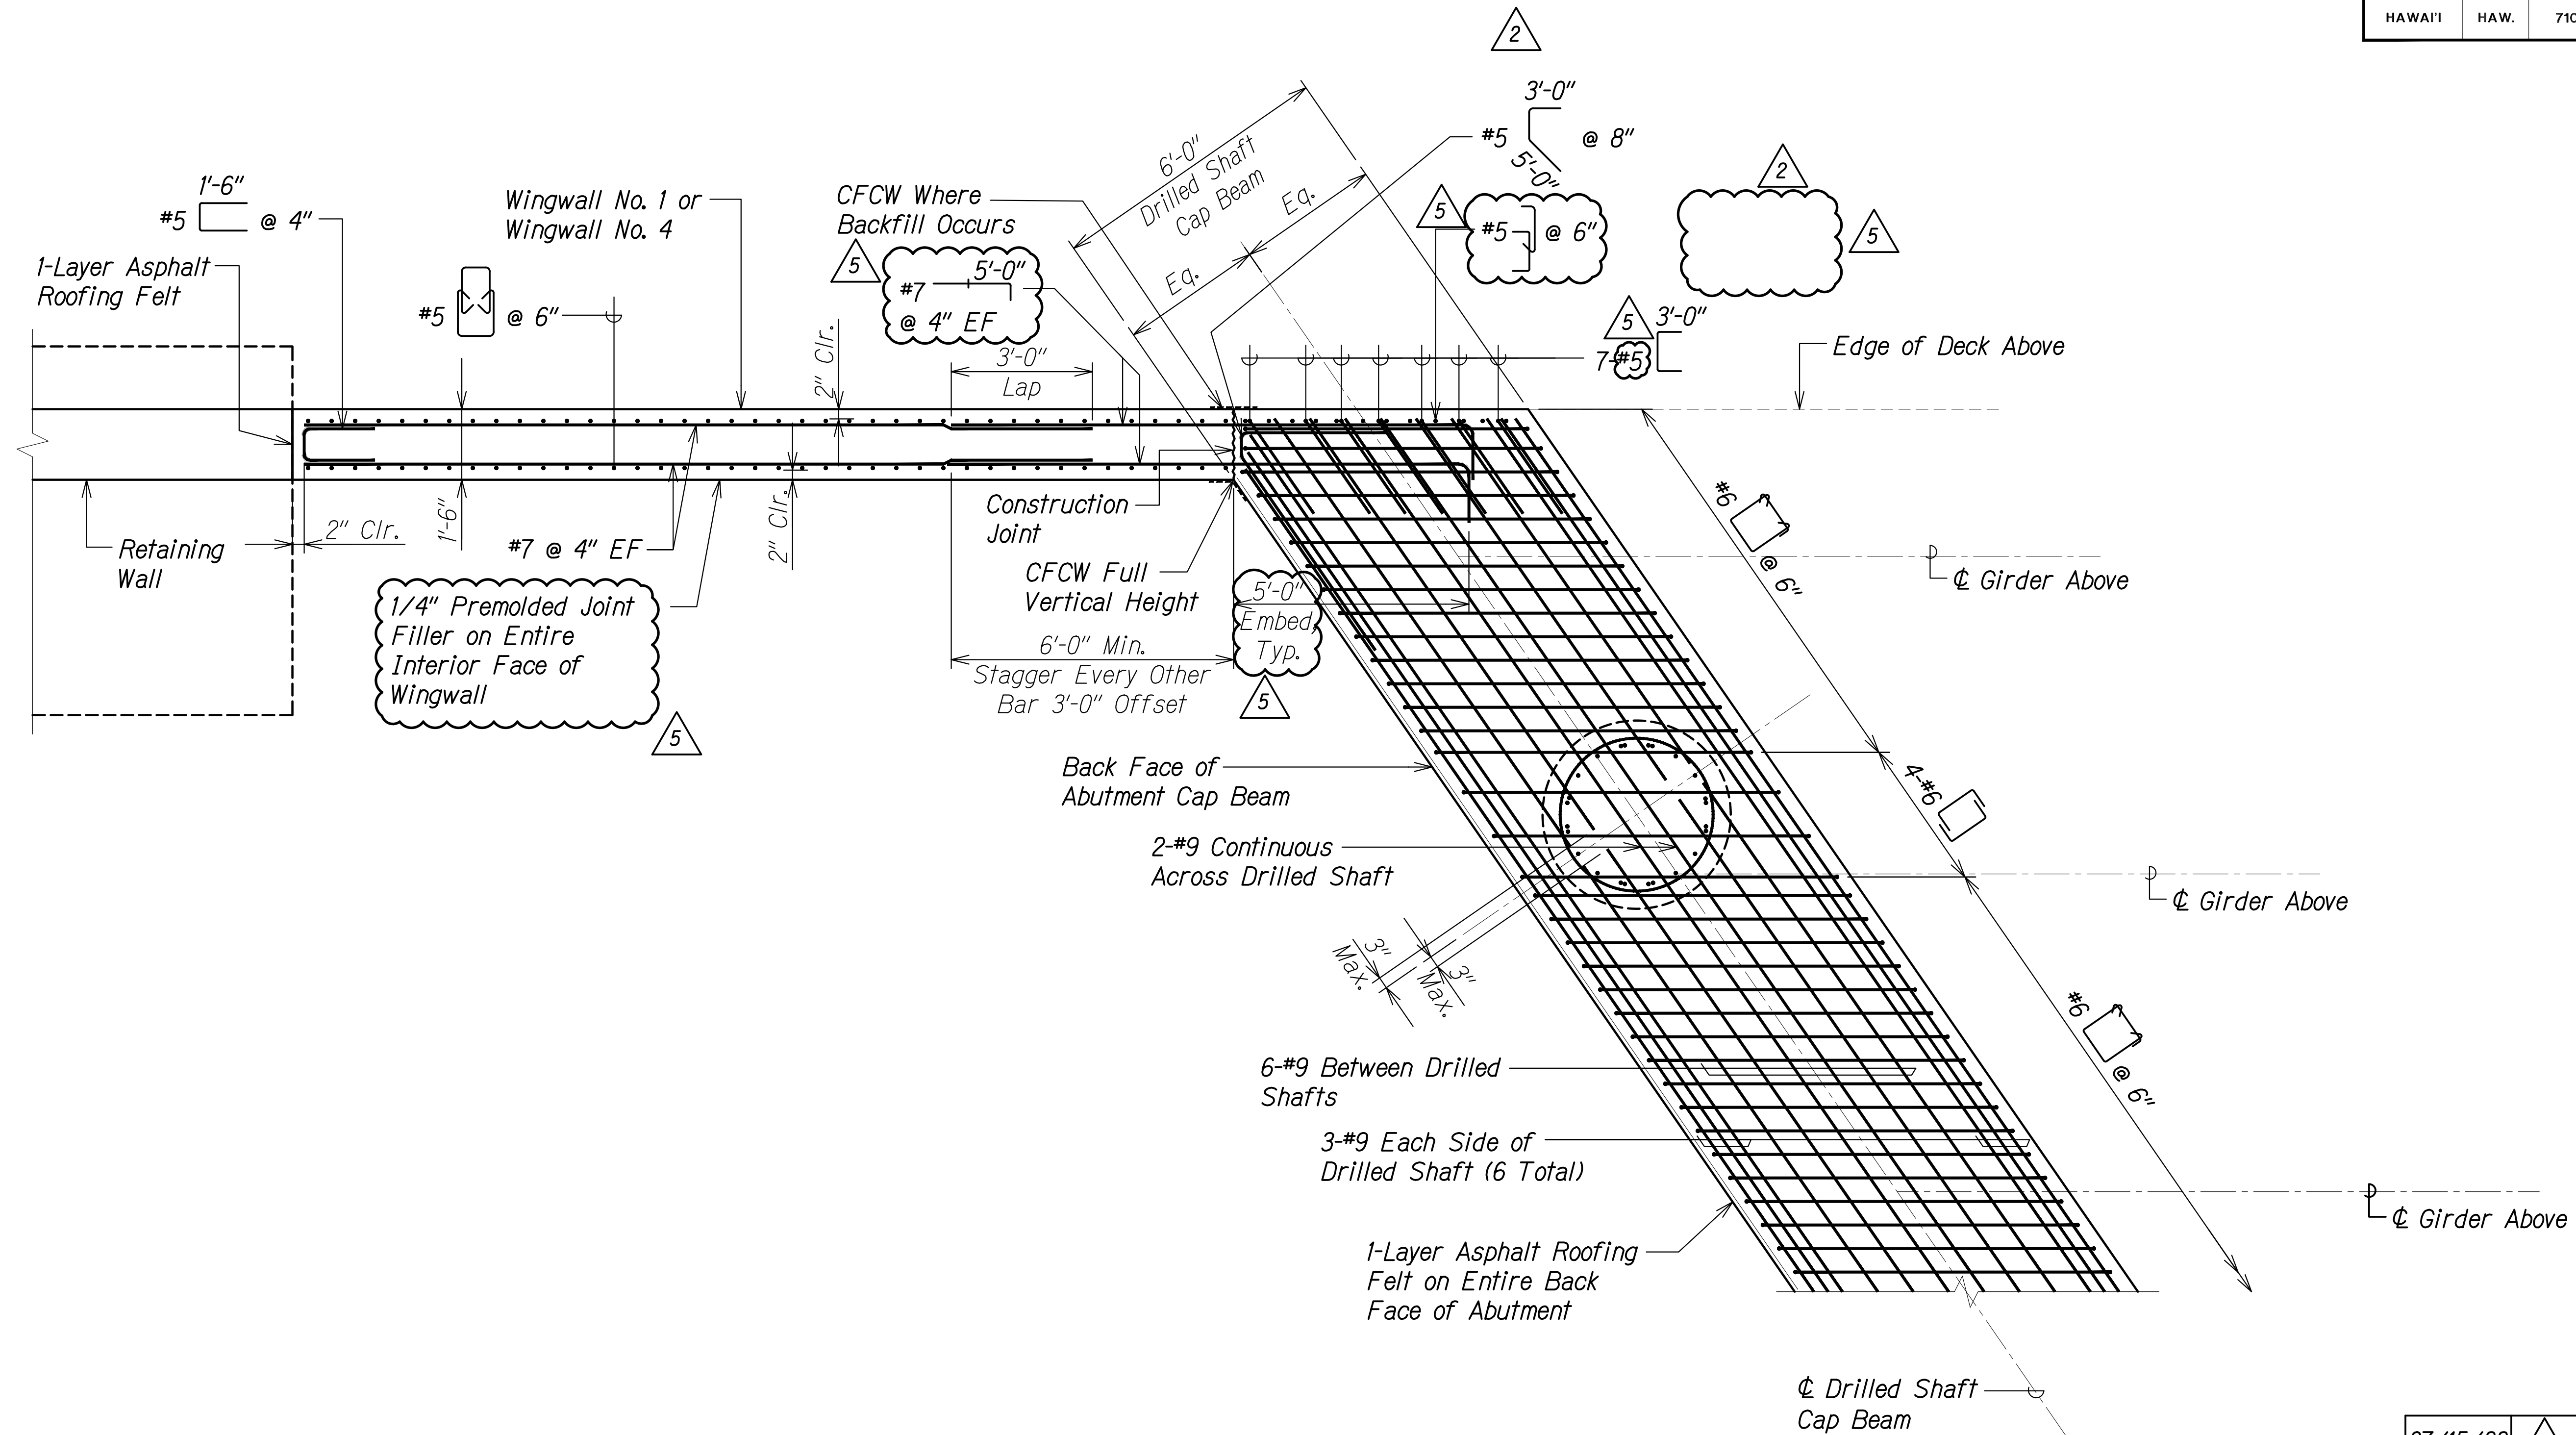


DRAWING NAME: Z:\00 UNDOING\20-013-FARR-HWY-KAPOLEI.GE.ID.IT.WRK-BRICK\01-CAD\07-15-22-ADD1-DELAS\THW3-SAD705-ABUT1-PLAN-ADD1-DELAS.DWG PLOT TIME: 07-15-22-4:48 PM

SURVEY PLOTTED BY	DATE
DRAWN BY	
DESIGNED BY	
QUANTITIES BY	
CHECKED BY	
ORIGINAL PLAN	
NOTE BOOK	
No.	

**TYPICAL DRILLED SHAFT CAP BEAM  
BOTTOM REINFORCING PLAN**  
Scale: 1/2" = 1'-0"

A  
SA7.5 SA7.5

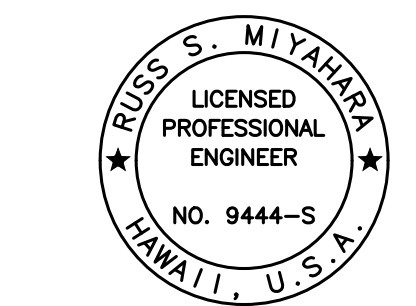

THIS WORK WAS PREPARED BY ME OR UNDER MY SUPERVISION AND CONSTRUCTION OF THIS PROJECT WILL BE UNDER MY OBSERVATION.  
Signature: *Ruges S. Miyahara*  
April 30, 2024  
EXPIRATION DATE OF THE LICENSE

07/15/22	5	Revised Reinforcing
06/08/22	2	Added Reinforcing
DATE		REVISION

STATE OF HAWAII  
DEPARTMENT OF TRANSPORTATION  
HIGHWAYS DIVISION


**Honouliuli Stream Bridge  
Abutment Reinforcing Plan**

FARRINGTON HIGHWAY WIDENING  
Kapolei Golf Course Road to Fort Weaver Road  
Project No. 7101A-01-20

Scale: As Shown Date: Apr. 2022



FED. ROAD DIST. NO.	STATE	PROJ. NO.	FISCAL YEAR	SHEET NO.	TOTAL SHEETS
HAWAII	HAW.	7101A-01-20	2021	ADD. 377	

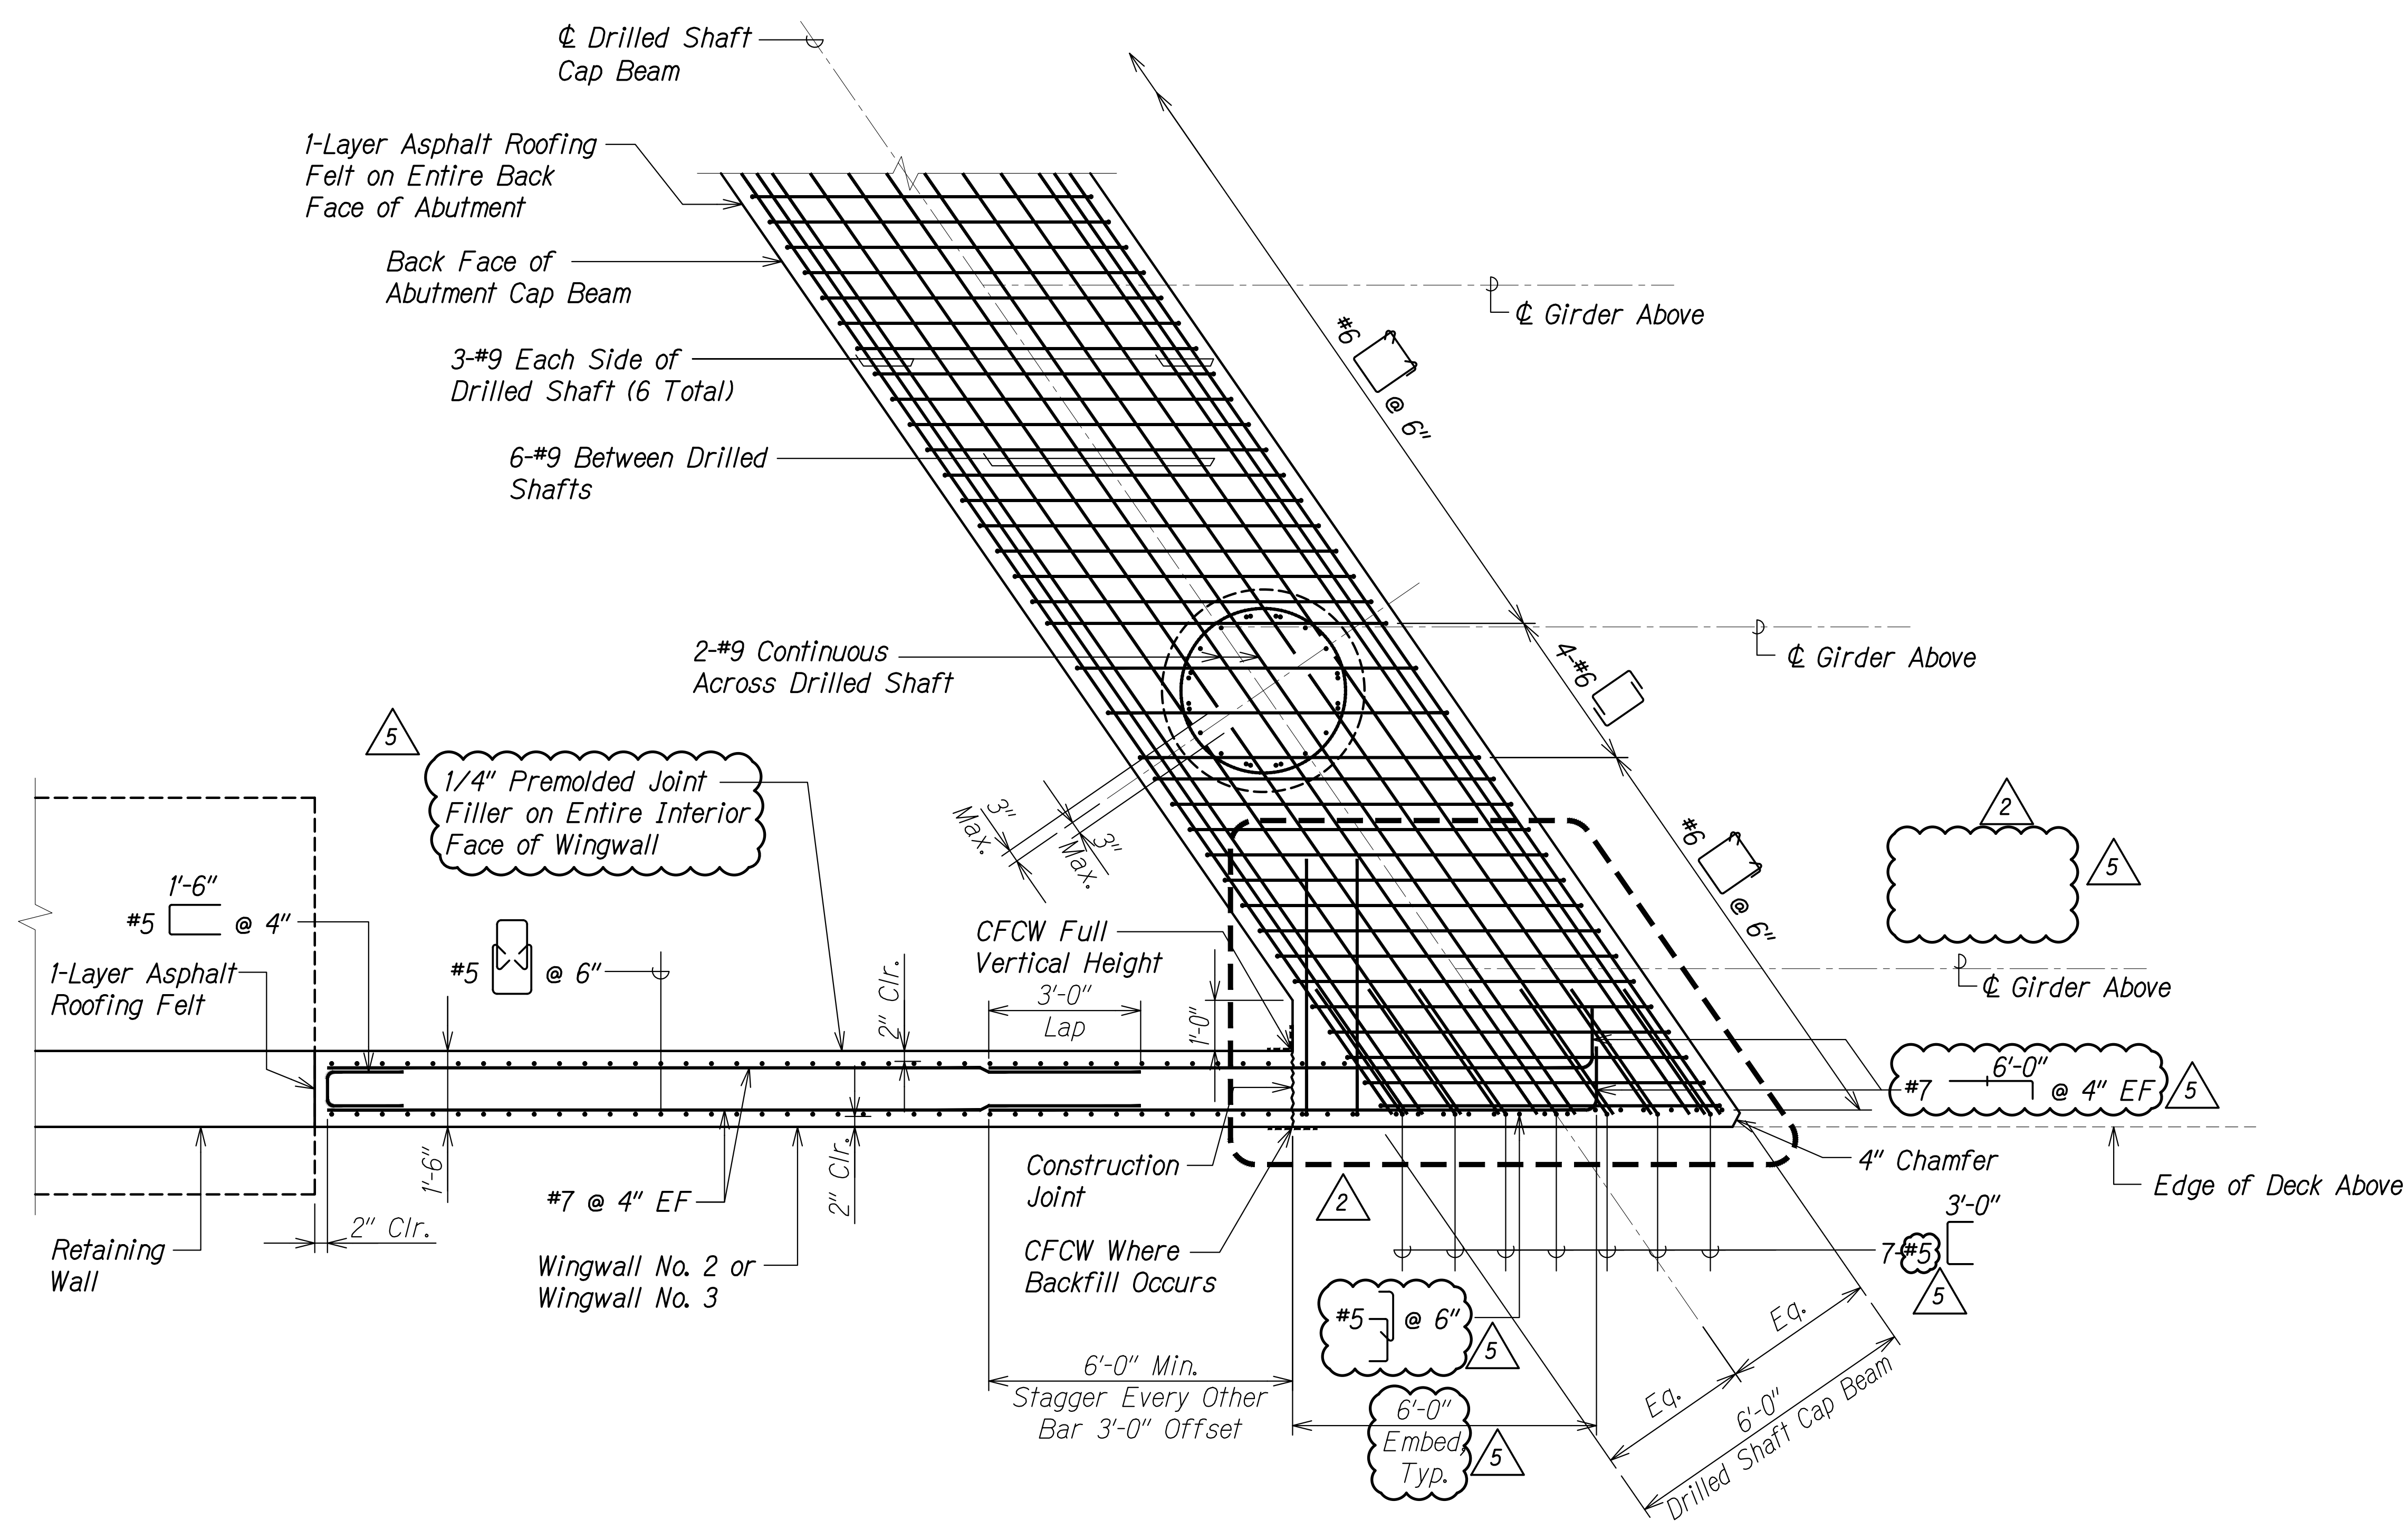


**TYPICAL DRILLED SHAFT CAP BEAM  
 BOTTOM REINFORCING PLAN**  
 Scale: 1/2" = 1'-0"

A  
 SA7.7 SA7.7

SURVEY PLOTTED BY	DATE
DRAWN BY	
DESIGNED BY	
QUANTITIES BY	
CHECKED BY	
ORIGINAL PLAN	
NOTE BOOK	
No.	

DRAWING NAME: Z:\00 UNDOING\20-013-FARR-HW-KAPOLEI.GE.ID.IT.WR-EMTC\01-CA\07-15-22-ADD1-DELAGS\FHWS-SAD705-ABUTT-PLAN-ADD1-DELAGS.DWG PLOT TIME: 07-15-22 4:49 PM


THIS WORK WAS PREPARED BY ME OR UNDER MY SUPERVISION AND CONSTRUCTION OF THIS PROJECT WILL BE UNDER MY OBSERVATION.  
 Signature: *Russ S. Miyahara*  
 EXPIRATION DATE OF THE LICENSE: April 30, 2024

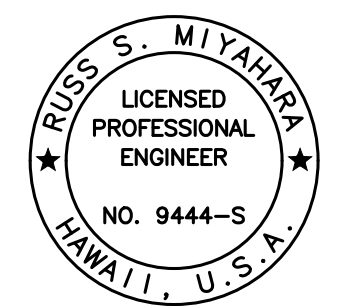

DATE	REVISION
07/15/22	5 Revised Reinforcing
06/08/22	2 Added Reinforcing

STATE OF HAWAII  
 DEPARTMENT OF TRANSPORTATION  
 HIGHWAYS DIVISION  
**Honouliuli Stream Bridge  
 Abutment Reinforcing Plan**  
 FARRINGTON HIGHWAY WIDENING  
 Kapolei Golf Course Road to Fort Weaver Road  
 Project No. 7101A-01-20  
 Scale: As Shown Date: Apr. 2022

FED. ROAD DIST. NO.	STATE	PROJ. NO.	FISCAL YEAR	SHEET NO.	TOTAL SHEETS
HAWAII	HAW.	7101A-01-20	2021	ADD. 378	

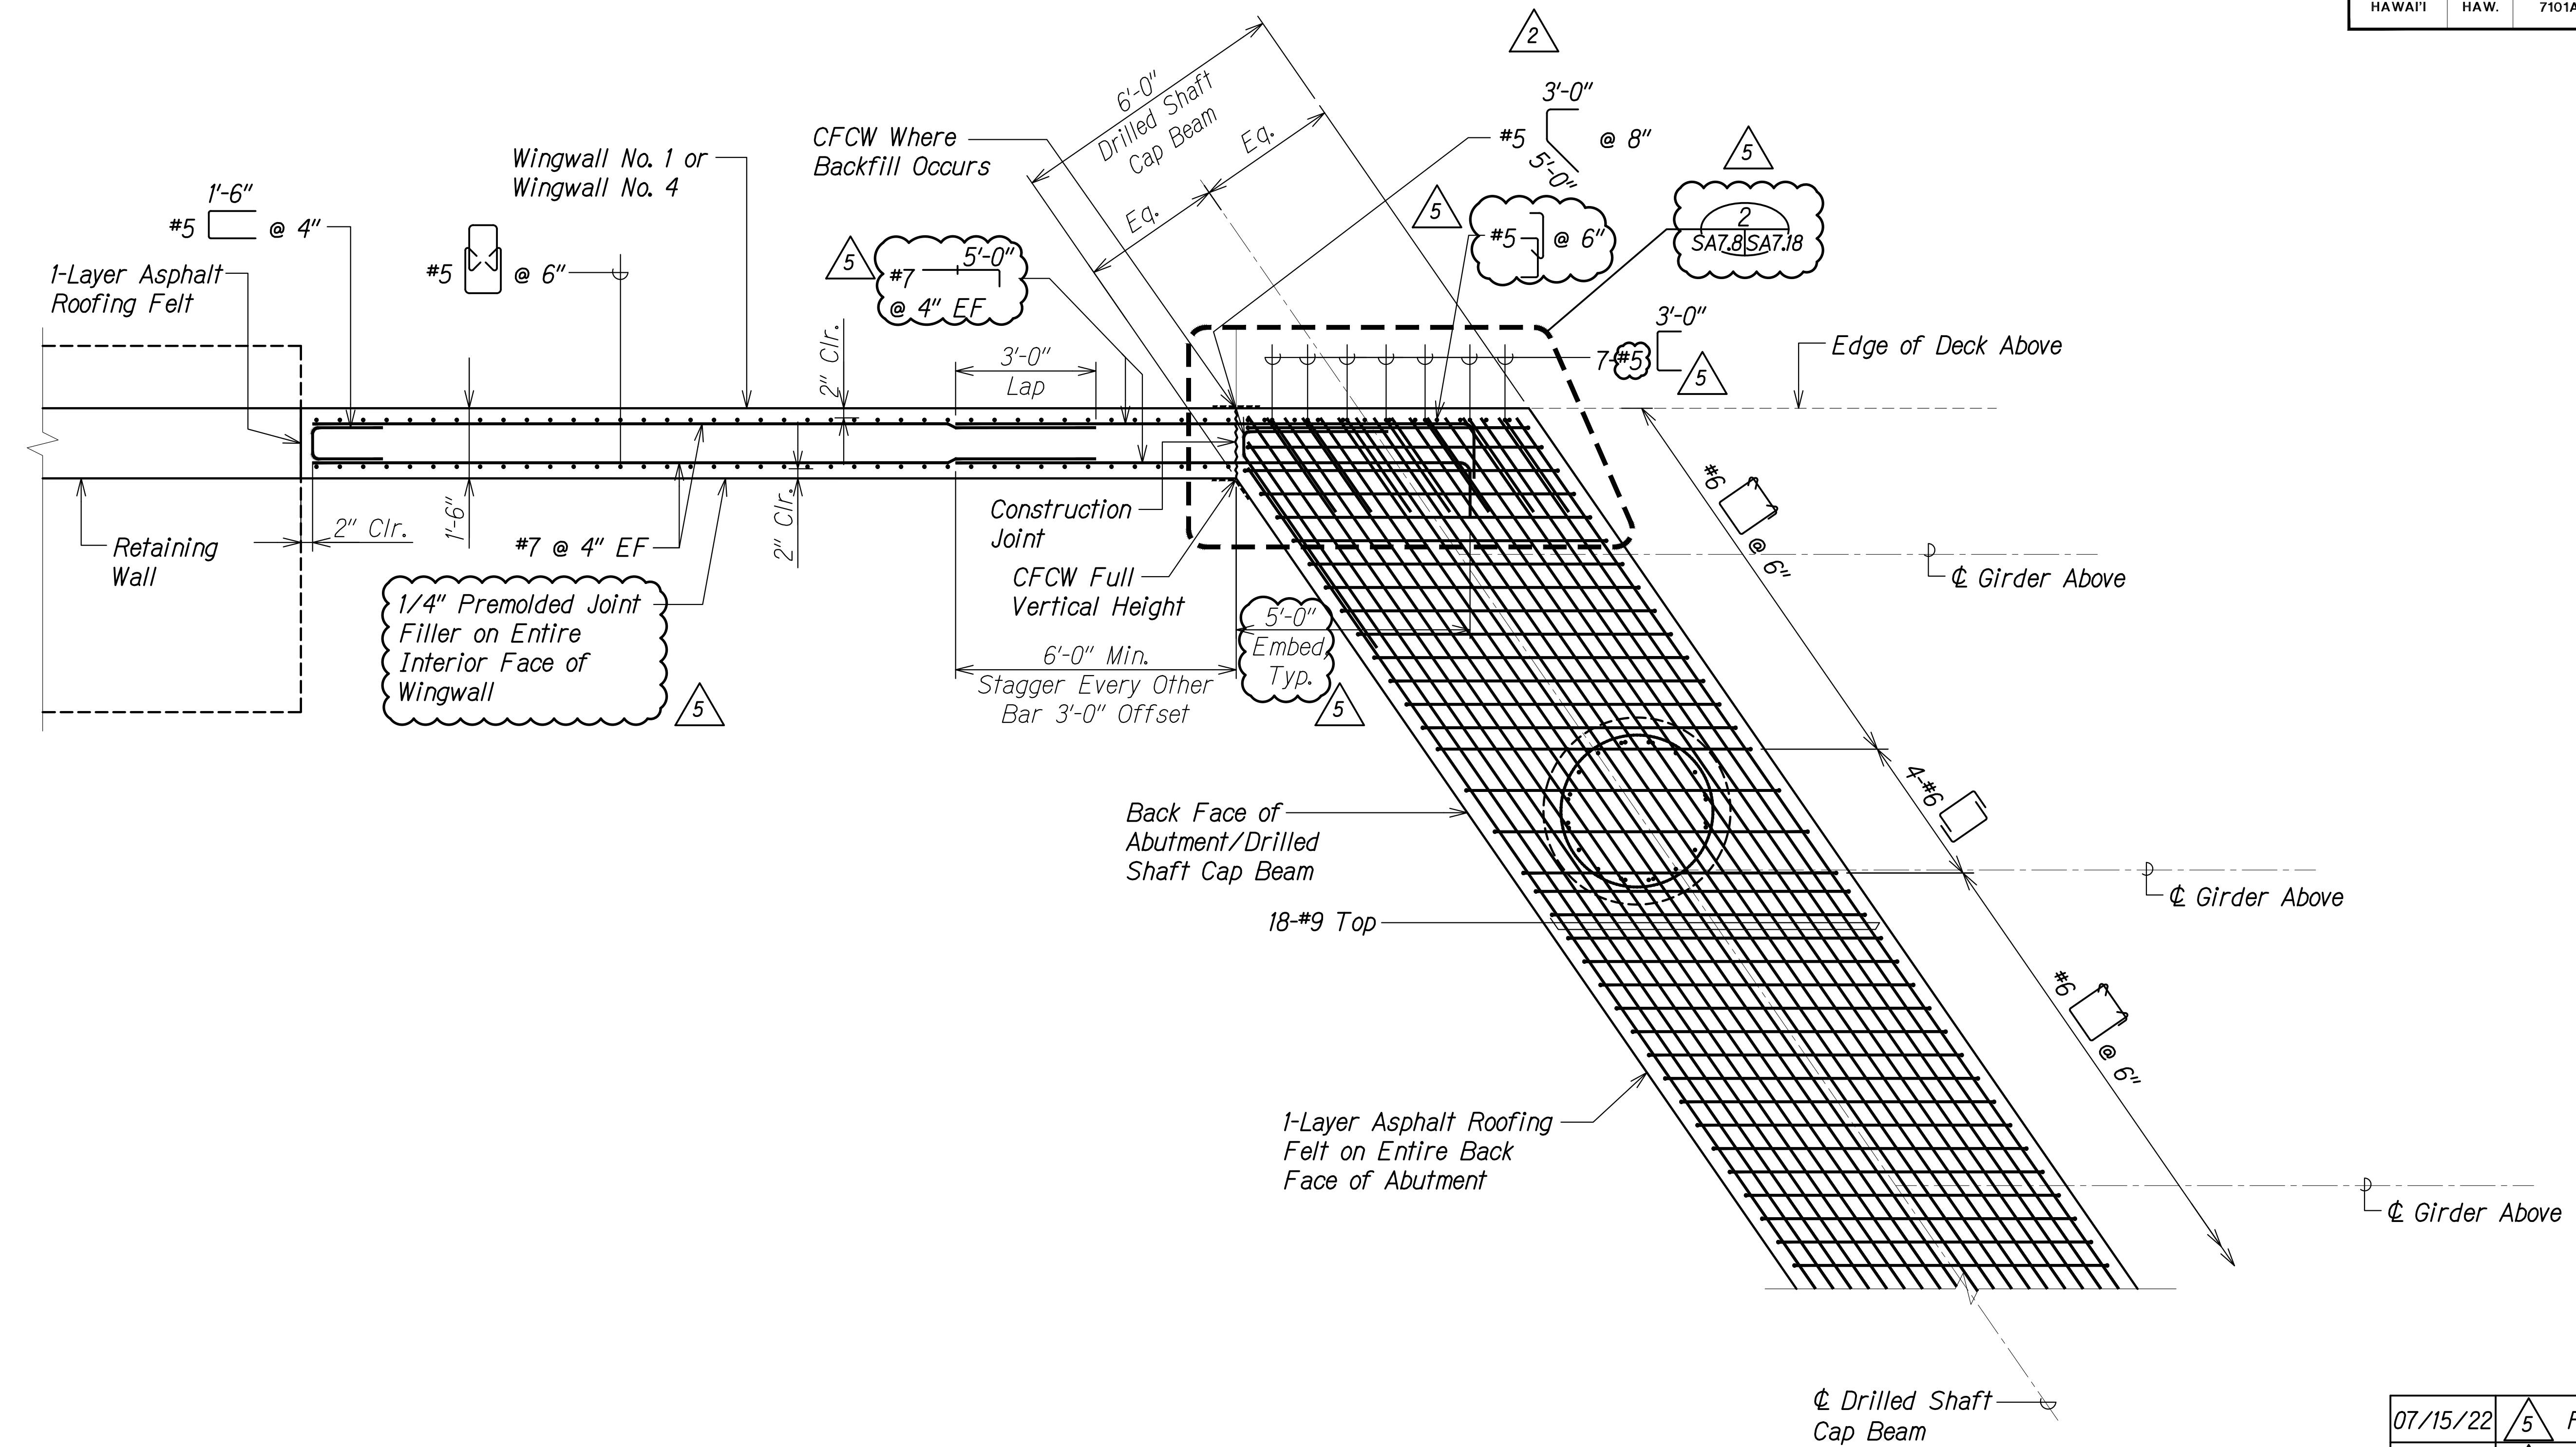

**TYPICAL DRILLED SHAFT CAP BEAM  
TOP REINFORCING PLAN**


Scale: 1/2" = 1'-0"

A  
SA7.8 SA7.8

SURVEY PLOTTED BY	DATE
DRAWN BY	
DESIGNED BY	
QUANTITIES BY	
CHECKED BY	
ORIGINAL PLAN	
NOTE BOOK	
No.	

DRAWING NAME: Z:\100 ONGOING\20-013-FARR-HWY-KAPOLEI.GE.ID.IT.WIP-EMT\01-CAD\07-15-22-ADD1-DELAGS\EMTS-S40708-ABUT1-PLAN-ADD1-DELAGS.DWG PLOT TIME: 07-15-22 4:50 PM

THIS WORK WAS PREPARED BY ME OR UNDER MY SUPERVISION AND CONSTRUCTION OF THIS PROJECT WILL BE UNDER MY OBSERVATION.  
 Signature: *Russ S. Miyahara*  
 EXPIRATION DATE OF THE LICENSE: April 30, 2024

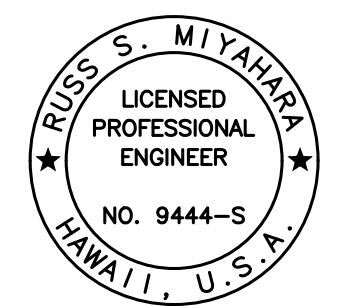


DATE	REVISION
07/15/22	5 Revised Reinforcing
06/08/22	2 Added Reinforcing

STATE OF HAWAII  
 DEPARTMENT OF TRANSPORTATION  
 HIGHWAYS DIVISION  
**Honouliuli Stream Bridge  
 Abutment Reinforcing Plan**  
 FARRINGTON HIGHWAY WIDENING  
 Kapolei Golf Course Road to Fort Weaver Road  
 Project No. 7101A-01-20  
 Scale: As Shown Date: Apr. 2022



FED. ROAD DIST. NO.	STATE	PROJ. NO.	FISCAL YEAR	SHEET NO.	TOTAL SHEETS
HAWAII	HAW.	7101A-01-20	2021	ADD. 379	

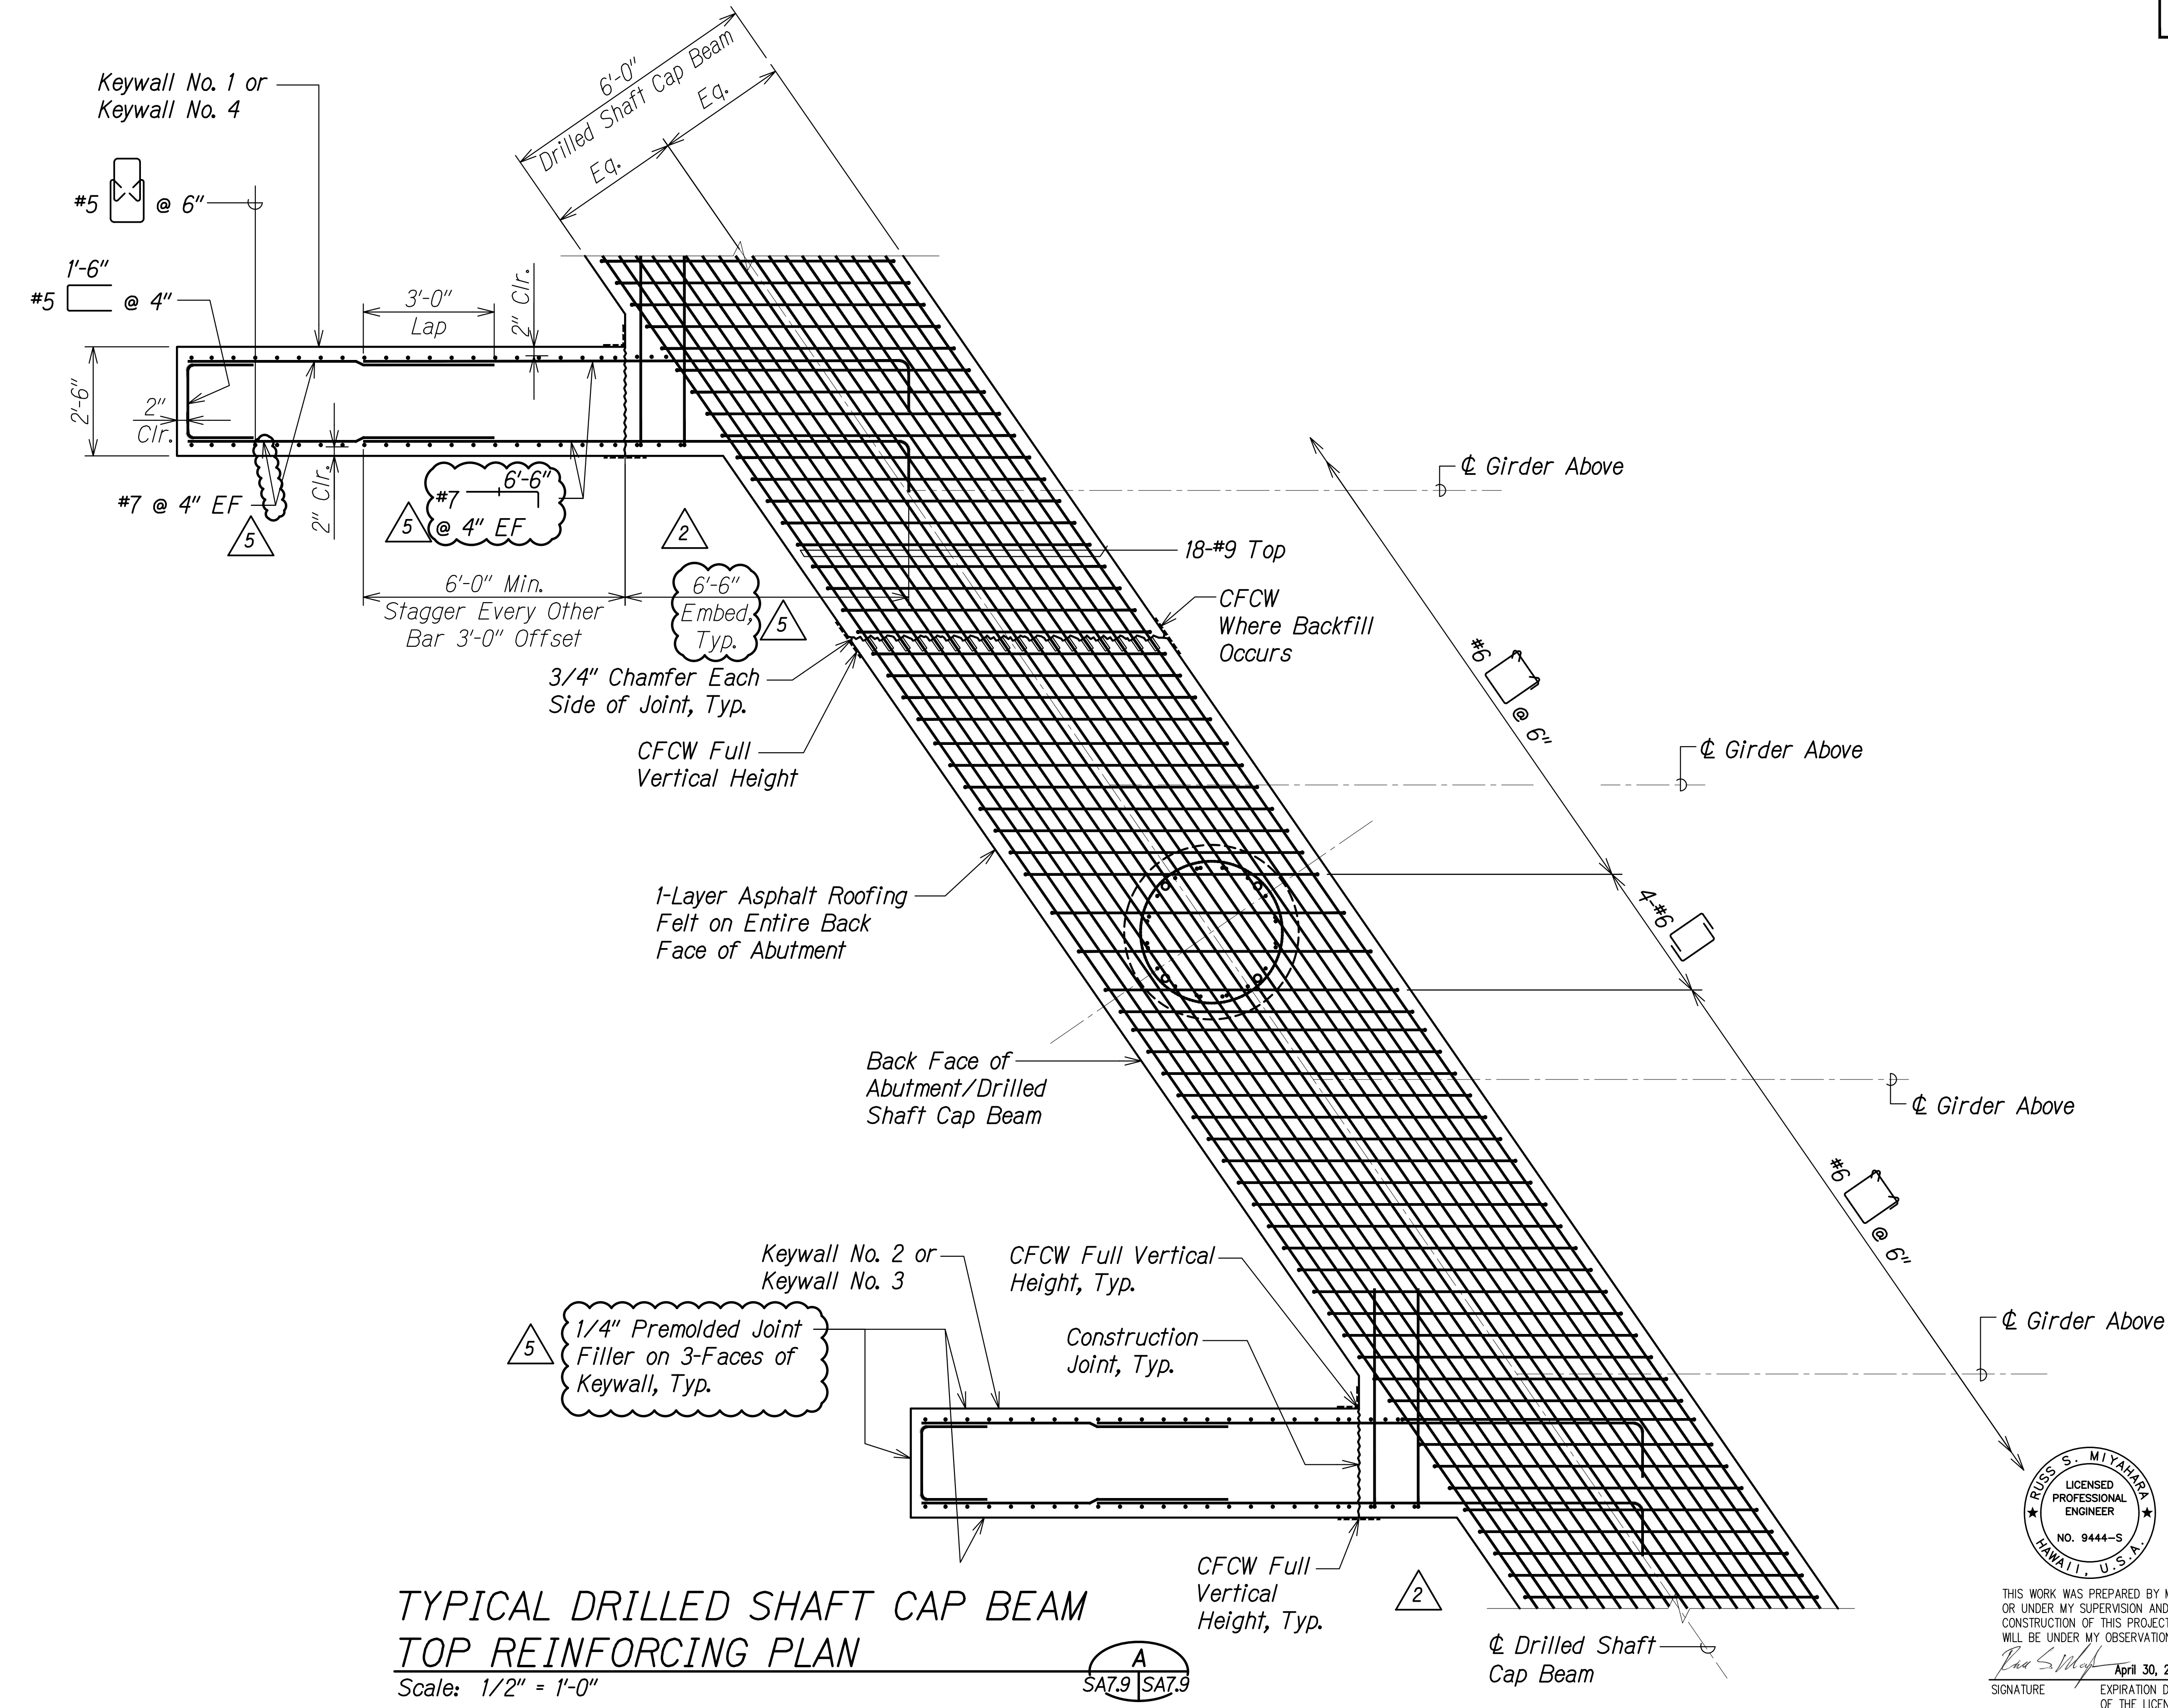


**TYPICAL DRILLED SHAFT CAP BEAM TOP REINFORCING PLAN**  
 Scale: 1/2" = 1'-0"

A  
SA7.9 SA7.9

SURVEY PLOTTED BY	DATE
DRAWN BY	
DESIGNED BY	
QUANTITIES BY	
CHECKED BY	
ORIGINAL PLAN No.	

DRAWING NAME: Z:\A00\CONCRETE\20-013-FARR-HWY-KAPOLEI-GC-10-11-WR-EMT\01-CAD\07-15-22-ADD1-DELAG\EMTS-S40708-ABUT1-PLAN-ADD1-DELAG.DWG PLOT TIME: 07-15-22 4:50 PM

DATE	REVISION
07/15/22	5 Revised Reinforcing
06/08/22	2 Added Reinforcing

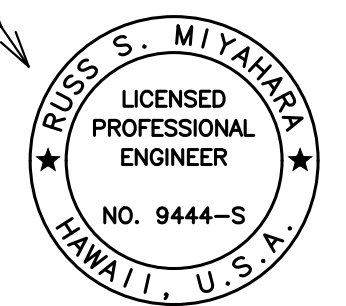

THIS WORK WAS PREPARED BY ME OR UNDER MY SUPERVISION AND CONSTRUCTION OF THIS PROJECT WILL BE UNDER MY OBSERVATION.  
 Signature: *Rugo S. Miyahara*  
 April 30, 2024  
 EXPIRATION DATE OF THE LICENSE

STATE OF HAWAII  
 DEPARTMENT OF TRANSPORTATION  
 HIGHWAYS DIVISION


**Honouliuli Stream Bridge Abutment Reinforcing Plan**

FARRINGTON HIGHWAY WIDENING  
 Kapolei Golf Course Road to Fort Weaver Road  
 Project No. 7101A-01-20

Scale: As Shown Date: Apr. 2022



FED. ROAD DIST. NO.	STATE	PROJ. NO.	FISCAL YEAR	SHEET NO.	TOTAL SHEETS
HAWAII	HAW.	7101A-01-20	2021	ADD. 380	

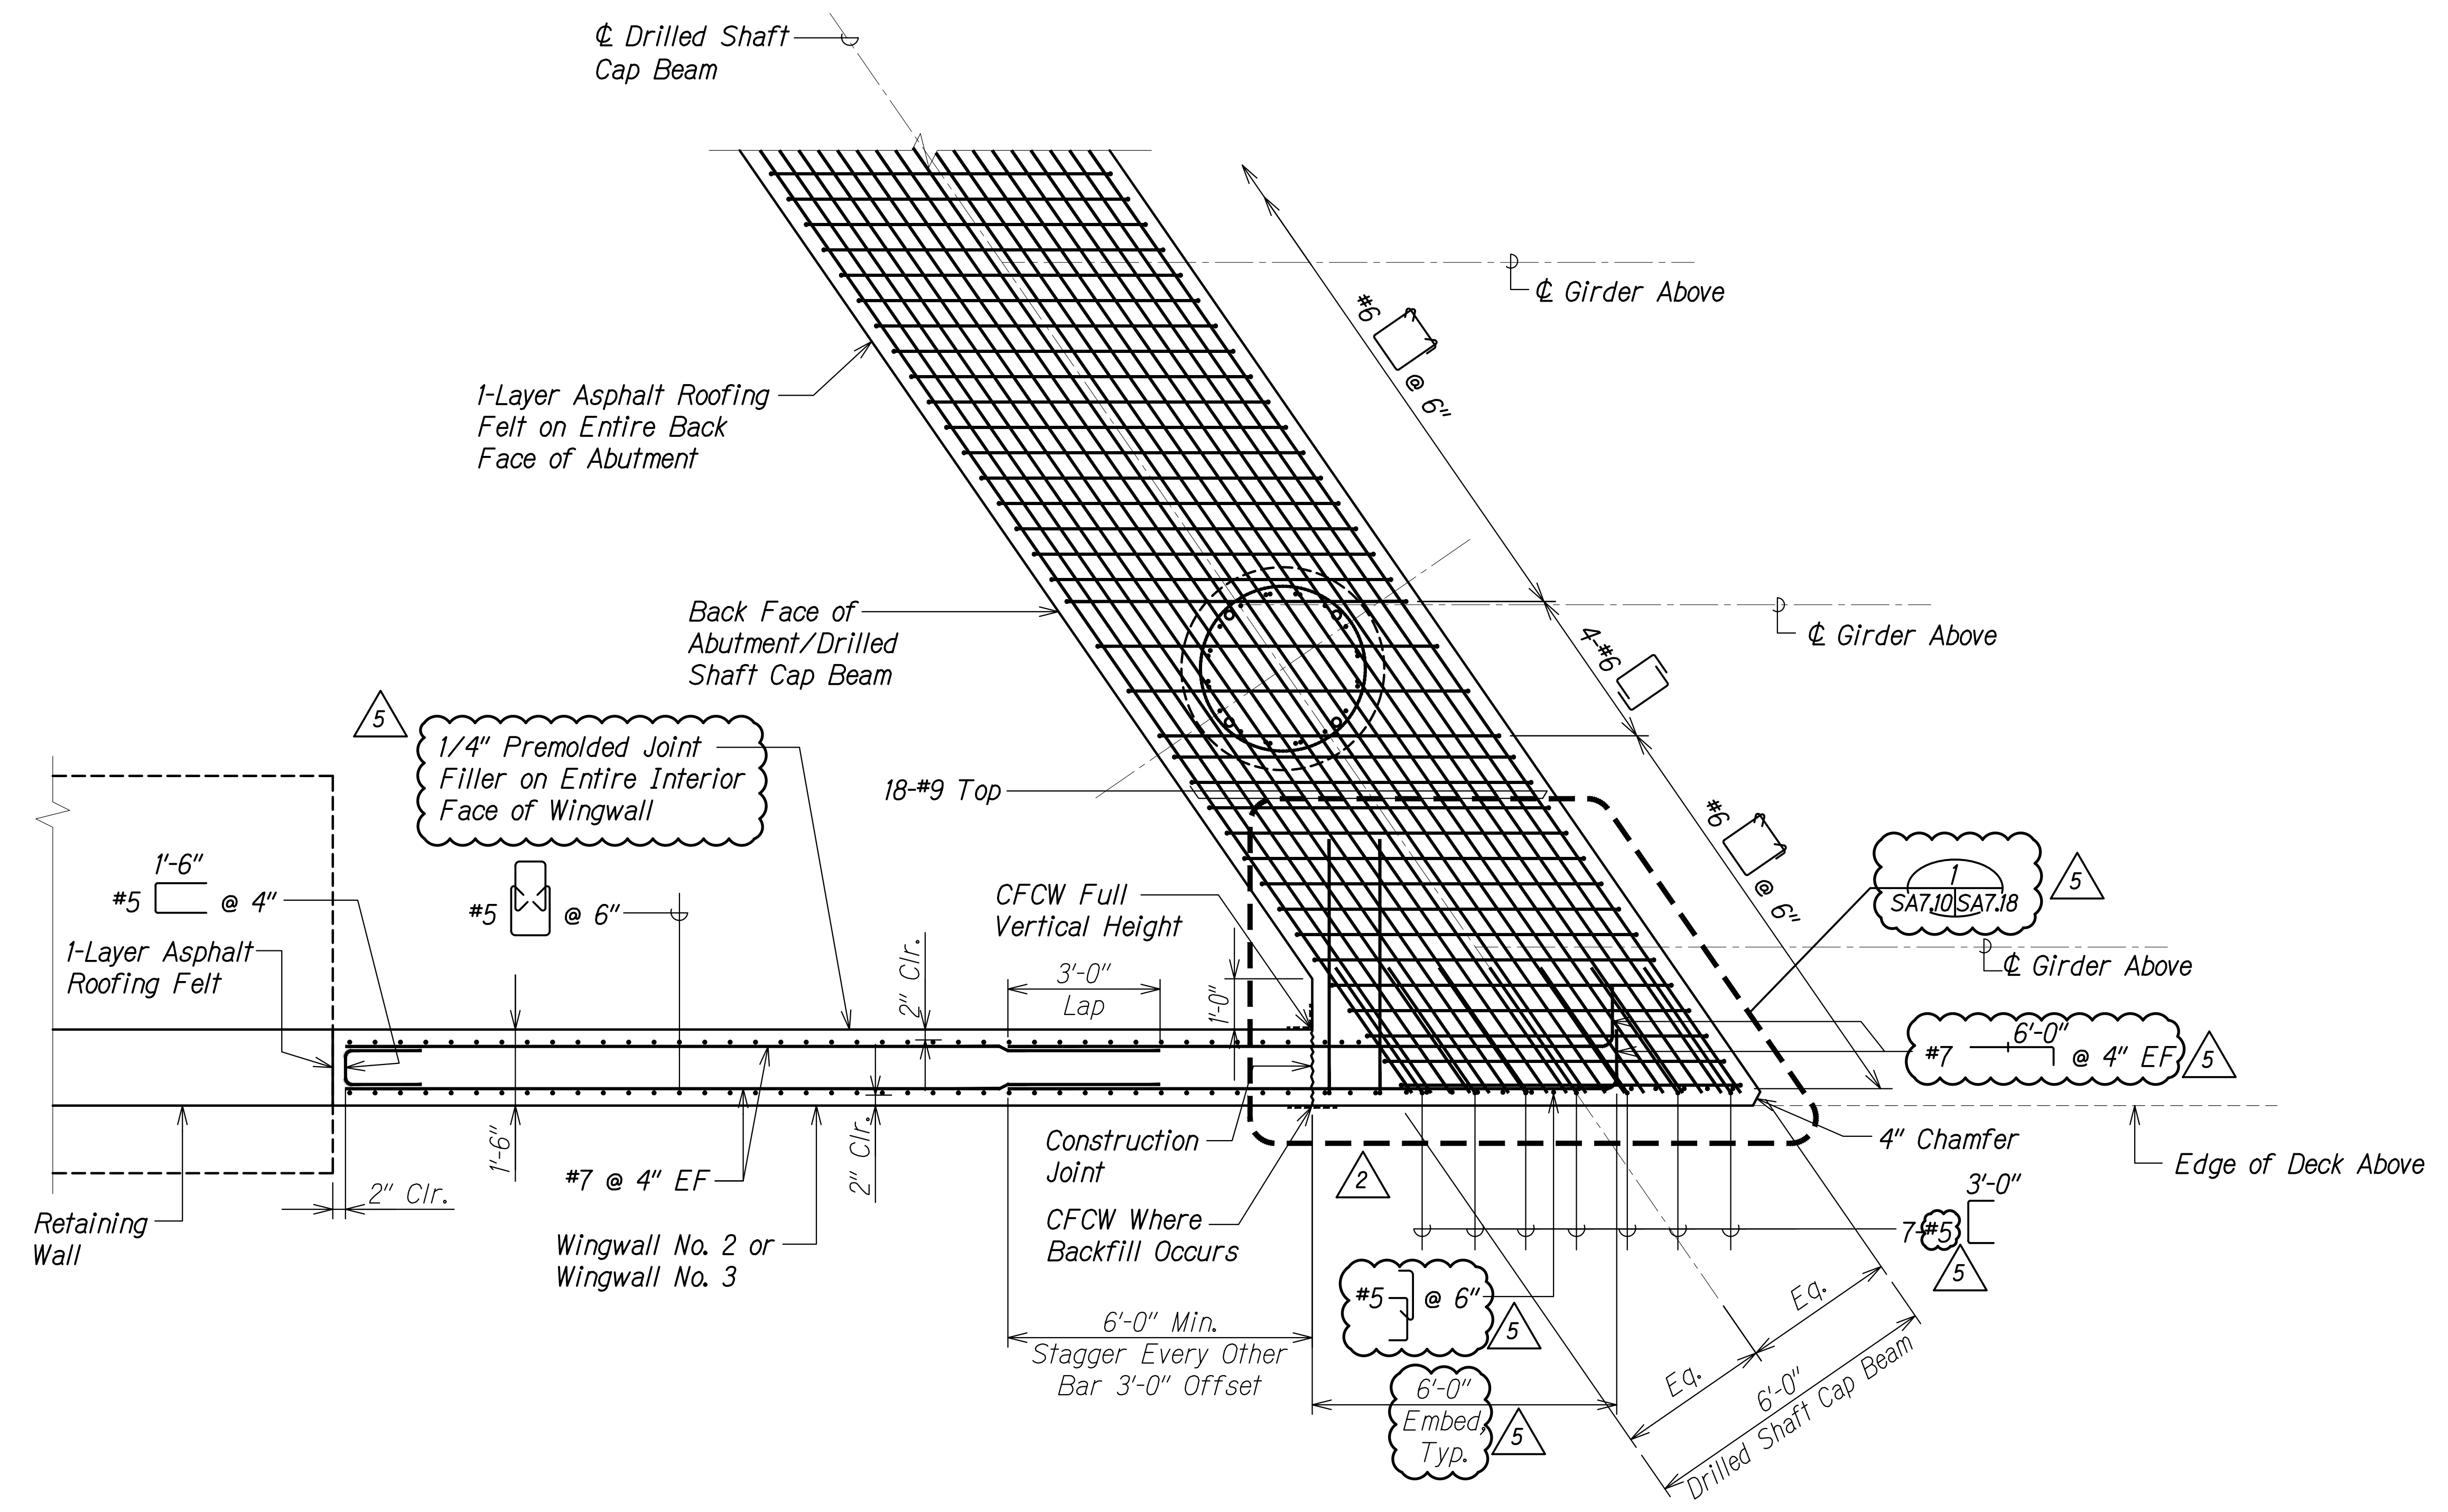


**TYPICAL DRILLED SHAFT CAP BEAM  
TOP REINFORCING PLAN**  
Scale: 1/2" = 1'-0"

ORIGINAL PLAN	DATE
SURVEY PLOTTED BY	
DRAWN BY	
DESIGNED BY	
QUANTITIES BY	
CHECKED BY	

DRAWING NAME: Z:\A\00\ONDONGS\20-013-FARR-HW-KAPOLEI.GE.ID.IT.WPR-EMTC\01-CAD\07-15-22-ADD1-DELAGS\HWIS-S&D\08-ABUTT-PLAN-ADD1-DELAGS.DWG PLOT TIME: 07-15-22 4:50 PM


THIS WORK WAS PREPARED BY ME OR UNDER MY SUPERVISION AND CONSTRUCTION OF THIS PROJECT WILL BE UNDER MY OBSERVATION.  
*Paul S. Miyahara*  
April 30, 2024  
SIGNATURE EXPIRATION DATE OF THE LICENSE

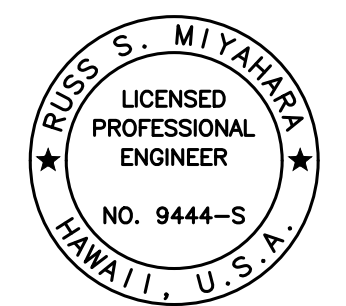

DATE	REVISION
07/15/22	5 Revised Reinforcing
06/08/22	2 Added Reinforcing

STATE OF HAWAII  
DEPARTMENT OF TRANSPORTATION  
HIGHWAYS DIVISION  
**Honouliuli Stream Bridge  
Abutment Reinforcing Plan**  
FARRINGTON HIGHWAY WIDENING  
Kapolei Golf Course Road to Fort Weaver Road  
Project No. 7101A-01-20  
Scale: As Shown Date: Apr. 2022  
SHEET No. SA7.10 OF 20 SHEETS

FED. ROAD DIST. NO.	STATE	PROJ. NO.	FISCAL YEAR	SHEET NO.	TOTAL SHEETS
HAWAII	HAW.	7101A-01-20	2021	ADD. 381	

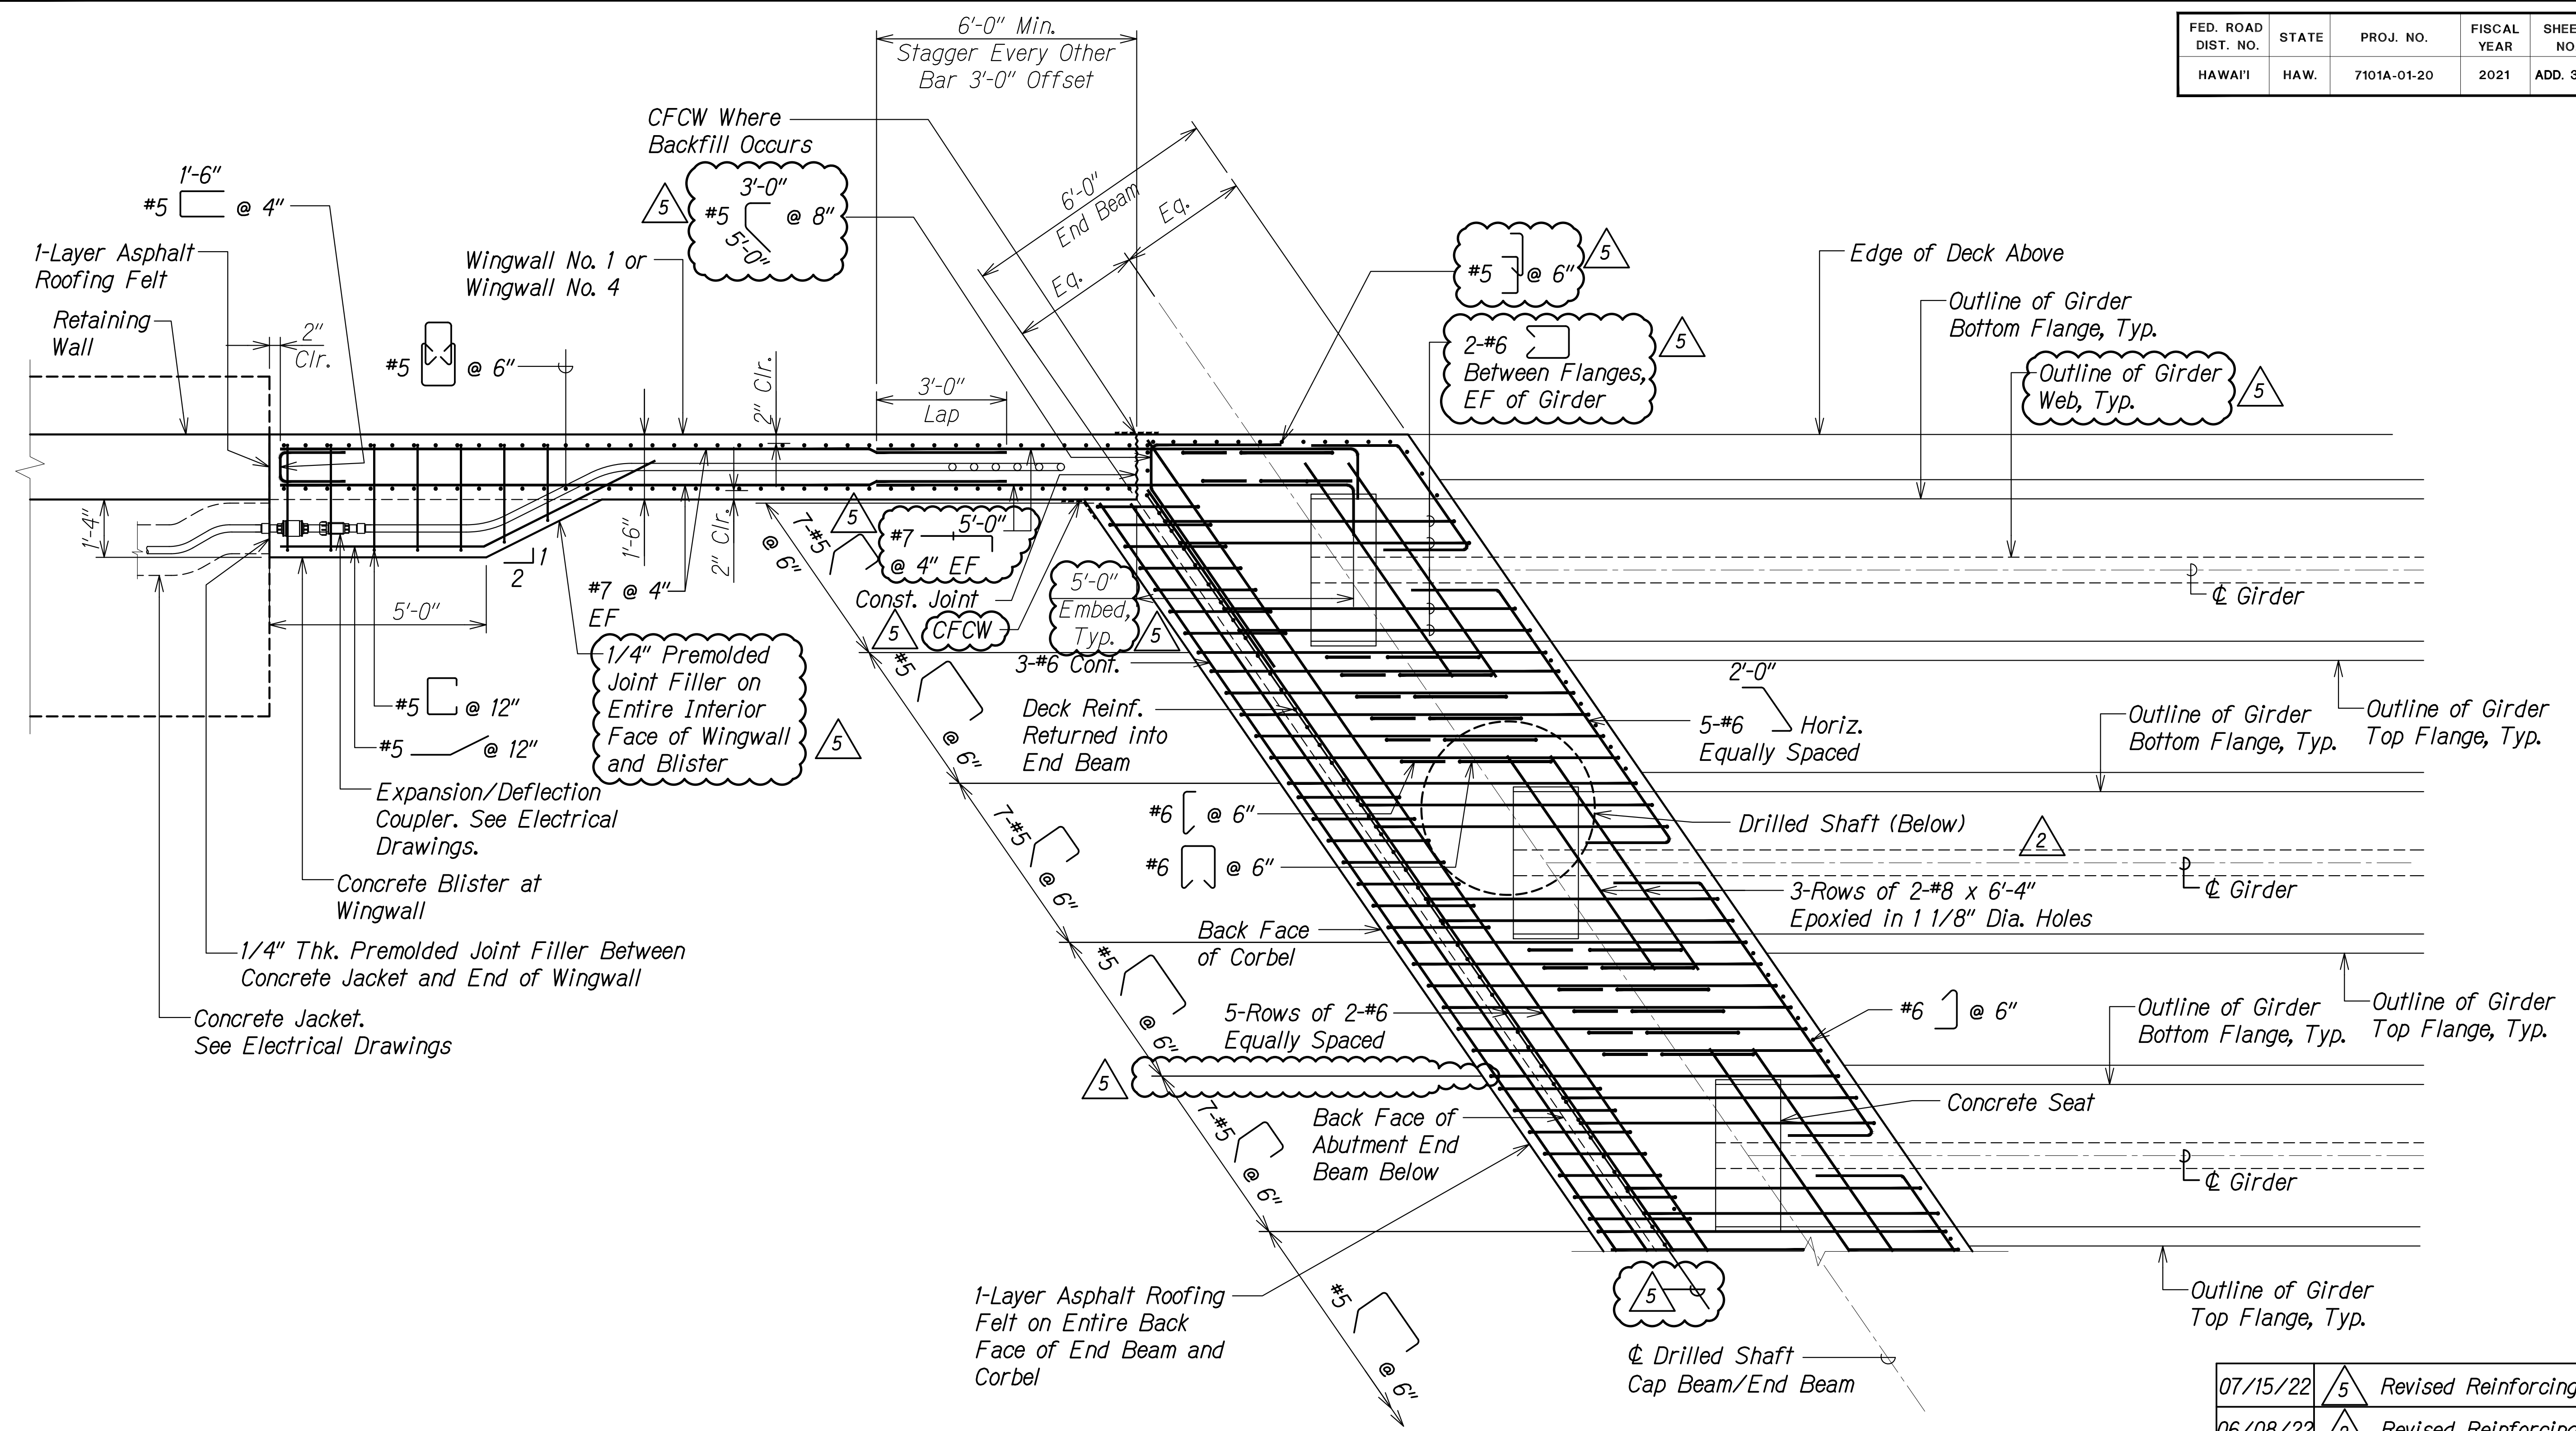


**TYPICAL END BEAM REINFORCING PLAN** A  
 Scale: 1/2" = 1'-0"  
 SA7.11 SA7.11

ORIGINAL PLAN	DATE
DRAWN BY	
DESIGNED BY	
QUANTITIES BY	
CHECKED BY	


DRAWING NAME: Z:\00 UNDOING\20-013-FARR-HW KAPOLEI GC ID ET WIP-BRIDGE\01 CAD\07-15-22 ADD1 DELAS\THW3-S40711 ABUT-PLAN-ADD1 DELAS.DWG PLOT TIME: 07-15-22 4:51 PM

THIS WORK WAS PREPARED BY ME OR UNDER MY SUPERVISION AND CONSTRUCTION OF THIS PROJECT WILL BE UNDER MY OBSERVATION.  
 Signature: *Paul S. Miyahara*  
 April 30, 2024  
 EXPIRATION DATE OF THE LICENSE

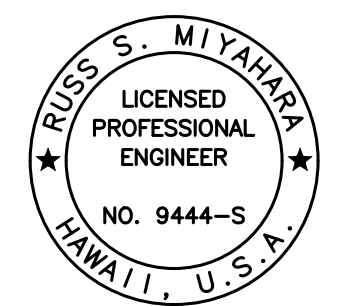

07/15/22	5	Revised Reinforcing
06/08/22	2	Revised Reinforcing Length
DATE	REVISION	
STATE OF HAWAII <b>DEPARTMENT OF TRANSPORTATION</b> HIGHWAYS DIVISION <b>Honouliuli Stream Bridge</b> <b>Abutment Reinforcing Plan</b> FARRINGTON HIGHWAY WIDENING Kapolei Golf Course Road to Fort Weaver Road Project No. 7101A-01-20 Scale: As Shown Date: Apr. 2022 <b>SHEET No. SA7.11 OF 20 SHEETS</b>		

FED. ROAD DIST. NO.	STATE	PROJ. NO.	FISCAL YEAR	SHEET NO.	TOTAL SHEETS
HAWAII	HAW.	7101A-01-20	2021	ADD. 382	

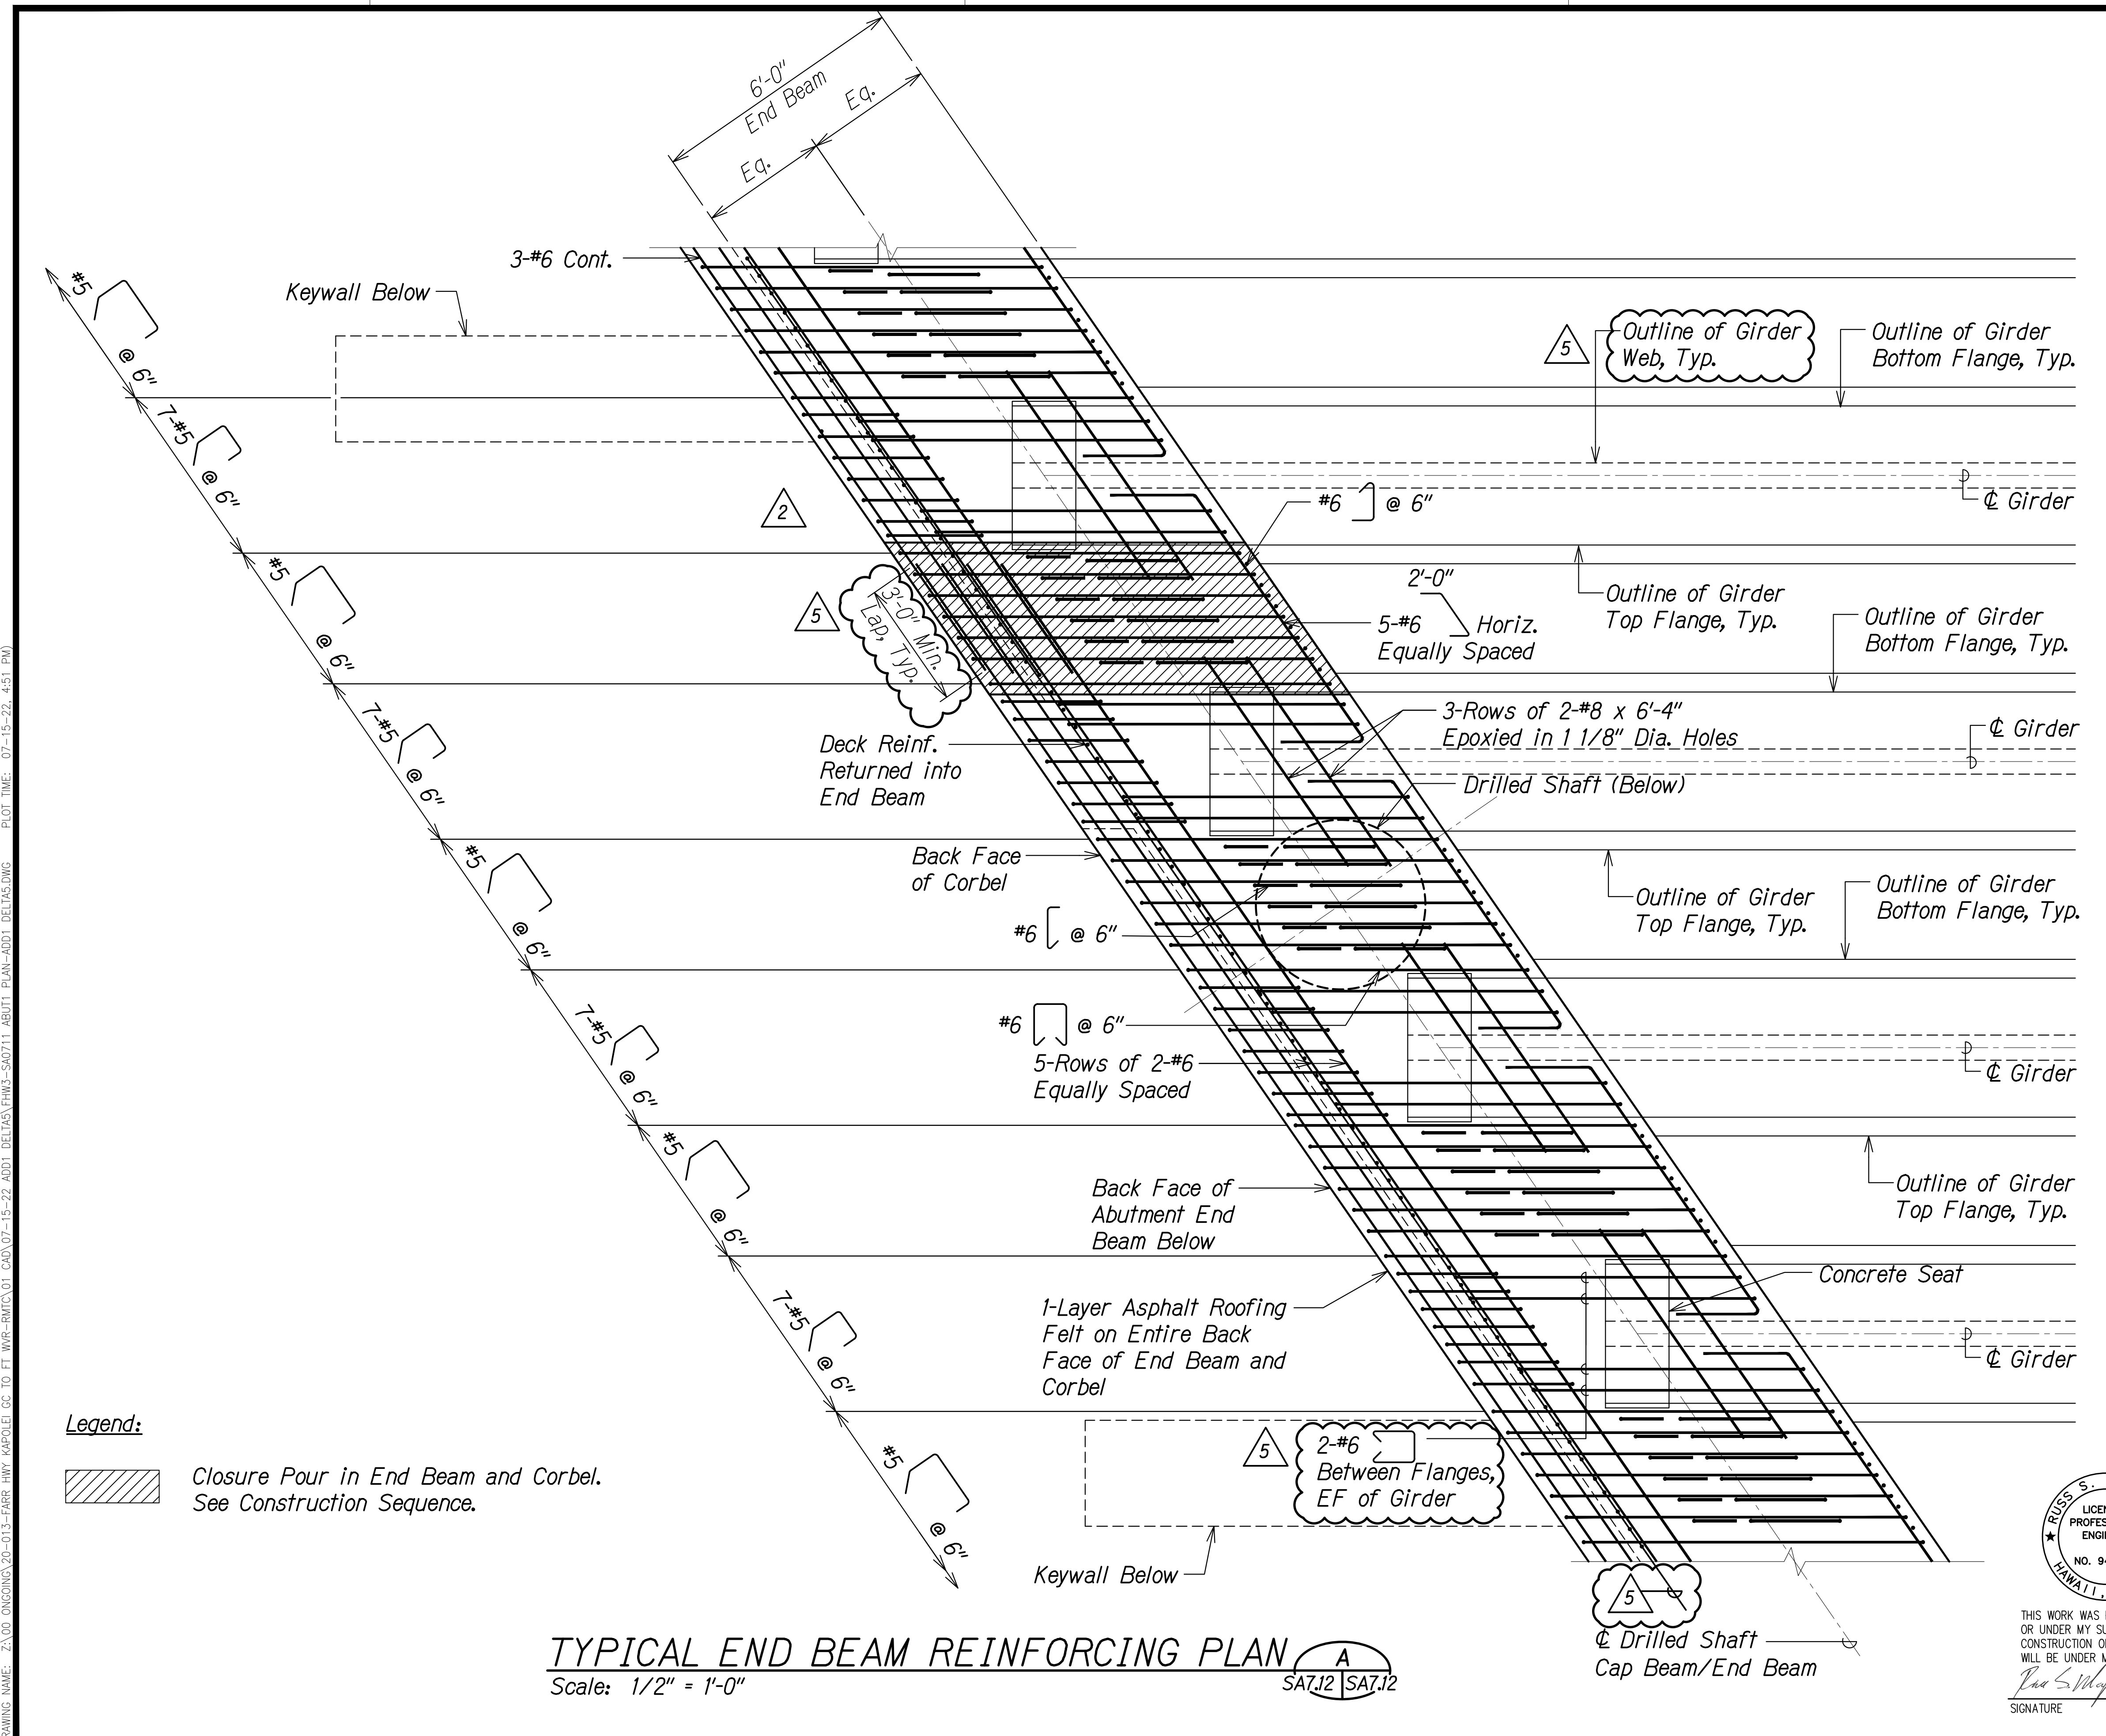

DRAWING NAME: Z:\ADD\CONCRETE\20-013-FARR-HWY-KAPOLEI\GE.ID.IT.WIP-RMT\01.GRD\07-15-22\ADD1-DELAS\ENR3-S&D\11-ABUT1-PLAN-ADD1-DELAS.DWG PLOT TIME: 07-15-22 4:51 PM


SURVEY PLOTTED BY	DATE
DRAWN BY	
DESIGNED BY	
QUANTITIES BY	
CHECKED BY	
ORIGINAL PLAN	
NOTE BOOK	
No.	

**Legend:**

Closure Pour in End Beam and Corbel. See Construction Sequence.

**TYPICAL END BEAM REINFORCING PLAN** A  
 Scale: 1/2" = 1'-0" SA7.12 | SA7.12

07/15/22	<span style="border: 1px solid black; padding: 2px;">5</span>	Revised Reinforcing
06/08/22	<span style="border: 1px solid black; padding: 2px;">2</span>	Clarified Lap Location
DATE	REVISION	

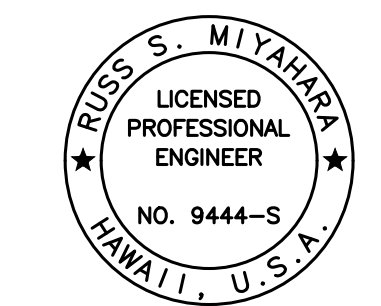

THIS WORK WAS PREPARED BY ME OR UNDER MY SUPERVISION AND CONSTRUCTION OF THIS PROJECT WILL BE UNDER MY OBSERVATION.  
 Signature: *Russ S. Miyahara*  
 April 30, 2024  
 EXPIRATION DATE OF THE LICENSE

STATE OF HAWAII  
 DEPARTMENT OF TRANSPORTATION  
 HIGHWAYS DIVISION


**Honouliuli Stream Bridge  
 Abutment Reinforcing Plan**

FARRINGTON HIGHWAY WIDENING  
 Kapolei Golf Course Road to Fort Weaver Road  
 Project No. 7101A-01-20

Scale: As Shown Date: Apr. 2022

**SHEET No. SA7.12 OF 20 SHEETS**

FED. ROAD DIST. NO.	STATE	PROJ. NO.	FISCAL YEAR	SHEET NO.	TOTAL SHEETS
HAWAII	HAW.	7101A-01-20	2021	ADD. 383	

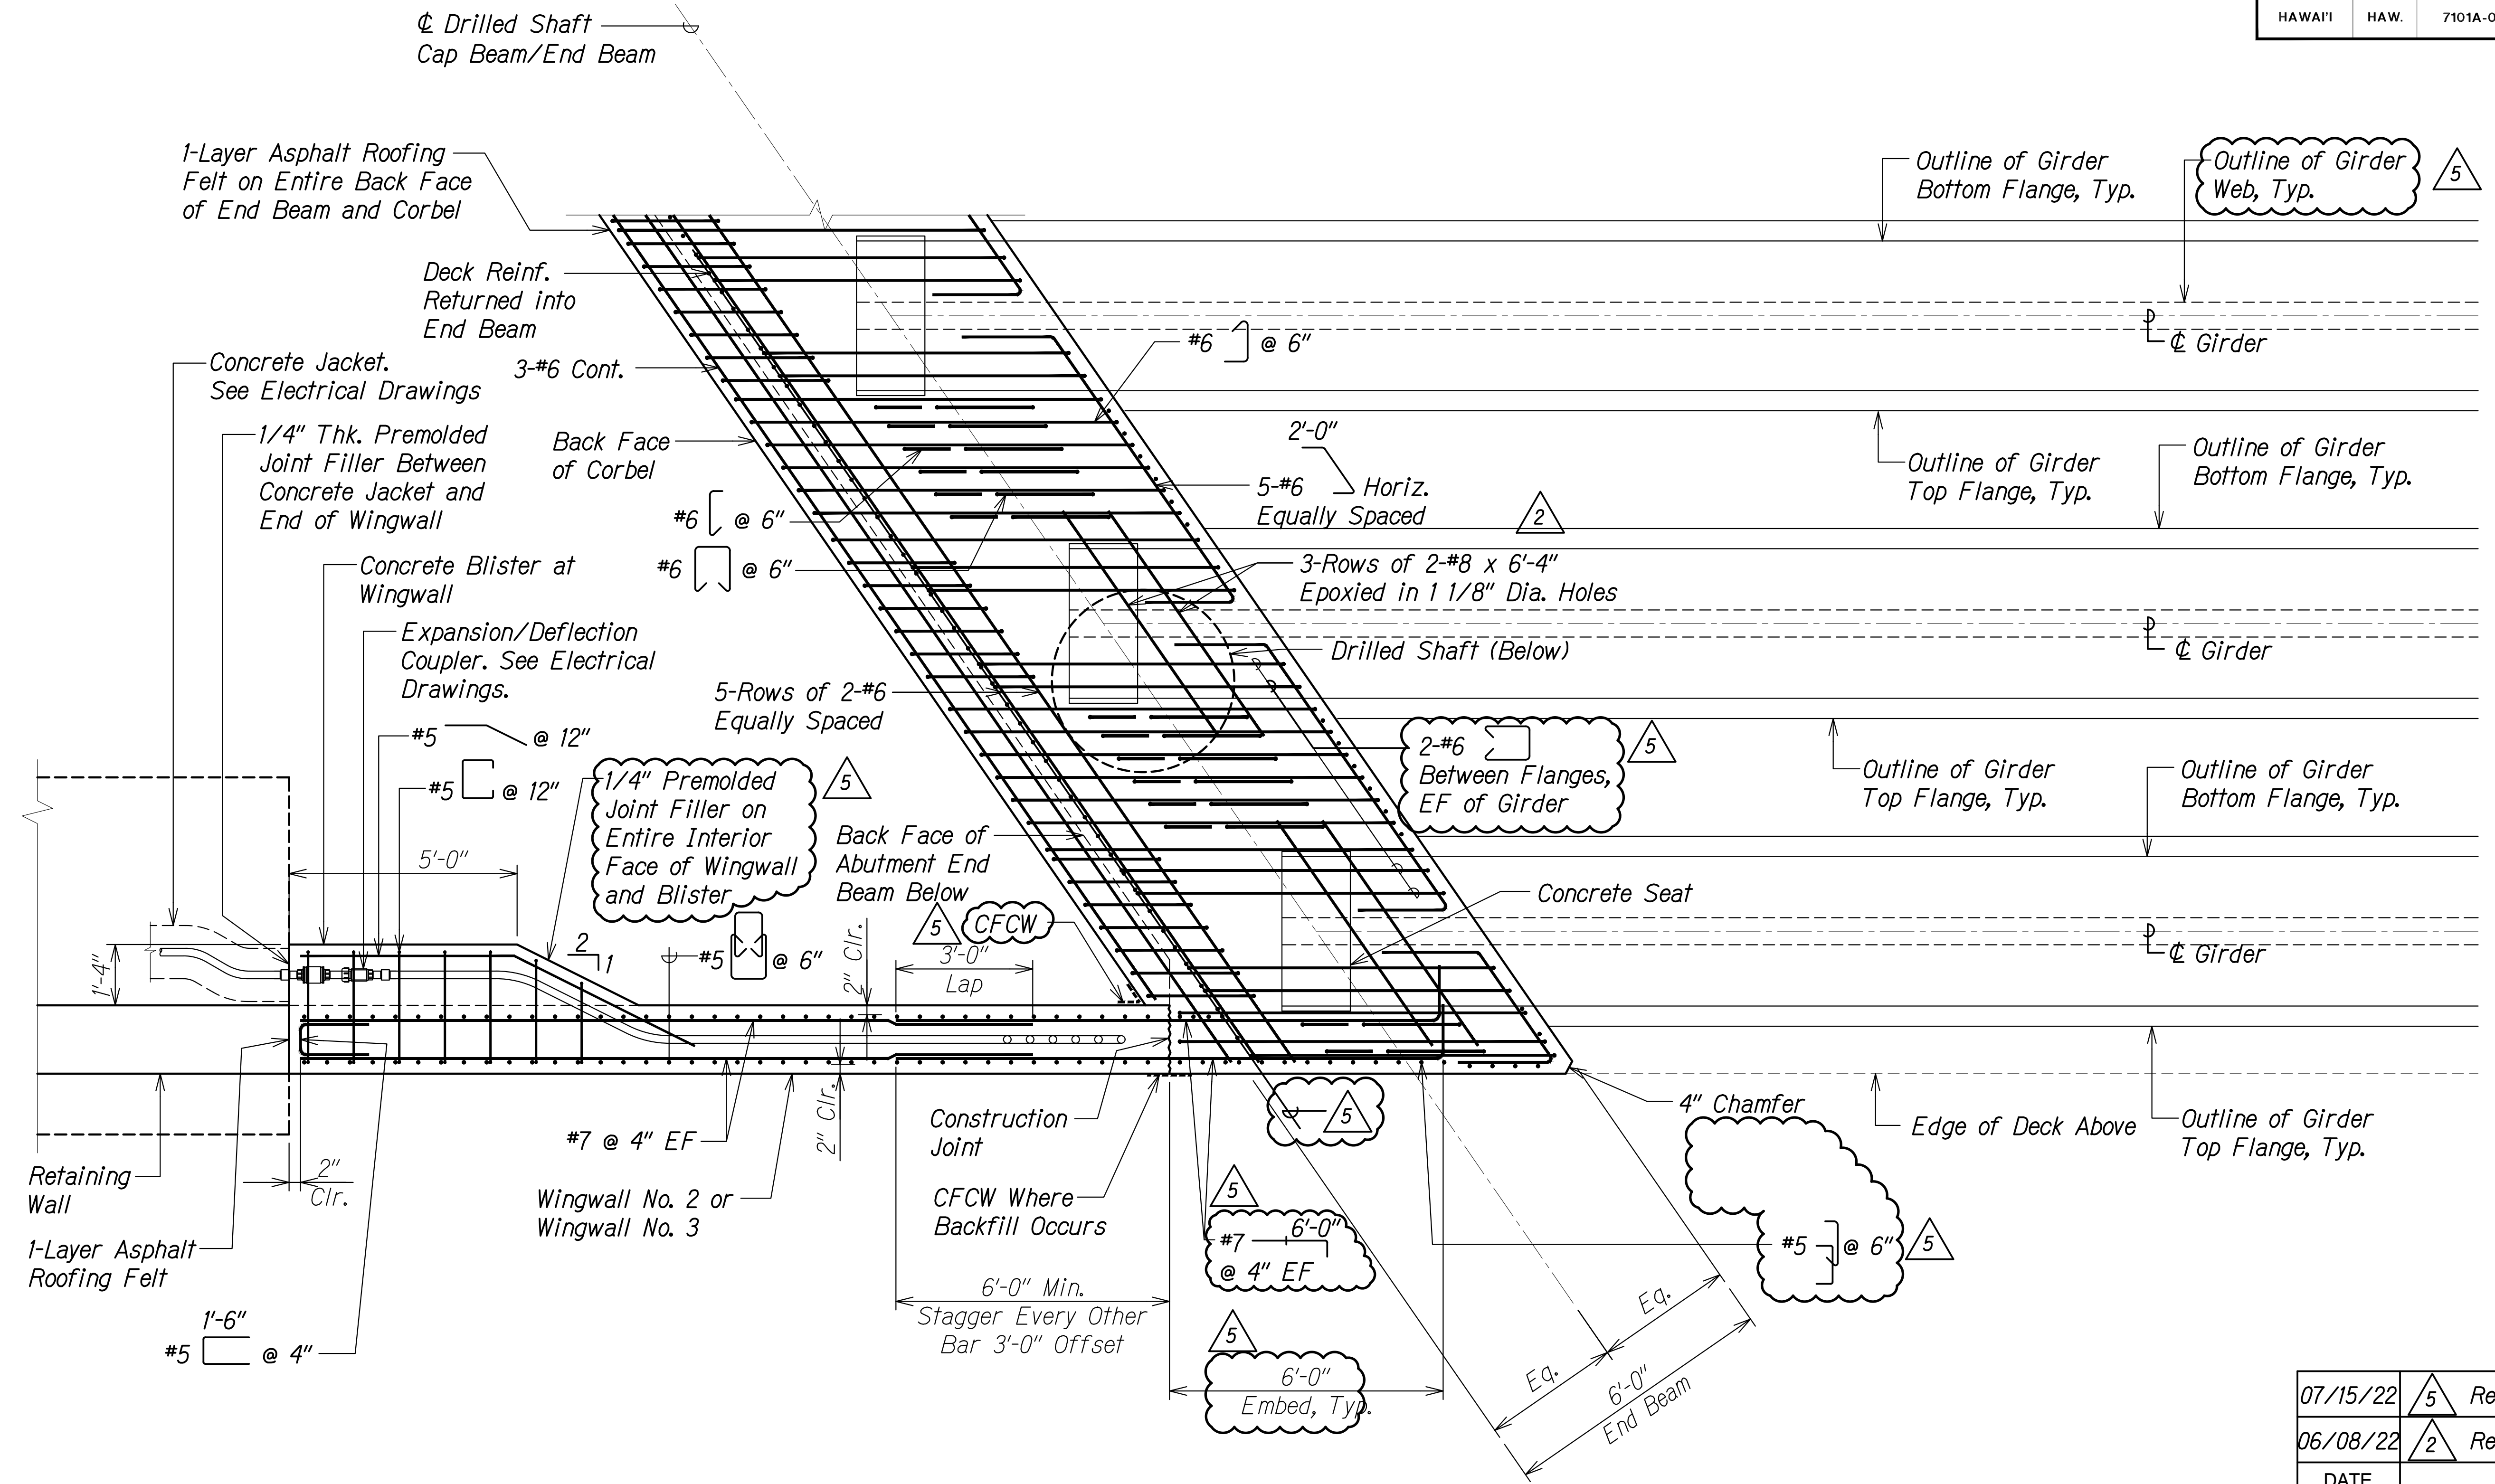


**TYPICAL END BEAM REINFORCING PLAN**  
 Scale: 1/2" = 1'-0"  
 SA7.13 SA7.13

SURVEY PLOTTED BY	DATE
DRAWN BY	
DESIGNED BY	
QUANTITIES BY	
CHECKED BY	
ORIGINAL PLAN	
NOTE BOOK	
No.	

DRAWING NAME: Z:\A00 UNDOINGS\20-013-FARR-HWY-KAPOLEI.GE.ID.IT.WIP-PRINT\01 CAD\07-15-22 ADD1 DELAS\THWS-S40711 ABUT1 PLAN-ADD1 DELAS.DWG PLOT TIME: 07-15-22 4:52 PM

07/15/22	5	Revised Reinforcing
06/08/22	2	Revised Reinforcing Length
DATE		REVISION

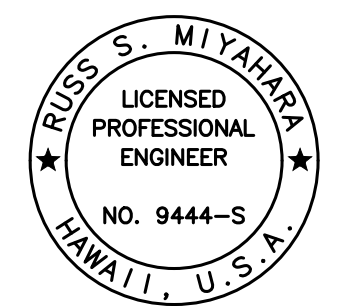

THIS WORK WAS PREPARED BY ME OR UNDER MY SUPERVISION AND CONSTRUCTION OF THIS PROJECT WILL BE UNDER MY OBSERVATION.  
 Russ S. Miyahara  
 SIGNATURE  
 April 30, 2024  
 EXPIRATION DATE OF THE LICENSE

STATE OF HAWAII  
 DEPARTMENT OF TRANSPORTATION  
 HIGHWAYS DIVISION

**Honouliuli Stream Bridge  
 Abutment Reinforcing Plan**


FARRINGTON HIGHWAY WIDENING  
 Kapolei Golf Course Road to Fort Weaver Road  
 Project No. 7101A-01-20

Scale: As Shown Date: Apr. 2022



FED. ROAD DIST. NO.	STATE	PROJ. NO.	FISCAL YEAR	SHEET NO.	TOTAL SHEETS
HAWAII	HAW.	7101A-01-20	2021	ADD. 386	

DRAWING NAME: Z:\A00\CONCRETE\20-013-FARR-HW-KAPOLEI.GD TO: IT-WR-EMT\01-CA\07-15-22-ADD1-DELAS\EMTS-S40716-HW-ABUT-SECT-ADD1-DELAS.DWG PLOT TIME: 07-15-22 6:58 PM

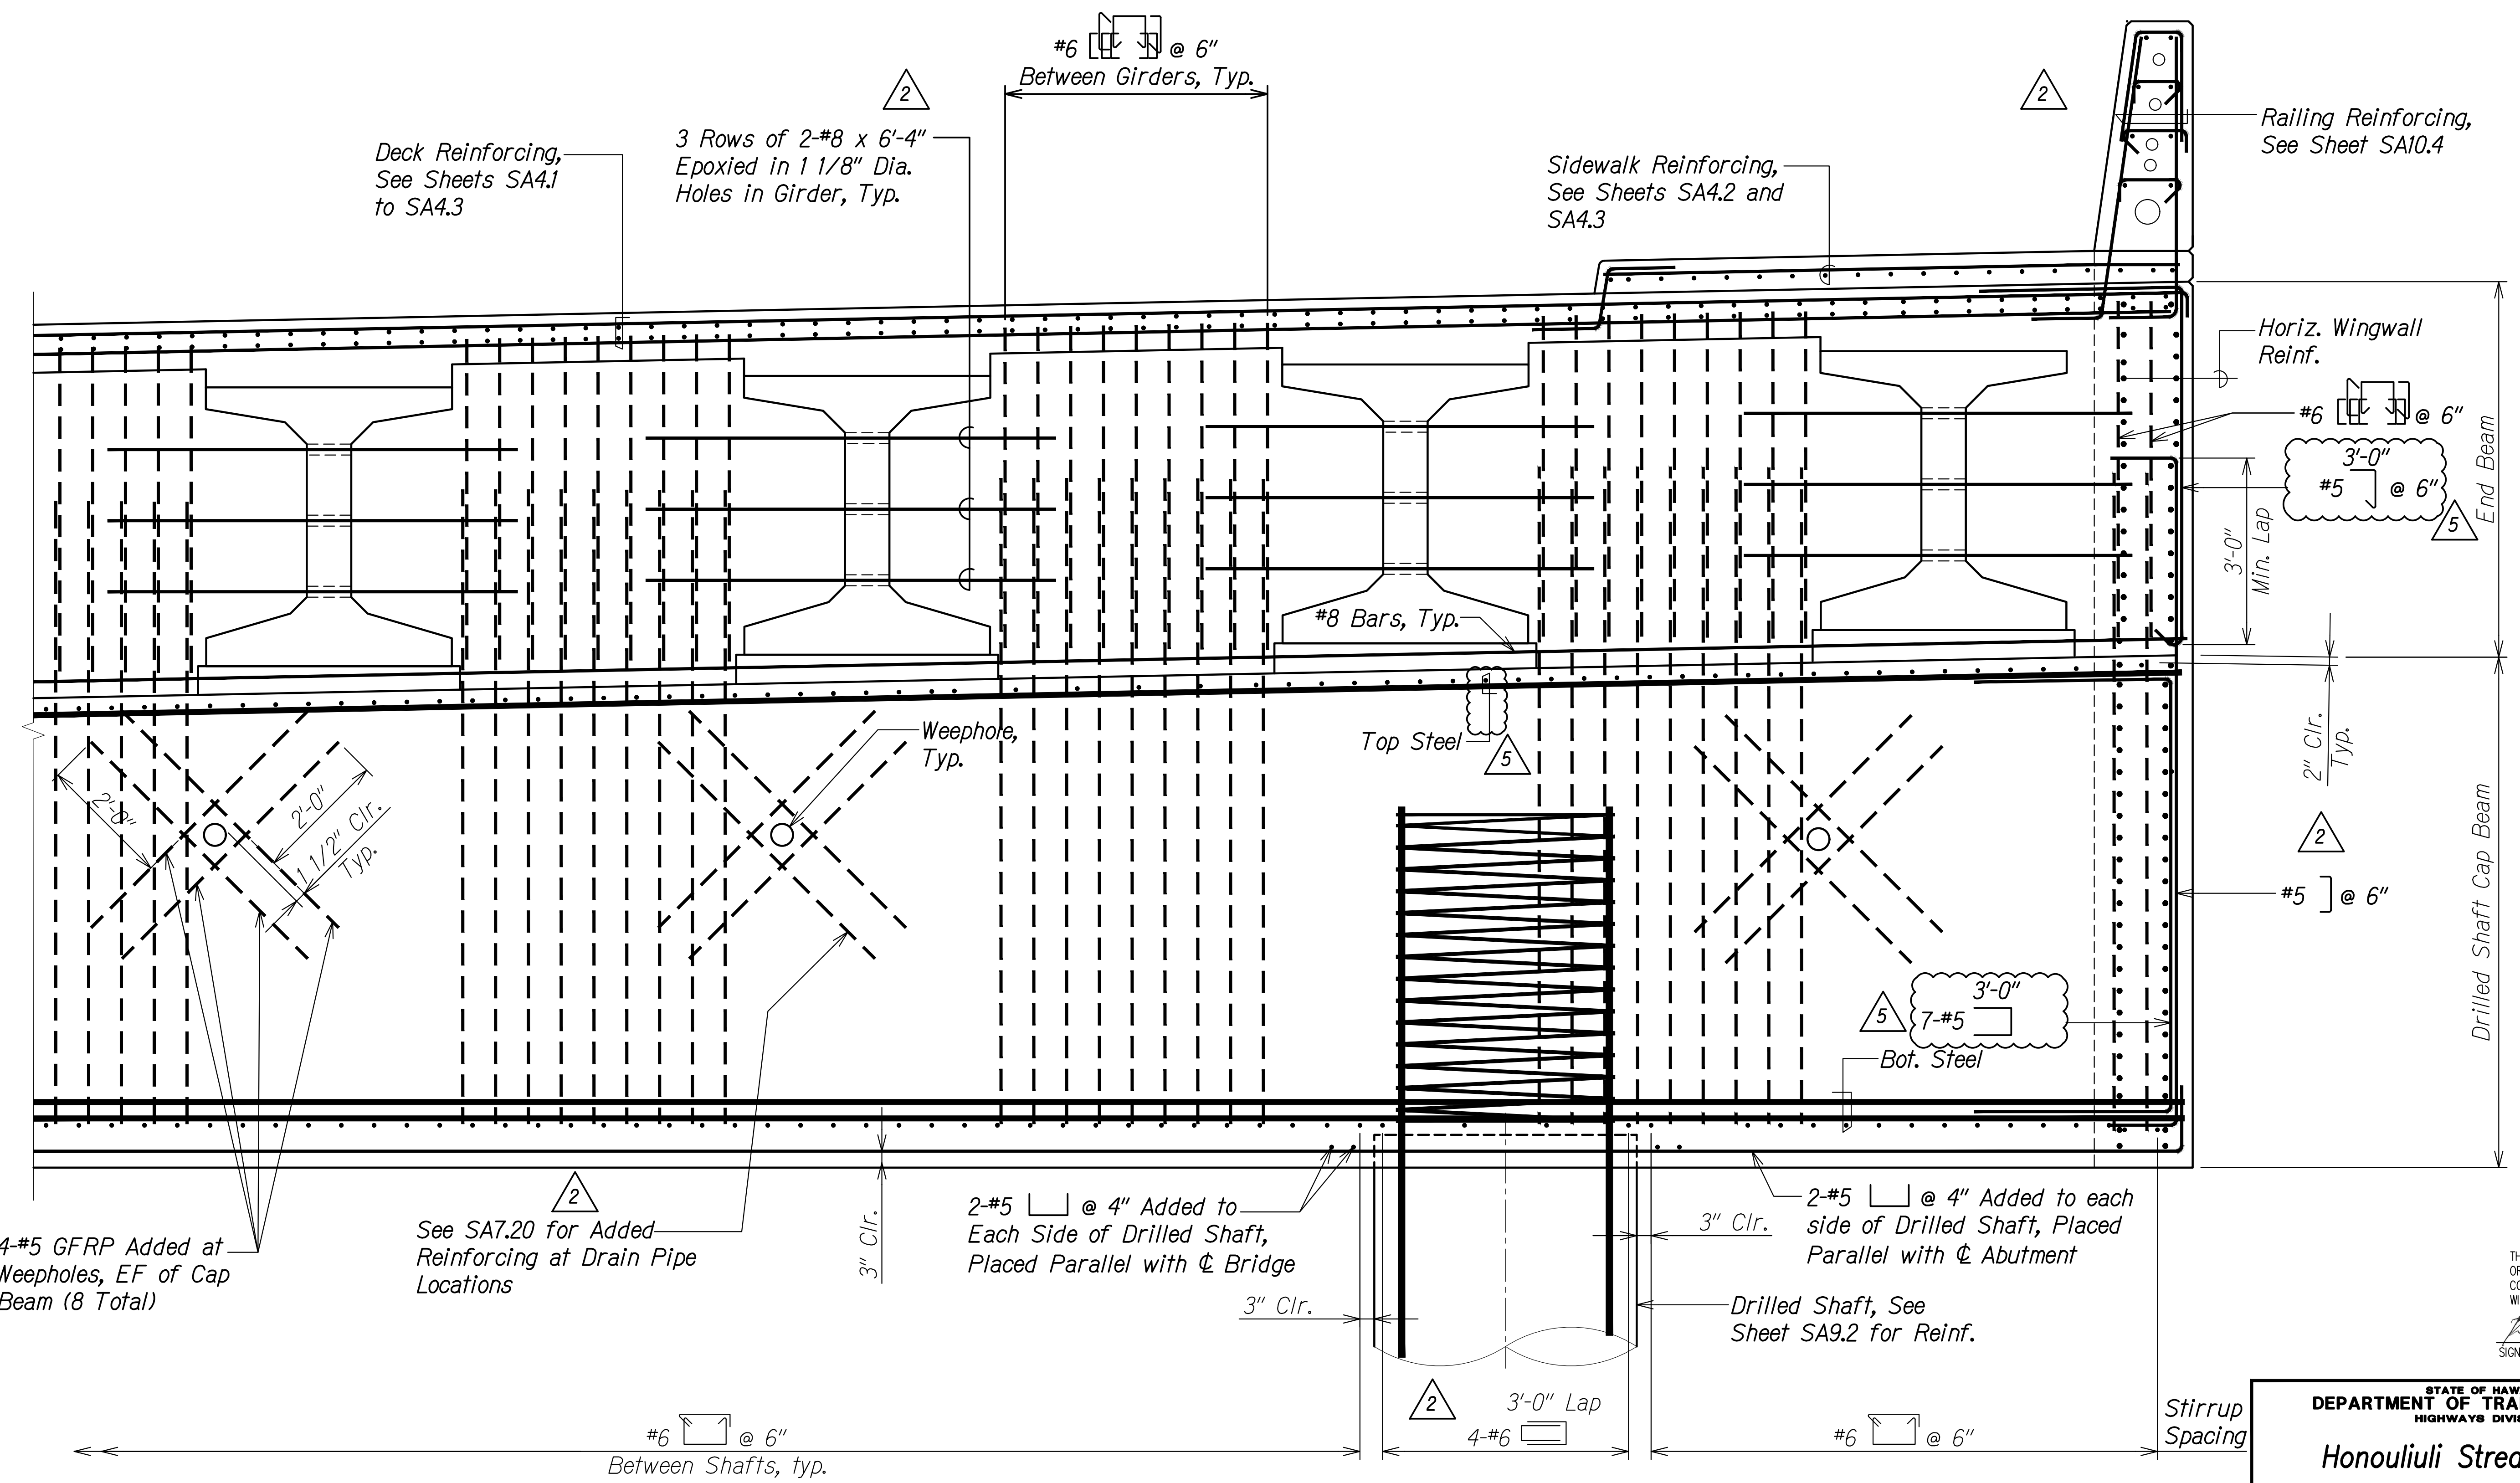

SURVEY PLOTTED BY	DATE
DRAWN BY	
DESIGNED BY	
QUANTITIES BY	
CHECKED BY	
ORIGINAL PLAN	
NOTE BOOK	
No.	

**SECTION A**  
Scale: 3/4" = 1'-0" SA7.16 SA7.16

DATE	REVISION
07/15/22	5 Revised Notes
06/08/22	2 Revised Details


STATE OF HAWAII  
DEPARTMENT OF TRANSPORTATION  
HIGHWAYS DIVISION

**Honouliuli Stream Bridge  
Abutment Section**

FARRINGTON HIGHWAY WIDENING  
Kapolei Golf Course Road to Fort Weaver Road  
Project No. 7101A-01-20

Scale: As Shown Date: Apr. 2022

**SHEET No. SA7.16 OF 20 SHEETS**

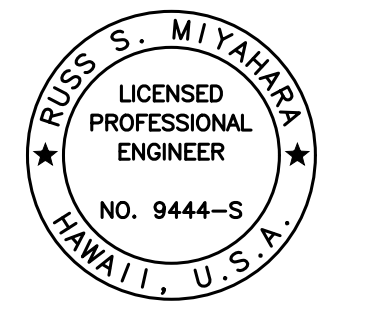


THIS WORK WAS PREPARED BY ME OR UNDER MY SUPERVISION AND CONSTRUCTION OF THIS PROJECT WILL BE UNDER MY OBSERVATION.


*Russ S. Miyahara* April 30, 2024  
SIGNATURE EXPIRATION DATE OF THE LICENSE



FED. ROAD DIST. NO.	STATE	PROJ. NO.	FISCAL YEAR	SHEET NO.	TOTAL SHEETS
HAWAII	HAW.	7101A-01-20	2021	ADD. 388	

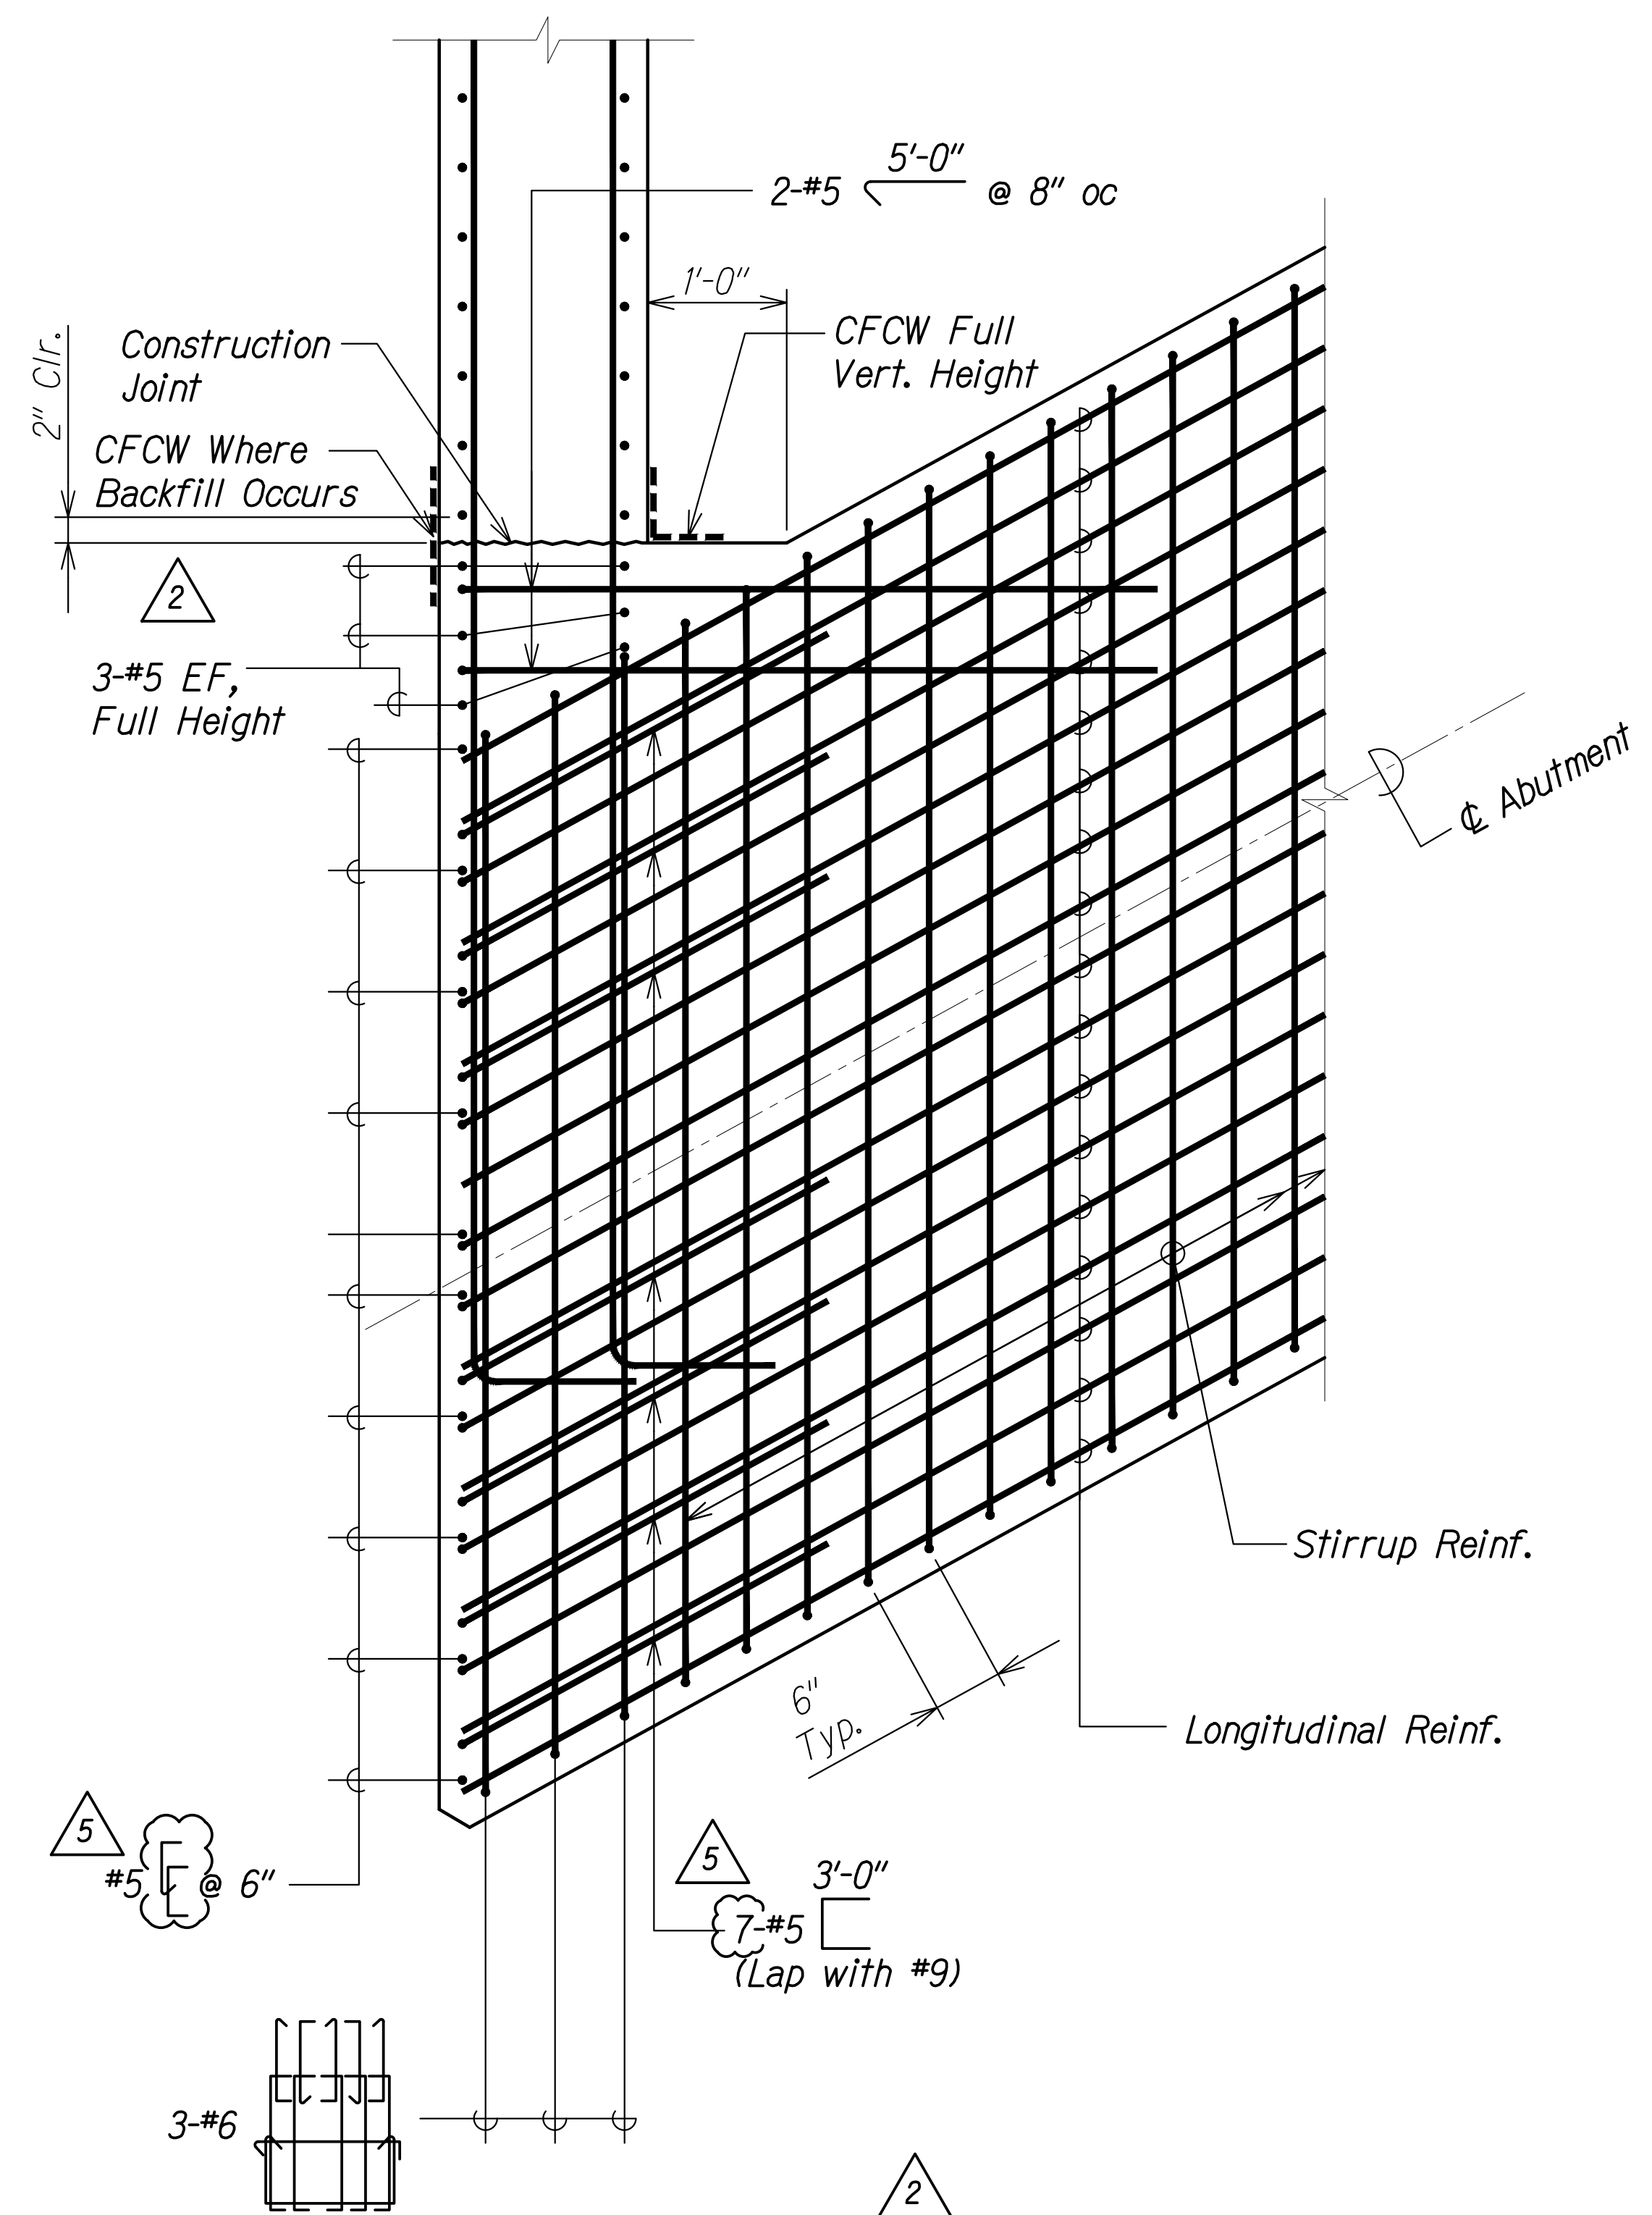

**DETAIL 1**  
Scale: 1" = 1'-0"  
SAT.10 SAT.18

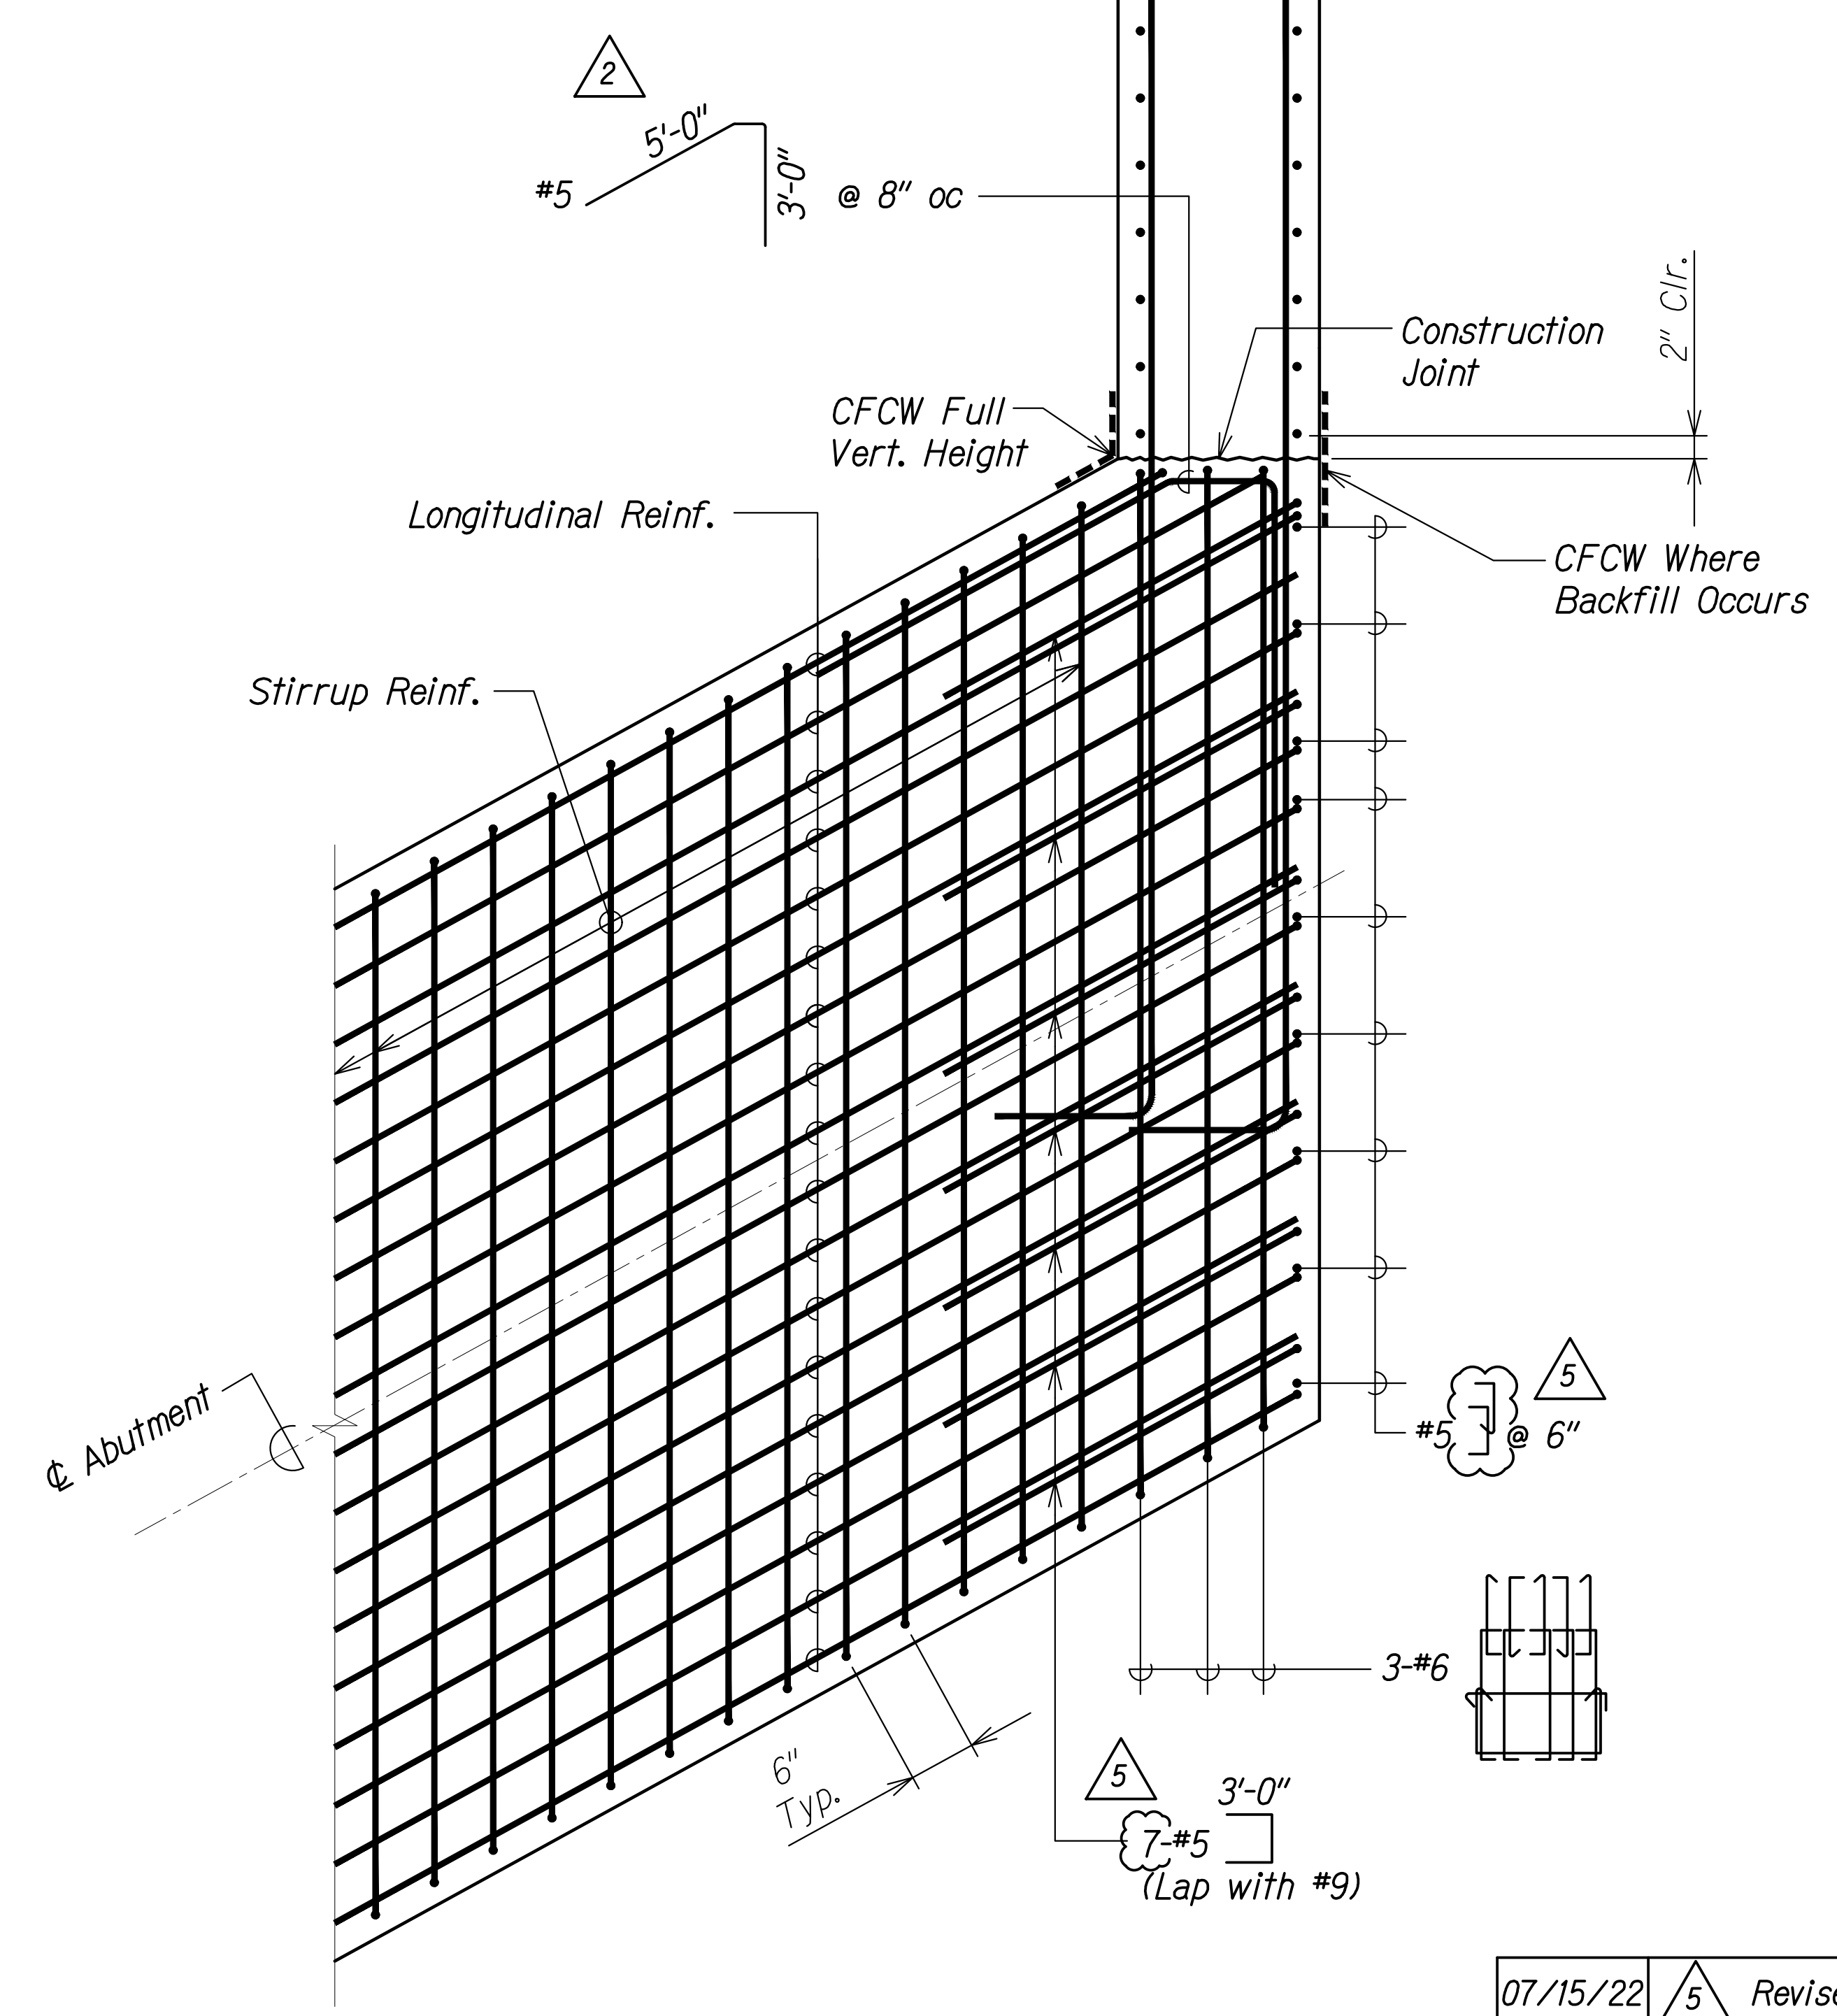

**DETAIL 2**  
Scale: 1" = 1'-0"  
SAT.8 SAT.18

SURVEY PLOTTED BY	DATE
DRAWN BY	
DESIGNED BY	
QUANTITIES BY	
CHECKED BY	
ORIGINAL PLAN	
NOTE BOOK	
No.	

DRAWING NAME: Z:\100\CONCRETE\20-013-FARR-HWY-KAPOLEI-GC-10-ET-WR-EMT\01-GAD\07-15-22-ADD1-DELAGS\EMHS-S40718-HWY-ABUTL-REINF-ADD1-DELAGS.DWG PLOT TIME: 07-15-22, 5:05 PM


**RUS S. MIYAHARA**  
LICENSED PROFESSIONAL ENGINEER  
NO. 9444-S  
HAWAII, U.S.A.

THIS WORK WAS PREPARED BY ME OR UNDER MY SUPERVISION AND CONSTRUCTION OF THIS PROJECT WILL BE UNDER MY OBSERVATION.


*Rus S. Miyahara*  
SIGNATURE  
April 30, 2024  
EXPIRATION DATE OF THE LICENSE

07/15/22	5	Revised Details
06/08/22	2	Revised Reinforcing
DATE		REVISION
STATE OF HAWAII <b>DEPARTMENT OF TRANSPORTATION</b> HIGHWAYS DIVISION <b>Honouliuli Stream Bridge</b> <b>Abutment Details</b> FARRINGTON HIGHWAY WIDENING Kapolei Golf Course Road to Fort Weaver Road Project No. 7101A-01-20 Scale: As Shown Date: Apr. 2022		
<b>SHEET No. SA7.18 OF 20 SHEETS</b>		

FED. ROAD DIST. NO.	STATE	PROJ. NO.	FISCAL YEAR	SHEET NO.	TOTAL SHEETS
HAWAII	HAW.	7101A-01-20	2021	ADD. 391	

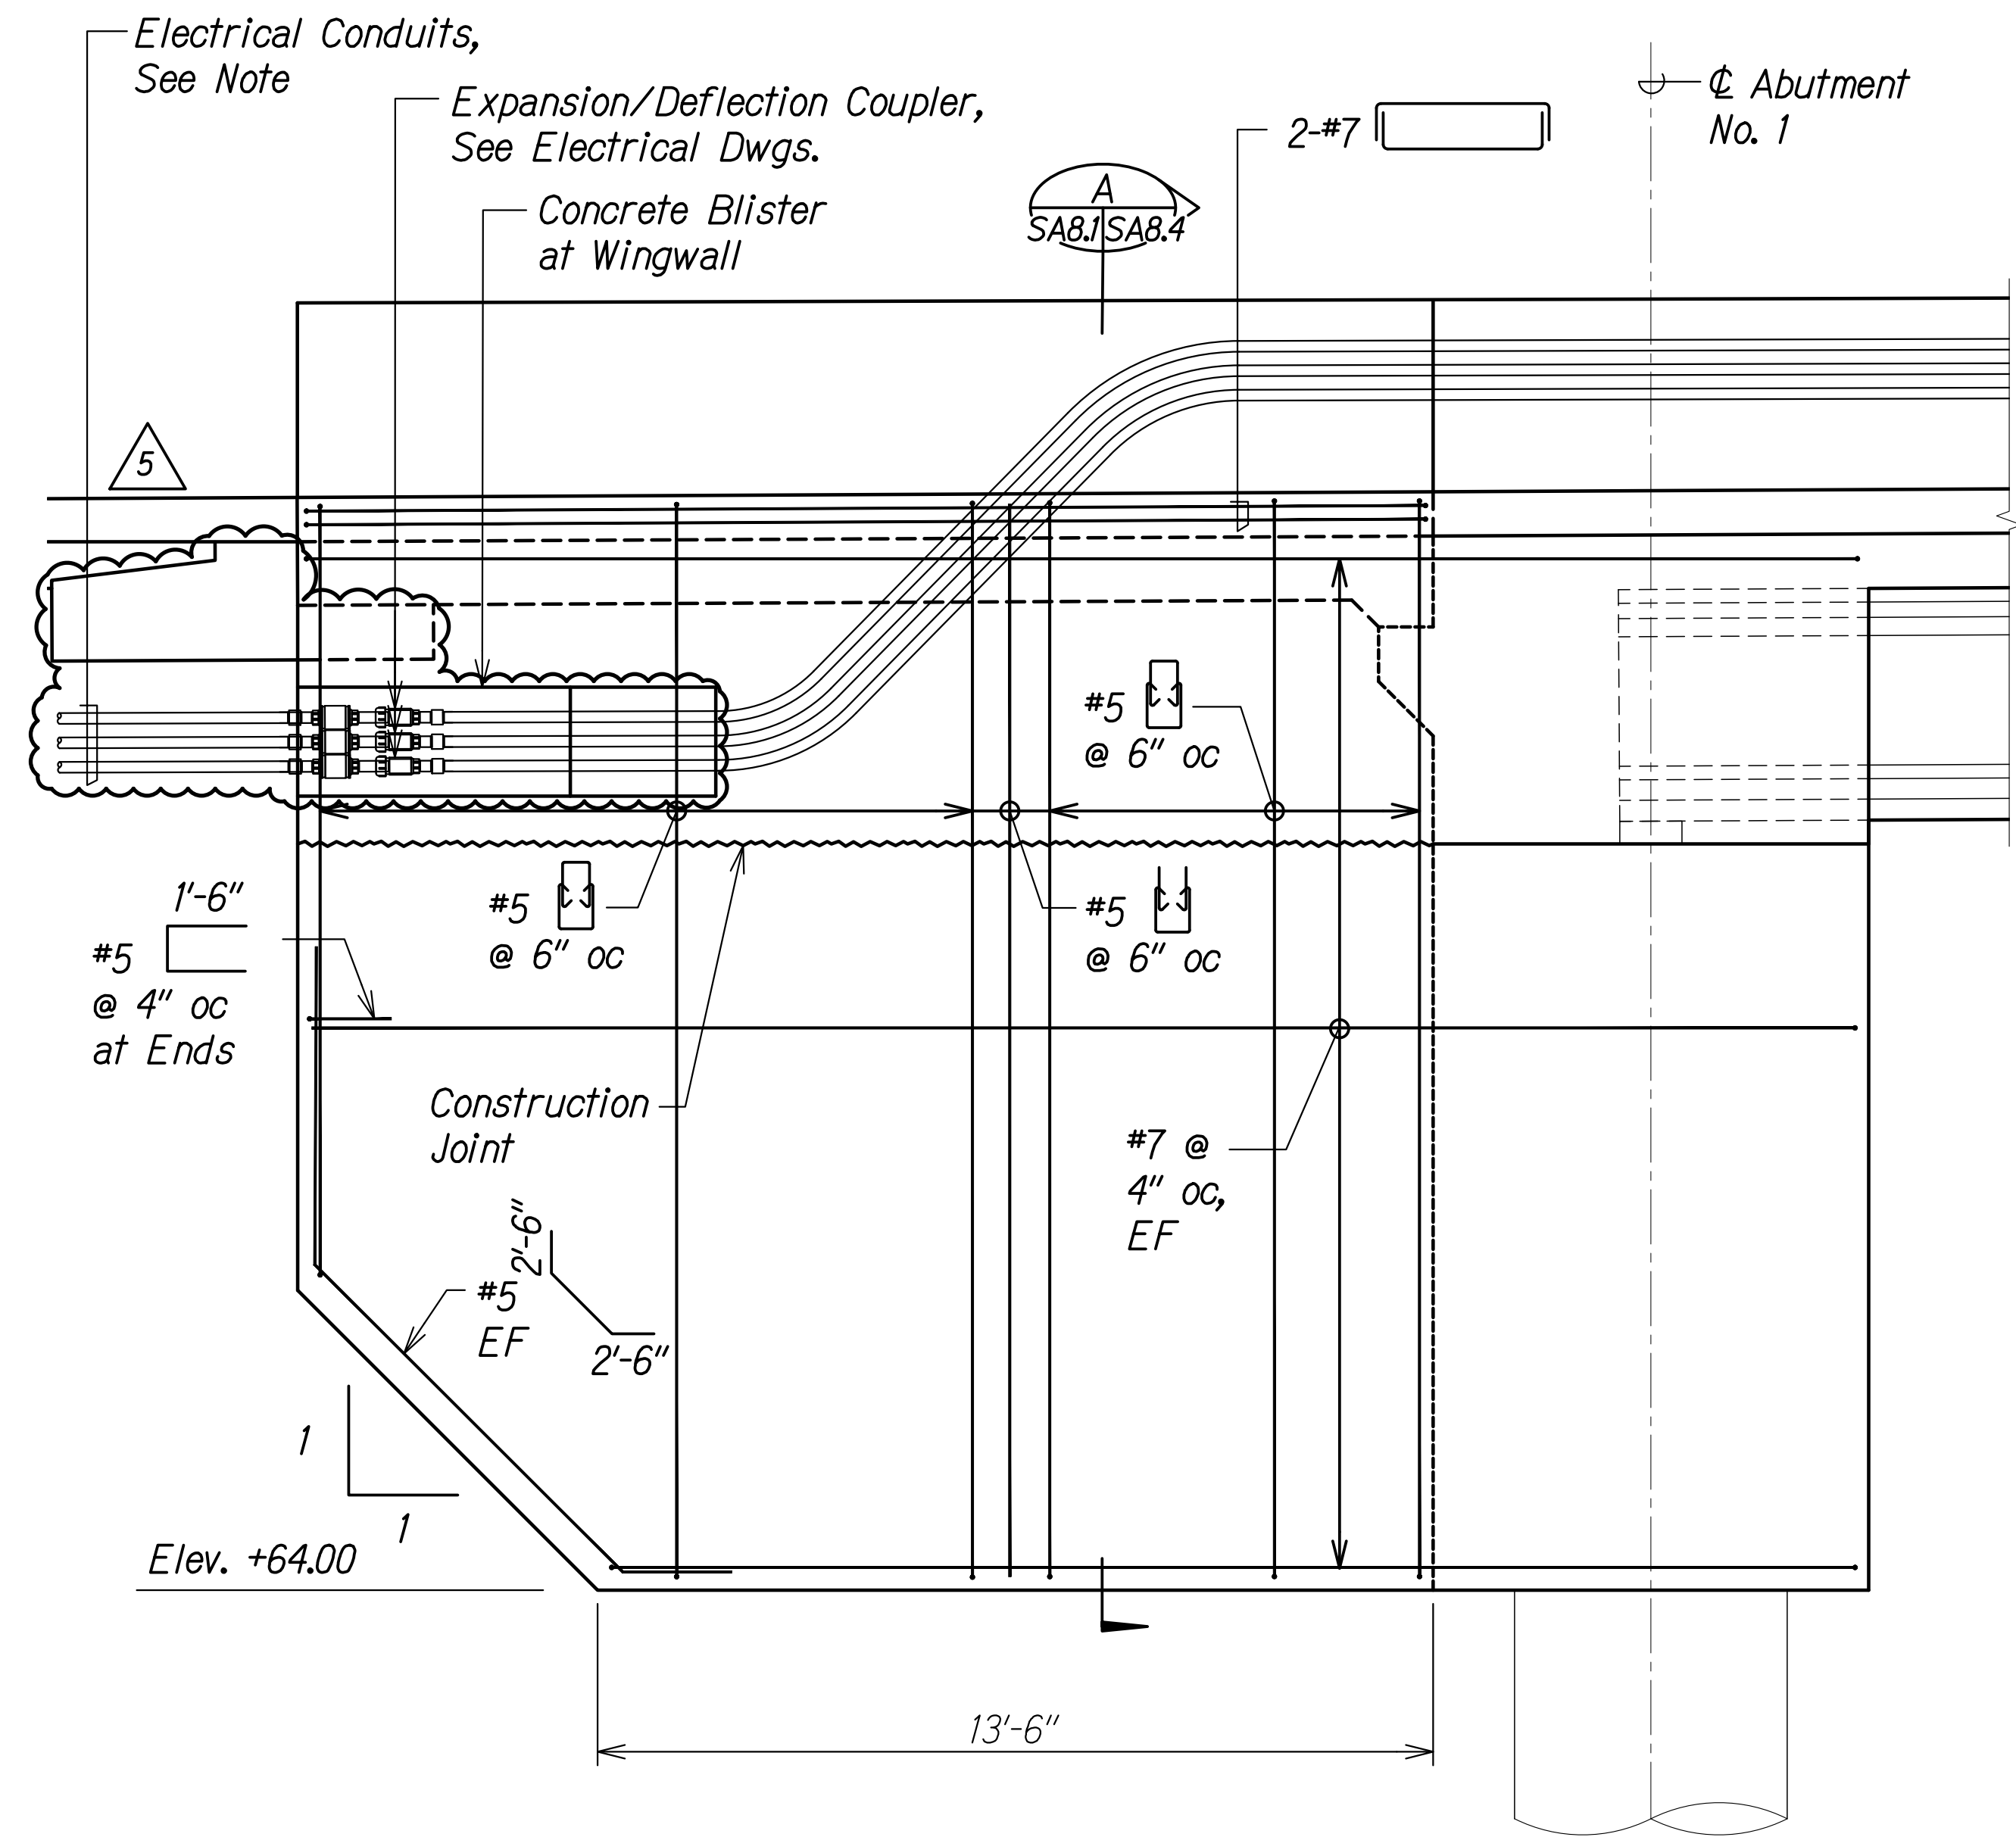

**WINGWALL NO. 1**  
**REINFORCING ELEVATION** A  
 Scale: 3/8" = 1'-0" SAB.1 SAB.1

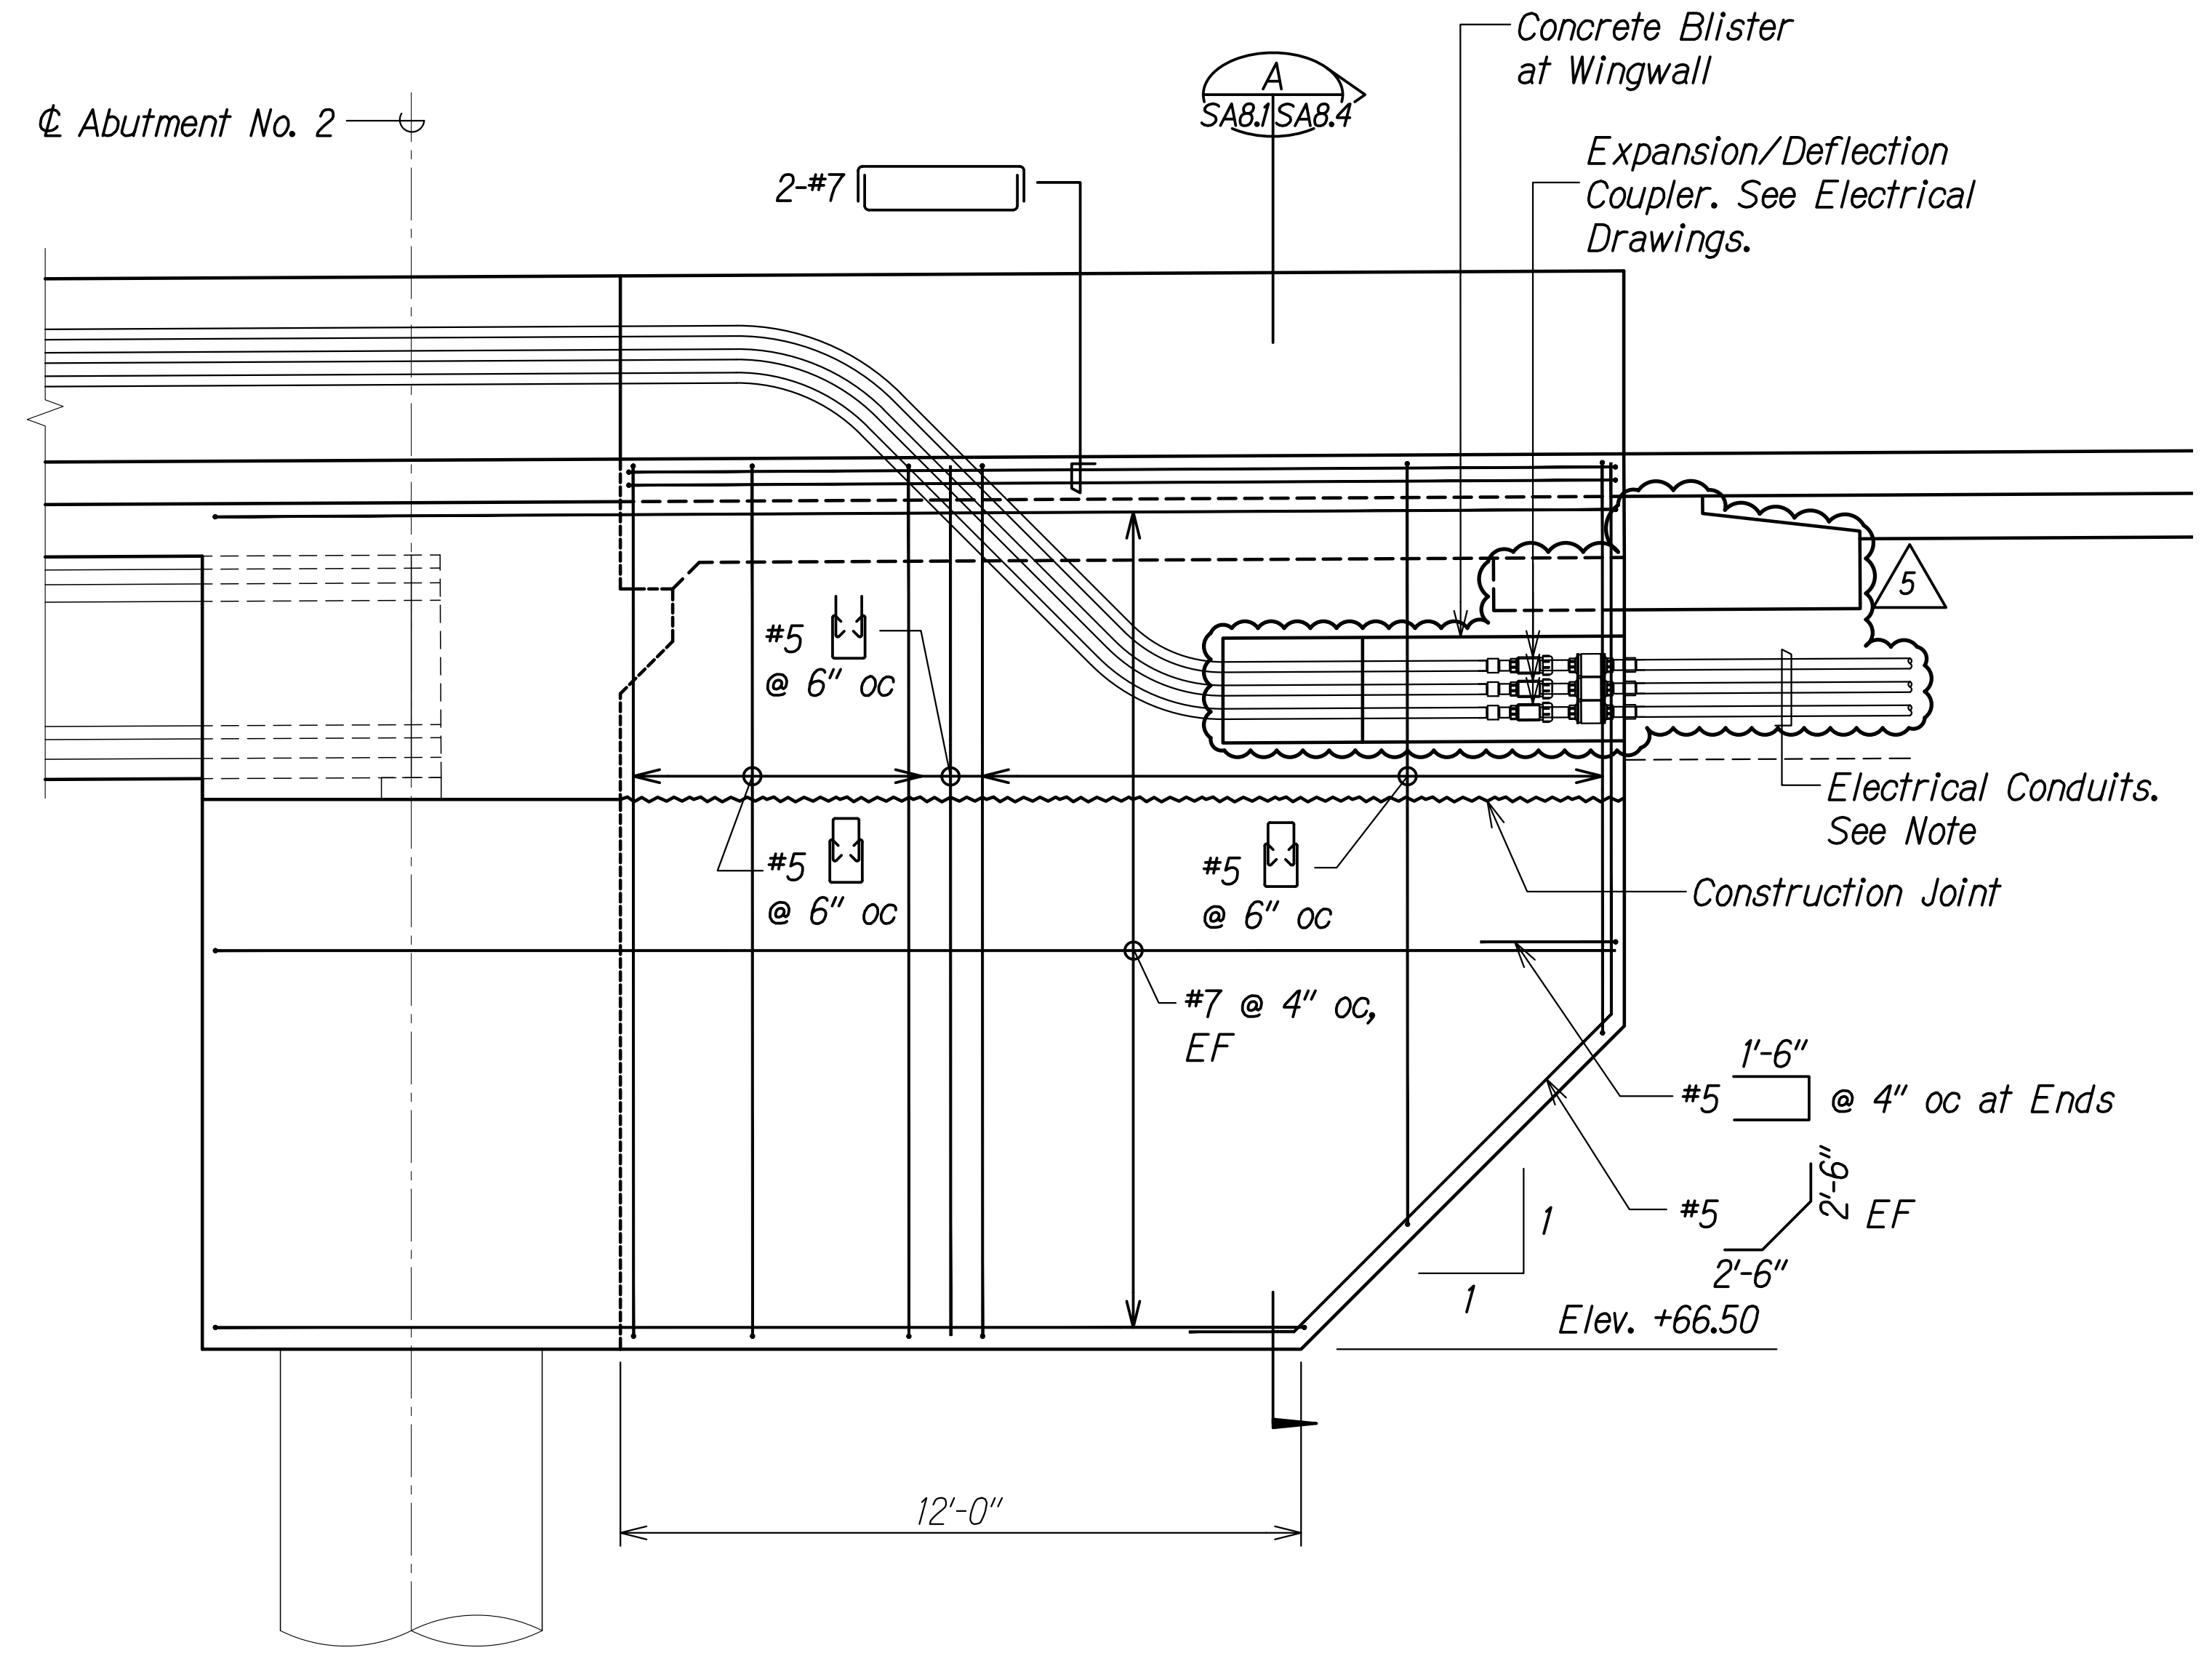

**WINGWALL NO. 3**  
**REINFORCING ELEVATION** B  
 Scale: 3/8" = 1'-0" SAB.1 SAB.1

SURVEY PLOTTED BY	DATE
DRAWN BY	
DESIGNED BY	
QUANTITIES BY	
CHECKED BY	
ORIGINAL PLAN	
NOTE BOOK	
No.	


DRAWING NAME: Z:\A00\CONCRETE\20-013-FARR-HWY-KAPOLEI.GC.ID.IT.WIP-EMT(CAD).DWG PLOT TIME: 07-15-22 5:56 PM

- Note:** 2
- (3) 2" Dia. conduits in Wingwall Nos. 1 and 3.


THIS WORK WAS PREPARED BY ME OR UNDER MY SUPERVISION AND CONSTRUCTION OF THIS PROJECT WILL BE UNDER MY OBSERVATION.  
 Signature: *Rugo S. Miyahara*  
 April 30, 2024  
 EXPIRATION DATE OF THE LICENSE

07/15/22	<span style="border: 1px solid black; border-radius: 50%; padding: 2px;">5</span>	Revised Sleeper Slab and Blister
06/08/22	<span style="border: 1px solid black; border-radius: 50%; padding: 2px;">2</span>	Revised Note
DATE		REVISION
STATE OF HAWAII DEPARTMENT OF TRANSPORTATION HIGHWAYS DIVISION <b>Honouliuli Stream Bridge</b> <b>Wingwall Reinforcing Elevations</b> FARRINGTON HIGHWAY WIDENING Kapolei Golf Course Road to Fort Weaver Road Project No. 7101A-01-20 Scale: As Shown Date: Apr. 2022		
SHEET No. SAB.1 OF 5 SHEETS		

FED. ROAD DIST. NO.	STATE	PROJ. NO.	FISCAL YEAR	SHEET NO.	TOTAL SHEETS
HAWAII	HAW.	7101A-01-20	2021	ADD. 392	

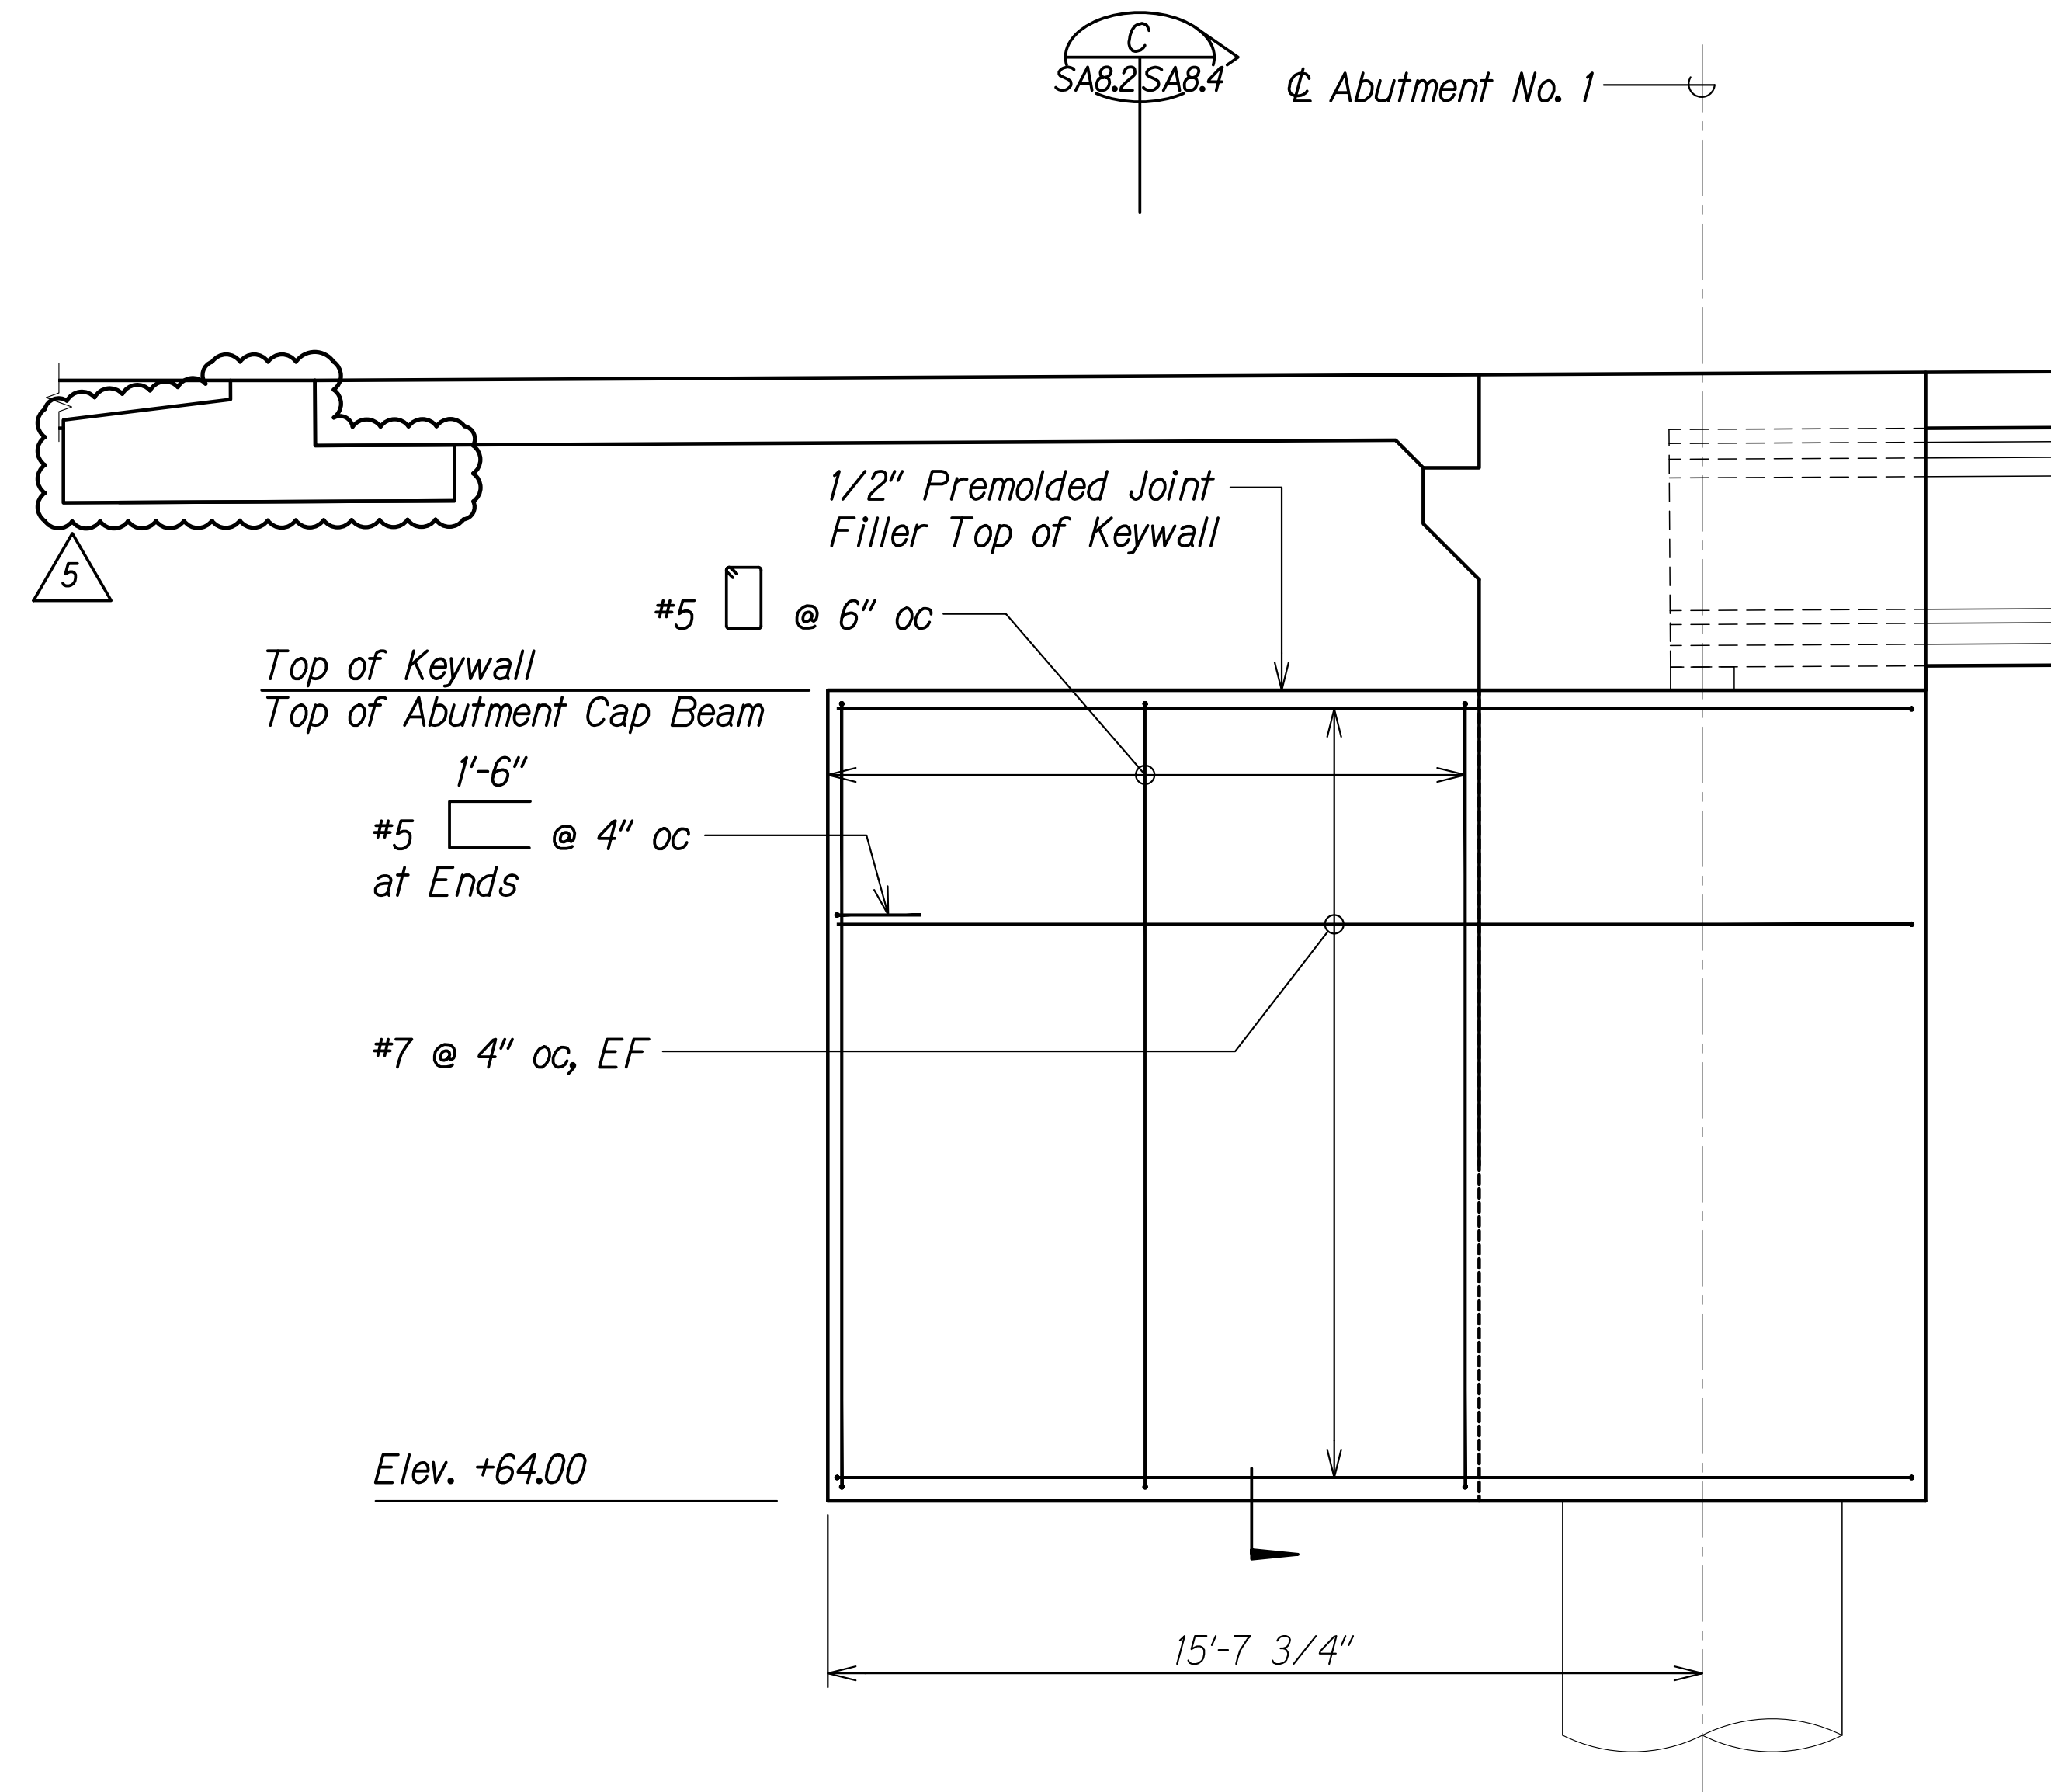


**KEYWALL  
REINFORCING ELEVATION** **A**  
Scale: 3/8" = 1'-0" SA8.2 SA8.2

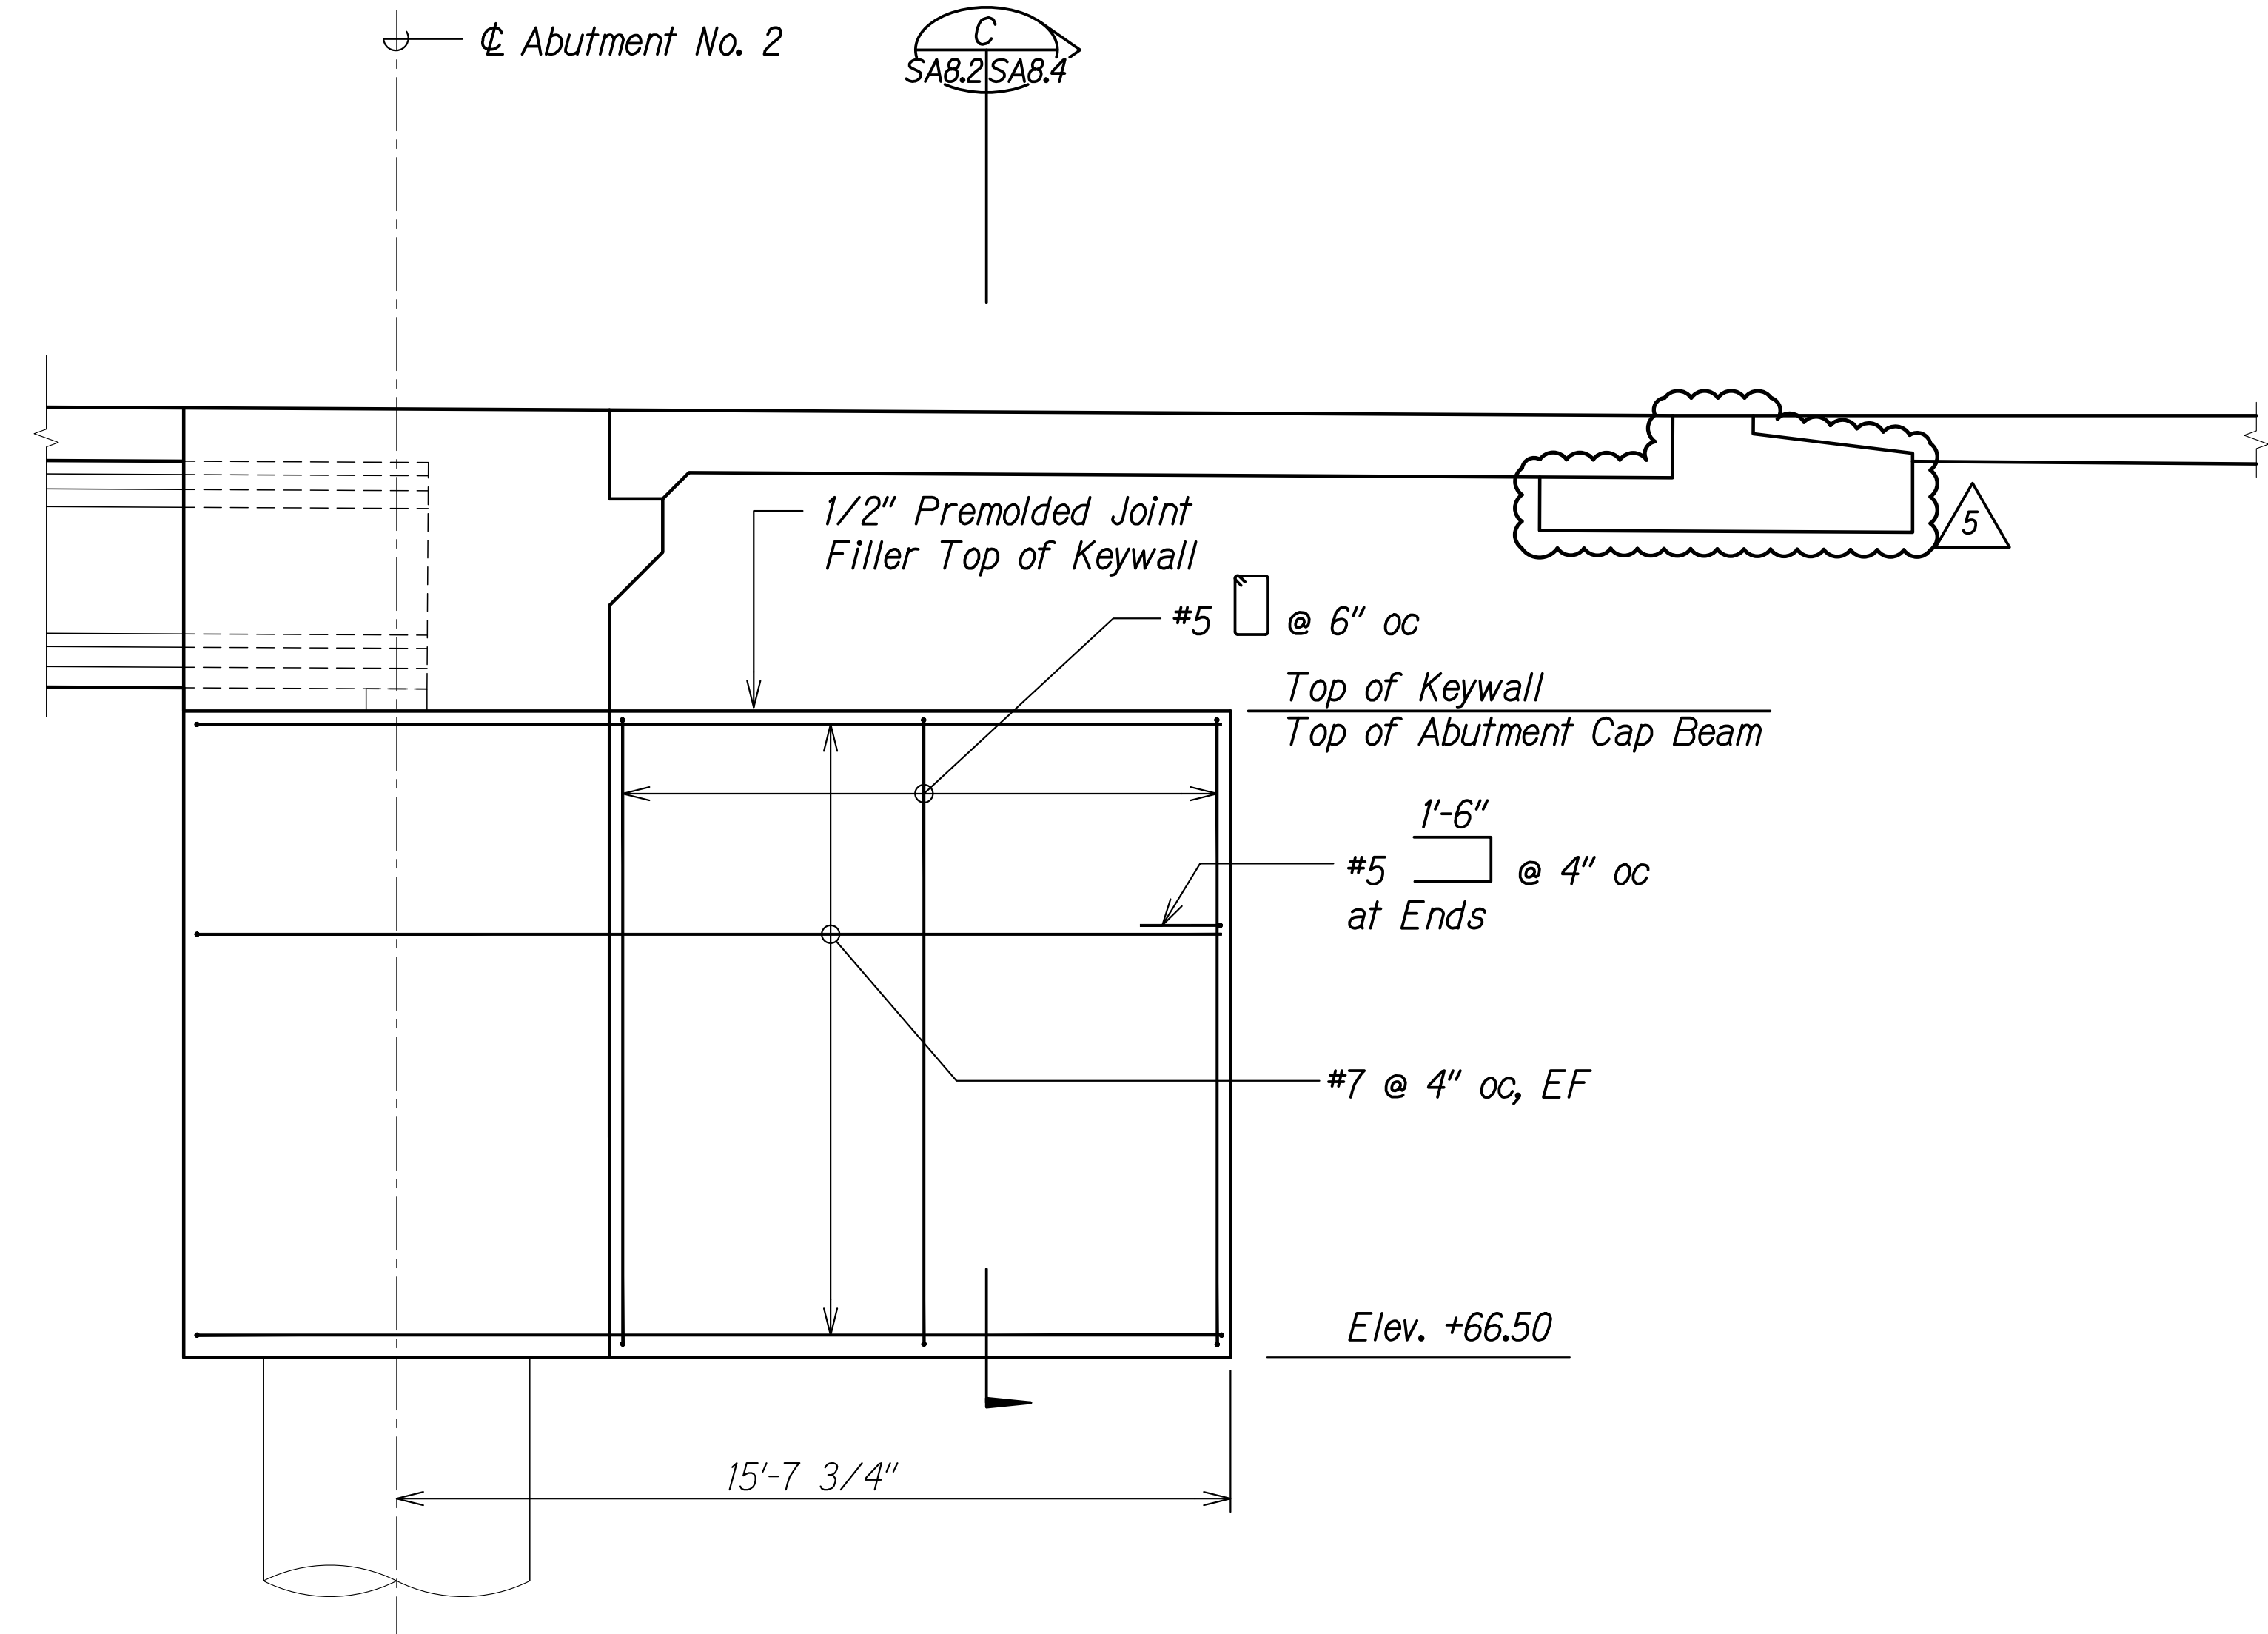

**KEYWALL  
REINFORCING ELEVATION** **B**  
Scale: 3/8" = 1'-0" SA8.2 SA8.2


ORIGINAL PLAN	DATE
DRAWN BY	
DESIGNED BY	
QUANTITIES BY	
CHECKED BY	
No.	

DRAWING NAME: Z:\A\00\ONDONG\20-013-FARR-HWY-KAPOLEI.GC.ID.IT.WIP-EMTC\01-CAD\07-15-22-ADD1-DELAS\EMTS-SAB82-HIGHWAY\WALL-DELAS.DWG PLOT TIME: 07-15-22, 5:07 PM

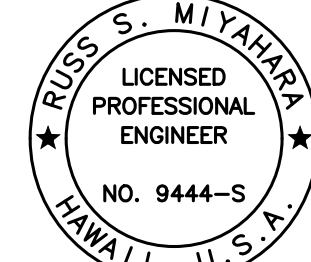
  
 THIS WORK WAS PREPARED BY ME OR UNDER MY SUPERVISION AND CONSTRUCTION OF THIS PROJECT WILL BE UNDER MY OBSERVATION.  
 Signature: *Rugo S. Miyakawa*  
 April 30, 2024  
 EXPIRATION DATE OF THE LICENSE

07/15/22	5	Revised Sleeper Slab
DATE		REVISION
STATE OF HAWAII DEPARTMENT OF TRANSPORTATION HIGHWAYS DIVISION <b>Honouliuli Stream Bridge</b> <b>Keywall Reinforcing Elevations</b> FARRINGTON HIGHWAY WIDENING Kapolei Golf Course Road to Fort Weaver Road Project No. 7101A-01-20		
Scale: As Shown	Date: Apr. 2022	
SHEET No. SA8.2 OF 5 SHEETS		

FED. ROAD DIST. NO.	STATE	PROJ. NO.	FISCAL YEAR	SHEET NO.	TOTAL SHEETS
HAWAII	HAW.	7101A-01-20	2021	ADD. 393	

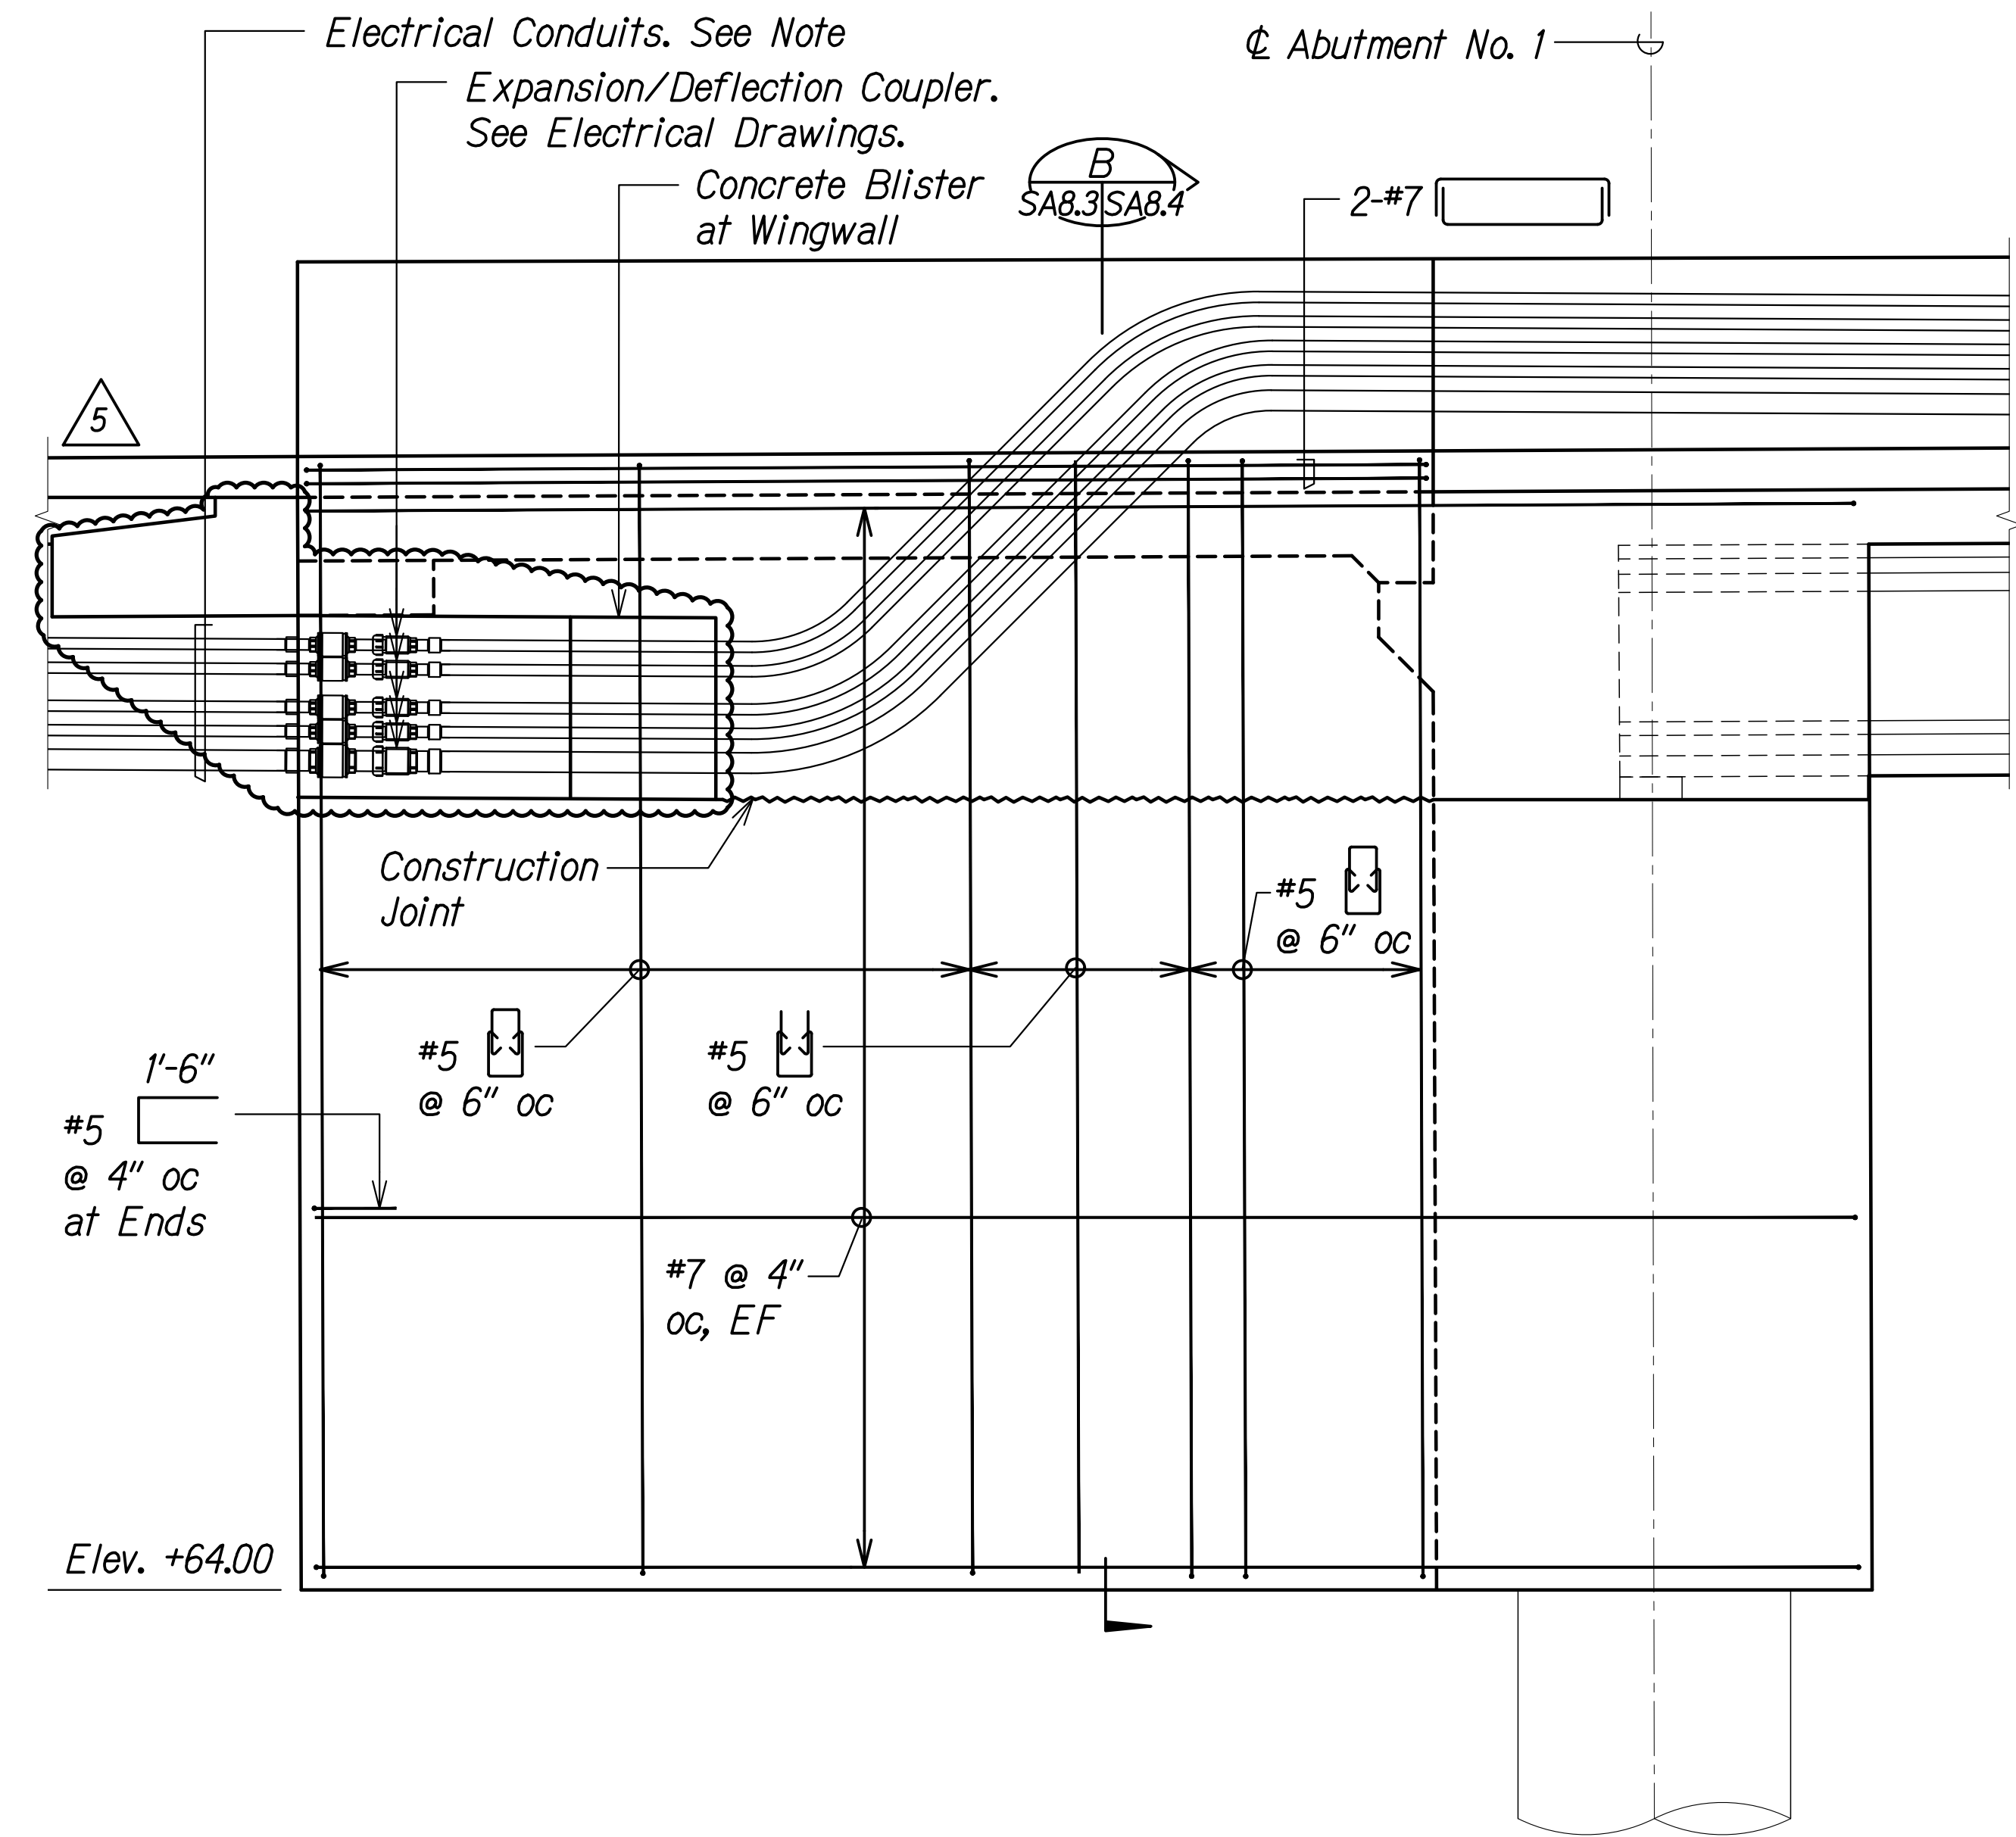

WINGWALL NO. 2  
 REINFORCING ELEVATION  
 Scale: 3/8" = 1'-0"  
 Section: A SAB.3 SAB.3

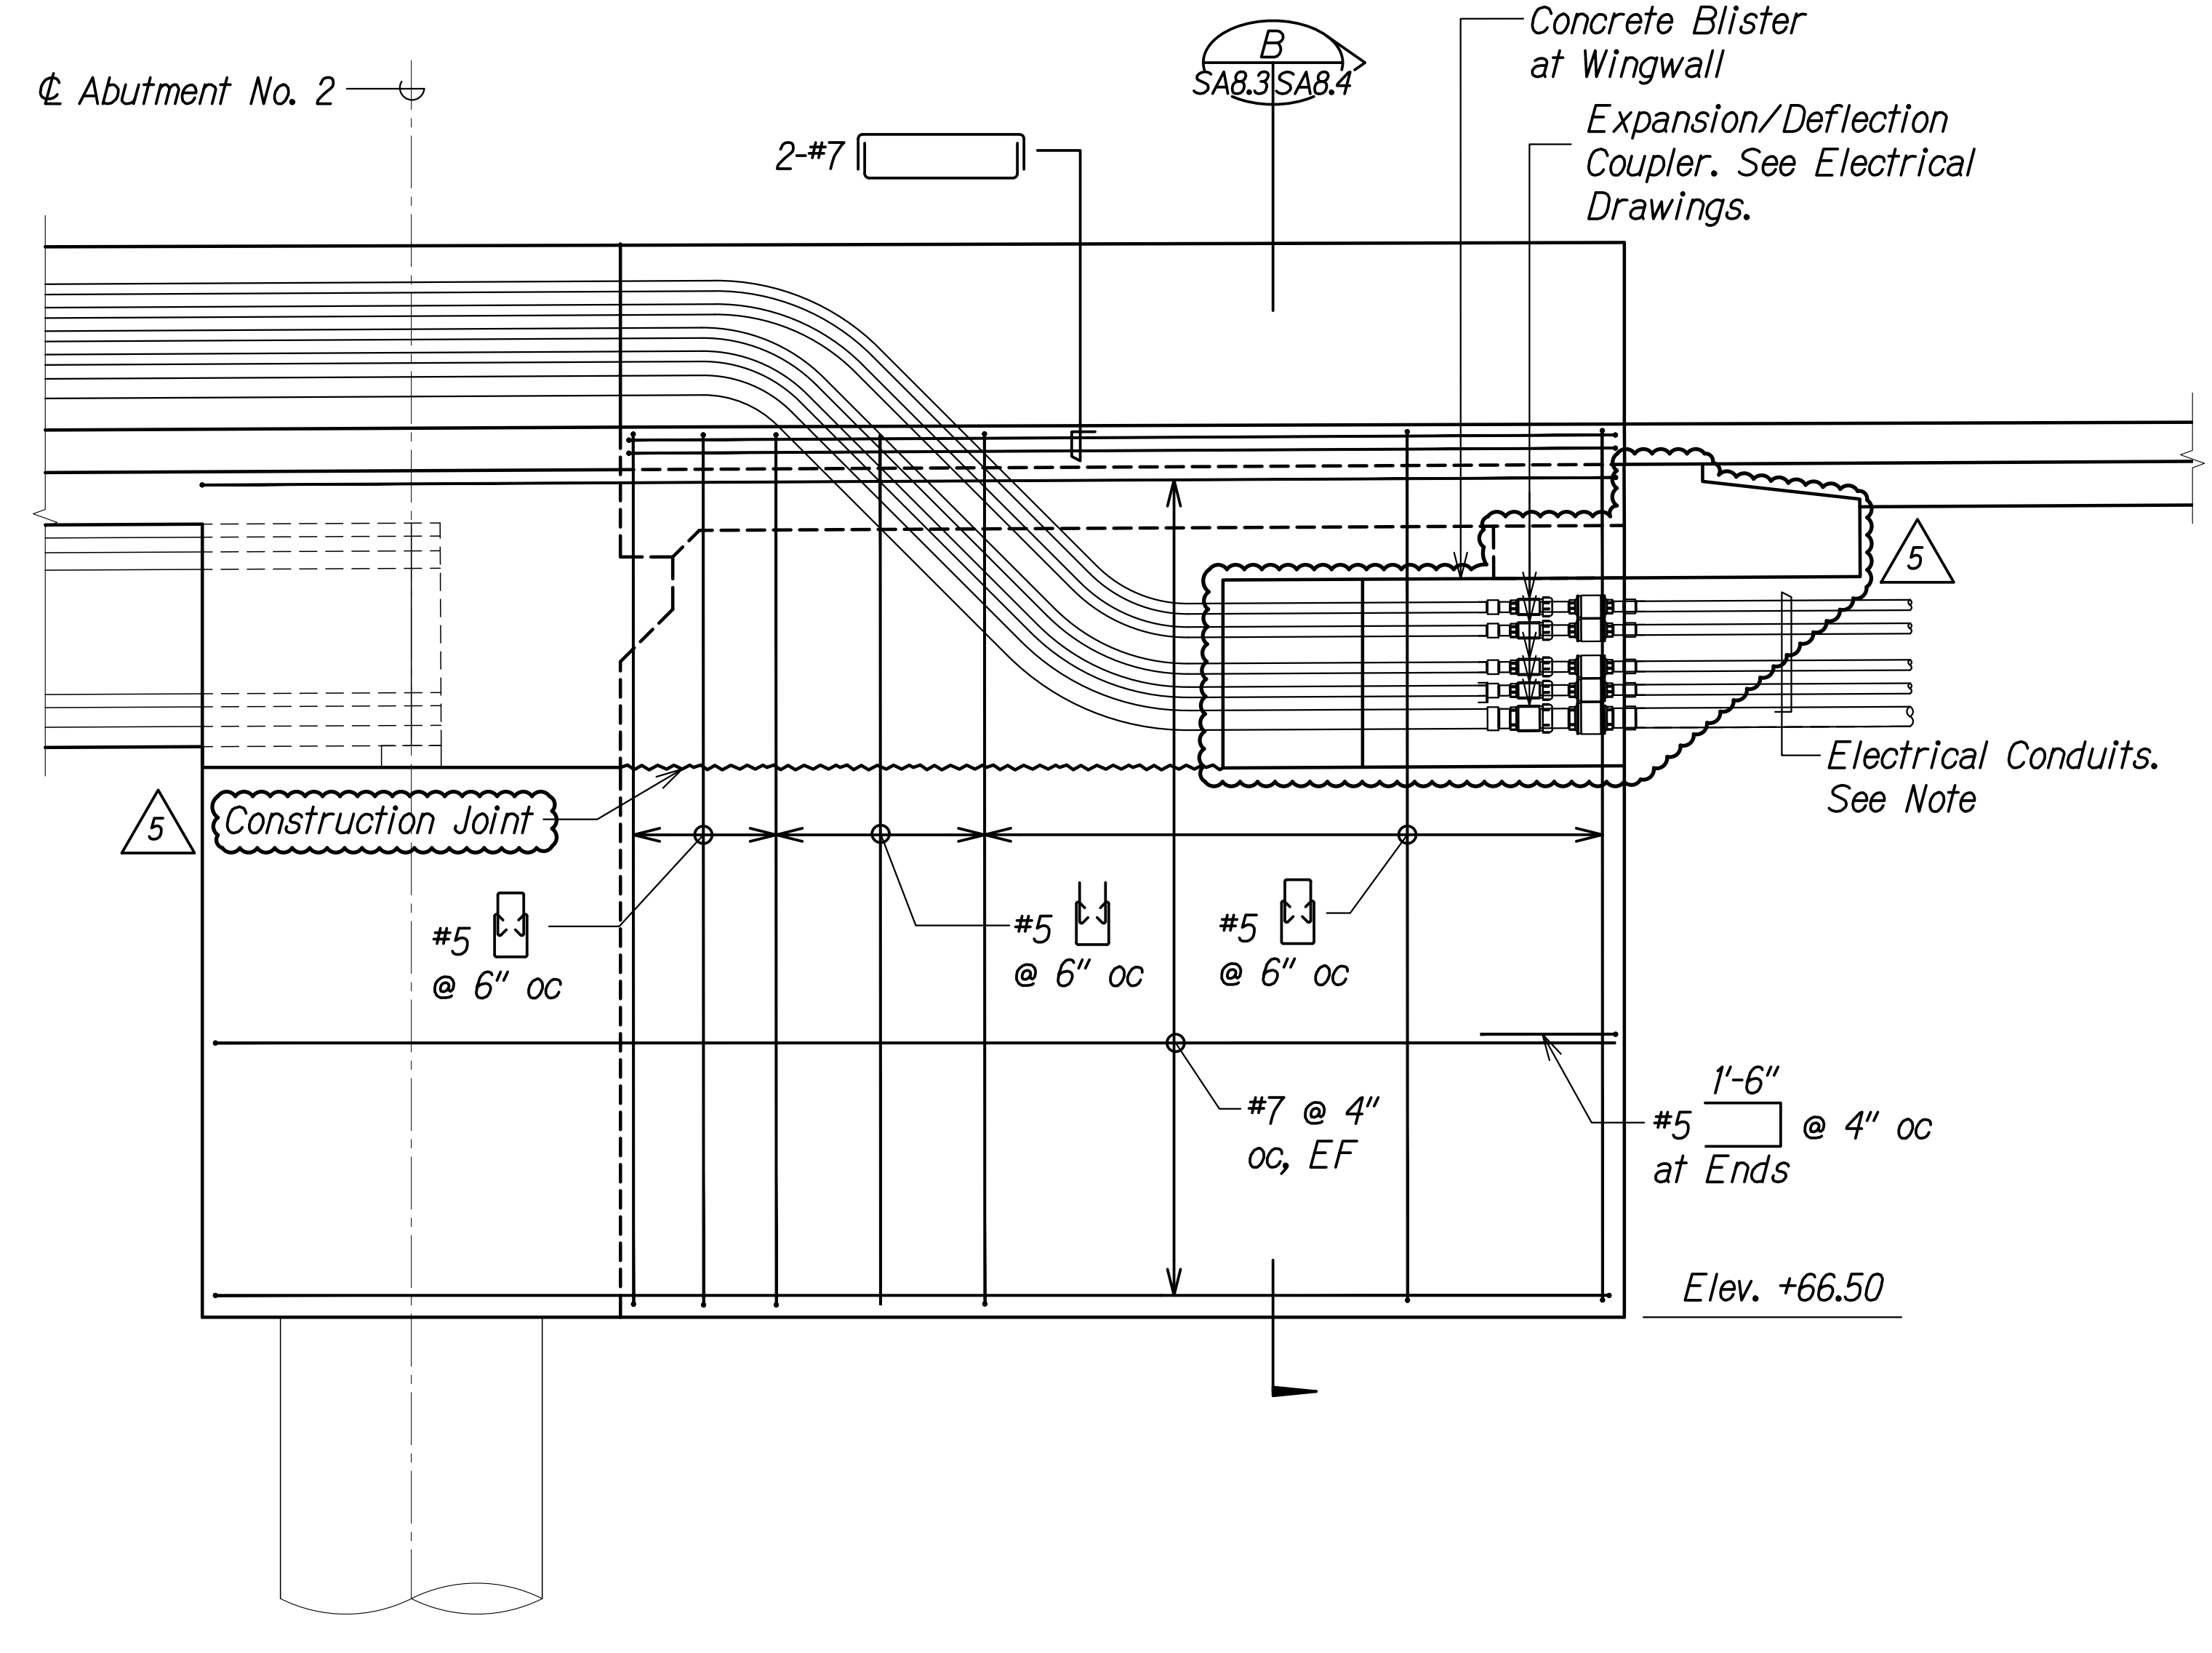

WINGWALL NO. 4  
 REINFORCING ELEVATION  
 Scale: 3/8" = 1'-0"  
 Section: B SAB.3 SAB.3


**Note:**

- (1) 4" Dia. conduit and (4) 2" dia. conduits in Wingwall Nos. 2 and 4.

SURVEY PLOTTED BY	DATE
DRAWN BY	
DESIGNED BY	
QUANTITIES BY	
CHECKED BY	
ORIGINAL PLAN No.	


DRAWING NAME: Z:\100\CONDOING\20-013-FARR-HWY-KAPOLEI.GC.ID.IT.WIP-EMTC\01-GAD\07-15-22 ADD1 DELIAS\EHWS-SAB083-HWY-KWALL-DELIAS.DWG PLOT TIME: 07-15-22, 5:07 PM

THIS WORK WAS PREPARED BY ME OR UNDER MY SUPERVISION AND CONSTRUCTION OF THIS PROJECT WILL BE UNDER MY OBSERVATION.  
 Signature: *Russ S. Miyahara*  
 EXPIRATION DATE OF THE LICENSE: April 30, 2024

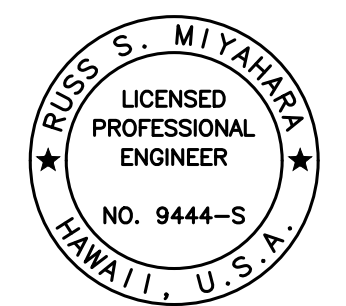

DATE	REVISION
07/15/22	5 Revised Sleeper Slab
STATE OF HAWAII DEPARTMENT OF TRANSPORTATION HIGHWAYS DIVISION <b>Honouliuli Stream Bridge</b> <b>Wingwall Reinforcing Elevations</b> FARRINGTON HIGHWAY WIDENING Kapolei Golf Course Road to Fort Weaver Road Project No. 7101A-01-20	
Scale: As Shown	Date: Apr. 2022
SHEET No. SA8.3 OF 5 SHEETS	

FED. ROAD DIST. NO.	STATE	PROJ. NO.	FISCAL YEAR	SHEET NO.	TOTAL SHEETS
HAWAII	HAW.	7101A-01-20	2021	ADD. 394	

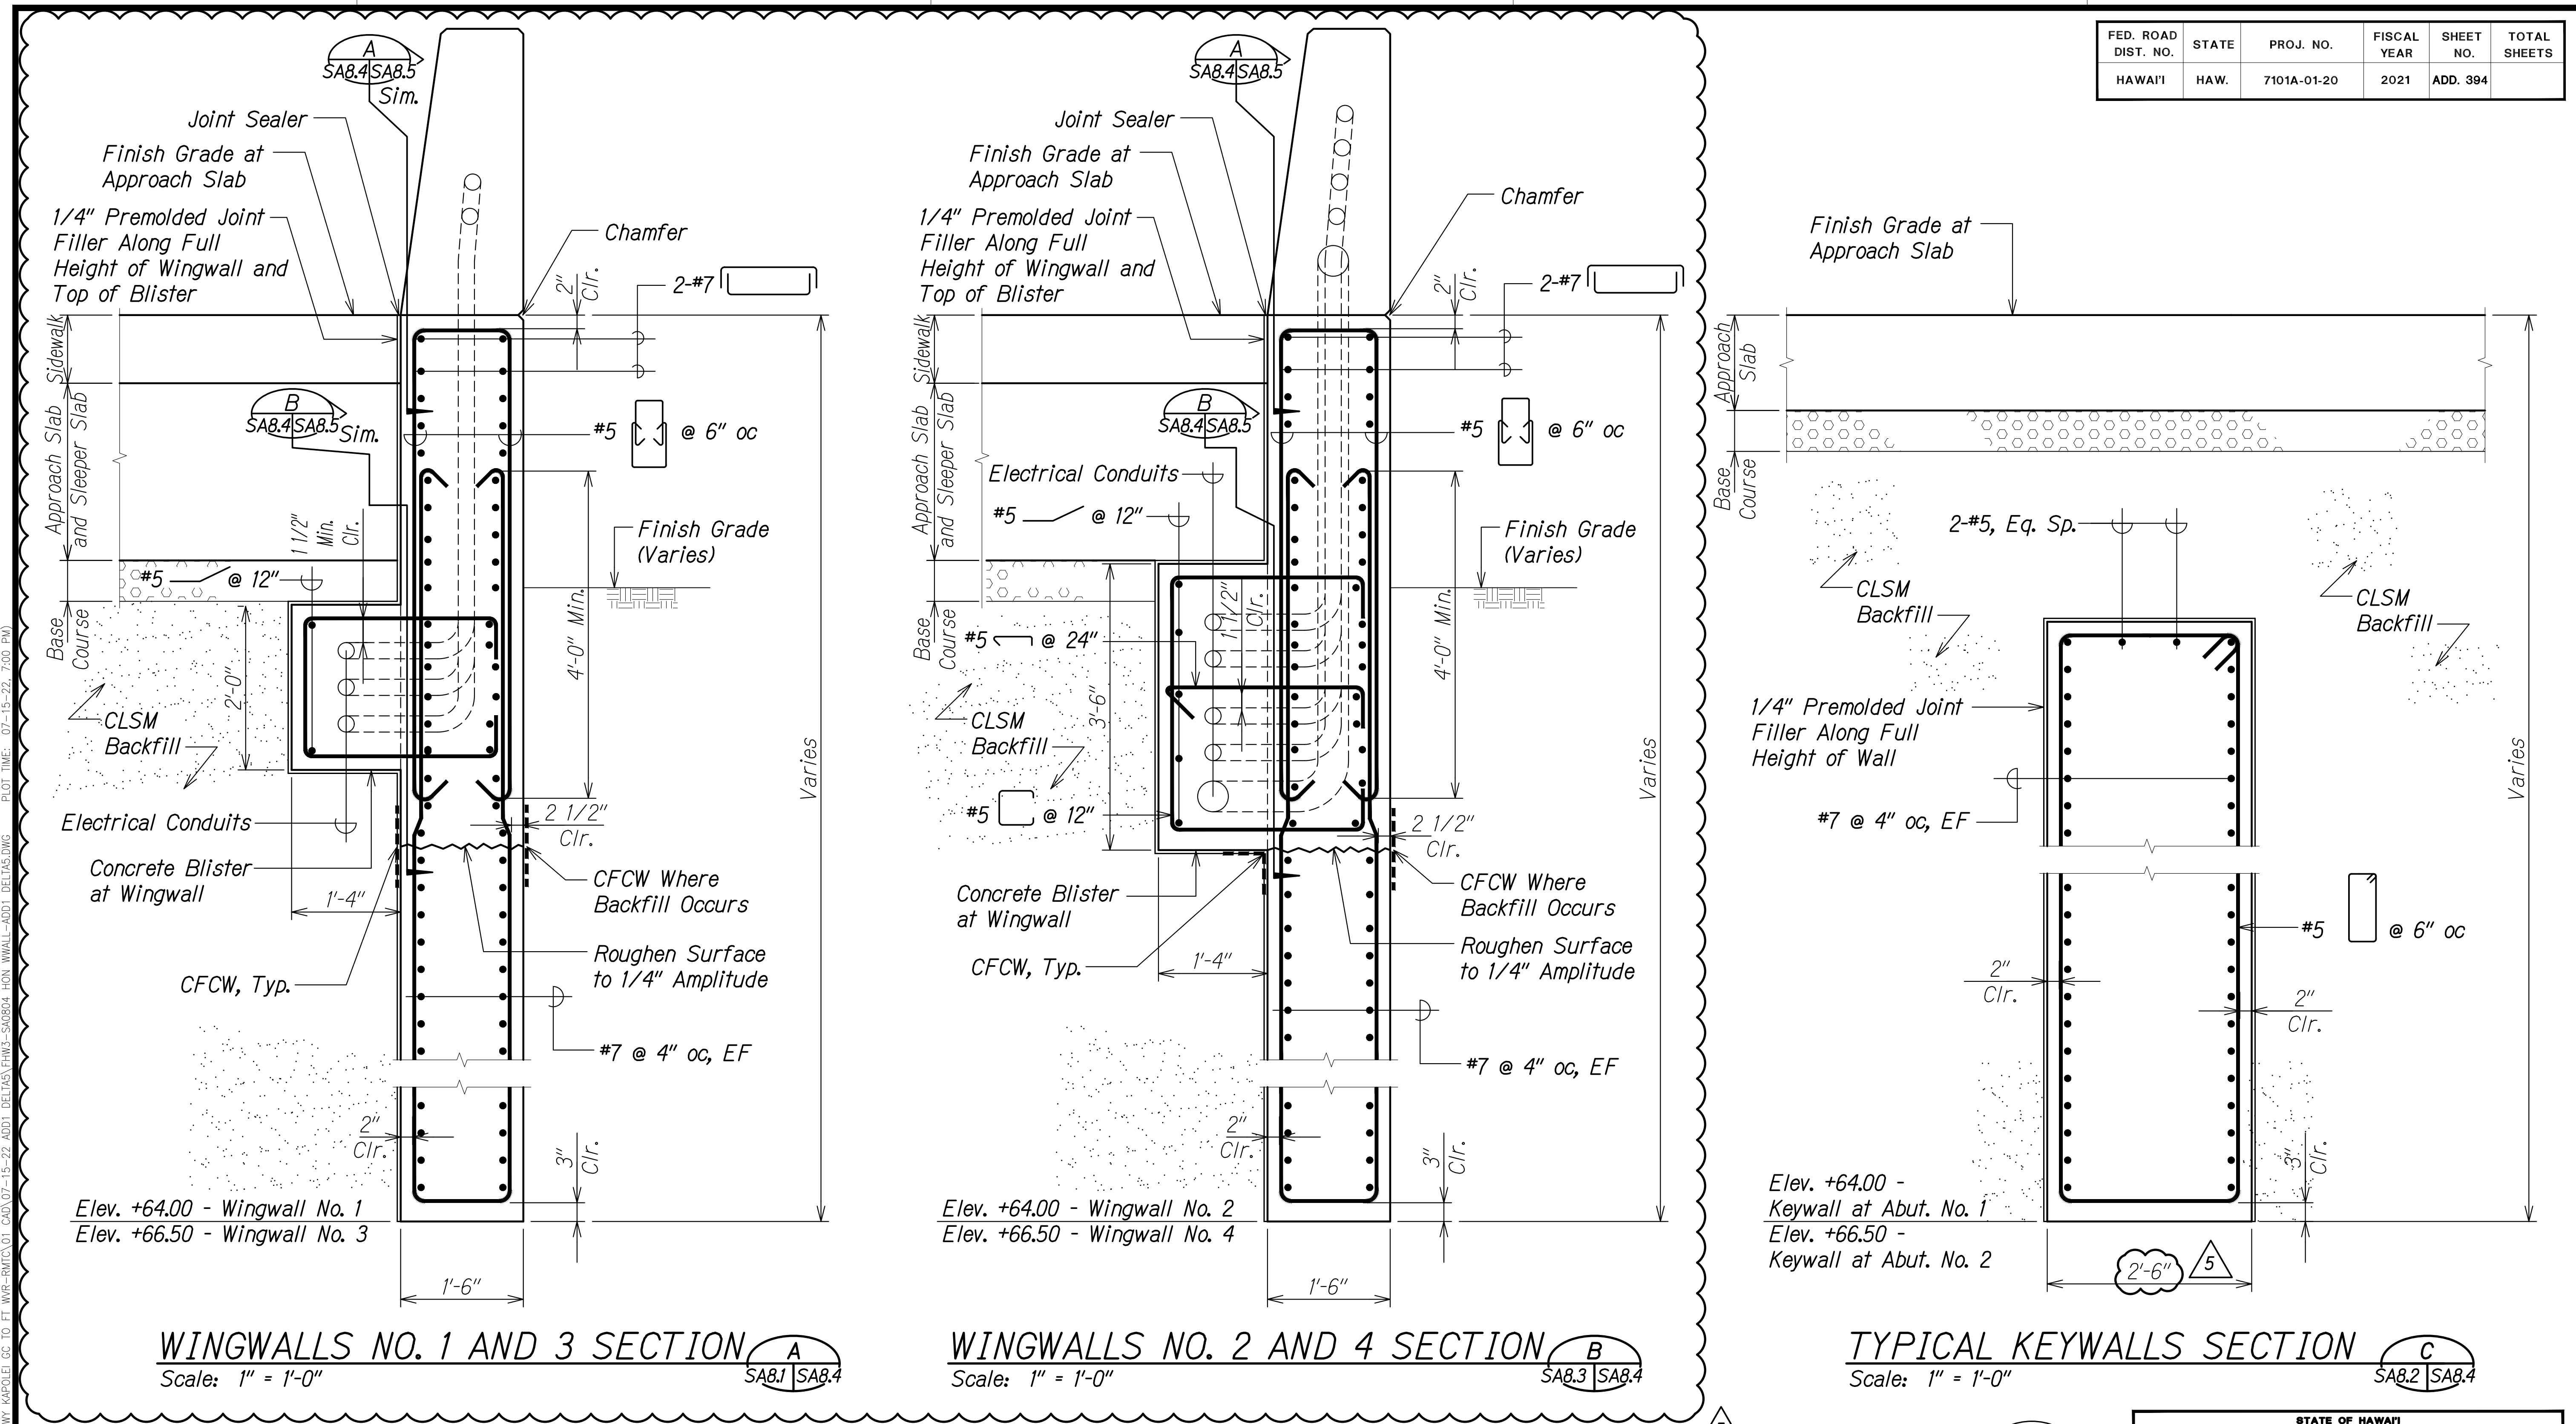

**WINGWALLS NO. 1 AND 3 SECTION** A  
Scale: 1" = 1'-0" SA8.1 SA8.4

**WINGWALLS NO. 2 AND 4 SECTION** B  
Scale: 1" = 1'-0" SA8.3 SA8.4

**TYPICAL KEYWALLS SECTION** C  
Scale: 1" = 1'-0" SA8.2 SA8.4

**Note:**  
1. Elevations at bottom of wingwall are taken at the lowest point. Bottom of wingwall elevation changes along the length.

2

DATE	
SURVEY PLOTTED BY	
DRAWN BY	
DESIGNED BY	
QUANTITIES BY	
CHECKED BY	
ORIGINAL PLAN No.	

DRAWING NAME: Z:\000\000000\20-013-FARR-HW-KAPOLEI-GC-10-ET-WR-EMTC\01-GAD\07-15-22-ADD1-DELAG-FHWS-SAB8.4-HW-KWALL-ADD1-DELAG.DWG PLOT TIME: 07-15-22 7:50 PM

DATE	REVISION
07/15/22	5 Revised Sections
06/08/22	2 Delete Note

THIS WORK WAS PREPARED BY ME OR UNDER MY SUPERVISION AND CONSTRUCTION OF THIS PROJECT WILL BE UNDER MY OBSERVATION.  
 SIGNATURE: *Paul S. Miyahara* April 30, 2024  
 EXPIRATION DATE OF THE LICENSE

STATE OF HAWAII  
 DEPARTMENT OF TRANSPORTATION  
 HIGHWAYS DIVISION


**Honouliuli Stream Bridge  
 Wingwall and Keywall Sections**

FARRINGTON HIGHWAY WIDENING  
 Kapolei Golf Course Road to Fort Weaver Road  
 Project No. 7101A-01-20


Scale: As Shown Date: Apr. 2022  
 SHEET No. SA8.4 OF 5 SHEETS



FED. ROAD DIST. NO.	STATE	PROJ. NO.	FISCAL YEAR	SHEET NO.	TOTAL SHEETS
HAWAII	HAW.	7101A-01-20	2021	ADD. 404	

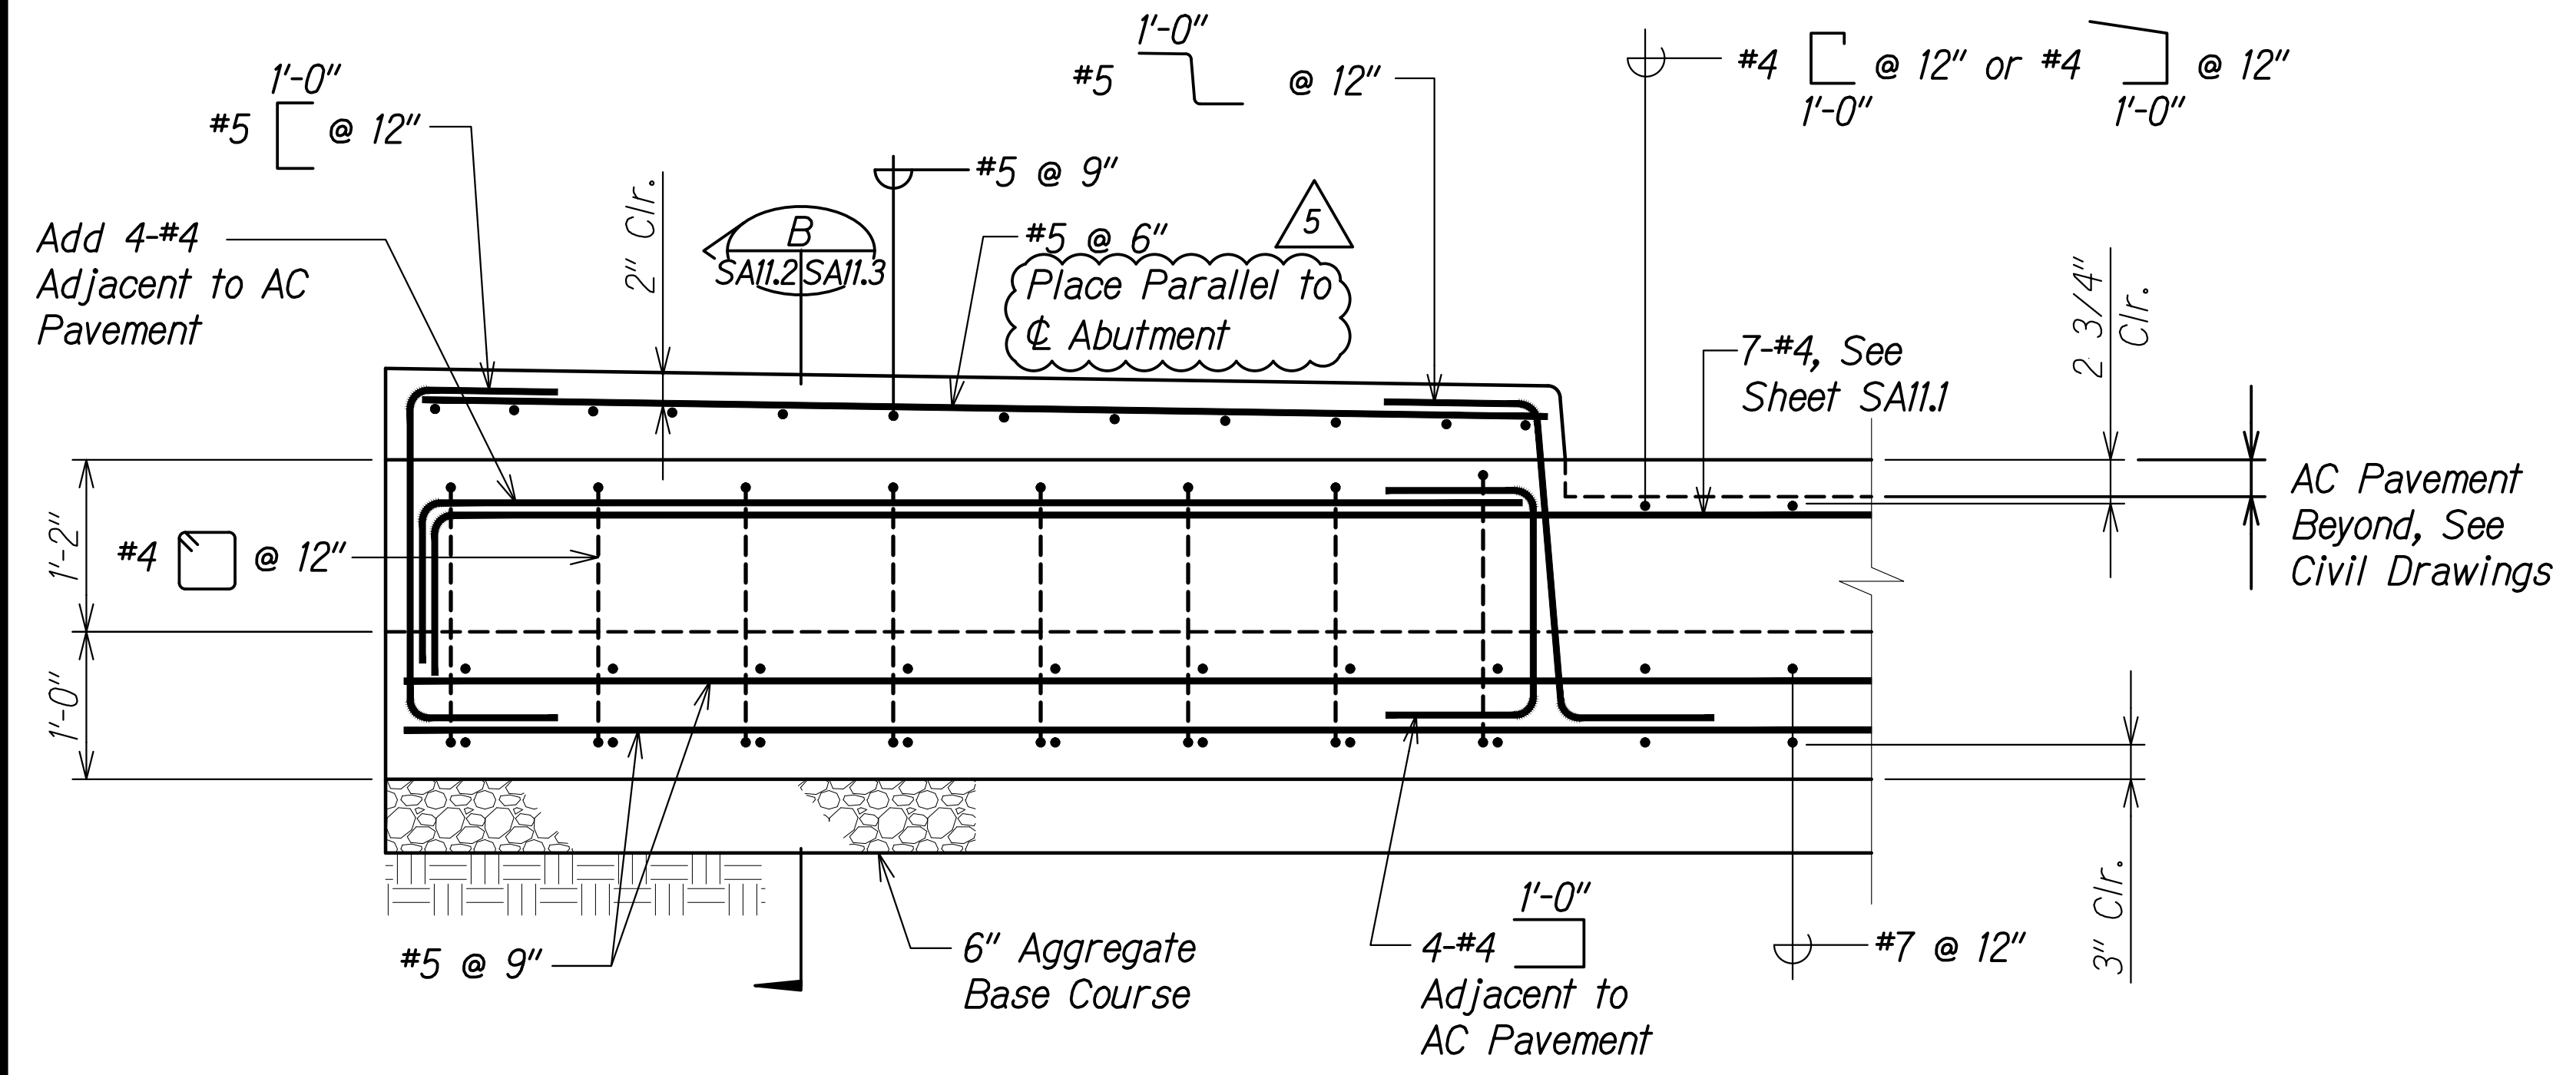


**SLEEPER SECTION AT SIDEWALK**  
Scale: 1" = 1'-0"

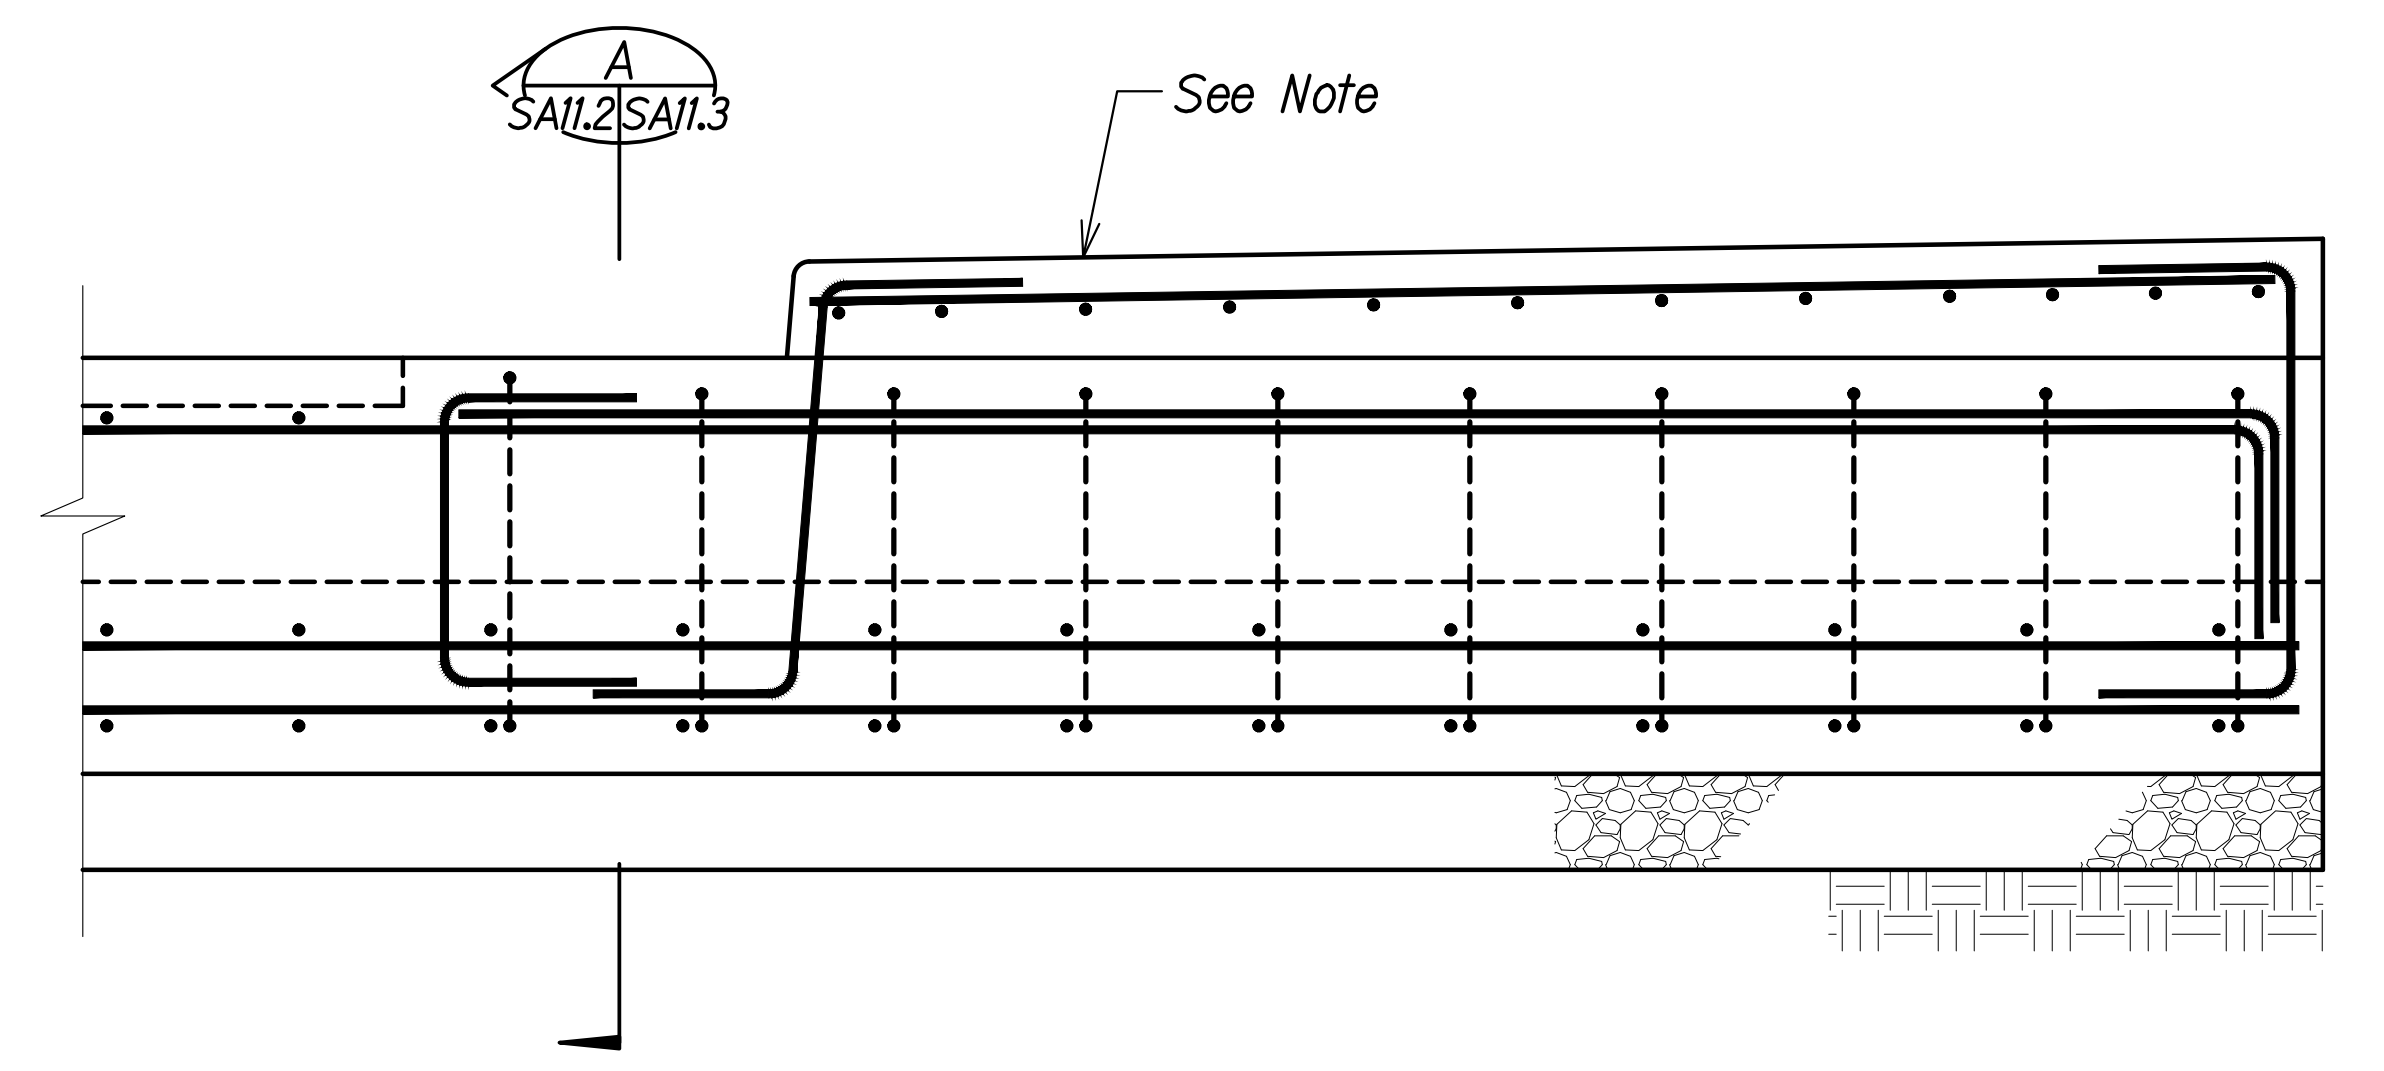

**SLEEPER SECTION AT SIDEWALK**  
Scale: 1" = 1'-0"

Note:


Reinforcing in section B is similar to section A. Section B is provided to show the condition of the sleeper slab at the gutter.

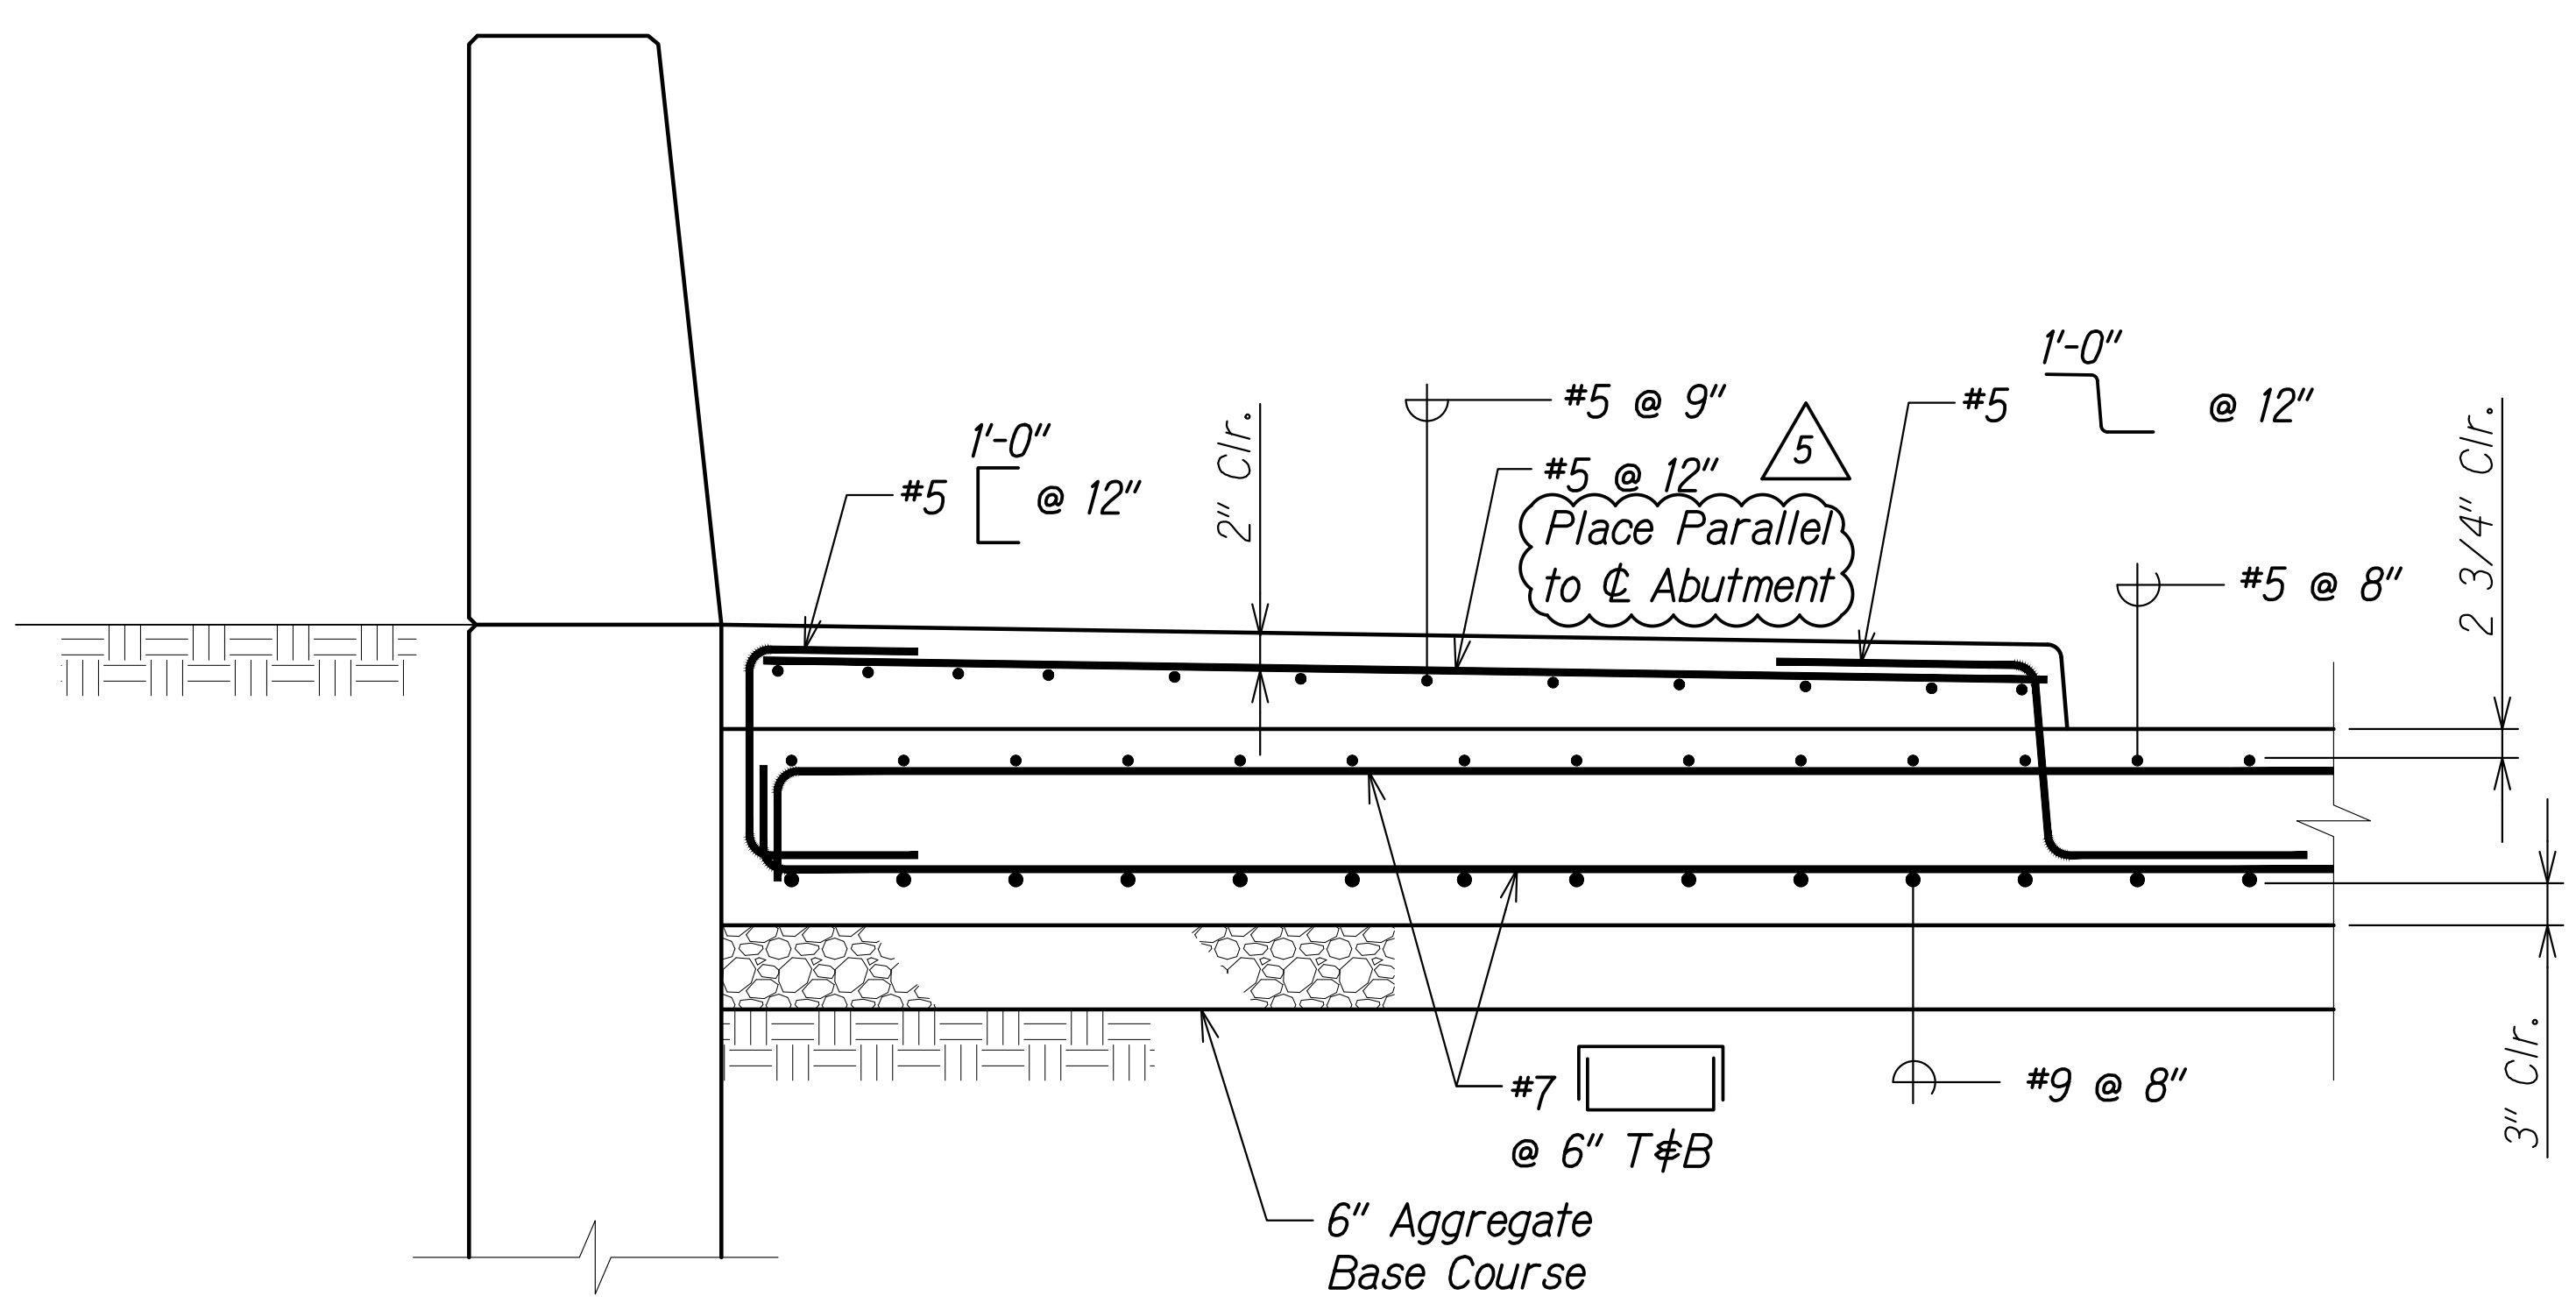

**APPROACH SECTION AT SIDEWALK**  
Scale: 1" = 1'-0"

SURVEY PLOTTED BY	DATE
DRAWN BY	
DESIGNED BY	
QUANTITIES BY	
CHECKED BY	
ORIGINAL PLAN	
NOTE BOOK	
No.	


DRAWING NAME: Z:\100 ONGOING\20-013-FARR-HWY-KAPOLEI-GC-10-ET-WP-RMT\01-GAD\07-15-22-ADD1-DELAS\EHWS-SA1102-APPROACH SECT-ADD1-DELAS.DWG PLOT TIME: 07-15-22: 5:10 PM

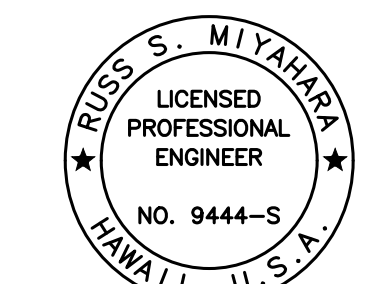

THIS WORK WAS PREPARED BY ME OR UNDER MY SUPERVISION AND CONSTRUCTION OF THIS PROJECT WILL BE UNDER MY OBSERVATION.  
Signature: *Rugo S. Miyahara*  
April 30, 2024  
EXPIRATION DATE OF THE LICENSE

DATE	REVISION
07/15/22	5 Revised Reinf. and Callouts
06/08/22	2 Revised Callouts
STATE OF HAWAII <b>DEPARTMENT OF TRANSPORTATION</b> HIGHWAYS DIVISION <b>Honouliuli Stream Bridge</b> <b>Approach Slab and Sleeper Slab Sections</b> FARRINGTON HIGHWAY WIDENING Kapolei Golf Course Road to Fort Weaver Road Project No. 7101A-01-20 Scale: As Shown Date: Apr. 2022	
SHEET No. SA112 OF 4 SHEETS	

FED. ROAD DIST. NO.	STATE	PROJ. NO.	FISCAL YEAR	SHEET NO.	TOTAL SHEETS
HAWAII	HAW.	7101A-01-20	2021	ADD. 412	

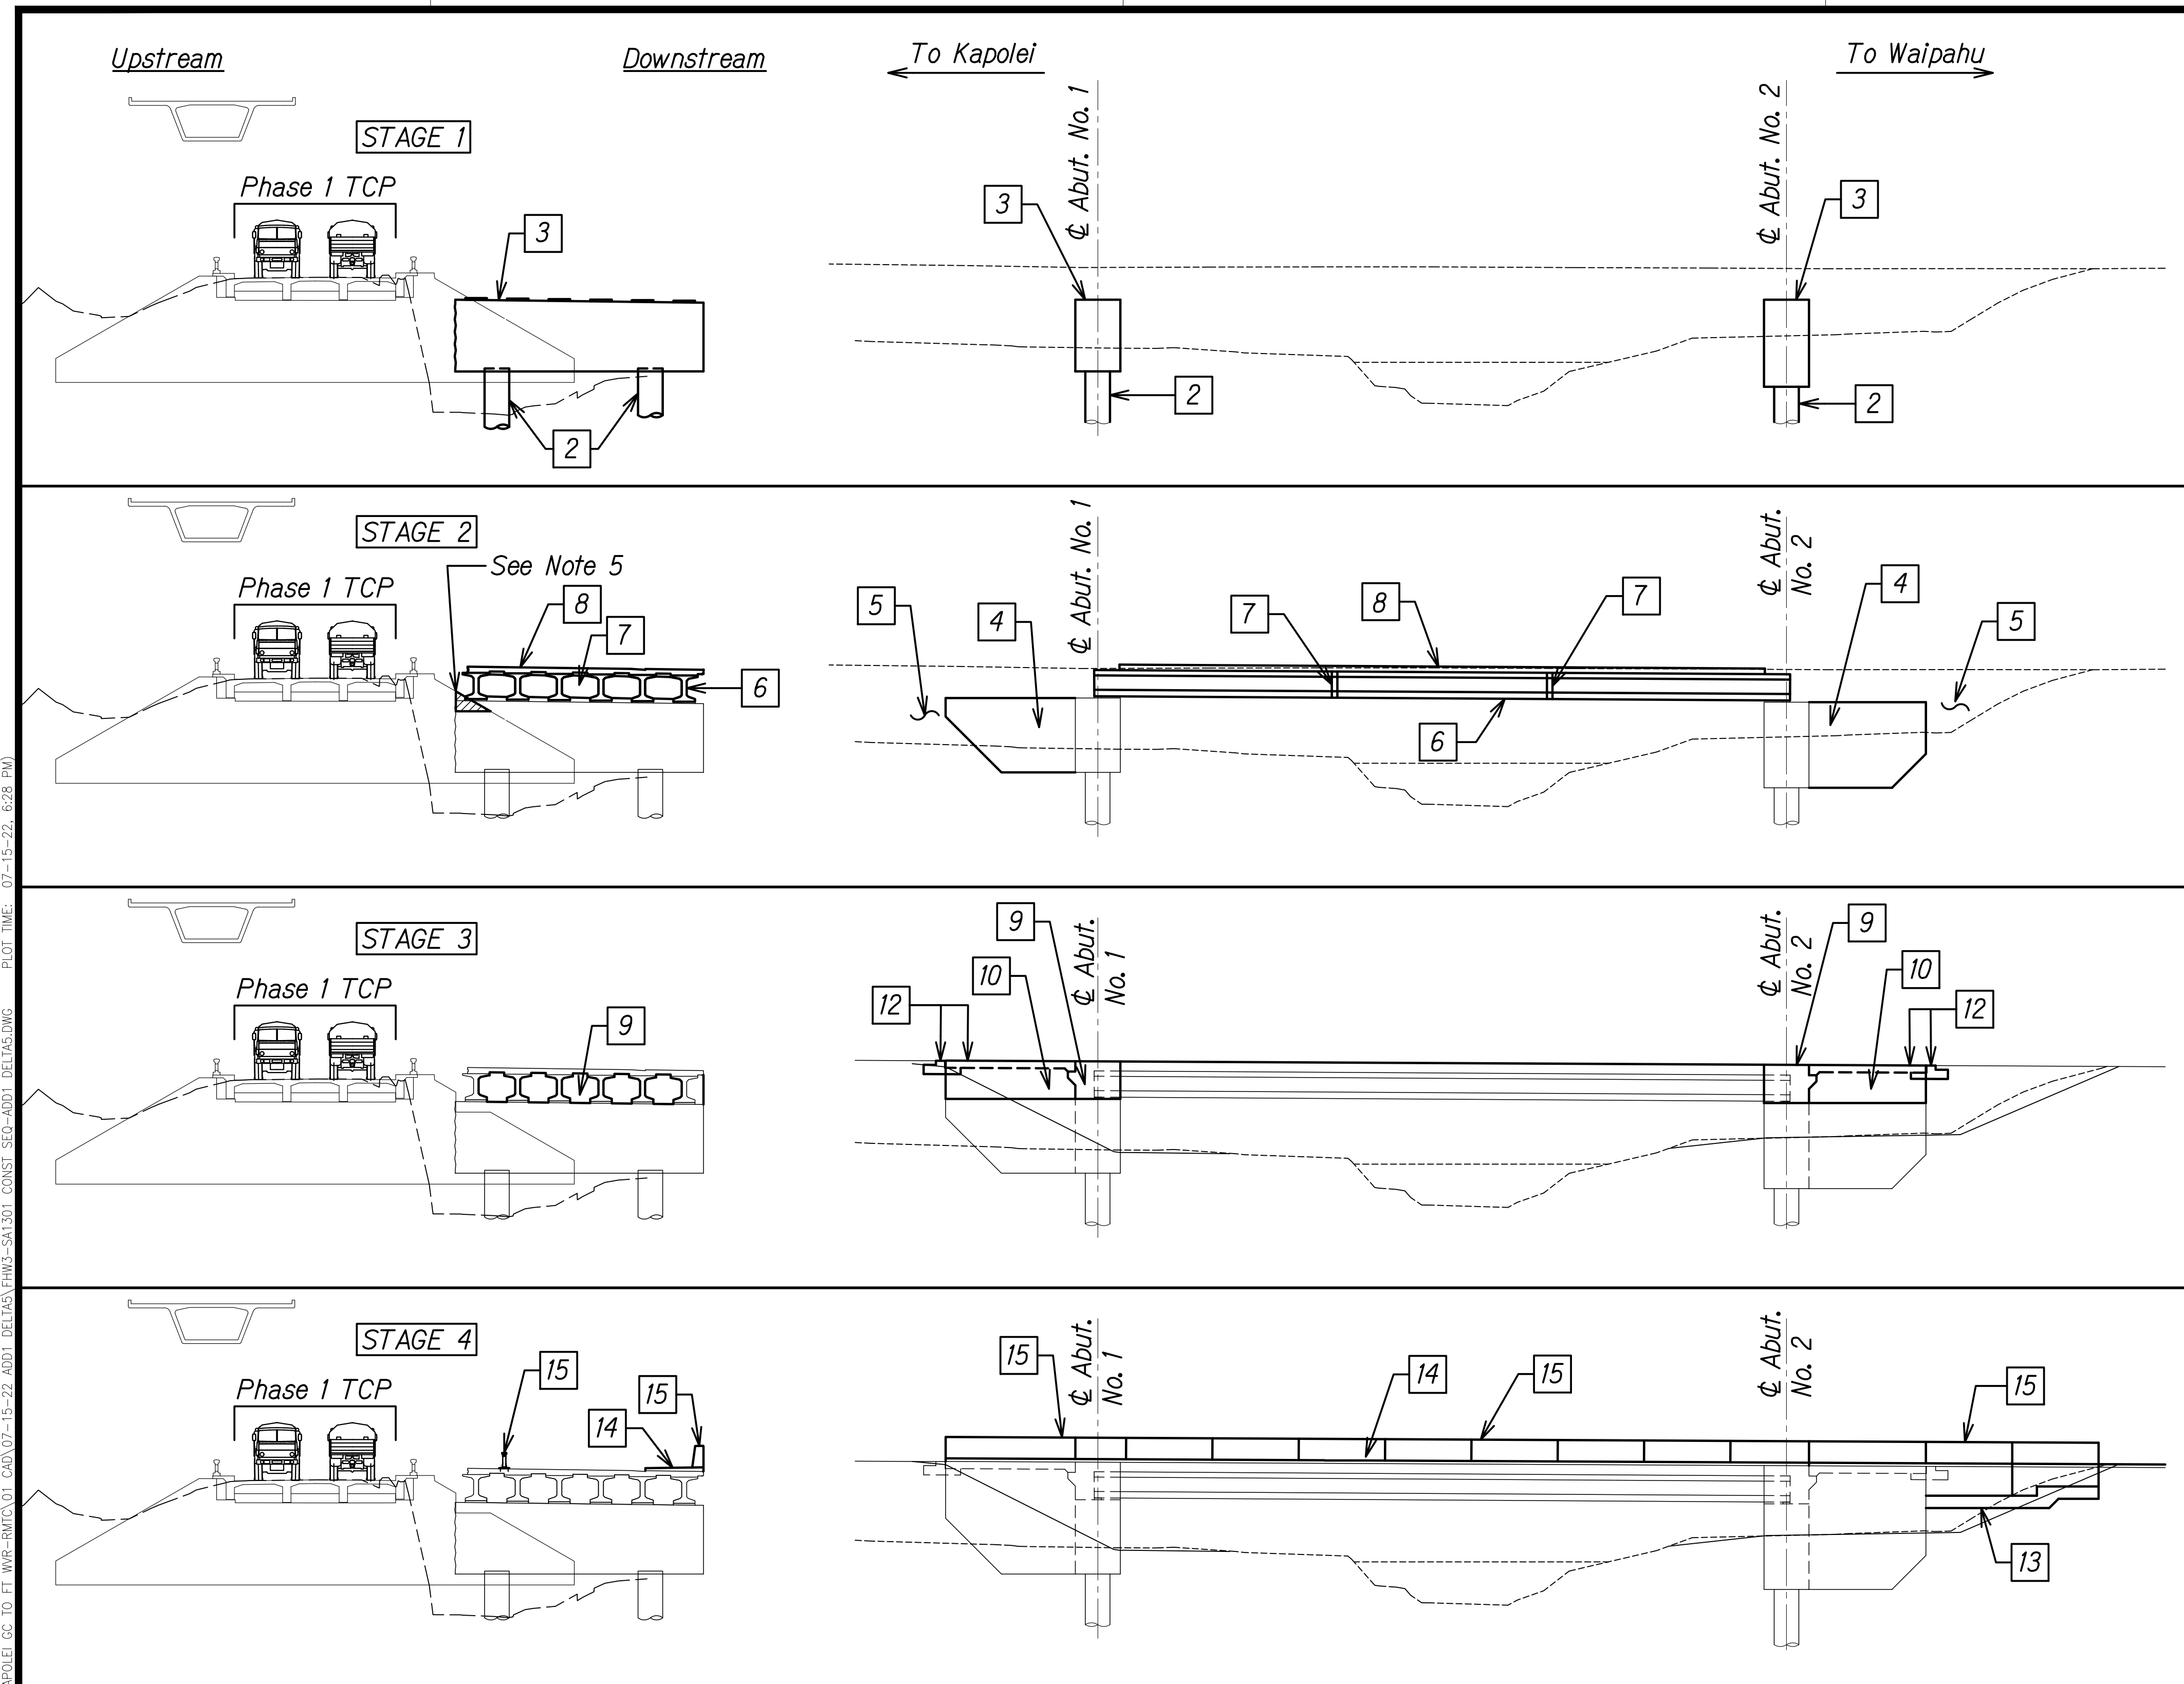

**CONSTRUCTION STAGE 1 - MAKAI BRIDGE**

- 1 Install trial and load test shaft.
- 2 Excavate to bottom of drilled shaft cap beam and install production drilled shafts ②, ③, ⑤, and ⑥.
- 3 Construct drilled shaft cap beams including seats, See Note 3.

**CONSTRUCTION STAGE 2 - MAKAI BRIDGE**

- 4 Construct wingwalls 2 and 4 and keywalls to top of drilled shaft cap beam, see Note 4.
- 5 Backfill behind abutment to 1'-0" below top of drilled shaft cap beam. Do not exceed 2-ft lifts for CLSM placement.
- 6 Erect girders G-5 through G-10, see Note 5.
- 7 Construct intermediate diaphragms.
- 8 Pour concrete deck, see Note 6.

**CONSTRUCTION STAGE 3 - MAKAI BRIDGE**

- 9 Pour end beams and corbel a minimum of 30 days after step 8. Concrete pour shall occur between 1:00 am and 4:00 am.
- 10 Construct remainder of wingwalls, see Note 7.
- 11 Backfill behind abutment to bottom of approach slab and sleeper slab.
- 12 Construct sleeper slab and approach slab, see Note 8.

**CONSTRUCTION STAGE 4 - MAKAI BRIDGE**

- 13 Construct retaining walls, see Note 9.
- 14 Pour sidewalk on downstream side of bridge, see Note 10.
- 15 Construct bridge railings, end posts, and temporary construction barriers.
- 16 Blanket grind and mechanically groove bridge deck, approach slabs, and sleeper slabs, see Note 11.

SEE PHASE 1 TCP - SHEET TC-15


SURVEY PLOTTED BY	DATE
DRAWN BY	
DESIGNED BY	
QUANTITIES BY	
CHECKED BY	
ORIGINAL PLAN	
NOTE BOOK	
No.	

DRAWING NAME: 2A100 UNDOINGS-20-013-FARR-HWY-KAPOLEI GC ID: ET-WR-EMTCV01 CAD: 07-15-22 AD01 DELIAS, EHW3-S41301 CONST: SE0-ADD1 DELIAS, EHW3-S41301 PLOT TIME: 07-15-22 6:28 PM

07/15/22	5	Revised Sheet Reference
06/08/22	2	Revised Sheet Reference
DATE		REVISION

THIS WORK WAS PREPARED BY ME OR UNDER MY SUPERVISION AND CONSTRUCTION OF THIS PROJECT WILL BE UNDER MY OBSERVATION.

*Paul S. Miyahara*  
 SIGNATURE  
 EXPIRATION DATE OF THE LICENSE: April 30, 2024

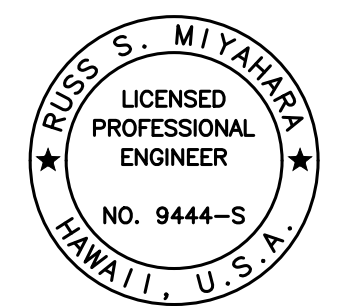

STATE OF HAWAII  
 DEPARTMENT OF TRANSPORTATION  
 HIGHWAYS DIVISION


**Honouliuli Stream Bridge  
 Construction Sequence**

FARRINGTON HIGHWAY WIDENING  
 Kapolei Golf Course Road to Fort Weaver Road  
 Project No. 7101A-01-20

Scale: As Shown Date: Apr. 2022

**SHEET No. SA131 OF 3 SHEETS**

FED. ROAD DIST. NO.	STATE	PROJ. NO.	FISCAL YEAR	SHEET NO.	TOTAL SHEETS
HAWAII	HAW.	7101A-01-20	2021	ADD. 413	

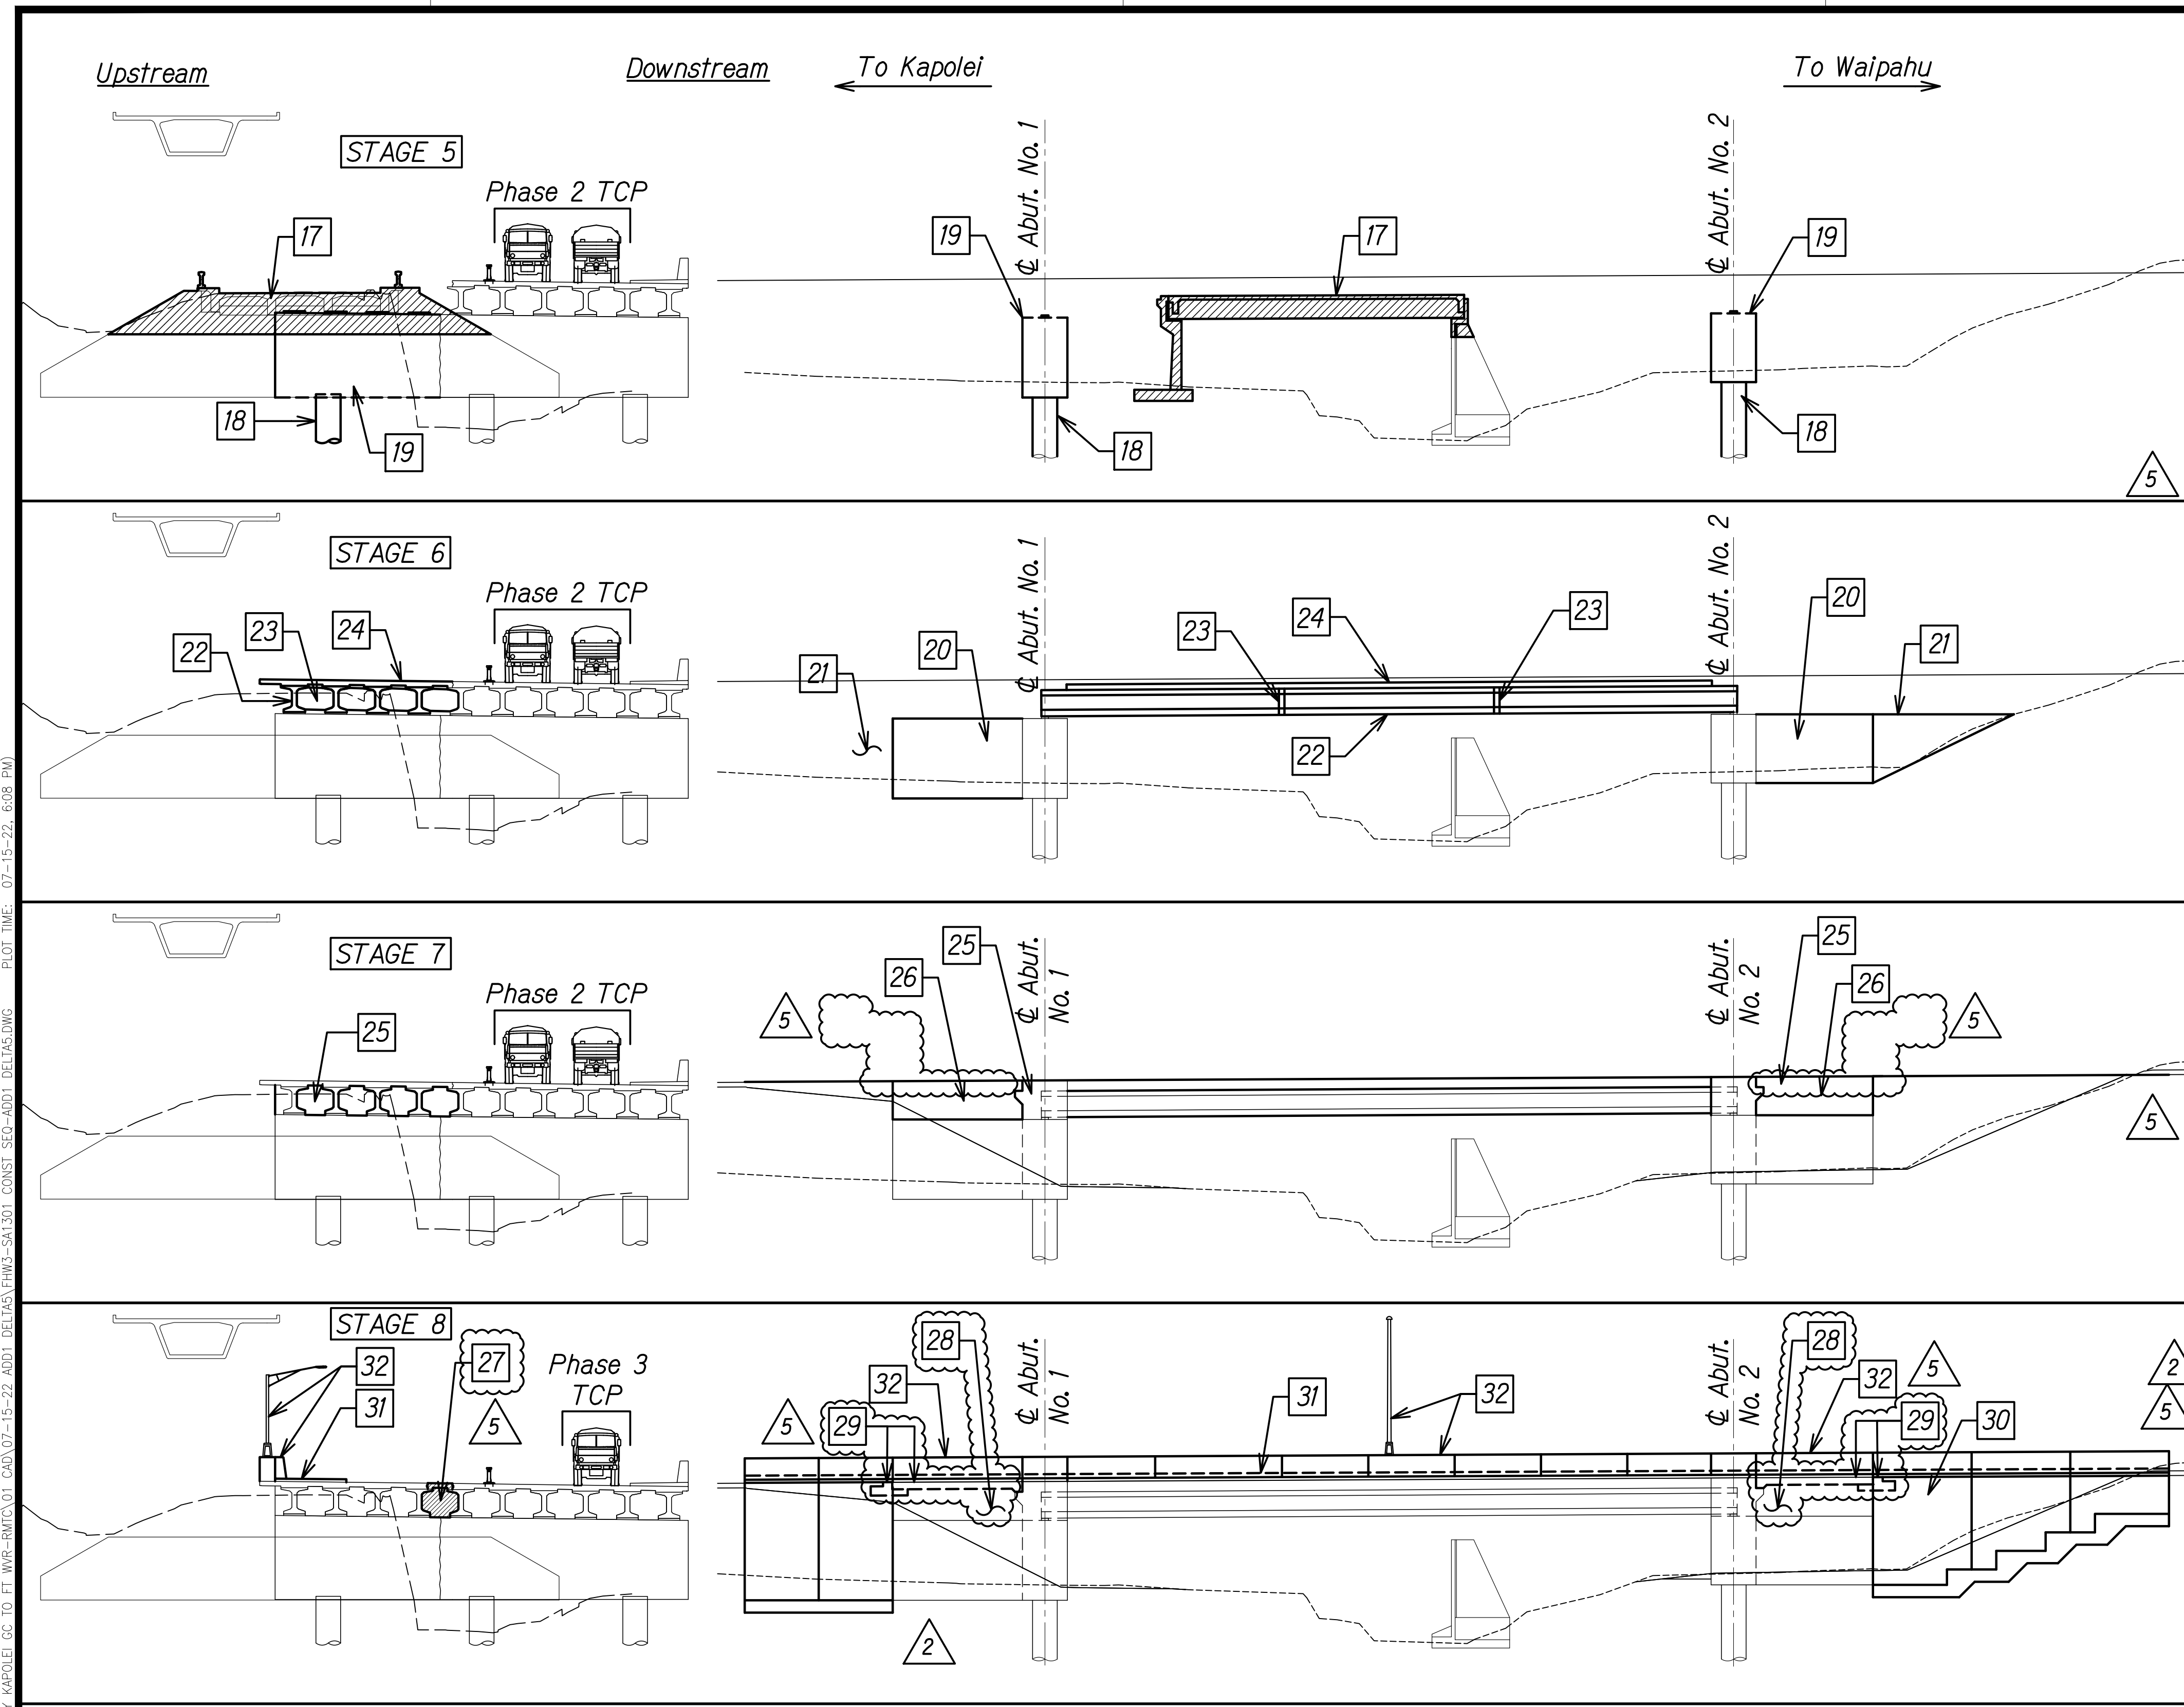

- CONSTRUCTION STAGE 5 - MAUKA BRIDGE**
- 17 Demolish existing bridge superstructure and substructure.
  - 18 Excavate to bottom of drilled shaft cap beam and install production drilled shafts (1) and (4).
  - 19 Construct drilled shaft cap beams including seats, see Note 12.
- CONSTRUCTION STAGE 6 - MAUKA BRIDGE**
- 20 Construct wingwalls 1 and 3 and keywalls to top of drilled shaft cap beam, see Note 13.
  - 21 Backfill behind abutment to 1'-0" below top of drilled shaft cap. Do not exceed 2-ft lifts for CLSM placement.
  - 22 Erect girders G-1 through G-4, see Note 14.
  - 23 Construct intermediate diaphragms.
  - 24 Pour concrete deck, see Note 15.
- CONSTRUCTION STAGE 7 - MAUKA BRIDGE**
- 25 Pour end beams and corbel a minimum of 30 days after step 24. Concrete pour shall occur between 1:00 am and 4:00 am.
  - 26 Construct remainder of wingwalls, see Note 16.
- CONSTRUCTION STAGE 8 - MAUKA BRIDGE**
- 27 Place closure pour at end beams, corbel, deck, and diaphragm locations between Mauka and Makai bridge using VESLMC. Concrete pour shall occur between 1:00 am and 4:00 am.
  - 28 Backfill behind abutment to bottom of approach slab and sleeper slab.
  - 29 Construct sleeper slab and approach slab, see Note 17.
  - 30 Construct retaining walls, see Note 18.
  - 31 Pour sidewalk on upstream side of bridge, see Note 19.
  - 32 Construct bridge railings, end posts, and light standards.
  - 33 Blanket grind and mechanically groove bridge deck, approach slabs, and sleeper slabs, see Note 20.

SEE PHASE 2 TCP - SHEET TC-21

SEE PH. 3 TCP SHEET TC-22

SEE PH. 2 TCP SHEET TC-21

SURVEY PLOTTED BY	DATE
DRAWN BY	
DESIGNED BY	
QUANTITIES BY	
CHECKED BY	
ORIGINAL PLAN	
NOTE BOOK	
No.	

DRAWING NAME: Z:\A00\_000\000\20-013-FARR-HW-KAPOLEI-GC-10-ET-WRP-EMTC\01-CA\07-15-22-ADD1-DEL\AS-EMTS-S4-1301-CONST-SEO-ADD1-DEL\DWG-07-15-22-608.dwg

DATE	REVISION
07/15/22	5 Revised Sheet Reference and Callout
06/08/22	2 Revised Details

THIS WORK WAS PREPARED BY ME OR UNDER MY SUPERVISION AND CONSTRUCTION OF THIS PROJECT WILL BE UNDER MY OBSERVATION.

*Paul S. Miyahara*  
 SIGNATURE  
 EXPIRATION DATE OF THE LICENSE: April 30, 2024

STATE OF HAWAII  
 DEPARTMENT OF TRANSPORTATION  
 HIGHWAYS DIVISION



**Honouliuli Stream Bridge  
 Construction Sequence**

FARRINGTON HIGHWAY WIDENING  
 Kapolei Golf Course Road to Fort Weaver Road  
 Project No. 7101A-01-20

Scale: As Shown      Date: Apr. 2022

SHEET No. SA13.2 OF 3 SHEETS

FED. ROAD DIST. NO.	STATE	PROJ. NO.	FISCAL YEAR	SHEET NO.	TOTAL SHEETS
HAWAII	HAW.	7101A-01-20	2021	ADD. 423	

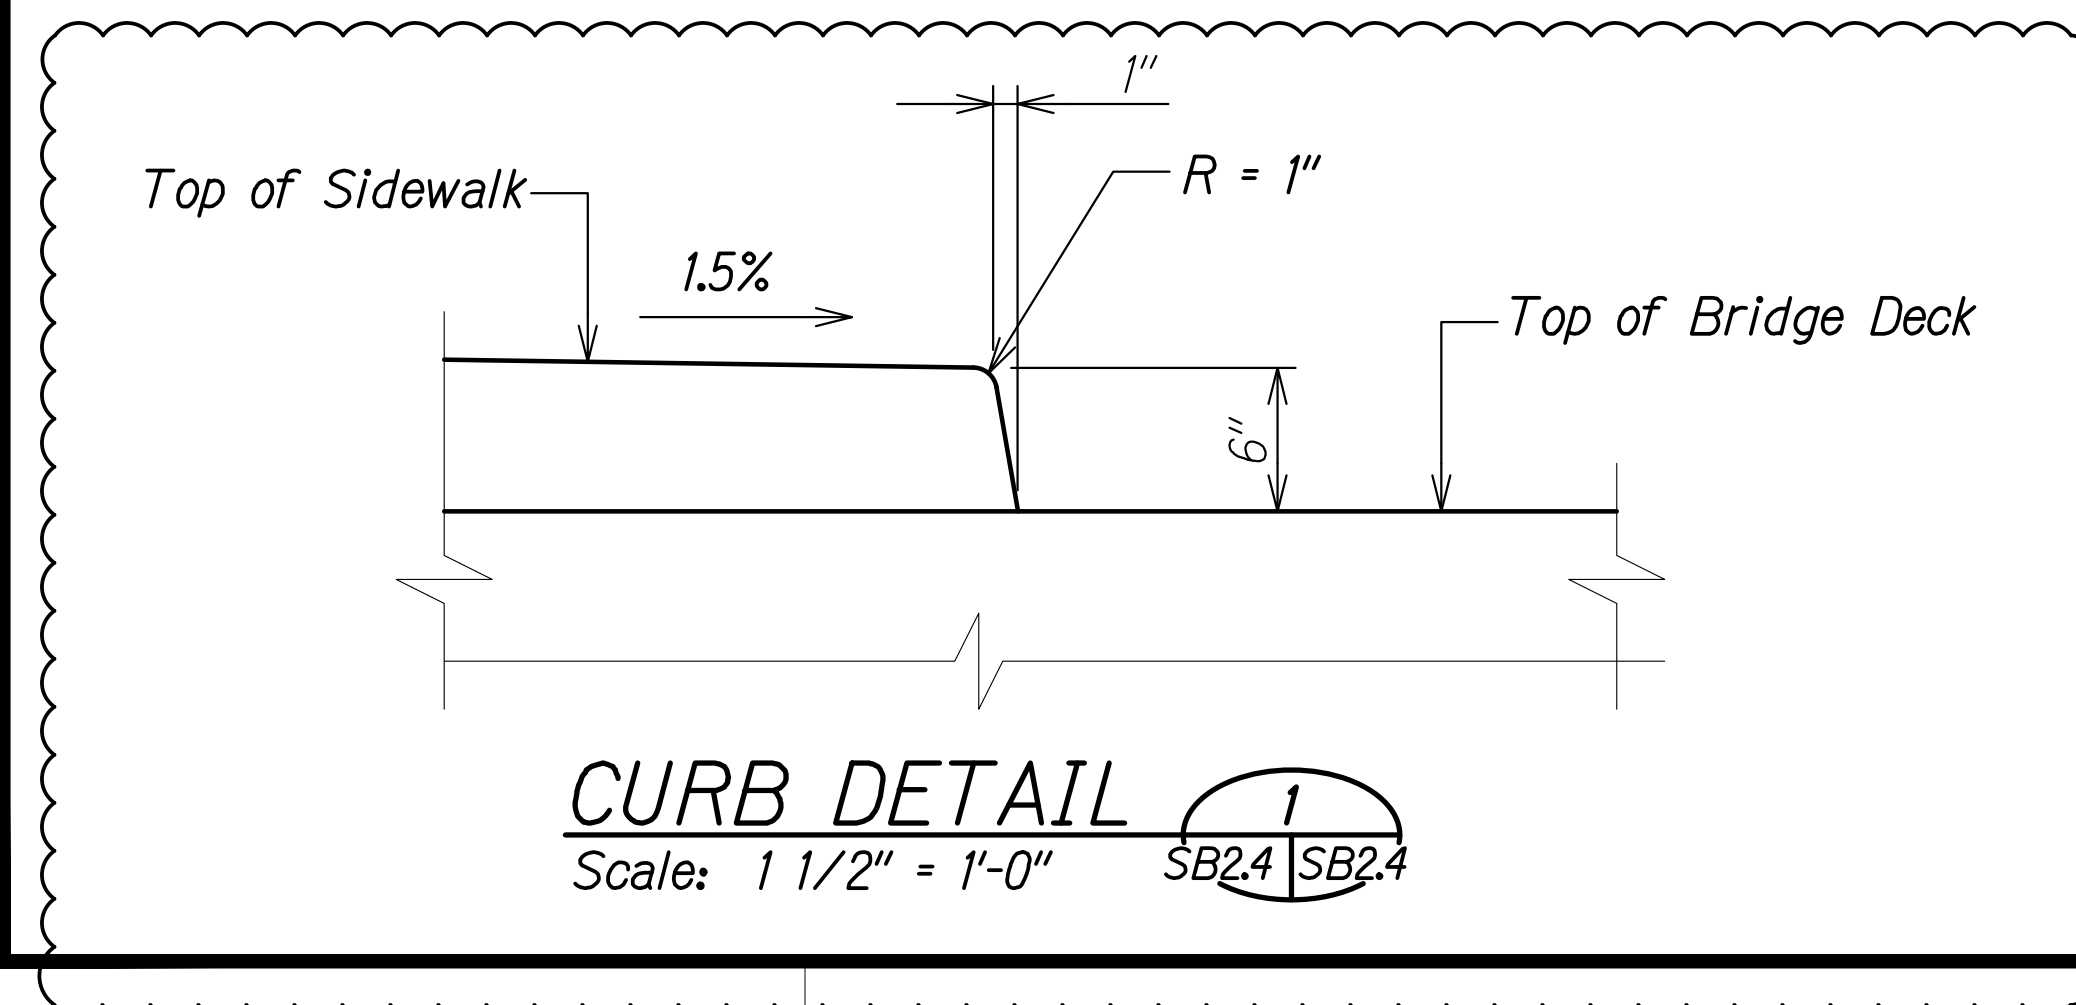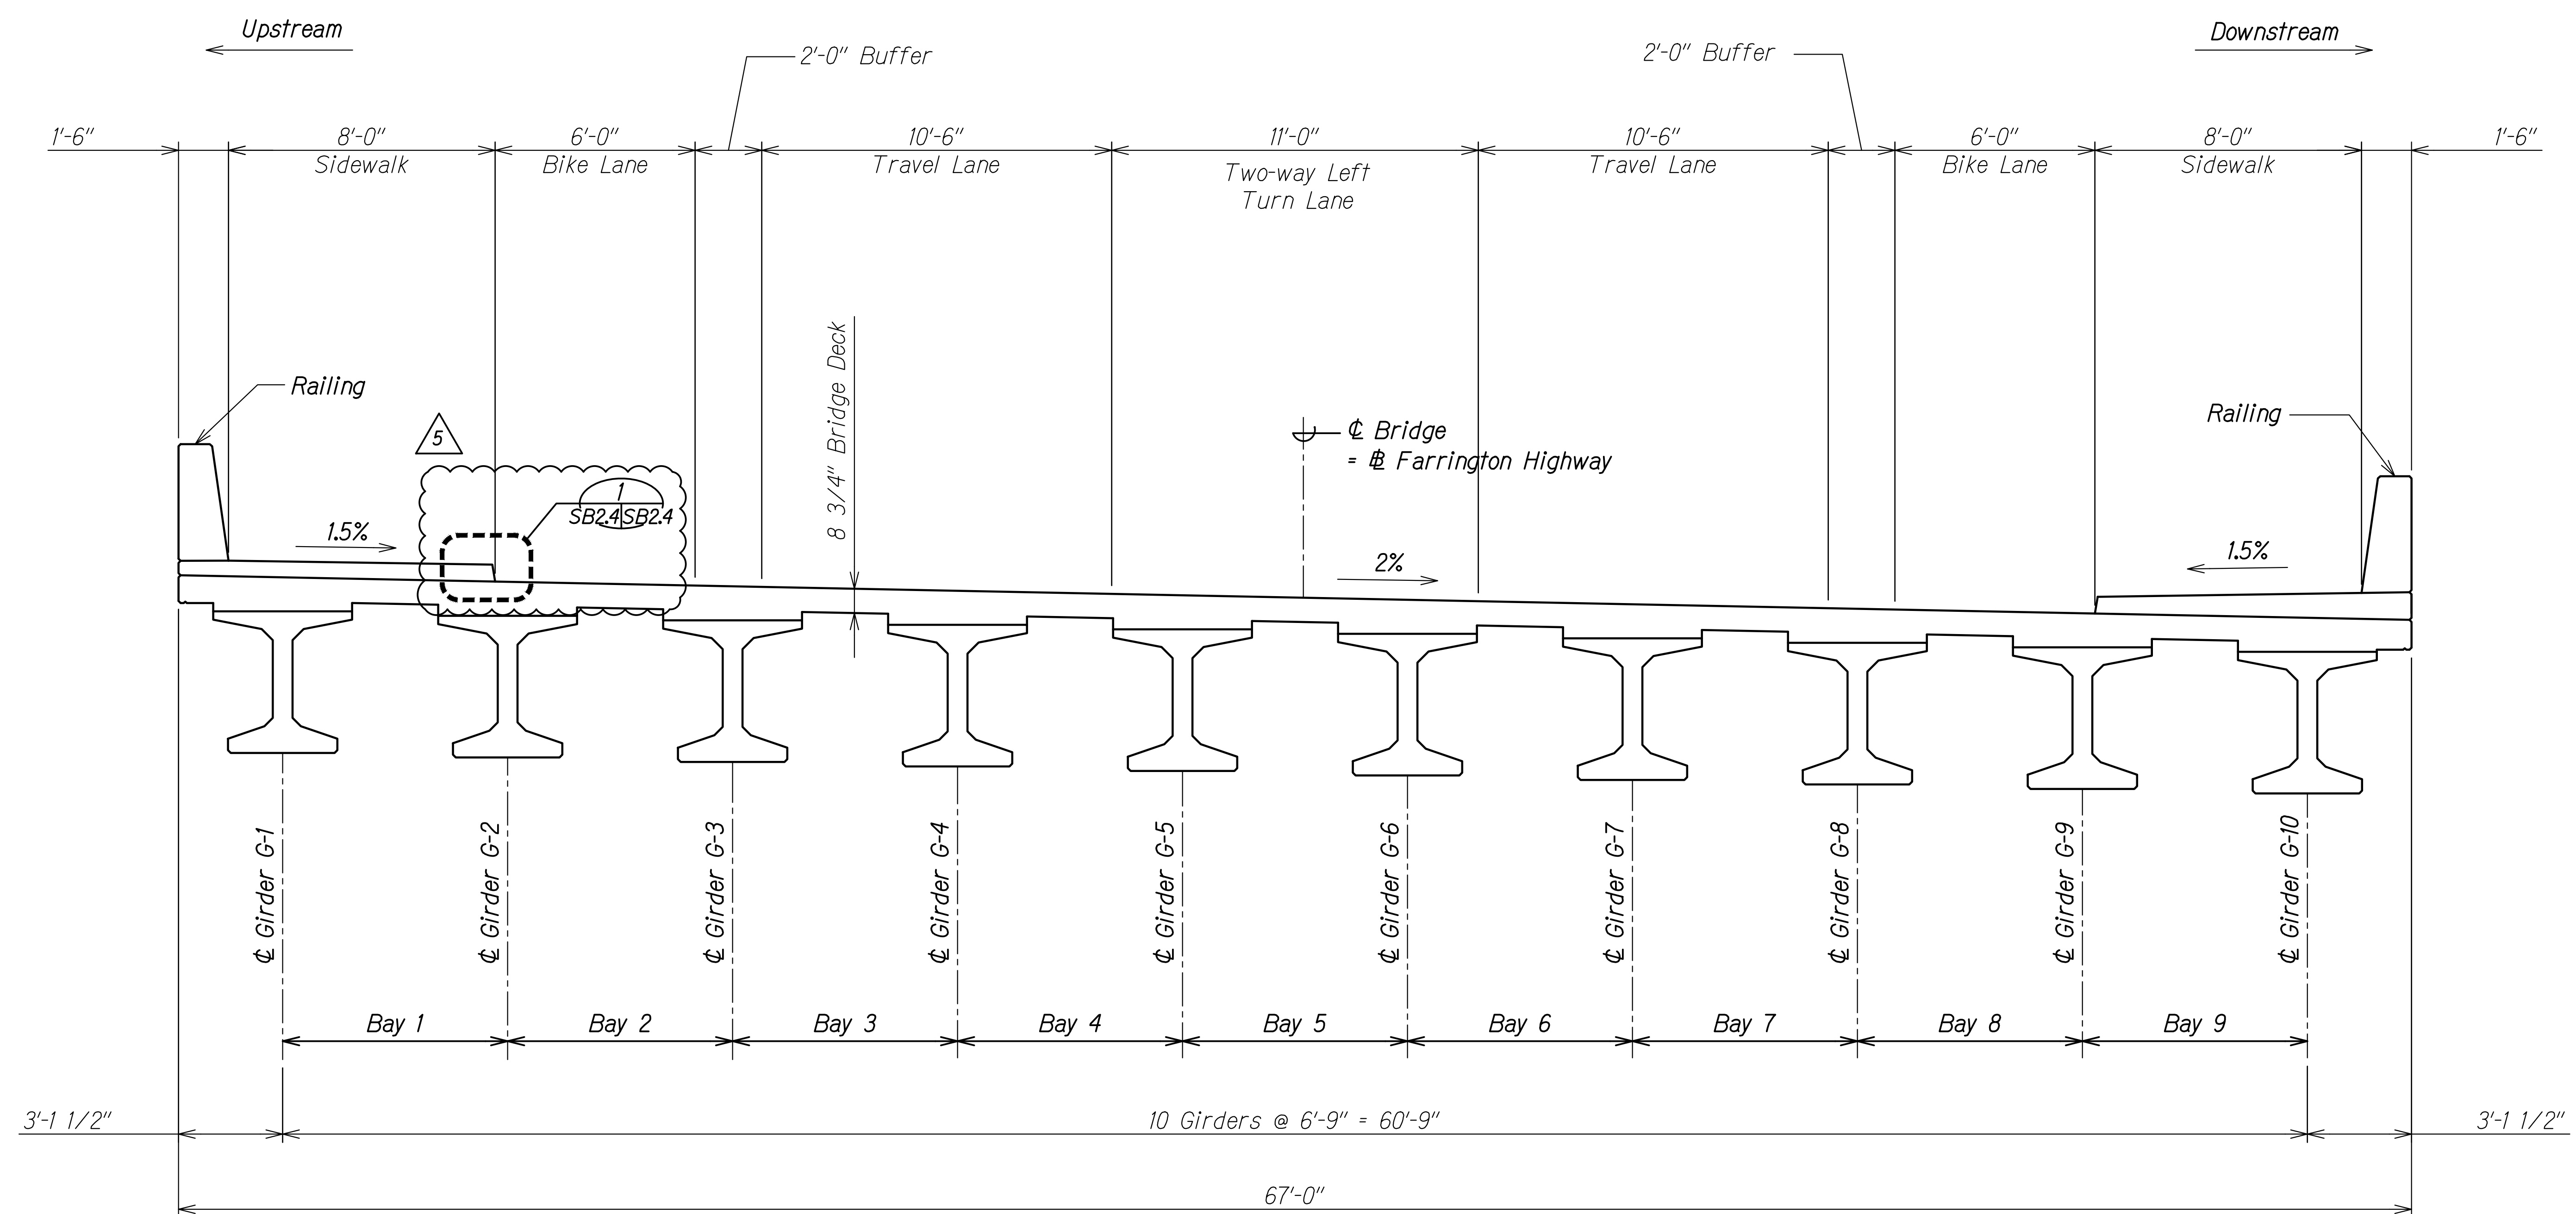


**TYPICAL TRANSVERSE SECTION**  
Scale: 3/8" = 1'-0" A SB2.4 SB2.4

SURVEY PLOTTED BY	DATE
DRAWN BY	
DESIGNED BY	
QUANTITIES BY	
CHECKED BY	
ORIGINAL PLAN	
NOTE BOOK	
No.	

DRAWING NAME: Z:\100 ONGOING\20-013-FARR-HWY-KAPOLEI\GC\_ID\_ET\_WPG-EMTC\01\_GAD\07-15-22 ADD1 DELIAS\EMHS-SB0204 KAL TYP TRANS SECT ADDS.DWG PLOT TIME: 07-15-22 5:34 PM

THIS WORK WAS PREPARED BY ME OR UNDER MY SUPERVISION AND CONSTRUCTION OF THIS PROJECT WILL BE UNDER MY OBSERVATION.  
*Paul S. Miyahara*  
 SIGNATURE      April 30, 2024      EXPIRATION DATE OF THE LICENSE

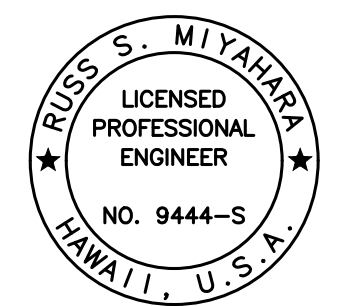


07/15/22	5	Added Curb Detail
DATE		REVISION
STATE OF HAWAII DEPARTMENT OF TRANSPORTATION HIGHWAYS DIVISION <b>Kaloi Gulch Bridge</b> <b>Typical Transverse Section</b> FARRINGTON HIGHWAY WIDENING Kapolei Golf Course Road to Fort Weaver Road Project No. 7101A-01-20 Scale: As Shown      Date: Apr. 2022 <b>SHEET No. SB2.4 OF 5 SHEETS</b>		







FED. ROAD DIST. NO.	STATE	PROJ. NO.	FISCAL YEAR	SHEET NO.	TOTAL SHEETS
HAWAII	HAW.	7101A-01-20	2021	ADD. 465	

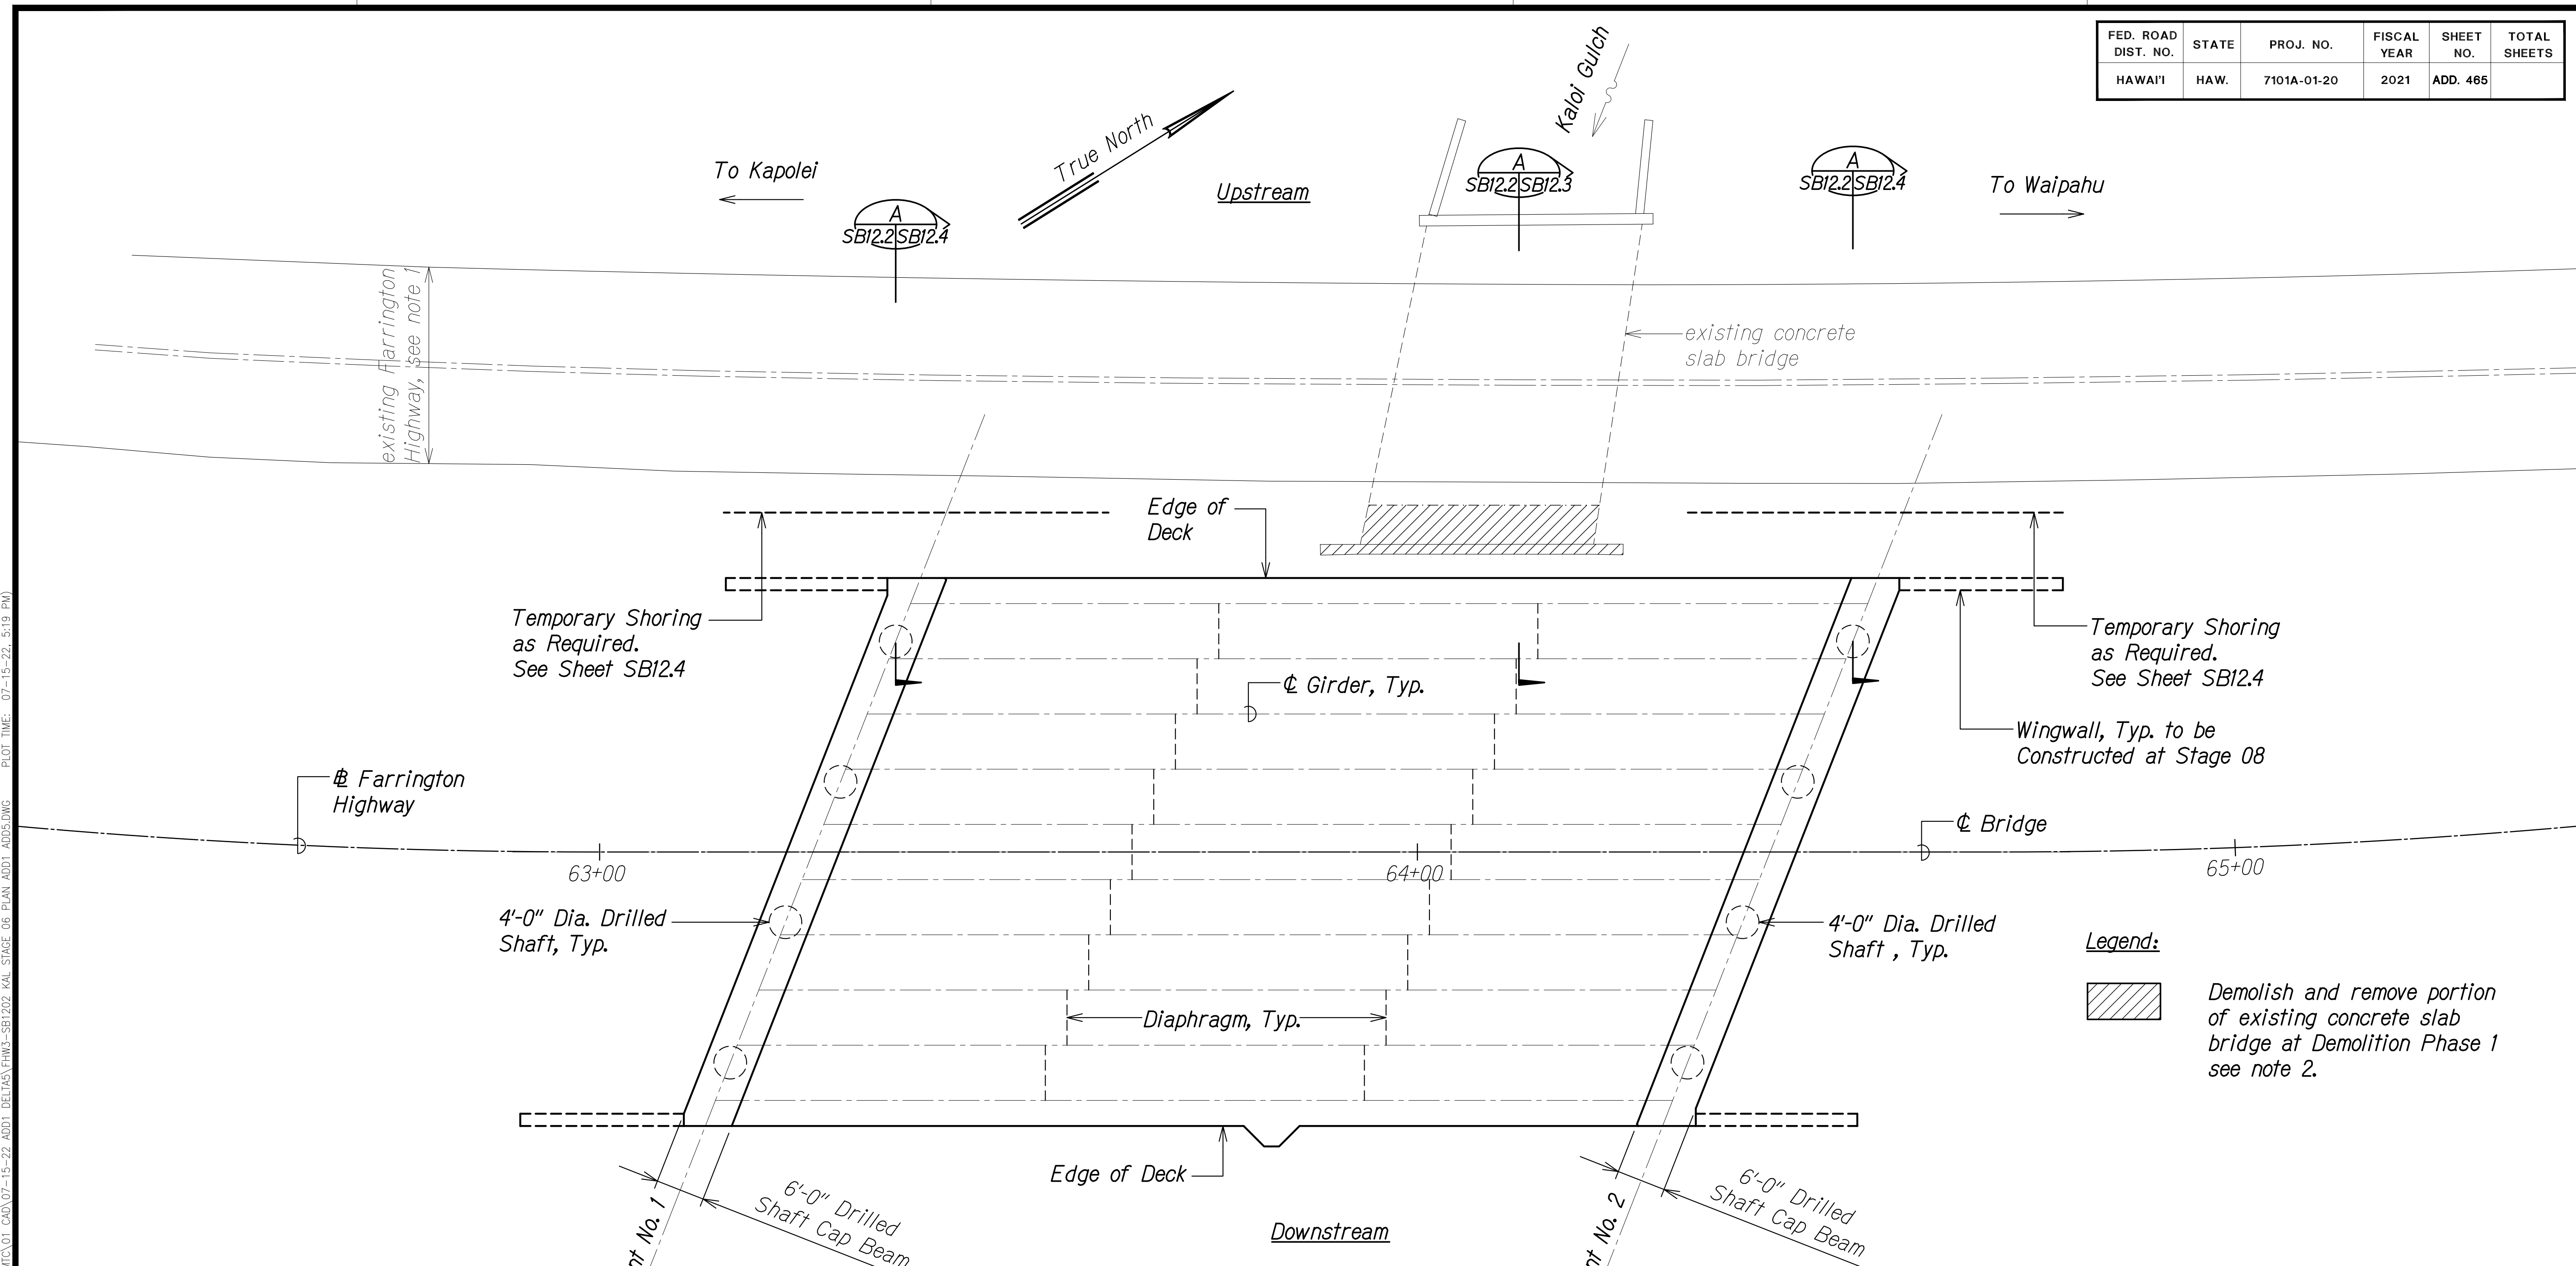

**Legend:**

Demolish and remove portion of existing concrete slab bridge at Demolition Phase 1 see note 2.

- Notes:**
- Existing Farrington Highway roadway shown as reference only. For detour road and temporary barrier requirements, see Civil sheet TC-10,
  - For demolition of all existing structures, see sheets SB3.1 to SB3.5.
  - For temporary shoring requirements and contractor submittals, see structural general note 8.H. Temporary slopes for excavation shall be 1H:1V or flatter.

**LAYOUT PLAN - STAGE 06**   
Scale: 1" = 10'-0" SB12.2 | SB12.2

SURVEY PLOTTED BY	DATE
DRAWN BY	
DESIGNED BY	
QUANTITIES BY	
CHECKED BY	
ORIGINAL PLAN	
NOTE BOOK	
No.	

DRAWING NAME: Z:\A\00\CONSTRUCTION\20-013-FARR-HWY-KAPOLEI\GC\10-ET-WIP-EMTC\01-GAD\07-15-22\ADD1-DELTA5\ENR\3-SB12.202 KAL STAGE 06 PLAN ADD1-ADD5.DWG PLOT TIME: 07-15-22: 5:19 PM

THIS WORK WAS PREPARED BY ME OR UNDER MY SUPERVISION AND CONSTRUCTION OF THIS PROJECT WILL BE UNDER MY OBSERVATION.  
*Ruges S. Miyahara*  
SIGNATURE      April 30, 2024  
EXPIRATION DATE OF THE LICENSE

DATE	REVISION
07/15/22	Revised Note
06/08/22	Revised Note

STATE OF HAWAII  
**DEPARTMENT OF TRANSPORTATION**  
HIGHWAYS DIVISION



**Kaloi Gulch Bridge**  
**Layout Plan During Construction**

FARRINGTON HIGHWAY WIDENING  
Kapolei Golf Course Road to Fort Weaver Road  
Project No. 7101A-01-20


Scale: As Shown      Date: Apr. 2022

**SHEET No. SB12.2 OF 4 SHEETS**

FED. ROAD DIST. NO.	STATE	PROJ. NO.	FISCAL YEAR	SHEET NO.	TOTAL SHEETS
HAWAII	HAW.	7101A-01-20	2021	ADD. 466	

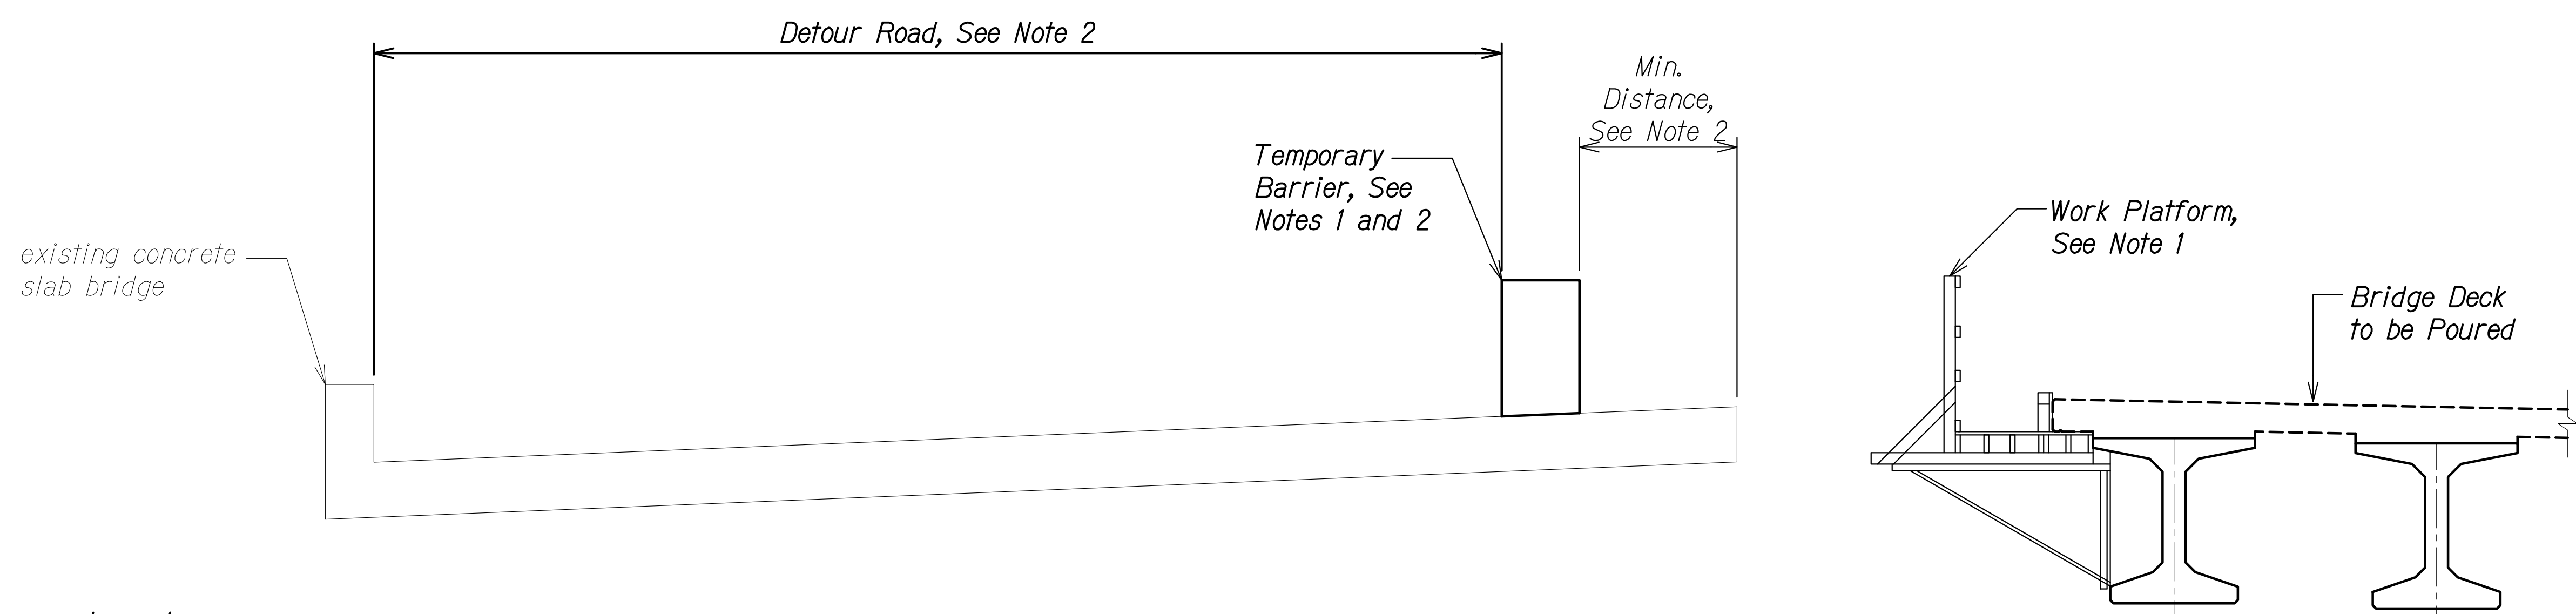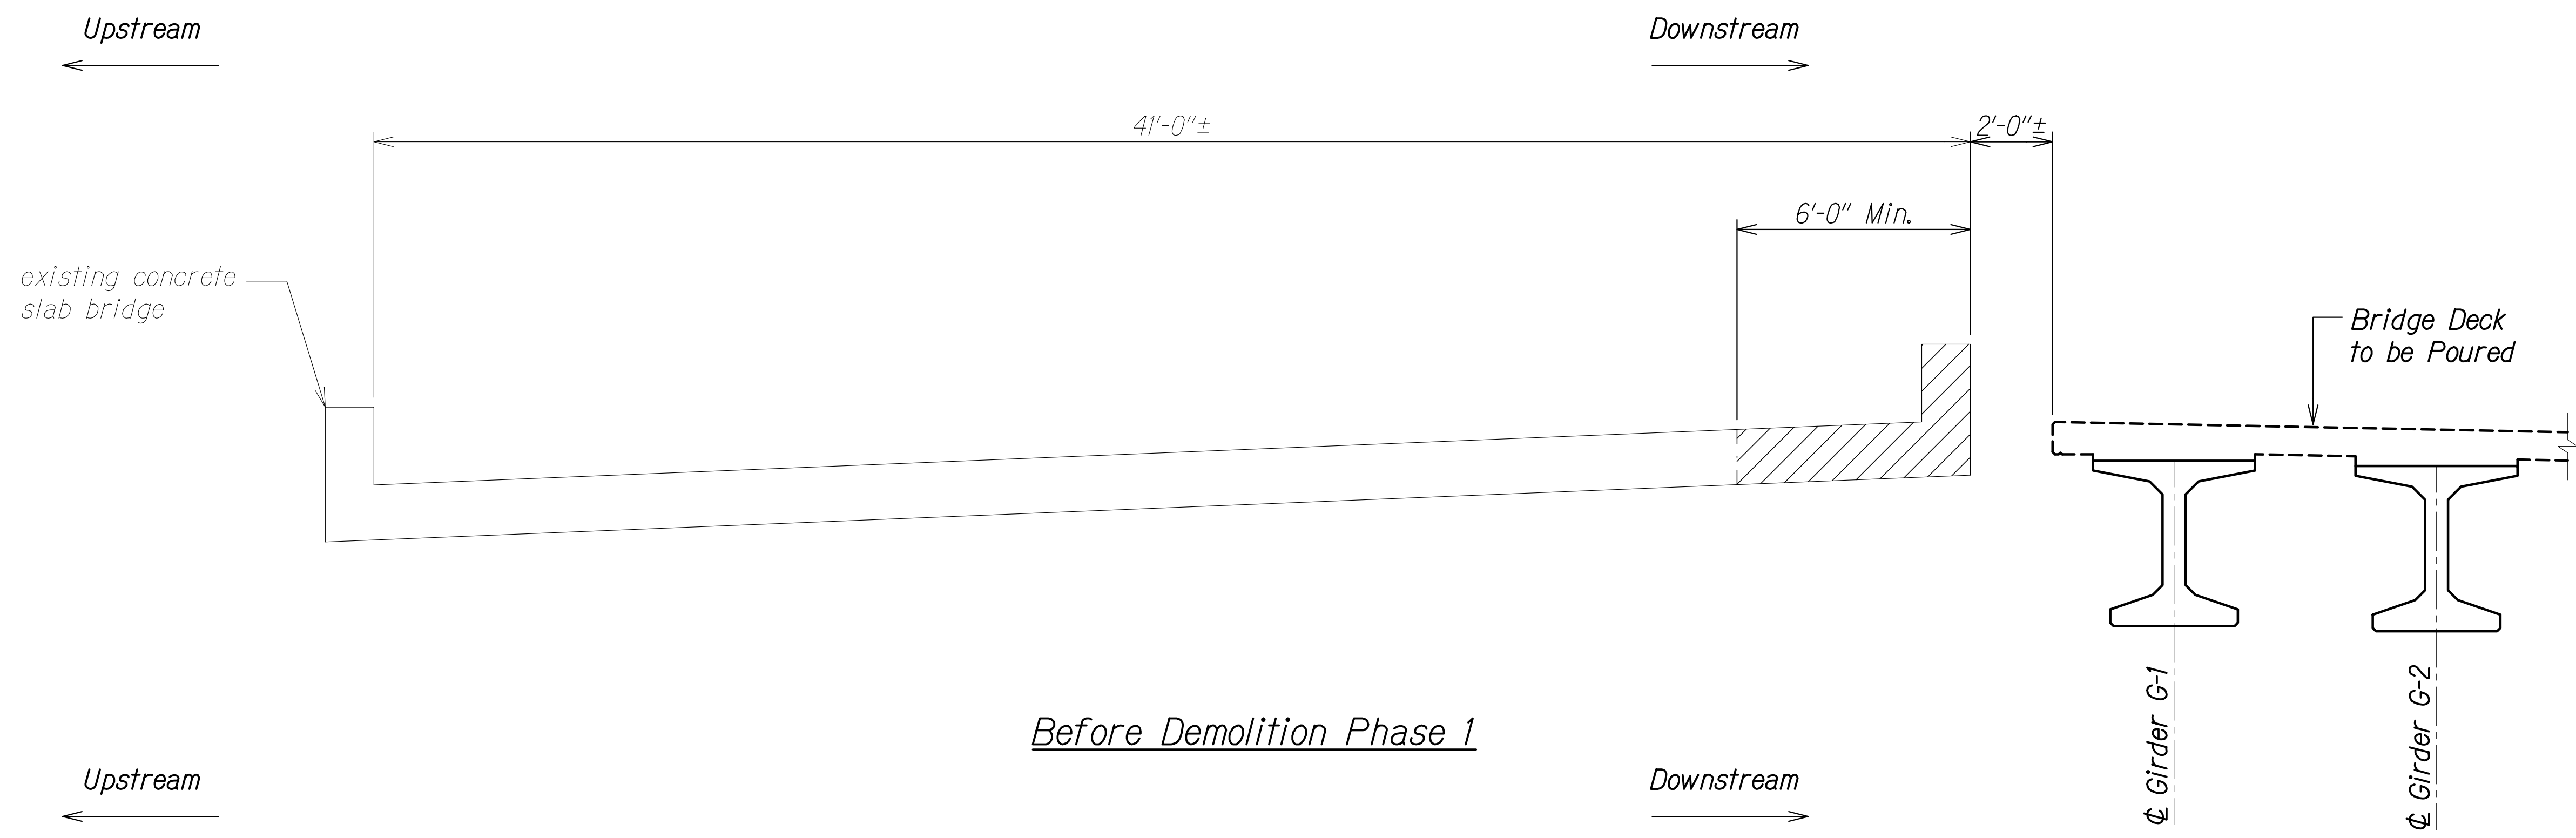

**Legend:**

 Demolish and remove portion of existing concrete slab bridge at Demolition Phase 1.

**Notes:**


1. Work platform and temporary barrier are shown for schematic purposes.
2. For detour road and temporary barrier requirements, see Civil sheet TC-10.
3. Horizontal distances shown are measured perpendicular to Farrington Highway.

After Demolition Phase 1

**SECTION AT STREAM**  
Scale: 3/8" = 1'-0"  
A  
SB12.2 SB12.3

SURVEY PLOTTED BY	DATE
DRAWN BY	
DESIGNED BY	
QUANTITIES BY	
CHECKED BY	
ORIGINAL PLAN	
NOTE BOOK	
No.	

DRAWING NAME: Z:\100 ONGOING\20-013-FARR-HWY-KAPOLEI\GE.ID.IT.WIP-RMTC\01-CA\07-15-22 ADD1-ADD5.DWG PLOT TIME: 07-15-22 5:50 PM

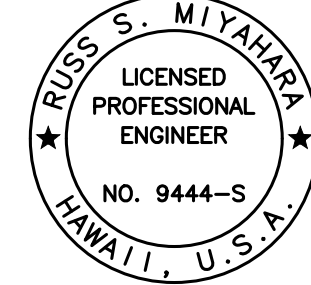  
THIS WORK WAS PREPARED BY ME OR UNDER MY SUPERVISION AND CONSTRUCTION OF THIS PROJECT WILL BE UNDER MY OBSERVATION.  
*Rus S. Miyakawa*  
SIGNATURE  
April 30, 2024  
EXPIRATION DATE OF THE LICENSE

07/15/22	5	Revised Note
06/08/22	2	Revised Note
DATE	REVISION	

STATE OF HAWAII  
DEPARTMENT OF TRANSPORTATION  
HIGHWAYS DIVISION


**Kaloi Gulch Bridge**  
Section During Construction

FARRINGTON HIGHWAY WIDENING  
Kapolei Golf Course Road to Fort Weaver Road  
Project No. 7101A-01-20


Scale: As Shown Date: Apr. 2022

SHEET No. S12.3 OF 4 SHEETS

FED. ROAD DIST. NO.	STATE	PROJ. NO.	FISCAL YEAR	SHEET NO.	TOTAL SHEETS
HAWAII	HAW.	7101A-01-20	2021	ADD. 467	

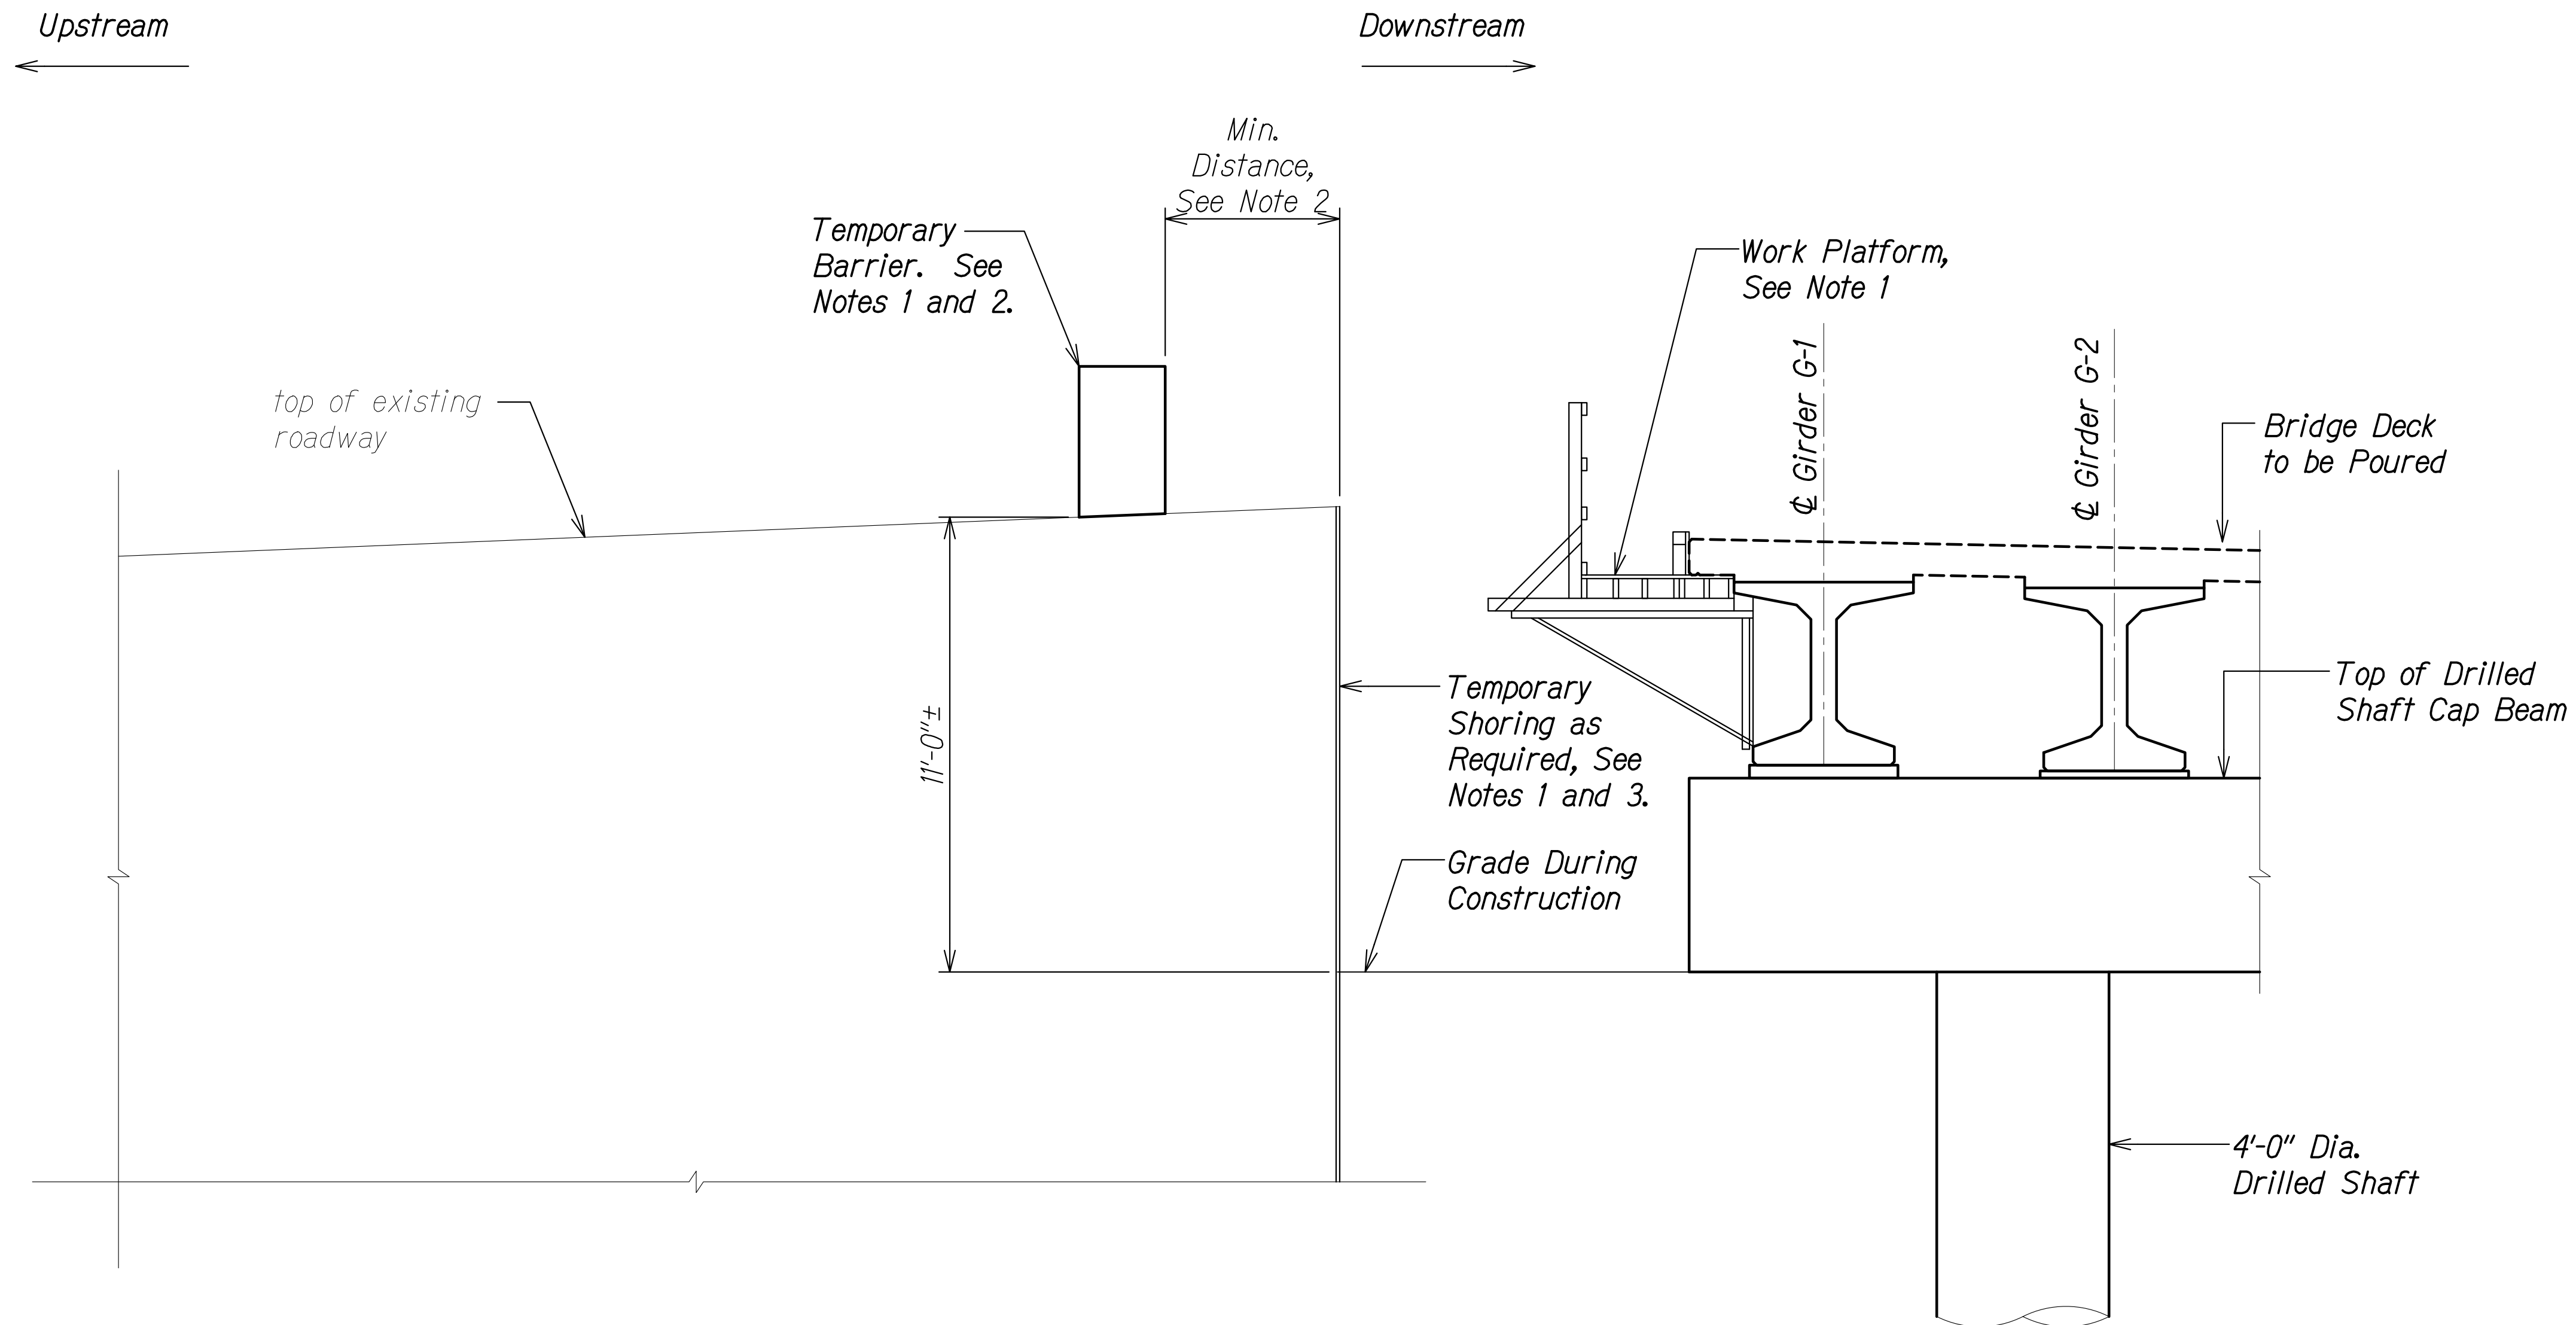


**Notes:**

1. Work platform, temporary barrier, and temporary shoring are shown for schematic purposes.
2. For detour road and temporary barrier requirements, see Civil sheet TC-10, 
3. For temporary shoring requirements and contractor submittals, see structural general note 8.H. Temporary slopes for excavation shall be 1H:1V or flatter.


**SECTION AT NEW ABUTMENT**

Scale: 3/8" = 1'-0"

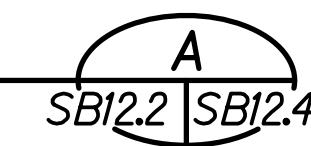



SURVEY PLOTTED BY	DATE
DRAWN BY	
DESIGNED BY	
QUANTITIES BY	
CHECKED BY	
ORIGINAL PLAN	
NOTE BOOK	
No.	

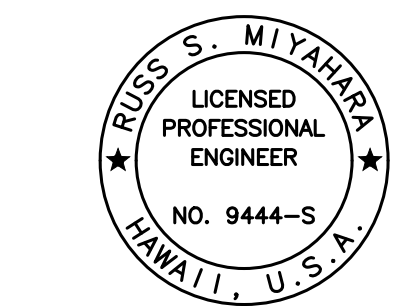DRAWING NAME: Z:\00\_ONGOING\20-013-FARR-HWY-KAPOLEI-GC-10-11-WP-RMTC\01-GAD\07-15-22-ADD1-DELIAS\HWY-SB\203-KAL-STAGE-SECT-ADD1-ADD5.DWG PLOT TIME: 07-15-22, 9:50 PM



THIS WORK WAS PREPARED BY ME OR UNDER MY SUPERVISION AND CONSTRUCTION OF THIS PROJECT WILL BE UNDER MY OBSERVATION.  
*Rugo S. Miyakawa*  
 SIGNATURE      April 30, 2024  
 EXPIRATION DATE OF THE LICENSE

07/15/22		Revised Note
06/08/22		Revised Note
DATE	REVISION	


STATE OF HAWAII  
 DEPARTMENT OF TRANSPORTATION  
 HIGHWAYS DIVISION

**Kaloie Gulch Bridge**  
 Section During Construction


FARRINGTON HIGHWAY WIDENING  
 Kapoleie Golf Course Road to Fort Weaver Road  
 Project No. 7101A-01-20

Scale: As Shown      Date: Apr. 2022


FED. ROAD DIST. NO.	STATE	PROJ. NO.	FISCAL YEAR	SHEET NO.	TOTAL SHEETS
HAWAII	HAW.	7101A-01-20	2021	ADD. 480	

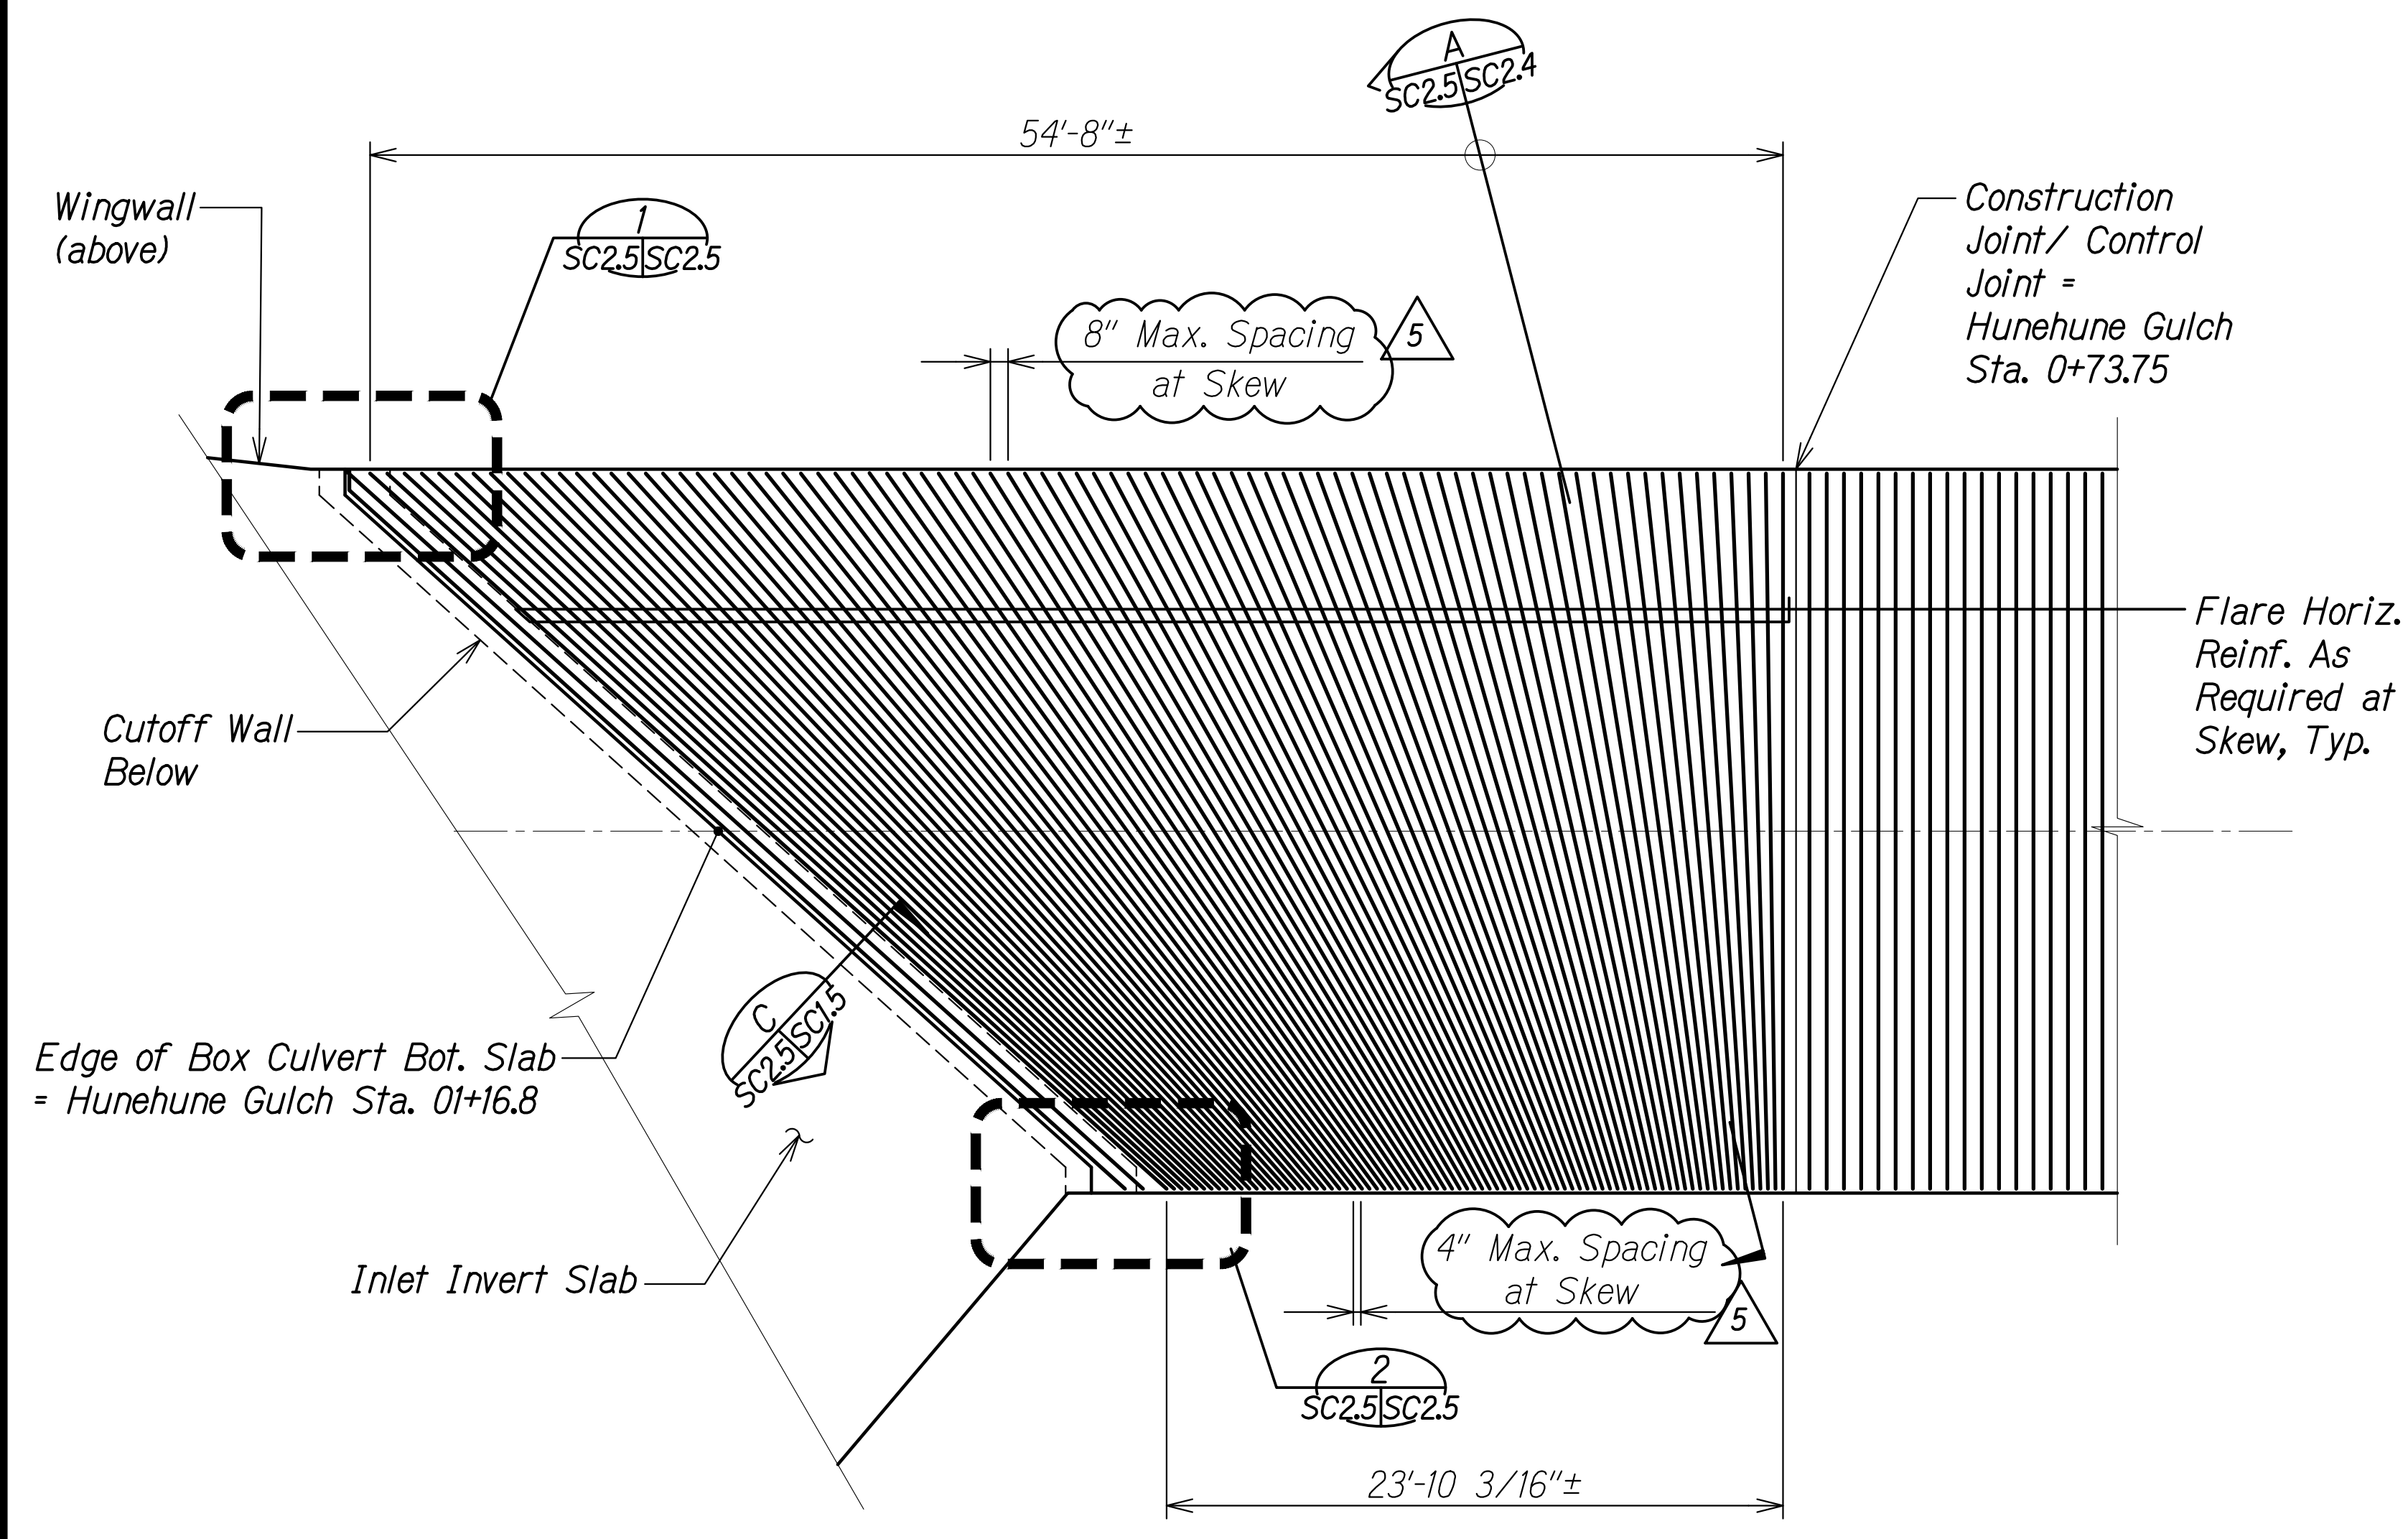

**BOTTOM SLAB REINFORCING PLAN AT INLET** A  
 Scale: 3/16" = 1'-0" SC2.5 | SC2.5

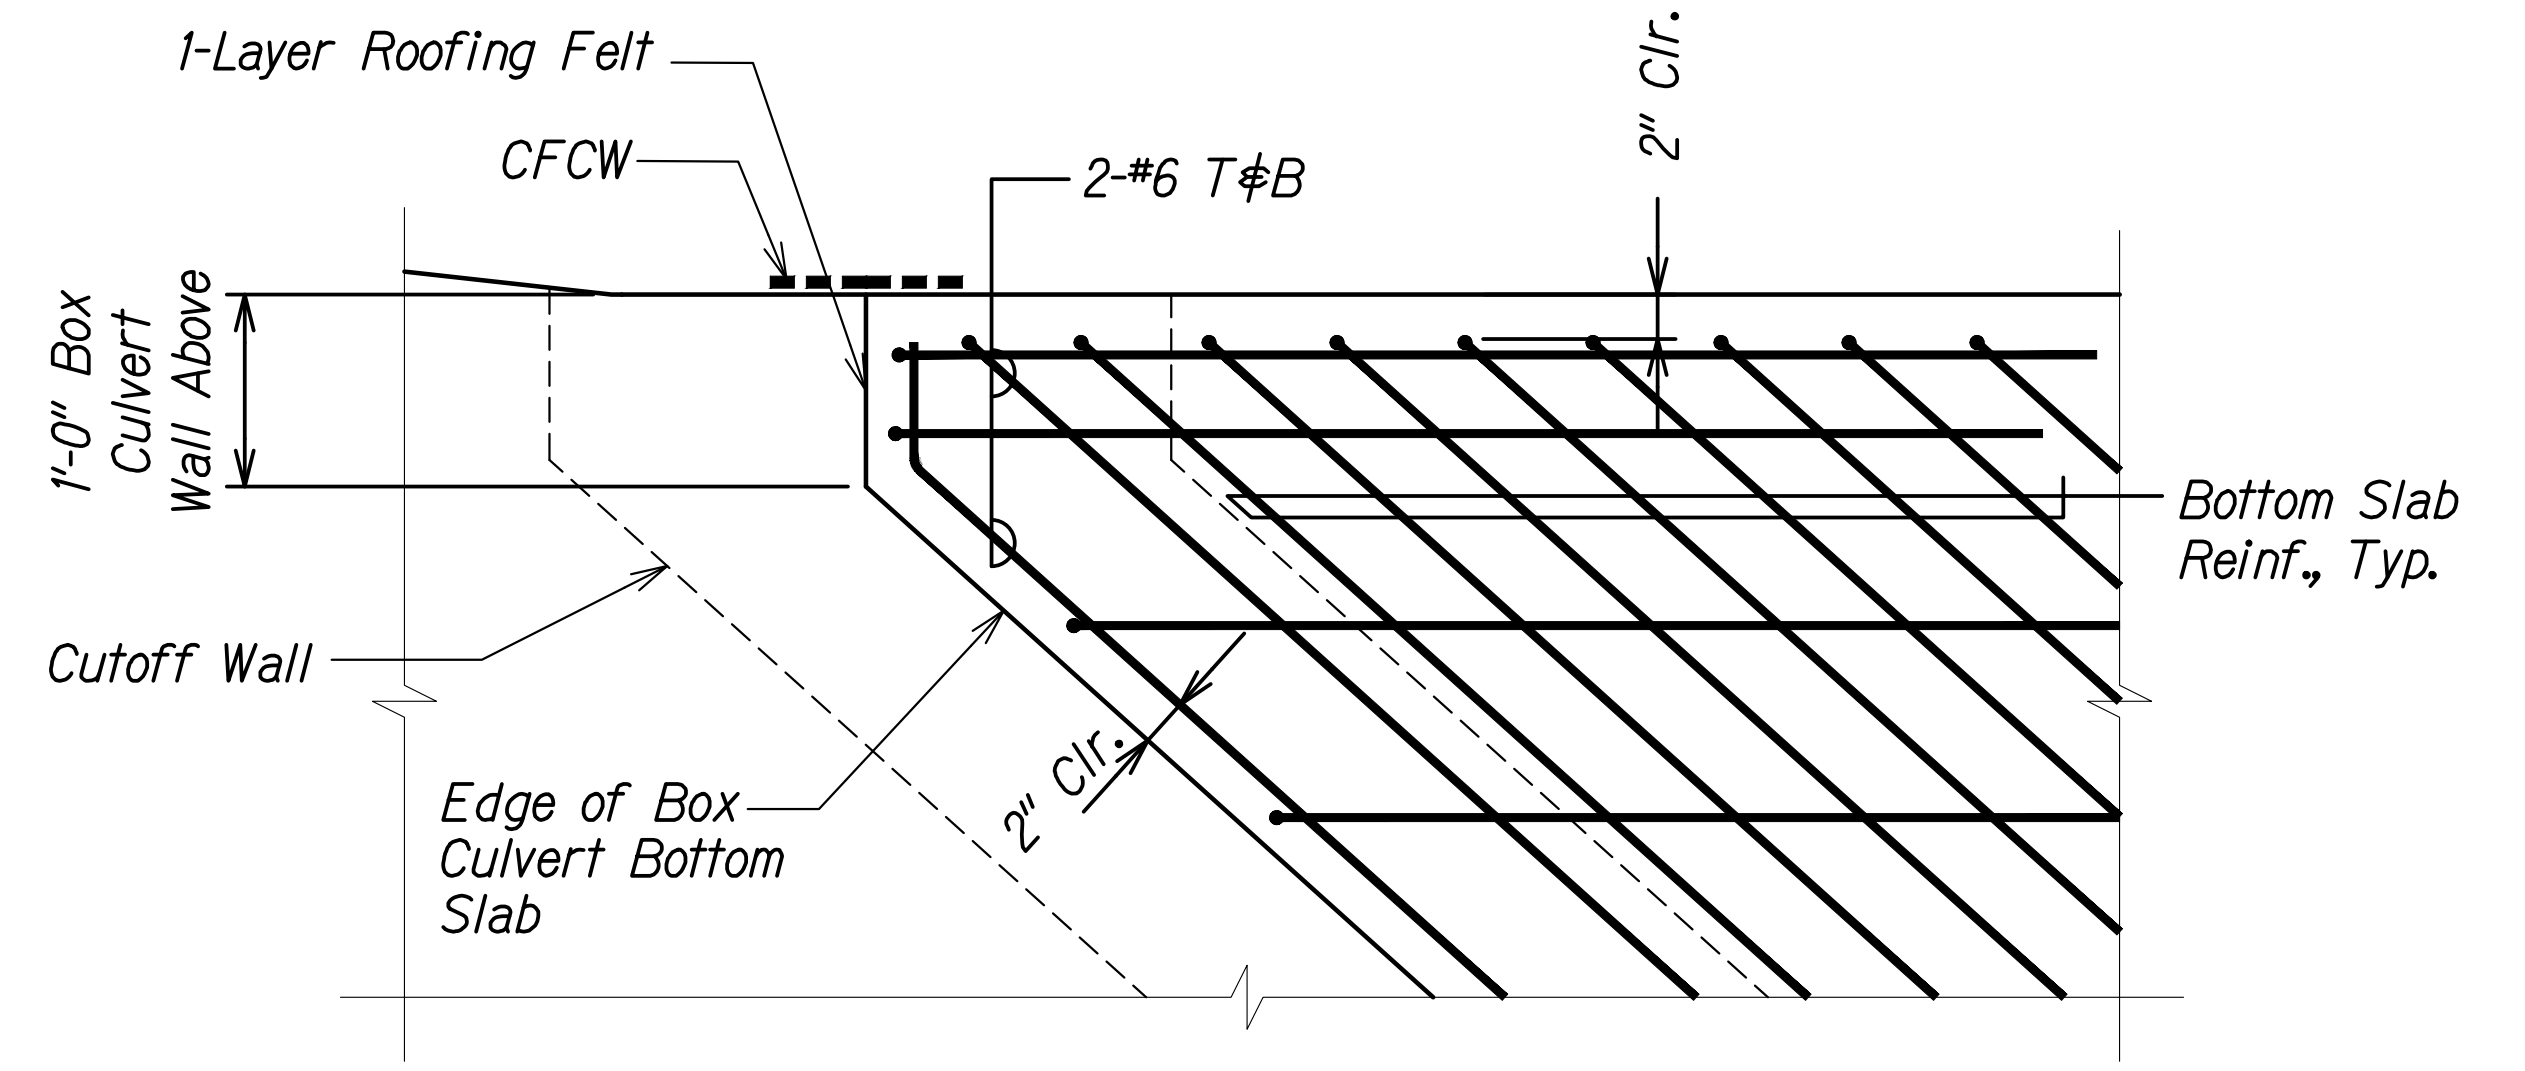

**INLET - BOX CULVERT BOT. SLAB DETAIL** 1  
 Scale: 1" = 1'-0" SC2.5 | SC2.5

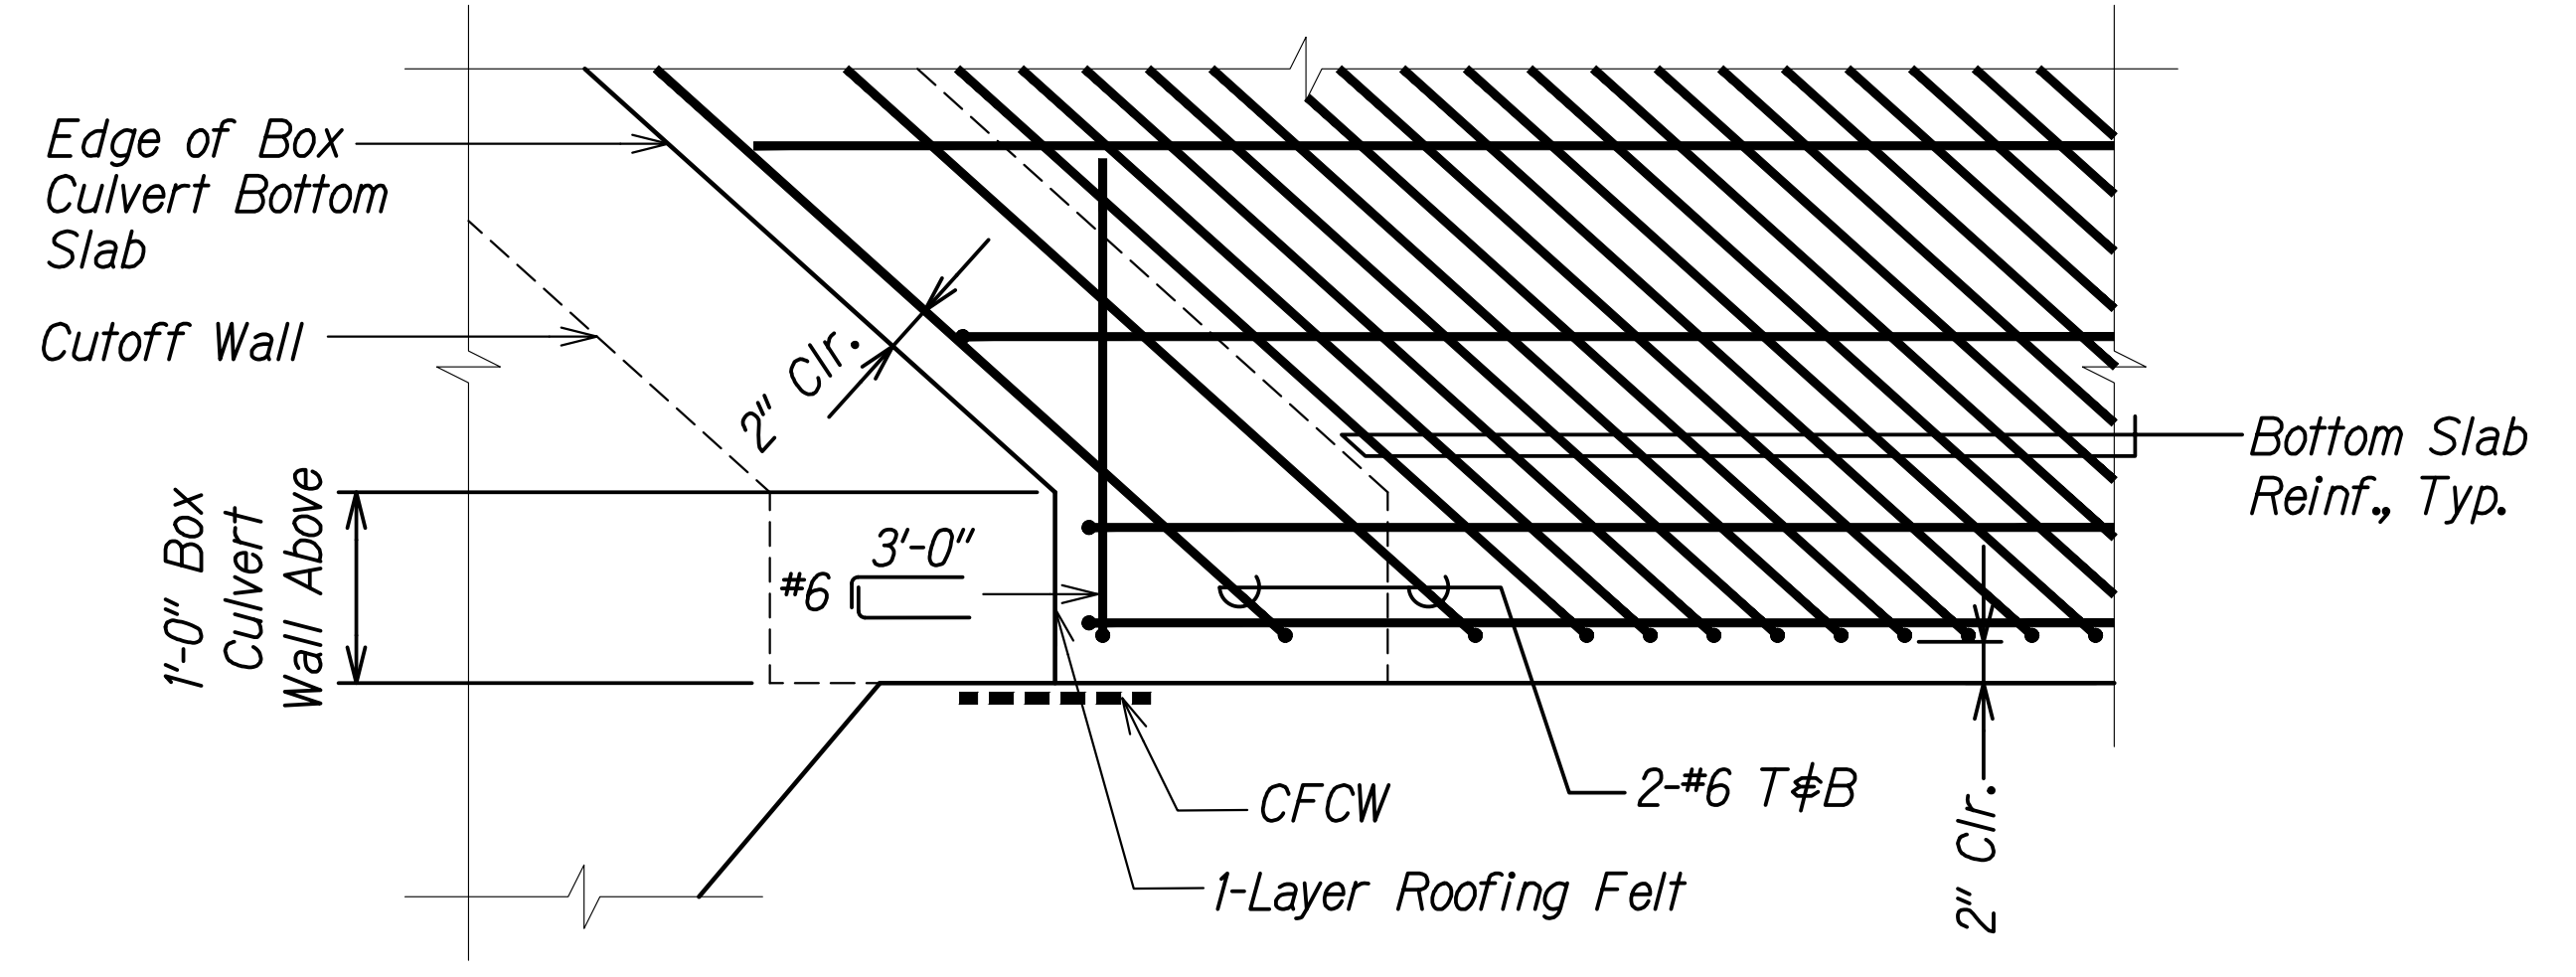

**INLET - BOX CULVERT BOT. SLAB DETAIL** 2  
 Scale: 1" = 1'-0" SC2.5 | SC2.5

SURVEY PLOTTED BY	DATE
DRAWN BY	
DESIGNED BY	
QUANTITIES BY	
CHECKED BY	
ORIGINAL PLAN	
NOTE BOOK	
No.	

DRAWING NAME: Z:\A00\ONDONGS\20-013-FARR-HW-KAPOLEI-GC-10-ET-WR-EMTC\01-GAD\07-15-22\ADD1-DELIAS\EMHS-SC0205-HUNE-BOX-BOT-SLAB-INLET-ADD5.DWG PLOT TIME: 07-15-22, 5:40 PM

RUSSELL S. MIYAHARA  
 LICENSED PROFESSIONAL ENGINEER  
 NO. 9444-S  
 HAWAII, U.S.A.  
 THIS WORK WAS PREPARED BY ME OR UNDER MY SUPERVISION AND CONSTRUCTION OF THIS PROJECT WILL BE UNDER MY OBSERVATION.  
 SIGNATURE: *Russ S. Miyahara* EXPIRATION DATE: April 30, 2024 OF THE LICENSE


07/15/22	5	Revised Dimension
DATE		REVISION
STATE OF HAWAII DEPARTMENT OF TRANSPORTATION HIGHWAYS DIVISION <b>Hunehune Gulch Box Culvert          Inlet Bottom Slab Plan and Details</b> FARRINGTON HIGHWAY WIDENING Kapolei Golf Course Road to Fort Weaver Road Project No. 7101A-01-20		
Scale: As Shown	Date: Apr. 2022	
SHEET No. SC2.5 OF 23 SHEETS		









FED. ROAD DIST. NO.	STATE	PROJ. NO.	FISCAL YEAR	SHEET NO.	TOTAL SHEETS
HAWAII	HAW.	7101A-01-20	2021	ADD. 482	

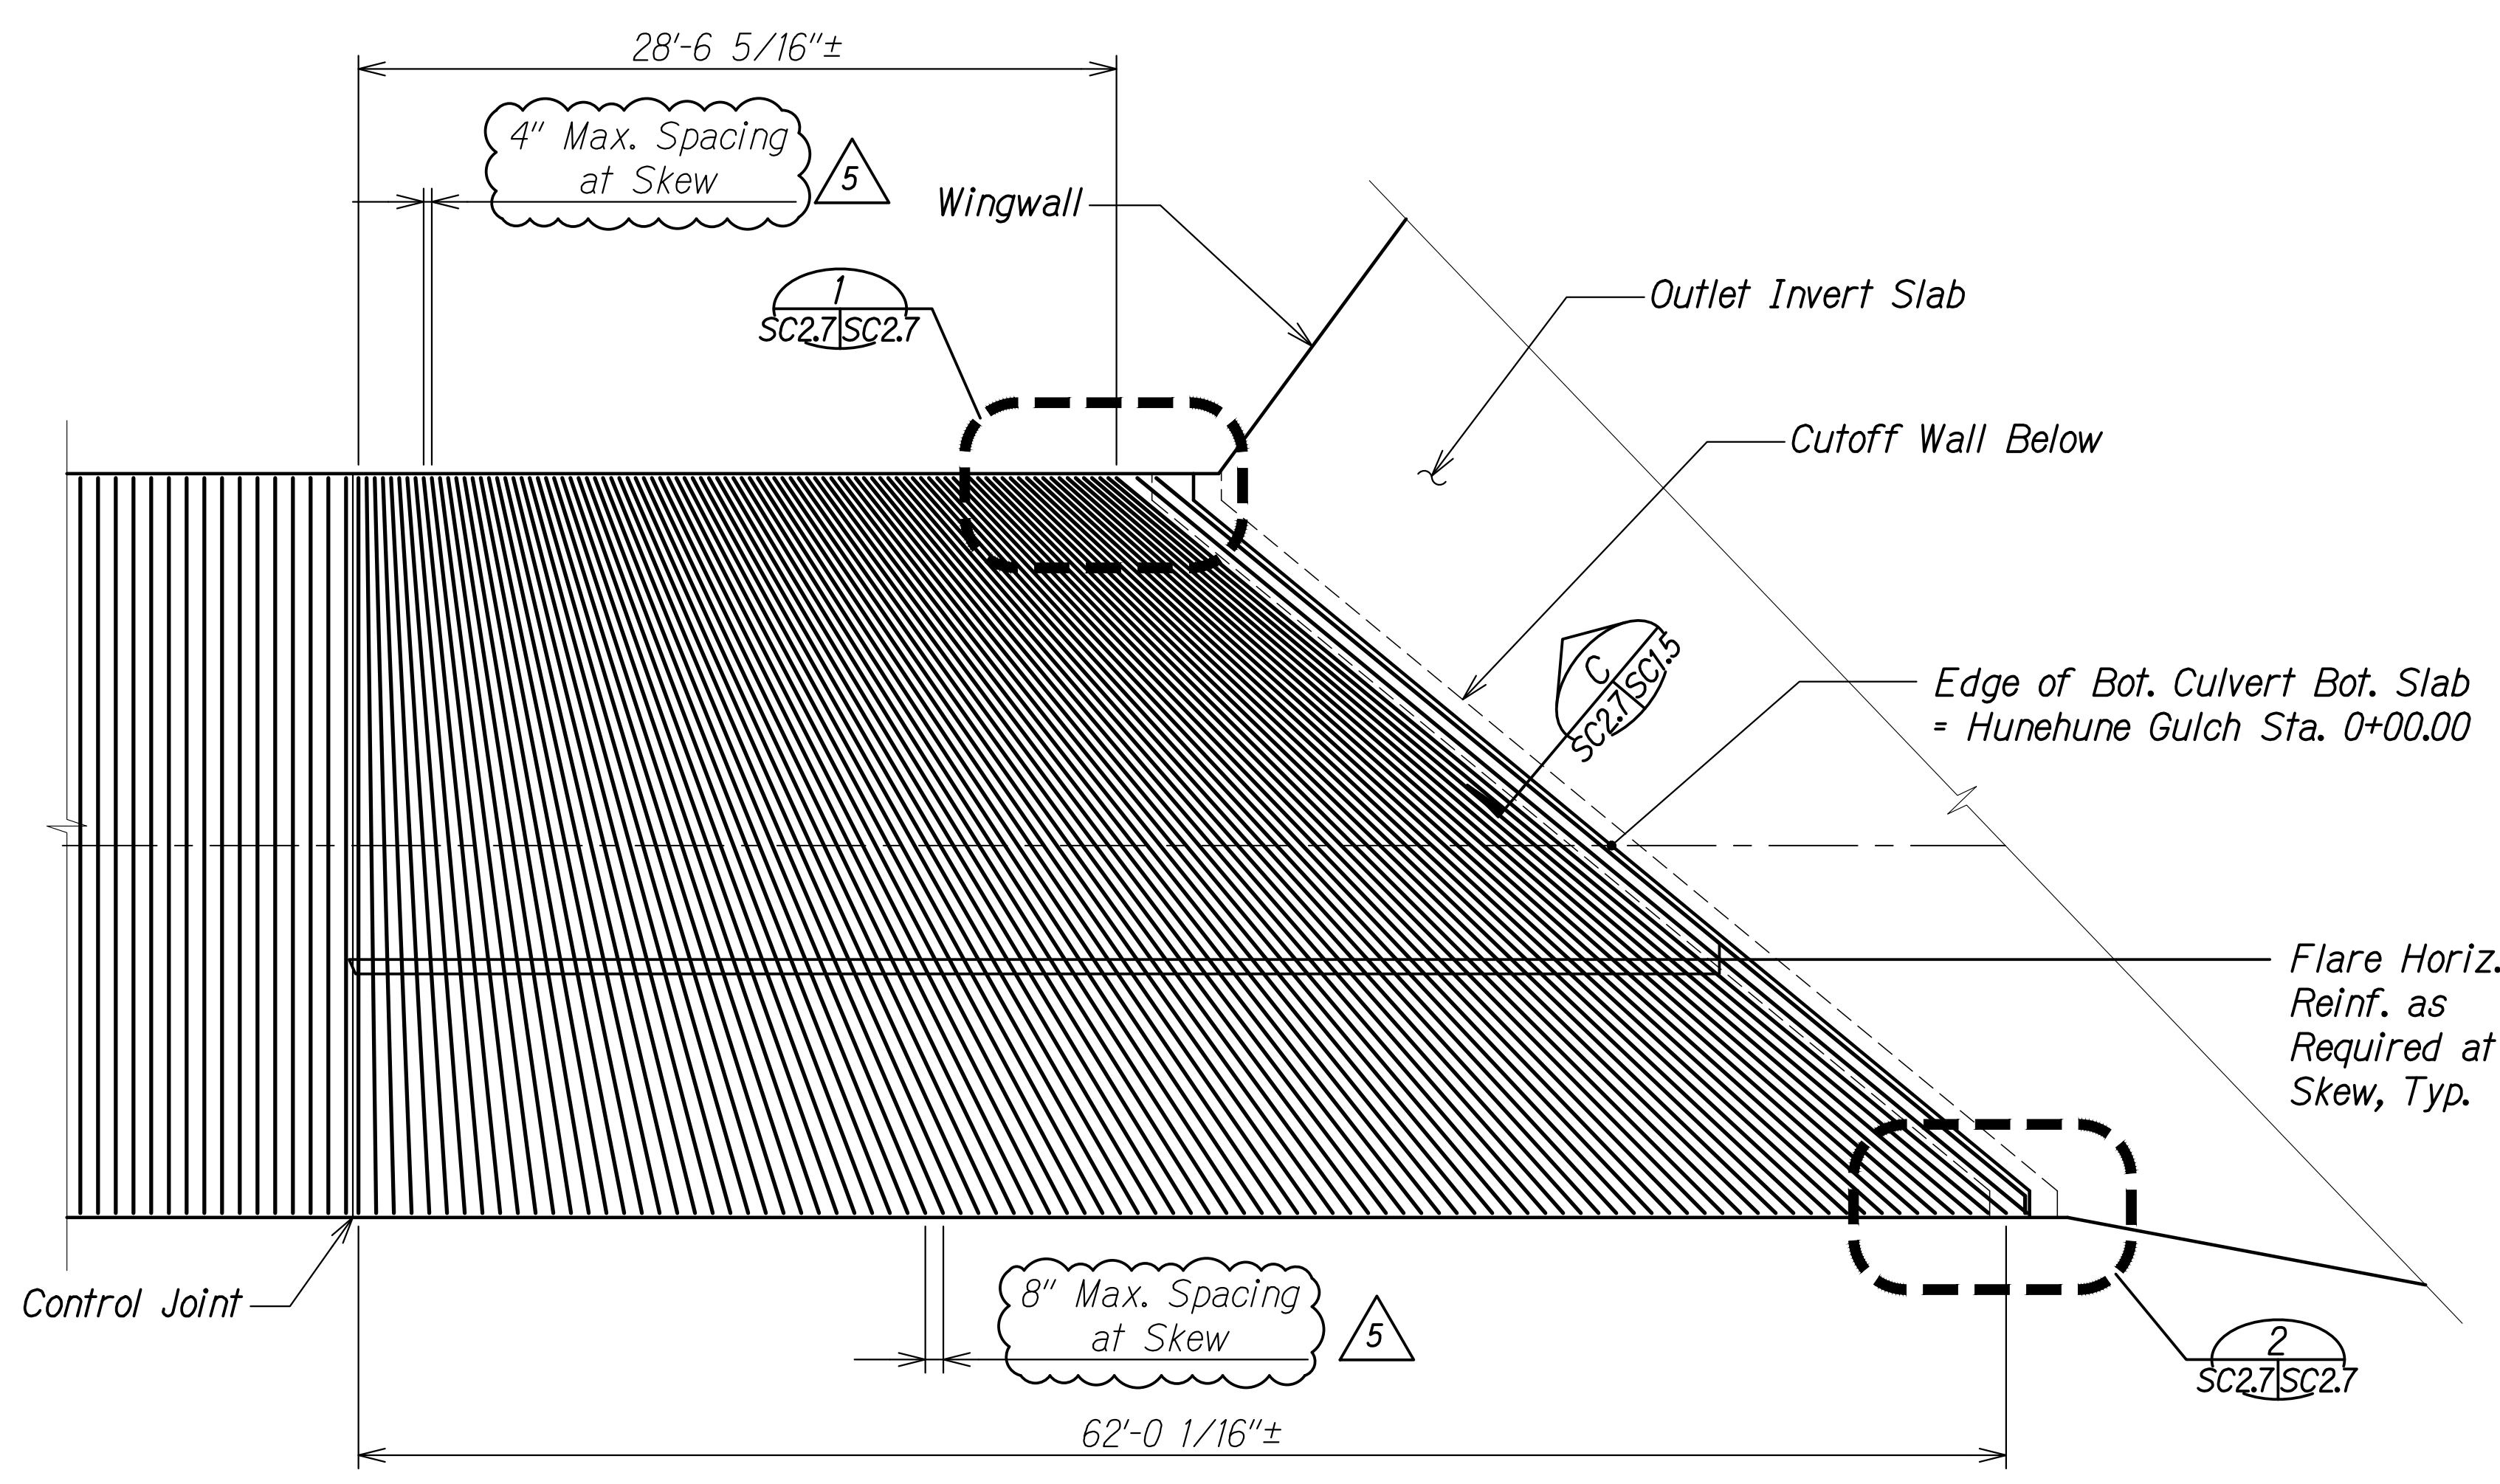

**BOTTOM SLAB REINFORCING PLAN AT OUTLET**  
 Scale: 3/16" = 1'-0"  
 SC2.14 | SC2.7

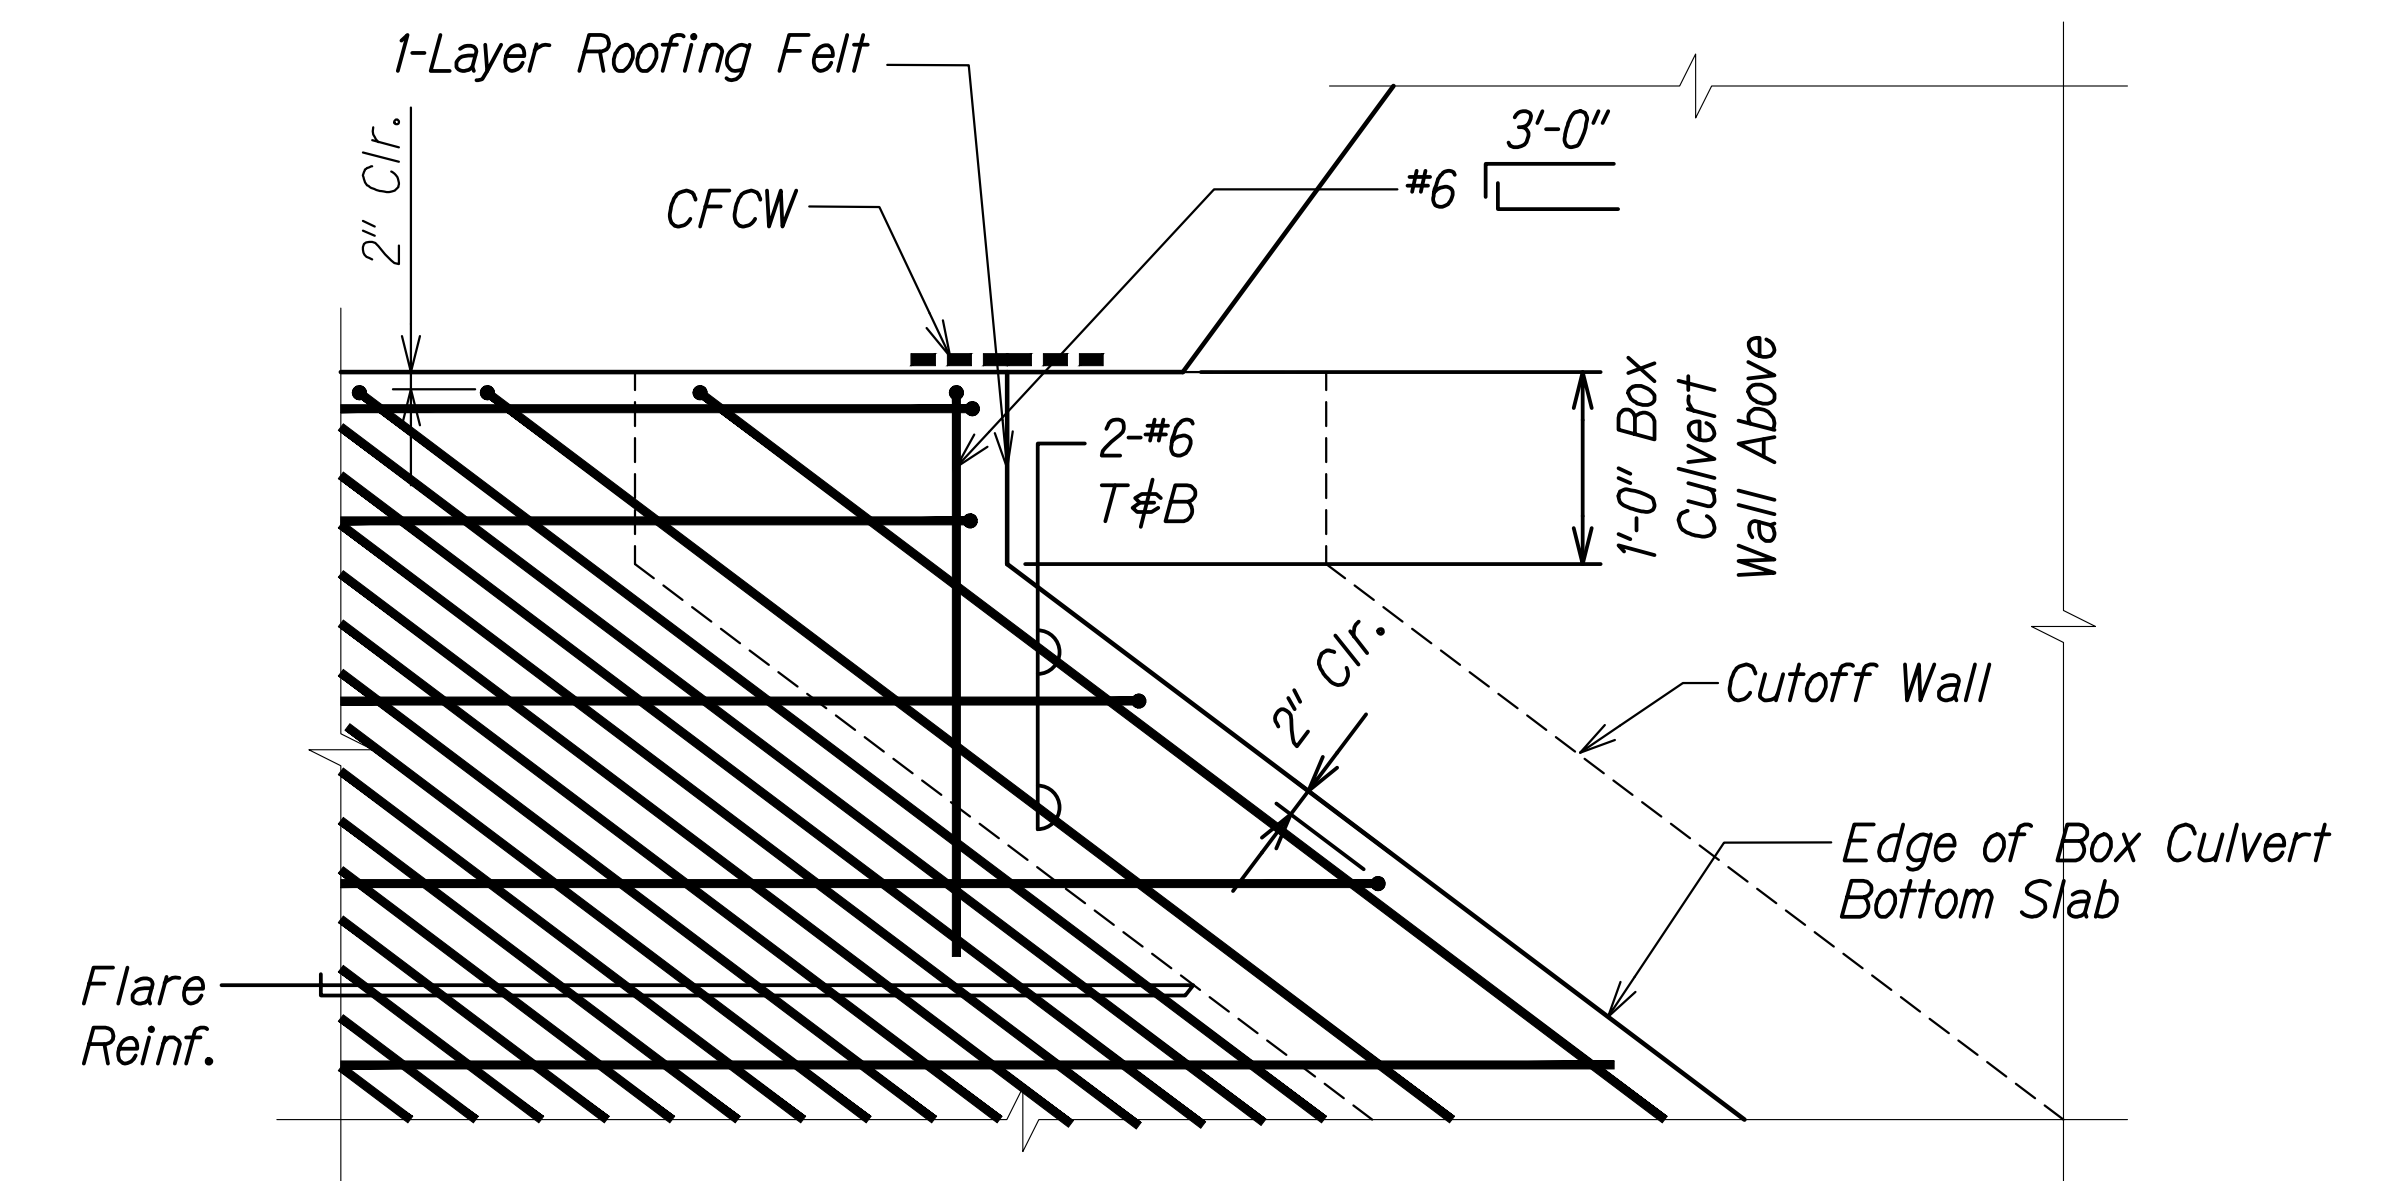


**OUTLET - BOX CULVERT BOT. SLAB DETAIL 1**  
 Scale: 1" = 1'-0"  
 SC2.7 | SC2.7

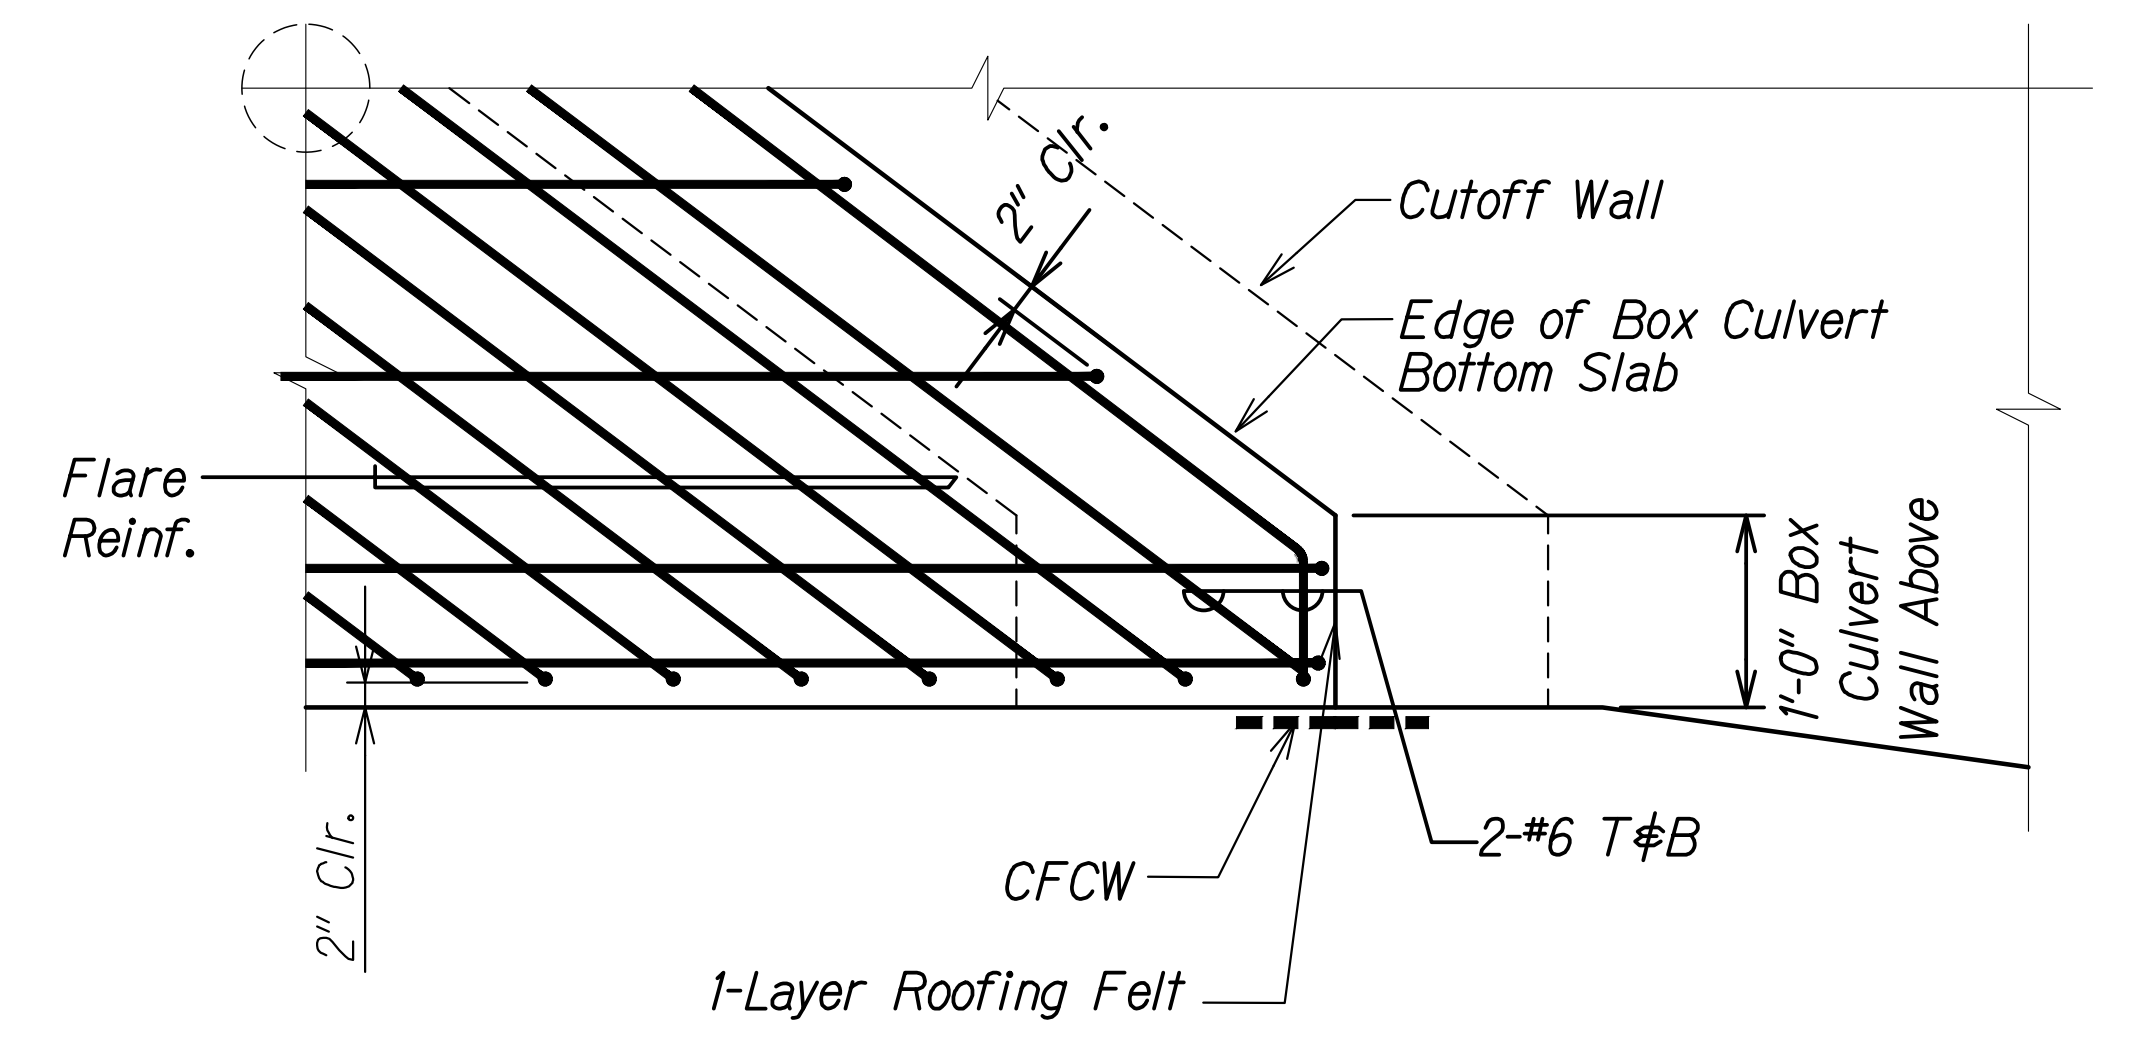

**OUTLET - BOX CULVERT BOT. SLAB DETAIL 2**  
 Scale: 1" = 1'-0"  
 SC2.7 | SC2.7

SURVEY PLOTTED BY	DATE
DRAWN BY	
DESIGNED BY	
QUANTITIES BY	
CHECKED BY	
ORIGINAL PLAN	
NOTE BOOK	
No.	


DRAWING NAME: Z:\A00 UNDOINGS\20-013-FARR-HW-KAPOLEI GC ID: ET WWP-BMT\01 CAD\07-15-22 ADD1 DELIAS\HW3-SC0207-HUNE BOX BOT SLAB OUTLET ADDS.DWG PLOT TIME: 07-15-22: 5:40 PM

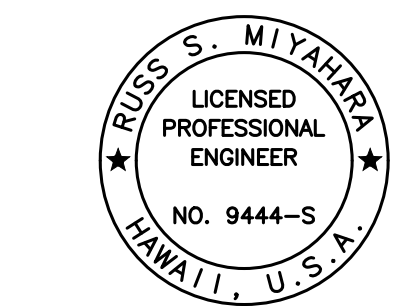


THIS WORK WAS PREPARED BY ME OR UNDER MY SUPERVISION AND CONSTRUCTION OF THIS PROJECT WILL BE UNDER MY OBSERVATION.  
 Signature: Russ S. Miyahara  
 April 30, 2024  
 EXPIRATION DATE OF THE LICENSE

07/15/22	5	Revised Dimension
DATE		REVISION
STATE OF HAWAII DEPARTMENT OF TRANSPORTATION HIGHWAYS DIVISION		
<b>Hunehune Gulch Box Culvert Outlet Bottom Slab Plan and Details</b>		
FARRINGTON HIGHWAY WIDENING Kapolei Golf Course Road to Fort Weaver Road Project No. 7101A-01-20		
Scale: As Shown	Date: Apr. 2022	
SHEET No. SC2.7 OF 23 SHEETS		


FED. ROAD DIST. NO.	STATE	PROJ. NO.	FISCAL YEAR	SHEET NO.	TOTAL SHEETS
HAWAII	HAW.	7101A-01-20	2021	ADD. 483	

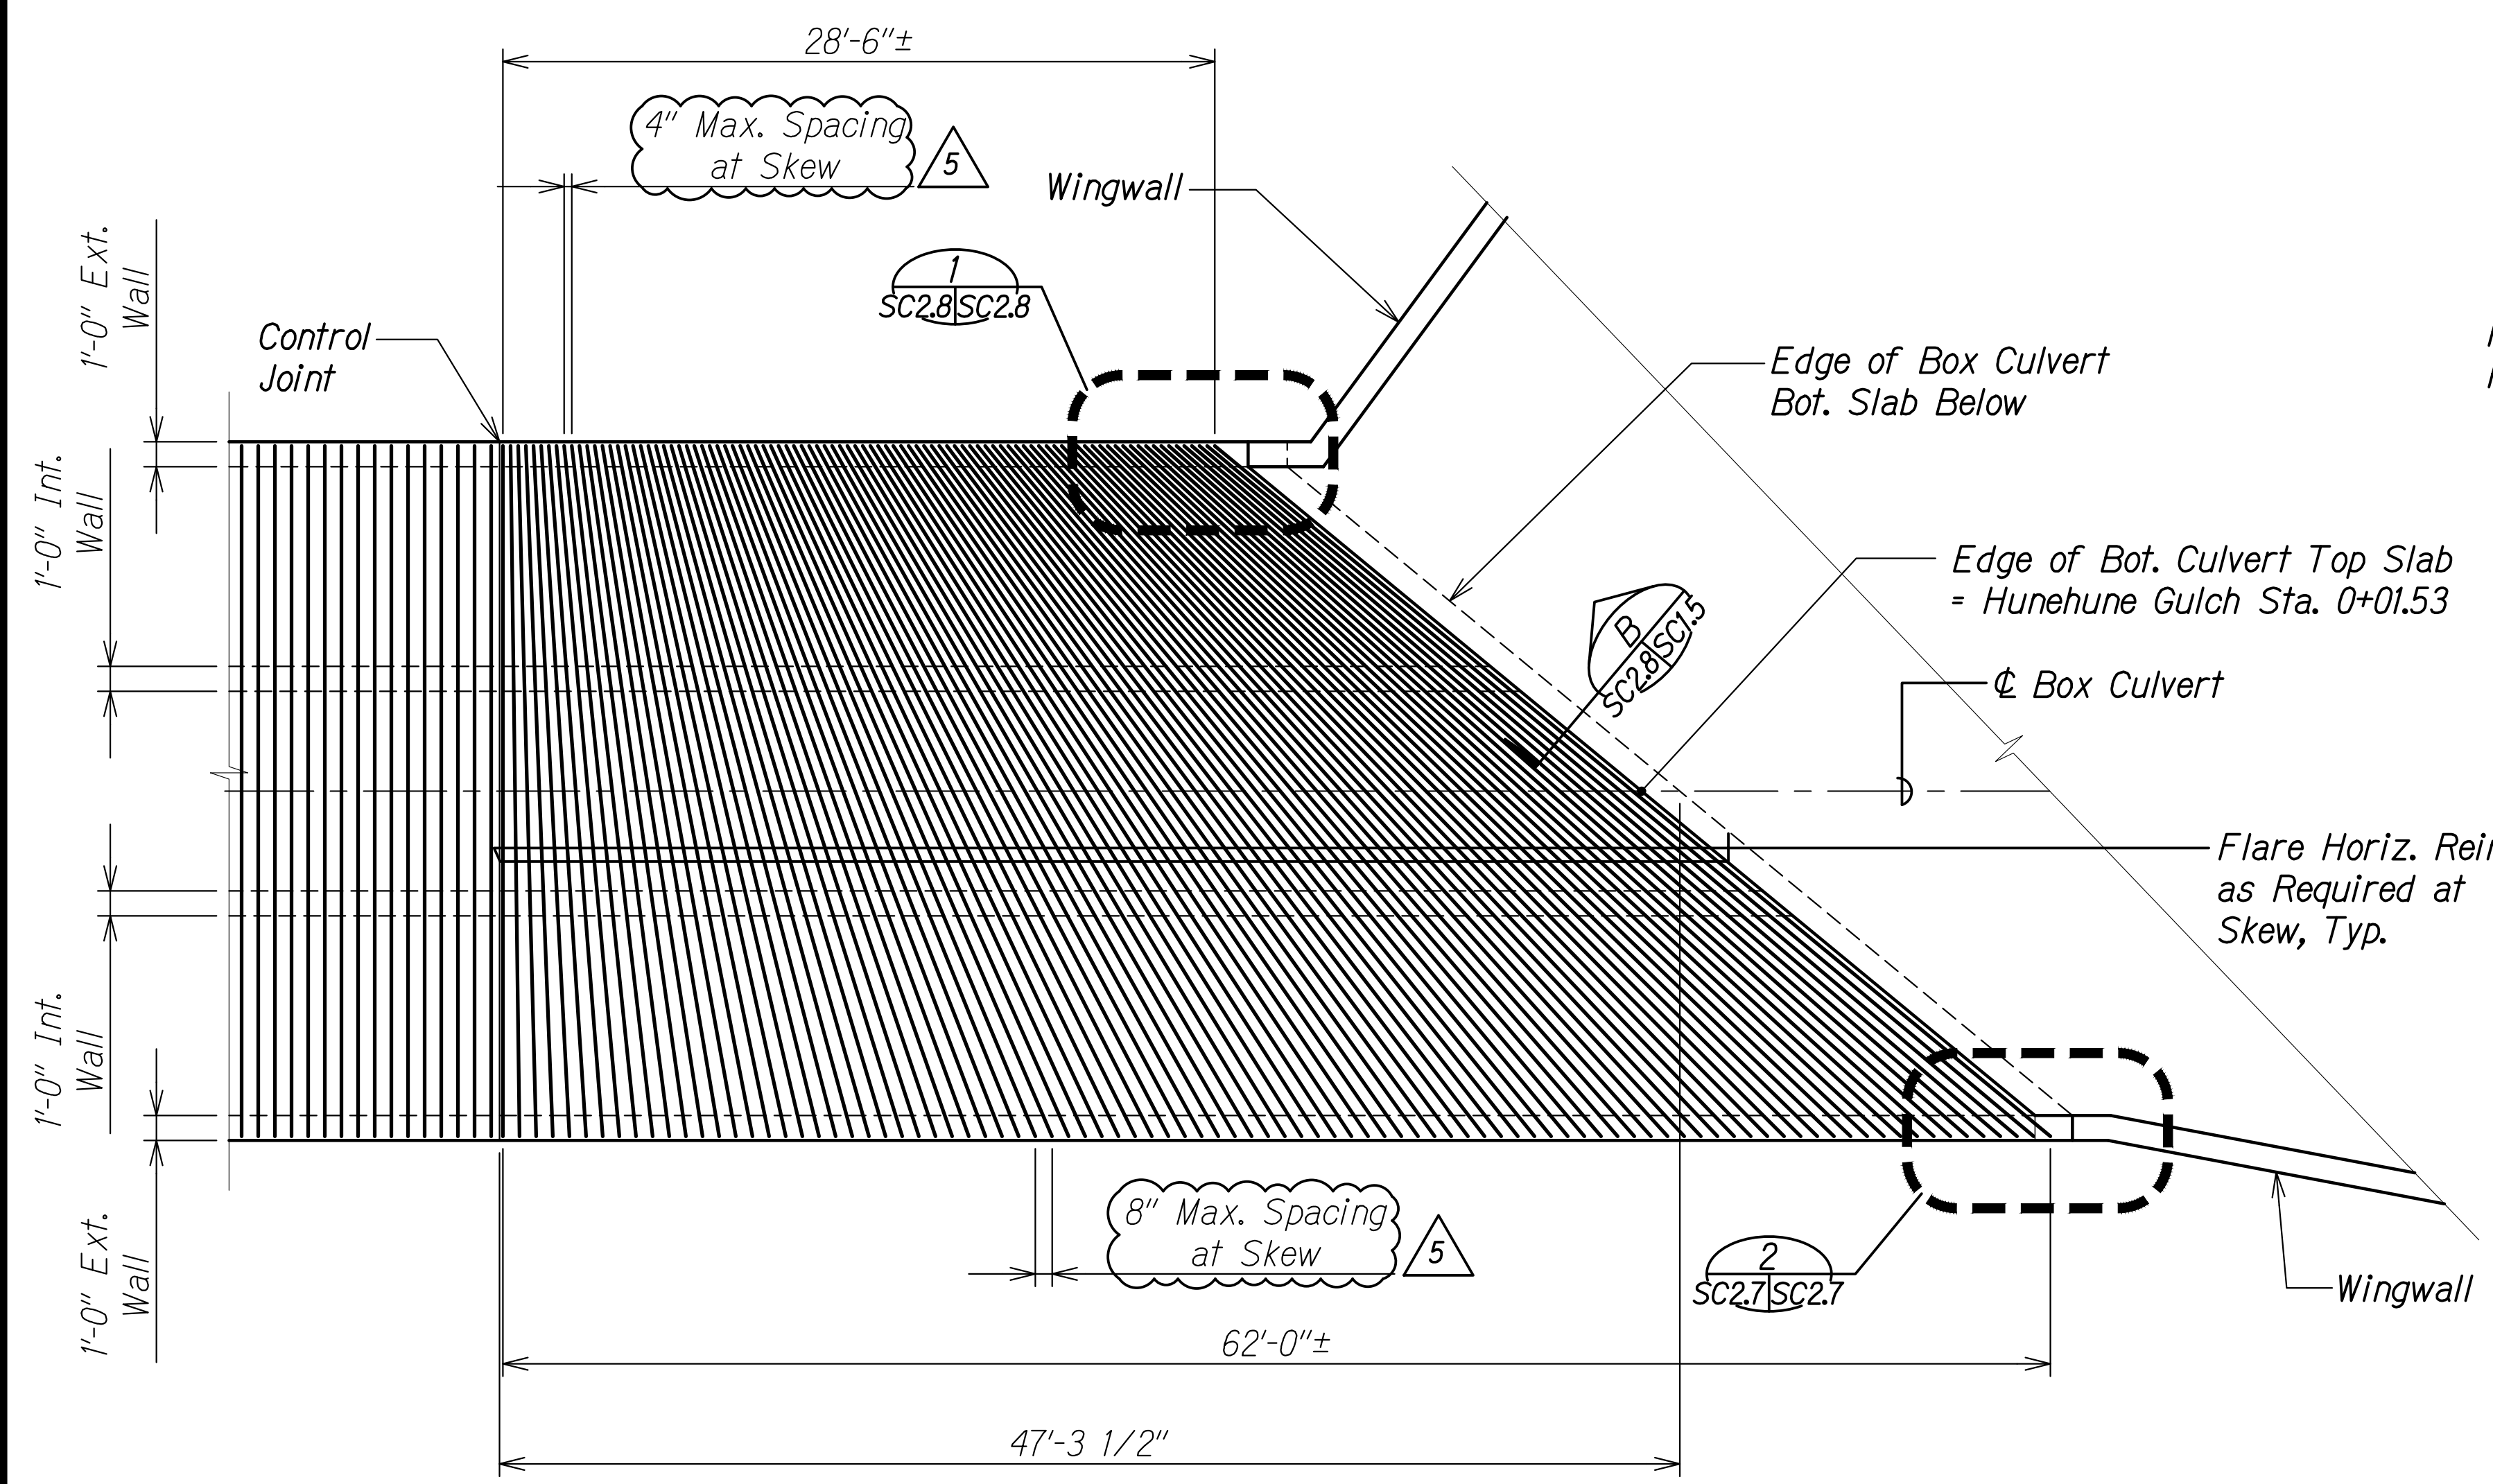

**TOP SLAB REINFORCING PLAN AT OUTLET** A  
 Scale: 3/16" = 1'-0" SC2.14 SC2.8

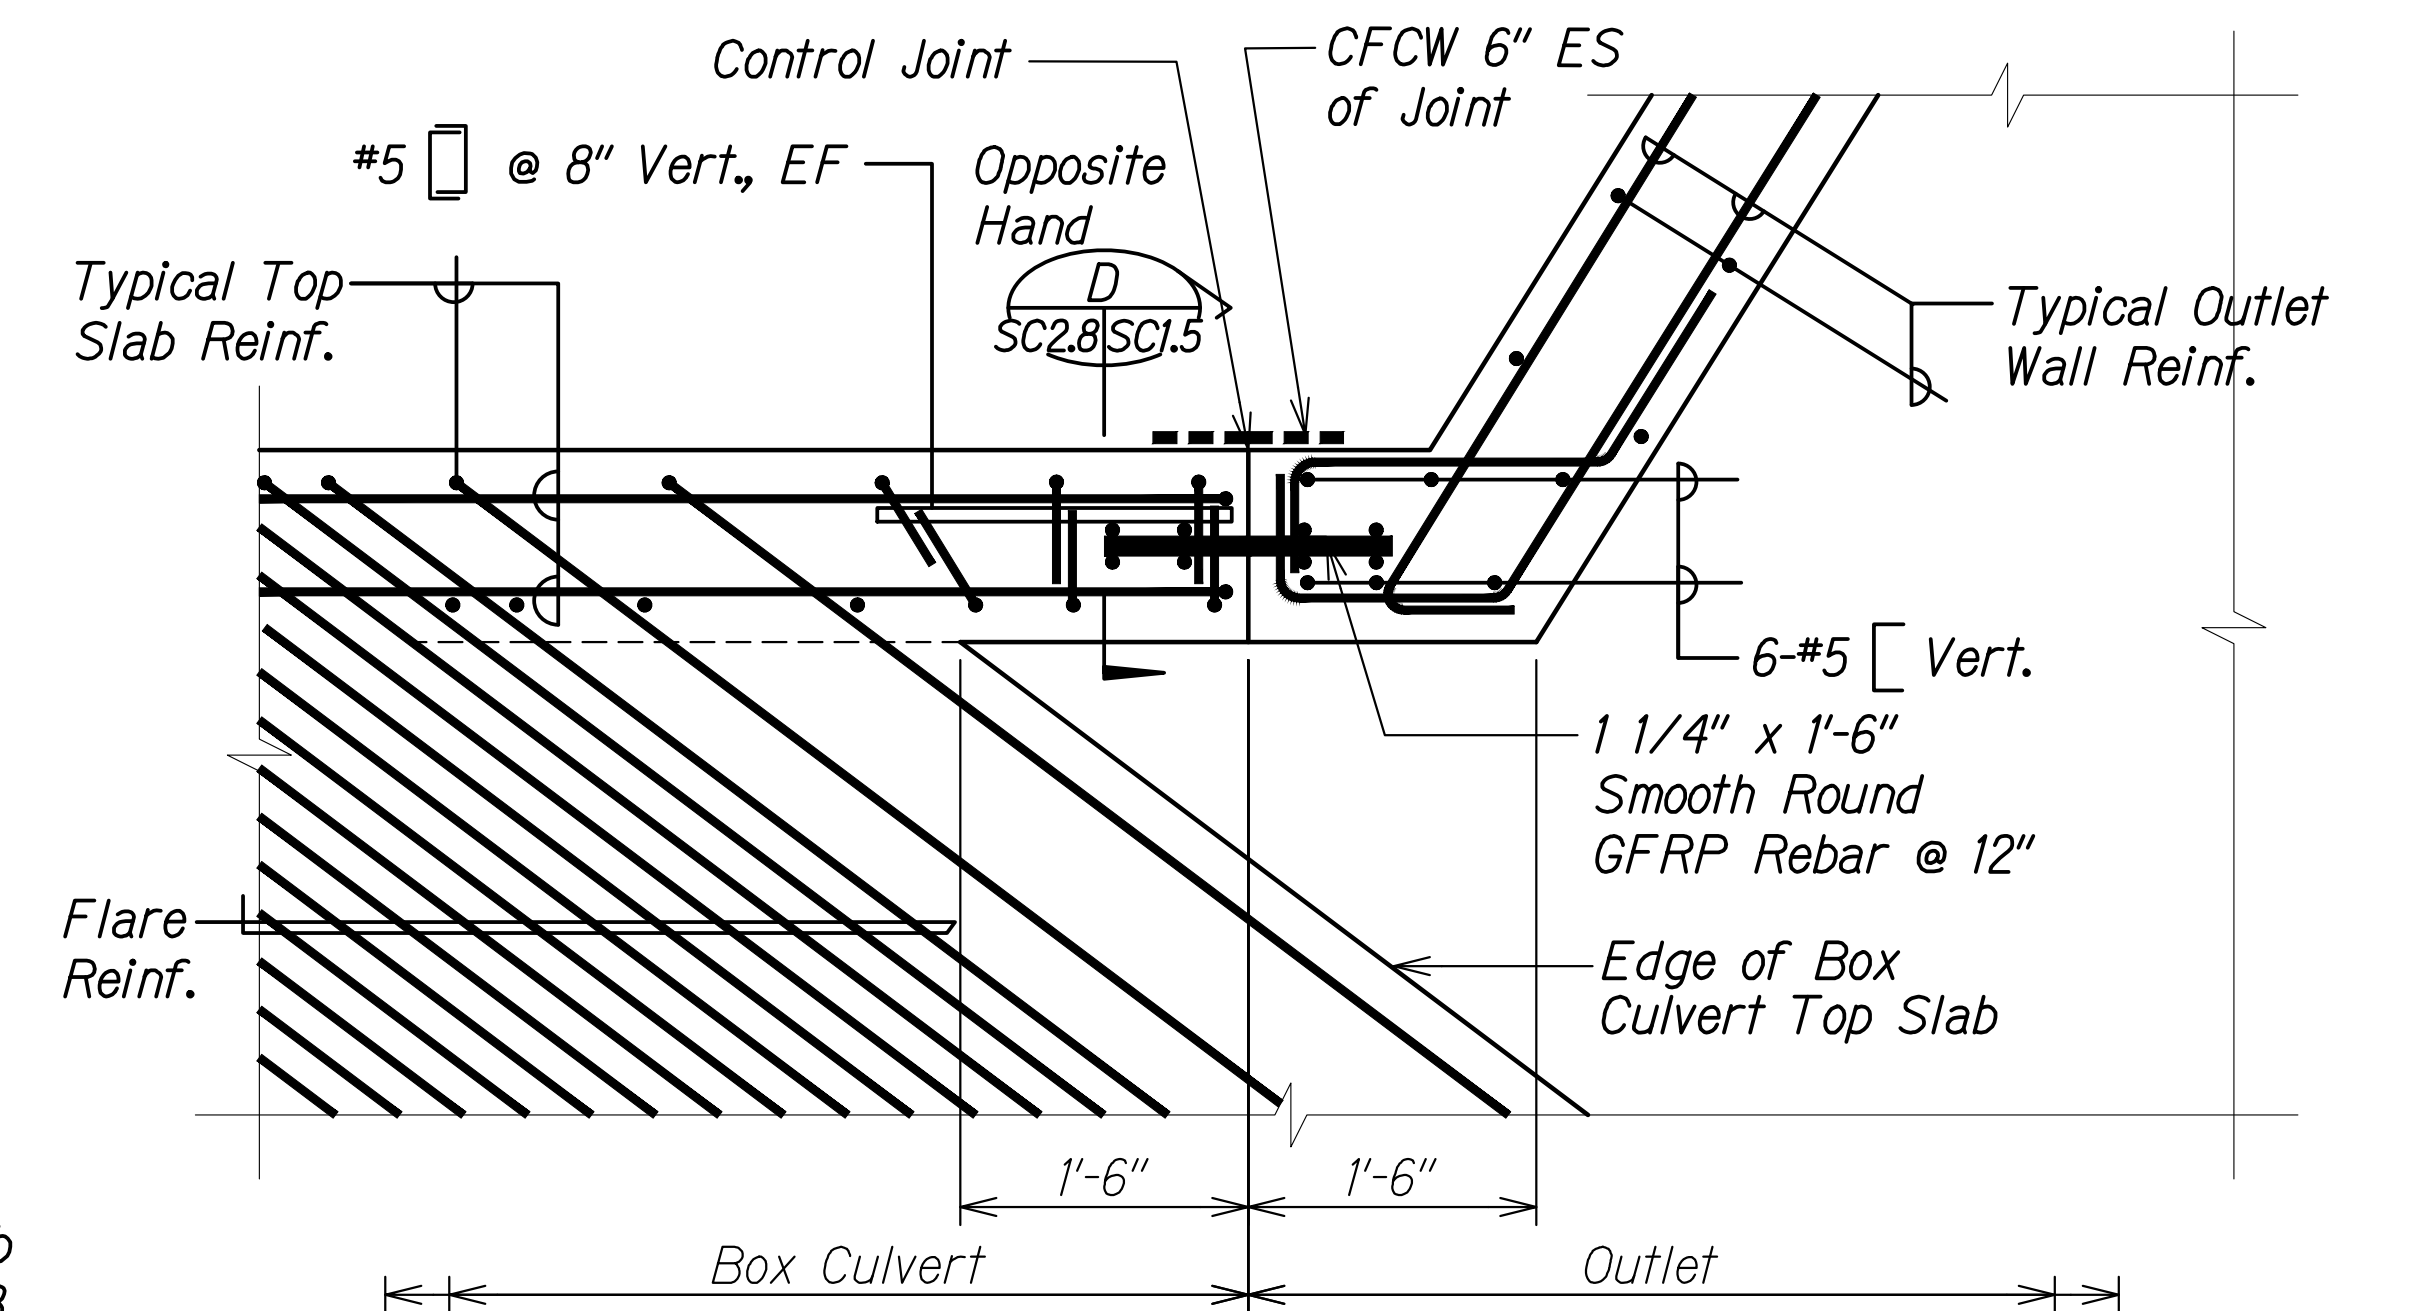

**OUTLET - BOX CULVERT TOP SLAB DETAIL** 1  
 Scale: 1" = 1'-0" SC2.8 SC2.8

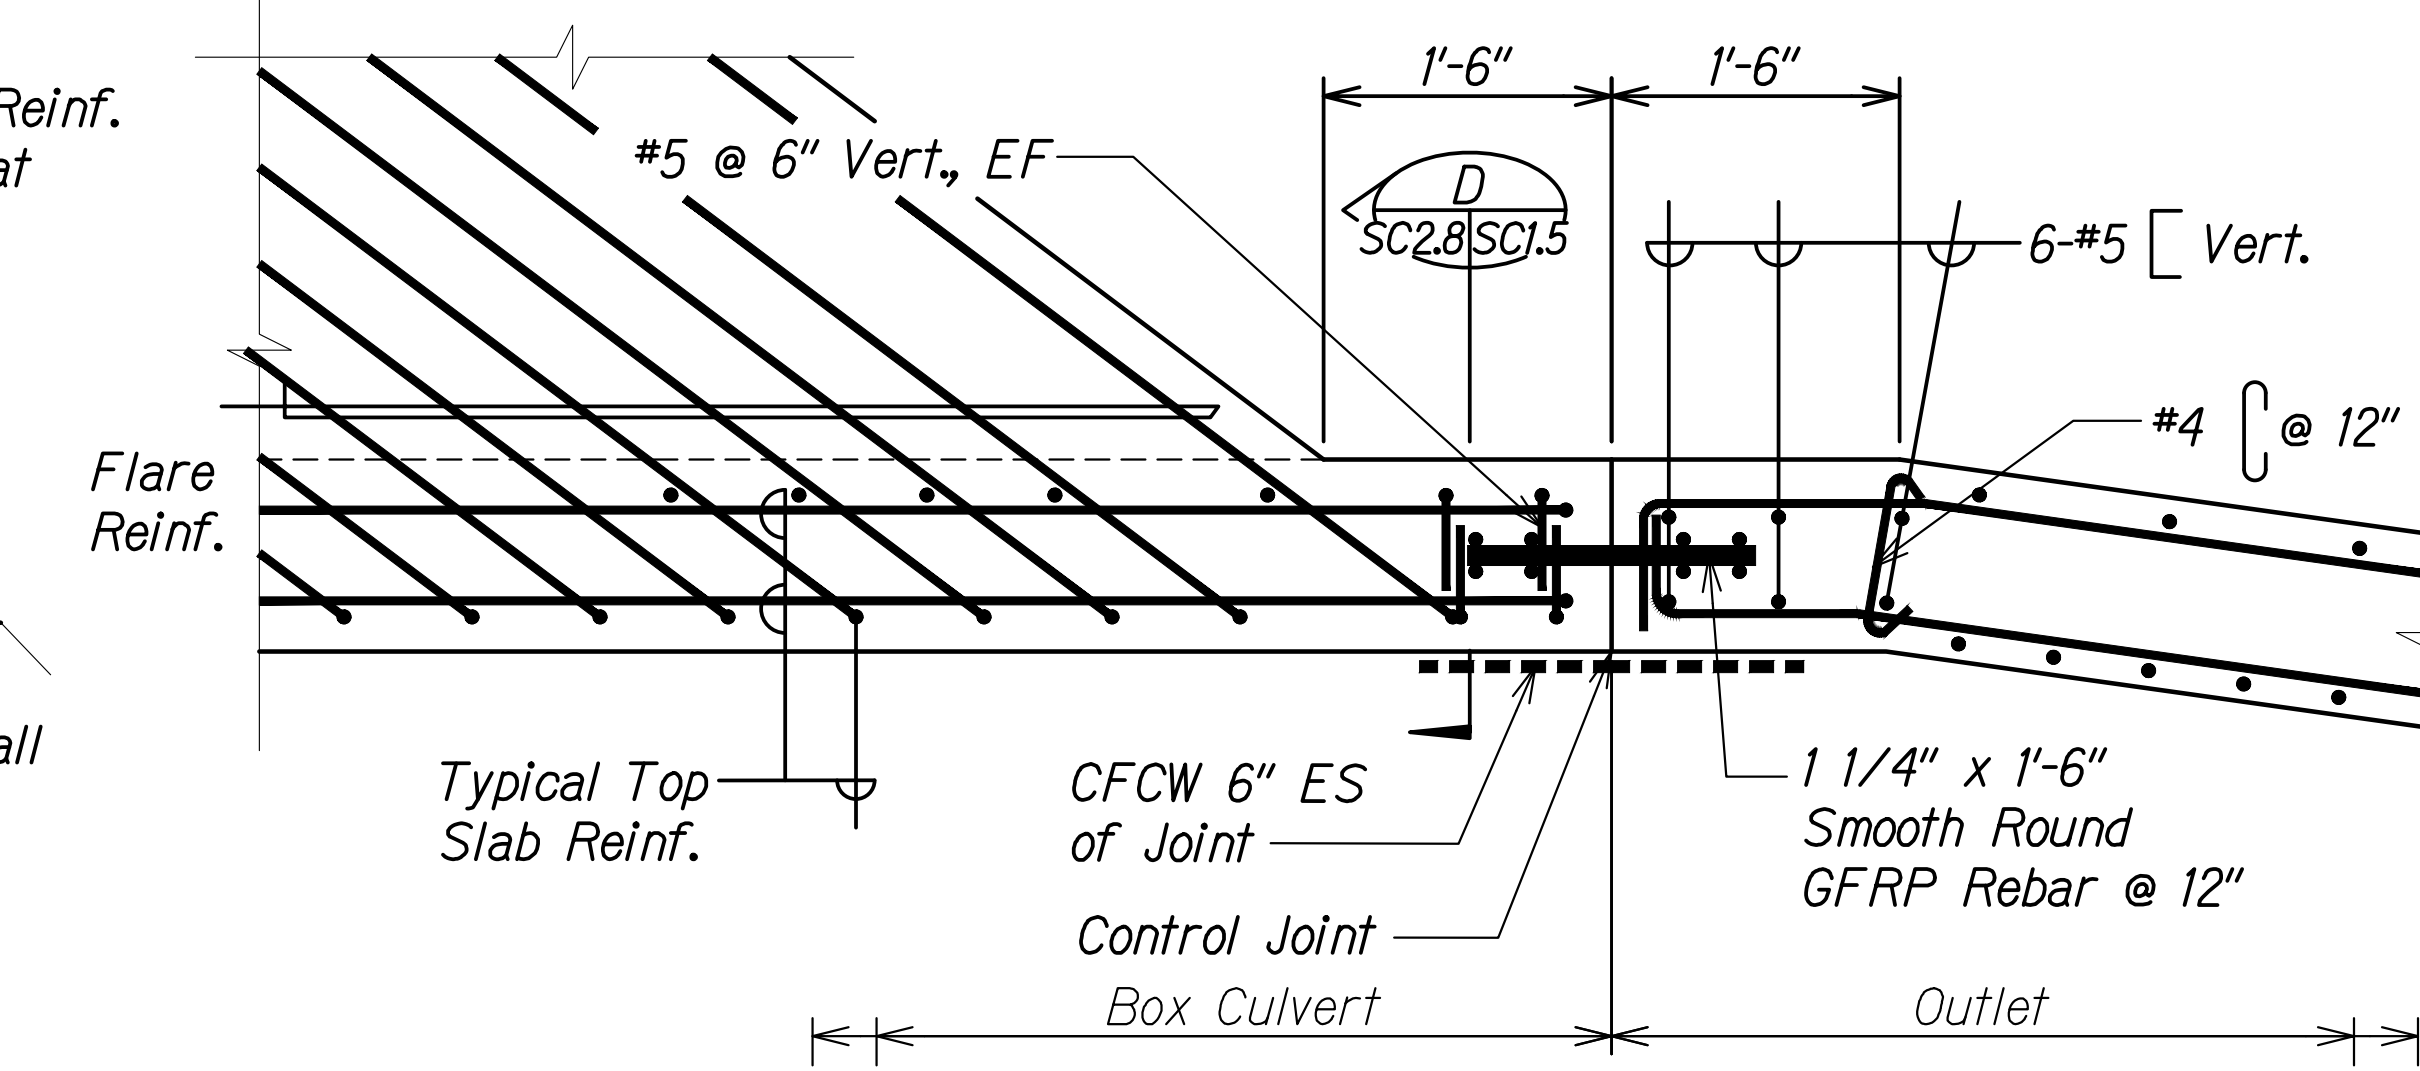


**OUTLET - BOX CULVERT TOP SLAB DETAIL** 2  
 Scale: 1" = 1'-0" SC2.8 SC2.8

SURVEY PLOTTED BY	DATE
DRAWN BY	
DESIGNED BY	
QUANTITIES BY	
CHECKED BY	
ORIGINAL PLAN	No.
NOTE BOOK	


DRAWING NAME: Z:\A00 UNDOINGS\20-013-FARR-HW-KAPOLEI GC ID: ET WPG-BMT\A01 CAD\07-15-22 ADD1 DELIAS\HW3-SC0208-HUNE BOX TOP SLAB OUTLET ADDS.DWG PLOT TIME: 07-15-22: 5:41 PM

THIS WORK WAS PREPARED BY ME OR UNDER MY SUPERVISION AND CONSTRUCTION OF THIS PROJECT WILL BE UNDER MY OBSERVATION.  
 Signature: *Russ S. Miyahara*  
 EXPIRATION DATE OF THE LICENSE: April 30, 2024

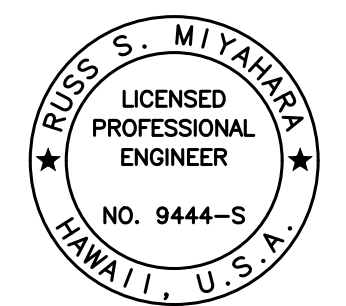

DATE	07/15/22	REVISION	5 Revised Dimension
STATE OF HAWAII DEPARTMENT OF TRANSPORTATION HIGHWAYS DIVISION <b>Hunehune Gulch Box Culvert          Outlet Top Slab Plan and Details</b> FARRINGTON HIGHWAY WIDENING Kapolei Golf Course Road to Fort Weaver Road Project No. 7101A-01-20			
Scale:	As Shown	Date:	Apr. 2022
SHEET No. SC2.8 OF 23 SHEETS			

FED. ROAD DIST. NO.	STATE	PROJ. NO.	FISCAL YEAR	SHEET NO.	TOTAL SHEETS
HAWAII	HAW.	7101A-01-20	2021	ADD. 493	

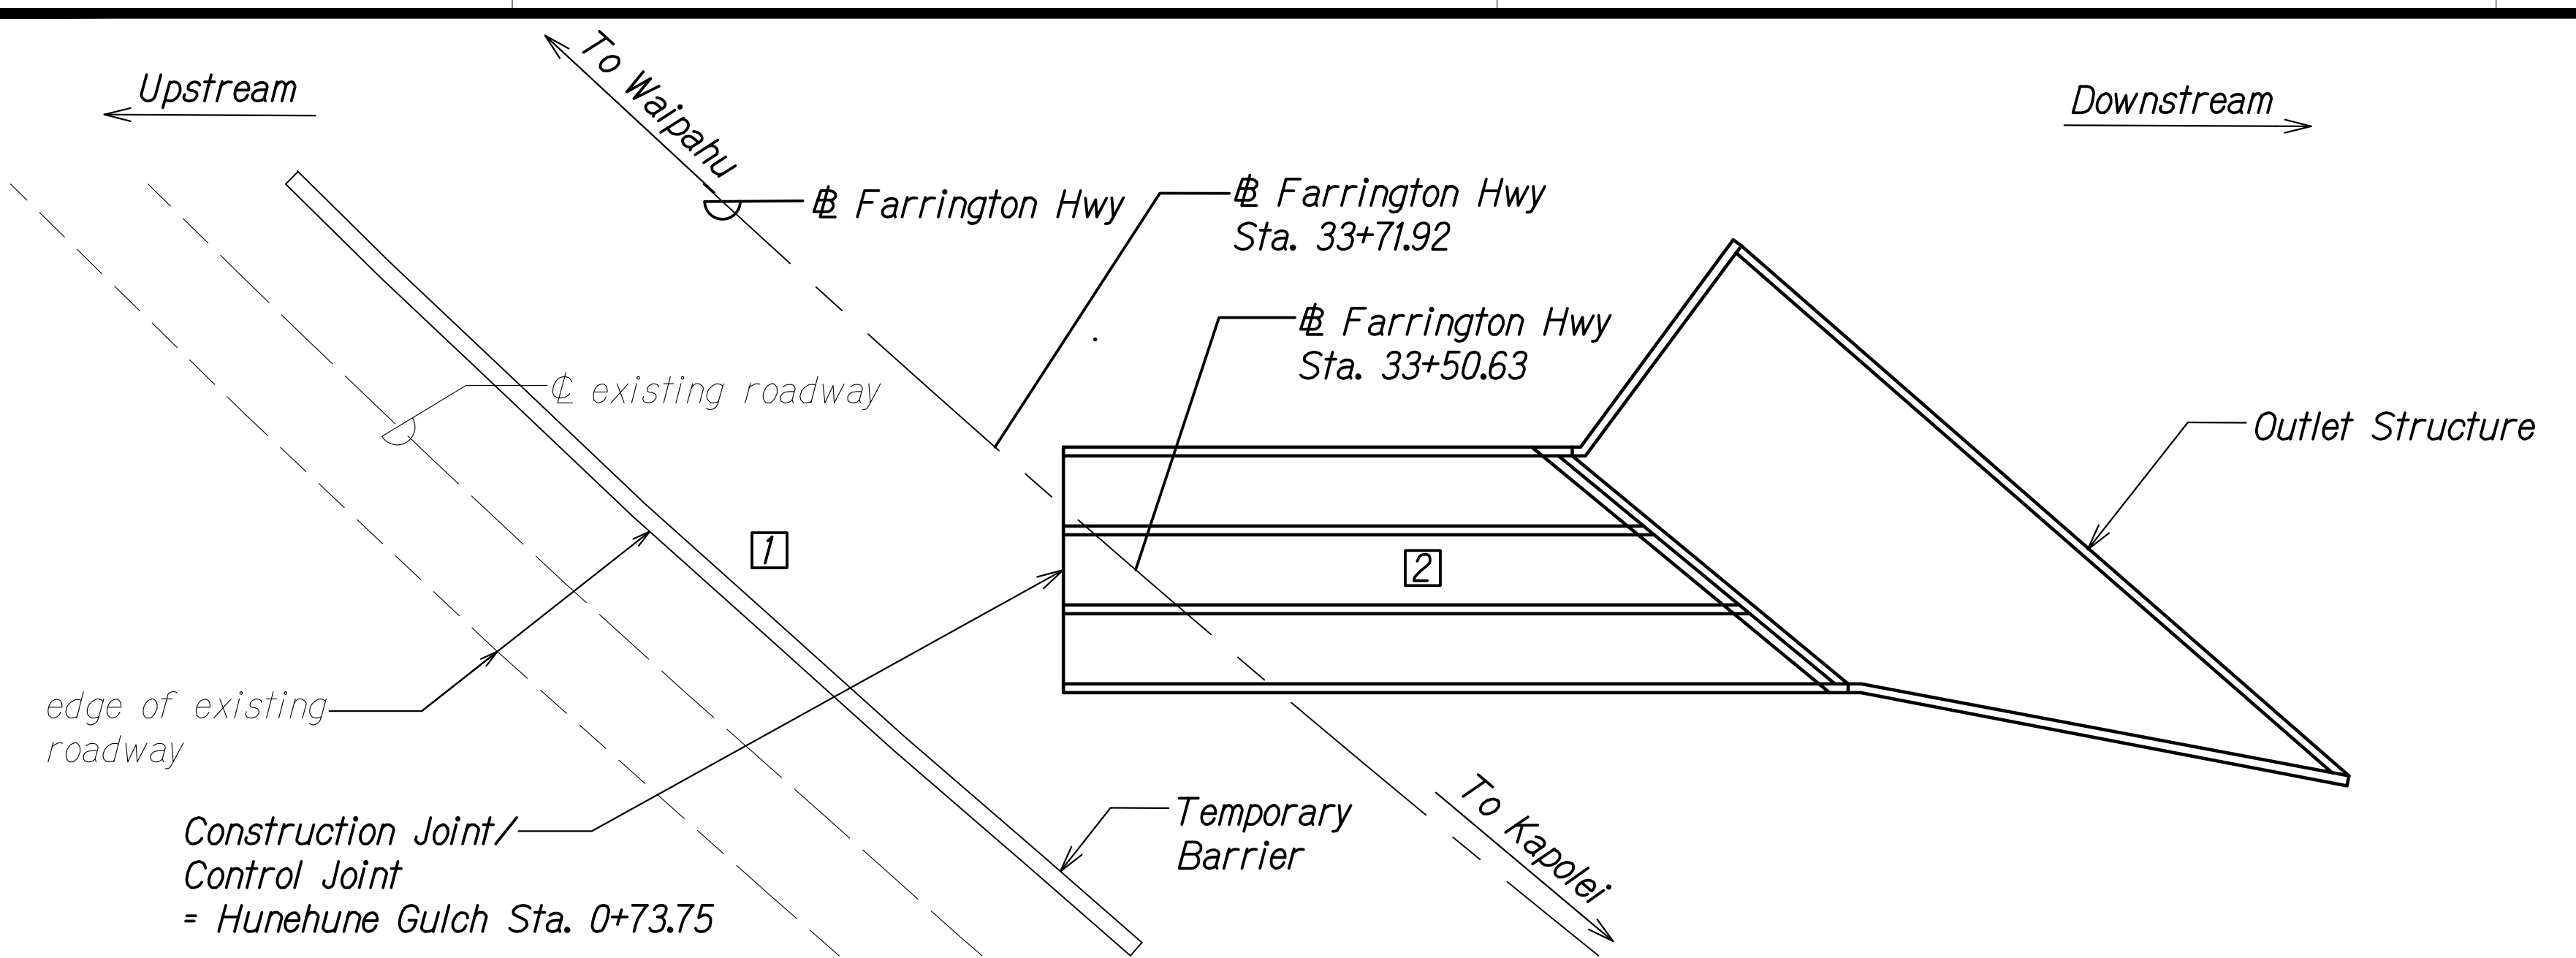

**LAYOUT PLAN**  
Scale: Not to Scale


**CONSTRUCTION STAGE 1**

- 1 Excavate and cut grade for construction of downstream end of culvert.
- Install Temporary Barrier along existing roadway. For layout and extent of temporary barrier along existing roadway, see Traffic Control Plan - Phase 1, Sheet TC-26 2 5




**Notes:**

The Contractor shall submit working drawings for the limits of excavation and demolition to the Engineer for approval. The working drawings shall show all proposed bracing and shoring as needed to protect the existing roadway and detour road. Demolition and excavation shall be coordinated with any temporary shoring, detour road, and construction of the new culvert.

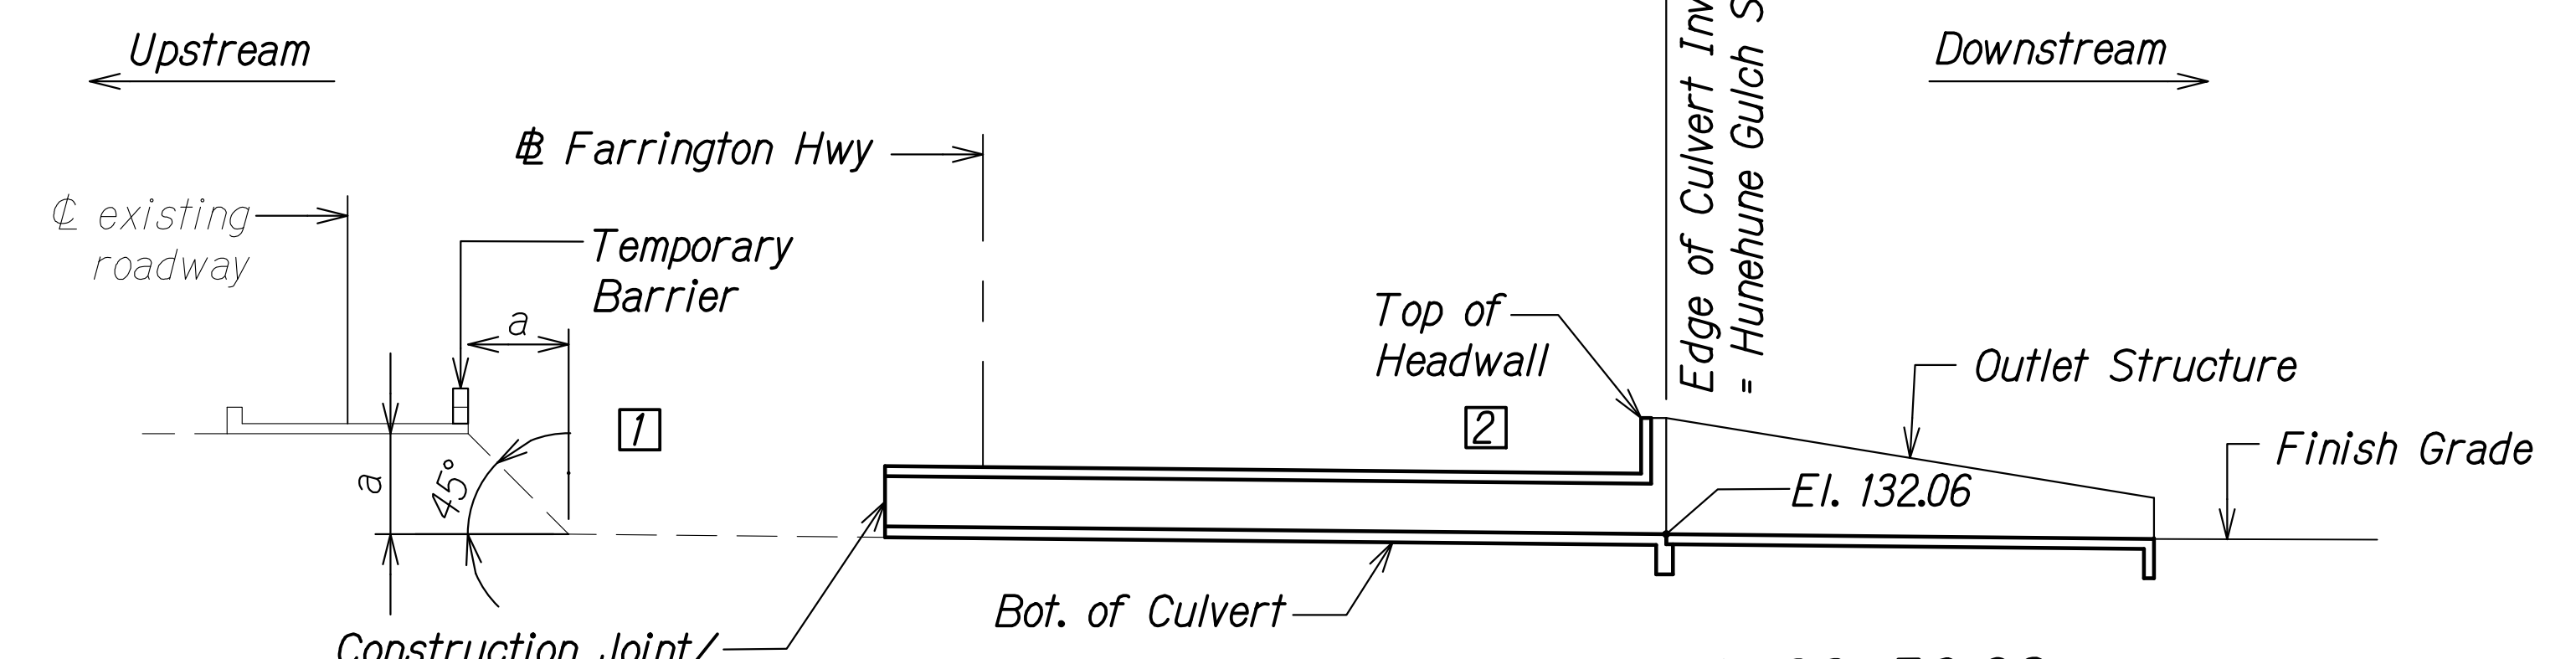


**SECTION AT STA 33+50.63**  
Scale: Not to Scale

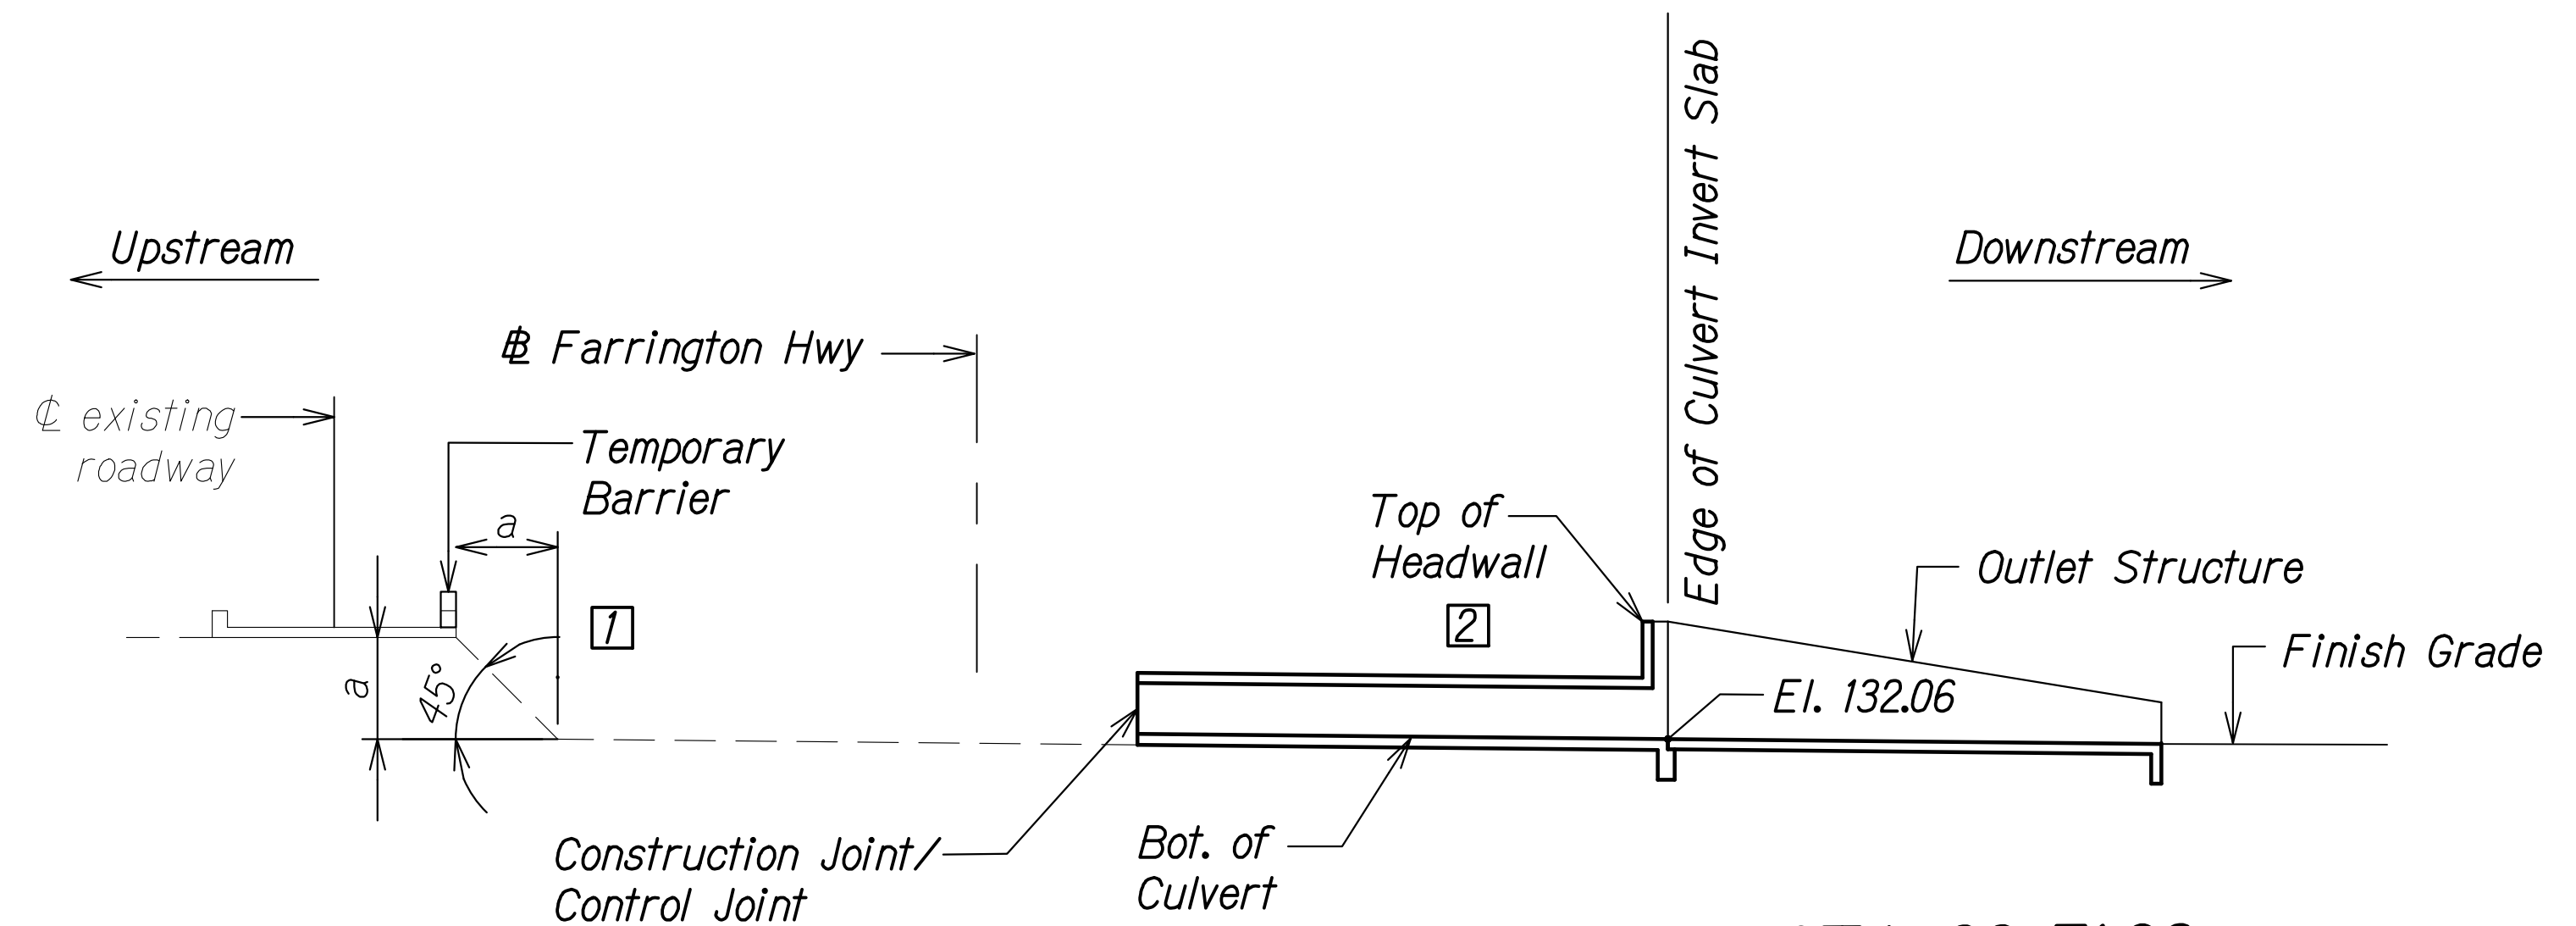

**SECTION AT STA 33+71.92**  
Scale: Not to Scale

SURVEY PLOTTED BY	DATE
DRAWN BY	
DESIGNED BY	
QUANTITIES BY	
CHECKED BY	
ORIGINAL PLAN	No.
NOTE BOOK	

DRAWING NAME: Z:\A\00\CONDOINGS\20-013-FARR-HWY-KAPOLEI.GC.ID.IT.WP8-EMTC\01.GRD\07-15-22 ADD1-DEL1AS\HWY3-SC0218-HUNE CONSTR-SEO ADD1-ADD05.DWG PLOT TIME: 07-15-22 5:42 PM

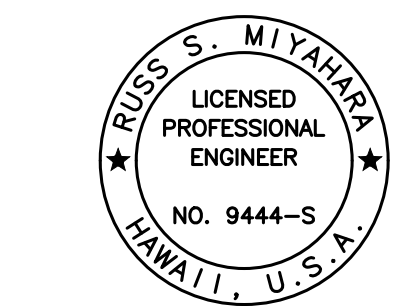


THIS WORK WAS PREPARED BY ME OR UNDER MY SUPERVISION AND CONSTRUCTION OF THIS PROJECT WILL BE UNDER MY OBSERVATION.  
 Signature: *Rugo S. Miyahara*  
 April 30, 2024  
 EXPIRATION DATE OF THE LICENSE

07/15/22	5	Revised Note
06/08/22	2	Revised Note
DATE	REVISION	
STATE OF HAWAII <b>DEPARTMENT OF TRANSPORTATION</b> HIGHWAYS DIVISION <b>Hunehune Gulch Box Culvert</b> <b>Construction Sequence</b> FARRINGTON HIGHWAY WIDENING Kapolei Golf Course Road to Fort Weaver Road Project No. 7101A-01-20 Scale: As Shown Date: Apr. 2022 <b>SHEET No. SC2.18 OF 23 SHEETS</b>		



FED. ROAD DIST. NO.	STATE	PROJ. NO.	FISCAL YEAR	SHEET NO.	TOTAL SHEETS
HAWAII	HAW.	7101A-01-20	2021	ADD. 495	


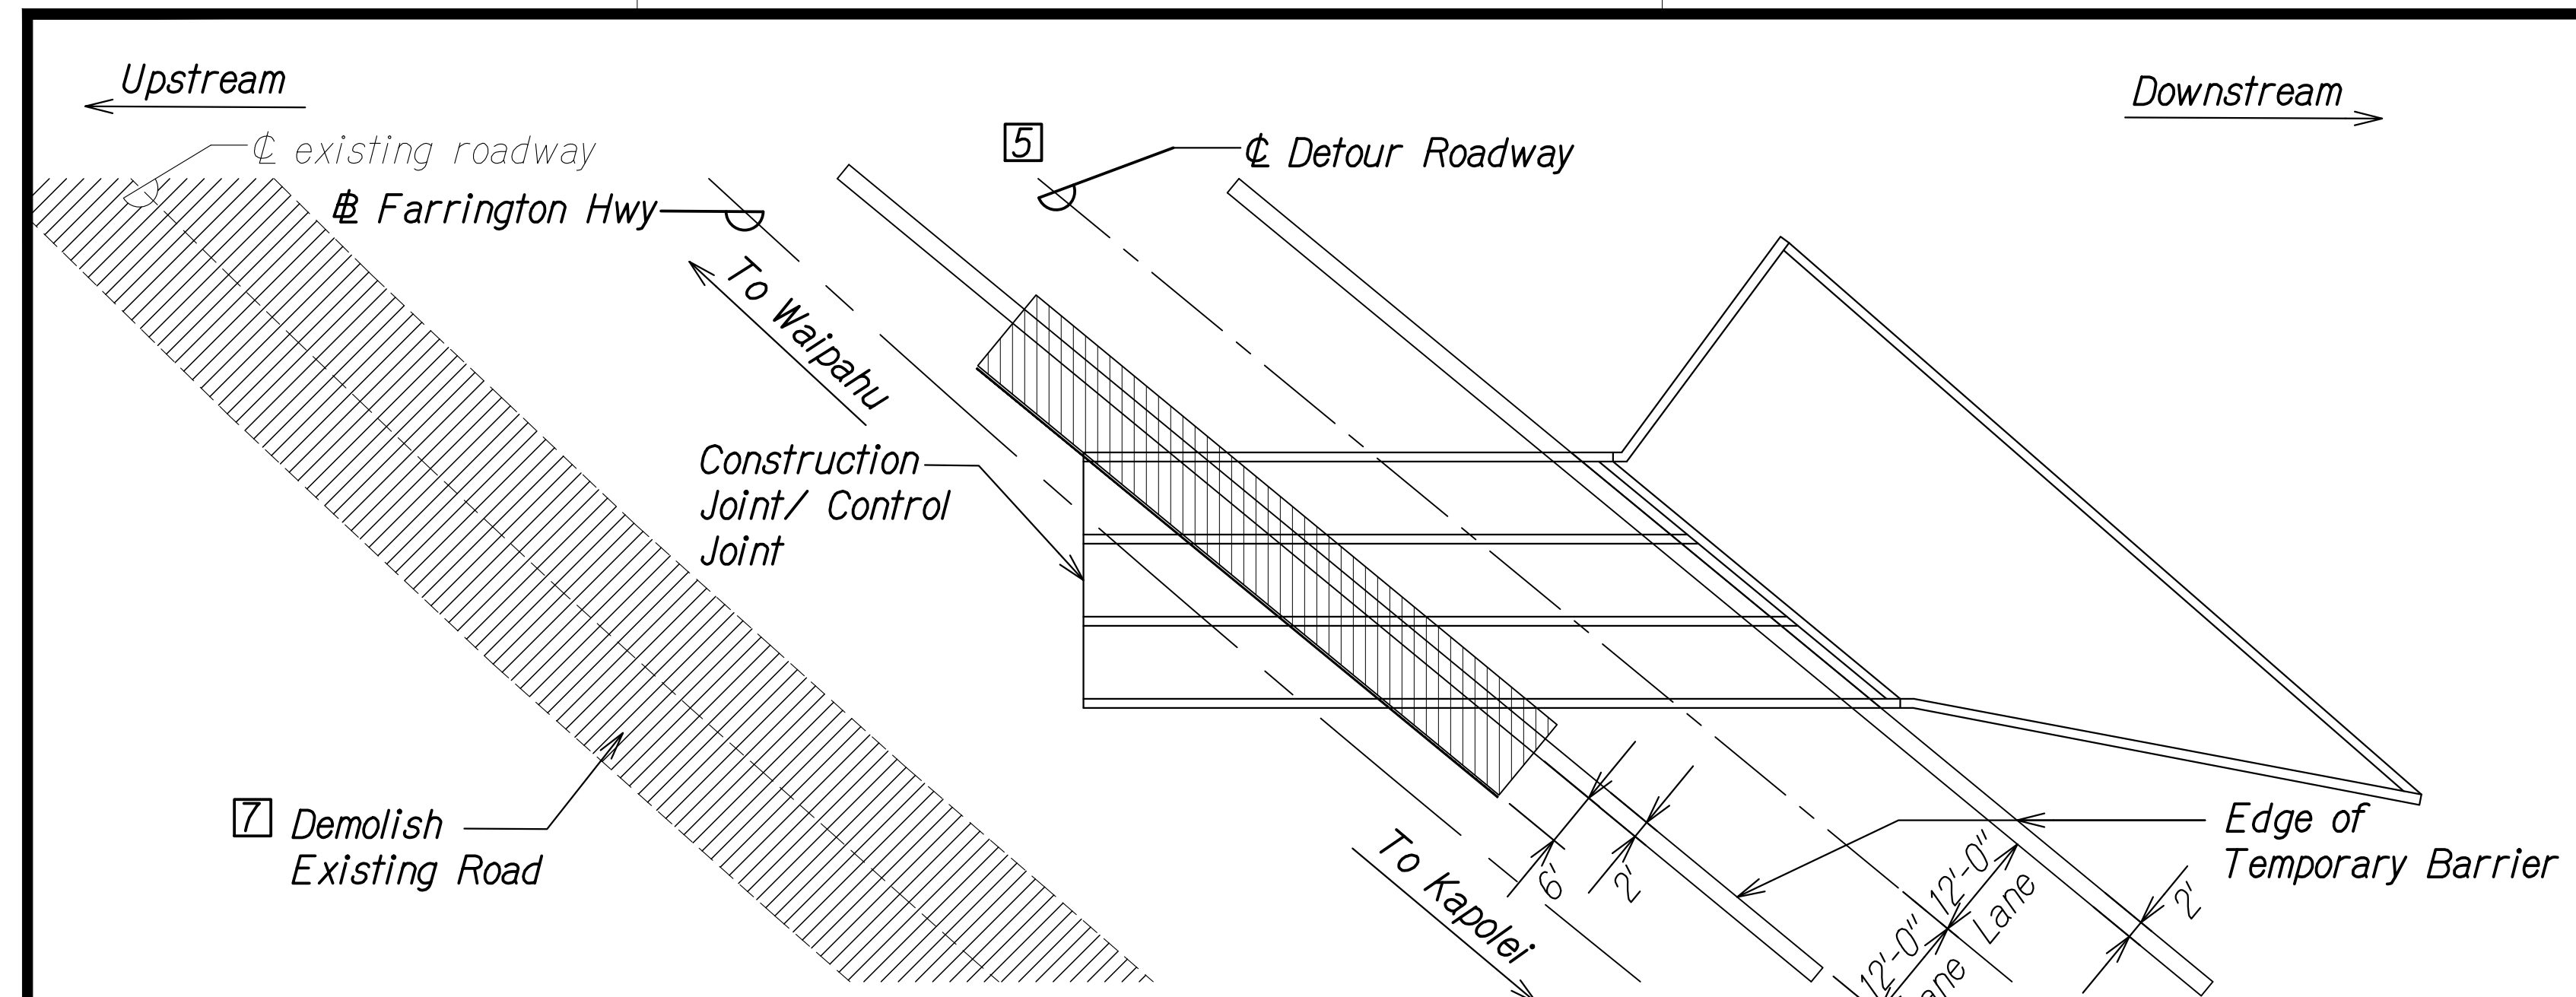


**CONSTRUCTION STAGE 3**

- 5 Construct detour roadway. See Traffic Control Plan - Phase 2, Sheet TC-30/2/5. Install Temporary Barrier along detour roadway. For extent and location of temporary barriers along detour roadway, see Traffic Control Plan - Phase 2, Sheet TC-30/2/5.
- 6 Open traffic to detour roadway.
- 7 Demolish existing roadway structure.


**Notes:**

The Contractor shall submit working drawings for the limits of excavation and demolition to the Engineer for approval. The working drawings shall show all proposed bracing and shoring as needed to protect the existing roadway and detour road. Demolition and excavation shall be coordinated with any temporary shoring, detour road, and construction of the new culvert.

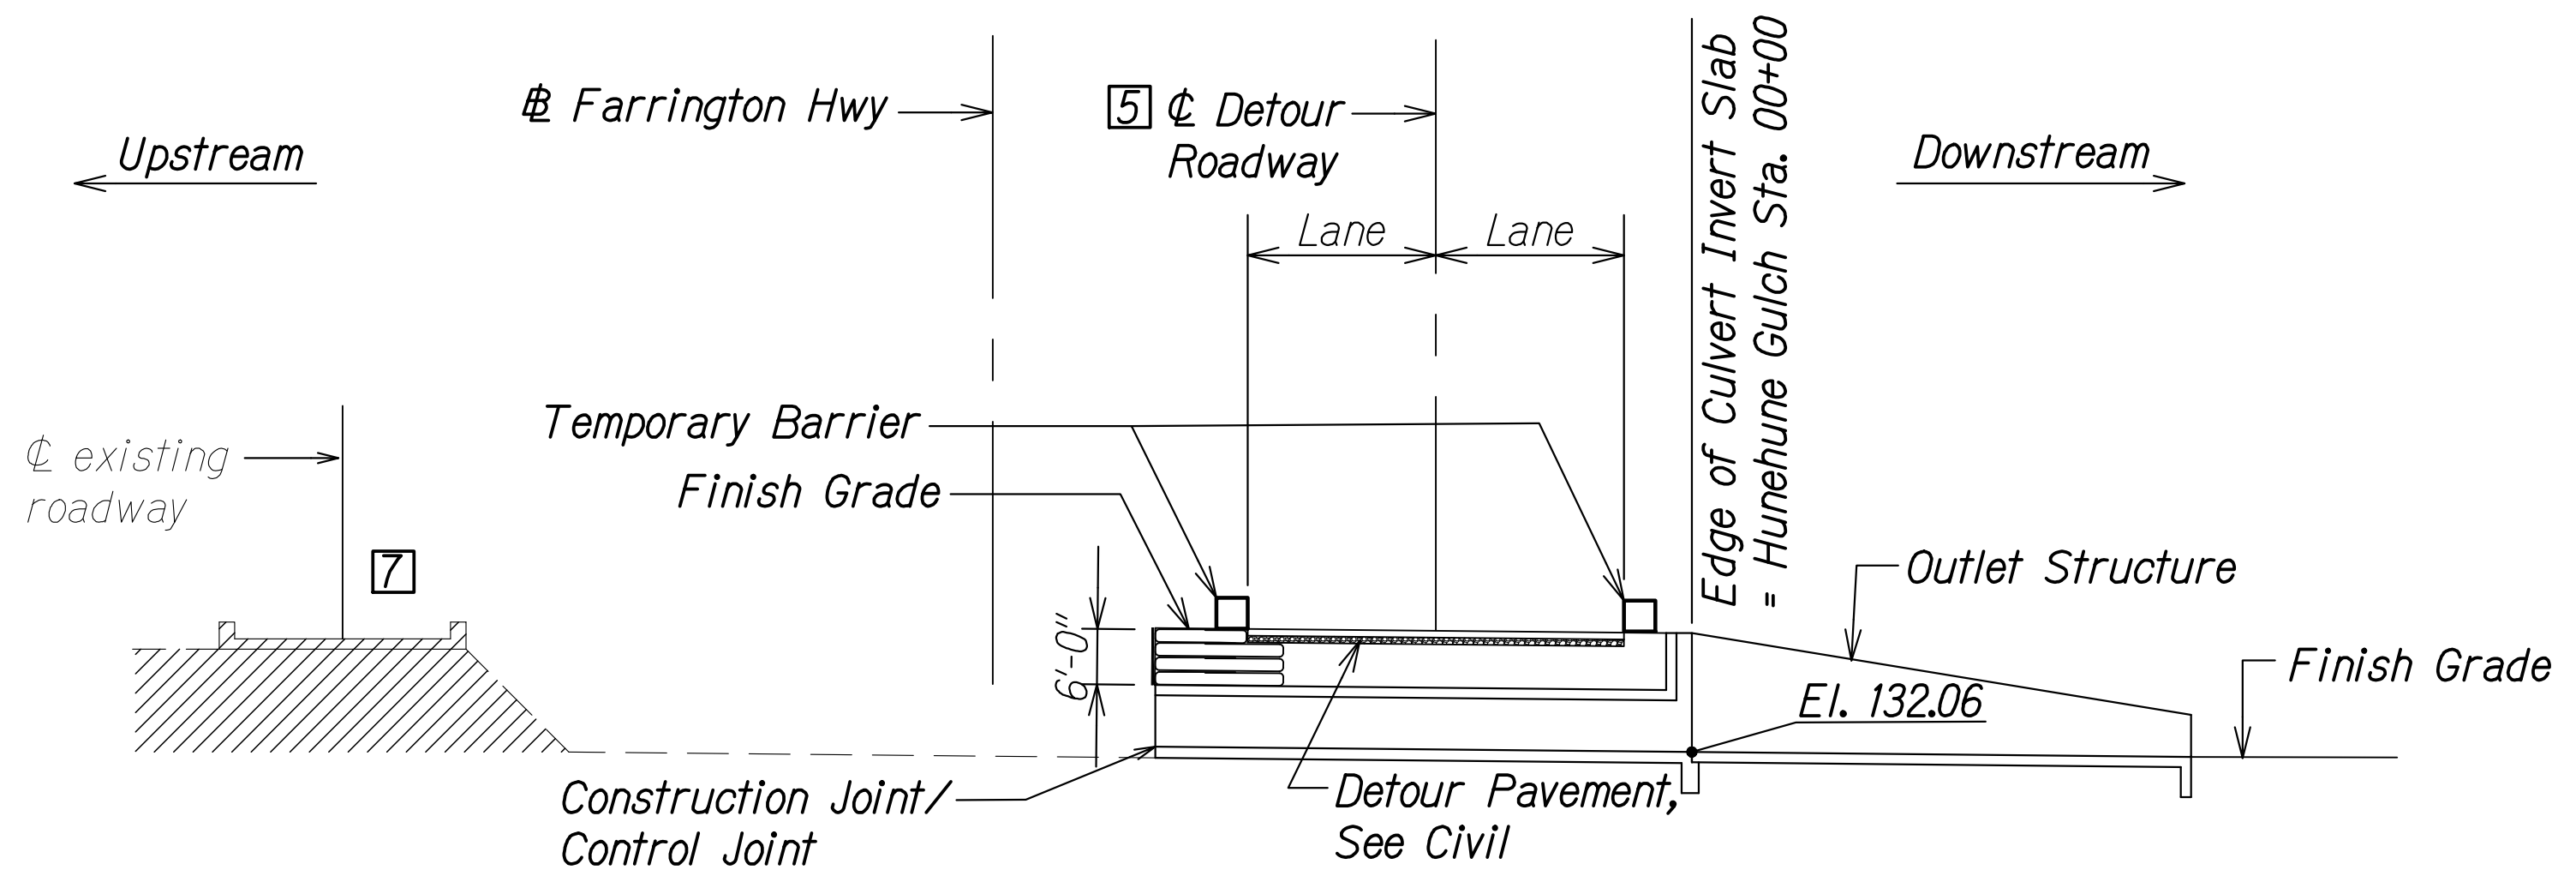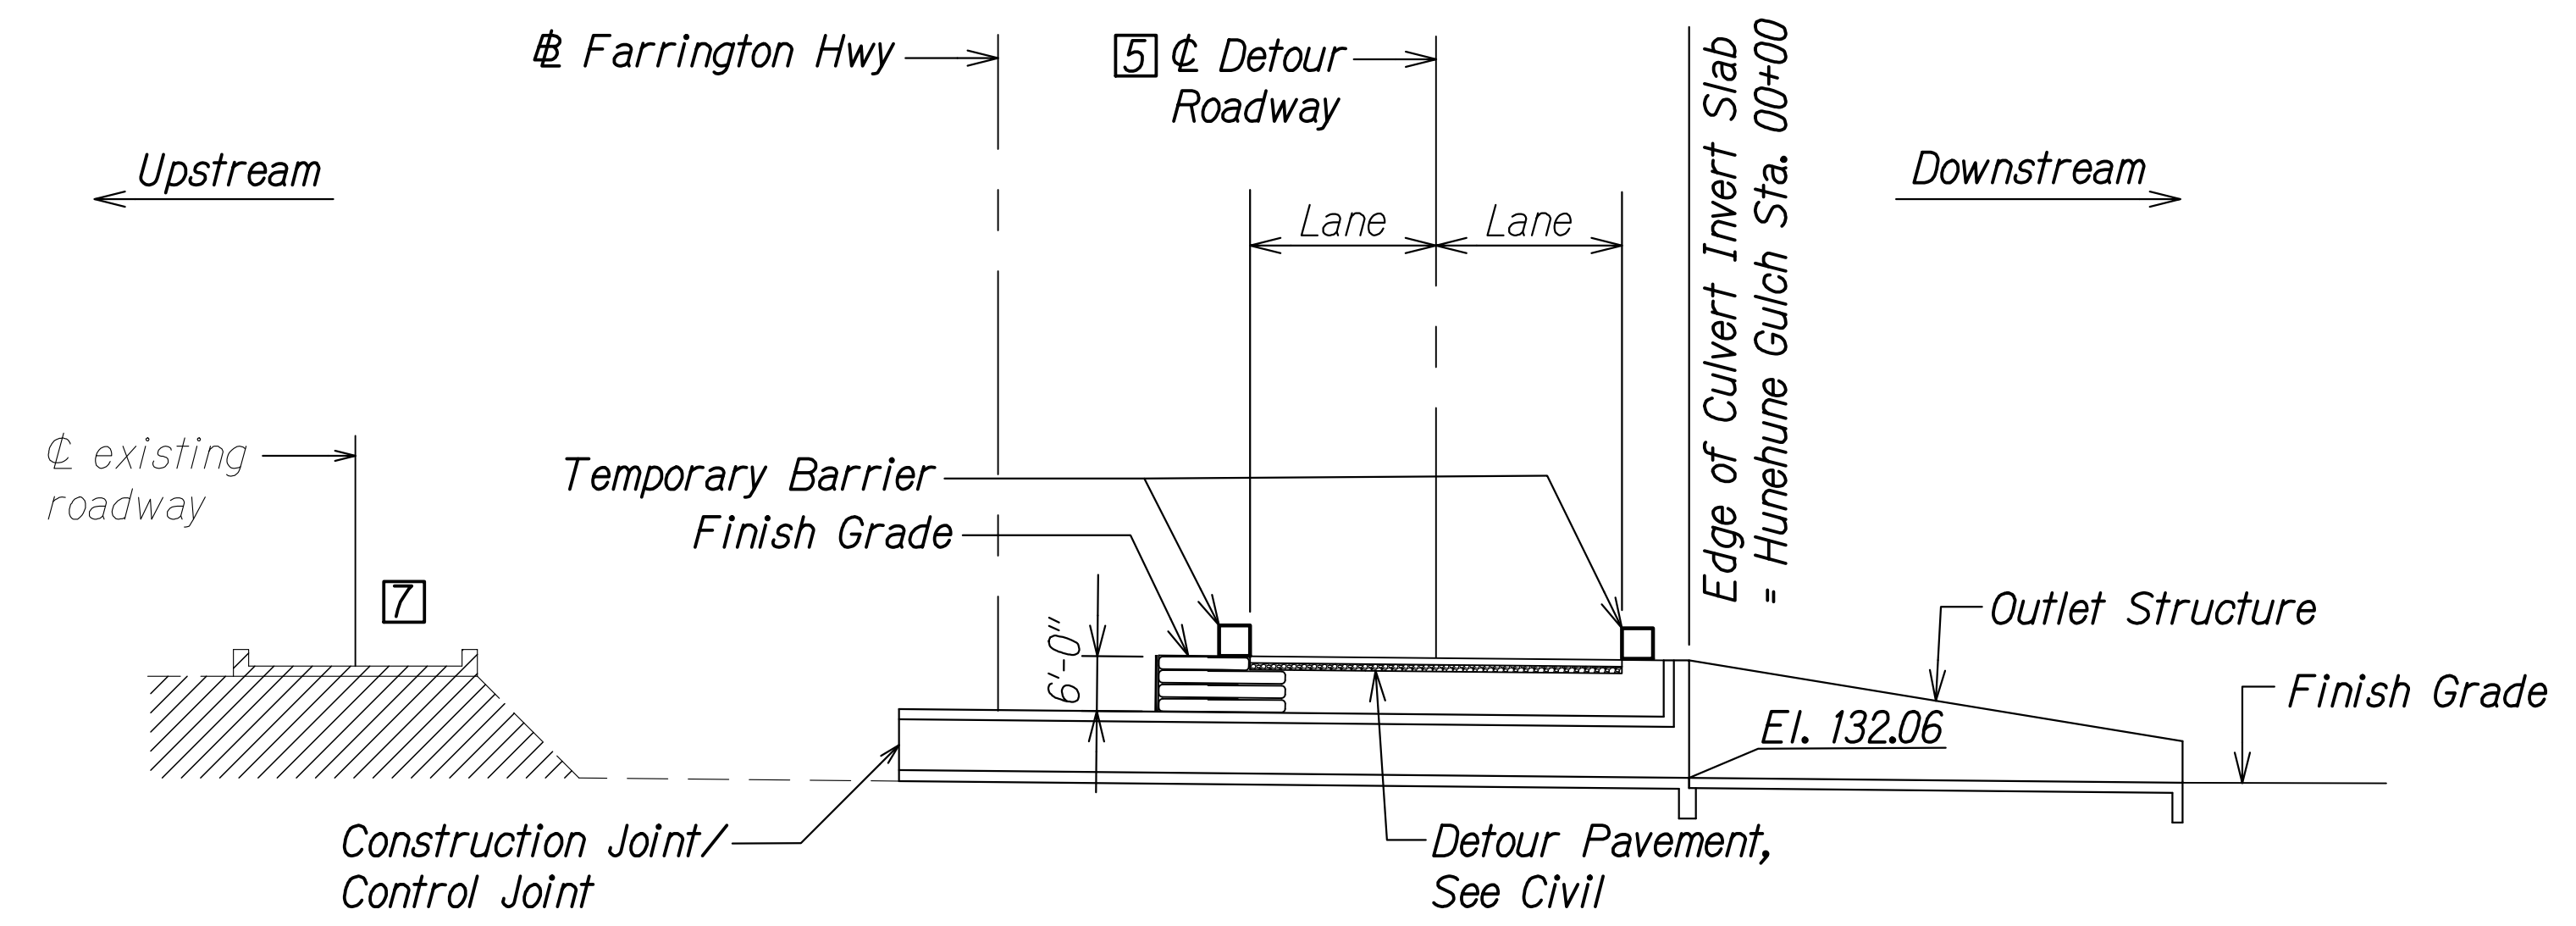

SURVEY PLOTTED BY	DATE
DRAWN BY	
DESIGNED BY	
QUANTITIES BY	
CHECKED BY	
ORIGINAL PLAN	No.
NOTE BOOK	

DRAWING NAME: Z:\A\00\CONSTR\20-013-FARR-HWY-KAPOLEI\GC\_ID\_ET\_WIP-EMT\01\_GAD\07-15-22\ADD1-ADD05.DWG PLOT TIME: 07-15-22 5:43 PM

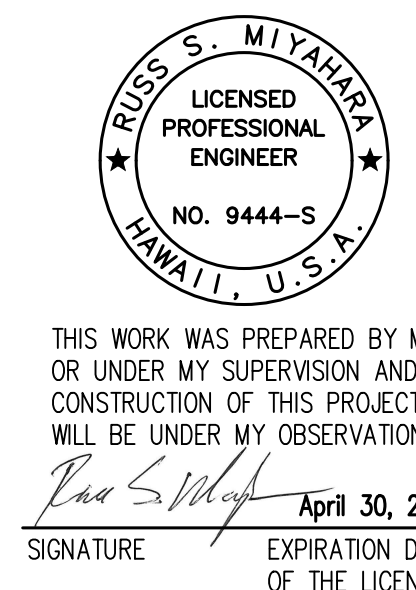

07/15/22	5	Revised Note
06/08/22	2	Revised Note
DATE	REVISION	

STATE OF HAWAII  
**DEPARTMENT OF TRANSPORTATION**  
HIGHWAYS DIVISION

**Hunehune Gulch Box Culvert Construction Sequence**


FARRINGTON HIGHWAY WIDENING  
Kapolei Golf Course Road to Fort Weaver Road  
Project No. 7101A-01-20

Scale: As Shown      Date: Apr. 2022


**SHEET No. SC2.20 OF 23 SHEETS**

FED. ROAD DIST. NO.	STATE	PROJ. NO.	FISCAL YEAR	SHEET NO.	TOTAL SHEETS
HAWAII	HAW.	7101A-01-20	2021	ADD. 499	

DRAWING NAME: Z:\100 ONGOING\20-013-FARR-HWY-KAPOLEI\06-10-ET-WIP-EMIT\01-GAD\07-15-22-ADD1-DEL\AS-EMIS-SC0301-PALE-BOX-CULV-LAYOUT-ADD5.DWG PLOT TIME: 07-15-22, 5:50 PM

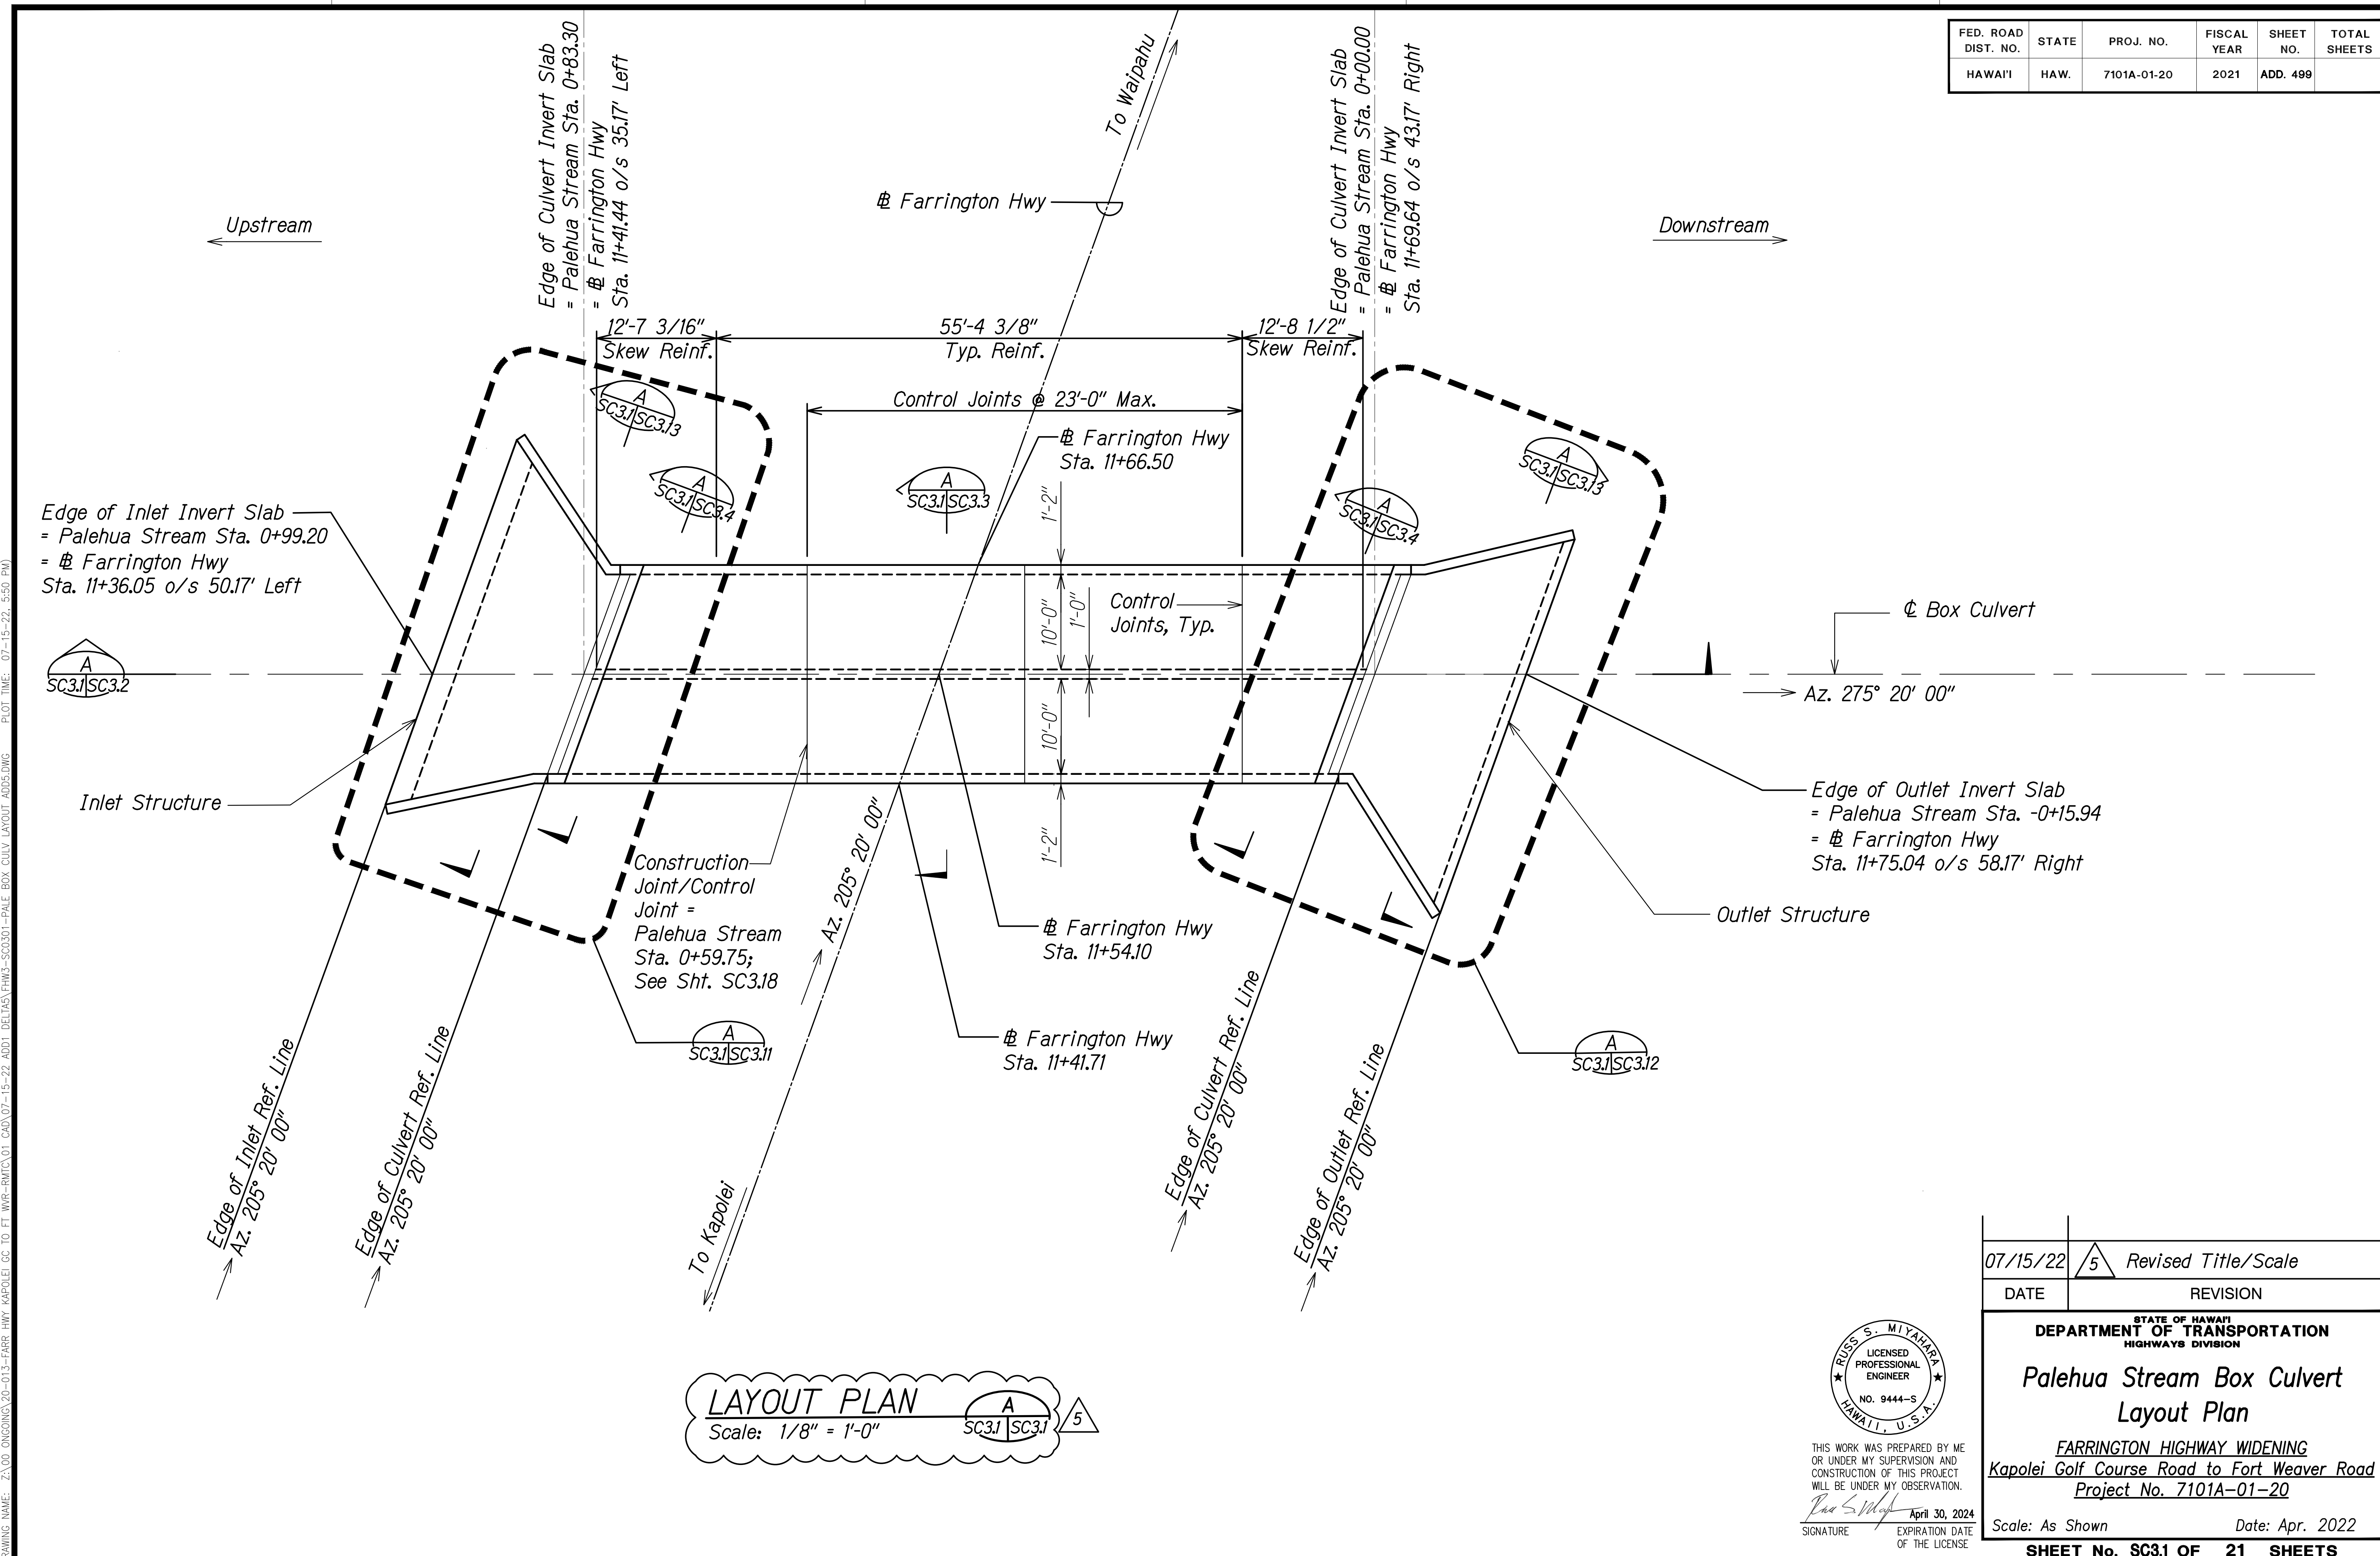

SURVEY PLOTTED BY	DATE
DRAWN BY	
DESIGNED BY	
QUANTITIES BY	
CHECKED BY	
ORIGINAL PLAN	
NOTE BOOK	
No.	

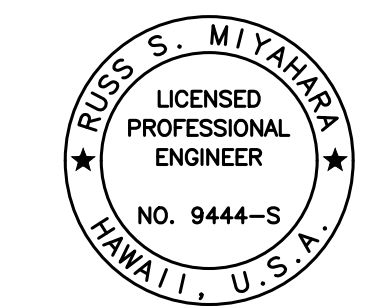


THIS WORK WAS PREPARED BY ME OR UNDER MY SUPERVISION AND CONSTRUCTION OF THIS PROJECT WILL BE UNDER MY OBSERVATION.  
*Rugo S. Miyahara*  
 SIGNATURE      April 30, 2024  
 EXPIRATION DATE OF THE LICENSE


07/15/22	5	Revised Title/Scale
DATE		REVISION
STATE OF HAWAII DEPARTMENT OF TRANSPORTATION HIGHWAYS DIVISION <b>Palehua Stream Box Culvert          Layout Plan</b> FARRINGTON HIGHWAY WIDENING Kapolei Golf Course Road to Fort Weaver Road Project No. 7101A-01-20		
Scale: As Shown		Date: Apr. 2022
SHEET No. SC3.1 OF 21 SHEETS		



FED. ROAD DIST. NO.	STATE	PROJ. NO.	FISCAL YEAR	SHEET NO.	TOTAL SHEETS
HAWAII	HAW.	7101A-01-20	2021	ADD. 516	

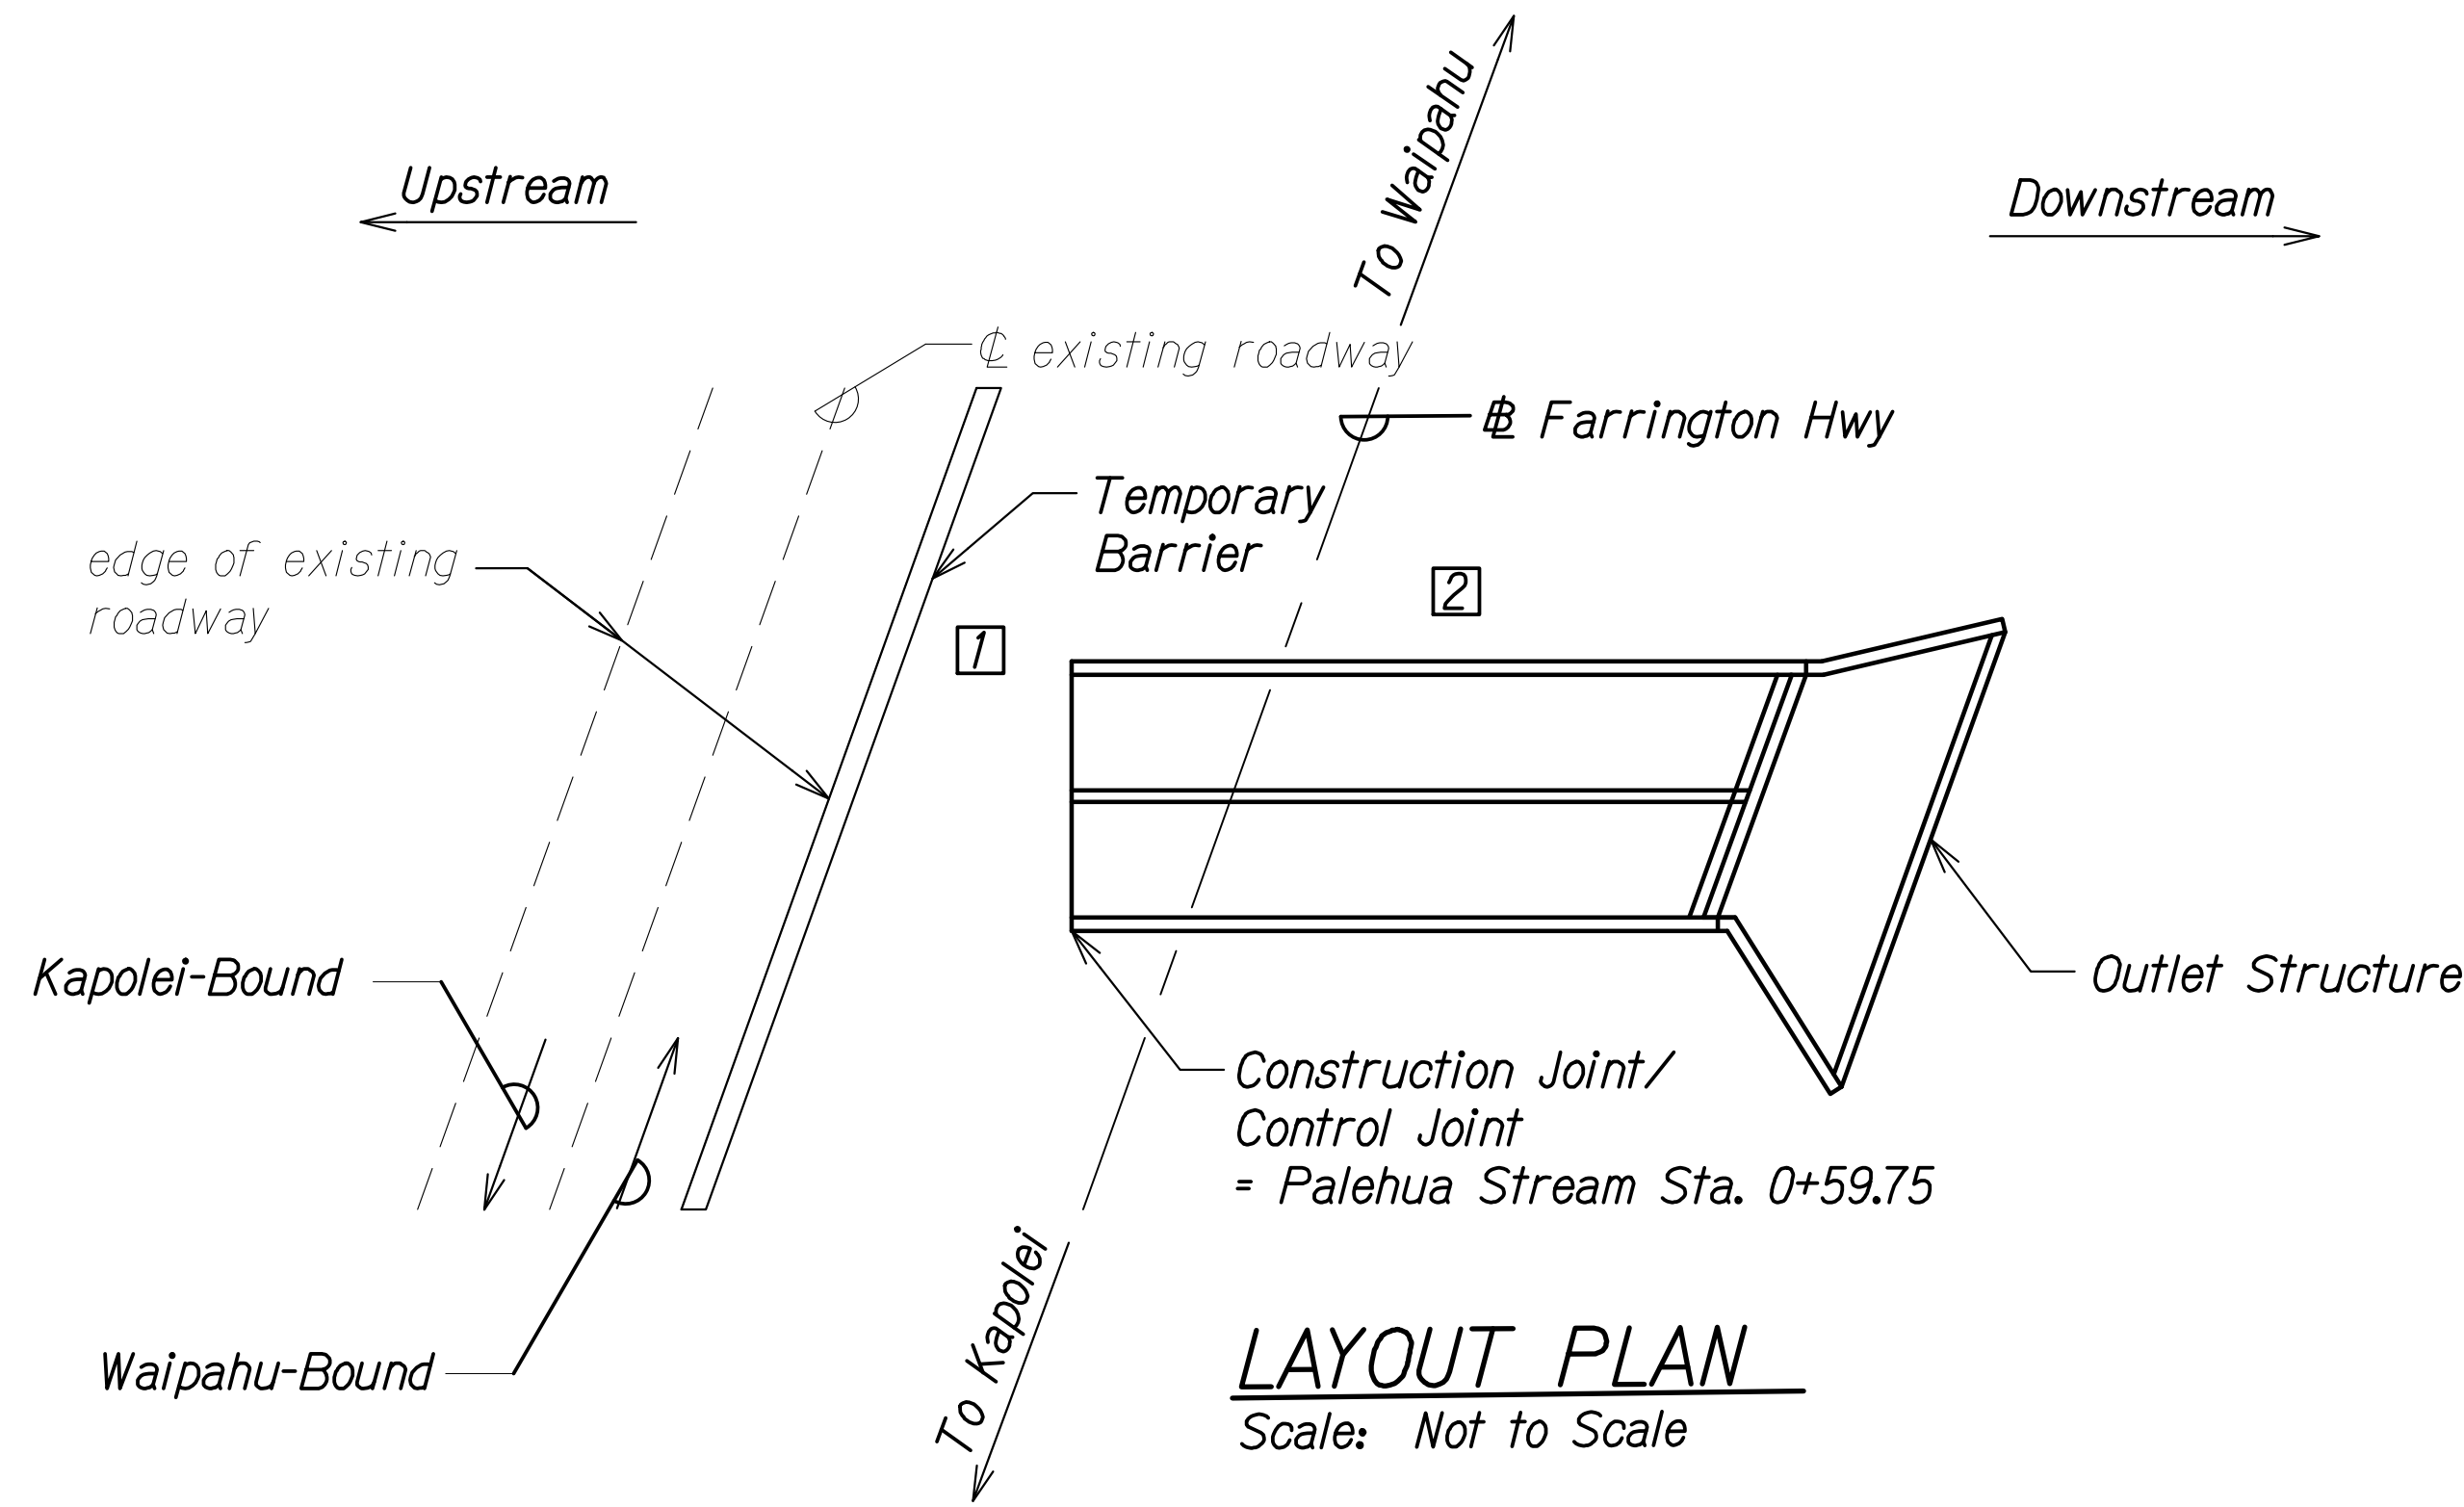

**LAYOUT PLAN**  
Scale: Not to Scale

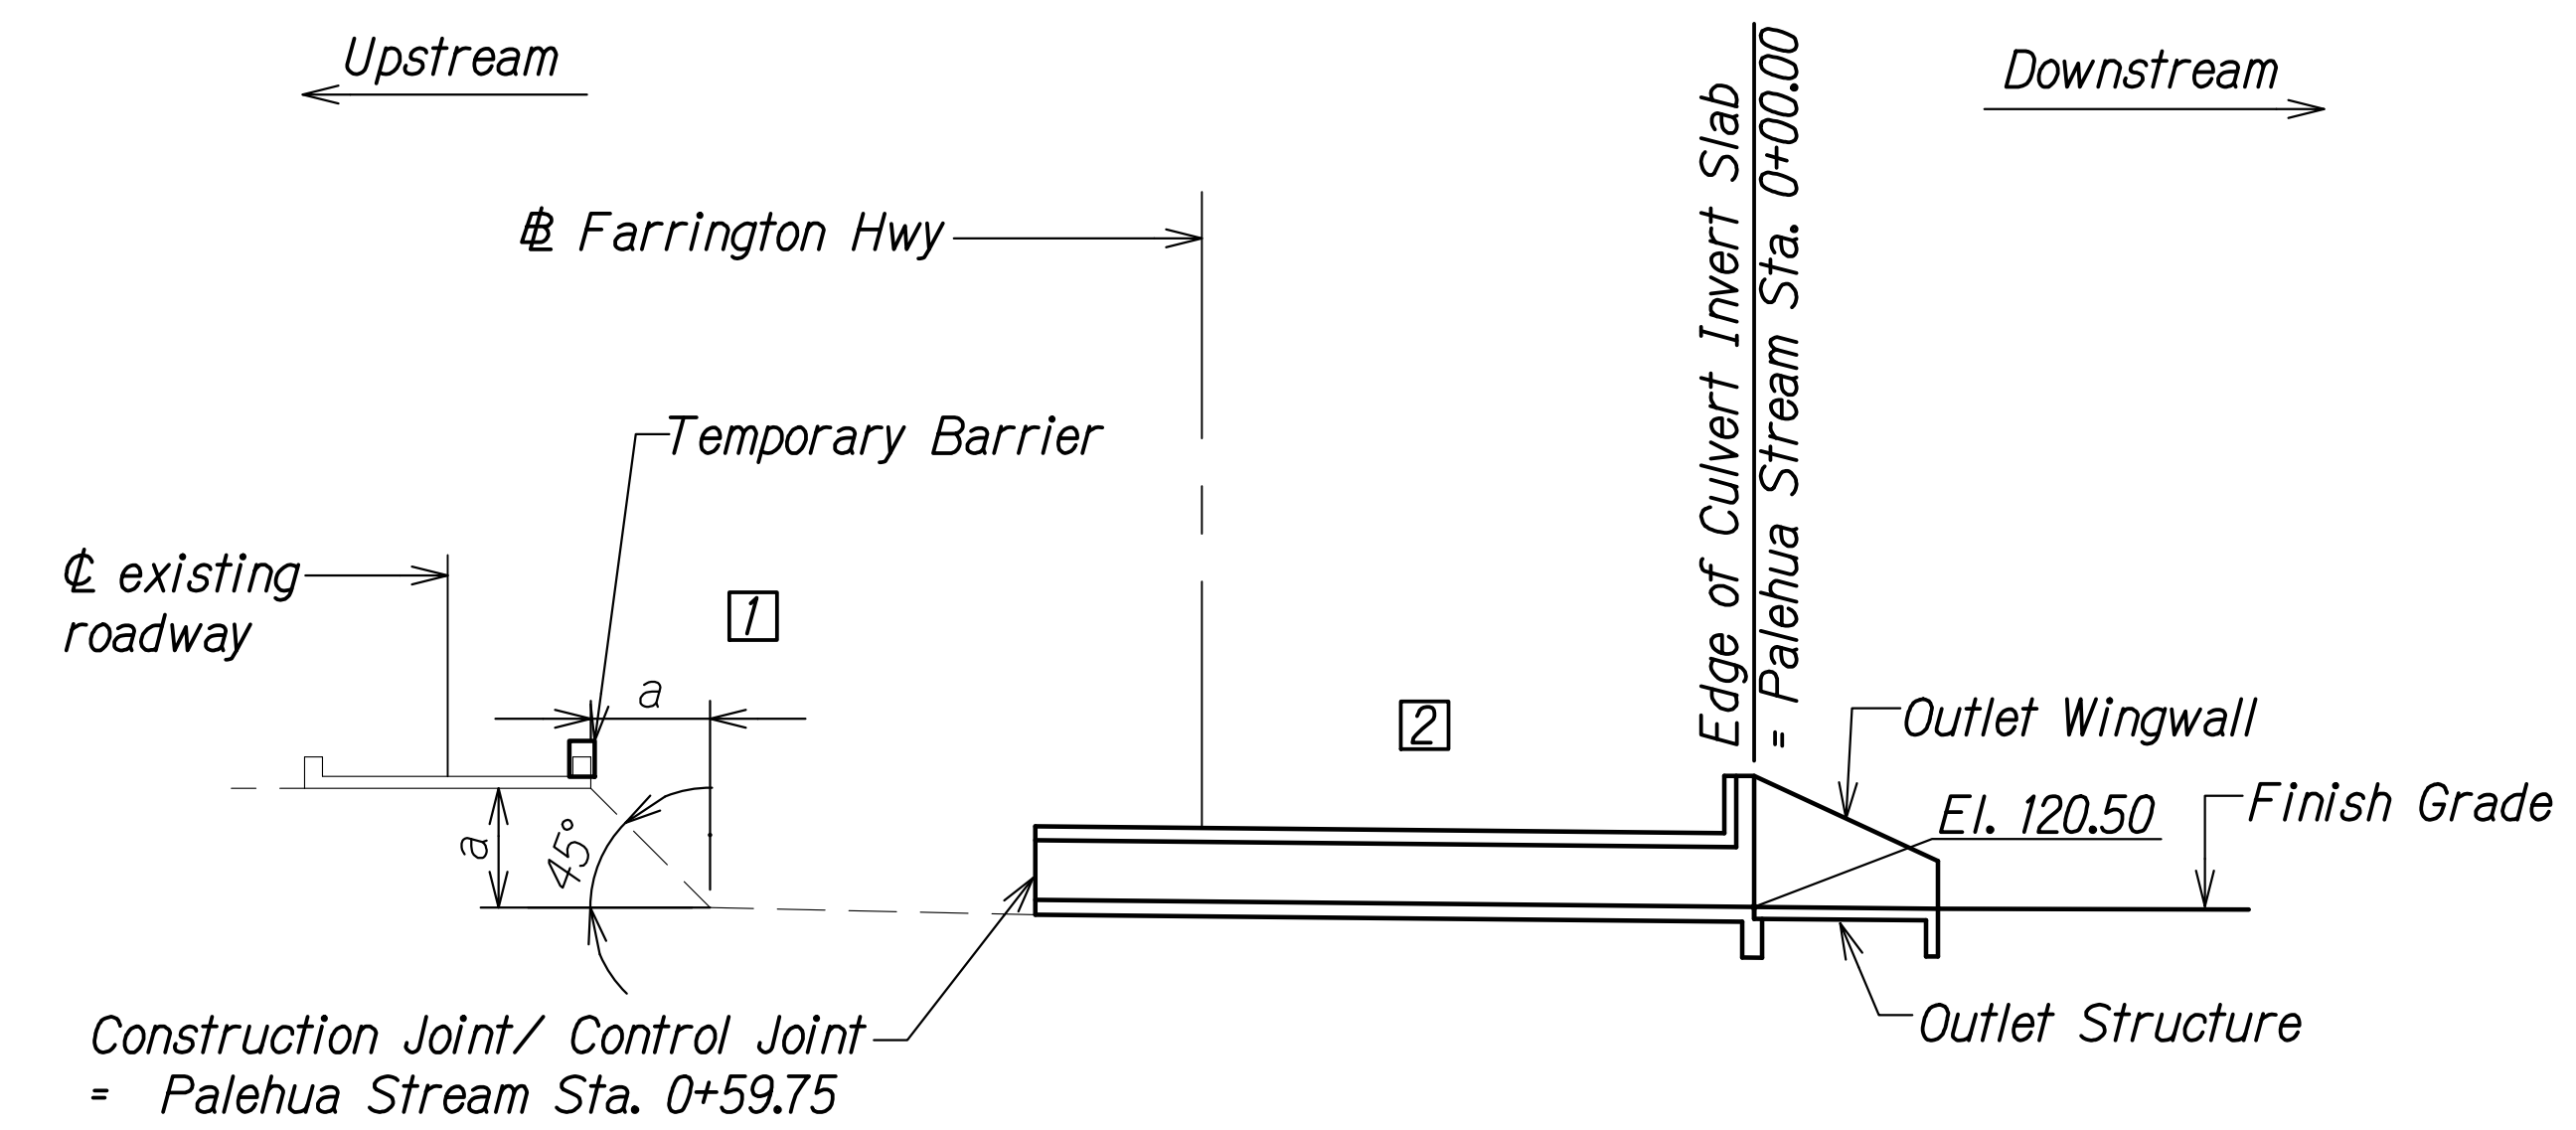

**SECTION AT BOX CULVERT**  
Scale: Not to Scale

**CONSTRUCTION STAGE 1**


- 1 Excavate and cut grade for construction of downstream end of culvert. Temporarily shore existing roadway, as required.  
  
For extent and location of temporary barrier along existing roadway, see Traffic Control Plan - Phase 1, Sheet TC-25.2 5
- 2 Construct downstream end of culvert and outlet structure.

**Notes:**

The Contractor shall submit working drawings for the limits of excavation and demolition to the Engineer for approval. The working drawings shall show all proposed bracing and shoring as needed to protect the existing roadway and detour road. Demolition and excavation shall be coordinated with any temporary shoring, detour road, and construction of the new culvert.

ORIGINAL PLAN	SURVEY PLOTTED BY	DATE
NOTE BOOK	DRAWN BY	
No. _____	DESIGNED BY	
	QUANTITIES BY	
	CHECKED BY	

DRAWING NAME: Z:\00\_ONGOING\20-013-FARR-HWY-KAPOLEI\01-CAD\07-15-22-ADD1-DELIAS\HWY3-SC0318-PALE-CONSTR-SEG-ADD1-ADD5.DWG PLOT TIME: 07-15-22, 5:51 PM

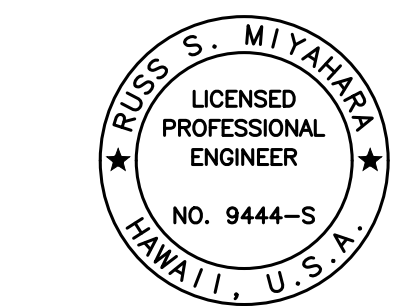

THIS WORK WAS PREPARED BY ME OR UNDER MY SUPERVISION AND CONSTRUCTION OF THIS PROJECT WILL BE UNDER MY OBSERVATION.  
*Rugo S. Miyakawa*  
SIGNATURE April 30, 2024  
EXPIRATION DATE OF THE LICENSE

DATE	REVISION
07/15/22	5 Revised Note
06/08/22	2 Revised Note


STATE OF HAWAII  
**DEPARTMENT OF TRANSPORTATION**  
HIGHWAYS DIVISION

**Palehua Stream Box Culvert  
Construction Sequence**

FARRINGTON HIGHWAY WIDENING  
Kapolei Golf Course Road to Fort Weaver Road  
Project No. 7101A-01-20

Scale: As Shown Date: Apr. 2022

FED. ROAD DIST. NO.	STATE	PROJ. NO.	FISCAL YEAR	SHEET NO.	TOTAL SHEETS
HAWAII	HAW.	7101A-01-20	2021	ADD. 517	

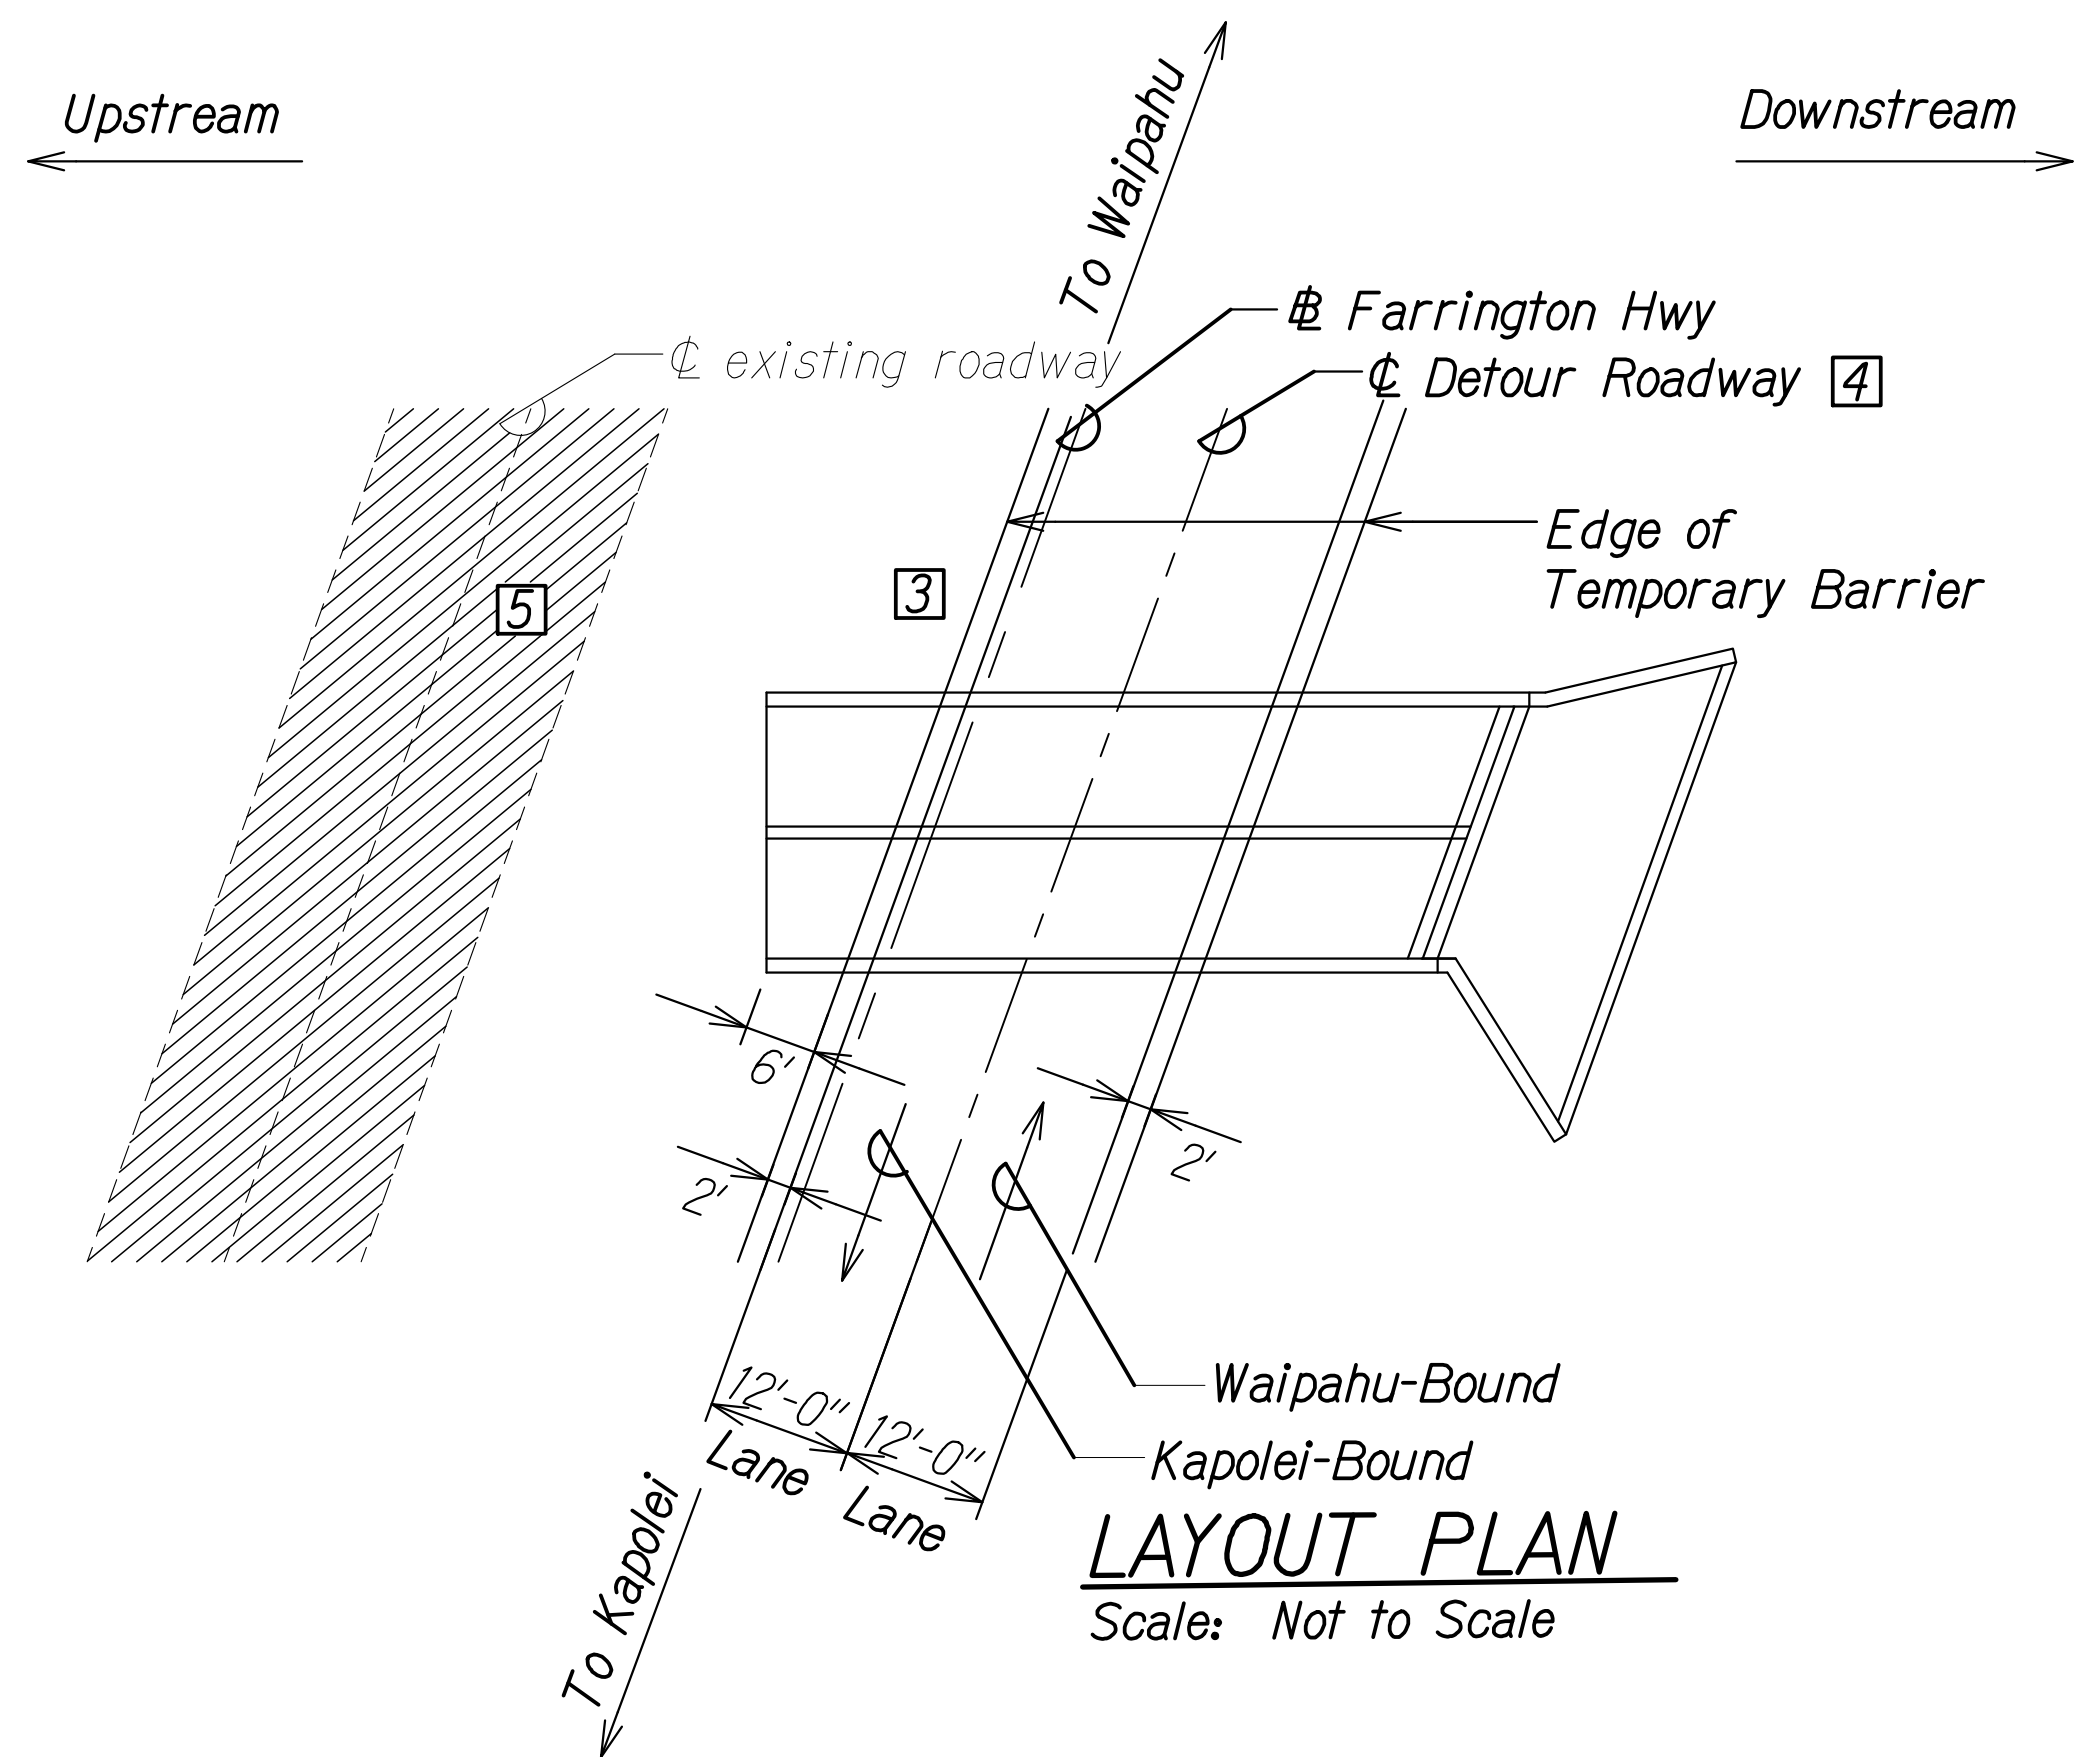


**CONSTRUCTION STAGE 2**

- 3 Backfill constructed portion of culvert to finish grade up to construction joint.
- 4 Construct roadway detour. See Traffic Control Plan - Phase 2, Sheet (TC-29). For extent and location of temporary barriers along detour roadway, see Traffic Control Plan - Phase 2, Sheet (TC-29).
- 5 Demolish existing roadway structure.

**Notes:**


The Contractor shall submit working drawings for the limits of excavation and demolition to the Engineer for approval. The working drawings shall show all proposed bracing and shoring as needed to protect the existing roadway and detour road. Demolition and excavation shall be coordinated with any temporary shoring, detour road, and construction of the new culvert.

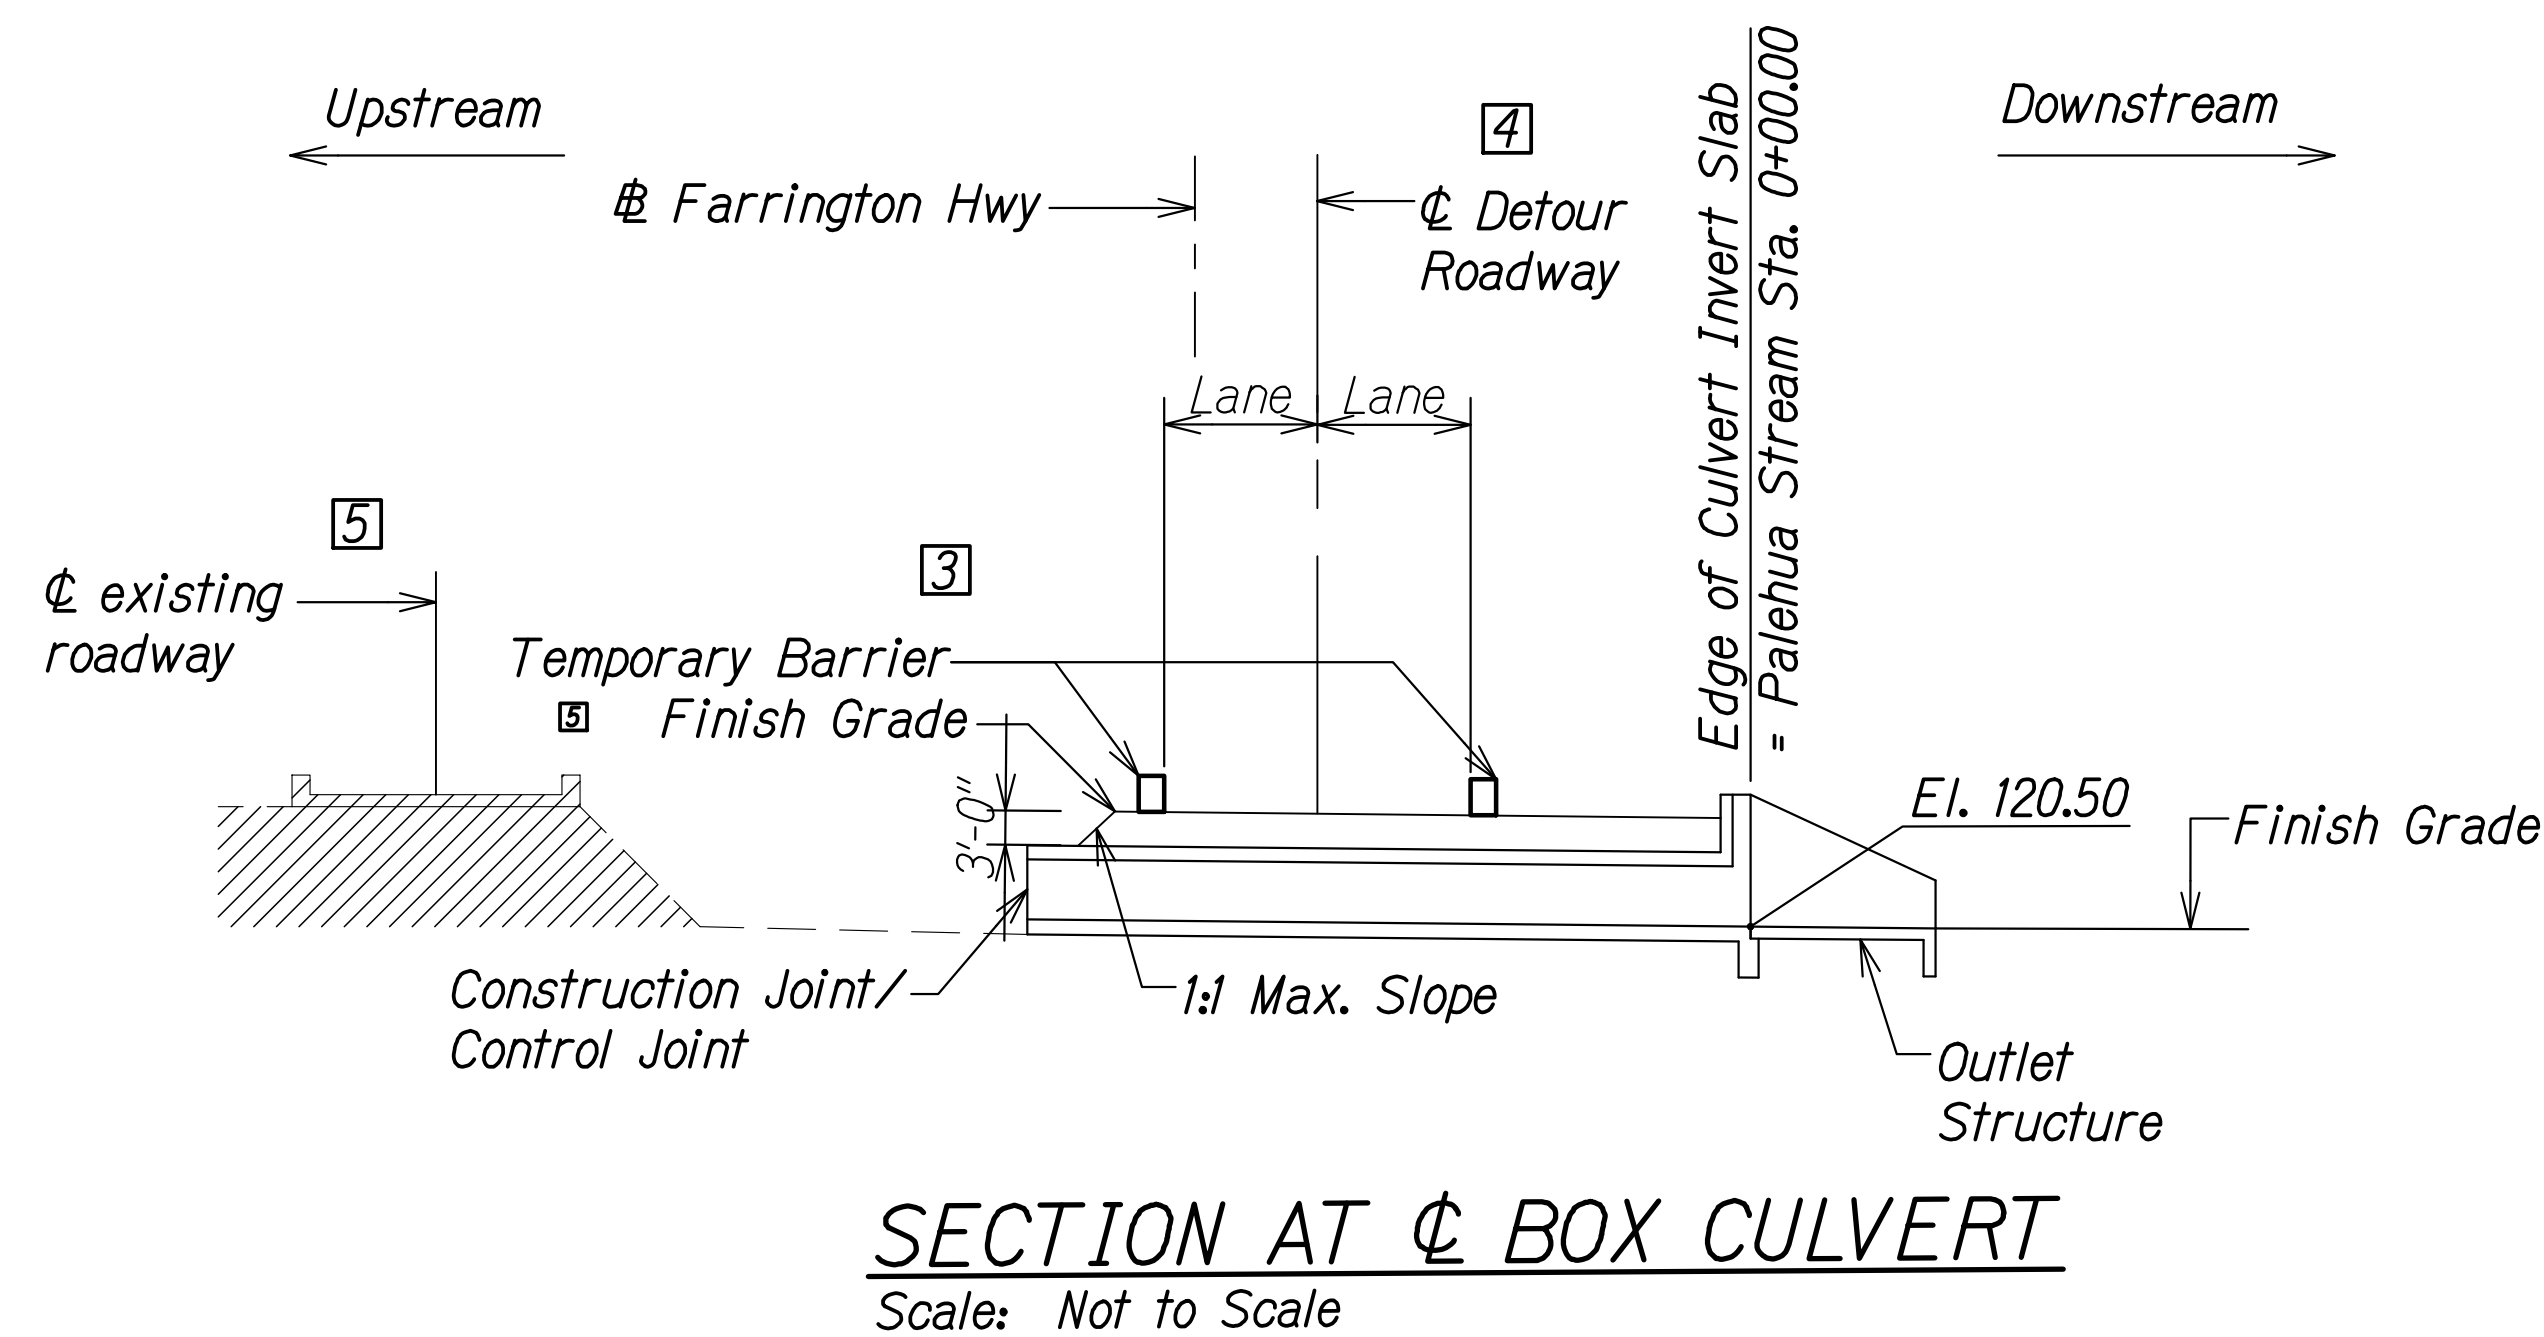

SURVEY PLOTTED BY	DATE
DRAWN BY	
DESIGNED BY	
QUANTITIES BY	
CHECKED BY	
ORIGINAL PLAN	
NOTE BOOK	
No.	

DRAWING NAME: Z:\100\CONSTR\20-013-FARR-HWY-KAPOLEI-GC-ID-IT-WP-RMTC\01-GAD\07-15-22-ADD1-DELIAS\HWY3-SC0318-PALE-CONSTR-SEG-ADD1-ADD5.DWG PLOT TIME: 07-15-22, 5:51 PM

DATE	REVISION
07/15/22	5 Revised Note
06/08/22	2 Revised Note

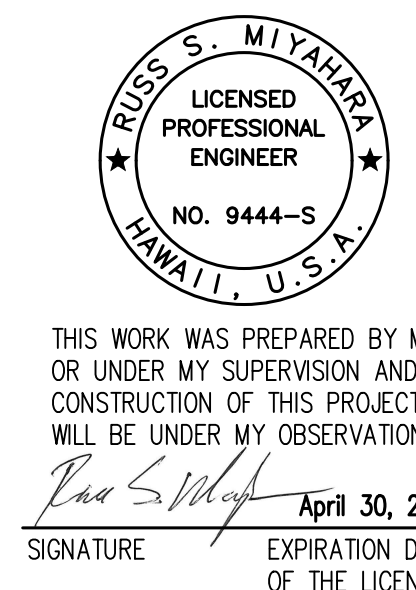


STATE OF HAWAII  
**DEPARTMENT OF TRANSPORTATION**  
HIGHWAYS DIVISION

**Palehua Stream Box Culvert**  
Construction Sequence

FARRINGTON HIGHWAY WIDENING  
Kapolei Golf Course Road to Fort Weaver Road  
Project No. 7101A-01-20

Scale: As Shown Date: Apr. 2022

FED. ROAD DIST. NO.	STATE	PROJ. NO.	FISCAL YEAR	SHEET NO.	TOTAL SHEETS
HAWAII	HAW.	7101A-01-20	2021	ADD. 530	

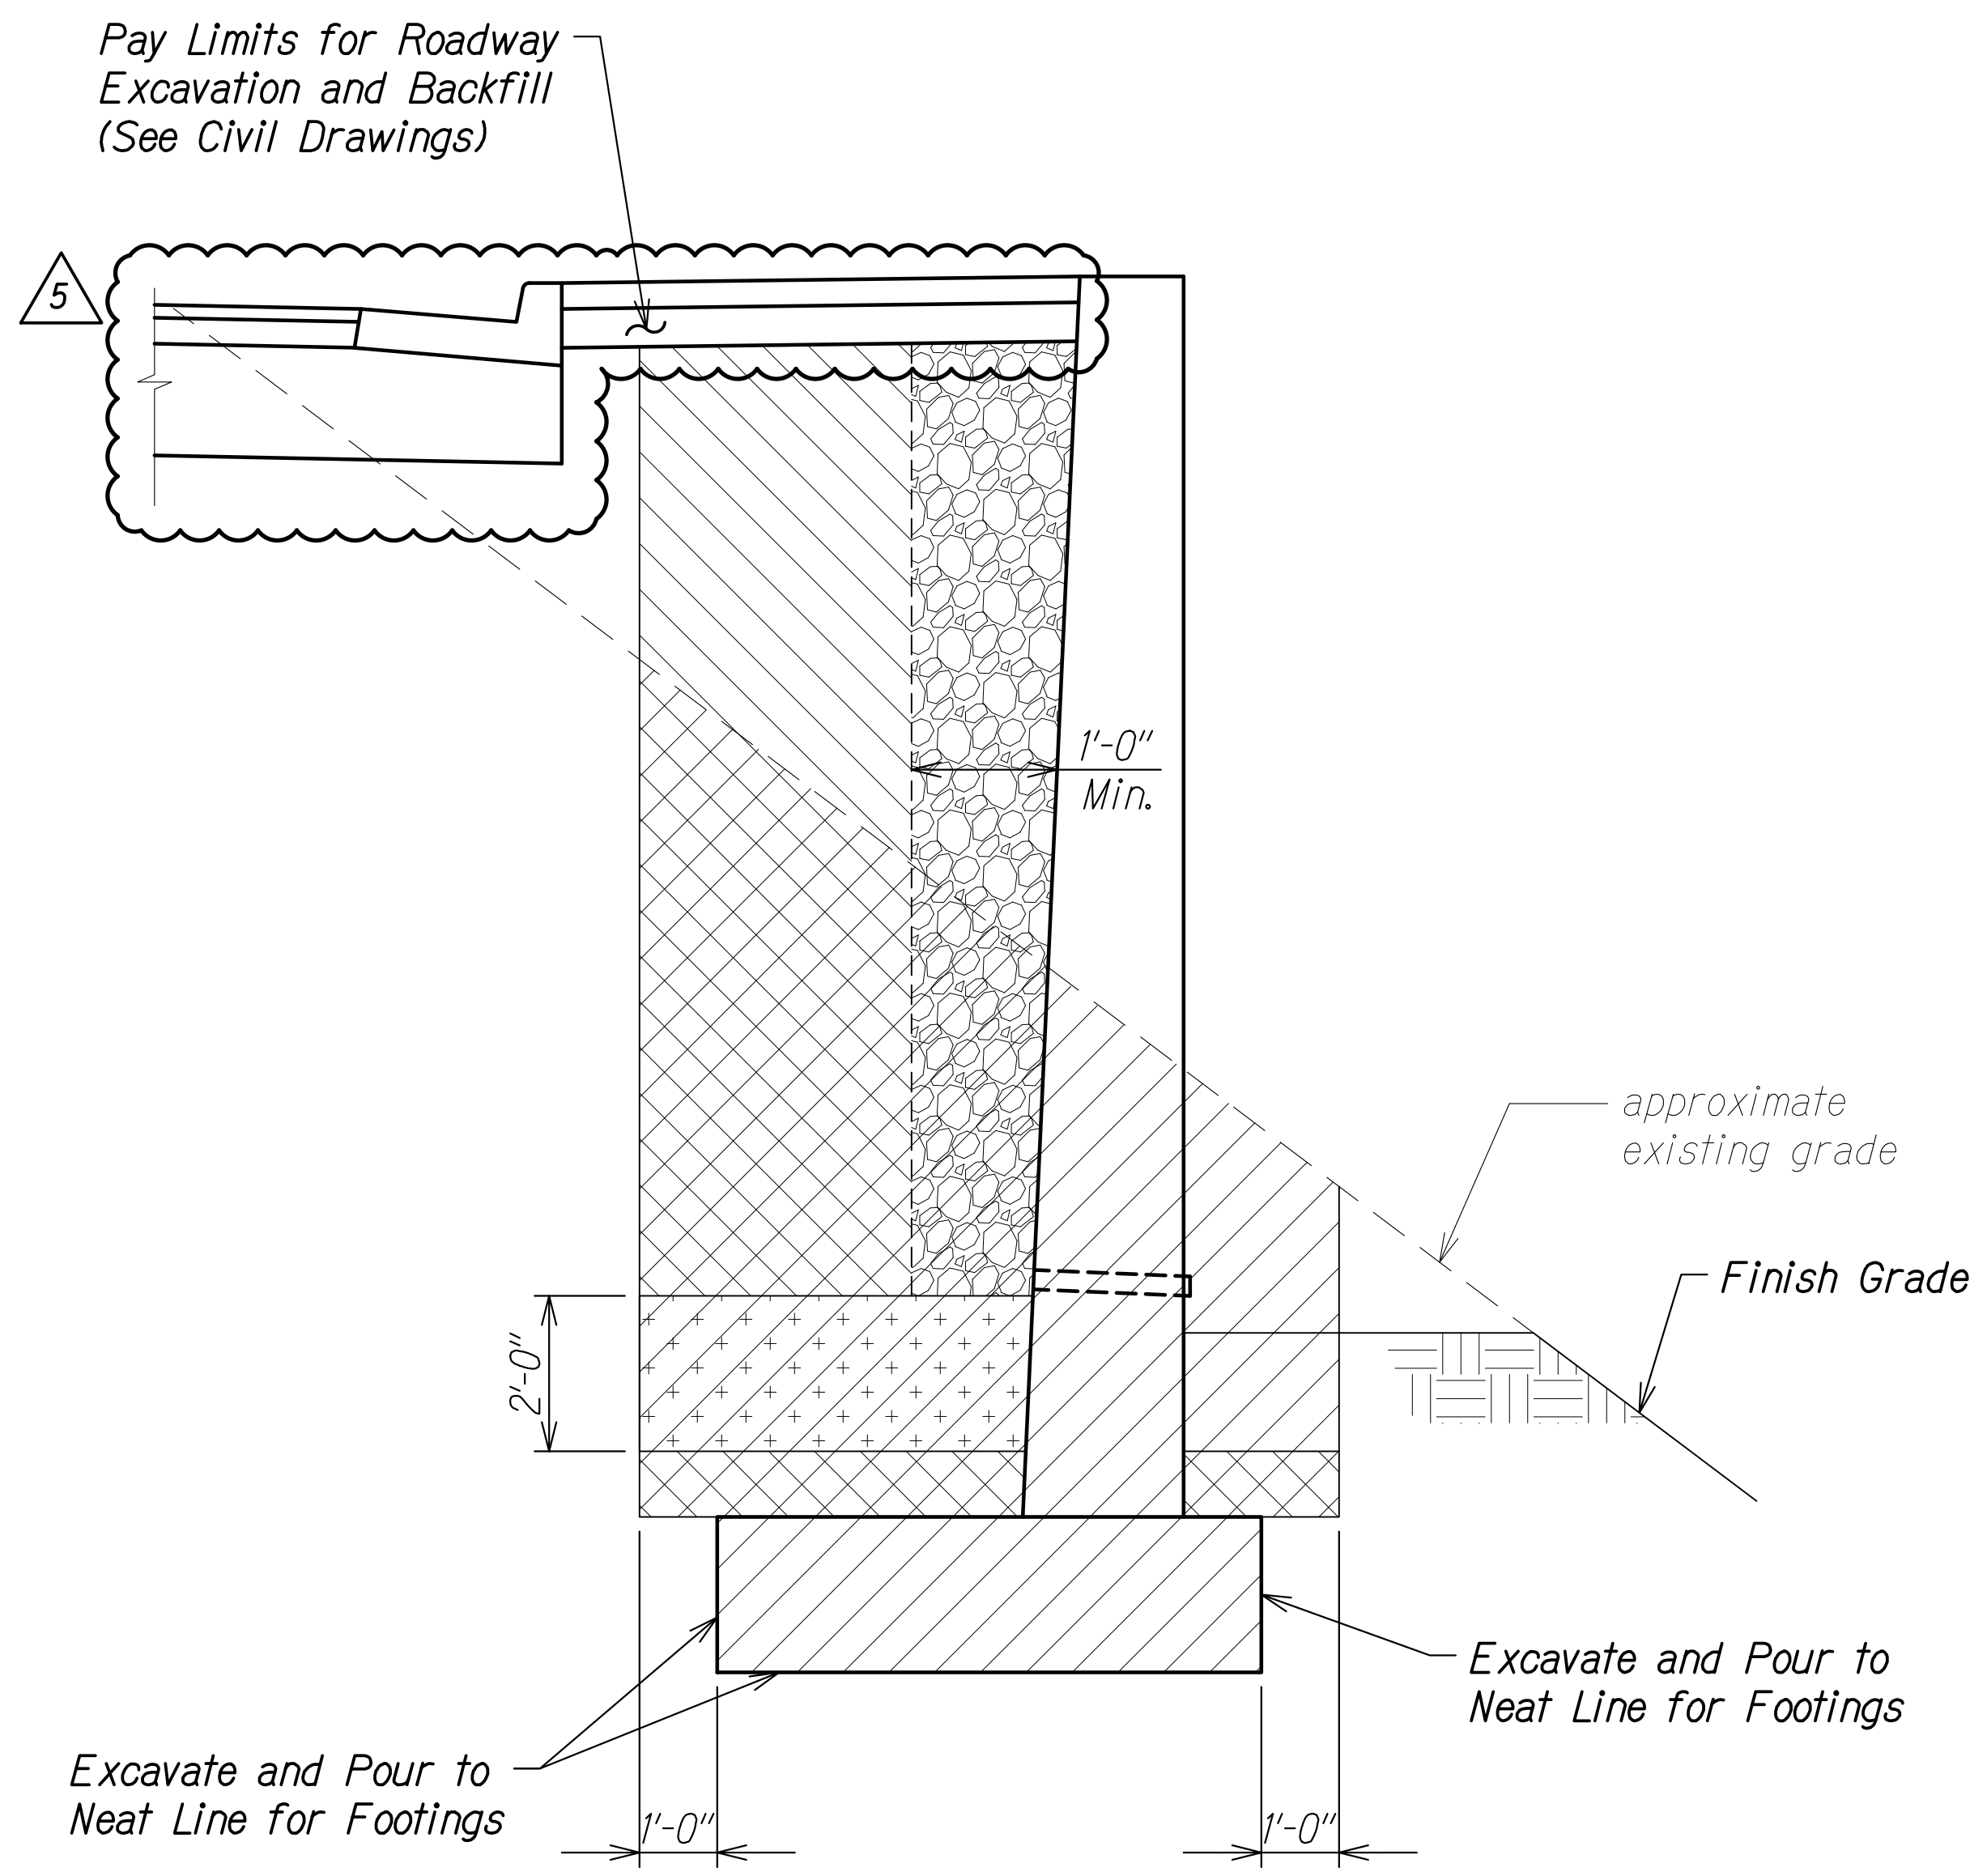





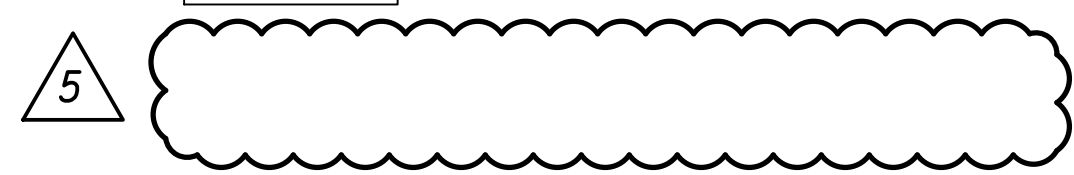
RETAINING WALL AT KAHI MOHALA

STRUCTURE EXCAVATION AND BACKFILL PAY LIMITS SECTION  
Scale: 1/2" = 1'-0"

A  
SD21 SD21


Legend:

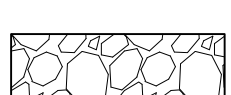-  Structure Excavation
-  Structure Backfill
-  Filter Material Wrapped in Filter Fabric
-  Impervious Material



SURVEY PLOTTED BY	DATE
DRAWN BY	
DESIGNED BY	
QUANTITIES BY	
CHECKED BY	
ORIGINAL PLAN	
NOTE BOOK	
No.	


DRAWING NAME: Z:\00\_ONGOING\20-013-FARR-HWY-KAPOLEI-GC-10-ET-WR-EMTC\01-CAD\07-15-22-ADD1-DELIAS\HWY3-SD201-EXC&BACKFILL.DWG PLOT TIME: 07-15-22, 9:52 PM

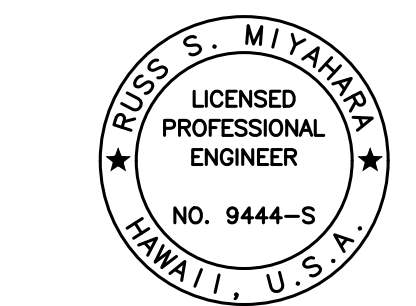


THIS WORK WAS PREPARED BY ME OR UNDER MY SUPERVISION AND CONSTRUCTION OF THIS PROJECT WILL BE UNDER MY OBSERVATION.  
Signature: *Rugo S. Miyakawa*  
April 30, 2024  
EXPIRATION DATE OF THE LICENSE

07/15/22	5	Revised Section and Legend
DATE	REVISION	
STATE OF HAWAII DEPARTMENT OF TRANSPORTATION HIGHWAYS DIVISION		
<b>Retaining Wall Pay Limit</b>		
FARRINGTON HIGHWAY WIDENING Kapolei Golf Course Road to Fort Weaver Road Project No. 7101A-01-20		
Scale: As Shown	Date: Apr. 2022	
SHEET No. SD21 OF 6 SHEETS		


FED. ROAD DIST. NO.	STATE	PROJ. NO.	FISCAL YEAR	SHEET NO.	TOTAL SHEETS
HAWAII	HAW.	7101A-01-20	2021	ADD. 537	

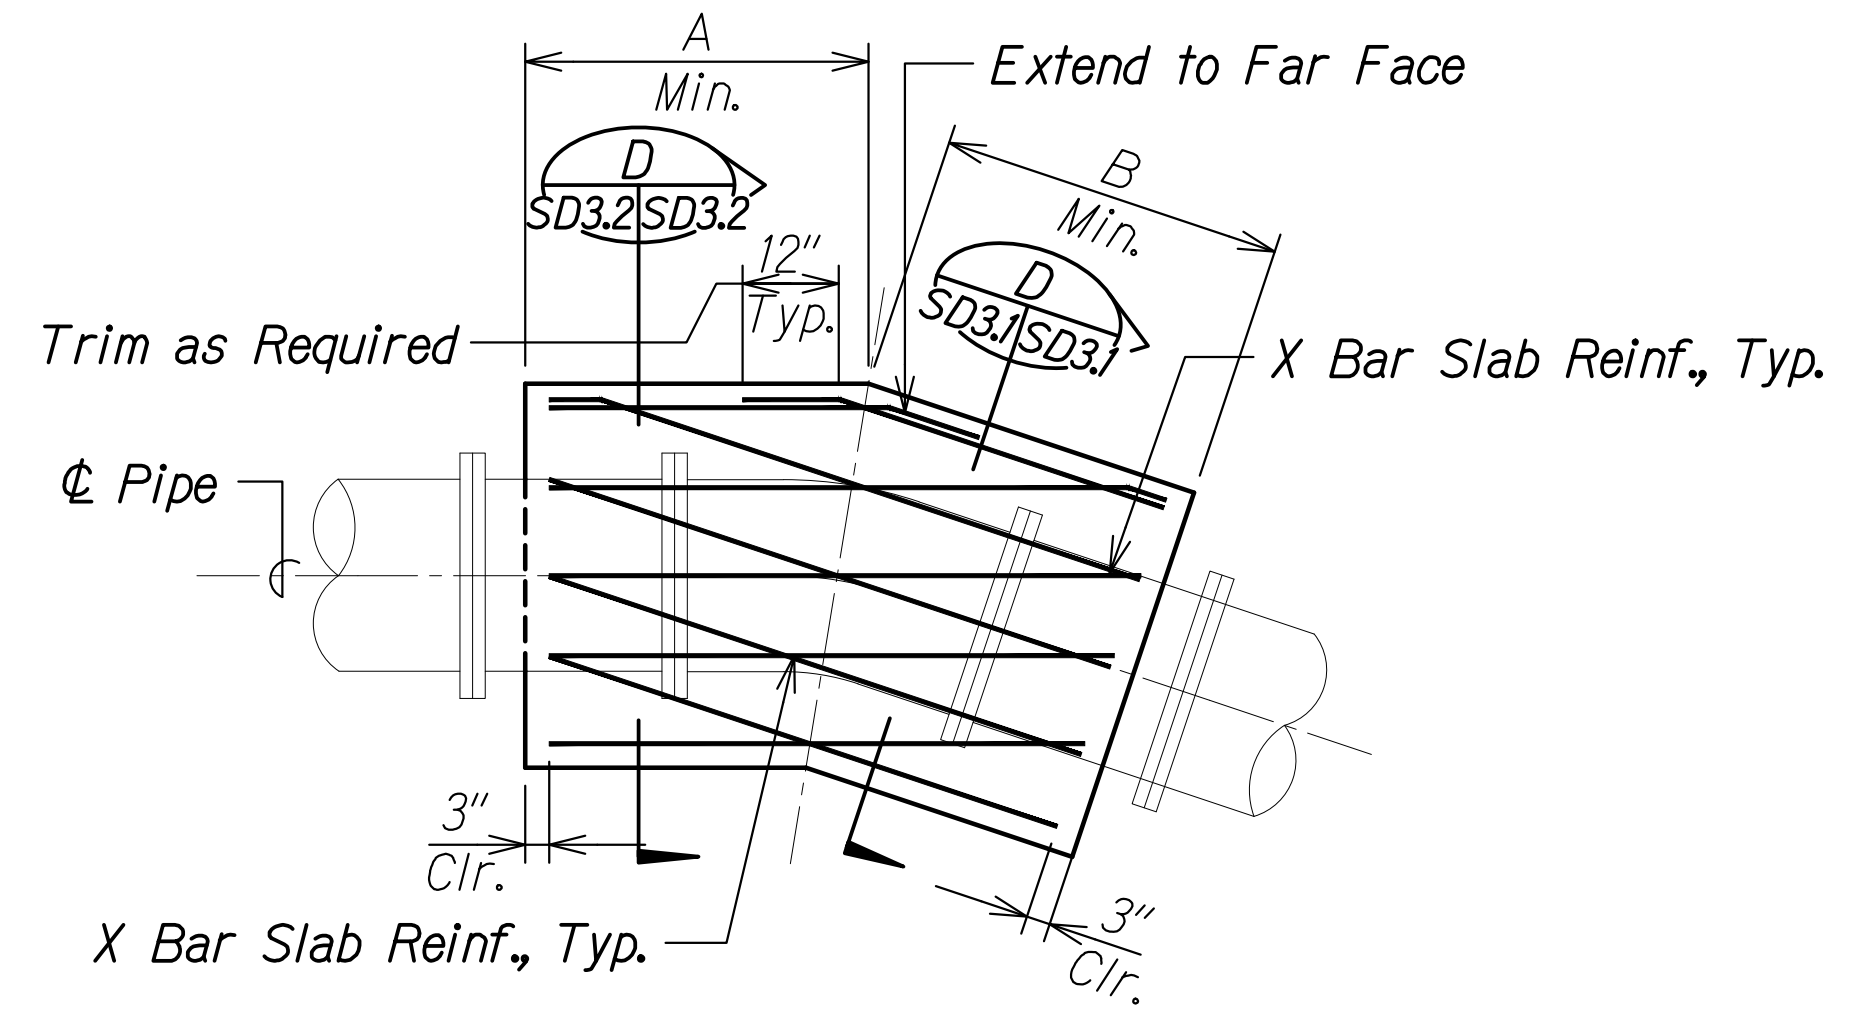


**TOP AND BOTTOM SLAB REINF.** A  
 Scale: 1/2" = 1'-0" SD3.2 | SD3.2

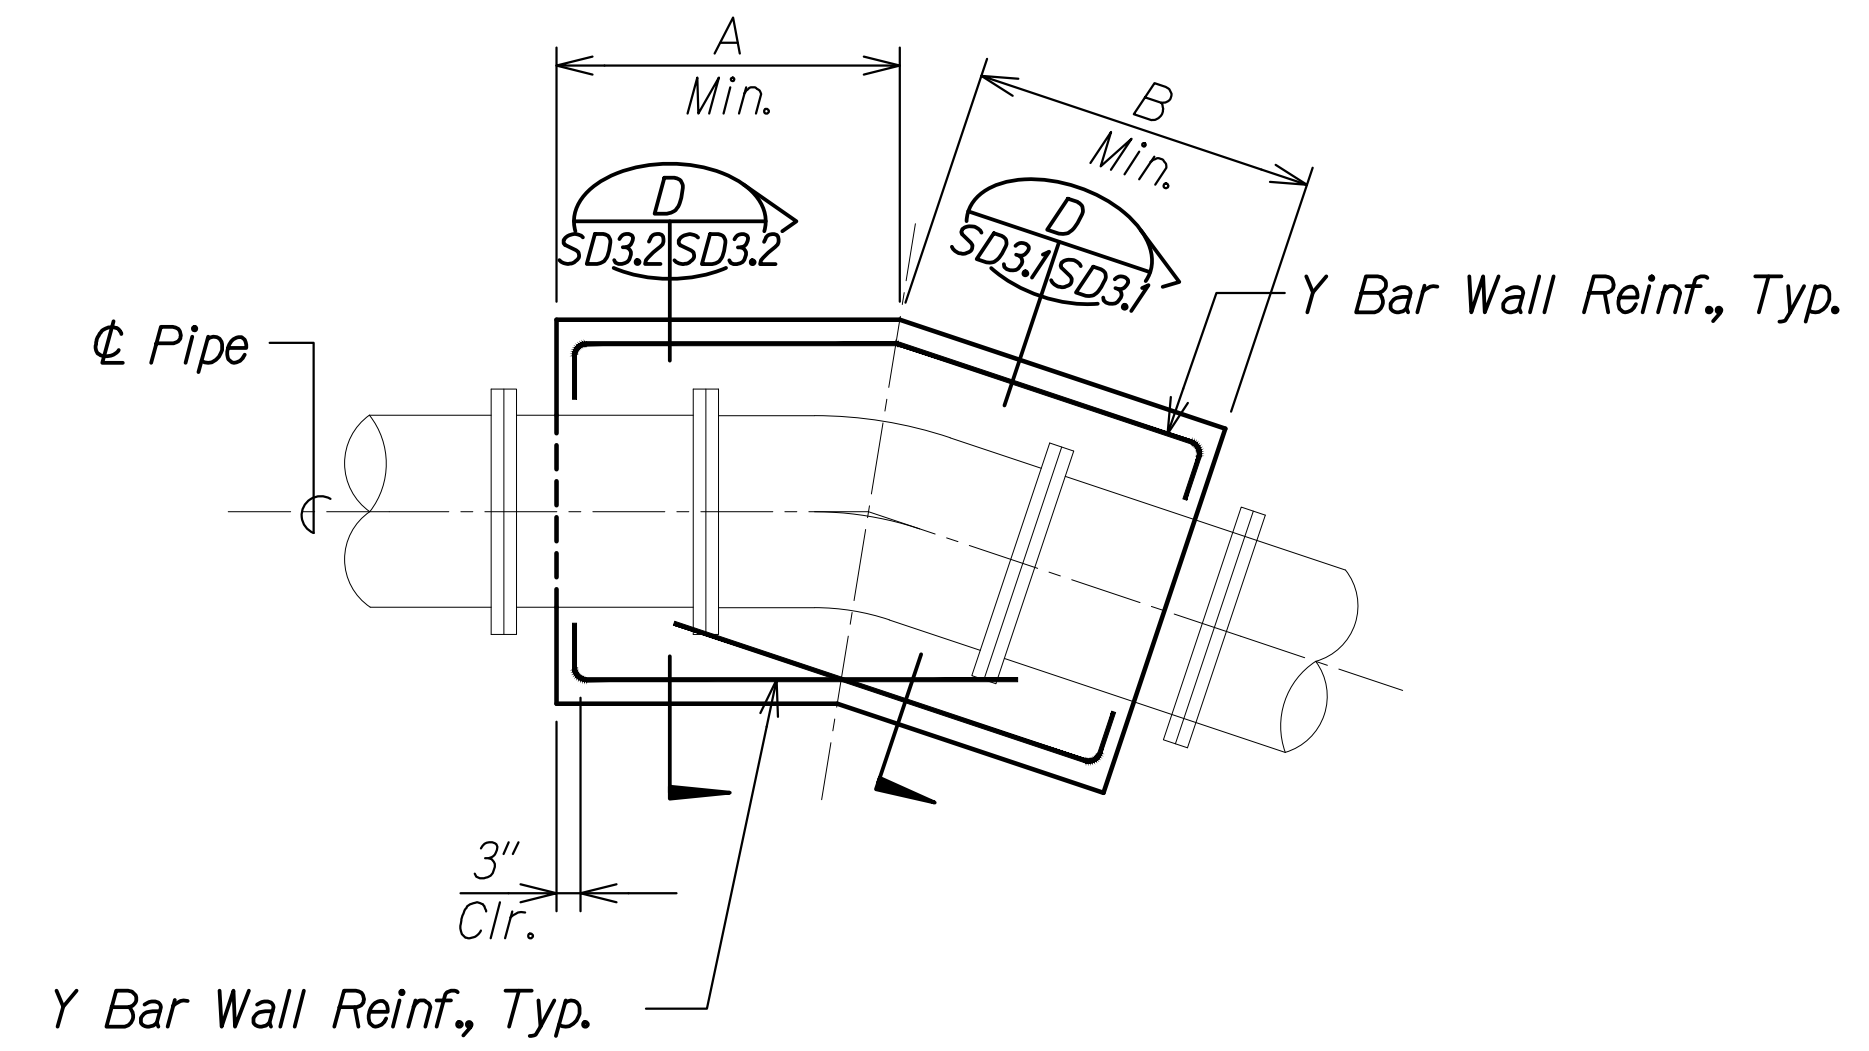

**WALL REINFORCING** B  
 Scale: 1/2" = 1'-0" SD3.2 | SD3.2

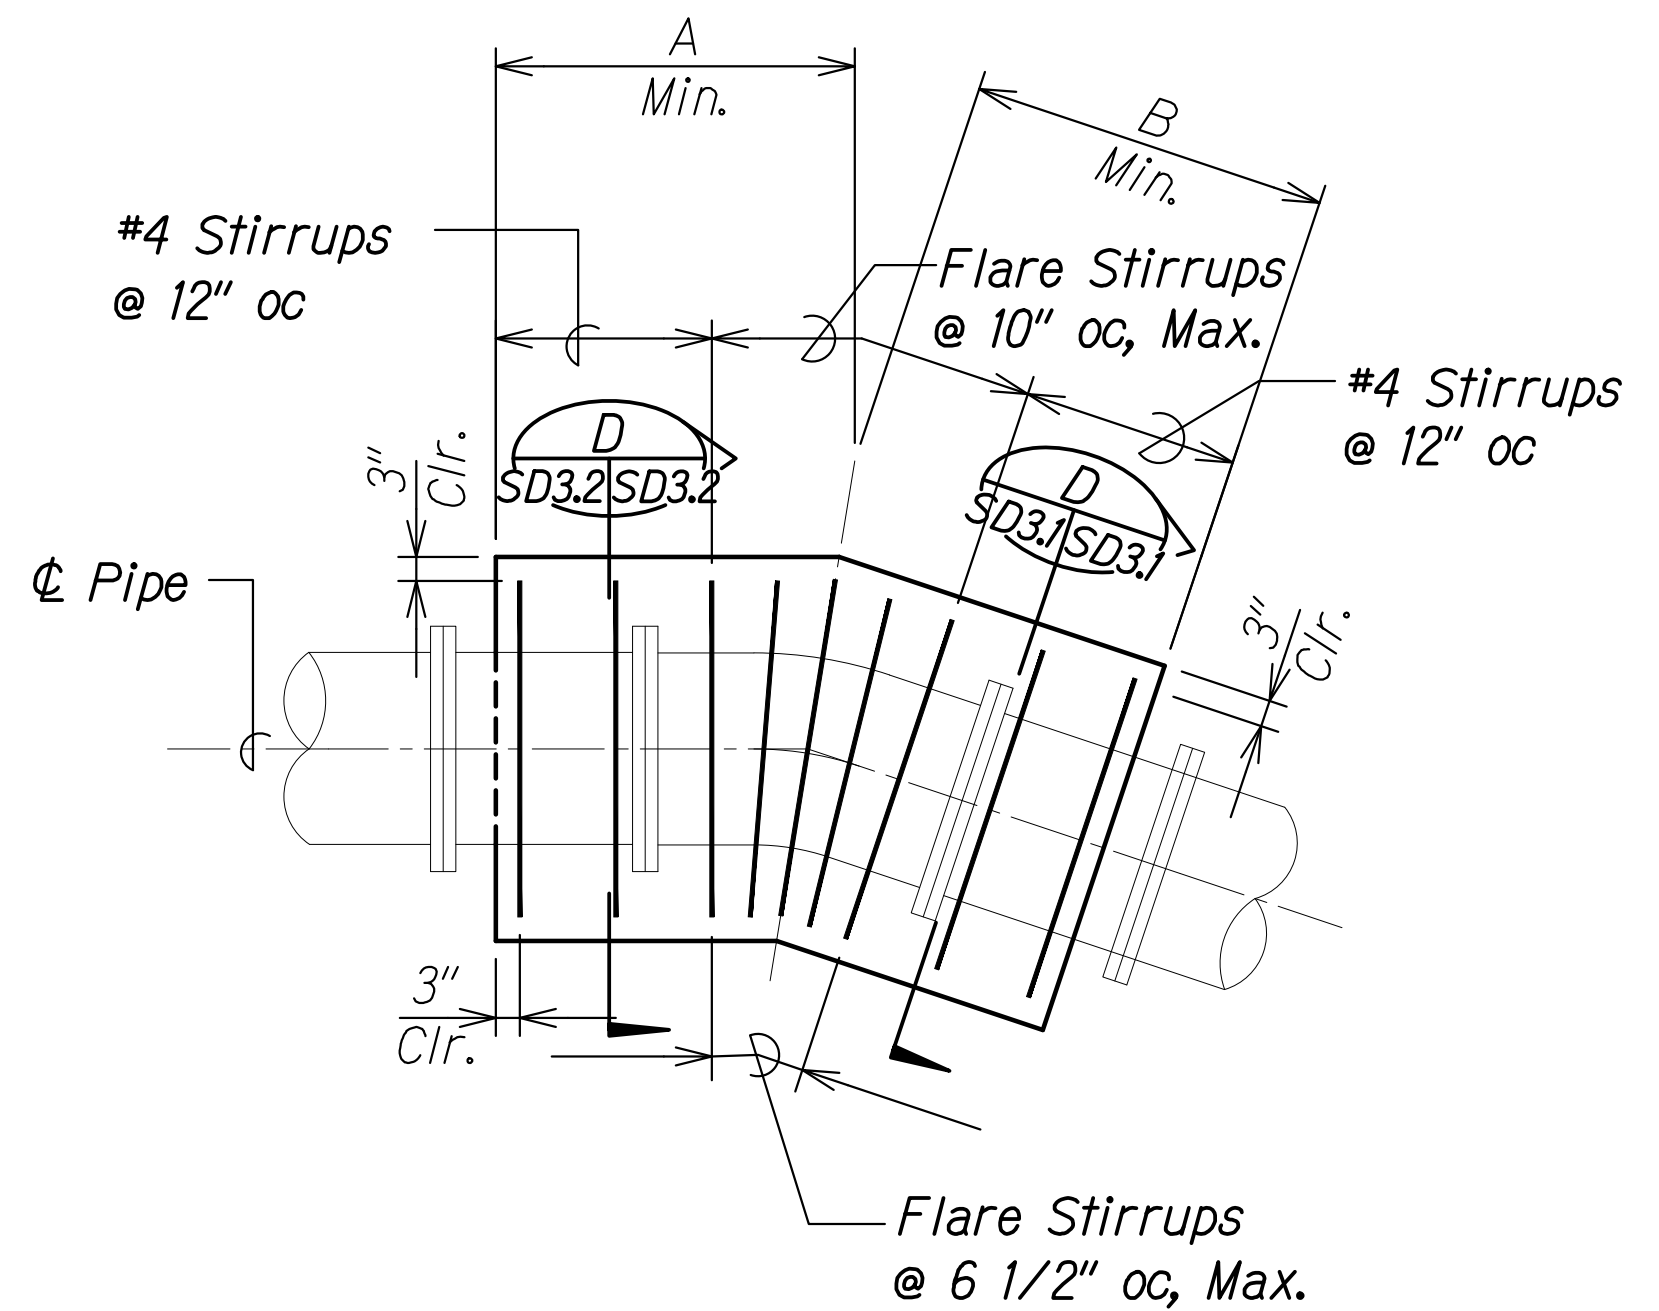

**STIRRUP REINFORCING** C  
 Scale: 1/2" = 1'-0" SD3.2 | SD3.2

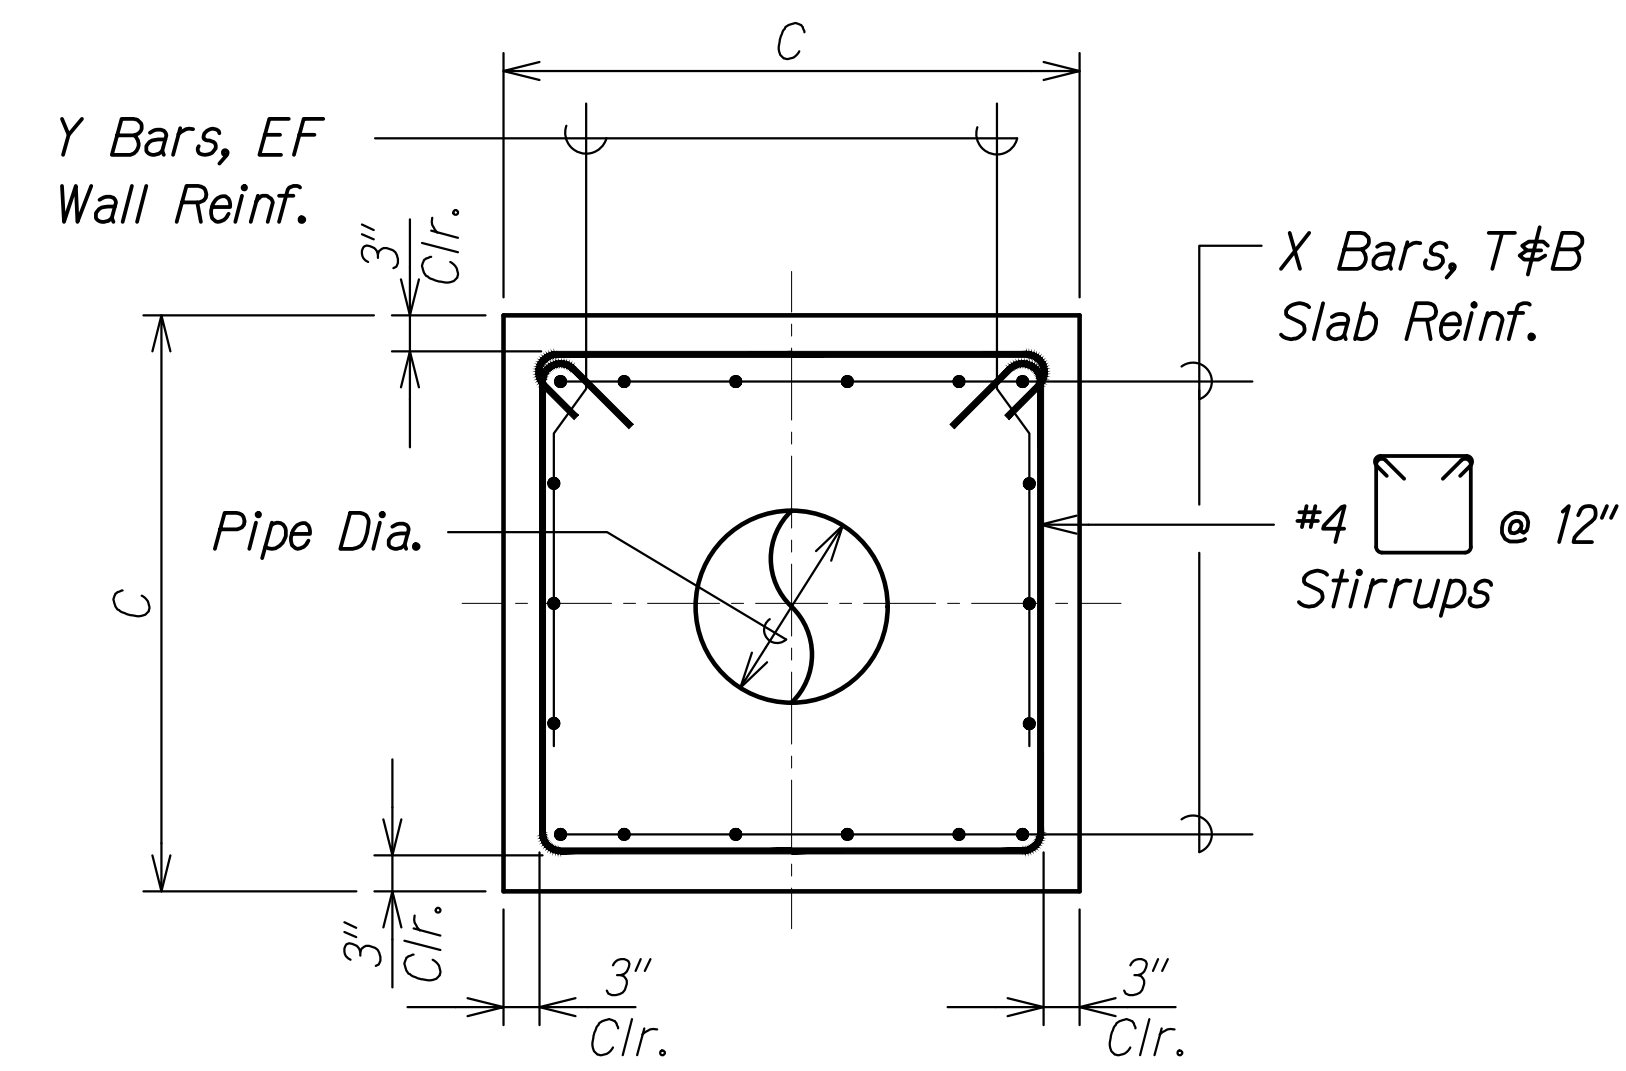

**TYPICAL HORIZONTAL PIPE JACKET SECTION** D  
 Scale: 3/4" = 1'-0" SD3.2 | SD3.2

**Notes:**

1. Concrete shall develop a minimum 28-Day compressive strength of 4,000 psi, unless shown otherwise.
2. See Sheet S0.7 for reinforcement notes.
3. Pipe test pressure = 200 psi
4. Any soft soil encountered during excavation shall be removed to firm soil and replaced with compacted fill.
5. Concrete jackets shall attain full design strength prior to any pressure testing on pipes.
6. 1/4 maximum horizontal bends.
7. Allowable lateral bearing pressure = 3.0 ksf.
8. Location of face of jacket shall be flush with the bell for slip joints and set back from the joint for mechanical joints in accordance with the City and County of Honolulu Board of Water Supply's "Water System Standards, 2002".

APPROVED: \_\_\_\_\_ DATE \_\_\_\_\_  
 Manager and Chief Engineer, BWS  
 (for work affecting BWS facilities in City/State R/W & BWS easements only)



THIS WORK WAS PREPARED BY ME OR UNDER MY SUPERVISION AND CONSTRUCTION OF THIS PROJECT WILL BE UNDER MY OBSERVATION.  
 Signature: *Russ S. Miyahara* April 30, 2024  
 EXPIRATION DATE OF THE LICENSE

**SCHEDULE**

PIPE DIAMETER	DIMENSIONS			REINFORCING		REMARKS
	A	B	C	X BAR	Y BAR	
16"	3'-0"	3'-0"	3'-2"	#6 @ 12"	#6 @ 12"	
20"	4'-3"	4'-3"	3'-6"	#6 @ 12"	#6 @ 10"	
30"	7'-5"	7'-5"	4'-6"	#6 @ 12"	#6 @ 6"	
36"	9'-8"	9'-8"	5'-0"	#7 @ 12"	#7 @ 6"	
42"	11'-11"	11'-11"	5'-6"	#7 @ 12"	#7 @ 4"	

DATE	REVISION
07/15/22	5 Revised notes
06/08/22	2 Revised notes and signature block

STATE OF HAWAII  
 DEPARTMENT OF TRANSPORTATION  
 HIGHWAYS DIVISION

**Horizontal Bend Pipe Jackets**

FARRINGTON HIGHWAY WIDENING  
 Kapolei Golf Course Road to Fort Weaver Road  
 Project No. 7101A-01-20

Scale: As Shown Date: Apr. 2022

ORIGINAL PLAN	DATE
SURVEY PLOTTED BY	
DRAWN BY	
DESIGNED BY	
QUANTITIES BY	
CHECKED BY	
No.	


DRAWING NAME: Z:\00\_ONGOING\20-013-FARR-HW-KAPOLEI GC ID: ET-WR-EMTC\01 CAD\07-15-22 ADD1 DELIAS\HW3-SD3.2 HORIZ JACKETS DET - ADD.1 DELIA 5.0WG PLOT TIME: 07-15-22 6:00 PM








FED. ROAD DIST. NO.	STATE	PROJ. NO.	FISCAL YEAR	SHEET NO.	TOTAL SHEETS
HAWAII	HAW.	7101A-01-20	2021	ADD. 539 S-1	

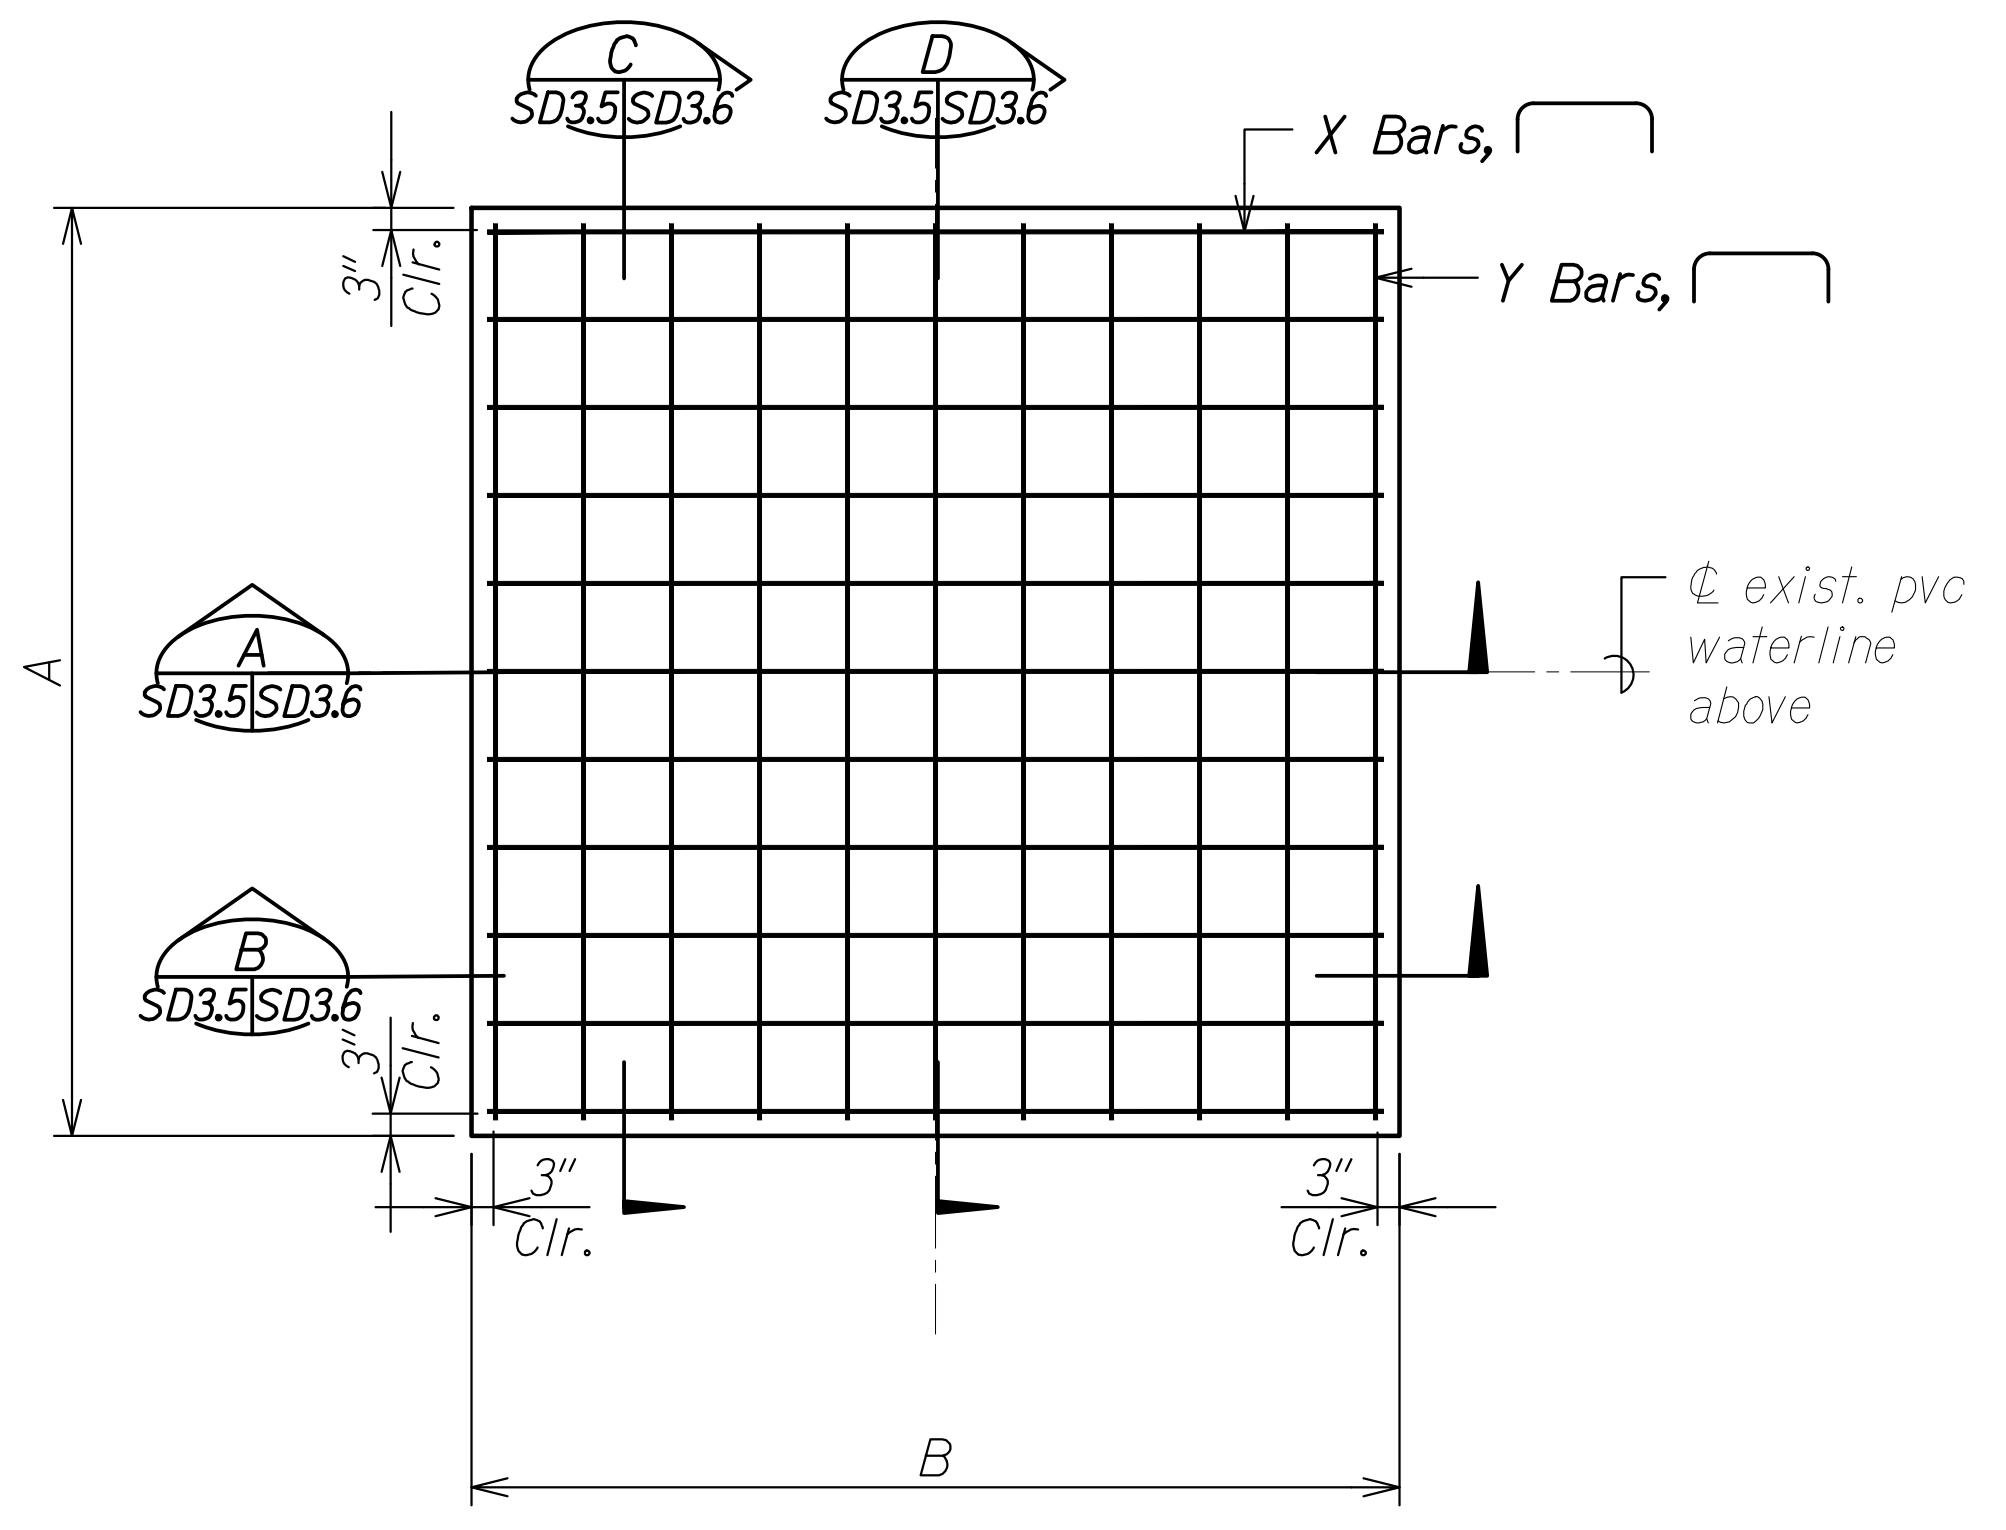

**LINE STOP CONCRETE SUPPORT BLOCK- PLAN**  
 Scale: 1/2" = 1'-0"  
 SD3.6 | SD3.5

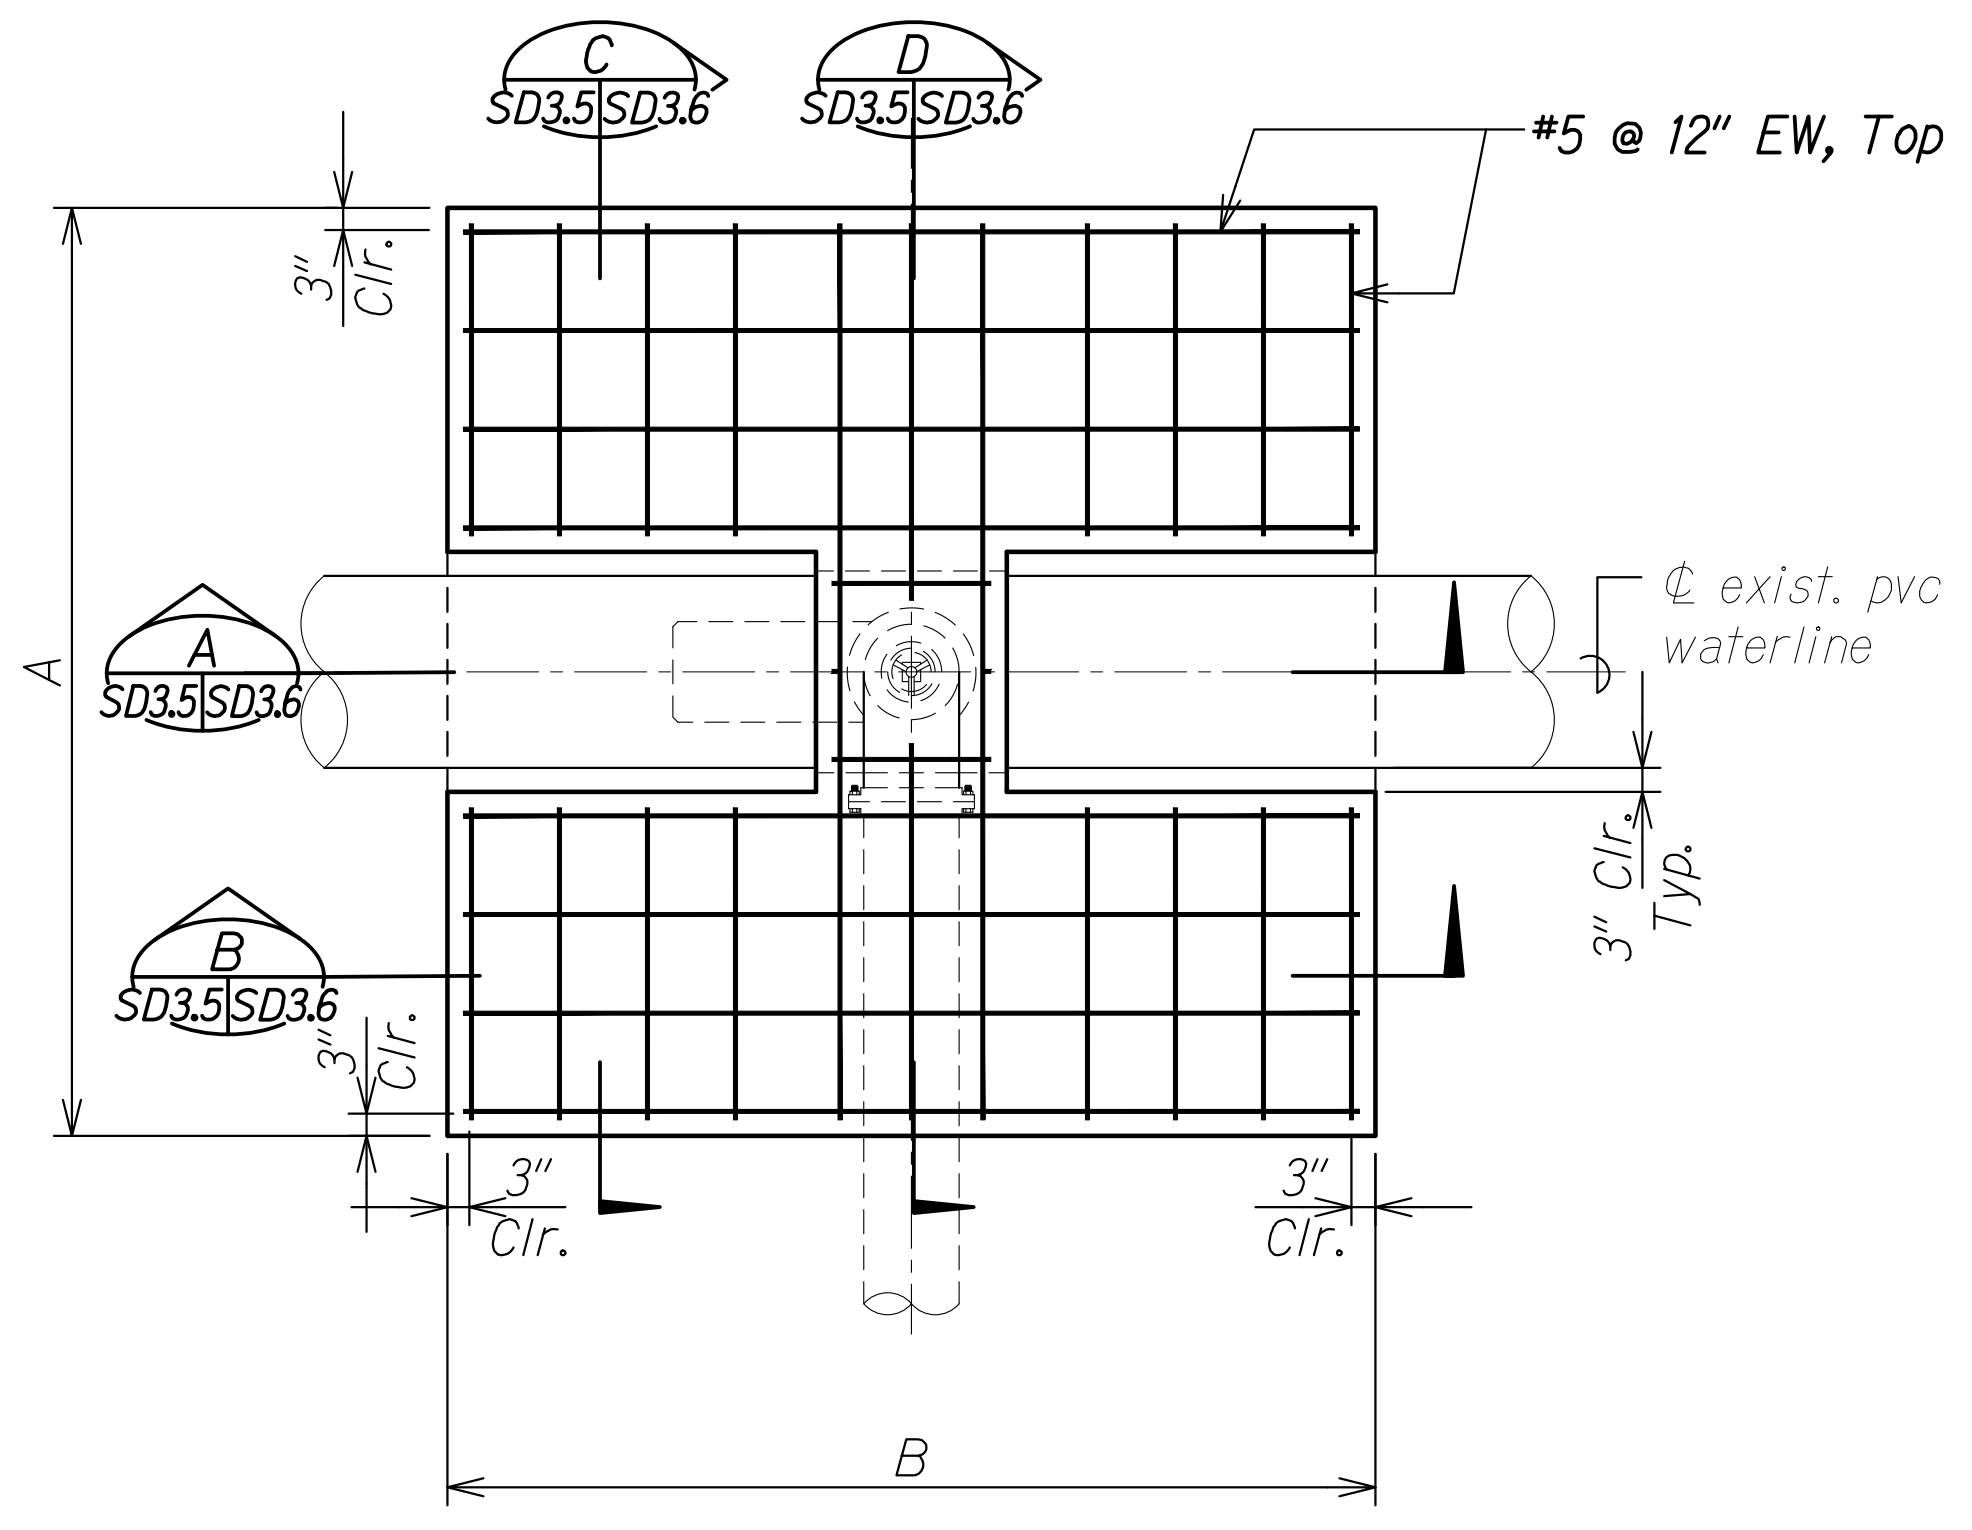


**LINE STOP CONCRETE SUPPORT BLOCK- PLAN**  
 Scale: 1/2" = 1'-0"  
 SD3.6 | SD3.5

- Notes:**
- Concrete shall develop a minimum 28-Day compressive strength of 4,000 psi, unless shown otherwise.
  - See Sheet S0.7 for reinforcement notes.
  - See Sheet SD3.3 for dimensions A, B, and C, and reinforcing X Bar and Y Bar.

APPROVED:  
 \_\_\_\_\_ DATE  
 Manager and Chief Engineer, BWS  
 (for work affecting BWS facilities in  
 City/State R/W & BWS easements only)


SURVEY PLOTTED BY	DATE
DRAWN BY	
DESIGNED BY	
QUANTITIES BY	
CHECKED BY	
No.	

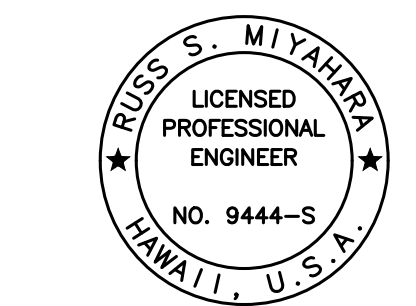


THIS WORK WAS PREPARED BY ME OR UNDER MY SUPERVISION AND CONSTRUCTION OF THIS PROJECT WILL BE UNDER MY OBSERVATION.  
 Signature: *Rugo S. Miyahara*  
 April 30, 2024  
 EXPIRATION DATE OF THE LICENSE

07/15/22	5	Added sheet
REVISION		
STATE OF HAWAII DEPARTMENT OF TRANSPORTATION HIGHWAYS DIVISION <b>Concrete Support Block Plans at PVC Pipe</b> FARRINGTON HIGHWAY WIDENING Kapolei Golf Course Road to Fort Weaver Road Project No. 7101A-01-20		
Scale: As Shown	Date: Apr. 2022	
SHEET No. SD3.5 OF 4 SHEETS		

FED. ROAD DIST. NO.	STATE	PROJ. NO.	FISCAL YEAR	SHEET NO.	TOTAL SHEETS
HAWAII	HAW.	7101A-01-20	2021	ADD. 539 S-2	

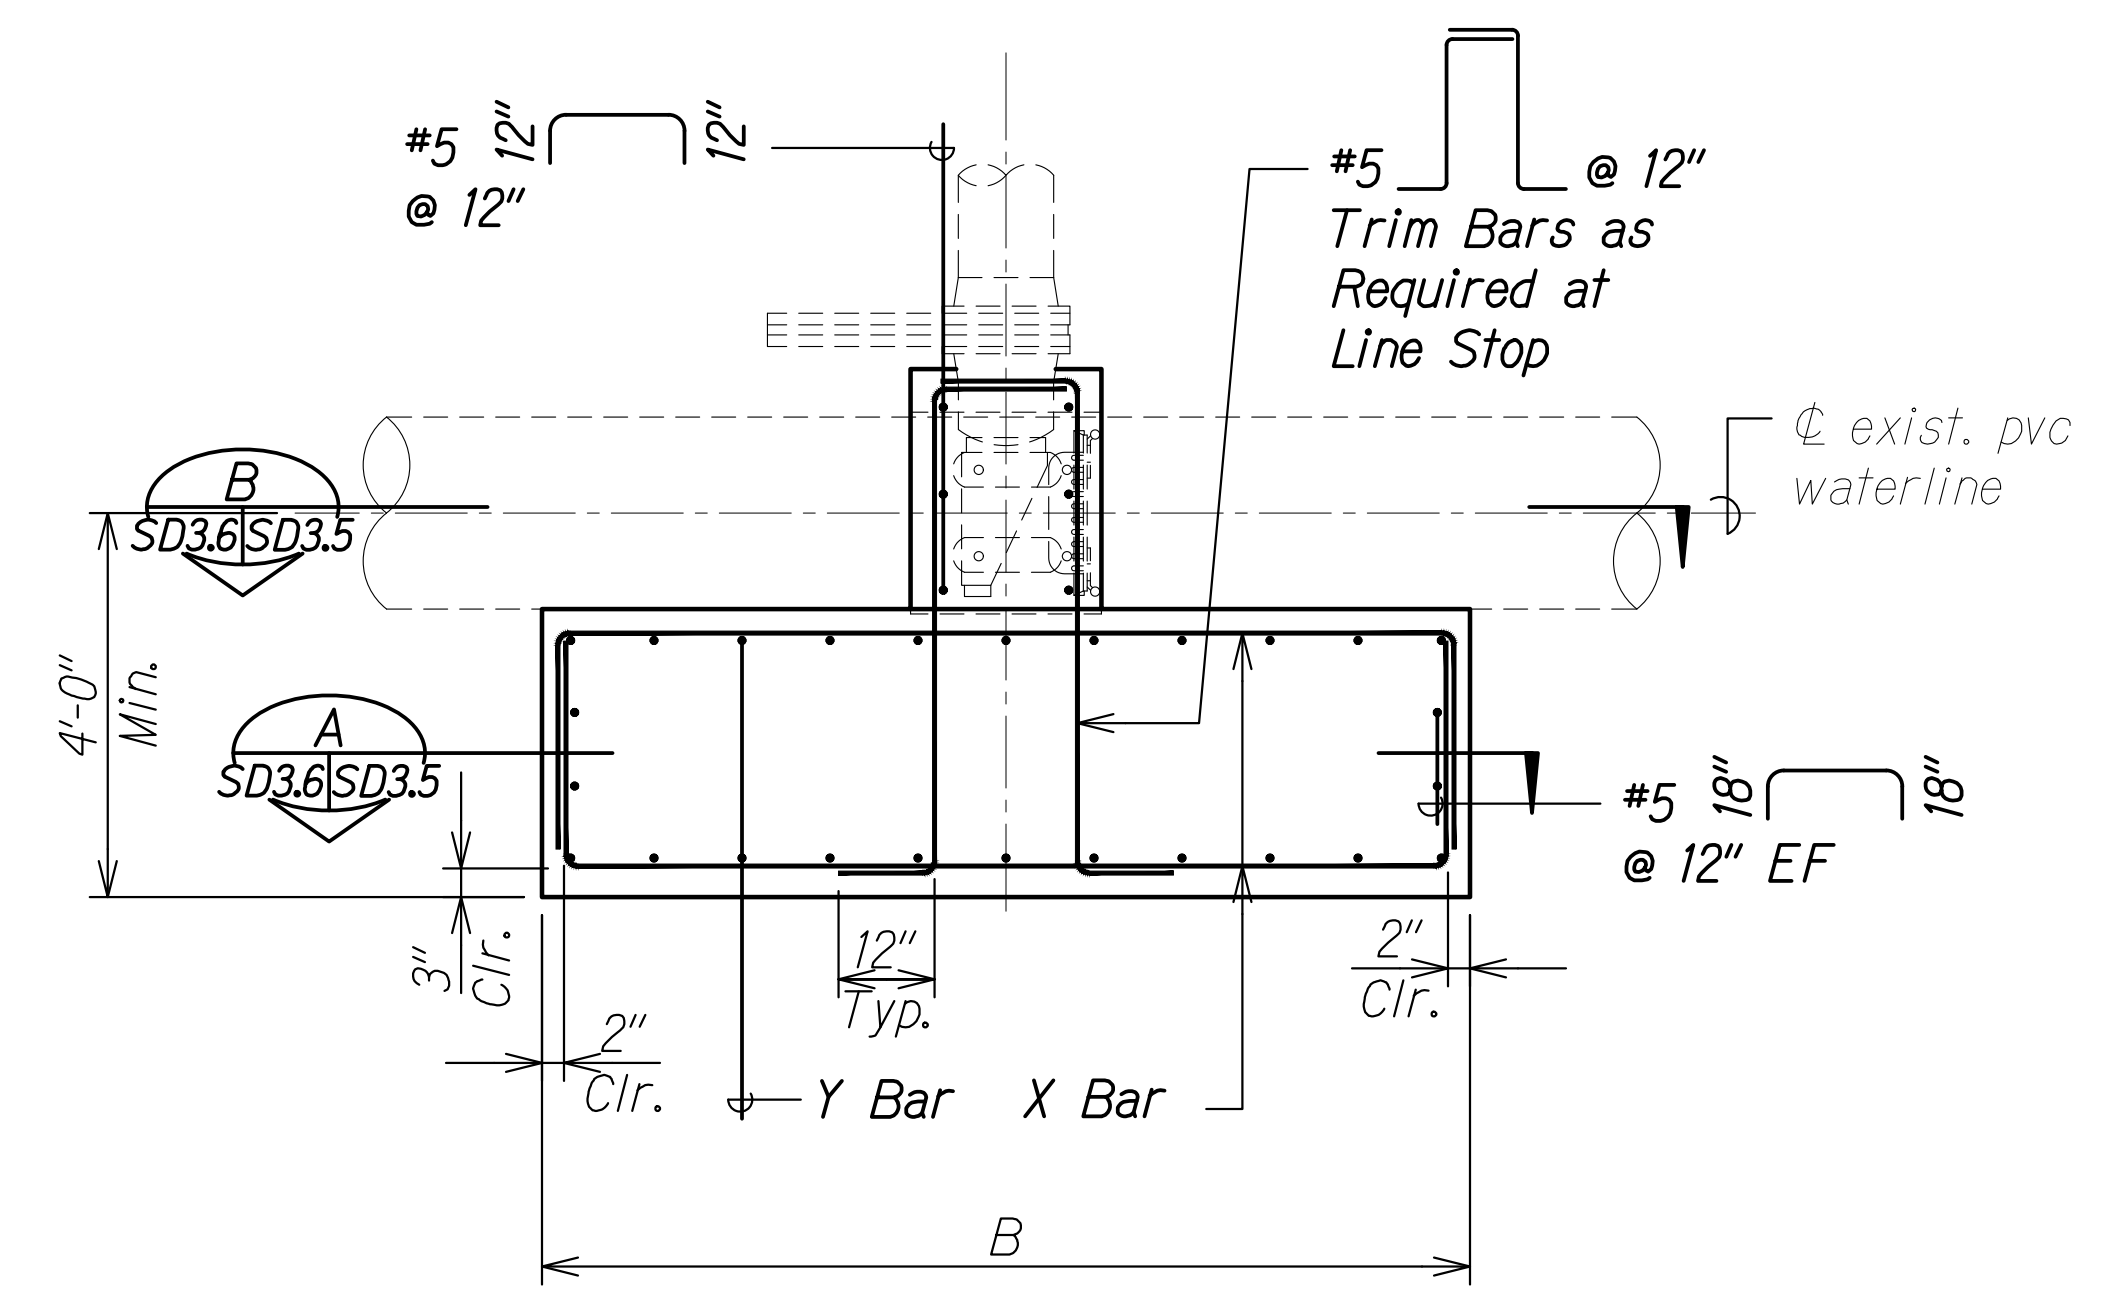


**LINE STOP CONCRETE SUPPORT BLOCK- SECTION A**  
 Scale: 1/2" = 1'-0"  
 SD3.5 | SD3.6

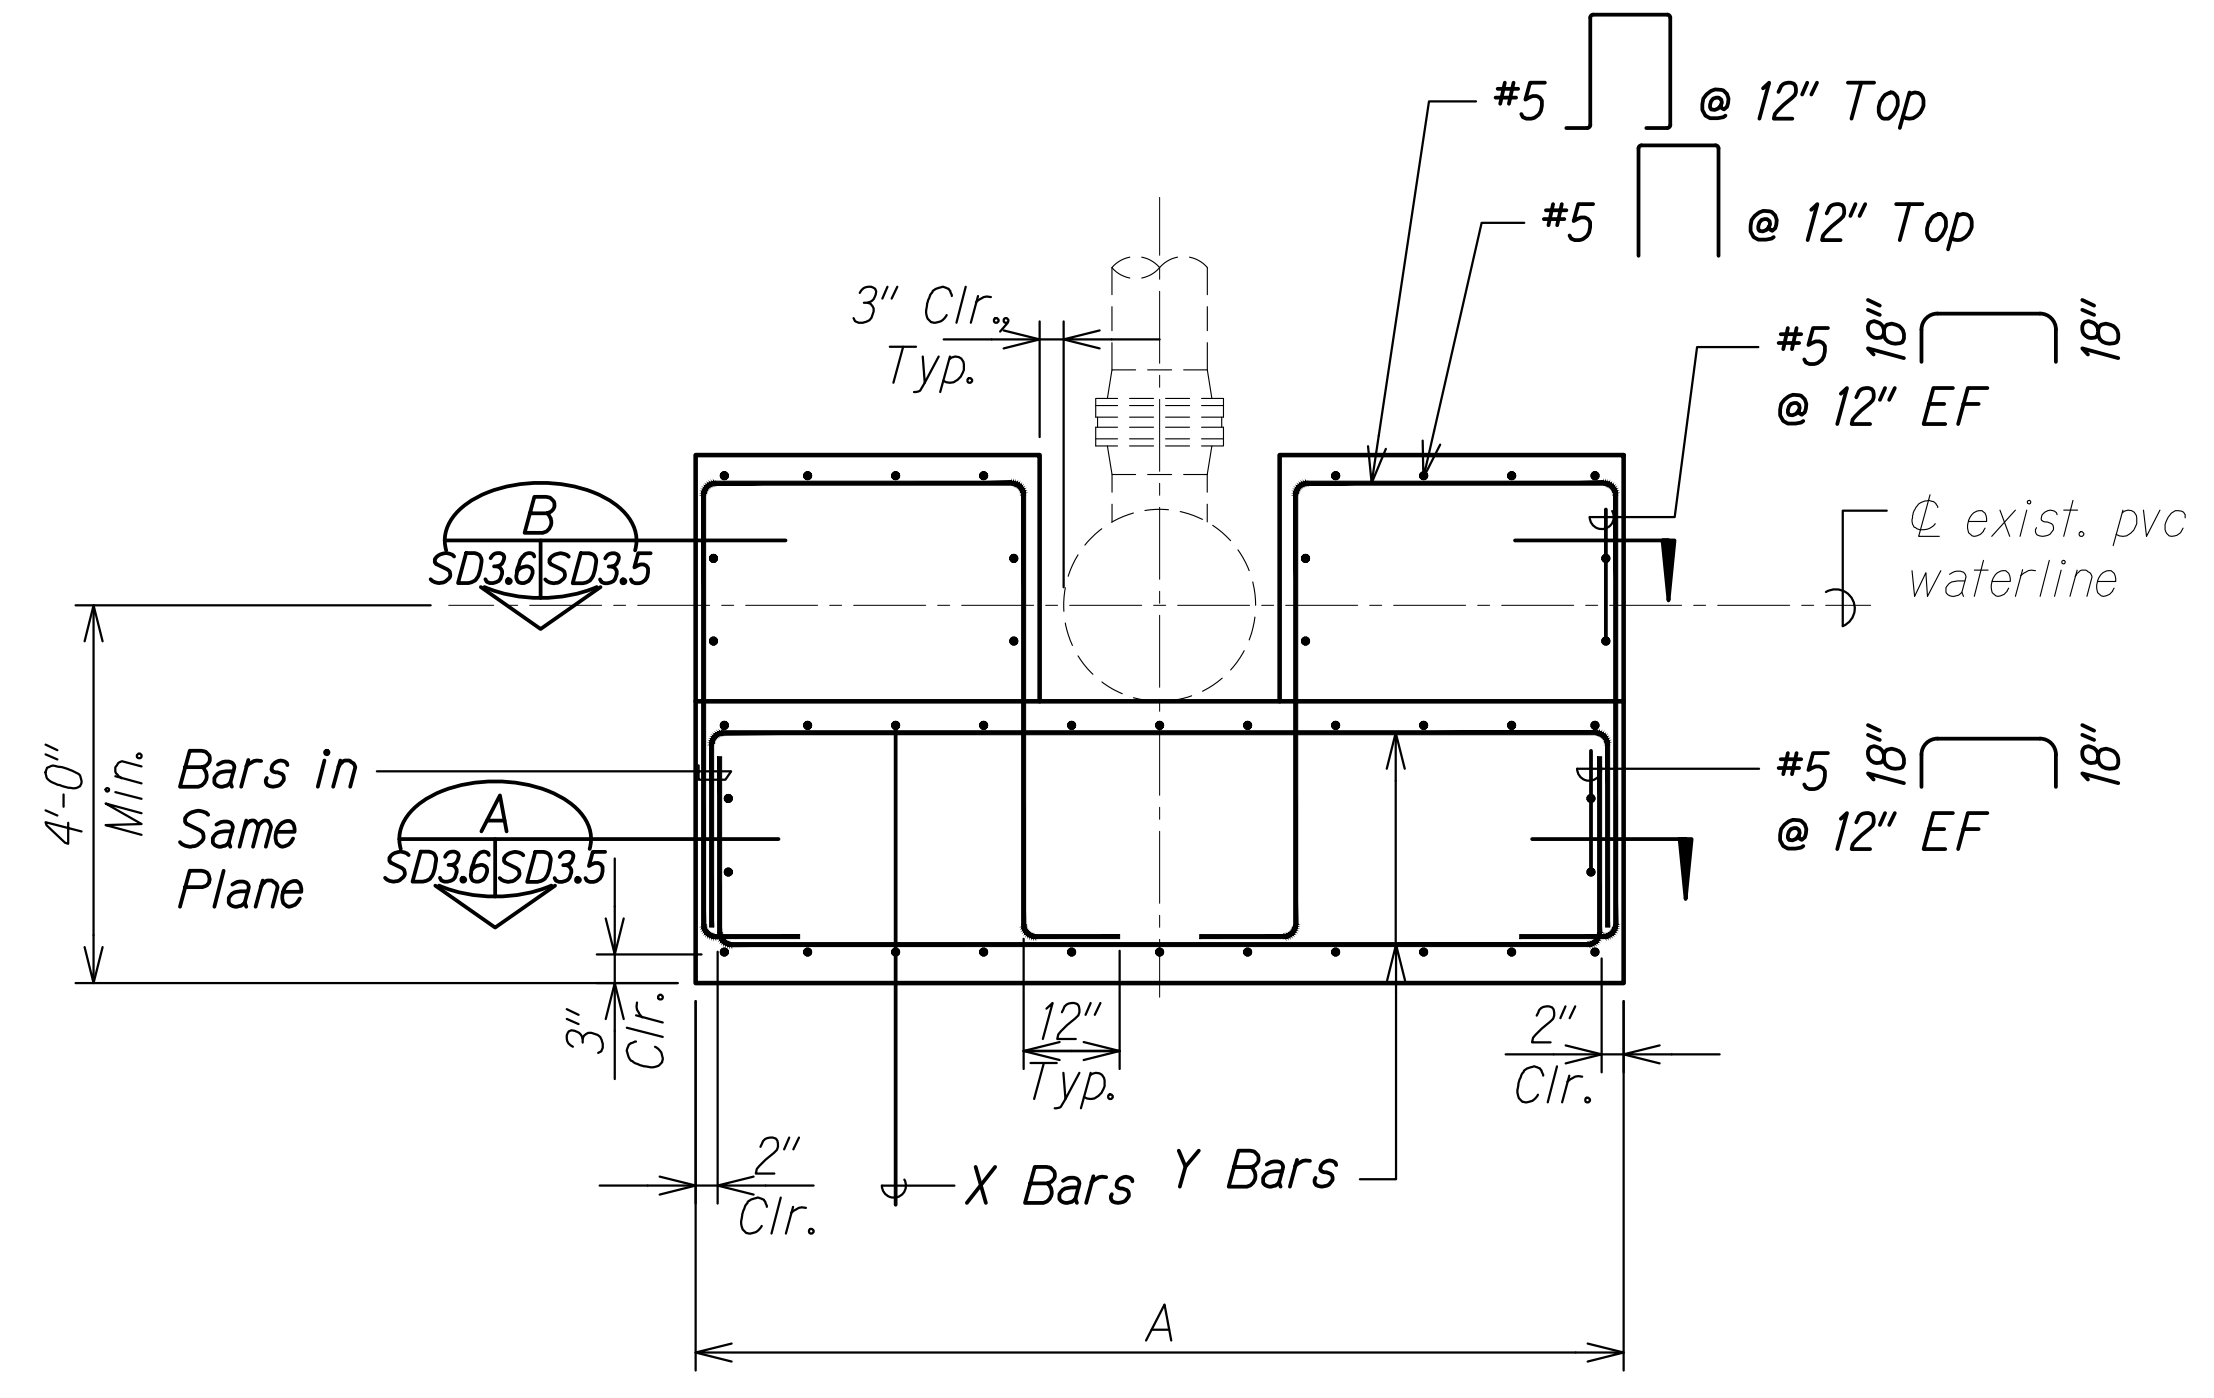


**LINE STOP CONCRETE SUPPORT BLOCK- SECTION C**  
 Scale: 1/2" = 1'-0"  
 SD3.5 | SD3.6

- Notes:**
- Concrete shall develop a minimum 28-Day compressive strength of 4,000 psi, unless shown otherwise.
  - See Sheet S0.7 for reinforcement notes.
  - See Sheet SD3.3 for dimensions A, B, and C, and reinforcing X Bar and Y Bar.

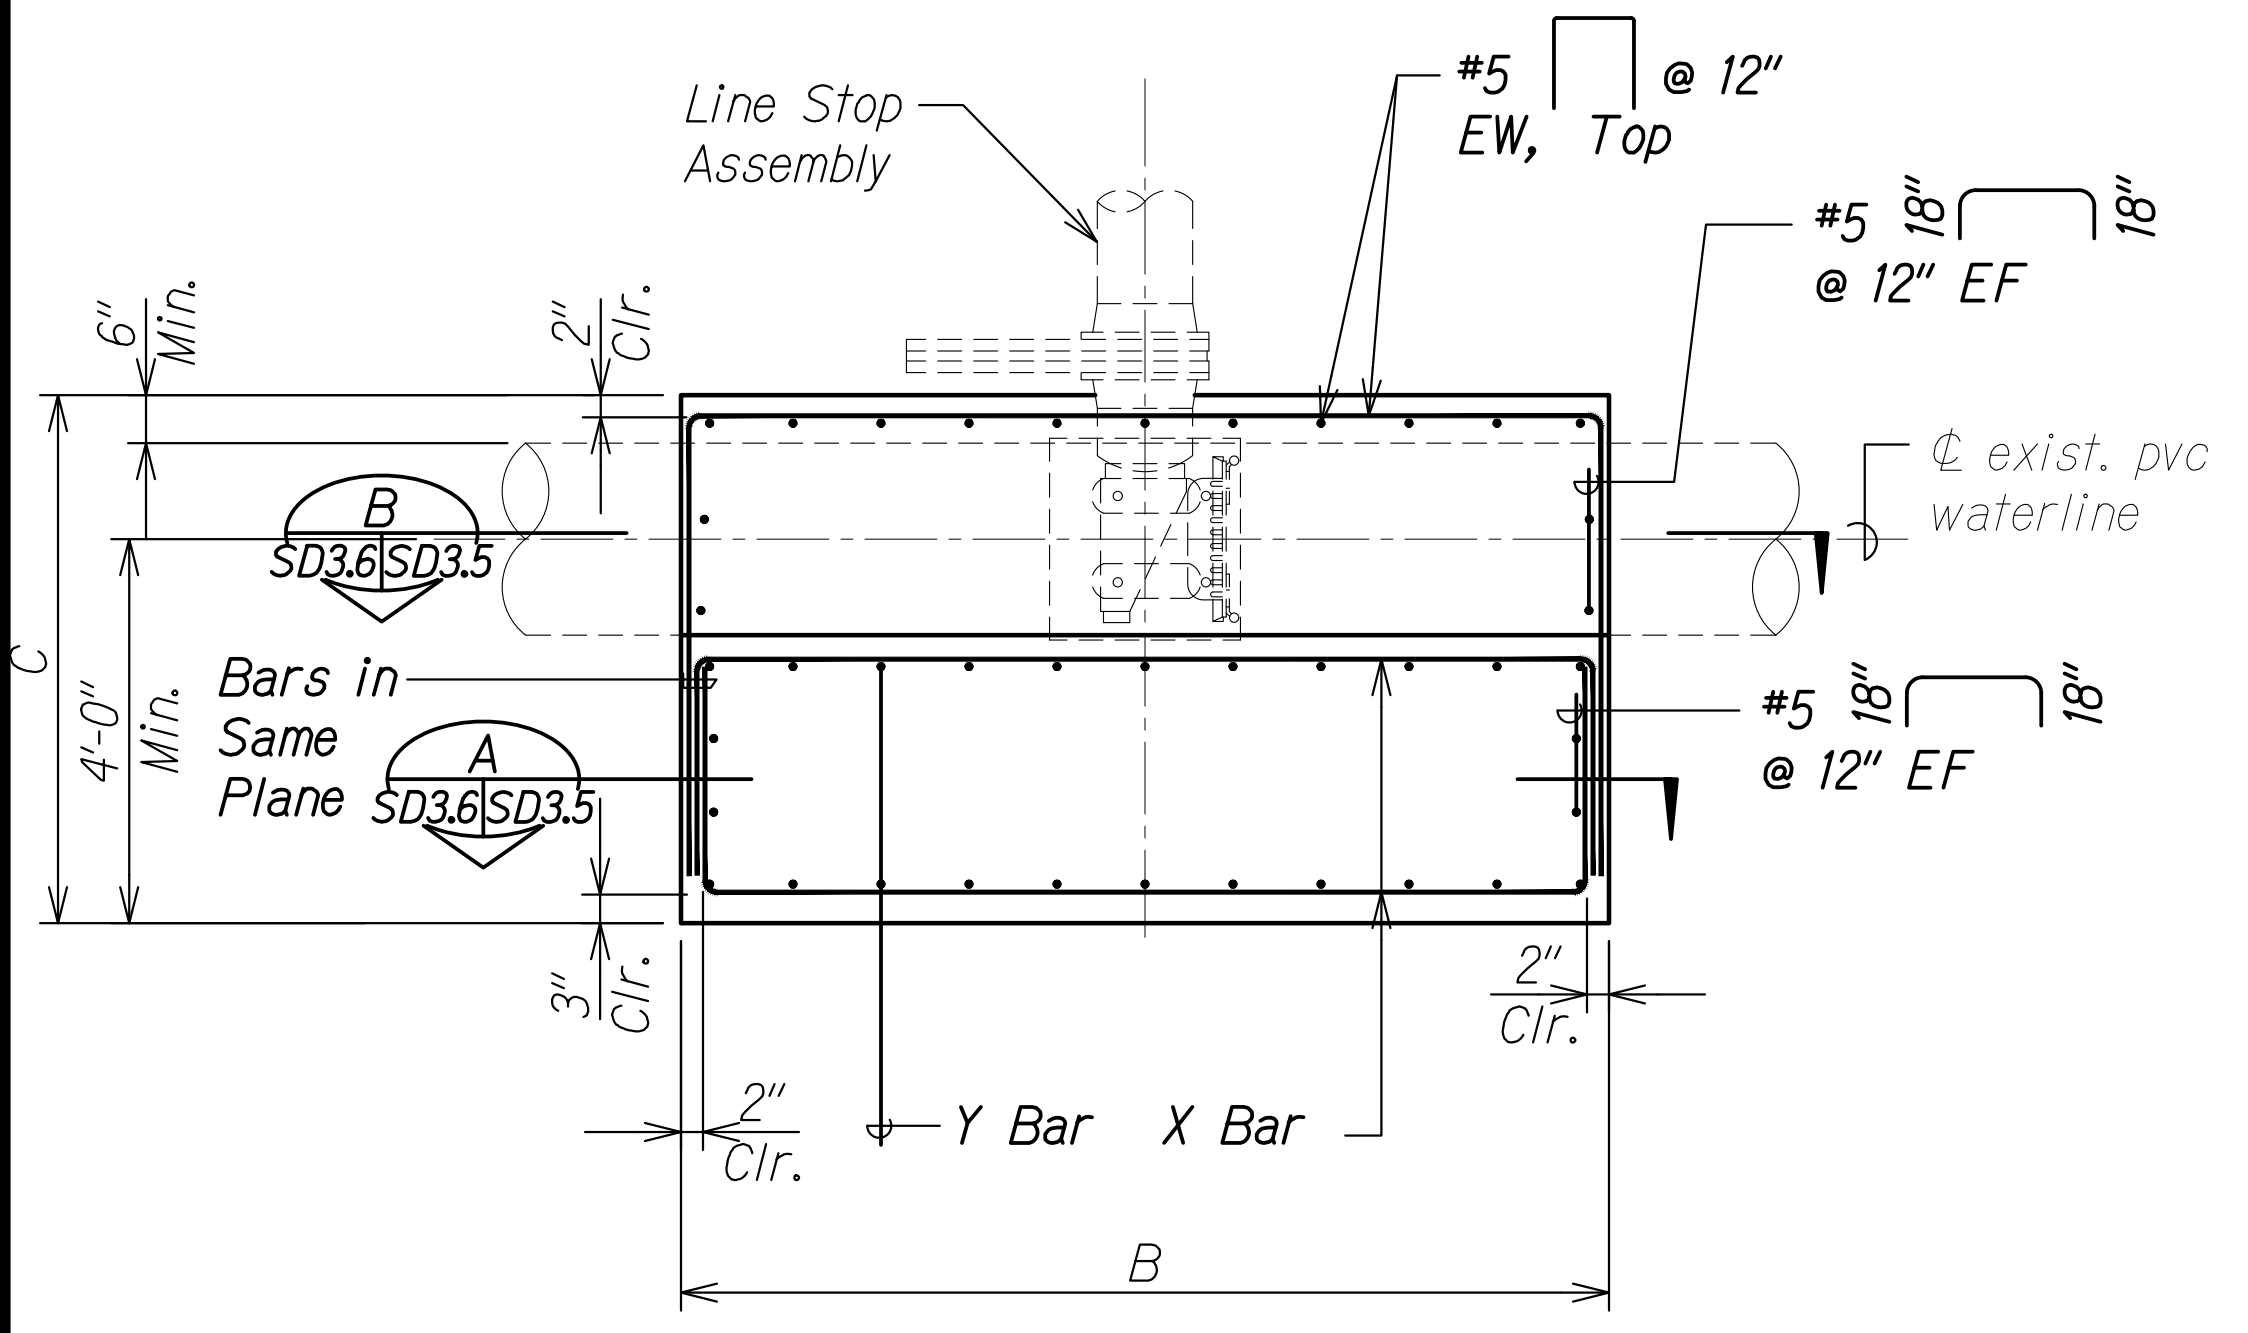


**LINE STOP CONCRETE SUPPORT BLOCK- SECTION B**  
 Scale: 1/2" = 1'-0"  
 SD3.5 | SD3.6

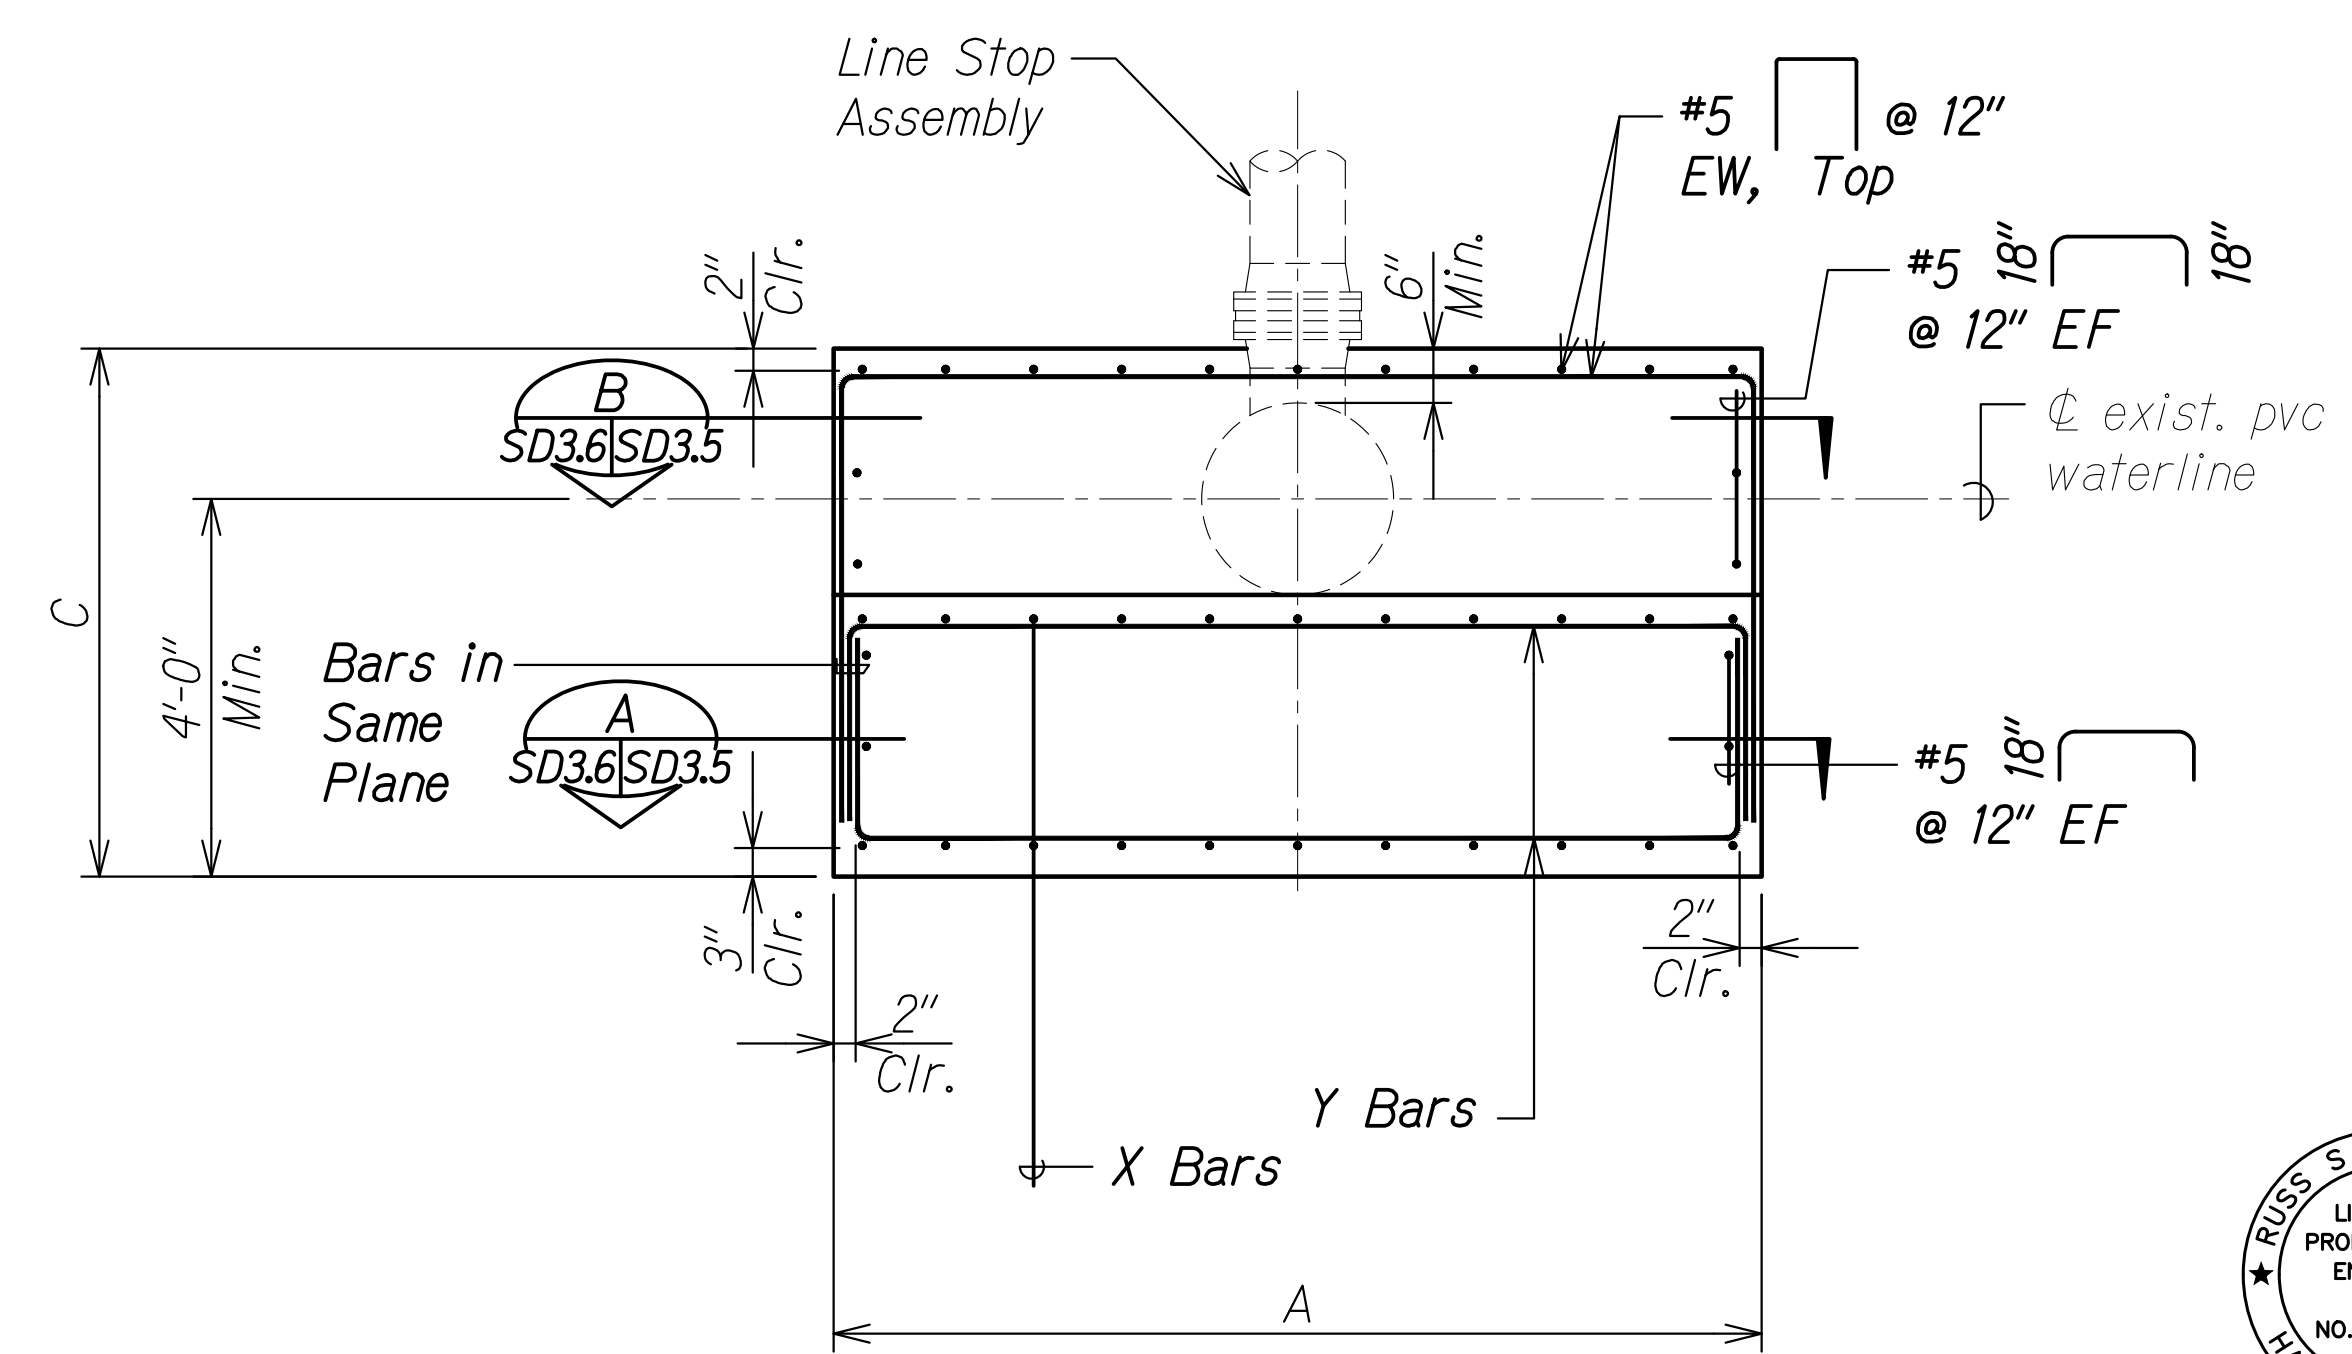

**LINE STOP CONCRETE SUPPORT BLOCK- SECTION D**  
 Scale: 1/2" = 1'-0"  
 SD3.5 | SD3.6

APPROVED:  
 Manager and Chief Engineer, BWS \_\_\_\_\_ DATE \_\_\_\_\_  
 (for work affecting BWS facilities in City/State R/W & BWS easements only)


SURVEY PLOTTED BY	DATE
DRAWN BY	
DESIGNED BY	
QUANTITIES BY	
CHECKED BY	
NO.	

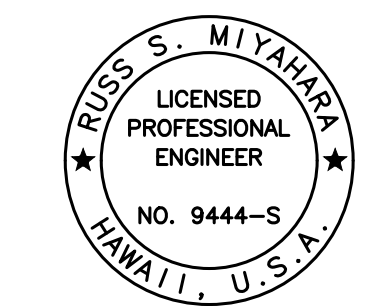


THIS WORK WAS PREPARED BY ME OR UNDER MY SUPERVISION AND CONSTRUCTION OF THIS PROJECT WILL BE UNDER MY OBSERVATION.  
 Signature: \_\_\_\_\_  
 April 30, 2024  
 EXPIRATION DATE OF THE LICENSE

07/15/22	5	Added sheet
DATE		REVISION
STATE OF HAWAII DEPARTMENT OF TRANSPORTATION HIGHWAYS DIVISION <b>Concrete Support Block Sections at PVC Pipe</b> FARRINGTON HIGHWAY WIDENING Kapolei Golf Course Road to Fort Weaver Road Project No. 7101A-01-20		
Scale: As Shown		Date: Apr. 2022
SHEET No. SD3.6 OF 4 SHEETS		


FED. ROAD DIST. NO.	STATE	PROJ. NO.	FISCAL YEAR	SHEET NO.	TOTAL SHEETS
HAWAII	HAW.	7101A-01-20	2021	ADD. 541	

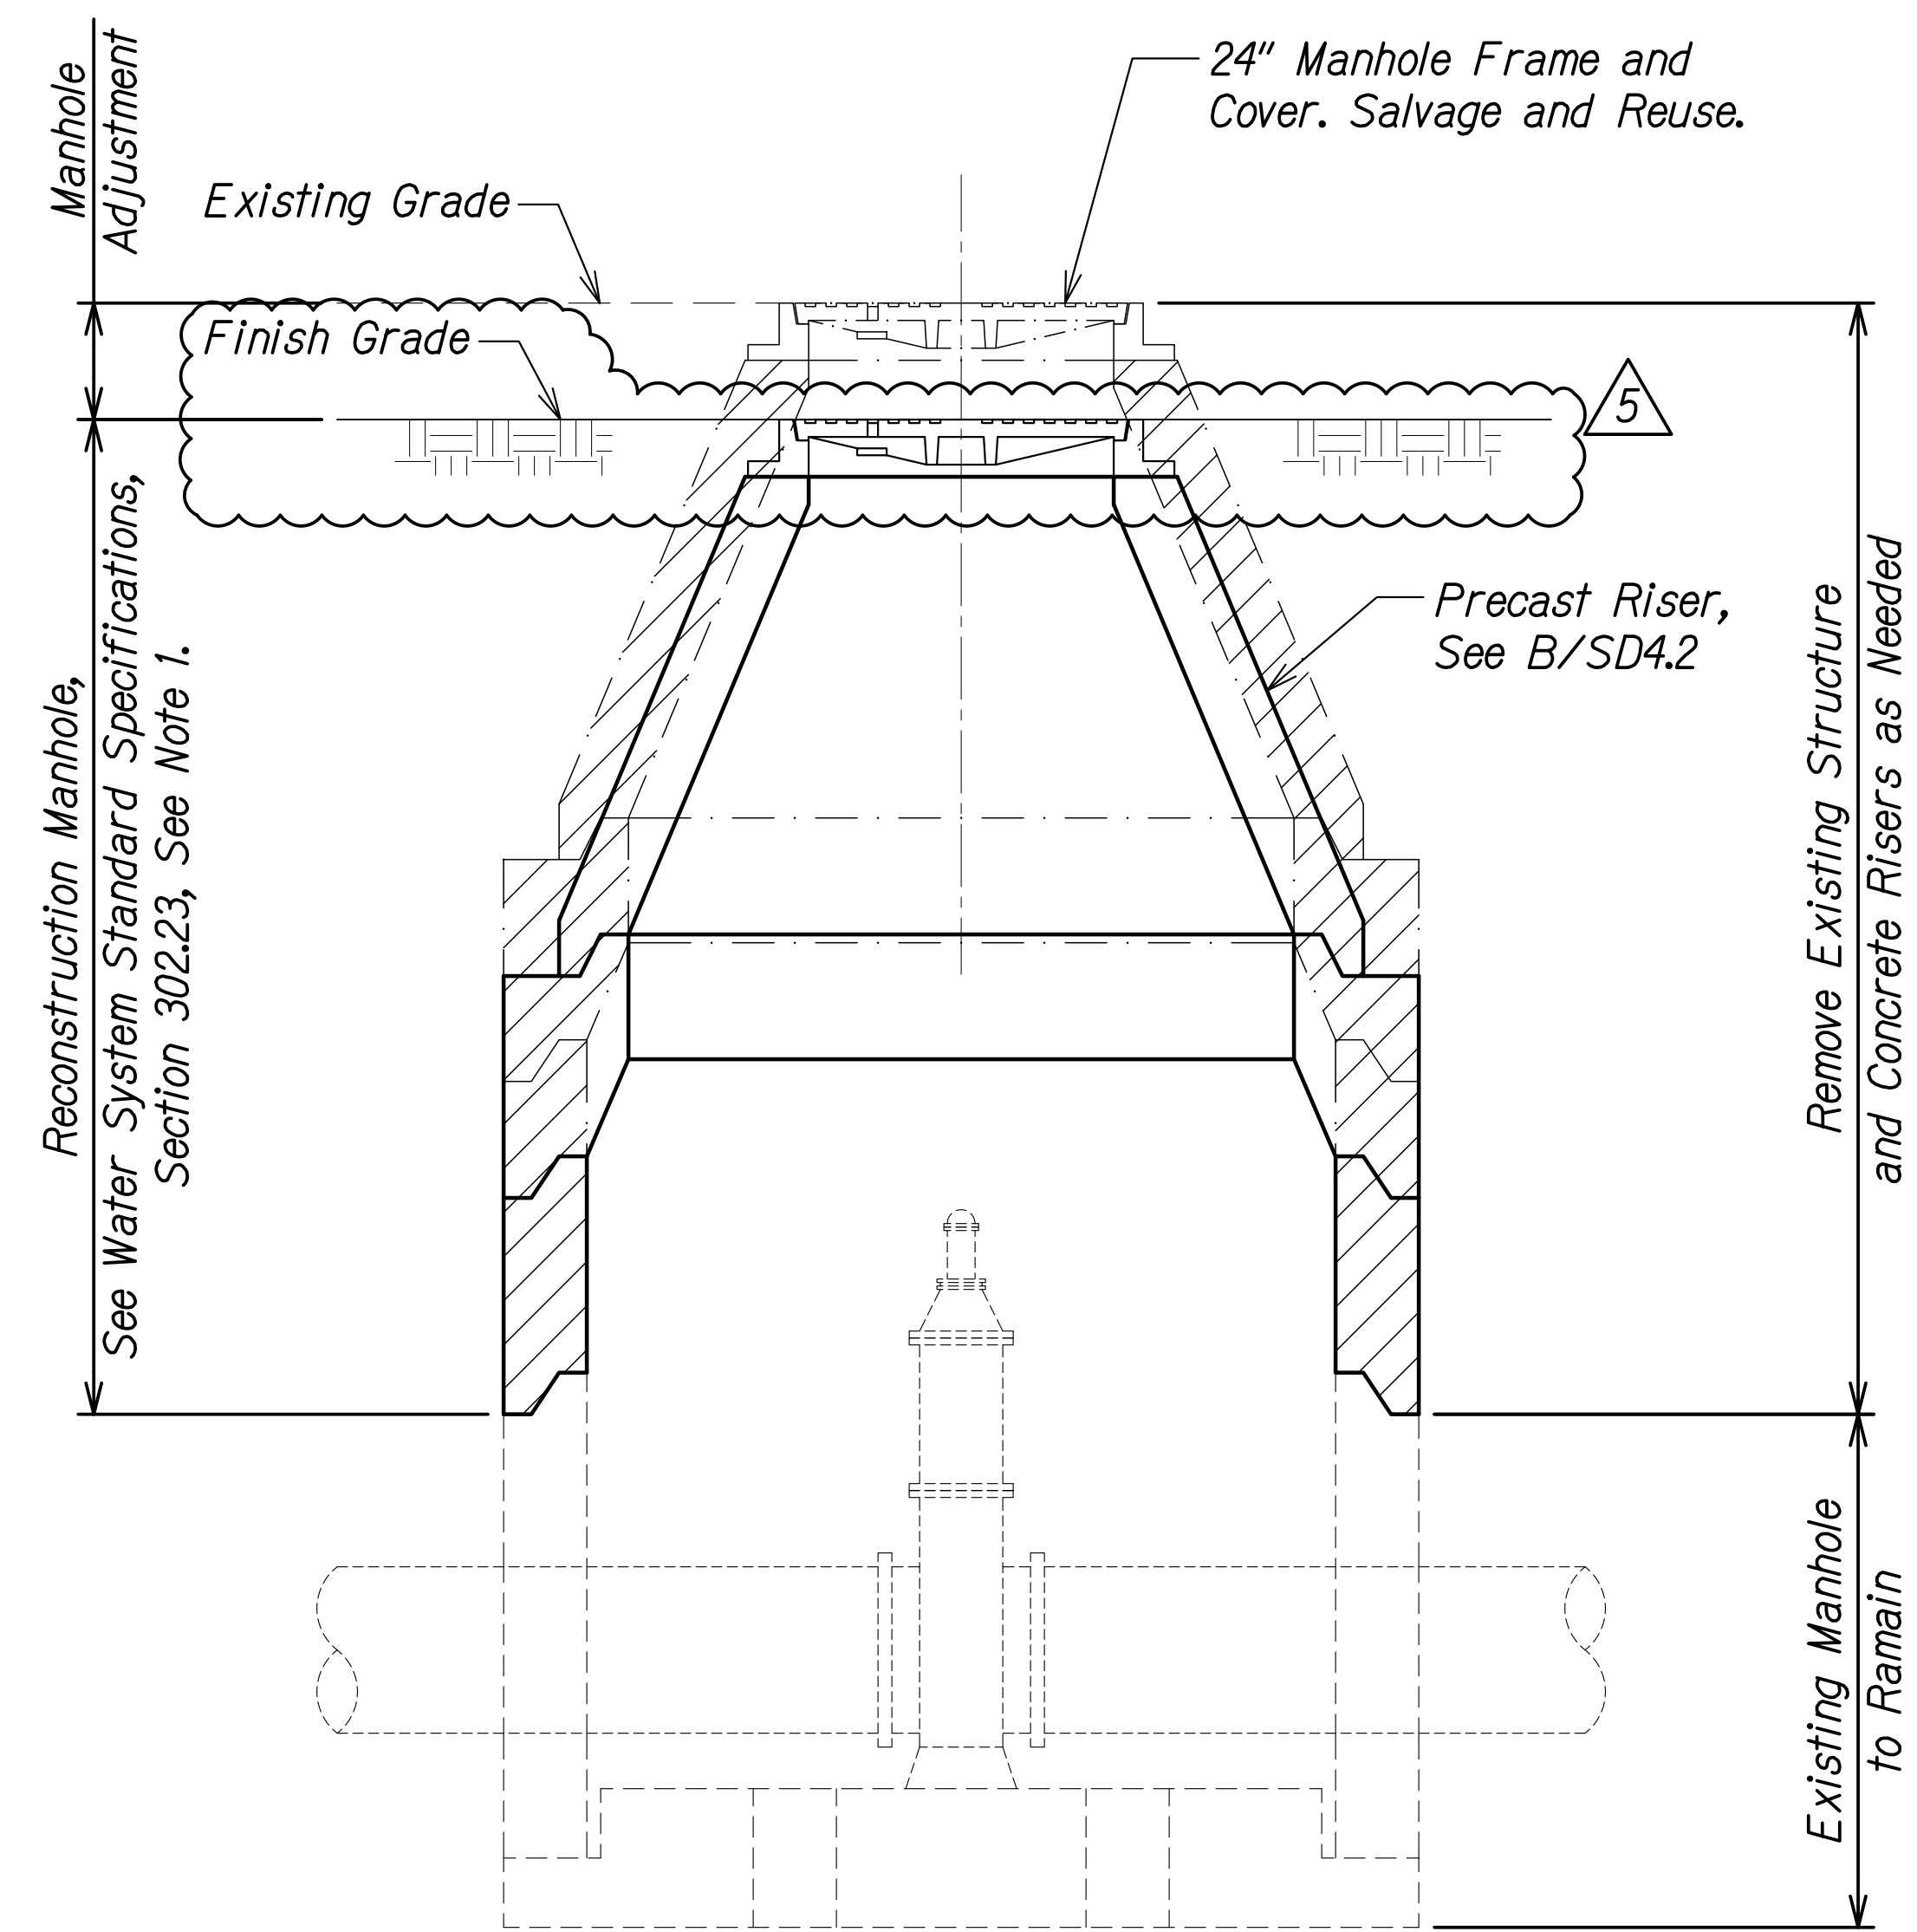

**EXISTING TYPE "B" PRECAST MANHOLE LOWERING**  
 Scale: 1" = 1'-0" A SD4.2 SD4.2

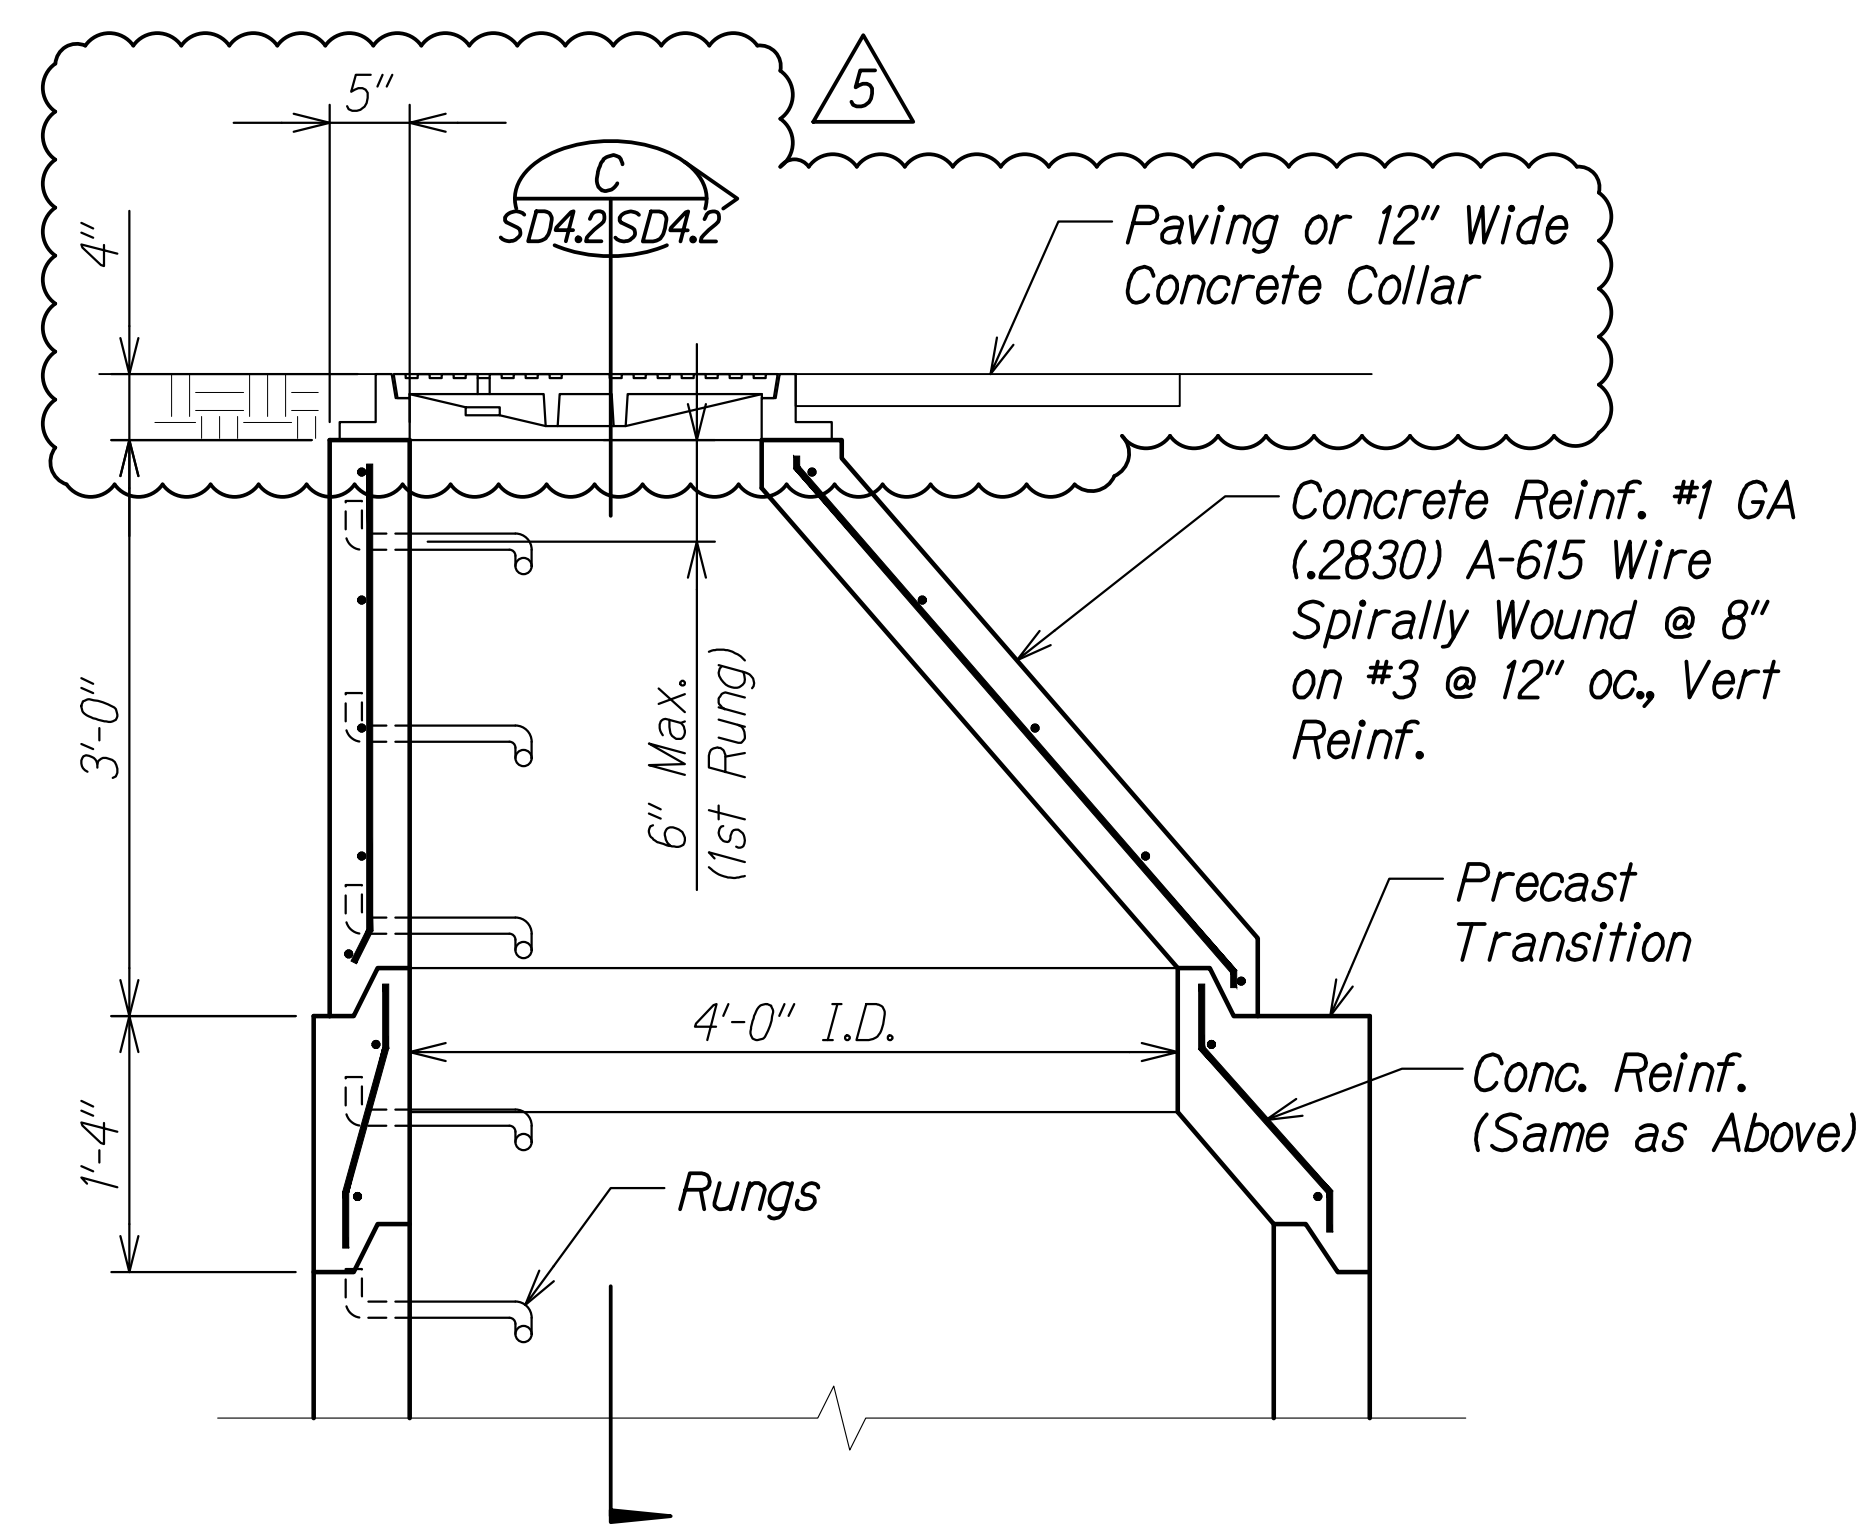

**TYPE "B" MANHOLE**  
 Scale: 1" = 1'-0" B SD4.2 SD4.2

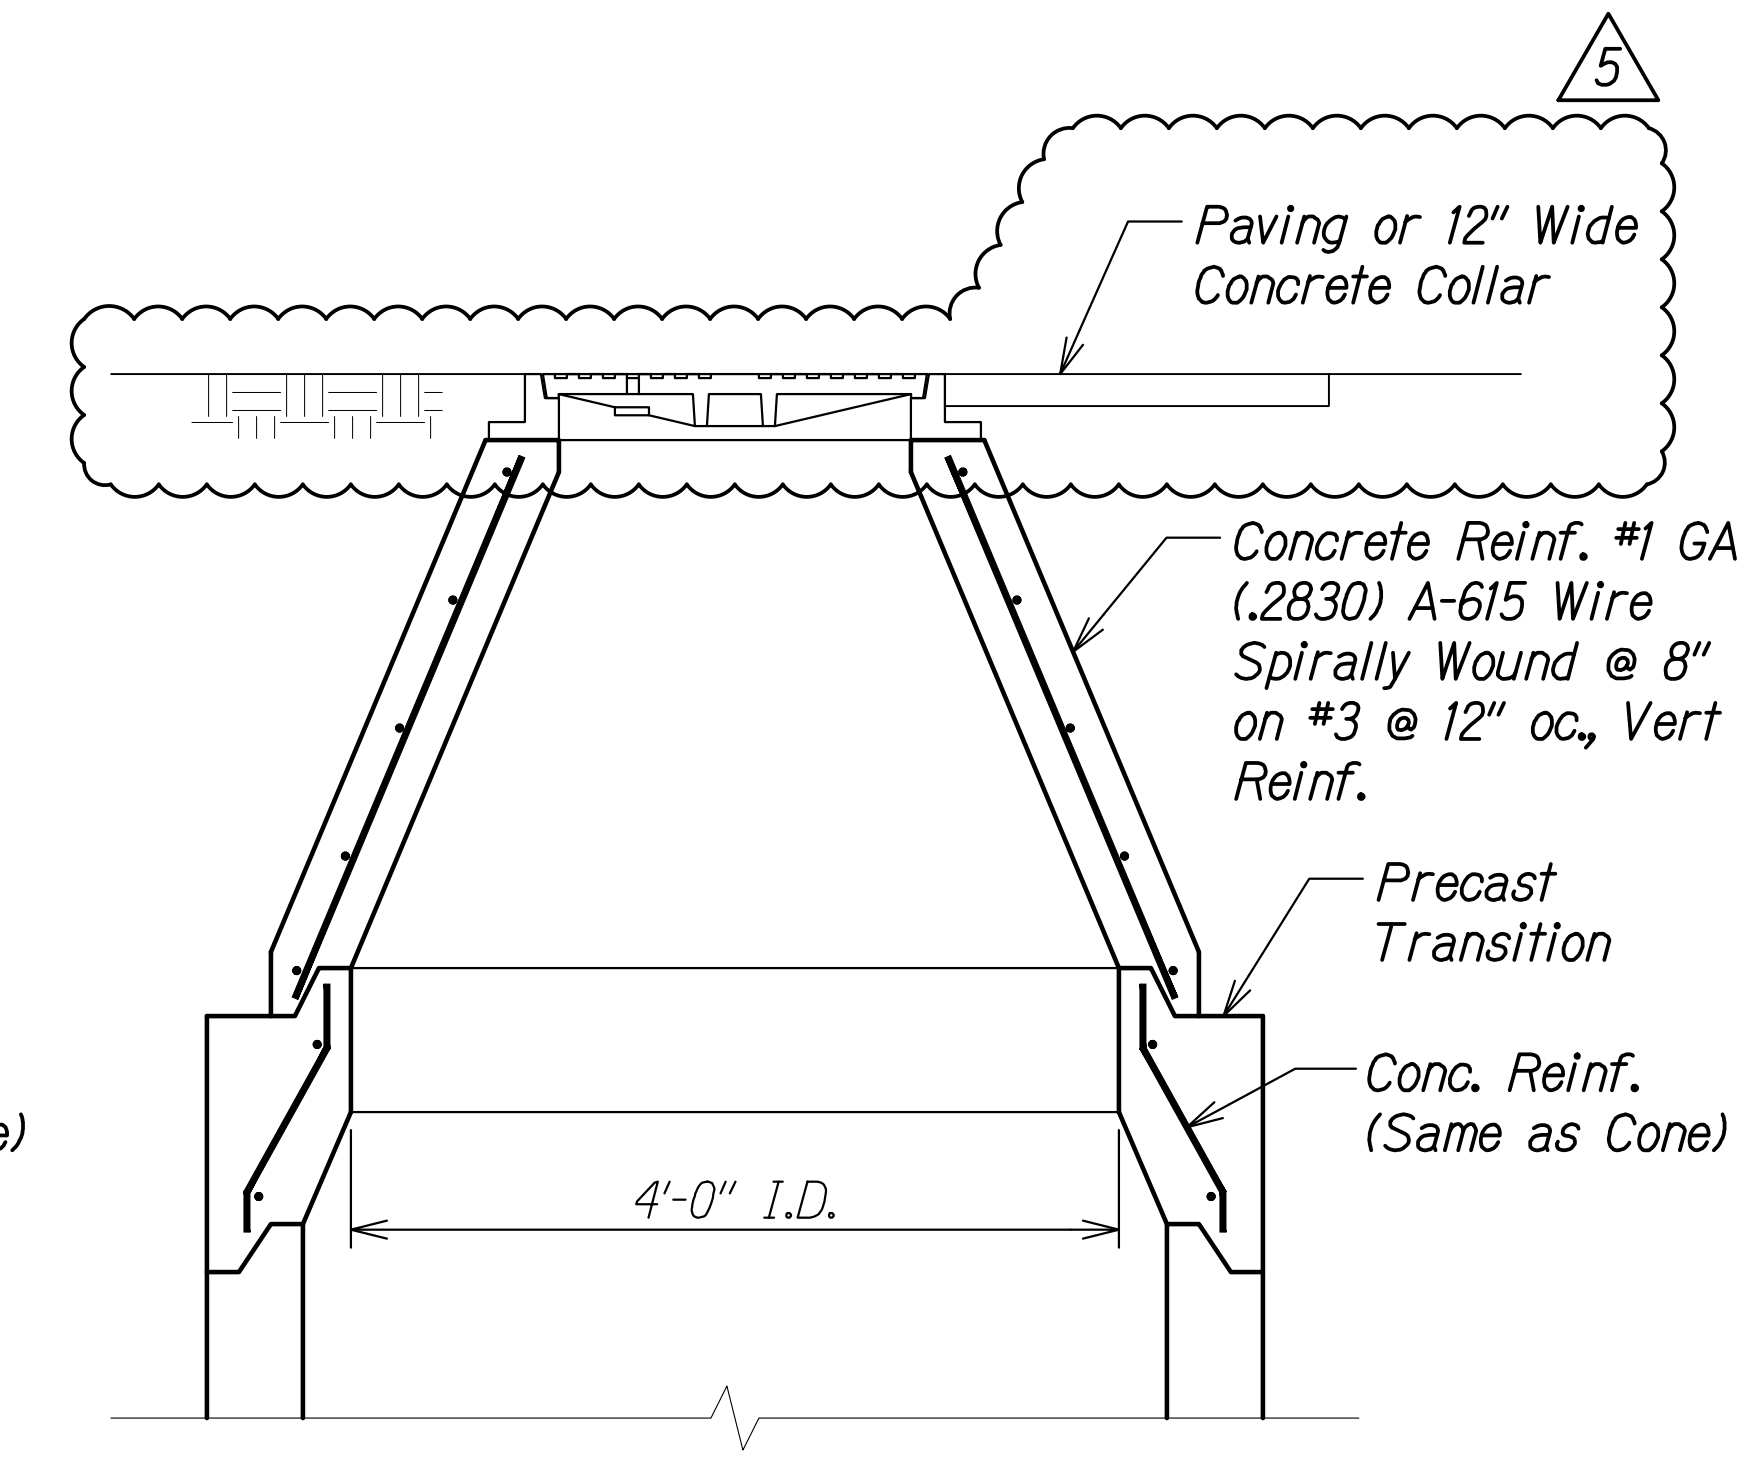

**SECTION C**  
 Scale: 1" = 1'-0" SD4.2 SD4.2

**Notes:**


- Contractor shall submit shop drawings for Type "B" manhole to BWS for approval.
- Existing waterlines, valves and appurtenances shall be protected at all times during construction.

SURVEY PLOTTED BY	DATE
DRAWN BY	
DESIGNED BY	
QUANTITIES BY	
CHECKED BY	
ORIGINAL PLAN	
NOTE BOOK	
No.	

DRAWING NAME: Z:\00\_ONGOINGS\20-013-FARR-HWY-KAPOLEI.GE.ID.IT.WP8-EMT(C).DWT DATE: 07-15-22 4:01 PM DELIAS\HWY3-SD4.02-TYPE B MH ADJ-ADD1 DELIAS.DWG PLOT TIME: 07-15-22 6:29 PM



APPROVED:  
 Manager and Chief Engineer, BWS  
 (for work affecting BWS facilities in City/State R/W & BWS easements only)

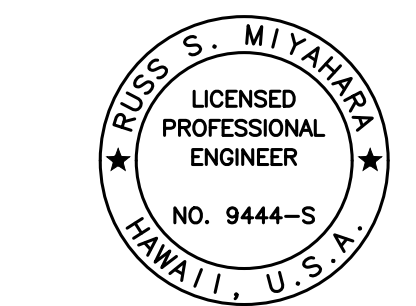

THIS WORK WAS PREPARED BY ME OR UNDER MY SUPERVISION AND CONSTRUCTION OF THIS PROJECT WILL BE UNDER MY OBSERVATION.  
 Signature: *Rugo S. Miyakawa*  
 April 30, 2024  
 EXPIRATION DATE OF THE LICENSE

07/15/22	5	Revised finish grade
06/08/22	2	Revised signature block
DATE	REVISION	


STATE OF HAWAII  
 DEPARTMENT OF TRANSPORTATION  
 HIGHWAYS DIVISION

**Type "B" Manhole Adjustment Section**


FARRINGTON HIGHWAY WIDENING  
 Kapolei Golf Course Road to Fort Weaver Road  
 Project No. 7101A-01-20

Scale: As Shown Date: Apr. 2022


FED. ROAD DIST. NO.	STATE	PROJ. NO.	FISCAL YEAR	SHEET NO.	TOTAL SHEETS
HAWAII	HAW.	7101A-01-20	2021	ADD. 544	

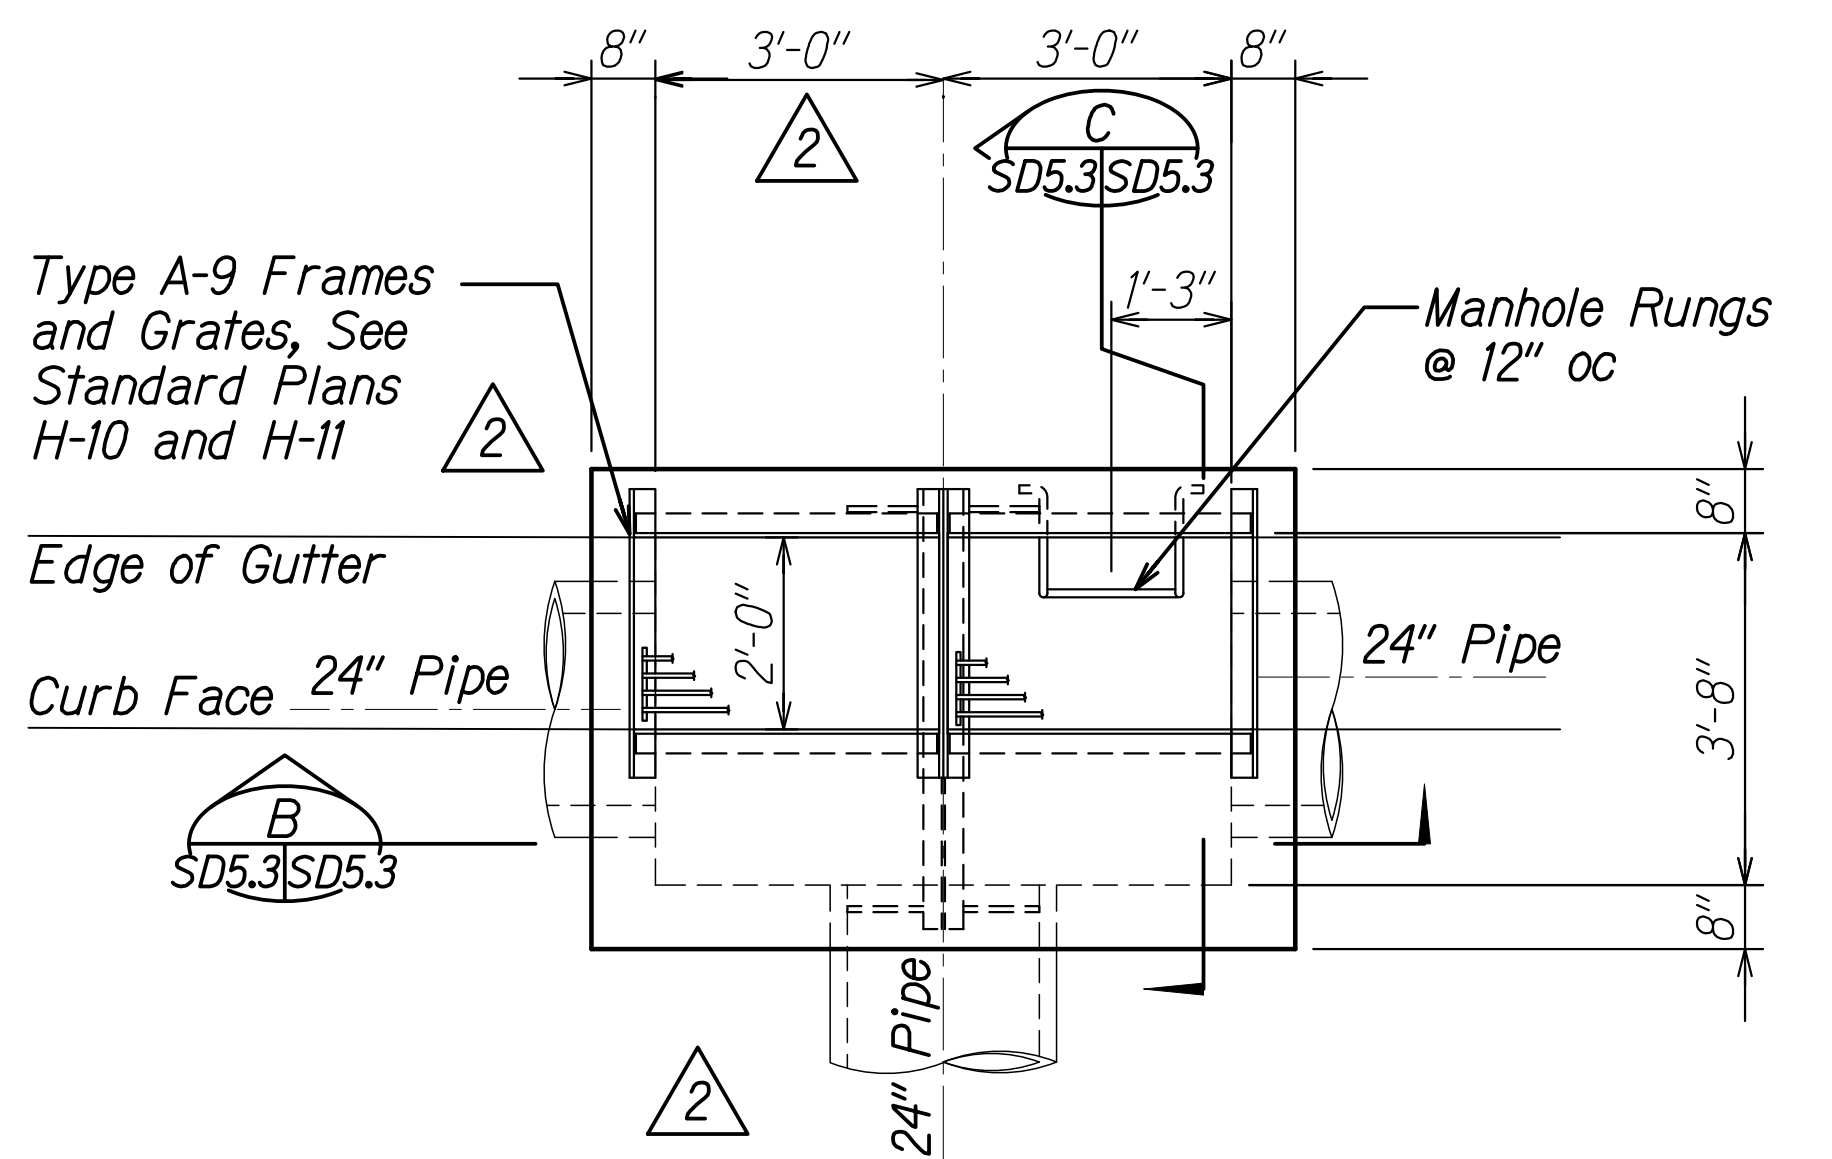


**PLAN - SPECIAL GRATED DROP INLET (GDI B2)**  
 Scale: 1/2" = 1'-0"  
 SD5.3 SD5.3

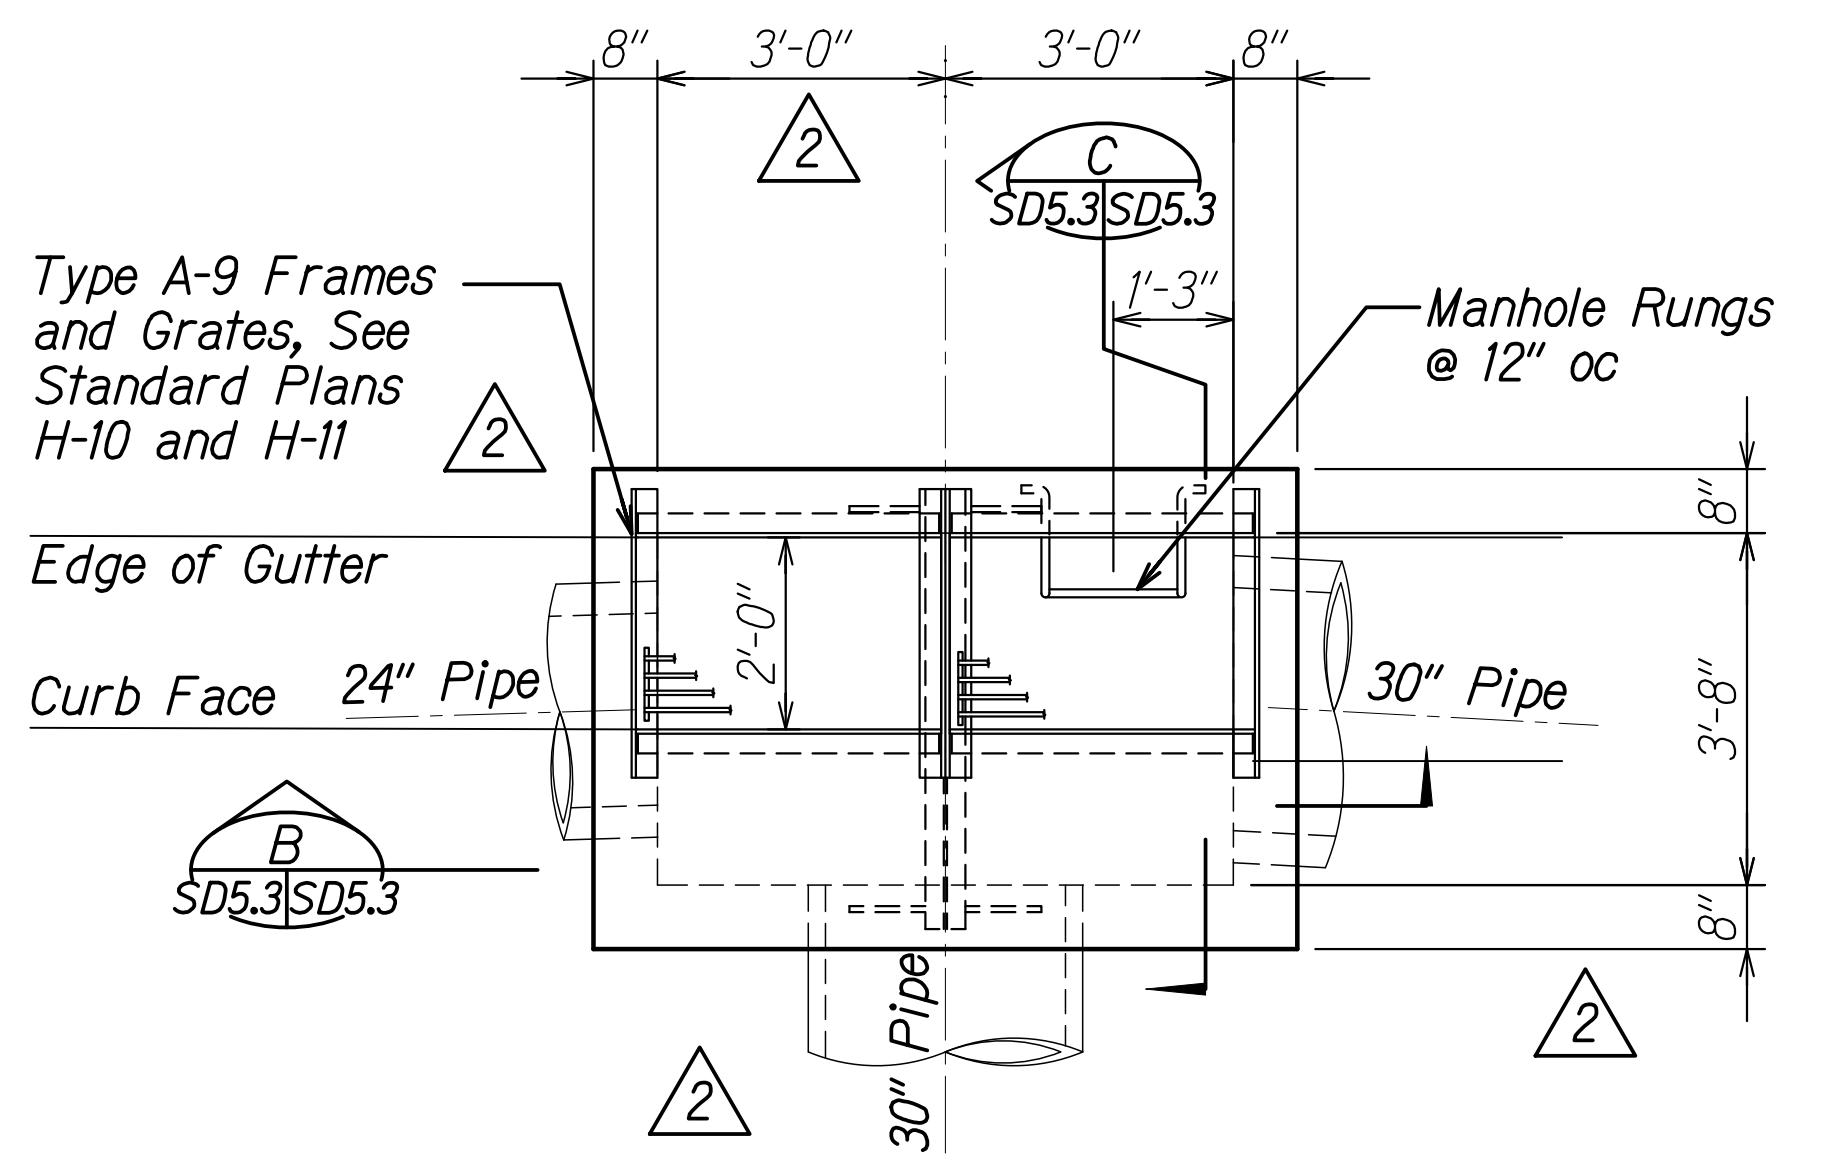

**PLAN - SPECIAL GRATED DROP INLET (GDI D2)**  
 Scale: 1/2" = 1'-0"  
 SD5.3 SD5.3

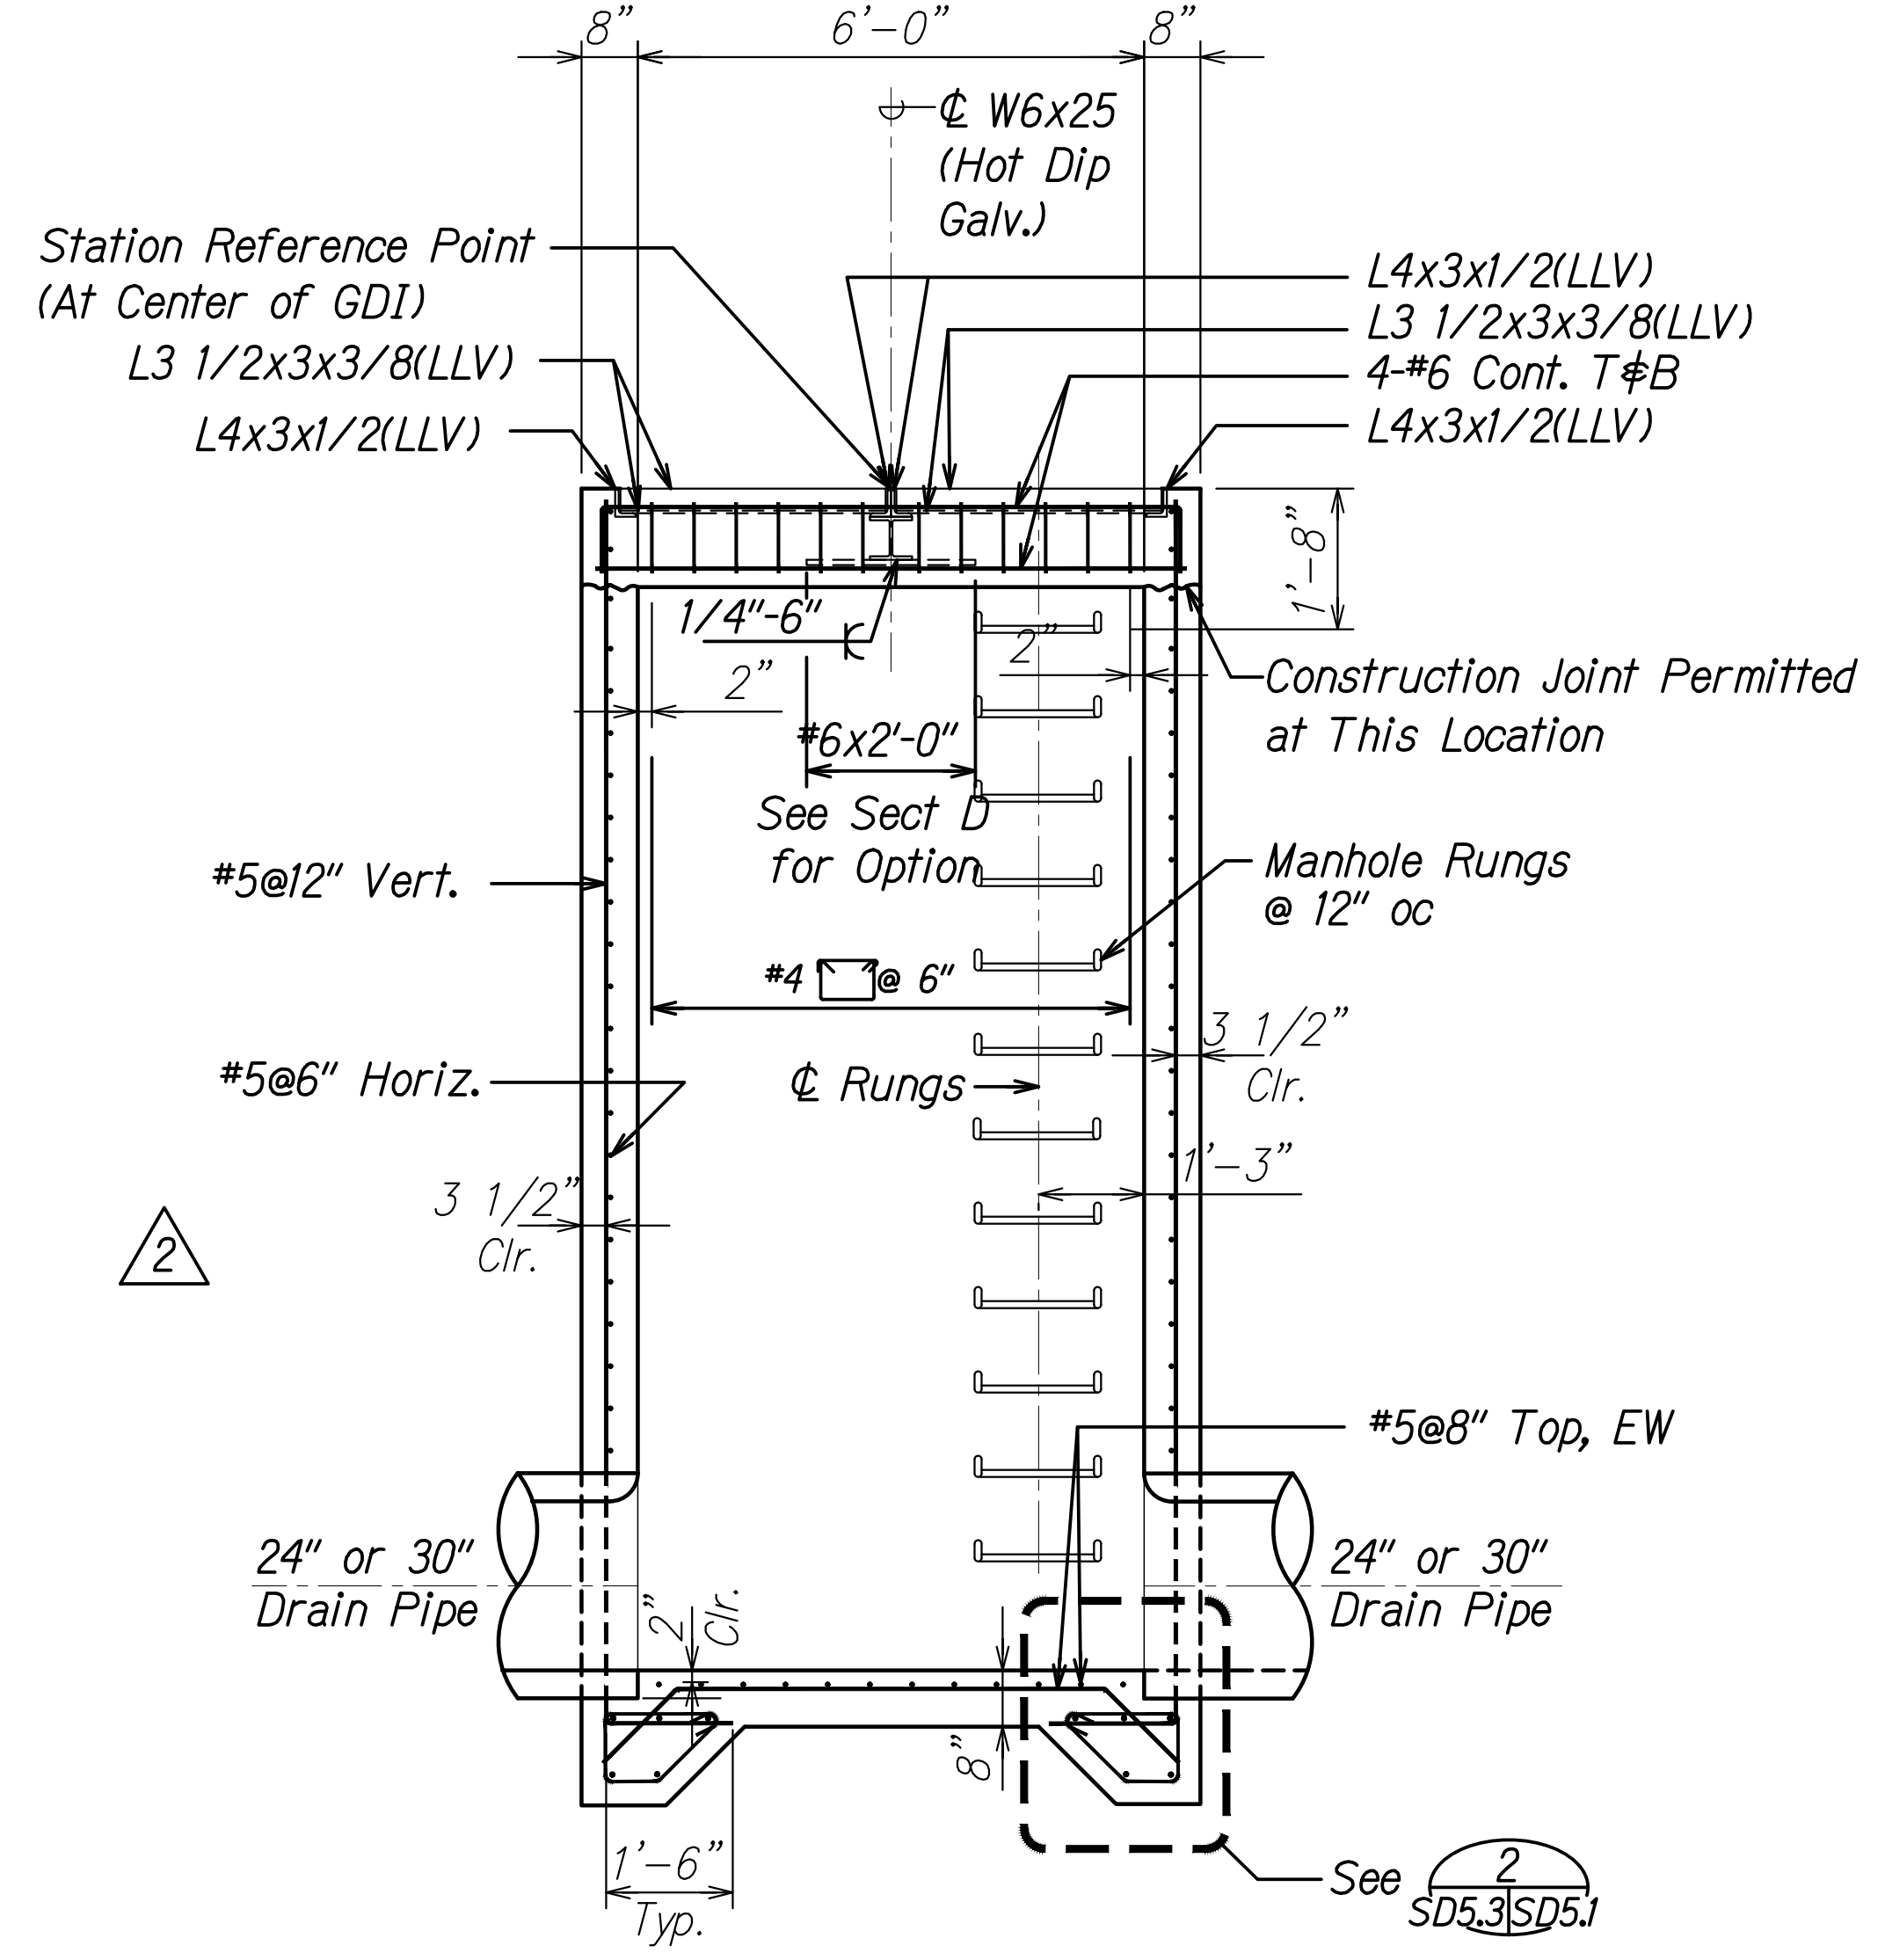

**SECTION - SPECIAL GRATED DROP INLET**  
 Scale: 1/2" = 1'-0"  
 SD5.3 SD5.3

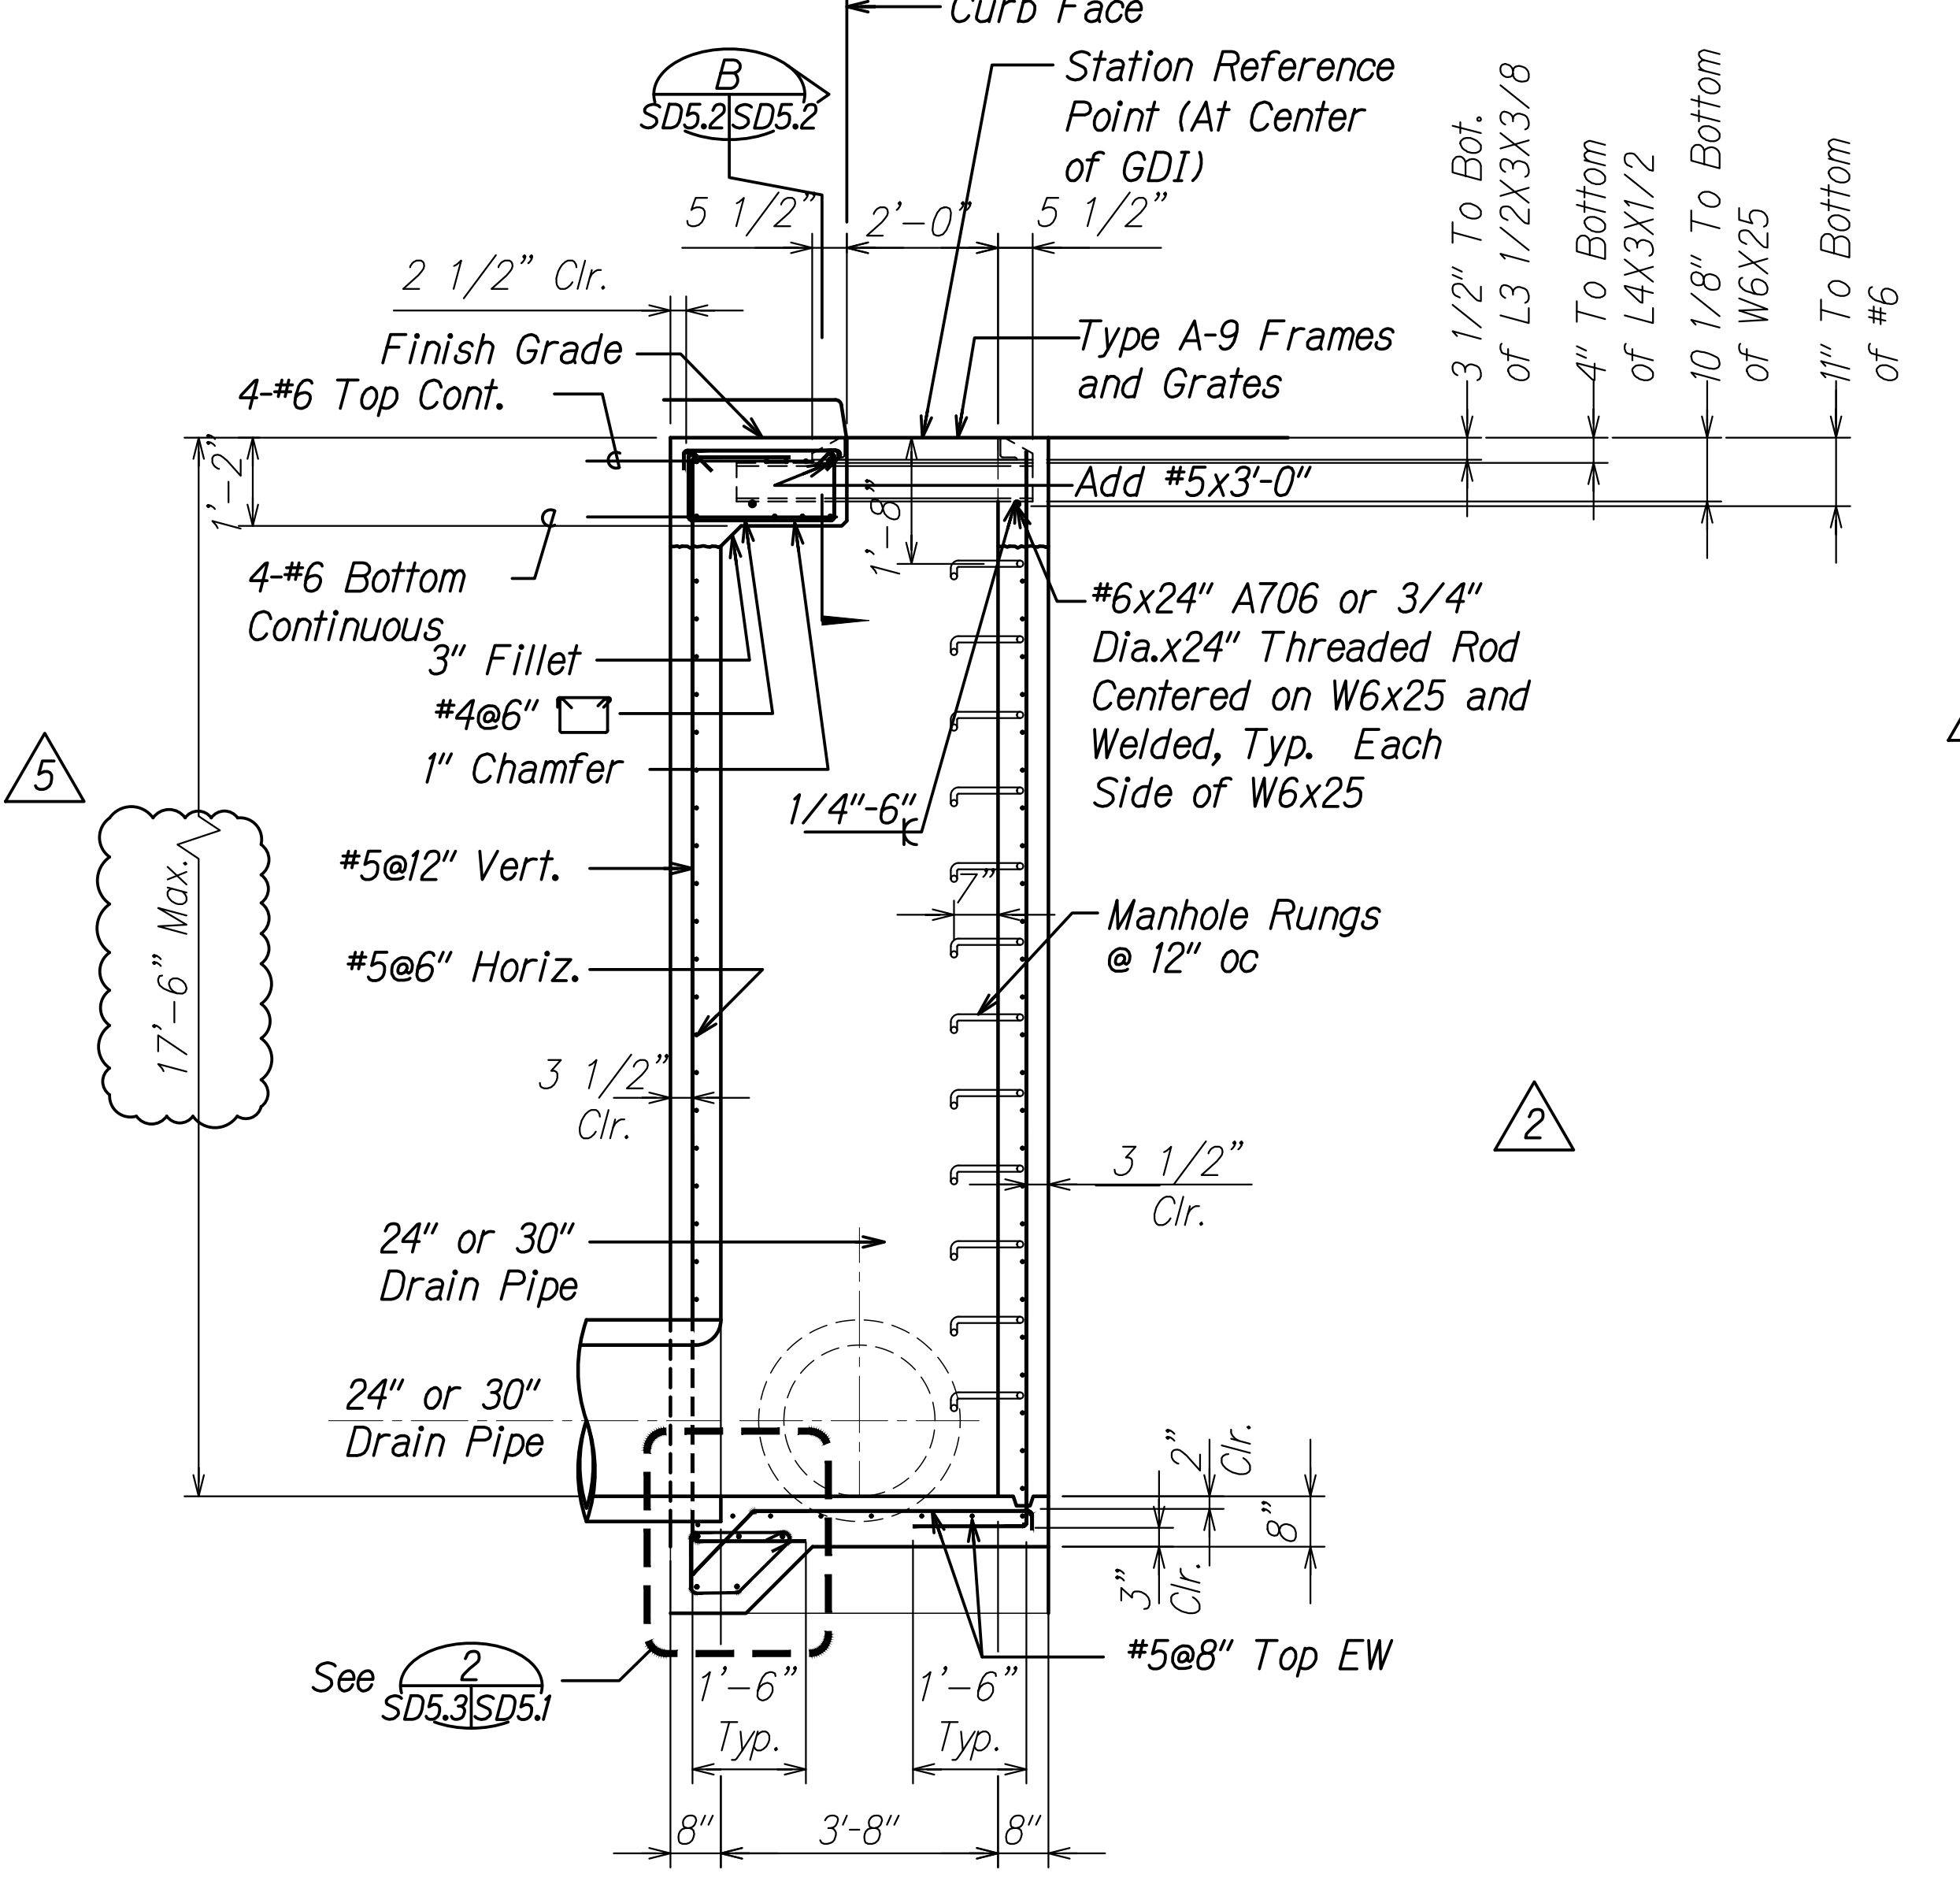

**SECTION - SPECIAL GRATED DROP INLET**  
 Scale: 1/2" = 1'-0"  
 SD5.3 SD5.3

ORIGINAL PLAN	DATE
DRAWN BY	
DESIGNED BY	
QUANTITIES BY	
CHECKED BY	

DRAWING NAME: Z:\ADD\CONCRETE\20-013-FARR-HWY-KAPOLEI-GC-10-ET-WR-EMT\01-GAD\07-15-22-ADD1-DELTA5-DWG-01-DELTA-5.DWG PLOT TIME: 07-15-22 5:57 PM

DATE	REVISION
07/15/22	5 Revised GDI Maximum height
06/08/22	2 Revised pipe and curb face location
STATE OF HAWAII DEPARTMENT OF TRANSPORTATION HIGHWAYS DIVISION <b>Special Grated Drop Inlet          B2 and D2</b> FARRINGTON HIGHWAY WIDENING Kapolei Golf Course Road to Fort Weaver Road Project No. 7101A-01-20 Scale: As Shown Date: Apr. 2022 SHEET No. SD5.3 OF 3 SHEETS	



General Notes:

1. Provide 5' Minimum Clear Between Street Light Poles & Sewer Laterals.
2. Provide 3' Minimum Clear Between Pullboxes & Sewer Laterals.
3. Provide 6' Minimum Clear Between Transformer Pads & Sewer Laterals (Do Not Straddle).
4. Provide 3' Minimum Clear Between Ductlines & Sewer Lines.
5. Contractor Shall Verify Sewer Lateral Locations with Civil Sheets.
6. Provide 3' Minimum Horizontal Clear & 6" Vertical Clear Between Water Lines & All Electrical Systems. Provide Minimum 12" Vertical Clear Between BWS Water Lines & All Electrical Systems.
7. The Electrical Contractor and any other subcontractor shall be responsible to arrange with the General Contractor to identify the locations of civil site utilities, driveways, etc. prior to electrical contractors layout of electric, telephone, street light, traffic signal, and CATV systems.
8. The Contractor Shall Maintain a Minimum Vertical Clearance of 16'-6" From the Ground to Existing Electrical Lines.

Notes for Construction:

- A. The Location of Overhead and Underground Facilities Shown on the Plans are From Existing Records With Varying Degrees of Accuracy and are Not Guaranteed As Shown. the Contractor Shall Exercise Extreme Caution Whenever Construction Crosses Or is In Proximity of Underground Lines and Shall Maintain Adequate Clearance When Operating Equipment Under Any Overhead Lines.
- B. The Contractor is to Comply With the Directions of the State of Hawaii Occupational Safety and Health Law (HIOSH).
- C. When Trench Excavation is Adjacent to Existing Structures Or Facilities, the Contractor is Responsible For Properly Sheeting and Bracing the Excavation and Stabilizing the Existing Ground to Render it Safe and Secure From Possible Slides, Cave-ins and Settlement, and For Properly Supporting Existing Structures and Facilities With Beams, Struts Or Underpinning to Fully Protect it From Damage.
- D. As Required by Section 645, the Contractor Shall Provide Two Off-duty Police Officers to Control the Flow of Traffic at Each Location.
- E. Where Pedestrian Walkways Exist, Such Walkways Shall Be Maintained In Passable Condition Or Other Facilities For Pedestrians Shall Be Provided. Passage Between Walkways At Intersections Shall Likewise Be Provided, All Shall Be ADA Compliant.
- F. Driveways Shall Be Kept Open Unless the Owners of the Property Using These Right-of-ways are Otherwise Provided For Satisfactorily.
- G. The Underground Pipes, Cables Or Ductlines Known by the Engineer to Exist From His Search of Records are Indicated on the Plans. the Contractor Shall Verify the Location and Depth of the Facilities and Exercise Proper Care In Excavating the Area. Wherever Connections of New Utilities to Existing Utilities are Shown on the Plans, the Contractor Shall Expose the Existing Lines At the Proposed Connections to Verify Their Locations and Depths Prior to Excavation For the New Lines.

City & County of Honolulu - Department of Transportation Services Traffic Signals And Technology Notes:


1. The Contractor Shall Notify The Traffic Signals And Technology Division, Department Of Transportation Services, Three (3) Working Days Prior To Commencing Work On The Traffic Signal System (Phone: 768-8388).
2. The Traffic Signal System Shall Be Kept Operational During Construction. Any Relocation Required Shall Be Approved By The Traffic Signals And Technology Division, Department Of Transportation Services, And Paid For By The Contractor.
3. The Contractor Shall Be Responsible For Any Damages To The Existing Traffic Signal Facilities, Including But Not Limited To The Traffic Signal Fiber Optic Cable System, And Interconnect System. Any And All Damages To The Facilities Shall Be Repaired By The Contractor At Their Cost In Accordance With The Requirements Of The Traffic Signal And Technology Division, Department Of Transportation Services.
4. Coordinate All Speciality Work to be Performed by Traffic Signal System (TS) Contractor and Closed Circuit Television (ITS) Contractor. Work Included are New and Relocation of HECO Services, Including HECO Metering and Underground Feeders to Equipment.

City & County of Honolulu - Department of Design & Construction Mechanical/Electrical Division Notes:

1. The Contractor Shall Notify the Mechanical/Electrical Division, Department of Design and Construction Two (2) Weeks in Advance of Any Relocation of Utility Pole(s) that May Be Necessary. (1-808-768-8431).
2. The Contractor Shall Notify the Mechanical/Electrical Division, Department of Design and Construction, Three (3) Working Days Prior to Commencing Work on the Street Light System. (1-808-768-8431).
3. The Street Lighting System Shall Be Kept Operational During Construction. Any Relocation Required Shall Be Approved by the Mechanical/Electrical Division and Paid for by the Contractor.
4. The Locations of the Existing Underground Street Light Facilities Shown On the Plans are from Existing Plans and are Approximate Only. The Contractor Shall Exercise Caution when Construction Crosses or Is In Close Proximity to the Existing Street Light Facilities. The Contractor Shall Be Responsible for Any Damages to the Existing Street Light Facilities. Any and All Damages to these Facilities Shall Be Repaired by the Contractor at His Cost in Accordance with the Requirements of the City and County of Honolulu.
5. The Contractor Shall Be Responsible for Any Damages to the City's Existing Communications Fiber Optic Cable System. Any and All Damages to these Facilities Shall be Repaired by the Contractor at His Cost in Accordance with the Requirements of the City and County of Honolulu.

6. Salvage and Deliver Existing Standards for steel poles, Luminaries & Control Nodes, Mass Arms from Wood Poles (HECO Joint Wood Poles) to Department of Facility Maintenance Pearl City Corp Yard at Pearl City (952 Third Street) as Directed by the Street Light Inspector. Contractor is to Contact 1-808-768-5300 a Minimum of Two Days Prior to Delivery of Salvage Items. Contractor is to Meet with Department of Facility Maintenance Personnel at Pearl City Corp Baseyard on the Day of Delivery to show where to Unload the Items (i.e. Steel Poles).

FED. ROAD DIST. NO.	STATE	PROJ. NO.	FISCAL YEAR	SHEET NO.	TOTAL SHEETS
HAWAII	HAW.	710A-01-20	2021	EA-1	790

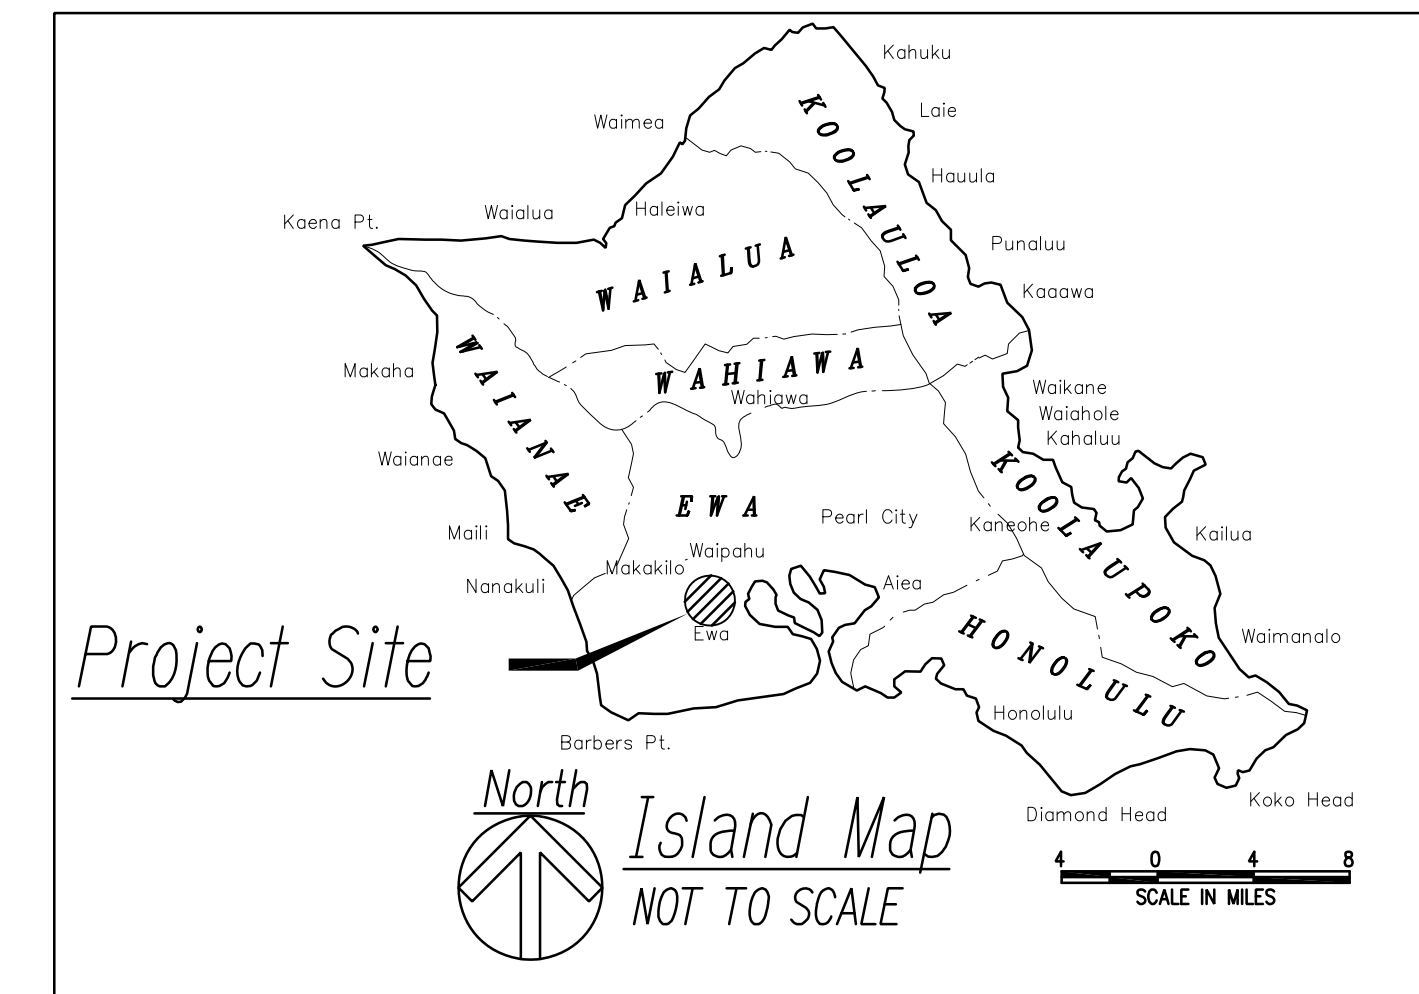


SURVEY PLOTTED BY	DATE
DRAWN BY	
TRACED BY	
QUANTITIES BY	
CHECKED BY	
ORIGINAL PLAN	
NOTE BOOK	
No.	

FILE: Z:\ACAD\PROJECTS\22067HA\EA01\_22\067H\_GENERAL-NOTES.DWG saved July 13, 2022

APPROVED BY

PROGRAM ADMINISTRATOR, MECHANICAL/ELECTRICAL DIVISION DATE  
DEPT. OF DESIGN AND CONSTRUCTION  
CITY & COUNTY OF HONOLULU

CHIEF, TRANSPORTATION TECHNOLOGY DIVISION DATE  
DEPT. OF TRANSPORTATION SERVICES  
CITY & COUNTY OF HONOLULU

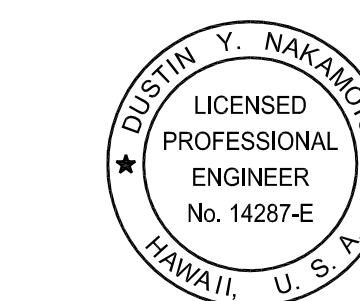

THIS WORK WAS PREPARED BY ME OR UNDER MY SUPERVISION AND CONSTRUCTION OF THIS PROJECT WILL BE UNDER MY OBSERVATION.

SIGNATURE DATE: April 30, 2024  
EXPIRATION DATE OF THE LICENSE

07/15/22	5	UPDATED NOTE
06/08/22	2	UPDATED NOTE, ADDED NOTE
DATE		REVISION

**STATE OF HAWAII**  
**DEPARTMENT OF TRANSPORTATION**  
HIGHWAYS DIVISION

**GENERAL NOTES**

FARRINGTON HIGHWAY WIDENING  
Kapolei Golf Course Road to Fort Weaver Road  
Project No. 7101A-01-20

Scale: As Shown Date: April 2022

**SHEET No. EA-1 OF 12 SHEETS**

ADD. 575



FED. ROAD DIST. NO.	STATE	PROJ. NO.	FISCAL YEAR	SHEET NO.	TOTAL SHEETS
HAWAII	HAW.	710A-01-20	2021	EA-2	790


## Electrical Symbols

Symbol	Description	Symbol	Description	Symbol	Description
	Exst. Street Light		Exst. HECO 3-PHASE PADMOUNT TRANSFORMER (1000-1500 KVA)		Traffic Signal Controller, See Detail A/EH07
	Note Symbol, See Plan For Notes		Exst. HECO 3-PHASE PADMOUNT TRANSFORMER (500-750 KVA)		CCTV Controller, See Detail A/EH07
	Breakline To Begin & End Duct Section Type		Exst. HECO 3-PHASE PADMOUNT TRANSFORMER (75-300 KVA)		Type Ø1Ø1 Traffic Signal Standard With Traffic Signal Heads Mounted On Mast Arm Standard; Pole "B" with 25' Mast Arm Indicated, Standard; Pole "B" With 25' Mast Arm Indicated, See Detail A/EH03
	Electric/Signal Ductline With Designators; Indicates Type "A" Duct Section With "2-2E" Ducts. See Sheet EF-01 For Duct Sections And This Sheet For The Conduit Schedule		HECO 1-PHASE PADMOUNT TRANSFORMER		Pedestrian Push Button, See Detail B/EH04
	Saw Cut Exst. A.C. Pavement, Conc. Sidewalk, Curb & Gutter Prior To Trench Excavation. Restore Subbase, Basecourse, Pavement, Conc. Sidewalk, Curb & Gutter Per Hdot Requirements, Thickness Shall Match Exst Road Design See Civil Sheets For Restoration Details.		Exst. HECO SWITCHGEAR PAD		Vehicle Loop Detector, See Sht EH06
	Traffic Signal Ducts & Wiring		HECO 1-PHASE OVERHEAD TRANSFORMER		Signal Standard, 10' Height, Unless Indicated Otherwise With Designator; Pole "A" Indicated, See Detail C/EH04
	Exst. Street Light Ducts & Wiring		HECO 3-PHASE OVERHEAD TRANSFORMER BANK		12" RYG Traffic Signal Head, See Mounting Details A/EH04
	Exst. Traffic Signal Ducts & Wiring		Exst. OVERHEAD HECO LINE		12" RYGA Traffic Signal Head (Straight Arrow), See Mounting Details A/EH04
	HECO 2' X 4' Handhole		Exst. OVERHEAD HECO LINE		12" RYGA Traffic Signal Head (Left Turn Arrow Indicated), See Mounting Details A/EH04
	HECO 3' X 5' Handhole		Exst. OVERHEAD HECO LINE		12" RYGA Programmed Visibility Traffic Signal Head (Left Turn Arrow Indicated), See Mounting Details A/EH04
	Exst. HECO 4' X 6' Manhole		Exst. OVERHEAD HECO LINE		Pedestrian Signal Head, See Mounting Detail C/EH05
	Exst. HECO 5' X 8' Manhole		Exst. OVERHEAD HECO LINE		Optical Pre-emption Detector, See Mounting Details A & B/EH05
	Exst. HECO 6' X 11' Manhole		Exst. OVERHEAD HECO LINE		CCTV Camera, See Mounting Detail B/EH08
	Exst. HECO 6' X 14' Manhole		Exst. OVERHEAD HECO LINE		HECO Meter Pedestal, See Detail A/EH01
	Exst. HECO 7' X 16' Manhole		Exst. OVERHEAD HECO LINE		Type "A" Metric State Highway Traffic Signal Pullbox
	HECO 6' X 18' Manhole		Exst. OVERHEAD HECO LINE		Type "B" Metric State Highway Traffic Signal Pullbox
	HECO 6' X 18' Manhole		Exst. OVERHEAD HECO LINE		Type "C" Metric State Highway Traffic Signal Pullbox
	HTCO 2' X 4' Handhole		Exst. UNDERGROUND HECO LINE		Type "B" Metric State Highway Street Light Pullbox
	Exst. HTCO 3' X 5' Handhole		Exst. UNDERGROUND HECO LINE		98W State Standard LED Street Light, Bracket Arm Length As Noted On Plan
	Exst. HTCO 5' X 10' Manhole		Exst. UNDERGROUND HECO LINE		98W Reduced Height LED Street Light, Bracket Arm Length And Mounting Height As Noted On Plan
	Exst. CATV 2' X 6' Handhole		Exst. UNDERGROUND HECO LINE		120W State Standard LED Street Light, Bracket Arm Length As Noted On Plan
	Exst. CATV 3' X 5' Handhole		Exst. UNDERGROUND HECO LINE		120W Reduced Height LED Street Light, Bracket Arm Length And Mounting Height As Noted On Plan
	CATV 4' X 6' Manhole		Exst. UNDERGROUND HECO LINE		Exst. City Street Light (To Be Removed)
	Exst. SIC 4' X 6' Manhole		Exst. UNDERGROUND HECO LINE		
	Exst. AT&T 6' X 6' Manhole		Exst. UNDERGROUND HECO LINE		
	AT&T 4' X 4' Manhole		Exst. UNDERGROUND HECO LINE		
			Metering Equipment, See Sheet EG-15		
			Metering Equipment, See Sheet EH-1		
			Exst. Metering Equipment		
			Concrete Stub Out Marker, See Sheet EF-01		
			Elec Connection, WP		

**Notes:**

- "X" Thru System Denotes Item to be Removed, Unless Otherwise Noted.
- Dashed Symbol Indicates Existing Item, Unless Otherwise Noted.
- Dashed and Screened Symbol Indicates Future Item, Unless Otherwise Noted.
- "Top Of Wall" Indicates Pole Base Mounted On Top Of Retaining Wall.  
 "In Cut Slope" Indicates Pole Base Located In Cut Slope Area.  
 "In Fill Slope" Indicates Pole Base Located In Fill Slope Area.  
 "Behind Guardrail" Indicates Pole Base Located Behind Guardrail.  
 "Breakaway" Indicates Breakaway Transformer Base.

See Detail 3/EG-18 For State Highway Light I.D. Tag Indicator Legend.

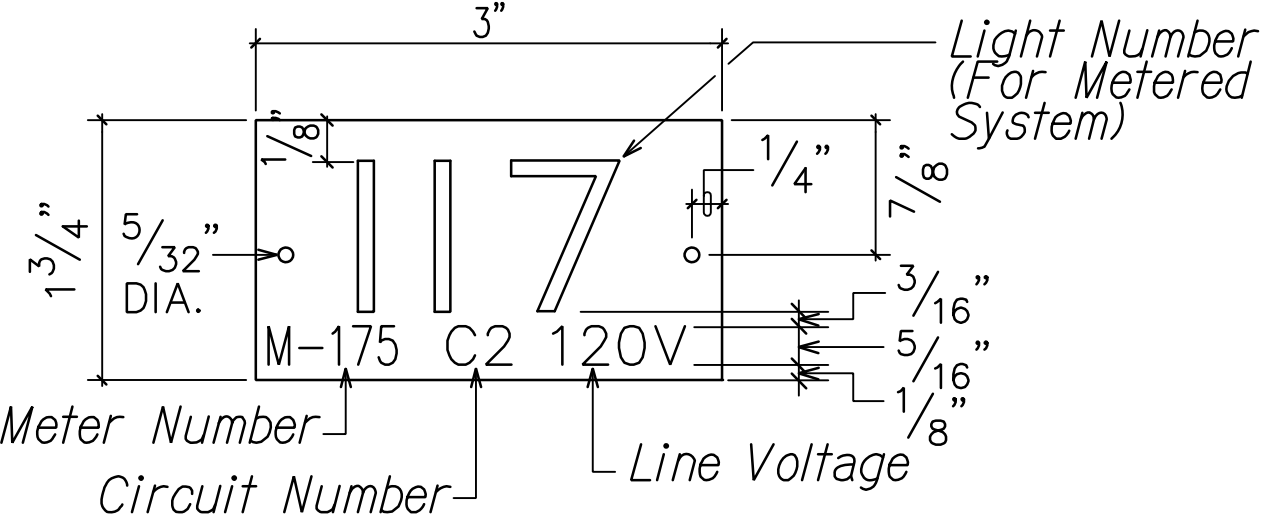

**STREET LIGHT I.D. TAG DETAIL**  
NOT TO SCALE (METERED SYSTEM)

SURVEY PLOTTED BY	DATE
DRAWN BY	
TRACED BY	
NOTED BY	
QUANTITIES BY	
CHECKED BY	
No.	

FILE: Z:\ACAD\PROJECTS\220674\EA02\_220674\_EEP-SYMBOLS.DWG saved July 13, 2022

JUSTIN Y. NAKAMOTO  
LICENSED PROFESSIONAL ENGINEER  
No. 14287-E  
HAWAII, U.S.A.

THIS WORK WAS PREPARED BY ME OR UNDER MY SUPERVISION AND CONSTRUCTION OF THIS PROJECT WILL BE UNDER MY OBSERVATION.

Signature:

April 30, 2024  
EXPIRATION DATE OF THE LICENSE

07/15/22	5	UPDATED LEGEND
06/08/22	2	UPDATED LEGEND
DATE		REVISION

**STATE OF HAWAII**  
**DEPARTMENT OF TRANSPORTATION**  
**HIGHWAYS DIVISION**

**ELECTRICAL SYMBOLS**

FARRINGTON HIGHWAY WIDENING  
Kapolei Golf Course Road to Fort Weaver Road  
Project No. 7101A-01-20

Scale: As Shown      Date: April 2022

**SHEET No. EA-2 OF 12 SHEETS**

HECo Underground Fuel Oil Pipeline Notes:  
Rev. 3/26/18

Equipment Schedule

FED. ROAD DIST. NO.	STATE	PROJ. NO.	FISCAL YEAR	SHEET NO.	TOTAL SHEETS
HAWAII	HAW.	710A-01-20	2021	EA-6	790

1. Excavation Near HECo Fuel Oil Pipelines

The Contractor Shall Exercise Extreme Caution Whenever Construction Crosses or is in Close Proximity to HECo's Underground Fuel Oil Pipelines. If Any Excavation Work Will Be Performed Within 10-Feet of the Fuel Pipelines, the Contractor Shall Notify HECo's Fuels Department at least Two Weeks Prior to the Start of the Excavation Work. If the Excavation is Adjacent to or Beneath the Fuel Pipeline, HECo May Require a Stand-By Person to Monitor the Work of the Contractor. The Cost of the Stand-By Person Shall Be Borne by the Contractor.

Whenever the Integrity of the Pipeline, its Coating, Test Stations, or Cathodic Protection System is Affected by the Excavation Work, the Pipeline and/or its Appurtenances Shall Be Repaired by HECo Personnel Or A Contractor With HECo Operator Qualification Certification, According to US DOT Regulations. The Cost of Any Repairs Shall Be Borne by the Contractor.

The Contractor Shall Notify the Hawaii One Call Center (HOCC) At Least Five Working Days Prior to the Start of Excavation Work, as Required By Hawaii Revised Statute 269E-7.

The US DOT Requires that the Pipeline be Inspected Any Time that it is Exposed. The Contractor Shall Make the Area with the Exposed Pipeline Available to HECo, and Provide Safe Access to the Excavated Area, for this Inspection.

2. Clearance Requirements

Any New Installation Near HECo's Fuel Oil Pipelines Shall Adhere to The Following Clearance Requirements:

- Parallel to HECo Fuel Pipeline: 24-Inches
- Crossing Below HECo Fuel Pipeline: 24-Inches Below
- Crossing Above HECo Fuel Pipeline: Crossing Above Not Permitted

3. Notification

Prior to Beginning Any Excavation Work, the Contractor Shall Notify the HECo Fuels Department at 543-4108.

In the Event of an Emergency, or Damage to Any Pipeline Facilities, Notify HECo Security Command Center at 543-7685, so HECo Personnel Can Secure the Damaged Section and Report Any Oil Spills to the Proper Authorities. All Costs Associated with the Damage, Repair, and Oil Spill Cleanup Shall Be Borne by the Contractor. This Phone is Manned 24-Hours a Day.

The Hawaiian Electric Co (HECo), Hawaiian Telcom (HTCo), Spectrum Oceanic Cable (CATV),  $\phi$  AT $\phi$ T pullboxes, handholes and transformer pad lots shall be constructed by the contract as shown in these drawings  $\phi$  in accordance with the the following standard drawings:

Type	Description	Type	Description
3' X 5' HECo Handhole	3' X 5' precast concrete handhole with precast concrete cover, provided in accordance with HECo standard drawing No. <u>103783</u> .	2' X 4' HTCo Pullbox	2' X 4' type 435TB precast concrete pullbox with 2-piece steel "slip-not" grip or polymer "non-skd" covers and ground rod, per HTCo standard drawing no. <u>34056</u> . A minimum of 2 precast concrete pullbox sections shall be required at each pullbox.
6' X 11' HECo Manhole	6' X 11' reinforced concrete manhole with traffic rated cover, provided in accordance with HECo standard drawing No. <u>103776</u> .	5' X 10'-6" HTCo Manhole	5' X 10'-6" X 6'-6" D precast reinforced concrete manhole with traffic rated frame and cover, and ground rod, provided in accordance with HTCo standard drawing No. <u>180016</u> .
6' X 14' HECo Manhole	6' X 14' reinforced concrete manhole with traffic rated cover, provided in accordance with HECo standard drawing No. <u>103777</u> .	2' X 6' CATV Handhole	2' X 6' reinforced concrete handhole with "slip-not" grip covers, similar to HTCo type 435TB6 (standard drawing no. <u>34078</u> ), except with "CATV" inscribed on cover. 3 pre-cast concrete pullbox sections shall be required at each pullbox.
6' X 18' HECo Manhole	6' X 18' reinforced concrete manhole with traffic rated cover, provided in accordance with HECo standard drawing No. <u>105260</u> .	4' X 6' CATV Manhole	4' X 6' reinforced concrete manhole with traffic rated frame $\phi$ cover, similar to HTCo standard drawing no. <u>180014</u> , except with "CATV" inscribed on cover.
8'-4" X 7'-8" HECo Transformer Pad Lot	8'-4" X 7'-8" transformer pad lot with reinforced concrete transformer pad $\phi$ ground rod per HECo standard drawing Nos. <u>30-5001</u> $\phi$ <u>011249</u> .		
4' X 4' AT $\phi$ T Manhole	4' X 4' reinforced concrete manhole with traffic rated frame $\phi$ cover, provided in accordance with drawing EF-16.		

Notes:  
If ducts enter handhole/manhole outside of the approved handhole/manhole window, submit the handhole/manhole shop drawing  $\phi$  structural calculations to the respective utility company for approval.

HECo handholes  $\phi$  manholes sized 3'x5' and larger shall be reviewed by HECo prior to ordering and fabrication.

5


ORIGINAL PLAN	SURVEY PLOTTED BY	DATE
NOTE BOOK	DRAWN BY	
No. _____	TRACED BY	
	QUANTITIES BY	
	CHECKED BY	

FILE: Z:\ACAD\PROJECTS\220674\EA06-220674-HECO-NOTES-03.dwg saved July 13, 2022

DRAWING REVIEW

Reviewed for Hawaiian Electric Company Facilities Only  
Req# \_\_\_\_\_ By \_\_\_\_\_ Date \_\_\_\_\_  
Transmission & Distribution Engineering  
Hawaiian Electric

Hawaiian Electric's review of these drawings shall in no way relieve the Customer, its Consultant, its Contractor or anyone acting on the Customer's behalf from the responsibility for engineering, design, materials and any other liability associated with this project including revisions made beyond the reviewed date.

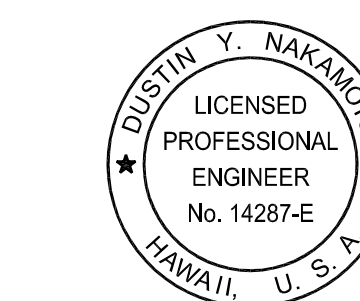

THIS WORK WAS PREPARED BY ME OR UNDER MY SUPERVISION AND CONSTRUCTION OF THIS PROJECT WILL BE UNDER MY OBSERVATION.

Signature: \_\_\_\_\_  
Date: April 30, 2024  
Expiration Date of the License

07/15/22	5 UPDATED EQUIP SCHD NOTES
DATE	REVISION

STATE OF HAWAII  
DEPARTMENT OF TRANSPORTATION  
HIGHWAYS DIVISION

**HAWAIIAN ELECTRIC (HECo) NOTES & EQUIPMENT SCHEDULE**

FARRINGTON HIGHWAY WIDENING  
Kapolei Golf Course Road to Fort Weaver Road  
Project No. 7101A-01-20


Scale: As Shown Date: April 2022



FED. ROAD DIST. NO.	STATE	PROJ. NO.	FISCAL YEAR	SHEET NO.	TOTAL SHEETS
HAWAII	HAW.	710A-01-20	2021	EB-04	790

General Electrical Notes:

1. **Caution!!! Electrical Hazard!!!** Existing HECO overhead and underground lines, are energized and will remain energized during construction unless prior special arrangements have been made with HECO. Only HECO personnel are to handle these energized lines and erect temporary guards to protect these lines from damage. The contractor shall work cautiously at all times to avoid accidents and damage to existing HECO facilities which can result in electrocution.
2. Construct new utility structures & coordinate relocation of respective utility facilities, prior to removal of existing, respectively.
3. See street lighting & traffic signal plans for street lighting & traffic signal work.
4. HECO, HECO & CATV to remove their respective overhead facilities.

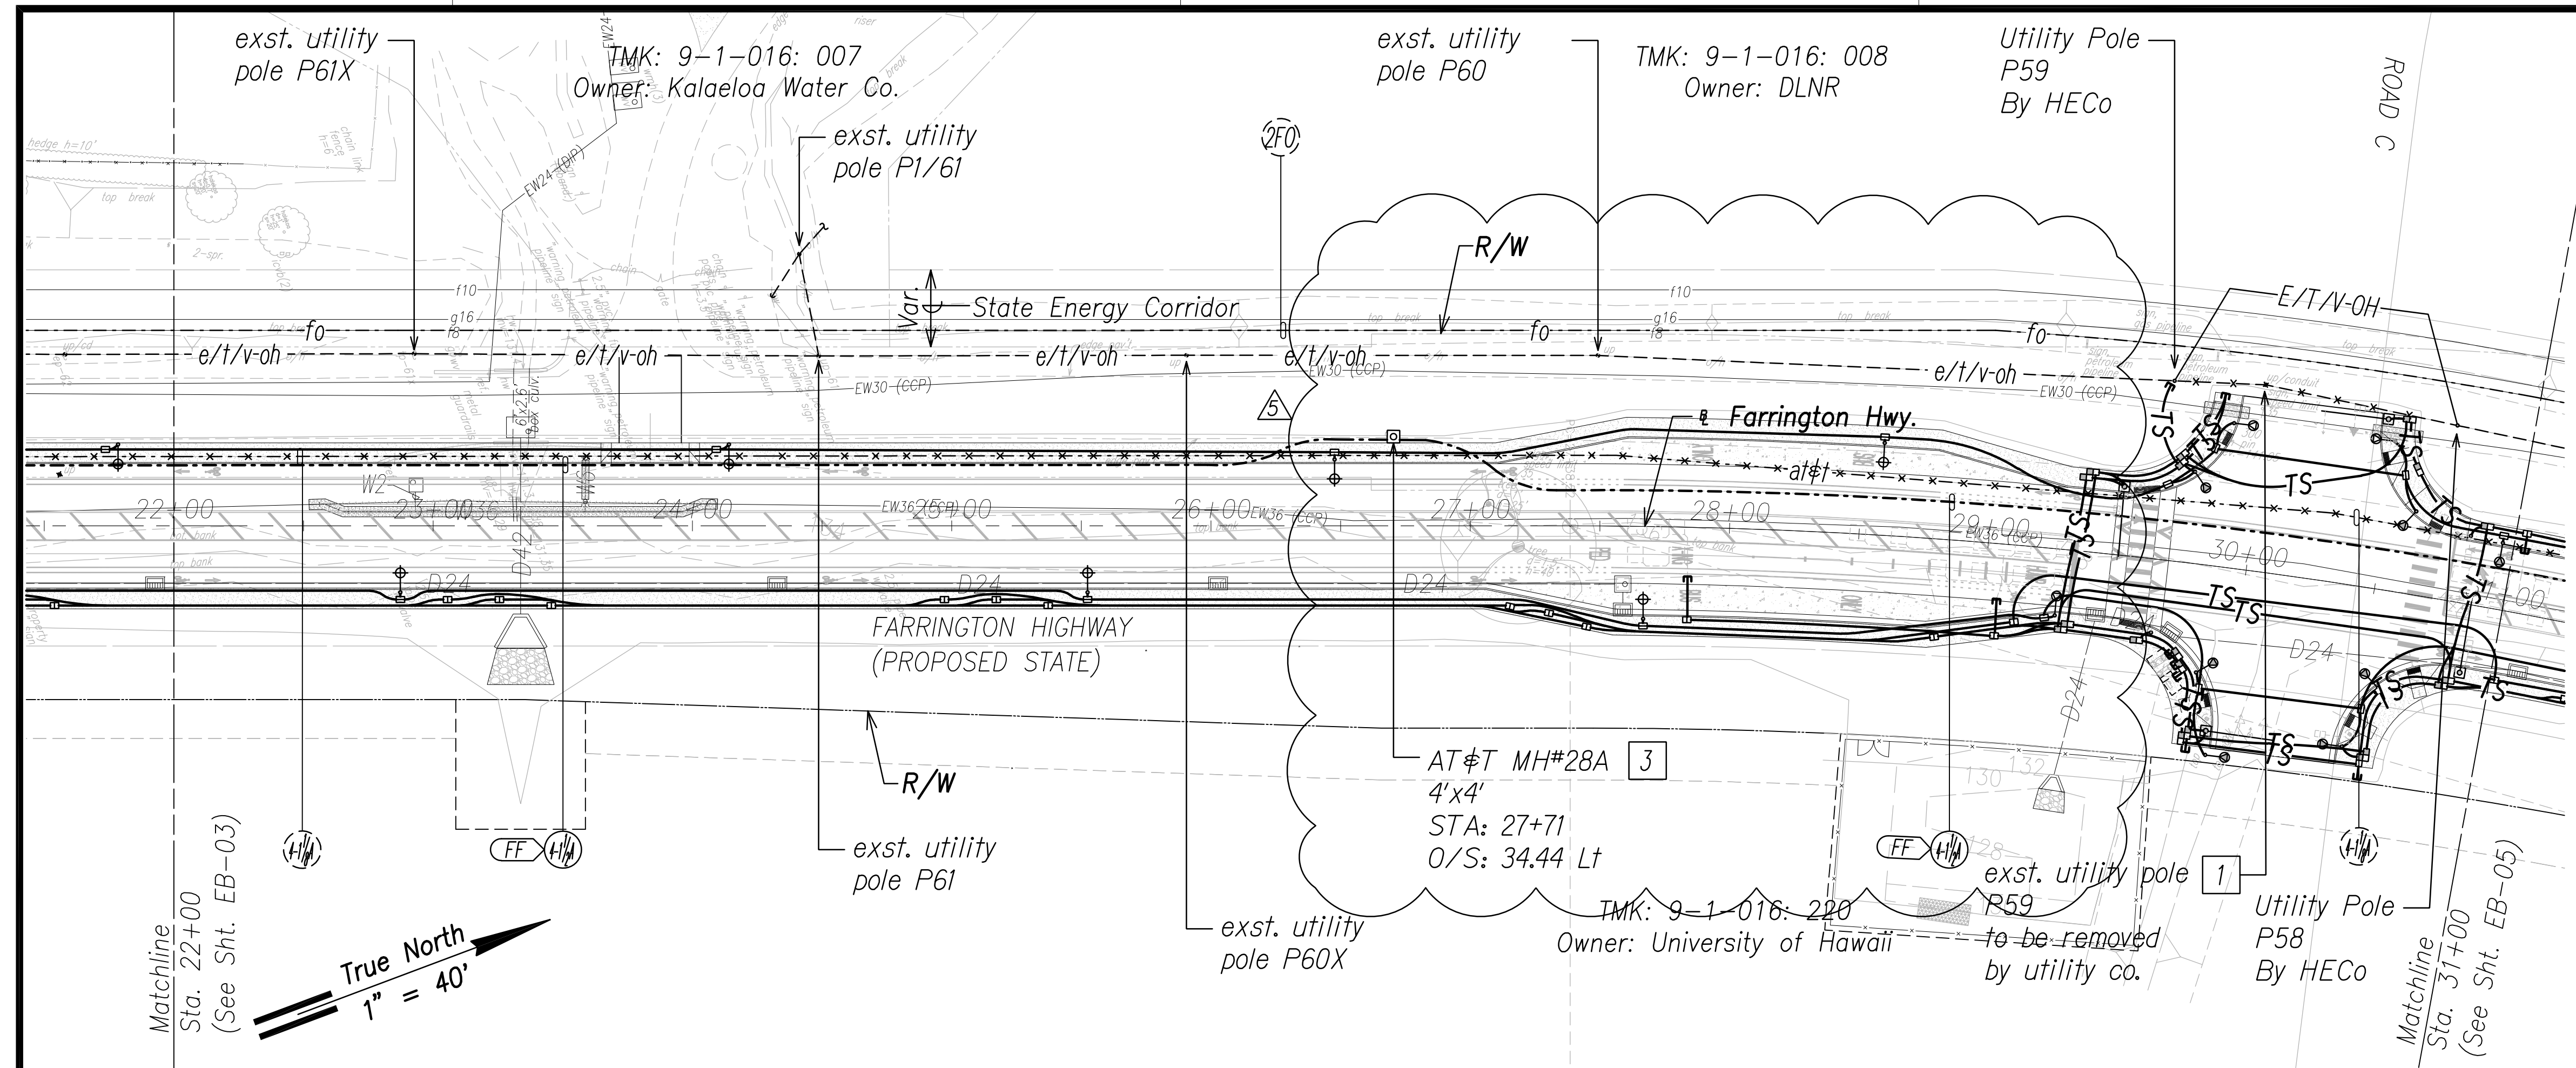



Matchline Sta. 22+00 (See Sht. EB-03)

True North  
1" = 40'

Notes:

- 1 Provide proper bracing/support for exst. utility pole during construction; submit details to respective utility company(s) for approval.
- 2 Excavate & expose exst. duct(s) to intercept with new duct(s). Coordinate and schedule work with AT&T prior to excavation. Repair to match existing.
- 3 Excavate & expose exst. duct(s) to intercept with new manhole. Coordinate and schedule work with AT&T prior to excavation. Provide duct entry for AT&T, per utility co. requirements. Repair to match existing.

**Electrical Plan 4 - (Sta. 22+00 to Sta. 31+00)**  
Scale: 1" = 40'

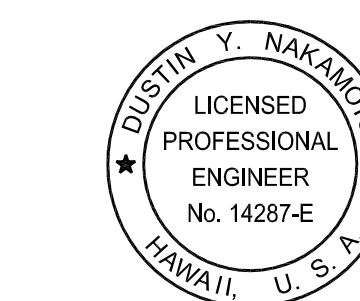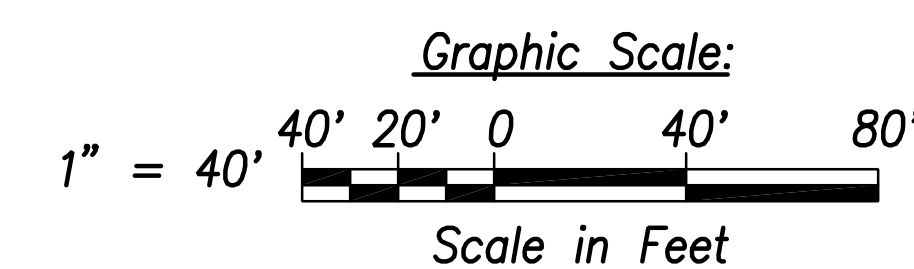

THIS WORK WAS PREPARED BY ME OR UNDER MY SUPERVISION AND CONSTRUCTION OF THIS PROJECT WILL BE UNDER MY OBSERVATION.

SIGNATURE: *[Signature]*  
Date: April 30, 2024  
EXPIRATION DATE OF THE LICENSE

DRAWING REVIEW

Reviewed for Hawaiian Electric Company Facilities Only  
Req# \_\_\_\_\_ By \_\_\_\_\_ Date \_\_\_\_\_  
Transmission & Distribution Engineering  
Hawaiian Electric

Hawaiian Electric's review of these drawings shall in no way relieve the Customer, its Consultant, its Contractor or anyone acting on the Customer's behalf from the responsibility for engineering, design, materials and any other liability associated with this project including revisions made beyond the reviewed date.

07/15/22	ADDED BUS BAYS & BWS CMTS
DATE	REVISION

STATE OF HAWAII  
DEPARTMENT OF TRANSPORTATION  
HIGHWAYS DIVISION

**ELECTRICAL PLAN 4**

FARRINGTON HIGHWAY WIDENING  
Kapolei Golf Course Road to Fort Weaver Road  
Project No. 7101A-01-20

Scale: As Shown Date: April 2022

SHEET No. EB-04 OF 25 SHEETS

SURVEY PLOTTED BY	DATE
DRAWN BY	
TRACED BY	
NOTED BY	
CHECKED BY	
NO.	

FILE: Z:\ACAD\PROJECTS\220671A\EB04\_220671A\_ELEC\_Roadway Plan 4 - Sta. 22+00 to 31+00.dwg saved July 13, 2022






FED. ROAD DIST. NO.	STATE	PROJ. NO.	FISCAL YEAR	SHEET NO.	TOTAL SHEETS
HAWAII	HAW.	710A-01-20	2021	EB-15	790

General Electrical Notes:

1. **Caution!!! Electrical Hazard!!!** Existing HECO overhead and underground lines, are energized and will remain energized during construction unless prior special arrangements have been made with HECO. Only HECO personnel are to handle these energized lines and erect temporary guards to protect these lines from damage. The contractor shall work cautiously at all times to avoid accidents and damage to existing HECO facilities which can result in electrocution.
2. Construct new utility structures & coordinate relocation of respective utility facilities, prior to removal of existing, respectively.
3. See street lighting & traffic signal plans for street lighting & traffic signal work.
4. HECO, HECO & CATV to remove their respective overhead facilities.
5. Coordinate manhole/handhole adjustments with respective utility(s).

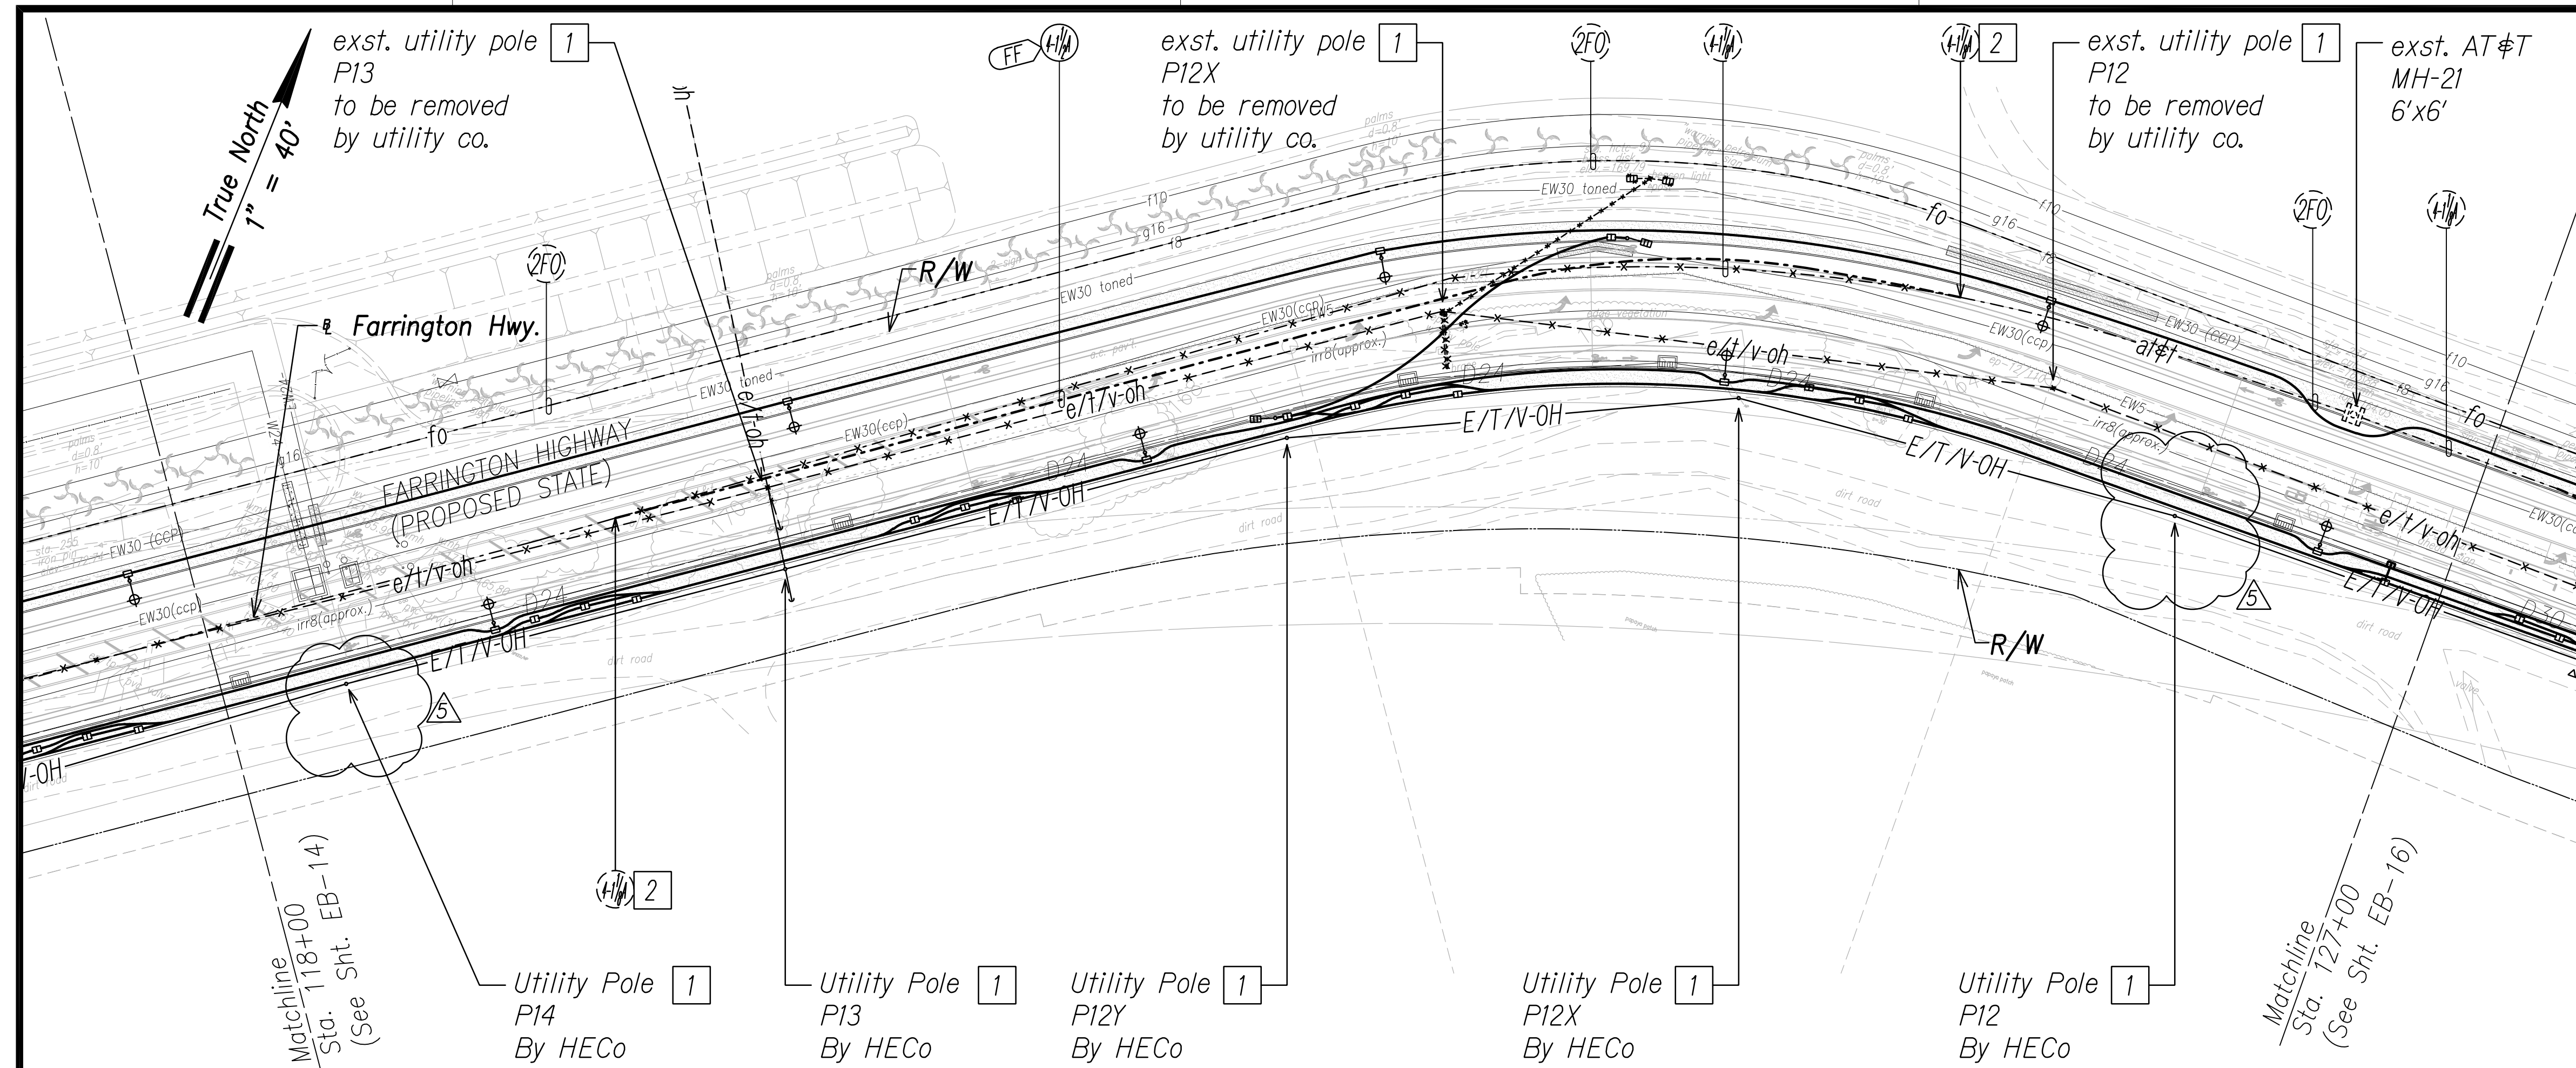

Notes:


1. Provide proper bracing/support for exst. utility pole during construction; submit details to respective utility company(s) for approval.
2. Excavate & expose exst. duct(s) to intercept with new duct(s). Coordinate and schedule work with AT&T prior to excavation. Repair to match existing.

DRAWING REVIEW

Reviewed for Hawaiian Electric Company Facilities Only  
 Req# \_\_\_\_\_ By \_\_\_\_\_ Date \_\_\_\_\_  
 Transmission & Distribution Engineering  
 Hawaiian Electric  
 Hawaiian Electric's review of these drawings shall in no way relieve the Customer, its Consultant, its Contractor or anyone acting on the Customer's behalf from the responsibility for engineering, design, materials and any other liability associated with this project including revisions made beyond the reviewed date.

SURVEY PLOTTED BY _____	DATE _____
DRAWN BY _____	_____
TRACED BY _____	_____
QUANTITIES BY _____	_____
CHECKED BY _____	_____
NO. _____	_____

**Electrical Plan 15 - (Sta. 118+00 to Sta. 127+00)**  
 Scale: 1" = 40'

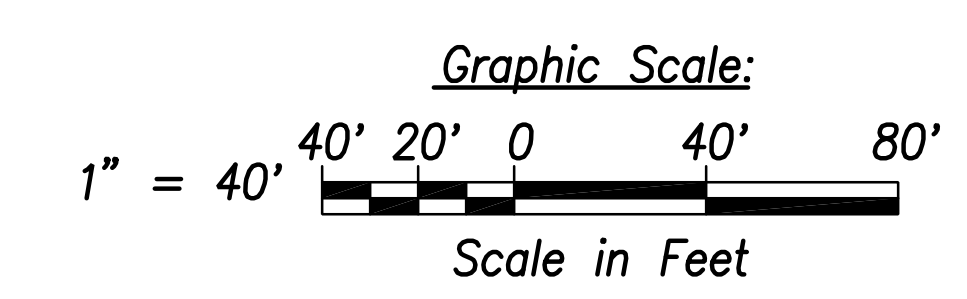



THIS WORK WAS PREPARED BY ME OR UNDER MY SUPERVISION AND CONSTRUCTION OF THIS PROJECT WILL BE UNDER MY OBSERVATION.  
 SIGNATURE \_\_\_\_\_  
 April 30, 2024  
 EXPIRATION DATE OF THE LICENSE

07/15/22	ADJUSTED POLE LOCATIONS
DATE	REVISION
STATE OF HAWAII <b>DEPARTMENT OF TRANSPORTATION</b> HIGHWAYS DIVISION  <b>ELECTRICAL PLAN 15</b>  FARRINGTON HIGHWAY WIDENING Kapolei Golf Course Road to Fort Weaver Road Project No. 7101A-01-20 Scale: As Shown      Date: April 2022	
<b>SHEET No. EB-15 OF 25 SHEETS</b>	





FED. ROAD DIST. NO.	STATE	PROJ. NO.	FISCAL YEAR	SHEET NO.	TOTAL SHEETS
HAWAII	HAW.	710A-01-20	2021	EB-25	790

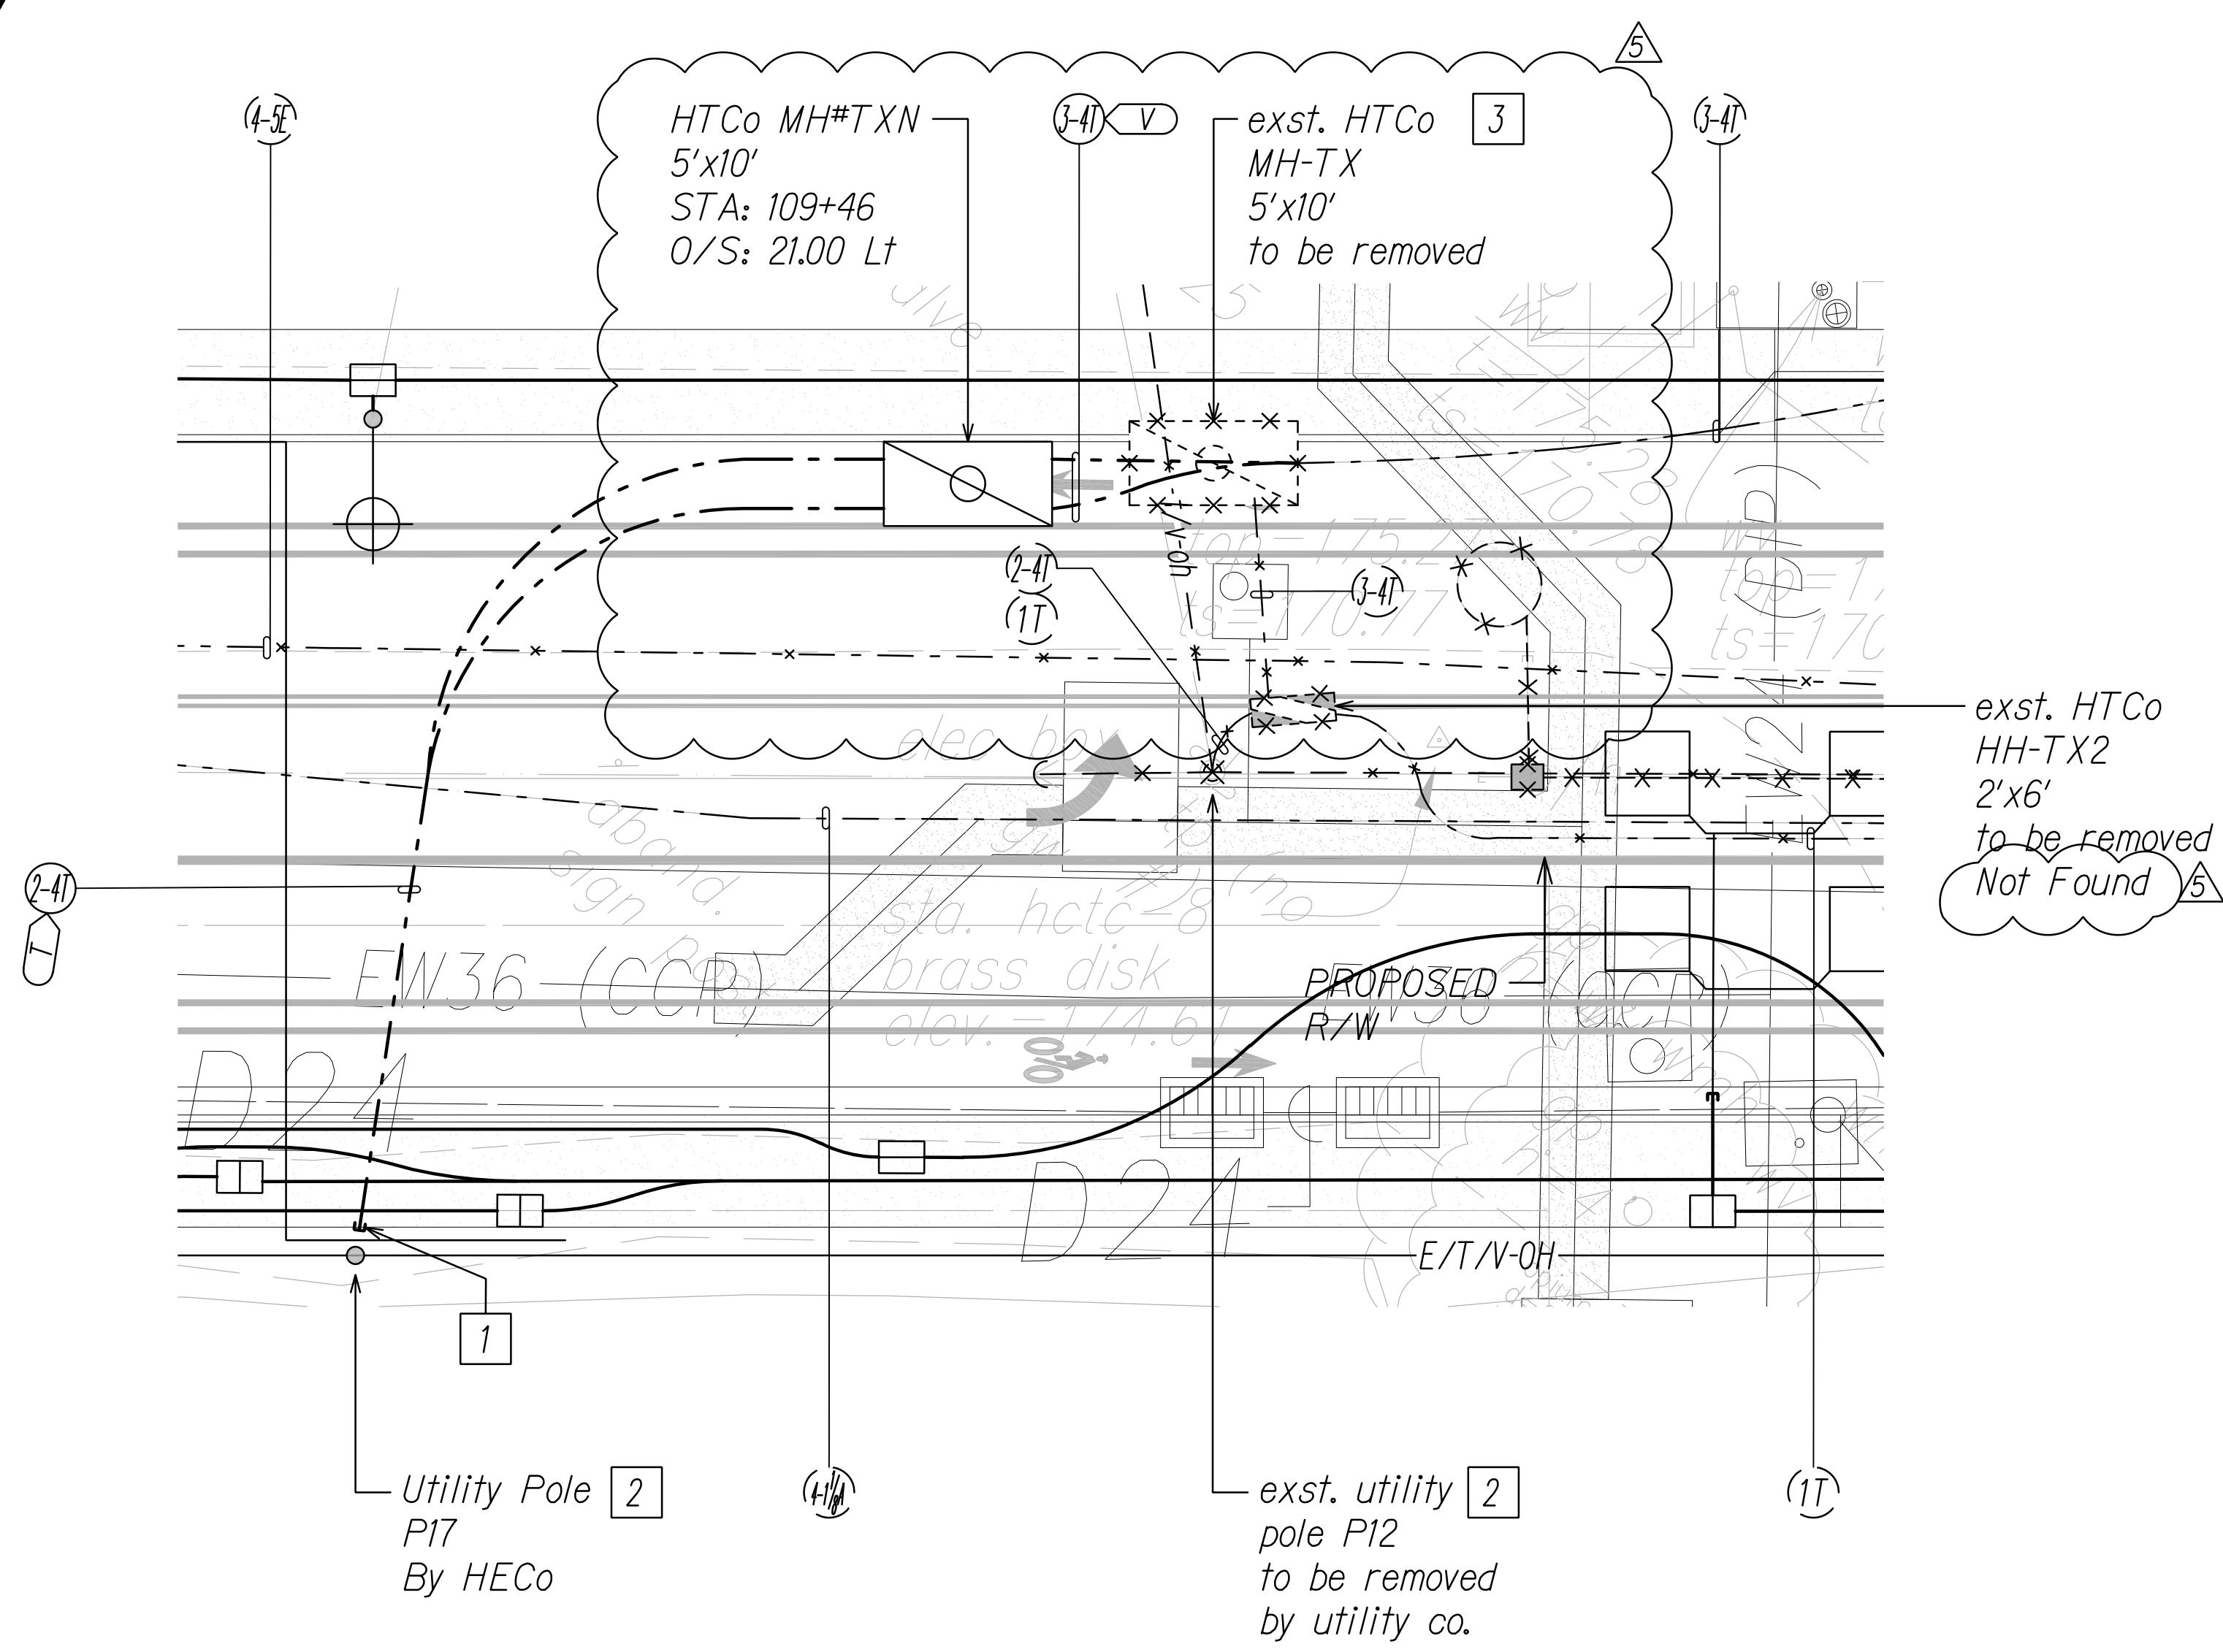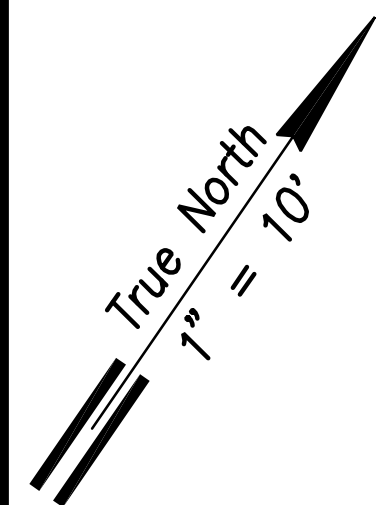



**General Electrical Notes:**

1. **Caution!!! Electrical Hazard!!!** Existing HECO overhead and underground lines, are energized and will remain energized during construction unless prior special arrangements have been made with HECO. Only HECO personnel are to handle these energized lines and erect temporary guards to protect these lines from damage. The contractor shall work cautiously at all times to avoid accidents and damage to existing HECO facilities which can result in electrocution.
2. Construct new utility structures & coordinate relocation of respective utility facilities, prior to removal of existing, respectively.
3. See street lighting & traffic signal plans for street lighting & traffic signal work.
4. HECO, H7Co & CATV to remove their respective overhead facilities.

**Notes:**

- 1 Provide conduit riser(s) up pole per utility company requirements.
- 2 Provide proper bracing/support for exst. utility pole during construction; submit details to respective utility company(s) for approval.
- 3 Excavate & expose exst. manhole wall(s). Coordinate and schedule work with H7Co prior to excavation. Demolish exst. manhole, provide couplings as required & extend duct(s) to exst. Repair to match existing.

**Enlarged Electrical Plan 5**  
Scale: 1" = 10'

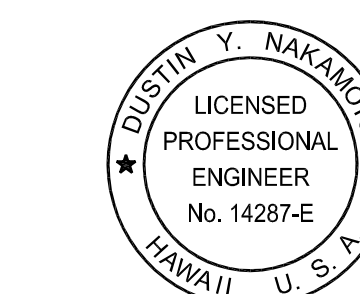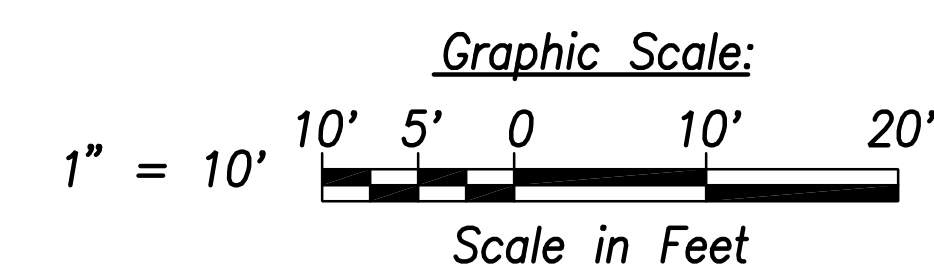

THIS WORK WAS PREPARED BY ME OR UNDER MY SUPERVISION AND CONSTRUCTION OF THIS PROJECT WILL BE UNDER MY OBSERVATION.

Signature: *[Signature]*  
Date: April 30, 2024  
Expiration Date of the License

**DRAWING REVIEW**  
Reviewed for Hawaiian Electric Company Facilities Only  
Req# \_\_\_\_\_ By \_\_\_\_\_ Date \_\_\_\_\_  
Transmission & Distribution Engineering  
Hawaiian Electric  
Hawaiian Electric's review of these drawings shall in no way relieve the Customer, its Consultant, its Contractor or anyone acting on the Customer's behalf from the responsibility for engineering, design, materials and any other liability associated with this project including revisions made beyond the reviewed date.


07/15/22	5	UPDATED DWG
DATE	REVISION	
<b>STATE OF HAWAII DEPARTMENT OF TRANSPORTATION HIGHWAYS DIVISION</b>		
<b>ENLARGED ELECTRICAL PLAN 5</b>		
FARRINGTON HIGHWAY WIDENING Kapolei Golf Course Road to Fort Weaver Road Project No. 7101A-01-20		
Scale: As Shown	Date: April 2022	
<b>SHEET No. EB-25 OF 25 SHEETS</b>		

SURVEY PLOTTED BY	DATE
DRAWN BY	
TRACED BY	
QUANTITIES BY	
CHECKED BY	
ORIGINAL PLAN	No. _____
NOTE BOOK	

FILE: Z:\ACAD\PROJECTS\22067A\EB25\_22067A\_ELEC\_ENLARGED\_PLAN (5.dwg) saved July 13, 2022



FED. ROAD DIST. NO.	STATE	PROJ. NO.	FISCAL YEAR	SHEET NO.	TOTAL SHEETS
HAWAII	HAW.	710A-01-20	2021	ED-01	790

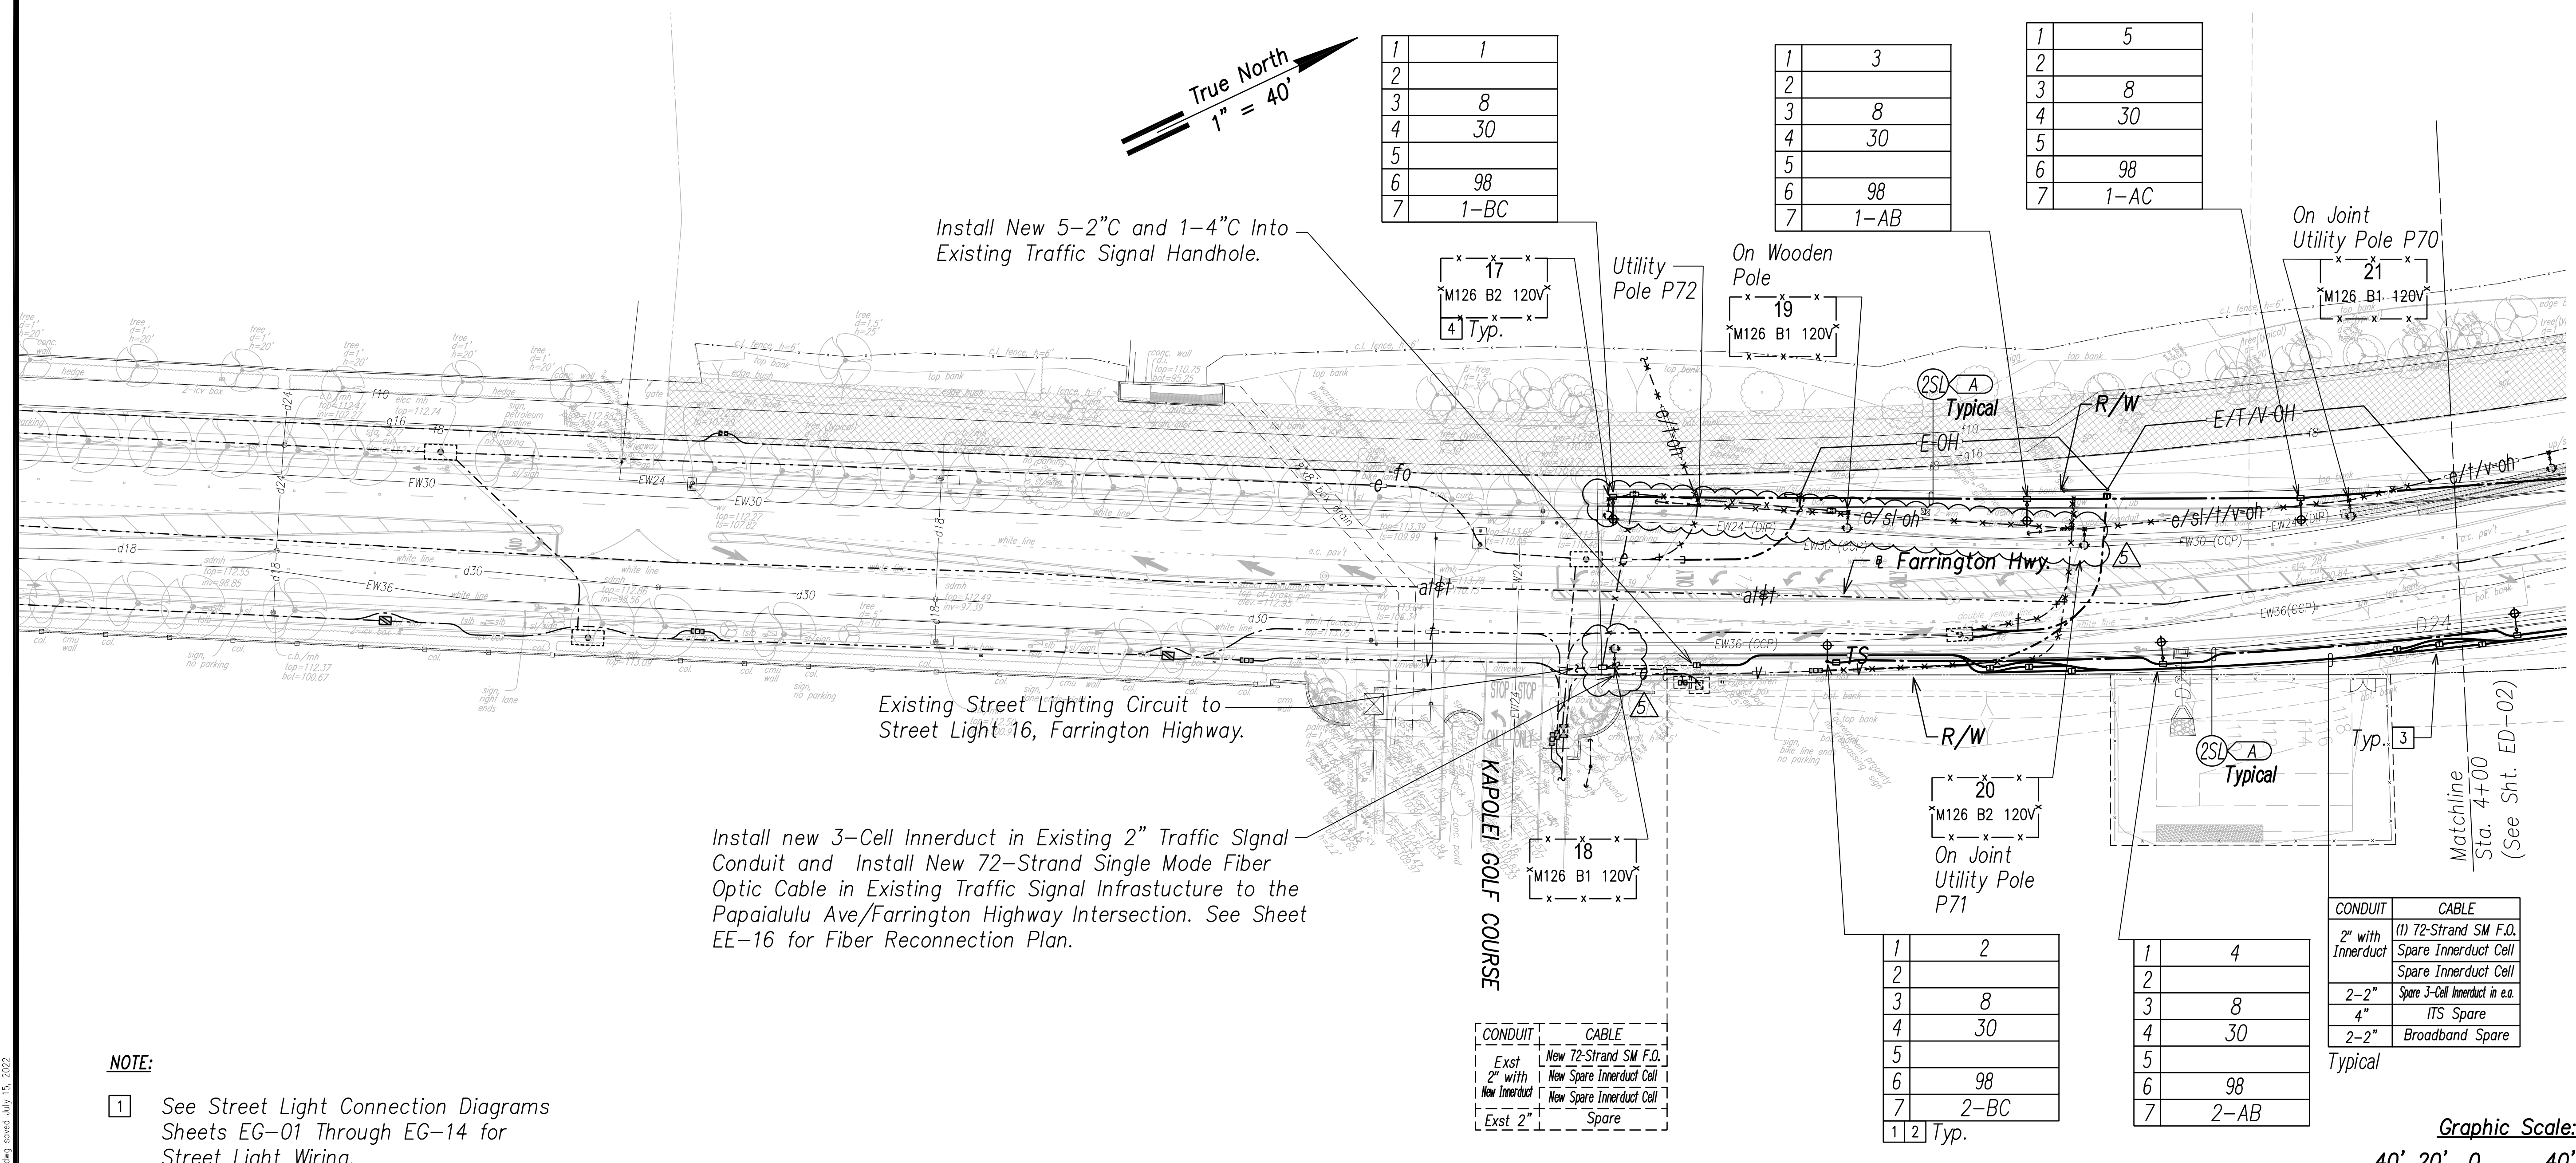

True North  
1" = 40'

1	1
2	
3	8
4	30
5	
6	98
7	1-BC

1	3
2	
3	8
4	30
5	
6	98
7	1-AB

1	5
2	
3	8
4	30
5	
6	98
7	1-AC

Install New 5-2"C and 1-4"C Into Existing Traffic Signal Handhole.

Existing Street Lighting Circuit to Street Light 16, Farrington Highway.

Install new 3-Cell Innerduct in Existing 2" Traffic Signal Conduit and Install New 72-Strand Single Mode Fiber Optic Cable in Existing Traffic Signal Infrastructure to the Papaialulu Ave/Farrington Highway Intersection. See Sheet EE-16 for Fiber Reconnection Plan.

CONDUIT	CABLE
Exst New 2"	New 72-Strand SM F.O.
2" with New Innerduct	New Spare Innerduct Cell
Exst 2"	New Spare Innerduct Cell
	Spare

1	2
2	
3	8
4	30
5	
6	98
7	2-BC
1 2	Typ.

1	4
2	
3	8
4	30
5	
6	98
7	2-AB

CONDUIT	CABLE
2" with Innerduct	(1) 72-Strand SM F.O. Spare Innerduct Cell
2-2"	Spare Innerduct Cell
4"	Spare 3-Cell Innerduct in e.a.
2-2"	ITS Spare
	Broadband Spare


Typical

**NOTE:**


- 1 See Street Light Connection Diagrams Sheets EG-01 Through EG-14 for Street Light Wiring.
- 2 See Sheet EG-18 for State Highway Light ID Tag Indicator Legend
- 3 Typical Handhole Grouping. See Sheet EG-15 for Details.
- 4 Salvage and Return All Removed Equipment to C&C DFM as Directed by Street Light Inspector.
- 5 All Traffic Signal Conduits to be in Minimum 3" Concrete Encasement.

SURVEY PLOTTED BY	DATE
DRAWN BY	
TRACED BY	
QUANTITIES BY	
CHECKED BY	
ORIGINAL PLAN	
NOTE BOOK	
No.	

FILE: Z:\MCAO\PROJECTS\220674\ED01-220674-SLTS\_Boarding Plan 1 - Sta. -5+00 to +4+00.dwg saved July 15, 2022

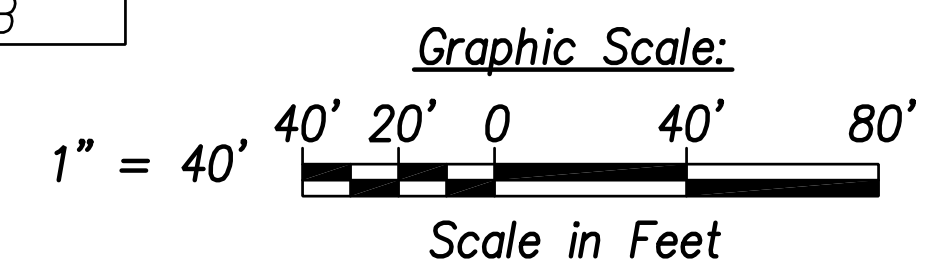

**Street Light & Traffic Signal Plan 1 - (Sta. -5+00 to Sta. 4+00)**  
Scale: 1" = 40'

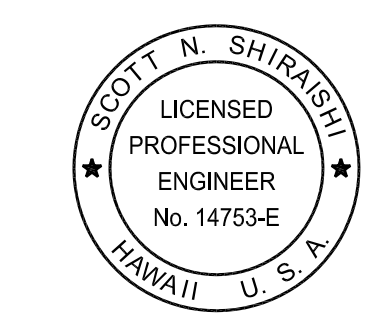

THIS WORK WAS PREPARED BY ME OR UNDER MY SUPERVISION AND CONSTRUCTION OF THIS PROJECT WILL BE UNDER MY OBSERVATION.

APPROVED BY  
PROGRAM ADMINISTRATOR, MECHANICAL/ELECTRICAL DIVISION DATE  
DEPT. OF DESIGN AND CONSTRUCTION  
CITY & COUNTY OF HONOLULU

Signature: Scott Shirasishi  
April 30, 2024  
SIGNATURE EXPIRATION DATE OF THE LICENSE

07/15/22	REVISED NOTE AND SYMBOLS
DATE	REVISION

STATE OF HAWAII  
DEPARTMENT OF TRANSPORTATION  
HIGHWAYS DIVISION



**STREET LIGHT & TRAFFIC SIGNAL PLAN 1**

FARRINGTON HIGHWAY WIDENING  
Kapolei Golf Course Road to Fort Weaver Road  
Project No. 7101A-01-20

Scale: As Shown Date: April 2022

**SHEET No. ED-01 OF 35 SHEETS**

FED. ROAD DIST. NO.	STATE	PROJ. NO.	FISCAL YEAR	SHEET NO.	TOTAL SHEETS
HAWAII	HAW.	710A-01-20	2021	ED-02	790

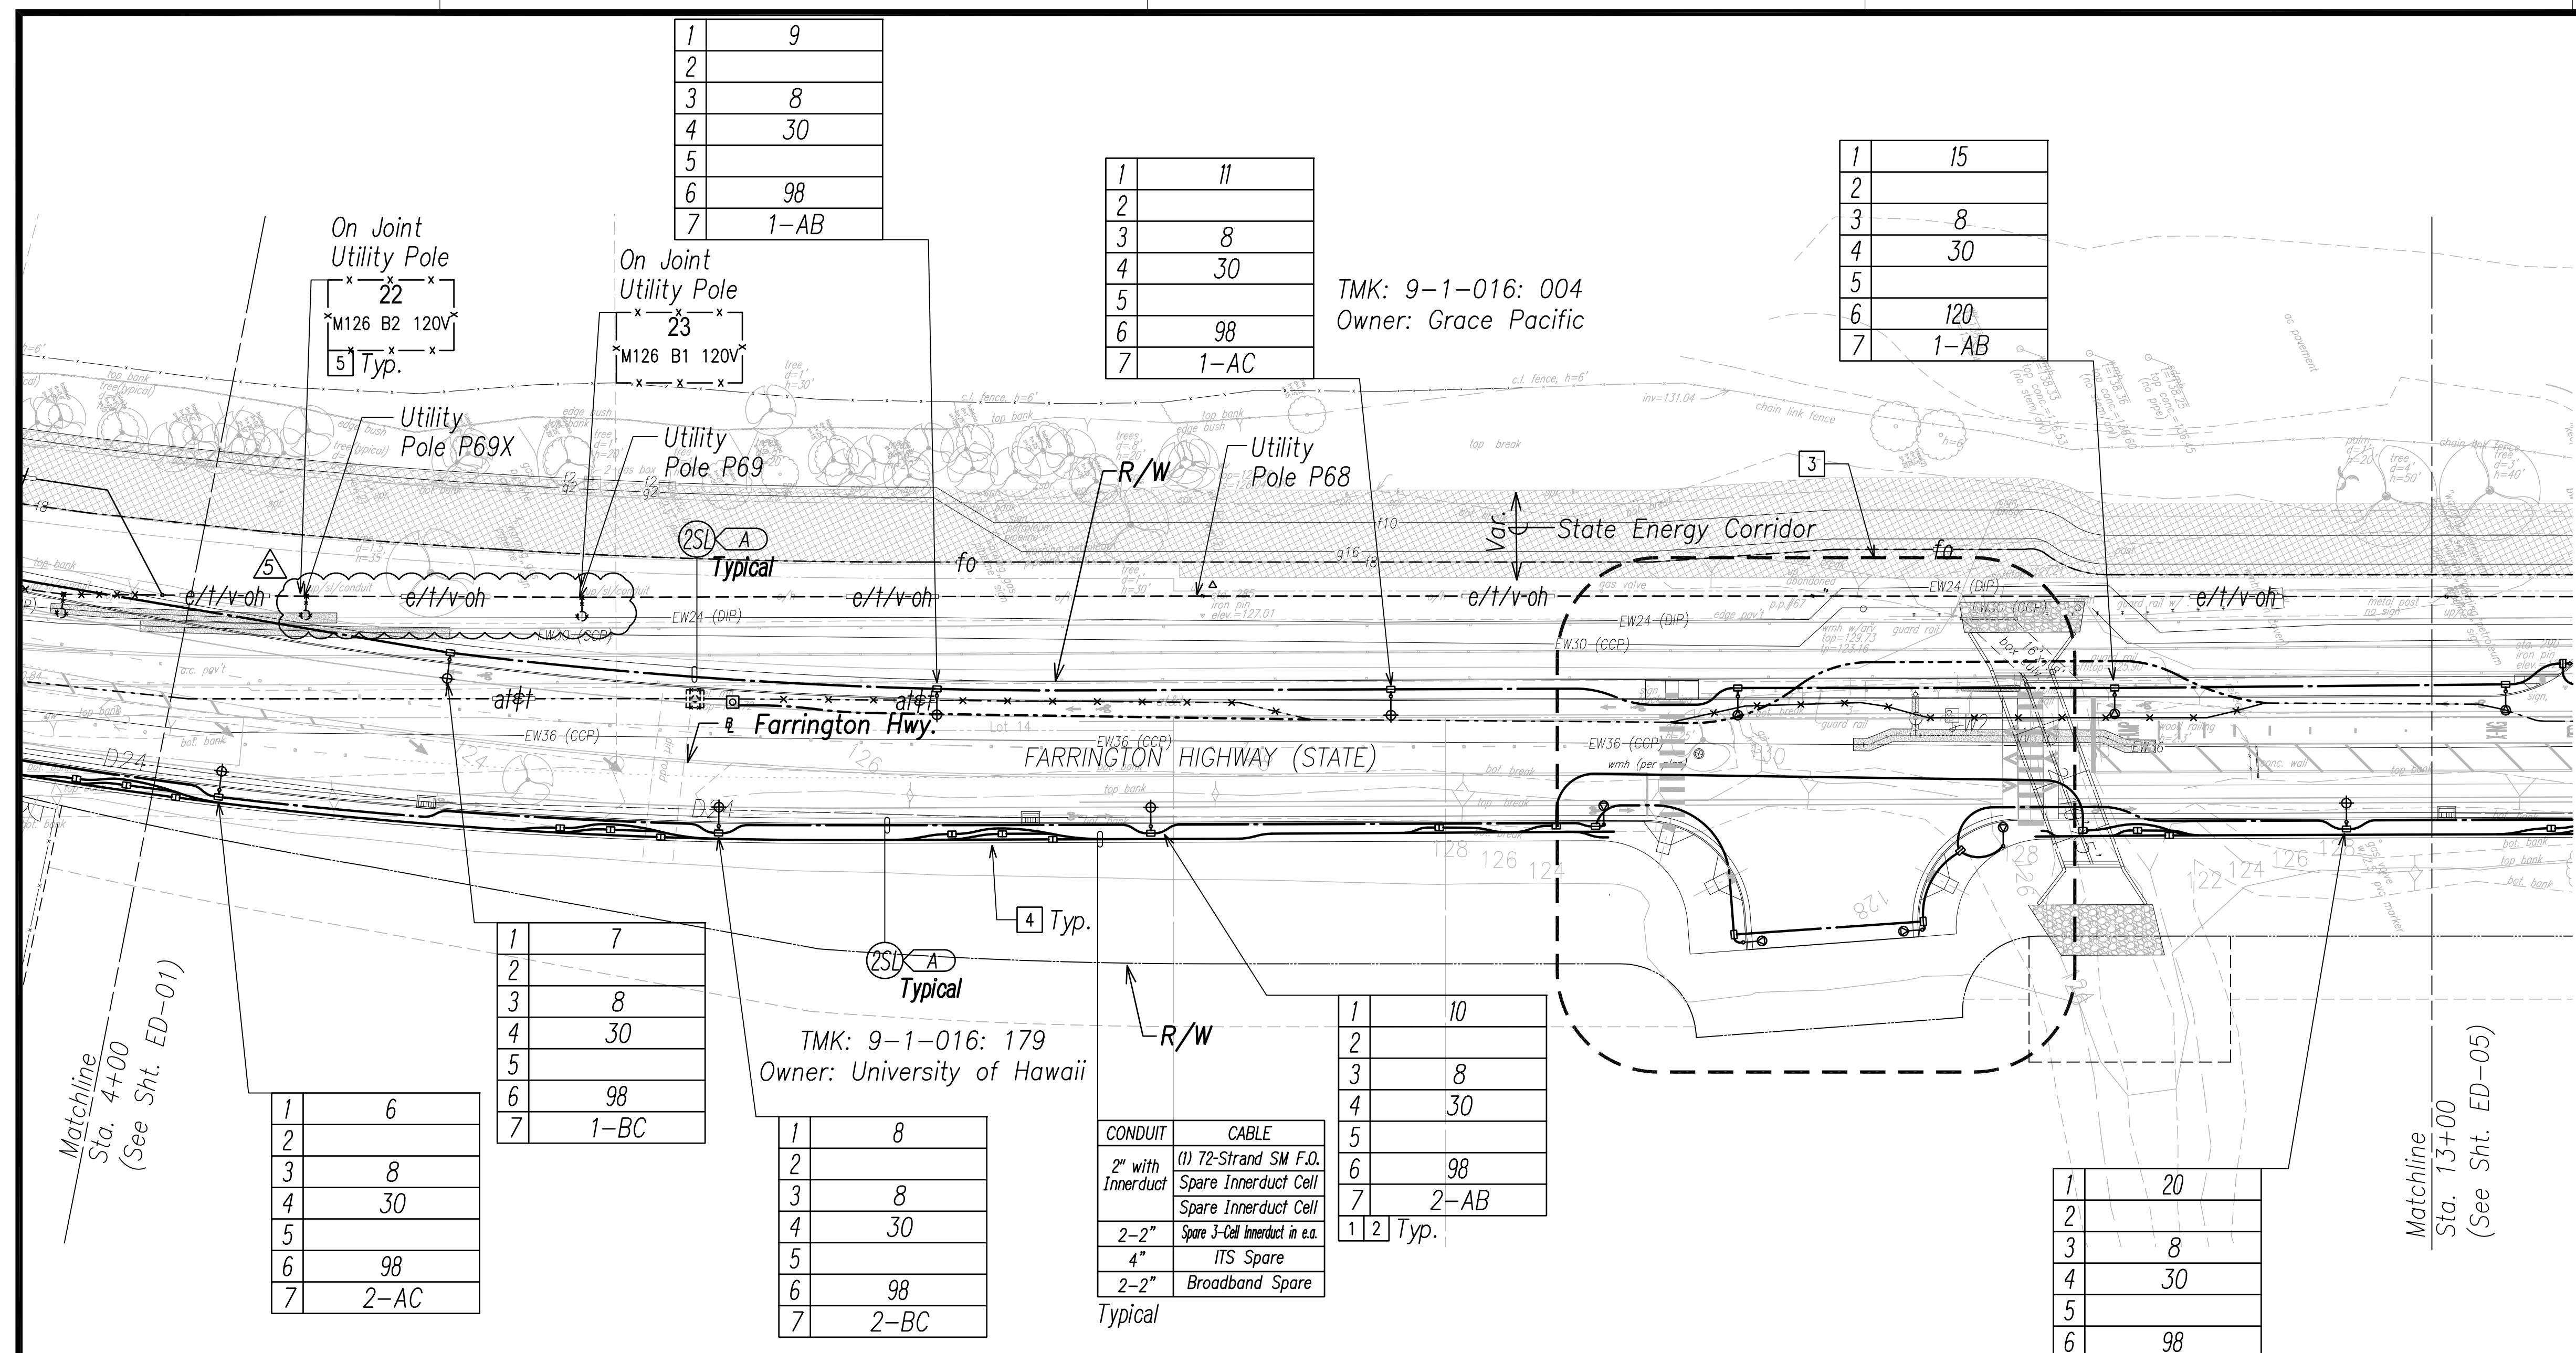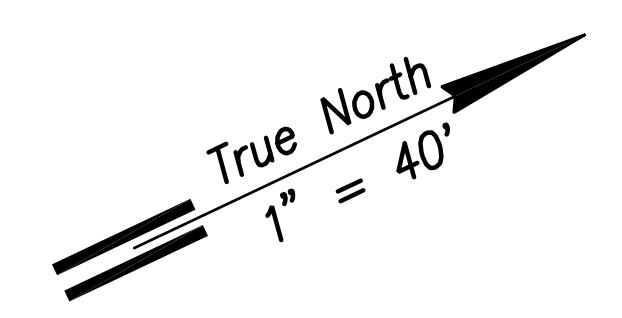

**NOTE:**

- 1 See Street Light Connection Diagrams Sheets EG-01 Through EG-14 for Street Light Wiring.
- 2 See Sheet EG-18 for State Highway Light ID Tag Indicator Legend.
- 3 See Enlarged Plan Sheet ED-03.
- 4 Typical Handhole Grouping. See Sheet EG-15 for Details.
- 5 Salvage and Return All Removed Equipment to C&C DFM as Directed by Street Light Inspector.
- 6 All Traffic Signal Conduits to be in Minimum 3" Concrete Encasement.



**Street Light & Traffic Signal Plan 2 - (Sta. 4+00 to Sta. 13+00)**  
 Scale: 1" = 40'

SURVEY PLOTTED BY	DATE
DRAWN BY	
TRACED BY	
QUANTITIES BY	
CHECKED BY	
ORIGINAL PLAN	
NOTE BOOK	
No.	

FILE: Z:\Mcd\Projects\220679A\_ED02\_220679A\_SLS\_Roadway\_Plan 2 - Sta. 4+00 to 13+00.dwg saved July 15, 2022

CONDUIT	CABLE
2" with Innerduct	(1) 72-Strand SM F.O. Spare Innerduct Cell Spare Innerduct Cell
2-2"	Spare 3-Cell Innerduct in e.a.
4"	ITS Spare
2-2"	Broadband Spare

Typical

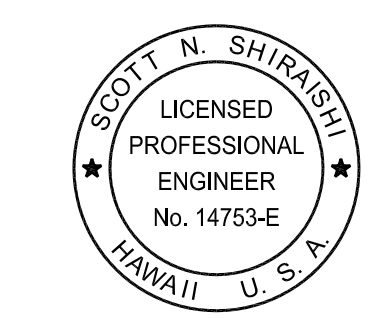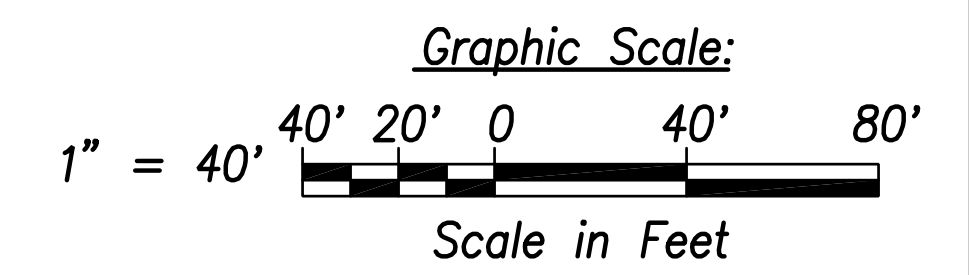

THIS WORK WAS PREPARED BY ME OR UNDER MY SUPERVISION AND CONSTRUCTION OF THIS PROJECT WILL BE UNDER MY OBSERVATION.

APPROVED BY  
 PROGRAM ADMINISTRATOR, MECHANICAL/ELECTRICAL DIVISION DATE  
 DEPT. OF DESIGN AND CONSTRUCTION  
 CITY & COUNTY OF HONOLULU

Scott Shirasaki  
 SIGNATURE April 30, 2022  
 EXPIRATION DATE OF THE LICENSE

07/15/22	REVISED NOTE AND SYMBOLS
DATE	REVISION

STATE OF HAWAII  
 DEPARTMENT OF TRANSPORTATION  
 HIGHWAYS DIVISION

**STREET LIGHT & TRAFFIC SIGNAL  
 PLAN 2**

FARRINGTON HIGHWAY WIDENING  
 Kapolei Golf Course Road to Fort Weaver Road  
 Project No. 7101A-01-20



Scale: As Shown Date: April 2022

**SHEET No. ED-02 OF 35 SHEETS**


ADD. 613



FED. ROAD DIST. NO.	STATE	PROJ. NO.	FISCAL YEAR	SHEET NO.	TOTAL SHEETS
HAWAII	HAW.	710A-01-20	2021	ED-06	790

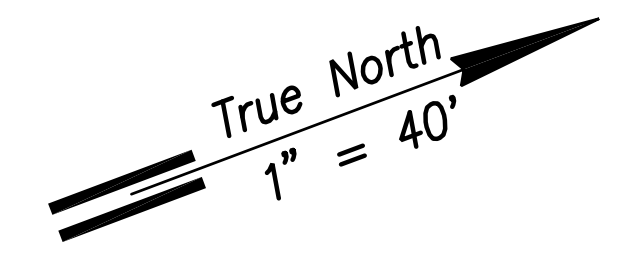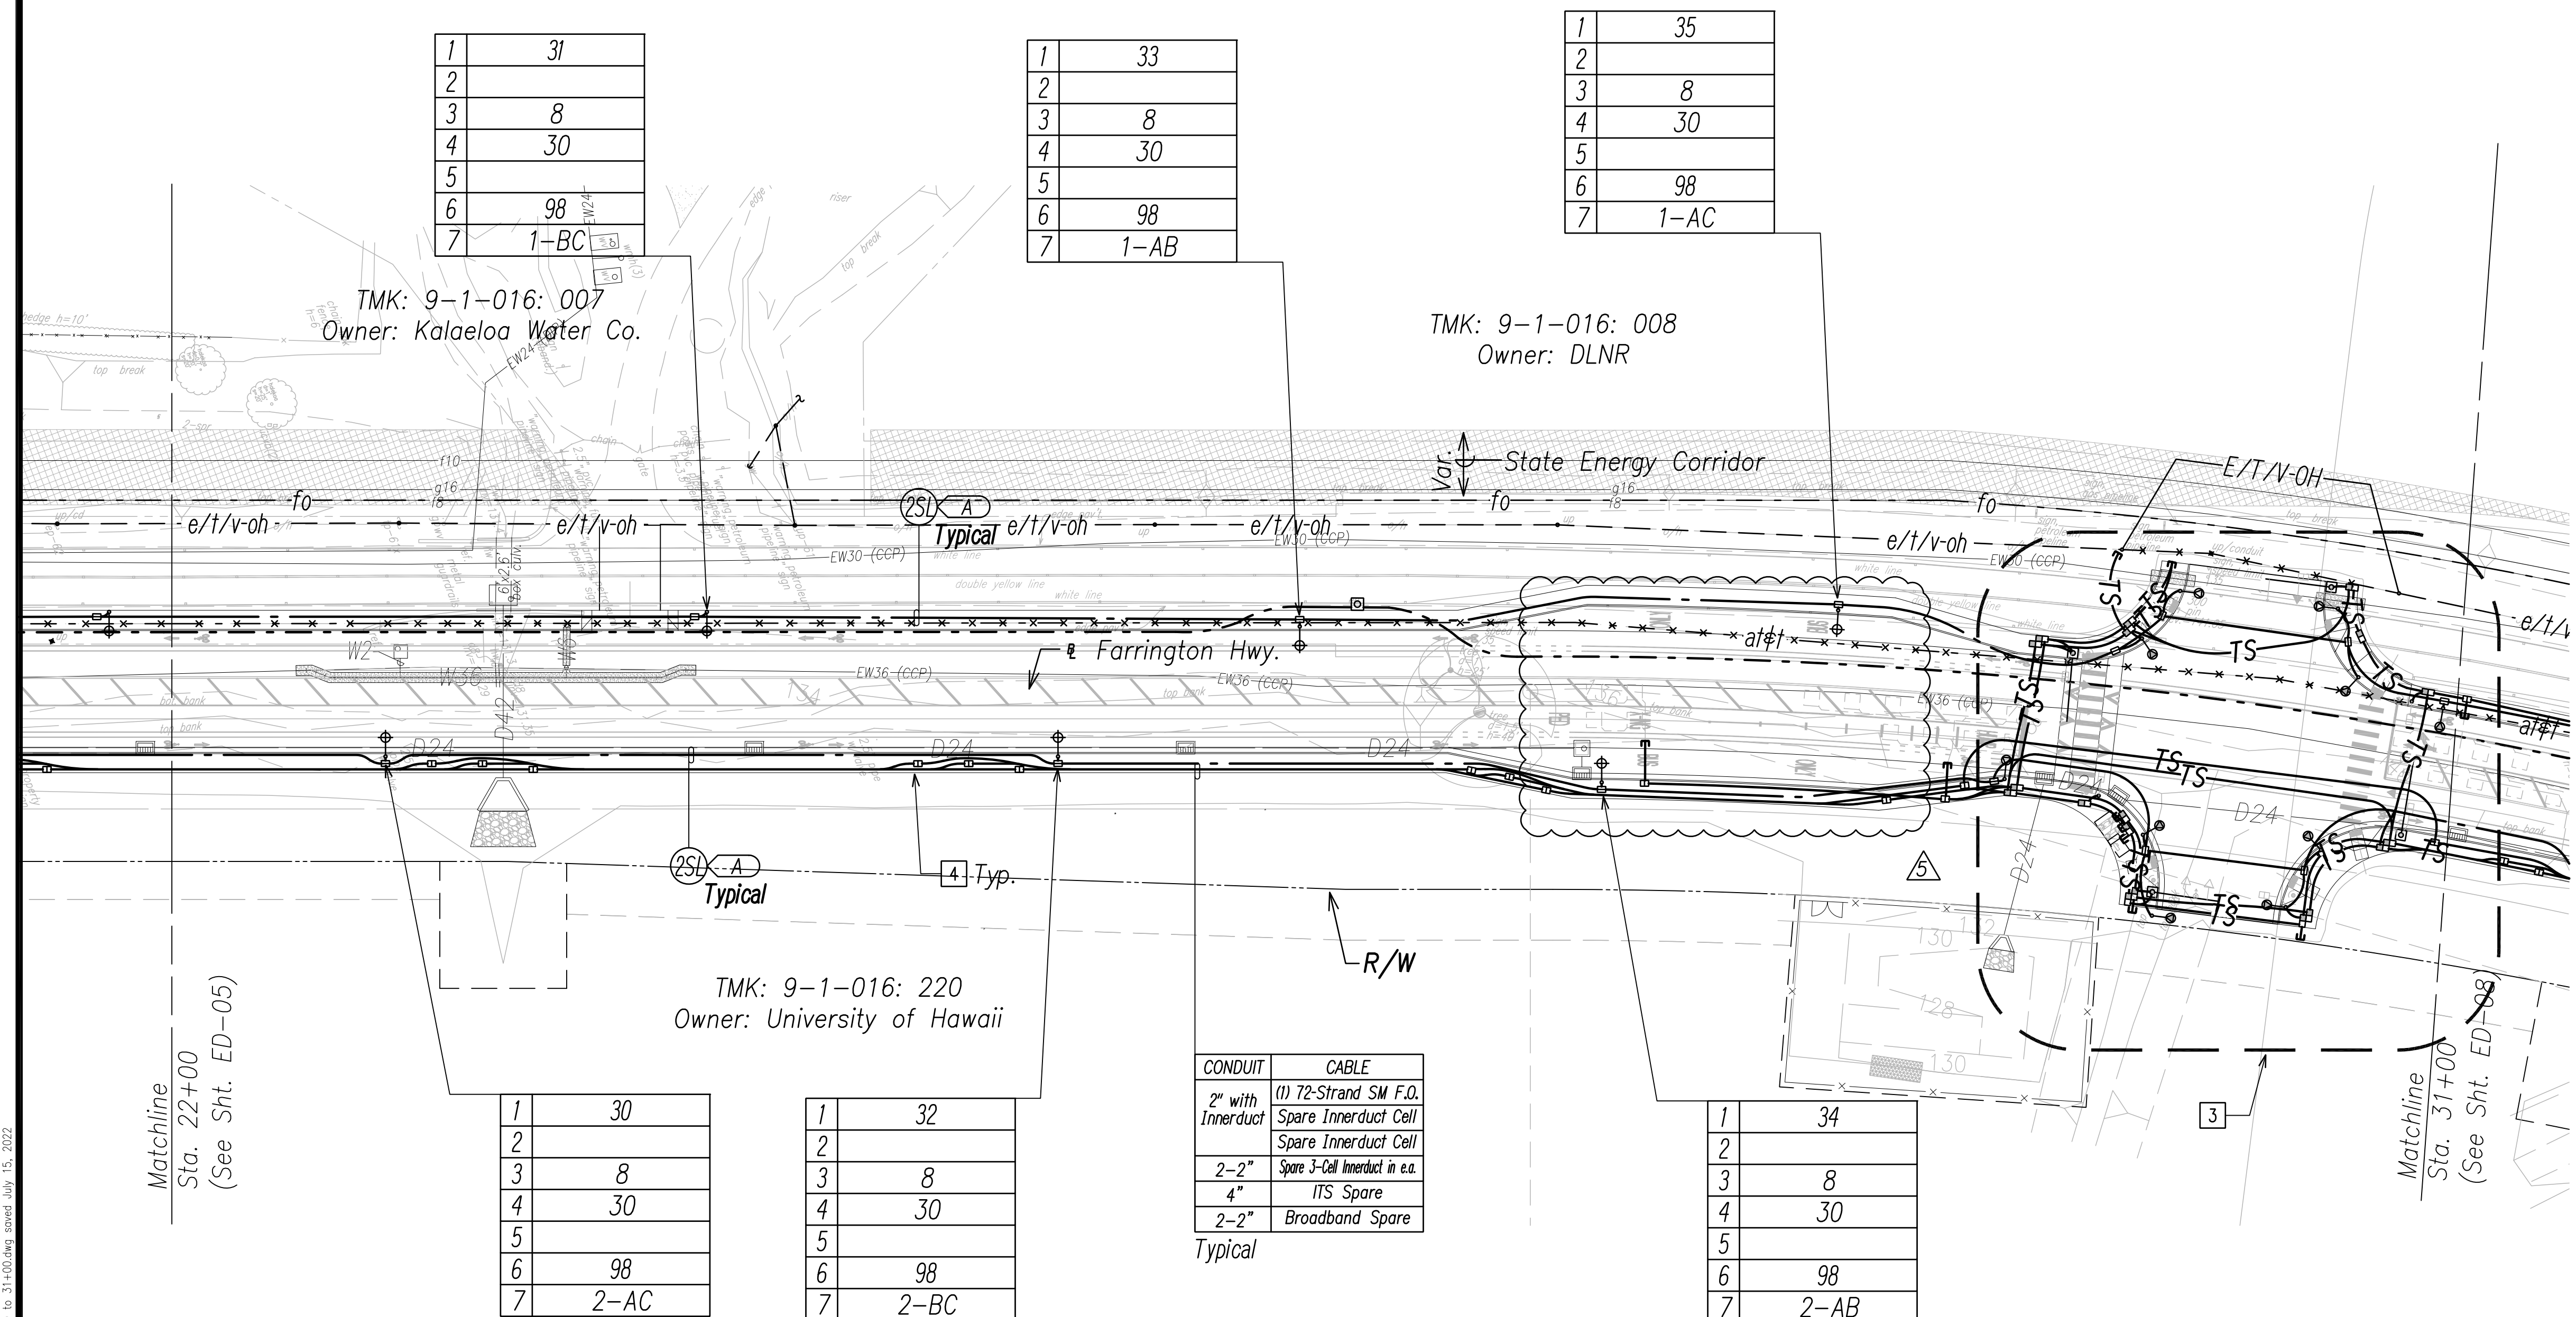

- NOTE:**
- See Street Light Connection Diagrams Sheets EG-01 Through EG-14 for Street Light Wiring.
  - See Sheet EG-18 for State Highway Light ID Tag Indicator Legend
  - See Enlarged Plan Sheet ED-07
  - Typical Handhole Grouping. See Sheet EG-15 for Details.
  - All Traffic Signal Conduits to be in Minimum 3" Concrete Encasement.

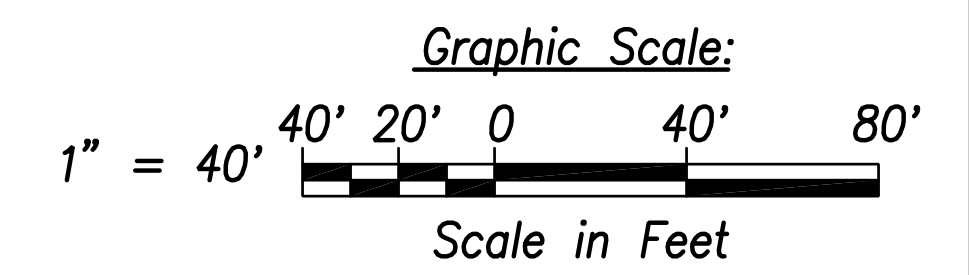

SURVEY PLOTTED BY	DATE
DRAWN BY	
TRACED BY	
QUANTITIES BY	
CHECKED BY	
ORIGINAL PLAN	
NOTE BOOK	
No.	

FILE: Z:\Acad\Projects\220677A\ED06\_220677A\_SITS\_Roadway\_Plan 6 - Sta. 22+00 to 31+00.dwg saved July 15, 2022

1	31
2	
3	8
4	30
5	
6	98
7	1-BC

1	33
2	
3	8
4	30
5	
6	98
7	1-AB

1	35
2	
3	8
4	30
5	
6	98
7	1-AC


1	30
2	
3	8
4	30
5	
6	98
7	2-AC

1	32
2	
3	8
4	30
5	
6	98
7	2-BC
1 2	Typ.

CONDUIT	CABLE
2" with Innerduct	(1) 72-Strand SM F.O. Spare Innerduct Cell Spare Innerduct Cell
2-2"	Spare 3-Cell Innerduct in e.a.
4"	ITS Spare
2-2"	Broadband Spare

Typical

1	34
2	
3	8
4	30
5	
6	98
7	2-AB

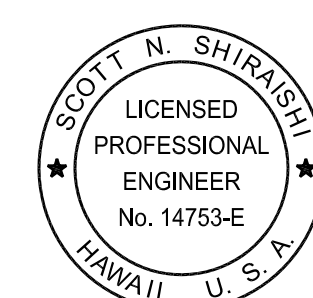

THIS WORK WAS PREPARED BY ME OR UNDER MY SUPERVISION AND CONSTRUCTION OF THIS PROJECT WILL BE UNDER MY OBSERVATION.

Signature: Scott Shirasishi  
 Date: April 30, 2024  
 EXPIRATION DATE OF THE LICENSE

07/15/22	REVISED LOCATIONS
DATE	REVISION

**STATE OF HAWAII**  
**DEPARTMENT OF TRANSPORTATION**  
**HIGHWAYS DIVISION**  
**STREET LIGHT & TRAFFIC SIGNAL**  
**PLAN 6**  
 FARRINGTON HIGHWAY WIDENING  
 Kapolei Golf Course Road to Fort Weaver Road  
 Project No. 7101A-01-20


Scale: As Shown      Date: April 2022

**SHEET No. ED-06 OF 35 SHEETS**

**Street Light & Traffic Signal Plan 6 - (Sta. 22+00 to Sta. 31+00)**  
 Scale: 1" = 40'



FED. ROAD DIST. NO.	STATE	PROJ. NO.	FISCAL YEAR	SHEET NO.	TOTAL SHEETS
HAWAII	HAW.	710A-01-20	2021	ED-24	790

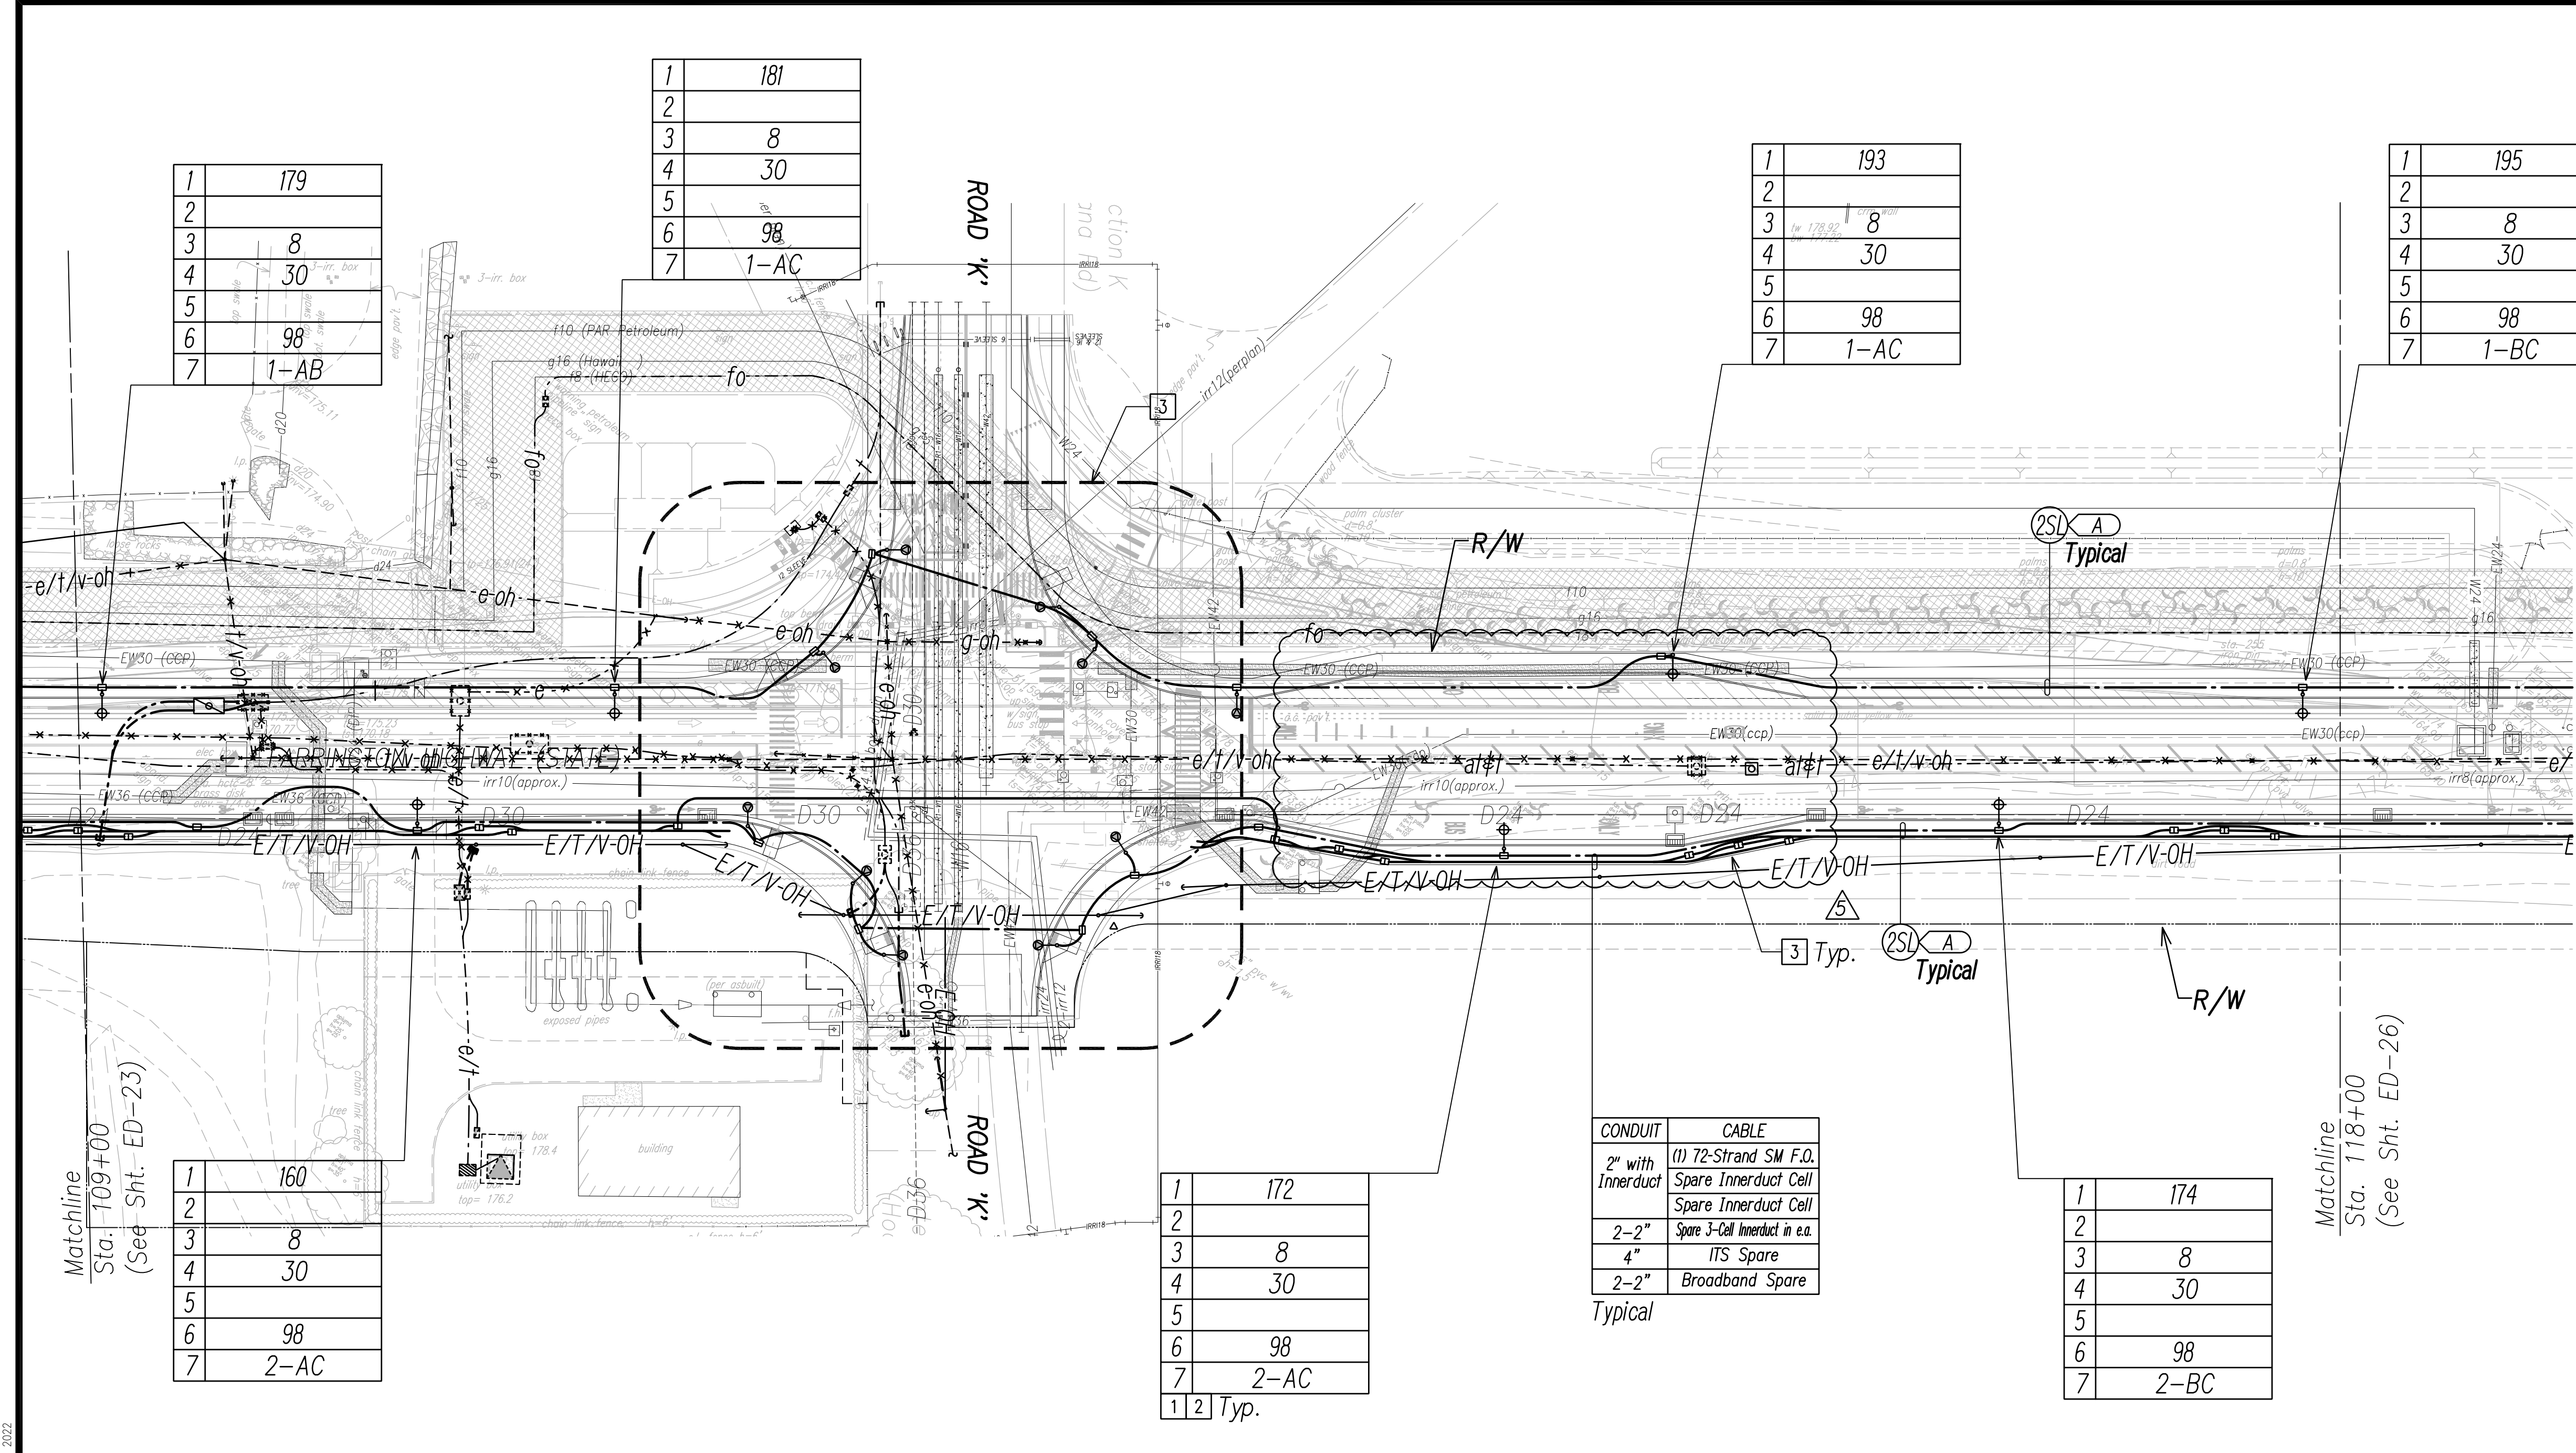

1	179
2	
3	8
4	30
5	
6	98
7	1-AB

1	181
2	
3	8
4	30
5	
6	98
7	1-AC

1	193
2	
3	8
4	30
5	
6	98
7	1-AC

1	195
2	
3	8
4	30
5	
6	98
7	1-BC

1	160
2	
3	8
4	30
5	
6	98
7	2-AC

1	172
2	
3	8
4	30
5	
6	98
7	2-AC
1 2	Typ.


1	174
2	
3	8
4	30
5	
6	98
7	2-BC

CONDUIT	CABLE
2" with Innerduct	(1) 72-Strand SM F.O. Spare Innerduct Cell Spare Innerduct Cell
2-2"	Spare 3-Cell Innerduct in e.a.
4"	ITS Spare
2-2"	Broadband Spare

Typical

**NOTE:**

- 1 See Street Light Connection Diagrams Sheets EG-01 Through EG-14 for Street Light Wiring.
- 2 See Sheet EG-18 for State Highway Light ID Tag Indicator Legend
- 3 See Enlarged Plan Sheet ED-25
- 4 Typical Handhole Grouping. See Sheet EG-15 for Details.
5. All Traffic Signal Conduits to be in Minimum 3" Concrete Encasement.

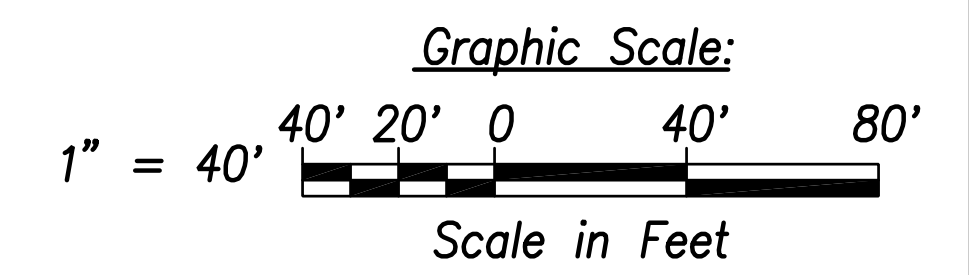

SURVEY PLOTTED BY	DATE
DRAWN BY	
TRACED BY	
QUANTITIES BY	
CHECKED BY	
ORIGINAL PLAN	
NOTE BOOK	
No.	

FILE: Z:\Mcd\Projects\220067H\ED24\_220067H\_SITS\_Roadway\_Plan\_24 - Sta. 109+00 to 118+00.dwg, saved July 15, 2022

**Street Light & Traffic Signal Plan 24 - (Sta. 109+00 to Sta. 118+00)**  
Scale: 1" = 40'



THIS WORK WAS PREPARED BY ME OR UNDER MY SUPERVISION AND CONSTRUCTION OF THIS PROJECT WILL BE UNDER MY OBSERVATION.  
*Scott Shirasishi*  
SIGNATURE April 30, 2024  
EXPIRATION DATE OF THE LICENSE

07/15/22	REVISED NOTE AND SYMBOLS
DATE	REVISION

STATE OF HAWAII  
DEPARTMENT OF TRANSPORTATION  
HIGHWAYS DIVISION

**STREET LIGHT & TRAFFIC SIGNAL  
PLAN 24**

FARRINGTON HIGHWAY WIDENING  
Kapolei Golf Course Road to Fort Weaver Road  
Project No. 7101A-01-20


Scale: As Shown Date: April 2022

**SHEET No. ED-24 OF 35 SHEETS**

ADD. 635



FED. ROAD DIST. NO.	STATE	PROJ. NO.	FISCAL YEAR	SHEET NO.	TOTAL SHEETS
HAWAII	HAW.	710A-01-20	2021	ED-32	790

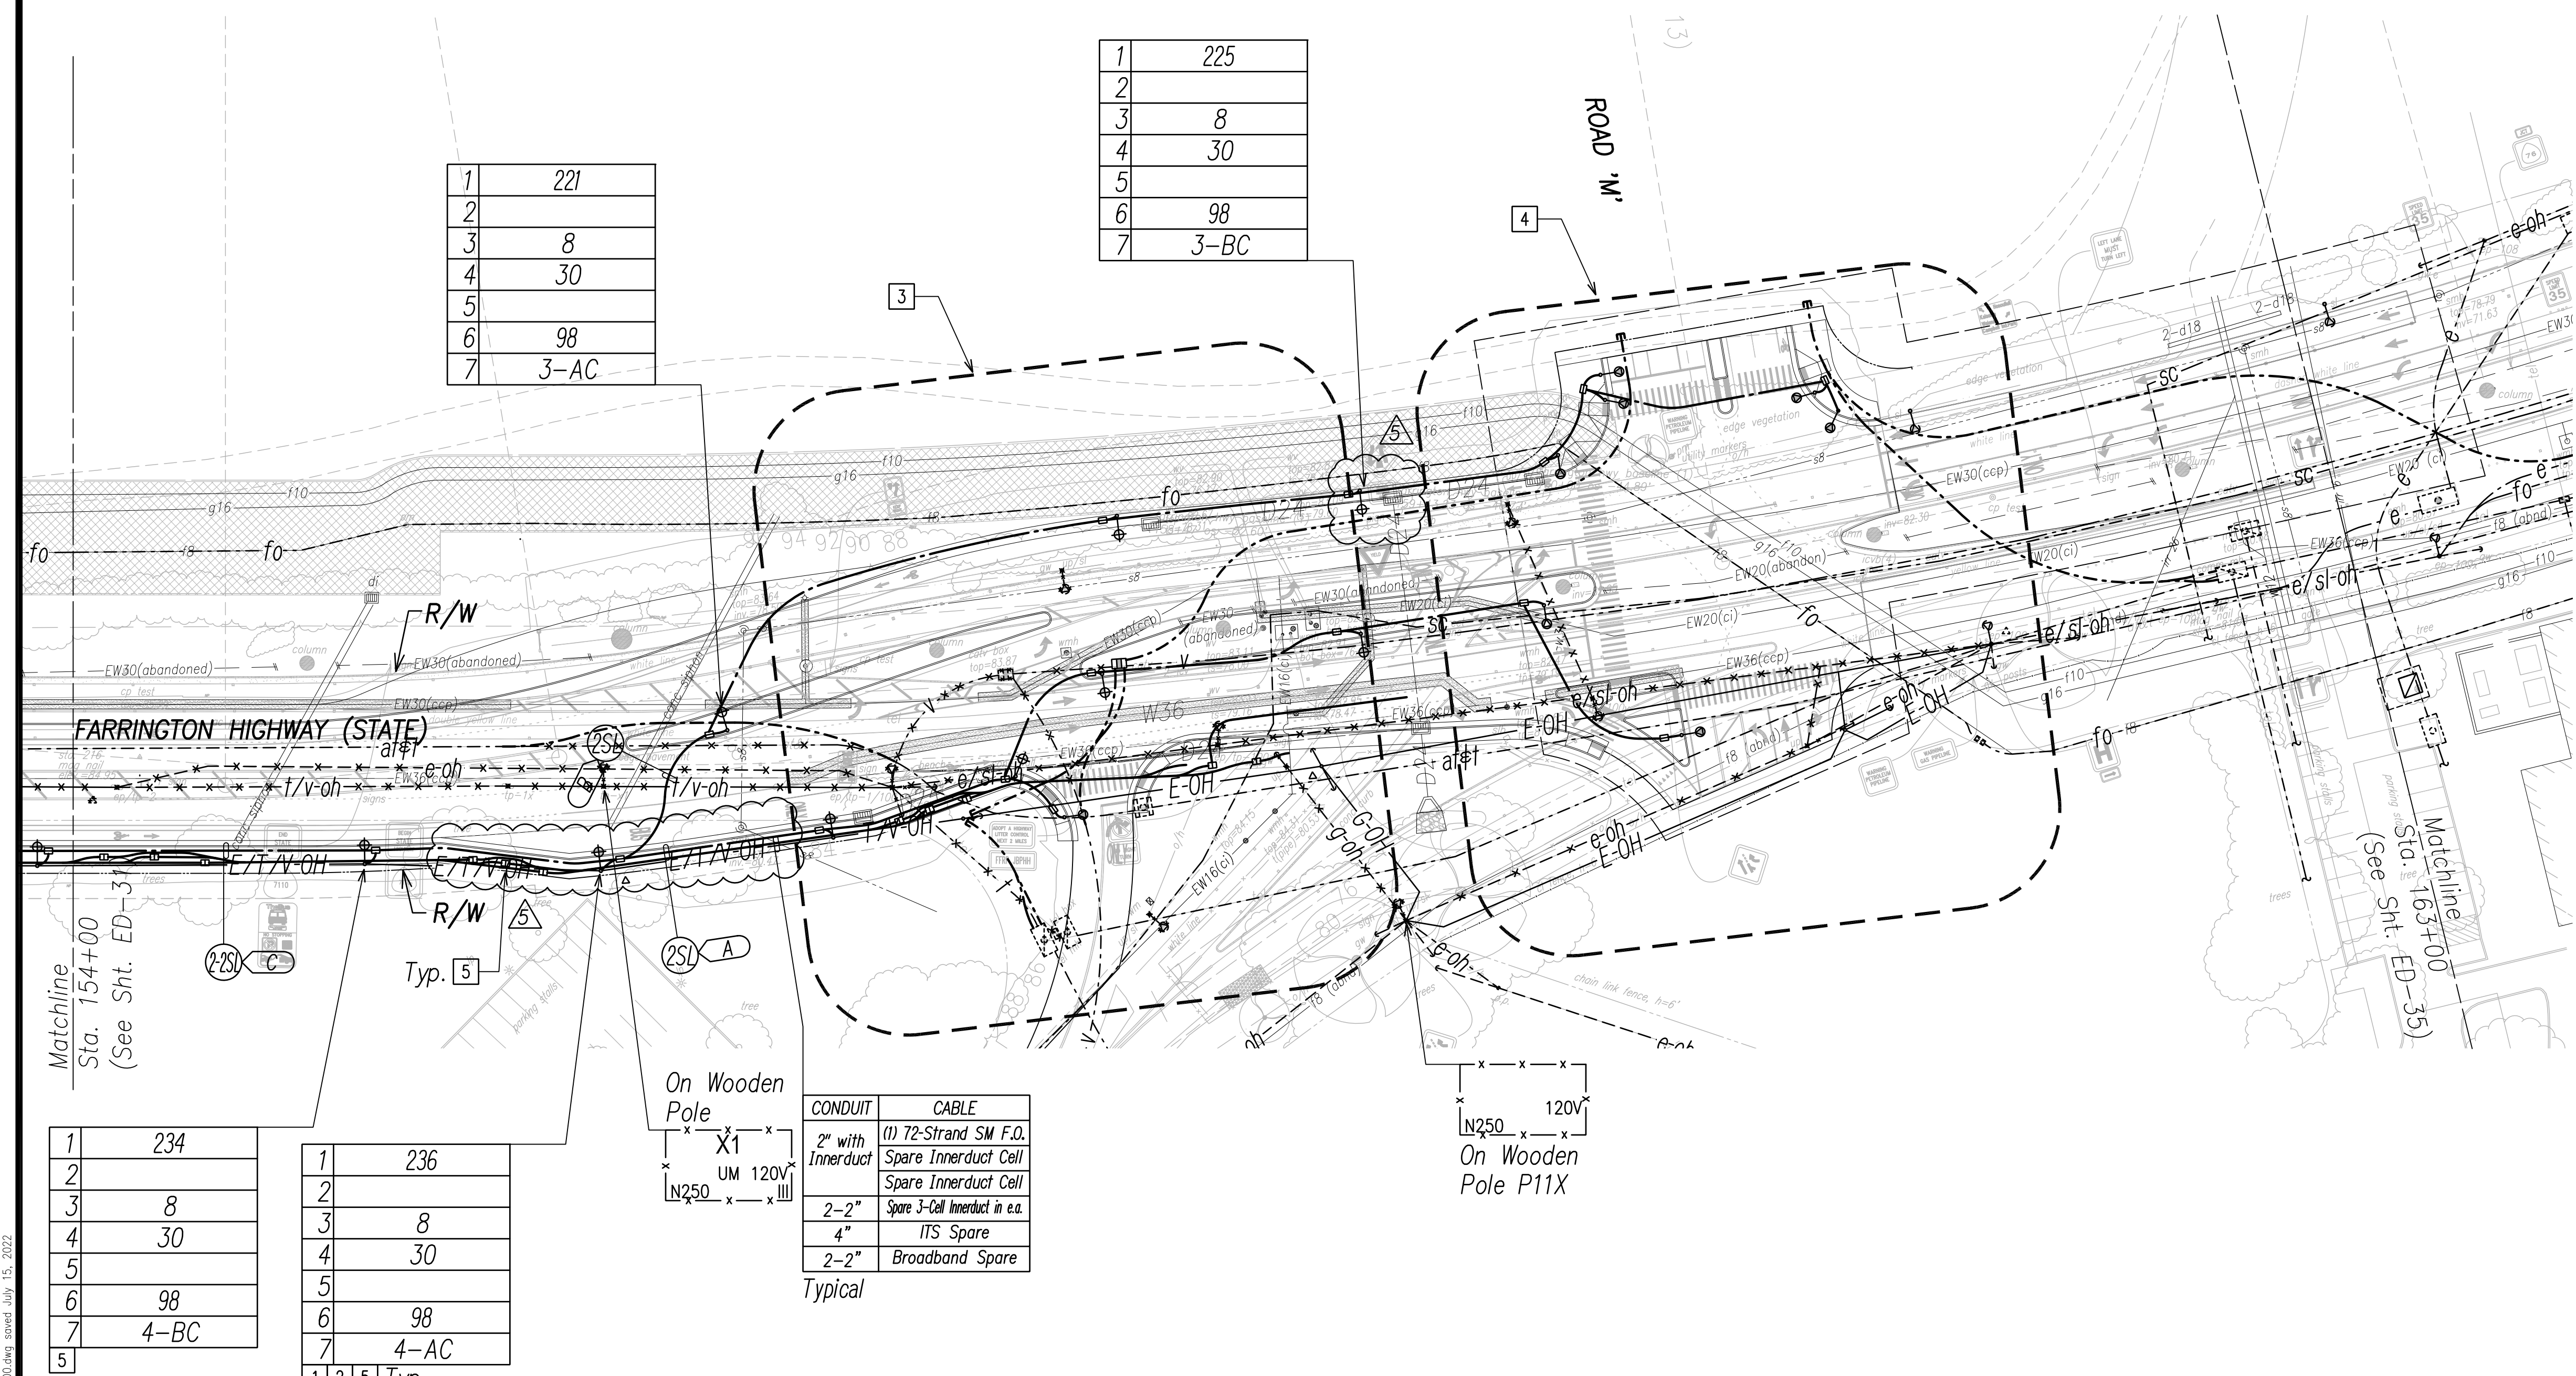

1	221
2	
3	8
4	30
5	
6	98
7	3-AC




1	225
2	
3	8
4	30
5	
6	98
7	3-BC

1	234
2	
3	8
4	30
5	
6	98
7	4-BC

1	236
2	
3	8
4	30
5	
6	98
7	4-AC
1 2 5	Typ.


CONDUIT	CABLE
2" with Innerduct	(1) 72-Strand SM F.O. Spare Innerduct Cell Spare Innerduct Cell
2-2"	Spare 3-Cell Innerduct in e.a.
4"	ITS Spare
2-2"	Broadband Spare

Typical

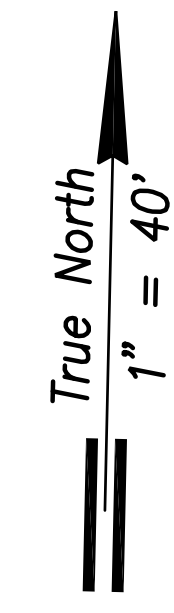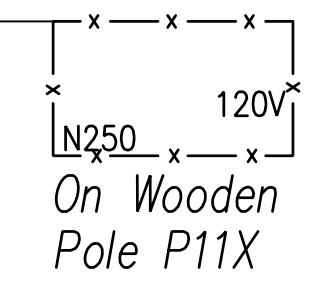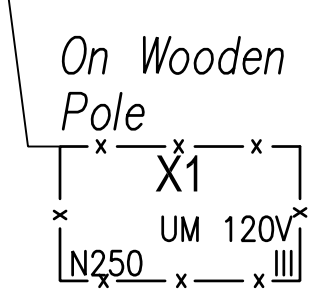


**NOTE:**

- 1 See Street Light Connection Diagrams Sheets EG-01 Through EG-12 for Street Light Wiring.
- 2 See Sheet EG-16 for State Highway Light ID Tag Indicator Legend
- 3 See Enlarged Plan Sheet ED-33
- 4 See Enlarged Plan Sheet ED-34
- 5 Street Light Mounted on HECO Pole
- 6 Typical Handhole Grouping. See Sheet EG-15 for Details.
7. All Traffic Signal Conduits to be in Minimum 3" Concrete Encasement.

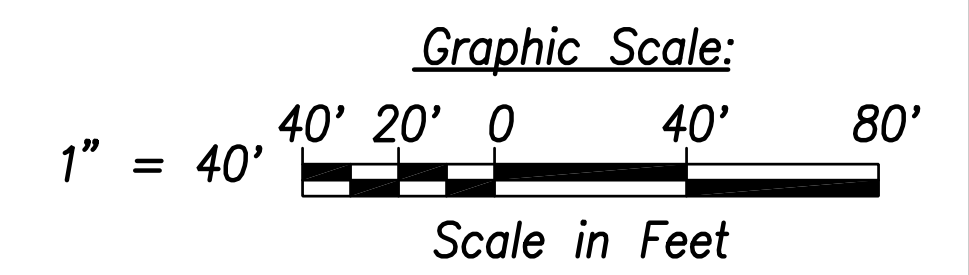

SURVEY PLOTTED BY	DATE
DRAWN BY	
TRACED BY	
CHECKED BY	
ORIGINAL PLAN	
NOTE BOOK	
No.	

FILE: Z:\Mcd\Projects\220677A\ED32\_220677A\_SITS\_Roadway\_Plan\_32 - Sta. 154+00 to 163+00.dwg saved July 15, 2022

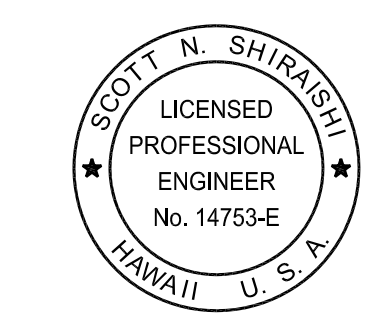

THIS WORK WAS PREPARED BY ME OR UNDER MY SUPERVISION AND CONSTRUCTION OF THIS PROJECT WILL BE UNDER MY OBSERVATION.

Scott Shirasishi  
April 30, 2024  
SIGNATURE EXPIRATION DATE OF THE LICENSE

07/15/22	REVISED NOTE AND SYMBOLS
DATE	REVISION

**STATE OF HAWAII**  
**DEPARTMENT OF TRANSPORTATION**  
**HIGHWAYS DIVISION**  
**STREET LIGHT & TRAFFIC SIGNAL**  
**PLAN 32**

FARRINGTON HIGHWAY WIDENING  
 Kapolei Golf Course Road to Fort Weaver Road  
 Project No. 7101A-01-20

Scale: As Shown      Date: April 2022

**SHEET No. ED-32 OF 35 SHEETS**

**Street Light & Traffic Signal Plan 32 - (Sta. 154+00 to Sta. 163+00)**  
Scale: 1" = 40'


ADD. 643








FED. ROAD DIST. NO.	STATE	PROJ. NO.	FISCAL YEAR	SHEET NO.	TOTAL SHEETS
HAWAII	HAW.	710A-01-20	2021	EE-14	790

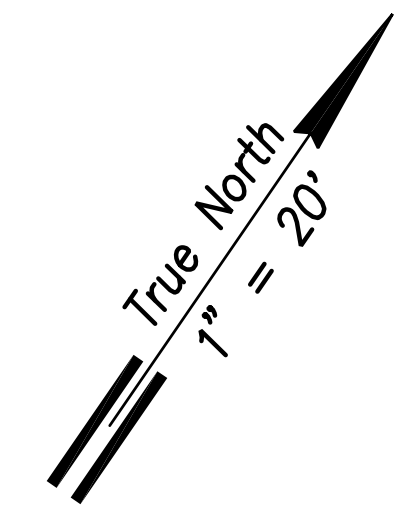

POLE	TYPE
A	Type II-30'
B	Type I-10'
C	Type II-25'
D	Street Light
E	Type I-10'
F	Type II-30'
G	Type II-35'
H	Type II-30'
I	Street Light

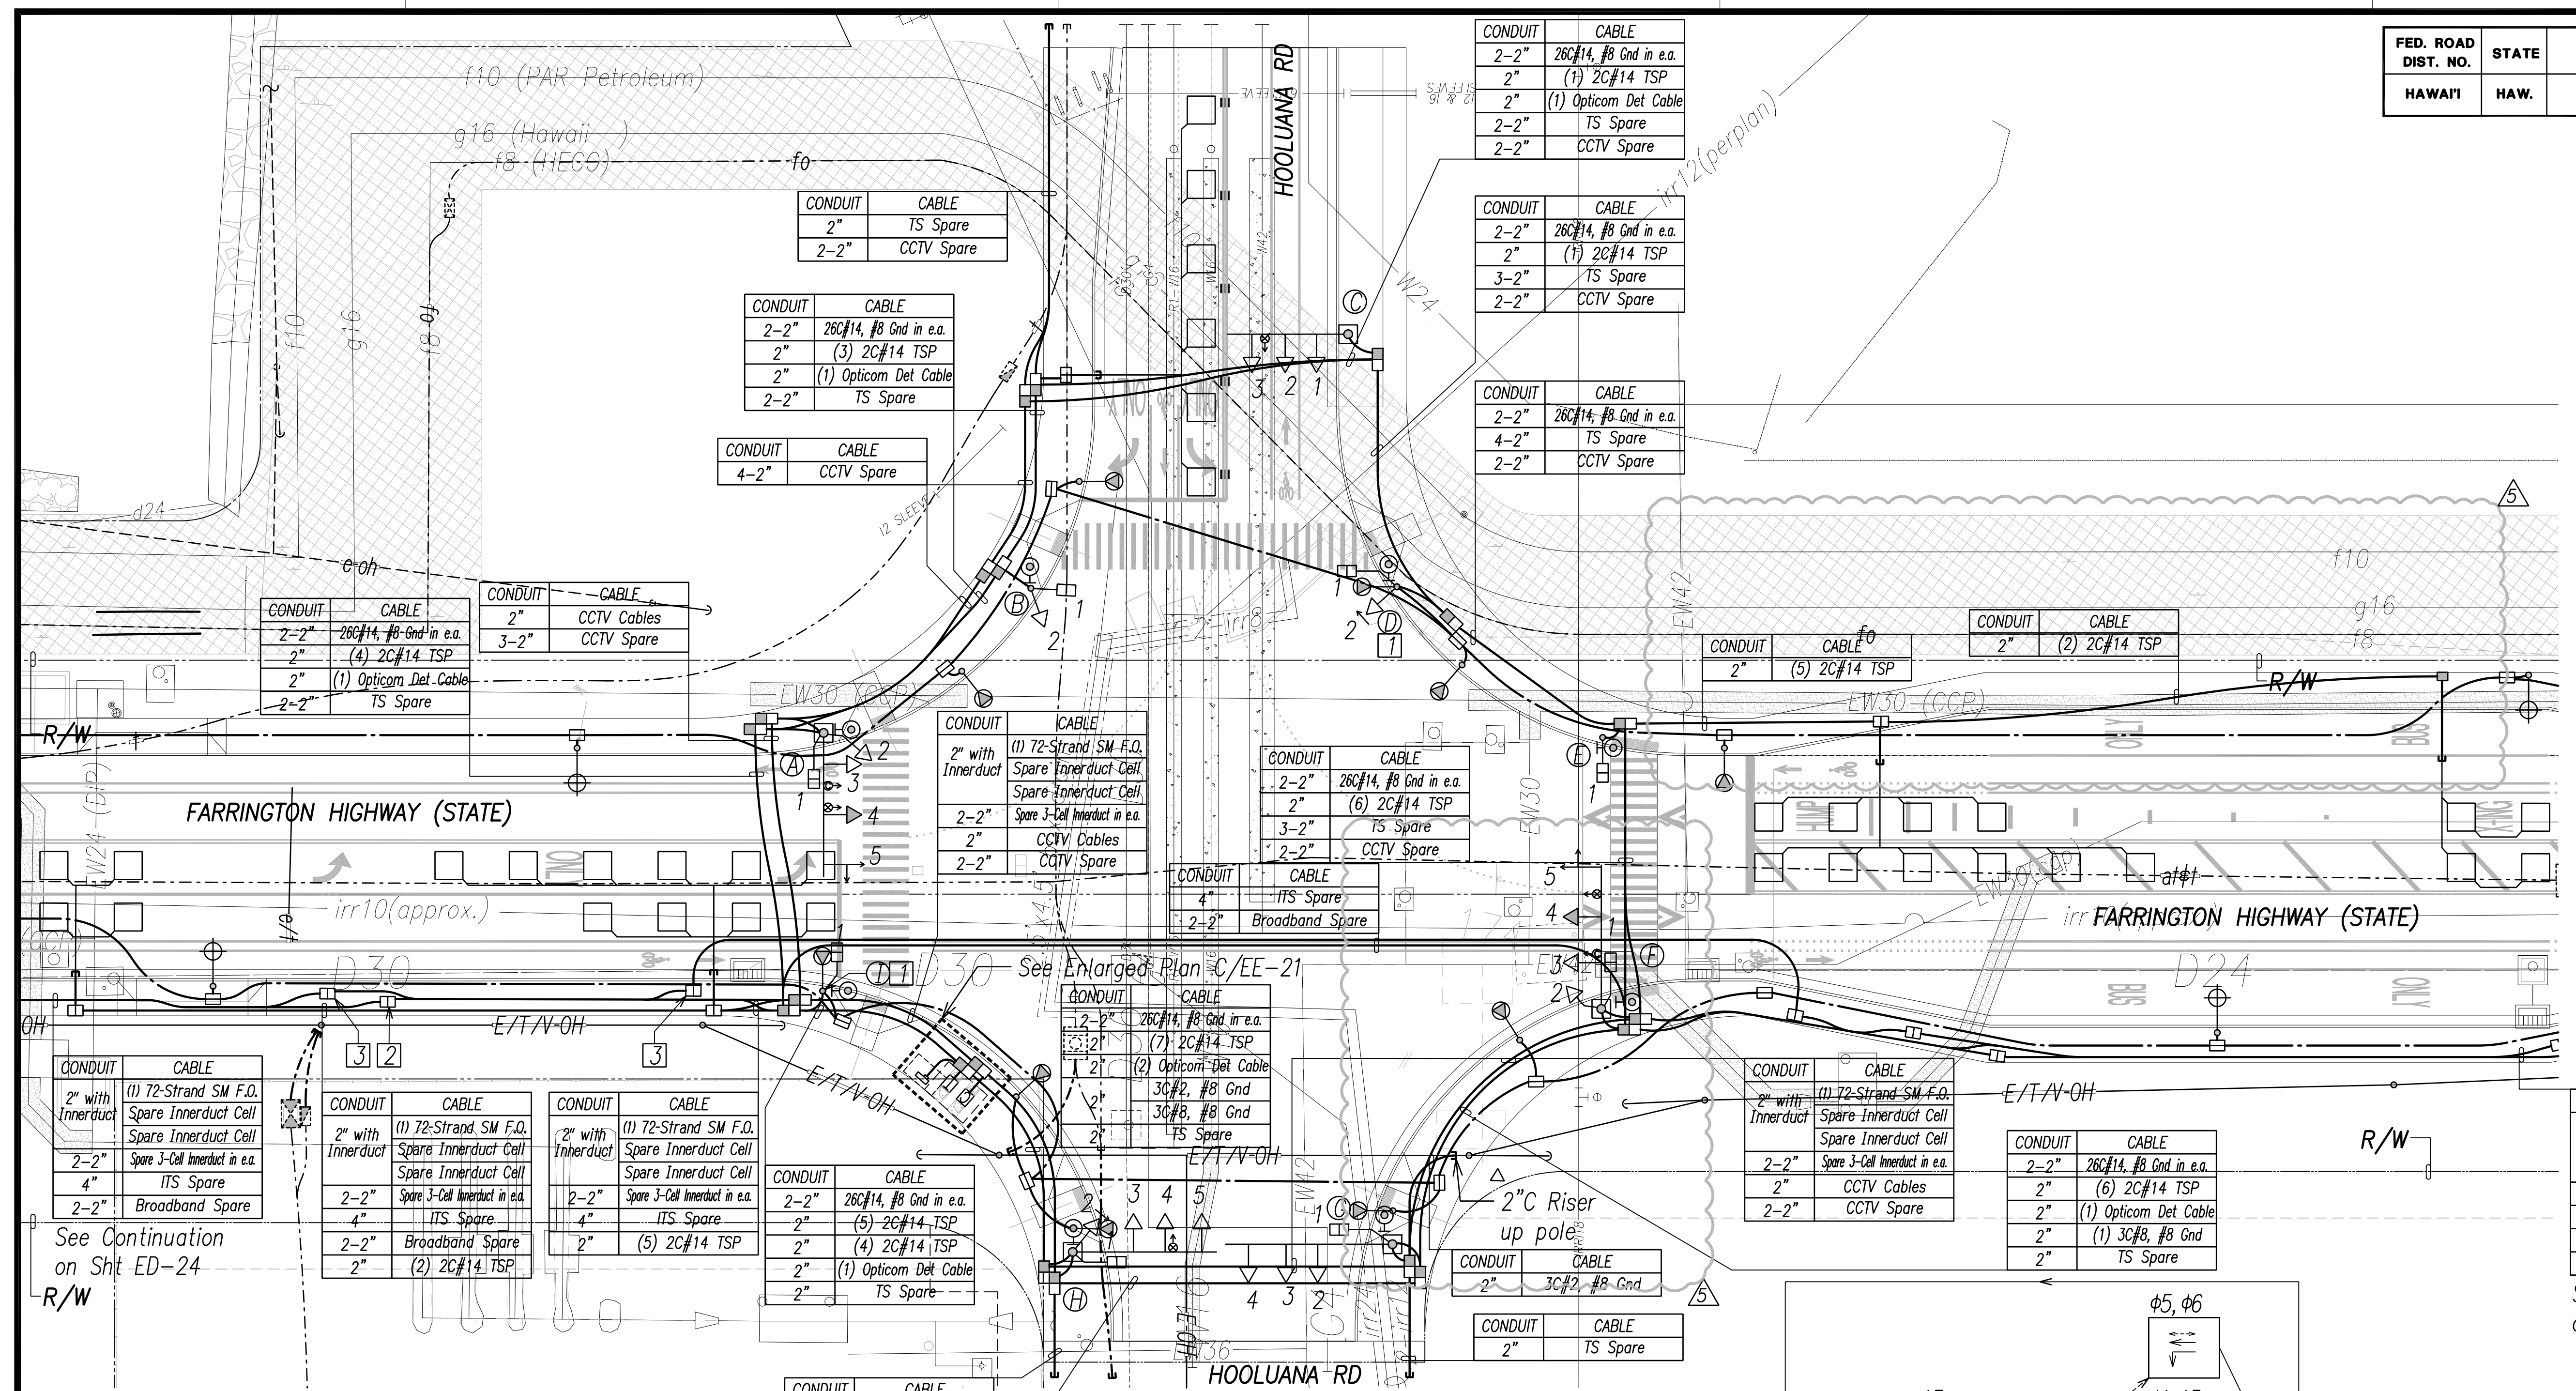


**Notes:**

- 1 Traffic Signal Equipment to be Mounted on Street Light. Provide 2"C to TS Handhole.
- 2 Type "B" TSPB to be labeled "ITS"
- 3 Type "B" TSPB to be labeled "STATE BROADBAND"
4. All Traffic Signal Conduits to be in Minimum 3" Concrete Encasement.
5. All TSPB to be Labeled "STATE SIGNAL" Unless Noted Otherwise.


CONDUIT	CABLE
2-2"	26C#14, #8 Gnd in e.a.
2"	(7) 2C#14 TSP
2"	(1) Opticom Det Cable
2"	TS Spare

Signal Indication	(LED)	(LED)	(LED)	(LED)
Description	12" RYG Ball	12" RYG (Left Arrow)	12" RYG (Str. Arrow)	Pedestrian Signal Head
Pole Letter-Number	A-2 G-2 A-3 G-3 B-2 G-4 C-1 H-3 C-2 H-4 C-3 H-5 F-2 F-3	A-5* D-2 F-5*	A-4 F-4	A-1 I-1 B-1 D-1 E-1 F-1 G-1 H-1

\* Indicates Programmed Visibility Signal Head  
**Traffic Signal Plan - Intersection K**  
 Scale: 1" = 20'

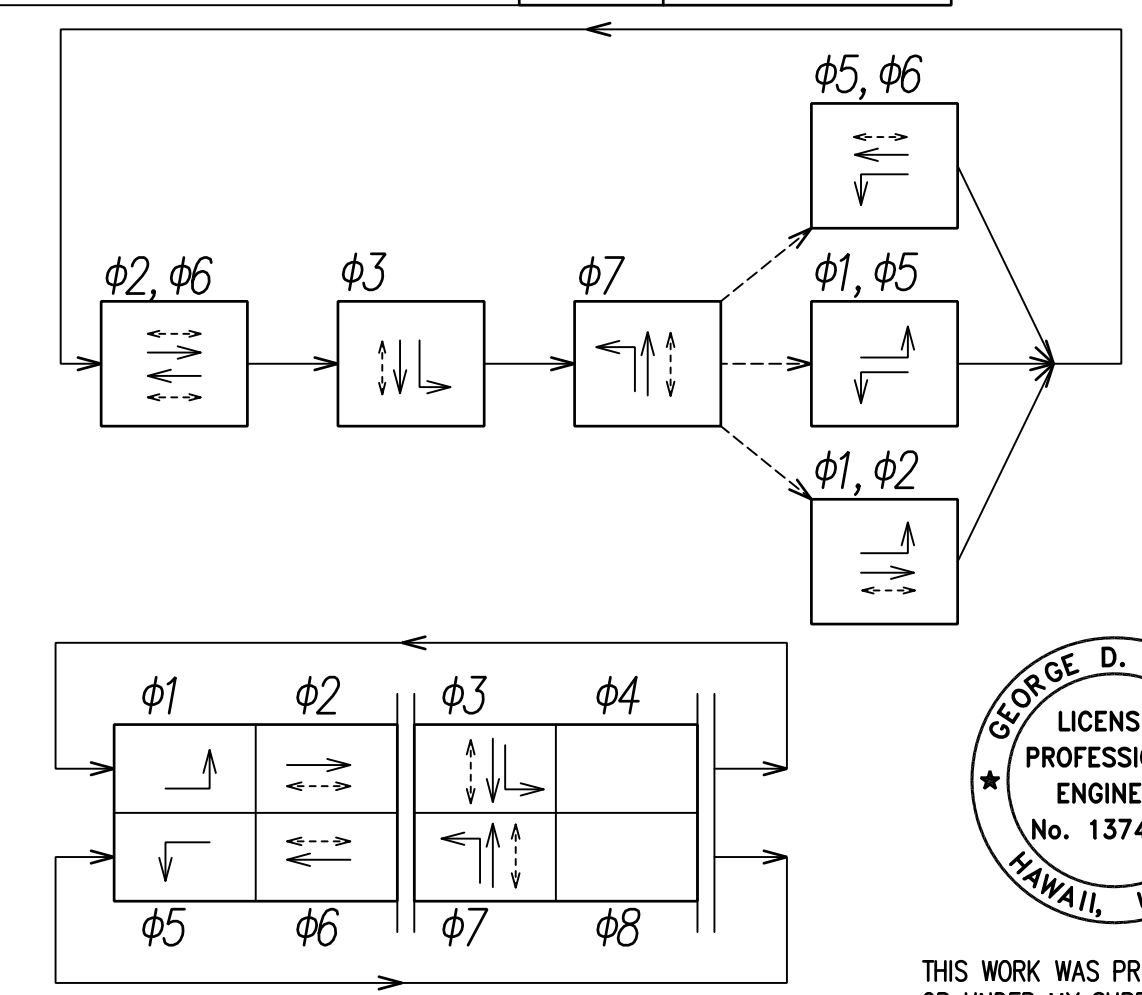


**Phase Sequence Diagram**

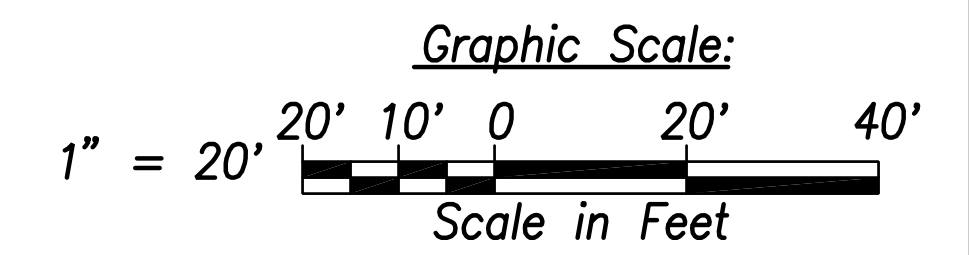

DATE	.....
SURVEY PLOTTED BY	.....
DRAWN BY	.....
TRACED BY	.....
QUANTITIES BY	.....
CHECKED BY	.....
ORIGINAL PLAN	.....
NOTE BOOK	.....
No.	.....

FILE: Z:\Work\Projects\2200679A\EE14\_2200679A\_INTERSECTION\_K.dwg saved July 15, 2022

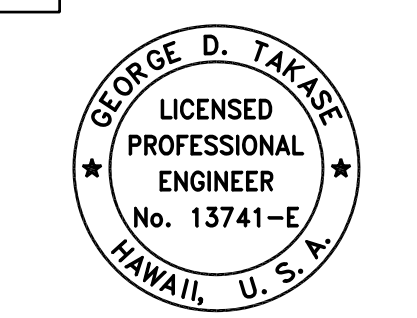

THIS WORK WAS PREPARED BY ME OR UNDER MY SUPERVISION AND CONSTRUCTION OF THIS PROJECT WILL BE UNDER MY OBSERVATION.  
 SIGNATURE: [Signature]  
 EXPIRATION DATE OF THE LICENSE: April 30, 2024


07/15/22	EQUIPMENT LOCATION REVISIONS
DATE	REVISION
STATE OF HAWAII <b>DEPARTMENT OF TRANSPORTATION</b> HIGHWAYS DIVISION <b>TRAFFIC SIGNAL PLAN</b> <b>INTERSECTION K</b> FARRINGTON HIGHWAY WIDENING Kapolei Golf Course Road to Fort Weaver Road Project No. 7101A-01-20	
Scale: As Shown	Date: April 2022
<b>SHEET No. EE-14 OF 790 SHEETS</b>	

ADD. 660


APRIL 2022




FED. ROAD DIST. NO.	STATE	PROJ. NO.	FISCAL YEAR	SHEET NO.	TOTAL SHEETS
HAWAII	HAW.	710A-01-20	2021	EE-17	790

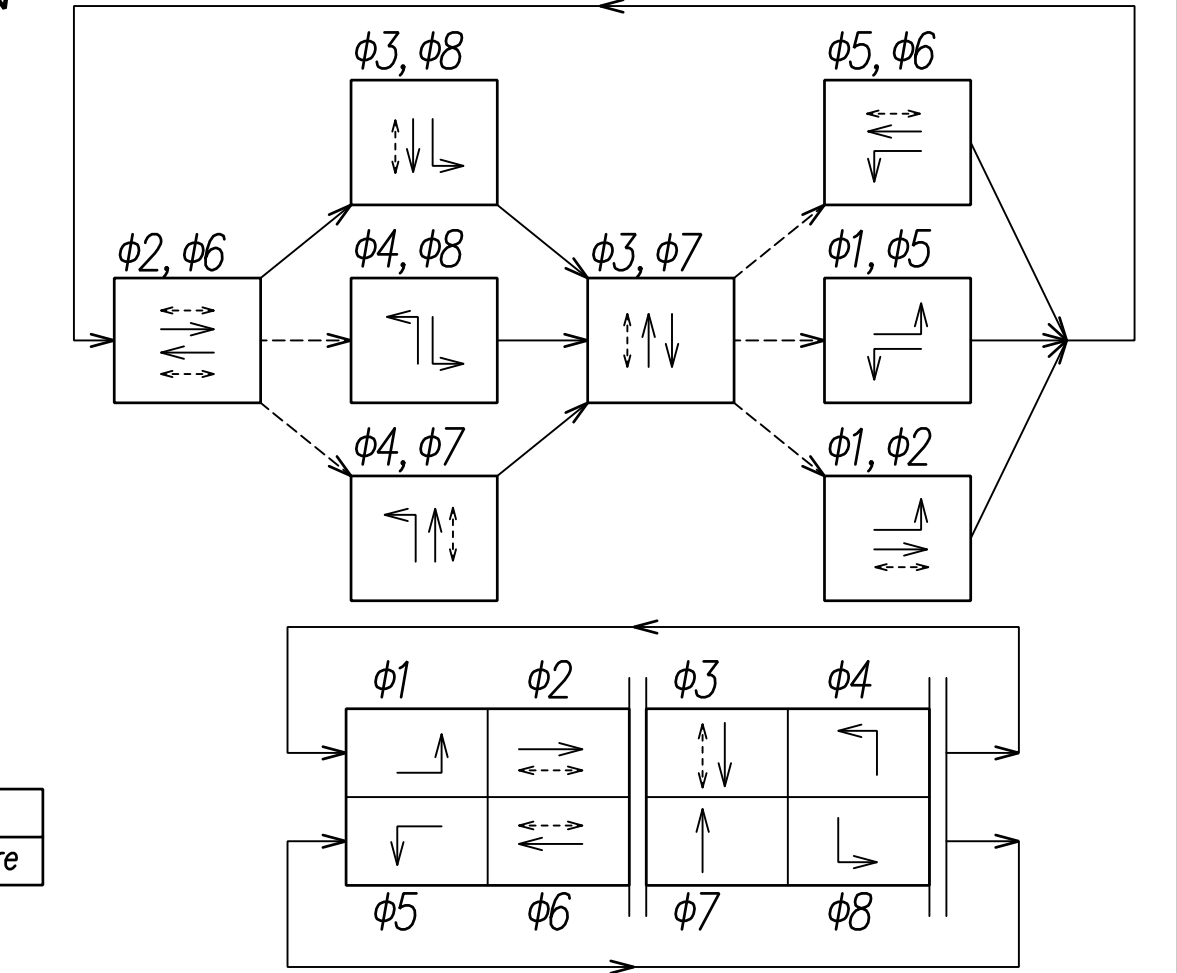

**Phase Sequence Diagram**  
 → Protected Movement  
 - - - Permitted Movement  
 ···· Pedestrian Movement

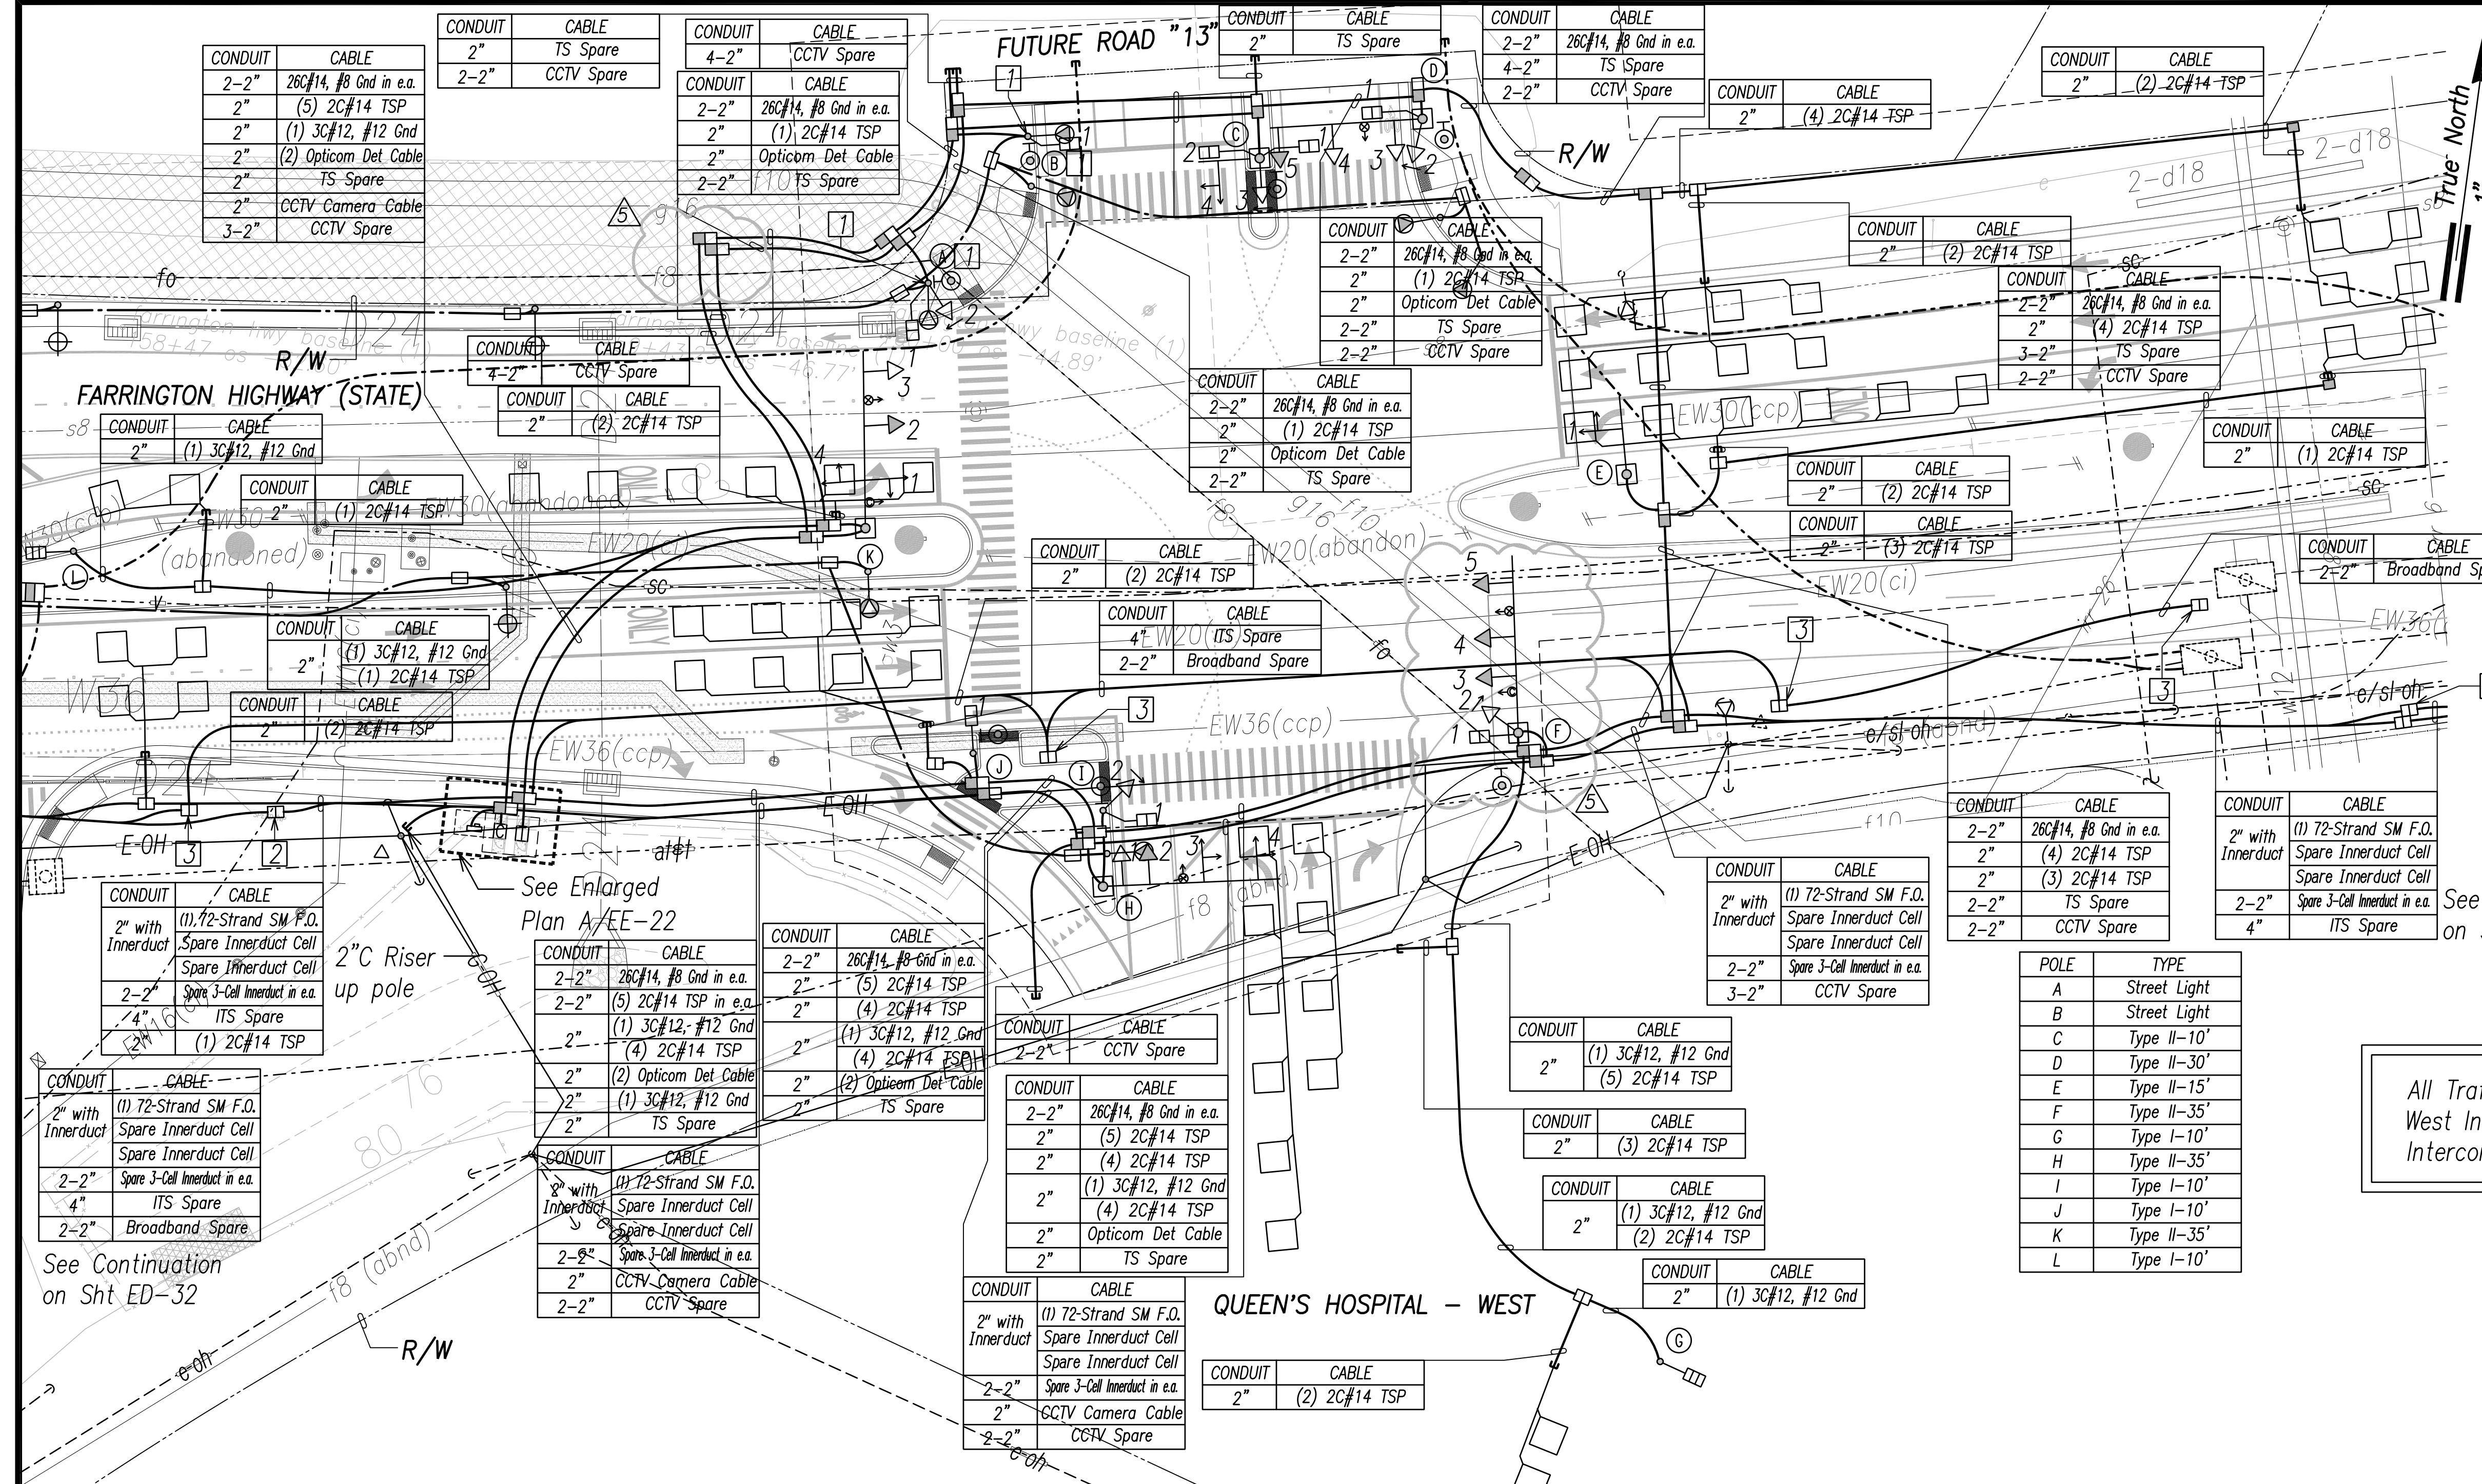

All Traffic Signal Work to be Part of the Queen's West Intersection Work. CCTV, Broadband, and Interconnect to be Part of Base Bid Work.

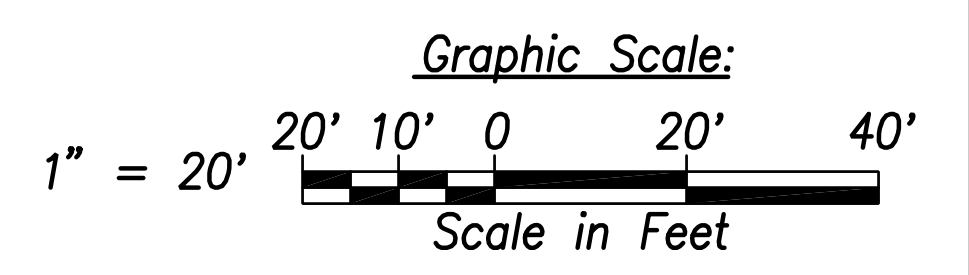


**Notes:**

- Future Traffic Signal Equipment to be Mounted on Street Light. Provide 2" C to TS Handhole.
- Type "B" TSPB to be labeled "ITS"
- Type "B" TSPB to be labeled "STATE BROADBAND"
- All Traffic Signal Conduits to be in Minimum 3" Concrete Encasement.
- All TSPB to be Labeled "STATE SIGNAL" Unless Noted Otherwise.

Signal Indication	(LED)	(LED)	(LED)	(LED)
Description	12" RYG Ball	12" RYG (Left Arrow)	12" RYG (Str. Arrow)	Pedestrian Signal Head
Pole Letter-Signal Head Number	D-3 D-4 H-1 K-3	A-2 H-3* C-3 H-4* C-4* I-2 D-2 K-1* E-1* K-4* F-2	D-5 F-3 F-4 F-5 H-2 K-2	D-1 B-1 F-1 C-1 I-1 C-2 J-1 A-1


\* Indicates Programmed Visibility Signal Head (Non-LED)  
**Traffic Signal Plan - Intersection M**  
 Scale: 1" = 20'

Note: Poles (C) and (L) are Type I-10' with Flashing Signal Heads with Sign: "STOP AHEAD WHEN FLASHING"

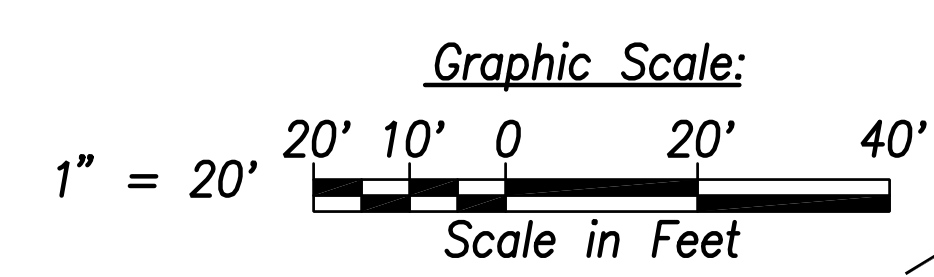

DATE	
SURVEY PLOTTED BY	
DRAWN BY	
TRACED BY	
QUANTITIES BY	
CHECKED BY	
ORIGINAL PLAN	
NOTE BOOK	
No.	

FILE: Z:\Work\Projects\220067HA\EET\_220067HA\_INTERSECTION\_Making\_samed\_july\_15\_2022

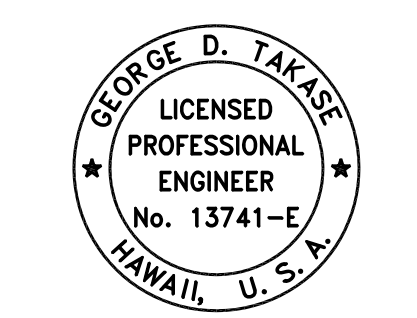

THIS WORK WAS PREPARED BY ME OR UNDER MY SUPERVISION AND CONSTRUCTION OF THIS PROJECT WILL BE UNDER MY OBSERVATION.  
 SIGNATURE: [Signature]  
 APRIL 30, 2024  
 EXPIRATION DATE OF THE LICENSE

07/15/22	EQUIPMENT LOCATION REVISIONS
DATE	REVISION

STATE OF HAWAII  
 DEPARTMENT OF TRANSPORTATION  
 HIGHWAYS DIVISION

**TRAFFIC SIGNAL PLAN**  
**INTERSECTION M**  
 FARRINGTON HIGHWAY WIDENING  
 Kapolei Golf Course Road to Fort Weaver Road  
 Project No. 7101A-01-20







Scale: As Shown      Date: April 2022

**SHEET No. EE-17 OF 23 SHEETS**

ADD. 663

APRIL 2022


FED. ROAD DIST. NO.	STATE	PROJ. NO.	FISCAL YEAR	SHEET NO.	TOTAL SHEETS
HAWAII	HAW.	710A-01-20	2021	EF-19	790

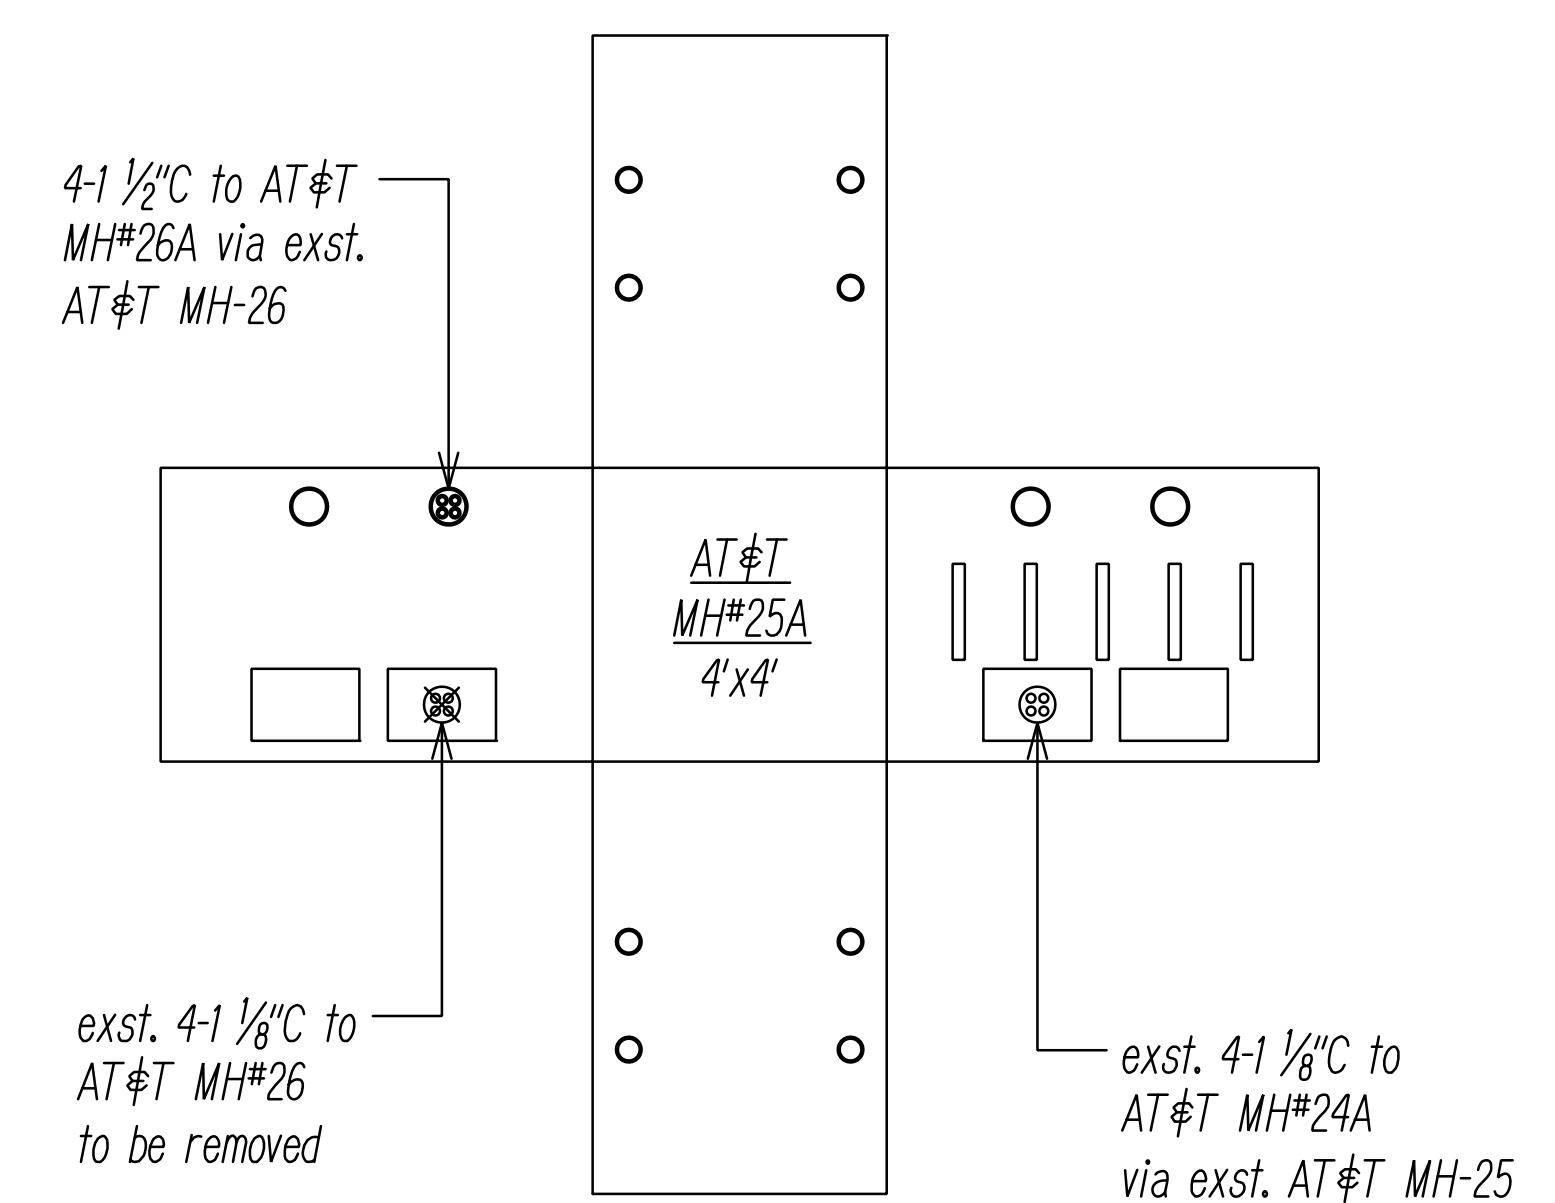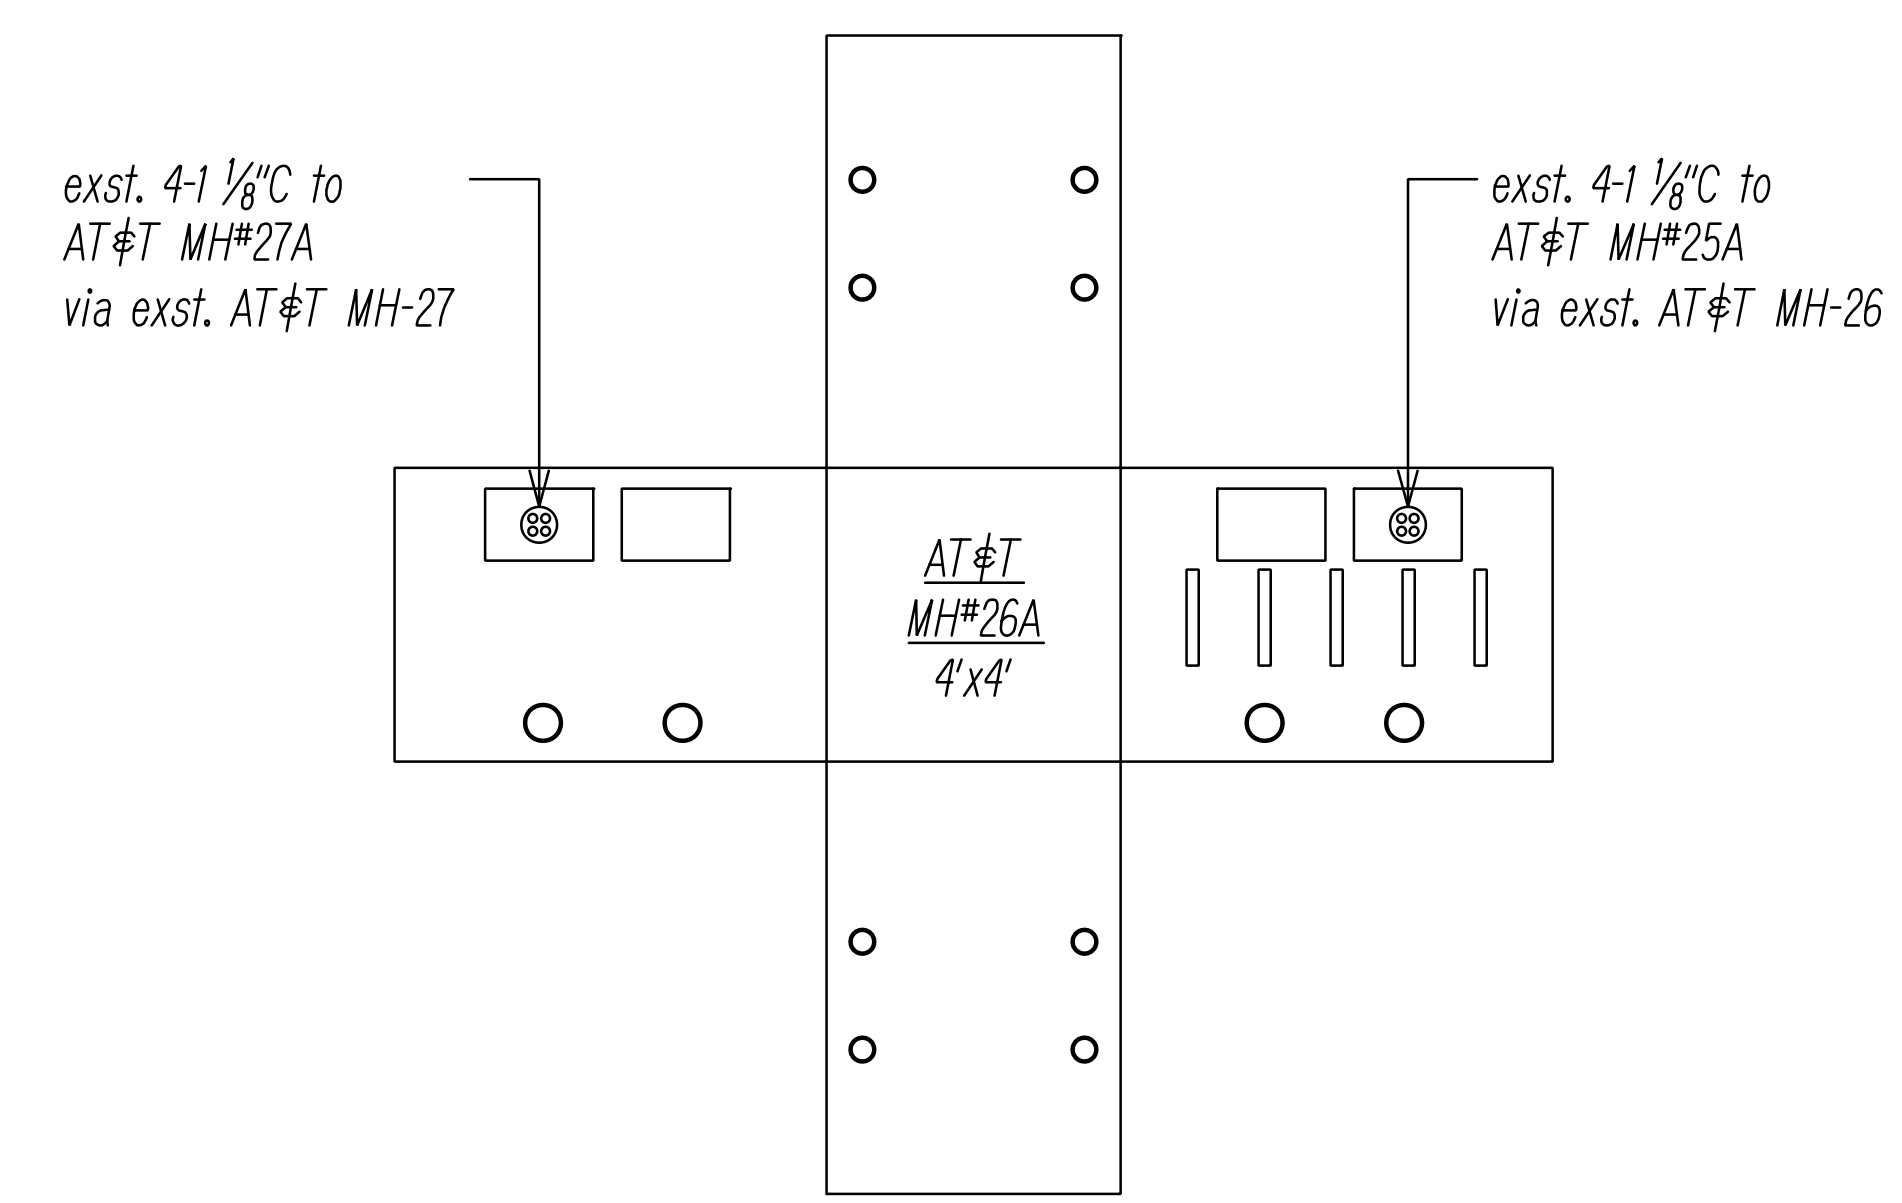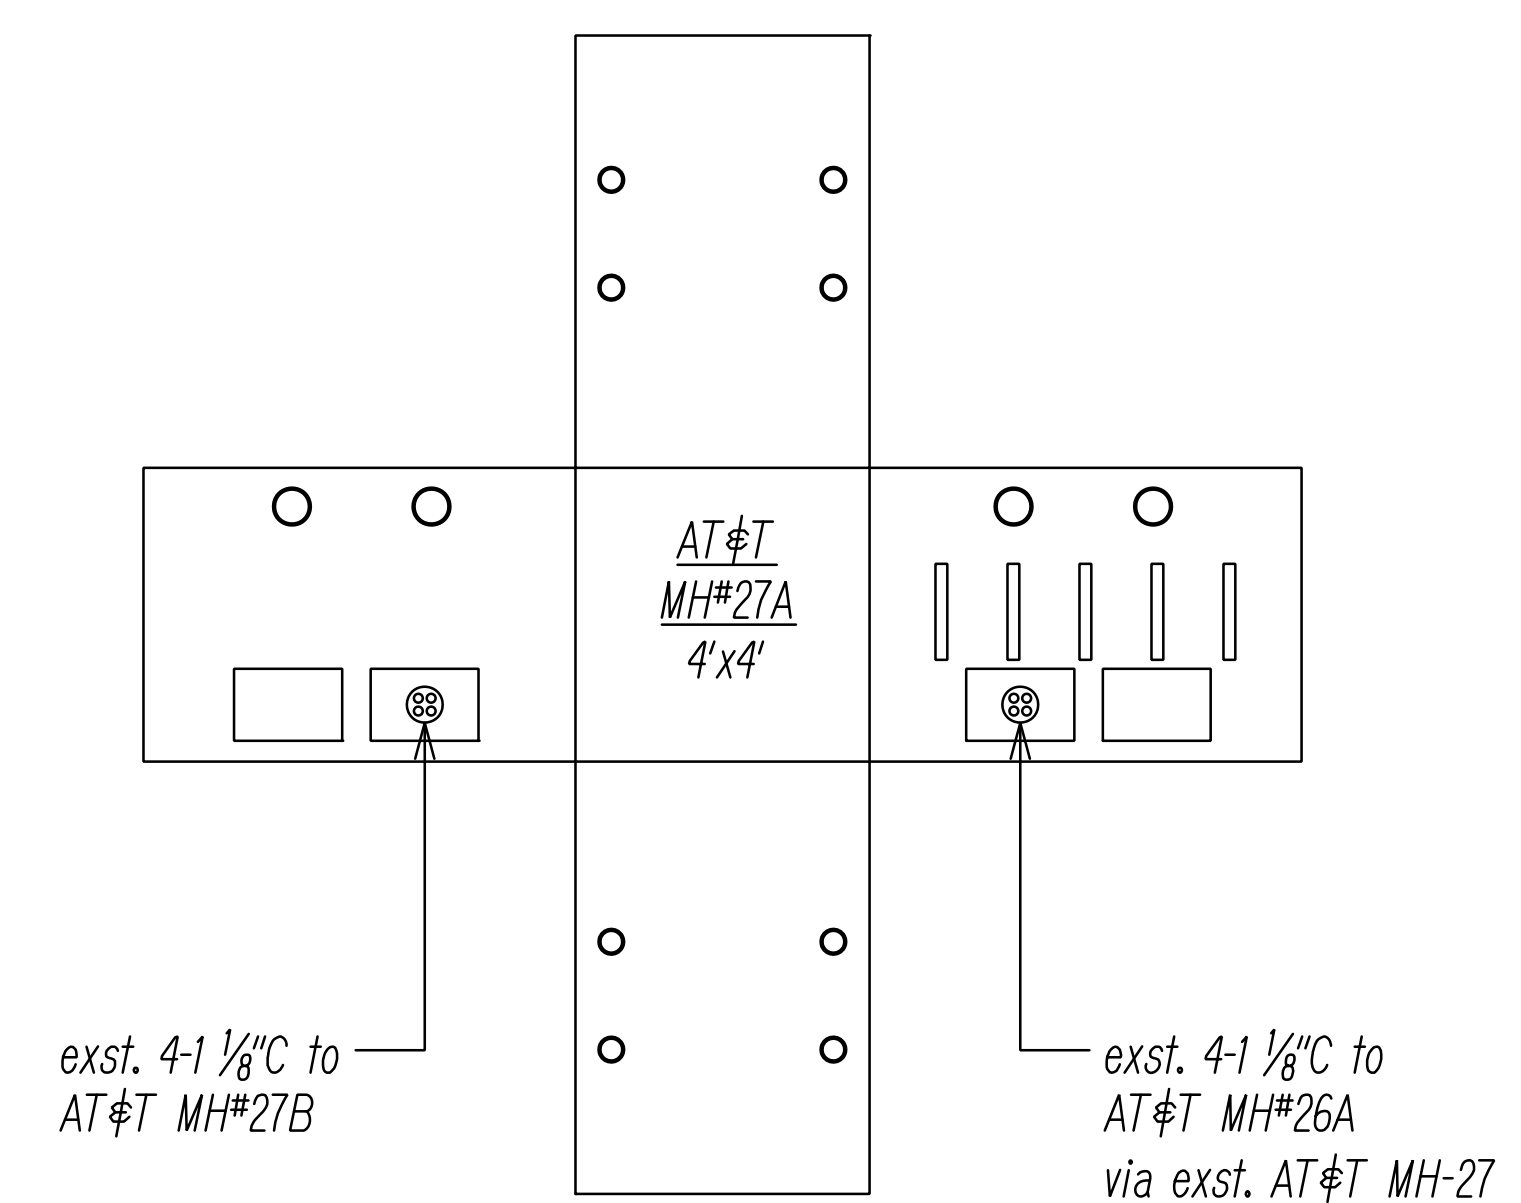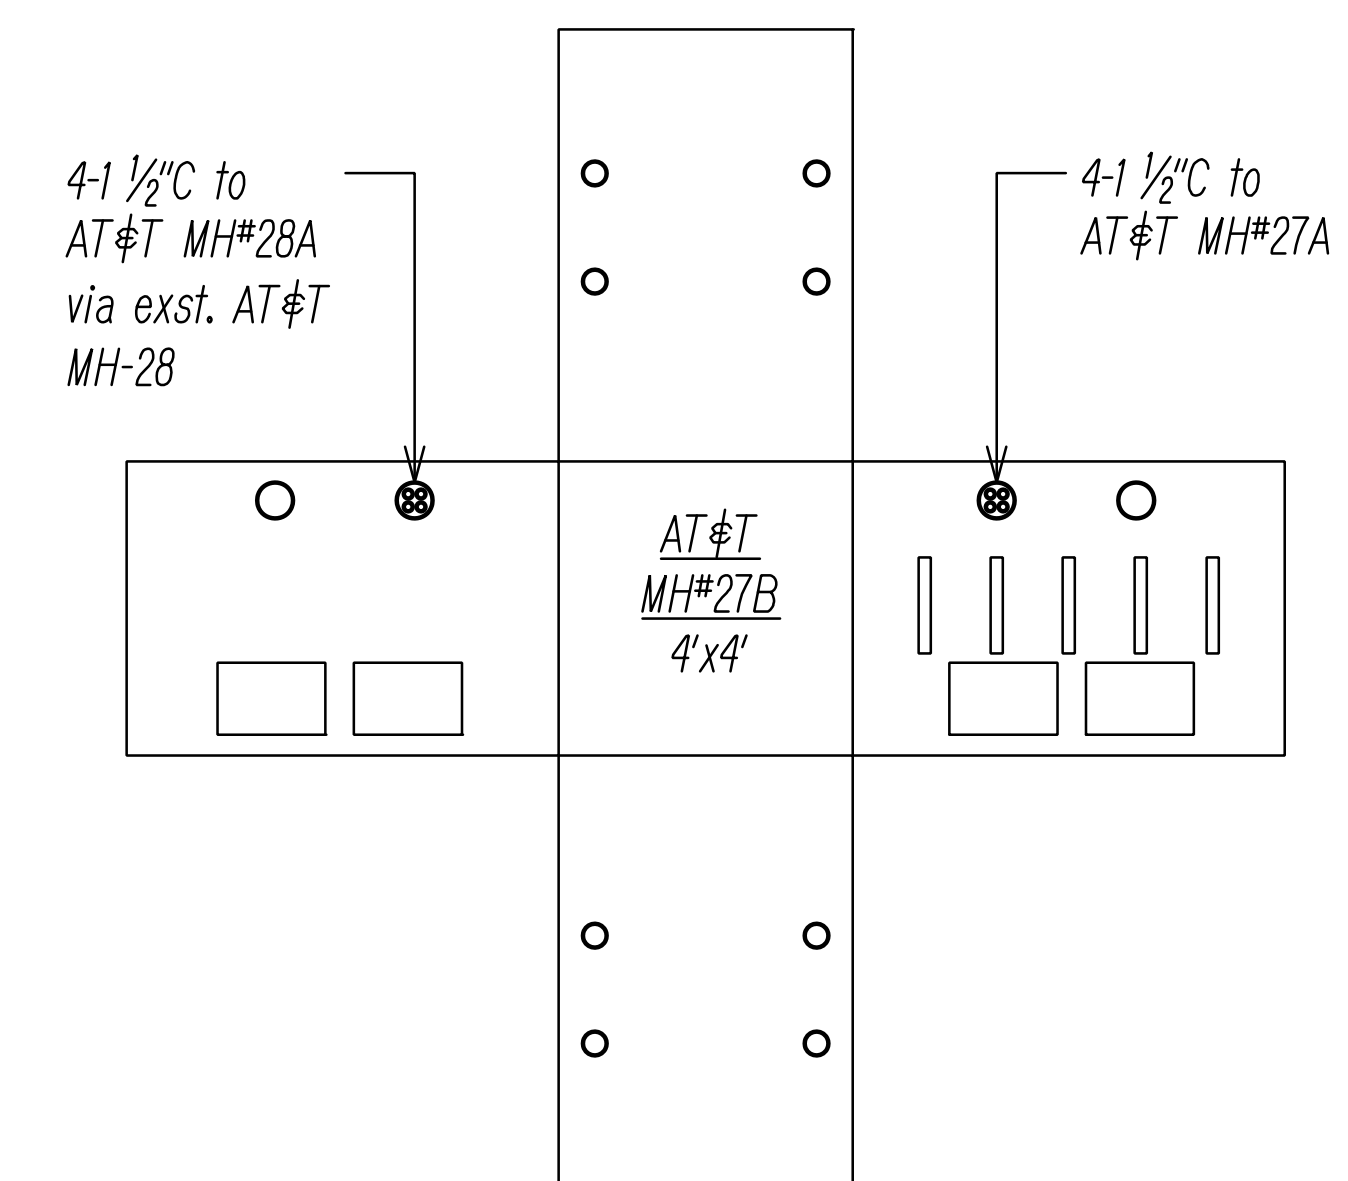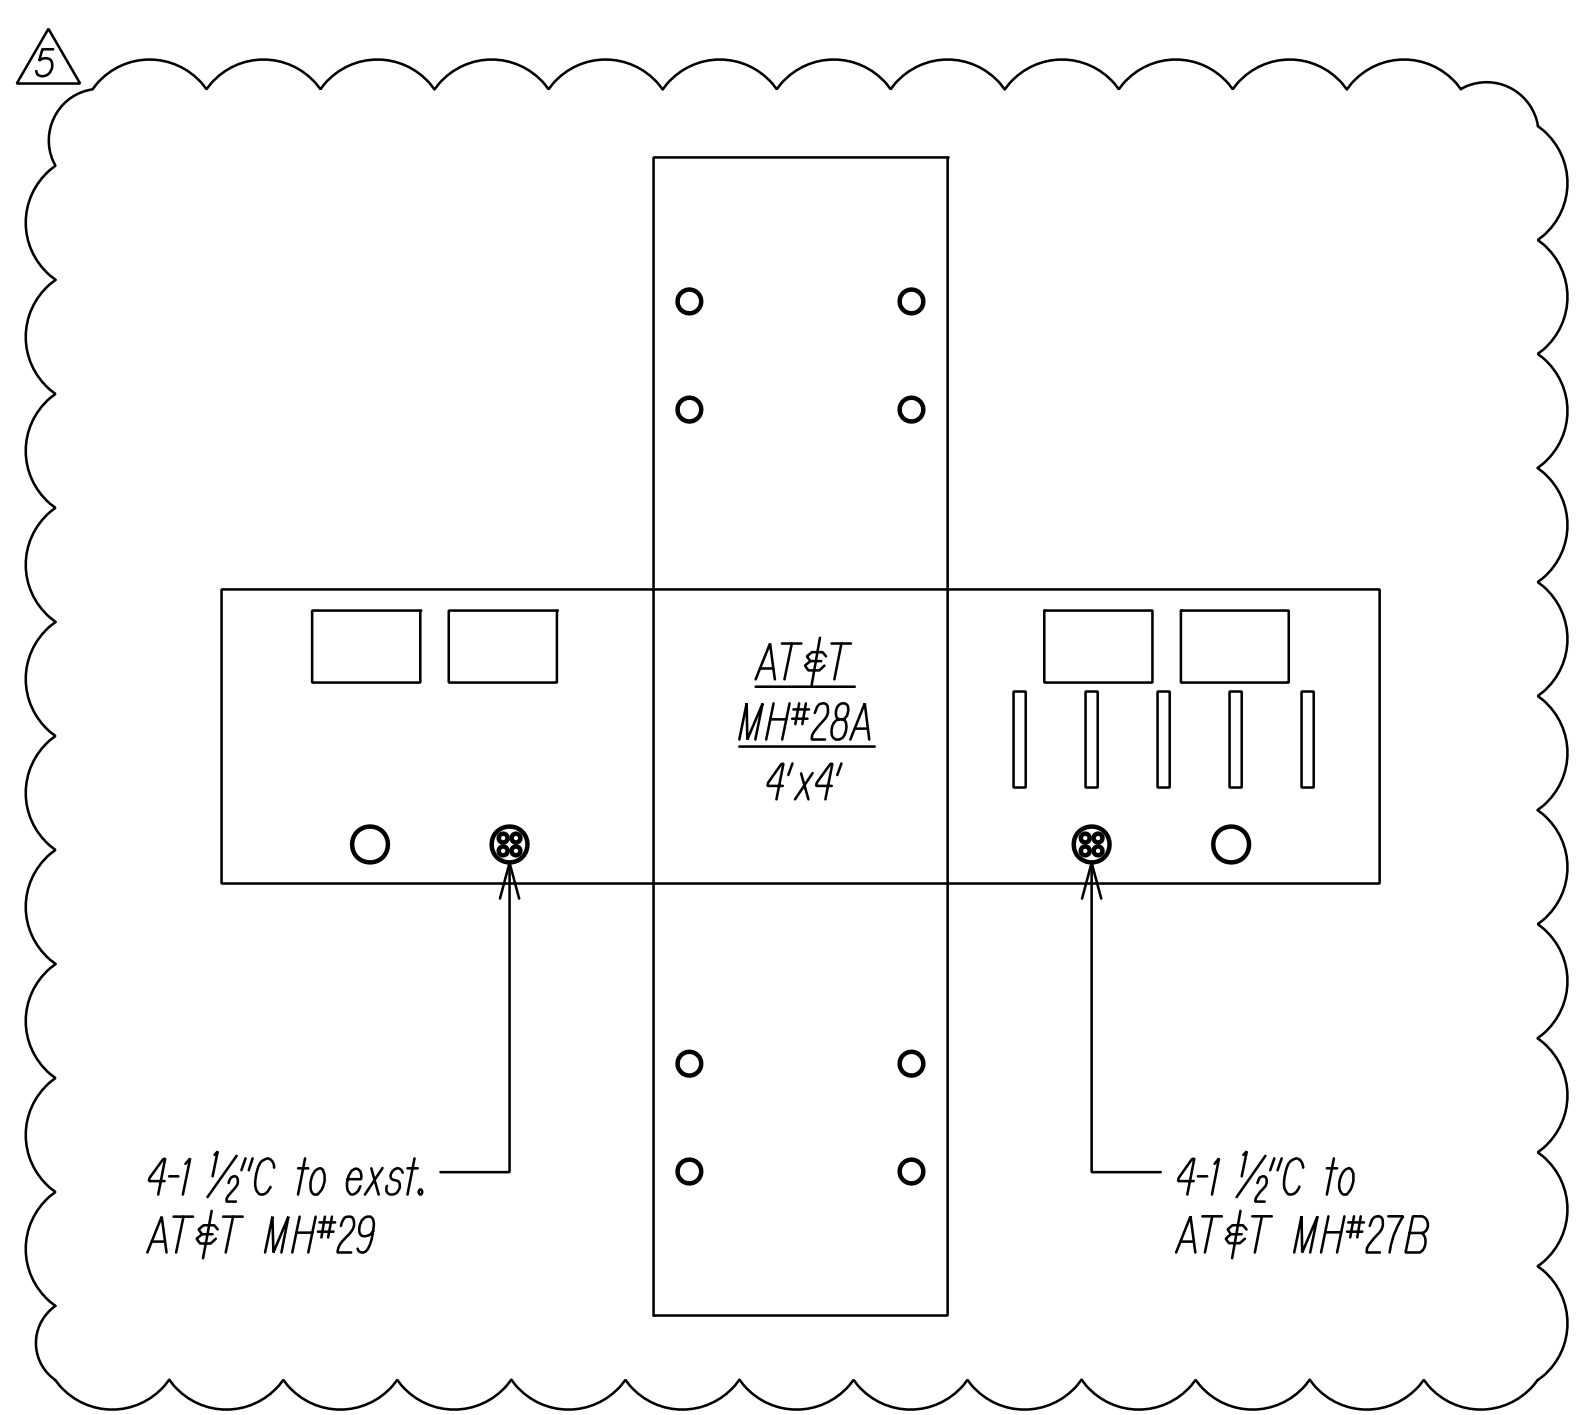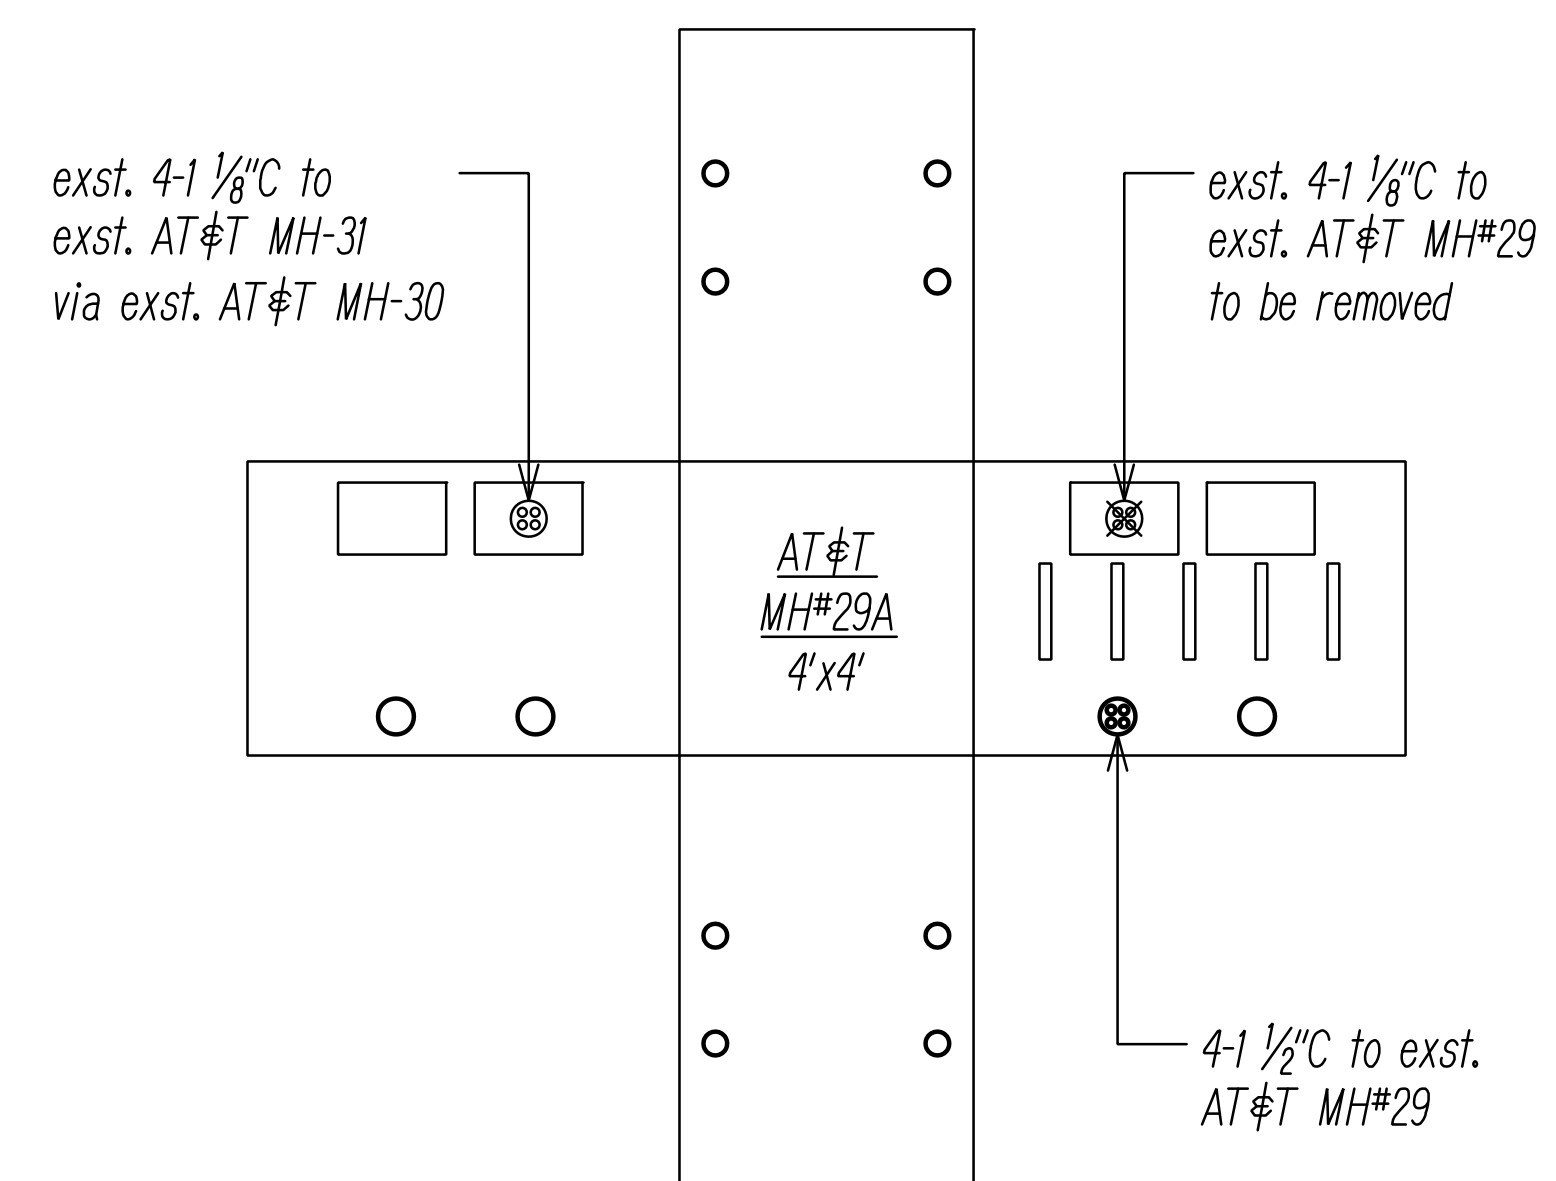

SURVEY PLOTTED BY	DATE
DRAWN BY	
TRACED BY	
QUANTITIES BY	
CHECKED BY	
ORIGINAL PLAN	
NOTE BOOK	
No.	

FILE: Z:\ACAD\PROJECTS\220674\EF19\_22\0674\_ATT-MH-DETAIL-04.dwg saved June 28, 2022

**AT&T MANHOLE DETAILS 4**  
NOT TO SCALE

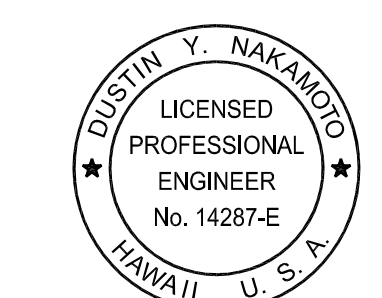

THIS WORK WAS PREPARED BY ME OR UNDER MY SUPERVISION AND CONSTRUCTION OF THIS PROJECT WILL BE UNDER MY OBSERVATION.

Signature: *[Signature]*  
Date: April 30, 2024  
Expiration Date of the License

07/15/22	ADDED BUS BAYS & BWS CMTS
DATE	REVISION


STATE OF HAWAII  
DEPARTMENT OF TRANSPORTATION  
HIGHWAYS DIVISION

**AT&T MANHOLE DETAILS 4**

FARRINGTON HIGHWAY WIDENING  
Kapolei Golf Course Road to Fort Weaver Road  
Project No. 7101A-01-20

Scale: As Shown Date: April 2022

FED. ROAD DIST. NO.	STATE	PROJ. NO.	FISCAL YEAR	SHEET NO.	TOTAL SHEETS
HAWAII	HAW.	710A-01-20	2021	EG-01	790

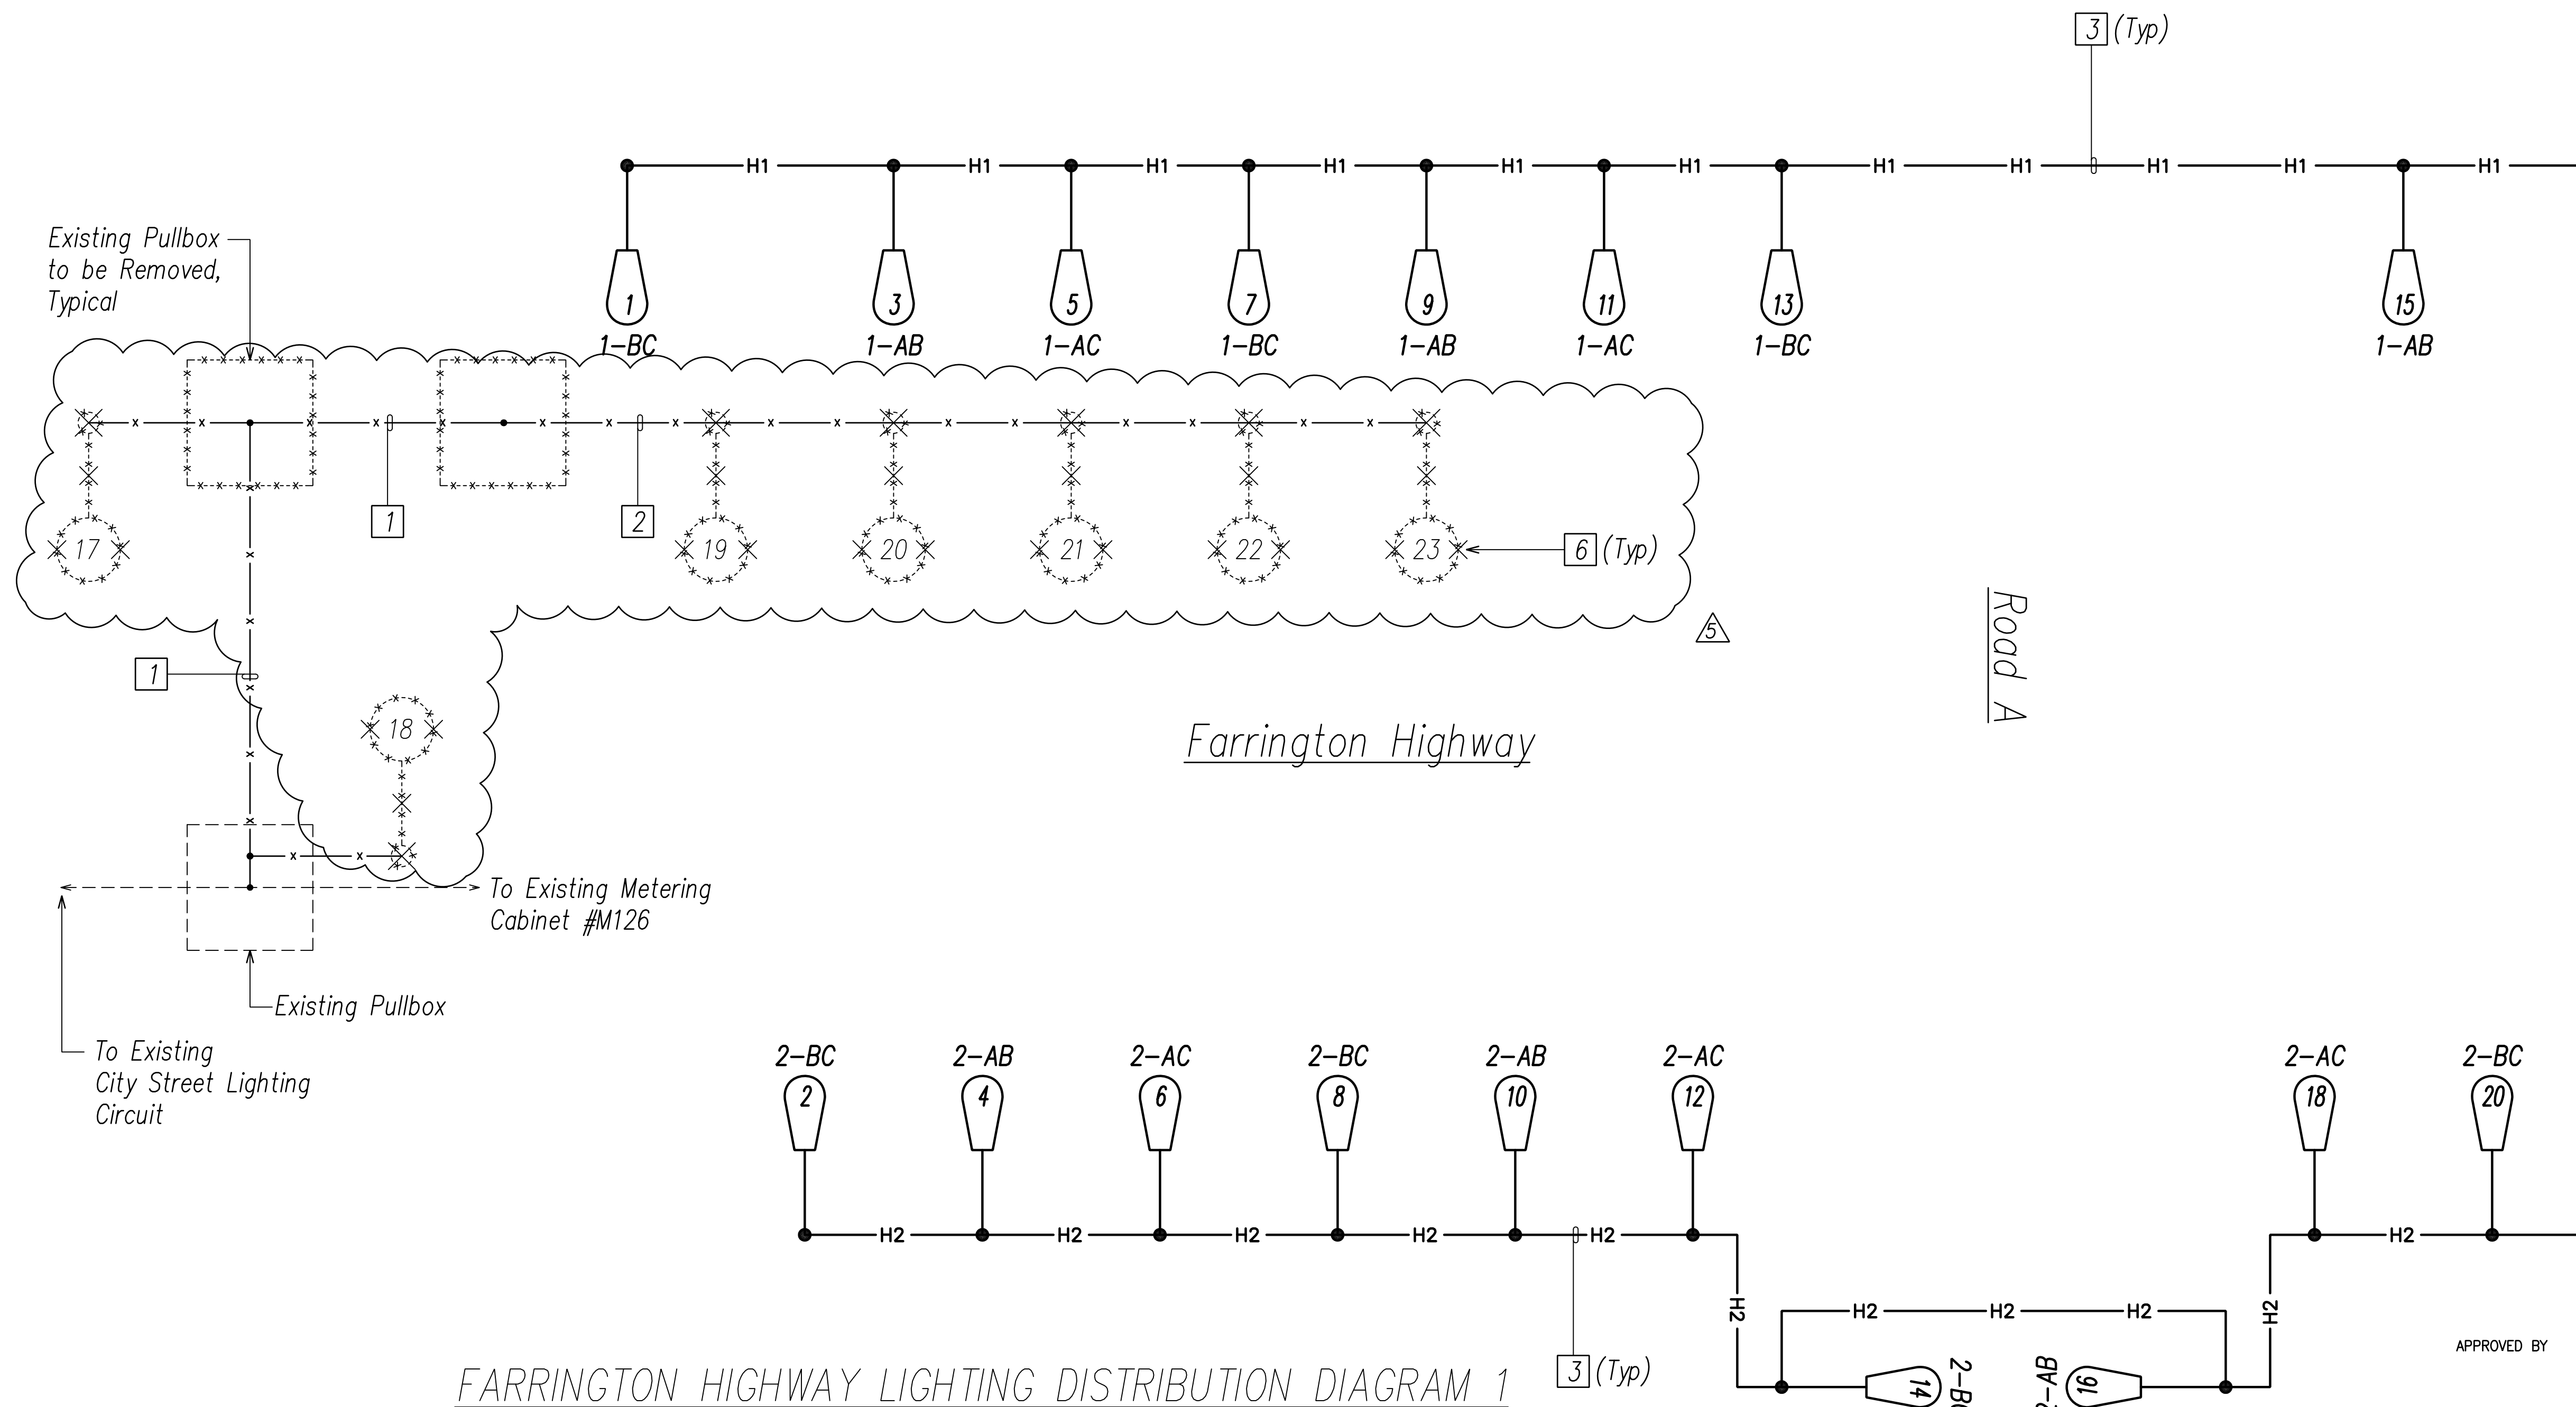

FARRINGTON HIGHWAY LIGHTING DISTRIBUTION DIAGRAM 1

**DIAGRAM NOTES:** (Items in ( ) Identified on Diagrams as Boxed Items)

- (1) Existing Underground Conductors, to be Removed
- (2) Existing Overhead Conductors, to be Removed
- (3) New 2" C, 3#2, 1#2 Gnd
- 4. General Notes:
  - a. Not all Highway Light Pullboxes are shown; See Highway Lighting Plans for Conduit and Pullbox Requirements.
  - b. For Typical Highway Lighting Standard Wiring Connection Diagram, See Sheet EG-14.
- 5. ~~New Pullboxes and Junction Boxes Are Not Shown on Diagram for Clarity.~~
- (6) Existing City Street Light, to be Removed

**DIAGRAM WIRING SYMBOLS:**

Symbol	Description
— H1 —	Denotes New Conduit with New Lighting Circuit H1
— H2 —	Denotes New Conduit with New Lighting Circuit H2
— K3 —	Denotes New Conduit with New Lighting Circuit H3.
— K4 —	Denotes New Conduit with New Lighting Circuit H4.
- - - - -	Denotes Existing Equipment and Wiring.
- x - x - x -	Denotes Existing Equipment, Conduit, and Wiring to be Removed.

SURVEY PLOTTED BY	DATE
DRAWN BY	
TRACED BY	
QUANTITIES BY	
CHECKED BY	
ORIGINAL PLAN	
NOTE BOOK	
No.	

FILE: Z:\ACAD\PROJECTS\220678\EG01\_220678.dwg, 11:00:07 AM, 7/15/2022



THIS WORK WAS PREPARED BY ME OR UNDER MY SUPERVISION AND CONSTRUCTION OF THIS PROJECT WILL BE UNDER MY OBSERVATION.  
 Scott Shirasishi  
 SIGNATURE  
 April 30, 2024  
 EXPIRATION DATE OF THE LICENSE

07/15/22 REVISED SYMBOLS  
 DATE REVISION

STATE OF HAWAII  
 DEPARTMENT OF TRANSPORTATION  
 HIGHWAYS DIVISION

**HIGHWAY LIGHTING  
 CONNECTION DIAGRAM 1**

FARRINGTON HIGHWAY WIDENING  
 Kapolei Golf Course Road to Fort Weaver Road  
 Project No. 7101A-01-20

Scale: As Shown Date: April 2022


SHEET No. EG-01 OF 17 SHEETS

APPROVED BY  
 PROGRAM ADMINISTRATOR, MECHANICAL/ELECTRICAL DIVISION DATE  
 DEPT. OF DESIGN AND CONSTRUCTION  
 CITY & COUNTY OF HONOLULU

MATCHLINE "A" SEE CONT. SHT. EG-2




FED. ROAD DIST. NO.	STATE	PROJ. NO.	FISCAL YEAR	SHEET NO.	TOTAL SHEETS
HAWAII	HAW.	710A-01-20	2021	EK-02	790

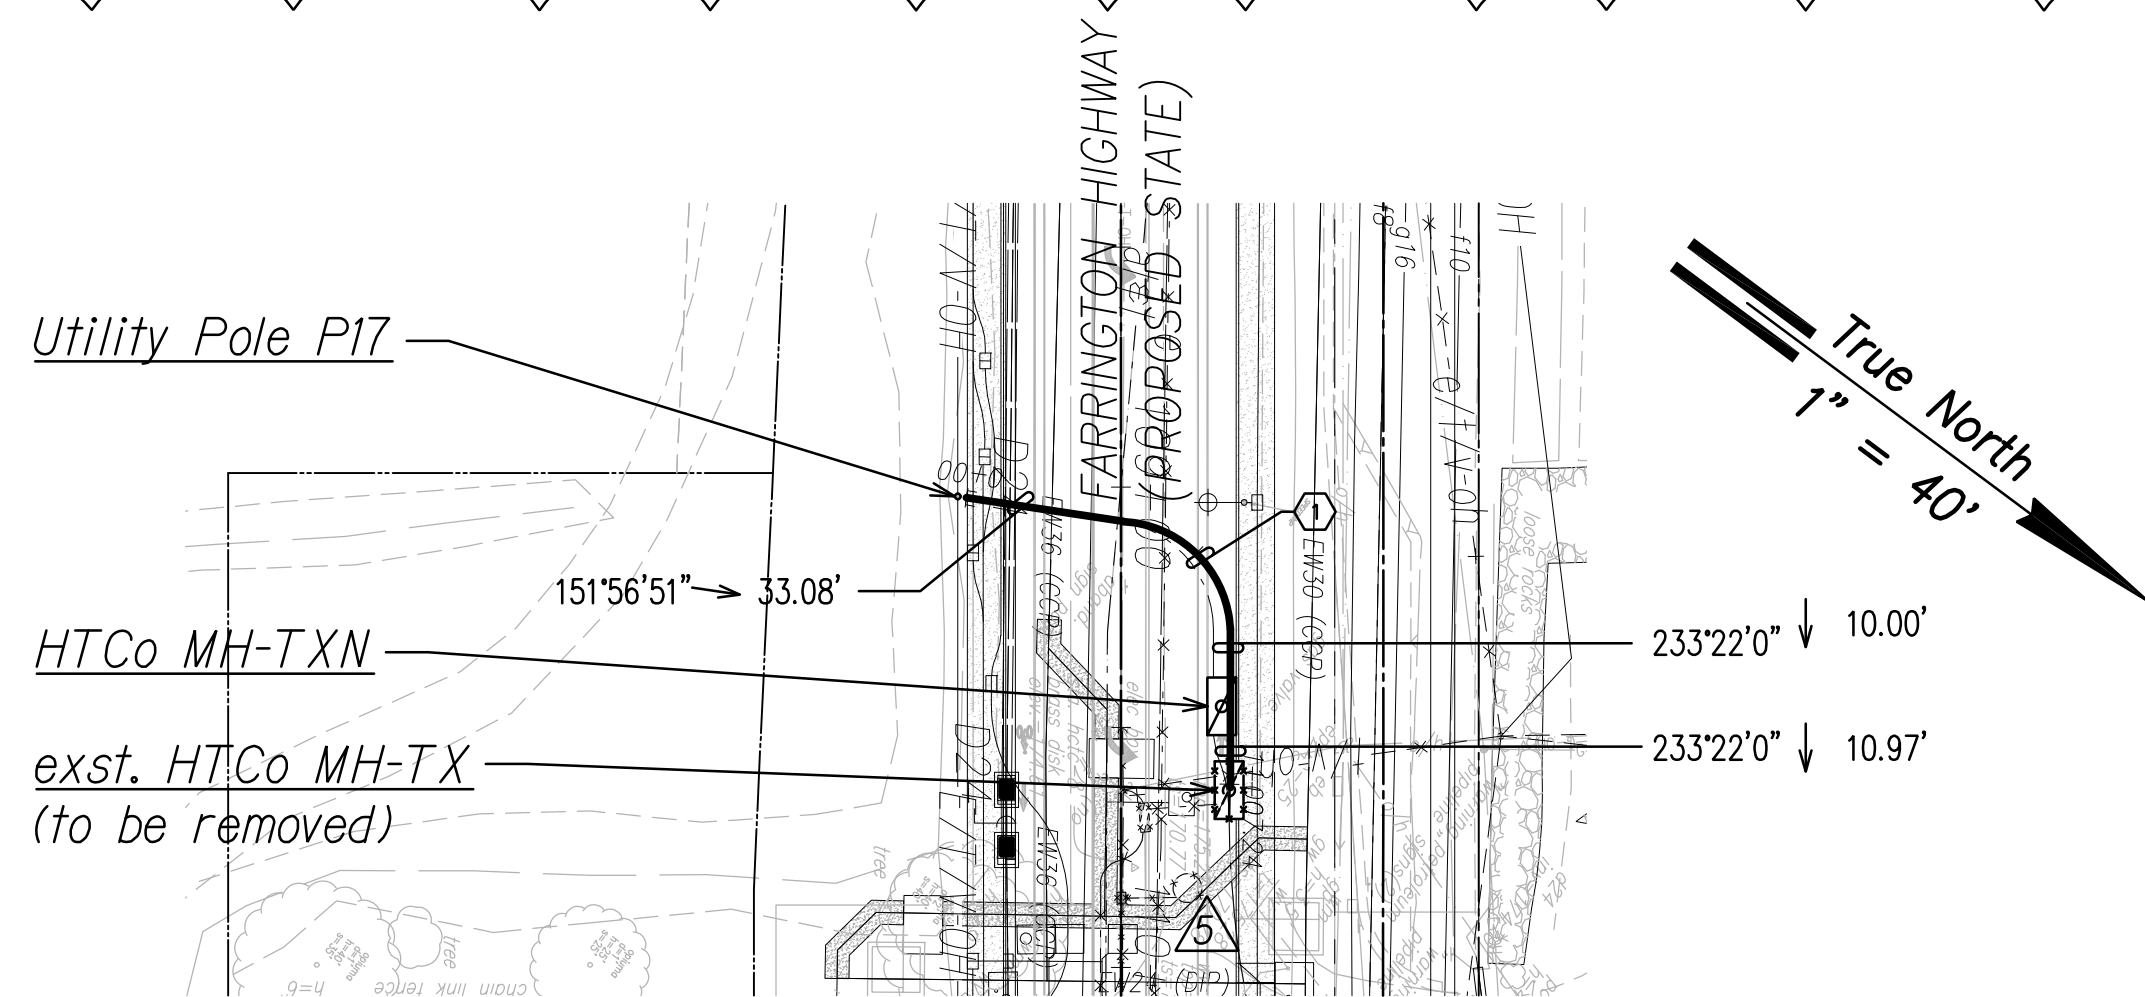

**HTCO DUCTLINE "D1"**

CURVE DATA						
ID	Δ	Δ / 2	RADIUS	T	C	Lc
(1)	84°0'46"	42°0'22.9"	23.62'	21.27'	31.62'	34.64'


**HTCo Ductline "D1" - Plan**  
Scale: 1" = 40'

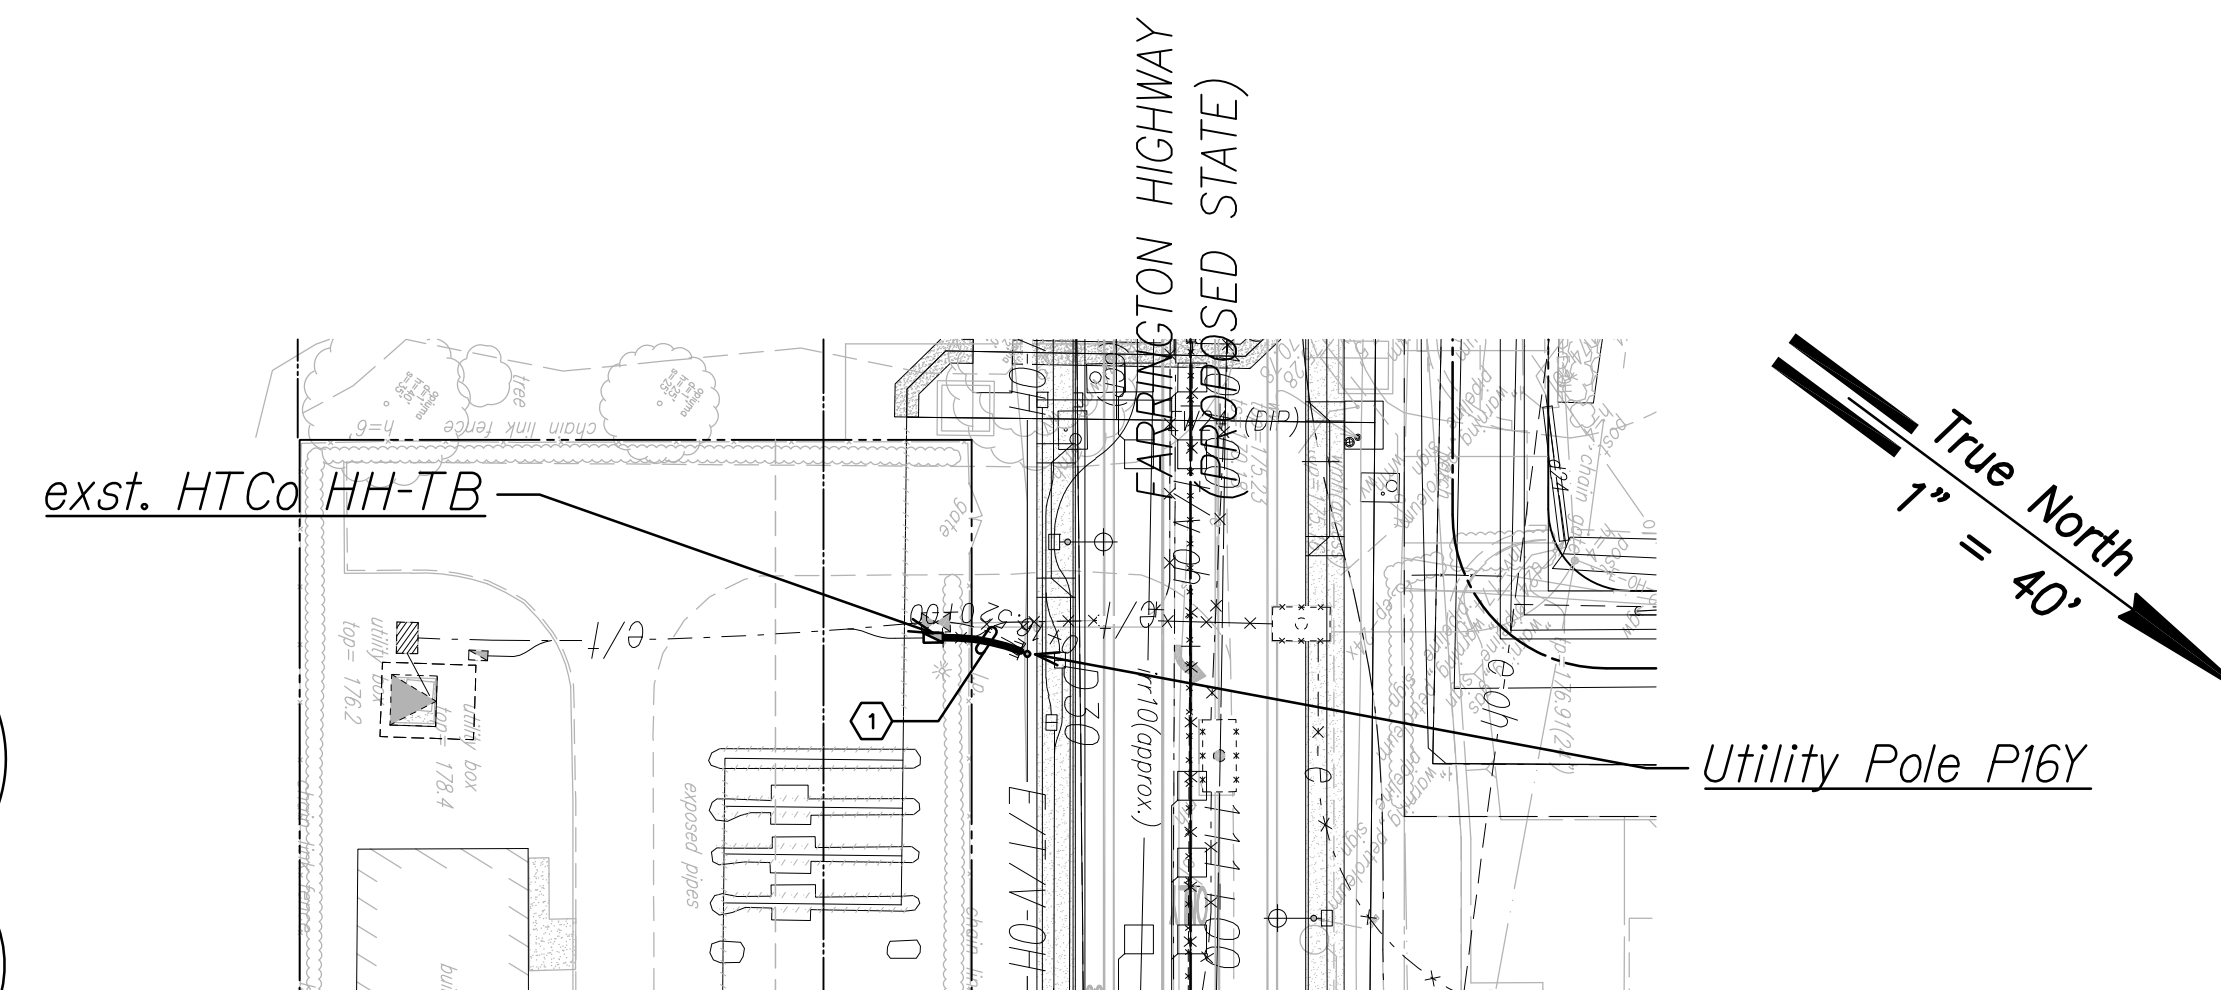


**HTCO DUCTLINE "D2"**

CURVE DATA						
ID	Δ	Δ / 2	RADIUS	T	C	Lc
(1)	22°21'26"	11°10'43.2"	42.29'	8.36'	16.40'	16.50'

**HTCo Ductline "D2" - Plan**  
Scale: 1" = 40'

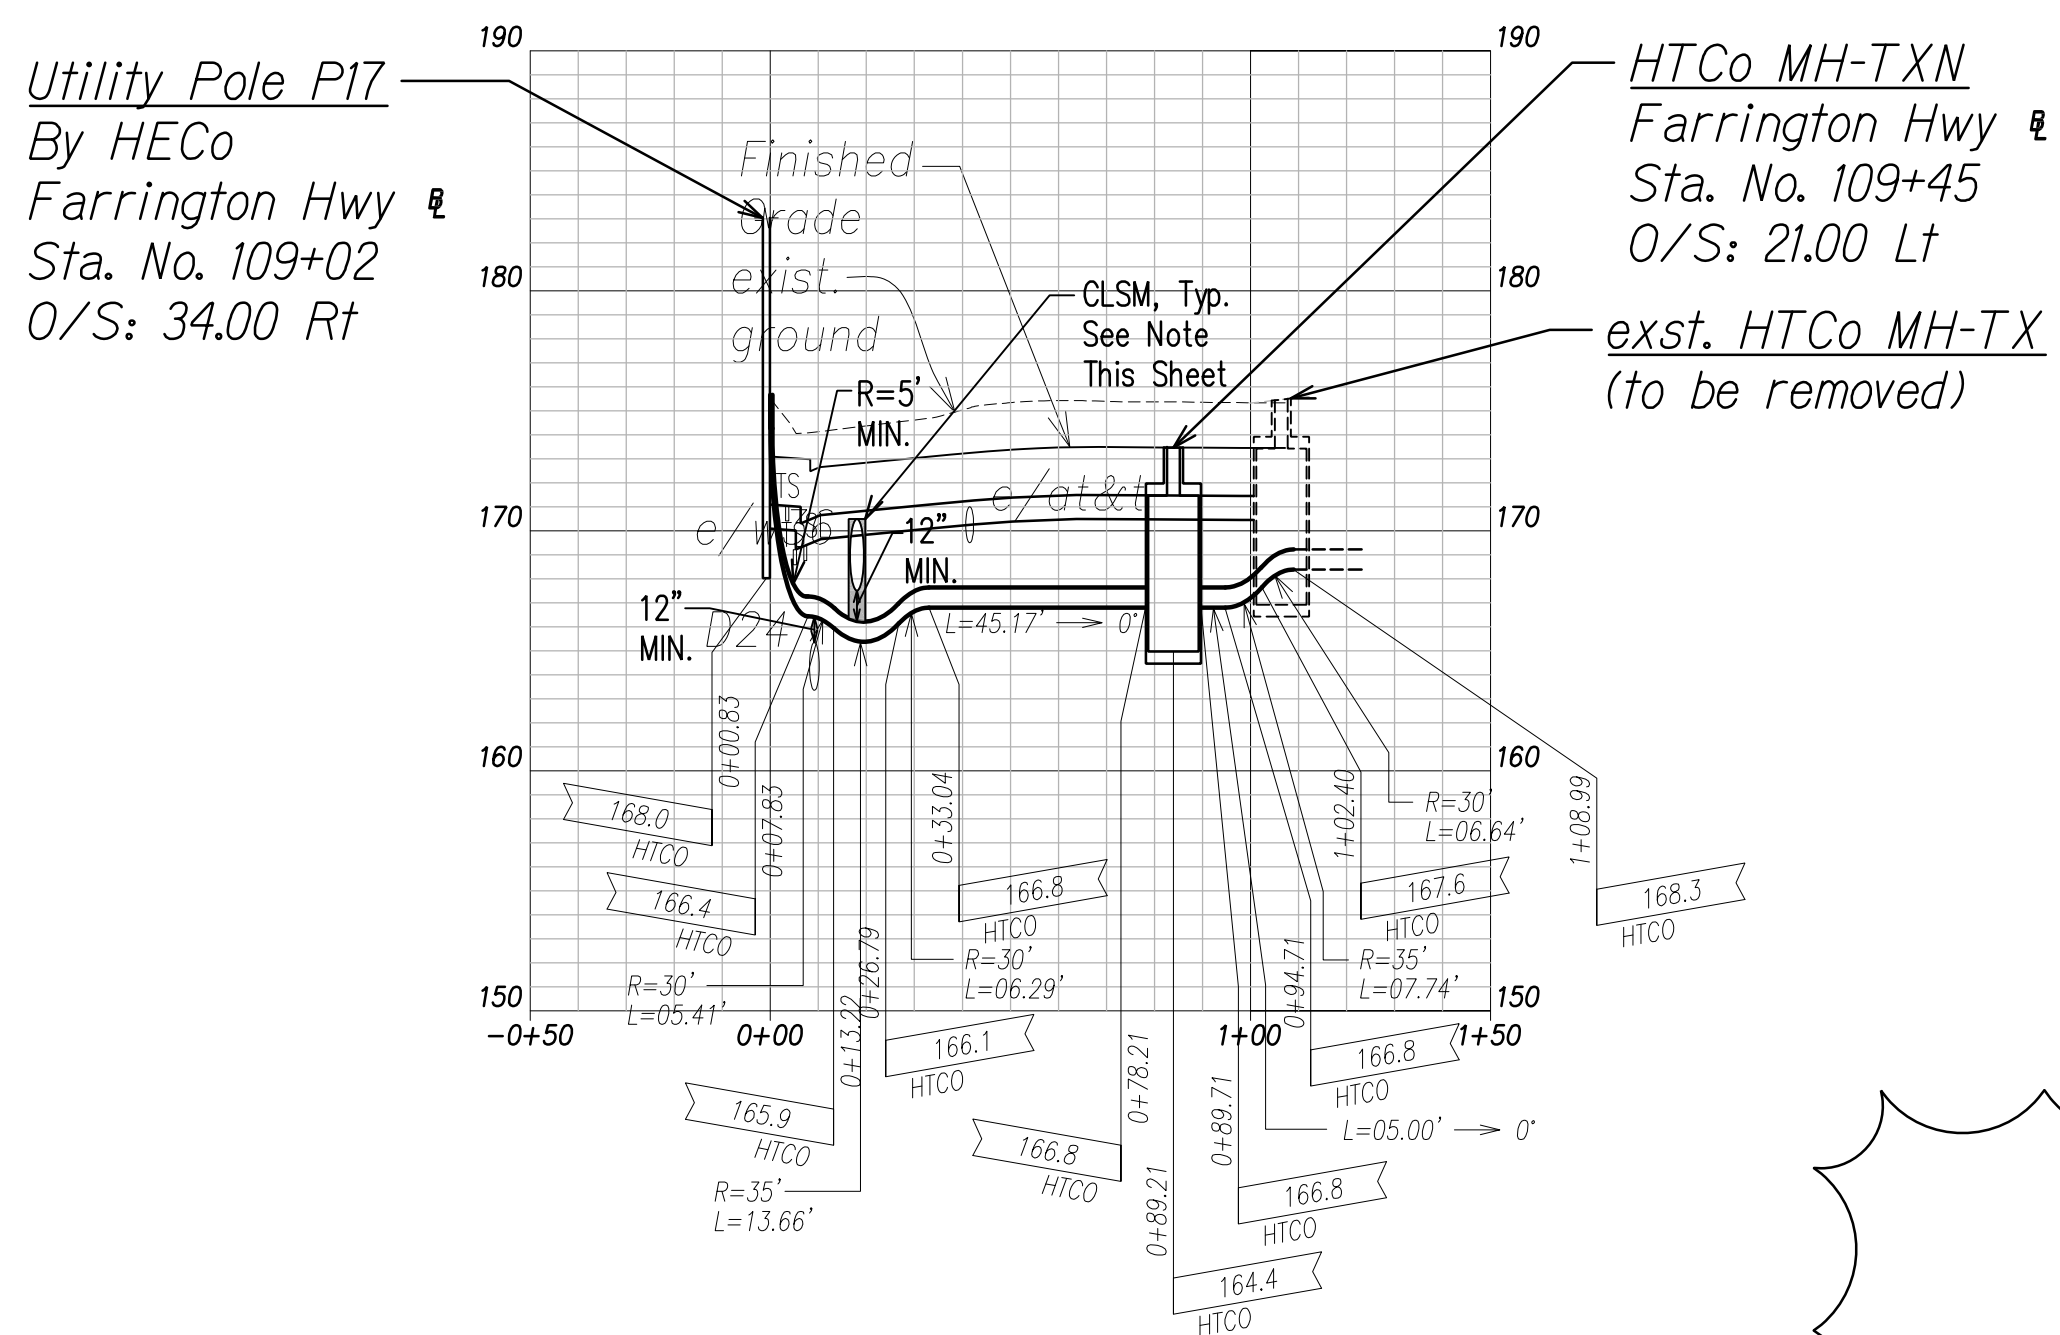

**HTCo Ductline "D1" - Profile**  
Scale: Horiz. 1" = 40'  
Vert. 1" = 4'

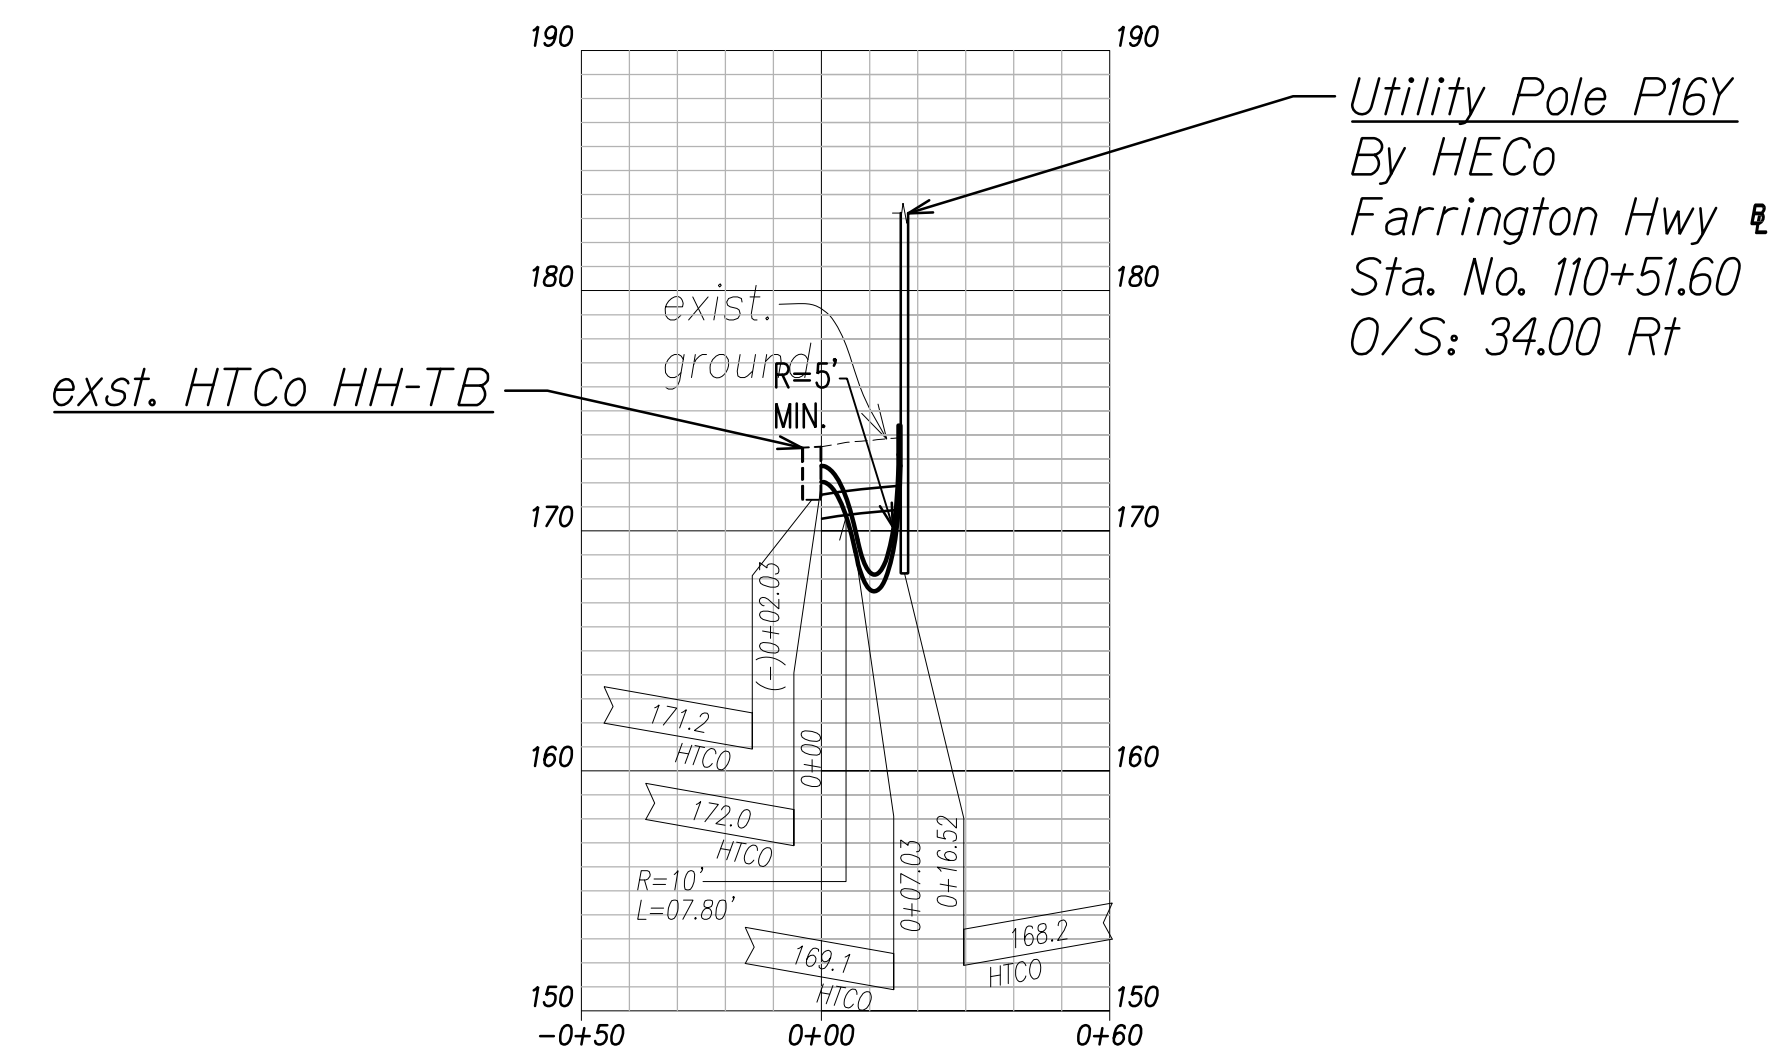



**HTCo Ductline "D2" - Profile**  
Scale: Horiz. 1" = 40'  
Vert. 1" = 4'

**Note:**  
The Contractor Shall Provide Controlled Low Strength Material (CLSM) in Areas Where Required Compaction Cannot be Met. CLSM Shall be Extended a Minimum of 2' Beyond the Waterline at the Crossing and Shall Extend to the Top of the Crossing Pipe.

SURVEY PLOTTED BY	DATE
DRAWN BY	
TRACED BY	
QUANTITIES BY	
CHECKED BY	
ORIGINAL PLAN	
NOTE BOOK	
No.	

FILE: Z:\ACAD\PROJECTS\22066711\22066711-02\22066711-02\22066711-02.dwg saved July 14, 2022

APPROVED BY  
HAWAIIAN TELCOM  
DATE

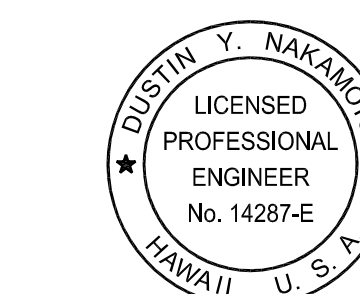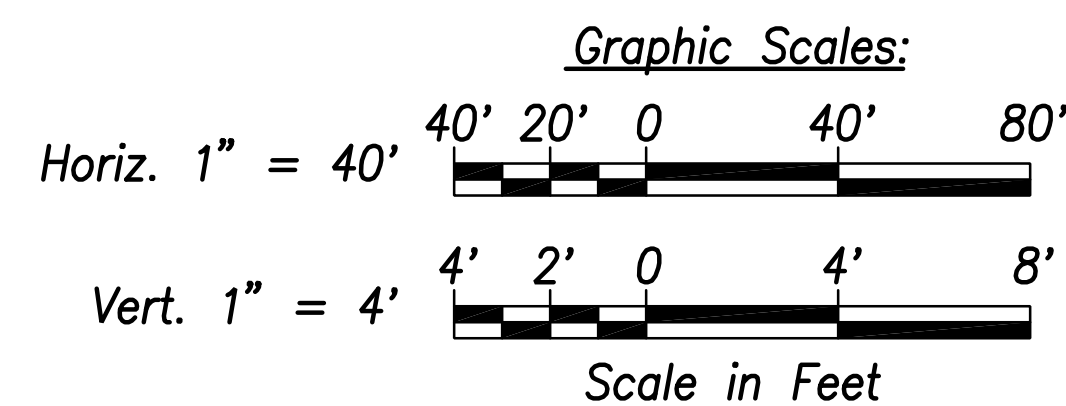

THIS WORK WAS PREPARED BY ME OR UNDER MY SUPERVISION AND CONSTRUCTION OF THIS PROJECT WILL BE UNDER MY OBSERVATION.

SIGNATURE:   
April 30, 2024  
EXPIRATION DATE OF THE LICENSE

07/15/22	5	UPDATED HTCO DUCTLINE "D1"
06/08/22	2	ADDED DRAWING
DATE		REVISION

STATE OF HAWAII  
DEPARTMENT OF TRANSPORTATION  
HIGHWAYS DIVISION


**HTCo DUCTLINE  
PLAN & PROFILE "D1 & "D2"**

FARRINGTON HIGHWAY WIDENING  
Kapolei Golf Course Road to Fort Weaver Road  
Project No. 7101A-01-20

Scale: As Shown Date: April 2022

**SHEET NO. EK-02 OF 5 SHEETS**


FED. ROAD DIST. NO.	STATE	PROJ. NO.	FISCAL YEAR	SHEET NO.	TOTAL SHEETS
HAWAII	HAW.	710A-01-20	2021	EK-05	790

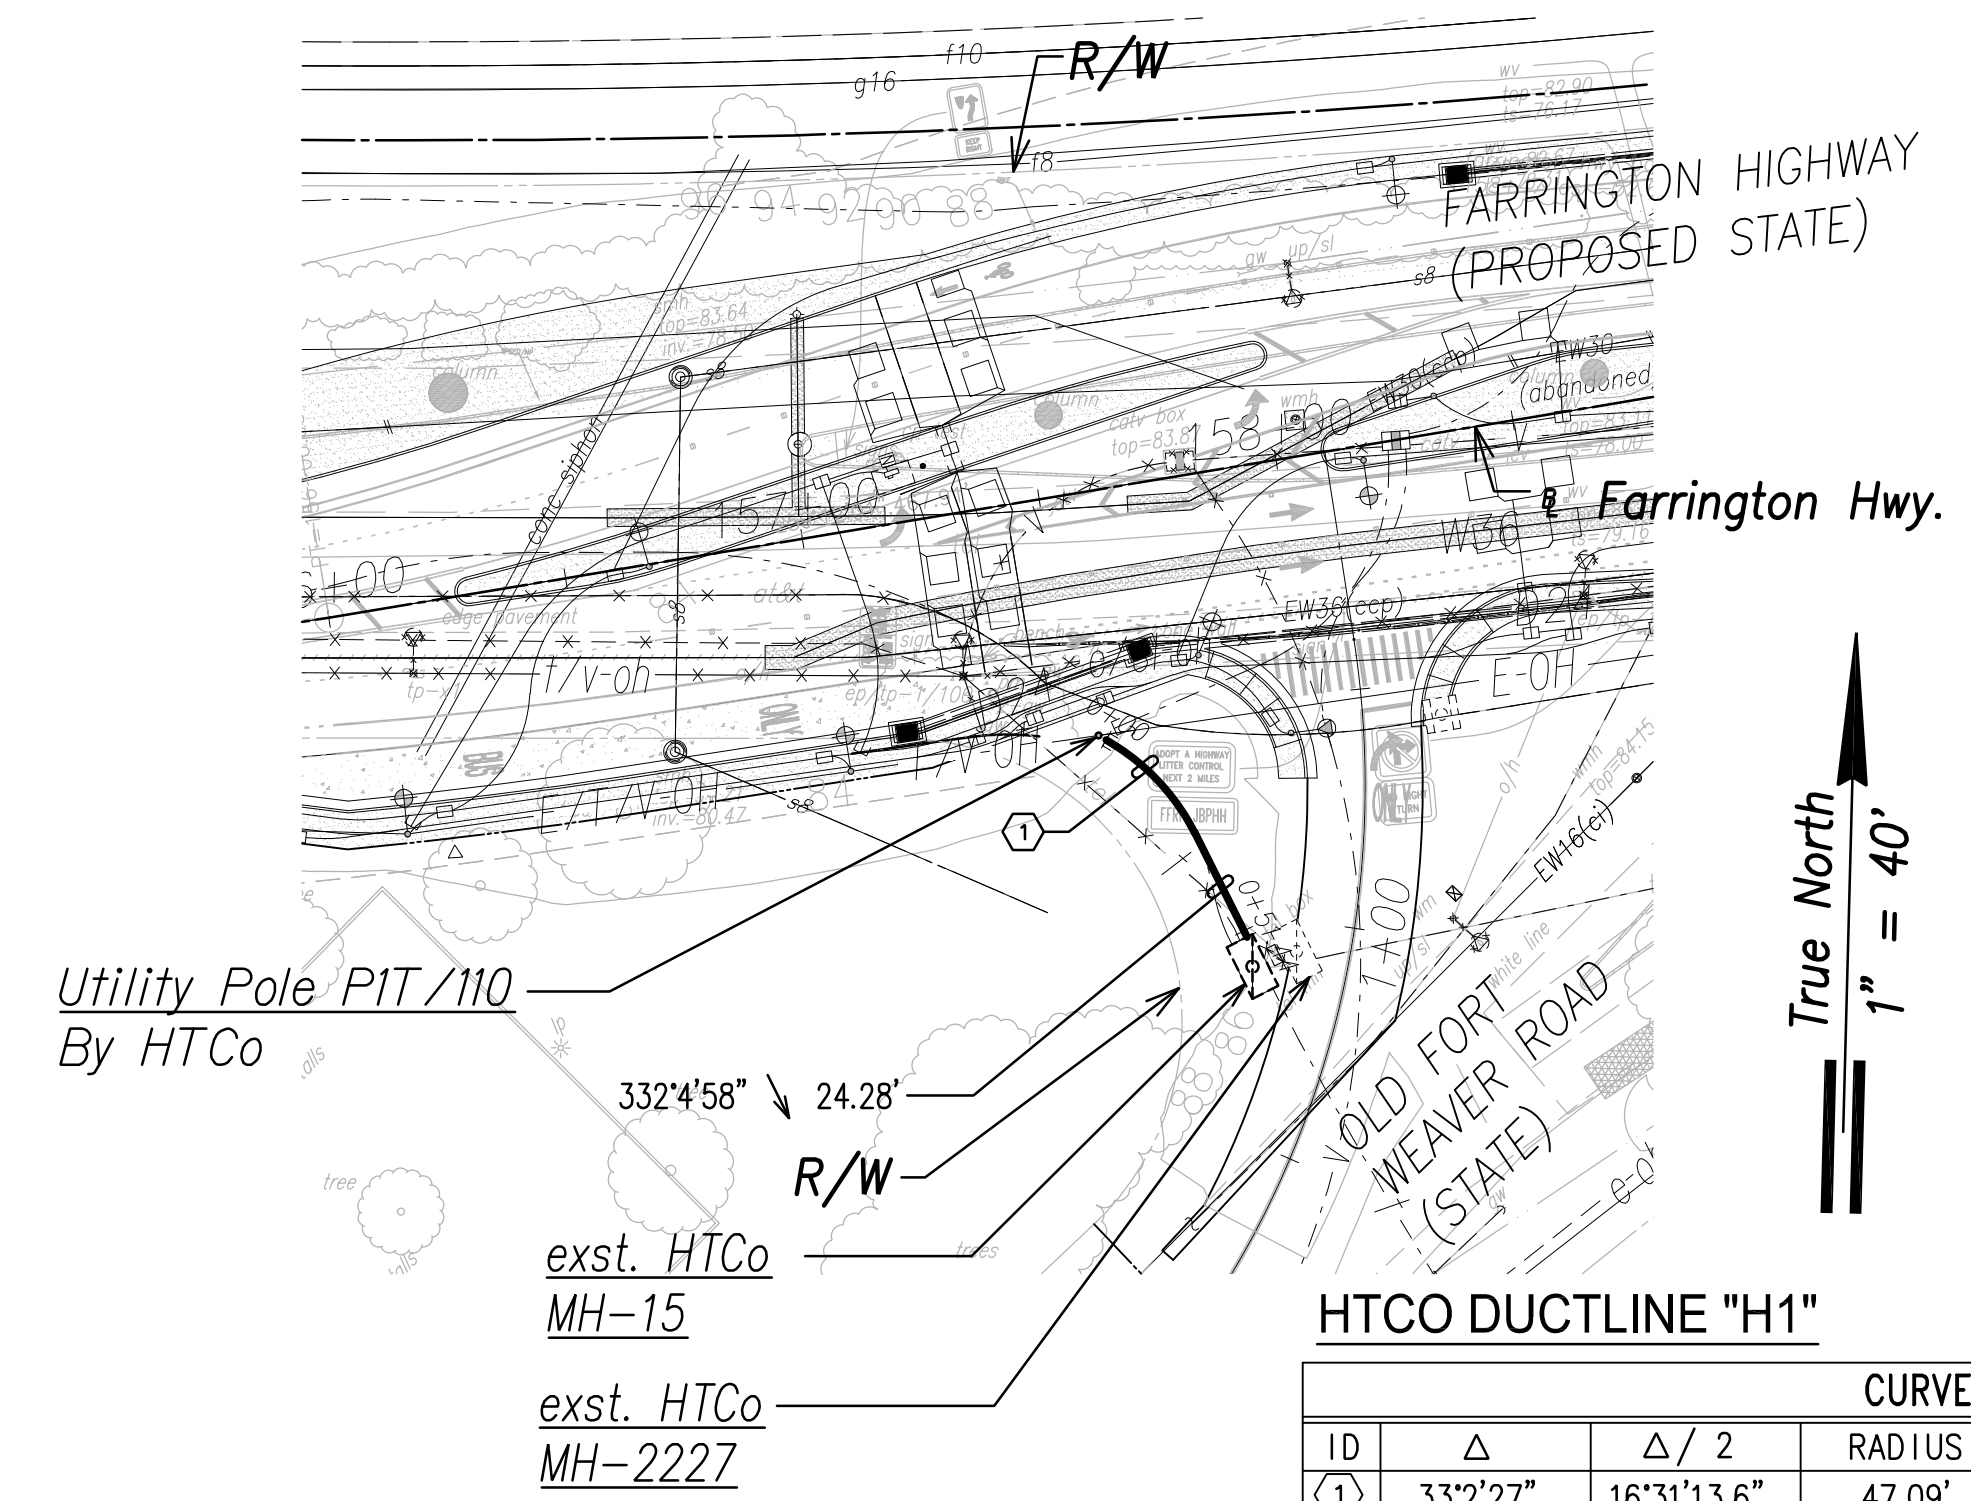

**HTCO DUCTLINE "H1"**


CURVE DATA						
ID	Δ	Δ / 2	RADIUS	T	C	Lc
(1)	33°2'27"	16°31'13.6"	47.09'	13.97'	26.78'	27.16'

**HTCo Ductline "H1" - Plan**  
Scale: 1" = 40'

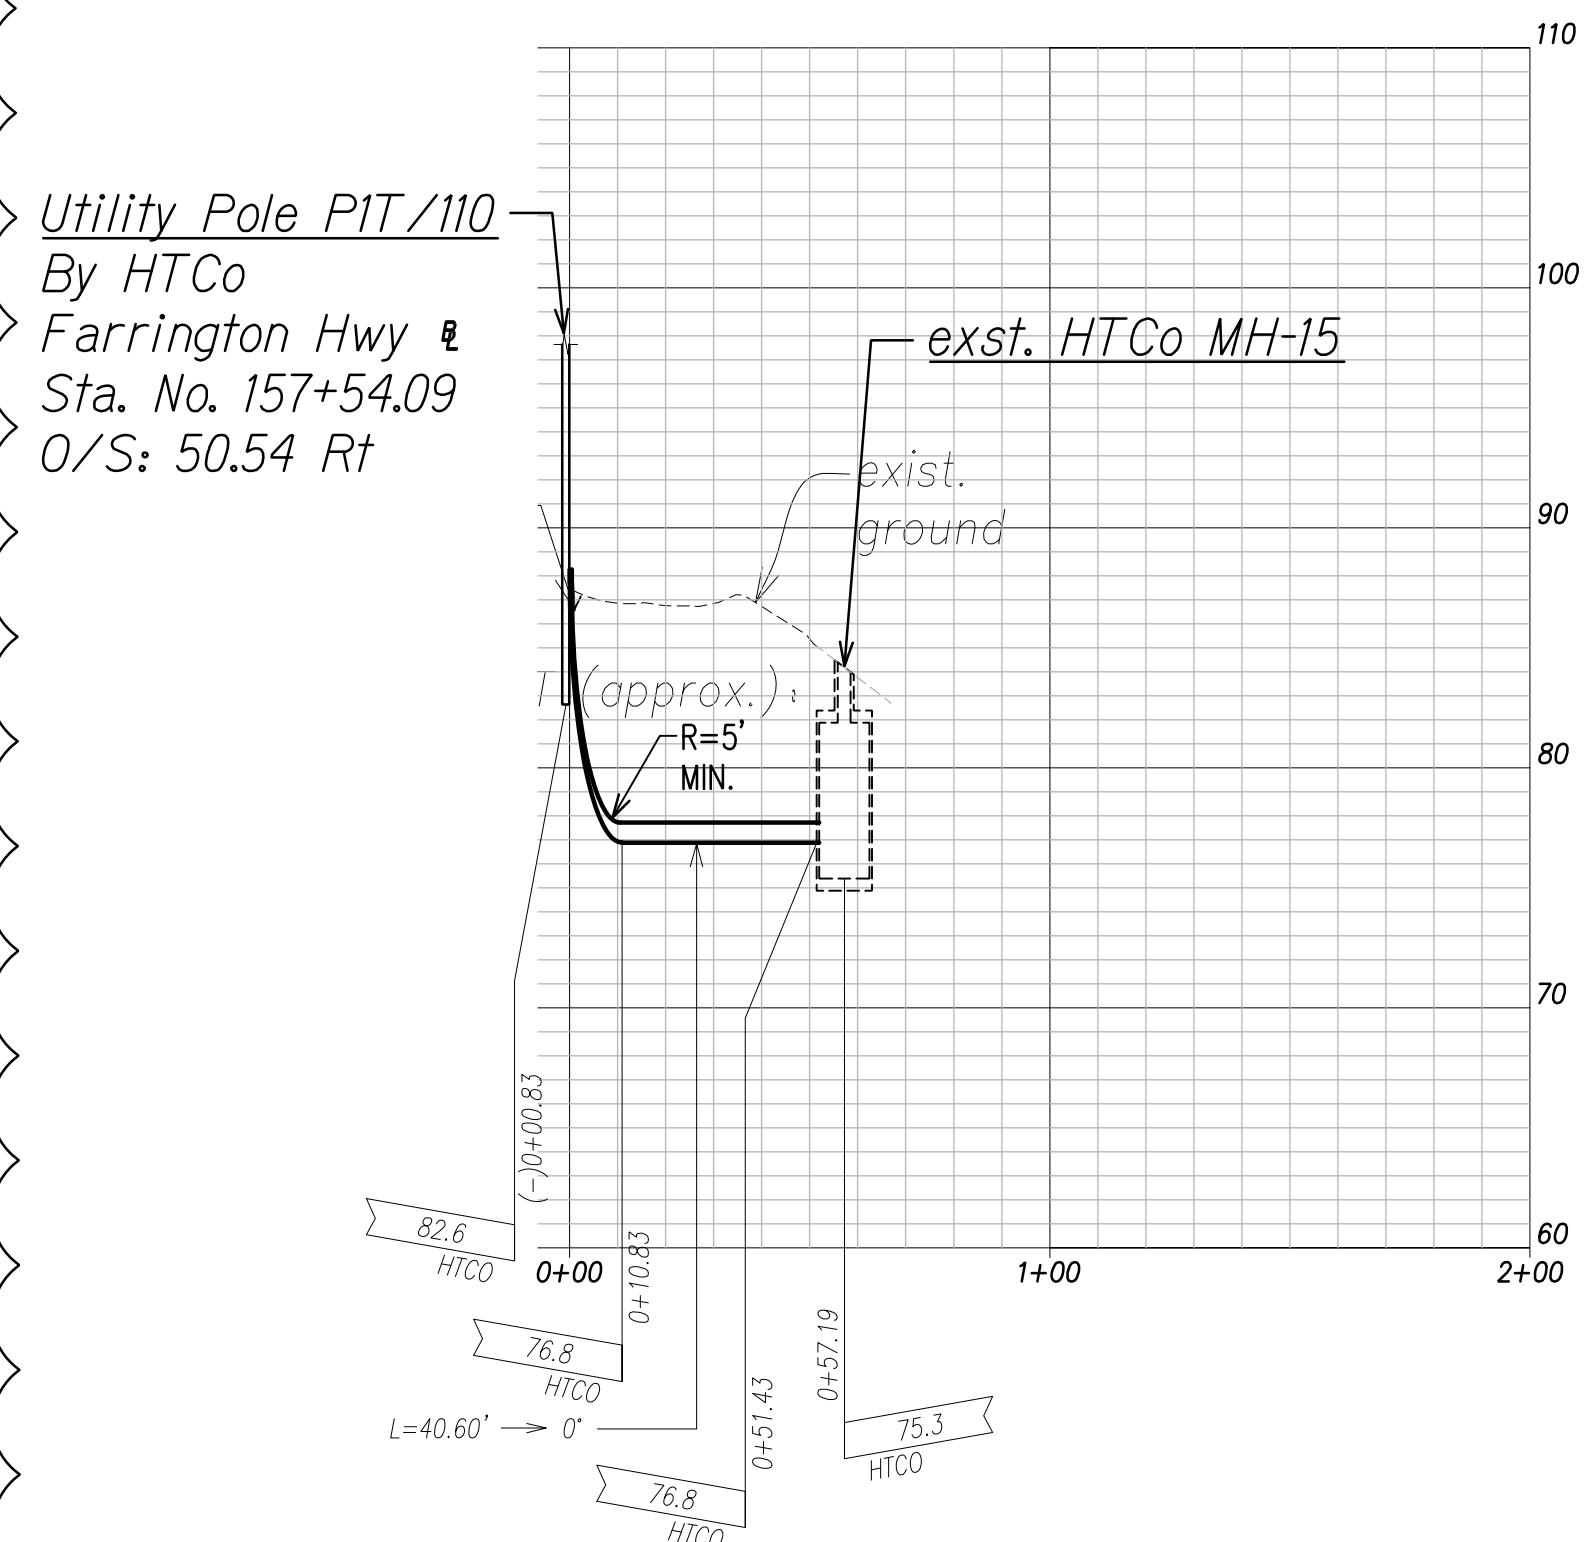

**HTCo Ductline "H1" - Profile**  
Scale: Horiz. 1" = 40'  
Vert. 1" = 4'


**Note:**  
The Contractor Shall Provide Controlled Low Strength Material (CLSM) in Areas Where Required Compaction Cannot be Met. CLSM Shall be Extended a Minimum of 2' Beyond the Waterline at the Crossing and Shall Extend to the Top of the Crossing Pipe.

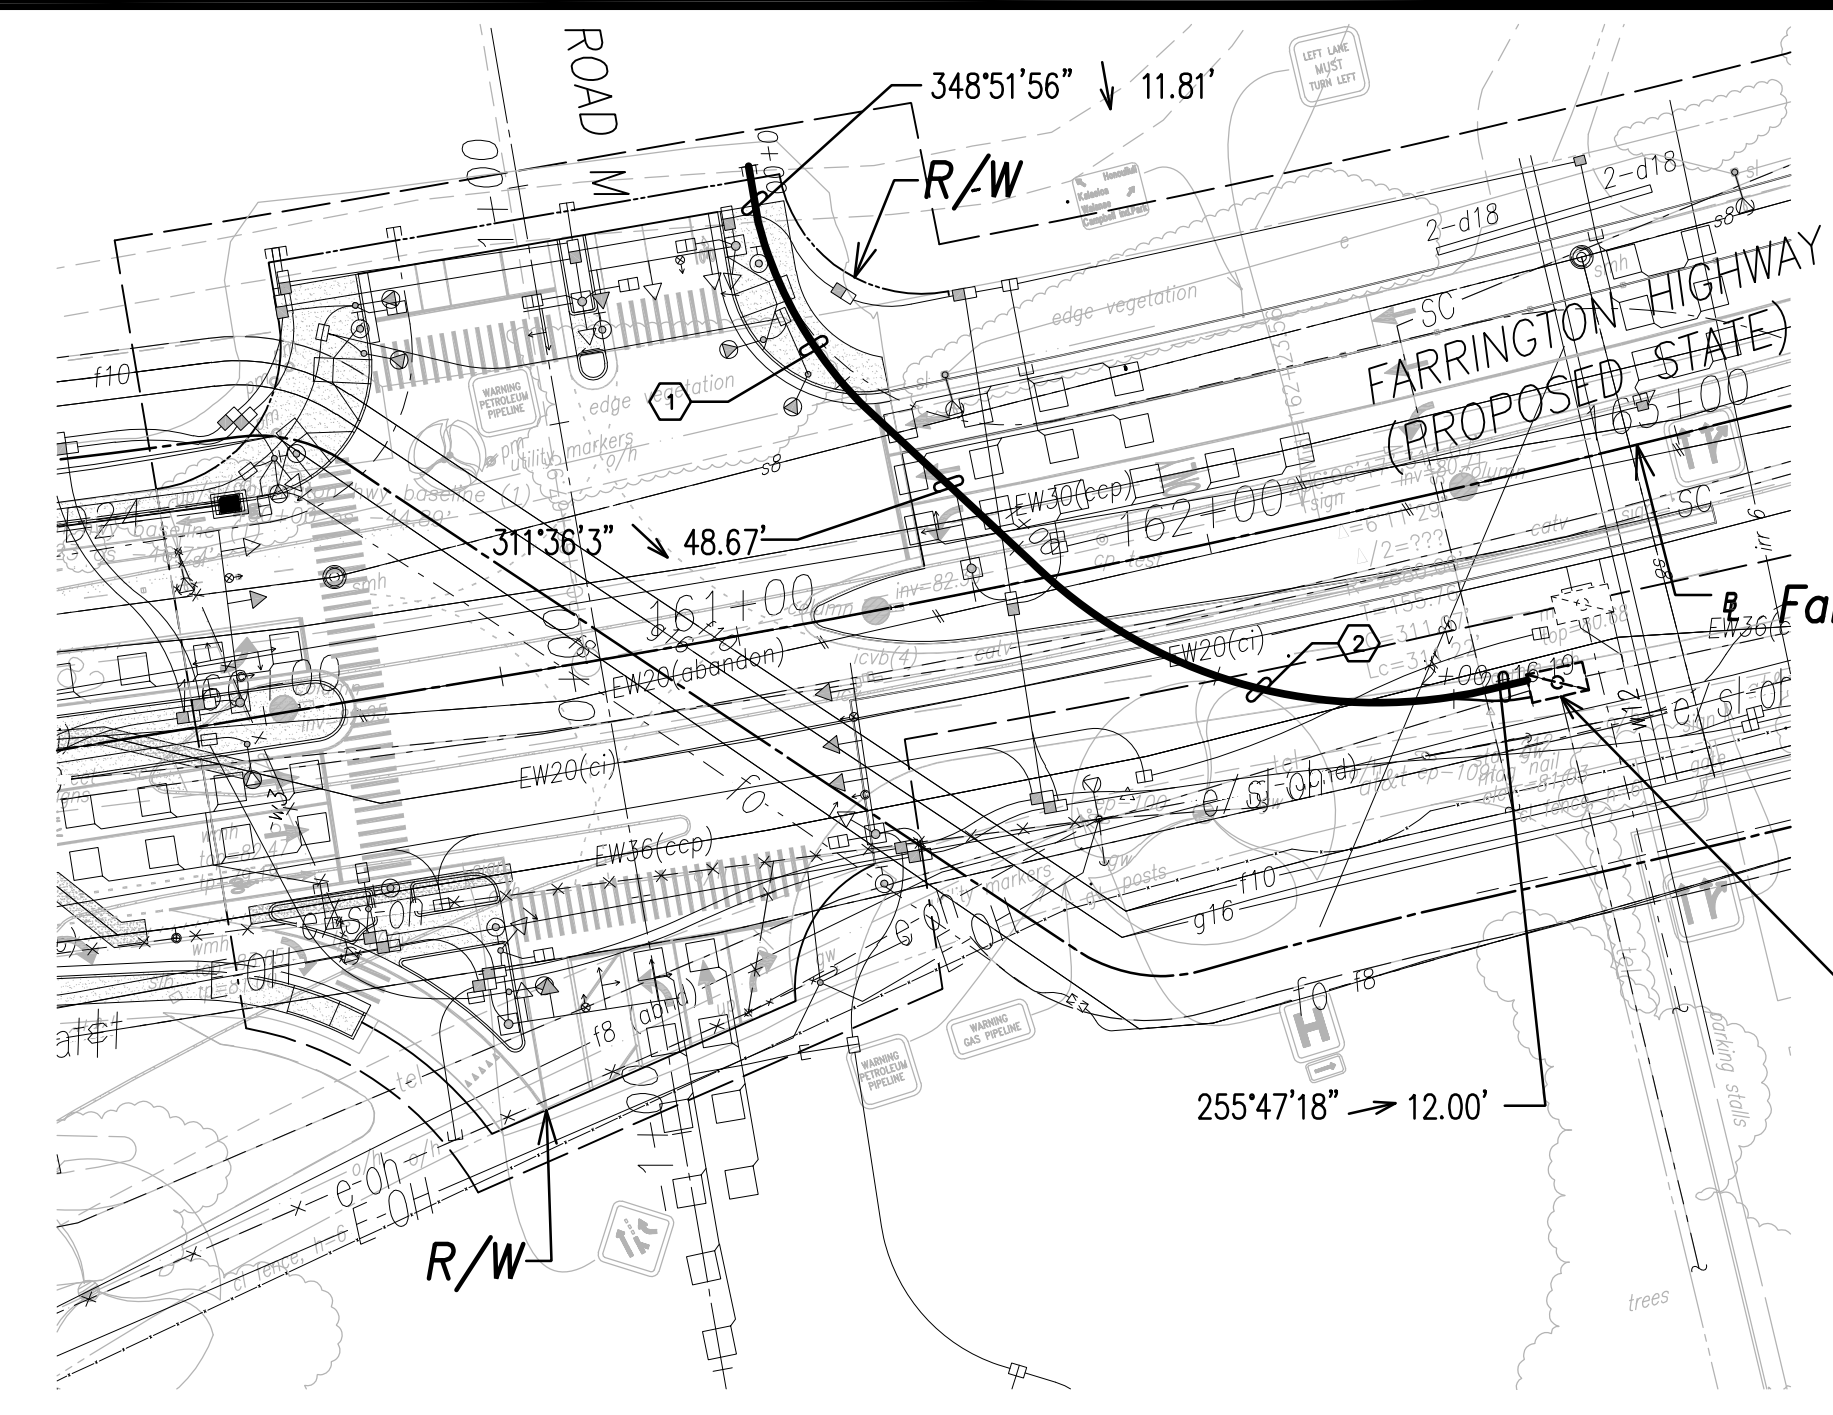

**HTCO DUCTLINE "H2"**



CURVE DATA						
ID	Δ	Δ / 2	RADIUS	T	C	Lc
(1)	29°21'3"	14°40'31.4"	85.32'	22.35'	43.23'	43.71'
(2)	55°32'19"	27°46'9.7"	102.67'	54.06'	95.67'	99.52'

**HTCo Ductline "H2" - Plan**  
Scale: 1" = 40'

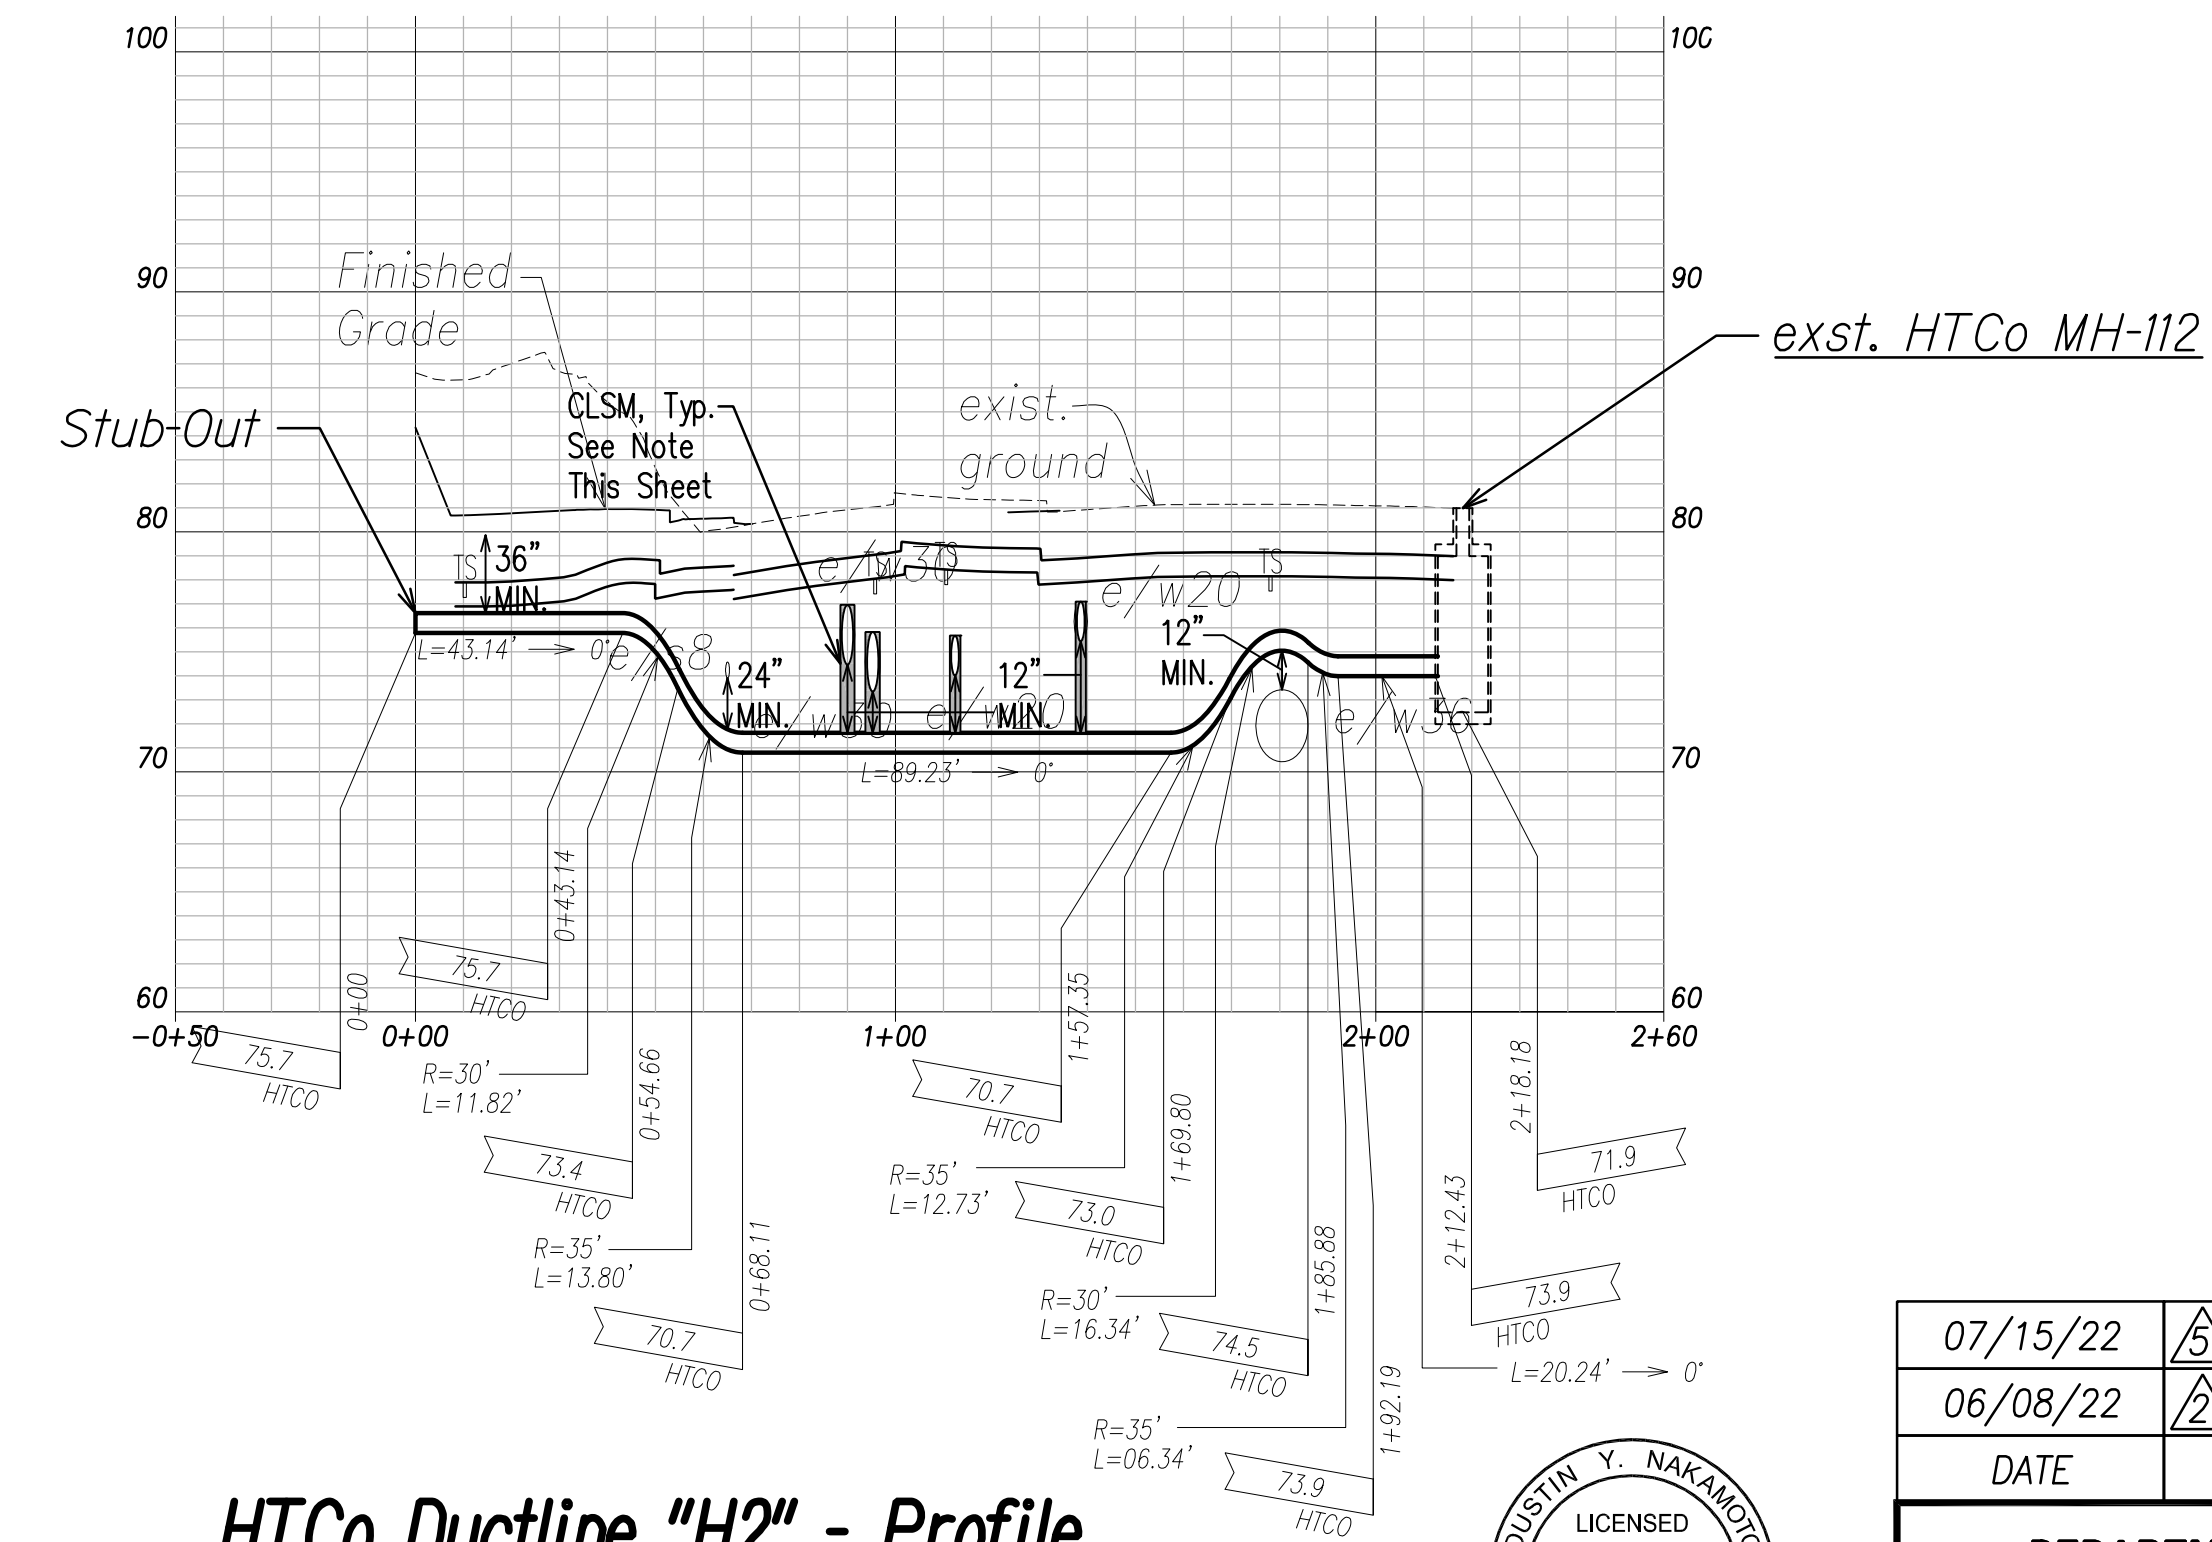

**HTCo Ductline "H2" - Profile**  
Scale: Horiz. 1" = 40'  
Vert. 1" = 4'

**Graphic Scales:**

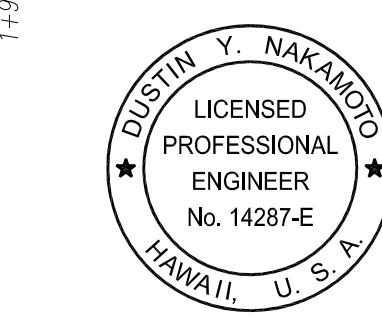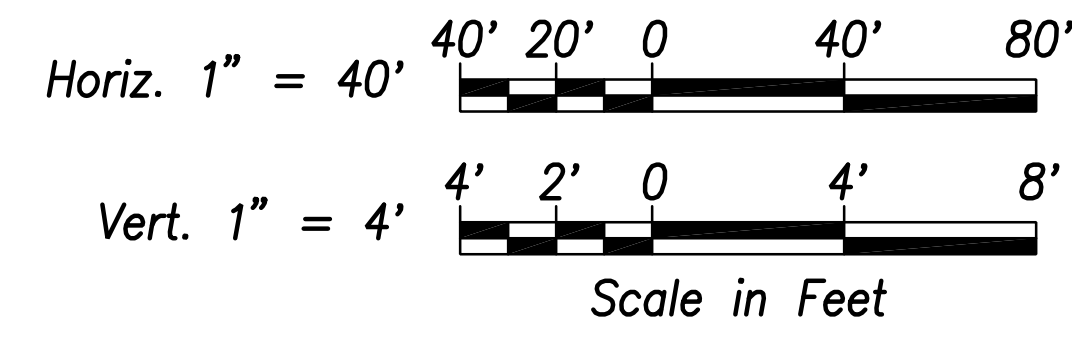

THIS WORK WAS PREPARED BY ME OR UNDER MY SUPERVISION AND CONSTRUCTION OF THIS PROJECT WILL BE UNDER MY OBSERVATION.

APRIL 30, 2024  
EXPIRATION DATE OF THE LICENSE

07/15/22	5	UPDATED HTCO DUCTLINE "H1"
06/08/22	2	ADDED DRAWING
DATE		REVISION

STATE OF HAWAII  
DEPARTMENT OF TRANSPORTATION  
HIGHWAYS DIVISION

**HTCO DUCTLINE  
PLAN & PROFILE "H1" & "H2"**

FARRINGTON HIGHWAY WIDENING  
Kapolei Golf Course Road to Fort Weaver Road  
Project No. 7101A-01-20

Scale: As Shown      Date: April 2022

**SHEET No. EK-05 OF 5 SHEETS**

DATE	SURVEY PLOTTED BY
DATE	DRAWN BY
DATE	TRACED BY
DATE	QUANTITIES BY
DATE	CHECKED BY
	No. _____


FILE: Z:\ACAD\PROJECTS\220679A\EK05\_220679A\HTCO-Ductline-Plan-Profile-H1-H2.dwg saved July 14, 2022

APPROVED BY  
HAWAIIAN TELCOM  
DATE






FED. ROAD DIST. NO.	STATE	PROJ. NO.	FISCAL YEAR	SHEET NO.	TOTAL SHEETS
HAWAII	HAW.	710A-01-20	2021	EL-06	790

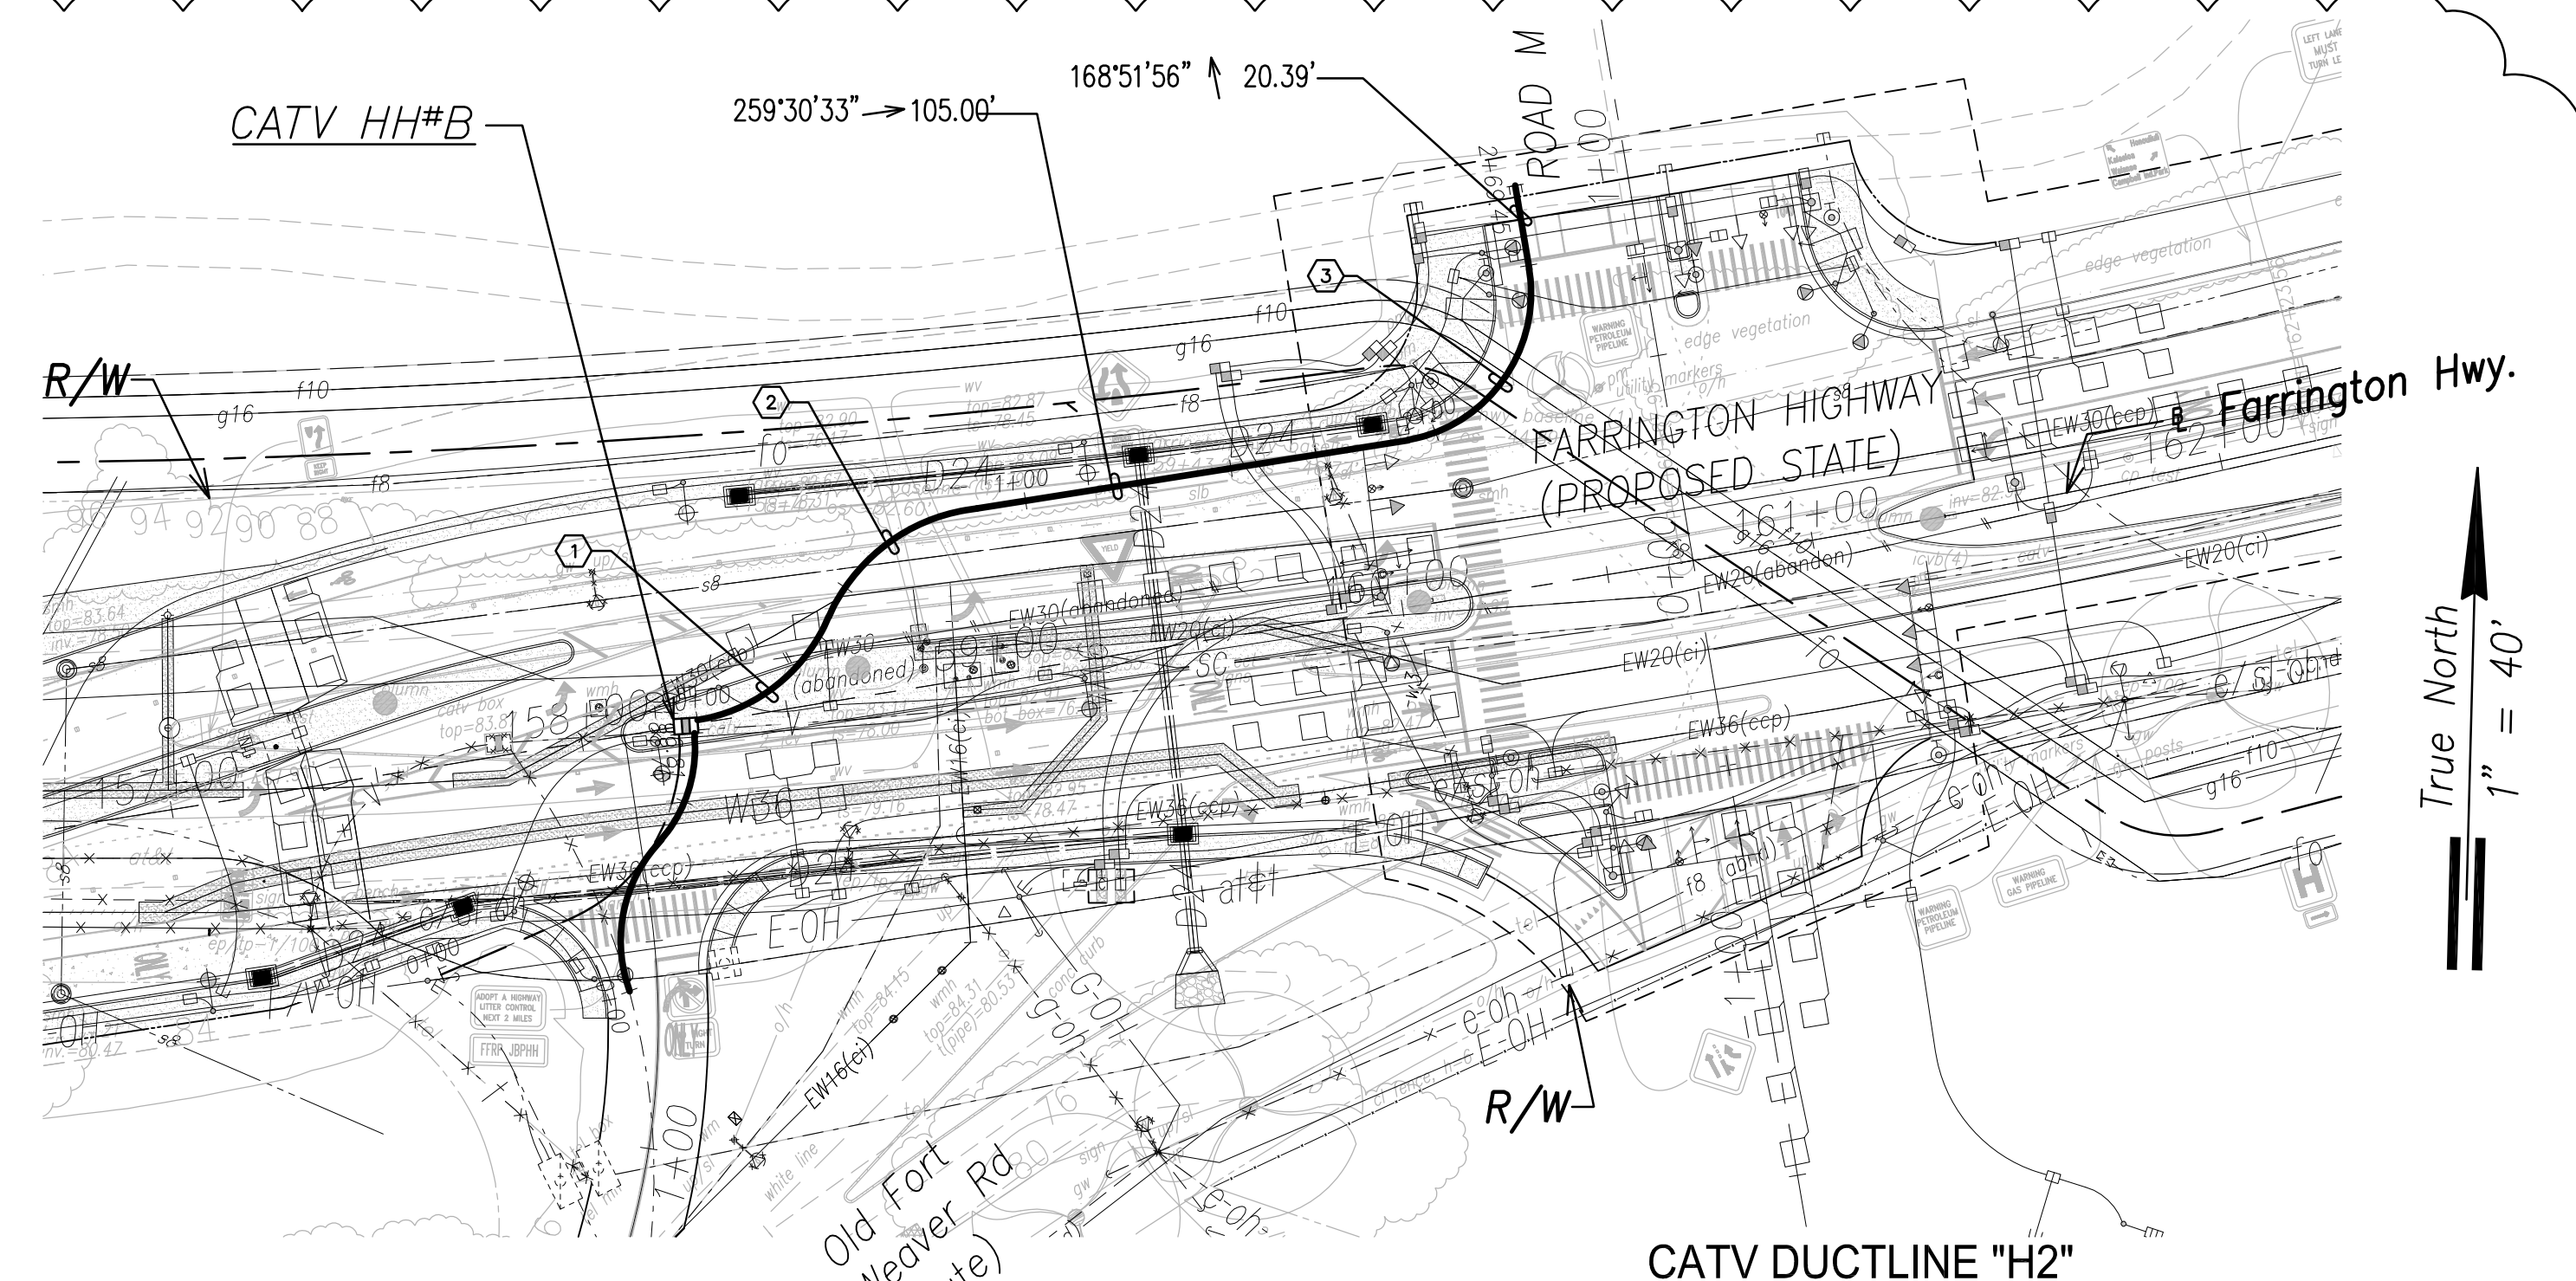

**CATV Ductline "H2" - Plan**  
Scale: 1" = 40'

**CATV DUCTLINE "H2"**


ID	Δ	Δ / 2	RADIUS	T	C	Lc
①	58°9'24"	29°4'42.2"	41.37'	23.01'	40.21'	41.99'
②	59°37'35"	29°48'47.3"	44.36'	25.42'	44.11'	46.17'
③	89°25'18"	44°42'39.2"	35.85'	35.49'	50.44'	55.95'

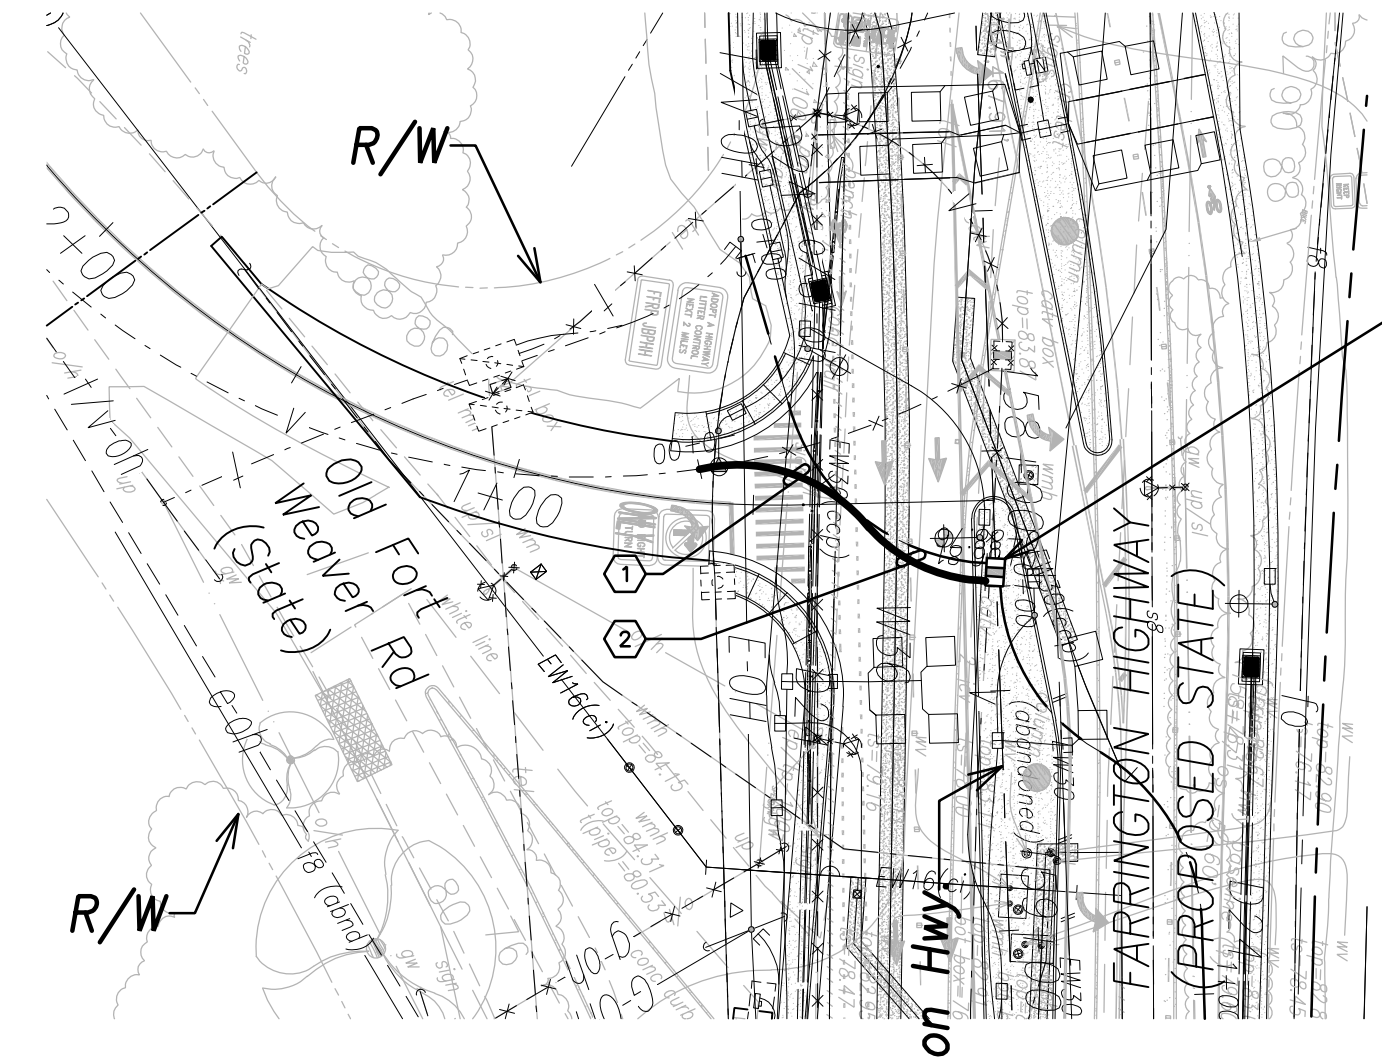


**CATV Ductline "H3" - Plan**  
Scale: 1" = 40'

**CATV DUCTLINE "H3"**

ID	Δ	Δ / 2	RADIUS	T	C	Lc
①	64°14'32"	32°7'16.2"	35.06'	22.01'	37.29'	39.31'
②	45°20'15"	22°40'7.4"	33.57'	14.02'	25.87'	26.56'

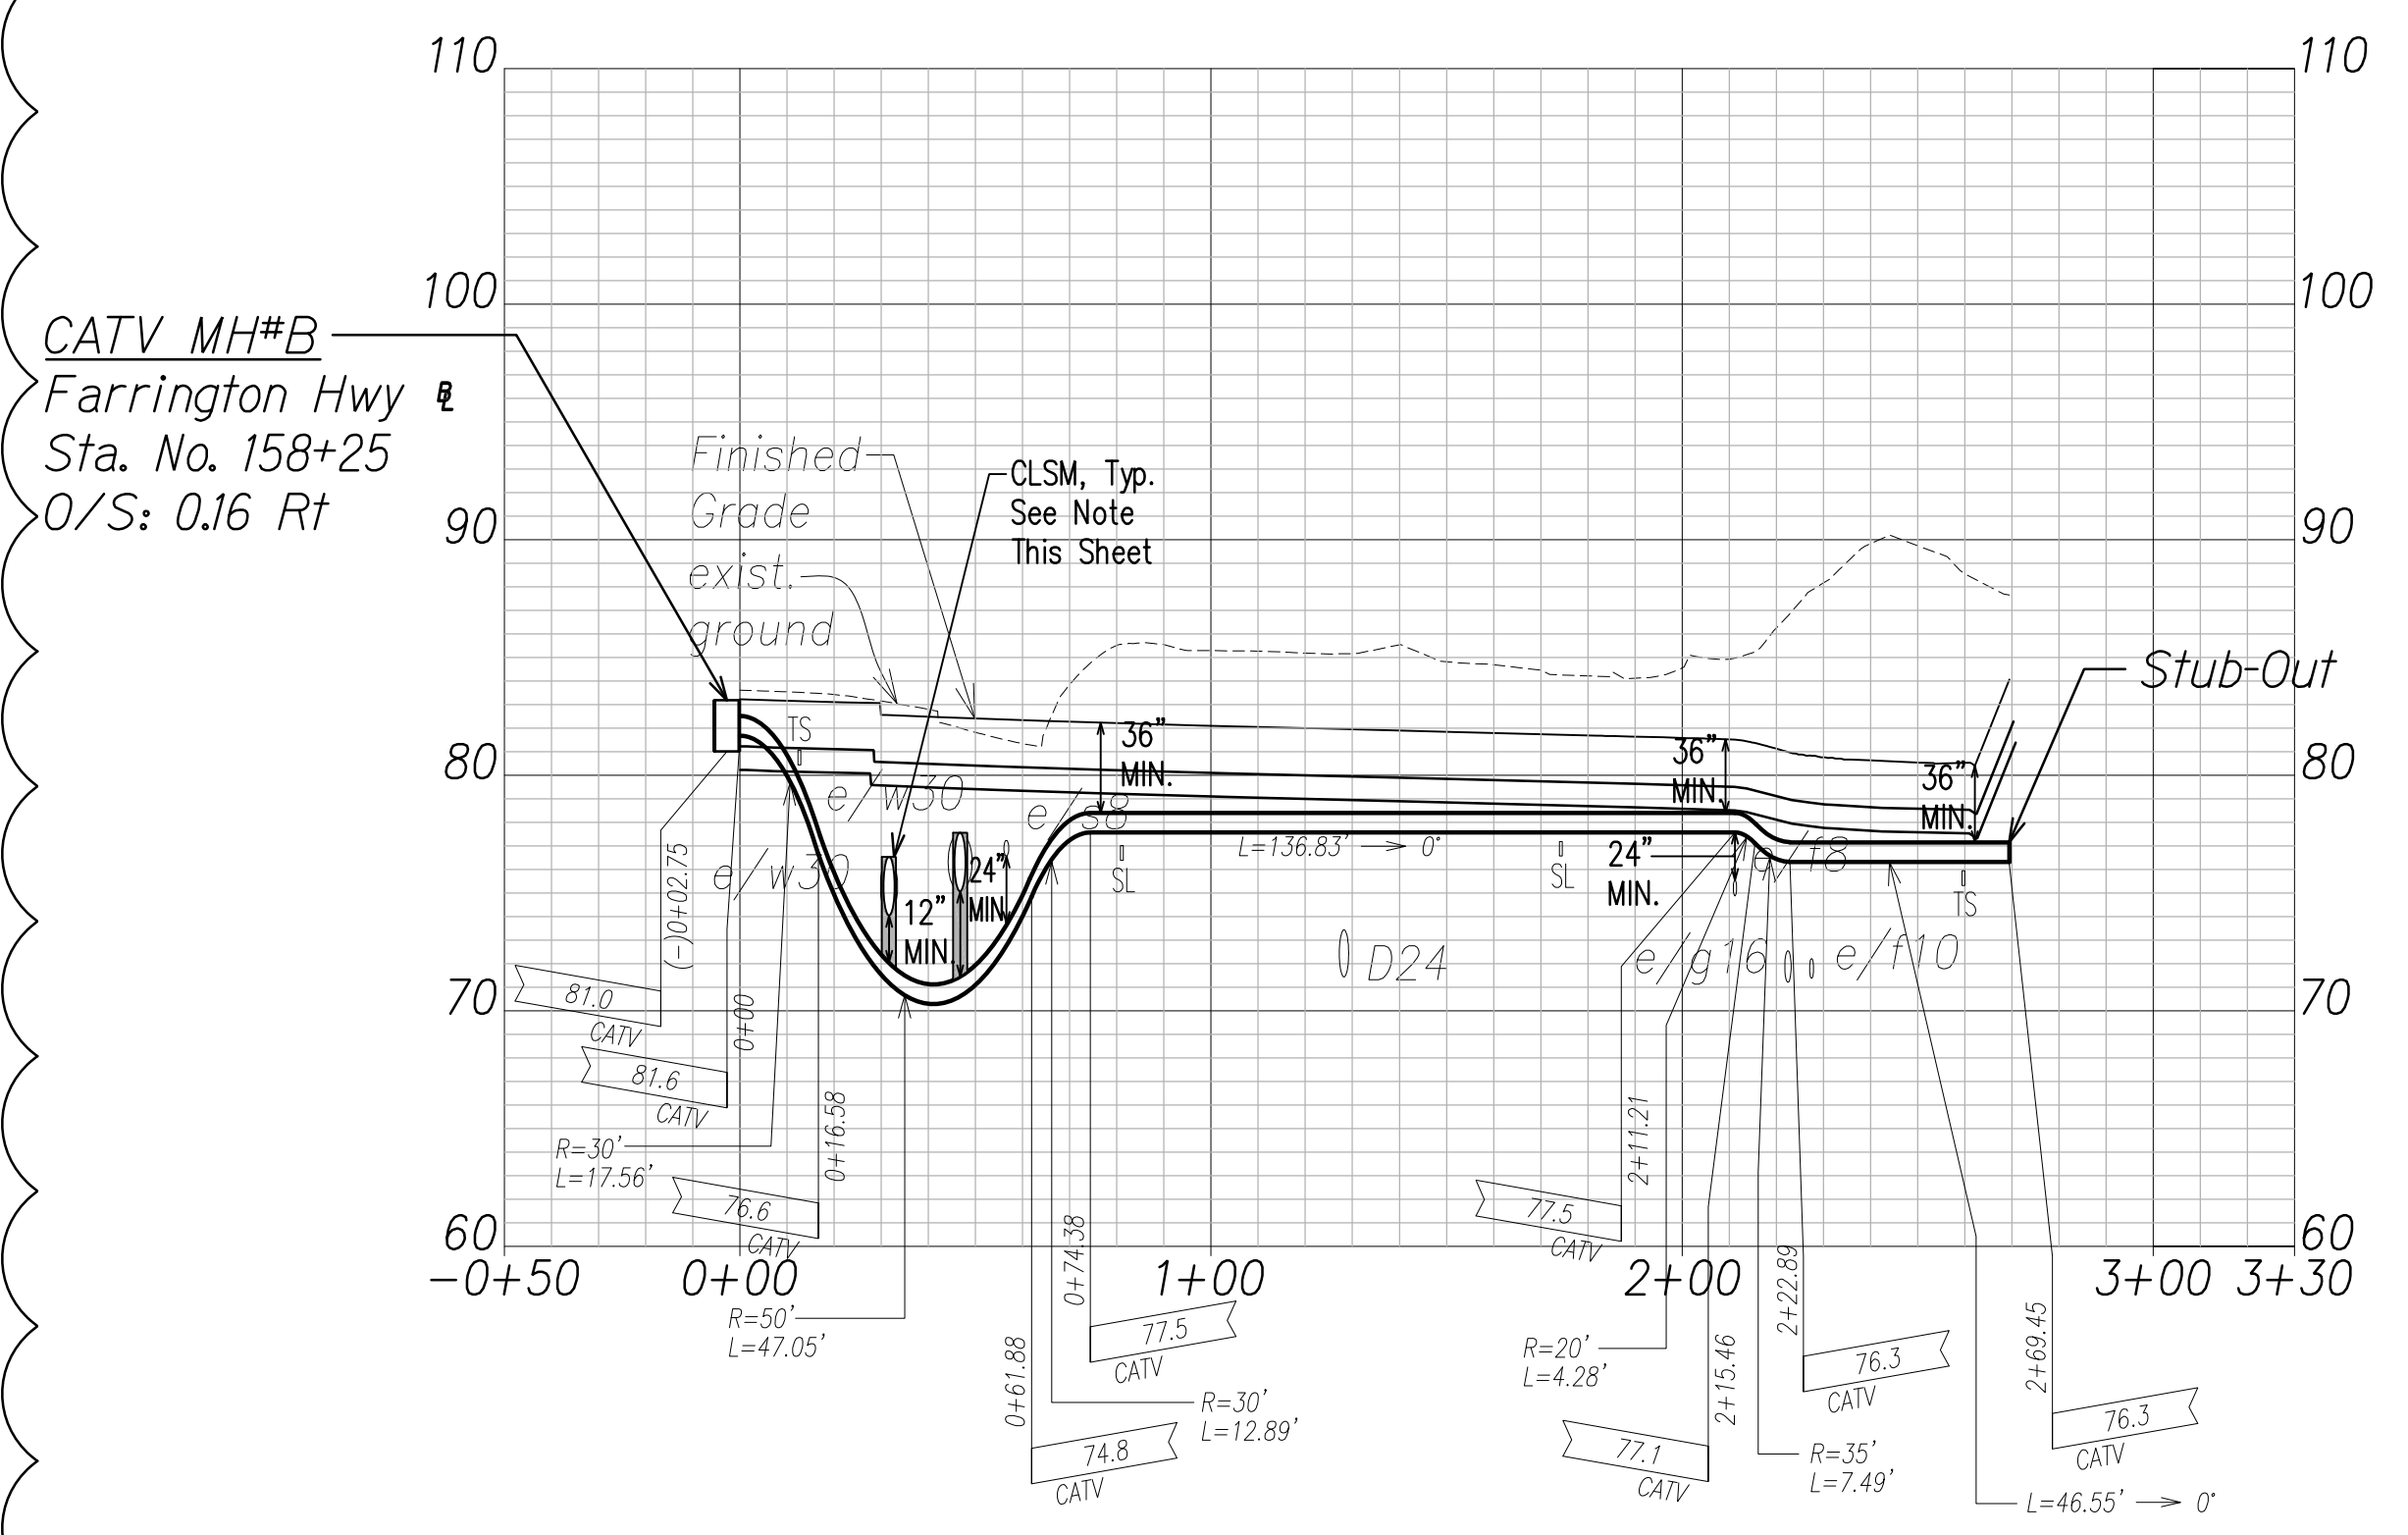

**CATV Ductline "H2" - Profile**  
Scale: Horiz. 1" = 40'  
Vert. 1" = 4'


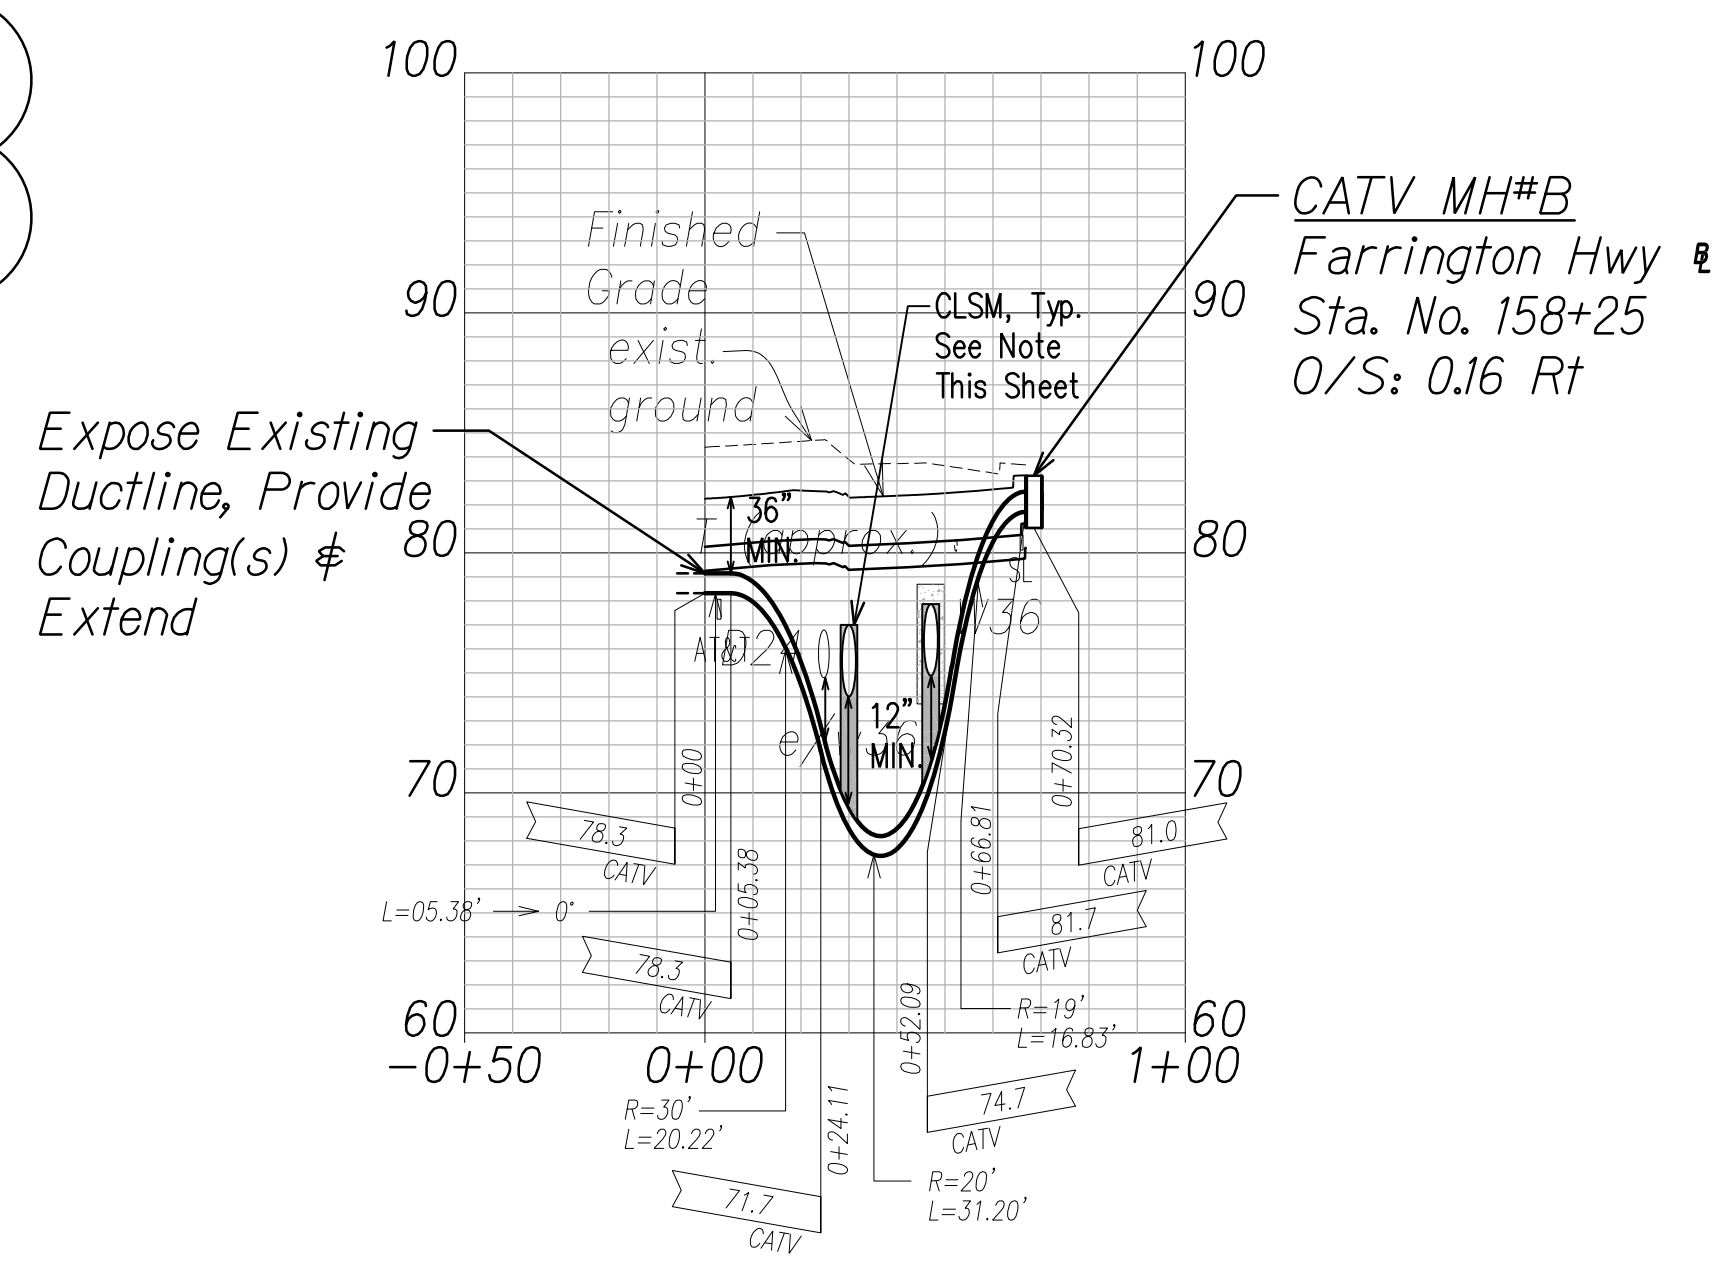


**CATV Ductline "H3" - Profile**  
Scale: Horiz. 1" = 40'  
Vert. 1" = 4'

DATE	
SURVEY PLOTTED BY	
DRAWN BY	
TRACED BY	
QUANTITIES BY	
CHECKED BY	
ORIGINAL PLAN	
NOTE BOOK	
No.	

FILE: Z:\ACAD\PROJECTS\220678A\EL06\_220678A-CATV-Ductline-Plan-Profile-H2-H3.dwg saved July 15, 2022

APPROVED BY \_\_\_\_\_ DATE \_\_\_\_\_  
SPECTRUM OCEANIC

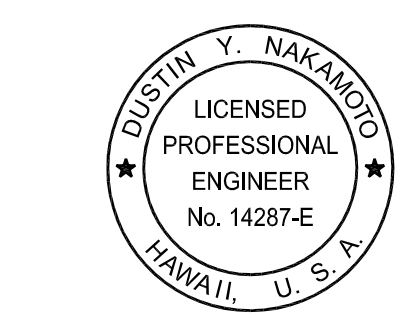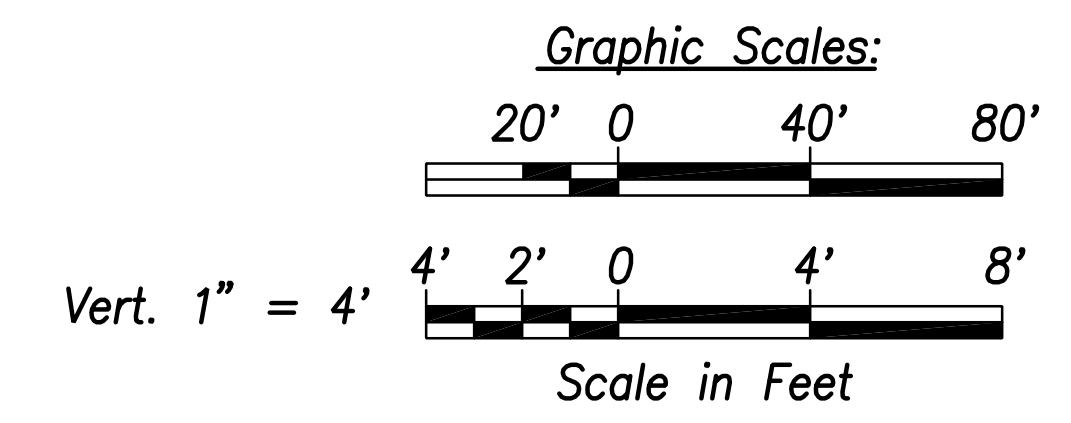

THIS WORK WAS PREPARED BY ME OR UNDER MY SUPERVISION AND CONSTRUCTION OF THIS PROJECT WILL BE UNDER MY OBSERVATION.

SIGNATURE \_\_\_\_\_ DATE: April 30, 2022  
EXPIRATION DATE OF THE LICENSE

07/15/22	⑤ UPDATED CATV DUCTLINE "H2"
06/08/22	② ADDED DRAWING
DATE	REVISION

STATE OF HAWAII  
DEPARTMENT OF TRANSPORTATION  
HIGHWAYS DIVISION

**CATV DUCTLINE  
PLAN & PROFILE "H2" & "H3"**

FARRINGTON HIGHWAY WIDENING  
Kapolei Golf Course Road to Fort Weaver Road  
Project No. 7101A-01-20



Scale: As Shown Date: April 2022

**SHEET NO. EL-06 OF 6 SHEETS**

ADD. 749S-2




FED. ROAD DIST. NO.	STATE	PROJ. NO.	FISCAL YEAR	SHEET NO.	TOTAL SHEETS
HAWAII	HAW.	710A-01-20	2021	EM-04	790

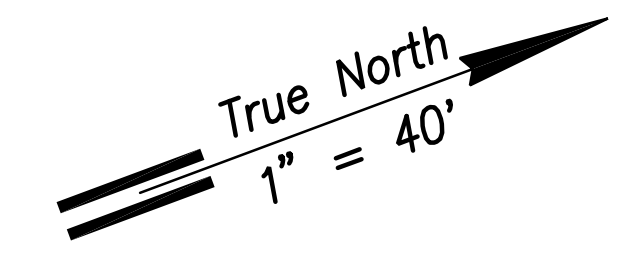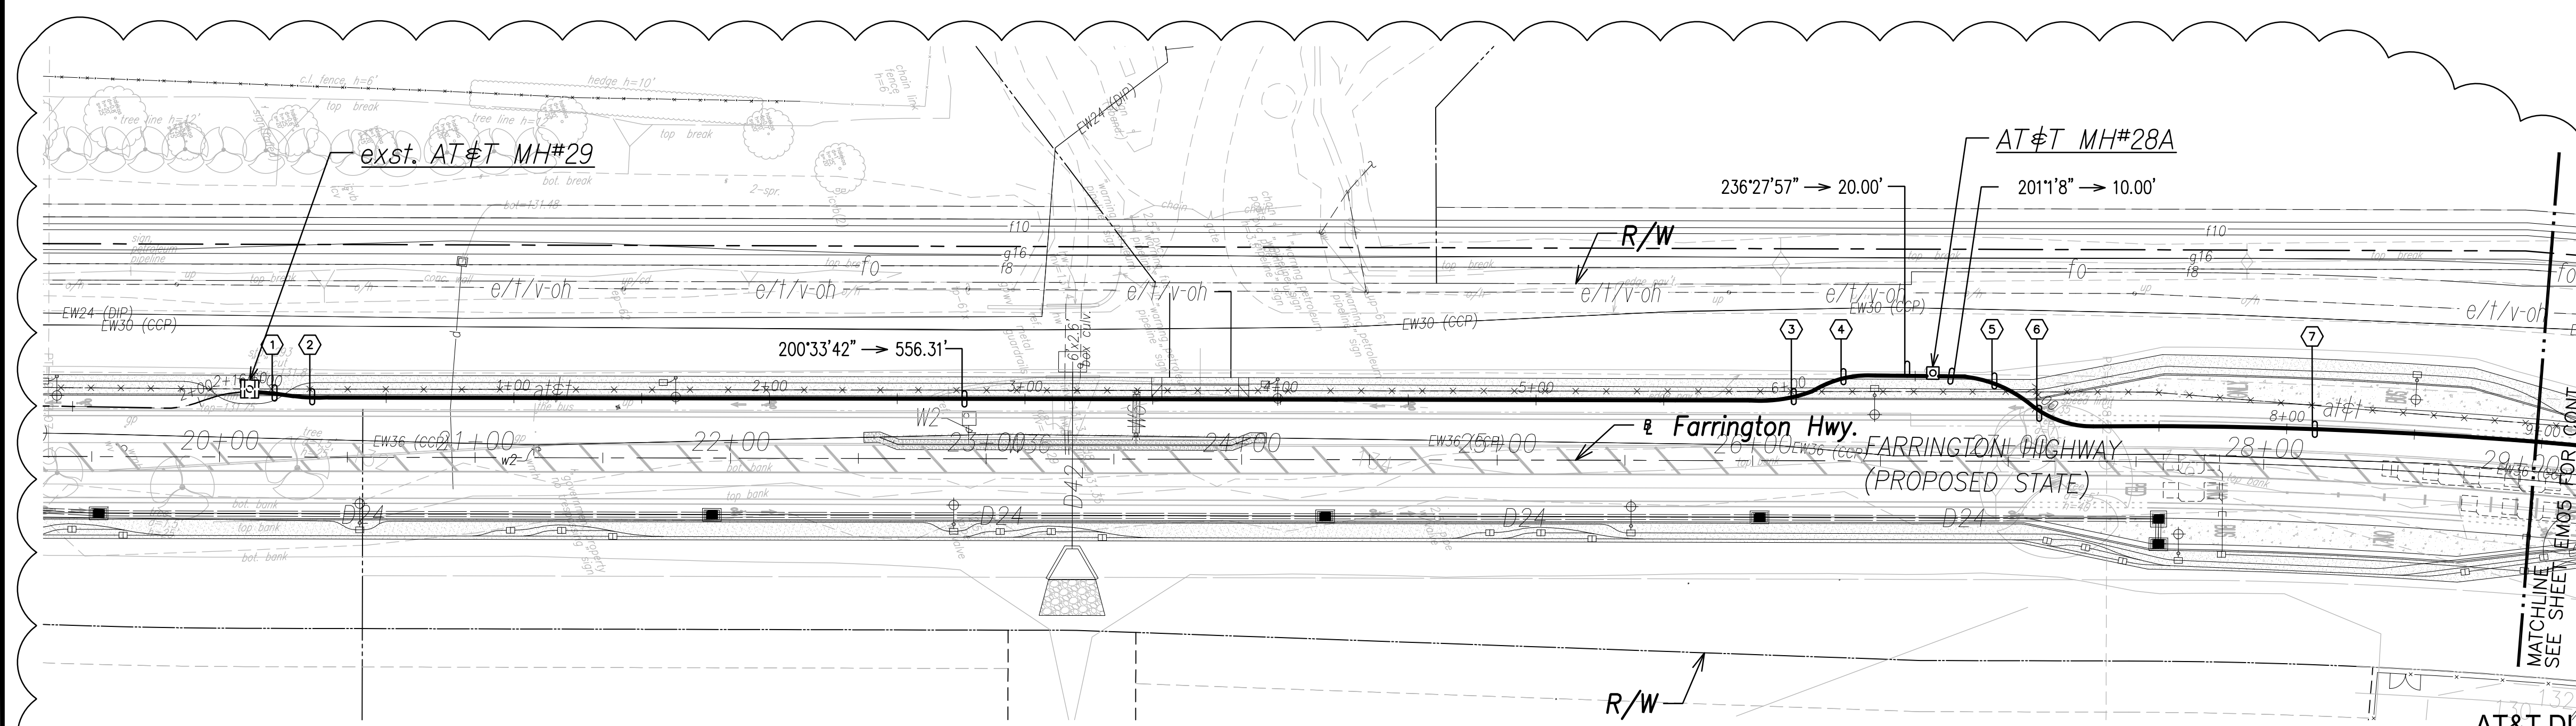


**AT&T Ductline "B1" - Plan**  
Scale: 1" = 40'

**AT&T DUCTLINE "B1"**

CURVE DATA						
ID	Δ	Δ / 2	RADIUS	T	C	Lc
①	4°30'45"	2°15'22.7"	173.63'	6.84'	13.67'	13.68'
②	11°14'51"	5°37'25.6"	69.21'	6.82'	13.57'	13.59'
③	24°6'4"	12°3'2.0"	59.09'	12.61'	24.67'	24.85'
④	35°28'40"	17°44'19.9"	42.07'	13.46'	25.64'	26.05'
⑤	34°19'34"	17°9'46.9"	50.50'	15.60'	29.80'	30.25'
⑥	36°10'27"	18°5'13.6"	39.24'	12.81'	24.36'	24.77'
⑦	5°5'42"	2°32'51.1"	1950.54'	86.78'	173.40'	173.45'

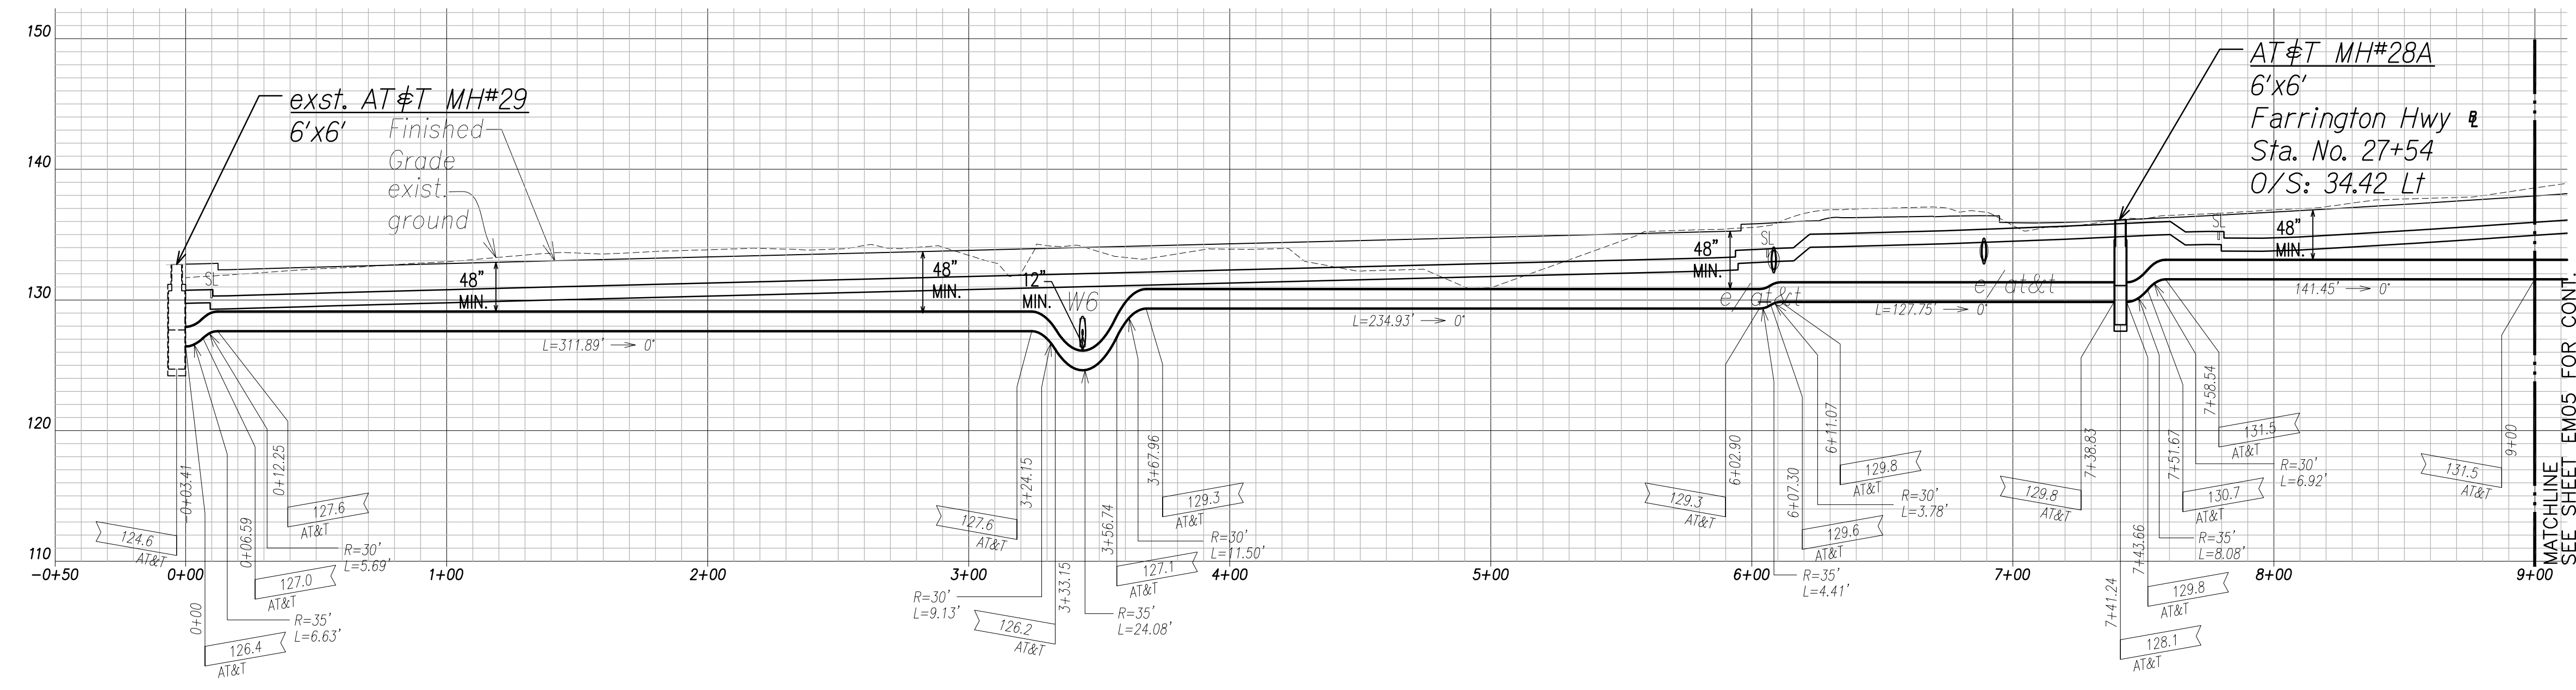


**AT&T Ductline "B1" - Profile**  
Scale: Horiz. 1" = 40'  
Vert. 1" = 4'

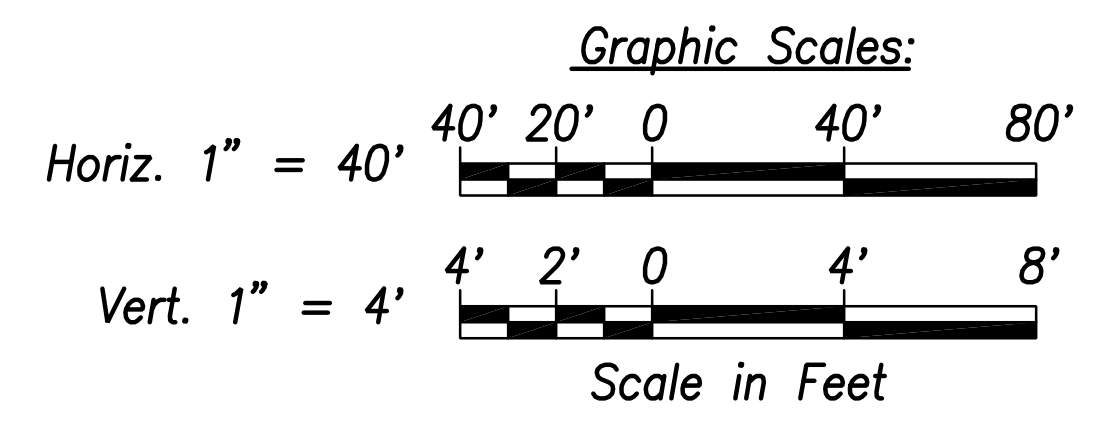

DATE	.....
SURVEY PLOTTED BY	.....
DRAWN BY	.....
TRACED BY	.....
QUANTITIES BY	.....
CHECKED BY	.....
ORIGINAL PLAN	.....
NOTE BOOK	.....
No.	.....

FILE: Z:\ACAD\PROJECTS\220067A\EM04\_220067A\_ATT-Ductline-Plan-Profile-B1-L.dwg saved July 14, 2022

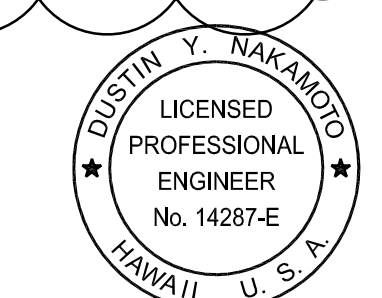

THIS WORK WAS PREPARED BY ME OR UNDER MY SUPERVISION AND CONSTRUCTION OF THIS PROJECT WILL BE UNDER MY OBSERVATION.

SIGNATURE:

April 30, 2024  
EXPIRATION DATE OF THE LICENSE

07/15/22	⑤ UPDATED AT&T DUCTLINE "B1"
06/08/22	② ADDED DRAWING
DATE	REVISION

STATE OF HAWAII  
DEPARTMENT OF TRANSPORTATION  
HIGHWAYS DIVISION

**AT&T DUCTLINE  
PLAN & PROFILE "B1"**


FARRINGTON HIGHWAY WIDENING  
Kapolei Golf Course Road to Fort Weaver Road  
Project No. 7101A-01-20

Scale: As Shown      Date: April 2022

**SHEET No. EM-04 OF 10 SHEETS**

ADD. 749S-6


FED. ROAD DIST. NO.	STATE	PROJ. NO.	FISCAL YEAR	SHEET NO.	TOTAL SHEETS
HAWAII	HAW.	710A-01-20	2021	EM-05	790

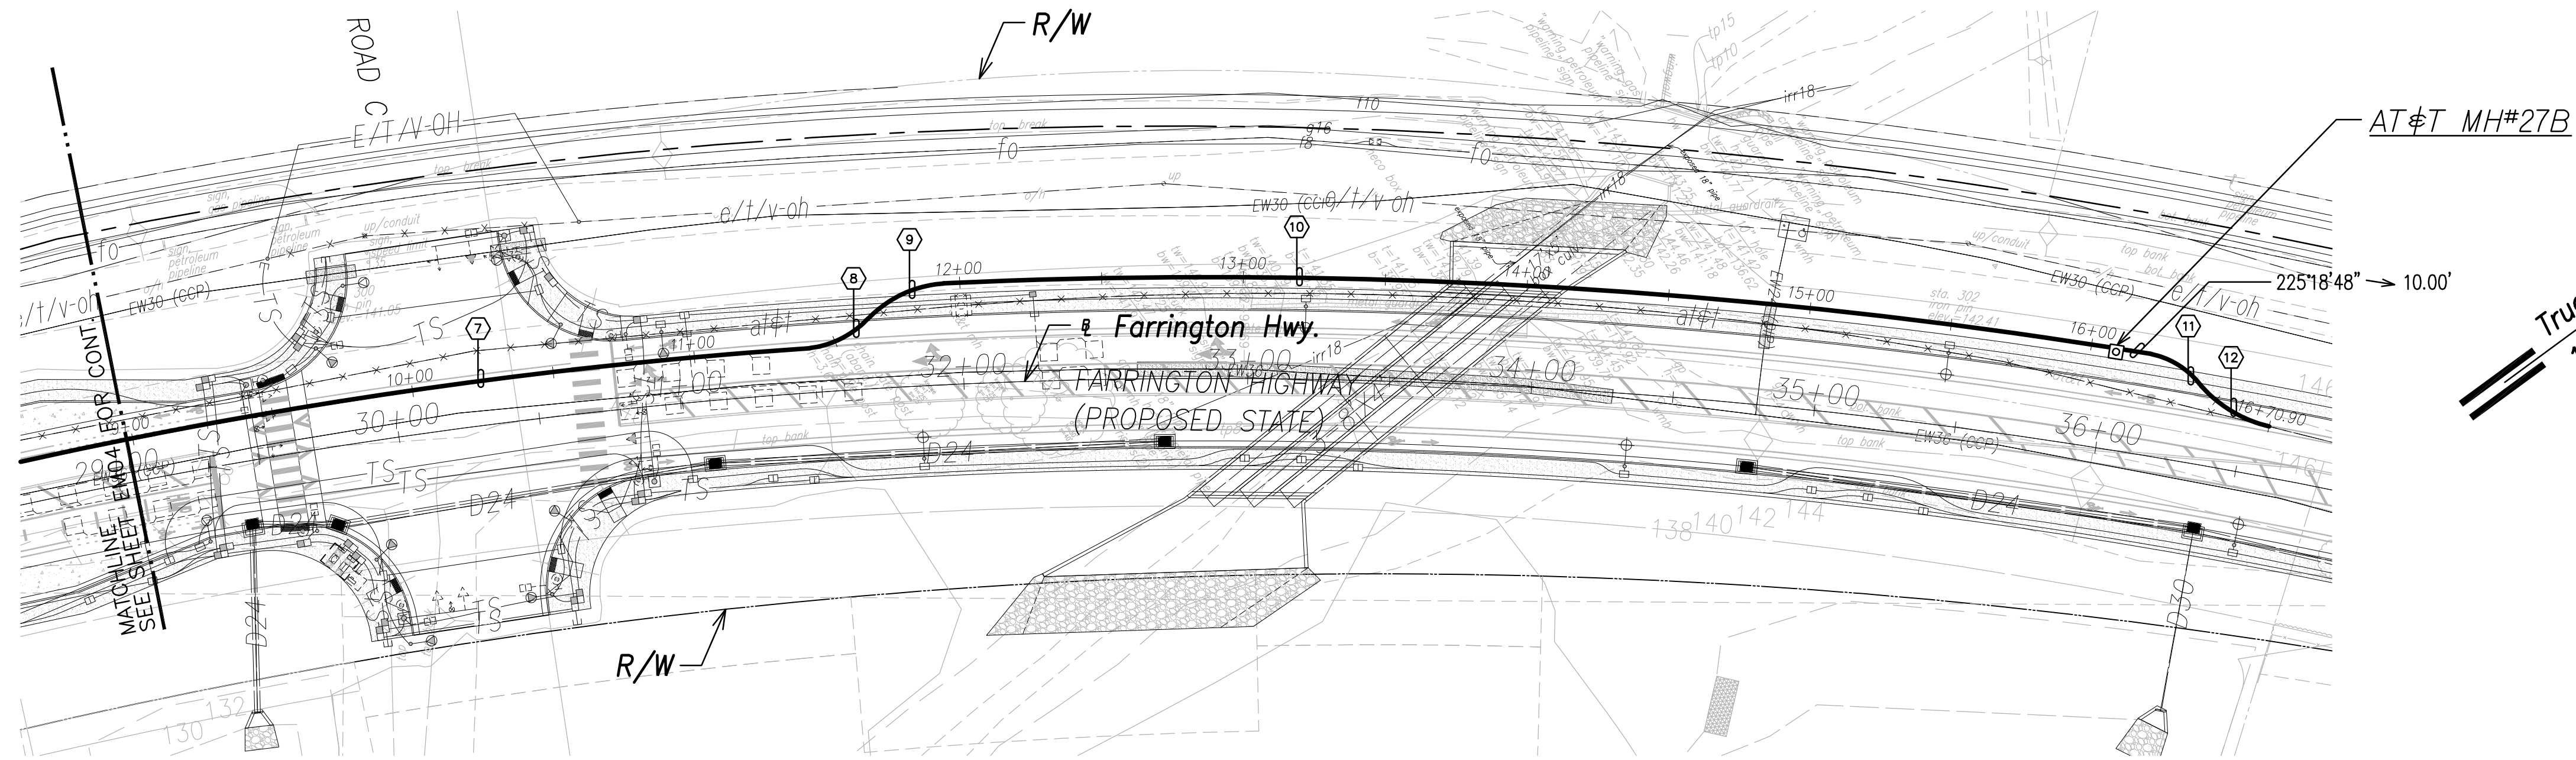


**AT&T Ductline "B1" - Plan**  
Scale: 1" = 40'

**AT&T DUCTLINE "B1"**

CURVE DATA						
ID	Δ	Δ / 2	RADIUS	T	C	Lc
(7)	7°24'26"	3°42'13.0"	1880.17'	121.70'	242.90'	243.07'
(8)	39°41'57"	19°50'58.6"	33.68'	12.16'	22.87'	23.34'
(9)	42°5'8"	21°2'33.9"	41.01'	15.78'	29.45'	30.12'
(10)	11°34'56"	5°47'28.1"	2039.16'	206.81'	411.51'	412.21'
(11)	40°30'53"	20°15'26.4"	30.18'	11.14'	20.90'	21.34'
(12)	35°2'35"	17°31'17.3"	46.17'	14.58'	27.80'	28.24'

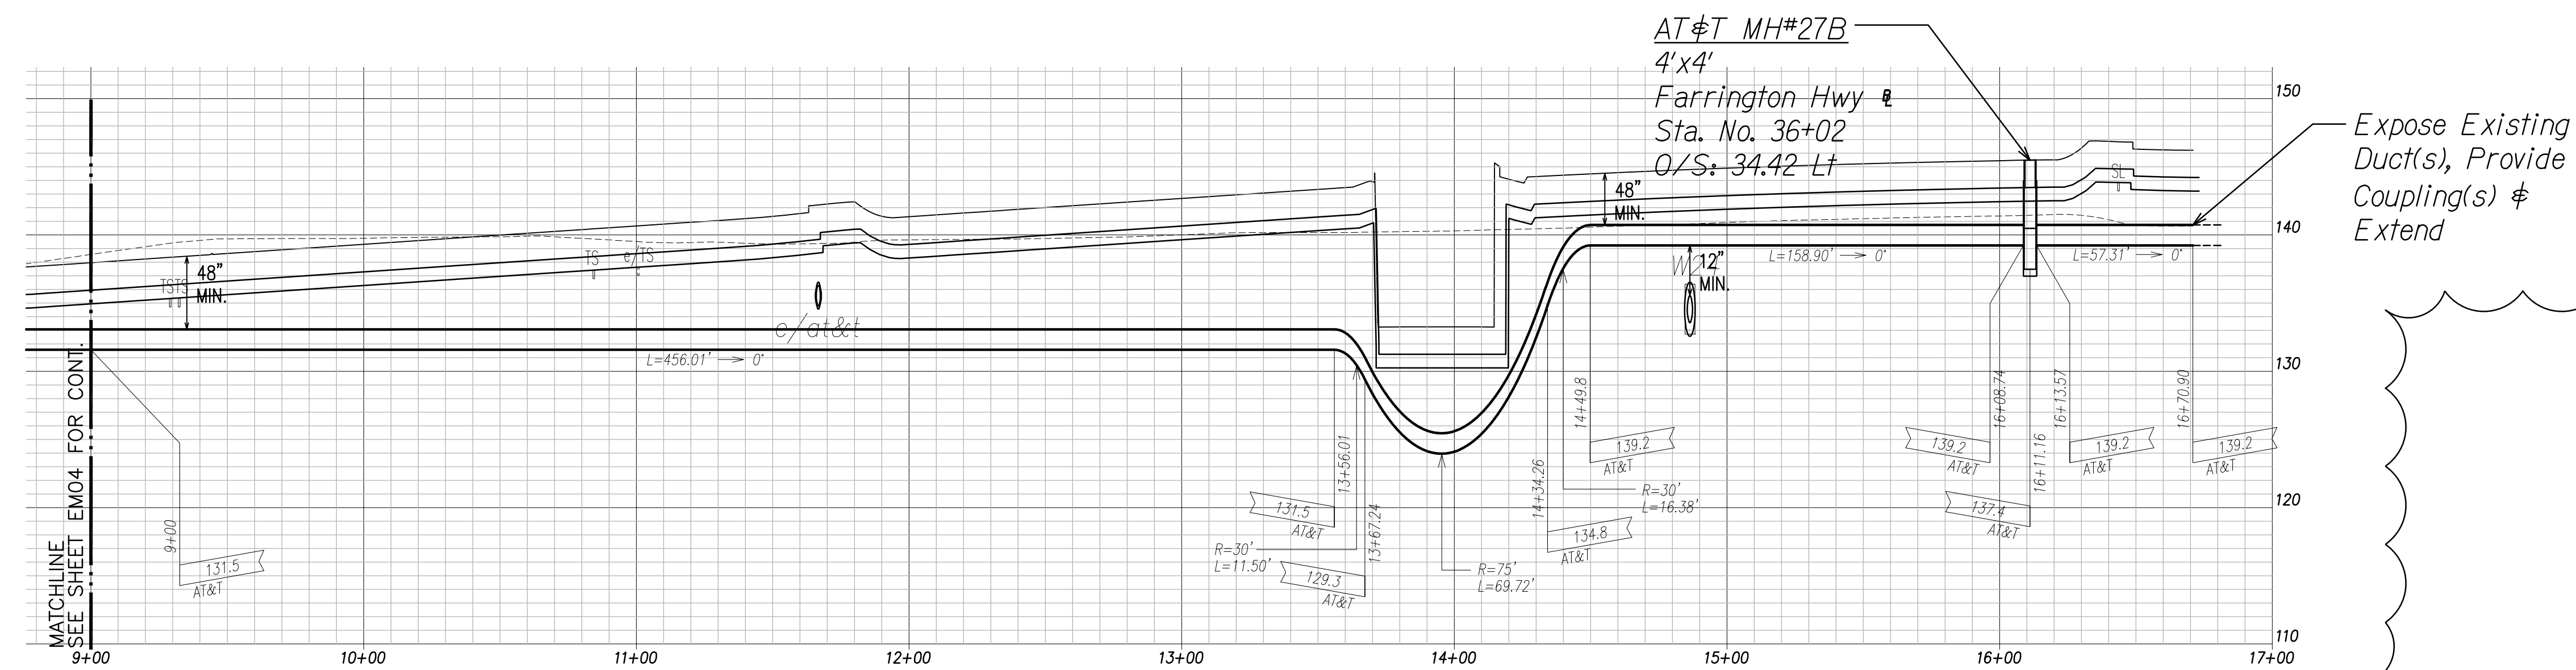


**AT&T Ductline "B1" - Profile**  
Scale: Horiz. 1" = 40'  
Vert. 1" = 4'

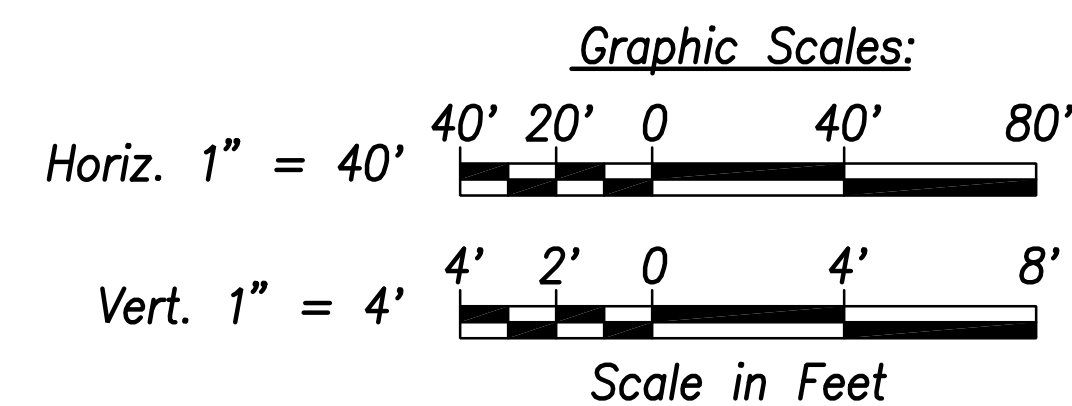

SURVEY PLOTTED BY	DATE
DRAWN BY	
TRACED BY	
QUANTITIES BY	
CHECKED BY	
NO.	

FILE: Z:\ACAD\PROJECTS\220679A\EM05-220679A-ATT-Ductline-Plan-Profile-B1-2.dwg saved July 14, 2022

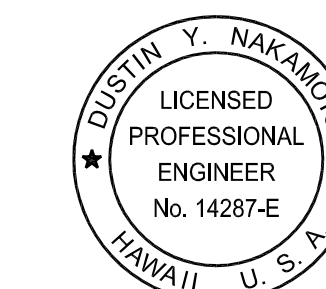

THIS WORK WAS PREPARED BY ME OR UNDER MY SUPERVISION AND CONSTRUCTION OF THIS PROJECT WILL BE UNDER MY OBSERVATION.

SIGNATURE:   
Date: April 30, 2024  
EXPIRATION DATE OF THE LICENSE

07/15/22	5	UPDATED AT&T DUCTLINE "B1"
06/08/22	2	ADDED DRAWING
DATE		REVISION

STATE OF HAWAII  
DEPARTMENT OF TRANSPORTATION  
HIGHWAYS DIVISION

**AT&T DUCTLINE  
PLAN & PROFILE "B1"**

FARRINGTON HIGHWAY WIDENING  
Kapolei Golf Course Road to Fort Weaver Road  
Project No. 7101A-01-20

Scale: As Shown Date: April 2022

**SHEET No. EM-05 OF 10 SHEETS**

ADD. 749S-7



**Questions for solicitation: B22001933 7101A-01-20 Farrington Hwy Widening,  
Kap. G. Course to Ft W. Rd**

118. Please confirm that the State's contractor maintaining the light nodes (I believe it is Johnson Controls) will be activating/bringing on-line the light nodes for the new lights and any activation costs will be covered by HDOT.

**Confirmed**

119. What is the new end date for RFI's?

**Please review information provided on HlePRO.**

120. There is no bid item for fiber optic equipment, termination and splicing. Please add a lump sum bid item for this work.

**Equipment should be incidental to the installation of the CCTV equipment. Splicing and termination is incidental to the fiber optic cables. See specs from addendum 2.**

121. Addendum 2 Traffic Control Plan TC-16 (Sheet 765) calls for temporary traffic signals for the Mauka Side but does not show what is required. Please provide temporary traffic control plan and lump sum bid item for this work.

**The plans specified that contractor shall design and provide a temporary traffic signal system. Cost shall be considered incidental to proposal item 645.1000.**

122. Fiber Optic Cable Spec Section 642.02, Paragraph F says the City will furnish the single-mode fiber optic cable for this project. Please advise where this single-mode fiber optic cable is being installed as I only see multi-mode fiber optic cable being installed for this project.

**There is no section 642. Section 647.02.F for the FOC does not mention single-mode FOC. There is no paragraph F in section 627.02 for the CCTV cameras.**

123. Please correct the index to drawings on the plan Title Sheet. Additional electrical sheets were added which go to Sheet 761 which overlaps the traffic control plan sheets that go from Sheet 750 to 780

**Electrical sheet numbers revised. Please see Addendum 5.**

124. The limits of demolition do not seem to capture the extents of all of the existing asphalt. Please clarify if it is the intention of the project to demolish and remove all of the existing asphalt along or we should only anticipate demolishing the asphalt within the limits of demolition as stated in note 1 on the demolition sheets.

**Please follow demolition plans. The existing pavement outside of the limits will not be removed.**

125. Sheet 101 of Addendum 2 added DMH L1-1. Please provide an additional bid item for this as the manhole is 10.00-10.99 and does not fall under any of the current bid items. **Please see Addendum 5 for revised manhole bid items.**

126. Addendum 2 eliminated bid item 604.2000 for the special drain manhole 9.00-9.99. We believe that this item was intended for the special drain manhole over the existing 6'x2.5' box culvert. Please advise as to which bid item this work would be incidental to. **Please see Addendum 5 for revised manhole bid items.**

127. Please refer to bid item 204.1000 Trench Excavation for Water Lines. Does the 7,887 CY include the excavation for the jackets on the existing water lines? Based on our takeoffs the quantity seems low if it were to consider both the excavation for new water lines as well as the excavation for the jackets on existing lines.

**The quantity for 204.1000 does include excavation to install concrete jackets on existing waterlines.**

128. Can you please clarify what bid items the drain headwalls should be incidental to?

**Please see proposal items 503.8000, 503.8010, 503.8020 and 503.8030 in Addendum 5.**

129. Please refer to note 3 on Sheet Add 4. This note states that the contractor shall install a temporary concrete barrier where the earth berm is removed. The existing earth berm runs down nearly the entire alignment of the project. The RFI responses from Addendum 2 indicate that the contractor shall install a 10' Dust Fence along the entire limits of grading. Will the concrete barrier be in addition to the dust fence installation or will the dust fence be considered a suitable barrier?

**Dust fence is not suitable barrier. The contractor shall provide dust fence and concrete barrier as indicated on plans.**

130. The existing berm along the farm properties are know to be made mostly of rubbish, green waste and other unsuitable materials . It is not possible to accurately determine the volume of material from this berm that would be suitable for reuse on this project. It is also not possible to determine the amount of rubbish that will be encountered in the berm. Please consider making an allowance item for the handling and disposal of the unsuitable material from the existing berms.

**The contractor shall bid in accordingly. Cost for handling and disposal of trash in various items of work is incidental.**

131. The AT&T Directional Drilling Plan & Profile calls 6" Ø Permalok steel casing pipe with a 200' vertical radius. Industry Standards dictate that the profile should utilize a 600' radius. Furthermore, Section 652.03(C)(3) Construction – Guidance System does not allow walkover guidance systems. Wireline guidance system require 3.5" Ø drill pipe, which further prohibits a tight radius. Please confirm HDD Bore Profile Attachment. **Please see revised directional drilled profile with the attached Addendum No.5.**

132. Can the microtunnel installation on Sheet No. C-181 be substituted with a conventional auger bore / Jack & Bore? **The Contractor substitute micro-tunnel installation provided they obtain approval from the BWS for their revised design, takes 100% responsibility for their design, and meets Army Corps of Engineers Section 404 requirements for their work.**

133. Special Provision Section 108, lines 23 -25, of Addendum 2 indicates "During the period between the Notice to Proceed and the Start Work Date the Contractor should adjust work forces, equipment, schedules, and procure materials and required permits, prior to beginning physical work." Please confirm that HDOT and its consultants will review and approve submittals during this period (up to 450 days after NTP). Please also confirm that the timelines for submittal approval stated in the contract documents shall apply during this period.

**Confirmed.**

134. Can the microtunnel installation on the Sheet No. C-181 be substituted with a conventional auger bore / Jack & Bore?

**See response for question number 132.**

135. The AT&T Directional Drilling Plan & Profile calls 6" Ø Permalok steel casing pipe with a 200' vertical radius. Industry Standards dictate that the profile should utilize a 600' radius. Furthermore, Section 652.03(C)(3) Construction – Guidance System does not allow walkover guidance systems. Wireline guidance system require 3.5" Ø drill pipe, which further prohibits a tight radius. Please confirm HDD Bore Profile Attachment (attachment will be emailed). **Please see revised directional drilled profile with the attached Addendum No.5.**

136. Please refer to special provision 675 - Mass Concrete. The description of this work describes mass concrete, which is the placement of any large volume of cast in place concrete with dimensions large enough to require taking measures to cope with the generation of heat from hydration of cement and attendant volume change. It is unclear what elements of the proposed project would be subject to the requirements of this specification section. Please consider providing a list of construction elements that would be governed by this specification.

**Elements that are considered mass concrete include but are not limited to the drilled shaft cap beams and end beams for both Honouliuli Stream Bridge and Kaloi Stream Bridge. Please see Addendum No.5 for revised special provisions Section 675 – Mass Concrete for requirements.**

137. The water line relocation work calls for Ductile Iron x CCP adapters. These adapters are custom made based on the true outside diameter at each tie in location. Prior to ordering these adapter the contractor needs to expose the existing line, break the concrete around the steel cylinder and measure the true outside diameter of the using a large caliper (typically borrowed from BWS). The concrete around the cylinder can then be patched and the excavation backfilled while the contractor waits on the fittings to arrive. Two of these fittings per tie in for the CCP sections are required and they are long lead items. Can this work be after the NTP date and prior to the official work start date? If not, has the duration of these operations and the procurement of these fittings been anticipated in the allowed time to complete the project?

**HDOT has accounted for long lead item procurement by the contractor, between NTP and start work date. Construction sequencing will be at the approval of the Engineer.**



138. Will HDOT pay for Materials on Hand for long lead items that are ordered after the NTP date and delivered prior to the work start date?

**Contractor is responsible for procurement and potential storage of materials.**

139. 1. DOH Noise Variance: Addendum 2 Response to Question 1 confirms Contractor is responsible to obtain the Noise Variance. The Contractor has no control over the DOH as to whether such a variance will be given or what restrictions might be imposed. Given the considerable LD's on the project and a tight overall schedule, the Contractor cannot price the work when DOH terms and conditions for a Noise Variance if one is granted at all, are unknown. The State should be responsible for any changes that are imposed by future DOH edicts, that differ from normal work shifts. Please confirm?

**HDOT is currently applying for a Noise Variance with DOH. Contractor may furnish HDOT's approved Noise Variance as supporting documentation for Contractor's own Noise Variance. Contractor will be held liable for days over contract time, as determined by the Engineer.**

140. 2. Referencing Addendum No.2, Question 2: Please clarify when the OWNER long-lead items will be obtained. This information is vital for the contractor to determine when to begin construction, as this could delay the start and completion of this project substantially.

**HDOT long lead items will be obtained between NTP and start work date. Contractor's start work date will not be affected.**

141. 3. Referencing spec. 641 Hydro-Mulch Seeding – Is erosion control matting required over all landscaped areas?

**Erosion control matting is required on all sloped areas 2 horizontal to 1 vertical or steeper.**

142. 4. Sheet C-181: In what bid item will Microtunneling be paid?

**Specification and proposal item will be added and issued within Addendum 5.**

143. Please clarify where the proposal schedule for Queens West starts and ends. Is this from the match line (Sta. 154+00) on Electrical Plan 19 to the match line (Sta. 164+73.18) on Electrical Plan 20?

**The start of the Queens West work starts at station 159+85. Pls see Addendum 5.**

144. Plan sheet 480 – SC2.5 – Hunehune Gulch Box Culvert Inlet Bottom Slab – Detail A. Reinforcing spacing indicates 86 bars on the 54'-8" side and 72 bars on the 23'10 3/16" side. Which is correct?

**Please follow 86 bars requirement, please see revision in Addendum No.5.**

145. Plansheet 481 – SC2.6 – Hunehune Gulch Box Culvert Top Slab – Detail A. Reinforcing spacing indicates 86 bars on the 54'-8" side and 72 bars on the 23'10 3/16" side. Which is correct?

**Please follow 86 bars requirement, please see revision in Addendum No.5.**

146. Plansheet 482 – SC2.7 – Hunehune Gulch Box Culvert Outlet Bottom Slab – Detail A. Reinforcing spacing indicates 93 bars on the 62'0 1/16" side and 86 bars on the 23'10 3/16" side. Which is correct?

**Please follow 93 bars requirement, please see revision in Addendum No.5.**

147. Plansheet 483 – SC2.8 – Hunehune Gulch Box Culvert Outlet Top Slab – Detail A. Reinforcing spacing indicates 93 bars on the 62'0" side and 86 bars on the 28'6" side. Which is correct?

**Please follow 93 bars requirement, please see revision in Addendum No.5.**

148. "Addendum 02, RFI Question #13 - Drawing C-5 (Sheet 6), Construction Notes – 4, Note 5, required the Contractor to retain the services of a licensed Professional Engineer(s) for quality control. This Contractor requested a specification. The response did not address the question. Is the Farrington Highway Widening project a Contractor Quality Control project, such that the Contractor provides inspection, sampling, testing, laboratory testing, daily reports, and licensed Professional Engineer oversight and certification? If so a specification should be provided for the Contractor to price the work."

**Note deleted. Please see Addendum No. 5.**

149. "Addendum 02, RFI Question #16 - Drawings C-28 through C-31, Typical Sections, ..... The question was not answered and the subject drawings have not been revised to answer the question. Contractor requests specifications for the Biaxial Polypropylene Geogrid and Non-Woven Geotextile Fabric."

**Added Geogrid Special Provision 316. Please see Addendum 5.**

150. Addendum 02, RFI Question #17 and #18 - Bid Items 623.0039. RFI response states "Revised 622.3000 & 623.0039 to ALLOWANCE. Both 622.3000 and 623.0039 are L.S. in the Addendum No. 2 Proposal Schedule. Please confirm the correct unit of measure.

**Revised to "LS". See Addendum No. 5.**

151. Addendum 02, RFI Question #51 and #71 - Q51 states contractor to provide staging areas. Q71 states – "See Construction Parcels in Add. No. 2. If additional staging area is required, Contractor will be responsible for obtaining required land. Addendum No. 2 plans do not provide parcels for staging. Please issue plans with staging areas shown.

**The contractor shall use areas within the project limit for staging. If addition area is desired the Contractor shall be responsible for obtaining their own additional staging areas at their own cost**

152. "Addendum 02, RFI Question 69 - SP 203-1A, Lines 29-36 – Testing In-situ material 2' below subgrade. RFI answer states an allowance will be created. Addendum # 2 proposal does not include an allowance. Specify payment via new allowance item."

**Added pay item 203.1000. Please see Addendum No.5.**

153. Addendum 02, RFI Question 74 - Sheet C-2, Note 25. The original note specifies the Contractor is responsible for temporary relocation of existing utilities. The response to Q74 modifies the original not making all utility relocation the Contractors responsibility. The response should be changed to address temporary relocation only.

**The Contractor is responsible for temporary utilities. The cost for temporary utilities shall be incidental to the various items of work.**

154. Addendum 02, RFI Question 93 - Response states the CCTV Controller should be part of the Queens West Bid Items Schedule, however, Addendum 02 proposal does not have a bid item for the CCTV Controller. Please provide bid item.

**CCTV controller for the Queens West intersection is part of the main CCTV bid item, not part of Queens West.**

155. "There are several items in the electrical drawings that are not accounted for in the pay item proposal. Please provide respective bid item or advise where items need to be priced for: CCTV - (3) 2'''C PVC W/ PULLSTRING. CONCRETE ENCASED CCTV - (8) 2'''C PVC, W/ PULLSTRING. CONCRETE ENCASED CCTV - 2'''C PVC, W/ PULLSTRING. CONCRETE ENCASED CCTV - 2'''C PVC. CONCRETE ENCASED TS - (2) 3'''C PVC, W/ PULLSTRING. CONCRETE ENCASED TS - (3) 2'''C PVC W/ PULLSTRING. CONCRETE ENCASED 2-3'''C PVC SCH 40, CONC.ENCASED (FOR TSP) @TRAFFIC CONTROLLER 4-2'''C PVC SCH 40, CONC.ENCASED W/PULLSTRING (FOR TS SPARE (4)) 5-2'''C PVC SCH 40, CONC.ENCASED (FOR TSP) @TRAFFIC CONTROLLER 1-3'''C PVC SCH 40 (FOR EXTENSION) HECO DUCTLINE, FOUR 5-INCH CONDUIT ENCASED IN CONCRETE JACKET (FUTURE) HECO DUCTLINE, SIX 5-INCH CONDUIT ENCASED IN CONCRETE JACKET HECO DUCTLINE, TWO 4-INCH FIBRE OPTIC CONDUIT ENCASED IN CONCRETE JACKET TS - 2-3'''C PVC W/ PULL STRING OUTDOOR CAT6 CCTV - CCTV CAMERA SECURITY - OPTICAL PRE-EMPTION DETECTOR WEATHERHEAD FOR TRAFFIC SIGNAL SERVICE TO BE INSTALLED ON POLE"

**All conduits to controller are considered incidental to the controller installation as the boxes are typically within 3' of the controller, per the specs. All installation and mounting equipment for Optical Pre-emption Detector is incidental to the equipment being installed.**

156. Addendum 02, Sheet No. C-3 - Work Near Kahi Mohala - Note 2 requires completing the makai shoulder including retaining wall within four+E75 (4) months of receiving Notice to Proceed. This conflicts with Special Provision 108..01 Notice to Proceed (NTP), that allows the Contractor up to 450 calendar days after NTP to begin physical work. Additionally, a joint Pole Line runs the length of the makai shoulder in this area. Does the State mean four (4) months after beginning physical work?

**Note revised. See Addendum No. 5.**

157. In a previous RFI question, "Item Number 603.2002 states there is 481 LF of 36" RCP, Class III. This piping is not found on either the utility and drain profiles or the grading and drainage plan. Please confirm where this size piping is or if this piping does not exist." The answer to this question was, "Please see Addendum No. 2 for revised sheet (Grading and Drainage Plan BL Sta. 109+00 to BL Sta 118+00). 36" RCP quantity has also been revised in the proposal schedule." In Addendum No. 2, on this sheet the linear footage of 36" RCP is found to be 34 LF. Contractor has also not found any other



quantity of this size RCP. The proposal quantity for Addendum No. 2 has not been changed. Please change the proposal quantity to the correct linear footage.

**Revised quantity for pay item 603.2002. See Addendum No. 5.**

158. Sheet 32, Sheet No. C-31, Typical Sections - 4, on detail "Typical Section - Road 'K' and Road 'L' is a 2' Gutter called out as "Conc. Curb and Gutter See C&C Std. Det. R-4A Rev." This appears to be another type of curb and gutter other than the Curb, Type 2D and Curb, Type 2DG. Please add a separate bid items for this gutter.

**Curb changed to State Type 2DG. See Addendum No. 5.**

159. Addendum 02, Sheet No. 5.3 - Special Grated Drop Inlet B2 or D2. The maximum height that is shown is 16'. GDI D2 called out this drawing and is found to be greater than 17 feet. Please either provide drawing for this height GDI or change current drawing to include this height.

**See revised drawings for GDI height**

160. Addendum 02 removed Bid Item 617.1000 "Imported Planting Soil" from the Proposal, however in the original plans on Sheet No. C-31, Typical Sections - 4, on detail "Typical Section - Road 'K' and Road 'L'" there is found to be a planter strip with 4" of topsoil. This is not a plan sheet that is included in Addendum 02. Please either add this Bid Item back into the proposal, or provide an updated drawing of this detail without the planter strip.

**Planter strip removed. See Addendum No. 5.**

161. Addendum 02, Sheet No. C-87, Grading and Drainage Plan Sta. 13+00 to Stat. 22+00, GDI B2-A is labeled as a standard Type 2A-9P, however the callout for the drawing is for Special Type 2A-9P. Please confirm whether callout is incorrect or if GDI B2-A is mislabeled.

**Callouts of structure type are correct.**

162. Addendum 02 removed 604.2000 "Type Special Manhole, 9.99 to 9 Feet" from the proposal. Is contractor to assume the Special Drain Manhole, found on Addendum 02 Sheet No. C-88 "Grading and Drainage Plan Sta. 22+00 to Sta 31+00", is included in Bid Items 205.2200 "Structure Excavation for 42" Inlet/Outlet Structure", 205.5200 Structure Backfill for 42" Inlet/Outlet Structure", 503.2200 "Concrete for 42" Inlet/Outlet Structures" and 602.2200 "Reinforcing Steel for 42" Inlet/Outlet

Structures". If this is not the case, please add a Bid Item for the Special Drain Manhole Found on Sheet No. C-88.

**Yes, the Sp. DMH at Sta. 23+33.8, o/s 38' Lt. and 42" Drainage Culvert Headwall are to be covered under bid items 205.2200, 205.5200, 503.2200 and 602.2200.**

163. Addendum 02 Sheet No. C-92, Grading and Drainage Plan Sta 57+75 to Sta. 66+00, GDI F2 appears to be shown as a Special Drain Manhole, but it is labeled as a typical Drain Manhole. Please clarify.

**GDI F2 is shown and called out as a grated drop inlet (GDI), not a special drain manhole on sheet C-92.**

164. Addendum 02, ADD. 351, SHEET No. SA1.2, Specifies Revision 2 is an elevation change. Contractor can only find a partial bubble around Abutment 1 center of drilled shaft cap beam station at the baseline. Please clarify.

**"Elevation Change" was the incorrect terminology to use for Delta 2 Revision Block. It should have stated "Revised Stationing."**

165. Addendum 02, 8, Sheet No. C-7, Water Pollution And Erosion Control Notes, 8. Sediment and Erosion Control BMP measures shown in the Contract Documents are minimum BMP requirements and do not constitute a complete Sediment and Erosion Control Plan. The Contractor shall incorporate additional BMP's..... Costs shall be included in lump sum Pay Item No. 209.0100, Installation, Maintenance, Monitoring, and Removal of BMP and shall not be paid for separately. The note as written does not allow Contractor's to quantify the BMP scope of work to assign to the Lump Sum Item. The note as written does not reflect the current Proposal Schedule which has 209.0100 Lump Sum to cover the plan sheet BMP's and 209.0200 Additional Water Pollution, Dust and Erosion Control - Force Account to cover additional unforeseen BMP's. Suggest revising the subject note to reflect the proposal and make 209.0100 - Lump Sum priceable.

**Contractor shall bid on project documents as shown.**

166. Addendum 02 changed the proposal Bid Item 503.7000 "Concrete For Reinforced Concrete Jackets" into a Lump Sum item. With Contractor having to follow BWS standard of being flush with

the face of slip joints contractor requests as-builts of all pipes to be concrete jacketed. Without being given these, it does not allow Contractor to quantify the Concrete Jacket linear footage of each pipe. Contractor requests to be given as-builts of pipe to be concrete jacketed or for the Bid Item to be changed to CY as to give the contractor a quantity to price from.

**Please see available waterline as-builts in Addendum No. 5. The contractor shall price Concrete for Reinforced Concrete Jackets as lump sum per contract documents with available information.**

167. Please confirm if the HECO 4-5E X Ductiline from approximately station 49+50 - 57+00 and 58+00 - 61+00 can be done in Phase 2.

**Contractor shall sequence work in accordance with TCP. Any deviations/changes resulting from alternative means and methods will require approval of the Engineer during the time of construction.**

168. Please provide profile for Temporary Waterline By-Pass 16, 17, 18, 19, 20 and 21.

**Added additional temporary bypass waterlines. See Addendum No. 5.**

169. Contractor is unable to find Temporary Waterline By-Pass 21, please confirm existence of this waterline and provide detail.

**Added additional temporary bypass waterlines. See Addendum No. 5, sheet C-178.**

170. "Addendum 02, RFI Question #12 - Drawing C-3 (Sheet 4) Construction Notes – 2, Access to Farm Lots, Note 5, requires the Contractor to relocate all irrigation lines impacted by construction... The RFI response tells Contractor to relocate shown lines and an ALLOWANCE item will be added for other not recorded lines that are still in service. Addendum No. 2, Proposal Schedule does not contain an allowance item for relocating unknown in service irrigation lines. Please issue a revised Proposal Schedule."

**Added pay item 624.9000. See Addendum No. 5.**

171. Addendum 02 Sheet No. C-103, Grading and Drainage Plan Sta. 154+00 to Sta. 165+00, GDI Q2, GDI Q2-1, GDI Q2-2, GDI Q2-4, and GDI Q3 all appear to be shown as Special Drain Manholes, but none of these are labeled as such. Please clarify if this is an incorrect drawing or if the callout is incorrect.

**Callouts of structure type are correct.**