


Waikakalaua Stream Bridge OB Joint Failure Repair Plan
Location Map (from Consor Engineers)


GPS Coordinates

N: 21° 28' 29.96"

W: 158° 00' 59.57"

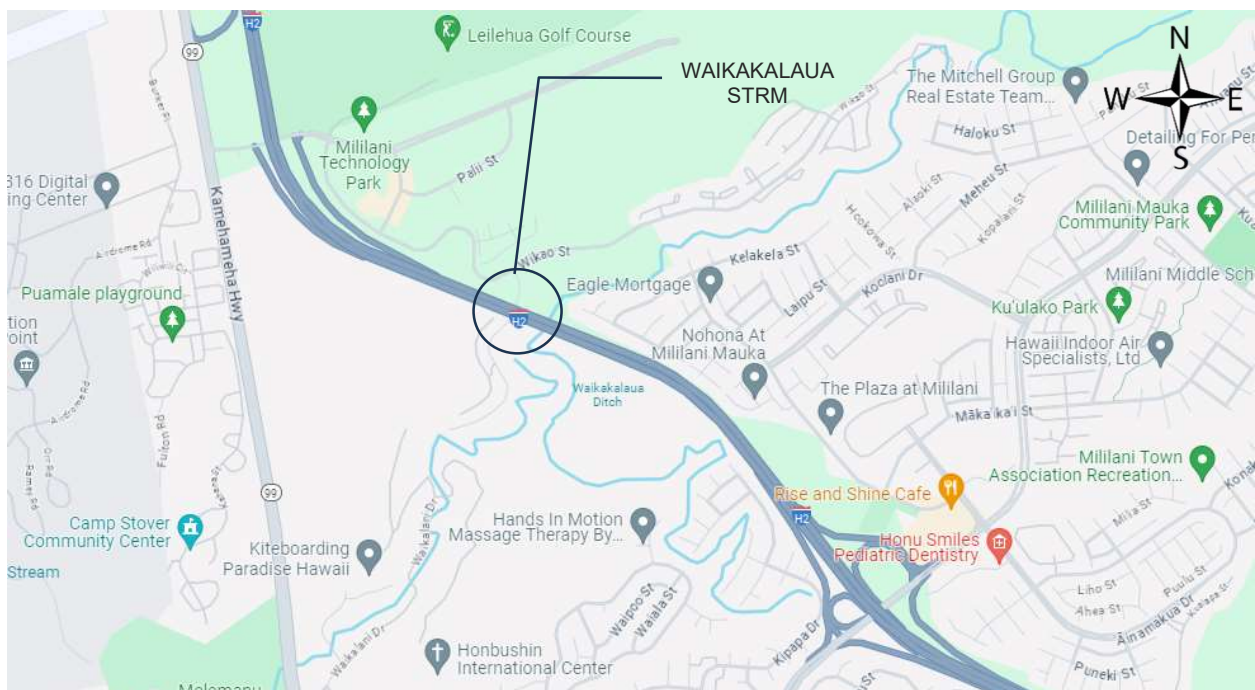

FED. ROAD DIST. NO.	STATE	PROJ. NO.	FISCAL YEAR	SHEET NO.	TOTAL SHEETS
		H2D-01-97M	1997	3	3

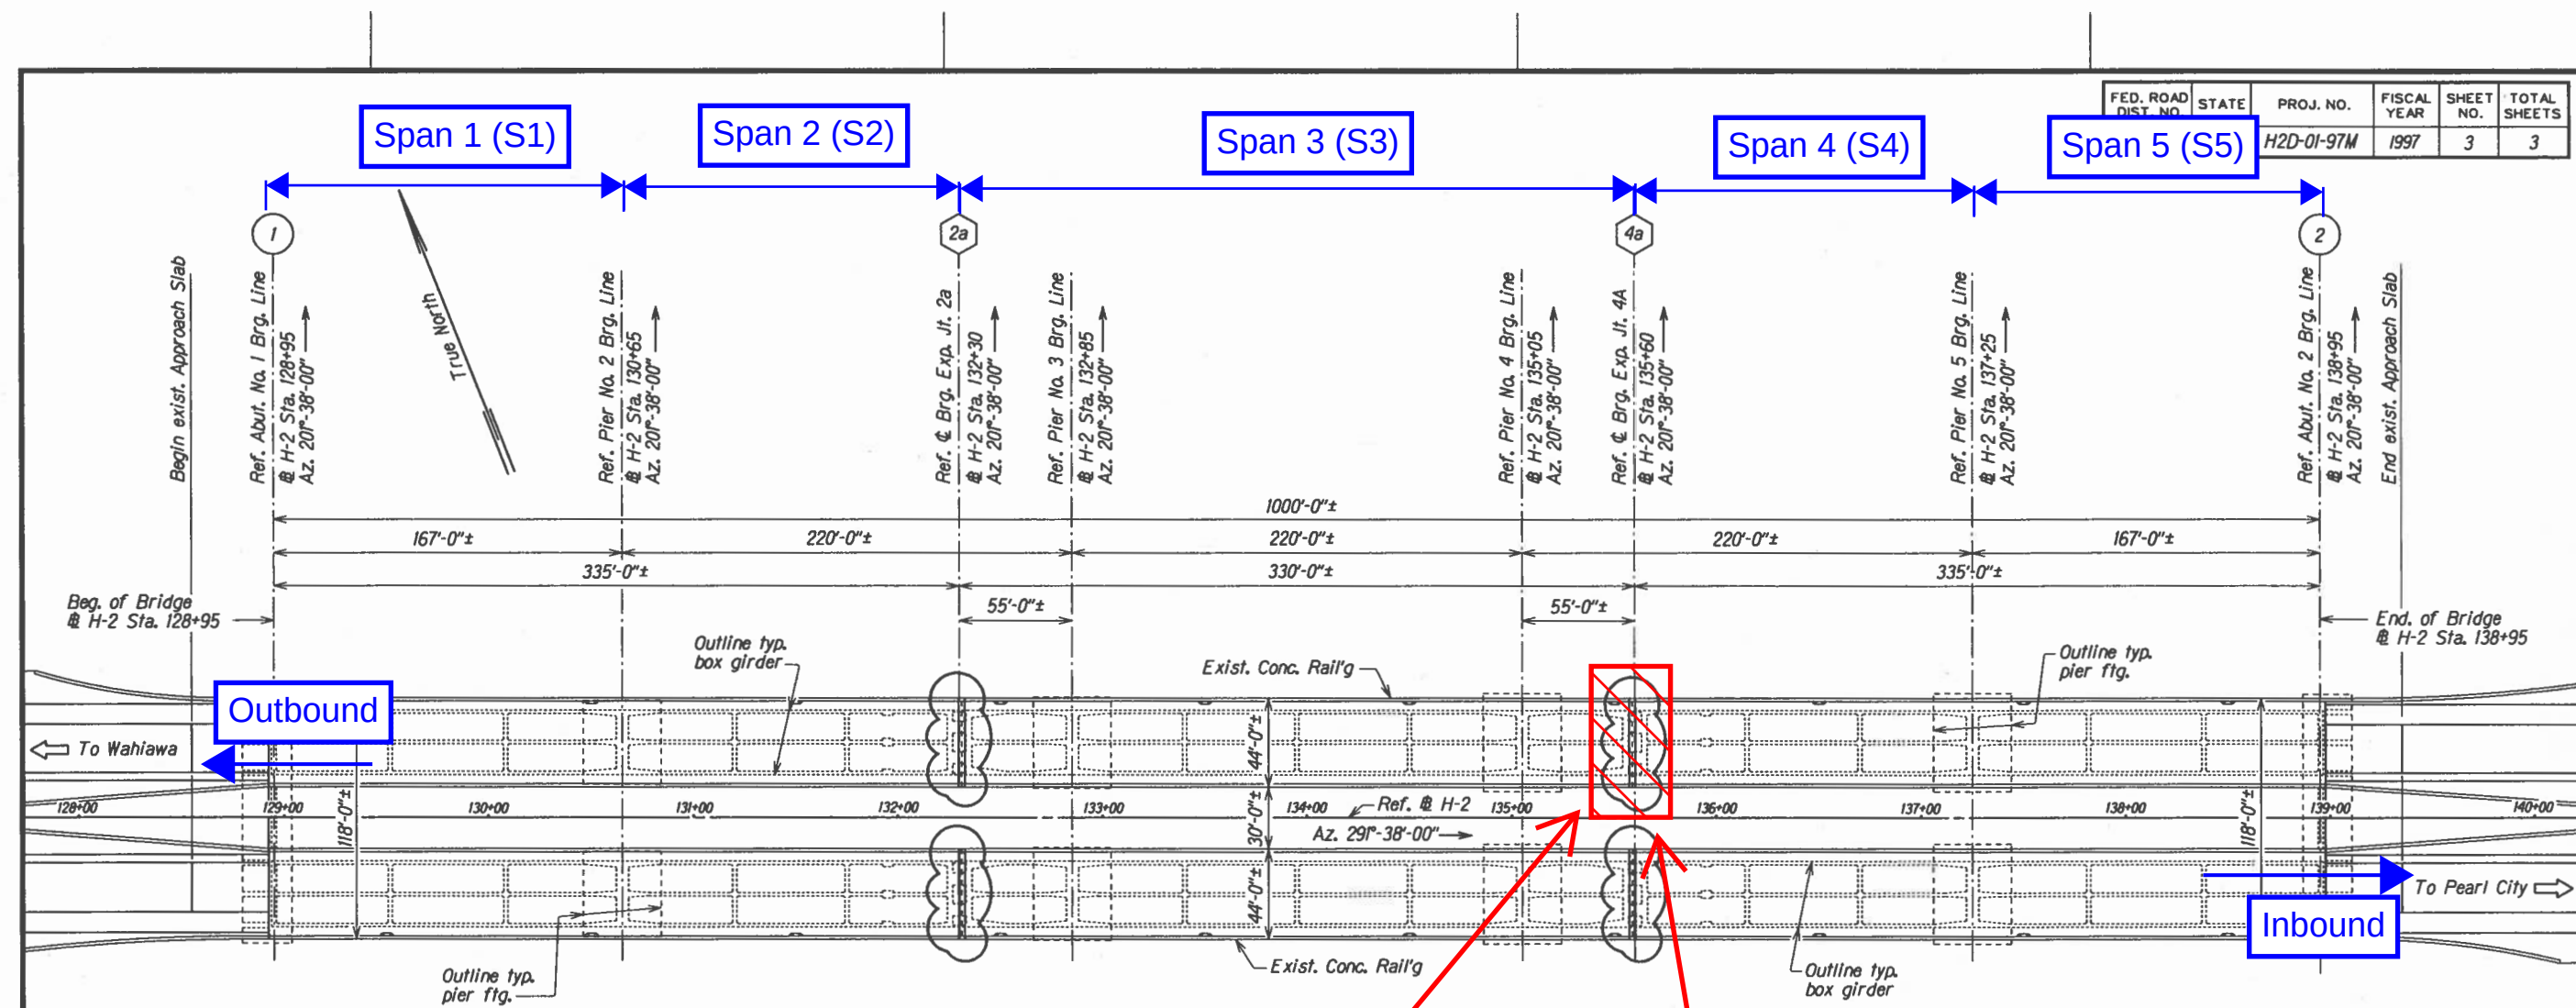

LAYOUT PLAN
Scale 1" = 40'-0"

Key to Symbols

Replace Expansion Joint Seals

Existing Deck Drain Location

1) Replace expansion joint (44LF) at Span 4 Outbound per as-built drawings,
Other similar joint technology may be reviewed and accepted.

2) Contractor shall provide necessary BMPs and catchment system to prevent any debris/dust from entering streams/waters.

Area of Work

Waikakalaua Stream Bridge OB
Route H2
Mile Post 6.24
Expansion Joint S4
Refer to Photo 16

STATE OF HAWAII
DEPARTMENT OF TRANSPORTATION
HIGHWAYS DIVISION

REHABILITATION AND BRIDGE REPAIR DETAILS

INTERSTATE ROUTE H-2
Repair Expansion Joints On Waikakalaua Bridge
Project No. H2D-01-97M

Scale: As Noted Date: Jan. 1997

SHEET No. Q2 OF 2 SHEETS

SURVEY PLATTED BY	DATE
DESIGNED BY	JAN 1997
TRANSMITTED BY	
NOTES MOVED	
QUANTITIES BY	
CHECKED BY	
APPROVED BY	

Outbound



Photo 16. Expansion joint, S4, both lanes, P3 @ 55', looking west.
Minor debris impaction throughout, CS2.