


MAUNA'ALA CARETAKER'S HOUSE REROOF - AS-BUILT DRAWINGS

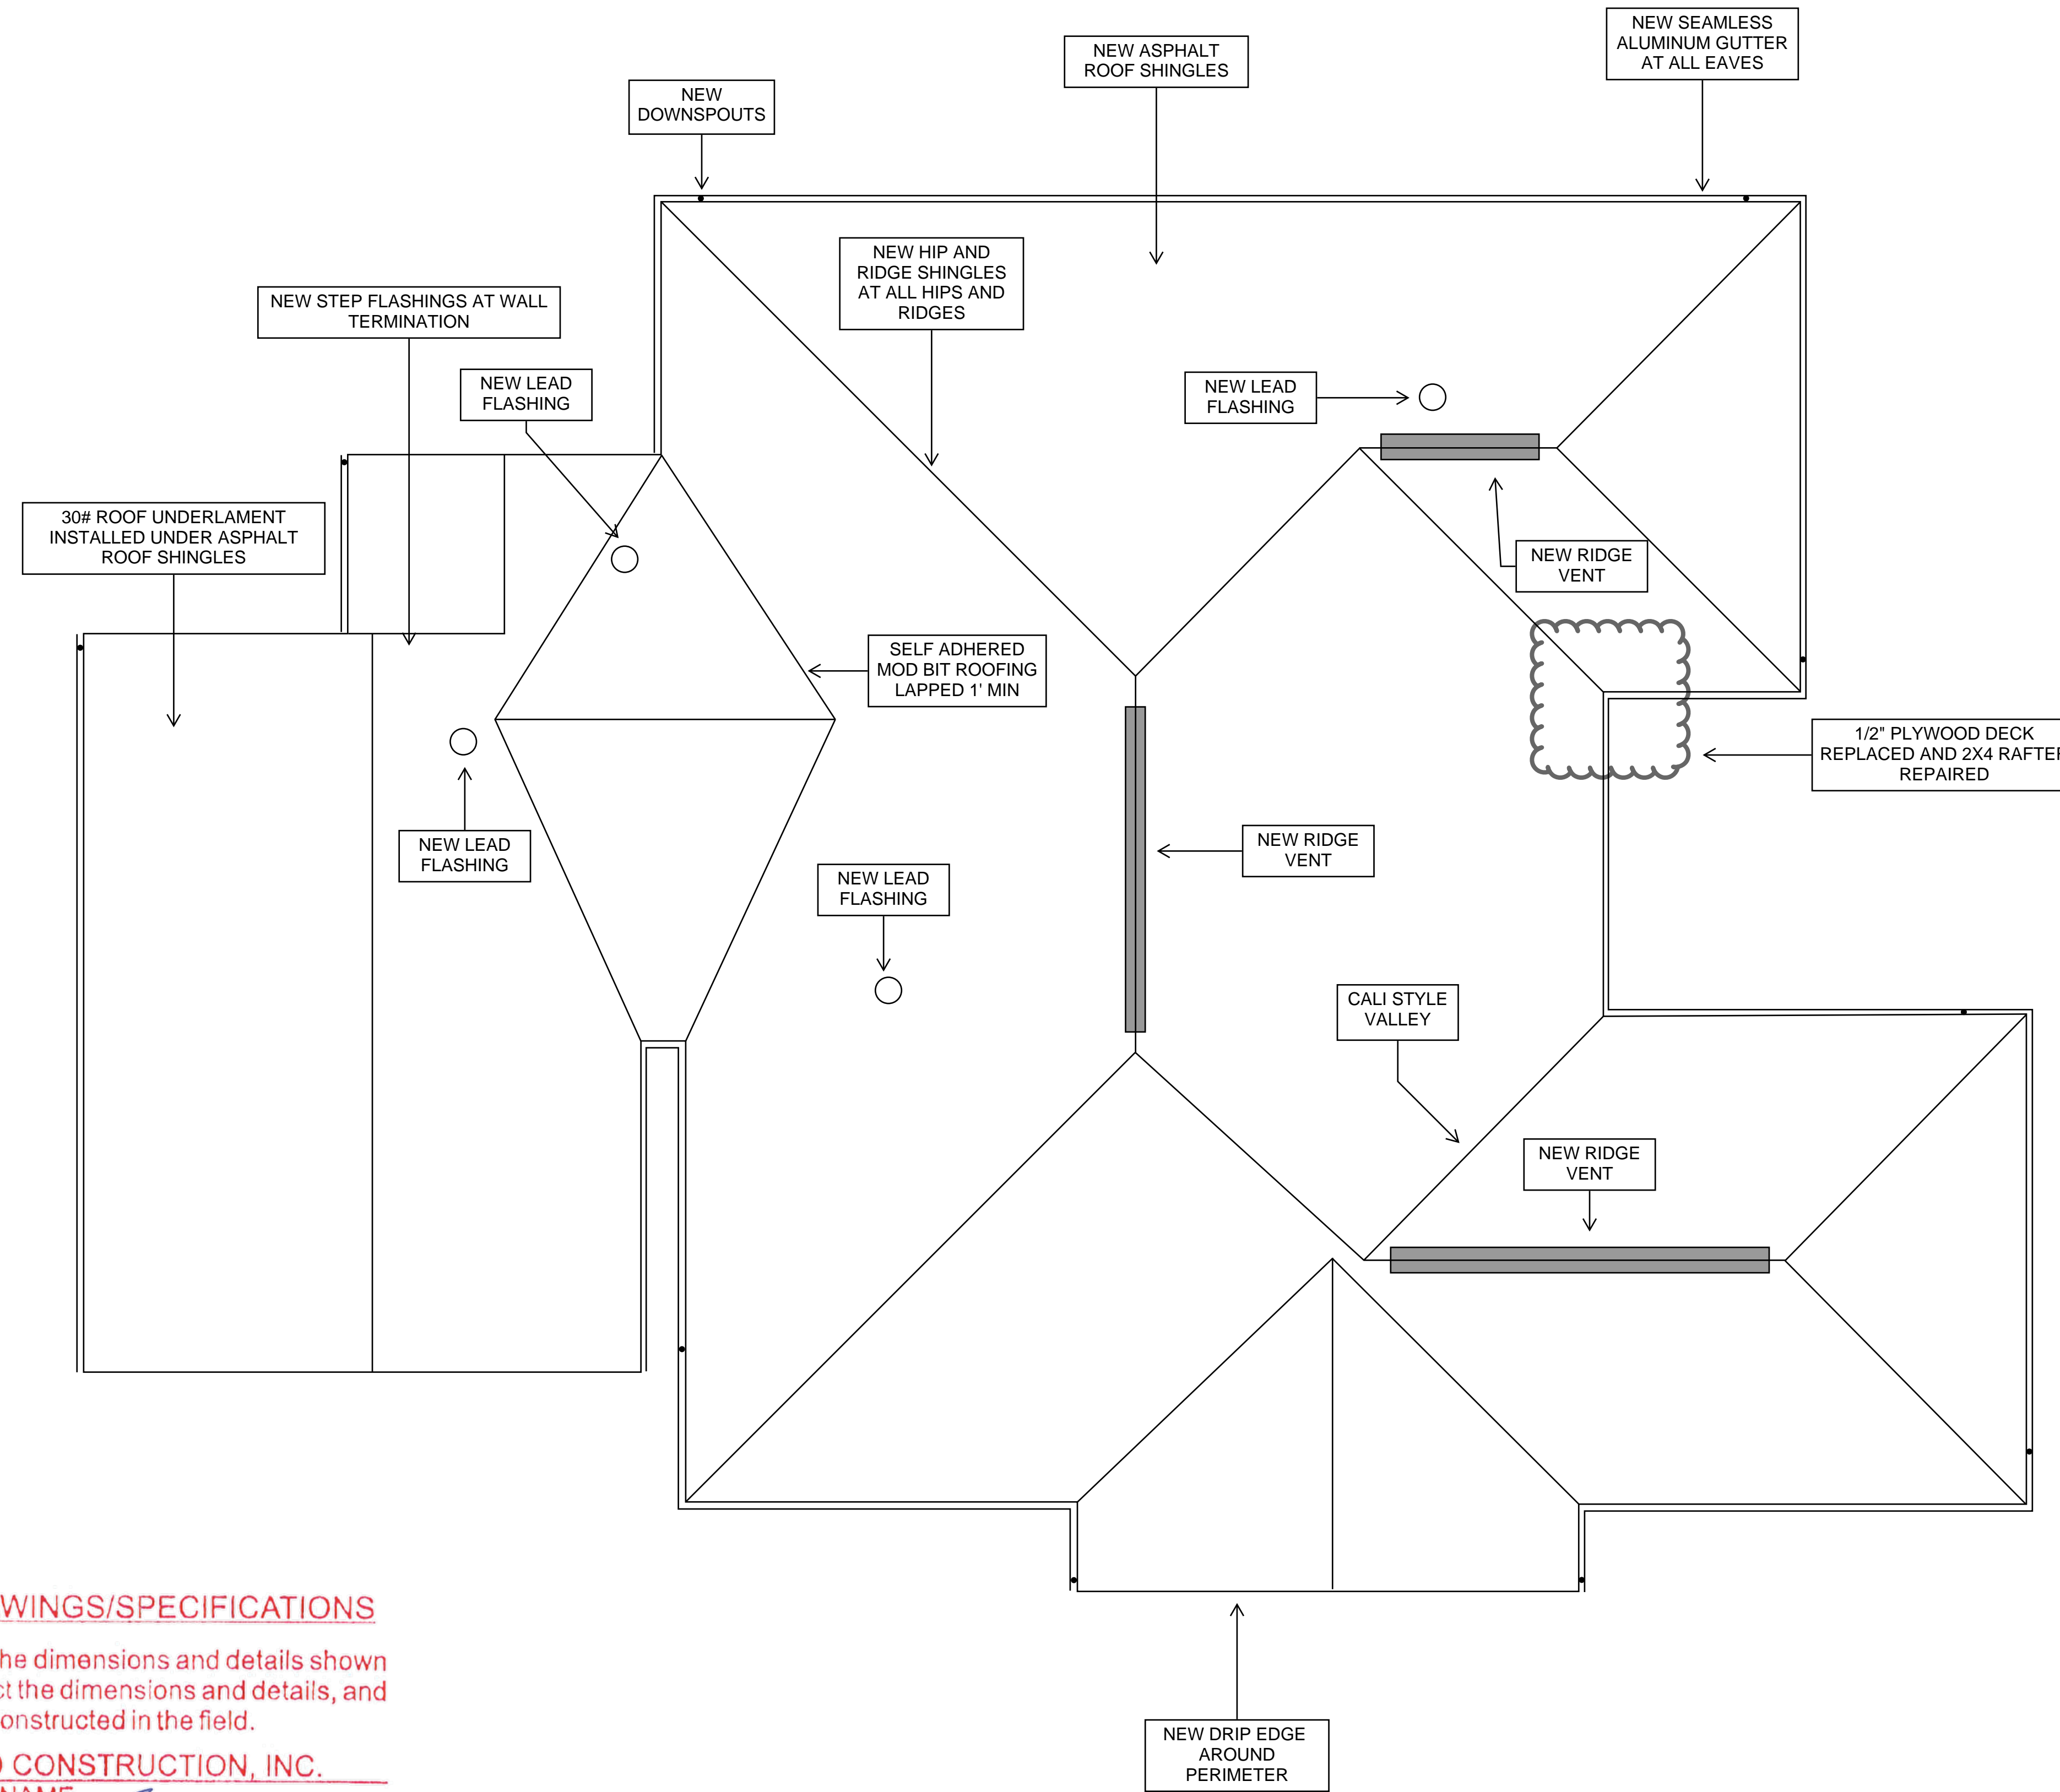

AS-BUILT DRAWINGS/SPECIFICATIONS

This certifies that the dimensions and details shown on this sheet reflect the dimensions and details, and specifications as constructed in the field.

CERTIFIED CONSTRUCTION, INC.
CONTRACTOR'S NAME

[Handwritten Signature]
Signature

01/06/2025
Date