


* ASI #3
item 6


Coverage is excluded from the redlined perimeters




OVERALL FIRST FLOOR PLAN
SCALE: 1/16" = 1'-0"

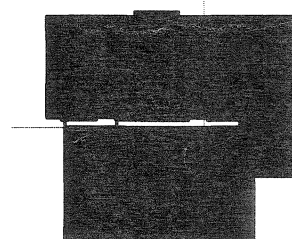


KEYPLAN® 1ST FLOOR

REVISION NO.	SYMBOL	DESCRIPTION	ENT. OF	DATE	APPROVED: PUBLIC WORKS ADMINISTRATOR
					
DEPT. OF ACCOUNTING & GENERAL SERVICES DIVISION OF PUBLIC WORKS STATE OF HAWAII HILO JUDICIARY COMPLEX JUDICIARY BUILDING HILO, HAWAII					
OVERALL FIRST FLOOR PLAN					
THIS WORK WAS PREPARED BY ME OR UNDER MY SUPERVISION					
DESIGNED BY: DC	DRAWN BY: AF	CHECKED BY: GPC	APPROVED BY: GPC	DATE: 11-21-14	PROJECT NO.: A102
				DATE: 01-26-04	SHEET: 81
				SCALE: 1/16" = 1'-0"	OF 457 SHEETS

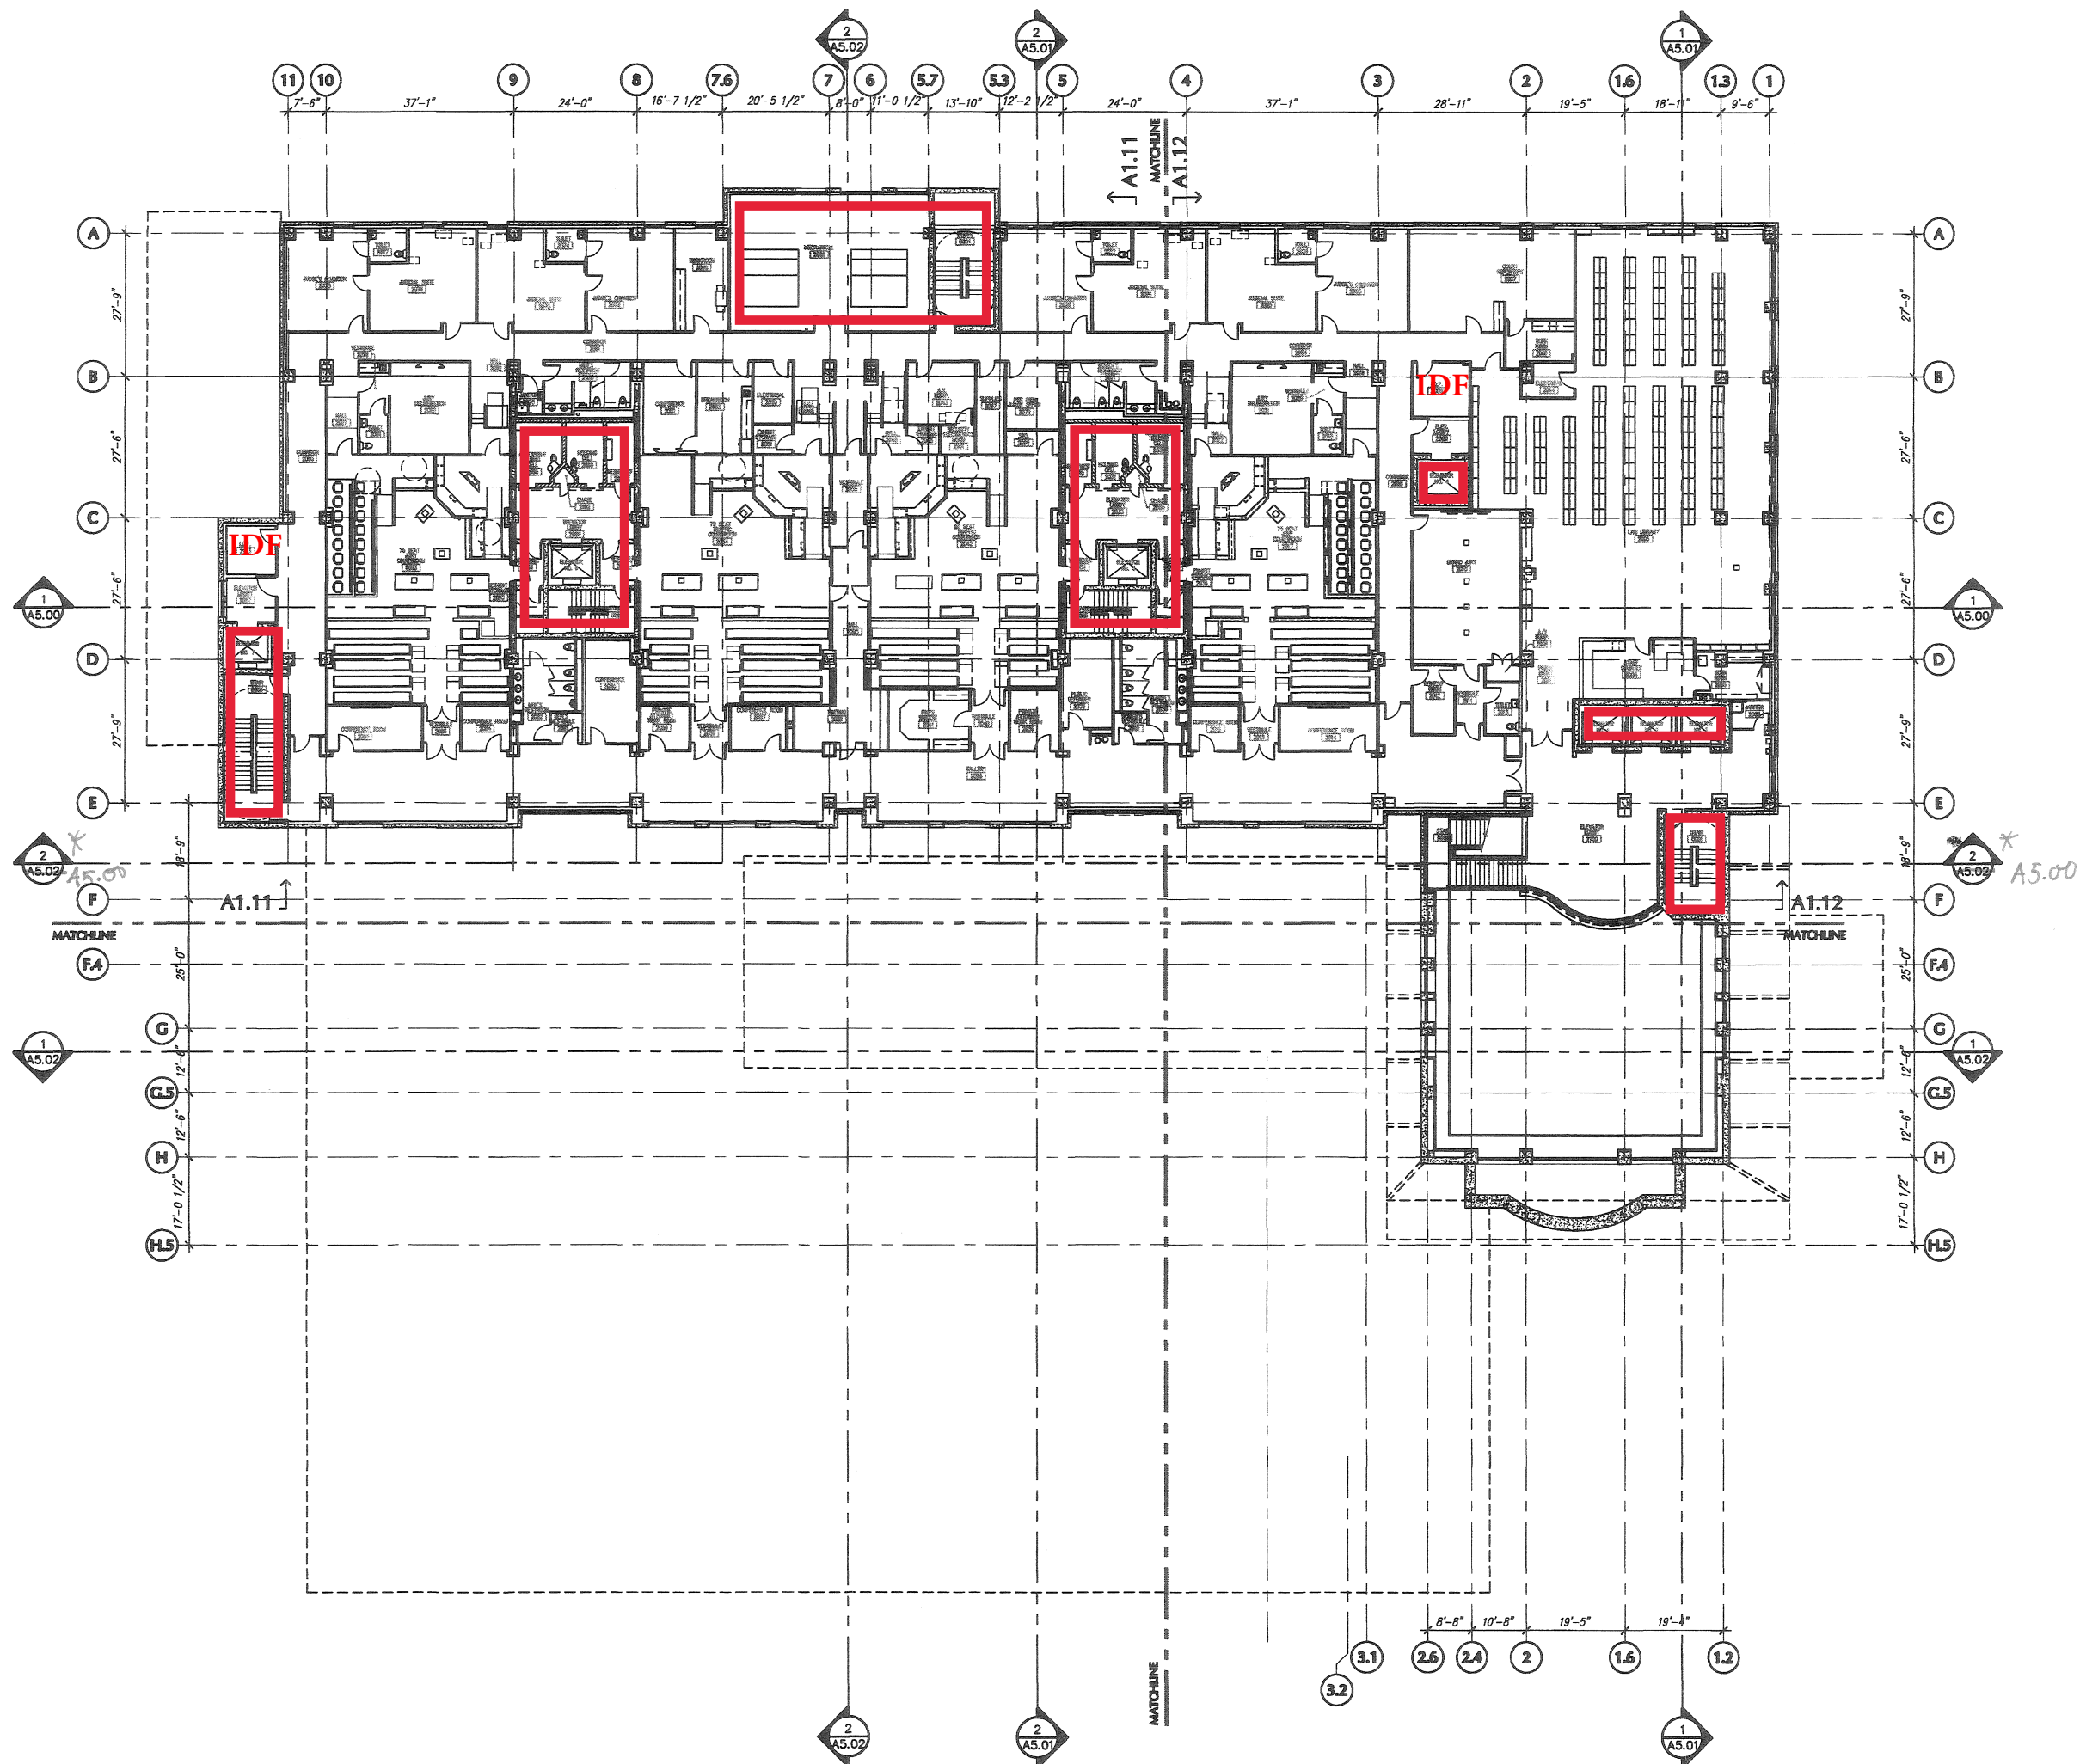


* ASI #3
item 7


Coverage is excluded from the redlined perimeters

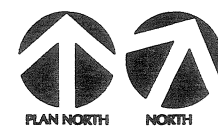


OVERALL SECOND FLOOR PLAN
SCALE: 1/16" = 1'-0"

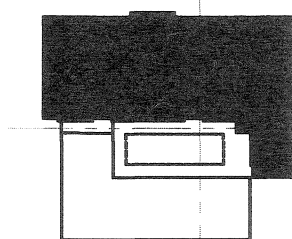


KEYPLAN @ 2ND FLOOR

REVISION NO.	SYL.	DESCRIPTION	INT. OF	DATE	APPROVED: PUBLIC WORKS ADMINISTRATOR
					
DEPT. OF ACCOUNTING & GENERAL SERVICES DIVISION OF PUBLIC WORKS STATE OF HAWAII HILO JUDICIARY COMPLEX JUDICIARY BUILDING HILO, HAWAII					
OVERALL SECOND FLOOR PLAN					
THIS WORK WAS PREPARED BY ME OR UNDER MY SUPERVISION.					
DESIGNED BY: DO	CHECKED BY: CB	DATE: 11-2-11	DRAWN BY: AF		
APPROVED BY: GR	DATE: 01-26-14		SHEET: 82		
ROAD: 1/16" = 1'-0"		DATE: 01/20/14		FILE: DRAWING: FLOOR:	

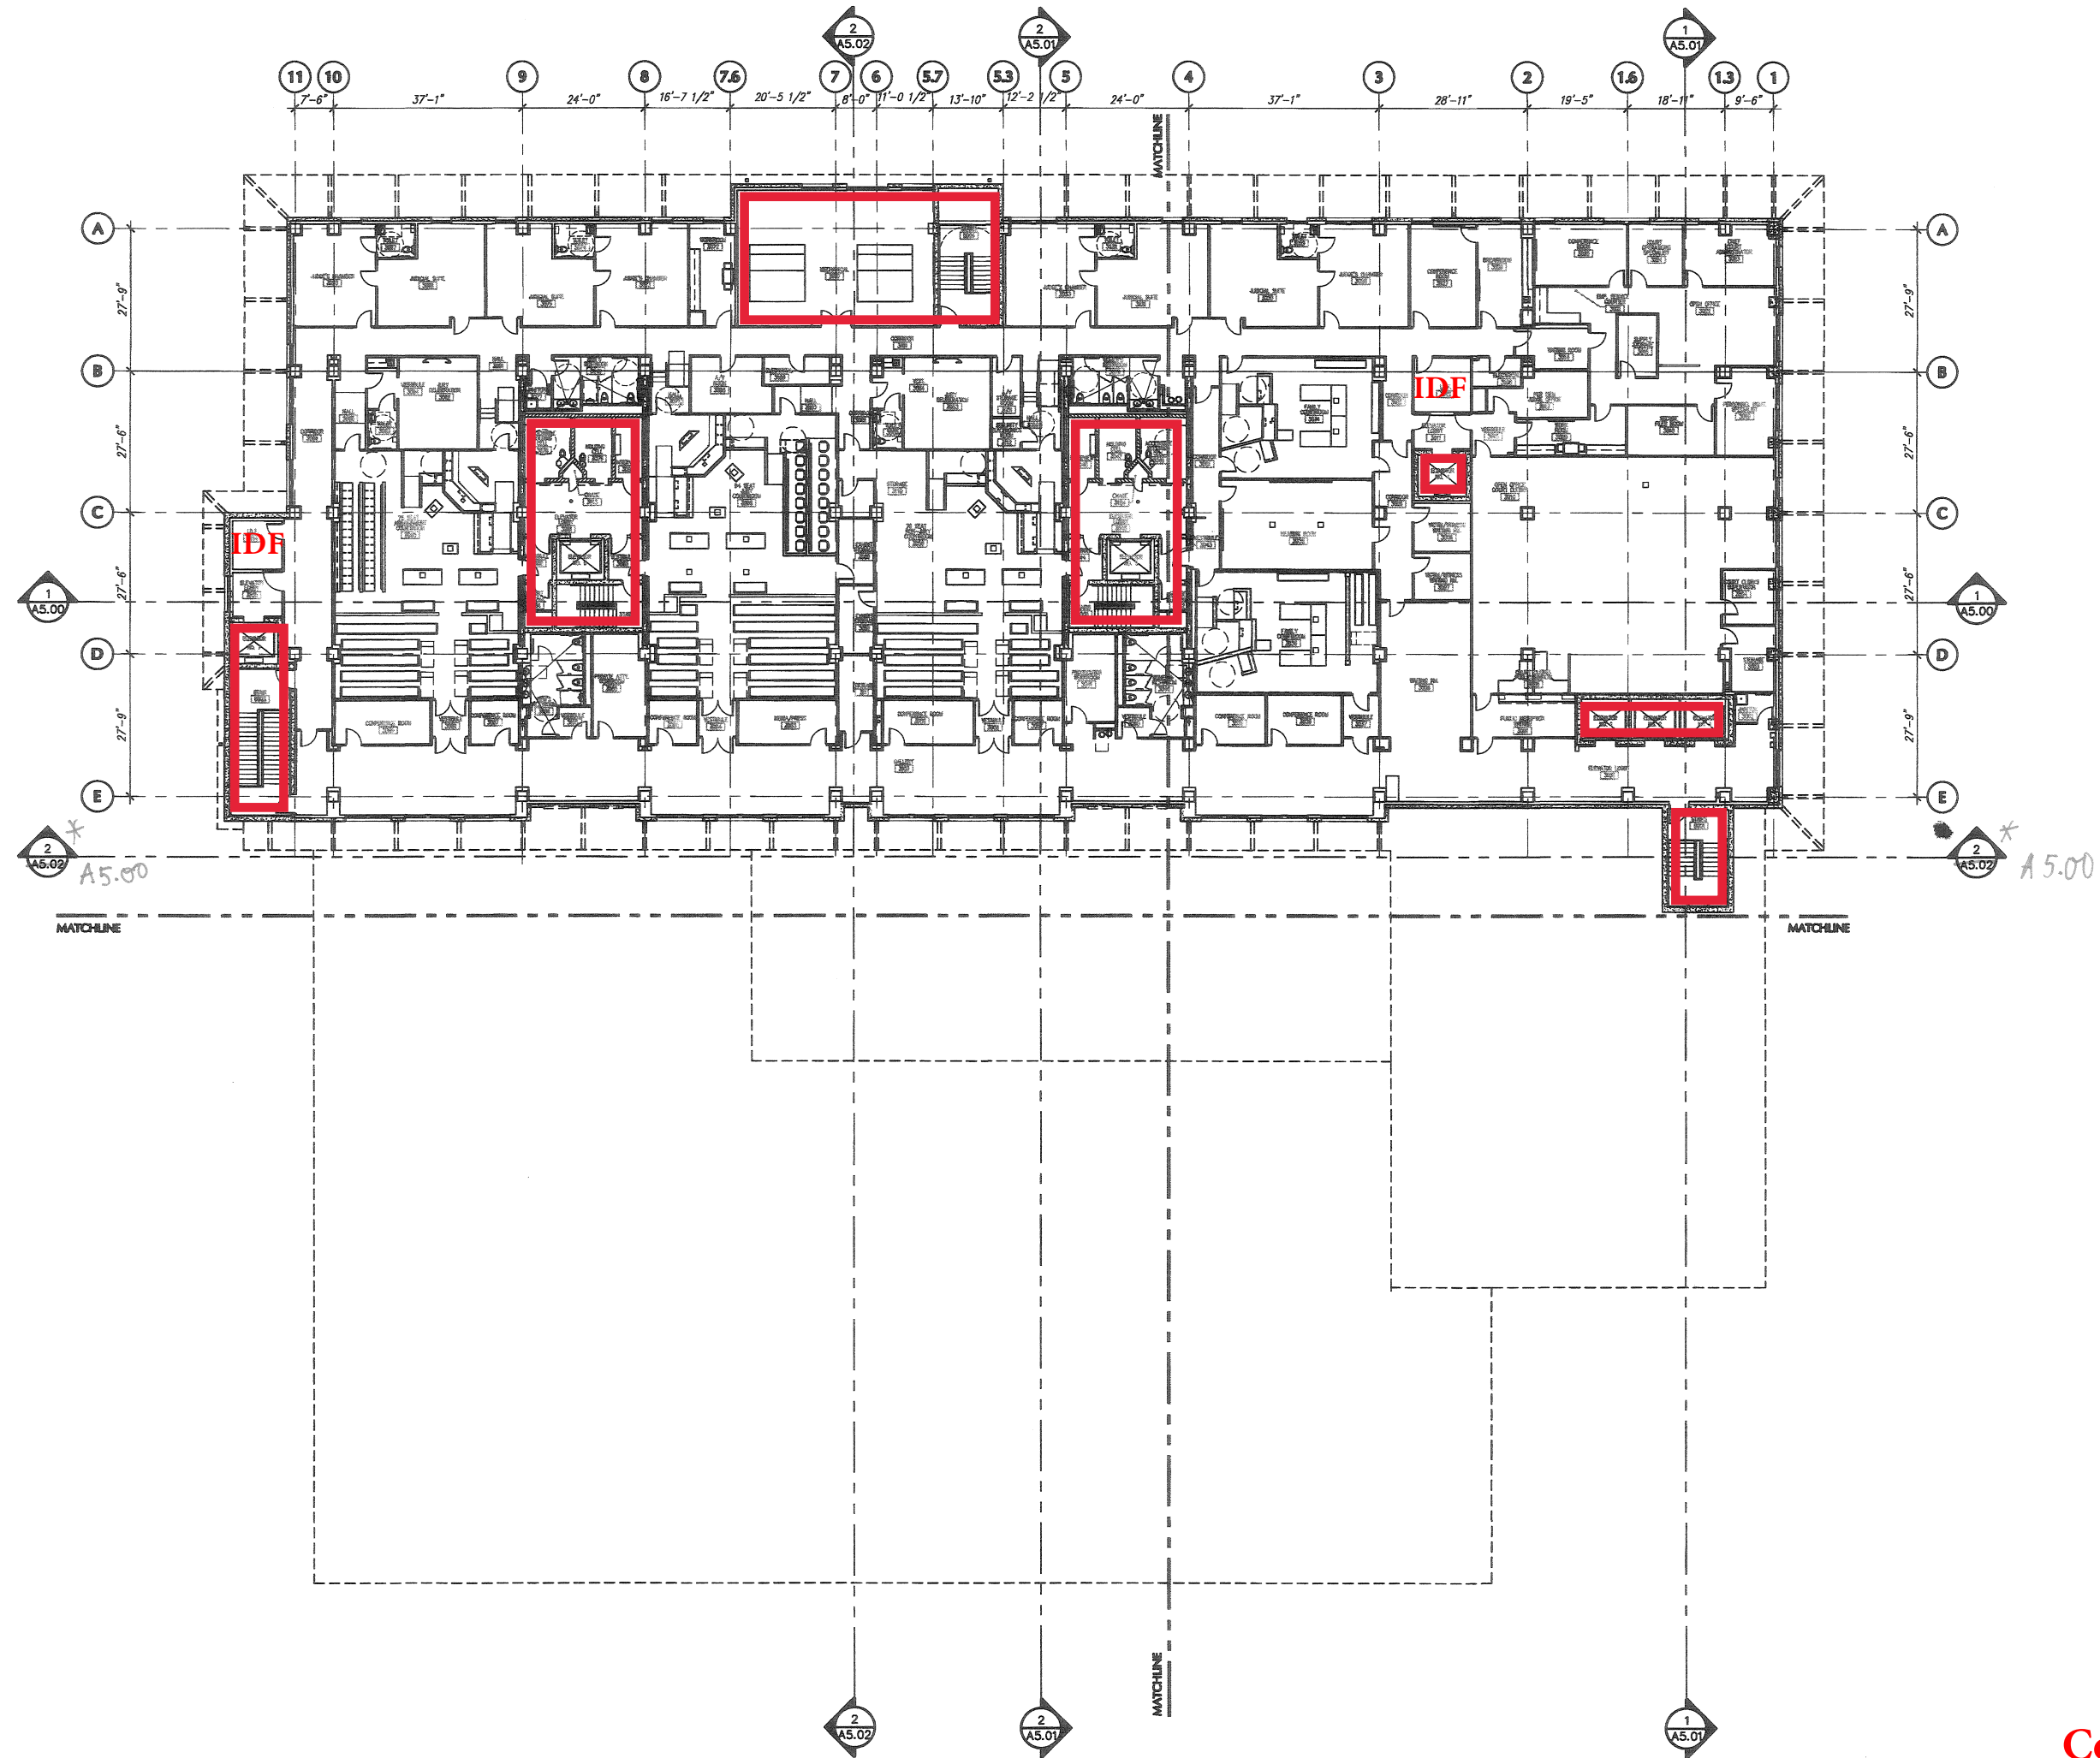


* ASI #3
item 8

Coverage is excluded from the redlined perimeters

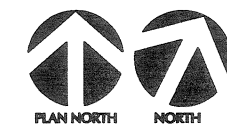

OVERALL THIRD FLOOR PLAN
SCALE: 1/16" = 1'-0"

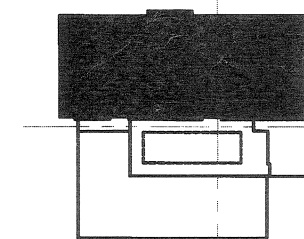

KEYPLAN © 3RD FLOOR

REVISION NO.	SYMBOL	DESCRIPTION	BY	DATE	APPROVED:
					PUBLIC WORKS ADMINISTRATOR

		DEPT. OF ACCOUNTING & GENERAL SERVICES DIVISION OF PUBLIC WORKS STATE OF HAWAII	
		HILO JUDICIARY COMPLEX JUDICIARY BUILDING HILO, HAWAII	
OVERALL THIRD FLOOR PLAN			
DESIGNED BY	CHECKED BY	DRAWN BY	DATE
DO	CG		11-23-145
DATE BY	APPROVED BY	DATE	83
AF	GR		
DP, DATE OF LICENSE	SCALE	DATE	FILE
04/30/04	1/16" = 1'-0"	01-26-04	487