





* ASI #3
item 6

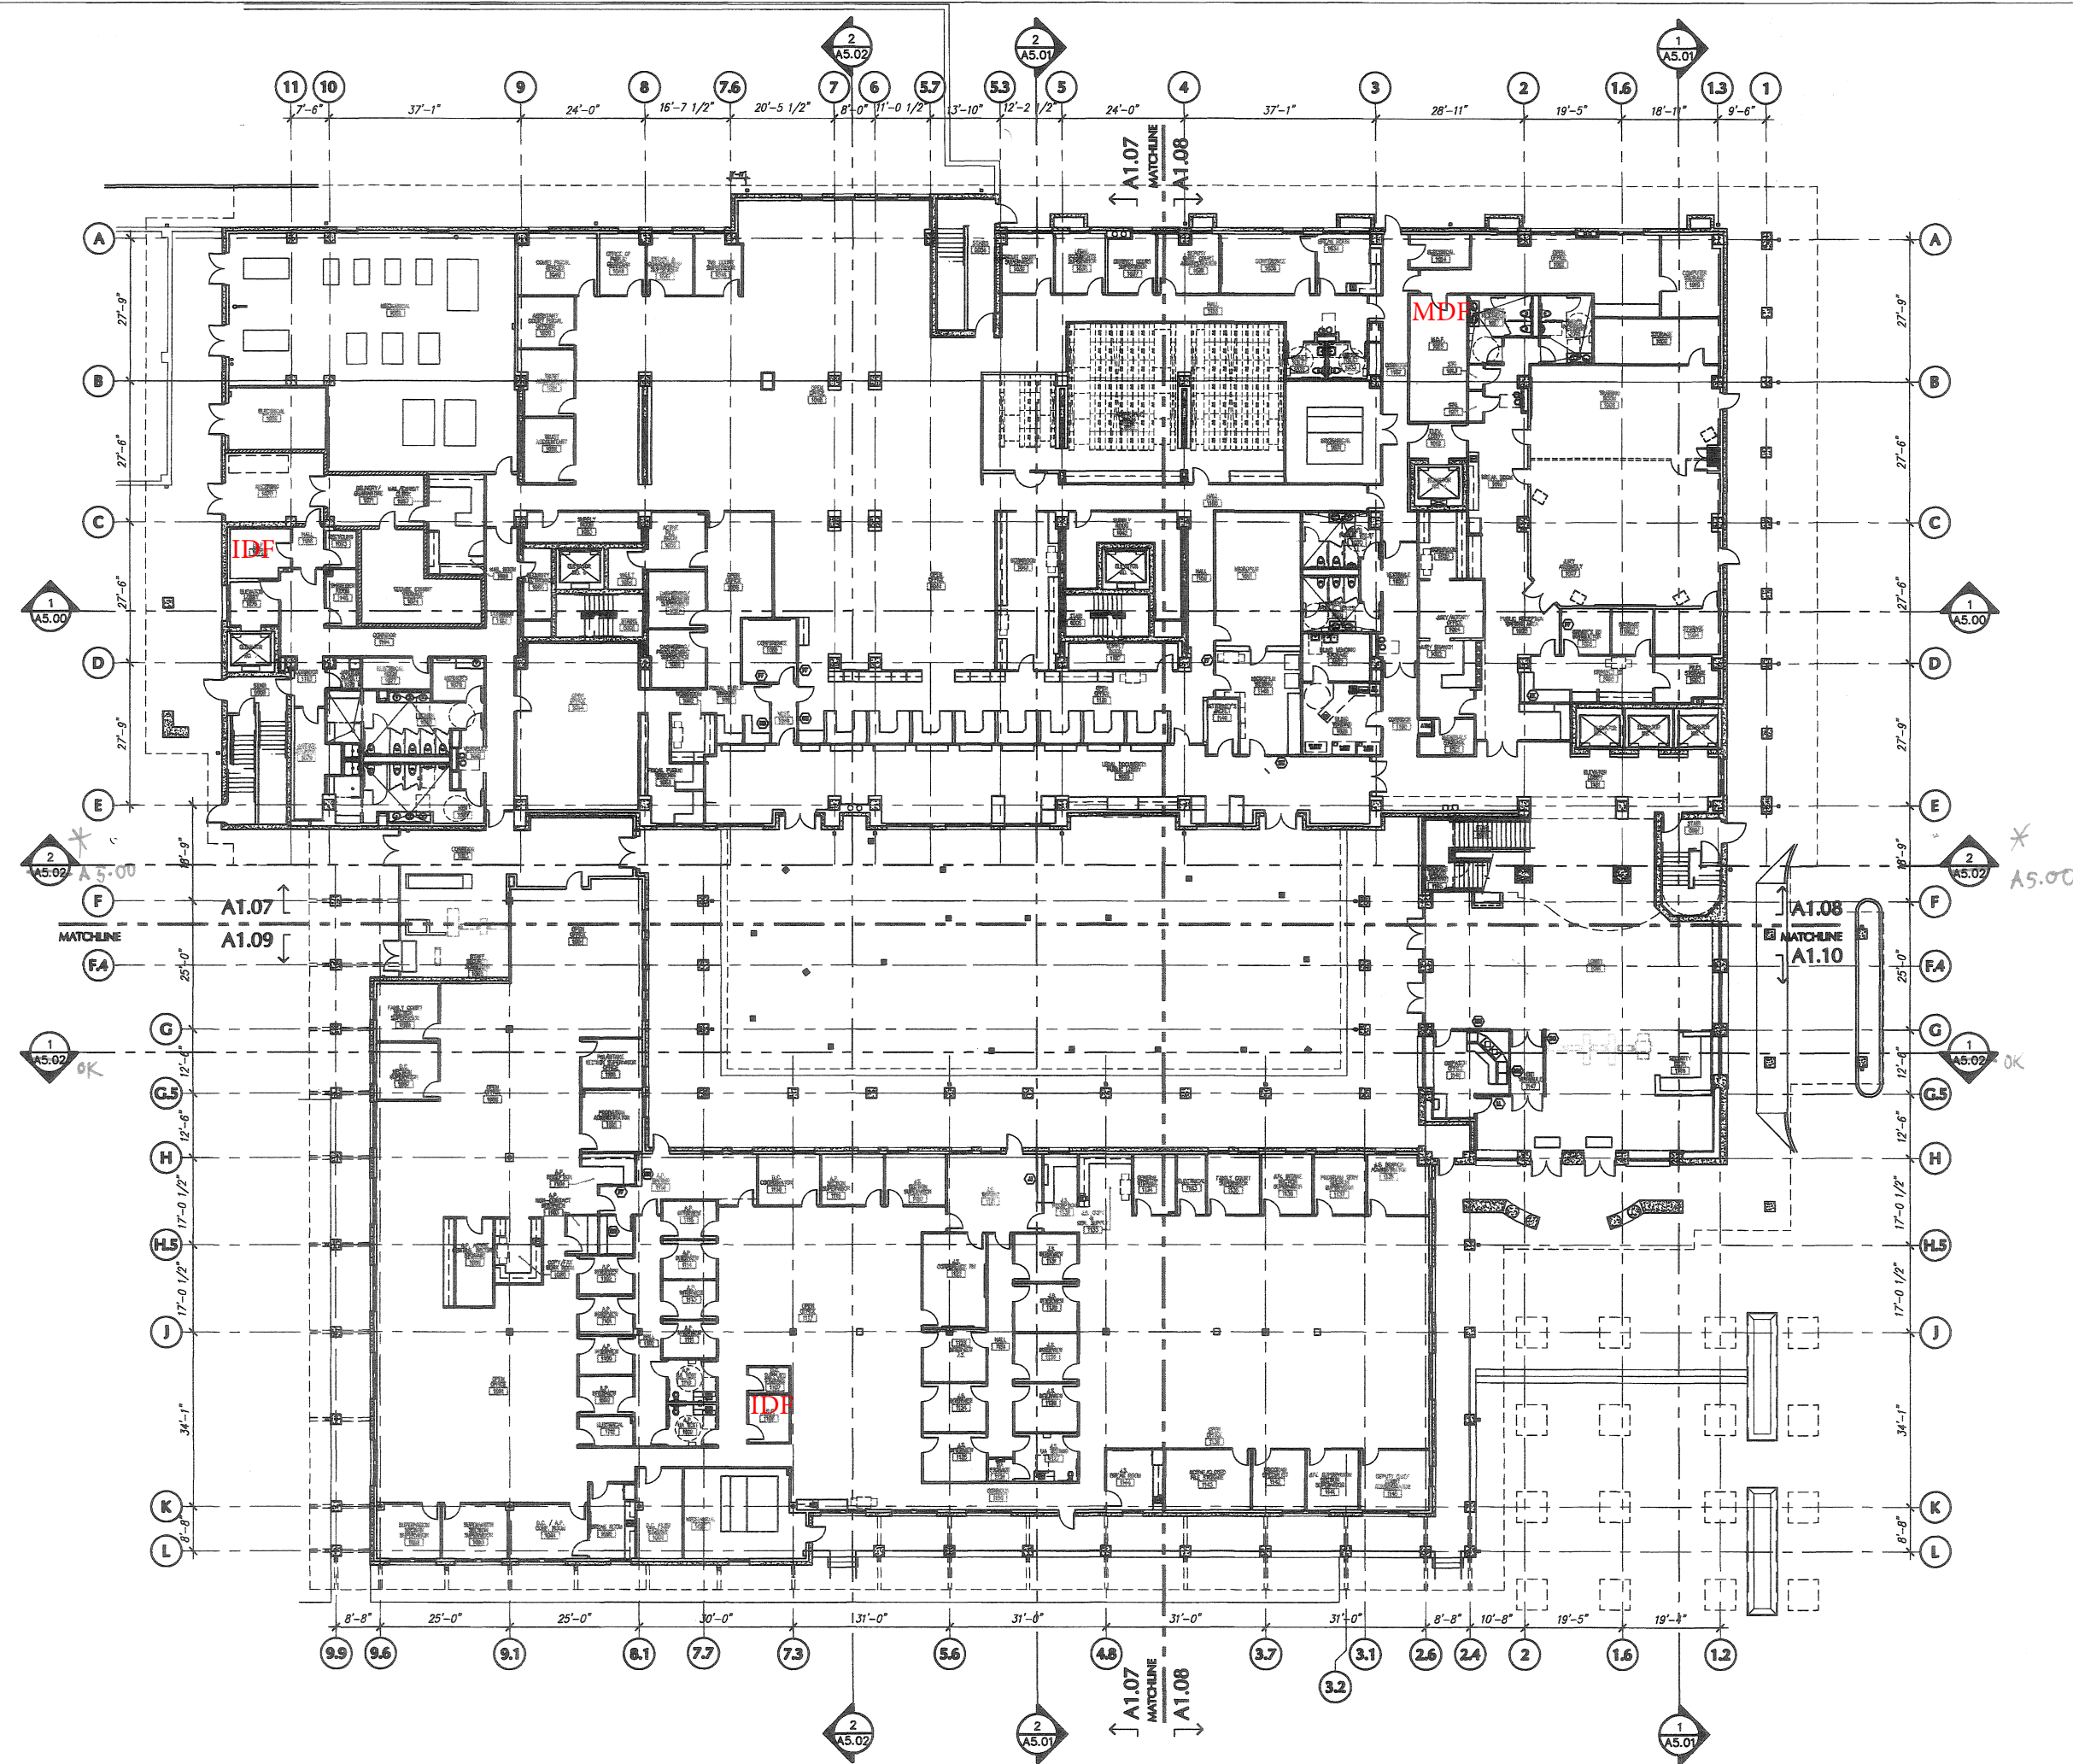


OVERALL FIRST FLOOR PLAN
SCALE: 1/16" = 1'-0"

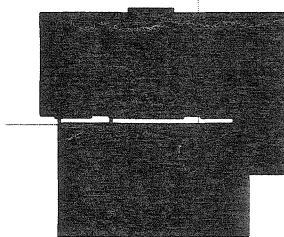

KEYPLAN @ 1ST FLOOR

REVISION NO.	SYMBOL	DESCRIPTION	SHEET NO.	DATE	APPROVED BY
					PUBLIC WORKS ADMINISTRATOR


		DEPT. OF ACCOUNTING & GENERAL SERVICES DIVISION OF PUBLIC WORKS STATE OF HAWAII HILO JUDICIARY COMPLEX JUDICIARY BUILDING HILO, HAWAII	
THIS WORK WAS PREPARED BY ME OR UNDER MY SUPERVISION. <i>Melvin Y. K. Choi</i>		OVERALL FIRST FLOOR PLAN DURRANT MEDIA FIVE DESIGNED BY: DO CHECKED BY: GS DATE: 11-2-11 APPROVED BY: AF DATE: 01-26-04 SCALE: 1/16" = 1'-0" SHEET: 81 OF 437	

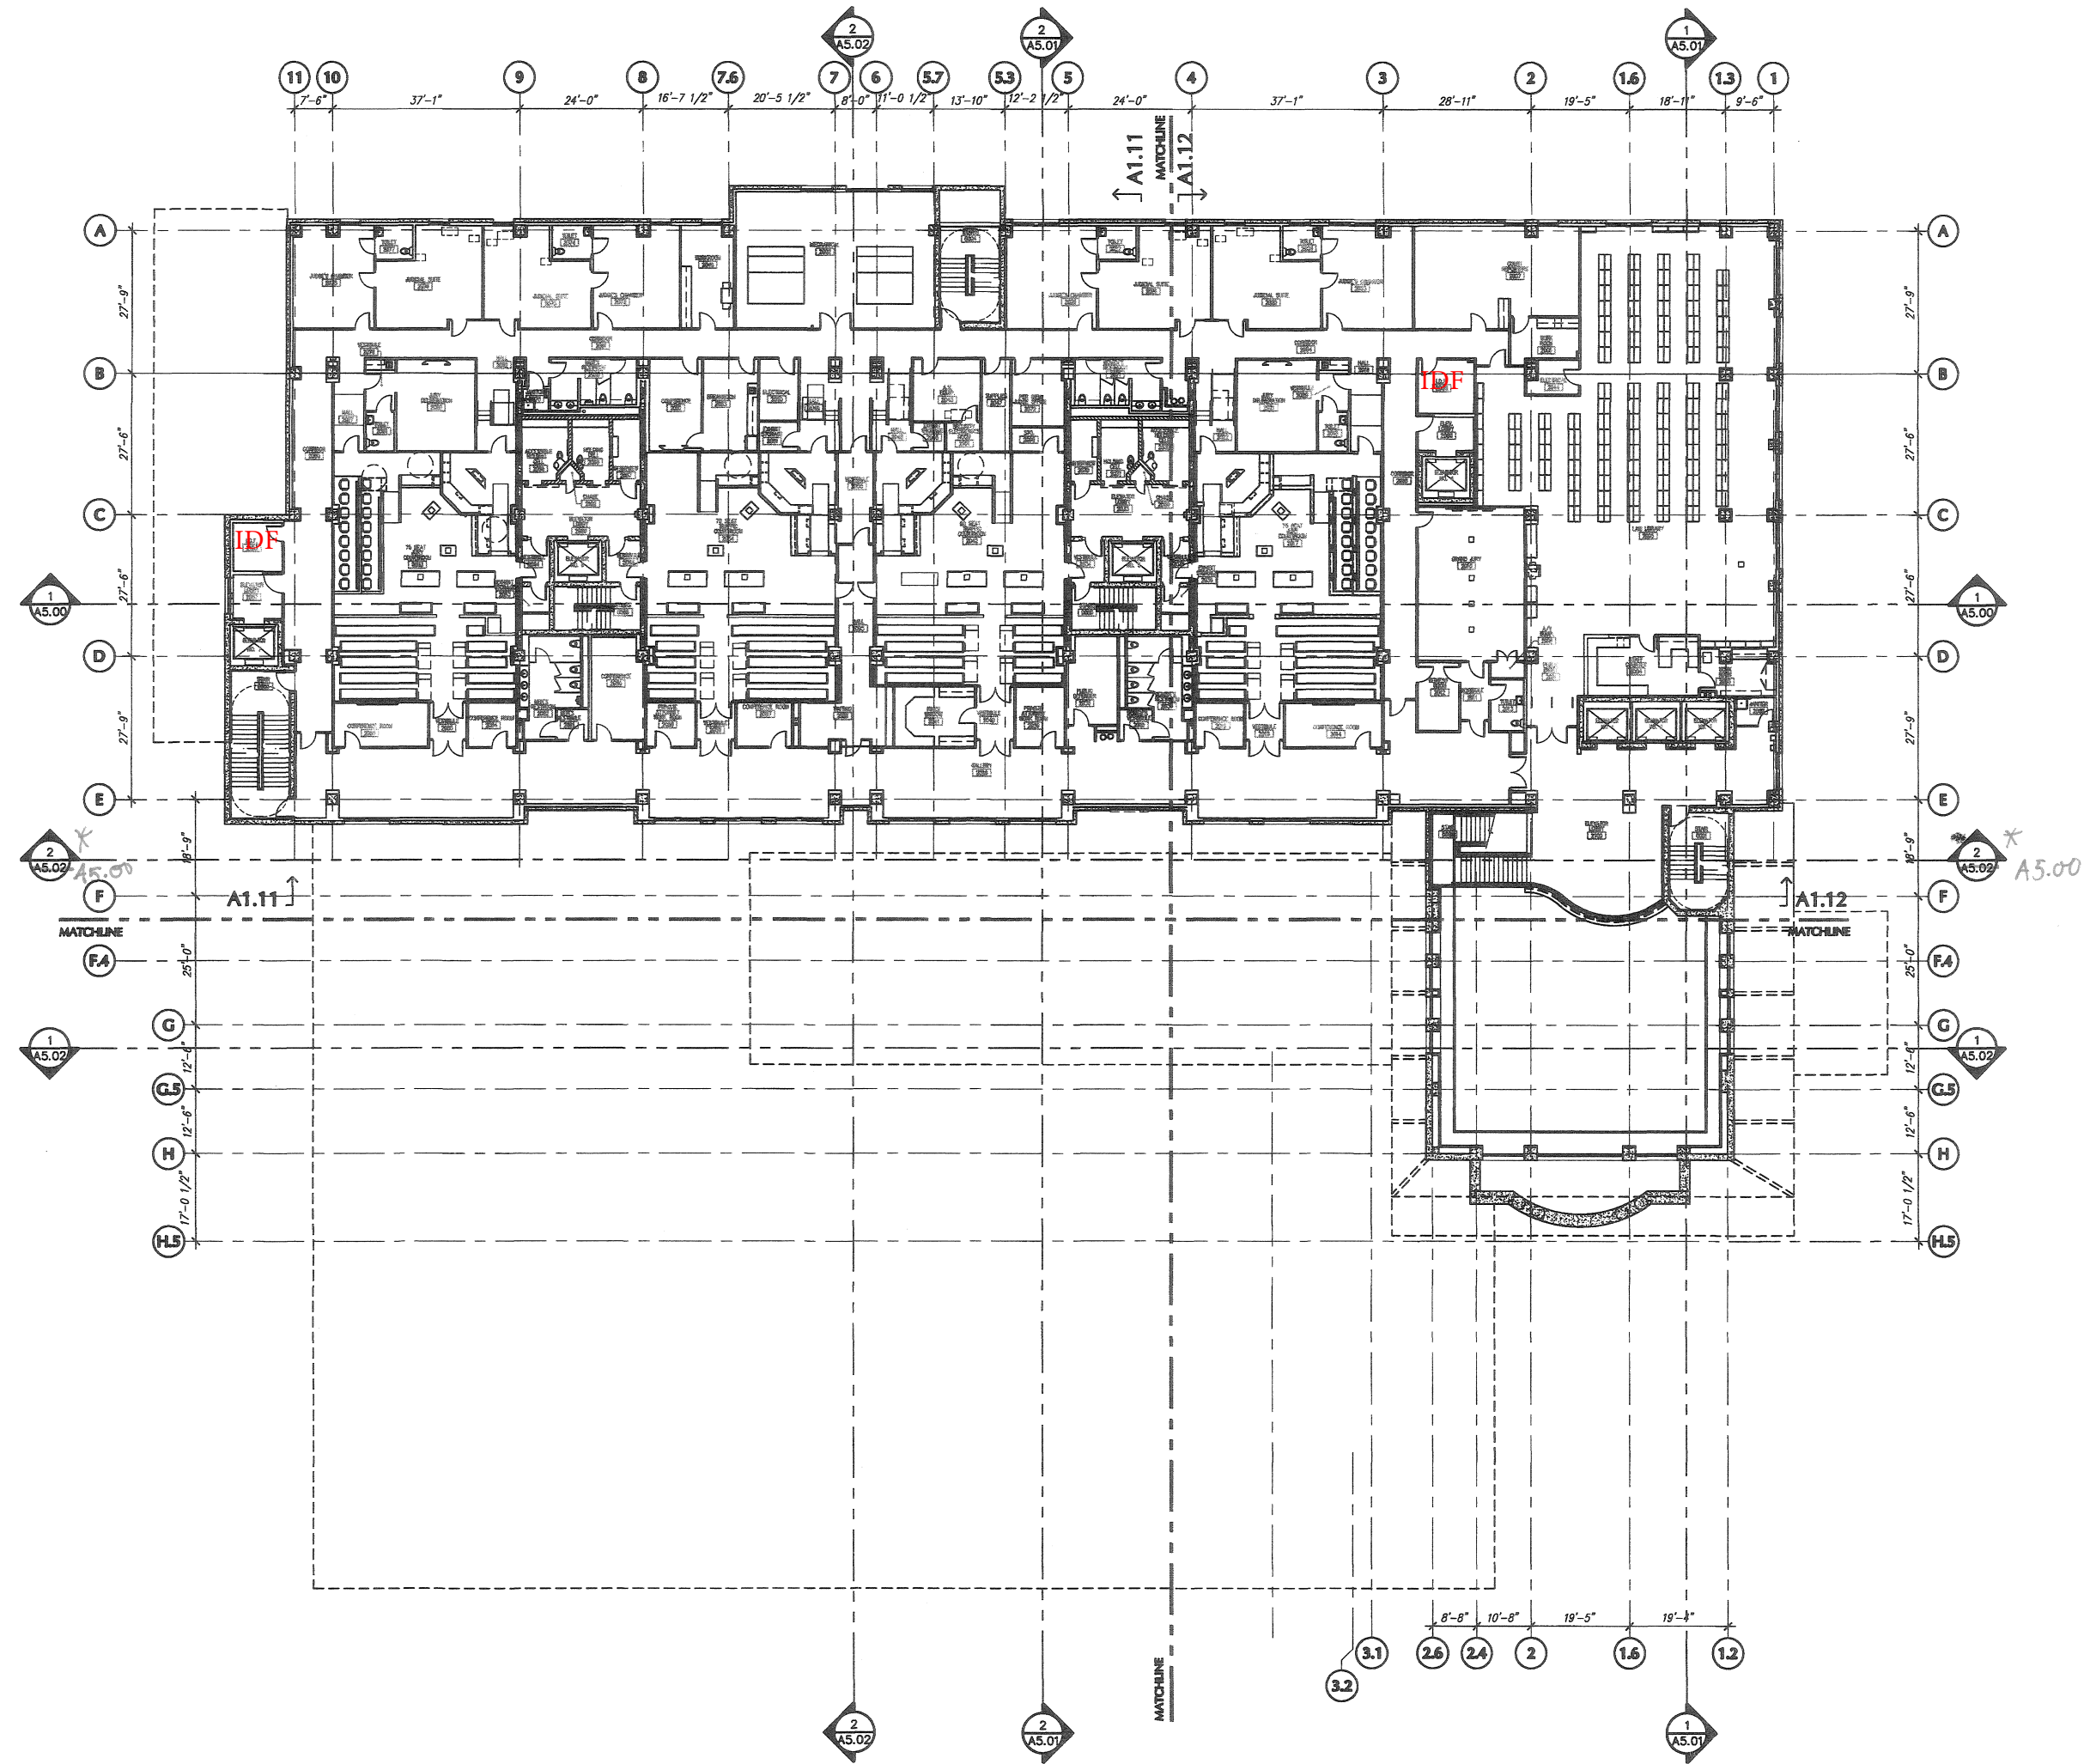

* A51 #3
item 7




OVERALL SECOND FLOOR PLAN
SCALE: 1/16" = 1'-0"

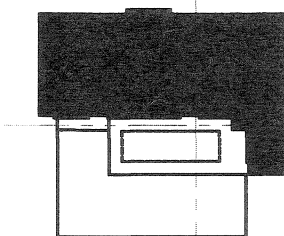

KEYPLAN @ 2ND FLOOR


REVISION NO.	SYMBOL	DESCRIPTION	SHT. OF	DATE	APPROVED: PUBLIC WORKS ADMINISTRATOR
 THIS WORK WAS PREPARED BY ME OR UNDER MY SUPERVISION. <i>Melvin Y. K. Choy</i> EXP. DATE OF LICENSE: 04/30/04 DEPT. OF ACCOUNTING & GENERAL SERVICES DIVISION OF PUBLIC WORKS STATE OF HAWAII HILO JUDICIARY COMPLEX JUDICIARY BUILDING HILO, HAWAII OVERALL SECOND FLOOR PLAN DURRANT MEDIA FIVE DESIGNED BY: DO CHECKED BY: CG DATE: 11-21-14 APPROVED BY: GR DATE: 01-26-14 SCALE: 1/16" = 1'-0" SHEET NO. A103 SHEET 82 OF 457 SHEETS					

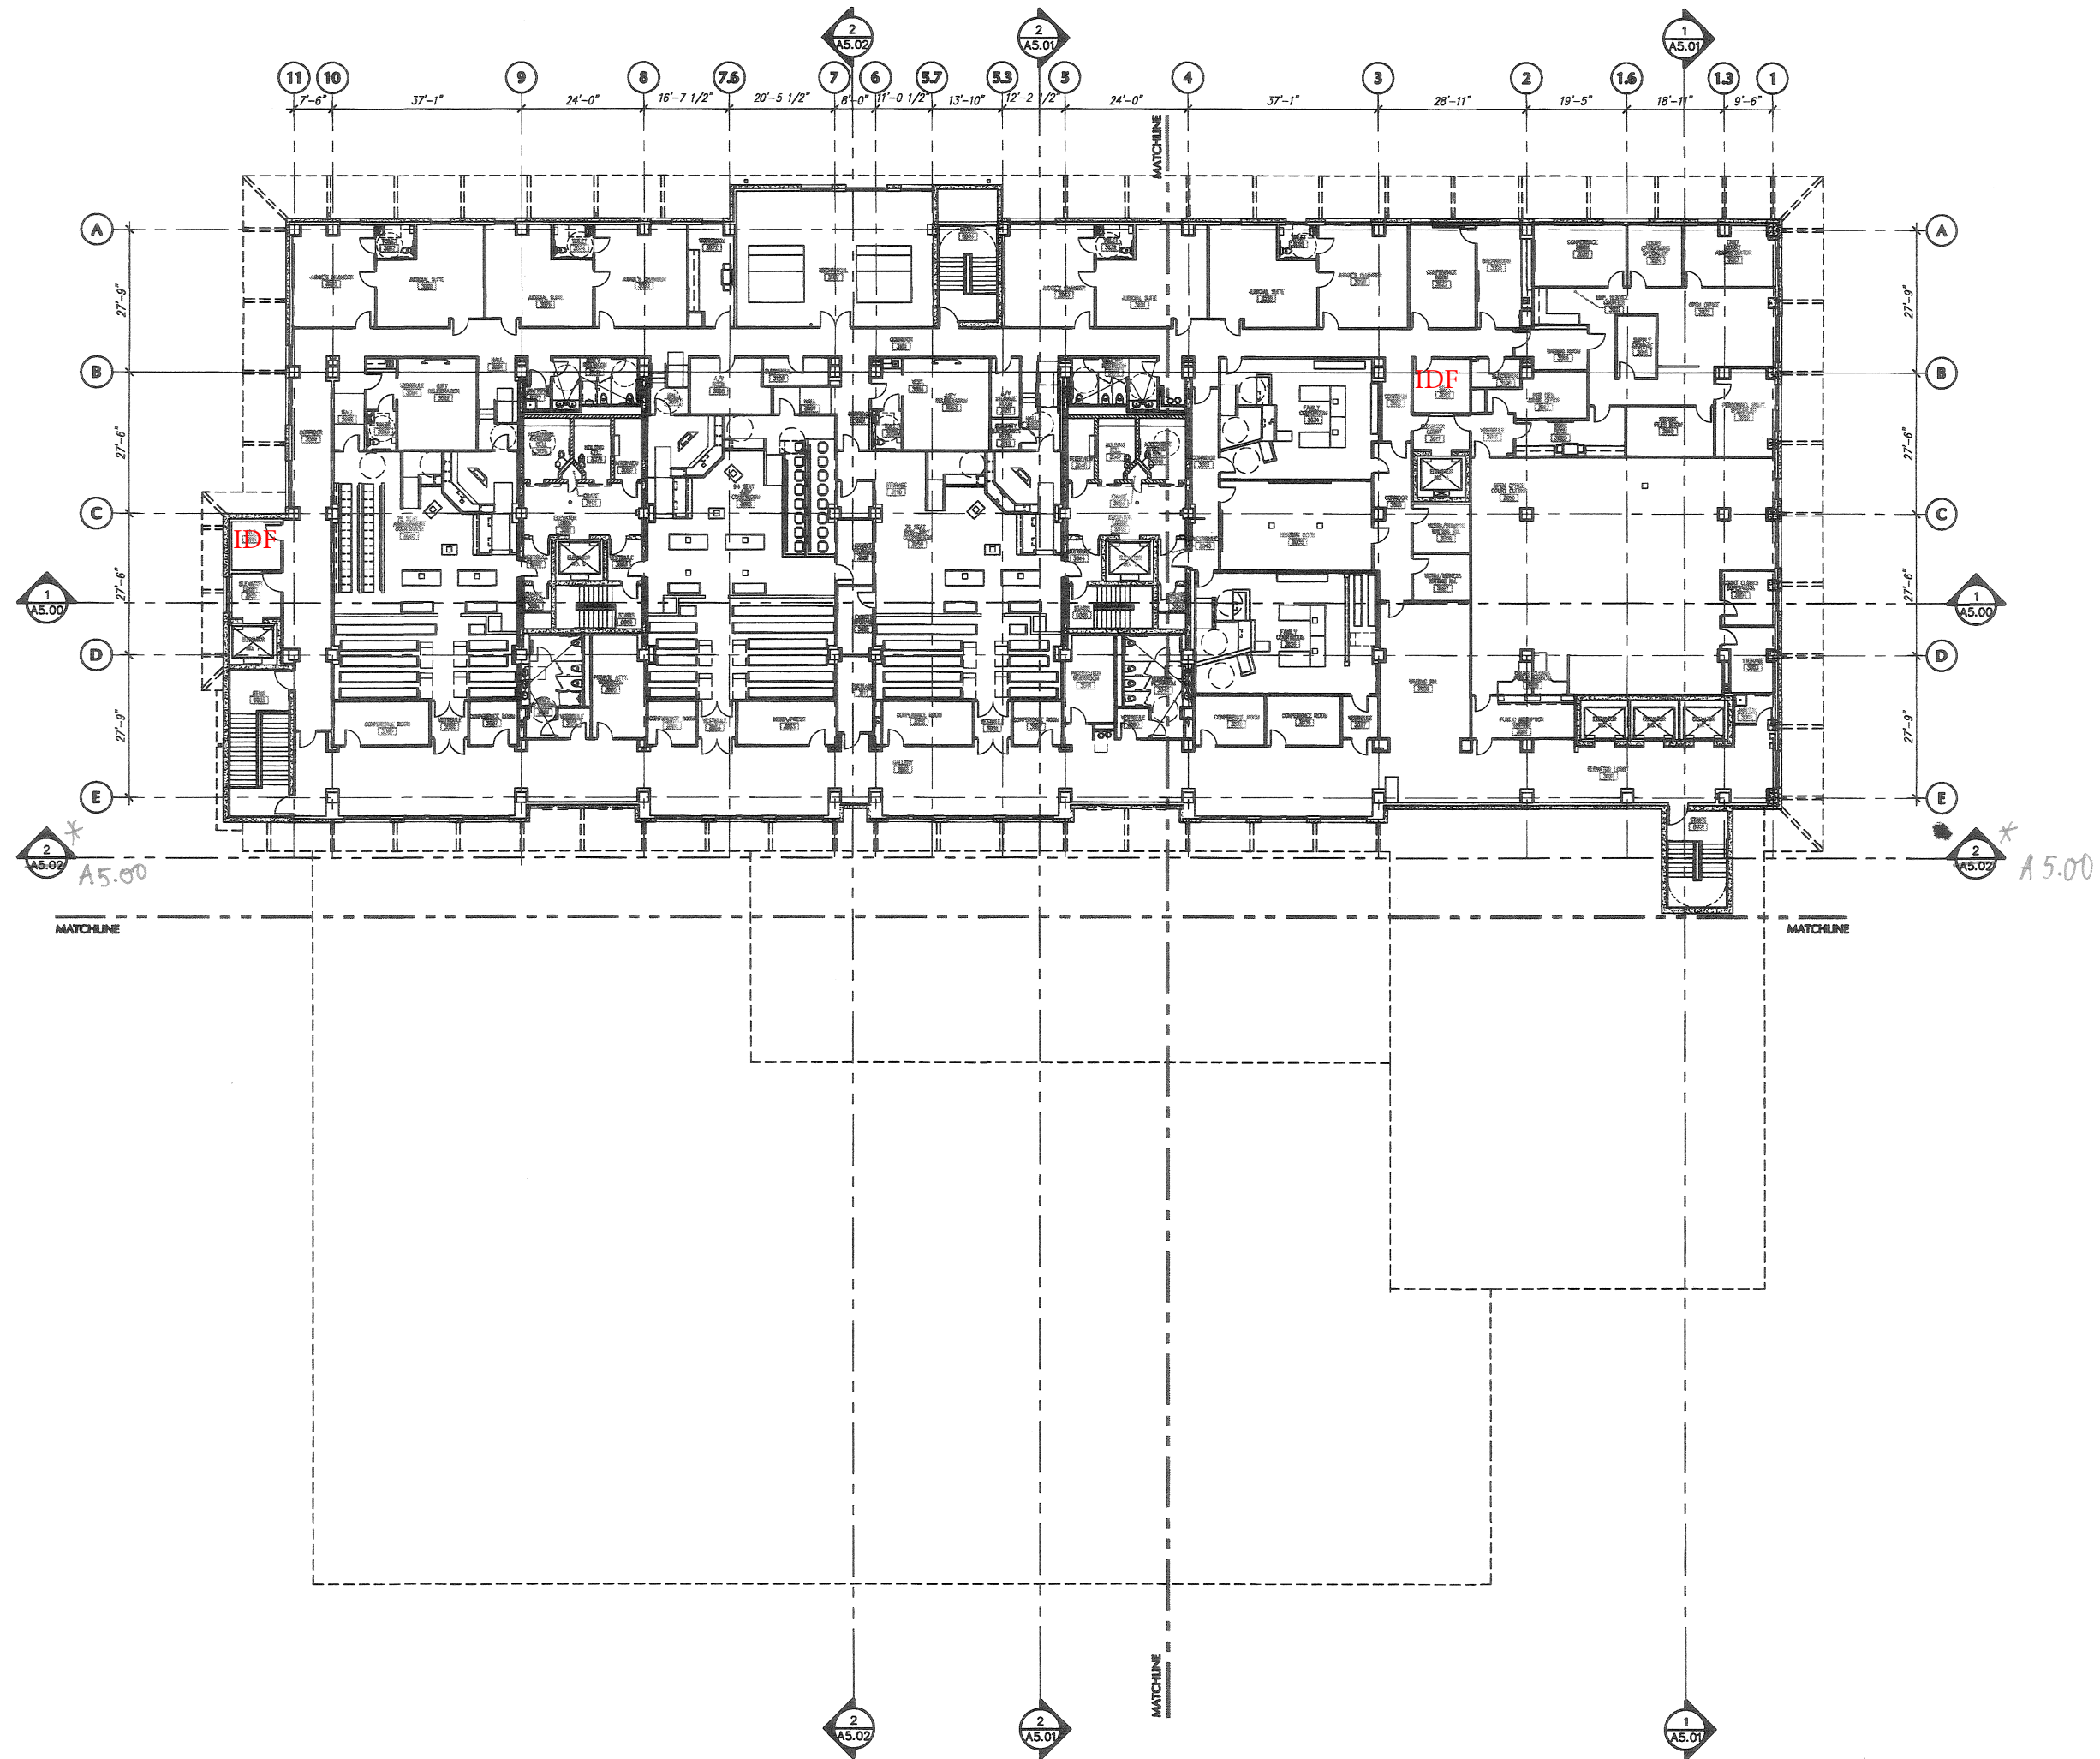

* ASI #3
item 8



OVERALL THIRD FLOOR PLAN
SCALE: 1/16" = 1'-0"

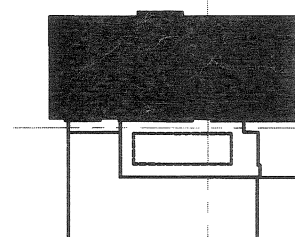

KEYPLAN @ 3RD FLOOR

REVISION NO.	SYMBOL	DESCRIPTION	SHT. OF	DATE	APPROVED: PUBLIC WORKS ADMINISTRATOR
 DEPT. OF ACCOUNTING & GENERAL SERVICES DIVISION OF PUBLIC WORKS STATE OF HAWAII HILO JUDICIARY COMPLEX JUDICIARY BUILDING HILO, HAWAII OVERALL THIRD FLOOR PLAN					
DESIGNED BY: DO DRAWN BY: AF			CHECKED BY: CG APPROVED BY: GR		DATE: 11-21-14 SHEET: 83
EXP. DATE OF LICENSE: 04/30/04			SCALE: 1/16" = 1'-0"		FILE: 497