



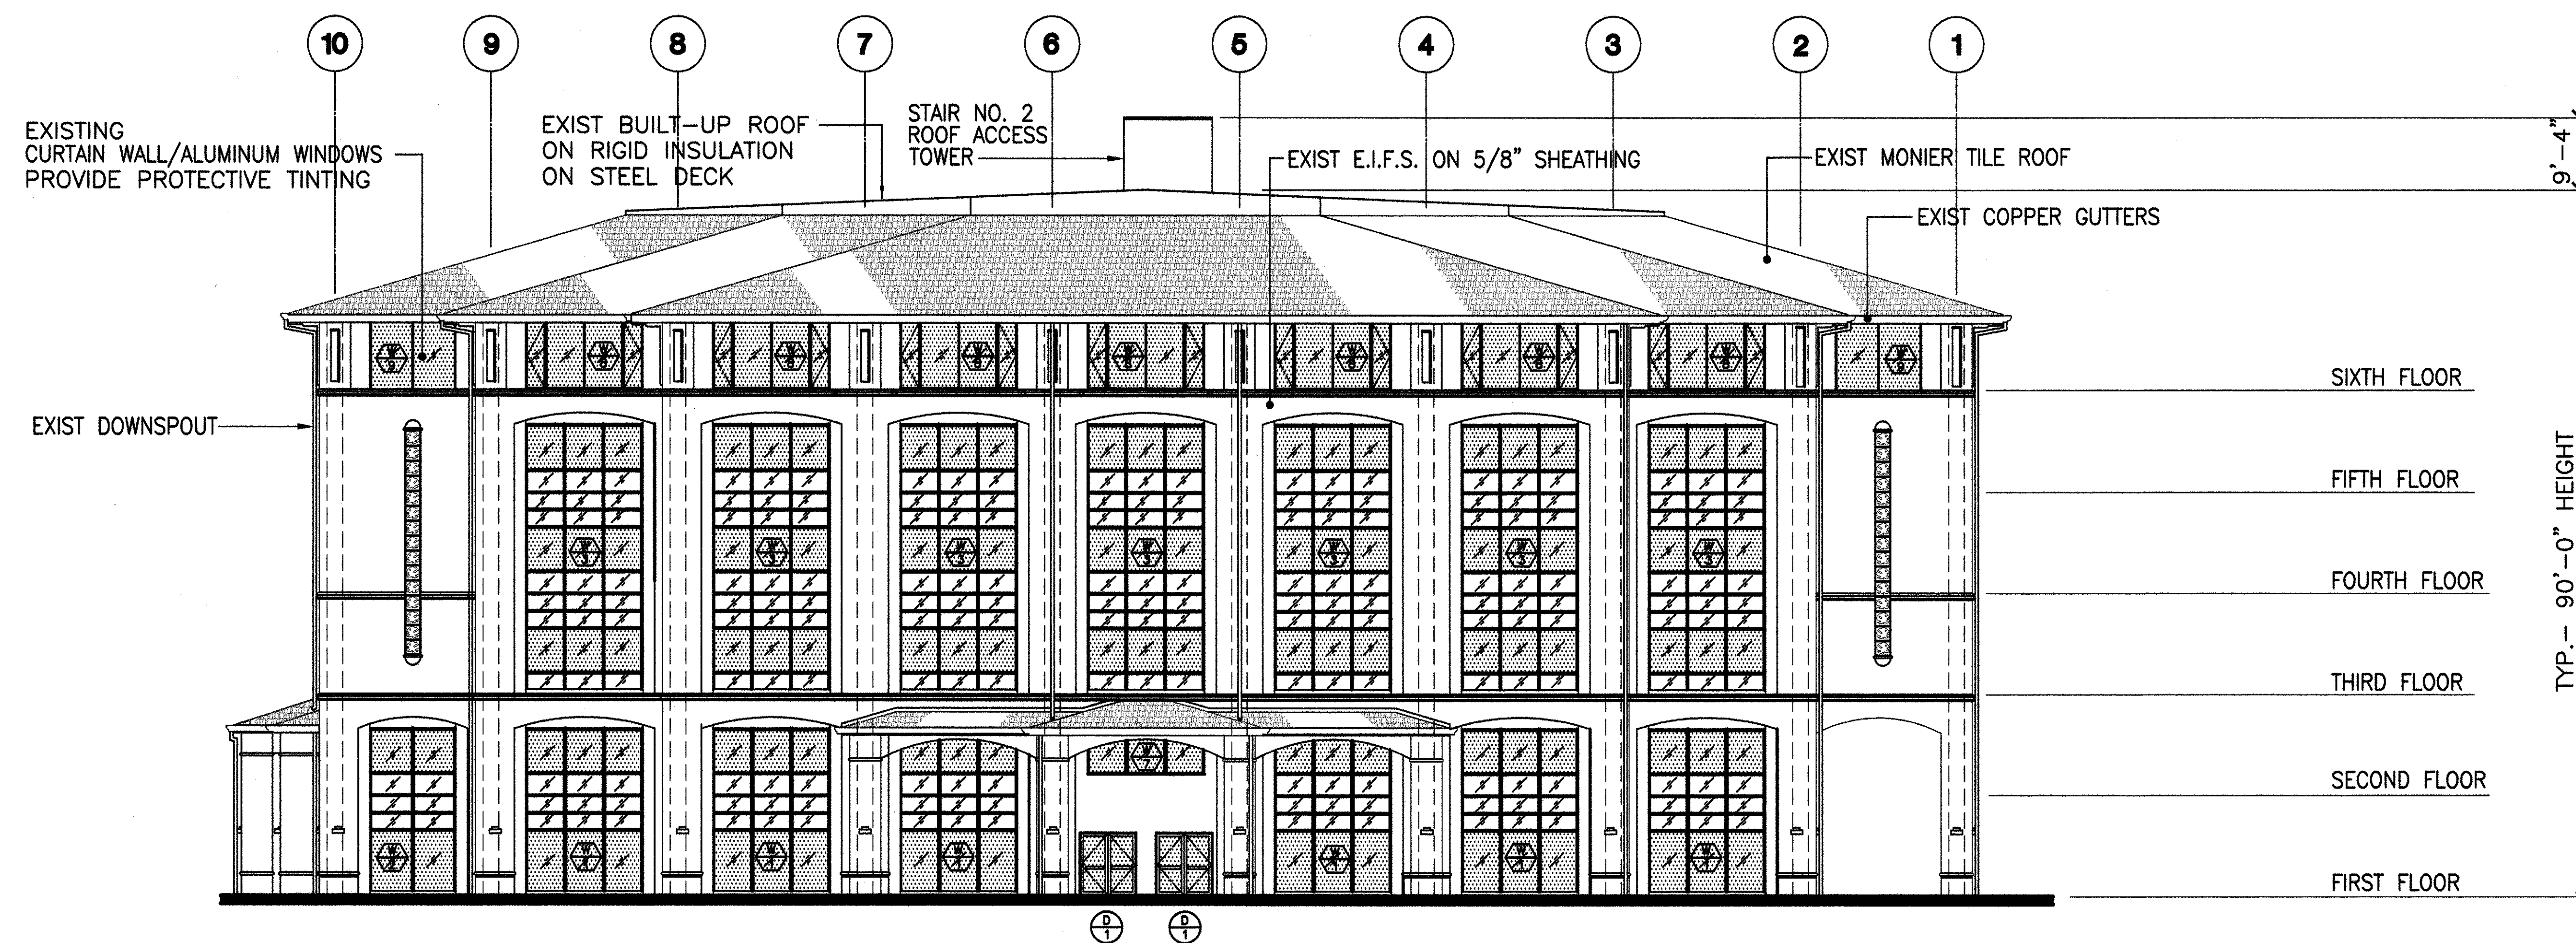

A NORTH WEST ELEVATION
A-6 SCALE: 1/16" = 1'-0"

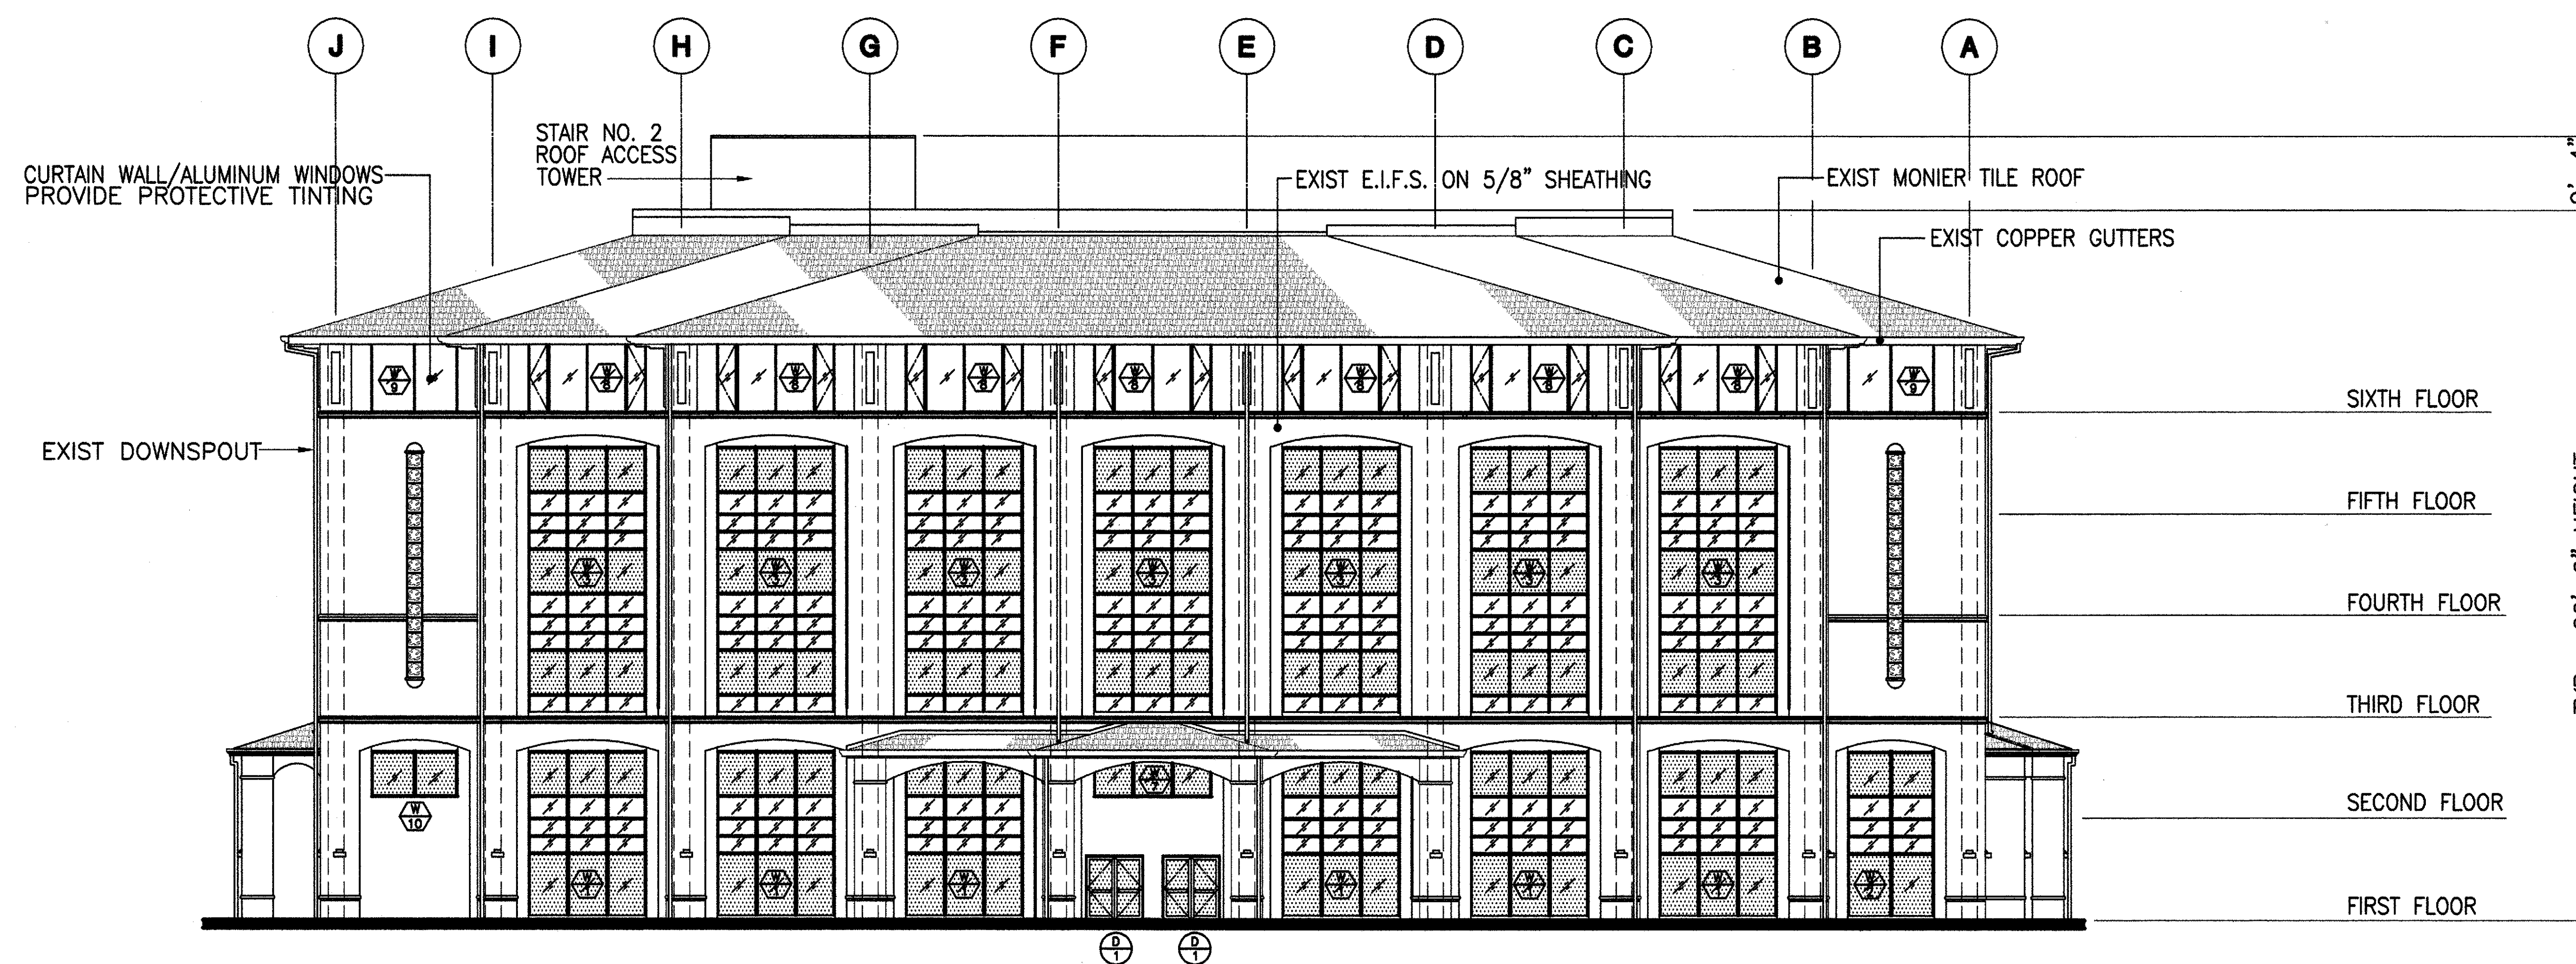

B NORTH EAST ELEVATION
A-6 SCALE: 1/16" = 1'-0"

AS BUILT DRAWING

SEP 8 2008

10' 0 10' 20' 30'
1/16" = 1'-0"


POST APP-1	REVISED DSGS JOB NO.	7/10	10/05/07
REVISION NO.	SYM.	DESCRIPTION	SHT OF DATE APPROVED: PUBLIC WORKS ADMINISTRATOR
DEPARTMENT OF ACCOUNTING & GENERAL SERVICES STATE OF HAWAII KAKUHIHEWA BUILDING INSTALL PROTECTIVE TINTING KAPOLEI OAHU HAWAII EXTERIOR ELEVATIONS			
MITSUNAGA & ASSOC., INC. DESIGNED BY: SW DRAWN BY: CAD SCALE: AS NOTED		DSGS JOB NO. 62-10-0515 42-10-0443 DATE: JULY 2007 SHEET 7 OF 11 SHTS	

THIS WORK WAS PREPARED BY ME OR UNDER MY SUPERVISION AND CONSTRUCTION OF THIS PROJECT WILL BE UNDER MY OBSERVATION. (OBSERVATION OF CONSTRUCTION AS DEFINED IN CHAPTER 16-115, SUBCHAPTER 1 DEFINITIONS, OF THE HAWAII ADMINISTRATIVE RULES, "PROFESSIONAL ENGINEERS, ARCHITECTS, SURVEYORS, AND LANDSCAPE ARCHITECTS") EXPIRATION DATE: 4-30-08


STEVEN D. WONG
LICENSED PROFESSIONAL ARCHITECT
No. 4646
HAWAII U.S.A.

MITUNAGA & ASSOCIATES, INC.

FILE 4 DRAWER 2 FOLDER 5

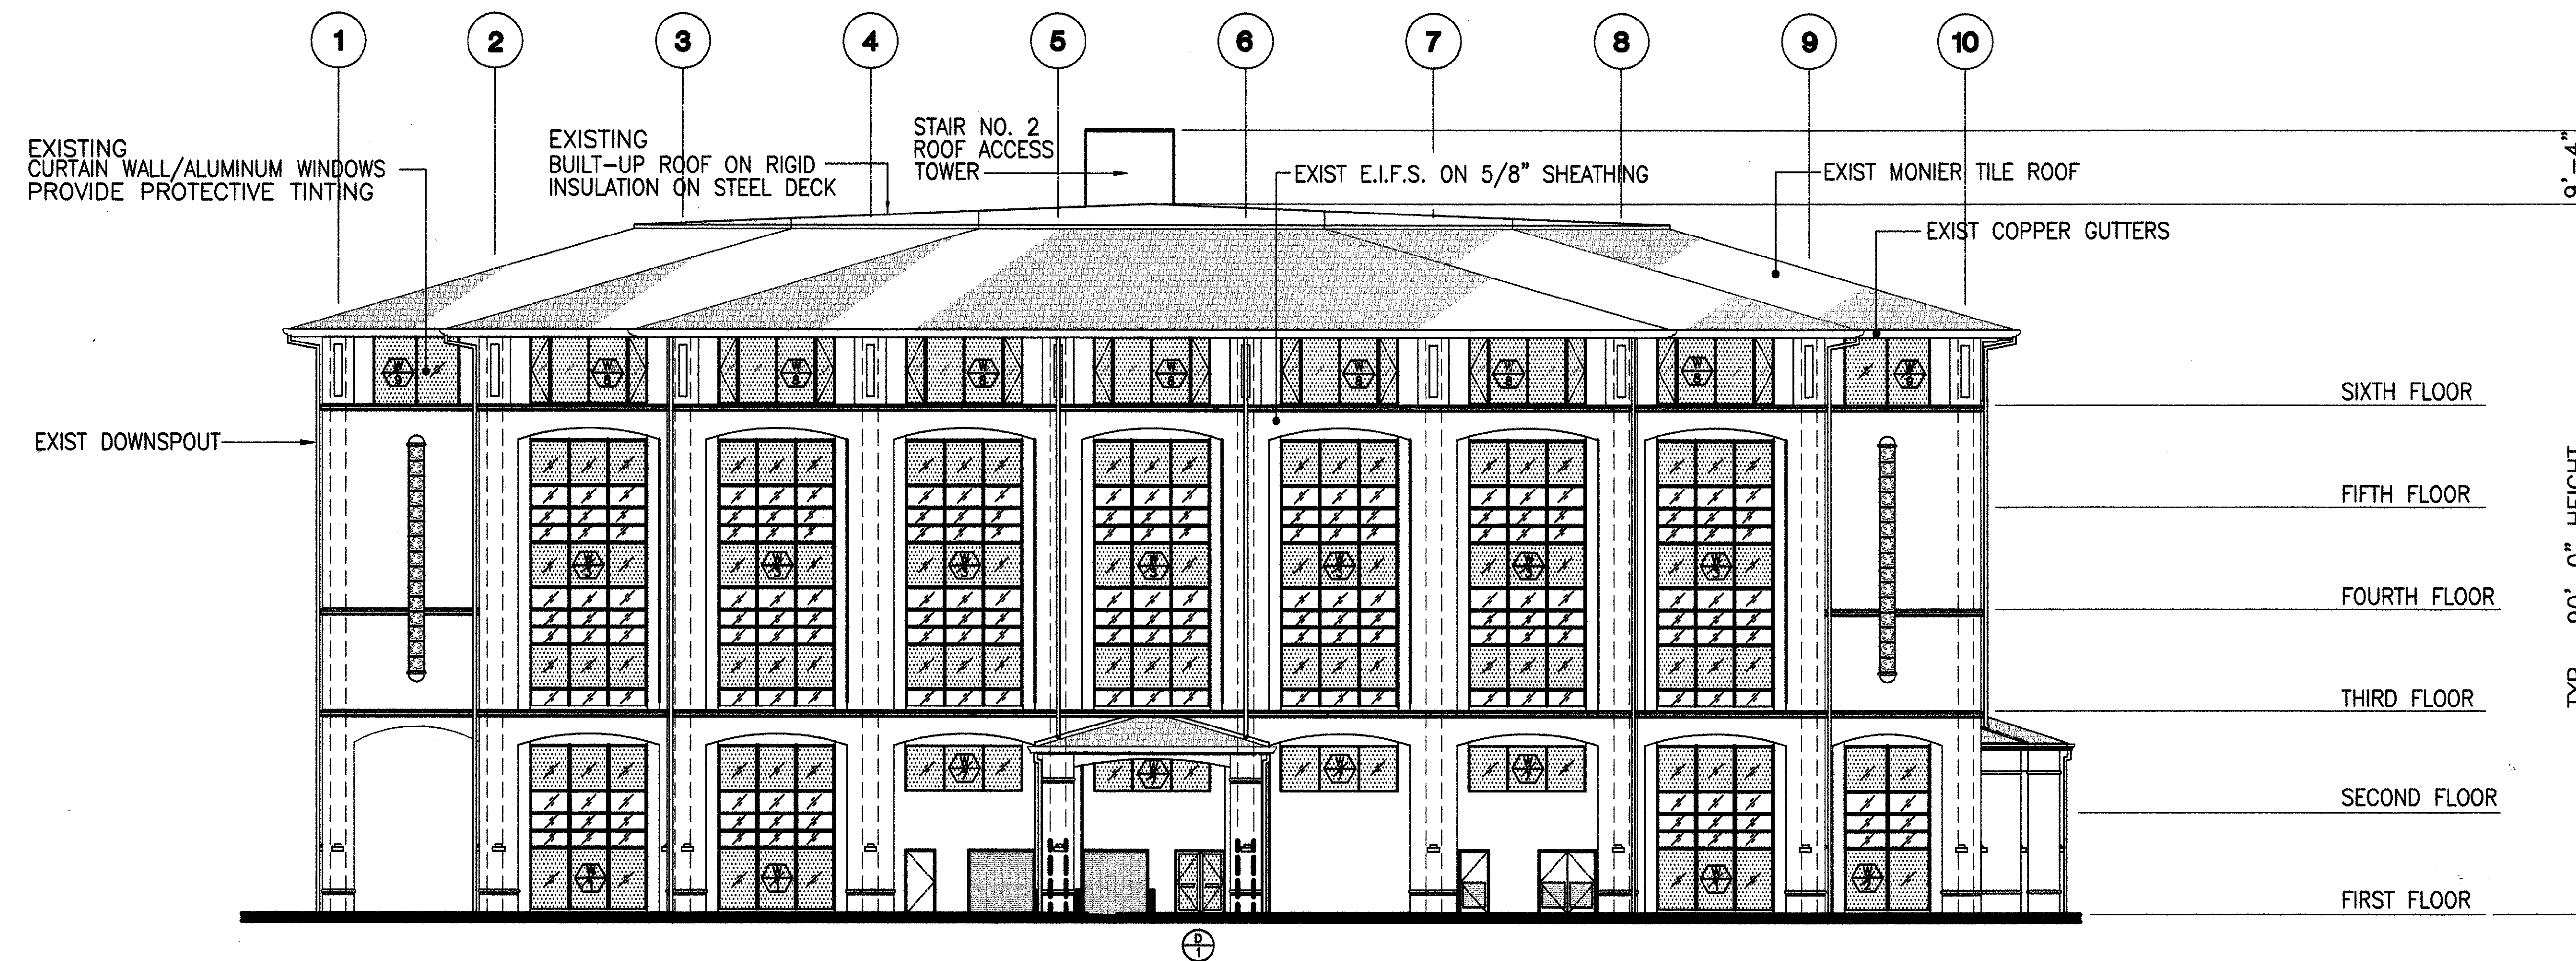

A SOUTH EAST ELEVATION
A-7 SCALE: 1/16" = 1'-0"

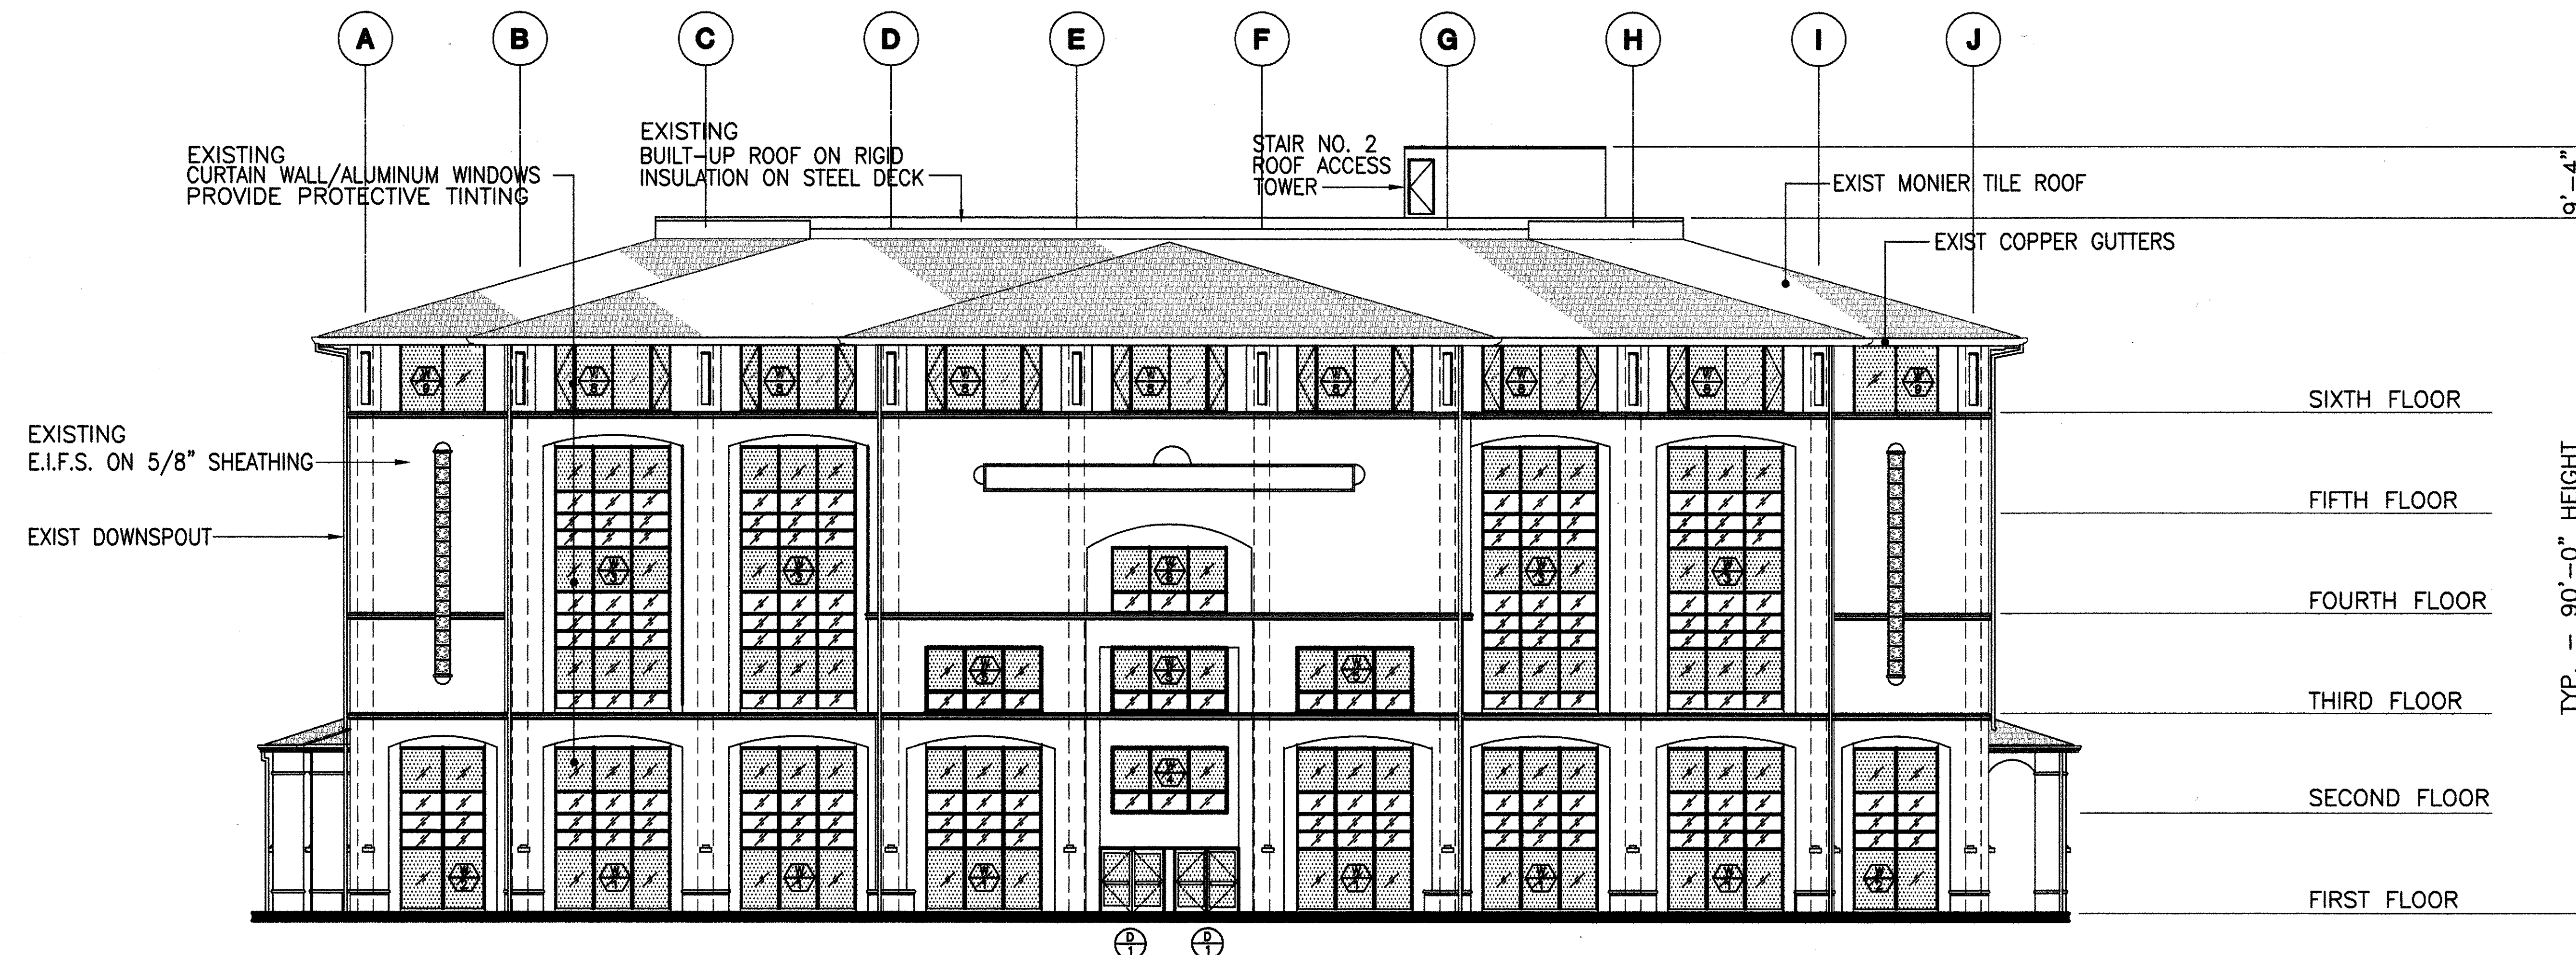


B SOUTH WEST ELEVATION
A-7 SCALE: 1/16" = 1'-0"

AS BUILT DRAWING


SEP 8 2008

10' 0 10' 20' 30'
1/16" = 1'-0"


POST ADD-1	REVISED DAPS JOB NO	5/11	10/05/07	
REVISION NO.	SYM.	DESCRIPTION	SHT OF	DATE
				APPROVED: PUBLIC WORKS ADMINISTRATOR
STEVEN D. WONG LICENSED PROFESSIONAL ARCHITECT No. 4646 HAWAII U.S.A. THIS WORK WAS PREPARED BY ME OR UNDER MY SUPERVISION AND CONSTRUCTION OF THIS PROJECT WILL BE UNDER MY OBSERVATION. (OBSERVATION OF CONSTRUCTION AS DEFINED IN CHAPTER 15-112, SUBCHAPTER 1, DEFINITIONS, OF THE HAWAII ADMINISTRATIVE RULES, "PROFESSIONAL ENGINEERS, ARCHITECTS, SURVEYORS, AND LANDSCAPE ARCHITECTS") EXPIRATION DATE: 4-30-09 <i>Steven D. Wong</i> MITSUNAGA & ASSOCIATES, INC. DEPARTMENT OF ACCOUNTING & GENERAL SERVICES STATE OF HAWAII KAKUHIHEWA BUILDING INSTALL PROTECTIVE TINTING KAPOLEI OAHU HAWAII EXTERIOR ELEVATIONS MITSUNAGA & ASSOC., INC. DESIGNED BY: SW CHECKED BY: SW DRAWN BY: CAD APPROVED BY: SW SCALE: AS NOTED DATE: JULY 2007 DAPS JOB NO. G2-10-0443 DRAWING NO. A-7 SHEET 8 OF 11 SHTS				
FILE <u>11</u> DRAWER <u>2</u> FOLDER <u>5</u>				

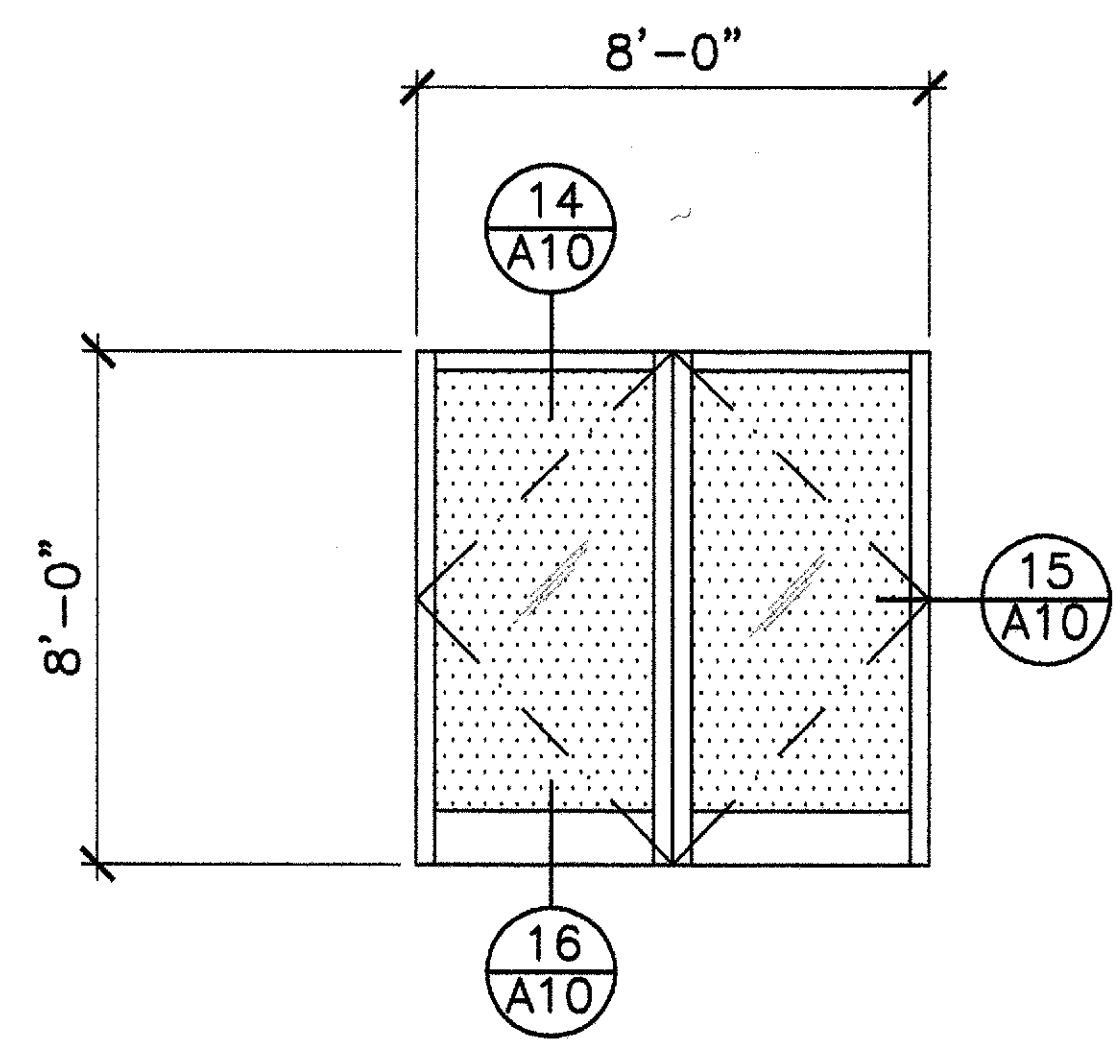


DOOR TYPE AA

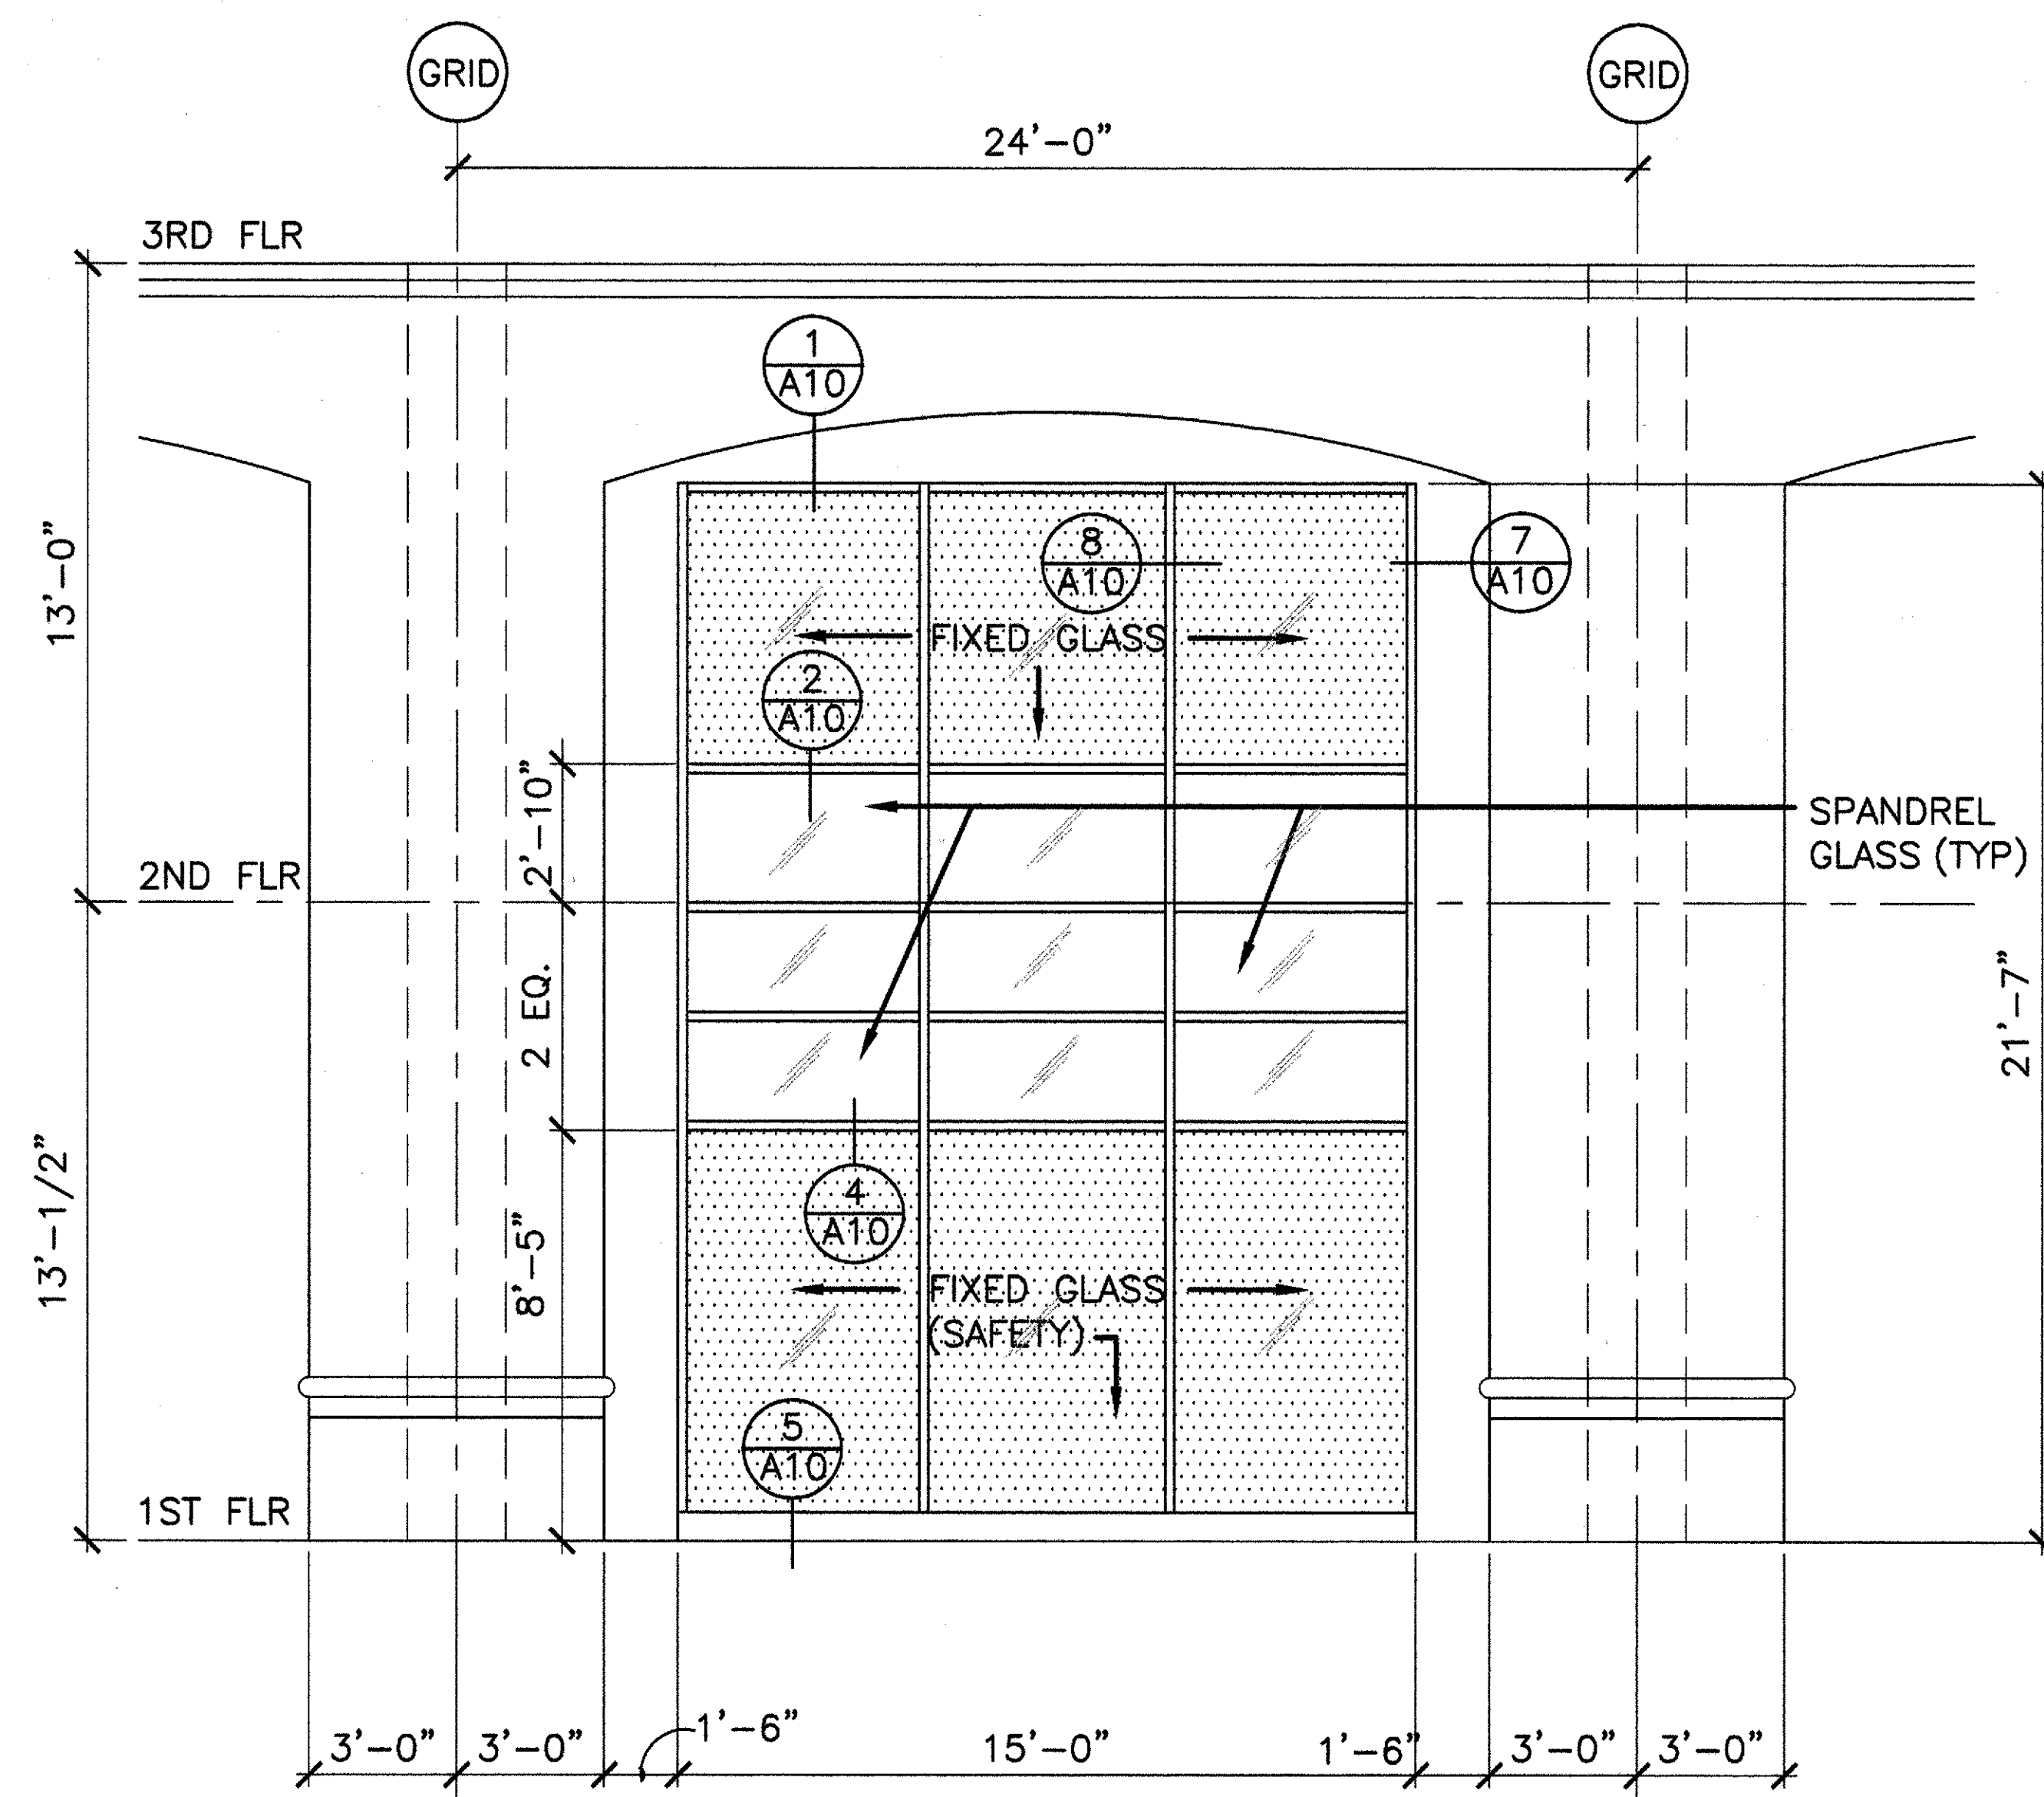

WINDOW TYPE A

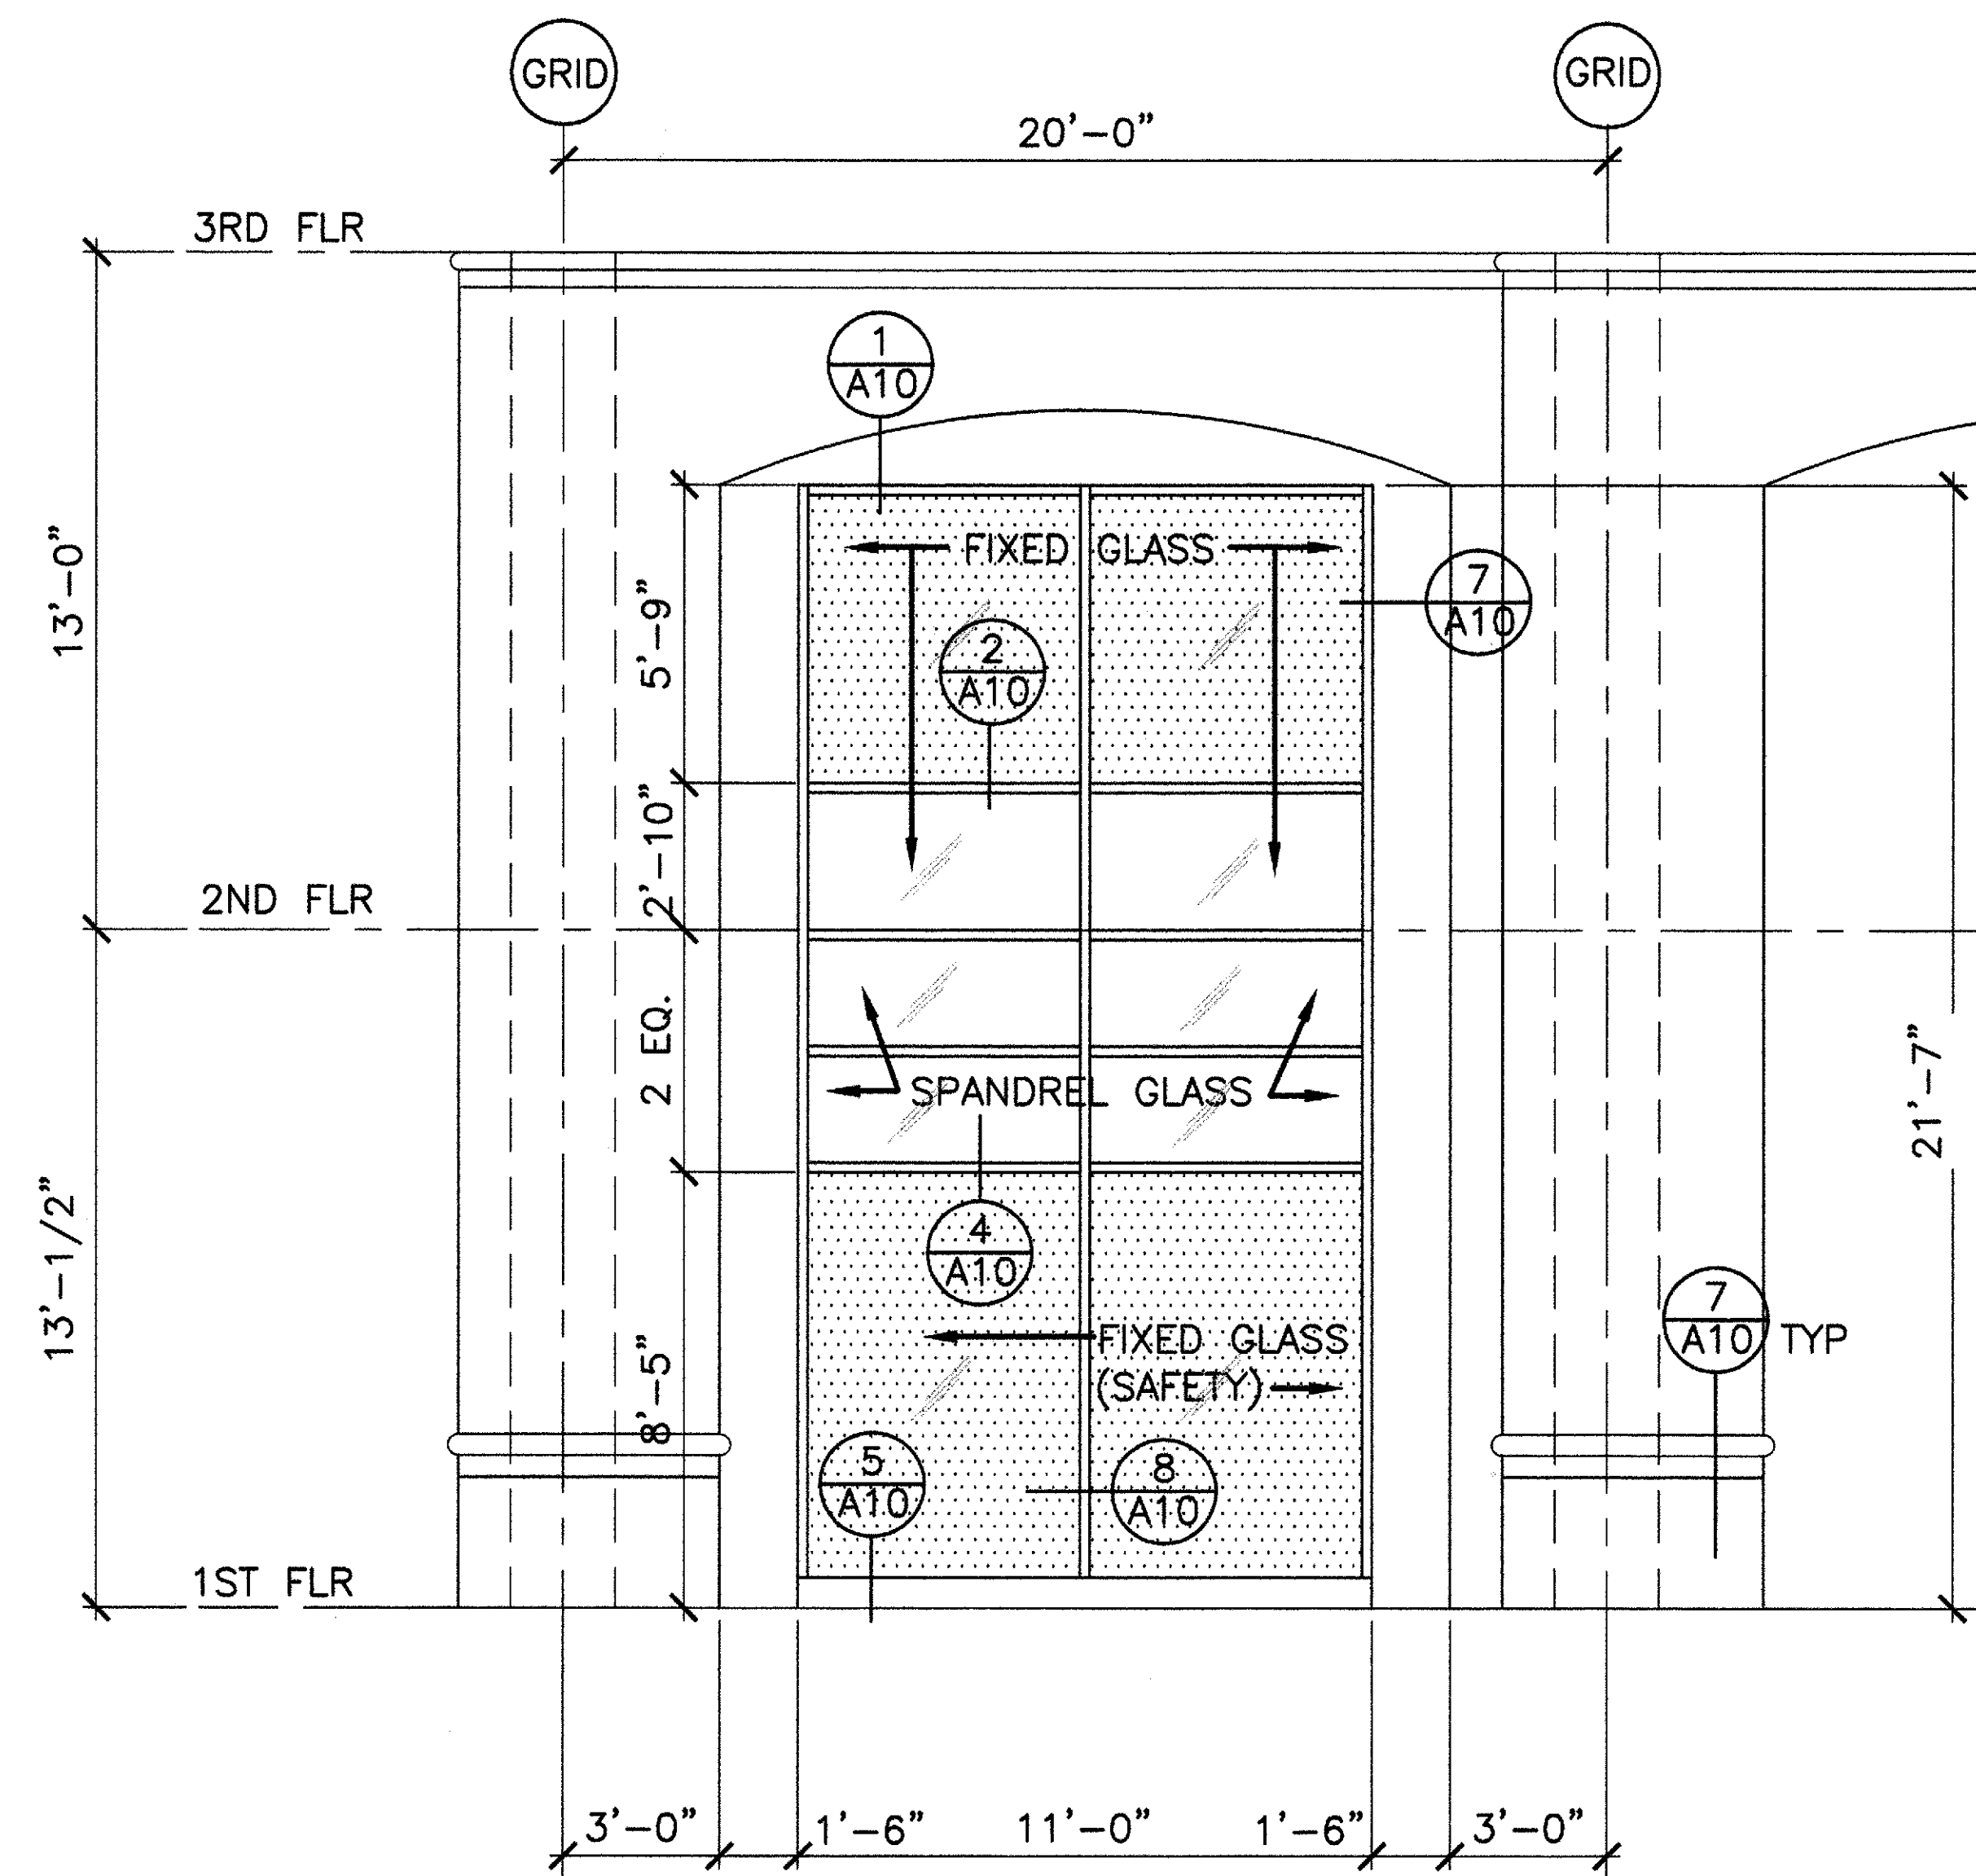

WINDOW TYPE B

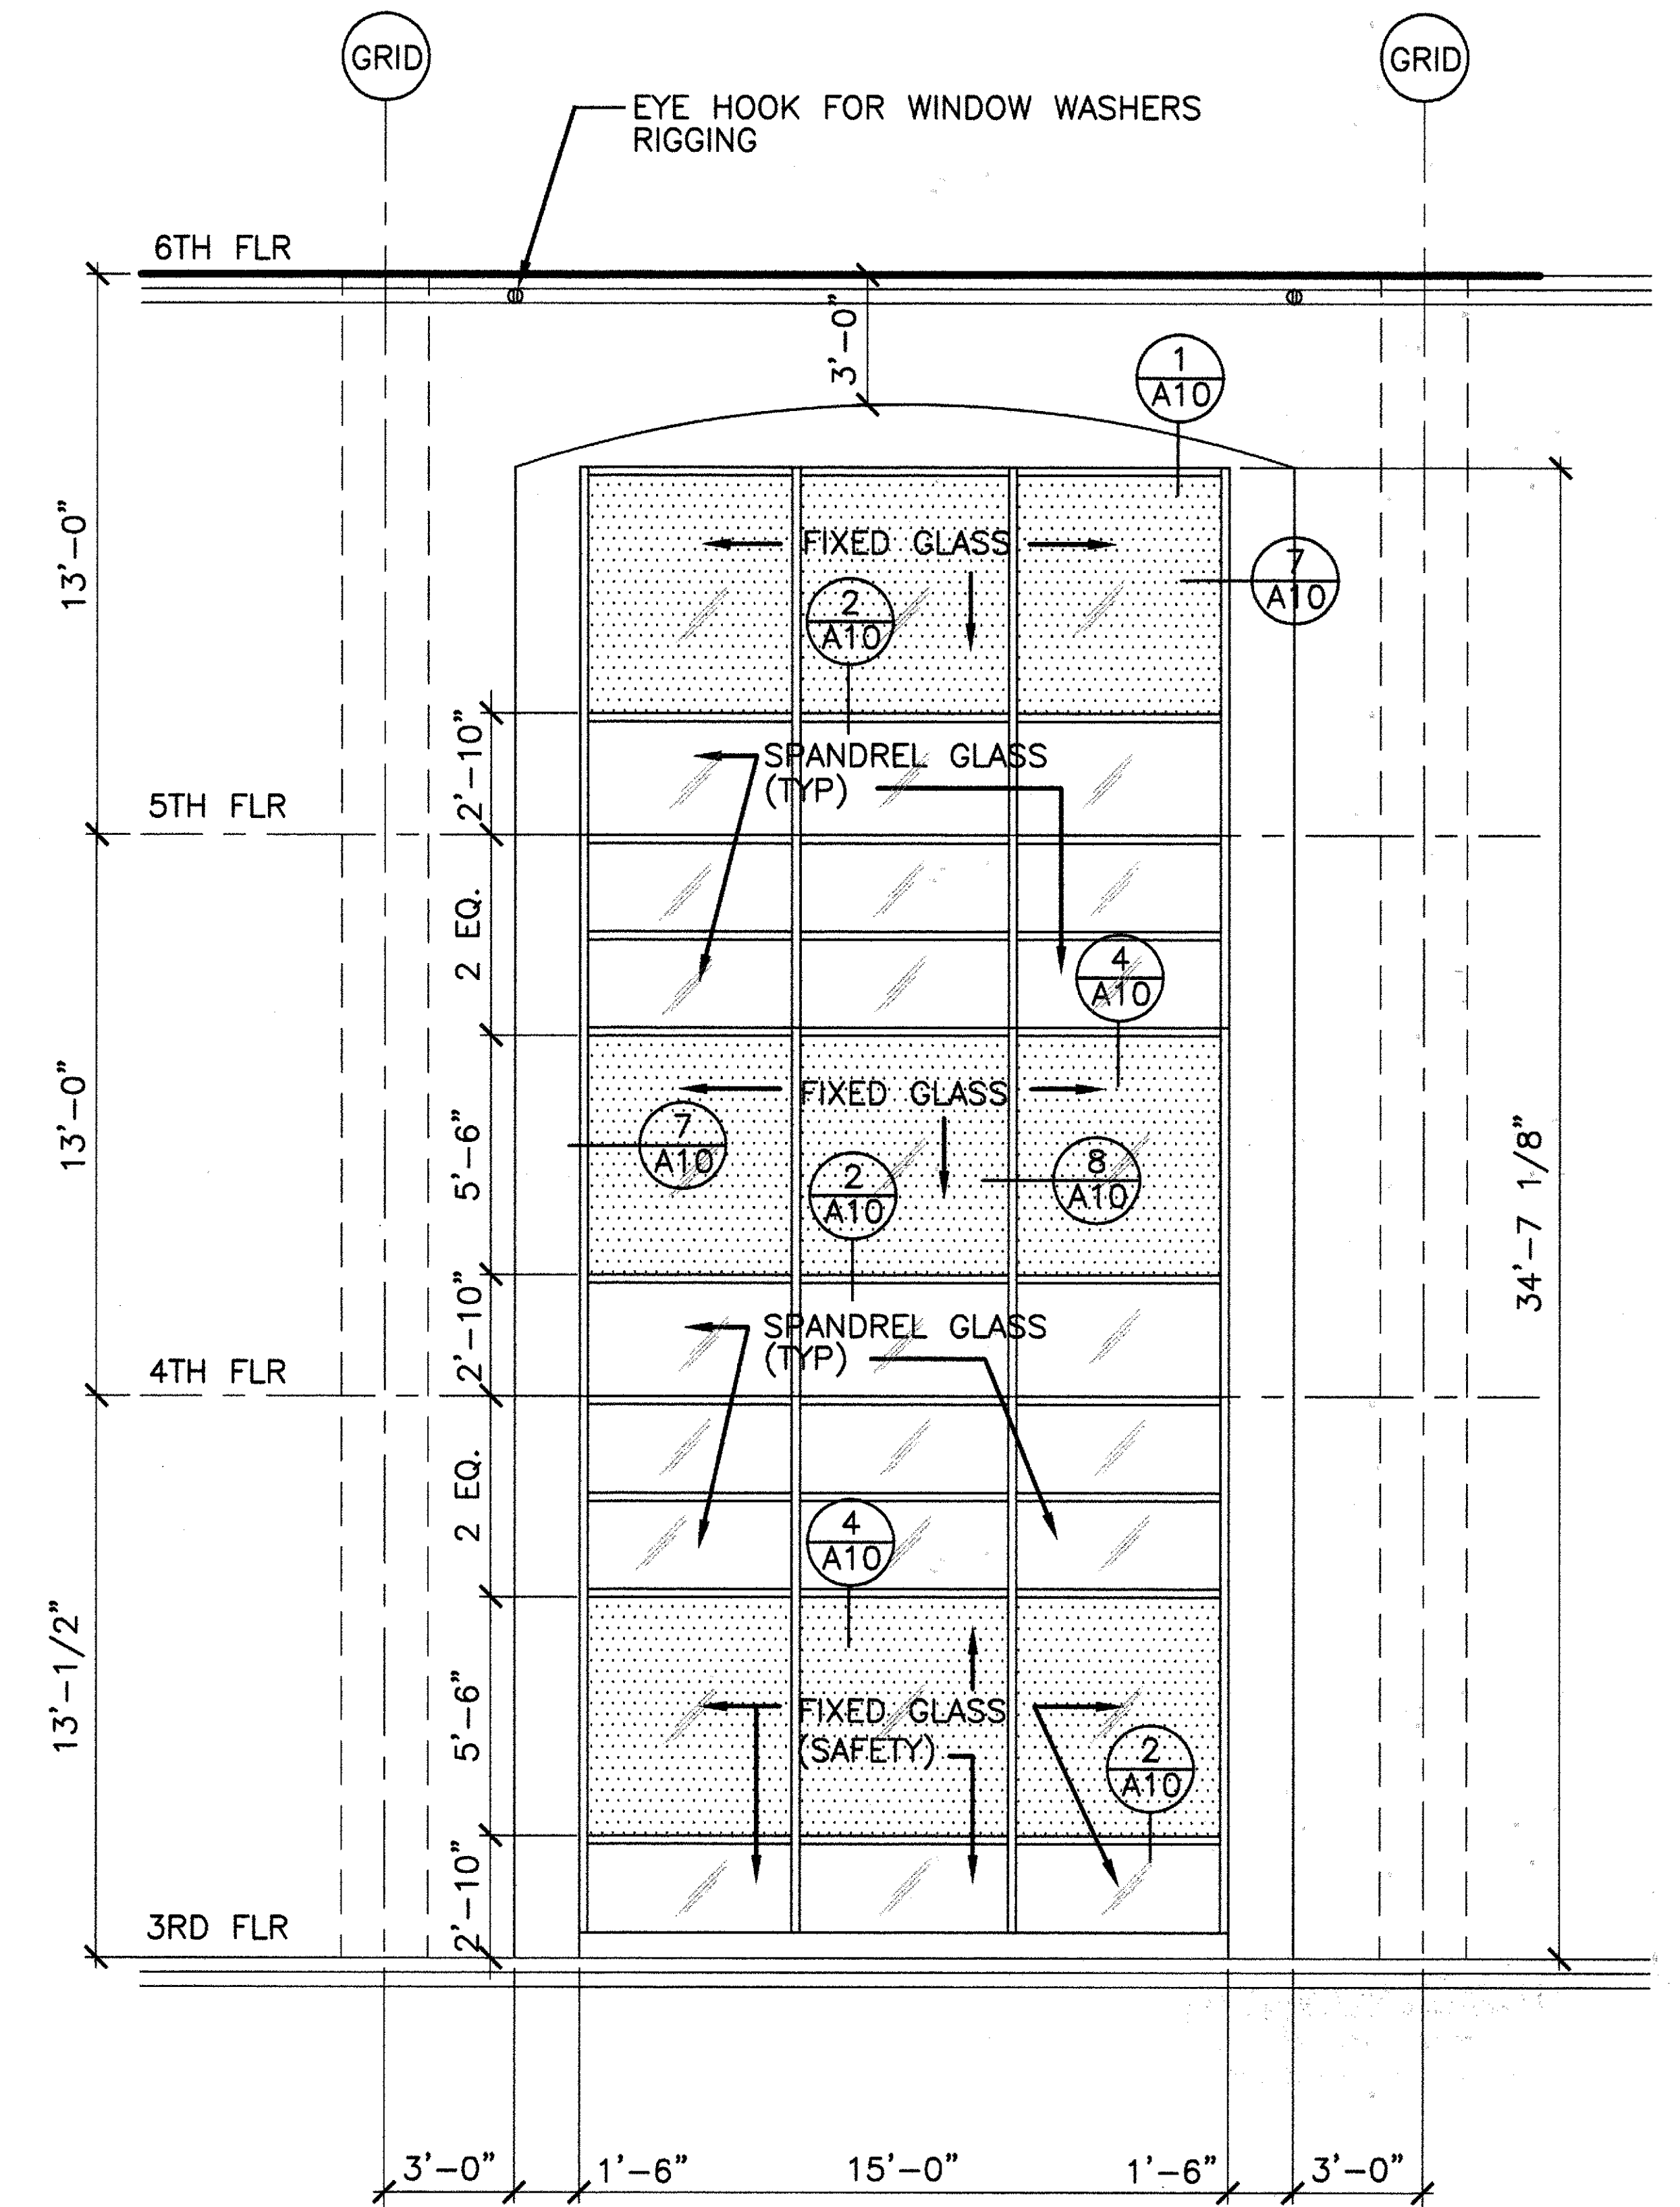

WINDOW TYPE C

DOOR/ WINDOW SCHEDULE

NO.	TYPE	SIZE (WxH)	FRAME MAT'L	GLASS	FRAME DETAILS			REMARKS
					HEAD	JAMB	SILL	
W1	A	15'-0" x 21'-6 5/8"	ALUMINUM	GRAY TINT .71 S.C.	1/A-10	7/A-10	5/A-10	
W2	B	11'-0" x 21'-6 5/8"	ALUMINUM	GRAY TINT .71 S.C.	1/A-10	7/A-10	5/A-10	
W3	C	15'-0" x 34'-7 1/8"	ALUMINUM	GRAY TINT .71 S.C.	1/A-10	7/A-10	9/A-10	
W4	D	15'-0" x 8'-7 1/8"	ALUMINUM	GRAY TINT .71 S.C.	11/A-10	1/A-10	9/A-10	
W5	E	15'-0" x 8'-7 1/8"	ALUMINUM	GRAY TINT .71 S.C.	11/A-10	7/A-10	9/A-10	
W6	F	15'-0" x 8'-7 1/8"	ALUMINUM	GRAY TINT .71 S.C.	13/A-10	7/A-10	9/A-10	
W7	G	15'-0" x 5'-8 5/8"	ALUMINUM	GRAY TINT .71 S.C.	10/A-10	8/A-10	10/A-10	
W8	H	15'-0" x 8'-7 1/8"	ALUMINUM	GRAY TINT .71 S.C.	11/A-10	8/A-10	5/A-10 (SIM)	
W9	J	11'-0" x 8'-7 1/8"	ALUMINUM	GRAY TINT .71 S.C.	11/A-10	7/A-10	5/A-10 (SIM)	
W10	K	11'-0" x 5'-8 5/8"	ALUMINUM	GRAY TINT .71 S.C.	10/A-10	8/A-10	10/A-10	
D1	AA	8'-0" x 8'-0"	ALUMINUM	GRAY TINT .71 S.C.	14/A-10	15/A-10	16/A-10	

AS BUILT DRAWING


SEP 8 2008
KKK ALUMINUM & GLASS INC.
 746 Kopke Street
 Honolulu, Hawaii 96819

NOTE: STIPPLED AREA INDICATES APPLICATION OF PROTECTIVE TINTING TO INTERIOR SURFACE OF WINDOW AND DOOR GLAZING.


GRAPHIC SCALE

1/4" = 1'-0"


POST APP-1	REVISED	DAGS JOB NO	9/11	10/05/07
REVISION NO.	SYMBOL	DESCRIPTION	SHEET OF	DATE
APPROVED: PUBLIC WORKS ADMINISTRATOR				
DEPARTMENT OF ACCOUNTING & GENERAL SERVICES STATE OF HAWAII KAKUHIHEWA BUILDING INSTALL PROTECTIVE TINTING KAPOLEI OAHU HAWAII				
DOOR/ WINDOW SCHEDULE AND TYPES				
MITSUNAGA & ASSOC., INC. DESIGNED BY: SW CHECKED BY: SW DATE: JULY 2007			DAGS JOB NO. 62-10-0515 42-10-0443 A-8 SHEET 9 OF 11 SHES	
SCALE: AS NOTED FILE H DRAWER 2 FOLDER 5				

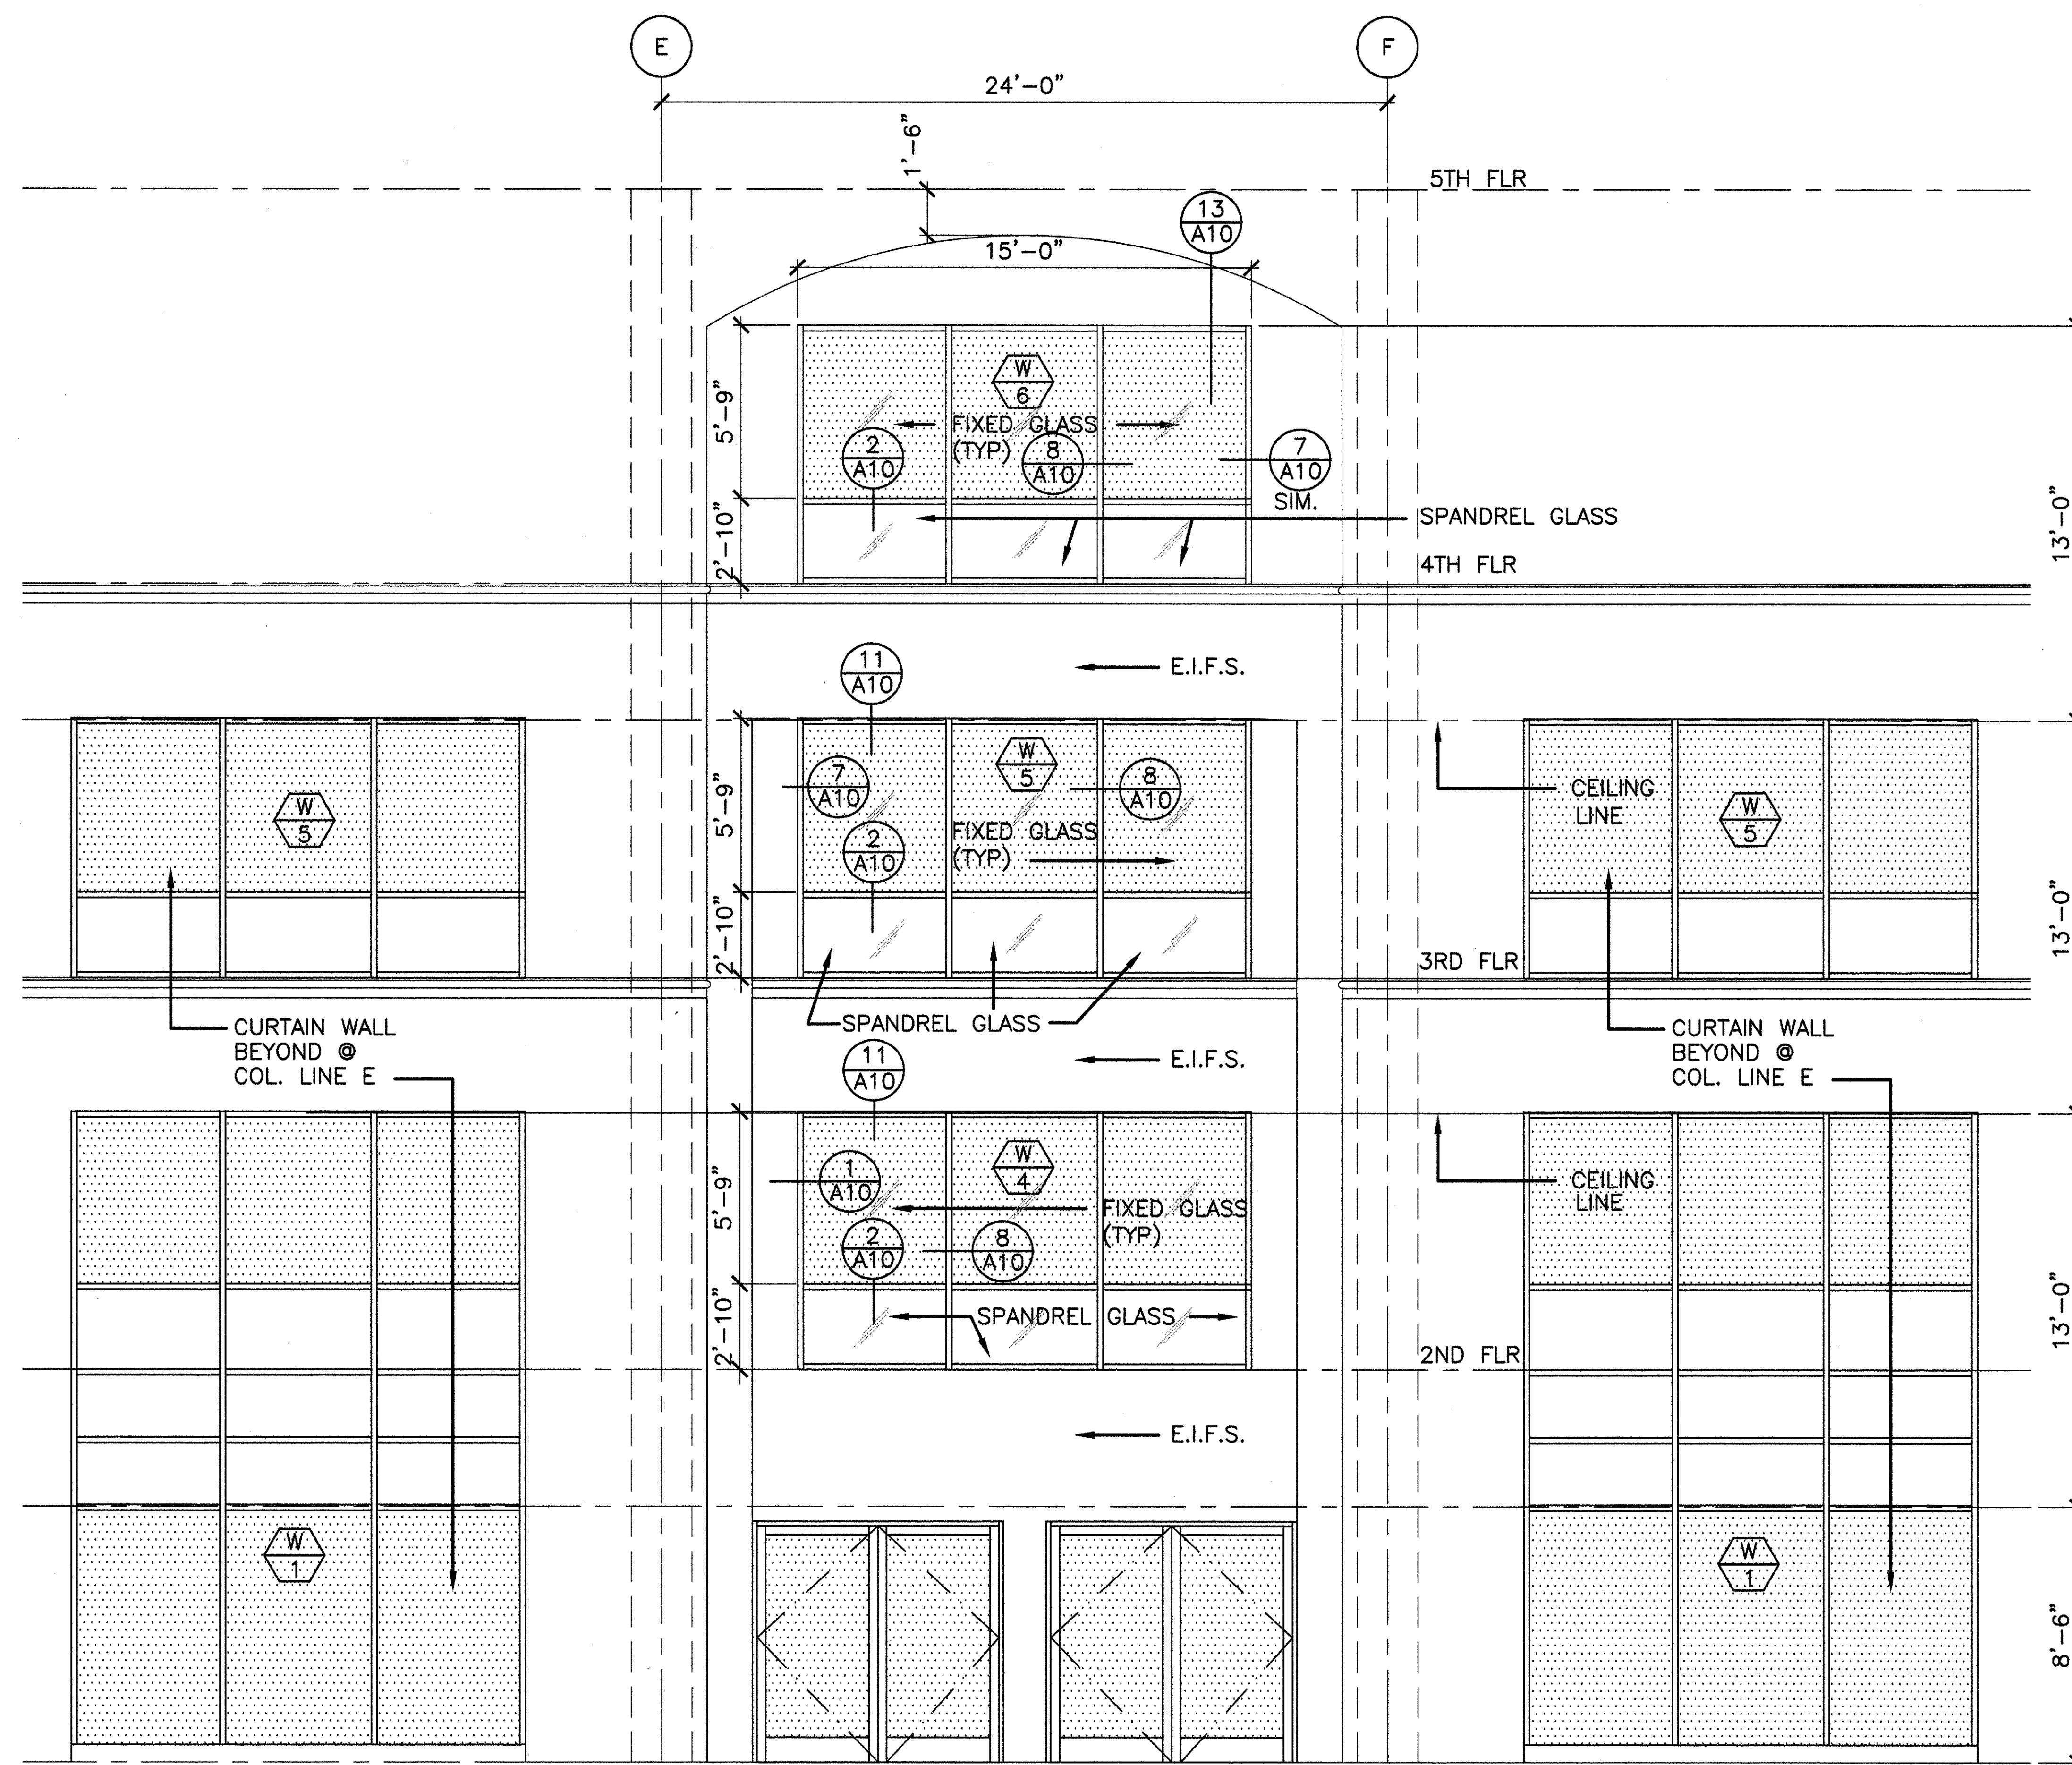


WINDOW TYPE D, E, & F

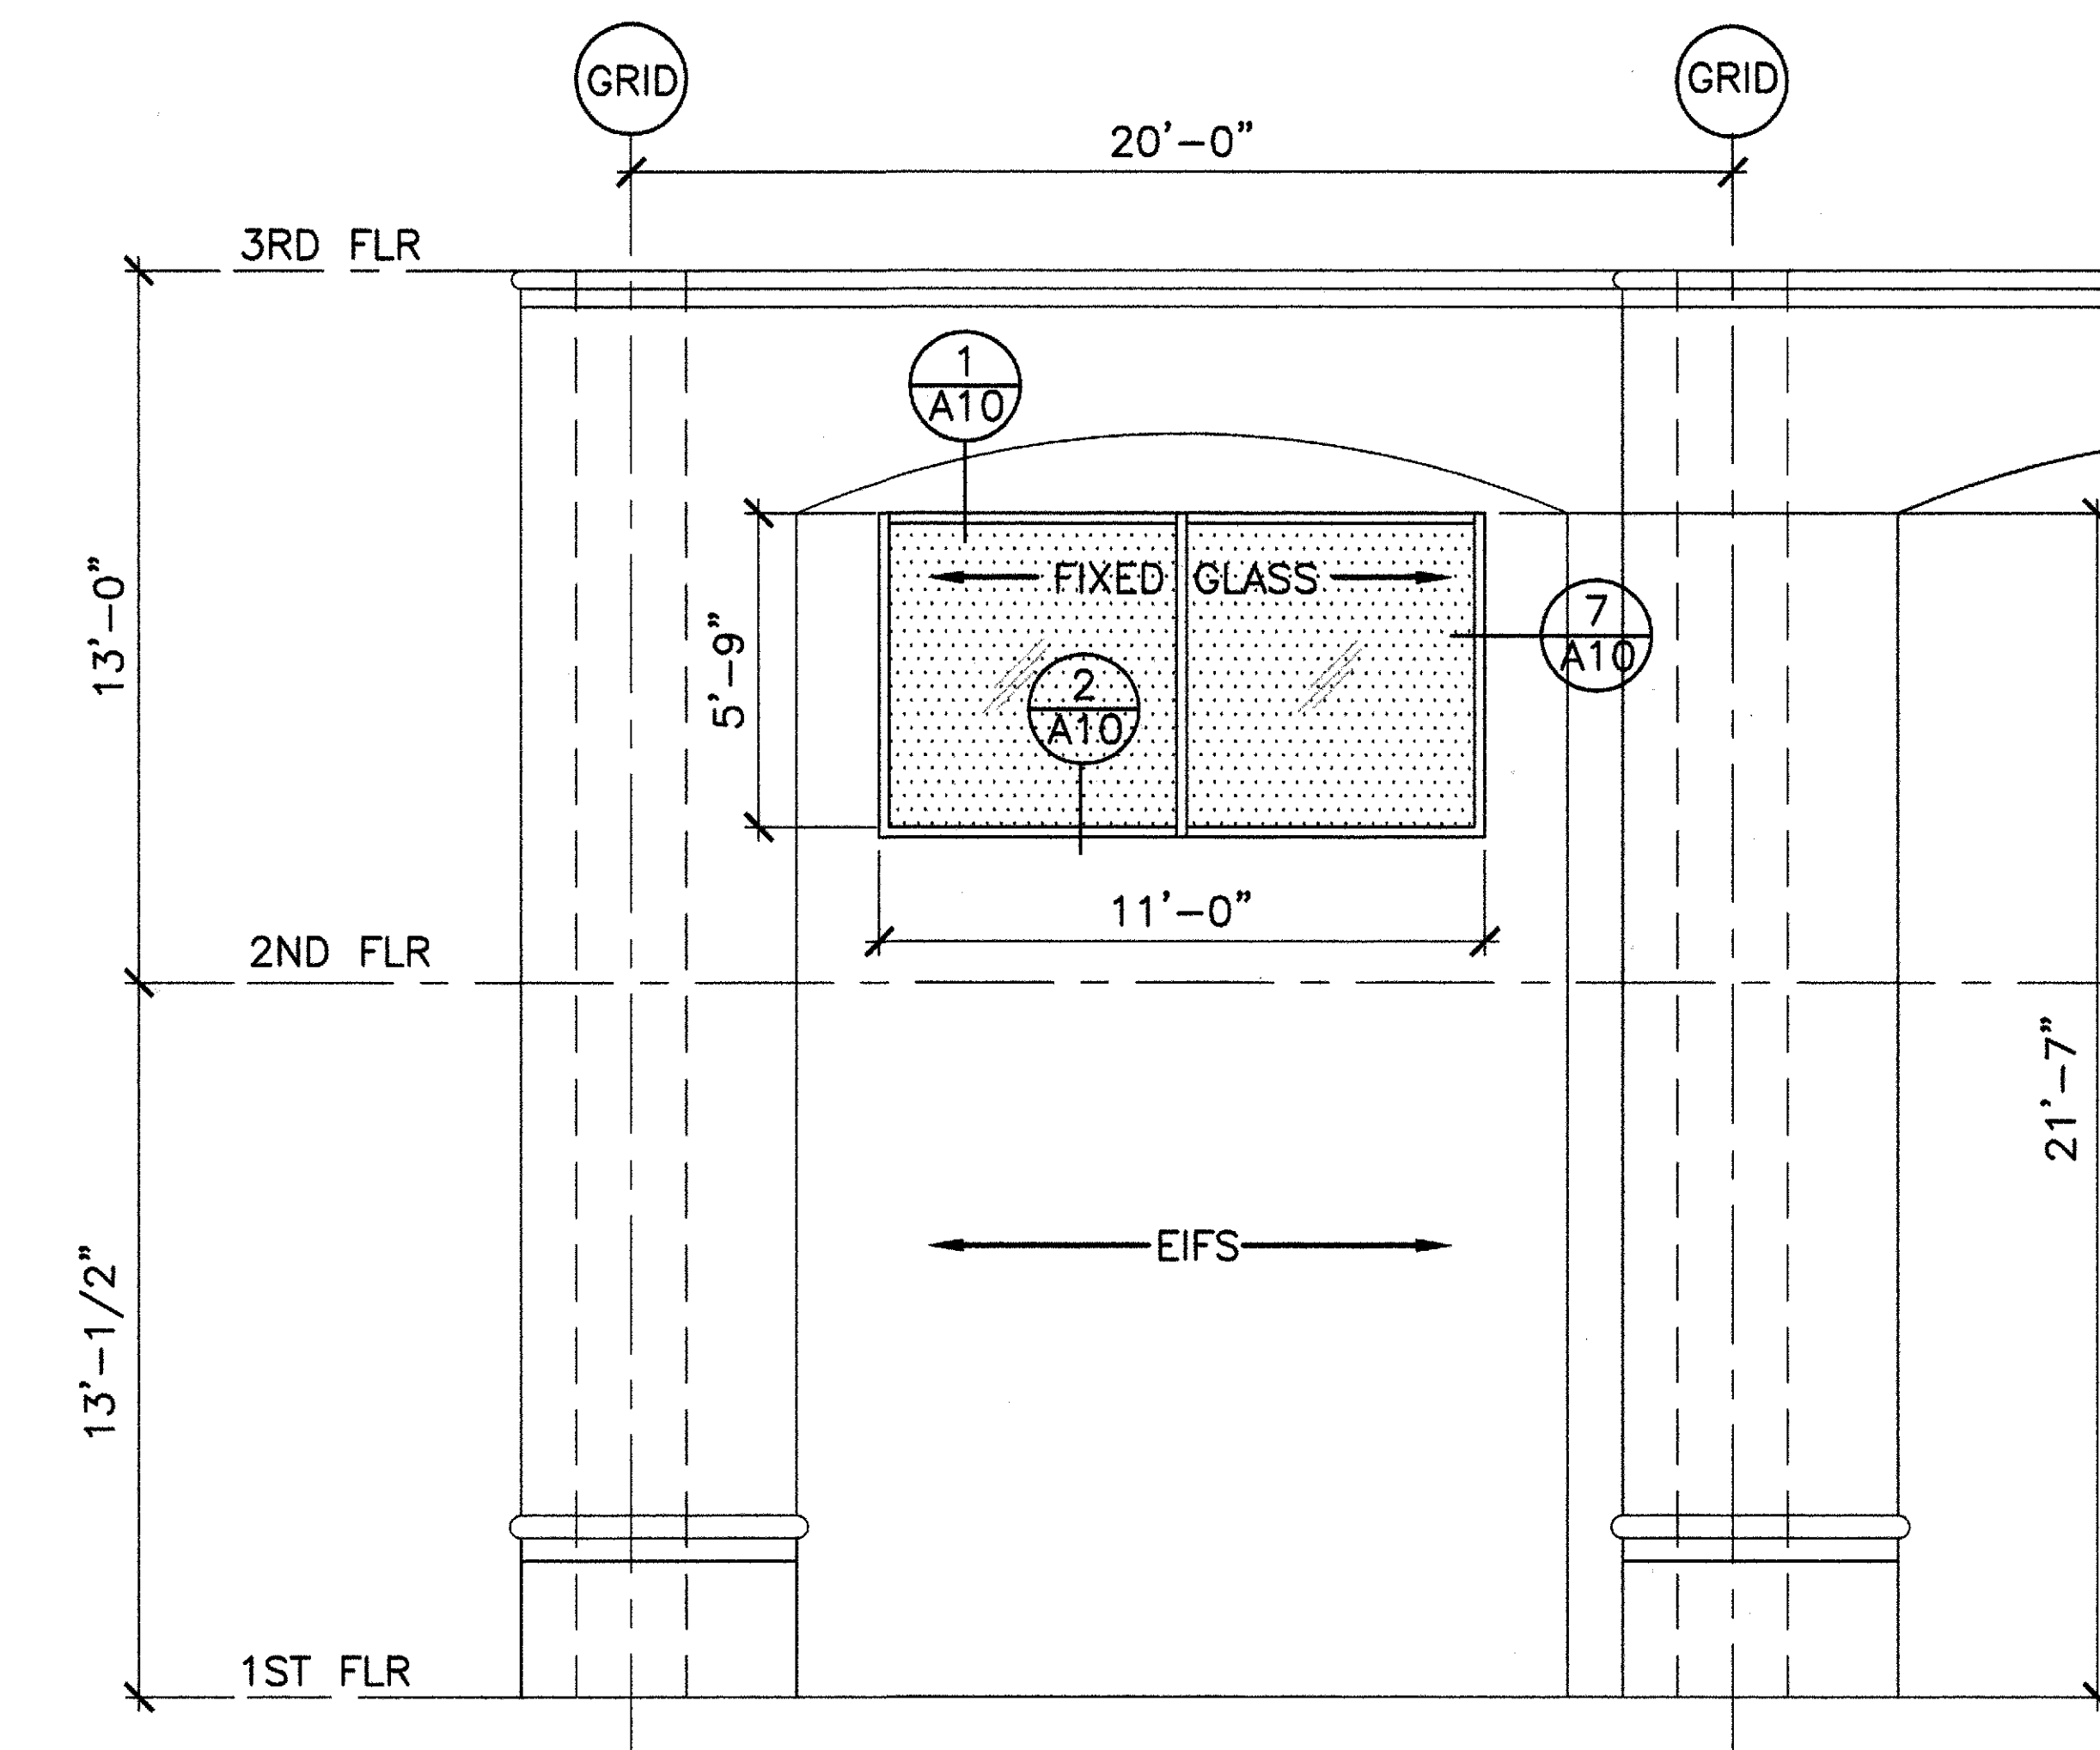


WINDOW TYPE K

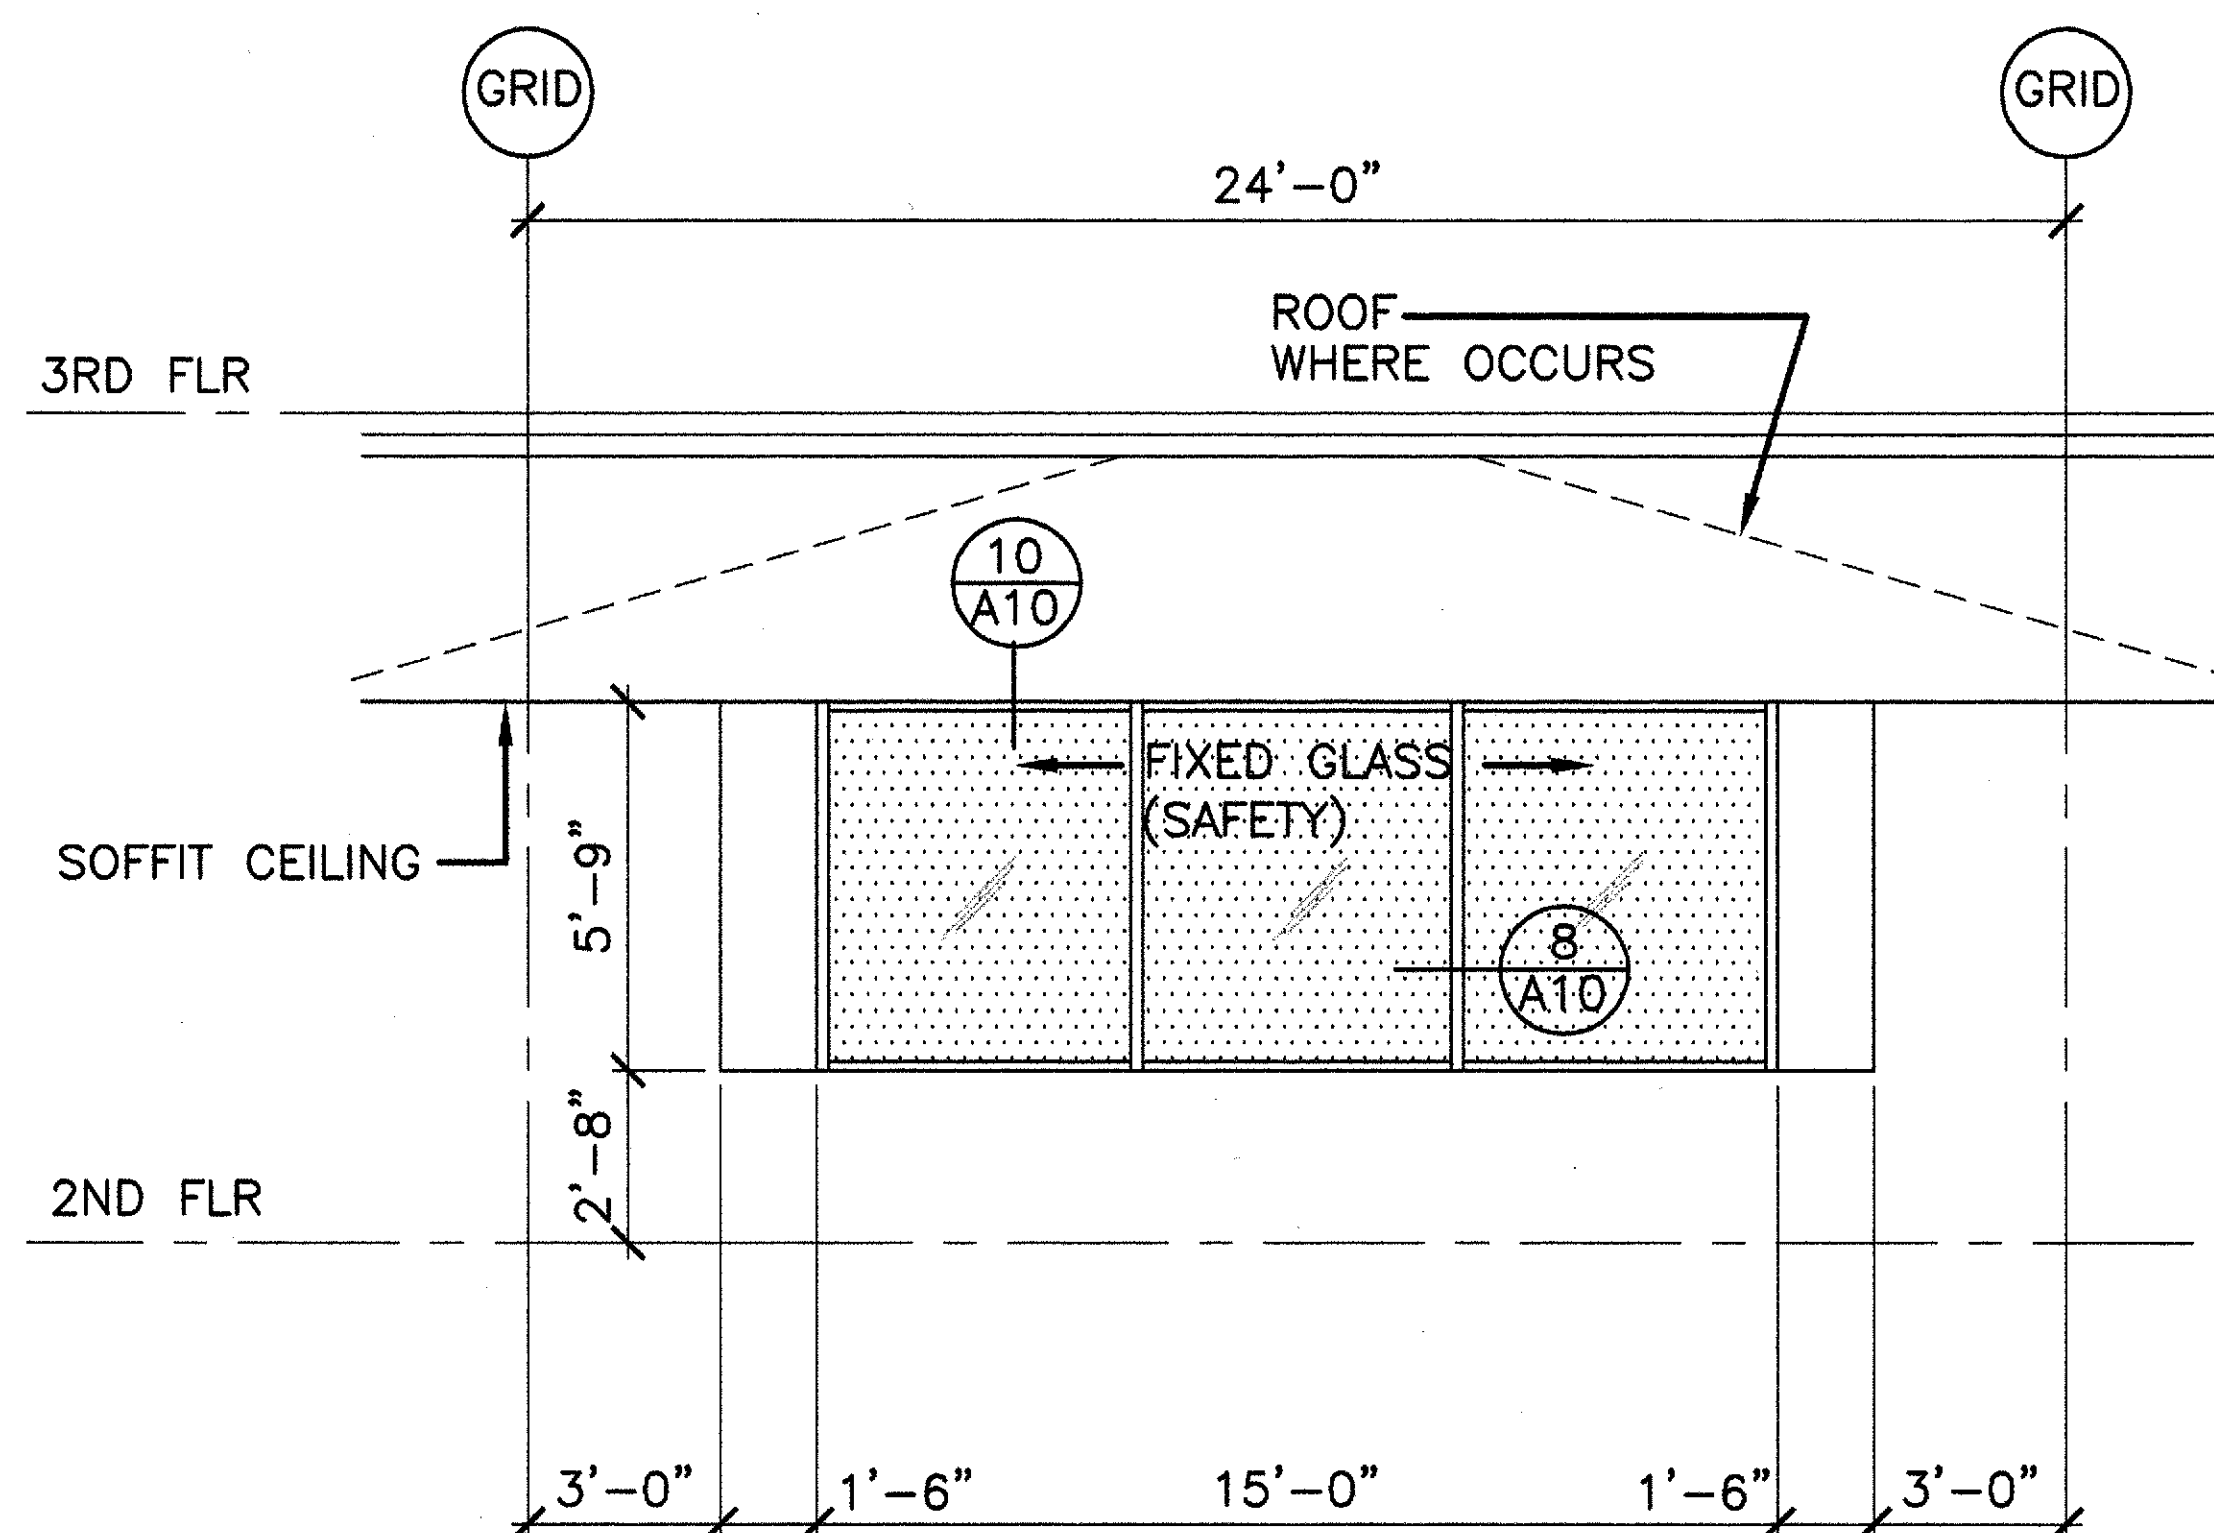

WINDOW TYPE G

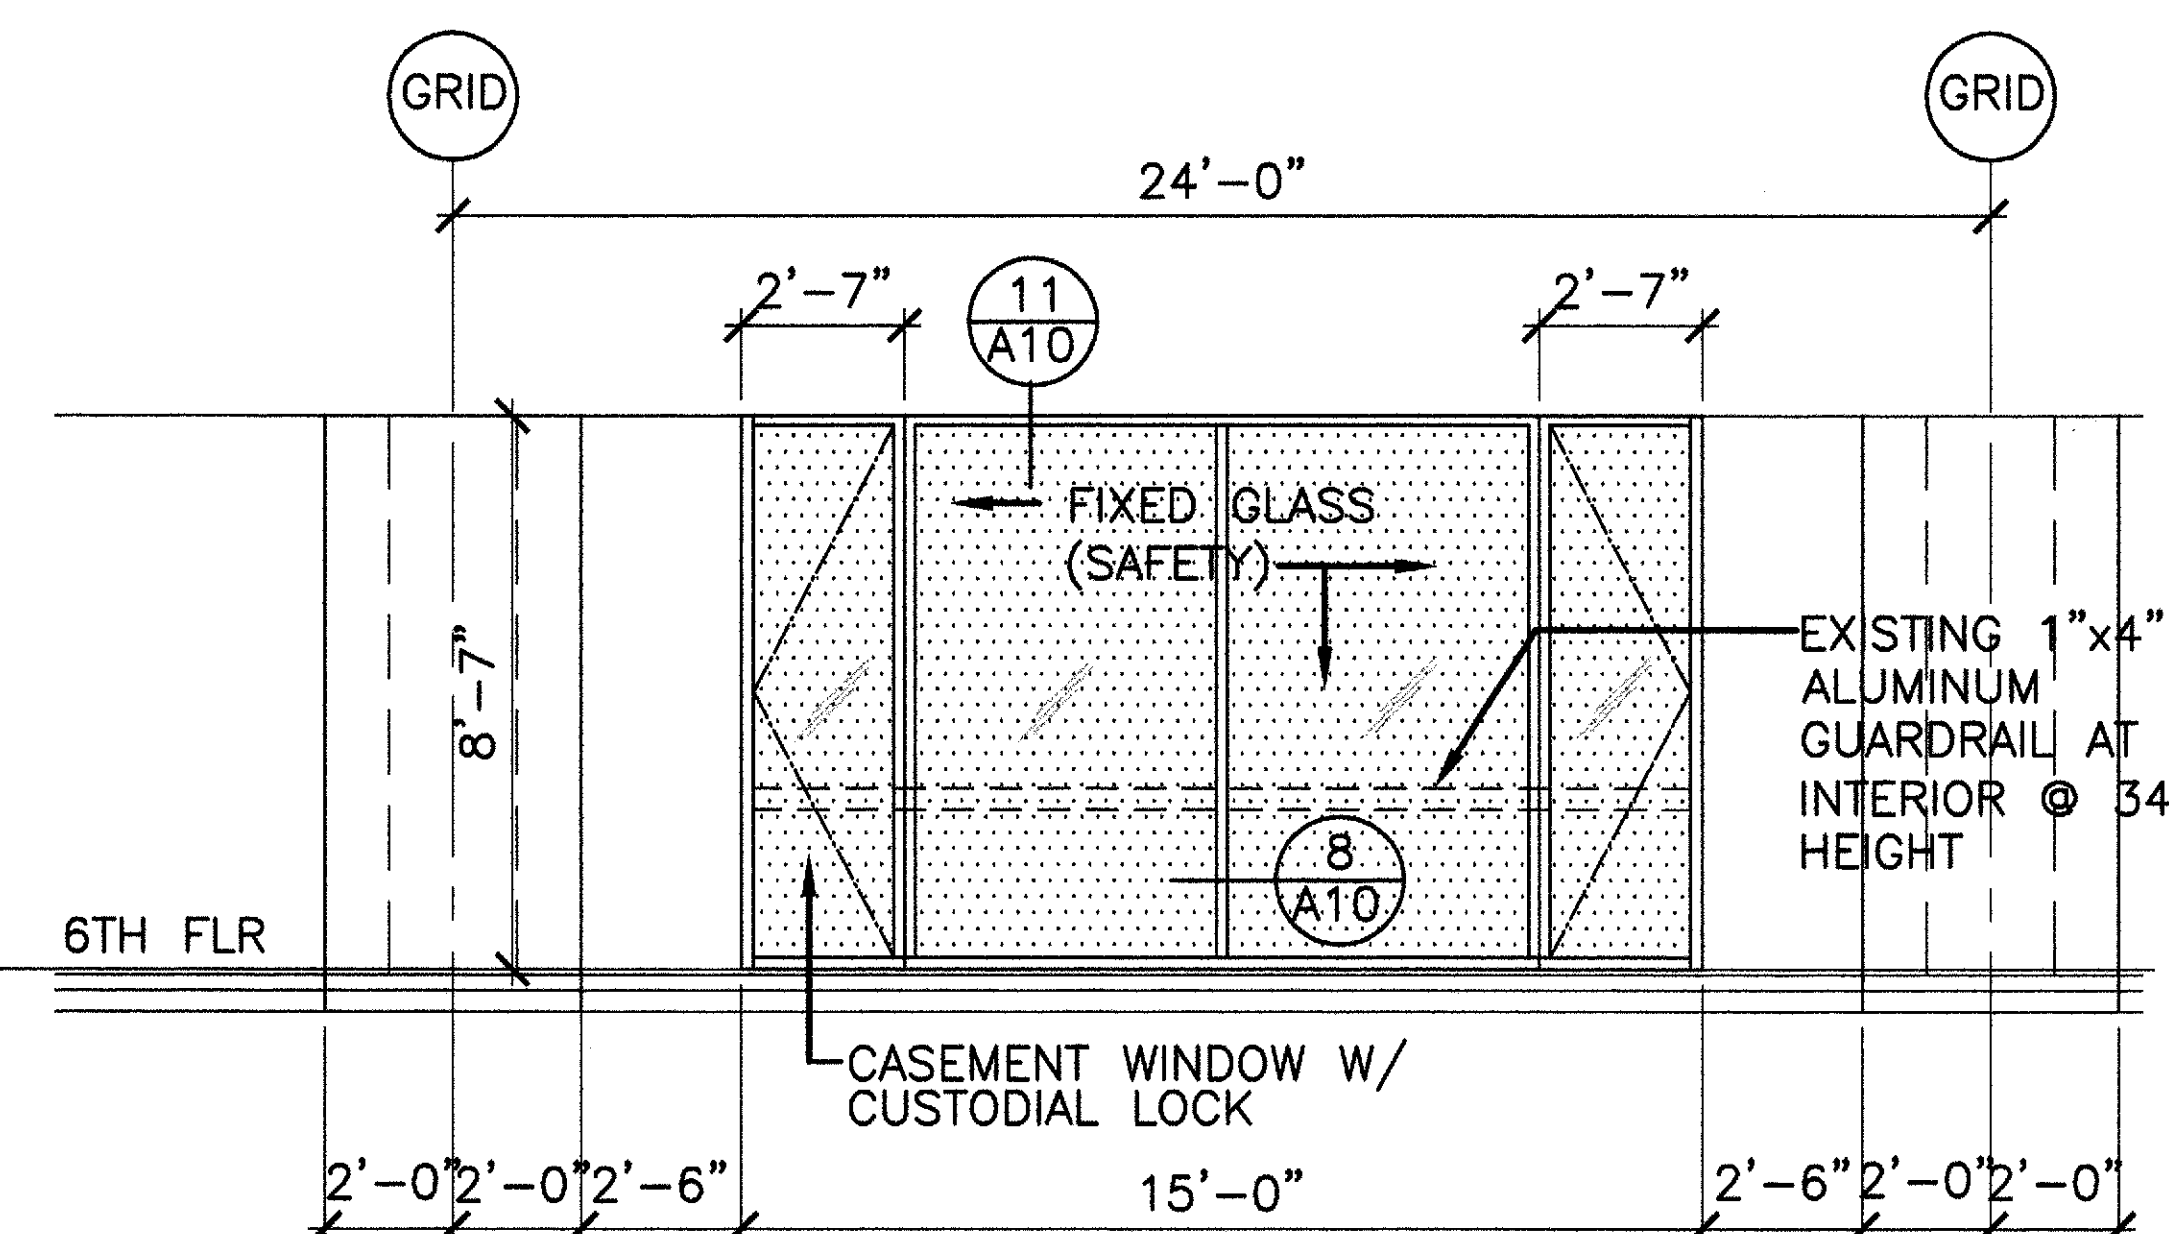

WINDOW TYPE H

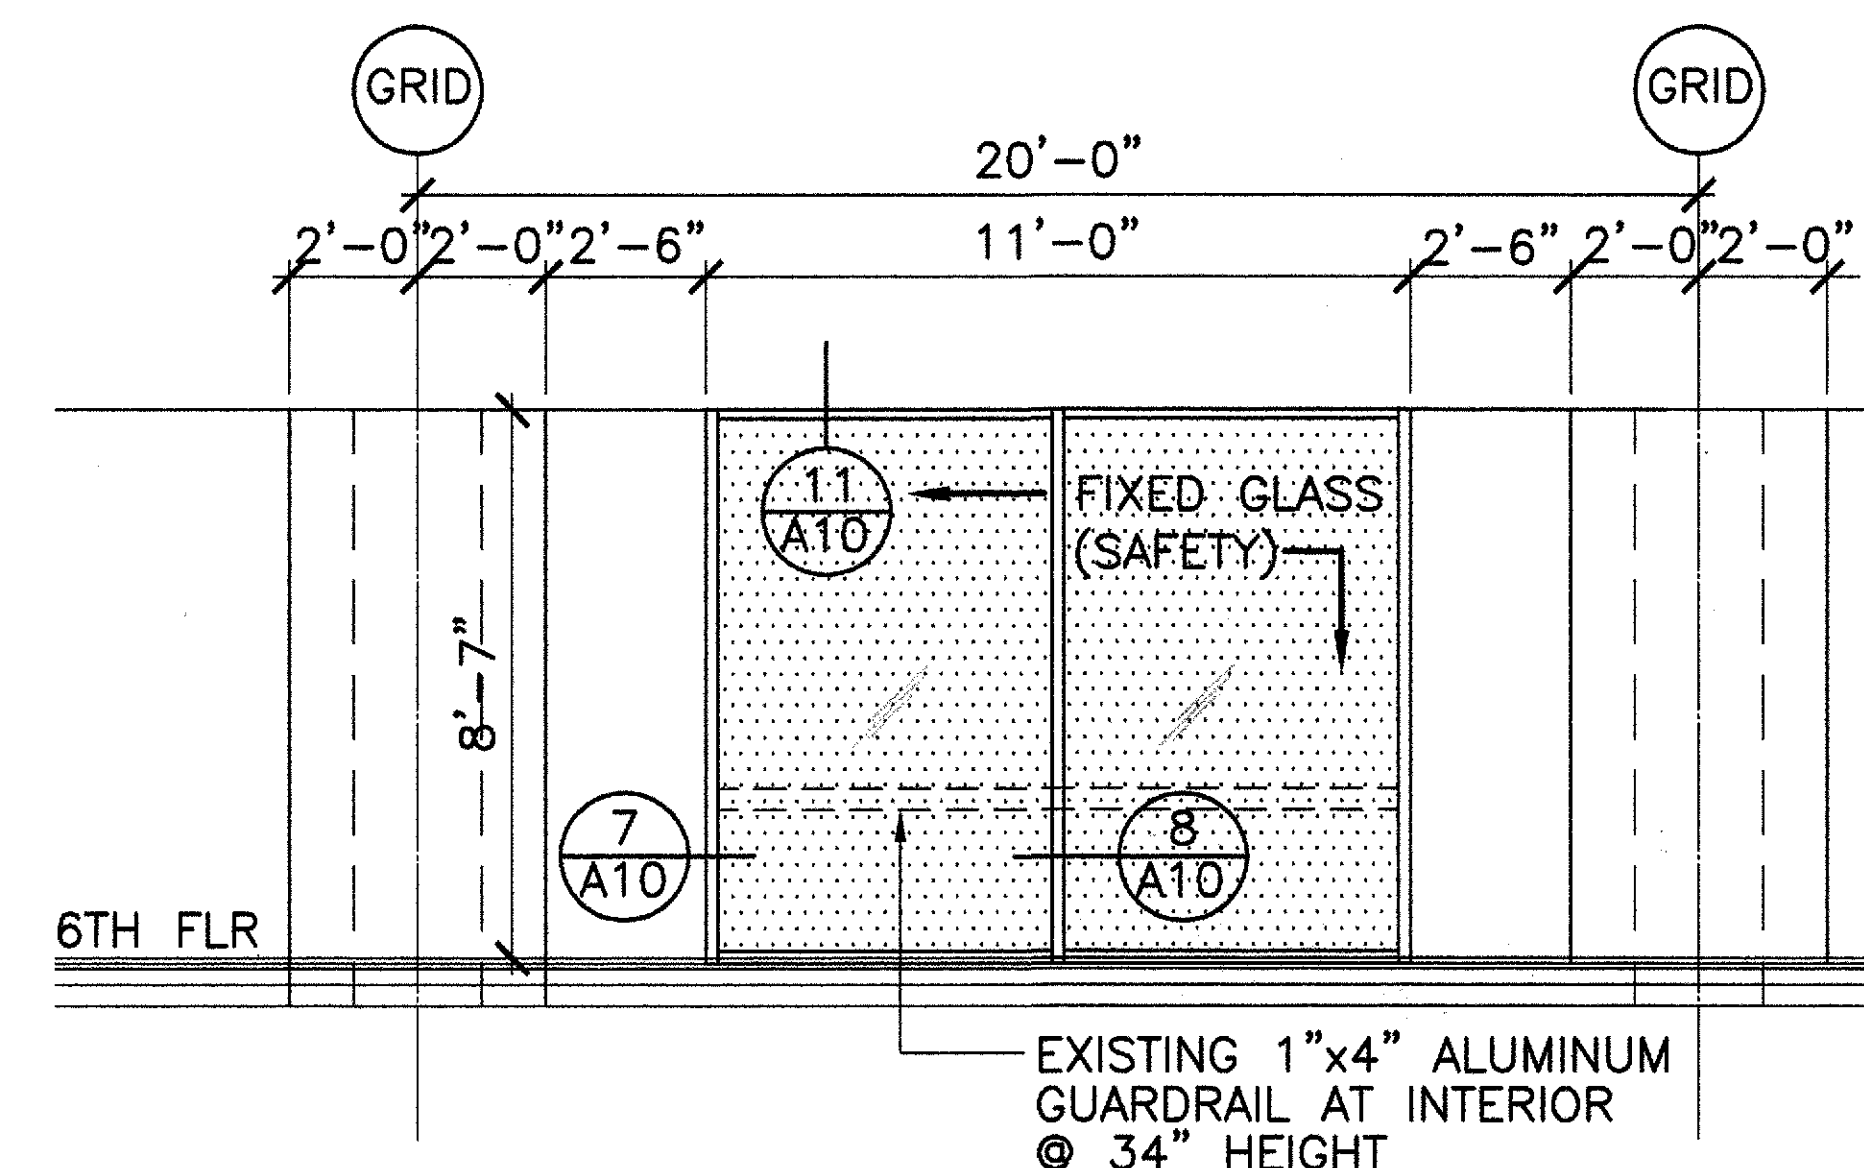

WINDOW TYPE J

AS BUILT DRAWING


SEP. 8 2008
 KKK ALUMINUM & GLASS INC.
 746 Kopke Street
 Honolulu, Hawaii 96819

NOTE: STIPPLED AREA INDICATES APPLICATION OF PROTECTIVE TINTING TO INTERIOR SURFACE OF WINDOW AND DOOR GLAZING.

GRAPHIC SCALE

1/4" = 1'-0" 5' 0' 5'





POST	REVISED	DATE	JOB NO.	10/11	10/09/07
ADD-1					
REVISION NO.	SYMBOL	DESCRIPTION	SHEET OF	DATE	APPROVED PUBLIC WORKS ADMINISTRATOR

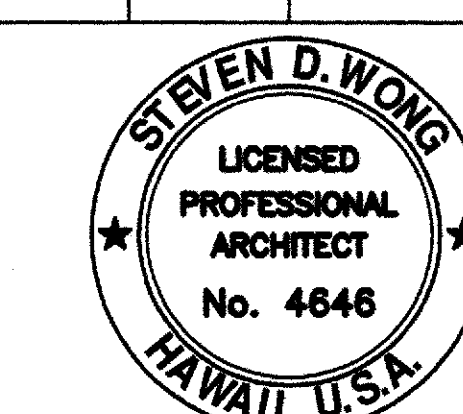


THIS WORK WAS PREPARED BY ME OR UNDER MY SUPERVISION AND CONSTRUCTION OF THIS PROJECT WILL BE UNDER MY OBSERVATION, (OBSERVATION OF CONSTRUCTION AS DEFINED IN CHAPTER 16-112, SUBCHAPTER 1, DEFINITIONS, OF THE HAWAII ADMINISTRATIVE RULES, PROFESSIONAL ENGINEERS, ARCHITECTS, SURVEYORS, AND LANDSCAPE ARCHITECTS) EXPIRATION DATE: 4-30-08
 Steven D. Wong
 MITSUNAGA & ASSOC., INC.

DEPARTMENT OF ACCOUNTING & GENERAL SERVICES STATE OF HAWAII	
KAKUHIHEWA BUILDING INSTALL PROTECTIVE TINTING	
KAPOLEI	OAHU HAWAII
DOOR TYPES	
MITSUNAGA & ASSOC., INC.	DAGS JOB NO. 62-10-0515 42-10-0443
DESIGNED BY: SW	CHECKED BY: SW
DRAWN BY: CAD	APPROVED BY: SW
SCALE: AS NOTED	DATE: JULY 2007
FILE: 4	DRAWER: 2 FOLDER: 5

DRAWING NO. A-9
 SHEET 10 OF 11 SHTS

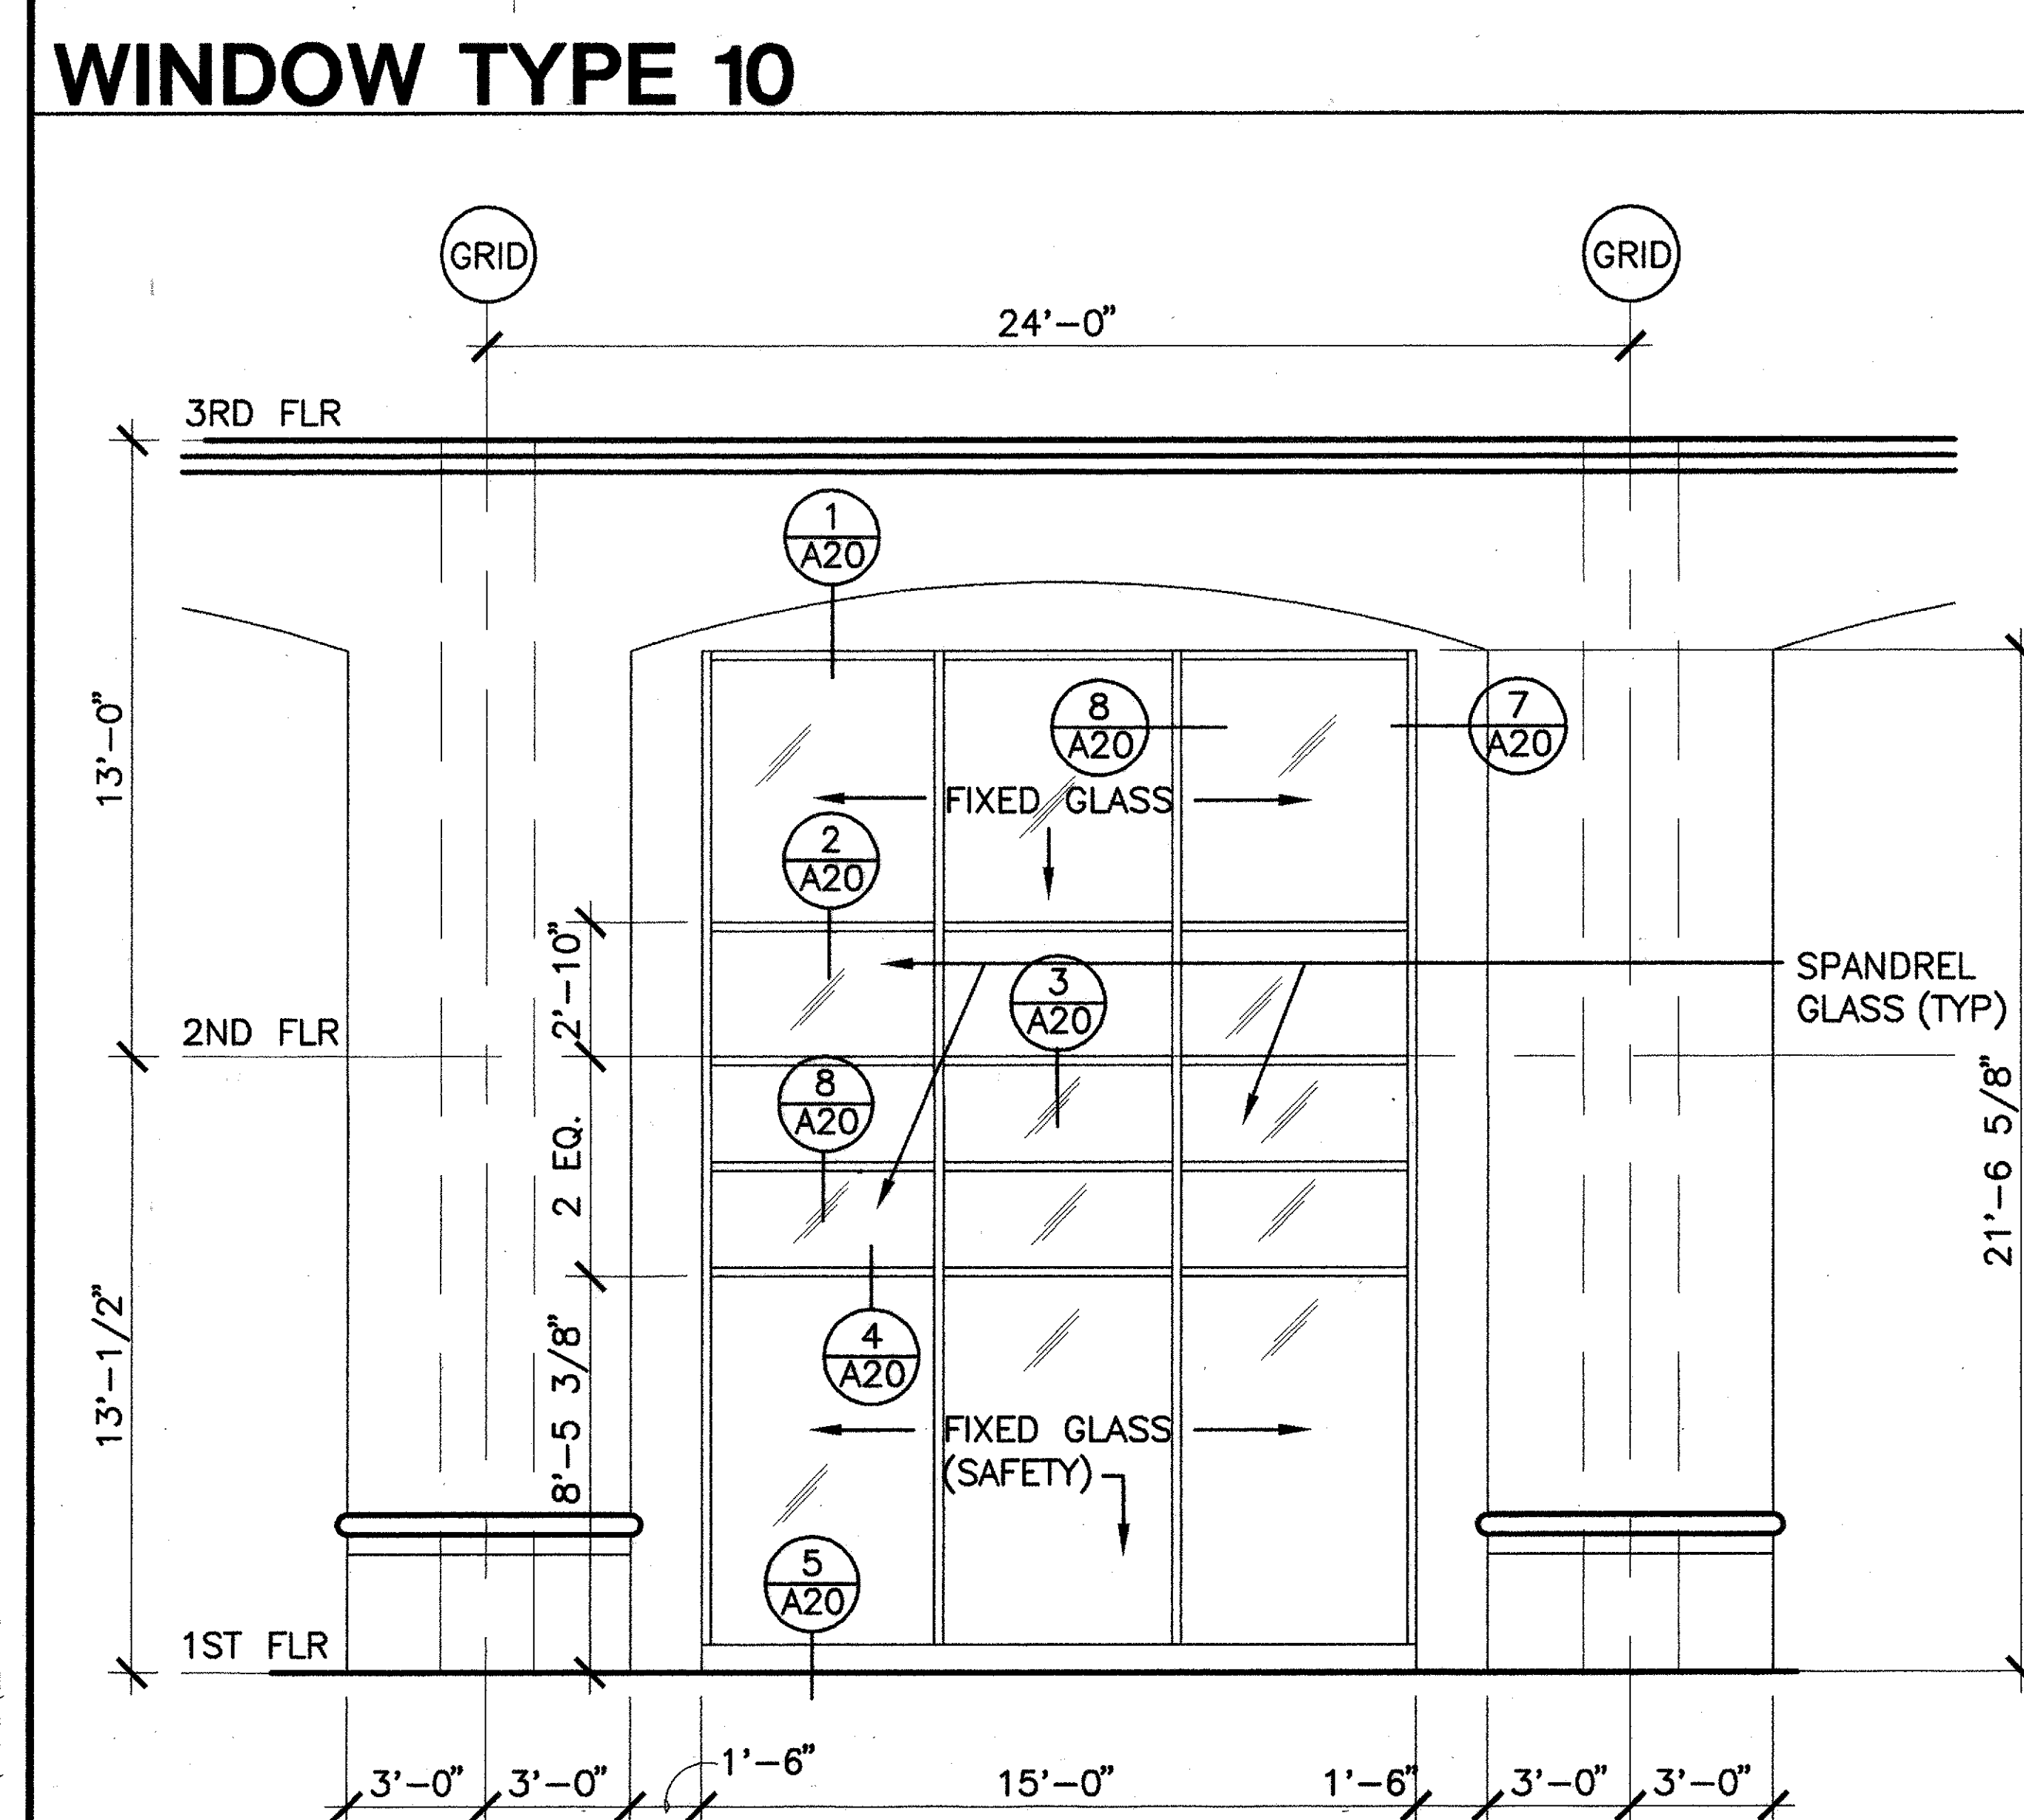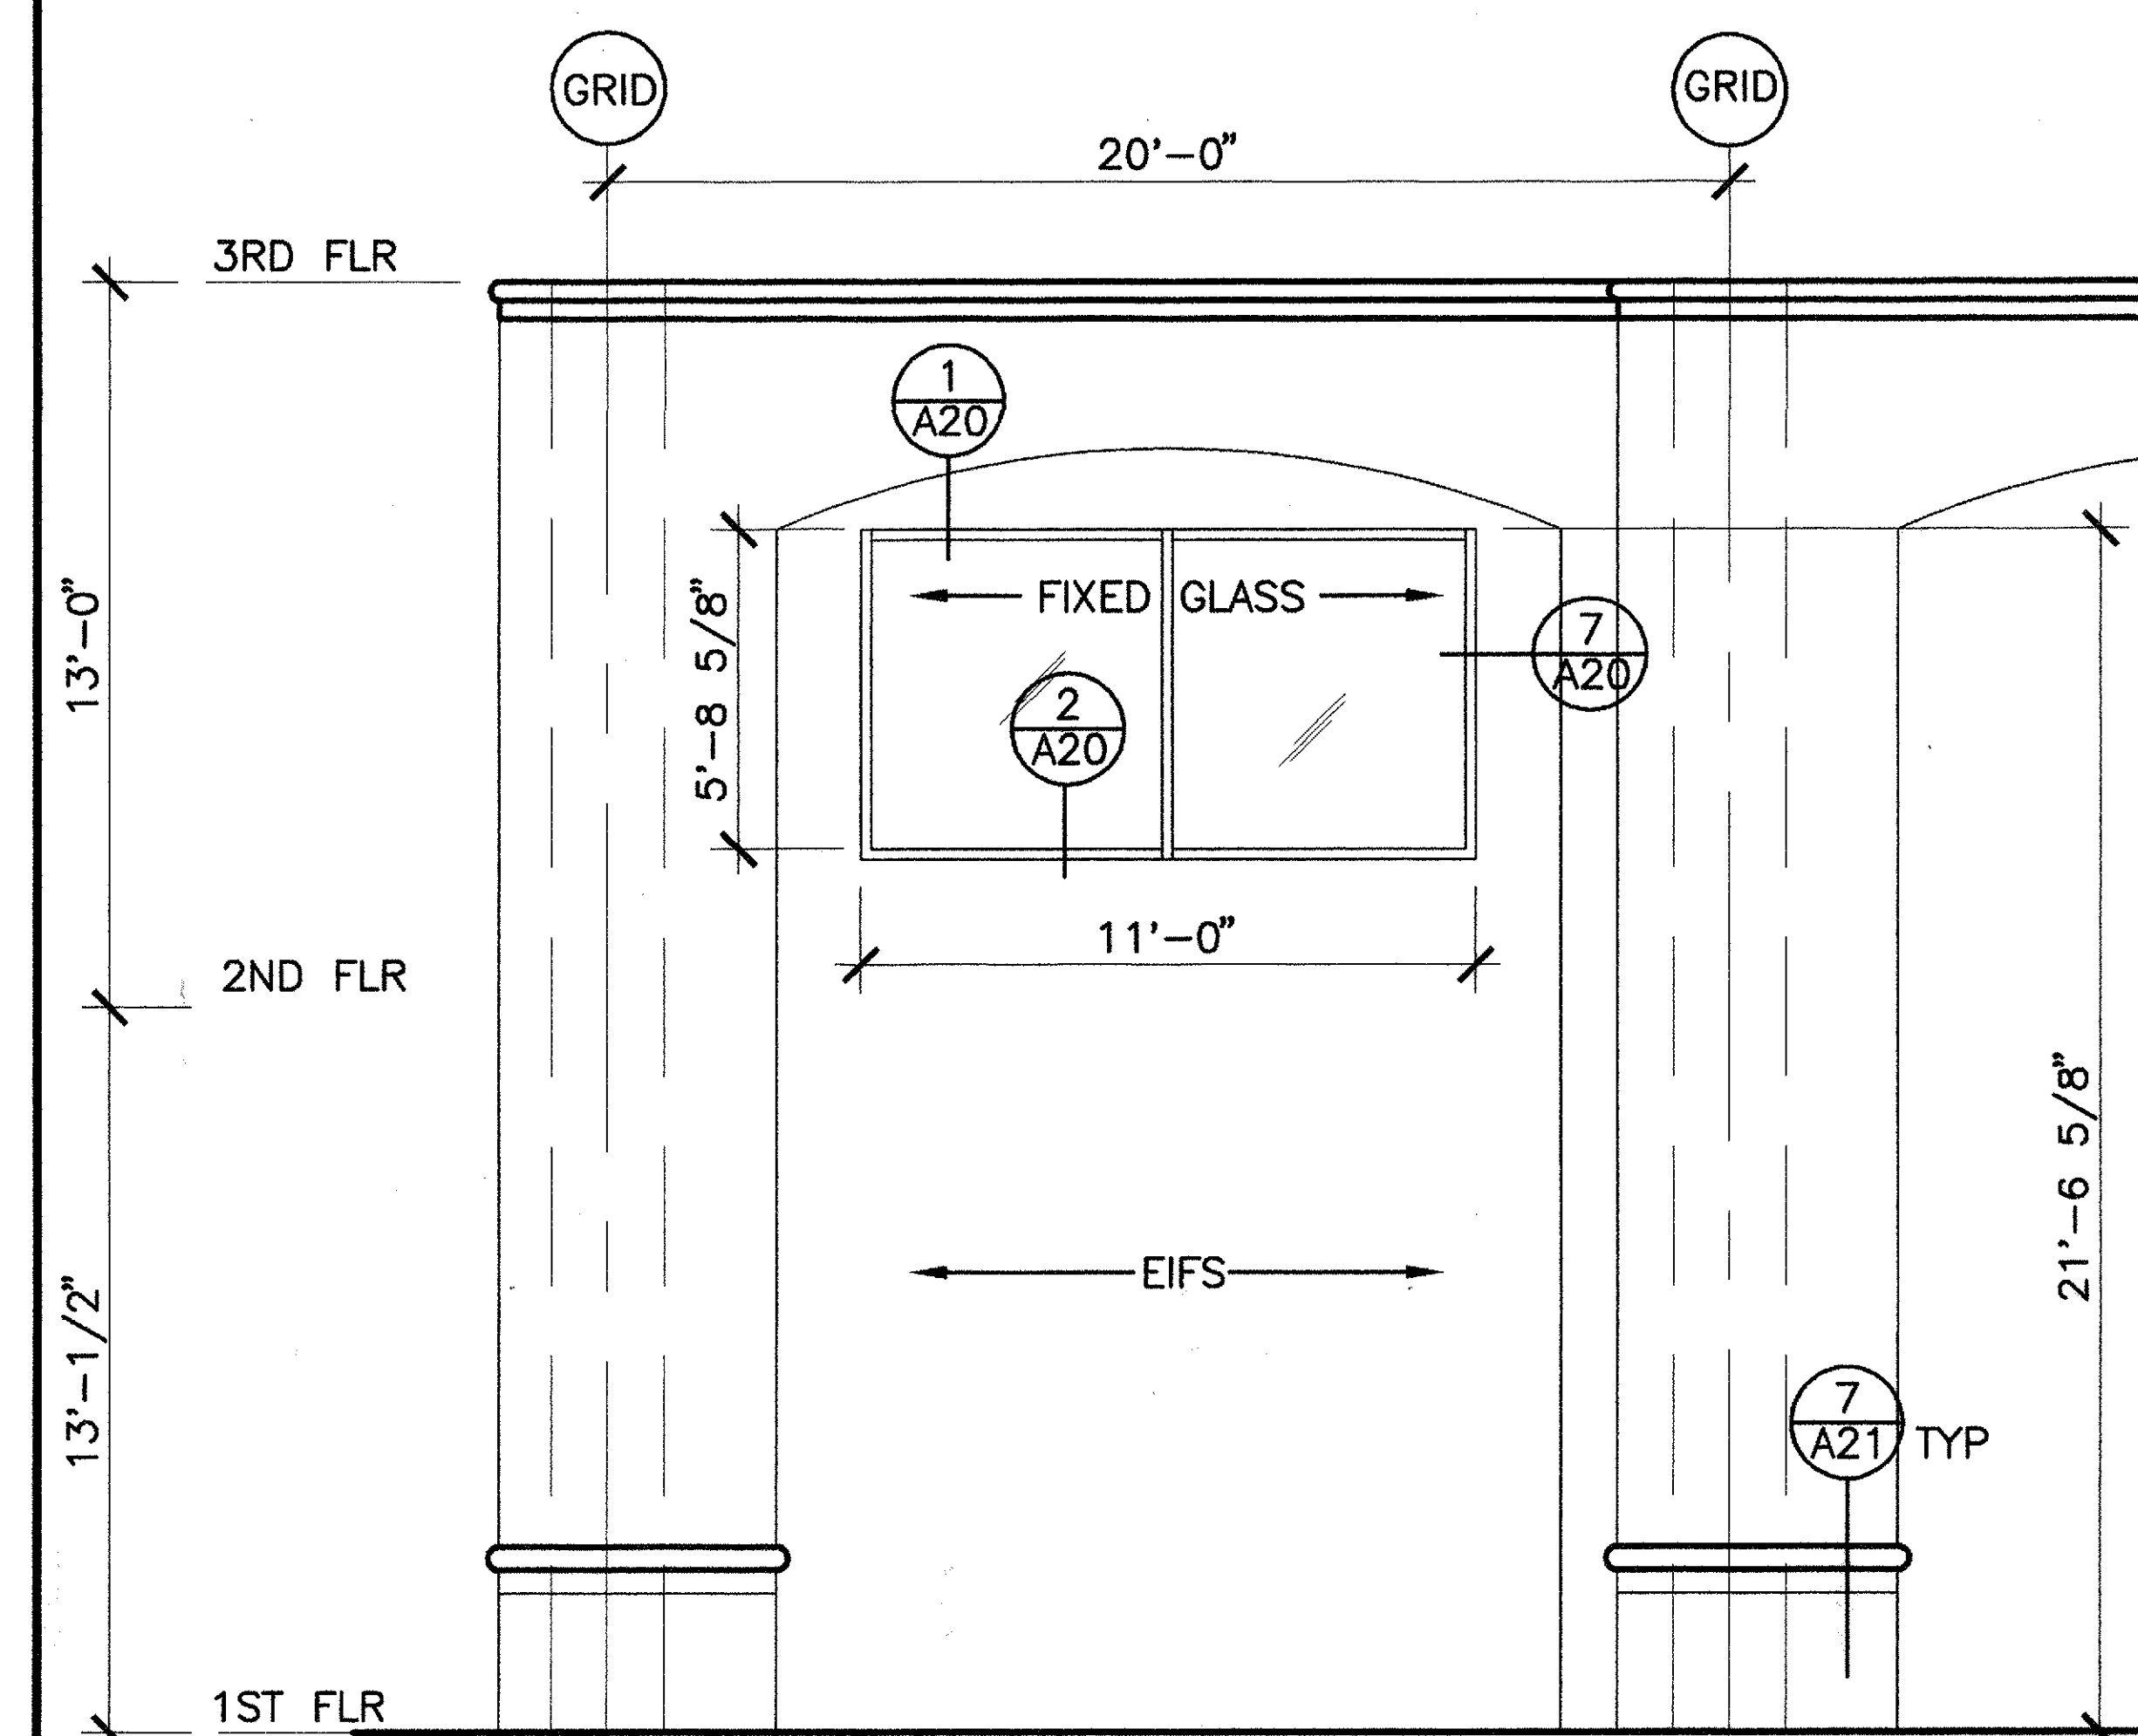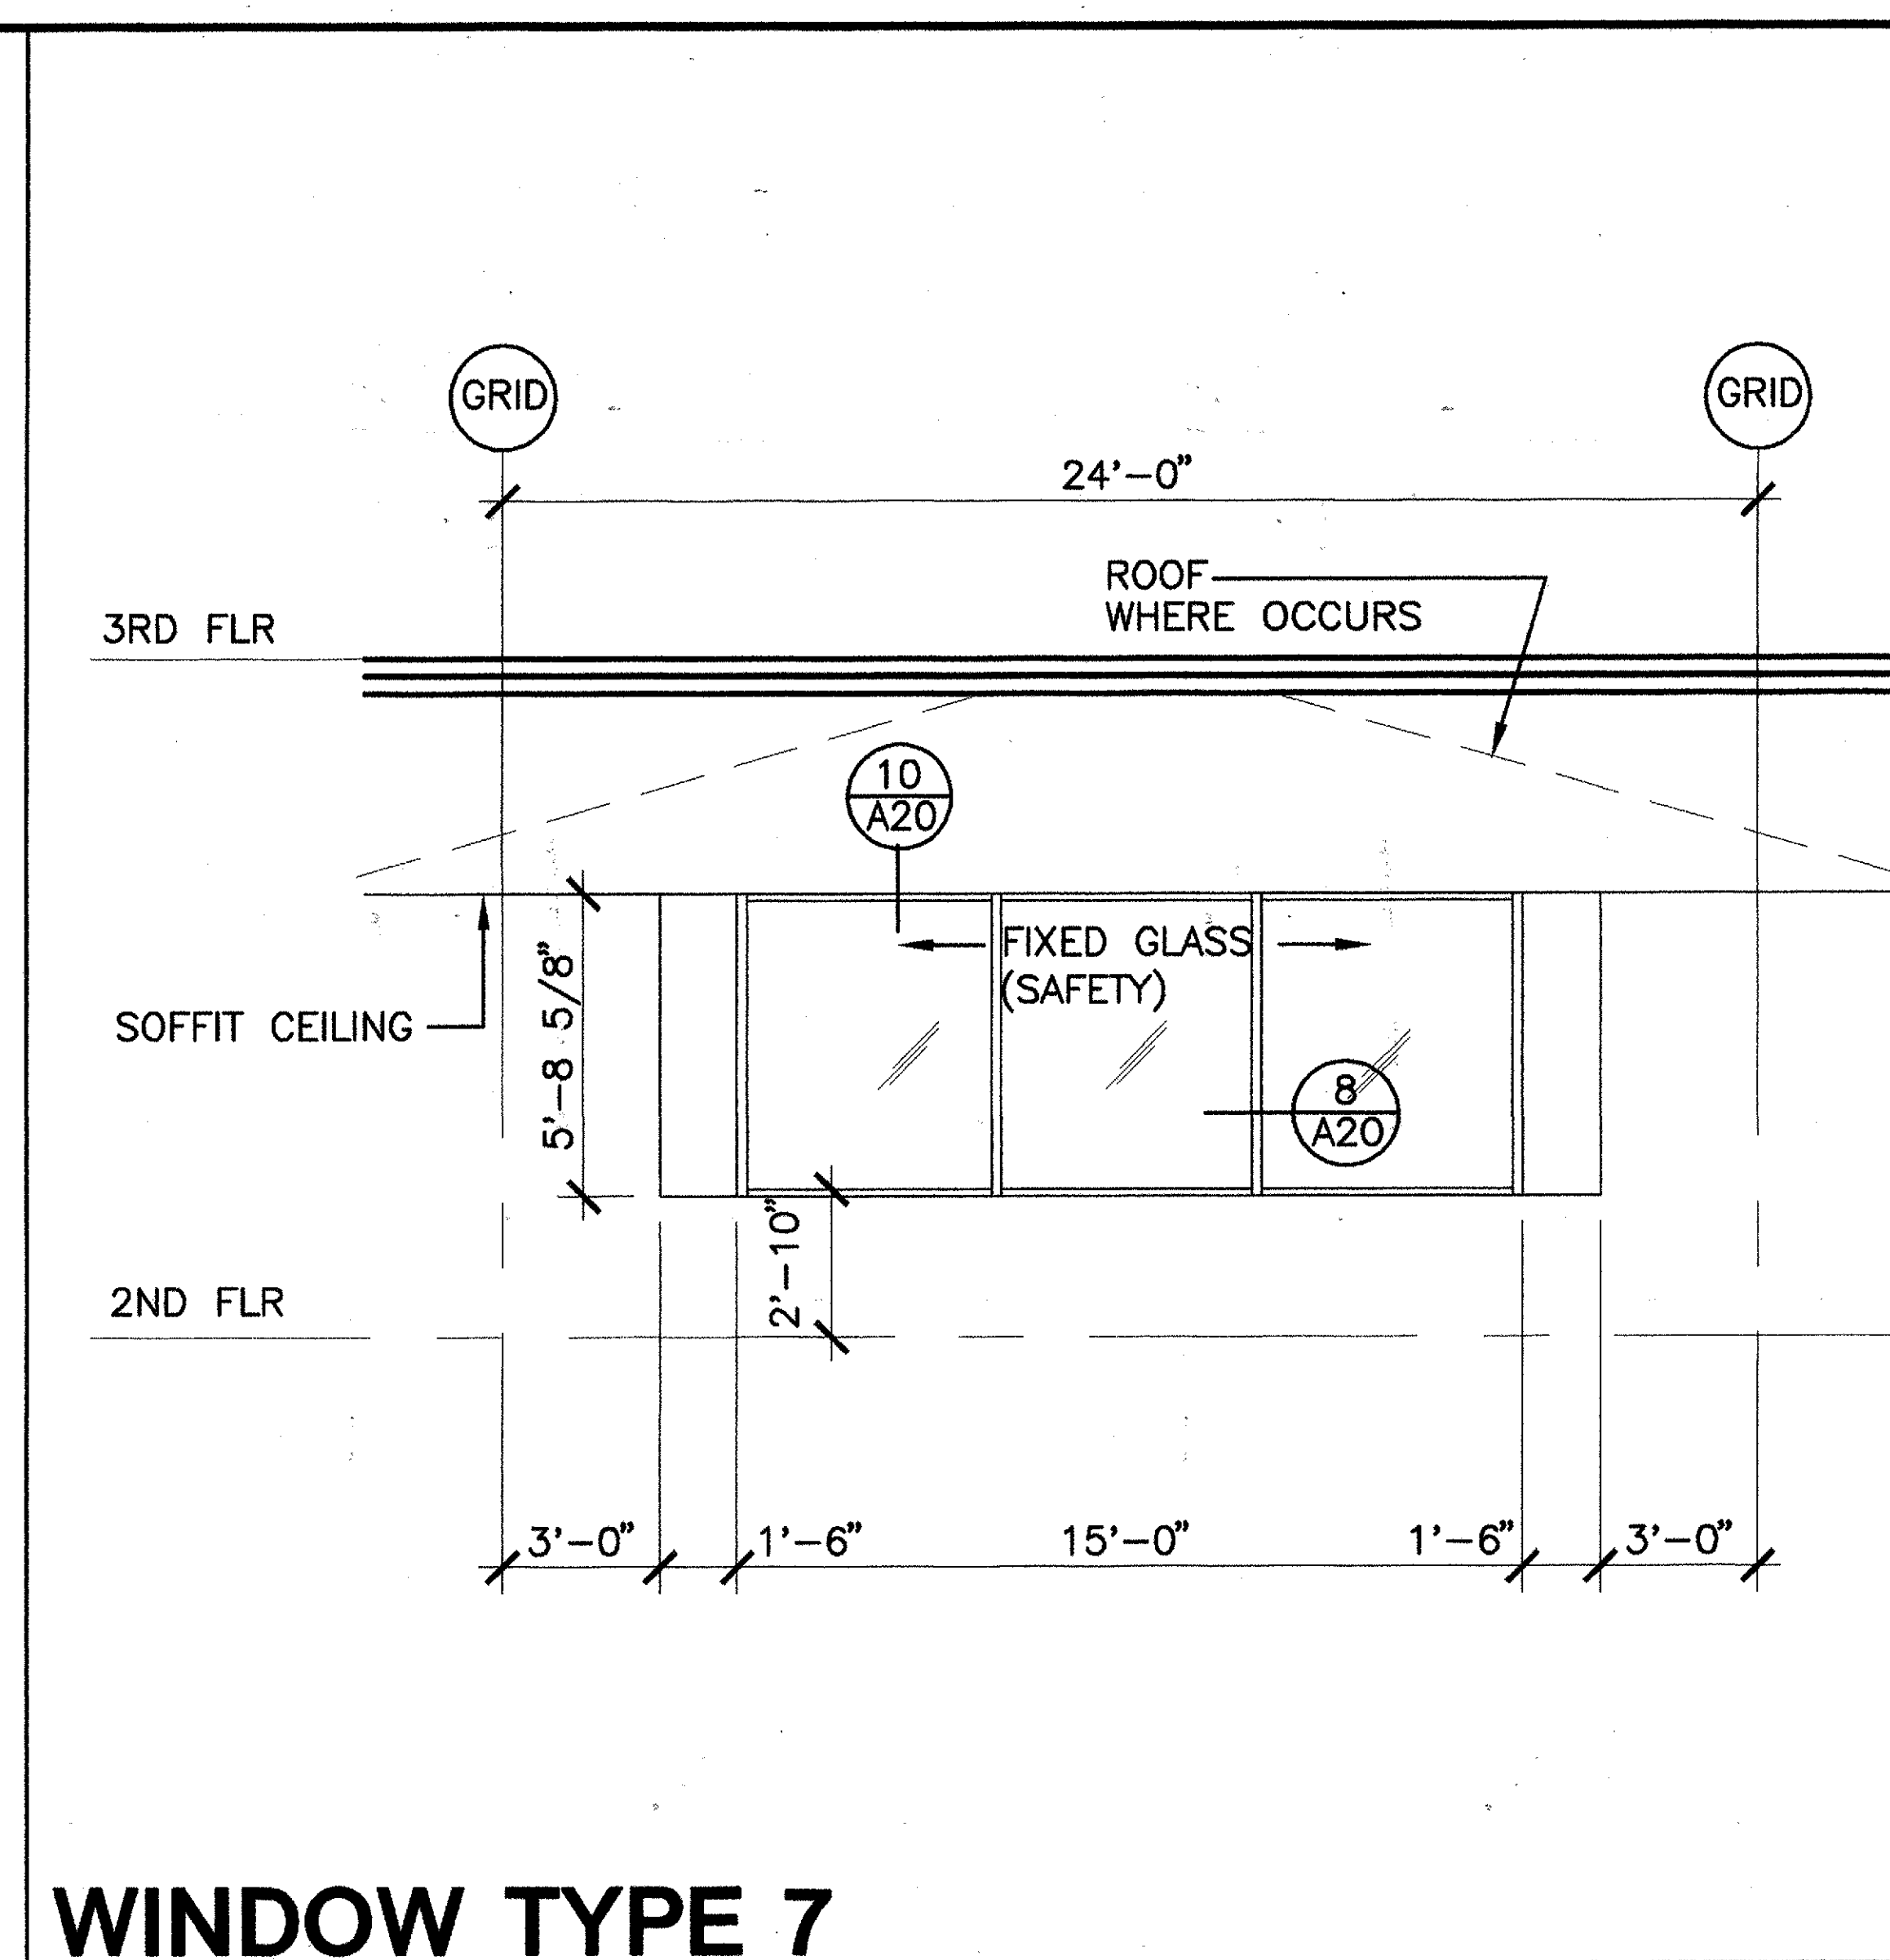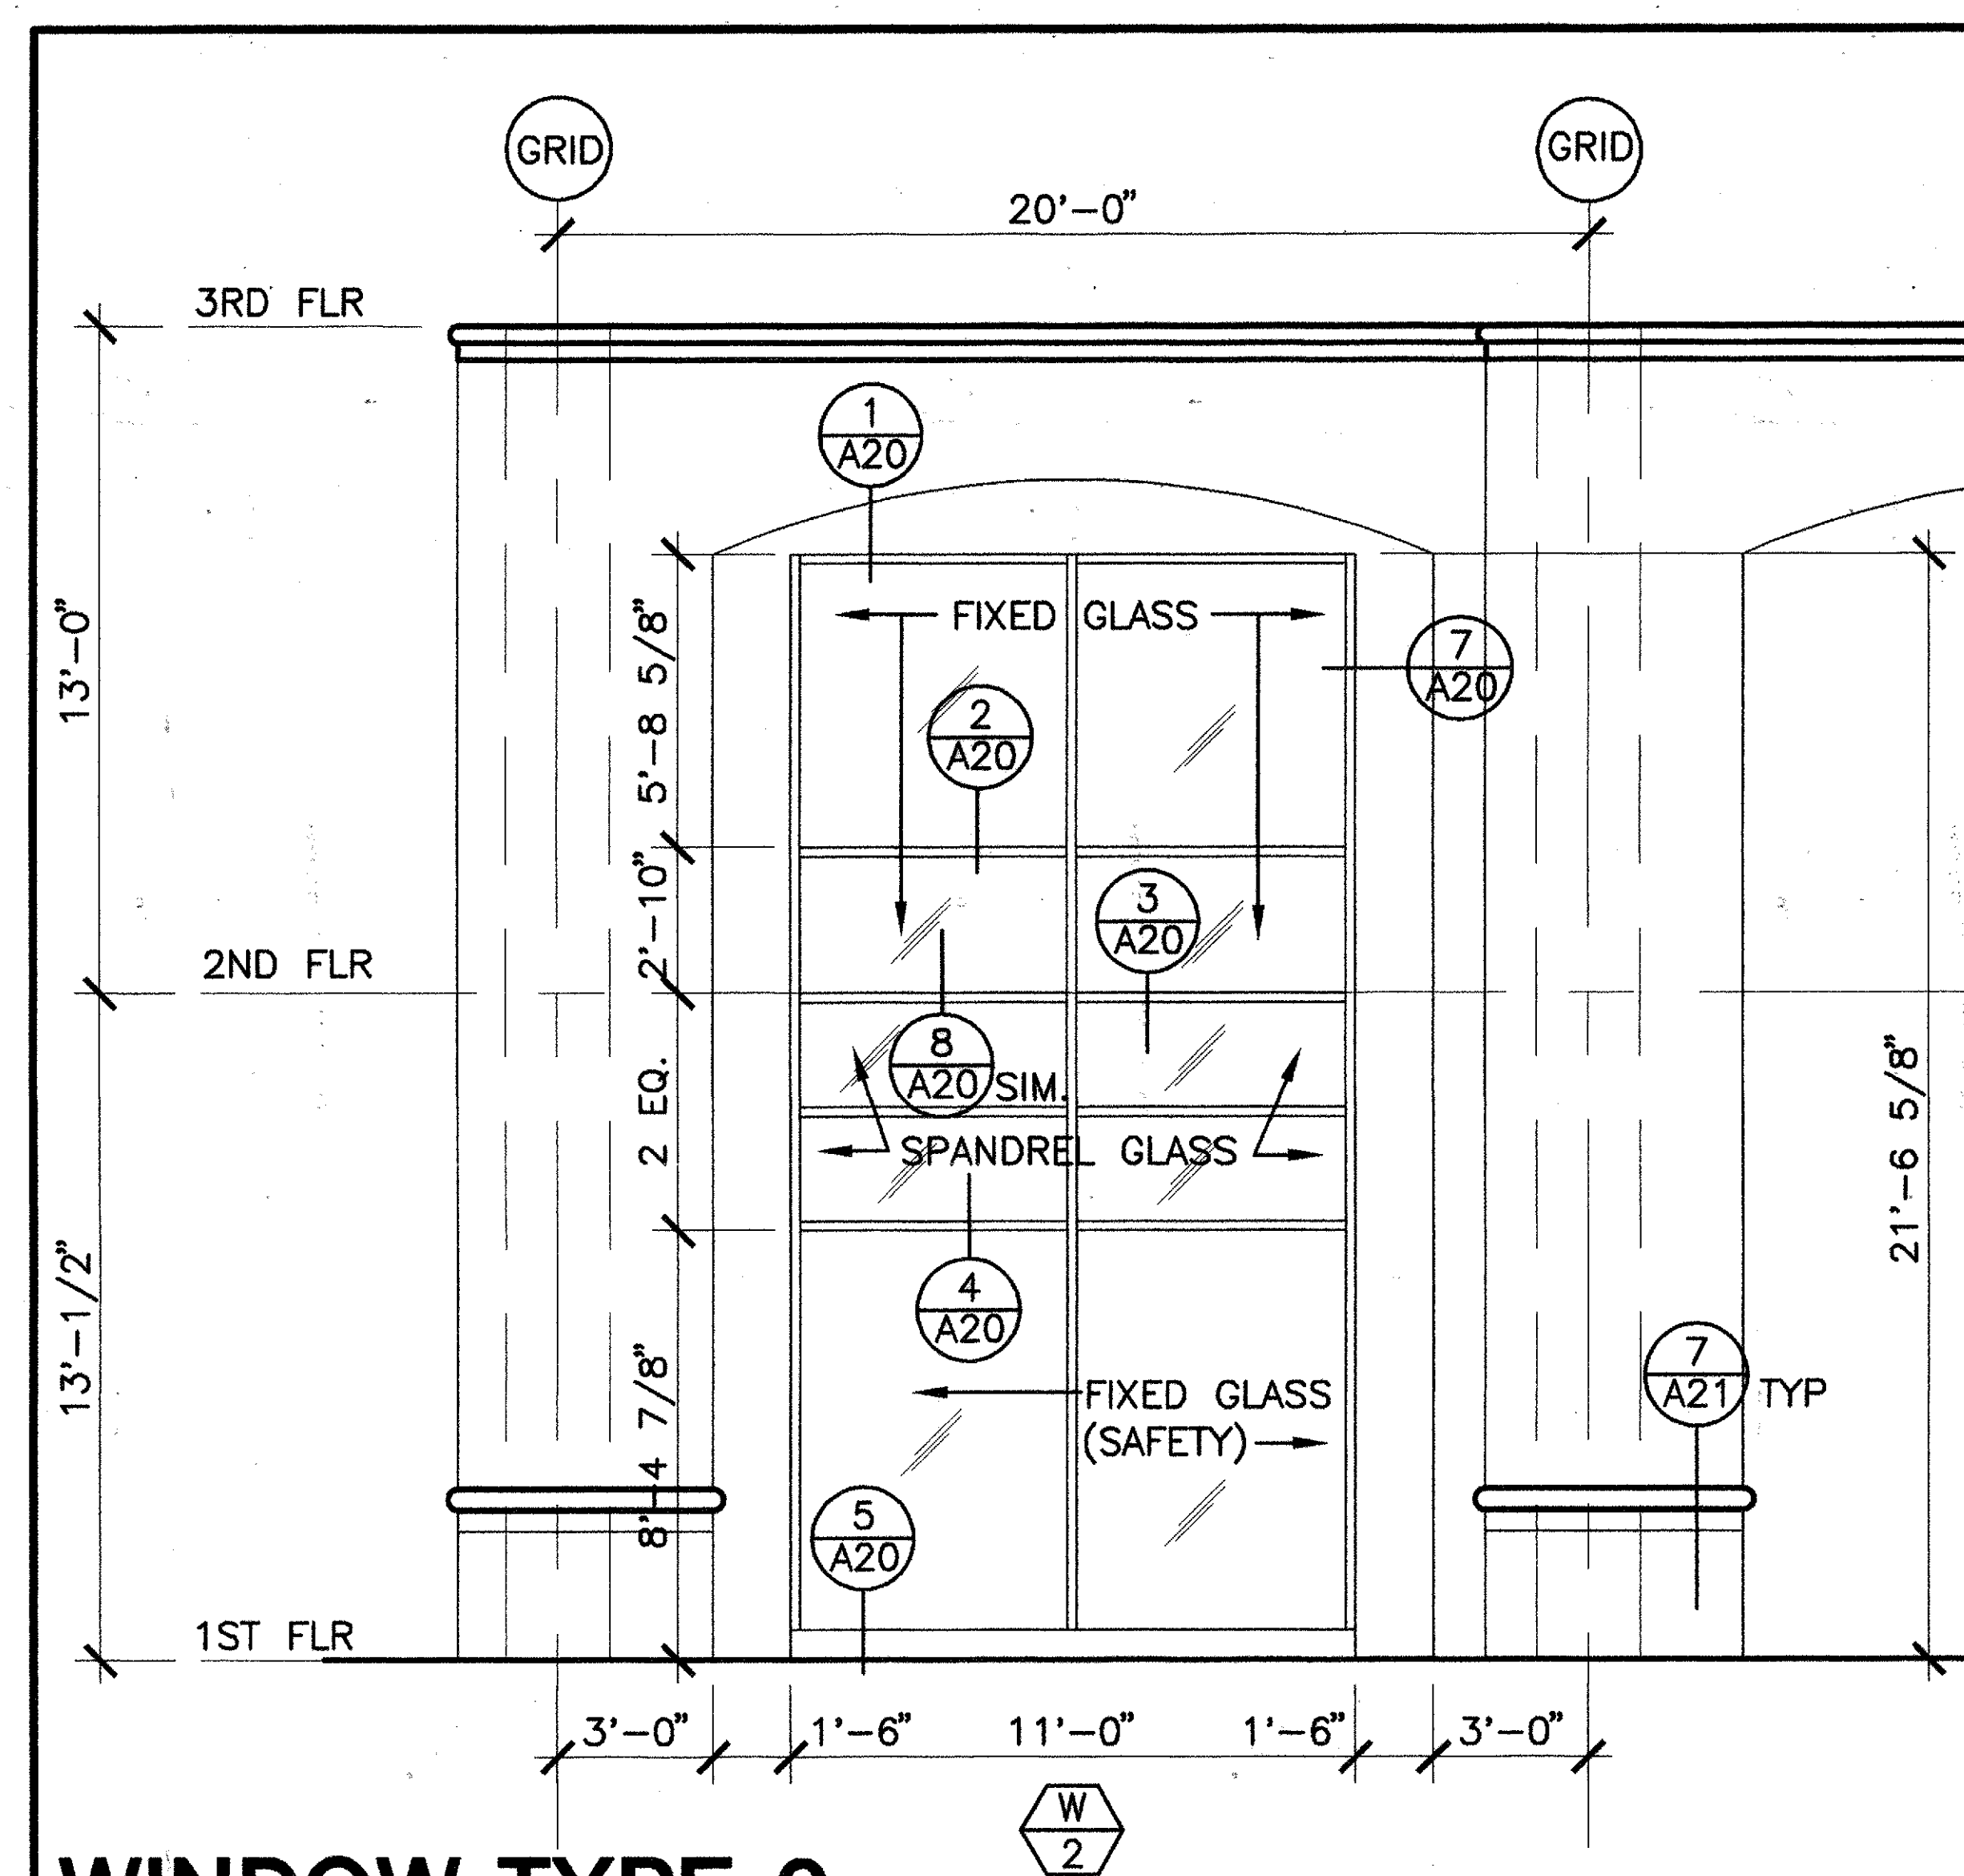


WINDOW TYPE 1

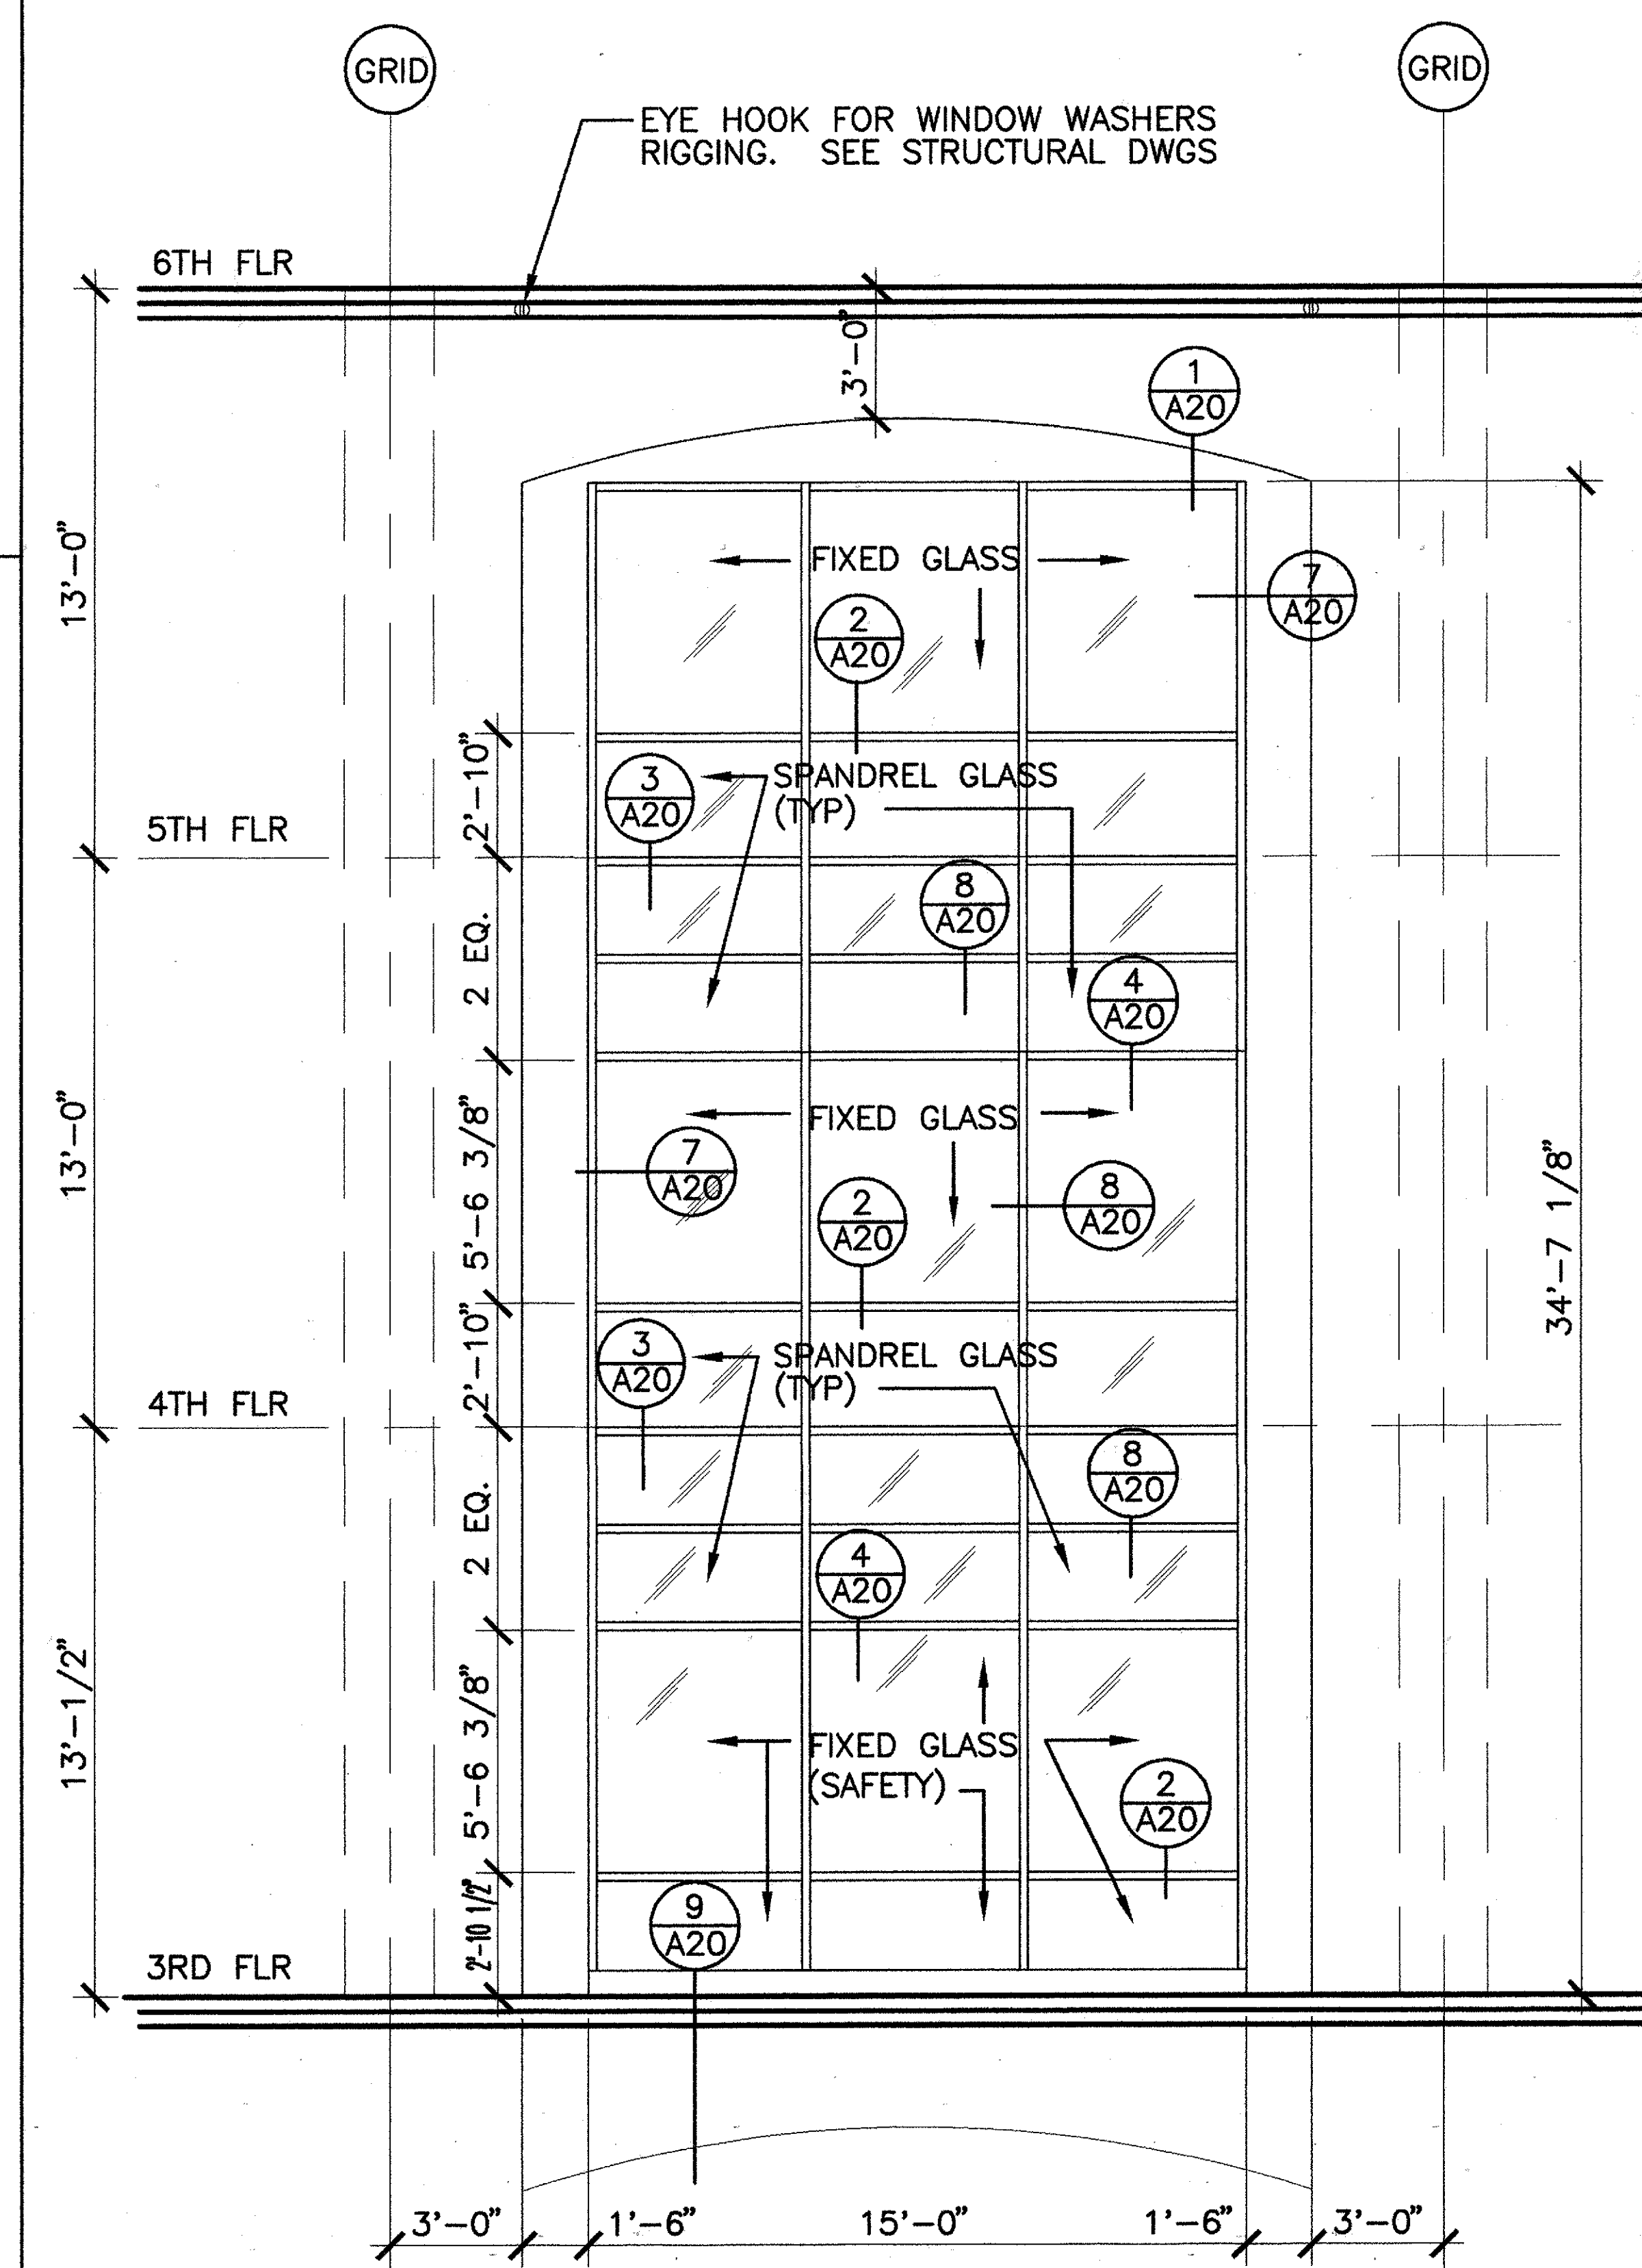


WINDOW TYPE 3


WINDOW SCHEDULE (CURTAIN WALL)

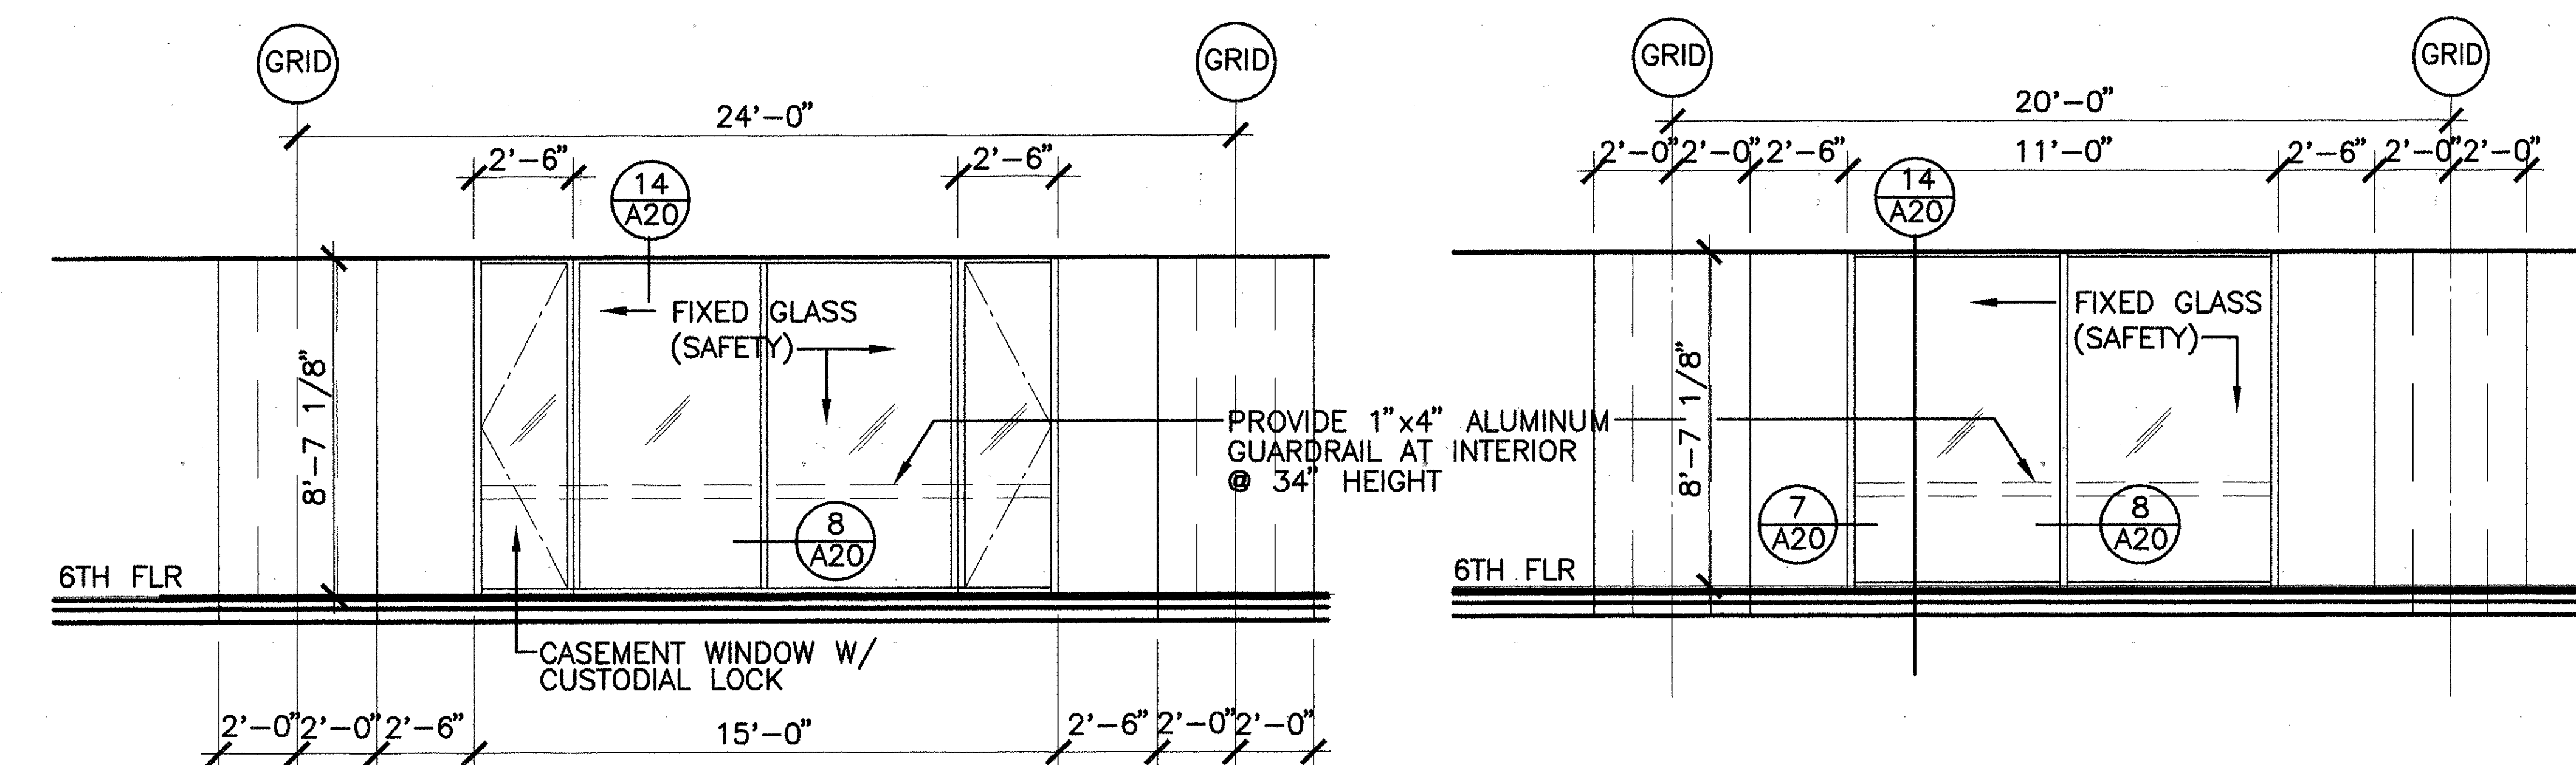
[illegible]

WINDOW TYPE 8

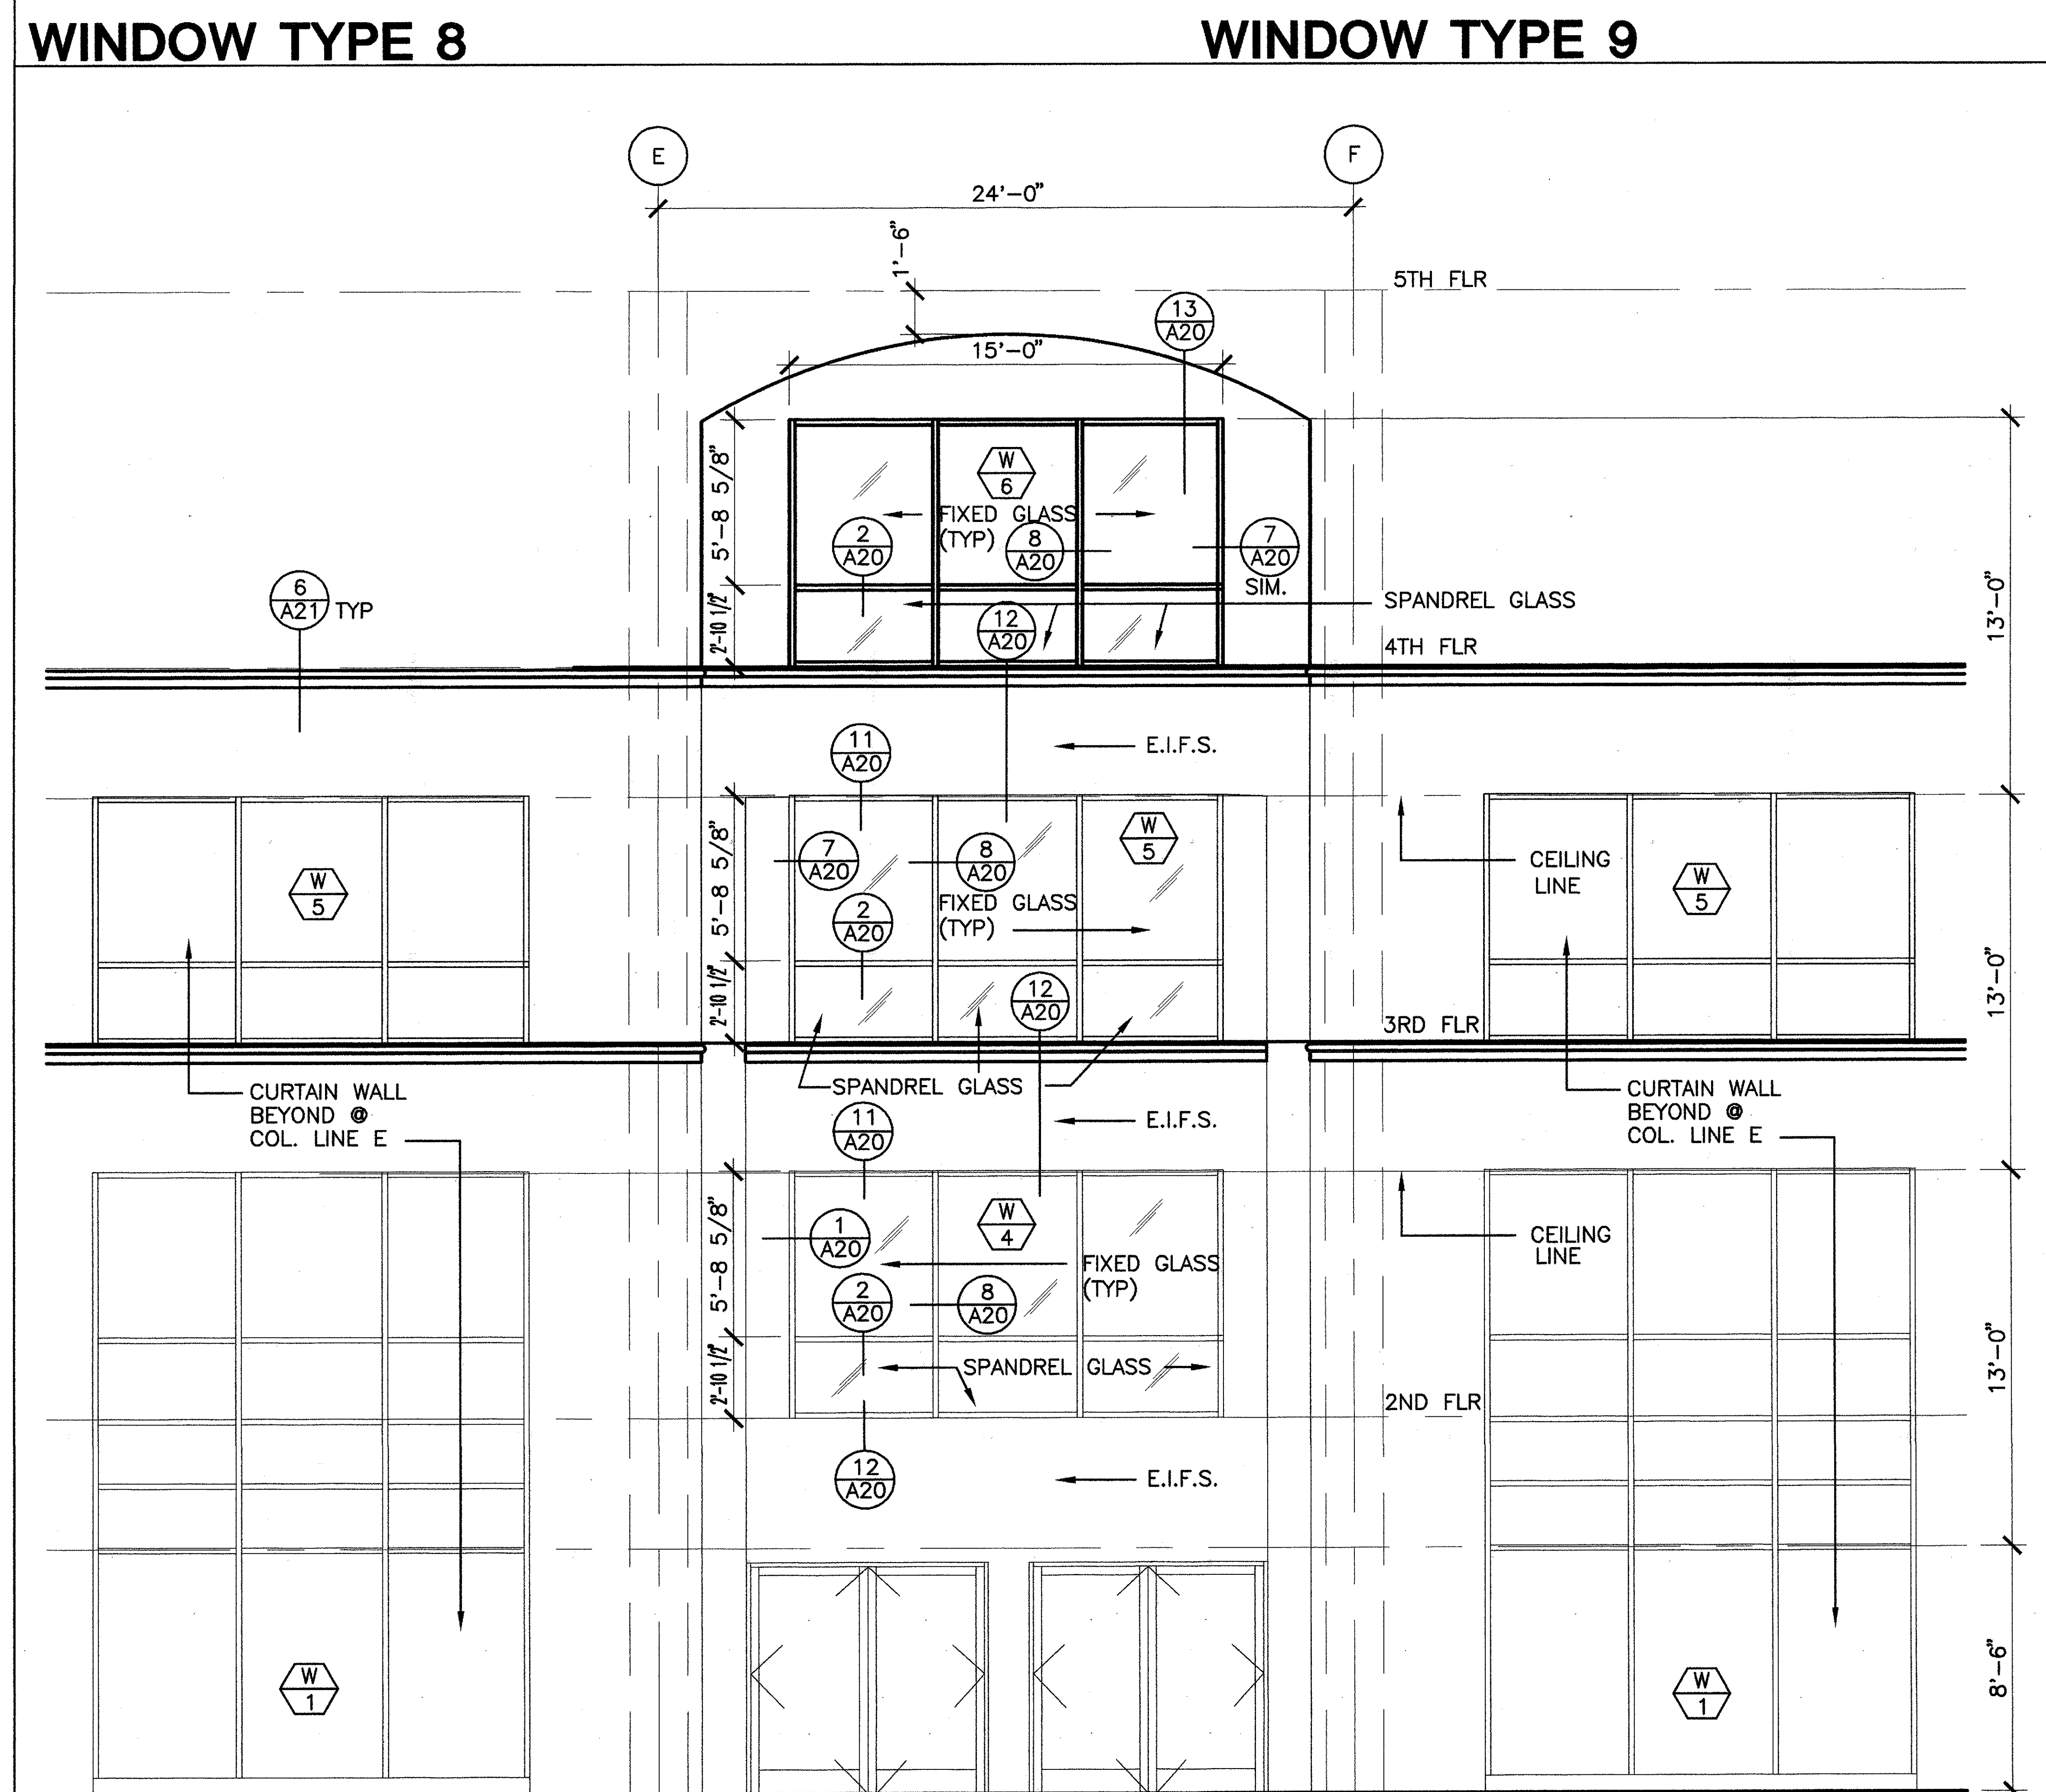


WINDOW TYPE 1, 4, 5 & 6

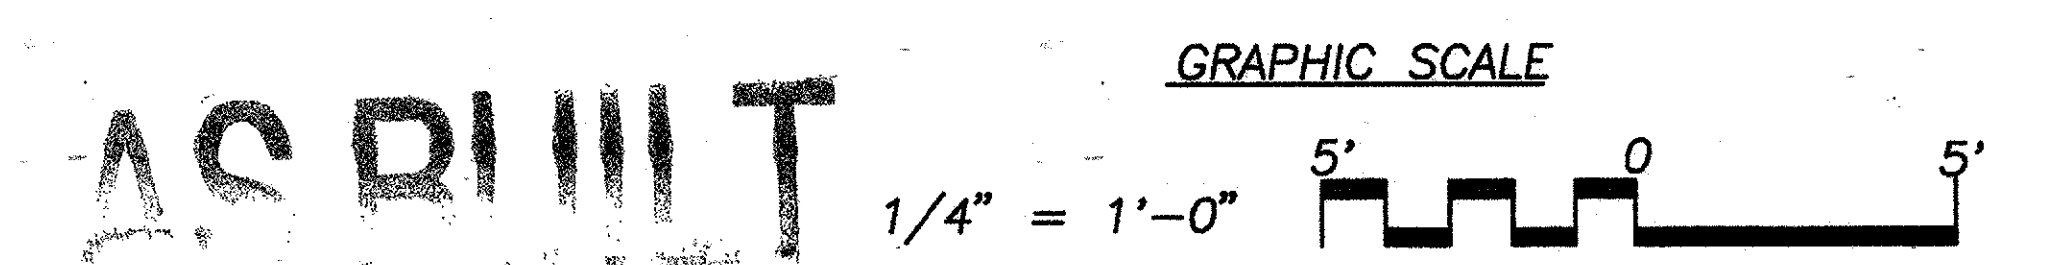


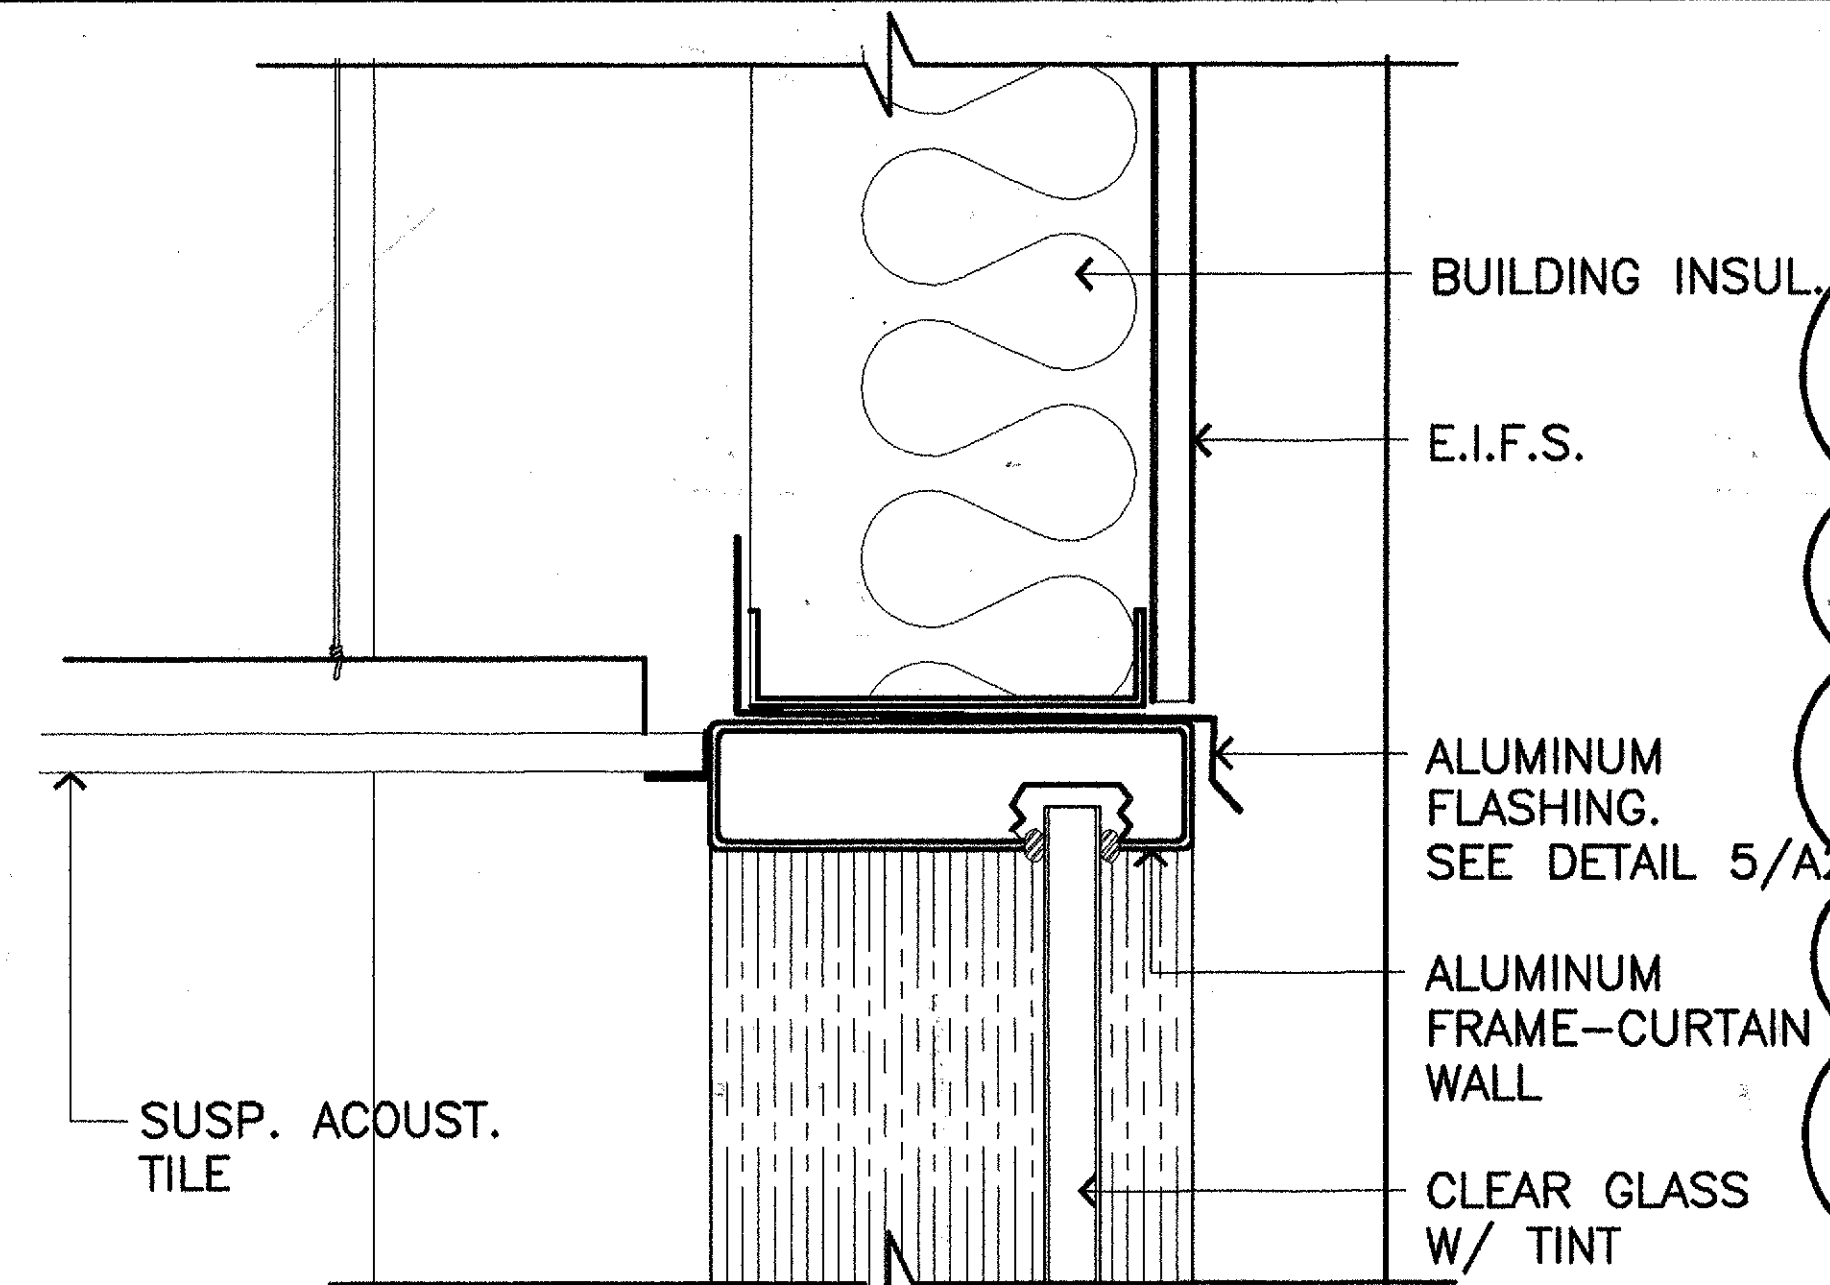


1 HEAD DETAIL
A-20 SCALE: 3" = 1'-0"

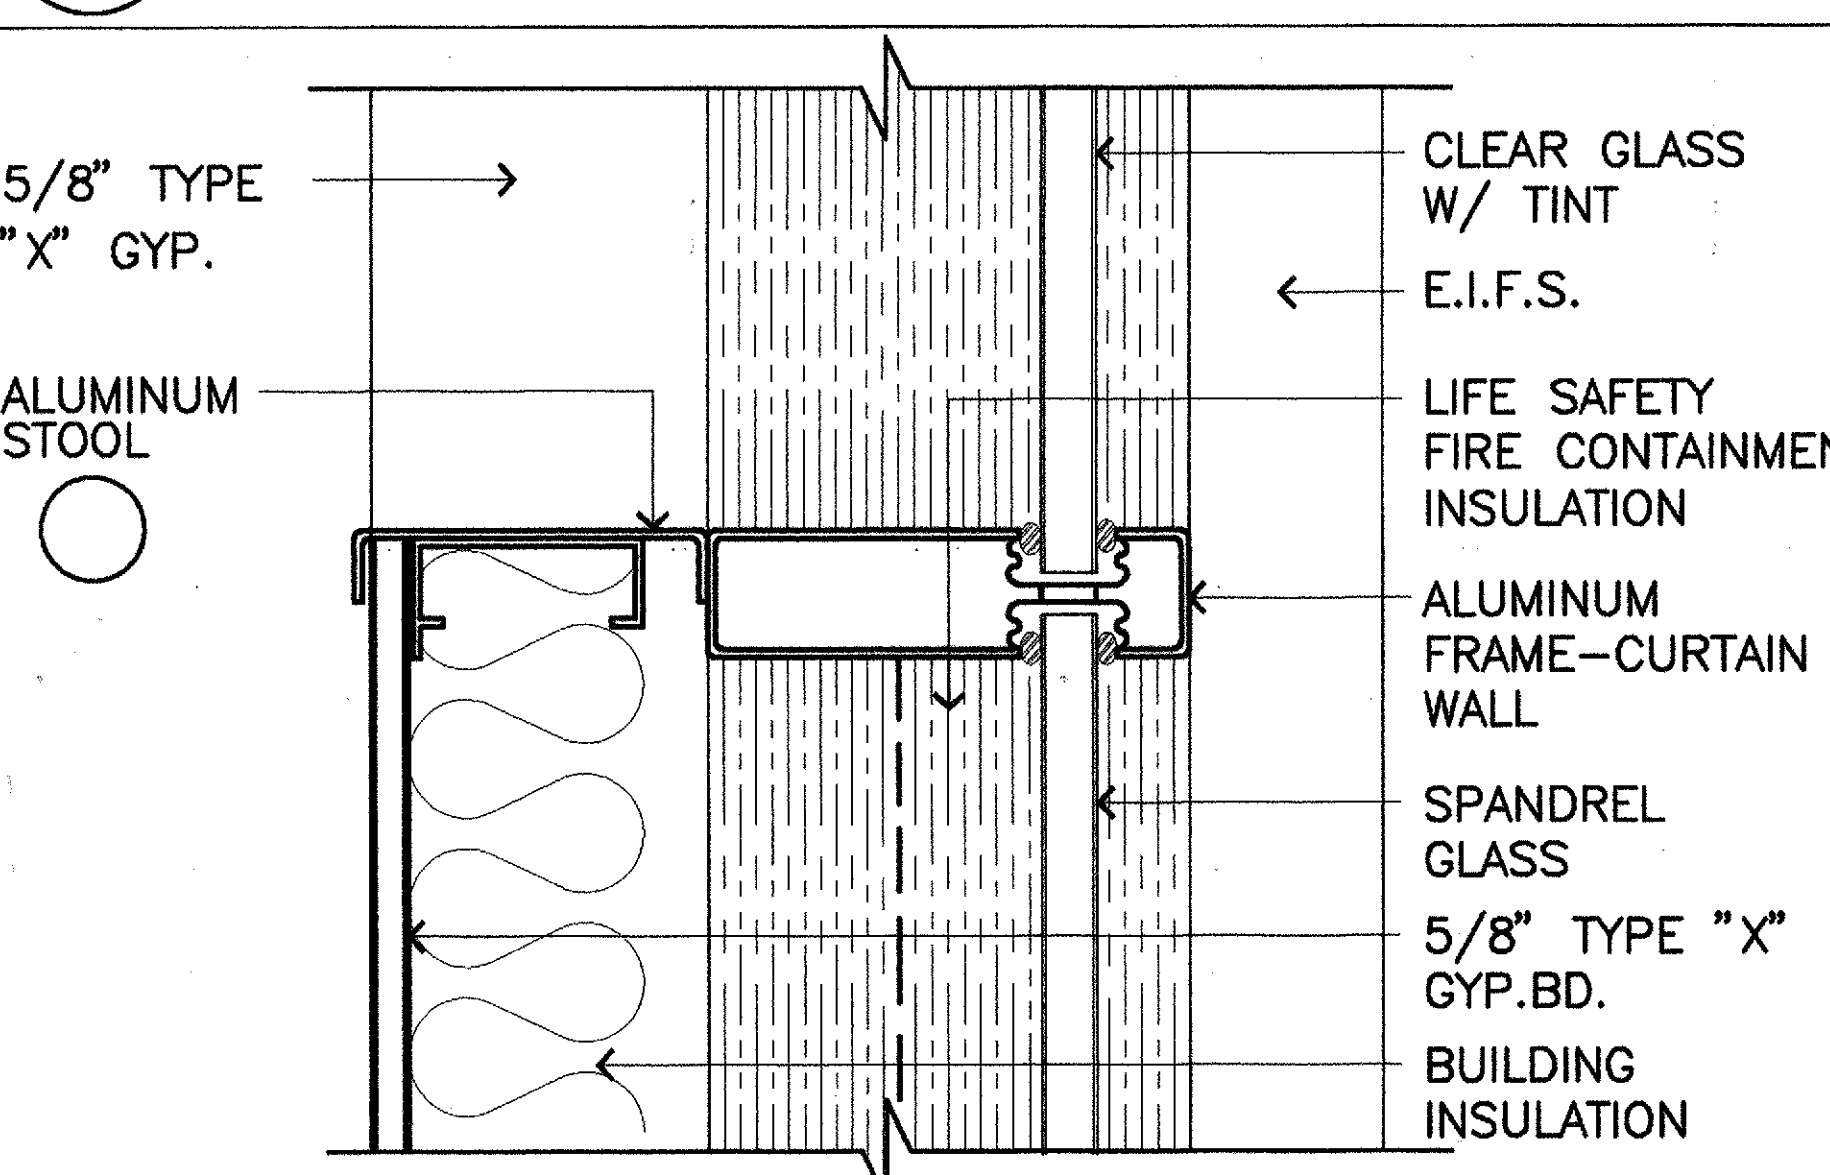


2 INTERMEDIATE SILL DETAIL
A-20 SCALE: 3" = 1'-0"

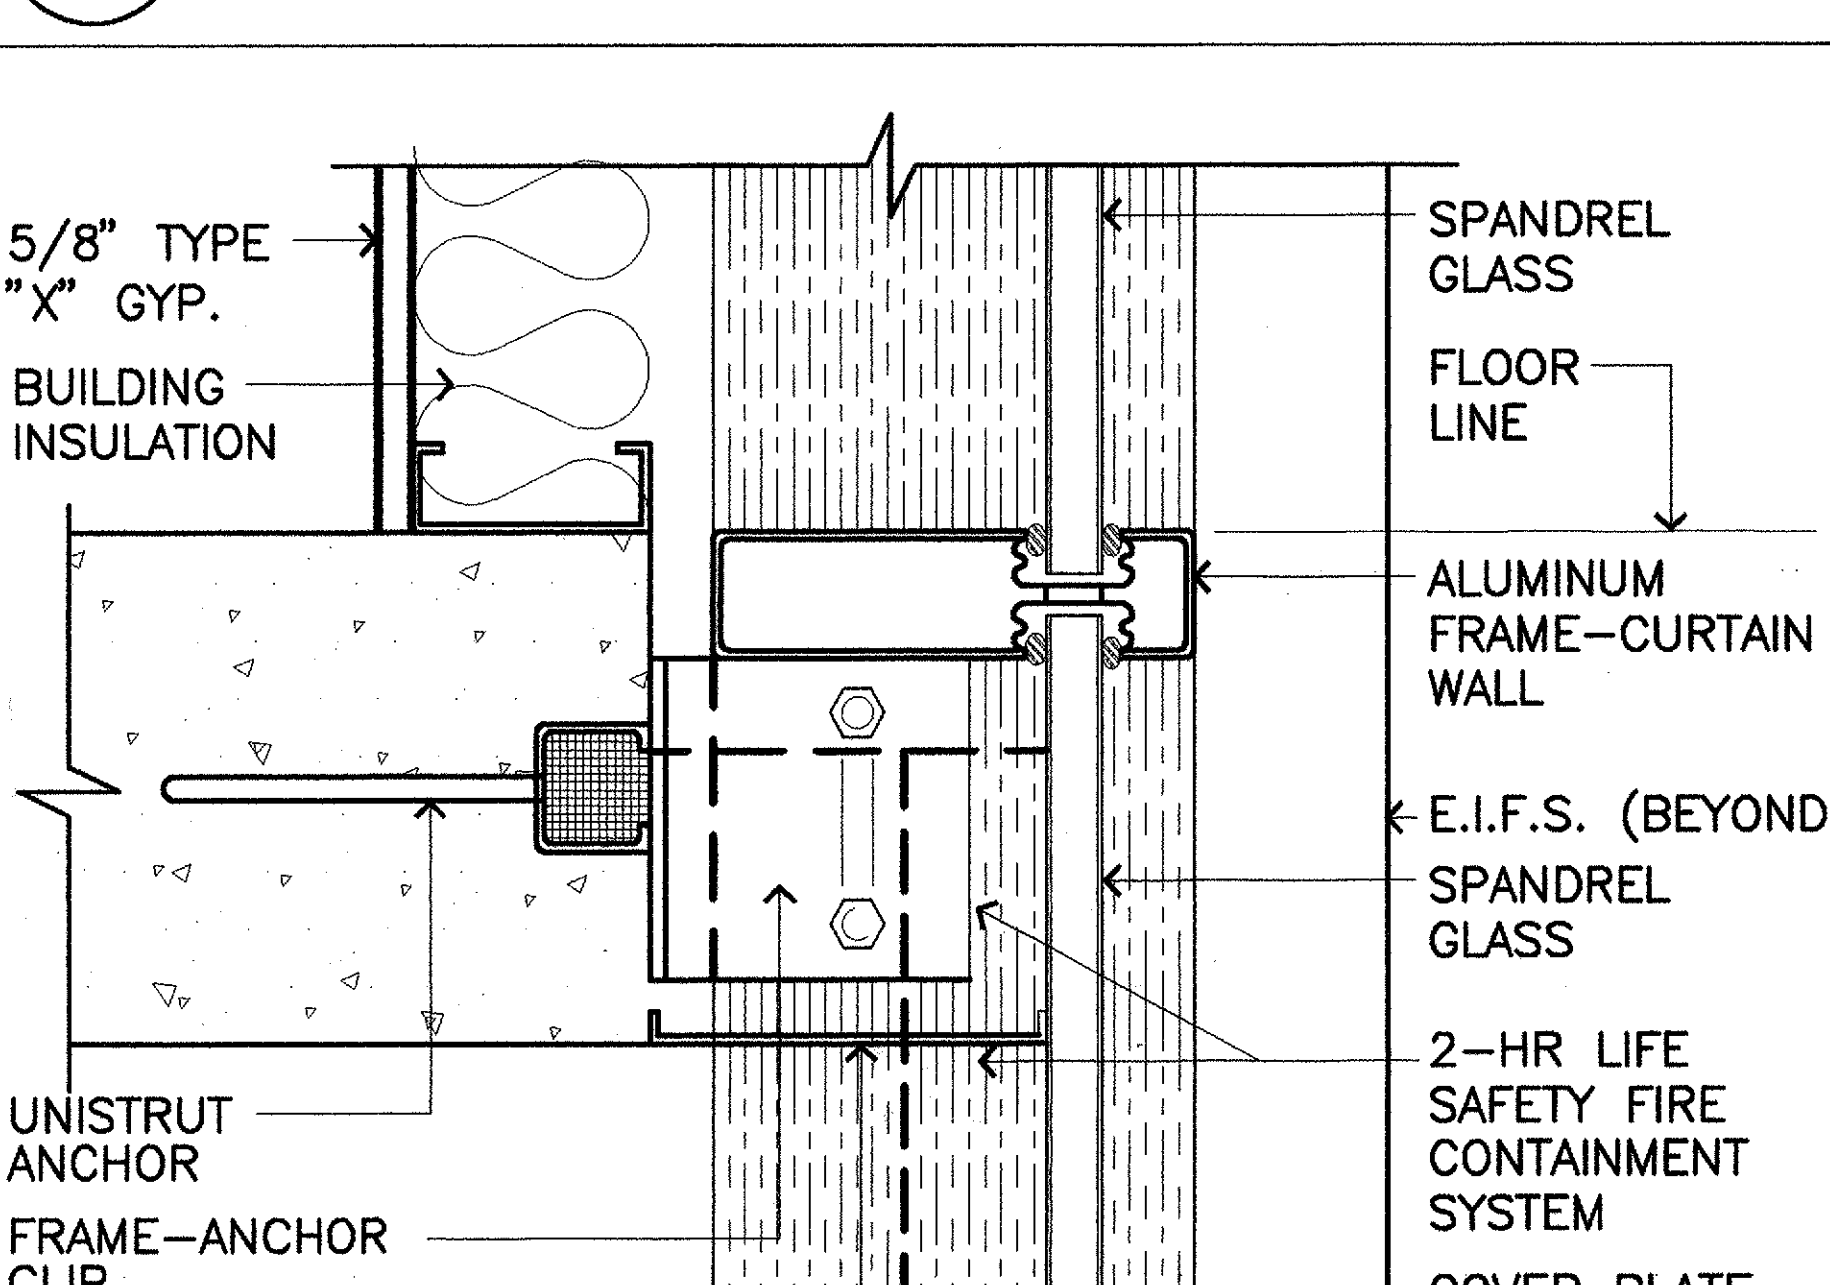


3 INTERMEDIATE SILL DETAIL
A-20 SCALE: 3" = 1'-0"

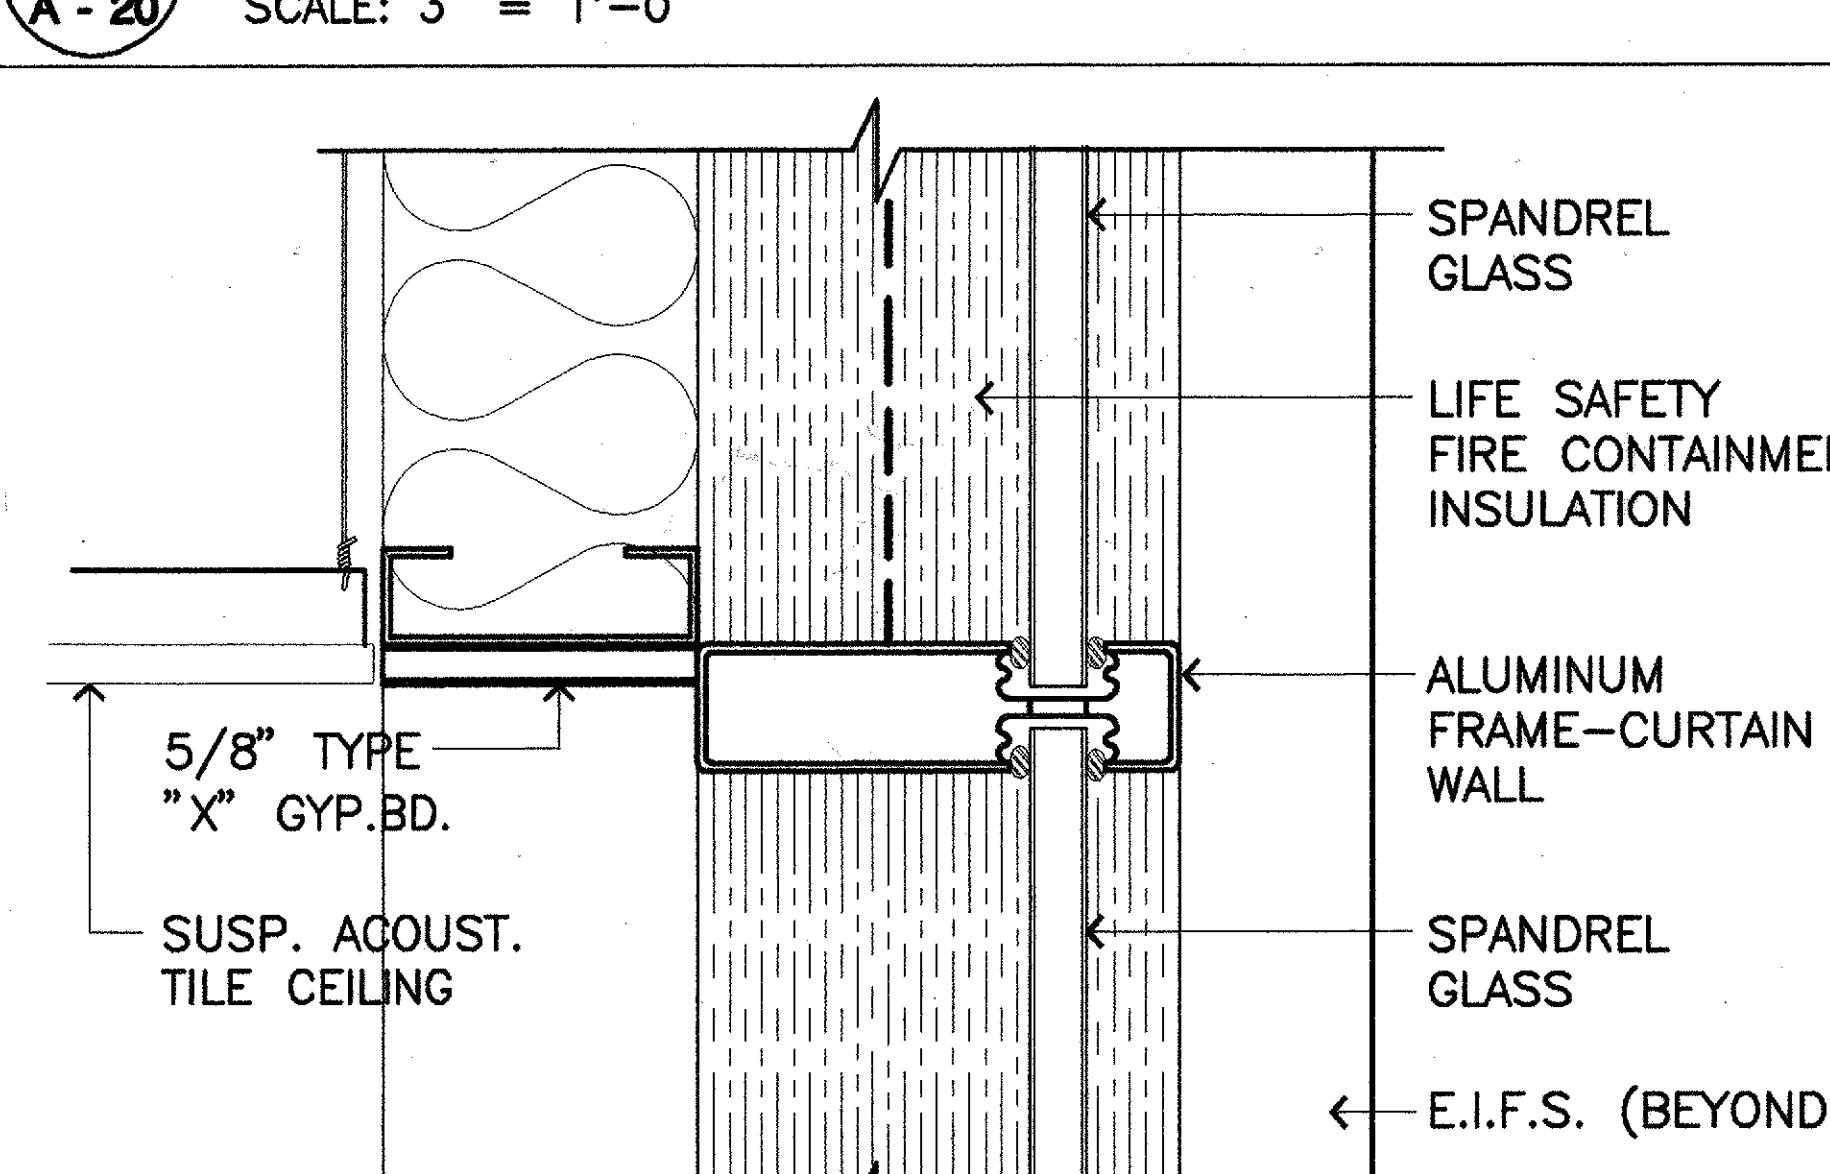


4 INTERMEDIATE HEAD DETAIL
A-20 SCALE: 3" = 1'-0"

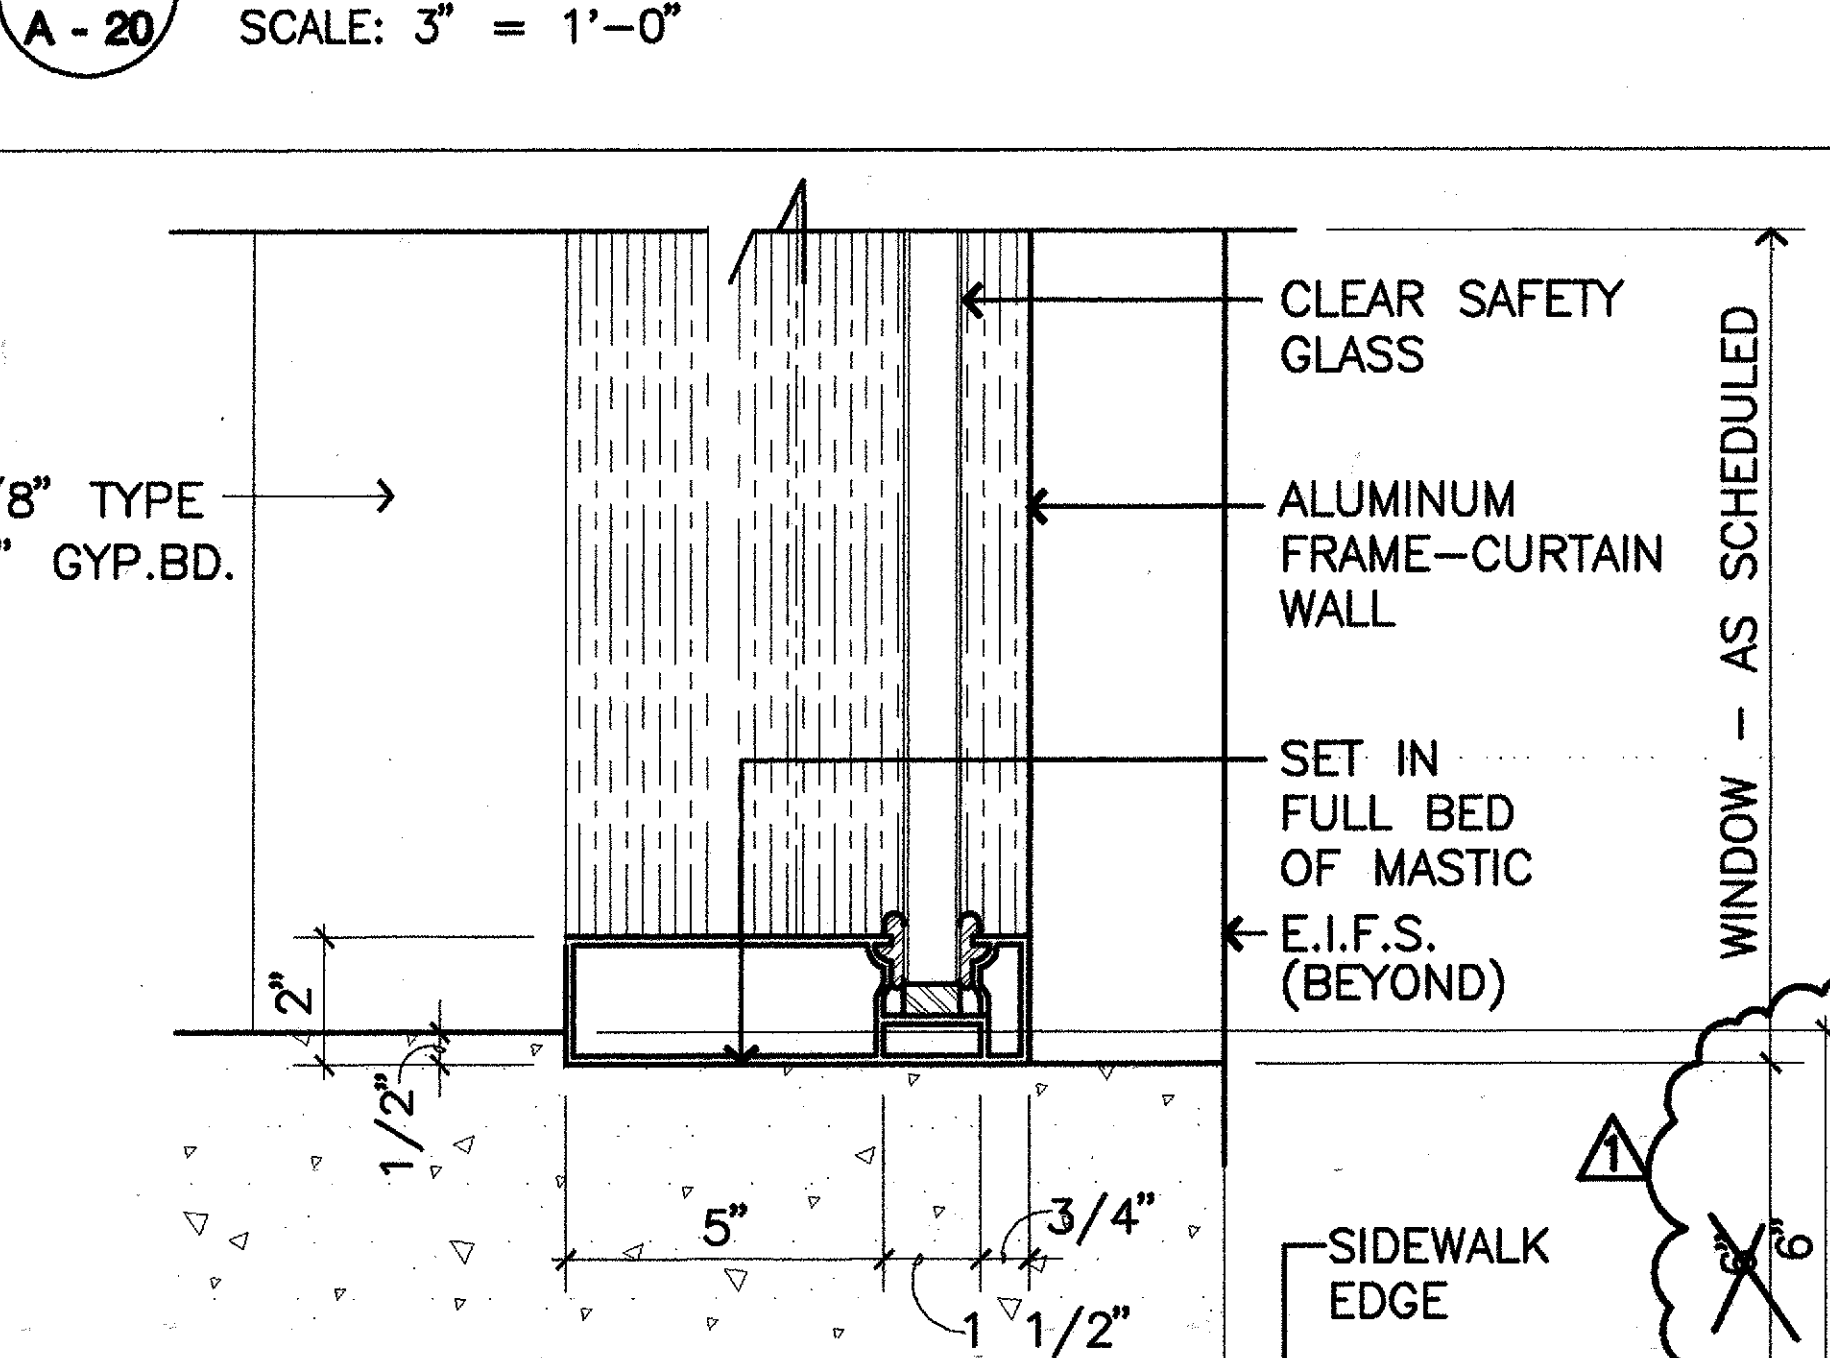


5 SILL DETAIL
A-20 SCALE: 3" = 1'-0"

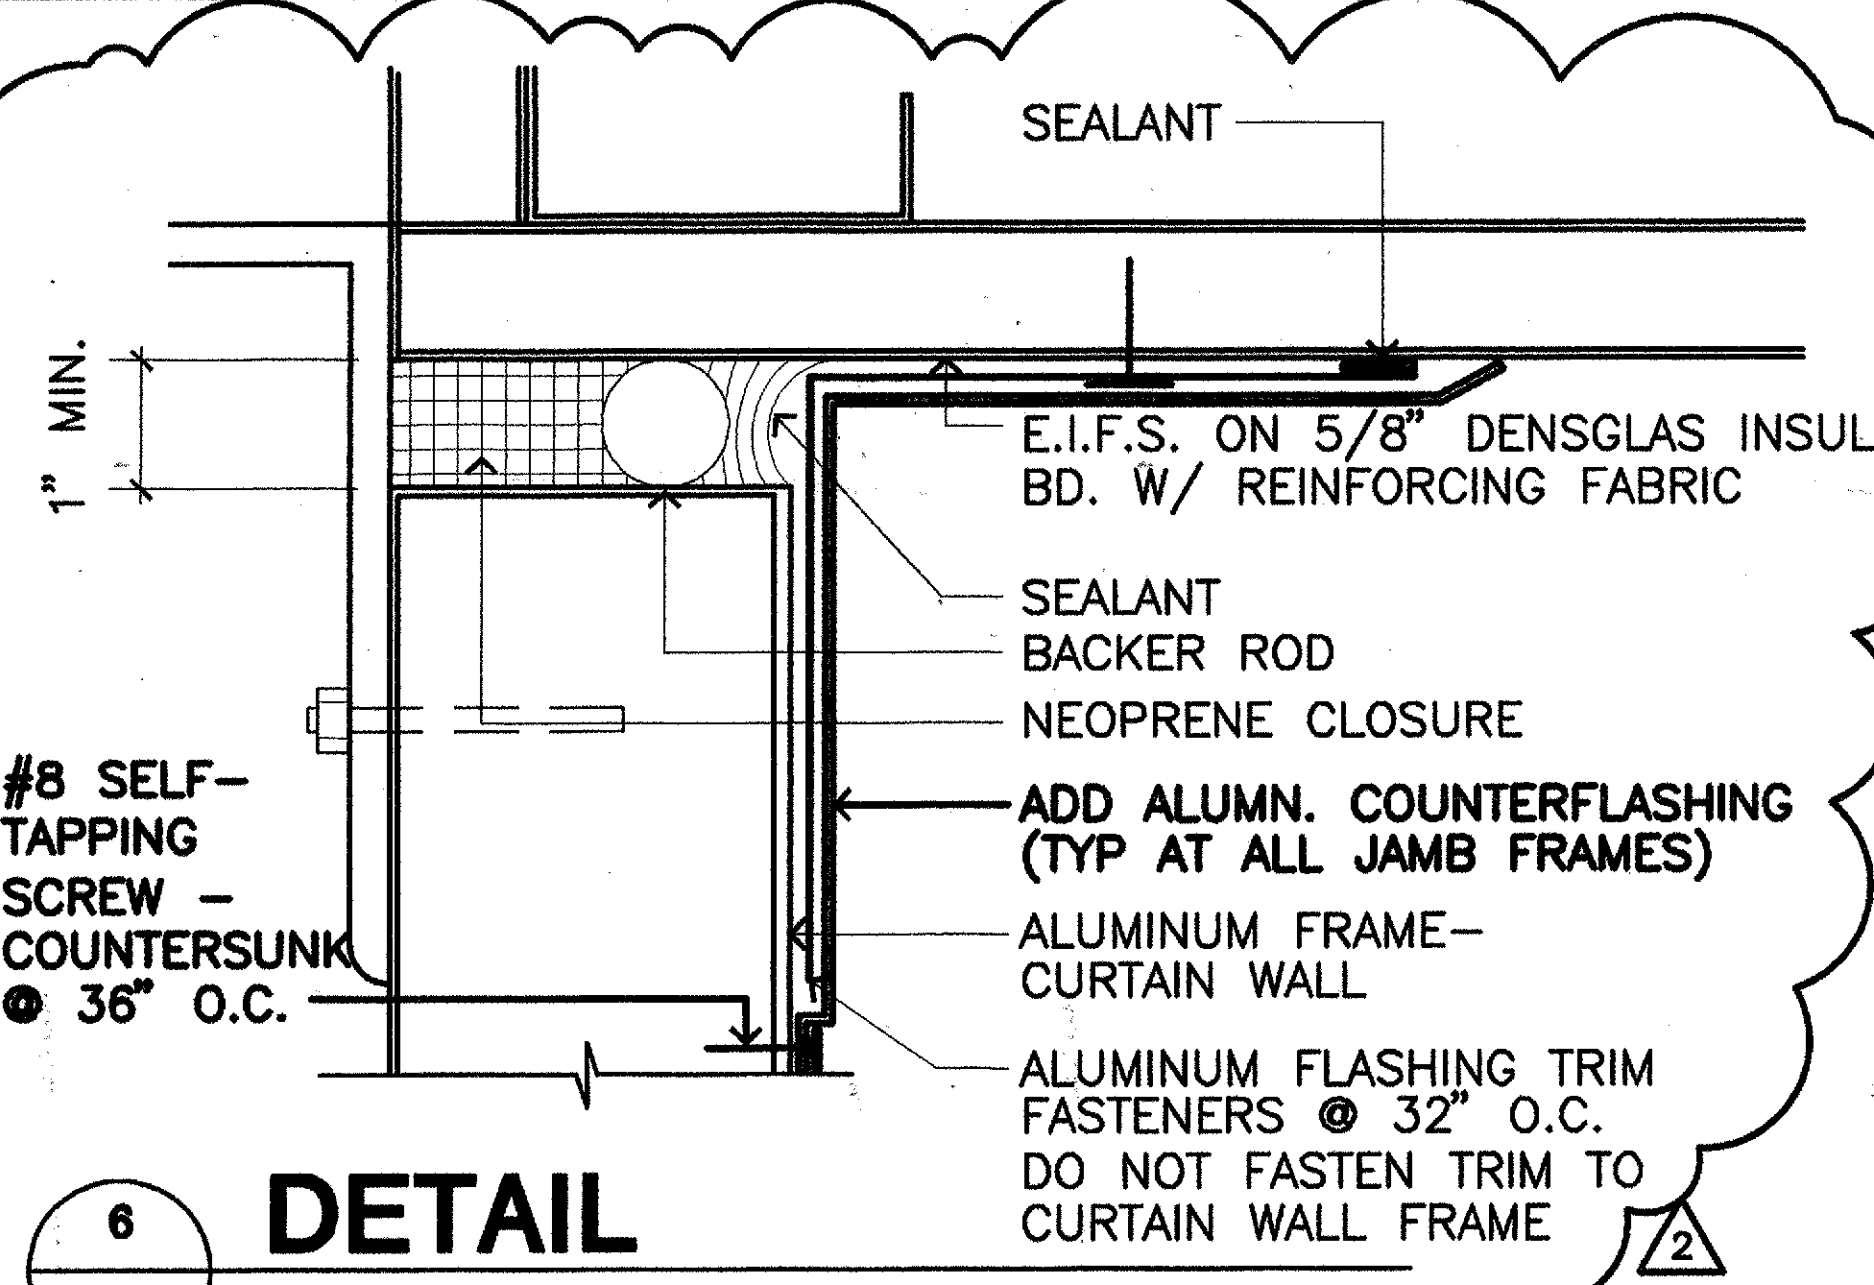


6 DETAIL
A-20 SCALE: FULL

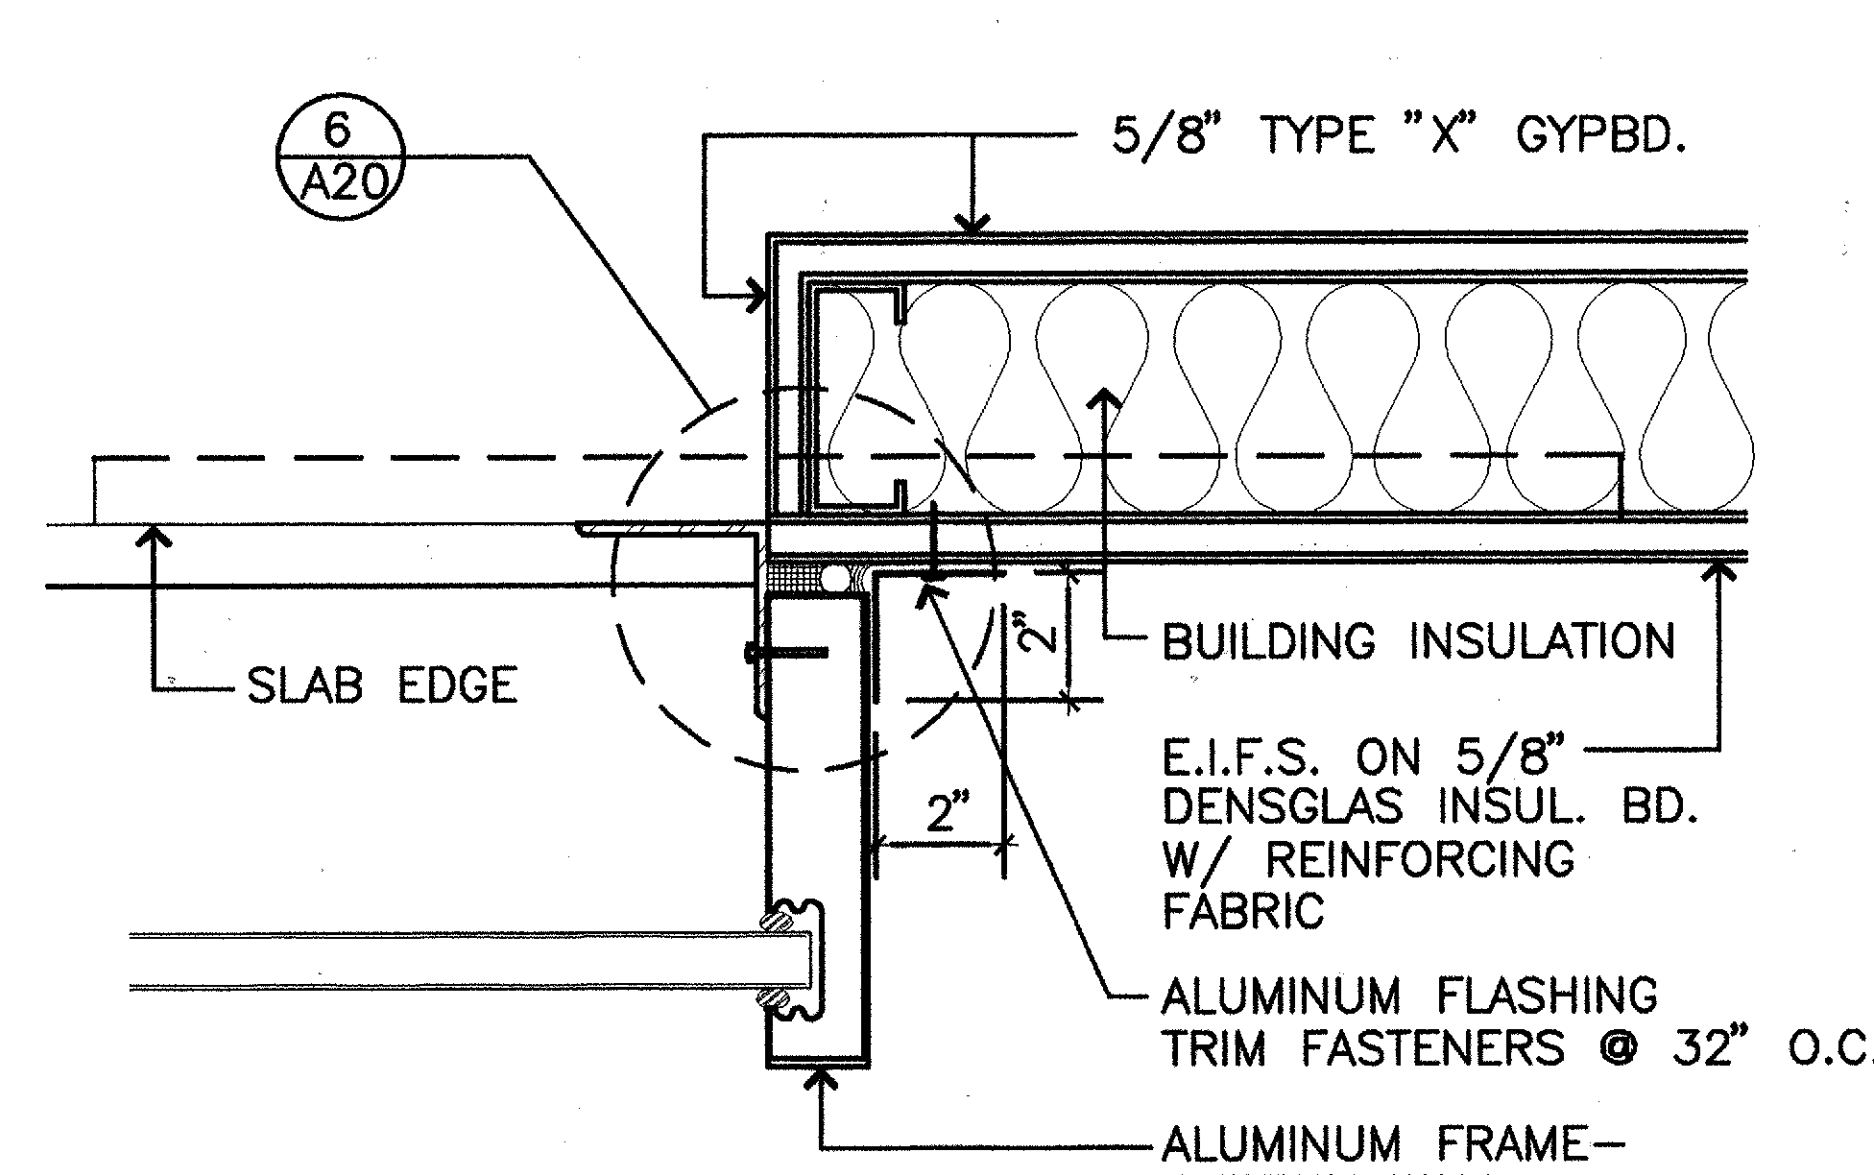


7 TYPICAL JAMB DETAIL
A-20 SCALE: 3" = 1'-0"

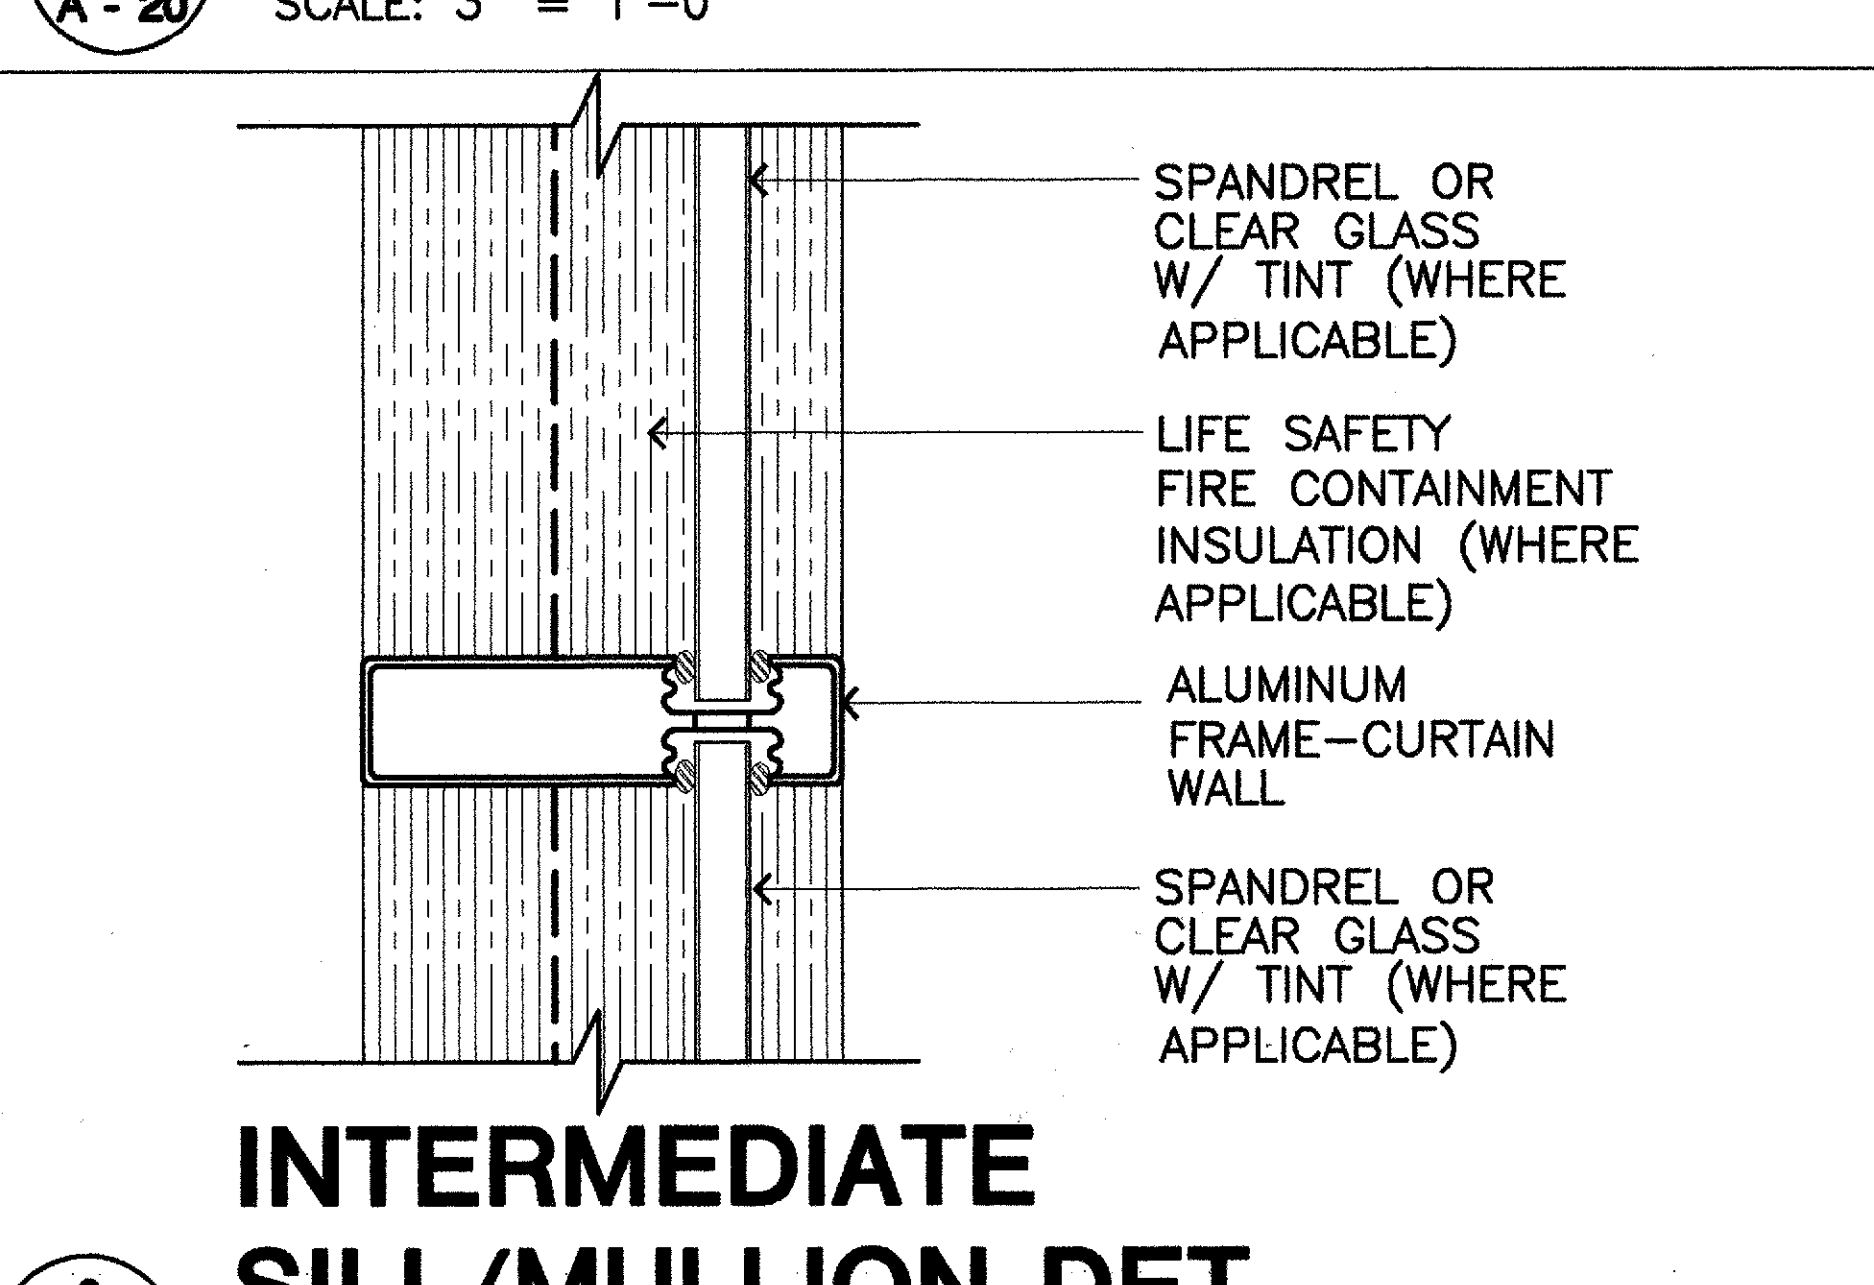


8 INTERMEDIATE SILL/MULLION DET
A-20 SCALE: 3" = 1'-0"

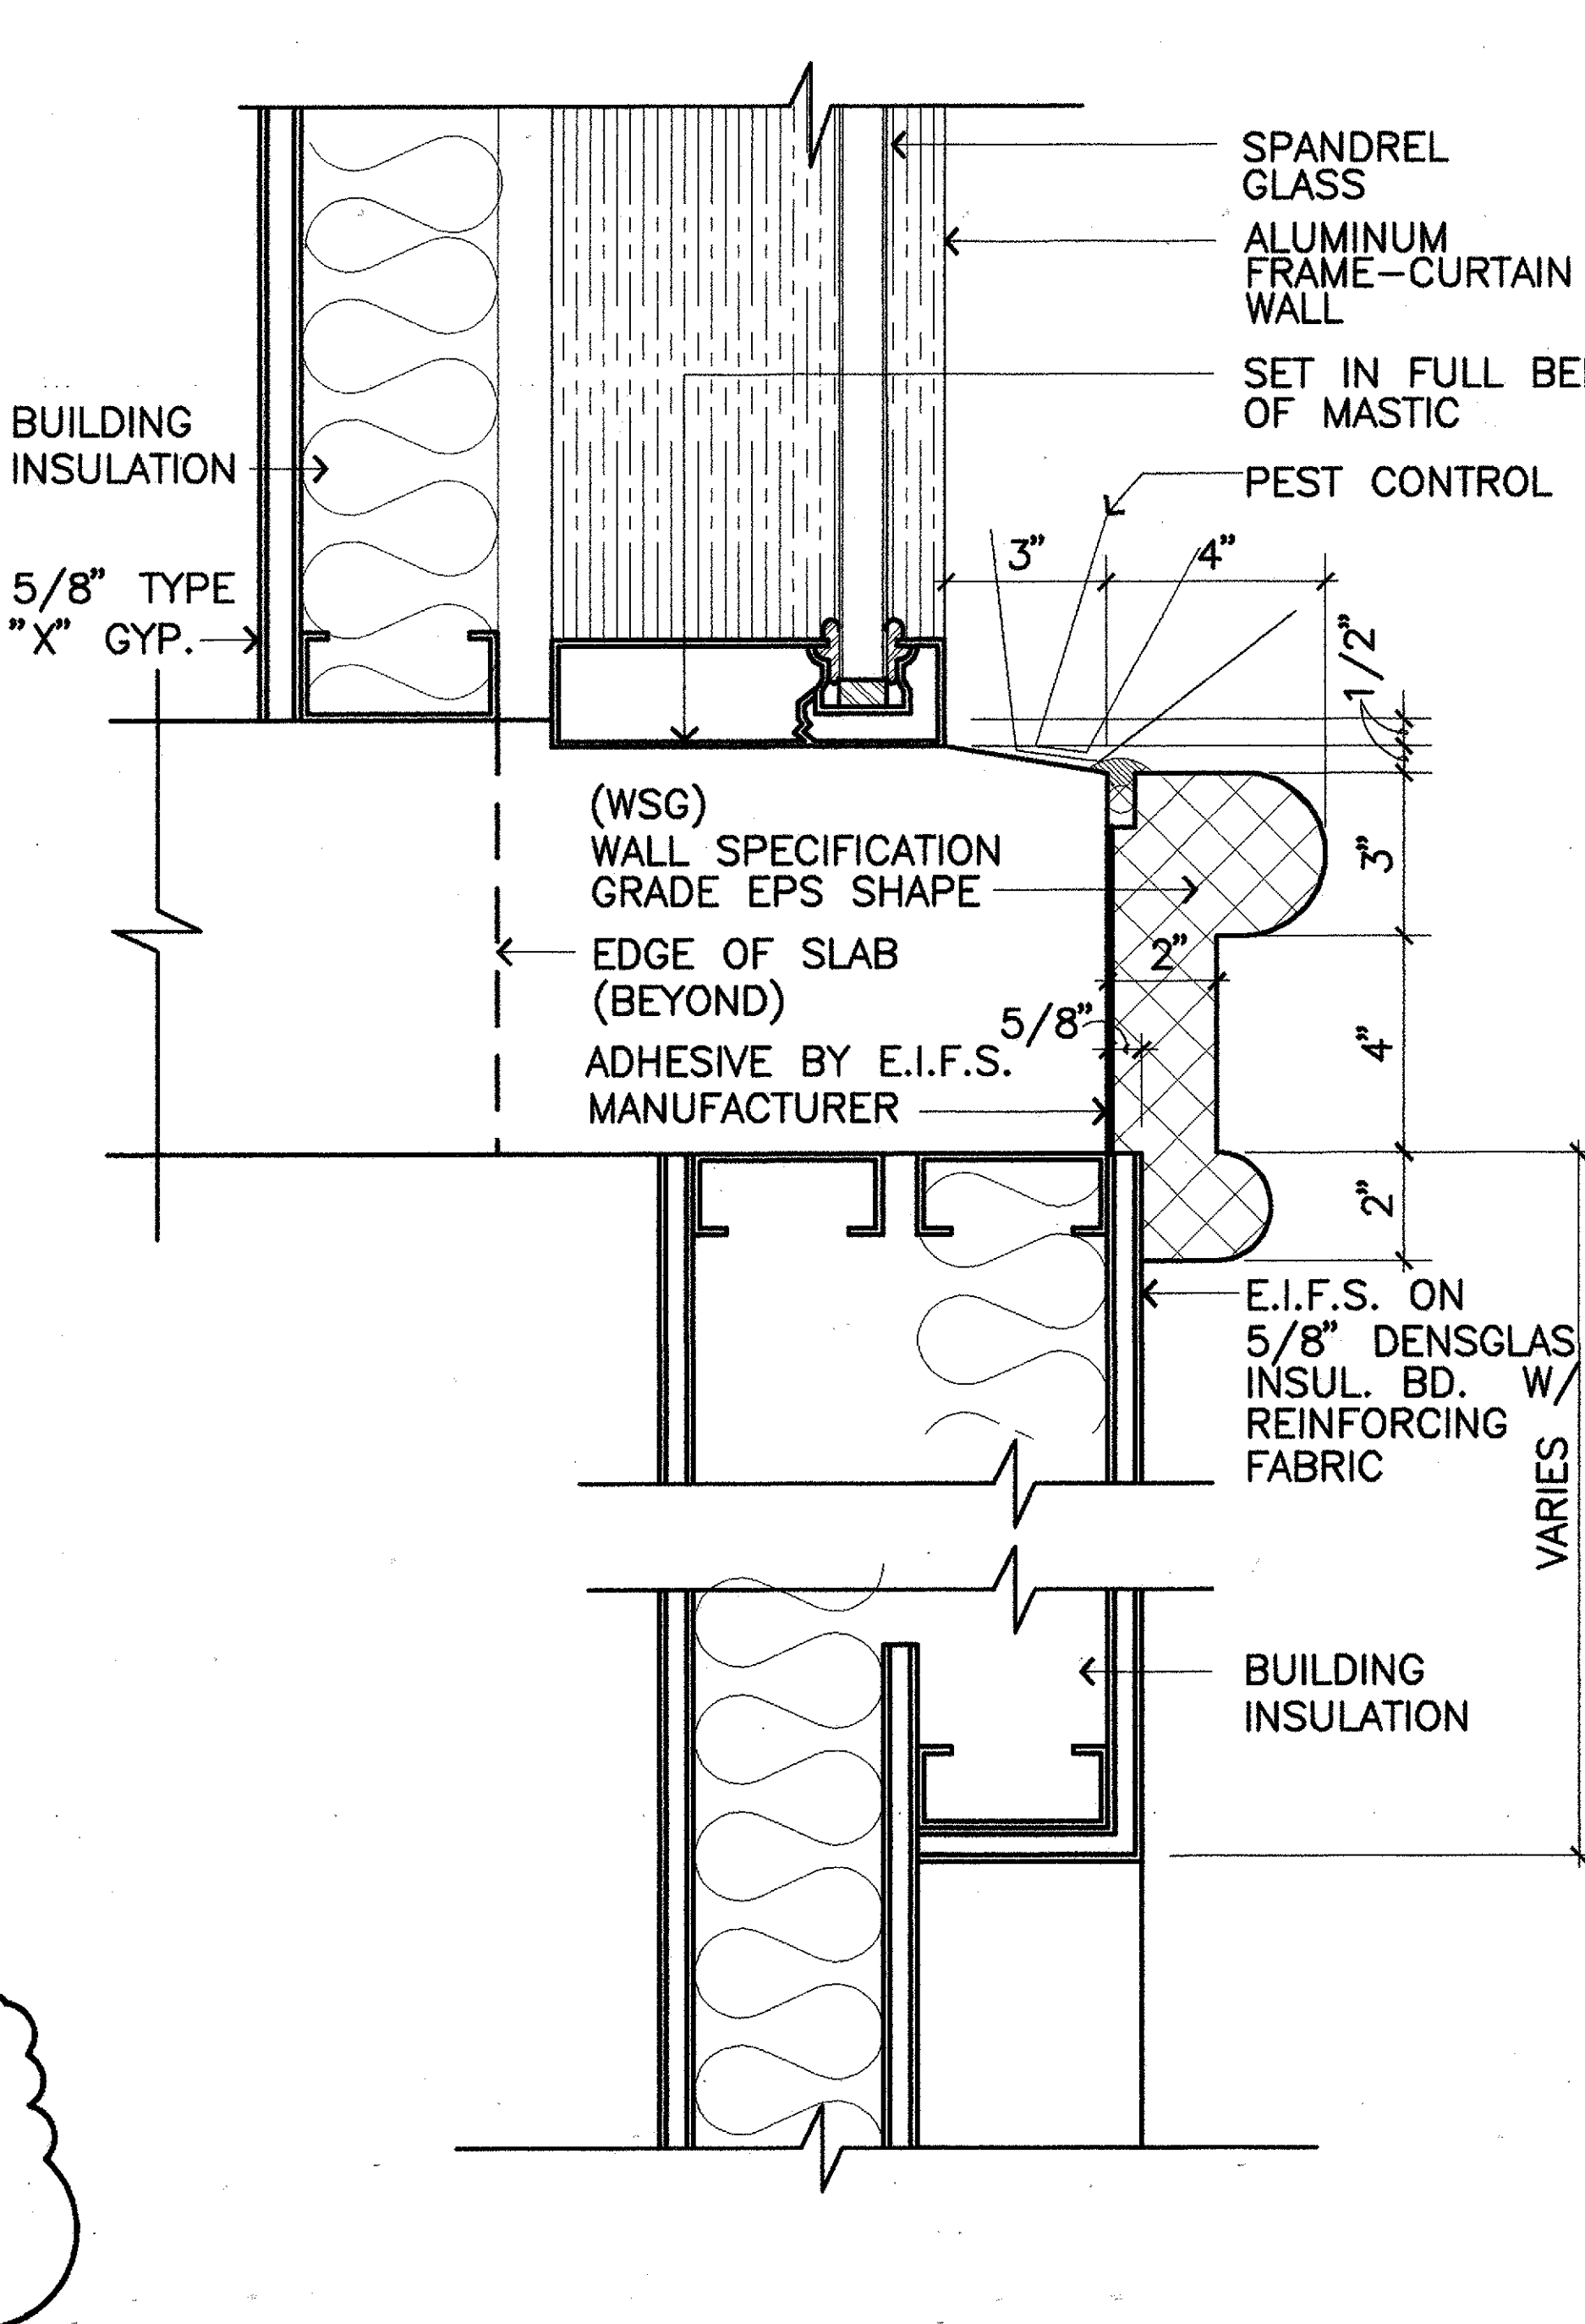


9 SILL DETAIL
A-20 SCALE: 3" = 1'-0"

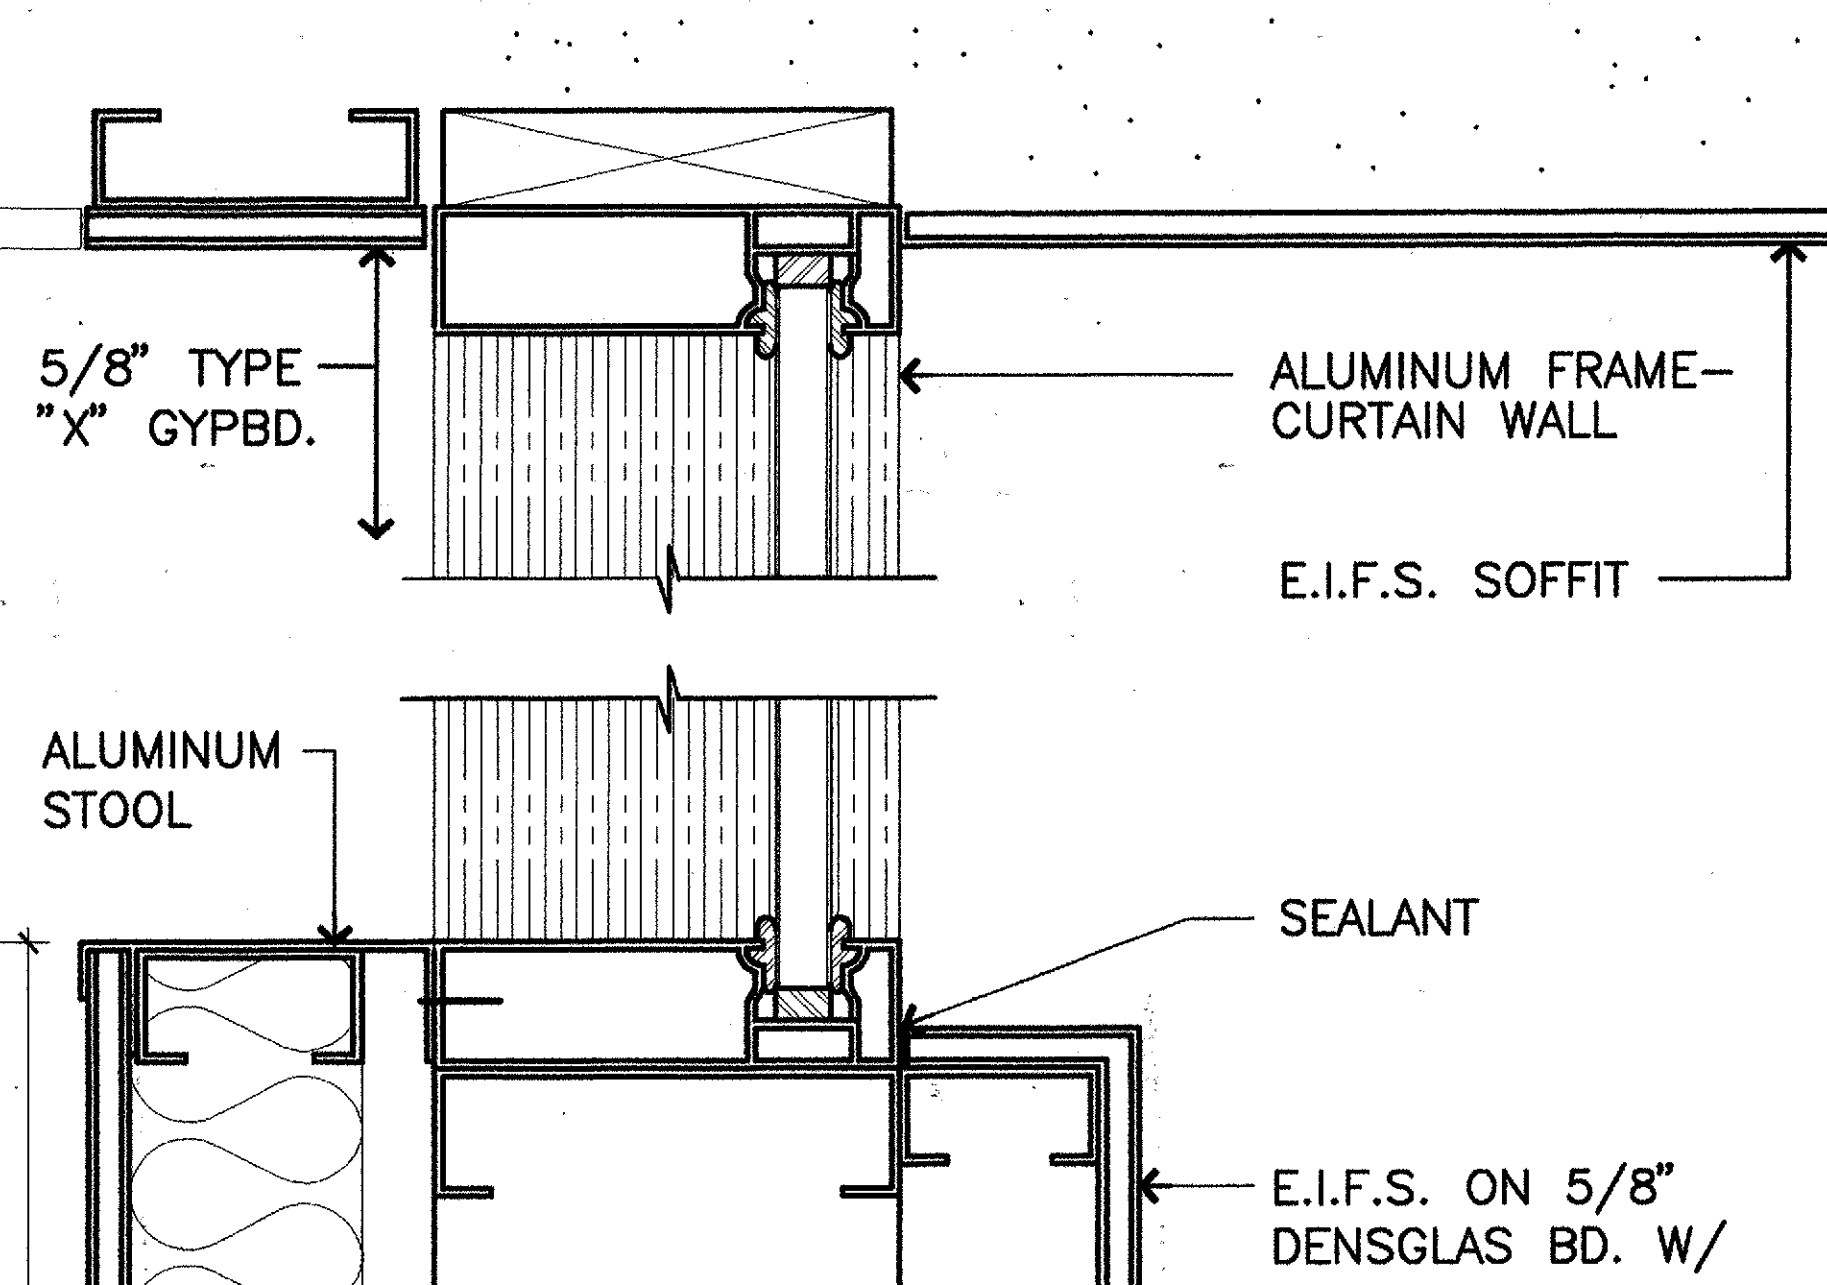


10 WINDOW DETAIL
A-20 SCALE: 3" = 1'-0"

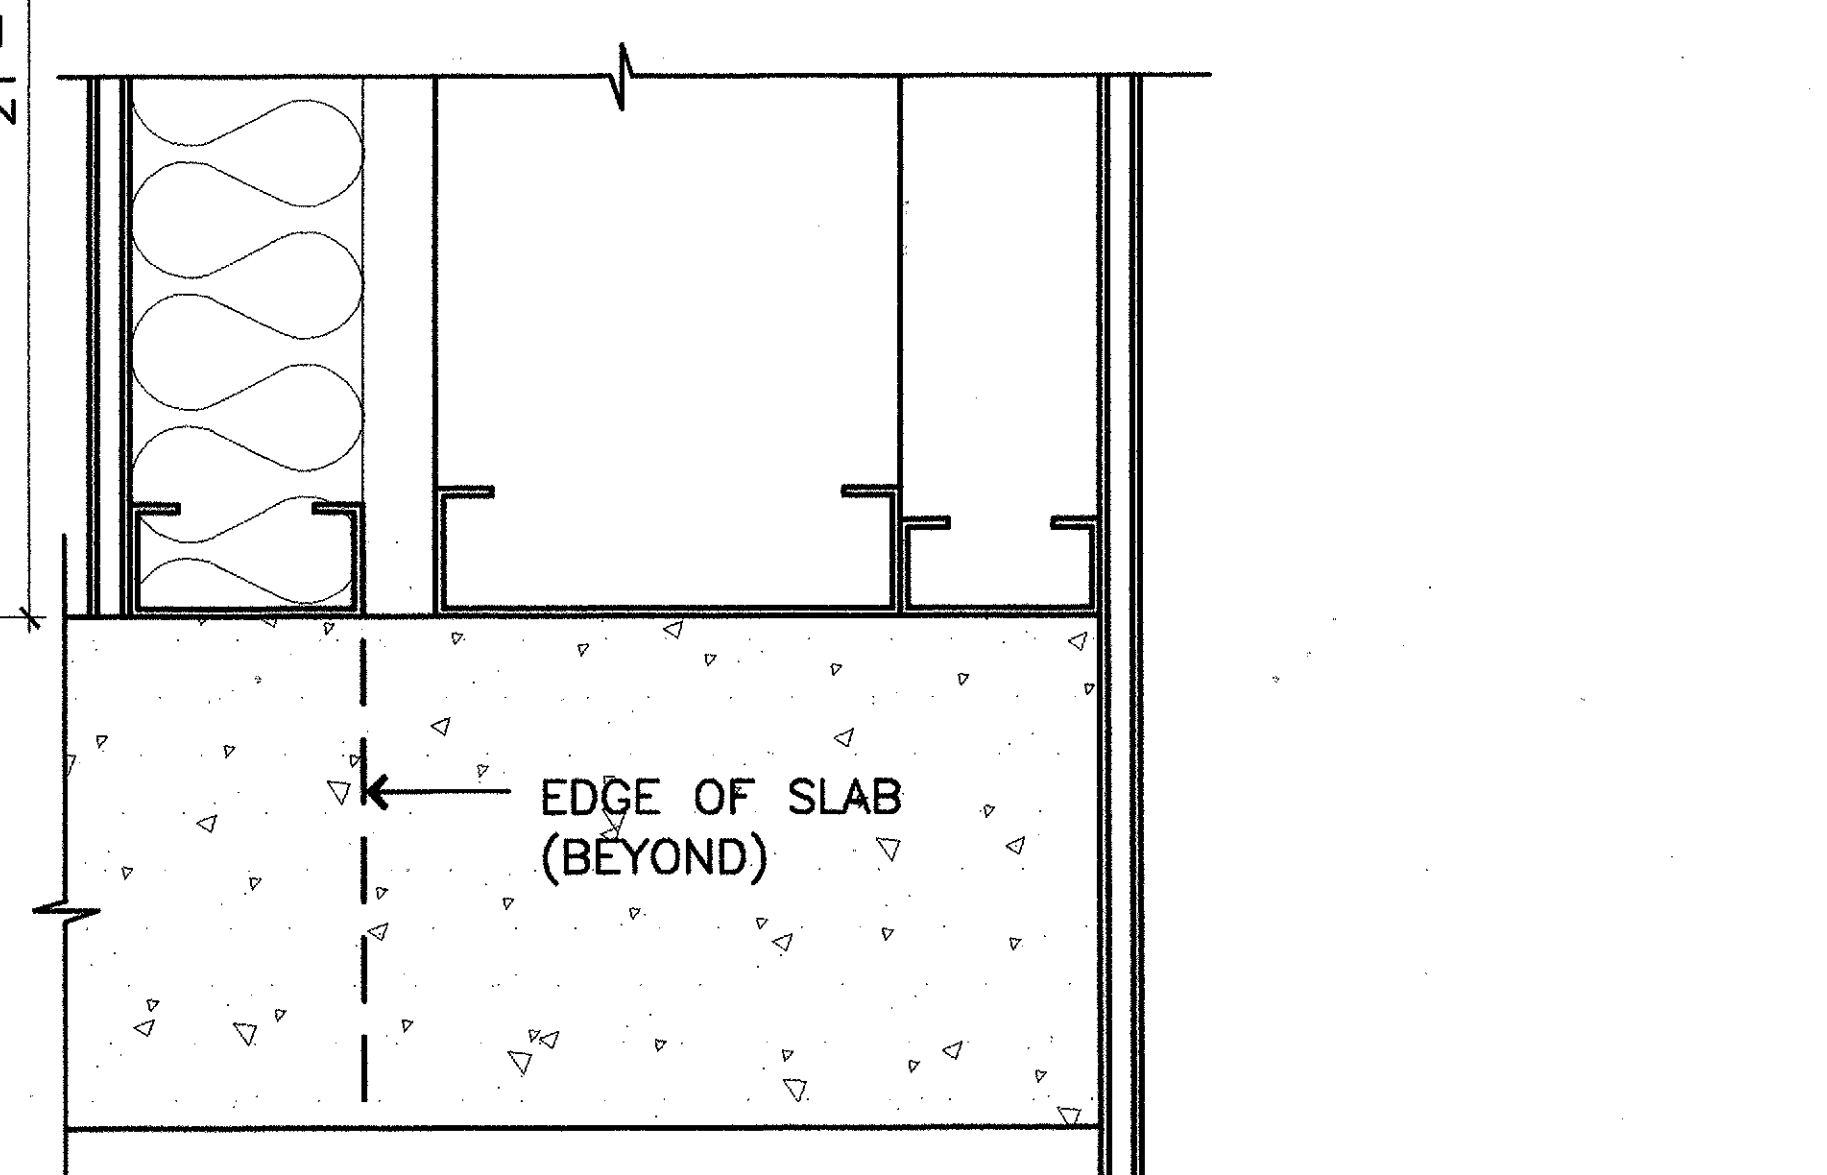


11 HEAD DETAIL
A-20 SCALE: 3" = 1'-0"

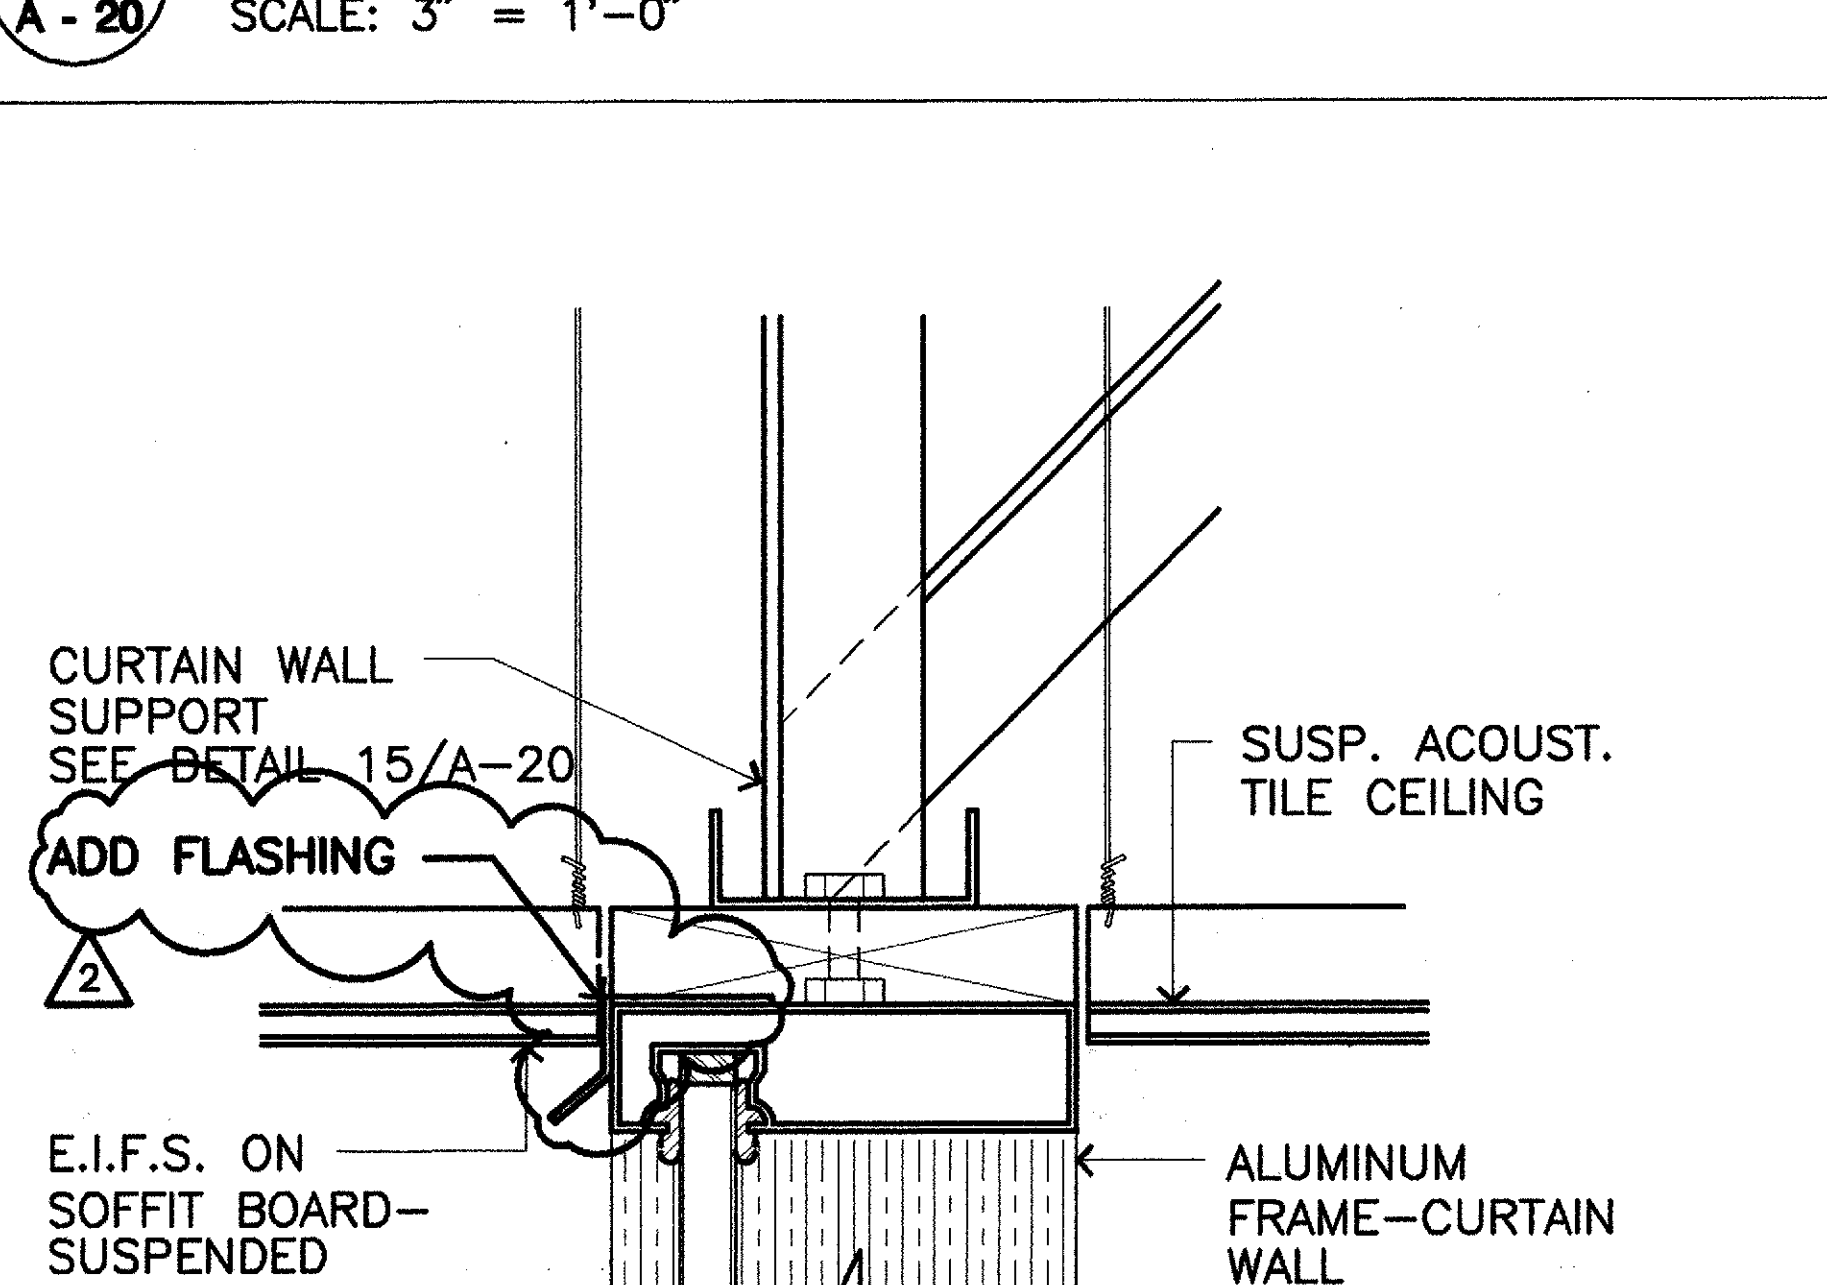


12 SILL DETAIL
A-20 SCALE: 3" = 1'-0"

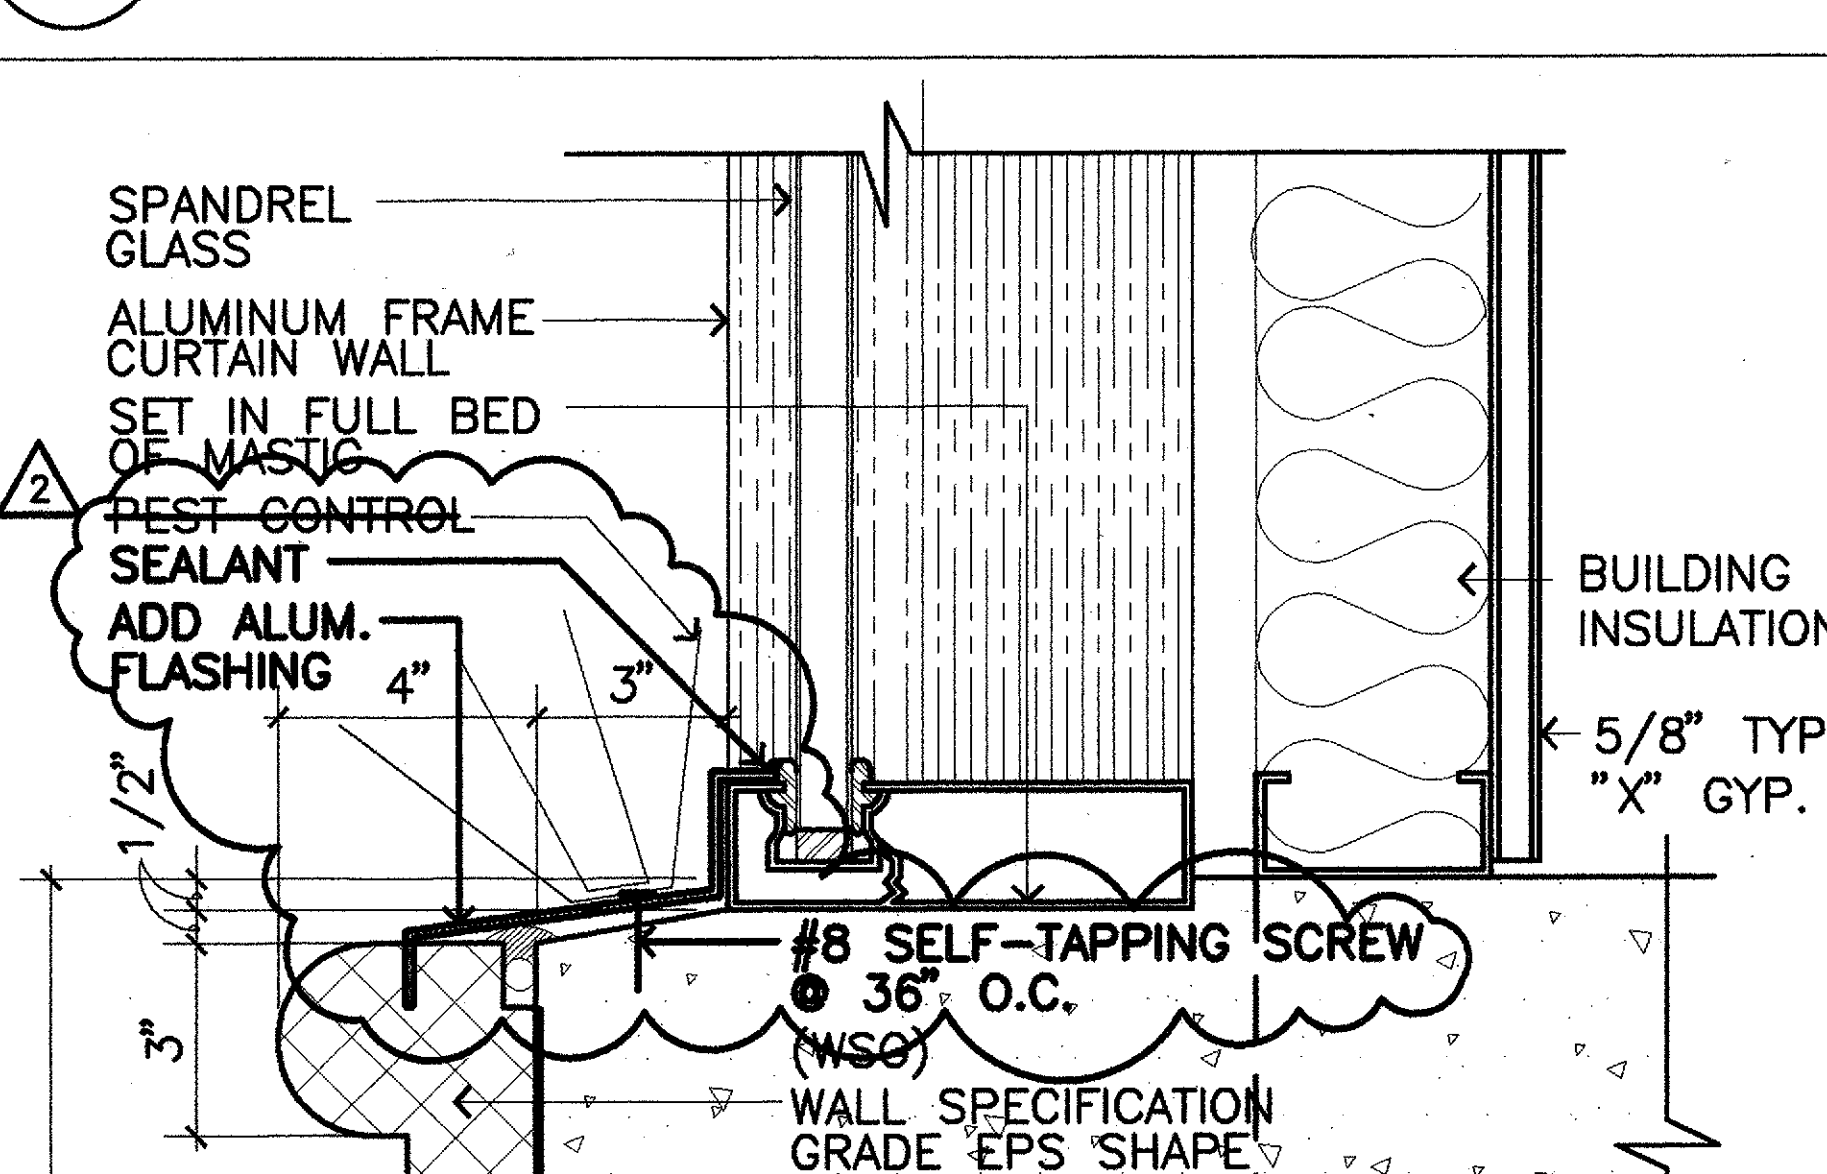


13 HEAD DETAIL
A-20 SCALE: 3" = 1'-0"

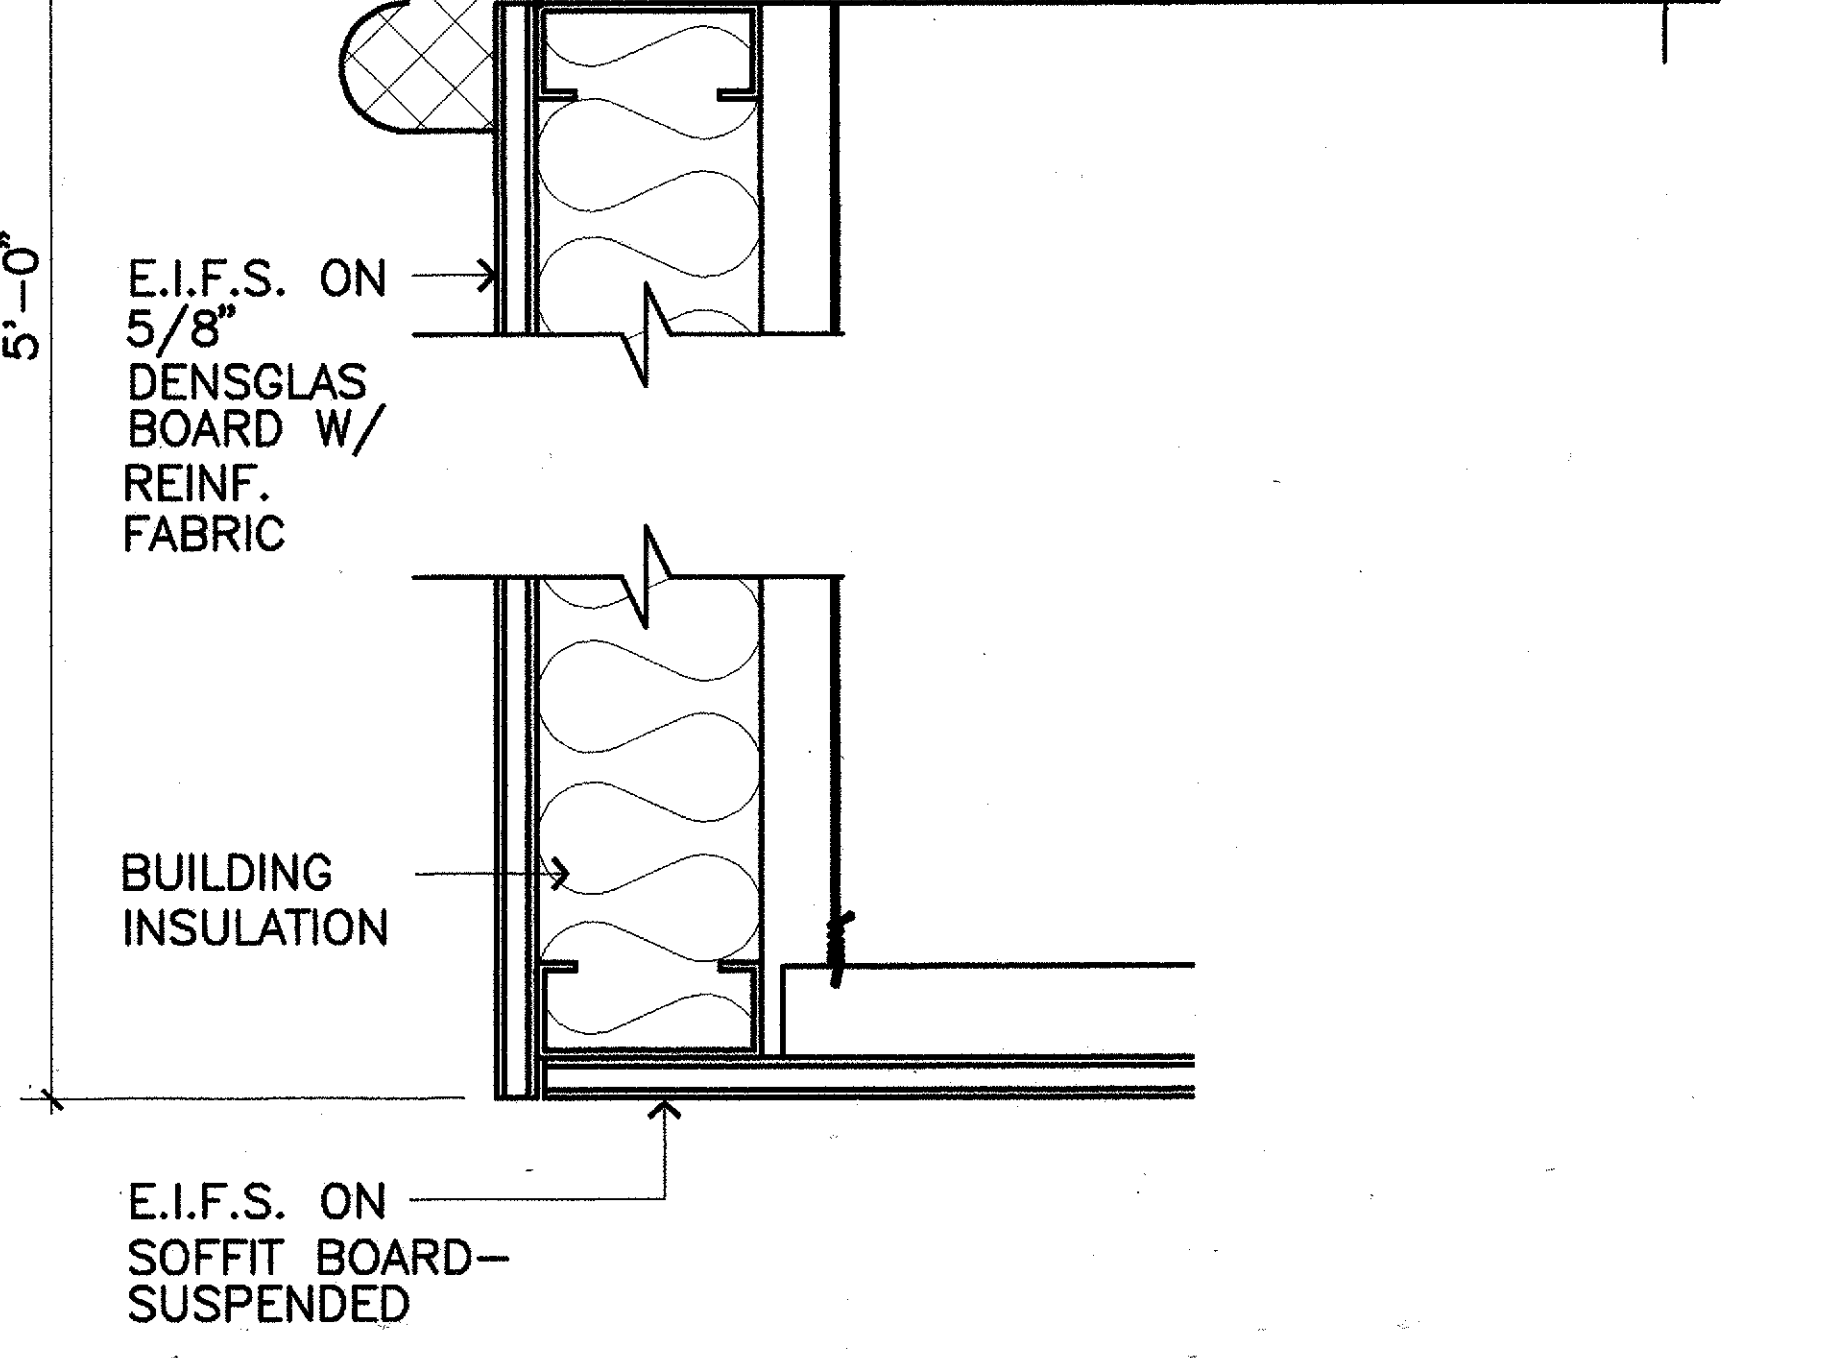


14 WINDOW DETAIL
A-20 SCALE: 3" = 1'-0"

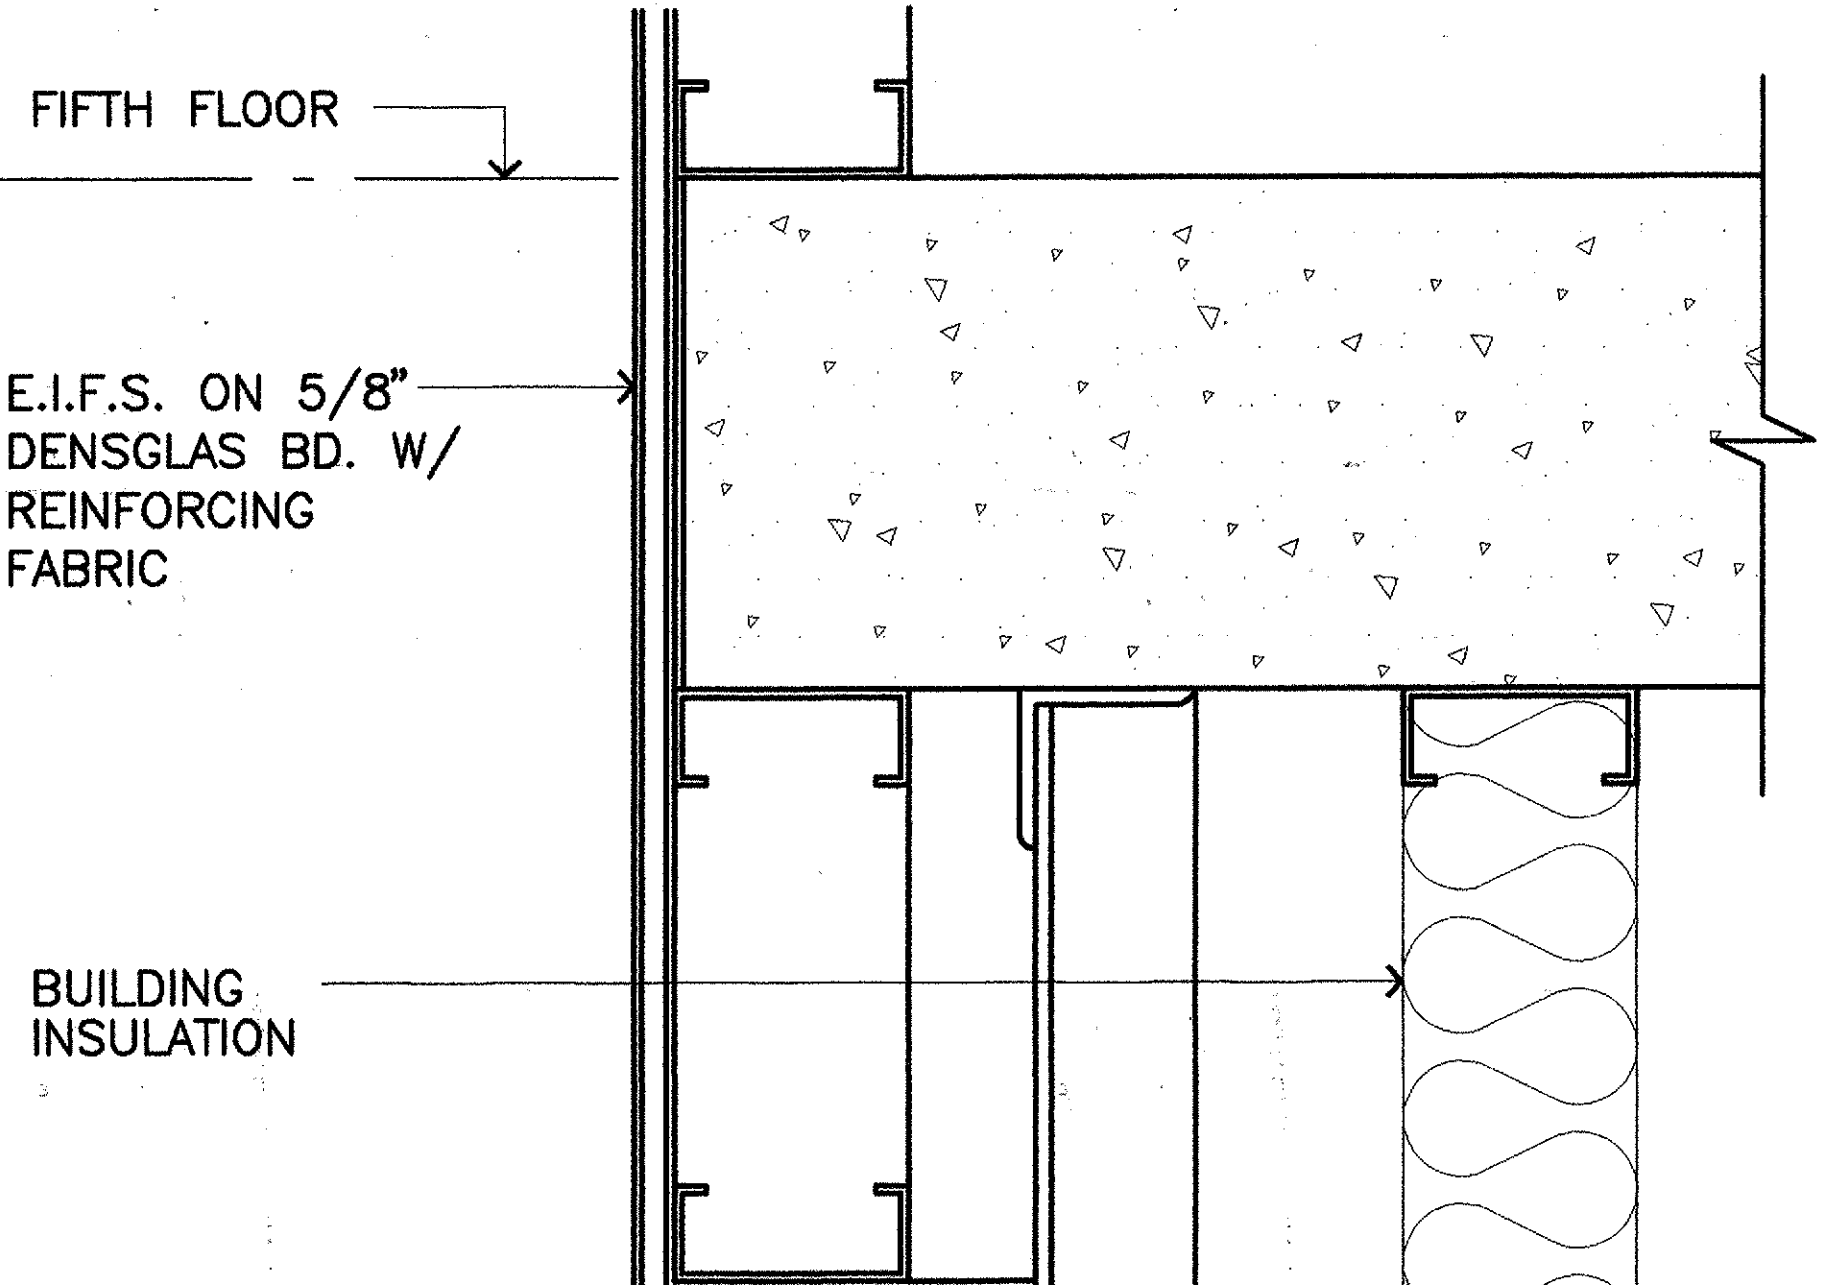


15 HEAD DETAIL
A-20 SCALE: 3" = 1'-0"

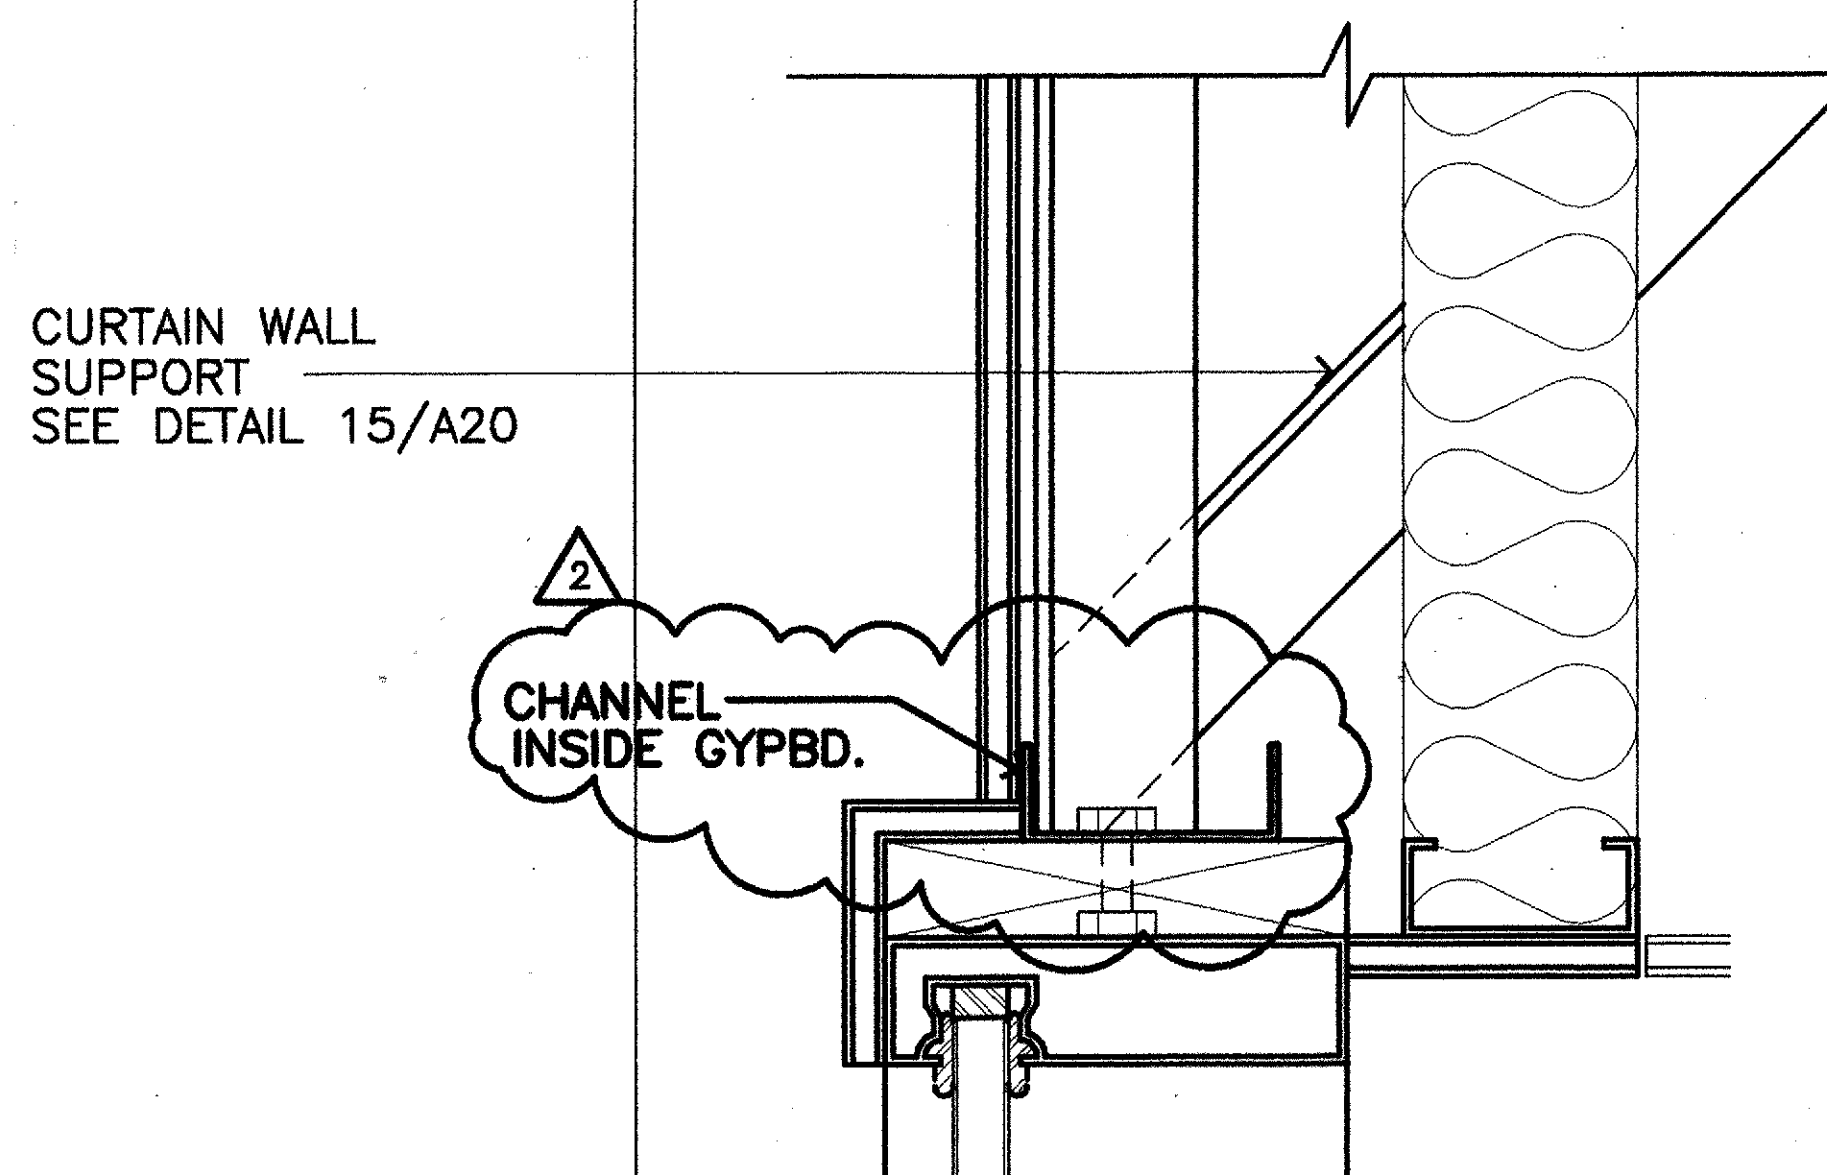


16 DR. HEAD DET.
A-20 SCALE: 3" = 1'-0"

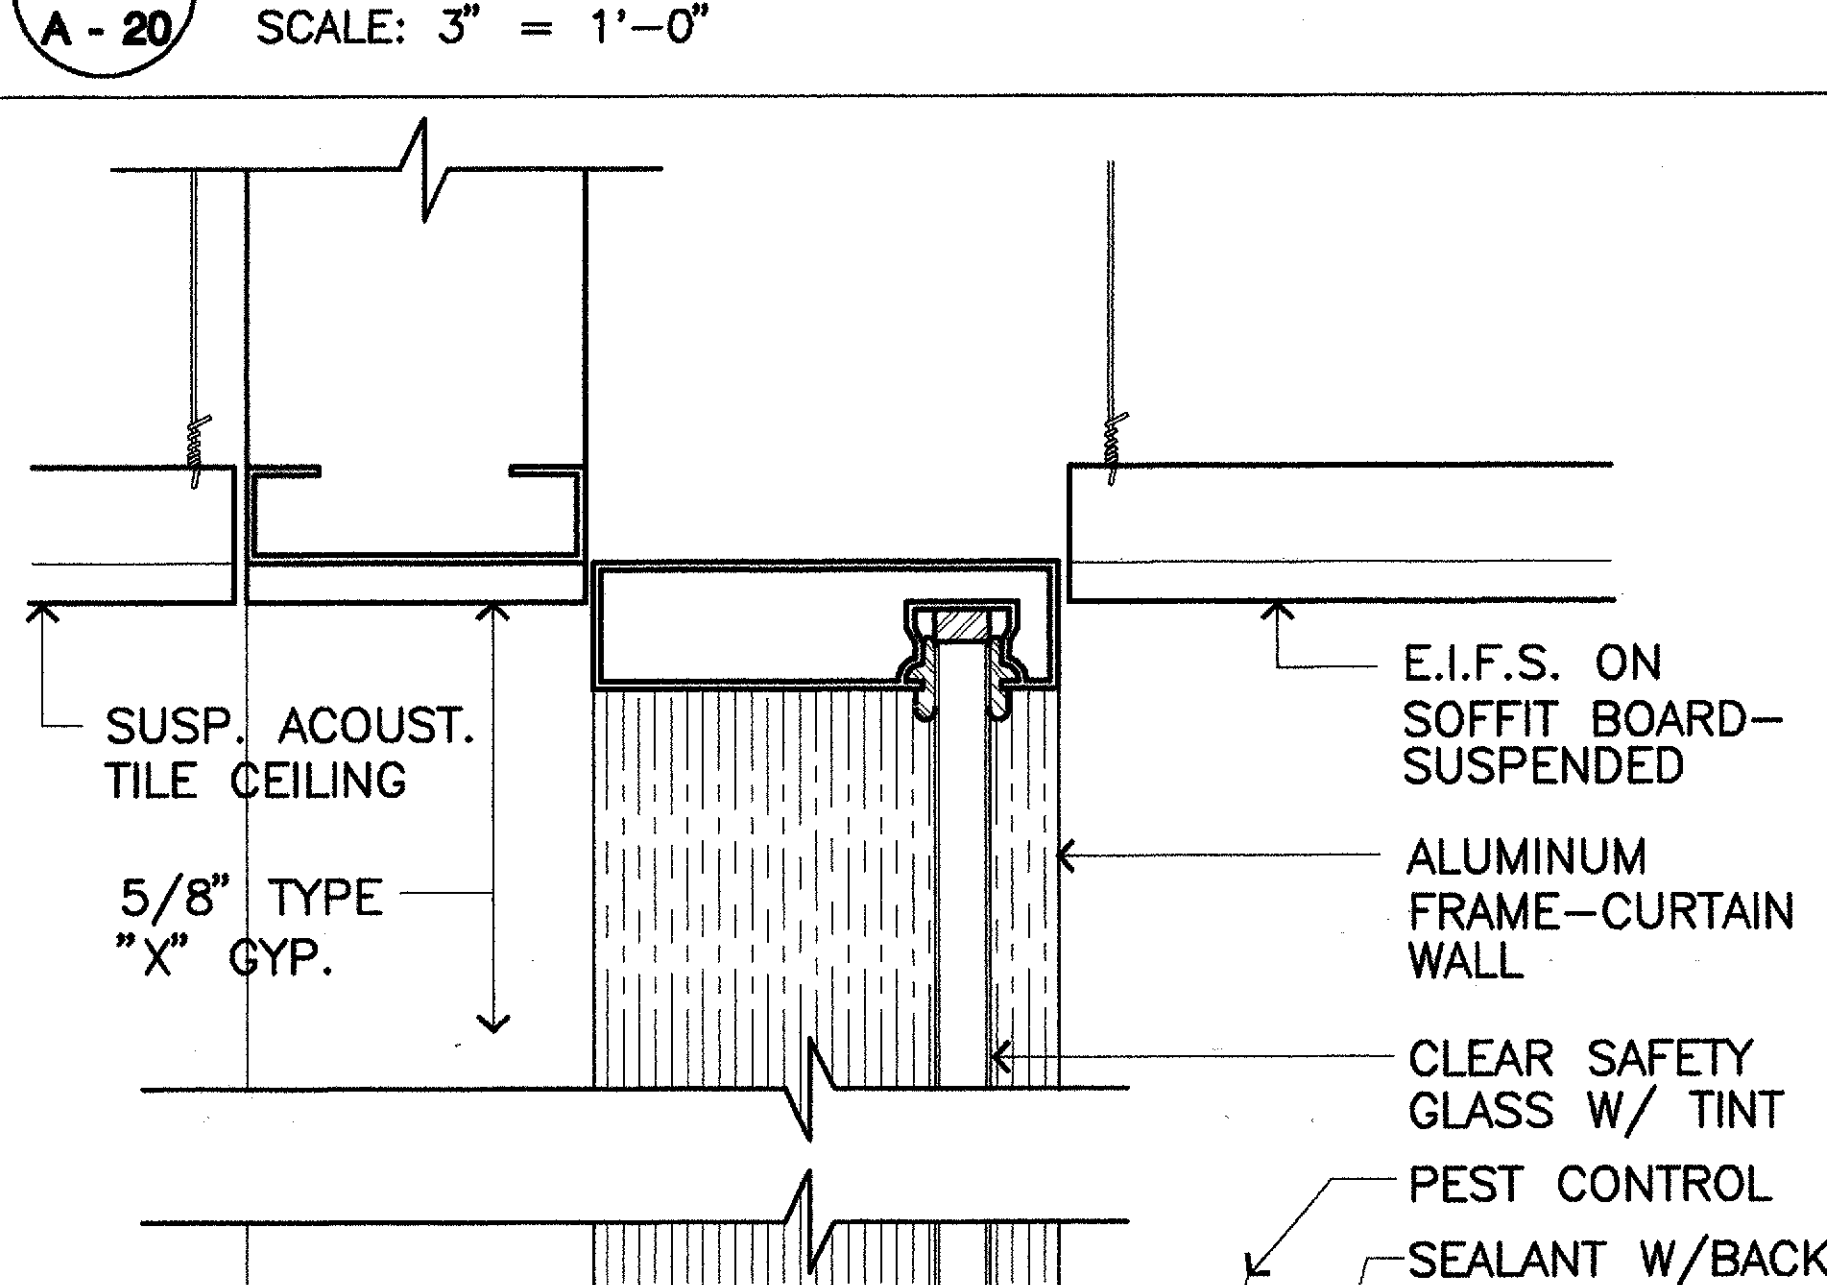


17 DR. JAMB DET.
A-20 SCALE: 3" = 1'-0"

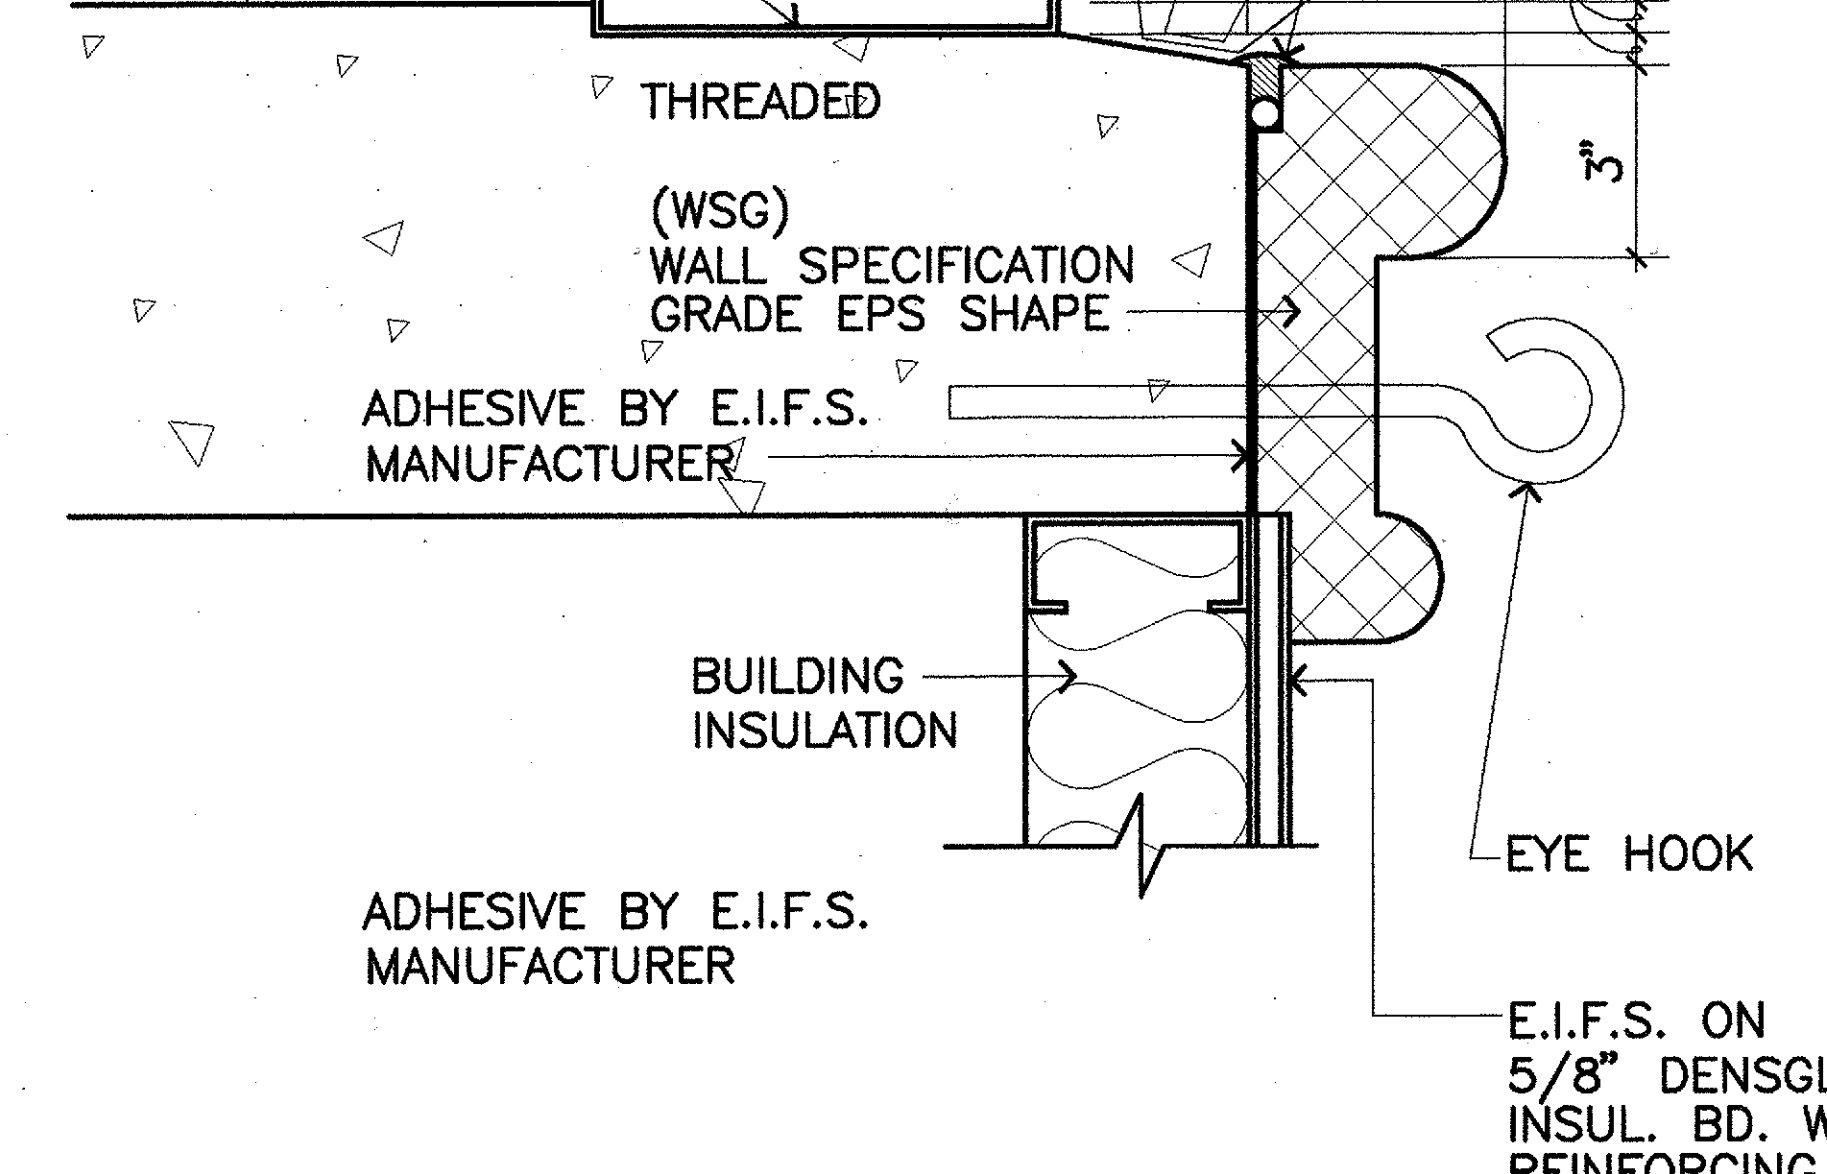


18 STAIRWELL DR. CURB DET
A-20 SCALE: 3" = 1'-0"

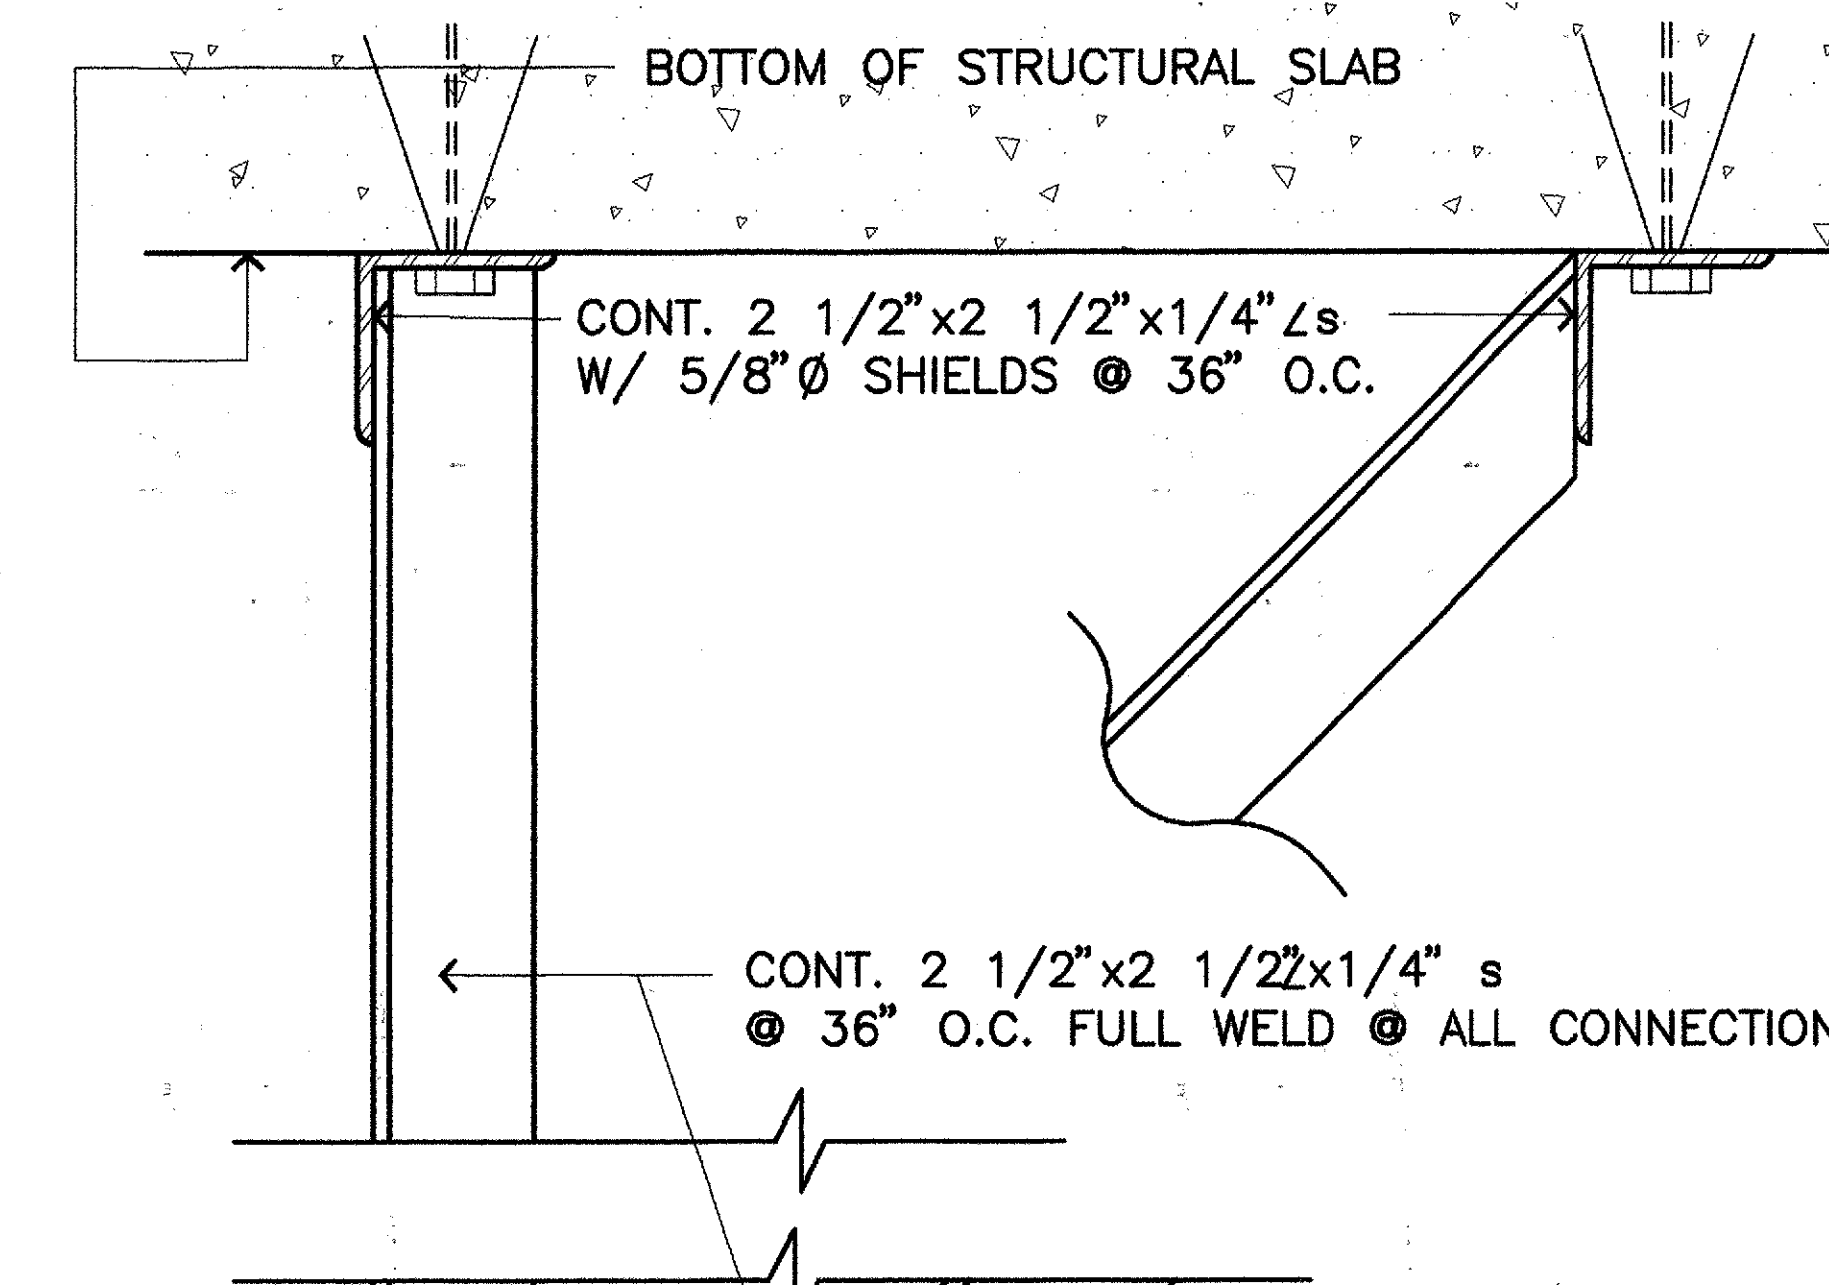


19 CURTAIN WALL SUPPORT DET
A-20 SCALE: 3" = 1'-0"

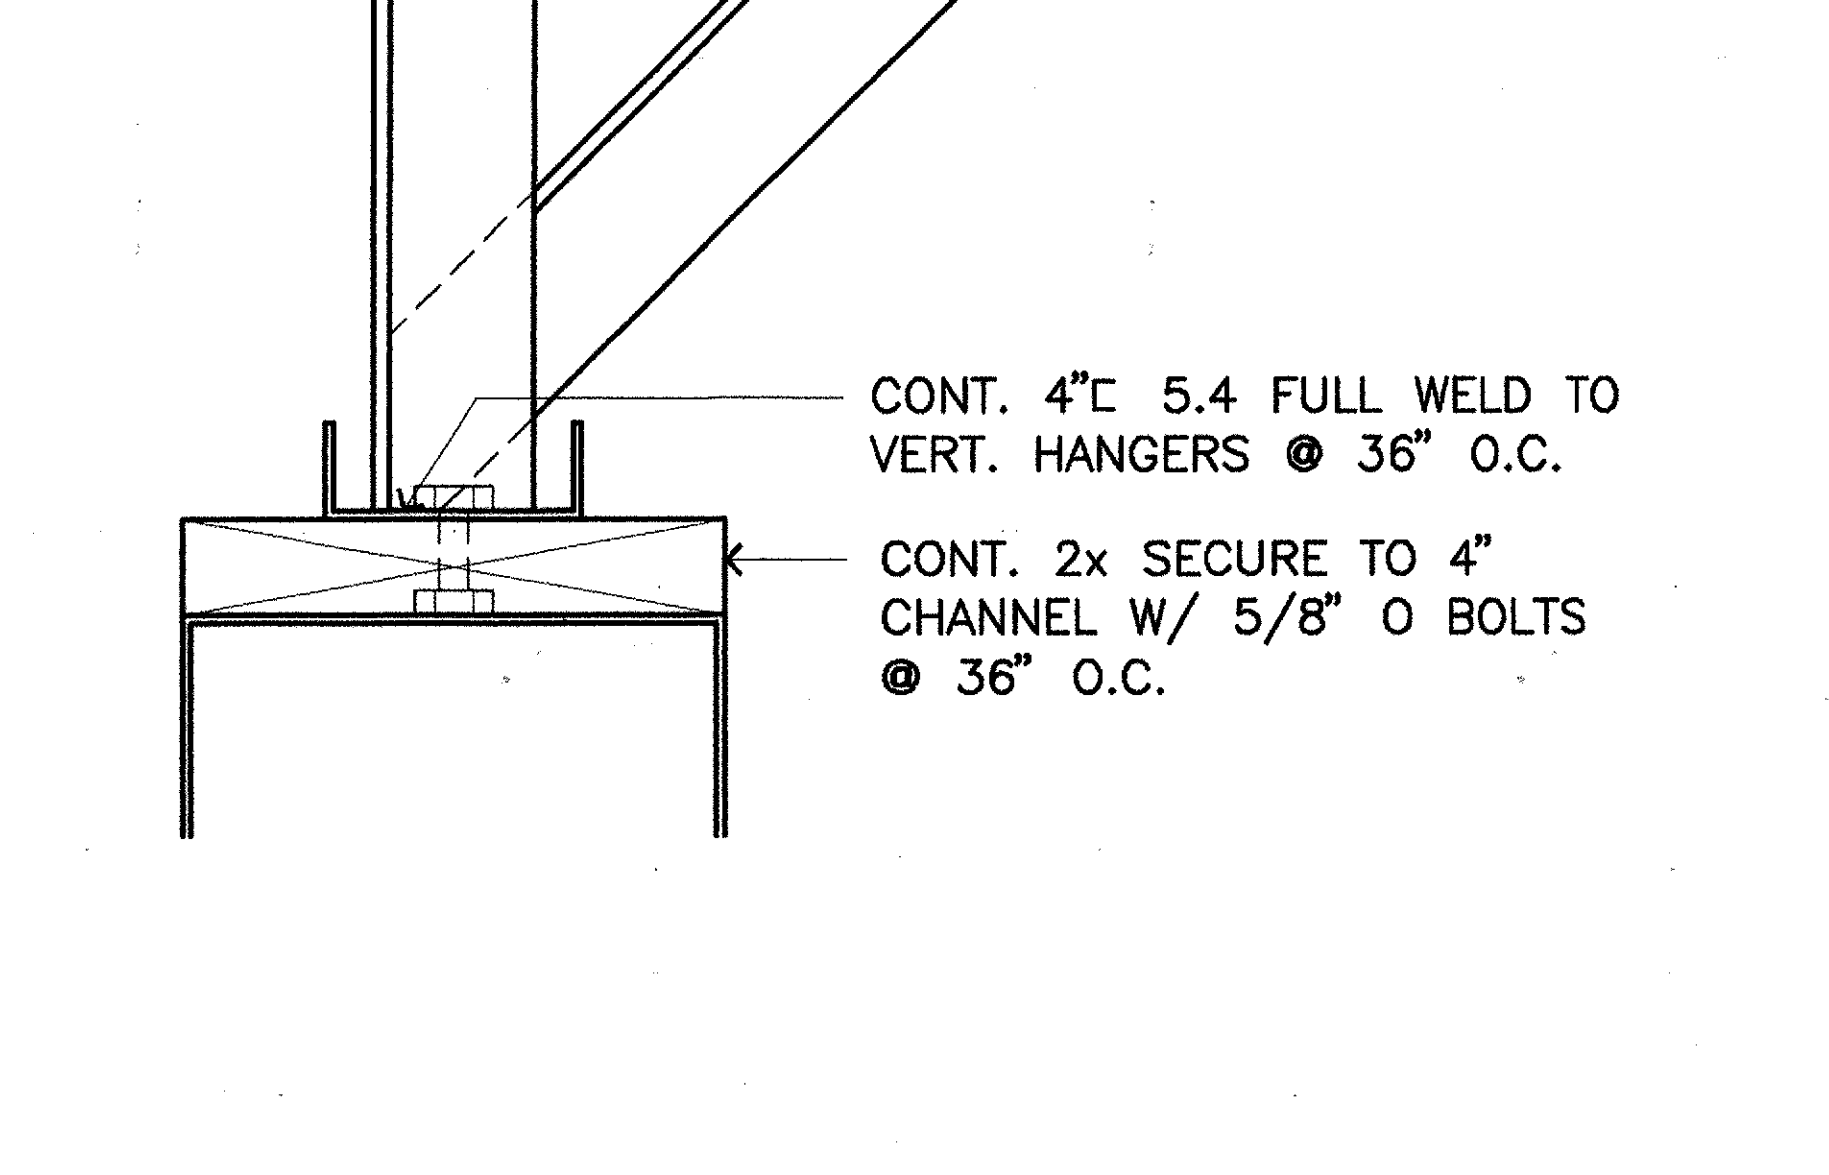


20 WINDOW DETAIL
A-20 SCALE: 3" = 1'-0"

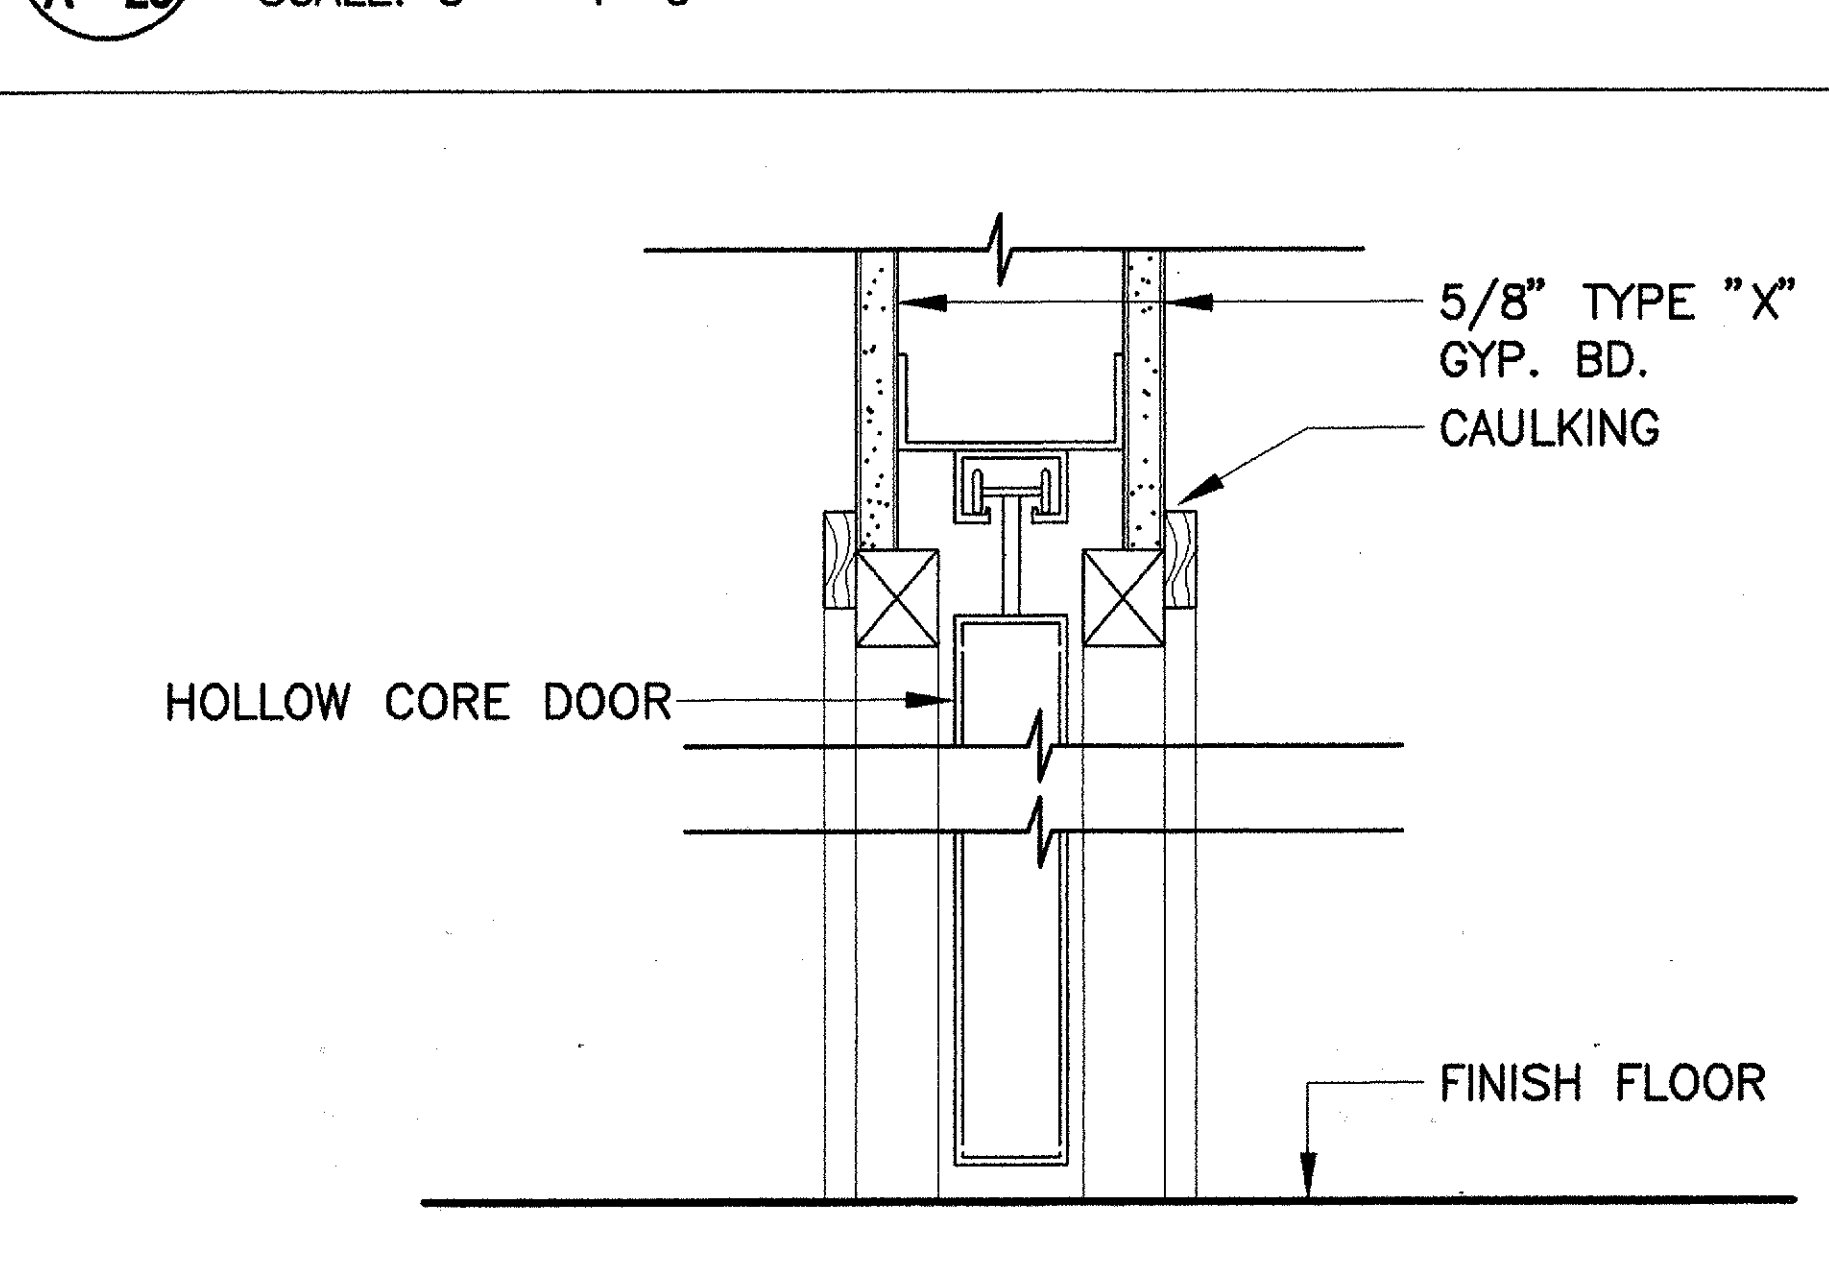


21 WINDOW DETAIL
A-20 SCALE: 3" = 1'-0"

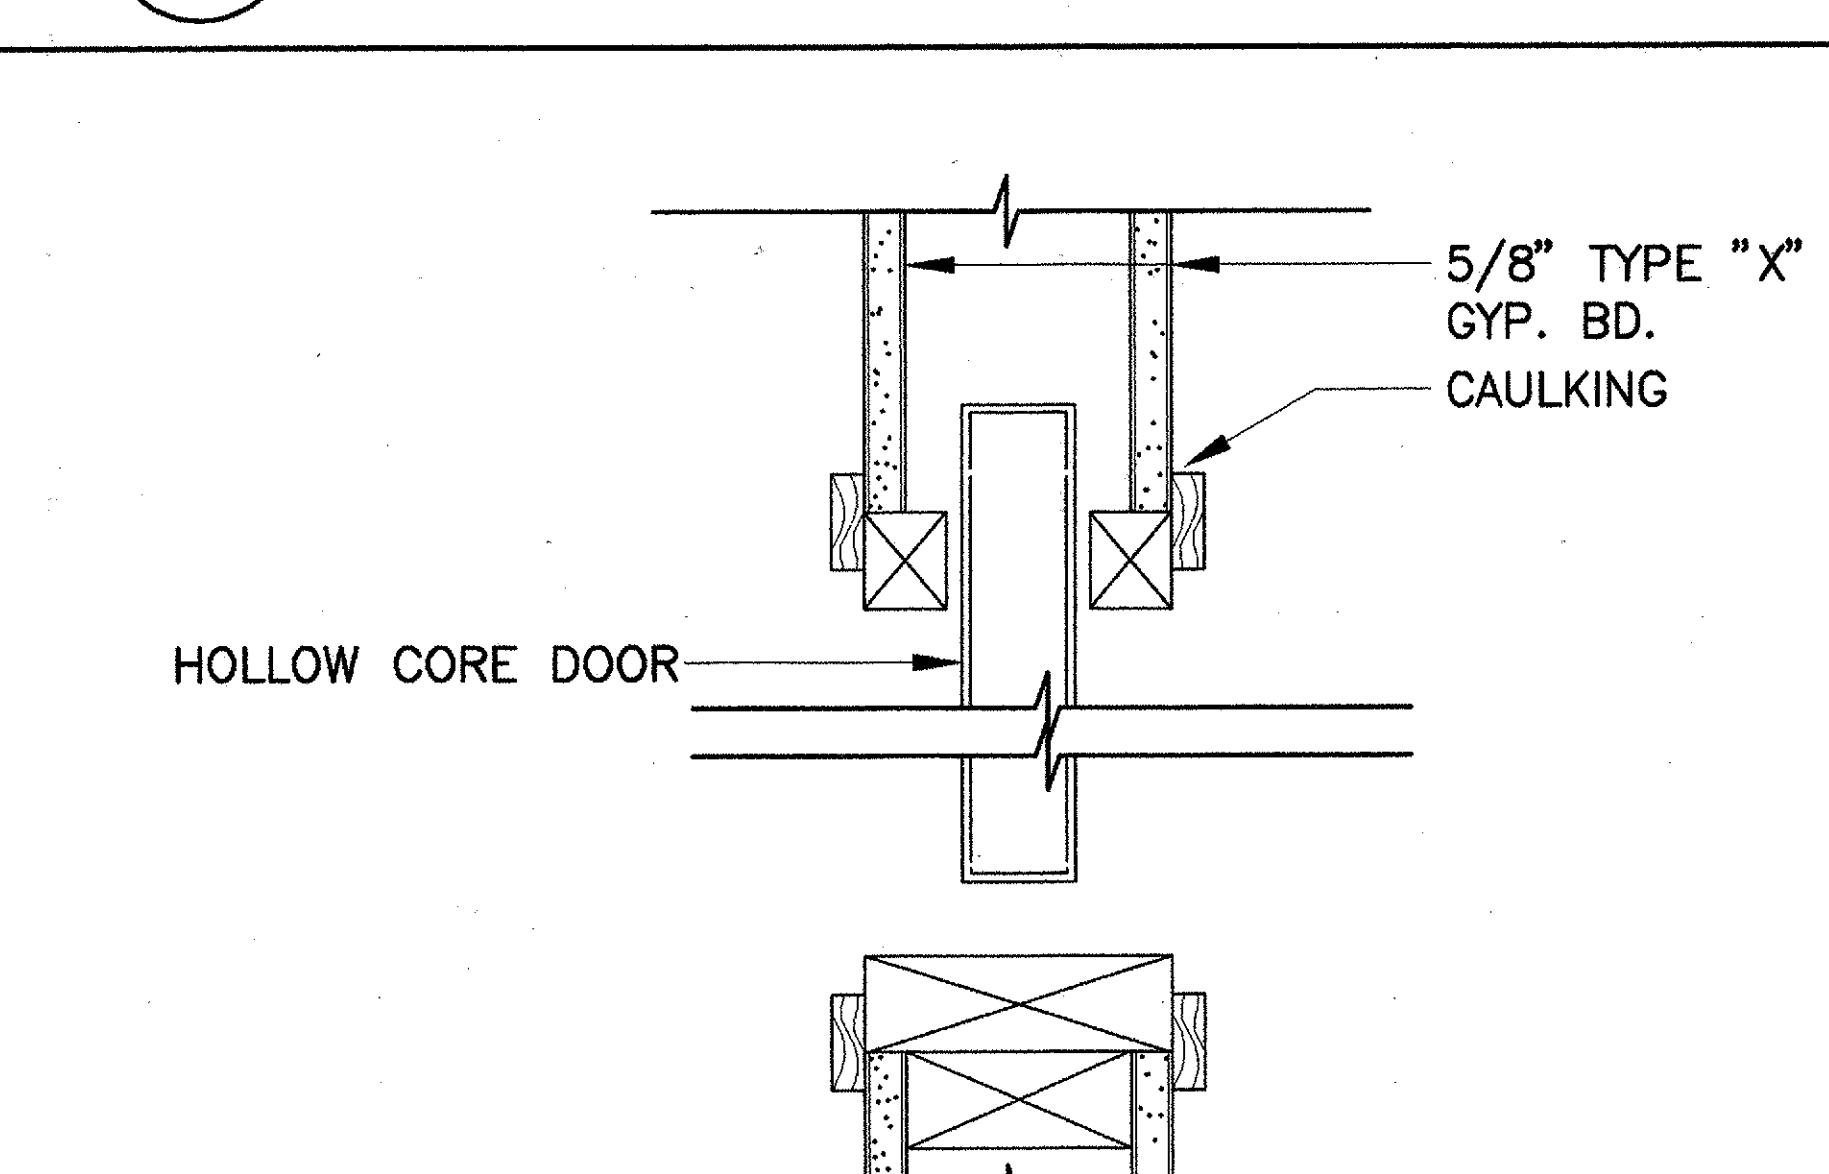


22 WINDOW DETAIL
A-20 SCALE: 3" = 1'-0"

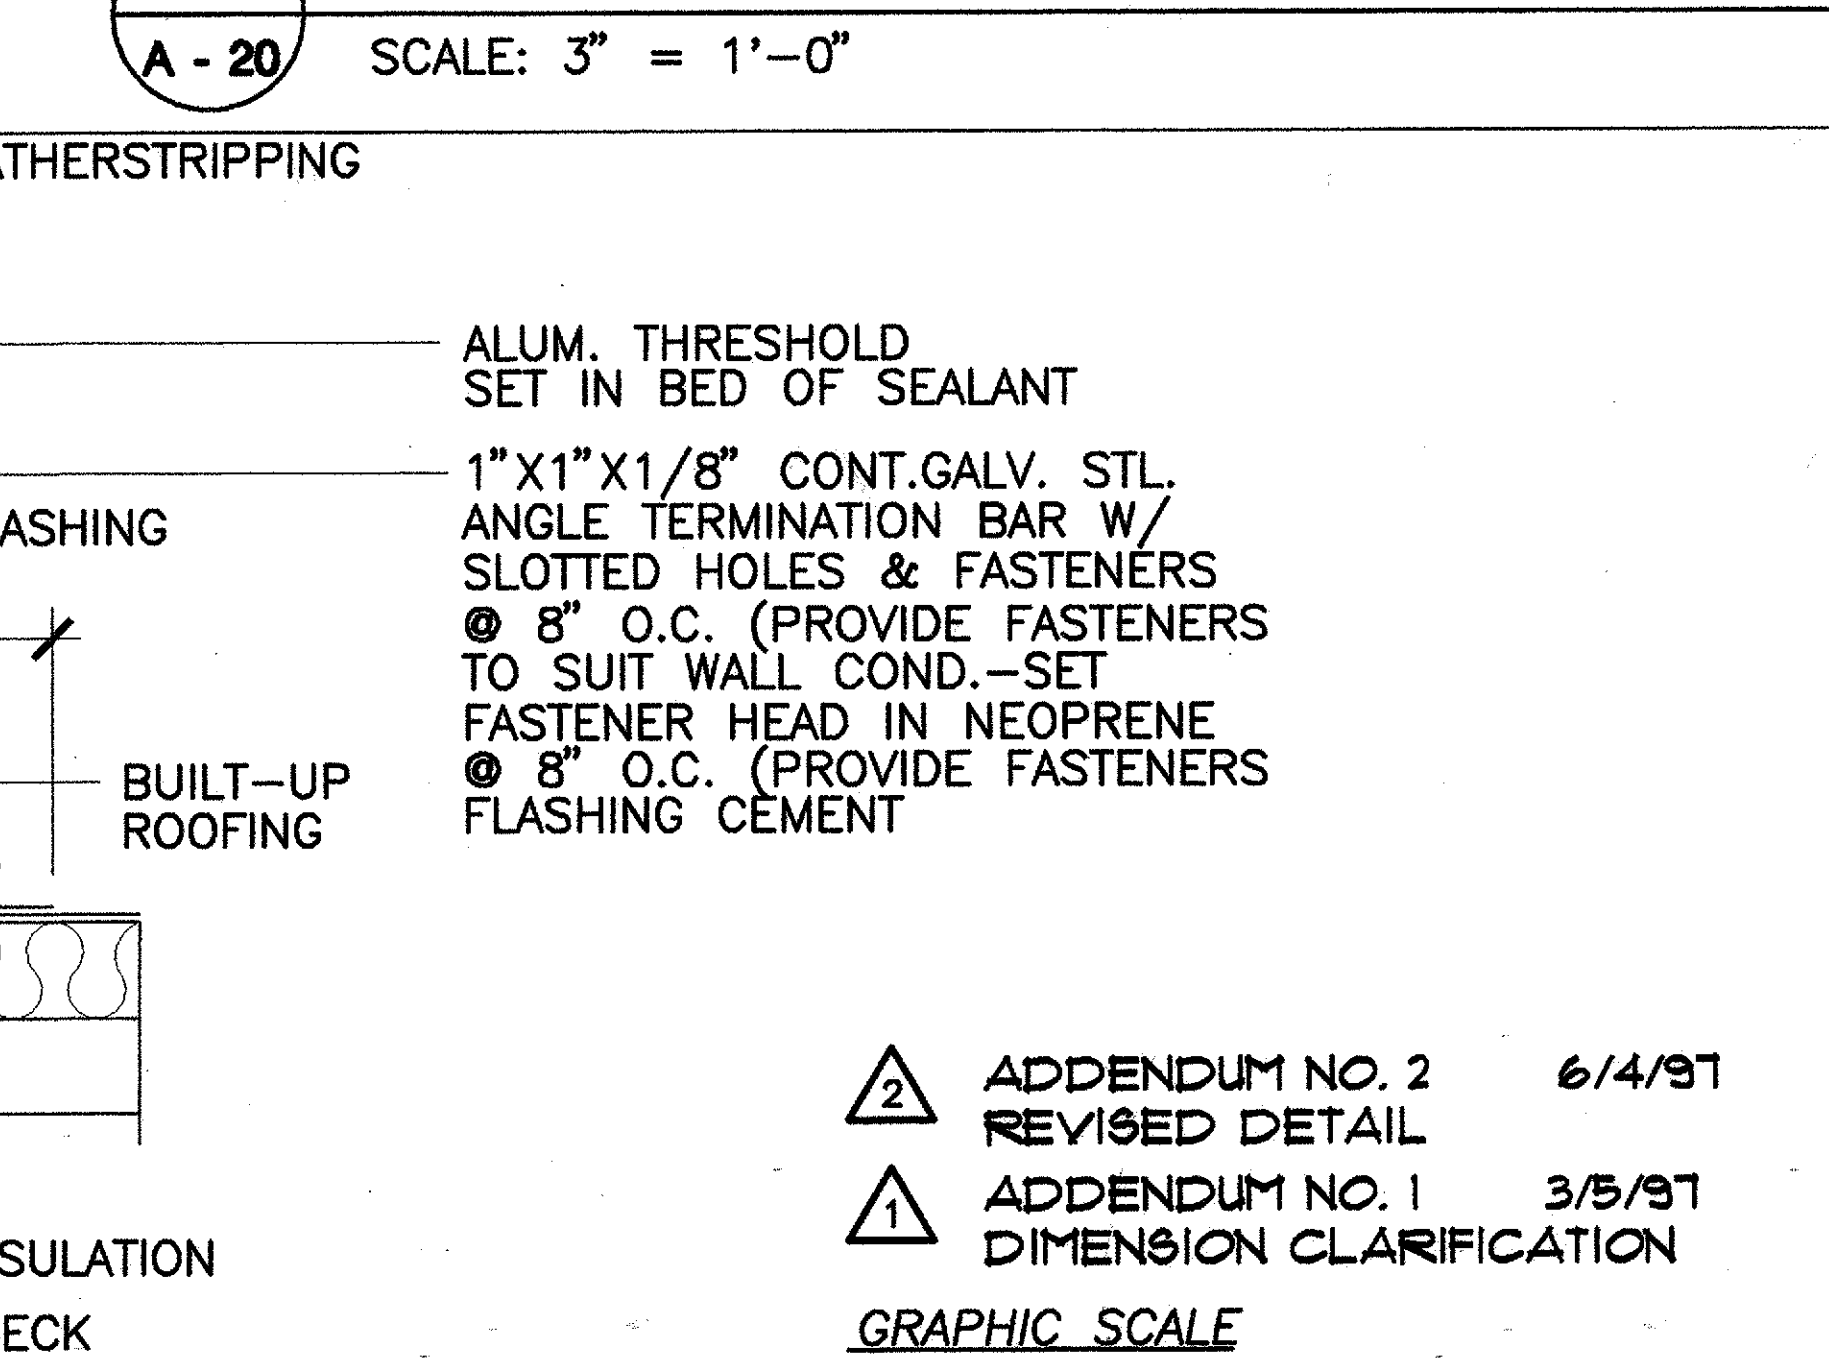


23 WINDOW DETAIL
A-20 SCALE: 3" = 1'-0"

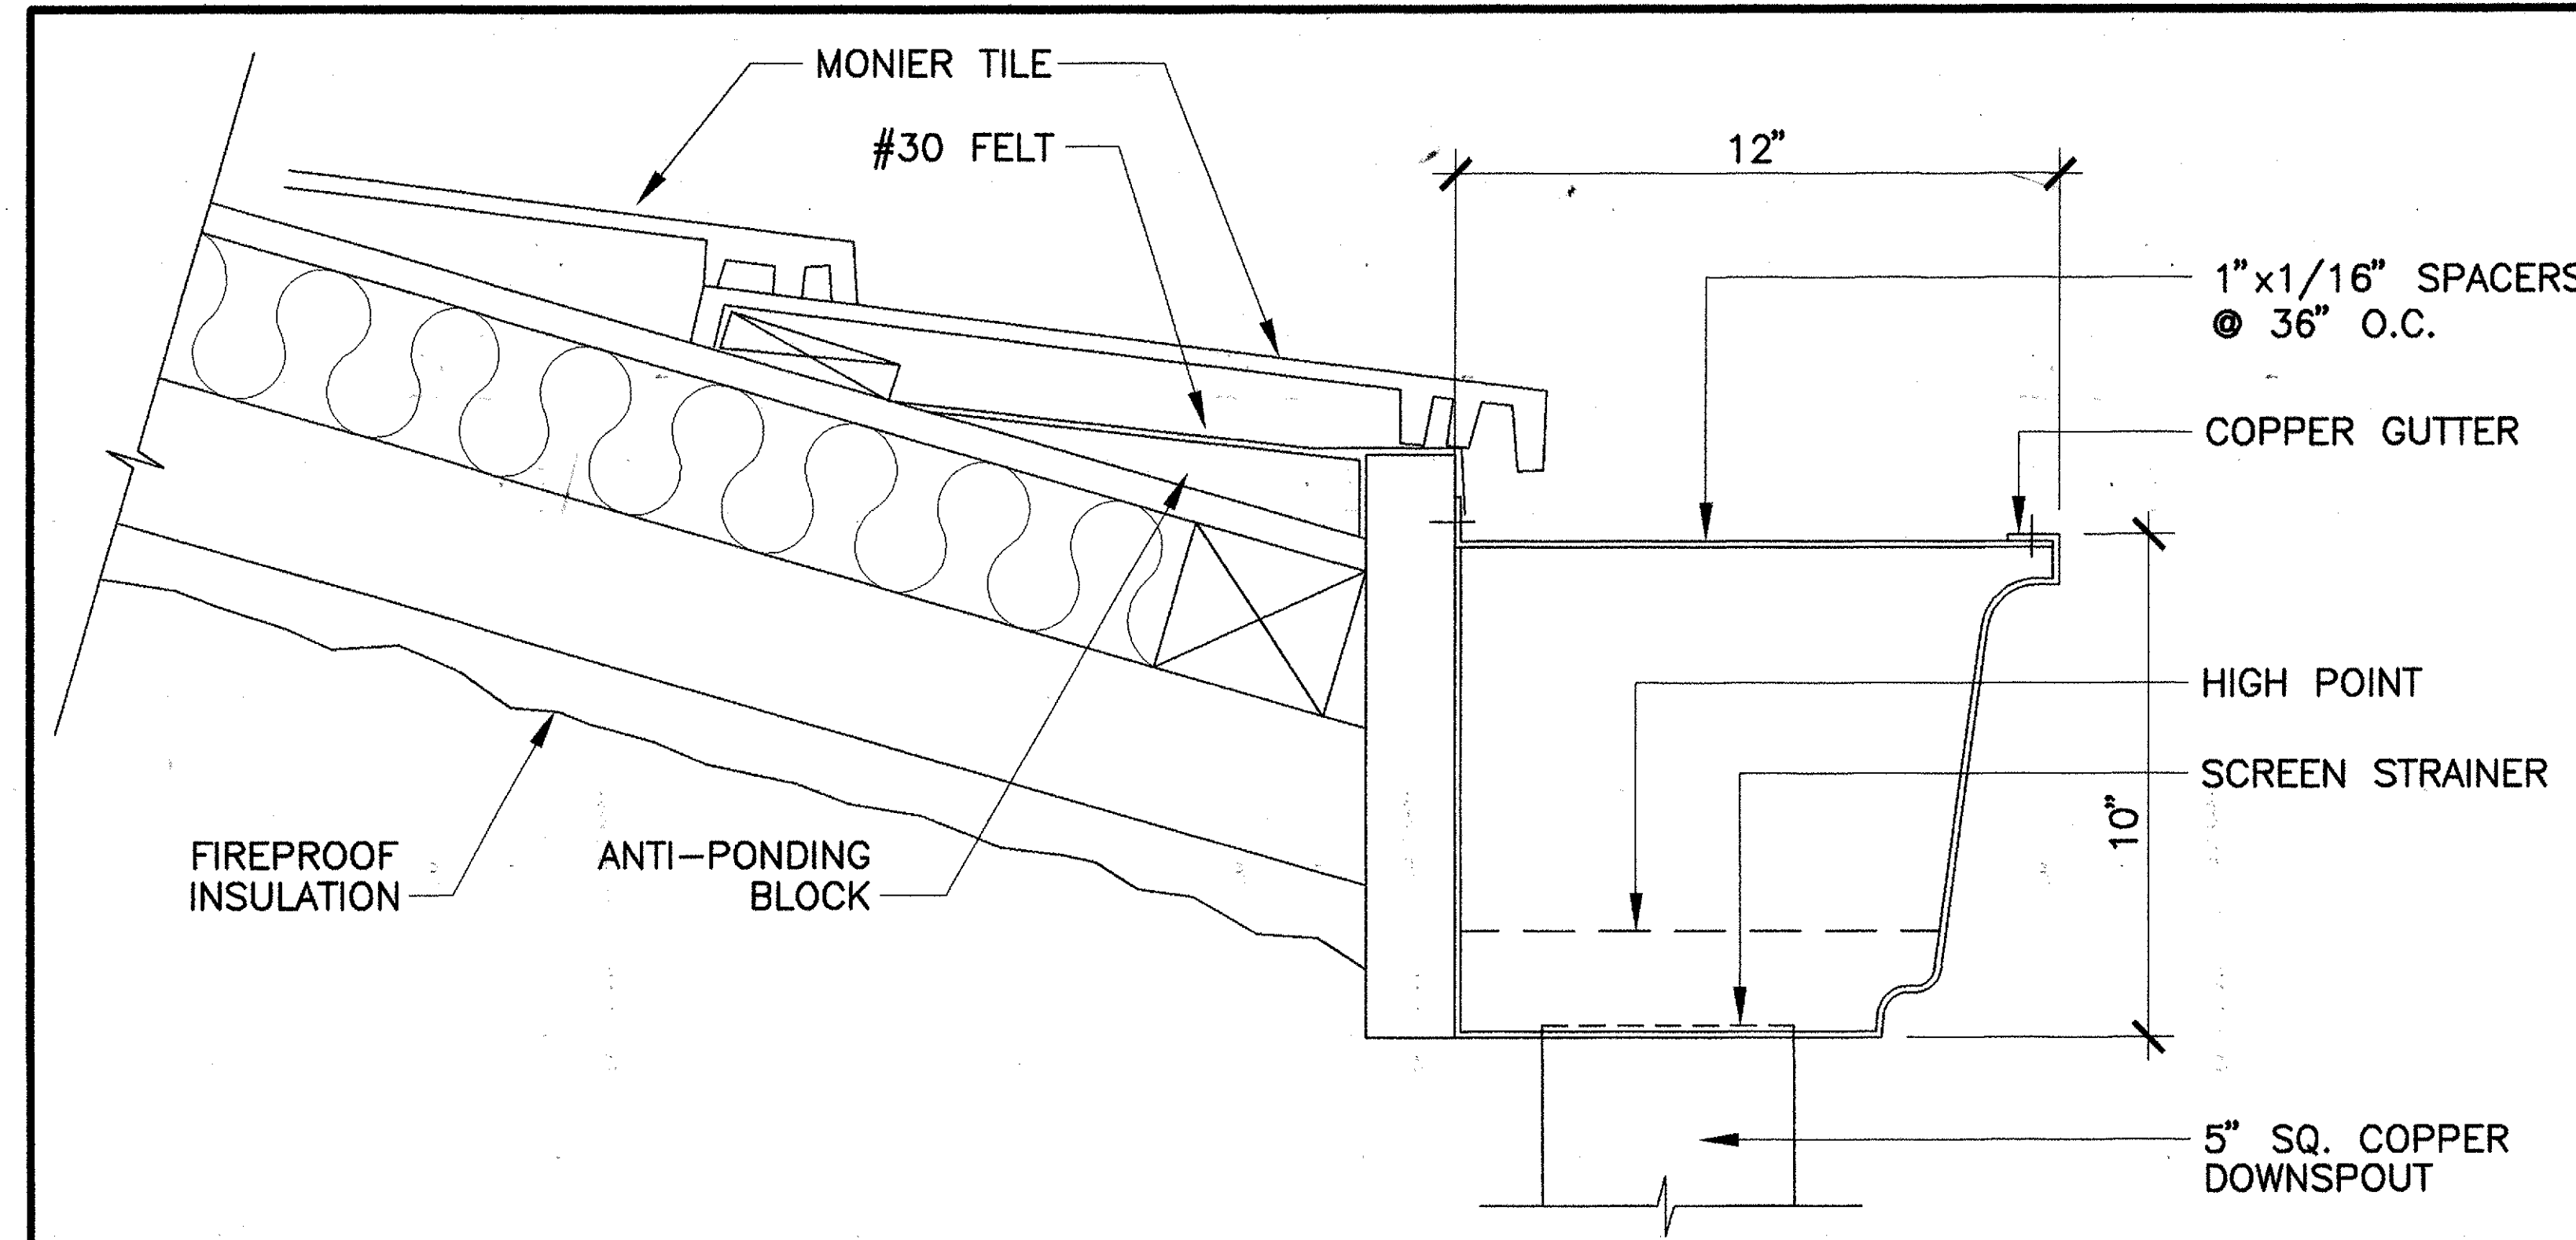


1 TYPICAL GUTTER DETAIL
A-21 SCALE: 3" = 1'-0"

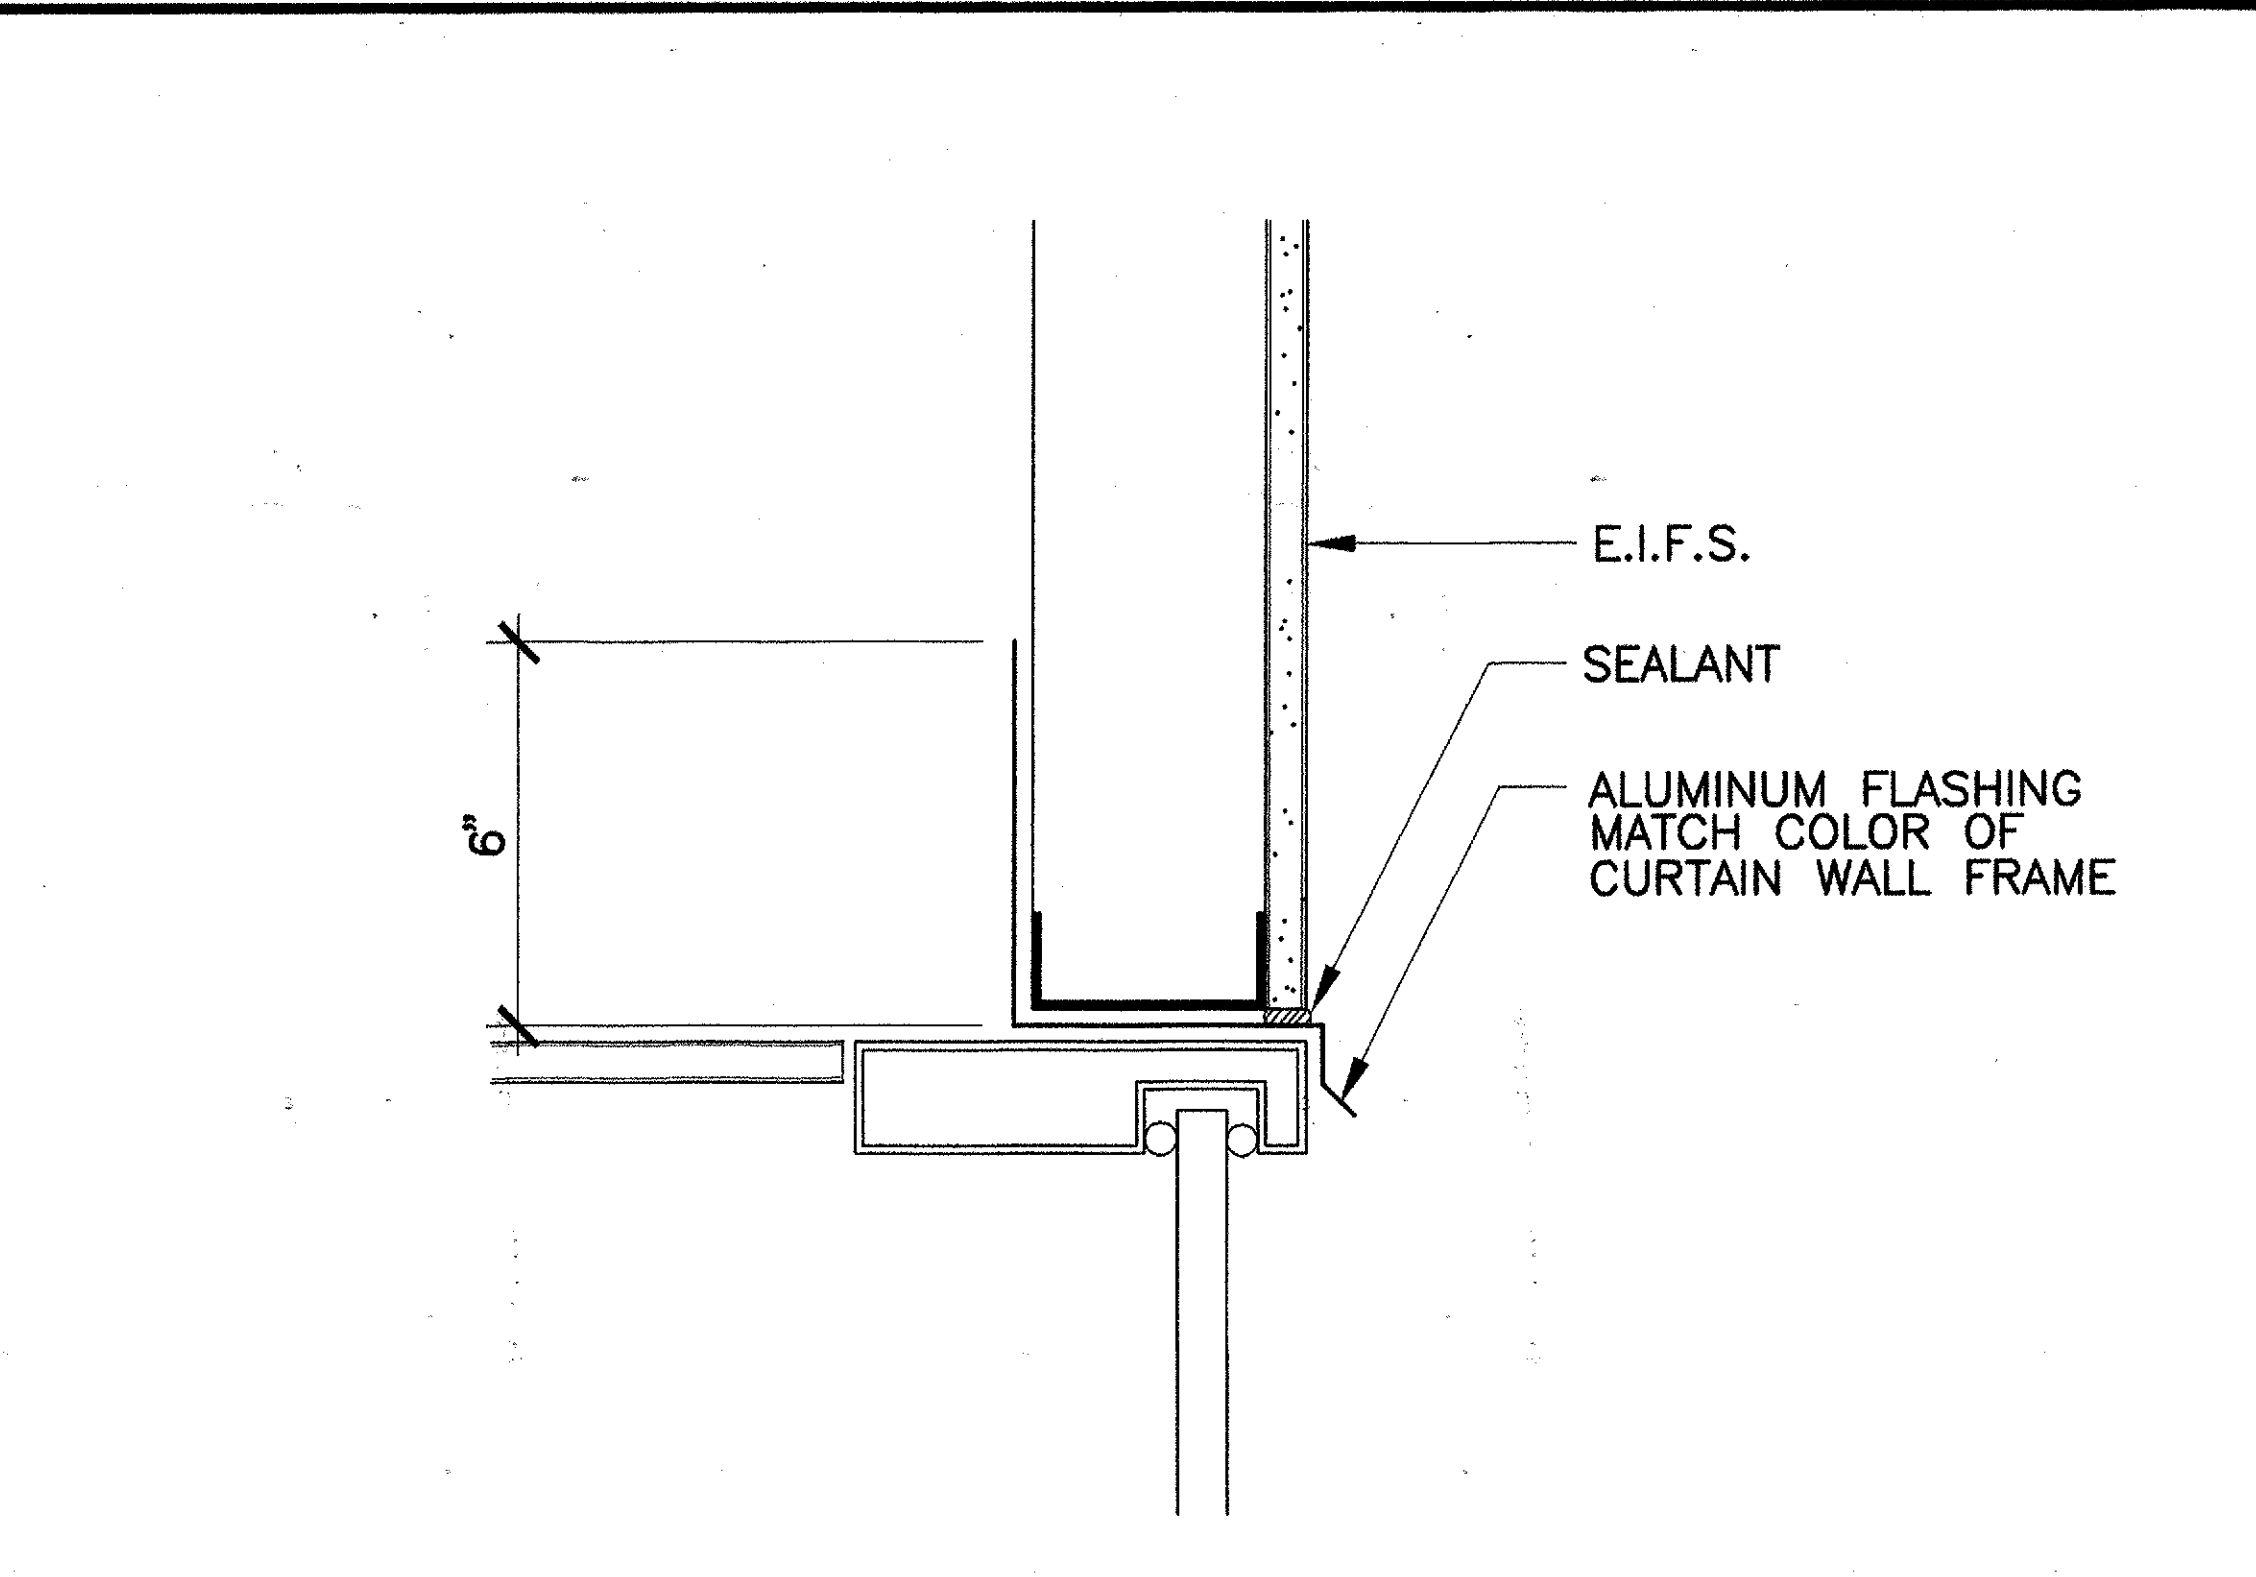


5 WINDOW HEAD FLASHING
A-21 SCALE: 3" = 1'-0"

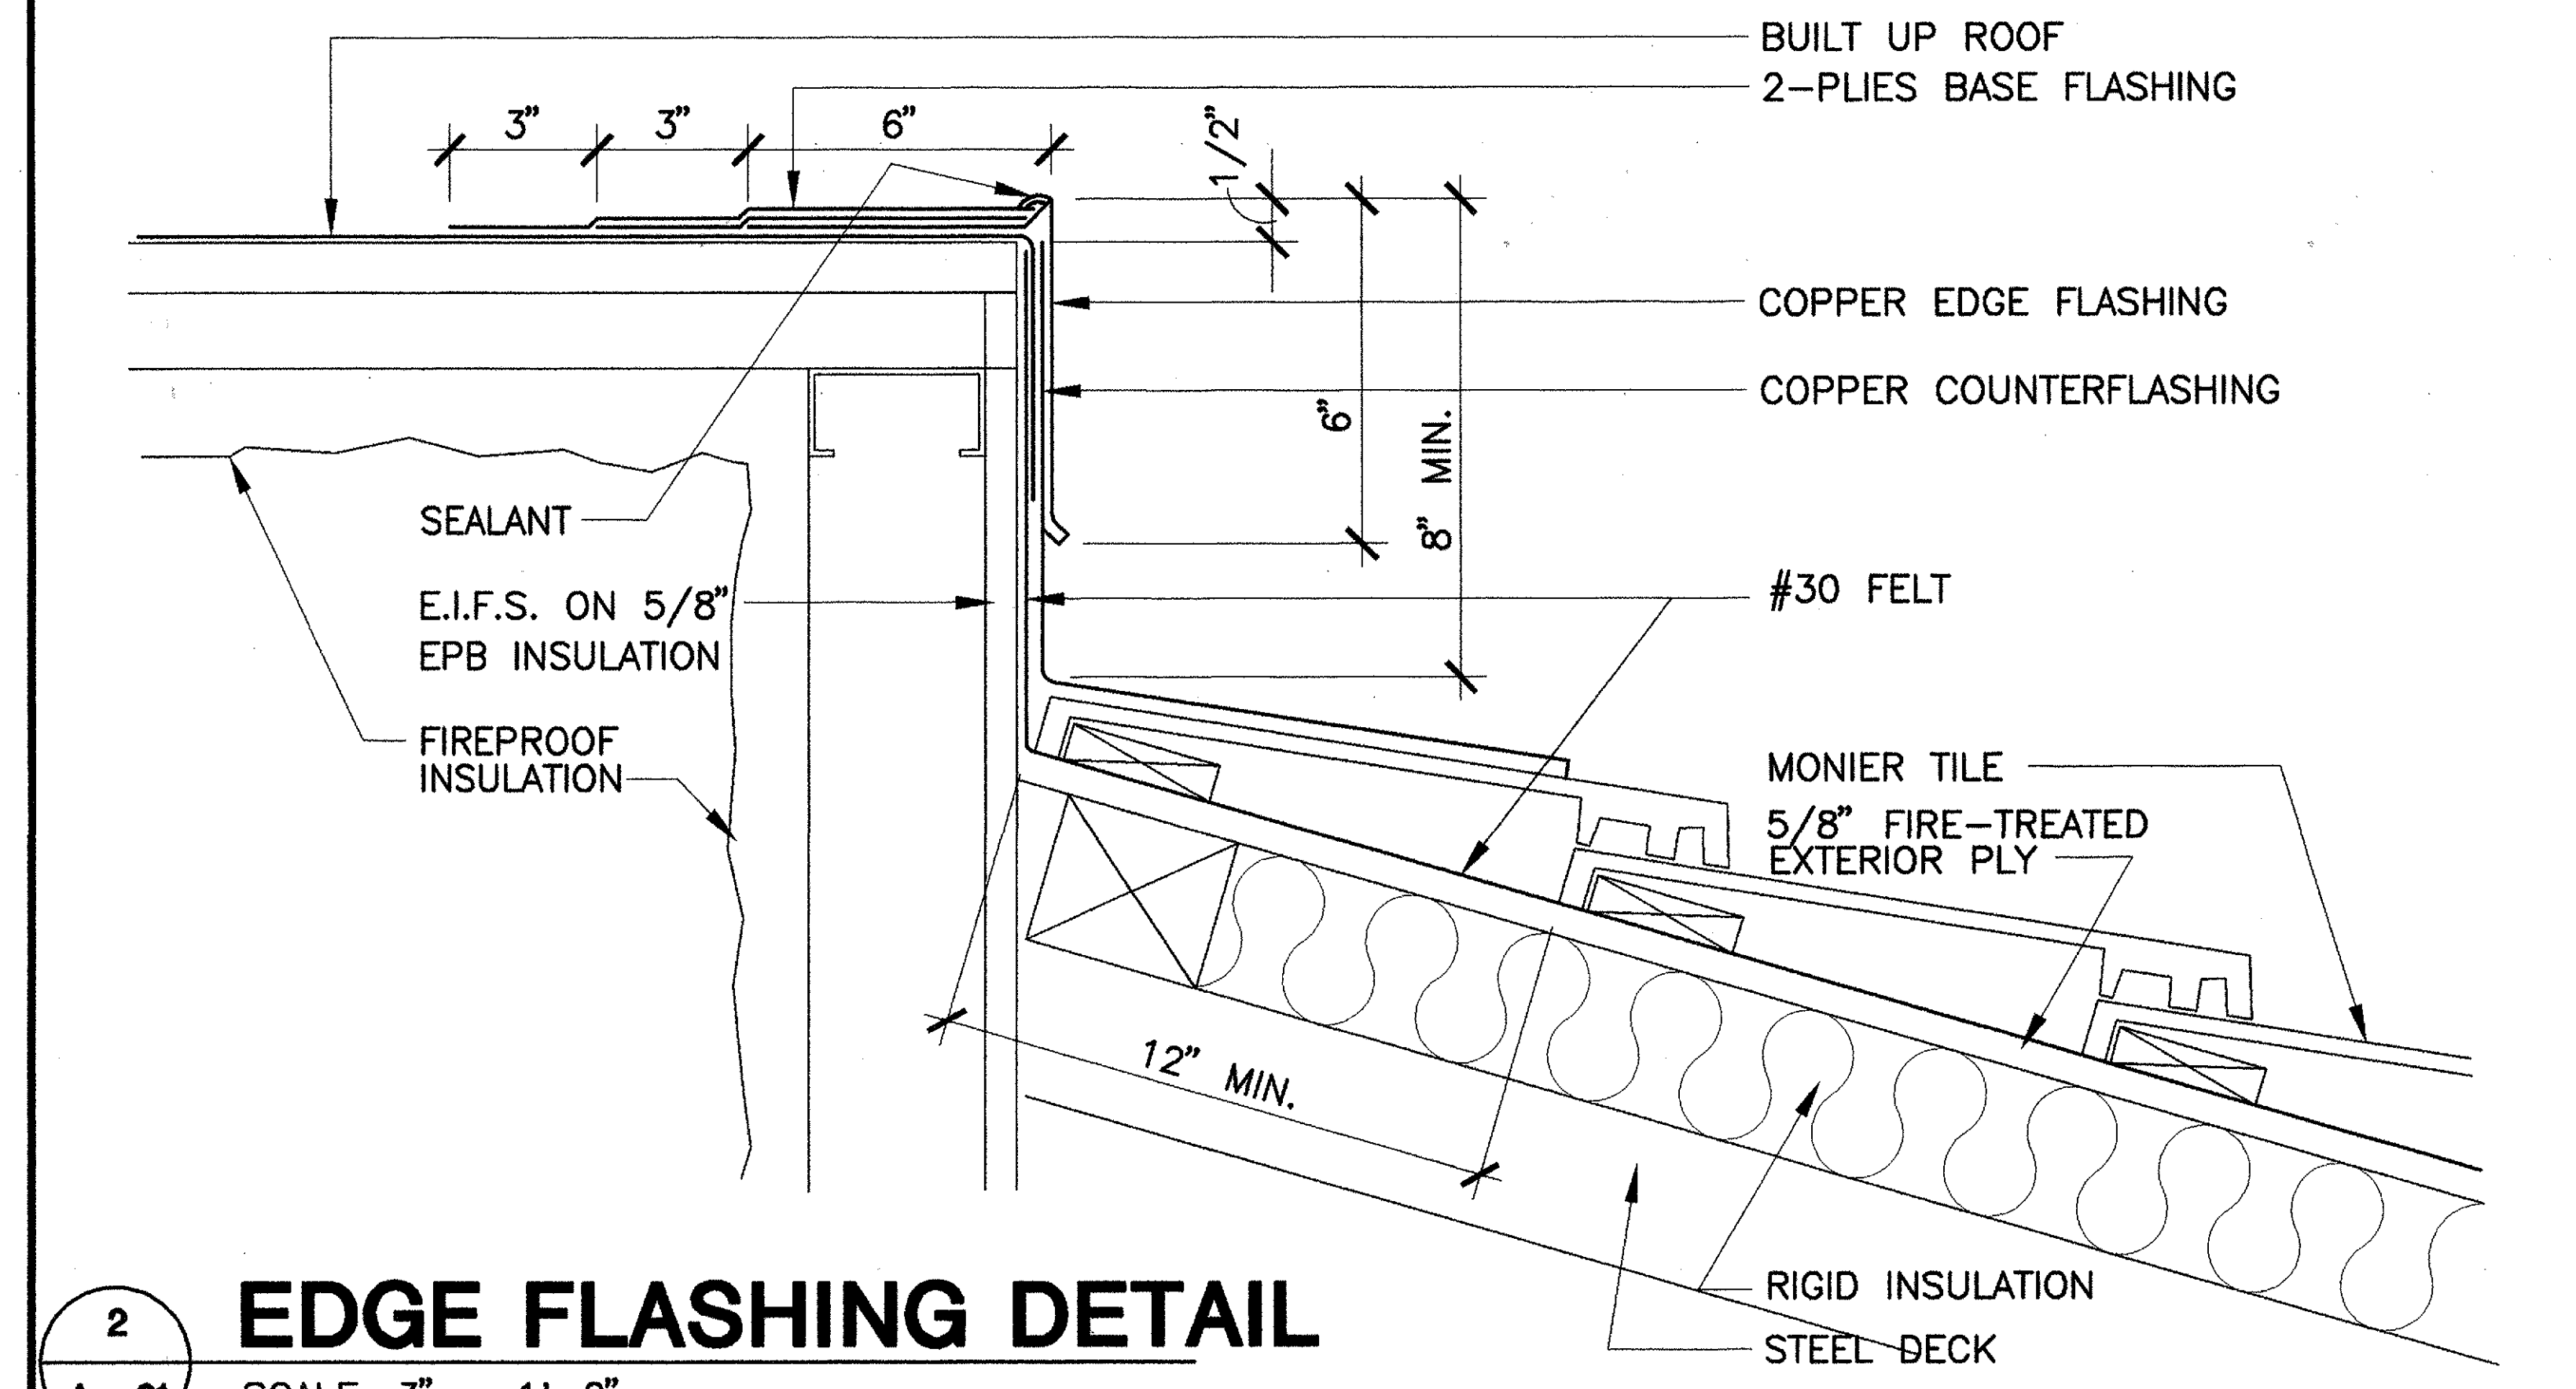


2 EDGE FLASHING DETAIL
A-21 SCALE: 3" = 1'-0"

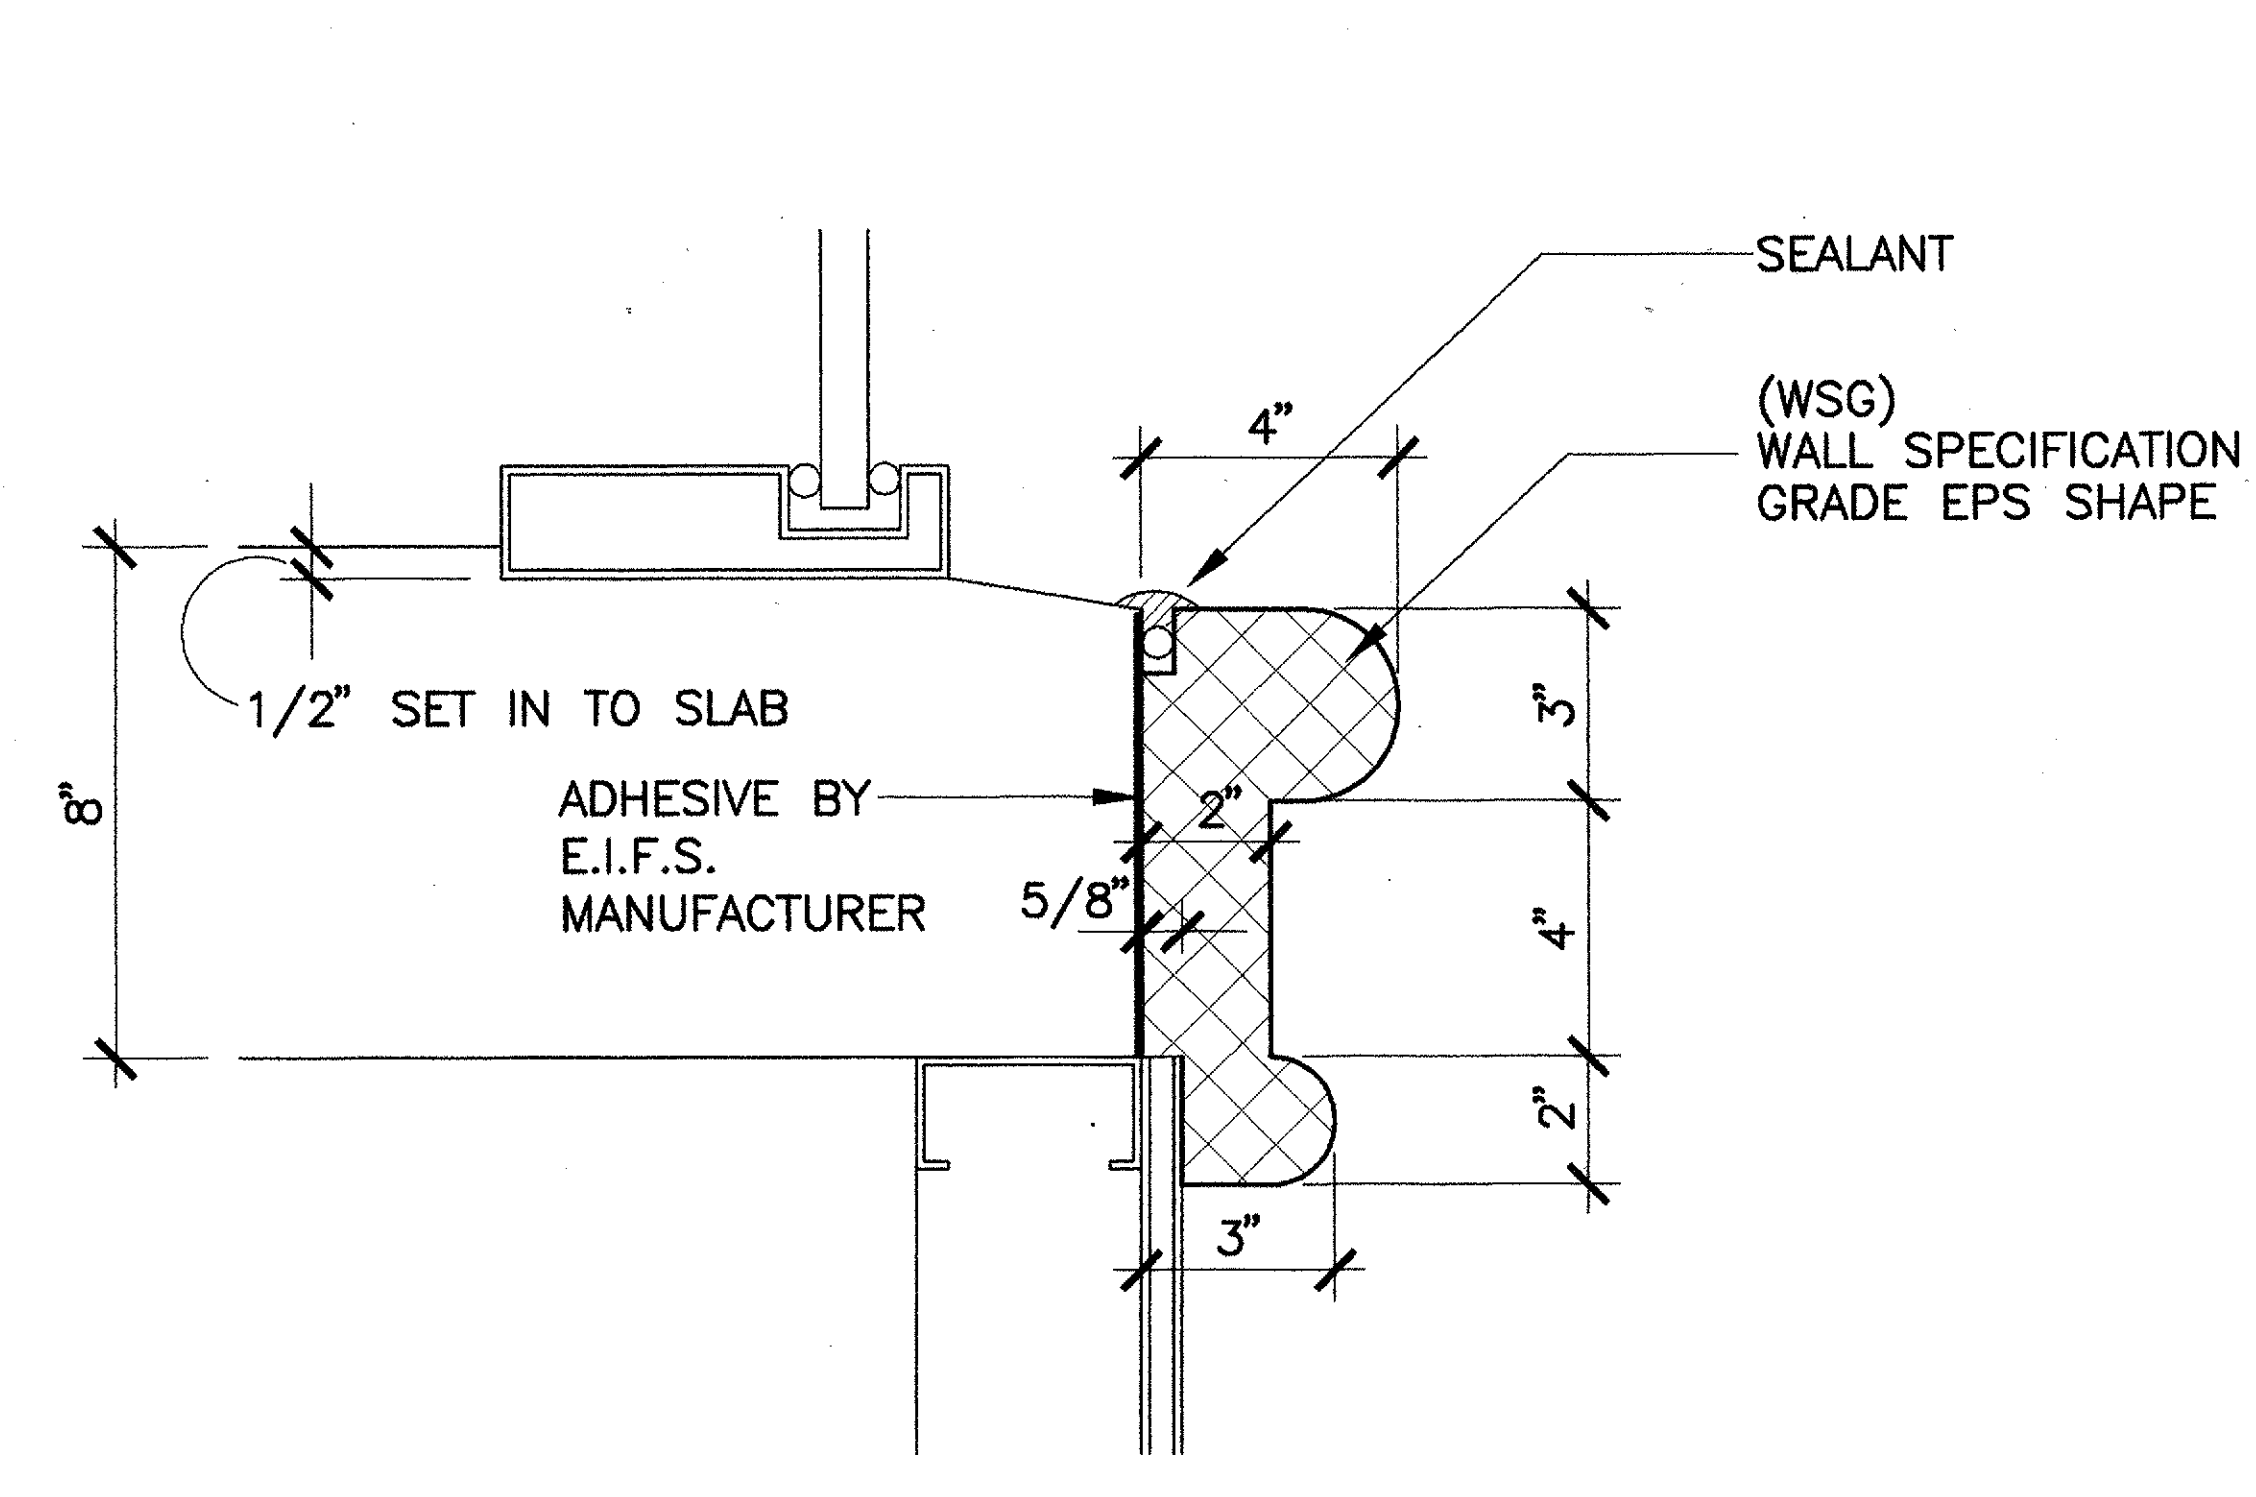


6 TYP. MOLDING DETAIL
A-21 SCALE: 3" = 1'-0"

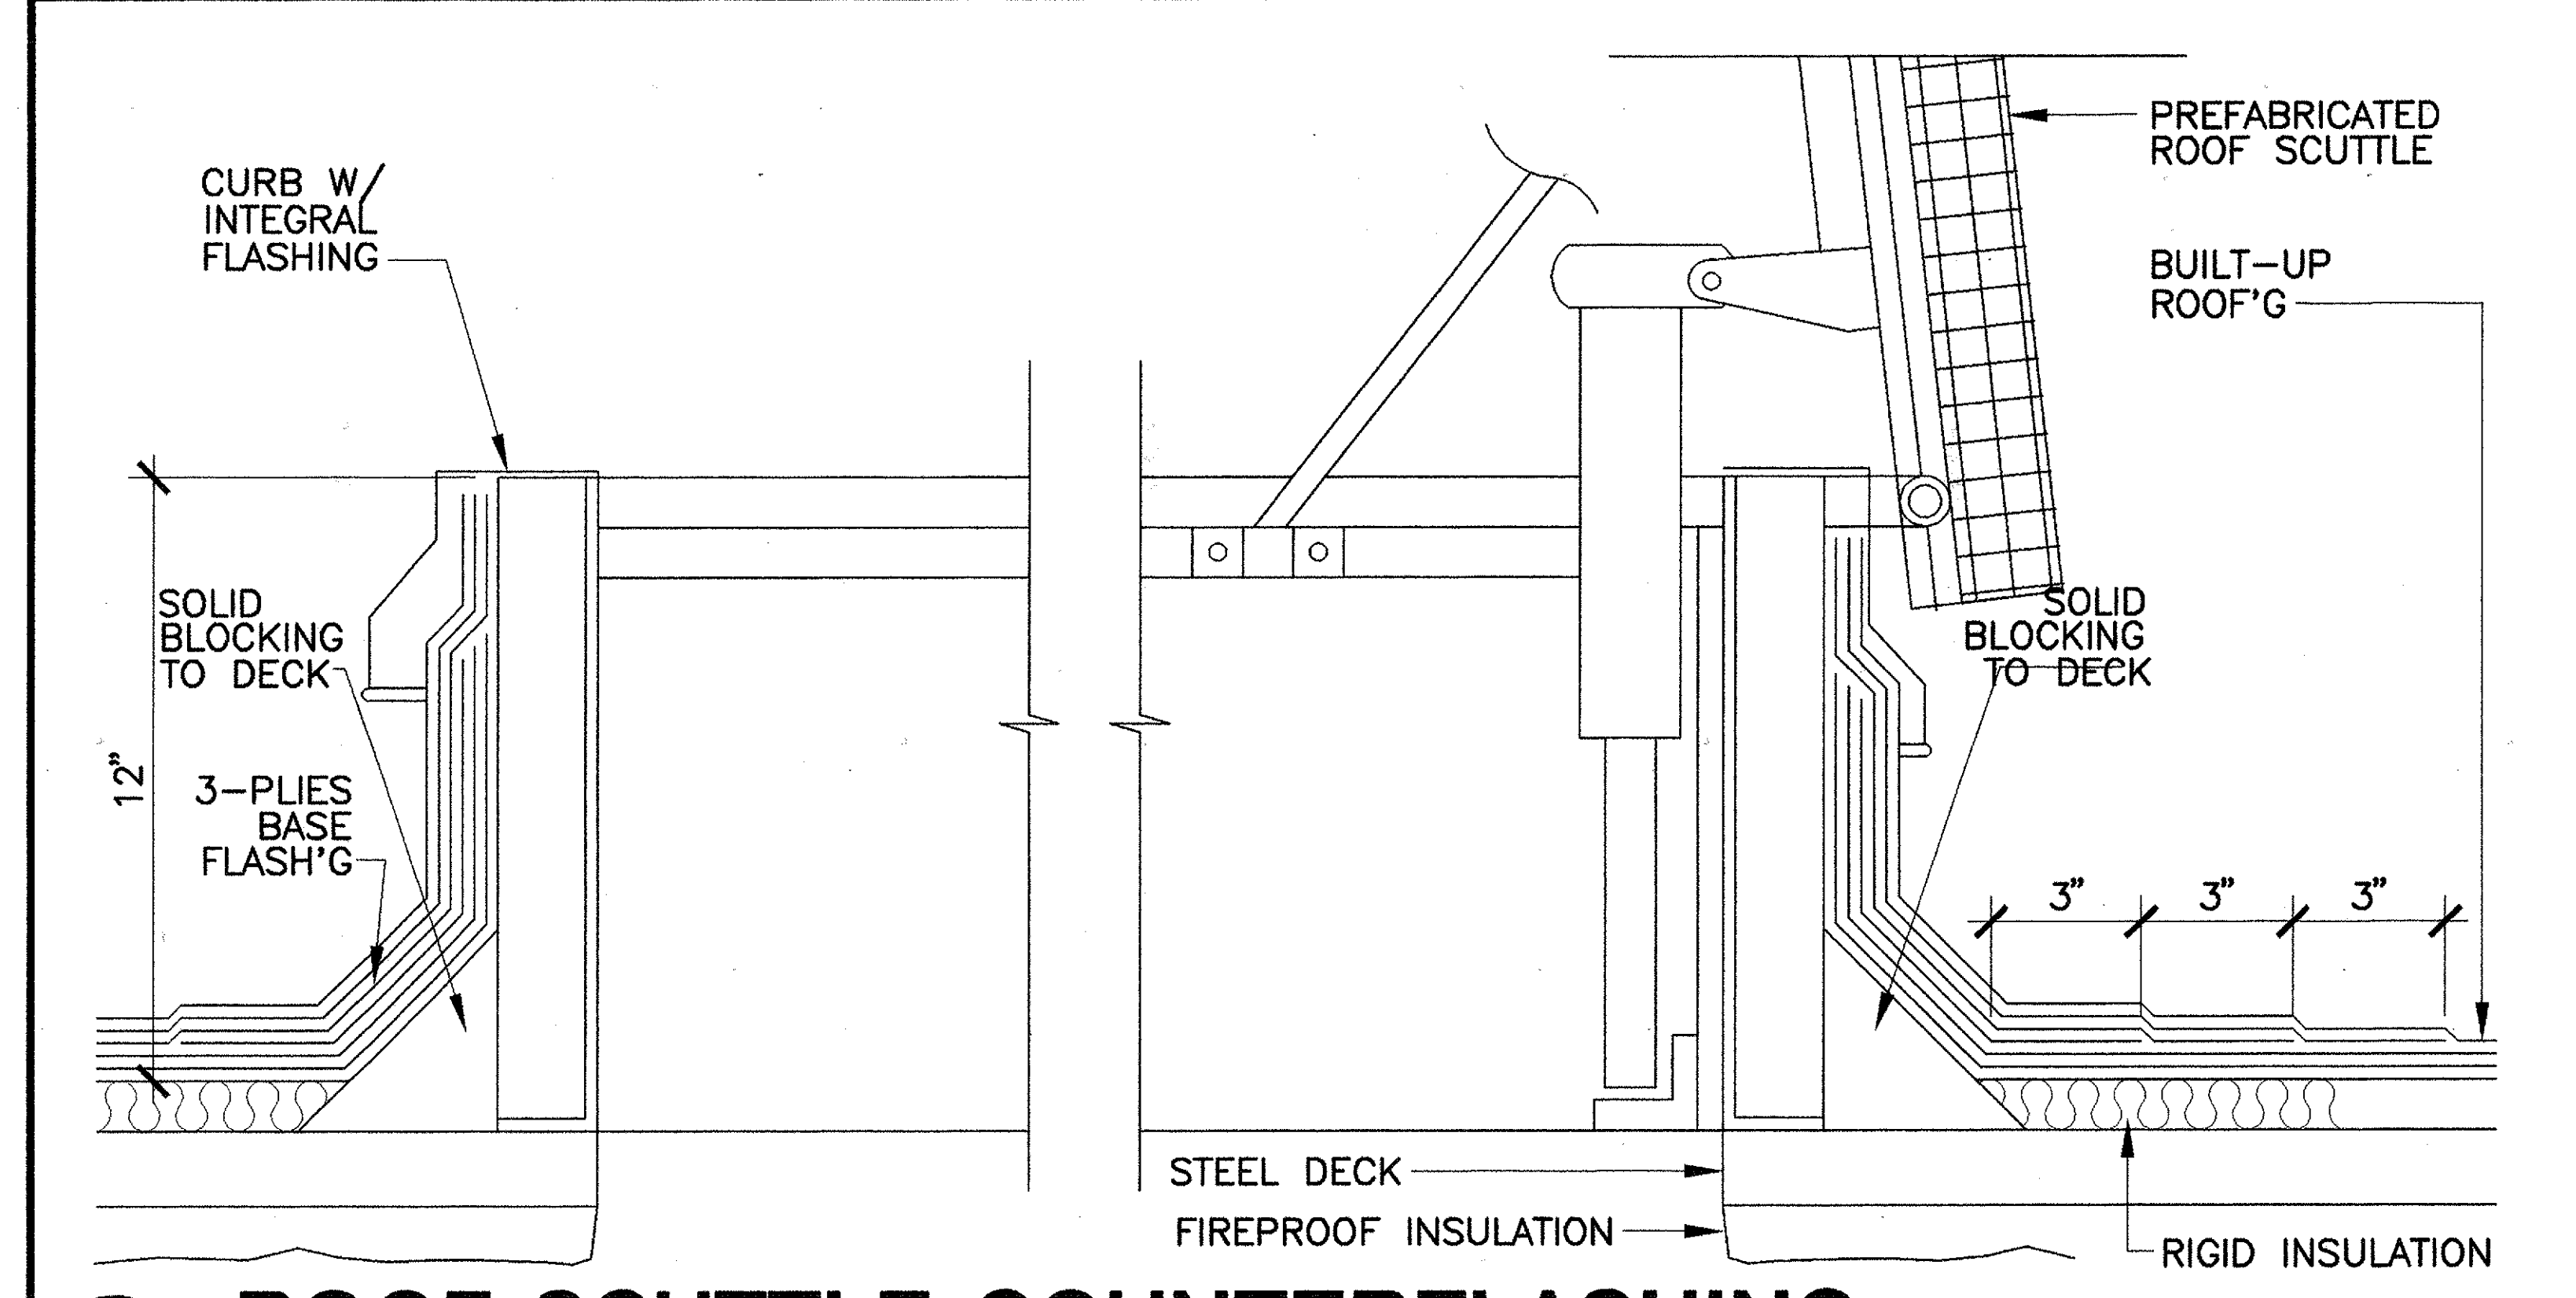


3 ROOF SCUTTLE COUNTERFLASHING
A-21 SCALE: 3" = 1'-0"

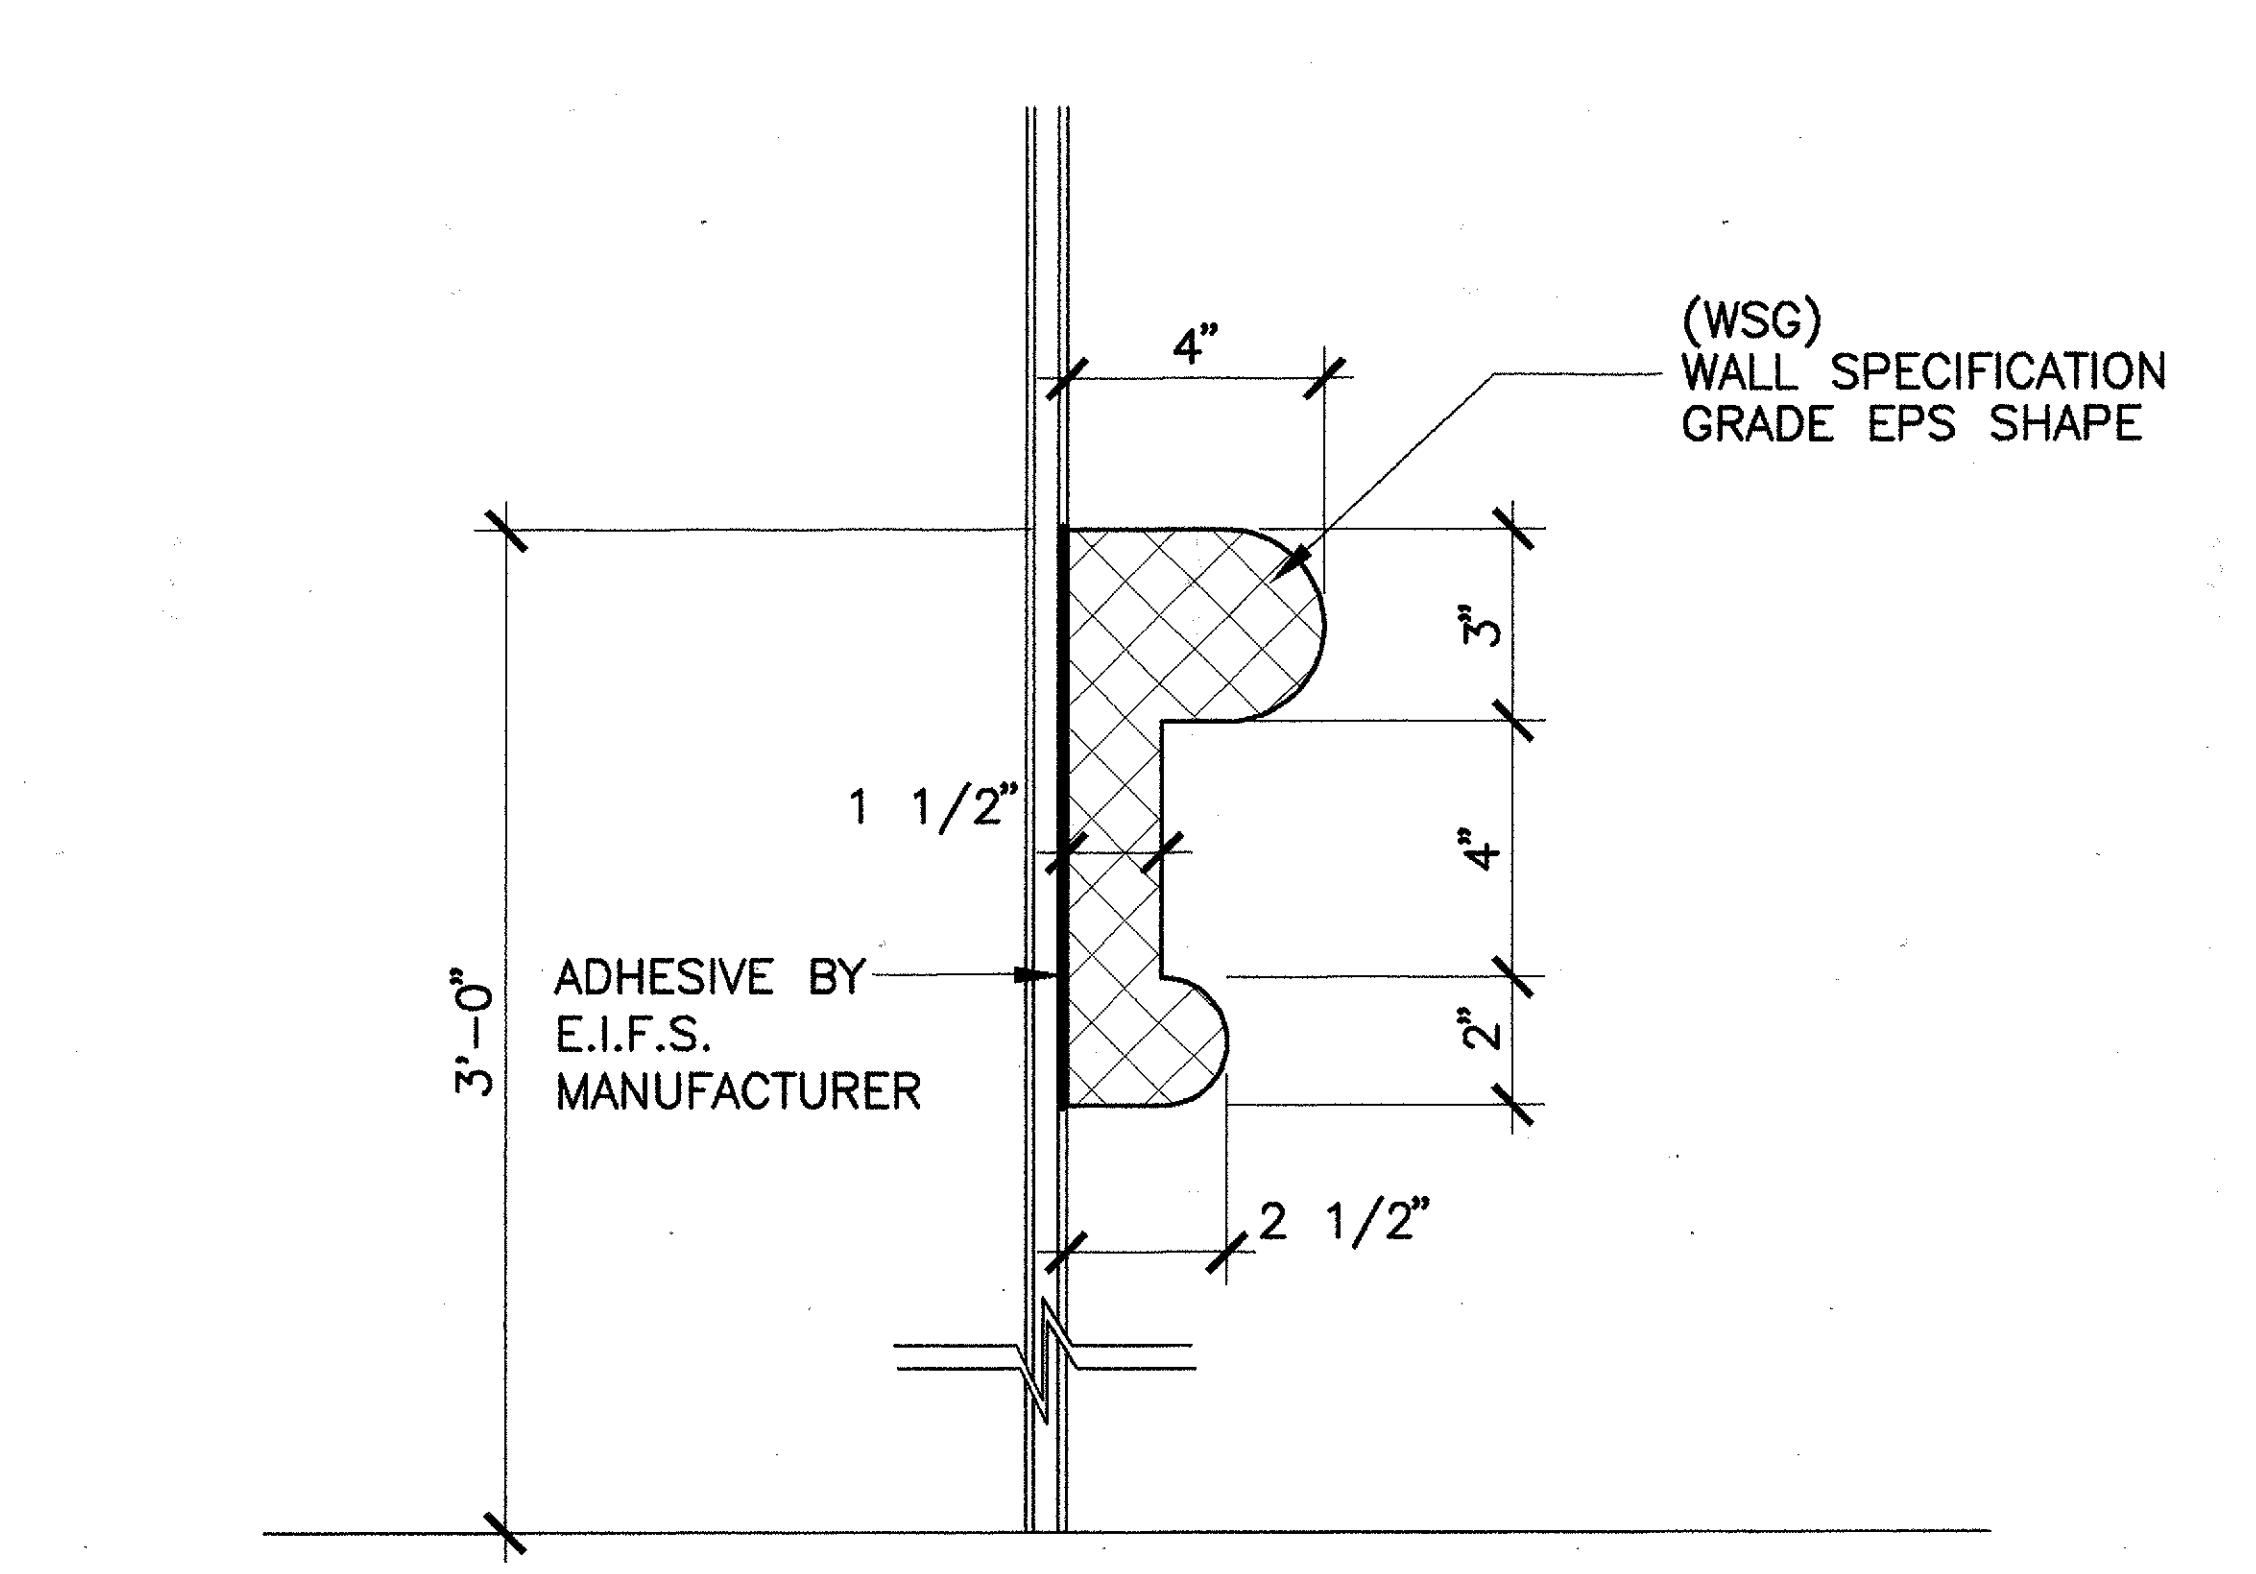

7 DETAIL @ COLUMN BASE Moulding
A-21 SCALE: 3" = 1'-0"

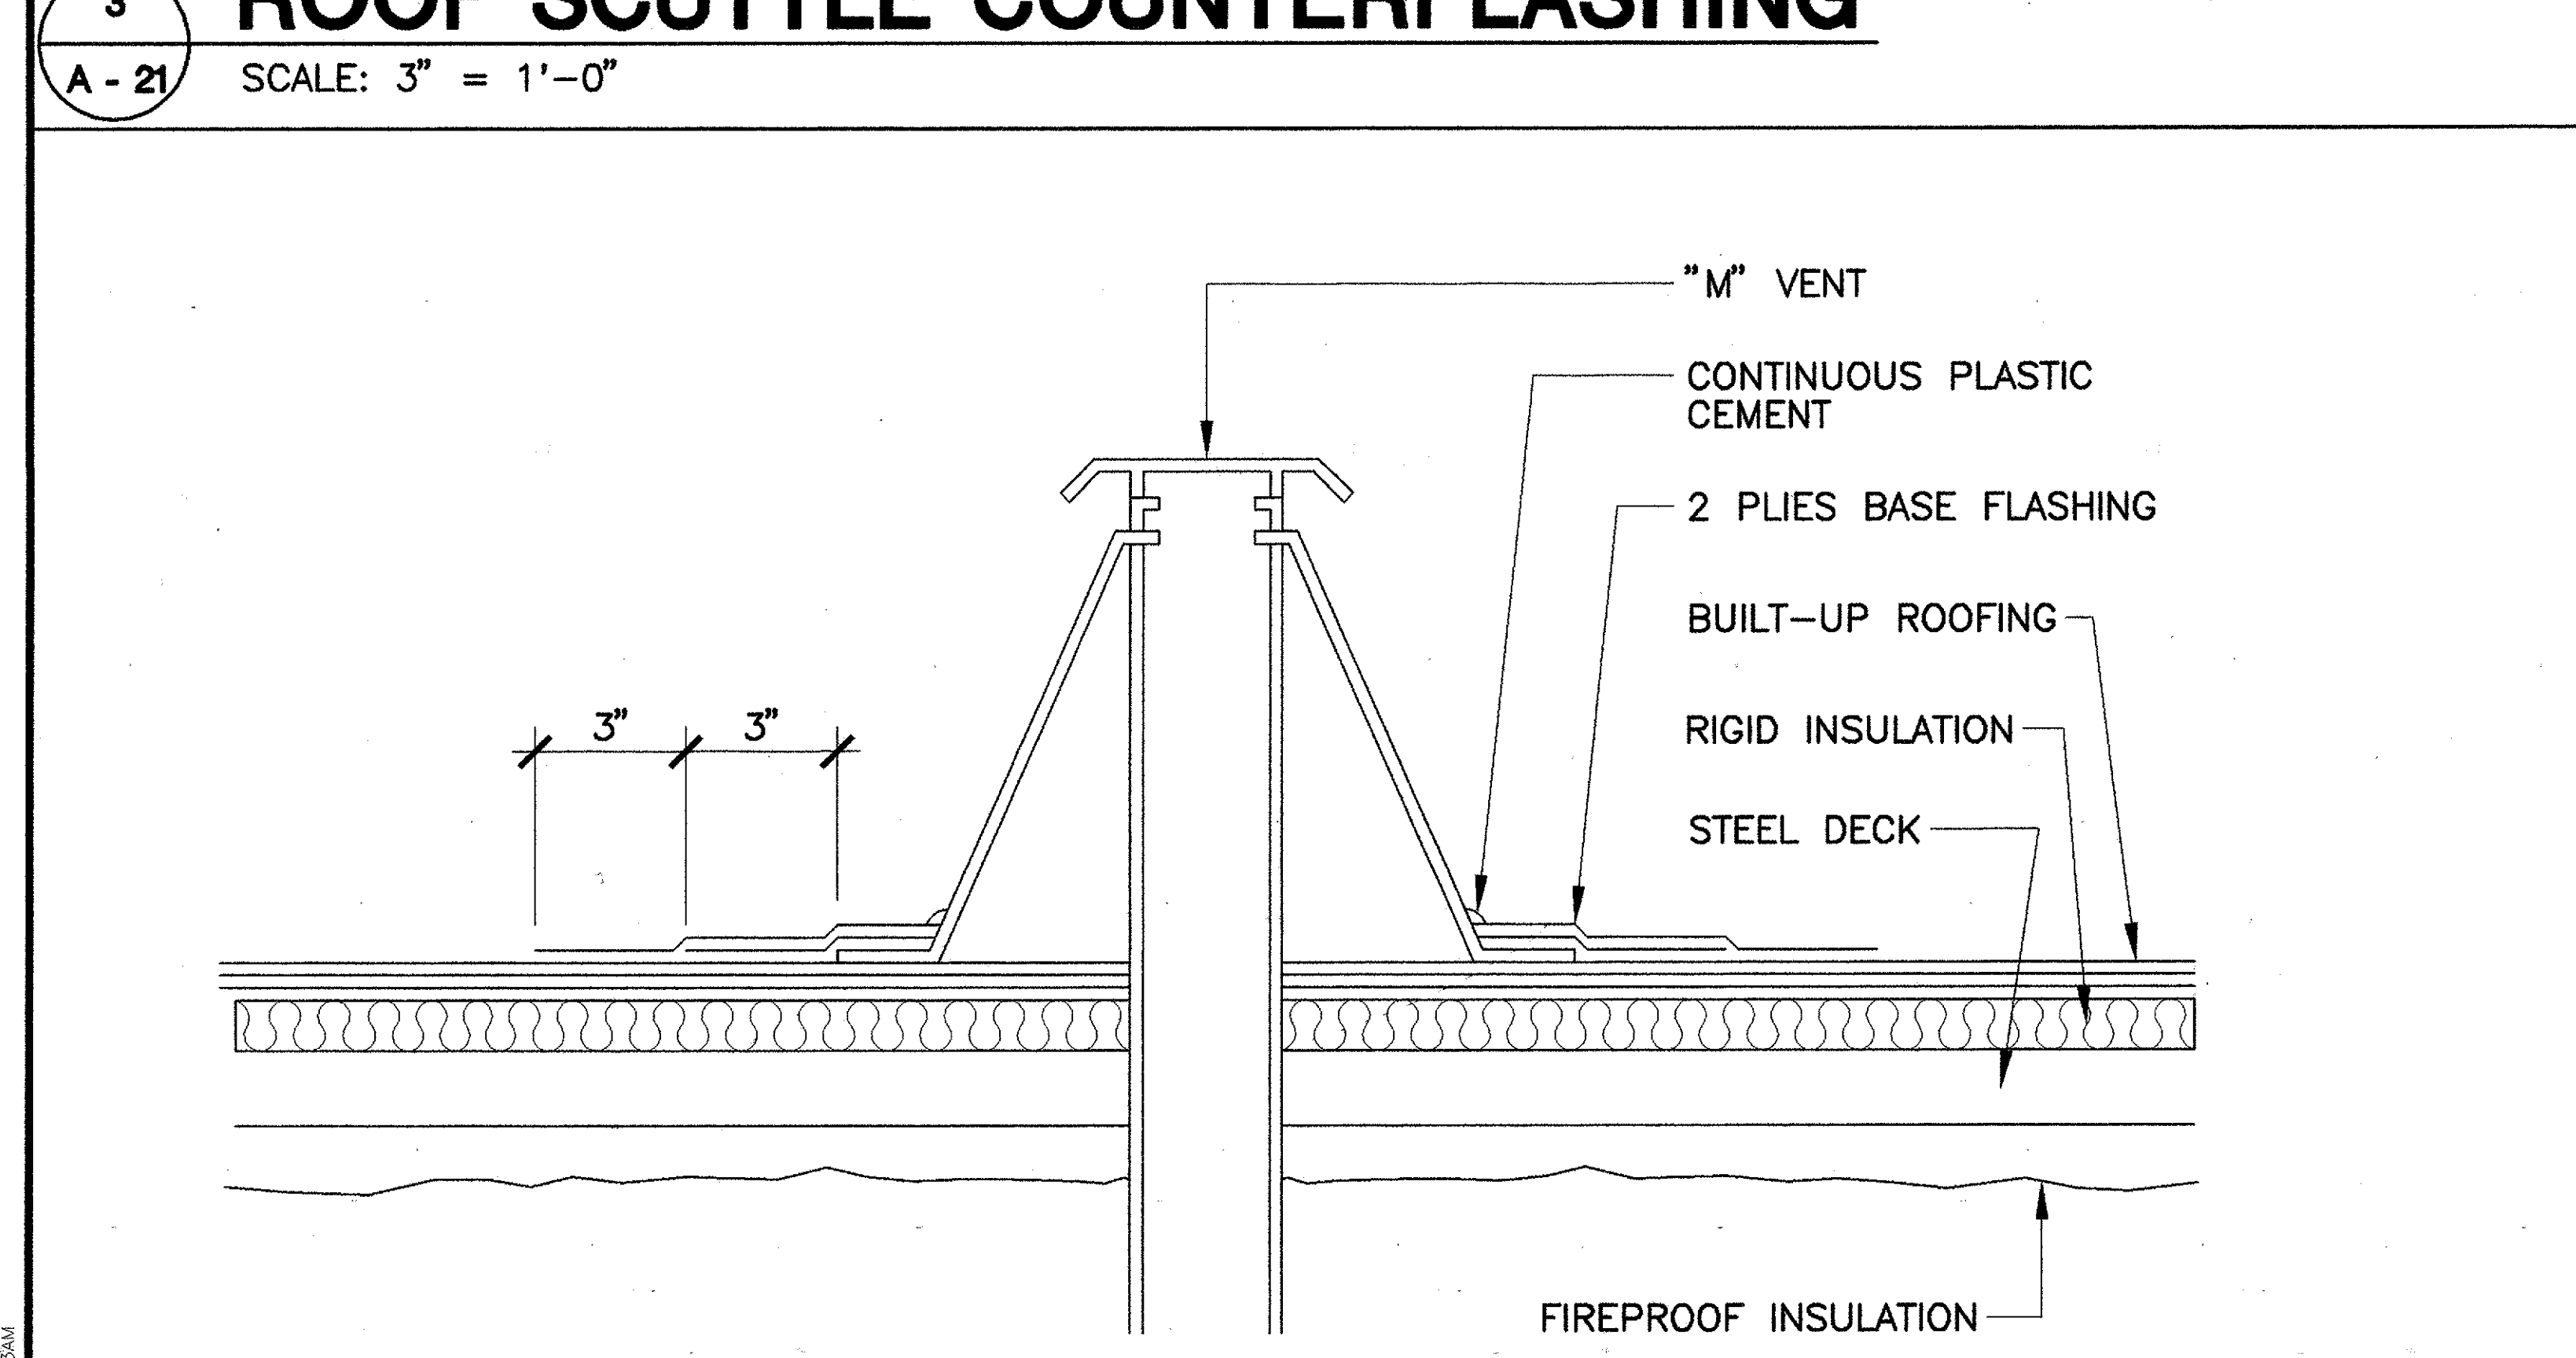

4 TYPICAL VENT PIPE FLASHING
A-21 SCALE: 3" = 1'-0"

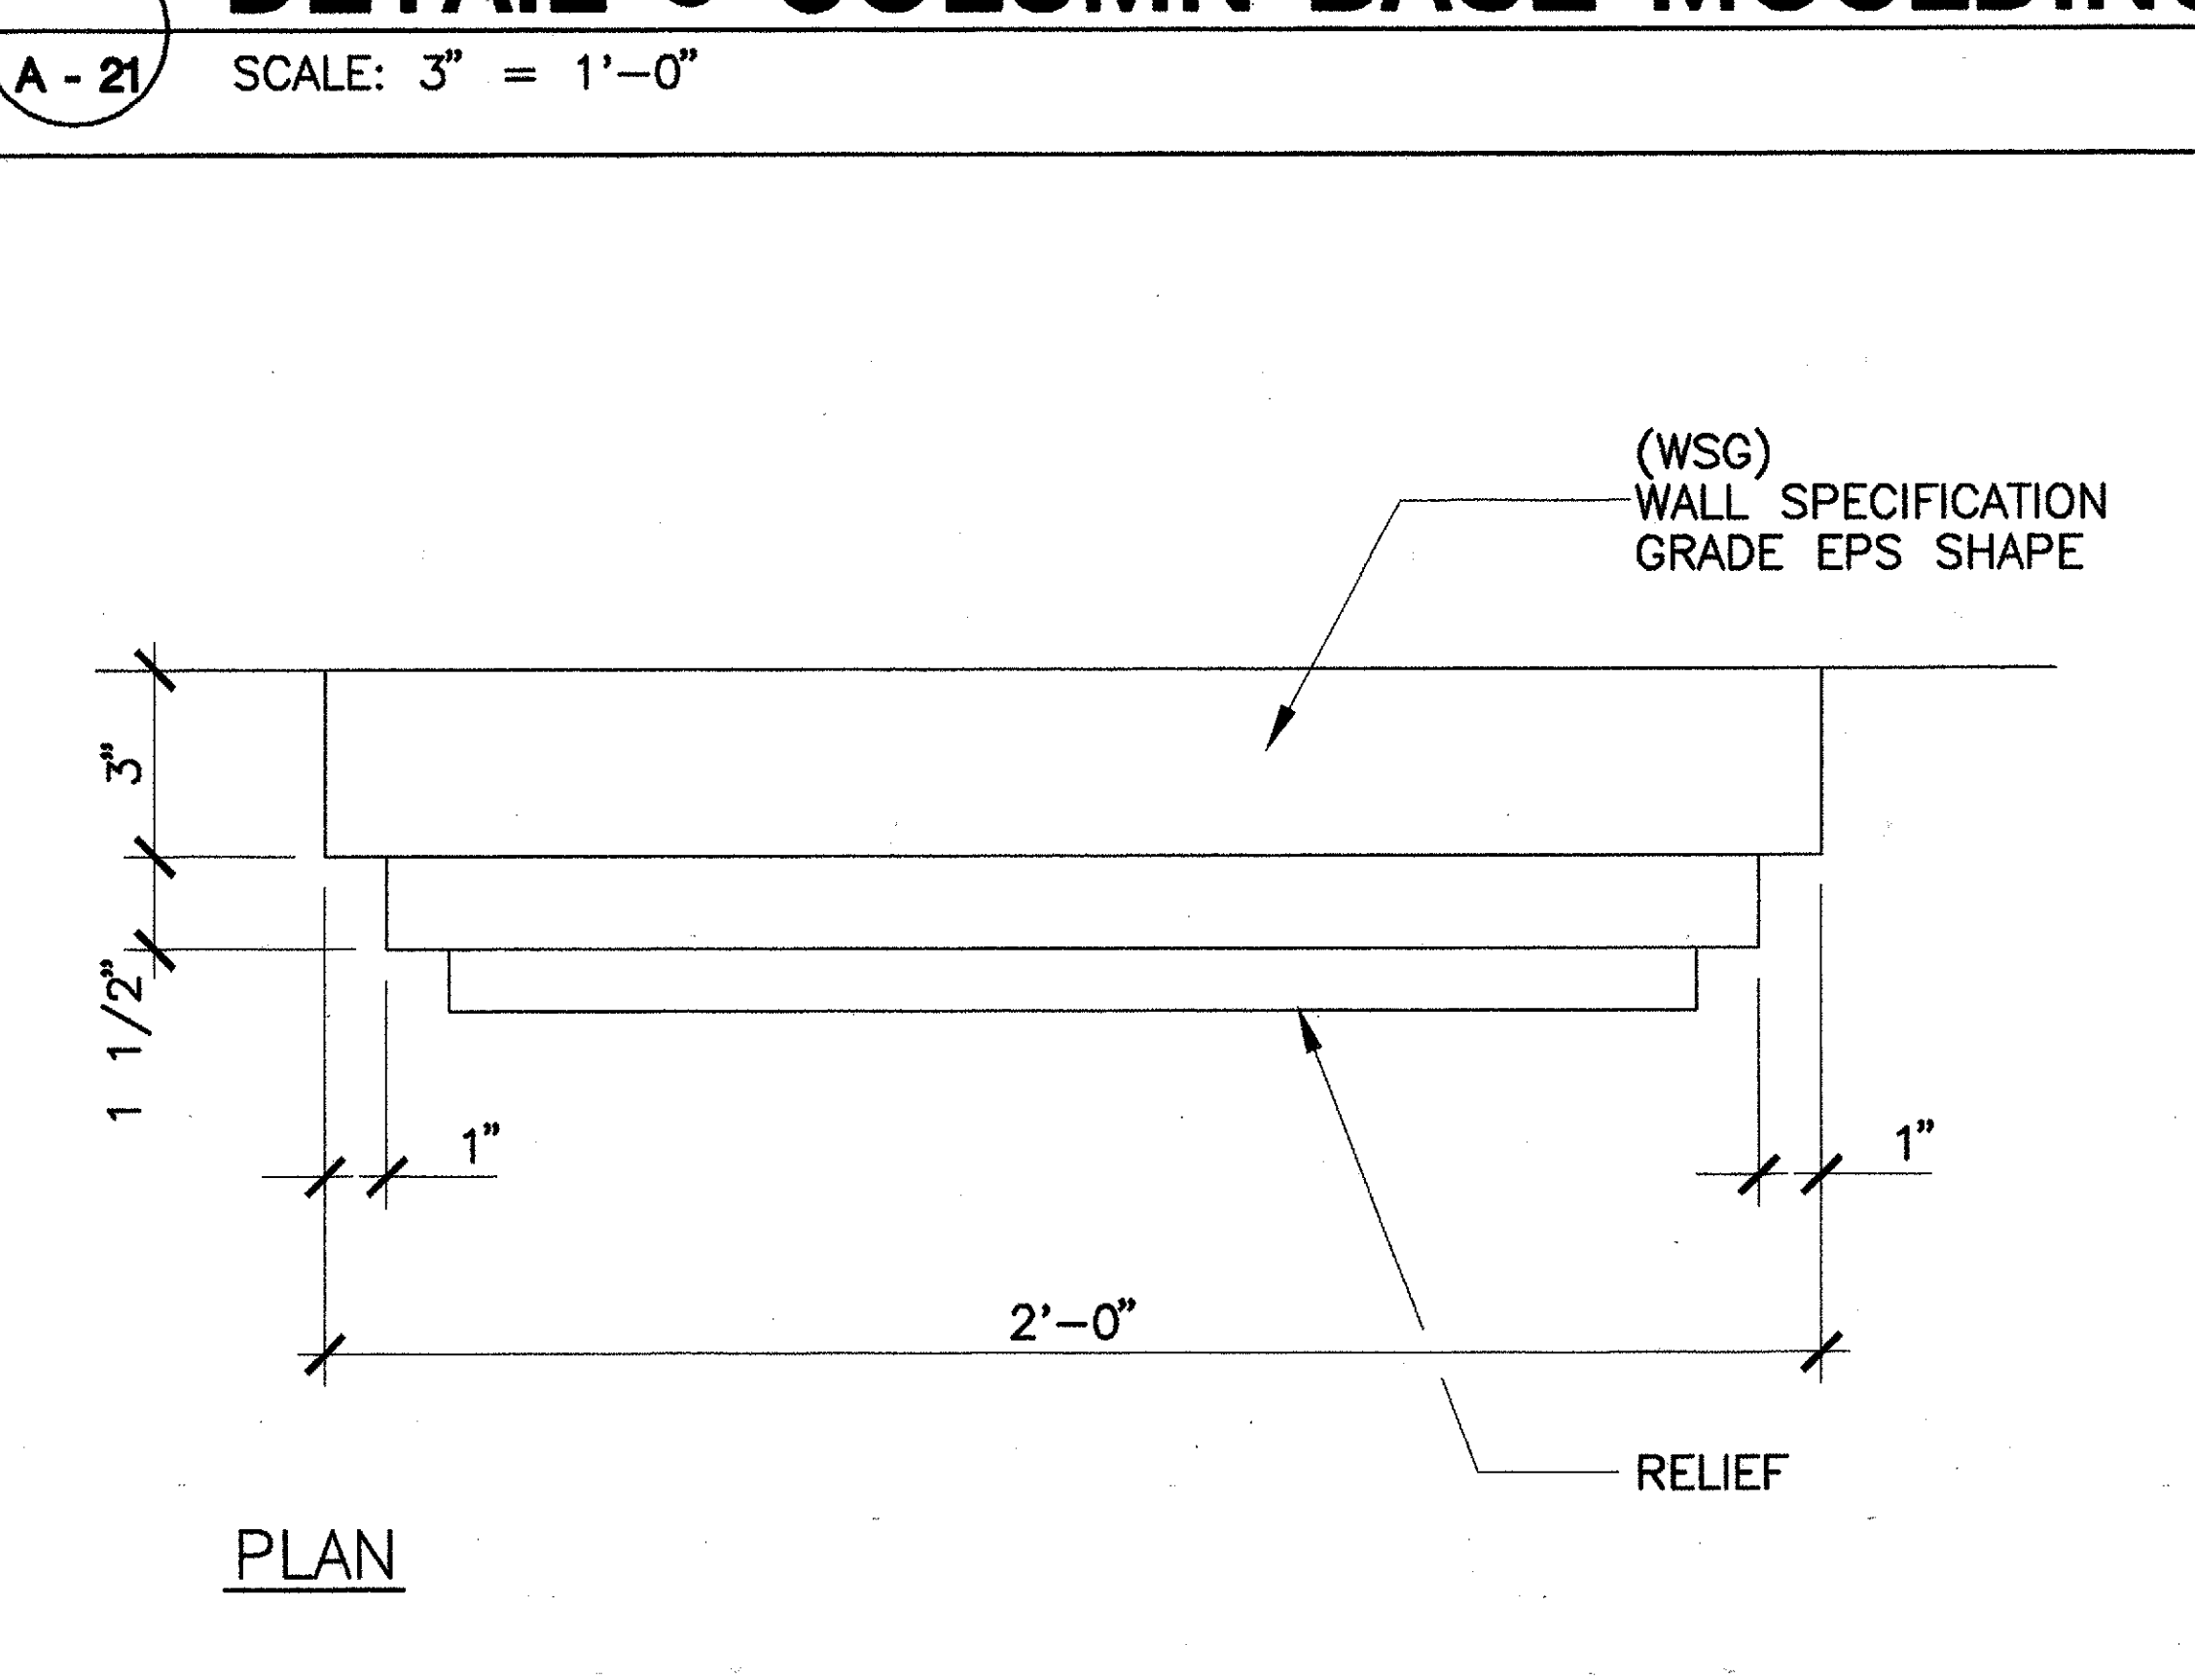


8 DETAIL @ CONT. WALL MOLDING
A-21 SCALE: 3" = 1'-0"

ROOM FINISH SCHEDULE


ROOM NAME	FLOOR				BASE		WALLS			CEILING			REMARKS
	VIN. COMP. TILE	CERAMIC TILE	BARE CONCRETE	RUBBER	4" RUBBER BASE		CER. TILE WAINS	PAINT	CARPET	NO CEILING	SUSP. ACOUS.	5/8" SUSP. GYP.	
LOBBY	•				•			•					
DATA ROOM	•				•			•					
WOMEN'S RESTROOM		•			•			•					
MEN'S RESTROOM		•			•			•					
JANITOR ROOM	•				•			•					
MECHANICAL ROOM #1			•		•								
MECHANICAL ROOM #2			•		•								
STORAGE ROOMS INCLUDING ELECTRICAL STORAGE AND CARPENTRY STORAGE	•				•			•					
ELECTRICAL ROOM #1	•				•			•					
ELECTRICAL ROOM #2	•				•			•					
TRASH ROOM			•		•			•					
MECHANICAL PUMPS CHILLER ROOM			•		•			•					
GENERATOR ROOM			•		•			•					
MAIN ELECTRIC ROOM			•		•			•					
ELEVATOR CABS				•	•			•					
STAIRWAYS					•			•					
BLIND VENDOR/STORAGE	•				•			•					
MAIL ROOM	•				•			•					
CUSTODIAN LOCKER/LUNCH ROOM	•				•			•					

COLOR SCHEDULE

NO.	ITEM	MANUFACTURER	COLOR	NO./STYLE	REMARKS
VCT-1	VINYL COMPOSITION TILE	MANNINGTON	BISQUE	107	"ESSENTIALS" 12" X 12"
B-1	RUBBER BASE	BURKE	TWEED	508	4" H X 4'-0" L
CT-1	FLOOR CERAMIC TILE	DAL-TILE	BUFF STONE	DK-147	2" x 2" UNGLAZED
CT-2	WAINSCOT MAIN BODY CERAMIC TILE	DAL-TILE	ALMOND	735 MATTE	4 1/4" X 4 1/4"
CT-3	WAINSCOT ACCENT #1	DAL-TILE	ALMOND	D-135	4 1/4" X 4 1/4"
CT-4	WAINSCOT ACCENT #2	DAL-TILE	MAYAN WHITE	D-400	4 1/4" X 4 1/4"
CL-1	SUSPENDED ACOUSTIC TILE CEILING	ARMSTRONG	WHITE	#574 SQ. CUT CIRBUS	2'-0" X 2'-0"
PT-1	INTERIOR PAINT	FULLER O'BRIEN	ANTIQUE LINEN	PRO-WHITE SEMI-GLOSS	-
PT-2	INTERIOR PAINT	FULLER O'BRIEN	BONE WHITE	PRO-WHITE-GLOSS	-
PT-3	EXTERIOR PAINT	FULLER O'BRIEN	ANTIQUE LINEN	PRO-WHITE EGGSHELL	-
PT-4	INTERIOR PAINT	FULLER O'BRIEN	PLATINUM	640-13	PENCHROME WOOD FINISHES
PT-5	EXTERIOR PAINT	FULLER O'BRIEN	COLONY SAND	G-95 - EGGSHELL	-
R-1	ROOF	MONIER	PALI GREEN	VILLA	-
AL-1	CURTAIN WALL FRAME	KAWNEER	HARTFORD MIST	PERMAIDIZE FINISH	-
PRT-1	TOILET PARTITIONS	AMPCO	TEAL GREEN		-
DPT-1	INTERIOR WOOD DOORS	FULLER O'BRIEN	PLATINUM	640-13 PENCHROME STAIN	-
DPT-2	METAL DOORS PAINT	FULLER O'BRIEN	BONE WHITE	PRO-WHITE-GLOSS	-
CPT-1	CARPET	PRINCE STREET	OKLAHOMA - NT27339	NATIONAL TOUR	-
CPT-2	CARPET	MAHARAM OR EXECUWALK II	19080-34 SPRUCE		SOLIDS @ ELEVATOR CAB
B-2	RUBBER FLOOR	ENDURA	BROWN		STAIR TREADS AT STAIRWAY
PL-1	PLASTIC LAMINATE	WILSONART	LIGHT BEIGE	1531-13	CHEMSURF

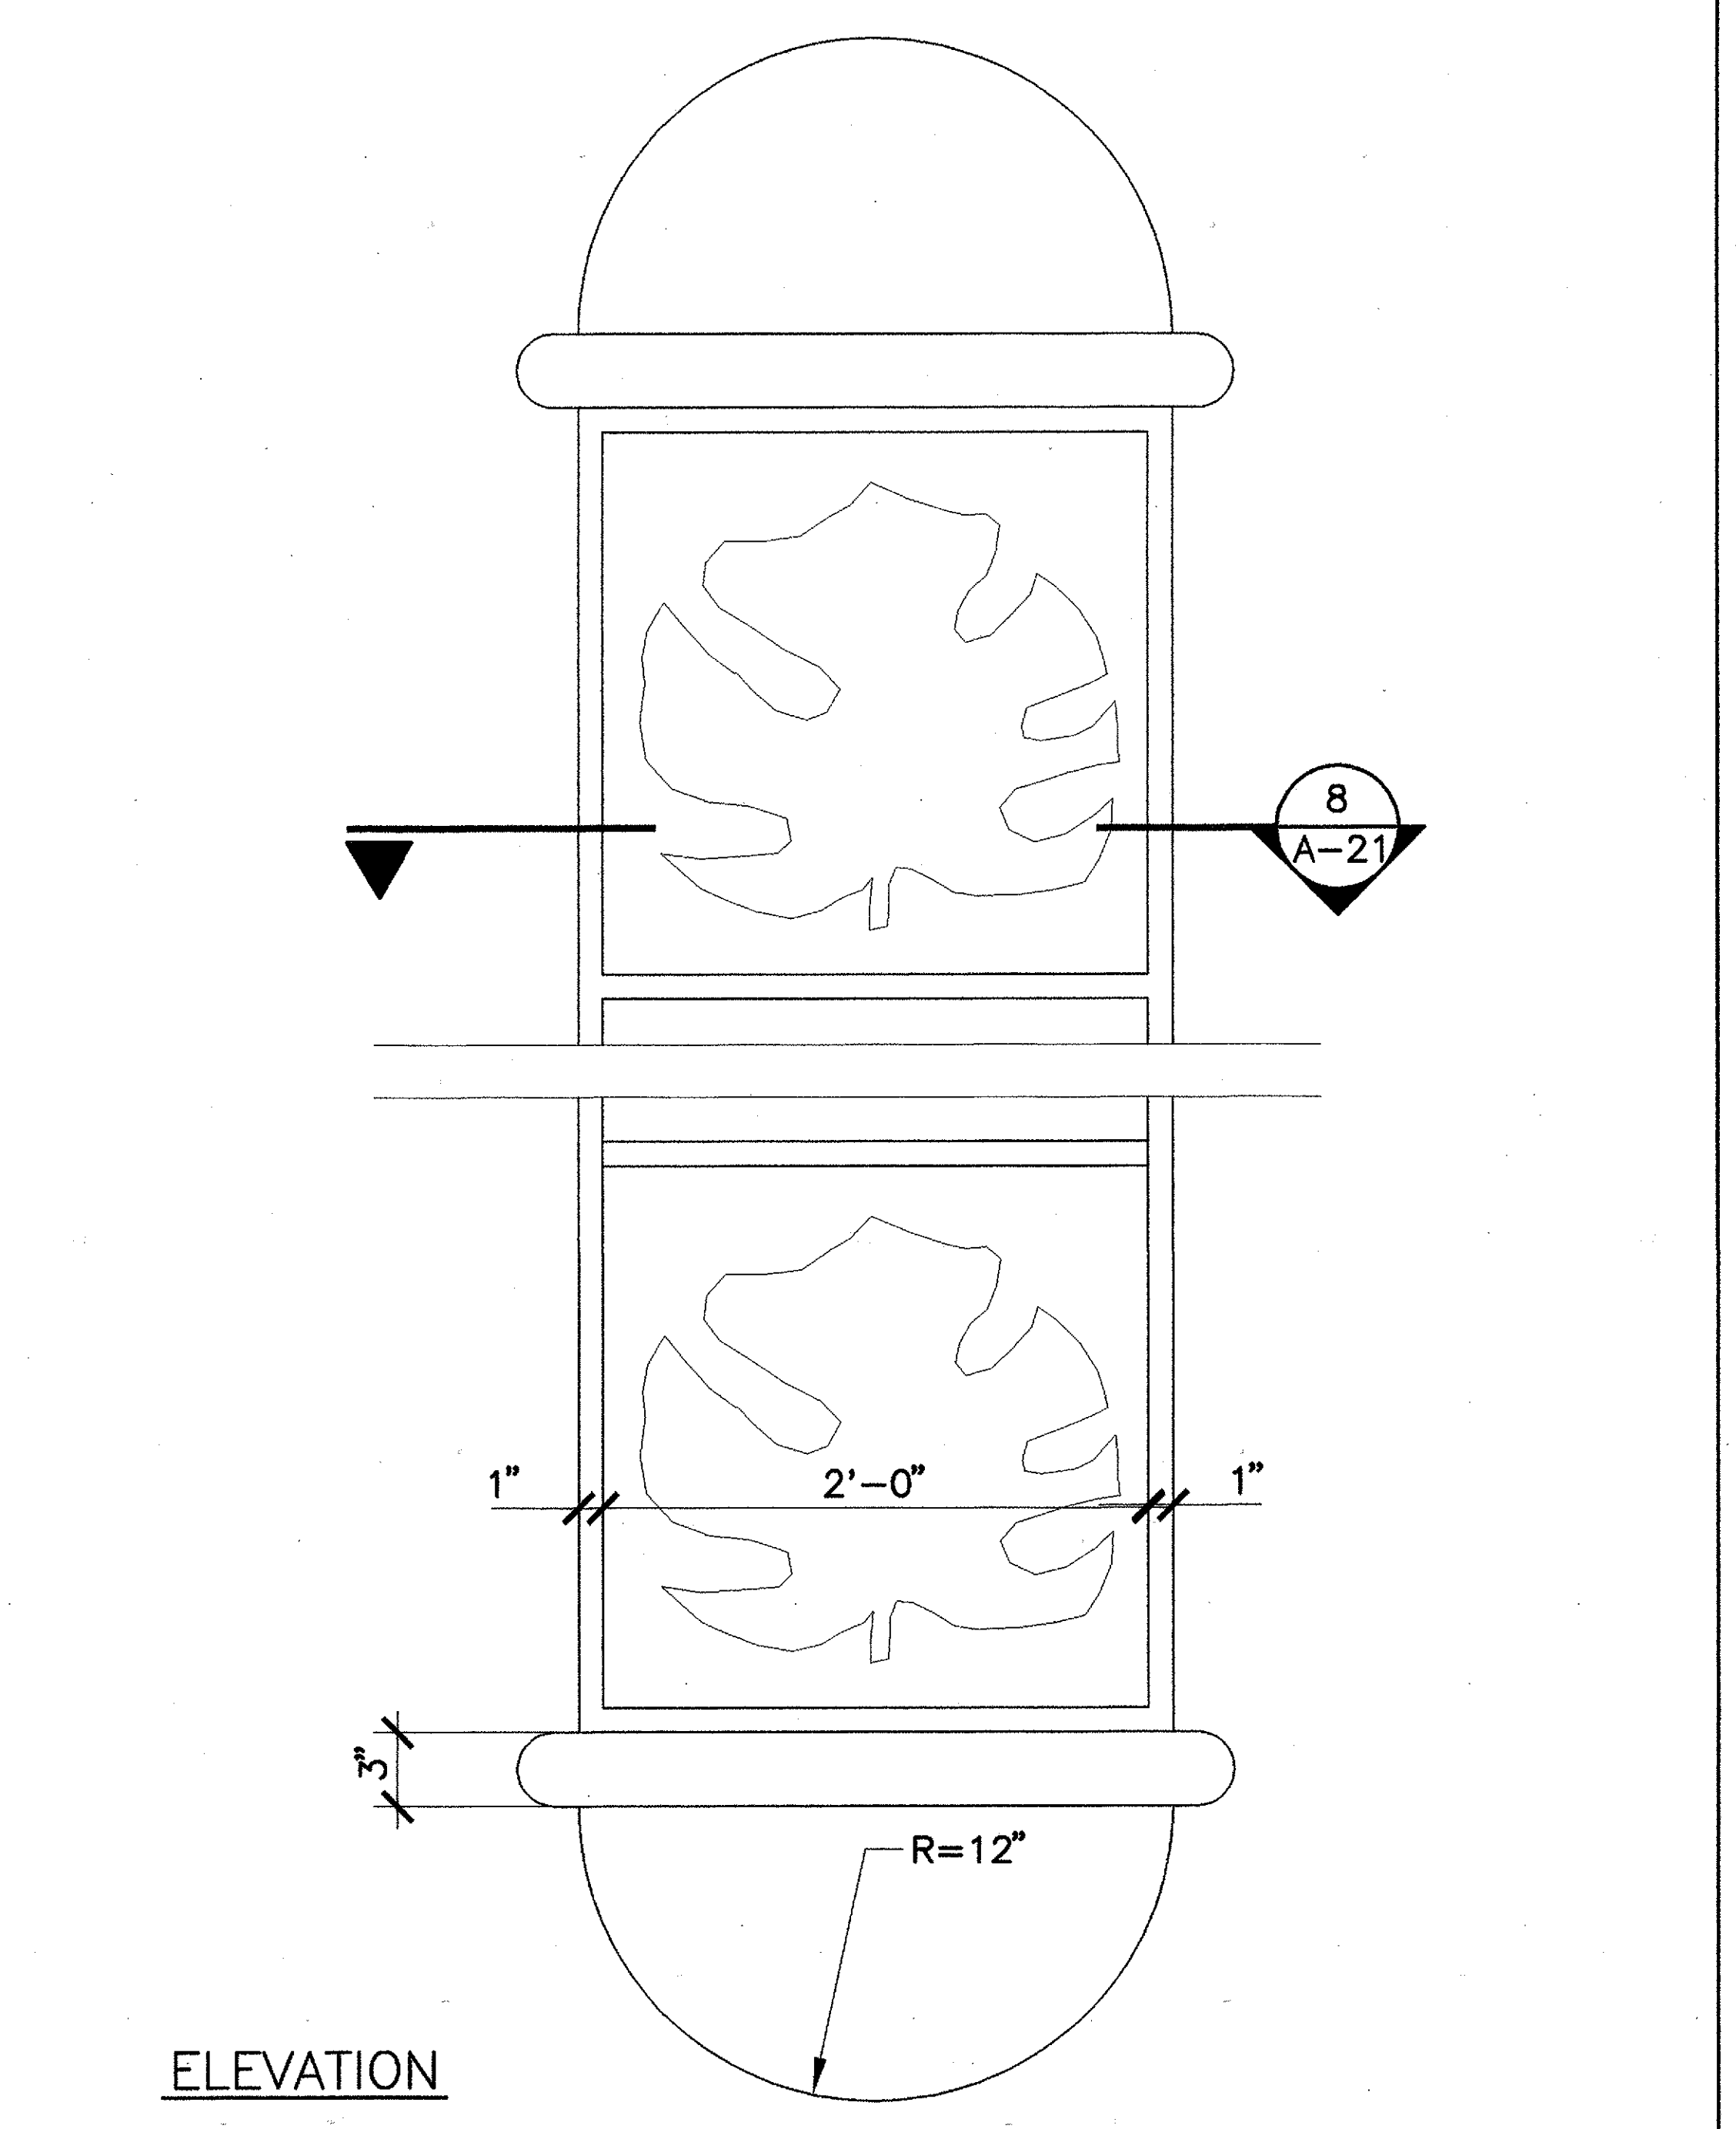

9 DETAIL @ CONT. WALL MOLDING
A-21 N.T.S.

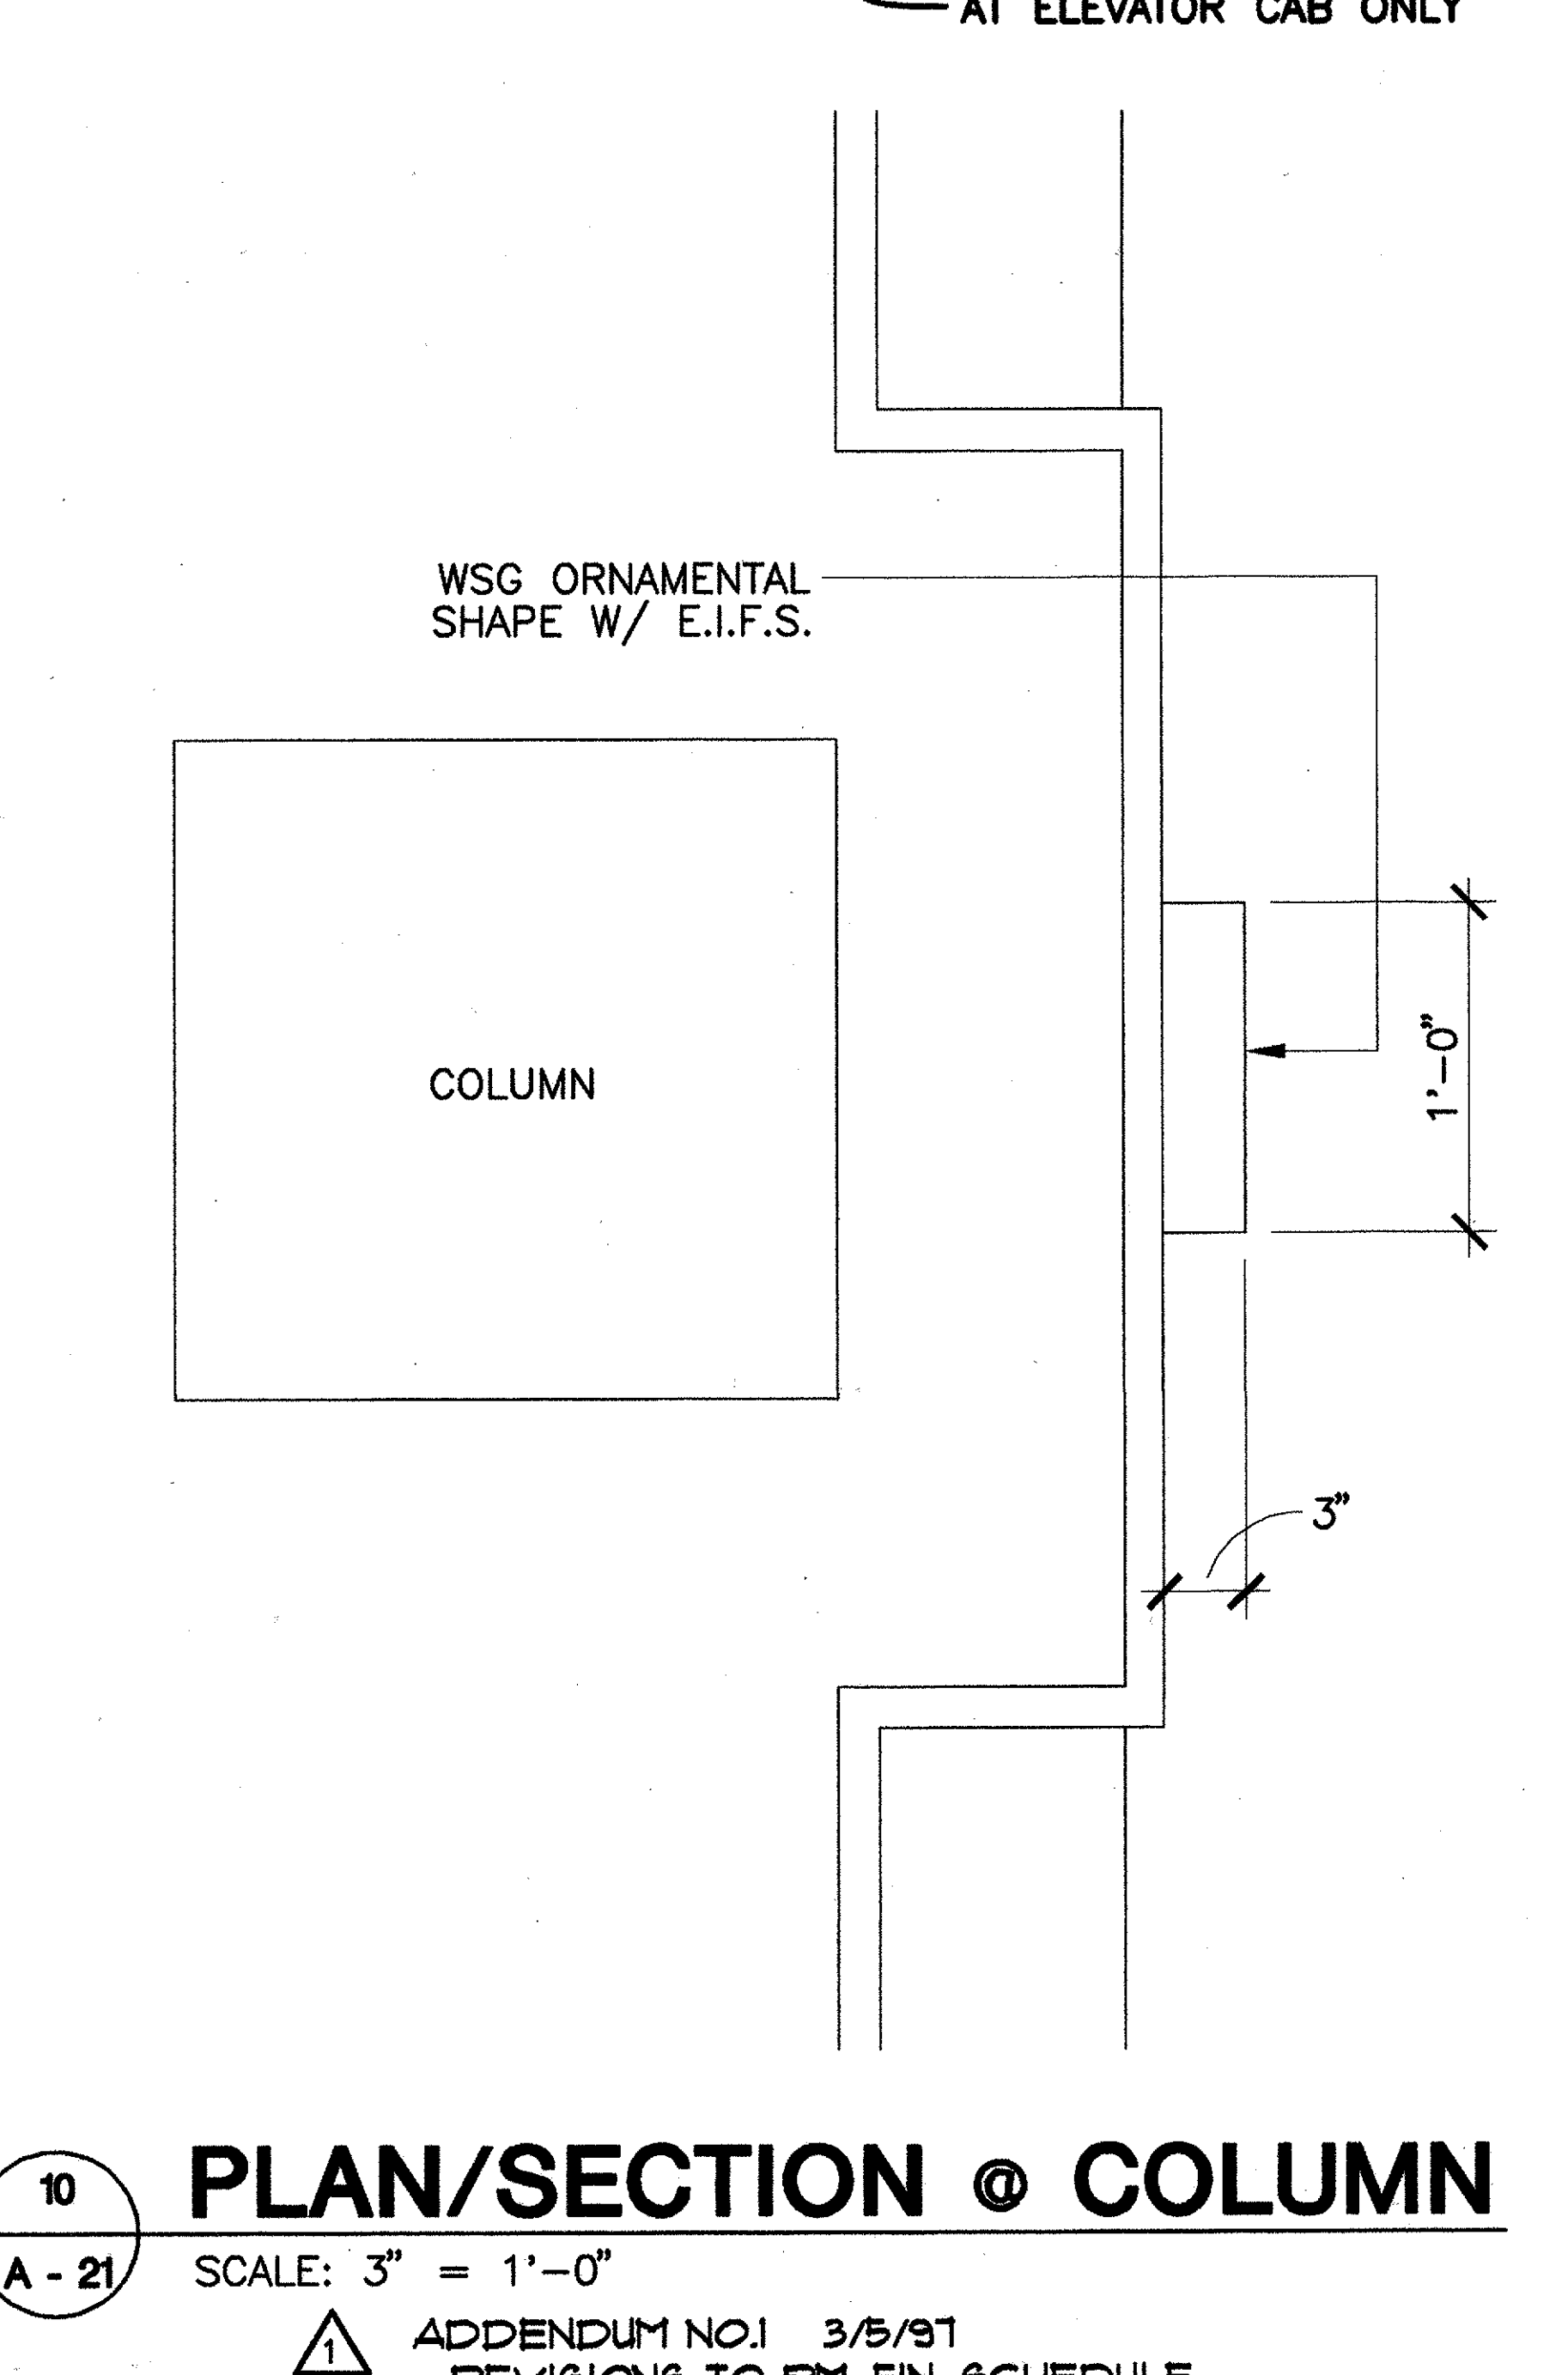

10 PLAN/SECTION @ COLUMN
A-21 SCALE: 3" = 1'-0"

ADDENDUM NO. 1 3/5/81
- REVISIONS TO R.M. FIN. SCHEDULE
GRAPHIC SCALE
AS BUILT

REVISIONS BY

THIS WORK WAS PREPARED BY ME OR UNDER MY CLOSE PERSONAL SUPERVISION AND TO THE BEST OF MY KNOWLEDGE AND BELIEF IT COMPLETLY ACCURATELY REPRESENTS THE DESIGN INTENT OF THE PROJECT. I AM NOT PROVIDING ANY WARRANTY OR GUARANTEE FOR THE WORK OR THE DESIGN. I AM NOT RESPONSIBLE FOR ANY CONSTRUCTION DEFECTS OR OMISSIONS. I AM NOT PROVIDING ANY DESIGN OR CONSTRUCTION SERVICES TO ANY OTHER PROJECTS. I AM NOT PROVIDING ANY DESIGN OR CONSTRUCTION SERVICES TO ANY OTHER PROJECTS. I AM NOT PROVIDING ANY DESIGN OR CONSTRUCTION SERVICES TO ANY OTHER PROJECTS.

MITCHELL & ASSOCIATES, INC.
ARCHITECTS
1410 KALANIANA'OLE BLVD., SUITE 100
HONOLULU, HI 96814
TEL: (808) 944-1111
FAX: (808) 944-2222

Sheet Title
FINISH SCHEDULE, COLOR SCHEDULE, & MISCELLANEOUS DETAILS

Date: APRIL 1, 1987
Scale: 3" = 1'-0"
Drawn By: ST
Job: A-46-627
Sheet: A-21

Kapolei Office Building - State Civic Center
DACS JOB NO. 12-10-4683