

**STATE OF HAWAII
DEPARTMENT OF TRANSPORTATION
AIRPORTS**

**ADDENDUM NO. 1
FOR
CBP FIS RENOVATION
DANIEL K. INOUE INTERNATIONAL AIRPORT
HONOLULU, OAHU, HAWAII
STATE PROJECT NO. CO1433-33**

August 13, 2026

This Addendum shall make the following amendment(s) to the Solicitation:

A. NOTICE TO BIDDERS

1. Prospective bidders are **hereby notified** that receiving of bids, scheduled for August 14, 2026, at 2:00 p.m., Hawaii Standard Time (HST), is **HEREBY POSTPONED** until **August 28, 2026, at 2:00 p.m., HST.**

The attached **NOTICE TO BIDDERS** dated r08/13/2026, shall be incorporated and made a part of the **NOTICE TO BIDDERS.**

B. TABLE OF CONTENTS

1. Delete **TABLE OF CONTENTS**, in its entirety and replace it with attached **TABLE OF CONTENTS**, dated r08/13/2026.

C. SPECIFICATIONS

1. Delete **SECTION 09650 RESILIENT FLOORING** in its entirety and replace it with attached **SECTION 09650 RESILIENT FLOORING**, dated r08/13/2026.
2. Add and make a part of the specifications the attached **SECTION 09670 FLUID-APPLIED FLOORING**, dated r08/13/2026.
3. Add and make a part of the specifications the attached **SECTION 09681 TILE CARPETING**, dated r08/13/2026.

D. PROPOSAL

1. Delete **PROPOSAL** dated r07/01/26, in its entirety, and replace it with attached **PROPOSAL**, dated r08/13/2026.

E. PLANS

1. Delete **PLANS SHEET NO. A-001 ABBREVIATIONS AND SYMBOLS LEGEND** and replace it with attached **PLANS SHEET NO. ADD. 1 A-001 ABBREVIATIONS AND SYMBOLS LEGEND**.
2. Delete **PLANS SHEET NO. A-104 ENLARGED FLOOR PLAN – CBP FLOORING** and replace it with attached **PLANS SHEET NO. ADD. 1 A-104 ENLARGED FLOOR PLAN – CBP FLOORING**.
3. Delete **PLANS SHEET NO. A-601 FINISH SCHEDULES** and replace it with attached **PLANS SHEET NO. ADD. 1 A-601 FINISH SCHEDULES**.
4. Delete **PLANS SHEET NO. A-603 SIGNAGE SCHEDULE AND MOUNTING HEIGHTS** and replace it with attached **PLANS SHEET NO. ADD. 1 A-603 SIGNAGE SCHEDULE AND MOUNTING HEIGHTS**.
5. Delete **PLANS SHEET NO. A-604 FURNITURE & EQUIPMENT PLAN AND FURNITURE SCHEDULE** and replace it with attached **PLANS SHEET NO. ADD. 1 A-604 FURNITURE & EQUIPMENT PLAN AND FURNITURE SCHEDULE**.

The following is provided for information.

F. PRE-BID MEETING MINUTES

1. The attached **PRE-BID MEETING MINUTES** and **ATTENDANCE SHEET** are provided for information.

G. RESPONSES TO REQUESTS FOR INFORMATION (RFI'S/QUESTIONS)

1. The attached **RESPONSES TO REQUESTS FOR INFORMATION** are provided for information.

Please acknowledge receipt of this **ADDENDUM NO. 1** by recording the date of its receipt in the space provided on the **PAGE P-4** of the Proposal.



CURT T. OTAGURO
Deputy Director of Transportation for Airports

NOTICE TO BIDDERS
Hawaii Revised Statutes (HRS),
Chapter 103D

The receiving of bids for **CBP FIS RENOVATION, DANIEL K. INOUE**
INTERNATIONAL AIRPORT, HONOLULU, OAHU, HAWAII,
PROJECT NO. CO1433-33, will begin as of the HiePRO Release Date. Bidders shall register
and submit complete bids through HiePRO only. Refer to the following HiePRO link for
important information on Vendor Registration: <https://hiepro.ehawaii.gov/welcome.html>.

The solicitation plans, specifications, proposal, and additional documents designated or
incorporated by reference shall be available in HiePRO.

HiePRO OFFER DUE DATE & TIME scheduled for August 14, 2026, at 2:00 p.m.,
Hawaii Standard Time (HST), is **HEREBY POSTPONED** until **August 28, 2026**, at
2:00 p.m., HST. Bidders shall submit and upload the complete proposal to HiePRO prior
to the offer due date and time. Proposals received after said due date and time shall not be
considered. Any additional support documents explicitly designated as confidential and/or
proprietary shall be uploaded as a separate file to HiePRO. Bidders shall not include
confidential and/or proprietary documents as part of their proposal. The record of each
bidder and their respective proposal shall be open to public inspection. FAILURE TO
UPLOAD THE PROPOSAL TO HiePRO SHALL BE GROUNDS FOR REJECTION.



CURT T. OTAGURO
Deputy Director of Transportation for Airports

TABLE OF CONTENTS

	<u>Page</u>
Instructions for Contractor's Licensing	HAI
Special Provisions	SP-1 to SP-5
Wage Rate Schedule (Not physically included in the Bid Documents)	
<u>SPECIFICATIONS PART I - GENERAL PROVISIONS</u>	
<u>SPECIFICATION PART II – TECHNICAL PROVISIONS</u>	
<u>DIVISION 1 - GENERAL REQUIREMENTS</u>	
SECTION 01010 DESCRIPTION OF WORK	01010-1 to 01010-6
SECTION 01210 ALLOWANCES	01210-1 to 01210-3
SECTION 01300 SUBMITTALS	01300-1 to 01300-8
SECTION 01310 PROJECT MANAGEMENT AND COORDINATION	01310-1 to 01310-4
SECTION 01330 SUBMITTAL PROCEDURES	01330-1 to 01330-8
SECTION 01400 CONTRACTOR QUALITY CONTROL PROGRAM	01400-1 to 01400-8
SECTION 01524 CONSTRUCTION WASTE MANAGEMENT	01524-1 to 01524-8
SECTION 01533 BARRICADES	01533-1
SECTION 01560 GENERAL ENVIRONMENTAL, HEALTH, AND SAFETY CONTROLS	01560-1 to 01560-4
SECTION 01561 CONSTRUCTION SITE POLLUTION CONTROLS	01561-1 to 01561-12
SECTION 01562 MANAGEMENT OF CONTAMINATED MEDIA, SOIL DISPOSAL, AND SOIL REUSE	01562-1 to 01562-14
SECTION 01565 SECURITY MEASURES	01565-1 to 01565-2
SECTION 01580 TEMPORARY FACILITIES AND UTILITIES	01580-1 to 01580-2
SECTION 01581 PROJECT IDENTIFICATION	01581-1 to 01581-3
SECTION 01600 PRODUCT REQUIREMENTS	01600-1 to 01600-4
SECTION 01611 VOLATILE ORGANIC COMPOUND (VOC) CONTENT RESTRICTIONS	01611-1 to 01611-3
SECTION 01700 EXECUTION AND CLOSEOUT REQUIREMENTS	01700-1 to 01700-12
SECTION 01715 EXISTING CONDITIONS – HAZARDOUS MATERIALS SURVEY	01715-1 to 01715-3
ATTACHMENT 1 – HAZARDOUS MATERIALS SURVEY REPORT IN SUPPORT OF THE STATE OF HAWAII DEPARTMENT OF TRANSPORTATION-AIRPORTS DIVISION STATE PROJECT NO. DO33 – CO1433-33 – CBP FIS RENOVATION	1 to 30
ATTACHMENT 2 – STATE OF HAWAII DEPARTMENT OF TRANSPORTATION AIRPORTS DIVISION HAZARDOUS MATERIALS REVIEW FORM	1
ATTACHMENT 3 – ARSENIC IN CANEC CEILINGS AND WALLBOARD IN HAWAII	1 to 3
SECTION 01780 CLOSEOUT SUBMITTALS	01780-1 to 01780-5
SECTION 01800 SPECIAL REQUIREMENTS FOR CONTRACTORS ON THE AOA	01800-1 to 01800-8
CBP FIS RENOVATION DANIEL K. INOUE INTERNATIONAL AIRPORT STATE PROJECT NO. CO1433-33	ADDENDUM NO. 1 TABLE OF CONTENTS TOC 1 of 3 r08/13/2026

DIVISION 2 – EXISTING CONDITIONS

SECTION 02070 DEMOLITION AND REMOVAL	02070-1 to 02070-6
SECTION 02410 SELECTIVE DEMOLITION	02410-1 to 02410-6

DIVISION 3 – CONCRETE

SECTION 03730 CONCRETE REPAIR	03730-1 to 03730-10
-------------------------------------	---------------------

DIVISION 4 (Not Used)

DIVISION 5 – METALS

SECTION 05120 STRUCTURAL STEEL	05120-1 to 05120-9
--------------------------------------	--------------------

DIVISION 6 – WOOD, PLASTICS, AND COMPOSITES

SECTION 06100 ROUGH CARPENTRY	06100-1 to 06100-2
-------------------------------------	--------------------

DIVISION 7 – THERMAL AND MOISTURE PROTECTION

SECTION 07520 MODIFIED BITUMINOUS MEMBRANE ROOFING	07520-1 to 07520-4
SECTION 07620 SHEET METAL FLASHING AND TRIM	07620-1 to 07620-3
SECTION 07920 JOINT SEALANTS	07920-1 to 07920-4

DIVISION 8 – DOORS AND FRAMES

SECTION 08111 HOLLOW METAL DOORS AND FRAMES	08111-1 to 08111-5
SECTION 08431 ALUMINUM-FRAMED STOREFRONTS	08431-1 to 08431-5
SECTION 08710 DOOR HARDWARE	08710-1 to 08710-7
SECTION 08800 GLAZING	08800-1 to 08800-5

DIVISION 9 – FINISHES

SECTION 09211 GYPSUM BOARD ASSEMBLIES	09211-1 to 09211-4
SECTION 09221 NON-STRUCTURAL METAL FRAMING	09221-1 to 09221-4
SECTION 09510 ACOUSTICAL CEILINGS	09510-1 to 09510-4
SECTION 09650 RESILIENT FLOORING	09650-1 to 09650-5
SECTION 09670 FLUID APPLIED FLOORING	09670-1 to 09670-3
SECTION 09681 TILE CARPETING	09681-1 to 09681-3
SECTION 09911 EXTERIOR PAINTING	09911-1 to 09911-5
SECTION 09912 INTERIOR PAINTING	09912-1 to 09912-7

DIVISION 10 – SPECIALTIES

SECTION 10142 PANEL SIGNAGE	10142-1 to 10142-3
-----------------------------------	--------------------

DIVISION 11 – EQUIPMENT

SECTION 11150 SECURITY CONTROL SYSTEM.....	11150-1 to 11150-12
--	---------------------

DIVISION 12 (Not Used)

DIVISION 13 – SPECIAL CONSTRUCTION

SECTION 13281 REMOVAL AND DISPOSAL OF ASBESTOS CONTAINING MATERIALS	13281-1 to 13281-23
SECTION 13282 LEAD PAINT CONTROL MEASURES	13282-1 to 13282-18
SECTION 13284 REMOVAL AND DISPOSAL OF ARSENIC-CONTAINING BUILDING PRODUCTS	13284-1 to 13284-16
SECTION 13288 TESTING AND AIR MONITORING	13288-1 to 13288-12
SECTION 13851 ADDRESSABLE FIRE ALARM SYSTEM	13851-1 to 13851-22

DIVISION 14 (Not Used)

DIVISION 15 – MECHANICAL

SECTION 15011 GENERAL MECHANICAL PROVISIONS	15011-1 to 15011-9
SECTION 15600 AIR CONDITIONING AND VENTILATION	15600-1 to 15600-20

DIVISION 16 – ELECTRICAL

SECTION 16050 ELECTRICAL WORK	16050-1 to 16050-13
SECTION 16510 LIGHTING.....	16510-1 to 16510-5
SECTION 16711 PATHWAYS FOR COMMUNICATIONS SYSTEMS ...	16711-1 to 16711-10
SECTION 16713 SLEEVE AND SLEEVE SEALS FOR COMMUNICATIONS PATHWAYS AND CABLING.....	16713-1 to 16713-5
SECTION 16717 COMMUNICATIONS HORIZONTAL CABLING	16717-1 to 16717-15

APPENDIX A: CONTRACTOR-PROCURED EQUIPMENT LIST	A-1
--	-----

Requirements of Chapter 104, HRS (eH104-3, Rev 05/24)	1 to 2
---	--------

Proposal.....	P-1 to P-8
---------------	------------

Proposal Schedule	P-9 to P-10
-------------------------	-------------

Surety Bid Bond

FORMS

Sample Contract
Performance Bond (Surety)
Performance Bond
Labor and Material Payment Bond (Surety)
Labor and Material Payment Bond
Chapter 104, HRS Compliance Certificate
Certification of Compliance for Employment of State Residents
Provisions to be Included in Construction Procurement Solicitation

SECTION 09650 – RESILIENT FLOORING

PART 1 – GENERAL

1.01 RELATED DOCUMENTS

The General Provisions for Construction Projects (2016), Special Provisions and General Requirements of the Specifications, apply to the work specified in this Section

1.02 REFERENCE STANDARDS

- A. ASTM E648 - Standard Test Method for Critical Radiant Flux of Floor-Covering Systems Using a Radiant Heat Energy Source; 2025a.
- B. ASTM F710 - Standard Practice for Preparing Concrete Floors to Receive Resilient Flooring; 2022.
- C. ASTM F1861 - Standard Specification for Resilient Wall Base; 2021 (Reapproved 2025).
- D. ASTM F1869 - Standard Test Method for Measuring Moisture Vapor Emission Rate of Concrete Subfloor Using Anhydrous Calcium Chloride; 2023.
- E. ASTM F2170 - Standard Test Method for Determining Relative Humidity in Concrete Floor Slabs Using in situ Probes; 2019a.
- F. ASTM F3261 - Standard Specification for Resilient Flooring in Modular Format with Rigid Polymeric Core; 2020.
- G. NFPA 253 - Standard Method of Test for Critical Radiant Flux of Floor Covering Systems Using a Radiant Heat Energy Source; 2023.
- H. RFCI (RWP) - Recommended Work Practices for Removal of Resilient Floor Coverings; 2018.

1.03 SUBMITTALS

- A. See SECTION 01300 - SUBMITTALS.
- B. Verification Samples: Submit two samples, 6 by 6 inch (___ by ___ mm) in size illustrating color and pattern for each resilient flooring product specified.
- C. Concrete Subfloor Test Report: Submit a copy of the moisture and alkalinity (pH) test reports.
- D. Installer's Qualification Statement.
- E. Maintenance Data: Include maintenance procedures, recommended maintenance materials, and suggested schedule for cleaning, stripping, and re-waxing.

F. Maintenance Materials: Furnish the following for Owner's use in maintenance of project.

1. See Section 01600 - PRODUCT REQUIREMENTS, for additional provisions.
2. Extra Flooring Material: 100 square feet (_____ square meters) of each type and color.

1.04 DELIVERY, STORAGE, AND HANDLING

- A. Upon receipt, immediately remove any shrink-wrap and check materials for damage and the correct style, color, quantity and run numbers.
- B. Store all materials off of the floor in an acclimatized, weather-tight space.

PART 2 – PRODUCTS

2.01 TILE FLOORING

- A. Resilient Tile with Rigid Polymeric Core: Printed film type, with transparent or translucent wear layer; polymeric rigid core with or without backing.
 1. Manufacturers:
 - a. HMTX Industries, LLC; Elemental Multi-Layer 0.55 : www.hmtxcommercial.com/#sle.
 - b. Karndean Designflooring; Karndean Korlok Select: www.karndean.com/#sle.
 2. Minimum Requirements: Comply with ASTM F3261, Class I; Type B - Embossed; Grade 1 - Commercial.
 3. Critical Radiant Flux (CRF): Minimum 0.45 watt per square centimeter, when tested in accordance with ASTM E648.
 4. Plank Tile Size: 6 by 36 inches (150 by 914 mm).
 5. Wear Layer Thickness: 0.020 inch (0.5 mm).
 6. Total Thickness: 0.26 inch (6.5 mm).
 7. Color: As indicated on drawings.
- B. Static Control Tile - Type RES-2: Homogeneous; color and pattern throughout thickness.
 1. Manufacturers:
 - a. Flexco Corporation; Delane ESD Vinyl: www.flexcofloors.com/#sle.

- b. Roppe Corporation; ESD Vinyl Static Control Tile: www.roppe.com/#sle.
- 2. Critical Radiant Flux (CRF): Minimum 0.45 watt per square centimeter, when tested in accordance with ASTM E648 or NFPA 253.
- 3. Tile Size: 12 by 12 inch (305 by 305 mm).
- 4. Total Thickness: 0.125 inch (3 mm).
- 5. Color: To be selected by Architect from manufacturer's full range.

2.02 RESILIENT BASE

- A. Resilient Base: ASTM F1861, Type TP, rubber, thermoplastic; provide cove base at resilient or solid flooring and straight base at carpet tile flooring.
 - 1. Height: 4 inches (100 mm).
 - 2. Thickness: 0.125 inch (3.2 mm).
 - 3. Finish: Satin.
 - 4. Length: Roll.
 - 5. Color: To be selected by Architect from manufacturer's full range.
 - 6. Accessories: Premolded external corners and internal corners.

2.03 ACCESSORIES

- A. Primers, Adhesives, and Seam Sealer: Waterproof; types recommended by flooring manufacturer.
- B. Adhesive for Vinyl Flooring: as recommended by flooring manufacturer.
- C. Moldings, Transition and Edge Strips: Same material as flooring.
- D. Copper Grounding Strips: Type and size as recommended by static control flooring manufacturer.

PART 3 – EXECUTION

3.01 EXAMINATION

- A. Verify that surfaces are flat to tolerances acceptable to flooring manufacturer, free of cracks that might telegraph through flooring, clean, dry, and free of curing compounds, surface hardeners, and other chemicals that might interfere with bonding of flooring to substrate.

- B. Verify that wall surfaces are smooth and flat within the tolerances specified for that type of work, are dust-free, and are ready to receive resilient base.
- C. Cementitious Subfloor Surfaces: Verify that substrates are ready for resilient flooring installation by testing for moisture and alkalinity (pH).
 - 1. Test as Follows:
 - a. Alkalinity (pH): ASTM F710.
 - b. Internal Relative Humidity: ASTM F2170.
 - c. Moisture Vapor Emission: ASTM F1869.
 - 2. Obtain instructions if test results are not within limits recommended by resilient flooring manufacturer and adhesive materials manufacturer.

3.02 PREPARATION

- A. Remove existing resilient flooring and flooring adhesives; follow the recommendations of RFCI (RWP).
- B. Prepare floor substrates as recommended by flooring and adhesive manufacturers.
- C. Remove subfloor ridges and bumps. Fill minor low spots, cracks, joints, holes, and other defects with subfloor filler to achieve smooth, flat, hard surface.
- D. Prohibit traffic until filler is fully cured.
- E. Clean substrate.

3.03 INSTALLATION - GENERAL

- A. Starting installation constitutes acceptance of subfloor conditions.
- B. Install in accordance with manufacturer's written instructions.
- C. Adhesive-Applied Installation:
 - 1. Fit joints and butt seams tightly.
 - 2. Set flooring in place, press with heavy roller to attain full adhesion.
- D. Where type of floor finish, pattern, or color are different on opposite sides of door, terminate flooring under centerline of door.
- E. Install edge strips at unprotected or exposed edges, where flooring terminates, and where indicated.
 - 1. Resilient Strips: Attach to substrate using adhesive.

- F. Scribe flooring to walls, columns, cabinets, floor outlets, and other appurtenances to produce tight joints.

3.04 INSTALLATION - TILE FLOORING

Mix tile from container to ensure shade variations are consistent when tile is placed, unless otherwise indicated in manufacturer's installation instructions.

3.05 INSTALLATION - RESILIENT BASE

- A. Fit joints tightly and make vertical. Maintain minimum dimension of 18 inches (45 mm) between joints.
- B. Install base on solid backing. Bond tightly to wall and floor surfaces.

3.06 CLEANING

- A. Remove excess adhesive from floor, base, and wall surfaces without damage.
- B. Clean in accordance with manufacturer's written instructions.

3.07 PROTECTION

Prohibit traffic on resilient flooring for 48 hours after installation.

PART 4 – MEASUREMENT AND PAYMENT

4.01 BASIS OF MEASUREMENT AND PAYMENT

Work under this section will not be measured nor paid for separately but shall be considered incidental to and included in the prices bid for the various items of work in this project.

END OF SECTION

SECTION 09670 – FLUID-APPLIED FLOORING

PART 1 – GENERAL

1.01 RELATED DOCUMENTS

The General Provisions for Construction Projects (2016), Special Provisions and General Requirements of the Specifications, apply to the work specified in this Section.

1.02 REFERENCE STANDARDS

- A. ASTM F710 - Standard Practice for Preparing Concrete Floors to Receive Resilient Flooring; 2022.
- B. ASTM F1869 - Standard Test Method for Measuring Moisture Vapor Emission Rate of Concrete Subfloor Using Anhydrous Calcium Chloride; 2023.
- C. ASTM F2170 - Standard Test Method for Determining Relative Humidity in Concrete Floor Slabs Using in situ Probes; 2019a.

1.03 SUBMITTALS

- A. See SECTION 01300 – SUBMITTALS.
- B. Product Data: Provide data on specified products, describing physical and performance characteristics; sizes, patterns and colors available; and limitations.
- C. Concrete Subfloor Test Report: Submit a copy of the moisture and alkalinity (pH) test reports.
- D. Manufacturer's Installation Instructions: Indicate special procedures, perimeter conditions requiring special attention, and application rate for each coat.
- E. Manufacturer's Qualification Statement.
- F. Maintenance Data: Include maintenance procedures, recommended maintenance materials, procedures for stain removal, repairing surface, and suggested schedule for cleaning.

1.04 DELIVERY, STORAGE, AND HANDLING

Store resin materials in a dry, secure area.

PART 2 – PRODUCTS

2.01 FLUID-APPLIED FLOORING SYSTEMS

- A. Fluid-Applied Flooring Type EPX-1: Epoxy, with aggregate.

1. Aggregate: manufacturer's standard texture granules.
2. System Thickness: 40 mils (1 mm), nominal, dry film thickness (DFT).
3. Texture: Slip resistant.
4. Sheen: Gloss.
5. Color: As selected by Architect.
6. Products:
 - a. Mapei Corporation; Mapefloor System 31: www.mapei.com/#sle.
 - b. PPG Flooring; 912 LV Epoxy Primer/Sealer with 610 SL Self-Leveling Epoxy and Epoxy Siloxane FLR650-0 Series, Gloss: www.pittsburghpaintsco.com/#sle and www.ppgpmc.com/home.aspx/#sle.
 - c. TNEMEC; 1/16" to 1/8" Pigmented High-Wear System: www.tnemec.com/#sle.
 - d. Westcoat Specialty Coating Systems; Double Broadcast Epoxy Dubro Quartz: www.westcoat.com/#sle.

PART 3 – EXECUTION

3.01 EXAMINATION

- A. Verify that subfloor surfaces are dust-free and free of substances that could impair bonding of materials to subfloor surfaces.
- B. Cementitious Subfloor Surfaces: Verify that substrates are ready for fluid-applied flooring installation by testing for moisture and alkalinity (pH).
 1. Test as Follows:
 - a. Alkalinity (pH): ASTM F710.
 - b. Internal Relative Humidity: ASTM F2170.
 - c. Moisture Vapor Emission: ASTM F1869.
 2. Obtain instructions if test results are not within limits recommended by fluid-applied flooring manufacturer.

3.02 PREPARATION

- A. Remove subfloor ridges and bumps. Fill low spots, cracks, joints, holes, and other defects with subfloor filler.
- B. Vacuum clean substrate.
- C. Apply primer to surfaces required by flooring manufacturer.

3.03 INSTALLATION - FLOORING

- A. Apply in accordance with manufacturer's instructions.
- B. Apply each coat to minimum thickness required by manufacturer.
- C. Finish to smooth level surface.

3.04 PROTECTION

- A. Prohibit traffic on floor finish for 48 hours after installation.
- B. Barricade area to protect flooring until fully cured.

PART 4 – MEASUREMENT AND PAYMENT

4.01 BASIS OF MEASUREMENT AND PAYMENT

Work under this section will not be measured nor paid for separately but shall be considered incidental to and included in the prices bid for the various items of work in this project.

END OF SECTION

SECTION 09681 – TILE CARPETING

PART 1 – GENERAL

1.01 RELATED DOCUMENTS

The General Provisions for Construction Projects (2016), Special Provisions and General Requirements of the Specifications, apply to the work specified in this Section.

1.02 REFERENCE STANDARDS

- A. ASTM F710 - Standard Practice for Preparing Concrete Floors to Receive Resilient Flooring; 2022.
- B. ASTM F1869 - Standard Test Method for Measuring Moisture Vapor Emission Rate of Concrete Subfloor Using Anhydrous Calcium Chloride; 2023.
- C. ASTM F2170 - Standard Test Method for Determining Relative Humidity in Concrete Floor Slabs Using in situ Probes; 2019a.

1.03 SUBMITTALS

- A. See SECTION 01300 - SUBMITTALS.
- B. Product Data: Provide data on specified products, describing physical and performance characteristics; sizes, patterns, colors available, and method of installation.
- C. Samples: Submit two carpet tiles illustrating color and pattern design for each carpet color selected.
- D. Concrete Subfloor Test Report: Submit a copy of the moisture and alkalinity (pH) test reports.
- E. Manufacturer's Qualification Statement.

PART 2 – PRODUCTS

2.01 MATERIALS

Tile Carpeting, Type CPT-1: Tufted, manufactured in one color dye lot.

2.02 ACCESSORIES

- A. Subfloor Filler: White premix latex; type recommended by flooring material manufacturer.
- B. Edge Strips: Embossed aluminum, color as selected by Architect.

C. Adhesives:

1. Compatible with materials being adhered; maximum VOC content of 50 g/L; CRI (GLP) certified; in lieu of labeled product, independent test report showing compliance is acceptable.

D. Carpet Tile Adhesive: Recommended by carpet tile manufacturer; releasable type.

PART 3 – EXECUTION

3.01 EXAMINATION

- A. Verify that subfloor surfaces are dust-free and free of substances that could impair bonding of adhesive materials to subfloor surfaces.
- B. Cementitious Subfloor Surfaces: Verify that substrates are ready for flooring installation by testing for moisture and alkalinity (pH).
 1. Test as Follows:
 - a. Alkalinity (pH): ASTM F710.
 - b. Internal Relative Humidity: ASTM F2170.
 - c. Moisture Vapor Emission: ASTM F1869.
 2. Obtain instructions if test results are not within limits recommended by flooring material manufacturer and adhesive materials manufacturer.

3.02 PREPARATION

- A. Prepare floor substrates as recommended by flooring and adhesive manufacturers.
- B. Remove subfloor ridges and bumps. Fill minor or local low spots, cracks, joints, holes, and other defects with subfloor filler.
- C. Apply, trowel, and float filler to achieve smooth, flat, hard surface. Prohibit traffic until filler is cured.
- D. Vacuum clean substrate.

3.03 INSTALLATION

- A. Starting installation constitutes acceptance of subfloor conditions.
- B. Install carpet tile in accordance with manufacturer's instructions.
- C. Blend carpet from different cartons to ensure minimal variation in color match.
- D. Cut carpet tile clean. Fit carpet tight to intersection with vertical surfaces without gaps.

- E. Lay carpet tile in square pattern, with pile direction parallel to next unit, set parallel to building lines.
- F. Trim carpet tile neatly at walls and around interruptions.
- G. Complete installation of edge strips, concealing exposed edges.

PART 4 – MEASUREMENT AND PAYMENT

4.01 BASIS OF MEASUREMENT AND PAYMENT

Work under this section will not be measured nor paid for separately but shall be considered incidental to and included in the prices bid for the various items of work in this project

END OF SECTION

PROPOSAL TO THE
STATE OF HAWAII
DEPARTMENT OF TRANSPORTATION

PROJECT: CBP FIS Renovation
Daniel K. Inouye International Airport
Honolulu, Oahu, Hawaii

PROJECT NO.: CO1433-33

COMPLETION TIME: TWO HUNDRED SEVENTY (270) calendar days from the date indicated in the Notice to Proceed from the Department.

LIQUIDATED DAMAGES: FIVE HUNDRED DOLLARS (\$500.00) for each and every calendar day which the Contractor has delayed the completion of this project.

PROJECT MANAGER: Ms. Erin Hashimoto
Department of Transportation Airports
Daniel K. Inouye International Airport
400 Rodgers Boulevard, Suite 700
Honolulu, HI 96819-1880
Phone: (808) 838-8803
Email: erin.a.hashimoto@hawaii.gov

ELECTRONIC SUBMITTAL: **Bidders shall submit and upload the complete proposal to HlePRO prior to the bid opening date and time. Any additional support documents explicitly designated as confidential and/or proprietary shall be uploaded as a separate file to HlePRO. See SPECIAL PROVISIONS 2.8 PREPARATION AND DELIVERY OF BID for complete details. FAILURE TO UPLOAD THE COMPLETE PROPOSAL TO HlePRO SHALL BE GROUNDS FOR REJECTION OF THE BID.**

Director of Transportation
869 Punchbowl Street
Honolulu, Hawaii 96813

Dear Sir:

The undersigned Bidder declares the following:

1. It has not, either directly or indirectly, entered into any agreement, participated in any collusion, or otherwise taken any action in restraint of free competitive bidding in connection with this proposal.
2. It has not been assisted or represented on this matter by any individual who has, in a State capacity, been involved in the subject matter of this contract within the past two years.
3. It has not and will not, either directly or indirectly offered or given a gratuity (i.e. an entertainment or gift) to any State or County employee to obtain a contract or favorable treatment under a contract.

The undersigned Bidder further agrees to the following:

1. If this proposal is accepted, it shall execute a contract with the Department to provide all necessary labor, machinery, tools, equipment, apparatus and any other means of construction, to do all the work and to furnish all the materials specified in the contract in the manner and within the time therein prescribed in the contract, and that it shall accept in full payment therefore the sum of the unit and/or lump sum prices as set forth in the attached proposal schedule for the actual quantities of work performed and materials furnished and furnish satisfactory security in accordance with Section 103D-324, Hawaii Revised Statutes, within 10 days after the award of the contract or within such time as the Director of Transportation may allow after the undersigned has received the contract documents for execution, and is fully aware that non-compliance with the aforementioned terms will result in the forfeiture of the full amount of the bid guarantee required under Section 103D-323, Hawaii Revised Statutes.
2. That the quantities given in the attached proposal schedule are approximate only and are intended principally to serve as a guide in determining and comparing the bids.
3. That the Department does not either expressly or by implication, agree that the actual amount of work will correspond therewith, but reserves the right to increase or decrease the amount of any class or portion of the work, or to omit portions of the work, as may be deemed necessary or advisable by the Director of Transportation, and that all increased or decreased quantities of work shall be performed at the unit prices set forth in the attached proposal schedule except as provided for in the specifications.

4. In case of a discrepancy between unit prices and the totals in said Proposal Schedule, the unit prices shall prevail.
5. Agrees to begin work within 10 working days after the date of notification to commence with the work, which date is in the notice to proceed, and shall finish the entire project within the time prescribed.
6. The Director of Transportation reserves the right to reject any or all bids and to waive any defects when in the Director's opinion such rejections or waiver will be for the best interest of the public.
7. The undersigned Bidder further agrees to the following: Pursuant to HRS §103D-405(d), any contractor (including consultants) paid for services to develop or prepare specifications or work statements shall be precluded from submitting an offer or receiving a contract for that particular solicitation. This includes the preparation of reports relied upon by HDOT in the development of the project scope.

The Bidder acknowledges receipt of and certifies that it has completely examined the following listed items: the Hawaii Department of Transportation, Air and Water Transportation Facilities Division General Provisions for Construction Projects dated 2016, the Notice to Bidders, the Special Provisions, if any, the Technical Provisions, the Proposal, the Contract and Bond Forms, and the Project Plans.

In accordance with Section 103D-323, Hawaii Revised Statutes, this proposal is accompanied with a bid security in the amount of 5% of the total amount bid, in the form checked below. (Check applicable bid security submitted with bid.)

_____ Surety Bid Bond (Use standard form),

_____ Cash,

_____ Cashier's Check,

_____ Certified Check, or

_____ .
(Fill in other acceptable security.)

The undersigned Bidder acknowledges receipt of any addendum issued by the Department by recording in the space below the date of receipt.

Addendum No. 1 _____

Addendum No. 3 _____

Addendum No. 2 _____

Addendum No. 4 _____

In accordance with Section 103D-302, Hawaii Revised Statutes, the undersigned as Bidder, has listed the name of each person or firm, who will be engaged by the Bidder on the project as a Subcontractor or Joint Contractor and the nature of work to be done by each. **The Bidder must adequately and unambiguously disclose the unique nature and scope of the work to be performed by each Subcontractor or Joint Contractor.** For each listed firm, the Bidder declares the respective firm is a Subcontractor or Joint Contractor and is subject to evaluation as a Subcontractor or Joint Contractor. It is understood that failure to comply with the aforementioned requirements may be cause for rejection of the bid submitted.

<u>Name of Subcontractor</u>	<u>Nature and Scope of Work</u>
1. _____	_____
2. _____	_____
3. _____	_____
4. _____	_____
5. _____	_____
6. _____	_____
7. _____	_____
8. _____	_____

<u>Name of Joint Contractor</u>	<u>Nature and Scope of Work</u>
1. _____	_____
2. _____	_____
3. _____	_____

NOTES:

"None" or if left blank indicates no Subcontractor or Joint Contractor.

If more space is needed, attach additional sheets.

The undersigned hereby certifies that the bid prices contained in the attached proposal schedule have been carefully checked and are submitted as correct and final.

This declaration is made with the understanding that the undersigned is subject to the penalty of perjury under the laws of the United States and is in violation of the Hawaii Penal Code, Section 710-1063, unsworn falsification to authorities, of the Hawaii Revised Statutes, for knowingly rendering a false declaration.

Bidder (Company Name)

By _____
Authorized Signature

Print Name and Title

Business Address

Business Telephone

Date

Contact Person (If different from above)

Phone: _____ Email: _____

NOTE:

If Bidder is a CORPORATION, the legal name of the corporation shall be set forth above, the corporate seal affixed, together with the signature(s) of the officer(s) authorized to sign contracts for the corporation. Please attach to this page current (not more than six months old) evidence of the authority of the officer(s) to sign for the corporation.

If Bidder is a PARTNERSHIP, the true name of the partnership shall be set forth above, with the signature(s) of the general partner(s). Please attach to this page current (not more than six months old) evidence of the authority of the partner authorized to sign for the partnership.

If Bidder is an INDIVIDUAL, the bidder's signature shall be placed above.

If signature is by an agent, other than an officer of a corporation or a partner of a partnership, a POWER OF ATTORNEY must be on file with the Department before opening bids or submitted with the bid. Otherwise, the Department may reject the bid as irregular and unauthorized.

PREFERENCES

Bidders acknowledge that while preferences are considered in the evaluation of bids, the award of the contract will be in the amount of the bid offered exclusive of any preferences.

A. HAWAII BIDDER PREFERENCE

In accordance with HRS §103D-302, the Hawaii bidder preference is applicable to this solicitation for evaluation purposes only. Bidders desiring to qualify for the five per cent (5%) preference shall submit with their bid a completed *Hawaii Bidder/Offeror Preference Certification Form* (Form SPO-081) at or before the time set for receipt of bids. Certifications submitted for previous or other solicitations will not be accepted.

☐ **Yes, the Bidder elects to receive the Hawaii Bidder Preference and has included the Form SPO-081 with the bid.**

B. APPRENTICESHIP AGREEMENT PREFERENCE

In accordance with HRS §103-55.6, the estimated value of this public works contract is \$250,000 or more and the apprenticeship agreement preference is applicable to this solicitation for evaluation purposes only. Bidders desiring to qualify for the five per cent (5%) preference shall submit with their bid a complete, valid CERTIFICATION OF BIDDER'S PARTICIPATION IN APPROVED APPRENTICESHIP PROGRAM UNDER ACT 17 (Certification Form 1) *for each apprenticeable trade* the Bidder will employ on the project.

☐ **Yes, the Bidder elects to receive the Apprenticeship Agreement Preference and has attached Certification Form(s) 1 for each apprenticeable trade the Bidder will employ for this project (excluding subcontractors).**

By submission of this offer, the Bidder certifies that it has indicated **all apprenticeable trades that Bidder will employ** for this project (excluding subcontractors) by listing the applicable trades below:

(Attach additional sheet if necessary.)

Form 1 Required. Failure to submit a valid Form 1 with the bid for every apprenticeable trade that Bidder will employ on the project will result in the preference being denied, regardless of whether the trade is listed above. If a Form 1 is submitted for a trade that is not listed above, the Form 1 will take

precedence over the listing and may be used to qualify Bidder for the preference.

Form 2 Required. If awarded the contract with the Apprenticeship Agreement Preference applied, then for the duration of the contract, the Bidder **shall** certify each month that work is being conducted on the project that the Contractor continues to be a participant in the relevant apprenticeship program for each trade it employs. Monthly certification shall be made on the Certification Form 2 and submitted to the HDOT.

Failure to comply with the requirements of the Apprenticeship Agreement Preference program will subject the Contractor to sanctions pursuant to HRS §103-55.6.

C. HAWAII PRODUCTS PREFERENCE

Hawaii Products Preference shall not apply to this solicitation.

D. RECYCLED PRODUCT PREFERENCE

Recycled Product Preference shall not apply to this solicitation.



STATE OF HAWAII
Hawaii Bidder/Offeror
Preference Certification Form
(As Defined in HRS103D-1001)

I, _____, _____ of
(Authorized Officer's Name) (Office or Position Held)

_____, certify the following:
(Name of Bidder/Offeror)

- (1) That the Bidder/Offeror holds a valid commercial place of business located in the State of Hawaii at the following address:

and that the above-named office was opened on the following date: _____,
and has been staffed by the Bidder/Offeror or an employee of the Bidder/Offeror for not less than two (2) consecutive years immediately preceding the time and date set for the opening of bids or receipt of proposals;

- (2) That the bid or proposal in response to IFB/RFP No. _____, is submitted under the name under which the Bidder/Offeror is authorized to do business in the State;
- (3) That not less than fifty-one percent (51%) of the total direct labor hours required for performance of the contract will be performed within the State; and
- (4) If the Bidder/Offeror is a joint venture, the Bidder/Offeror is composed entirely of parties meeting the requirements of paragraphs (1), (2), and (3).

I certify under penalty of perjury that the above statements are true. I agree to maintain the above qualifications throughout contract performance; any changes in eligibility shall be reported to the Contract Administrator or purchasing agency's contact person identified in the RFP/IFB. I acknowledge that failure to maintain the above qualifications triggers a price adjustment equal to the value of the preference applied and may constitute cause for debarment under HRS §103D-702.

Signature of Authorized Officer

Print Name and Title

Date

CBP FIS RENOVATION
Daniel K. Inouye International Airport
Honolulu, Oahu, Hawaii
Project No. CO1433-33

PROPOSAL SCHEDULE

Item No.	Description	Approx Qty	Unit	Unit Price	Total
01010.1	CBP FIS Renovation	Lump Sum	Lump Sum	Lump Sum	\$
01210.1	Unforeseen Conditions	Allowance	Allowance	Allowance	<u>\$ 300,000.00</u>
01210.2	Security Measures	Allowance	Allowance	Allowance	<u>\$ 20,000.00</u>
01210.3	Furniture	Allowance	Allowance	Allowance	<u>\$ 50,000.00</u>
01210.4	Equipment	Allowance	Allowance	Allowance	<u>\$ 100,000.00</u>
01210.5	Security Control System	Allowance	Allowance	Allowance	<u>\$ 200,000.00</u>
01561.1	Construction Site Pollution Controls	LS	LS	LS	\$
01562.1	Management of Contaminated Media, Soil Disposal, and Soil Reuse	LS	LS	LS	\$
01562.2	Additional Management of Contaminated Media, Soil Disposal, and Soil Reuse	Allowance	Allowance	Allowance	<u>\$ 25,000.00</u>
TOTAL AMOUNT FOR COMPARISION OF BIDS					\$

NOTES:

The bid prices herein shall include all labor, materials, equipment, and incidentals necessary to construct all items in place, including installation and testing of equipment, complete and ready for operation, all in accordance with the plans and specifications.

- Note 1: Bids shall include all Federal, State, County and other applicable taxes and fees.
- Note 2: The TOTAL AMOUNT FOR COMPARISON OF BIDS shall be used to determine the lowest responsible bidder.
- Note 3: Bidders shall complete all unit prices and amounts. Failure to do so shall be grounds for rejection of bid.
- Note 4: The State reserves the right to reject any or all Bids and to waive any defects in said Bids in the best interest of the State.
- Note 5: Submission of a Bid is a warranty that the bidder has made an examination of the project site and is fully aware of all conditions to be encountered in performing the work and the requirements of the plans and specifications.
- Note 6: The bidder's attention is directed to Section 2.11 - BID SECURITY of the General Provisions as amended by the Special Provisions.
- Note 7: Bidder shall be paid for actual work performed as directed by the Engineer for allowance items. Bidder shall not be paid overhead and profit for unused allowance funds.
- Note 8: If the TOTAL AMOUNT FOR COMPARISON OF BIDS exceeds the funds available for the project, then the State reserves the right to negotiate with the lowest, responsive, responsible bidder as permitted under Section 103D-302, Hawaii Revised Statutes (HRS), to further reduce the scope of work and award a contract thereafter.
- Note 9: **Bidders shall submit and upload the complete proposal to HlePRO prior to the bid opening date and time. Proposals received after said due date and time shall not be considered. Any additional support documents explicitly designated as confidential and/or proprietary shall be uploaded as a separate file to HlePRO. Bidders shall not include confidential and/or proprietary documents with the proposal. The record of each bidder and respective bid shall be open to public inspection. Original (wet ink, hard copy) proposal documents are not required to be submitted. Contract award shall be based on evaluation of proposals submitted and uploaded to HlePRO.**

FAILURE TO UPLOAD THE COMPLETE PROPOSAL TO HlePRO SHALL BE GROUNDS FOR REJECTION OF THE BID.

If there is a conflict between the specification document and the HlePRO solicitation, the specifications shall govern and control, unless otherwise specified.

ABBREVIATIONS LEGEND

A	
AB	ANCHOR BOLT
ABS	ACRYLONITRILE BUTADIENE STYRENE
ABV	ABOVE
A/C	AIR CONDITIONING
AC	ASPHALTIC CONCRETE
ACP	ACOUSTICAL CEILING PANEL
AD	AREA DRAIN
ADDL	ADDITIONAL
ADF	ACCESSIBLE DRINKING FOUNTAIN
ADJ	ADJACENT
AFF	ABOVE FINISH FLOOR
AFS	ABOVE FINISH SLAB
AGGR	AGGREGATE
ALUM	ALUMINUM
ALT	ALTERNATE
ANOD	ANODIZED
APPROX	APPROXIMATE
ARCH	ARCHITECTURAL

B	
BBQ	BARBEQUE
BD	BOARD
BFF	BELOW FINISH FLOOR
BKBD	BACK BOARD
BLDG	BUILDING
BLK	BLOCK
BLKG	BLOCKING
BM	BEAM
BOD	BOTTOM OF DECK
BOT F	BOTTOM FACE
BOT	BOTTOM
BR	BEDROOM
BRG	BEARING
BRKT	BRACKET
BSMT	BASEMENT
BTWN	BETWEEN
BUR	BUILT-UP ROOFING

C	
CAB	CABINET
CB	CATCH BASIN
CEM	CEMENT
CER	CERAMIC
CFCI	CONTRACTOR FURNISHED / CONTRACTOR INSTALLED / OWNER INSTALLED / CORNER CURB
CFOI	CONTRACTOR FURNISHED / CONTRACTOR INSTALLED / OWNER INSTALLED / CORNER CURB
CG	CORNER CURB
CMPST	COMPOSITE
CI	CAST IRON
CIP	CAST IN PLACE
CJ	CONTROL JOINT
CL	CENTER LINE
CLG	CLOSG
CLO	CLOSET
CLR	CLEAR
CMU	CONCRETE MASONRY UNIT
CNTR	COUNTER
CO	CLEAN OUT
COL	COLUMN
CONC	CONCRETE
COND	CONDITION
CONN	CONNECTION
CONSTR	CONSTRUCTION
CONT	CONTINUE/CONTINUOUS
CONTR	CONTRACTOR
COORD	COORDINATE
COP	COPPER
CORR	CORRIDOR
CPT	CARPET
CSK	COUNTERSINK
CT	CERAMIC TILE
CTR	CENTER
CUH	CABINET UNIT HEATER
CULT	CULTURED
CW	COLD WATER PIPING
D	DEEP/DEPTH
DBL	DOUBLE
DEG	DEGREE
DEPT	DEPARTMENT
DET	DETAIL
DF	DRINKING FOUNTAIN
DIA	DIAMETER
DIAG	DIAGONAL
DIM	DIMENSION
DISP	DISPENSER
DN	DOWN
DR	DOOR
DS	DOWNSPOUT
DSP	DRY STANDPIPE
DW	DISHWASHER
DWG	DRAWING
DWR	DRAWER

E	
EA	EAST
EIFS	EACH
EJ	EXTERIOR INSULATION FINISH SYSTEM
EL	EXPANSION JOINT
ELAST	ELEVATION
ELEC	ELASTOMERIC
ELEV	ELECTRICAL
EMER	ELEVATOR
ENCL	EMERGENCY
EPB	ENCLOSURE
EPDM	ELECTRICAL PANEL BOARD
ES	ETHYLENE PROPYLENE DIENE MONOMER
EQ	EACH SIDE
EQUIP	EQUAL
EOS	EQUIPMENT
EW	EDGE OF SLAB
EXH	ELECTRIC WATER COOLER
EXP	EXHAUST
EXPN	EXPOSED
EXT	EXPANSION
(E)	EXTERIOR EXISTING

F	
FA	FAHRENHEIT
FAB	FIRE ALARM
FB	FABRICATE
FCU	FLAT BAR
FD	FAN COIL UNIT
FDTN	FLOOR DRAIN
FE	FOUNDATION
FEC	FIRE EXTINGUISHER
FF	FIRE EXTINGUISHER CABINET
FF & E	FINISH FLOOR
FGL	FURNITURE, FIXTURES AND EQUIPMENT
FH	FIBERGLASS
FHC	FIRE HYDRANT
FHC	FIRE HOSE CABINET
FIN	FINISH
FIN GR	FINISH GRADE
FIX	FIXTURE
FLDG	FOLDING
FLG	FLOORING
FLR	FLOOR
FLUOR	FLUORESCENT
FLR SK	FLOOR SINK
FOC	FLOOR SINK
FOF	FACE OF CONCRETE
FOM	FACE OF FINISH
FOS	FACE OF MASONRY
FOW	FACE OF STUD
FP	FACE OF WALL
FR	FIRE PROOF
FRP	FRAME
FRP	FIBERGLASS REINFORCED PLASTIC
FRT	FIRE RETARDANT
FRZ	FREEZER
FT	FEET
FTD	FACIAL TISSUE DISPENSER
FTG	FOOTING
FURG	FURRING
FUT	FUTURE

G	
G	NATURAL GAS
GA	GAUGE
GALV	GALVANIZED
GB	GRAB BAR
GEN	GENERAL
GFGI	GOVERNMENT FURNISHED / GOVERNMENT INSTALLED
GFRG	GLASSFIBER REINFORCED GYPSUM
GFRC	GLASSFIBER REINFORCED CONCRETE
GL	GLASS/GLAZING
GLU LAM	GLUE LAMINATED WOOD
GPM	GALLONS PER MINUTE
GRAN	GRANITE
GSS	GYPSUM SHEATHING BOARD
GTV	GATE VALVE
GWT	GLAZED WALL TILE
GYP	GYPSUM
GWB	GYPSUM WALL BOARD

H	
H	HIGH
HB	HOSE BIBB
HC	HOLLOW CORE
HCP	HANDICAPPED
HD	HEAD
HDBD	HARDBOARD
HDW	HARDWARE
HDWD	HARDWOOD
HM	HOLLOW METAL
HORIZ	HORIZONTAL
HS	HAND SINK
HT	HEIGHT
HVAC	HEATING, VENTILATION AND AIR CONDITIONING
HW	HOT WATER
HWR	HOT WATER RETURN
HWS	HOT WATER SUPPLY

I	
ID	INSIDE DIAMETER
INCL	INCLUDED
IMP	INSULATED METAL PANEL
IN	INCH
INFO	INFORMATION
INSUL	INSULATION/INSULATED
INT	INTERIOR
INV	INVERT

J	
J-BOX	JUNCTION BOX
JAN	JANITOR
JST	JOIST
JT	JOINT

K	
KD	KNOCK DOWN
KIT	KITCHEN
KO	KNOCK-OUT
KW	KILOWATT
KWH	KILOWATT HOUR

L	
L	LENGTH
LAB	LABORATORY
LAM	LAMINATE
LAV	LAVATORY
LB	POUND
LBF/SF	POUNDS PER SQUARE FOOT
LDG	LANDING
LF	LINEAR FOOT
LH	LEFT HAND
LKR	LOCKER
LLV	LONG LEG VERTICAL
LOC	LOCATION
LT	LIGHT
LR	LIVING ROOM
LVR	LOUVER

M	
M	METER
M2	SQUARE METER
MATL	MATERIAL
MAX	MAXIMUM
MB	MACHINE BOLT
MBR	MASTER BEDROOM
MC	MEDICINE CABINET
MECH	MECHANICAL
MEMB	MEMBRANE
MEZZ	MEZZANINE
MFR	MANUFACTURER
MH	MANHOLE
MI	MIRROR
MID	MIDDLE
MIN	MINIMUM
MISC	MISCELLANEOUS
MLDG	MOULDING
MM	MILLIMETER
MCO	MASONRY OPENING
MOD	MODULE
MP	METAL PANEL
MR	MOISTURE RESISTANT
MTD	MOUNTED
MTL	METAL
MTG	MOUNTING
MULL	MULLION
MUN	MUNTIN
MW	MICROWAVE

N	
N	NORTH
NFS	NON-FROST SUSCEPTIBLE
NIC	NOT IN CONTRACT
NO	NUMBER
NOM	NOMINAL
NTS	NOT TO SCALE

O	
OA	OVERALL
OBS	OBSCURE
OC	ON CENTER
OD	OUTSIDE DIAMETER
OFICI	OWNER FURNISHED / CONTRACTOR INSTALLED
OFICI	OWNER FURNISHED / OWNER INSTALLED
OFD	OVERFLOW DRAIN
OH	OVER HANG
OPH	OPPOSITE HAND
OPNG	OPENING
OPP	OPPOSITE
OPR	OPERABLE
OVHD	OVER HEAD

P	
PA	PUBLIC ACCESS
PC	PIECE
PCC	PRECAST CONCRETE
PEND	PENDANT
PERIM	PERIMETER
PH	PENTHOUSE
PLAS	PLASTER
PLBG	PLUMBING
PL	PROPERTY LINE
PLAM	PLASTIC LAMINATE
PLYWD	PLYWOOD
PNL	PANEL
PR	PAIR
PROP	PROPERTY
PREFAB	PREFABRICATE
PT	PAINT
PTD	PAPER TOWEL DISPENSER
PTDR	PAPER TOWEL DISPENSER AND RECEPTACLE
PTN	PARTITION
PTR	PAPER TOWEL RECEPTACLE
PVC	POLYVINYL CHLORIDE
PVMT	PAVEMENT

Q	
QT	QUARRY TILE

R	
R	RISER
R	RADIUS
RA	RETURN AIR
RB	RUBBER BASE
RB HK	ROBE HOOK
RCP	REFLECTED CEILING PLAN
RD	ROOF DRAIN
REC	RECESSED
REF	REFRIGERATOR
REFL	REFLECTED
REG	REGISTER
REINF	REINFORCE
RECS	RECOMMENDATIONS
REOD	REQUIRED
RESIL	RESILIENT
REST	REST ROOM
REV	REVISION
RTF	RUBBER TILE FLOOR
RFG	ROOFING
RLG	RAILING
RH	RIGHT HAND
RND	ROUND
RM	ROOM
RO	ROUGH OPENING
RWL	RAIN WATER LEADER

S	
S	SOUTH
SA	SUPPLY AIR
SAB	SOUND ATTENUATION BLANKET
SB	SPLASH BLOCK
SC	SOLID BLOCK
SCHED	SCHEDULE
SCD	SEAT COVER DISPENSER
MOD	SCUPPER
SCR	SHOWER CURTAIN ROD
SCRN	SCREEN
SD	SMOKE DETECTOR
SECT	SECTION
SED	SEE ELECTRICAL DRAWINGS
SF	SQUARE FEET
SFNT	STOREFRONT
SHT	SHEET
SHR	SHOWER
SHTHG	SHEATHING
SHV	SHELVING
SIM	SIMILAR
SL	SLOPE
SLDG	SLIDING
SLNT	SEALANT
SM	SHEET METAL
SND	SANITARY NAPKIN DISPENSER
SNDU	SANITARY NAPKIN DISPOSAL UNIT
SPC	SPACING
SPEC	SPECIFICATION
SPKLR	SPRINKLER
SPKR	SPEAKER
SQ	SQUARE
SSD	SEE STRUCTURAL DRAWINGS
SST	STAINLESS STEEL
SMD	SEE MECHANICAL DRAWINGS
SMLS	SEAMLESS
SS	SOLID SURFACE
STA	STATION
STD	STANDARD
STL	STEEL
STOR	STORAGE
STR	STRINGERS
STRUCT	STRUCTURAL
SURR	SURROUND
SUSP	SUSPENDED
SVCE	SERVICE
SW	SWITCH
SYMM	SYMMETRICAL
SYS	SYSTEM

T	
T	TREAD
TB	TOWEL BAR
TBD	TO BE DETERMINED
TD	TRENCH DRAIN
TEL	TELEPHONE
TEMP	TEMPERATURE
TER	TERRAZZO
T&G	TONGUE AND GROOVE
THRES	THRESHOLD
THRU	THROUGH
THK	THICKNESS
TK BD	TACK BOARD
TMPO	TEMPERED
TCC	TOP OF CURB
TOM	TOP OF MASONRY
TOP	TOP OF PARAPET
TOS	TOP OF SLAB
TOW	TOP OF WALL
TPD	TOILET PAPER DISPENSER
TPH	TOILET PAPER HOLDER
TS	TUBE STEEL
TSH	TOWEL SHELF
TSTAT	THERMOSTAT
TV	TELEVISION
TYP	TYPICAL
TLT	TOILET

U	
UBC	UNIFORM BUILDING CODE
UC	UNDERCUT
UNGD	UNDERGROUND
UH	UNIT HEATER
UL	UNDERWRITERS LABORATORY
UNFIN	UNFINISHED
UNO	UNLESS OTHERWISE NOTED
UR	URINAL

V	
VAR	VARIES
VB	VALVE BOX
VCT	VINYL COMPOSITION TILE
VERT	VERTICAL
VEST	VESTIBULE
VOL	VOLUME
VP	VENEER PLASTER
VTR	VENT THROUGH ROOF
VWC	VINYL WALL COVERING


W	
W	WIDE
W	WITH
WC	WALL COVERING
WCLR	WATER COOLER
WD	WOOD
WDSP	WASTE DISPOSER
WDW	WINDOW
WF	WIDE FLANGE
WGL	WIRED GLASS
WH	WATER HEATER
WO	WITHOUT
WP	WATERPROOF / WATERPROOFING
WR	WATER REPELLENT
WSCT	WAINSCOT
WSP	WET STAND PIPE
WT	WEIGHT
WWF	WELDED WIRE FABRIC

MATERIALS LEGEND


	SAND, MORTAR, PLASTER, TILE, BACKER BOARD		CONCRETE		GYPSUM BOARD
	EARTH (UNCLASSIFIED FILL)		CMU		PLYWOOD
	CLASSIFIED COMPACTED FILL		INSULATION - RIGID BOARD		STEEL
	EARTH (UNDISTURBED)		WOOD - FINISHED, TRIM		ALUMINUM
	DEMOLITION		EXISTING (TO REMAIN)		INSULATION - BATT
					ACOUSTIC CEILING PANEL
					GLAZING, GLASS
					CARPET
					FLOORING - CERAMIC TILE OR RESILIENT

SYMBOLS LEGEND

	ROOM NAME		ROOM DESIGNATION		WALL TYPE
	DOOR DESIGNATION		CEILING HEIGHT DESIGNATION		GRIDLINE
	SIGNAGE DESIGNATION		WINDOW / LOUVER DESIGNATION		DETAIL DESIGNATION
	PLAN KEYNOTE		EXTERIOR ELEVATION DESIGNATION		BUILDING SECTION DESIGNATION
	BREAK LINE		WALL SECTION DESIGNATION		DETAIL SECTION DESIGNATION
	REVISION DESIGNATION		INTERIOR ELEVATION DESIGNATION		TITLE DESIGNATION
	MATCHLINE				
	LEVEL NAME ELEVATION		DATUM DESIGNATION		
	GRAPHIC SCALE				
	FURNITURE DESIGNATION				
	NORTH ARROW / PLAN NORTH				
	VIEW NAME 1				

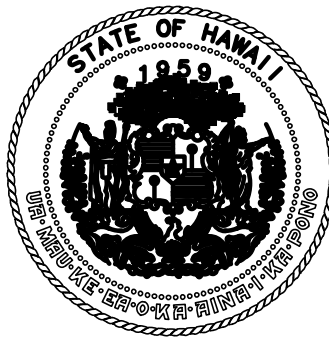

STATE OF HAWAII
DEPARTMENT OF TRANSPORTATION
AIRPORTS

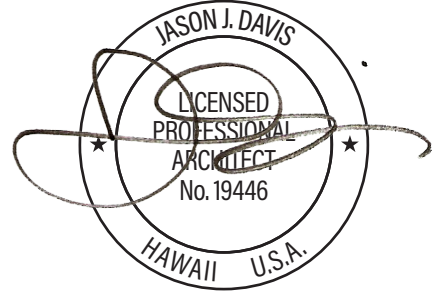

THIS WORK WAS PREPARED BY ME
OR UNDER MY SUPERVISION AND
CONSTRUCTION OF THIS PROJECT
WILL BE UNDER MY OBSERVATION.

DSGN.	DRWN.	CHKD.	APPD.
JV	AQ/JV	JV/EE/MM	JD

07/30/26 ADDENDUM 1

NO.	DATE	REVISIONS
-----	------	-----------

CONSTRUCTION
DOCUMENTS

APRIL 2026
DATE

PROJECT TITLE :

CBP FIS RENOVATION

AT
DANIEL K. INOUE INTERNATIONAL AIRPORT
HONOLULU, OAHU, HAWAII


PROJECT NO.:

CO1433-33

SHEET TITLE:

ABBREVIATIONS AND
SYMBOLS LEGEND

DATE :	DWG. NO.
2026.04.18	A-001
SHEET :	
7 OF 61 SHEETS	

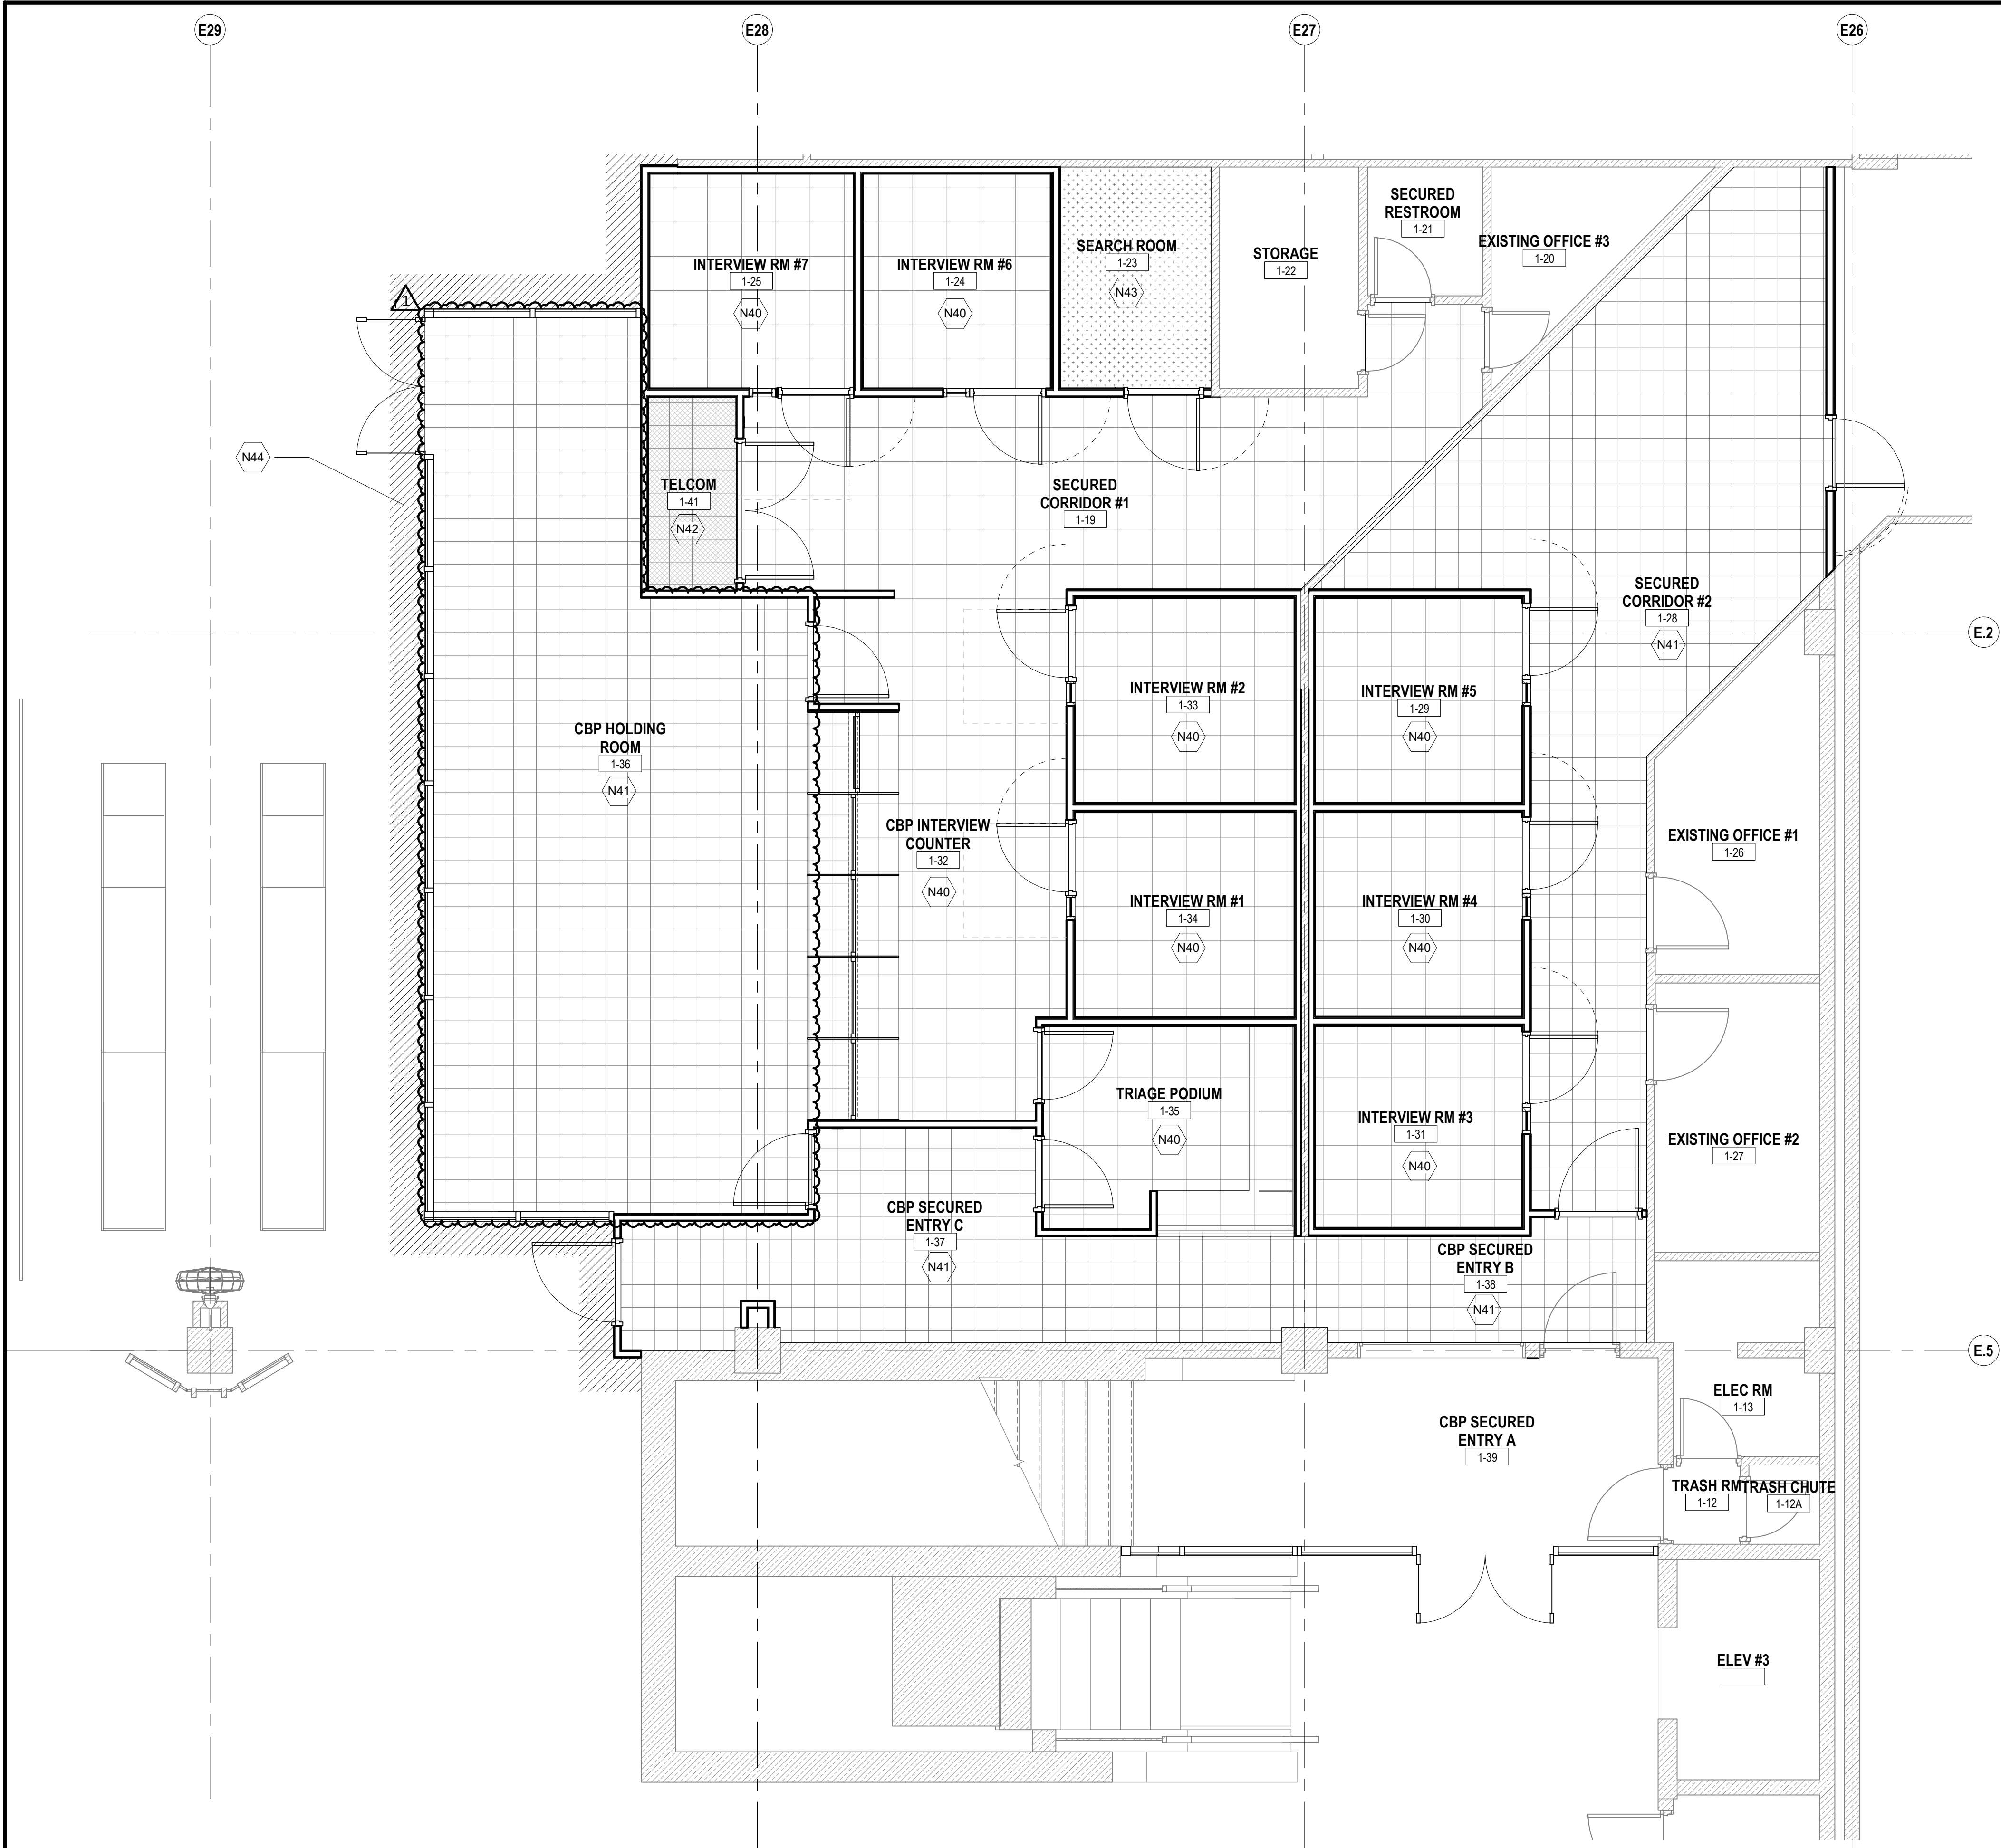

1
A-104

ENLARGED FLOOR PLAN - CBP FLOORING PLAN

1/4" = 1'-0"

0' 2' 4' 8'

FLOOR FINISH PLAN GENERAL NOTES


- ALL WALLS TO BE PAINTED P-1, UNO.
- ALL FLOORING TRANSITIONS OCCUR AT CENTERLINE OF DOOR OR OPENING, UNO.

INTERIOR FINISH LEGEND


- COORDINATE WORK WITH EXIST FINISHES
- CPT-1
- RES-1
- RES-2
- EPX-1

KEYNOTES

- N40 CARPET TILE - REFER TO ROOM FINISH SCHED
- N41 RESILIENT TILE FLOORING - REFER TO ROOM FINISH SCHED
- N42 RESILIENT ANTI-STATIC FLOORING - REFER TO ROOM FINISH SCHED
- N43 EPOXY COATING O/ CONC - REFER TO ROOM FINISH SCHED
- N44 UNINSTALL EXIST CARPET TILE FLOORING AS REQUIRED TO CONSTRUCT PARTITIONS AND STOREFRONT SYSTEM - REINSTALL AND TRIM TO FINAL DIMENSIONS

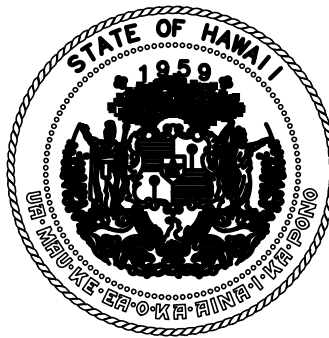

STATE OF HAWAII
DEPARTMENT OF TRANSPORTATION
AIRPORTS

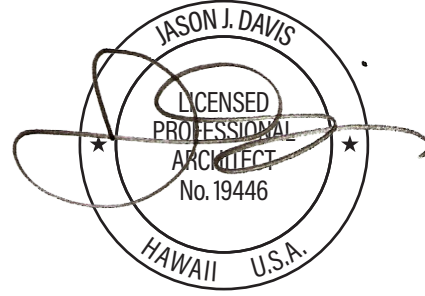

THIS WORK WAS PREPARED BY ME
OR UNDER MY SUPERVISION AND
CONSTRUCTION OF THIS PROJECT
WILL BE UNDER MY OBSERVATION.

DSGN.	DRWN.	CHKD.	APPD.
JV	AQ/JV	JV/EE/MM	JD

07/30/26 ADDENDUM 1

NO.	DATE	REVISIONS
-----	------	-----------

CONSTRUCTION
DOCUMENTS

APRIL 2026
DATE

PROJECT TITLE :

CBP FIS RENOVATION

AT
DANIEL K. INOUE INTERNATIONAL AIRPORT
HONOLULU, OAHU, HAWAII

PROJECT NO.:

CO1433-33

SHEET TITLE:

ENLARGED FLOOR
PLAN - CBP
FLOORING

DATE :

2026.04.18

SHEET :

18 OF 61 SHEETS


DWG. NO.

A-104


ROOM FINISH SCHEDULE					
ROOM NUMBER	ROOM NAME	FLOOR FIN	BASE	WALL FIN	CEILING FIN
1-11	COMM	*	*	*	*
1-12	TRASH RM	*	*	*	*
1-12A	TRASH CHUTE	*	*	*	*
1-13	ELEC RM	*	*	*	*
1-14	WOMEN RR	*	*	*	*
1-15	JANITOR	*	*	*	*
1-16	MEN RR	*	*	*	*
1-17	JANITOR	*	*	*	*
1-19	SECURED CORRIDOR #1	*	*	PT-1	*
1-20	EXISTING OFFICE #3	*	*	*	*
1-21	SECURED RESTROOM	*	*	*	*
1-22	STORAGE	*	*	*	*
1-23	SEARCH ROOM	CPT-1	RB	PT-1	ACT O/ GYP BD
1-24	INTERVIEW RM #6	CPT-1	RB	PT-1	ACT O/ GYP BD
1-25	INTERVIEW RM #7	CPT-1	RB	PT-1	ACT O/ GYP BD
1-26	EXISTING OFFICE #1	*	*	*	*
1-27	EXISTING OFFICE #2	*	*	*	*
1-28	SECURED CORRIDOR #2	RES-1	RB	PT-1	GYP BD
1-29	INTERVIEW RM #5	CPT-1	RB	PT-1	ACT O/ GYP BD
1-30	INTERVIEW RM #4	CPT-1	RB	PT-1	ACT O/ GYP BD
1-31	INTERVIEW RM #3	CPT-1	RB	PT-1	ACT O/ GYP BD
1-32	CBP INTERVIEW COUNTER	CPT-1	RB	PT-1	GYP BD
1-33	INTERVIEW RM #2	CPT-1	RB	PT-1	ACT O/ GYP BD
1-34	INTERVIEW RM #1	CPT-1	RB	PT-1	ACT O/ GYP BD
1-35	TRIAGE PODIUM	CPT-1	RB	PT-1	ACT O/ GYP BD
1-36	CBP HOLDING ROOM	RES-1	RB	PT-1	GYP BD
1-37	CBP SECURED ENTRY C	RES-1	RB	PT-1	GYP BD
1-38	CBP SECURED ENTRY B	RES-1	RB	PT-1	ACP-1
1-39	CBP SECURED ENTRY A	*	*	PT-1	*
1-40	CUSTOMS INSPECTION AREA	*	*	*	*
1-41	TELCOM	RES-2	RB	PT-1	GYP BD
1-42	MECH ROOM	*	*	*	*
1-43	SECURED CORRIDOR #3	*	*	*	*
1-44	BAGGAGE CLAIM	*	*	*	*

NOTE:
1. * INDICATES EXISTING TO REMAIN
2. EXISTING DOORS AND FRAMES TO BE PAINTED TO MATCH TRIM PAINT
3. ALL FINISHED SUBJECT TO APPROVAL FROM USER AND ARCHITECT.

MATERIAL AND FINISH SCHEDULE					
SYMBOL	MATERIAL	DESCRIPTION	FINISH / COLOR	LOCATION	REMARKS
ACP-1	ACOUSTIC CEILING PANEL AND GRID SYSTEM	24"x24"x3/4" TEGULAR EDGE	USG RADAR / WHITE	HALLWAYS	
ACT	ACOUSTIC CEILING TILE	12"x12"	WHITE	INTERVIEW ROOMS, SEARCH ROOM	ADHERED TO GYP BD CEILING - COORDINATE CEILING FIXTURES
CPT-1	CARPET TILE	24"x24" CARPET TILE / SHAW CONTRACT	STRUCTURE TILE SIMPLY BY NATURE / SHINY PEBBLE 94761	SEE ROOM FINISH SCHEDULE	BASIS OF DESIGN PRODUCT SUBJECT TO CBP APPROVAL
EPX-1	EPOXY FLOORING	FLUID-APPLIED FLOORING SYSTEM	GRAY WITH TEXTURE GRANULES	SEARCH ROOM	
PLAM-1	PLASTIC LAMINATE	HIGH PRESSURE LAMINATE	BLUE	TRIAGE PODIUM COUNTER	
PLAM-2	PLASTIC LAMINATE	HIGH PRESSURE LAMINATE	WHITE	TRIAGE PODIUM COUNTER	
PLAM-3	PLASTIC LAMINATE	HIGH PRESSURE LAMINATE	KOA WOOD	TRIAGE PODIUM COUNTER	
PT-1	PAINT - EGGSHELL WALL AND CEILING PAINT	EGGSHELL PAINT	HNL STANDARD WALL COLOR	WALLS AND GYP BD CEILINGS	
PT-2	PAINT - SEMI GLOSS TRIM PAINT	SEMI GLOSS PAINT	HNL STANDARD TRIM COLOR	DOORS AND FRAMES	
RB	RESILIENT BASE	6" RESILIENT BASE / FLEXCO	BARK 02	STRAIGHT AT CARPET, COVED AT HARD FLOORING	BASIS OF DESIGN PRODUCT SUBJECT TO CBP APPROVAL
RES-1	RESILIENT FLOORING - LUXURY VINYL	KARNDEAN 18x36	OPUS 18x24 / URBAS SP213	SEE ROOM FINISH SCHEDULE	BASIS OF DESIGN PRODUCT SUBJECT TO CBP APPROVAL
RES-2	RESILIENT FLOORING - ANTI-STATIC TILE	12"x12" ARMSTRONG FLOORING	LIGHT GRAY PATTERN	COMMUNICATIONS CLOSET	BASIS OF DESIGN PRODUCT SUBJECT TO CBP APPROVAL

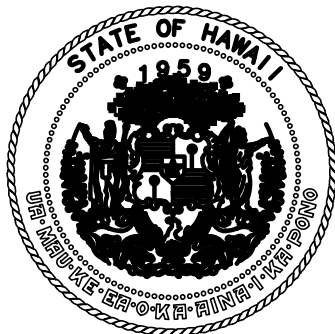

STATE OF HAWAII
DEPARTMENT OF TRANSPORTATION
AIRPORTS

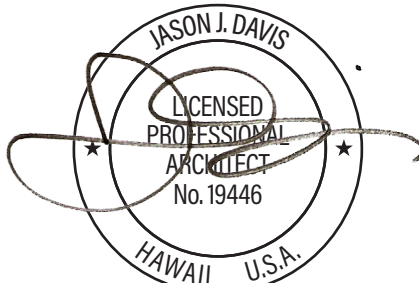

THIS WORK WAS PREPARED BY ME
OR UNDER MY SUPERVISION AND
CONSTRUCTION OF THIS PROJECT
WILL BE UNDER MY OBSERVATION.

DSGN.	DRWN.	CHKD.	APPD.
JV	AQ/JV	JV/EE/MM	JD

07/30/26 ADDENDUM 1

NO.	DATE	REVISIONS
-----	------	-----------

CONSTRUCTION DOCUMENTS

APRIL 2026
DATE

PROJECT TITLE :

CBP FIS RENOVATION

AT
DANIEL K. INOUE INTERNATIONAL AIRPORT
HONOLULU, OAHU, HAWAII


PROJECT NO.:

CO1433-33


SHEET TITLE:

FINISH SCHEDULES


DATE :	DWG. NO. A-601
2026.04.18	
SHEET :	
38 OF 61 SHEETS	

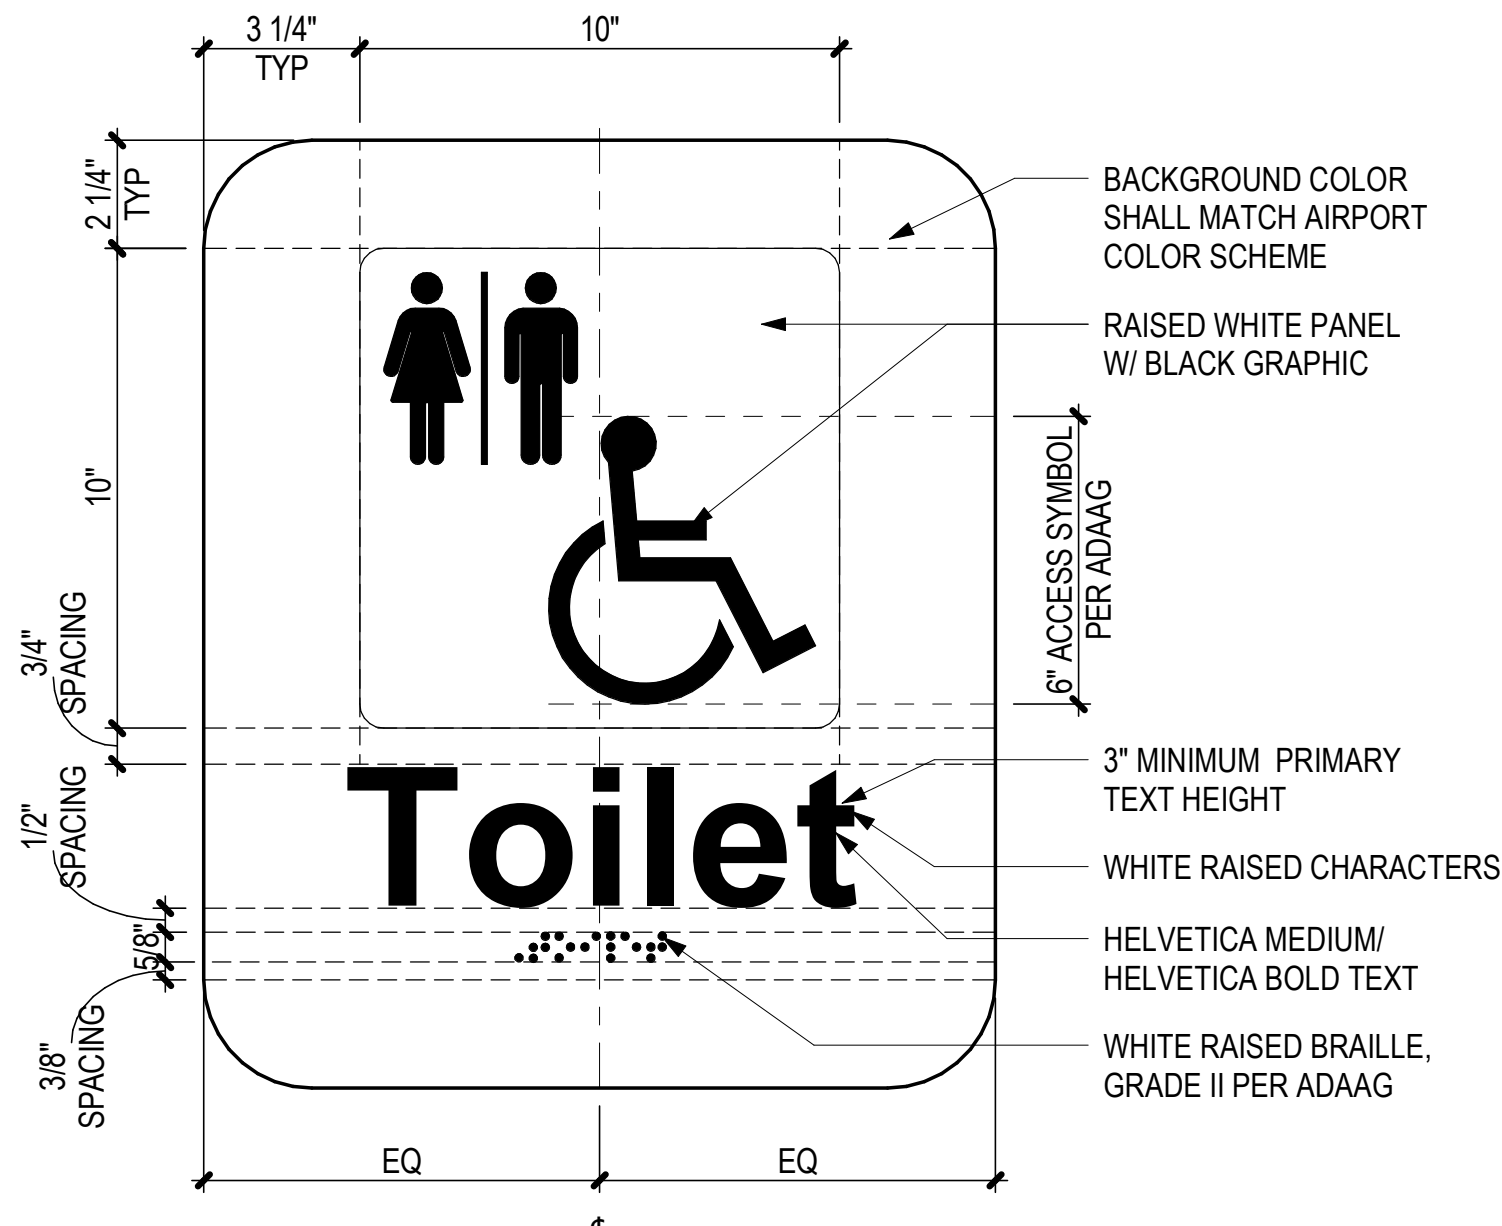


3 PICTOGRAM TACTILE SIGN
SCALE: 3" = 1'-0"

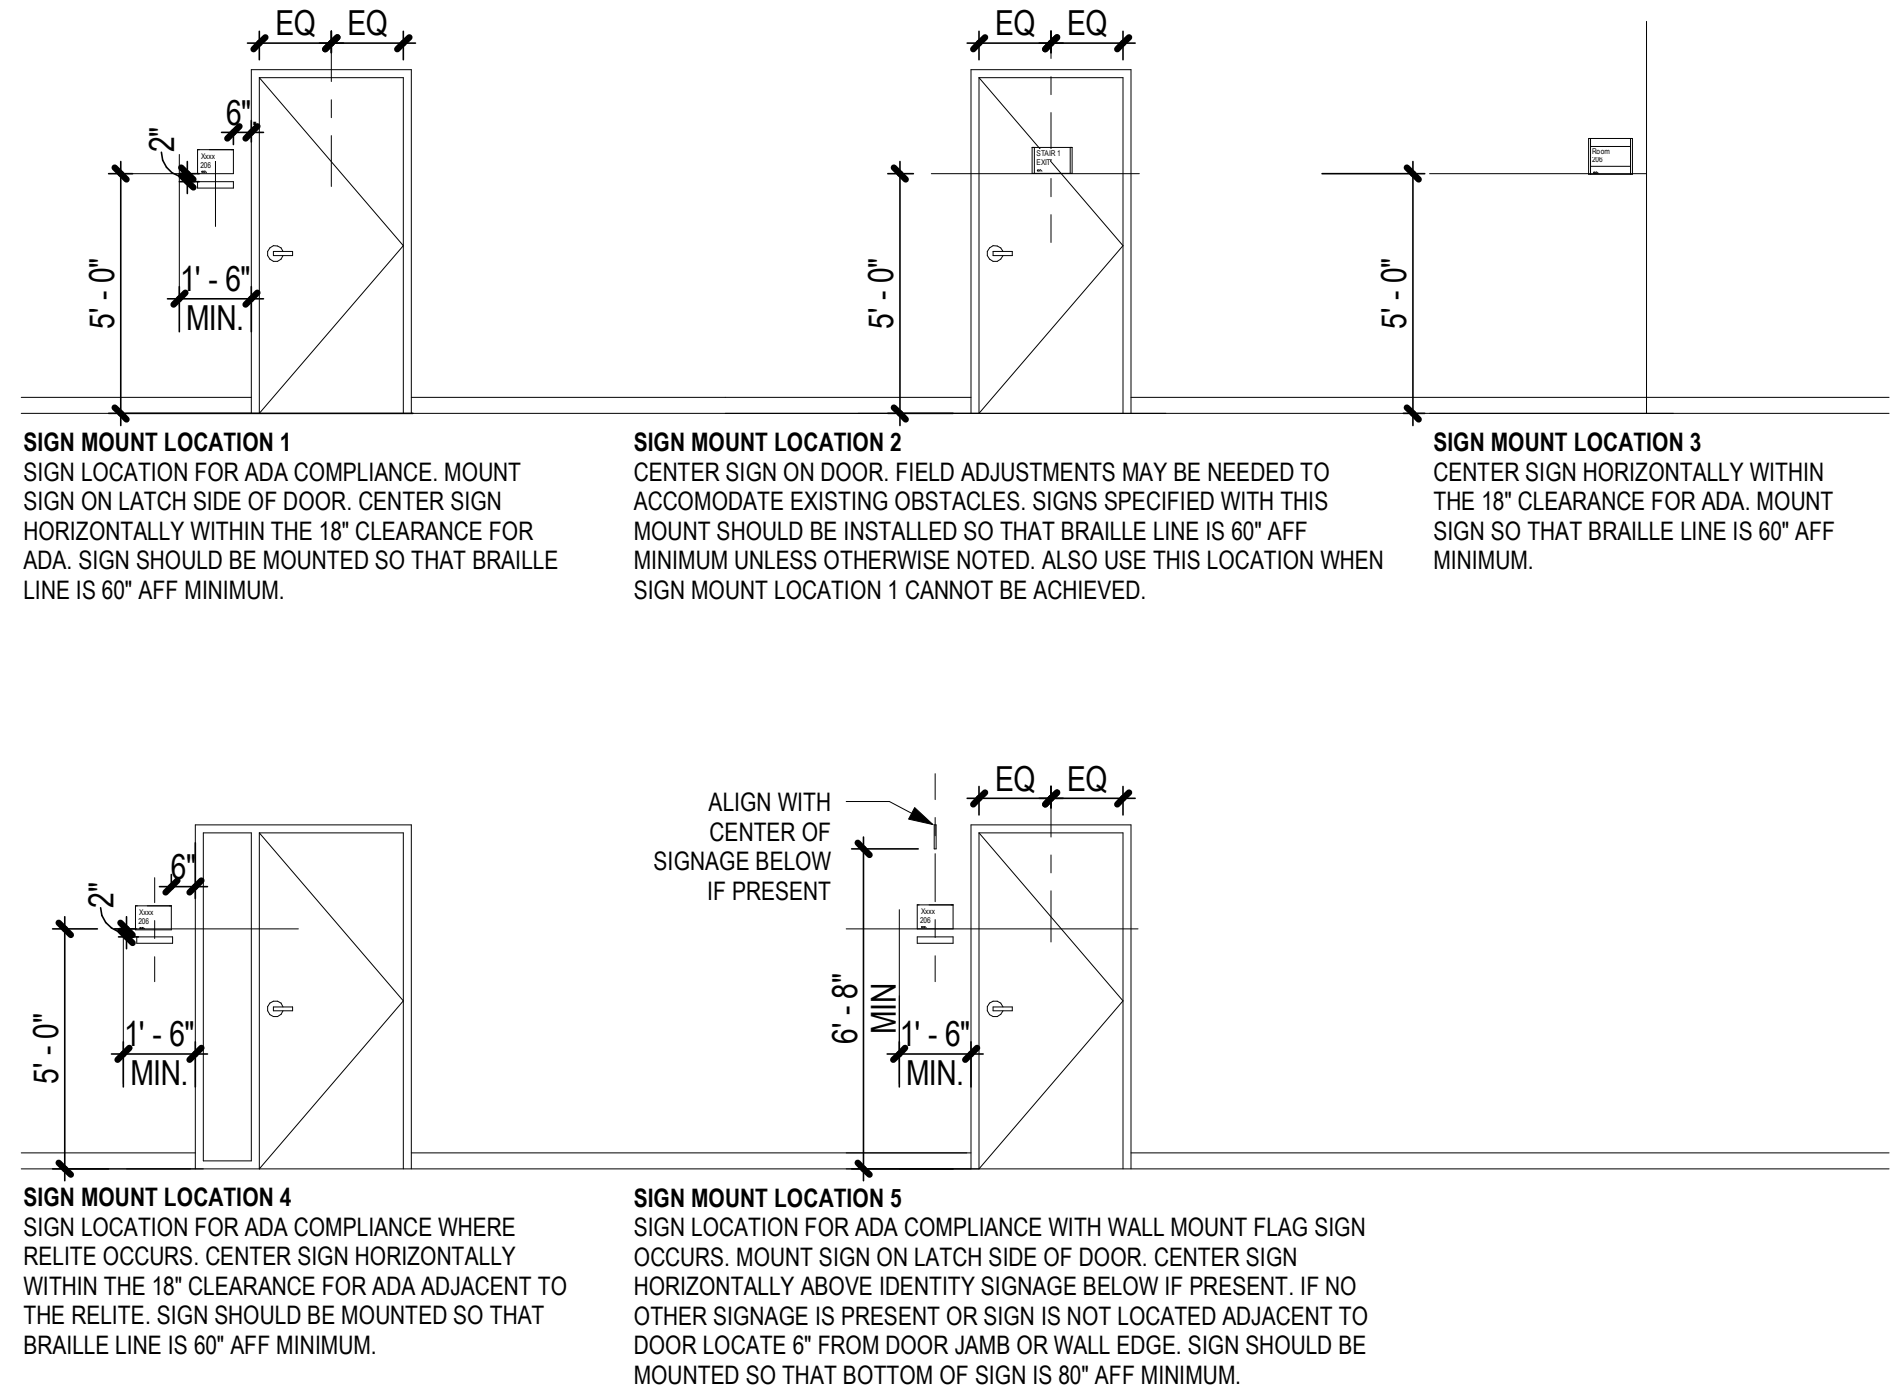

SIGNAGE MOUNTING HEIGHTS, TYPICAL

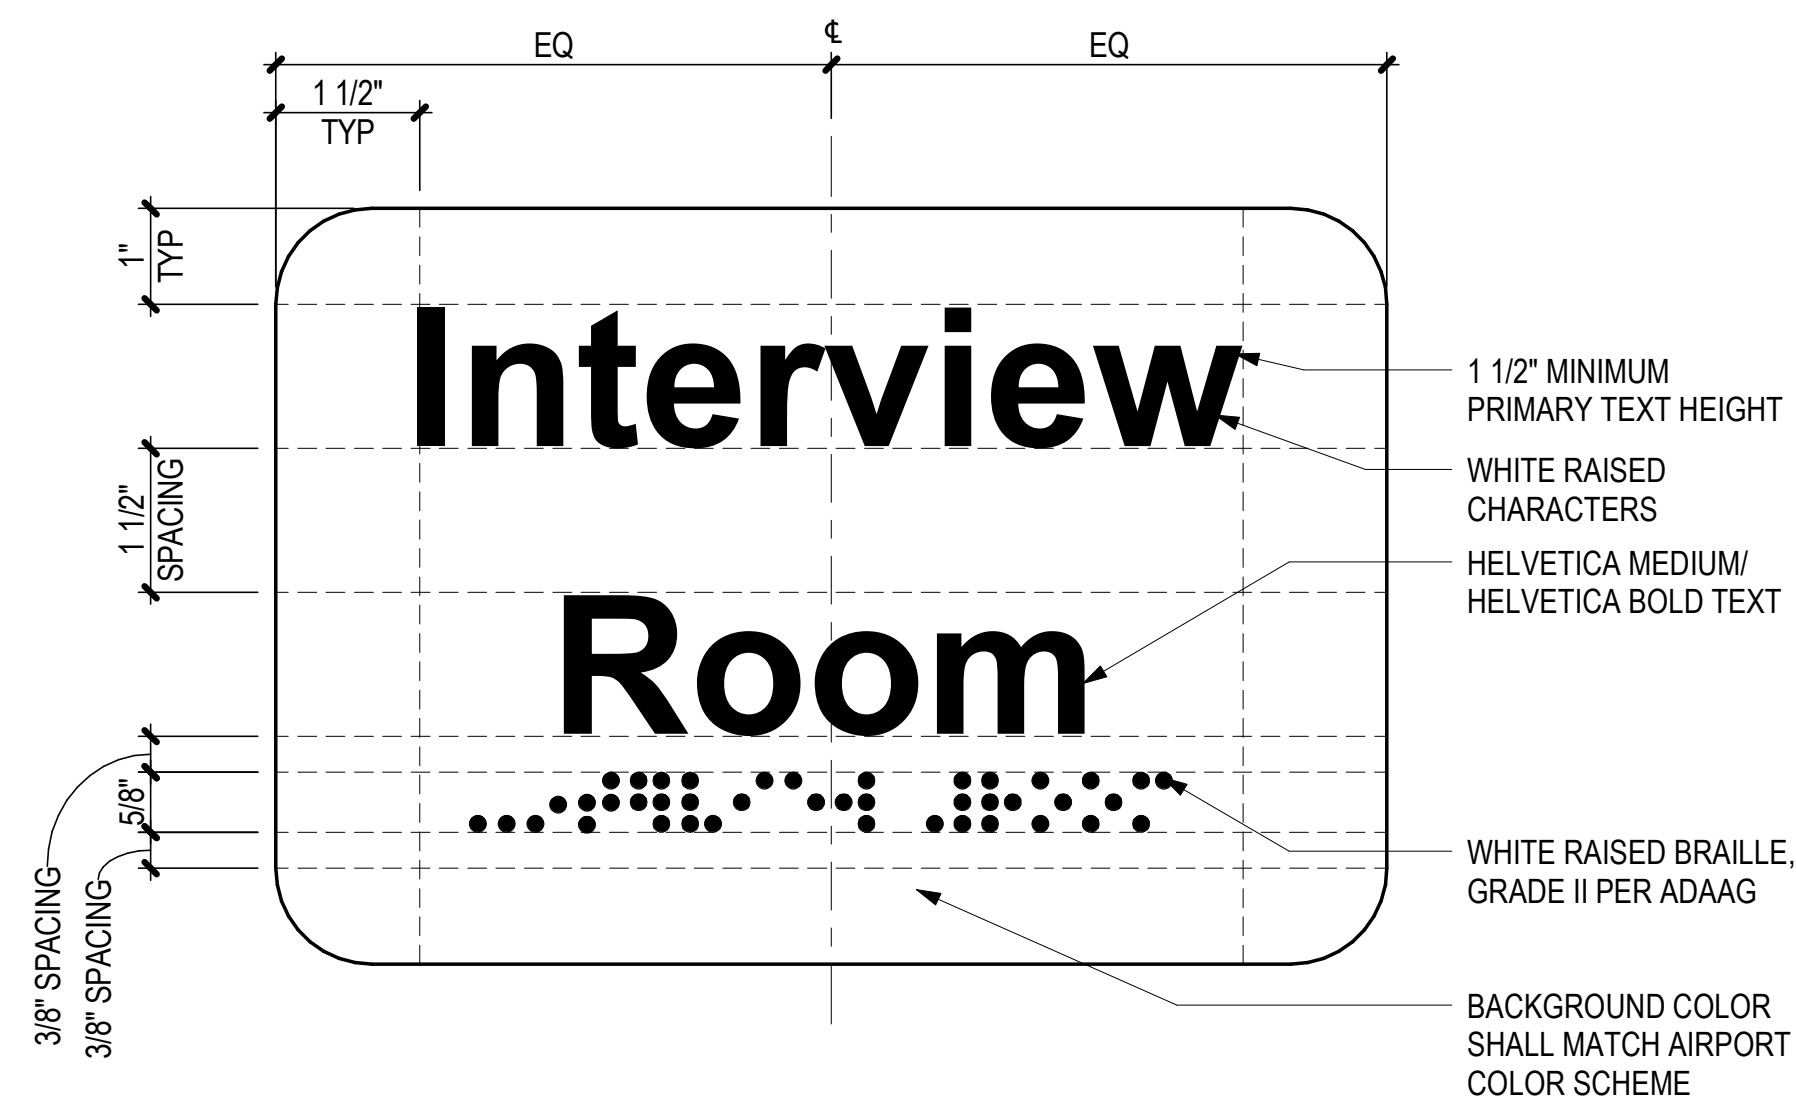


2 MULTI-LINE TACTILE SIGN
SCALE: 6" = 1'-0"

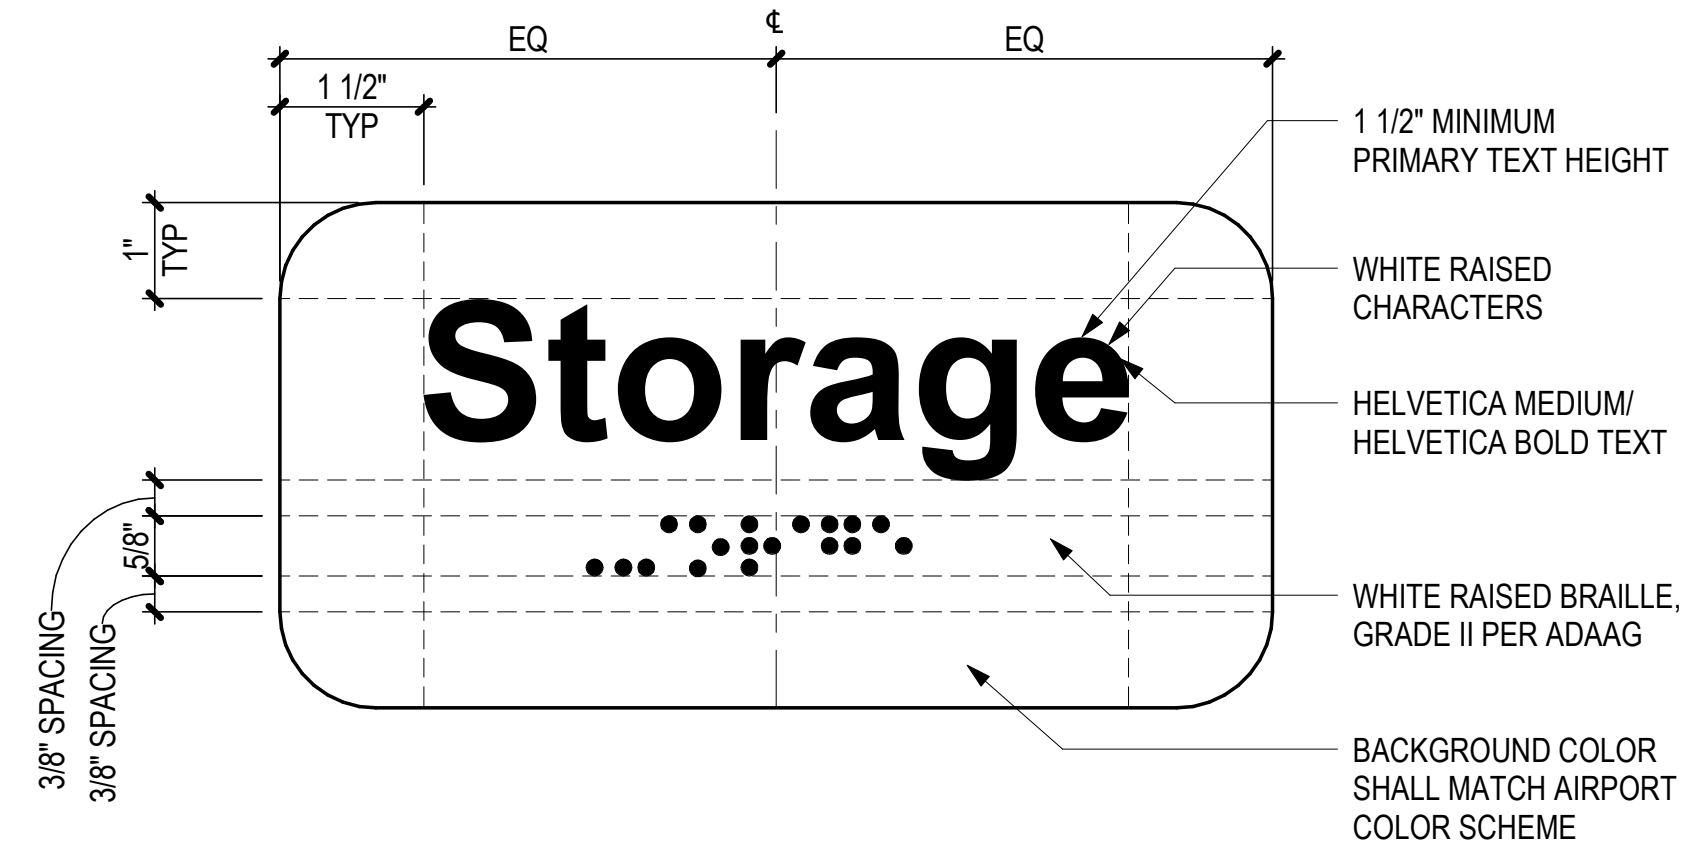


1 SINGLE LINE TACTILE SIGN
SCALE: 6" = 1'-0"

SIGNAGE SCHEDULE		
ROOM NAME	ROOM NUMBER	SIGN TYPES
SEARCH ROOM	1-23	A
INTERVIEW RM #6	1-24	INTERVIEW ROOM 6
INTERVIEW RM #7	1-25	INTERVIEW ROOM 7
EXISTING OFFICE #1	1-26	OFFICE
EXISTING OFFICE #2	1-27	OFFICE
SECURED CORRIDOR #2	1-28	SECONDARY SCREENING
INTERVIEW RM #5	1-29	INTERVIEW ROOM 5
INTERVIEW RM #4	1-30	INTERVIEW ROOM 4
INTERVIEW RM #3	1-31	INTERVIEW ROOM 3
INTERVIEW RM #2	1-33	INTERVIEW ROOM 2
INTERVIEW RM #1	1-34	INTERVIEW ROOM 1
TRIAGE PODIUM	1-35	CBP OFFICES
CBP HOLDING ROOM	1-36	HOLDING ROOM
CBP SECURED ENTRY C	1-37	SECONDARY SCREENING
CBP SECURED ENTRY B	1-38	SECONDARY SCREENING
TEL.COM	1-41	COMMUNICATIONS
SECURED CORRIDOR #3	1-43	SECONDARY SCREENING

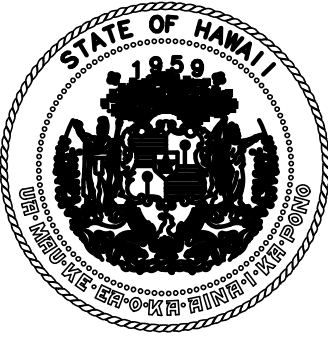

STATE OF HAWAII
DEPARTMENT OF TRANSPORTATION
AIRPORTS

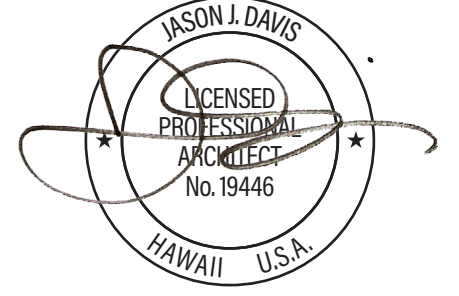


THIS WORK WAS PREPARED BY ME
OR UNDER MY SUPERVISION AND
CONSTRUCTION OF THIS PROJECT
WILL BE UNDER MY OBSERVATION.

DSGN.	DRWN.	CHKD.	APPD.
JV	AQ/JV	JV/EE/MM	JD



07/30/26 ADDENDUM 1

NO.	DATE	REVISIONS
CONSTRUCTION DOCUMENTS		
APRIL 2026 DATE		
PROJECT TITLE :		
CBP FIS RENOVATION		
AT DANIEL K. INOUE INTERNATIONAL AIRPORT HONOLULU, OAHU, HAWAII		
PROJECT NO.:		
CO1433-33		
SHEET TITLE:		
SIGNAGE SCHEDULE AND MOUNTING HEIGHTS		
DATE :		DWG. NO.
2026.04.18		A-603
SHEET :		
40 OF 61 SHEETS		

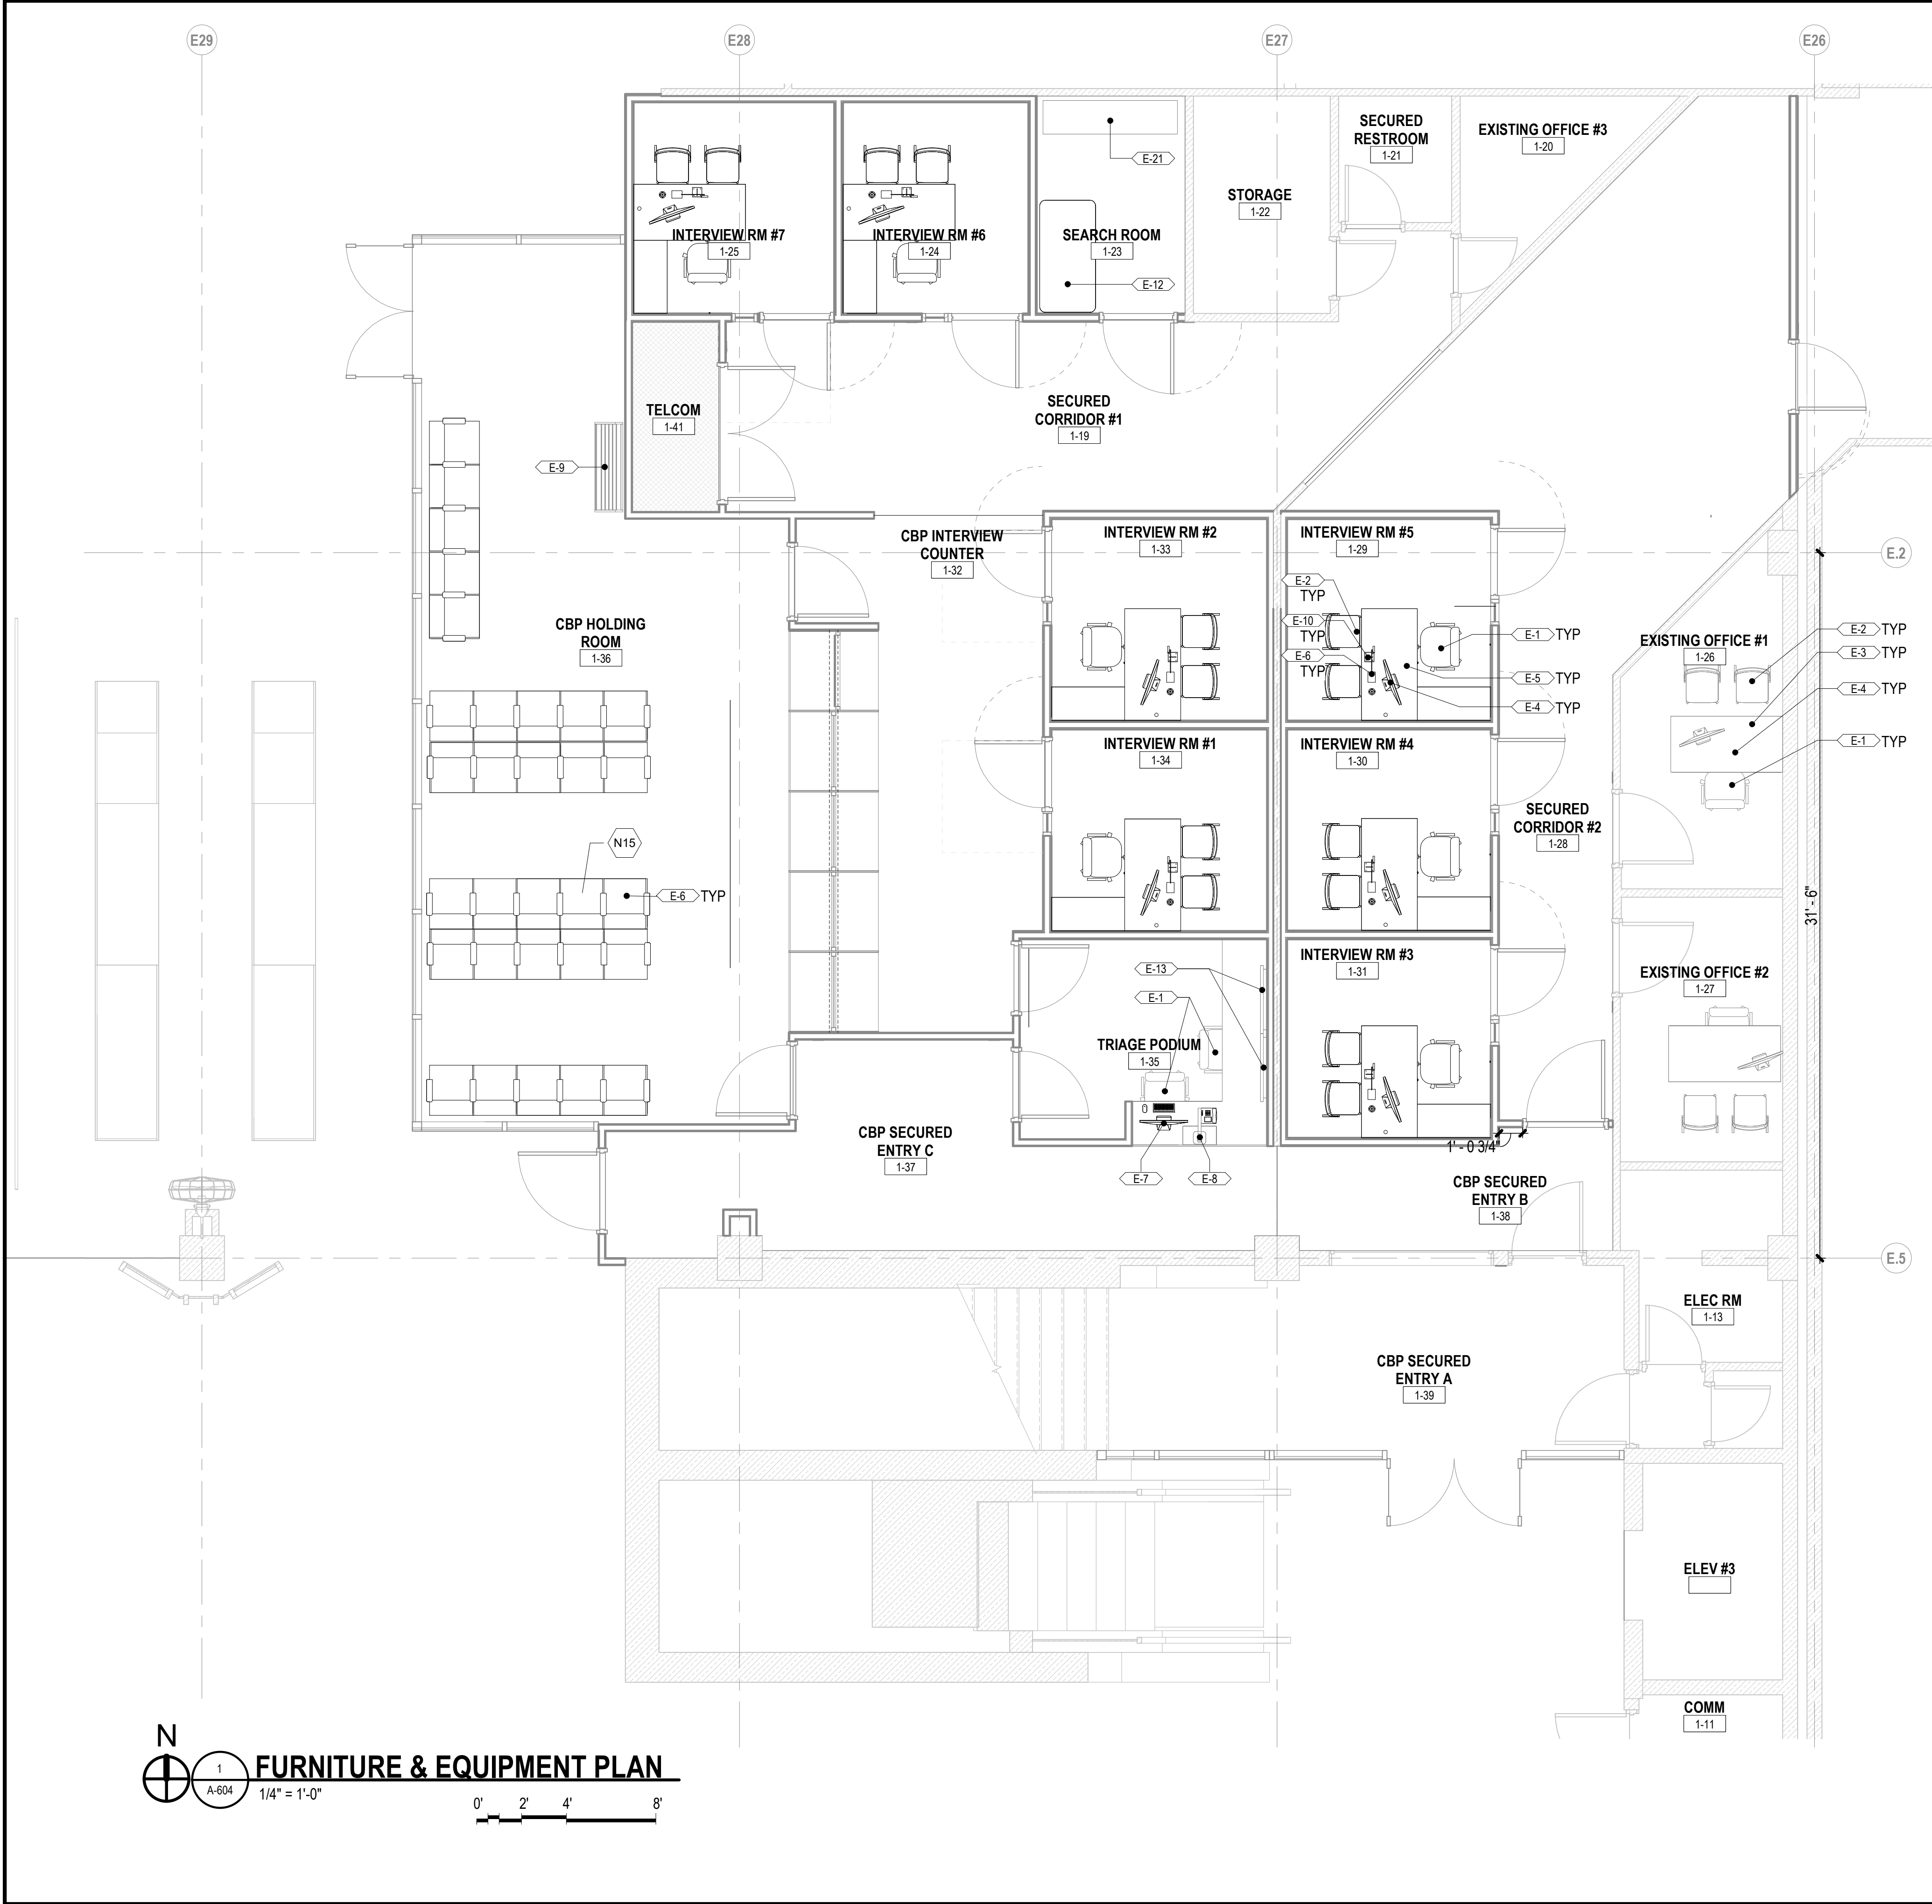

FURNITURE AND EQUIPMENT NOTES


1. PROVIDE FURNISHINGS AND EQUIPMENT AS INDICATED TO SUPPORT CBP OPERATIONS WITHIN THE SECONDARY SCREENING AREA. SEE A-604 AND SPECIFICATIONS APPENDIX A FOR FURNISHINGS AND EQUIPMENT.

KEYNOTES


N15 REINSTALL EXIST SEATING INDICATED BY USER - COORDINATE

FURNITURE SCHEDULE

CODE	DESCRIPTION	RESPONSIBILITY
E-1	OFFICE CHAIR	CFCI
E-2	INTERVIEWEE CHAIR - HEAVY SLED-BASED	CFCI
E-3	OFFICE DESK 36" x 60"	CFCI
E-4	COMPUTER AND MONITOR	OFOI
E-5	INTERVIEW ROOM DESK 30" x 60" W/ 24" RETURN - PROVIDE GROMMETS - FIXED TO FLOOR	CFCI
E-6	OBJECT CAMERA	CFOI
E-7	TRIAGE COMPUTER	OFOI
E-8	TASK LIGHT	CFOI
E-9	LITERATURE RACK	CFCI
E-10	RESTRAINT RING - FIXED TO DESK	CFCI
E-12	TABLE, 30" x 60" W/ ROUNDED CORNERS - FIXED TO FLOOR	CFCI
E-13	MONITOR	CFCI
E-14	MULTIFUNCTION OFFICE PHONE	CFOI
E-20	AIRPORT SEATING - EXISTING TO BE RELOCATED	CFCI
E-21	72"x16"x18" STAINLESS STEEL BENCH SECURED TO FLOOR AND/OR WALL	CFCI

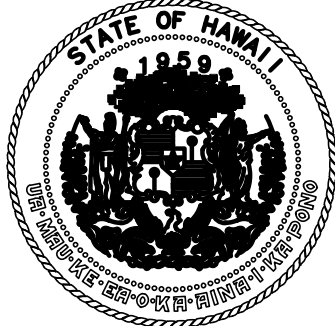

STATE OF HAWAII
DEPARTMENT OF TRANSPORTATION
AIRPORTS

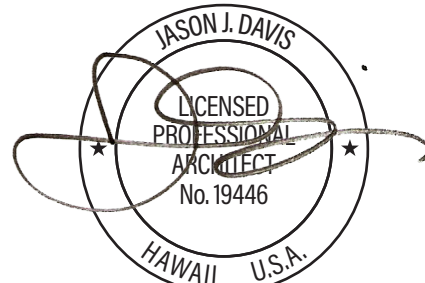

THIS WORK WAS PREPARED BY ME
OR UNDER MY SUPERVISION AND
CONSTRUCTION OF THIS PROJECT
WILL BE UNDER MY OBSERVATION.

DSGN.	DRWN.	CHKD.	APPD.
JV	AQ/JV	JV/EE/MM	JD

07/30/26 ADDENDUM 1

NO.	DATE	REVISIONS
-----	------	-----------

CONSTRUCTION
DOCUMENTS

APRIL 2026
DATE

PROJECT TITLE :

CBP FIS RENOVATION

AT
DANIEL K. INOUE INTERNATIONAL AIRPORT
HONOLULU, OAHU, HAWAII

PROJECT NO.:

CO1433-33

SHEET TITLE:

FURNITURE &
EQUIPMENT PLAN
AND FURNITURE
SCHEDULE

DATE :
2026.04.18
SHEET :
41 OF 61 SHEETS

DWG. NO.

A-604

**STATE OF HAWAII
DEPARTMENT OF TRANSPORTATION
AIRPORTS**

PRE-BID MEETING MINUTES

DATE: July 16, 2026

TIME: 9:00 a.m.

LOCATION: Department of Transportation, Airport
Office Daniel K. Inouye International
Airport Terminal 1 - 7th Floor,
Conference Room C
400 Rodgers Blvd., Suite 700, Honolulu, HI 96819

PROJECT: CBP FIS RENOVATION
Daniel K. Inouye International Airport
State Project No. CO1433-33

I. INTRODUCTION

Attendee introductions (name and company).

II. IMPORTANT ITEMS

1. This meeting is to clarify general questions only. If there is a conflict between what was stated in this meeting and the bid documents, the bid documents shall govern. Any significant changes will be issued through an addendum. A copy of the meeting minutes will be issued to all attendees.
2. Description of Work: The scope of work consists of consolidating the Federal Inspection Services (FIS) Secondary Screening operational areas within the Customs and Border Protection (CBP) facilities at the Daniel K. Inouye International Airport (HNL) through demolition, removal and disposal, renovations, and upgrades to mechanical, electrical, architectural, security, and telecommunications systems, as well as emergency egress improvements and installation of controlled access features. Renovations include modifying existing exterior spaces and secured interior areas, including ceilings, flooring, walls, doors, painting, and lighting. Additionally, scope includes procurement, delivery, and installation of all furniture, equipment, and security equipment necessary to support CBP operational requirements.
3. The completion time of this Contract is two hundred seventy (270)

calendar days from the date indicated in the Notice to Proceed from Department of Transportation, Airports (DOTA).

4. Deadline for Request for Information (RFI) questions is on July 23, 2026 at 2:00 p.m. Hawaii Standard Time (HST).

All questions must be submitted in HlePRO. Verbal RFI(s) will not receive a response.

5. HlePRO OFFER DUE DATE & TIME is August 14, 2026, at 2:00 p.m., HST.

- a. The complete proposal must be uploaded to HlePRO. Failure to upload the complete proposal to HlePRO shall be grounds for rejection of the bid.
 - b. Bidders shall complete all unit prices and amounts. Failure to do so shall be grounds for rejection of bid.
 - c. The bidder's attention is directed to Section 2.11 - BID SECURITY as amended by the Special Provisions.
6. To be eligible for award, bidders must possess a valid State of Hawaii General Engineering "A" or General Building "B" license at the time of bidding.
7. General Conditions as set forth in Division 1- General Requirements Section 01010- Description of Work. Including the but not limited to the following:
 - a. Hours of work – Work can be performed at the construction site at any time over a 24-hour period without considerable disruption to airport operations or other adjacent tenants. Work shall generally be performed between the hours of 10:00 p.m. and 6:30 a.m. Noise, including demolition work, shall occur from 10:00 p.m. to 6:30 a.m. Contractor shall coordinate other work activities with the Engineer for hours between 6:30 a.m. to 1:30 p.m. Dependent on the type and location of work activities, the Contractor may be required to alternate work hours. Contractor shall coordinate their schedule with the Engineer. If rescheduling of work or intermittent work is required, such work shall be performed at no extra cost to the State.
 - b. The Contractor shall coordinate the phases of work with DOTA to permit the continuing operation of existing Airport facilities and to minimize disruption to pedestrian and vehicular traffic.

- c. The Contractor may be required to suspend work during Airline Operational Blackout Dates listed in Section 01010, Paragraph 1.06 C.

III. GENERAL DISCUSSIONS

- 1. Question: Are there special badging requirements for this project?

Response: Refer to SECTION 01010 – DESCRIPTION OF WORK, Subsection 1.05 – Location of Work for provisions related to AOA and CBP badging access.

- 2. Question: Will parking be available for contractor personnel? Are monthly parking passes an option?

Response: Refer to SECTION 01010 – DESCRIPTION OF WORK, Subsection 1.03 – Vehicle Parking for provisions related to vehicle parking.

Refer to SECTION 01010 – DESCRIPTION OF WORK, Subsection 1.04 – Provisions for Field Office/Storage Space for provisions related to field offices.

- 3. Question: Will deliveries of materials be allowed on site?

Response: Refer to SECTION 01010 – DESCRIPTION OF WORK, Subsection 1.04 – Provisions for Field Office/Storage Space for provisions related to staging of materials and equipment.

- 4. Question: Will staging be available?

Response: Refer to SECTION 01010 – DESCRIPTION OF WORK, Subsection 1.04 – Provisions for Field Office/Storage Space for provisions related to staging of materials and equipment.

- 5. Question: What are the requirements for deliveries?

Response: Refer to SECTION 01010 – DESCRIPTION OF WORK: Subsection 1.04 – Provisions for Field Office/Storage Space, Subsection 1.05 – Location of Work, Subsection 1.06 – Hours of Work, Subsection 1.08 – Operation of Airport Facilities During Construction, and Subsection 1.10 – Special Project Requirements.

**STATE OF HAWAII
DEPARTMENT OF TRANSPORTATION
AIRPORTS**

MEETING ATTENDANCE SHEET

DATE: July 16, 2026

TIME: 9:00 AM

LOCATION: HNL Terminal 1 - 7th Floor, Conference Room C

PROJECT: CBP FIS RENOVATION
DANIEL K. INOUE INTERNATIONAL AIRPORT
STATE PROJECT NO. CO1433-33

Name/Title	Company / Address	Contact Information
Name: Erin Hashimoto Title: Engineer / State Project Manager	Company: HDOT-Airports (HNL) Address: 400 Rodgers Blvd, #700 Honolulu, HI 96819	Phone: (808) 838-8803 Email: erin.a.hashimoto@hawaii.gov
Name: Glenn Kechola Jr. Title: Paint Supervisor	Company: Society Contracting LLC Address: 1903 Waihoua Pl.	Phone: 808-455-8157 Email: bids@societycontracting.com
Name: Melvin Inoue Title: PM	Company: Summit Construction Address: 98-055 Kam Hwy Bldg C-2	Phone: 808-531-5414 Email: mtie@summit-hawaii.net
Name: Ed CUBA CUB Title: Estimator	Company: Ralph S. Inouye Co., Ltd Address:	Phone: 808-330-4006 Email: Ed@rsinouye.com
Name: JA 46 Title: PM 8:55 AM	Company: Summit Address: 98-055 Kam Hwy Bldg C-2	Phone: 808 531-5914 Email: 541@summit-hi.net
Name: James Huang Title: Maintenance Man	Company: All Maint and Repair Address:	Phone: (808) 623-7757 Email: allmaintenanceandrepair@yahoo.com
Name: Thuan Title: Project Man.	Company: All Maint and Repair Address:	Phone: (808) 623-7757 Email: allmaintenanceandrepair@yahoo.com

Name: Christopher Title: NARITO	Company: NARITO SM Address:	Phone: 808 722 1672 Email: Ikaika@narito-sm.com
Name: LEO PERALTA Title:	Company: NARITO SM Address:	Phone: 501-9400 Email: leo@narito-sm.com

MEETING ATTENDANCE SHEET

Pre-Bid Meeting

Project Name: **CBP FIS Renovation**
 Daniel K. Inouye International Airport
 Project No. CO1433-33
 Meeting Location: Daniel K. Inouye International Airport, Terminal 1, 7th Floor, Airports Division Office, Conference Room C
 Date: July 16, 2026, 9:00 am

Name: Cami Dillon Title: Coastal Engineer	Company: Oceanit Address:	Phone: Fax: E-Mail: Cdillon@oceanit.com
Name: CHRYSTAL MADIGAN Title: ENGINEER	Company: OCEANIT Address:	Phone: Fax: E-Mail: cmadigan@oceanit.com
Name: JAC & Pankin Title: OWNER	Company: GUAN TO COAST Address: 98-055 W	Phone: Fax: E-Mail:
Name: Nilo Samuels Title: PM	Company: Titan Industries LLC Address:	Phone: 808-673-2022 Fax: E-Mail: nsamuels@titanhawaii.com
Name: Timothy Pagoduan Title: SP	Company: Titan Industries Address:	Phone: 808 465 7063 Fax: E-Mail: Tpagoduan@titanhawaii.com
Name: Stephen Enando Title:	Company: Oceanit Address:	Phone: Fax: 808-368-0860 E-Mail: senando@oceanit.com
Name: Title:	Company: Address:	Phone: Fax: E-Mail:
Name: Title:	Company: Address:	Phone: Fax: E-Mail:
Name: Title:	Company: Address:	Phone: Fax: E-Mail:
Name: Title:	Company: Address:	Phone: Fax: E-Mail:

CBP FIS RENOVATION
DANIEL K. INOUE INTERNATIONAL AIRPORT
HONOLULU, OAHU, HAWAII
STATE PROJECT NO. CO1433-33

RESPONSES TO REQUEST FOR INFORMATION (RFI's / QUESTIONS)

The following Requests for Information (RFI) were received.

1. **QUESTION:** This question pertains to the # 01210-3 Furniture portion - can we omit the following CODES E-4, E6-10, E13 & E14 from our pricing? No specification on these items. Please advise

ANSWER: No. See revised finish schedule on attached A-sheets.

2. **QUESTION:** Regarding RES-1, the specifications reference ASTM F3261 for the SPC (stone-plastic/polymer composite) flooring, which is typically installed as a floating floor. However, the specifications also require a glue-down installation. Floating floor systems are generally more suitable for residential applications and may not be appropriate for this commercial application. Please clarify the required flooring product and installation method for RES-1.

ANSWER: See revised finish schedule on attached A-sheets.

3. **QUESTION:** Provide Specs for CPT-1 (Carpet Tile) if this is the material to follow based on ROOM FINISH SCHEDULE.

ANSWER: See revised finish schedule on attached A-sheets.

4. **QUESTION:** Section 03730- CONCRETE REPAIR references the repair of concrete spalls, delamination, honeycombing, cracks and other defective concrete. Please provide the repair details, estimated quantities and specific structural locations where this work is required.

ANSWER: Based on our investigations, we did not observe any existing concrete spalls, delamination, honeycombing, cracking, or other forms of concrete damage requiring repair. Section 03730 – Concrete Repair is included in the specifications so that, if the contractor encounters any existing concrete damage during the course of their work, they have a defined procedure and requirements to follow. No specific repair locations or quantities are identified at this time. Contractor is responsible for providing documentation of existing conditions prior to start of work.

5. **QUESTION:** Please provide drawing for the signage indicated on sheet A-603.

ANSWER: Signage drawings provided with revised A-sheets.

6. **QUESTION:** Is the existing roof under warranty and if yes, who is maintaining the roof for DOT?

ANSWER: Yes, R & C Roofing Contractors.

7. **QUESTION:** Does the Project Labor Agreement (PLA) apply to this project?

ANSWER: No.

8. **QUESTION:** Is all work for the security control system covered under the Allowance?

ANSWER: Yes.

9. **QUESTION:** Please provide the specifications for the floor finishes indicated on the material and finish schedule to include CPT-1, RB, RES-1 and EPX-1.

ANSWER: See revised finish schedule on attached A-sheets.