

STATE OF HAWAII
DEPARTMENT OF TRANSPORTATION
HIGHWAYS DIVISION

ADDENDUM NO. 1

TO

SPECIAL PROVISIONS, PROPOSAL, CONTRACT AND BOND

FOR

**INTERSTATE ROUTE H-1 AND H-201
DESTINATION SIGN UPGRADE / REPLACEMENT, PHASE 3
DISTRICT OF HONOLULU, ISLAND OF OAHU
FEDERAL-AID PROJECT NO. NH-0300(144)**

January 9, 2023

This Addendum shall make the following amendments to the Bid Documents:

A. NOTICE TO BIDDERS

1. Prospective bidders are hereby notified that the receiving of sealed bids, scheduled for 2:00 P.M. Hawaii Standard Time (HST), January 12, 2023 is **HEREBY POSTPONED** until 2:00 P.M (HST), January 26, 2023. The deadline to submit the Disadvantaged Business Enterprise (DBE) Contract Goal Verification and Good Faith Efforts documentation scheduled for 4:30 P.M. (HST), January 17, 2023 is **HEREBY POSTPONED** until 4:30 PM (HST), January 31, 2023.
2. Delete Notice to Bidders in its entirety and replace with the attached Notice to Bidders pages NB-1 through NB-4 dated r01/09/23.

B. SPECIFICATIONS

1. Table of Contents
 - a. Delete Table of Contents its entirety and replace with the attached Table of Contents pages 1 through 4 dated r01/09/23.
2. SECTION 102 – BIDDING REQUIREMENTS AND CONDITIONS.
 - a. Delete Special Provisions Section 102 in its entirety and replace with the attached Special Provisions Section 102 dated r01/09/23.

3. SECTION 675 – PREPARATION AND COATING OF GALVANIZED BRIDGE COMPONENTS.

- a. Delete Special Provisions Section 675 dated 9/29/22 in its entirety and replace with the attached Special Provisions Section 675 dated r01/09/23.

4. SECTION 697 – CLEAN AND PAINT NEW STEEL.

- a. Delete Special Provisions Section 697 dated 9/29/22 in its entirety and replace with the attached Special Provisions Section 697 dated r01/09/23.

C. PROPOSAL SCHEDULE

1. Replace Proposal Schedule pages P-8 to P-11 dated 12/1/22 with the attached revised Proposal Schedule pages P-8 to P-11 dated r01/09/23.

D. PLANS

1. Replace Plan Sheet No. 13 with the attached revised Plan Sheet No. ADD. 13.
2. Replace Plan Sheets No. 105 thru 108 with the attached revised Plan Sheets No. ADD. 105 thru ADD. 108.
3. Replace Plan Sheets No. 110 thru 129 with the attached revised Plan Sheets No. ADD. 110 thru ADD. 129.
4. Replace Plan Sheet No. 130 with the attached revised Plan Sheet No. ADD. 130.
5. Replace Plan Sheet No. 132 with the attached revised Plan Sheet No. ADD. 132.
6. Replace Plan Sheet No. 136 with the attached revised Plan Sheet No. ADD. 136.
7. Replace Plan Sheet No. 137 with the attached revised Plan Sheet No. ADD. 137.
8. Replace Plan Sheet No. 139 with the attached revised Plan Sheet No. ADD. 139.


9. Replace Plan Sheet No. 143 with the attached revised Plan Sheet No. ADD. 143.
10. Replace Plan Sheet No. 144 with the attached revised Plan Sheet No. ADD. 144.
11. Replace Plan Sheets No. 146 thru 165 with the attached revised Plan Sheets No. ADD. 146 thru ADD. 165.
12. Replace Plan Sheets No. 167 thru 169 with the attached revised Plan Sheets No. ADD. 167 thru ADD. 169.
13. Add and make part of the PLANS the attached Sheet ADD. 127S-1.

The following is provided for information.

E. PRE-BID MEETING MINUTES

1. A Pre-bid meeting was scheduled for December 27, 2022 at 10:00 AM (HST) via Microsoft Teams. No prospective bidders were in attendance.

Please acknowledge receipt of this Addendum No. 1 by recording the date of its receipt in the space provided on page P-4 of the Proposal.

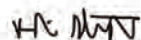

ROBIN K. SHISHIDO
Deputy Director, Highways Division

NOTICE TO BIDDERS
(Chapter 103D, HRS)

The receiving of SEALED BIDS for INTERSTATE ROUTE H-1 AND H-201 DESTINATION SIGN UPGRADE/REPLACEMENT, PHASE 3, Federal Aid Project No. NH-0300(144), DISTRICT OF HONOLULU, ISLAND OF OAHU, will begin as advertised on December 16, 2022 in HiePRO. Bidders are to register and submit bids through HiePro only. See the following HiePRO link for important information on registering: <https://hiepro.ehawaii.gov/welcome.html>.

Deadline to submit bids is Bid Opening Day, January 26, 2023 at 2:00 pm Hawaii Standard Time (HST). Bids received after said due date and time shall not be considered.

The following documents are made part of the Contract Documents and are included in HiePRO; Variance for Community Noise Control, Community Noise Permit, Community Noise Permit extension, Community Noise Permit amendment, and Geotechnical Engineering Exploration report dated February 3, 2022.

The scope of work for this project includes construction of overhead sign structures, sign frames, and drilled shafts; reconstruction of concrete barriers, glare screens; grading; installation of metal guardrail, destination sign panels, pavement markings; modifications to the electrical conduits and pullboxes; maintenance and removal of temporary erosion control measures; and traffic control. The five overhead sign structures to be replaced are located on various highway routes on Oahu. These are shown on the Title Sheet of the plans. The estimated cost of construction is between \$8,000,000 and \$10,000,000.

To be eligible for award, bidders must possess a valid State of Hawaii General Engineering "A" license prior to the award of contract.

A 5% bid adjustment for bidders that are parties to apprenticeship agreements pursuant to Section 103-55.6, Hawaii Revised Statutes (HRS), is applicable to this project.

Compliance with Act 192, SLH 2011 and the Bipartisan Infrastructure Law, Section 25019(a), - is a requirement for this project whereby a minimum of 80% of the bidder's work force on this project must consist of Hawaii residents.

A pre-bid conference is scheduled for December 27, 2022 at 10 am on Microsoft Teams. All prospective bidders or their representatives (employees) are encouraged to attend, but attendance is not mandatory. Due to the impacts of COVID 19, the pre-bid meeting will be conducted virtually. Please call Microsoft Teams to join the Pre-bid meeting at (808) 829-4853, Phone Conference ID: ID: 170 131 137#.

ALL requests for information (RFI) shall be received in writing via HiePRO no less than 14 calendar days before bid opening. Questions received after the deadline will not be addressed. Verbal requests for information will not receive a response. Anything said at the conference is for clarification purposes and any changes to the bid documents will be made by addendum and posted in HiePRO.

Any protest of this solicitation shall be submitted in writing to the Director of Transportation, in accordance with §103D-701, HRS and §3-126, HAR.

Campaign contributions by State and County Contractors. Contractors are hereby notified of the applicability of Section 11-355, HRS, which states that campaign contributions are prohibited from specified State or county government contractors during

the term of the contract if the contractors are paid with funds appropriated by the legislative body. For more information, contact the Campaign Spending Commission at (808) 586-0285.

The U.S. Department of Transportation Regulation entitled "Nondiscrimination in Federally-Assisted Programs of the U.S. Department of Transportation," Title 49, Code of Federal Regulations (CFR), Part 21 is applicable to this project. Bidders are hereby notified that the Department of Transportation will affirmatively ensure that the contract entered into pursuant to this advertisement will be awarded to the lowest responsible bidder without discrimination on the grounds of race, color, national origin or sex (as directed by 23 CFR Part 200).

The Equal Employment Opportunity Regulations of the Secretary of Labor implementing Executive Order 11246, as amended shall be complied with on this project.

The U.S. Department of Transportation Regulations entitled "Participation by Disadvantaged Business Enterprise in Department of Transportation Programs", Title 49, Code of Federal Regulations, Part 26 is applicable to this project. Bidders are hereby notified that the Department of Transportation will strictly enforce full compliance with all of the requirements of the Disadvantaged Business Enterprise (DBE) program with respect to this project.


Bidders are directed to read and be familiar with the Disadvantaged Business Enterprise (DBE) Requirements, which establishes the program requirements pursuant to Title 49 Code of Federal Regulations Part 26 and, particularly, the requirements of certification, method of award, and evidence of good faith. All Bidders must e-mail the Engineer at james.fu@hawaii.gov, the Disadvantaged Business Enterprise (DBE)

Contract Goal Verification and Good Faith Efforts (GFE) Documentation for Construction, Disadvantaged Business Enterprise (DBE) Confirmation and Commitment Agreement – Trucking Company and Disadvantaged Business Enterprise (DBE) Confirmation and Commitment Agreement – Subcontractor, Manufacturer, or Supplier by January 31, 2023 2:00 pm (HST). Failure to provide these documents shall be cause for bid/proposal rejection.

Driving While Impaired (DWI) Education. HDOT encourages all organizations contracted with the DOT to have an employee education program preventing DWI. DWI is defined as operating a motor vehicle while impaired by alcohol or other legal or illegal substances. HDOT promotes this type of program to accomplish our mission to provide a safe environment for motorists, bicyclists and pedestrians utilizing our State highways, and expects its contractors to do so as well.

For additional information, contact James Fu, Project Manager, by phone at (808)692-7611, by fax at (808)692-7617 or email at james.fu@hawaii.gov.

The State reserves the right to reject any or all proposals and to waive any defects in said proposals for the best interest of the public.

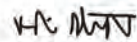

ROBIN K. SHISHIDO
Deputy Director, Highways Division

Posted:

TABLE OF CONTENTS

Notice To Bidders

Instructions for Contractor’s Licensing

Notice of Requirement for Affirmative Action to Ensure
Equal Employment Opportunity (Executive Order 11246)

Disadvantaged Business Enterprise (DBE) Requirements

Required Federal-Aid Contract Provisions

Special Provisions Title Page

Special Provisions:

DIVISION 100 - GENERAL PROVISIONS		
Section	Description	Pages
101	Terms, Abbreviations, and Definitions	101-1a – 101-13a
102	Bidding Requirements and Conditions	102-1a – 102-8a
103	Award And Execution of Contract	103-1a – 103-5a
104	Scope of Work	104-1a – 104-2a
105	Control of Work	105-1a – 105-3a
106	Material Restrictions and Requirements	106-1a
107	Legal Relations and Responsibility To Public	107-1a – 107-6a
108	Prosecution And Progress	108-1a – 108-27a
109	Measurement and Payment	109-1a – 109-2a



DIVISION 200 - EARTHWORK		
Section	Description	Pages
201	Clearing and Grubbing	201-1a
203	Excavation and Embankment	203-1a – 203-2a
209	Temporary Water Pollution, Dust, and Erosion Control	209-1a – 209-28a

DIVISION 300 - BASES		
Section	Description	Pages
301	Hot Mix Asphalt Base Course	301-1a – 301-2a

DIVISION 400 - PAVEMENTS		
Section	Description	Pages
401	Hot Mix Asphalt Pavement	401-1a – 401-37a
407	Tack Coat	407-1a
415	Cold Planing of Existing Pavement	415-1a

DIVISION 500 - STRUCTURES		
Section	Description	Pages
501	Steel Structures	501-1a
503	Concrete Structures	503-1a – 503-7a
507	Railing	507-1a
511	Drilled Shafts	511-1a – 511-22a

DIVISION 600 - INCIDENTAL CONSTRUCTION		
Section	Description	Pages
601	Structural Concrete	601-1a – 601-15a
602	Reinforcing Steel	602-1a – 602-2a
606	Guardrail	606-1a
607	Chain Link Fences and Gates	607-1a
629	Pavement Markings	629-1a – 629-3a
630	Traffic Control Guide Signs	630-1a – 630-2a
636	E-Construction	636-1a – 636-3a
641	Hydro-Mulch Seeding	641-1a
645	Work Zone Traffic Control	645-1a – 645-2a
656	Drilling Holes and Installing Dowel Reinforcing Bars	656-1a
670	Positive Protection Barrier	670-1a

671	Moveable Steel Barrier	671-1a – 671-2a
672	Portable Concrete Barrier	672-1a – 672-2a
675	Preparation and Coating of Galvanized Steel Components	675-1a – 675-8a
695	Removal and Disposal of Lead-Based Paint	695-1a – 695-6a
697	Clean and Paint New Steel	697-1a – 697-10a
699	Mobilization	699-1a



DIVISION 700 - MATERIALS		
Section	Description	Pages
702	Bituminous Materials	702-1a
750	Traffic Control Sign and Marker Materials	750-1a – 750-2a
755	Pavement Marking Materials	755-1a

Requirement of Chapter 104, HRS
Wages and Hours of Employees on Public Works Law

Federal Wage Rates

Proposal Title Page

Proposal P-1 – P-7
Proposal Schedule P-8 - P-12

Disadvantaged Business Enterprise (DBE) Contract Goal Verification and Good Faith Efforts (GFE) Documentation For Construction

Disadvantaged Business Enterprise (DBE) Confirmation and Commitment Agreement – Trucking Company

Disadvantaged Business Enterprise (DBE) Confirmation and Commitment Agreement – Subcontractor, Manufacturer, or Supplier

Surety Bid Bond

Sample Forms

Contract

Performance Bond (Surety)

Performance Bond

Labor and Material Payment Bond (Surety)

Labor and Material Payment Bond

Disclosure of Lobbying Activities
Standard Form - LLL and LLL-A

Statement of Compliance
Form WH-348

Chapter 104, HRS Compliance Certificate

END OF TABLE OF CONTENTS

1 Make this section a part of the Standard Specifications:

2
3 **“SECTION 102 - BIDDING REQUIREMENTS AND CONDITIONS**

4
5
6 **102.01 Prequalification of Bidders.** Prospective bidders shall be capable of
7 performing the work for which they are bidding.

8
9 In accordance with HRS Chapter 103D-310, the Department may require
10 any prospective bidder to submit answers to questions contained in the
11 'Standard Qualification Questionnaire For Prospective Bidders On Public Works
12 Contracts' furnished by the Department, properly executed and notarized, setting
13 forth a complete statement of the experience of such prospective bidder and its
14 organization in performing similar work and a statement of the equipment
15 proposed to be used, together with adequate proof of the availability of such
16 equipment. Whenever it appears to the Department, from answers to the
17 questionnaire or otherwise, that the prospective bidder is not fully qualified and
18 able to perform the intended work, the Department will, after affording the
19 prospective bidder an opportunity to be heard and if still of the opinion that the
20 bidder is not fully qualified to perform the work, refuse to receive or consider any
21 bid offered by the prospective bidder. All information contained in the answers to
22 the questionnaire shall be kept confidential. Questionnaire so submitted shall be
23 returned to the bidders after serving their purpose.

24
25 No person, firm or corporation may bid where (1) the person, firm, or
26 corporation, or (2) a corporation owned substantially by the person, firm, or
27 corporation, or (3) a substantial stockholder or an officer of the corporation, or (4)
28 a partner or substantial investor in the firm is in arrears in payments owed to the
29 State or its political subdivisions or is in default as a surety or failure to do
30 faithfully and diligently previous contracts with the State.

31
32 **102.02 Contents of Proposal Forms.** The Department will furnish
33 prospective bidders with proposal forms posted in HlePRO stating:

- 34
35 (1) The location,
36
37 (2) Description of the proposed work,
38
39 (3) The approximate quantities,
40
41 (4) Items of work to be done or materials to be furnished,
42
43 (5) A schedule of items, and
44
45 (6) The time in which the work shall be completed.
46

47 Papers bound with or attached to the proposal form are part of the
48 proposal. The bidder shall not detach or alter the papers bound with or attached
49 to the proposal when the bidder submits its proposal through HlePRO.
50

51 Also, the bidder shall consider other documents including the plans and
52 specifications a part of the proposal form whether attached or not.
53

54 **102.03 (Unassigned).**
55

56 **102.04 Estimated Quantities.** The quantities shown in the contract are
57 approximate and are for the comparison of bids only. The actual quantity of
58 work may not correspond with the quantities shown in the contract. The
59 Department will make payment to the Contractor for unit price items in
60 accordance with the contract for only the following:
61

62 (1) Actual quantities of work done and accepted, not the estimated
63 quantities; or
64

65 (2) Actual quantities of materials furnished, not the estimated
66 quantities.
67

68 The Department may increase, decrease, or omit each scheduled
69 quantities of work to be done and materials to be furnished. When the
70 Department increases or decreases the estimated quantity of a contract item by
71 more than 15% the Department will make payment for such items in accordance
72 with Subsection 104.06 - Methods of Price Adjustment.
73

74 **102.05 Examination of Contract and Site of Work.** The bidder shall
75 examine carefully the site of the proposed work and contract before submitting a
76 proposal.
77

78 By the act of submitting a bid for the proposed contract, the bidder
79 warrants that:
80

81 (1) The bidder and its Subcontractors have reviewed the contract
82 documents and found them free from ambiguities and sufficient for the
83 purpose intended;
84

85 (2) The bidder and its workers, employees and subcontractors have
86 the skills and experience in the type of work required by the contract
87 documents bid upon;
88

89 (3) Neither the bidder nor its employees, agents, suppliers or
90 subcontractors have relied upon verbal representations from the
91 Department, its employees or agents, including architects, engineers or
92 consultants, in assembling the bid figure; and

93 (4) The basis for the bid figure are solely on the construction contract
94 documents.

95
96 Also, the bidder warrants that the bidder has examined the site of the
97 work. From its investigations, the bidder acknowledges satisfaction on:

- 98
99 (1) The nature and location of the work;
100
101 (2) The character, quality, and quantity of materials;
102
103 (3) The difficulties to be encountered; and
104
105 (4) The kind and amount of equipment and other facilities needed;
106

107 Subsurface information or hydrographic survey data furnished are for the
108 bidders' convenience only. The data and information furnished are the product
109 of the Department's interpretation gathered in investigations made at the specific
110 locations. These conditions may not be typical of conditions at other locations
111 within the project area or that such conditions remain unchanged. Also,
112 conditions found at the time of the subsurface explorations may not be the same
113 conditions when work starts. The bidder shall be solely responsible for
114 assumptions, deductions, or conclusions the bidder may derive from the
115 subsurface information or data furnished.
116

117 If the Engineer determines that the natural conditions differ from that
118 originally anticipated or contemplated by the Contractor in the items of
119 excavation, the State may treat the difference in natural conditions, as falling
120 within the meaning of Subsection 104.02 – Changes.
121

122 **102.06 Preparation of Proposal.** The submittal of its proposal shall be on
123 forms furnished by the Department. The bidder shall specify in words or figures:

- 124
125 (1) A unit price for each pay item with a quantity given;
126
127 (2) The products of the respective unit prices and quantities
128
129 (3) The lump sum amount; and
130
131 (4) The total amount of the proposal obtained by adding the amounts
132 of the several items.
133

134 The words and figures shall be in ink or typed. If a discrepancy occurs
135 between the prices written in words and those written in figures, the prices
136 written in words shall govern.
137

138 When an item in the proposal contains an option to be made, the bidder
139 shall choose in accordance with the contract for that particular item.
140 Determination of an option will not permit the Contractor to choose again.

141
142 The bidder shall sign the proposal properly in ink. A duly authorized
143 representatives of the bidder or by an agent of the bidder legally qualified and
144 acceptable to the Department shall sign, including one or more partners of the
145 bidder and one or more representatives of each entity comprising a joint venture.

146
147 When an agent, other than the officer(s) of a corporation authorized to
148 sign contracts for the corporation or a partner of a partnership, signs the
149 proposals, a 'Power of Attorney' shall be on file with the Department or submitted
150 with the proposal. Otherwise, the Department will reject the proposal as irregular
151 and unauthorized.

152
153 The bidder shall submit acceptable evidence of the authority of the
154 partner, member(s) or officer(s) to sign for the partnership, joint venture, or
155 corporation respectively with the proposal. Otherwise, the Department will reject
156 the proposal as irregular and unauthorized.

157
158 **102.07 Irregular Proposals.** The Department may consider proposals
159 irregular and may reject the proposals for the following reasons:

160
161 (1) The proposal is a form not furnished by the Department, altered, or
162 detached;

163
164 (2) The proposal contains unauthorized additions, conditions, or
165 alternates. Also, the proposal contains irregularities that may tend to
166 make the proposal incomplete, indefinite, or ambiguous to its meaning;

167
168 (3) The bidder adds provisions reserving the right to accept or reject an
169 award. Also, the bidder adds provisions into a contract before an award;

170
171 (4) The proposal does not contain a unit price for each pay item listed
172 except authorized optional pay items; and

173
174 (5) Prices for some items are out of proportion to the prices for other
175 items.

176
177 (6) If in the opinion of the Director, the bidder and its listed
178 subcontractors do not have the Contractor's licenses or combination of
179 Contractor's licenses necessary to complete the work.

180
181 Where the prospective bidder is bidding on multiple projects
182 simultaneously and the proposal limits the maximum gross amount of awards
183 that the bidder can accept at one bid letting, the proposal is not irregular if the

184 limit on the gross amount of awards is clear, and the Department selects the
185 awards that can be given.

186
187 **102.08 Proposal Guaranty.** The Department will not consider a proposal of
188 \$25,000 or more unless accompanied by:

189
190 (1) A deposit of legal tender; or

191
192 (2) A valid surety bid bond, underwritten by a company licensed to
193 issue bonds in the State of Hawaii, in the form and composed,
194 substantially, with the same language as provided herewith and signed by
195 both parties; or

196
197 (3) A certificate of deposit, share certificate, cashier's check,
198 treasurer's check, teller's check, or official check drawn by, or a certified
199 check accepted by and payable on demand to the State by a bank,
200 savings institution, or credit union insured by the Federal Deposit
201 Insurance Corporation (FDIC) or the National Credit Union Administration
202 (NCUA).

203
204 (a) The bidder may use these instruments only to a maximum of
205 \$100,000.

206
207 (b) If the required security or bond amount totals over \$100,000
208 more than one instrument not exceeding \$100,000 each and
209 issued by different financial institutions shall be acceptable.

210
211 (c) The instrument shall be made payable at sight to the
212 Department.

213
214 (d) Proposal Guaranty listed in (1) and (3) shall be in its original
215 form, and shall be received at the Contracts Office, Department of
216 Transportation, 869 Punchbowl Street, Honolulu, Hawaii 96813
217 before the bid deadline.

218
219 In accordance with HRS Chapter 103D-323, the above shall be in a sum
220 not less than 5% of the amount bid.

221
222

223 **102.09 Delivery of Proposal.** The bidder shall submit the proposal in
224 HlePRO. Bids received after said due date and time shall not be considered.
225 Original bid documents do not have to be submitted. Award will be made based
226 on proposals submitted in HlePRO.

227
228 **102.10 Withdrawal or Revision of Proposals.** A bidder may withdraw or
229 revise a proposal after the bidder submits the proposal in HlePRO. Withdrawal

230 or revision of proposal must be completed before the time set for the receiving of
231 bids.

232
233 **102.11 Public Opening of Proposals.** Not applicable.

234
235 **102.12 Disqualification of Bidders.** The Department may disqualify a bidder
236 and reject its proposal for the following reasons:

237
238 (1) Submittal of more than one proposal whether under the same or
239 different name.

240
241 (2) Evidence of collusion among bidders. The Department will not
242 recognize participants in collusion as bidders for any future work of the
243 Department until such participants are reinstated as qualified bidders.

244
245 (3) Lack of proposal guaranty.

246
247 (4) Submittal of an unsigned or improperly signed proposal.

248
249 (5) Submittal of a proposal without a listing of subcontractors or
250 containing only a partial or incomplete listing of subcontractors.

251
252 (6) Submittal of an irregular proposal in accordance with Subsection
253 102.07 - Irregular Proposals.

254
255 (7) Evidence of assistance from a person who has been an employee
256 of the agency within the preceding two years and who participated while in
257 State office or employment in the matter with which the contract is directly
258 concerned, pursuant to HRS Chapter 84-15.

259
260 (8) Suspended or debarred in accordance with HRS Chapter 104-25.

261
262 (9) Failure to complete the prequalification questionnaire, if applicable.

263
264 (10) Failure to attend the mandatory pre-bid meeting, if applicable.

265
266 **102.13 Material Guaranty.** The successful bidder may be required to furnish
267 a statement of the composition, origin, manufacture of materials, and samples.

268
269 **102.14 Substitution of Materials and Equipment Before Bid Opening.** See
270 Subsection 106.13 for Substitution Of Materials and Equipment After Bid
271 Opening.

272
273 (A) **General.** When brand names of materials or equipment are specified
274 in the contract documents, they are to indicate a quality, style,
275 appearance, or performance and not to limit competition. The bidder shall

276 base its bid on one of the specified brand names unless alternate brands
277 are qualified as equal or better in an addendum. Qualification of such
278 proposed alternate brands shall be submitted via email to the Contact
279 person listed in HlePRO for the solicitation and also post a question in
280 HlePRO under the question/answer tab referencing the email with the
281 request. The request must be posted in HlePRO no later than 14
282 calendar days before the bid opening date, not including the bid opening
283 date.

284

285 An addendum will be issued to inform all prospective bidders of any
286 accepted substitution in accordance with Subsection 102.17 – Addenda.

287

288 **(B) Statement of Variances.** The statement of variances must list all
289 features of the proposed substitution that differ from the contract
290 documents and must further certify that the substitution has no other
291 variant features. The brochure and information submitted shall be clearly
292 marked showing make, model, size, options, and any other features
293 requested by the Engineer and must include sufficient evidence to
294 evaluate each feature listed as a variance. A request will be denied if
295 submitted without sufficient evidence. If after installing the substituted
296 product, an unlisted variance is discovered, the Contractor shall
297 immediately replace the product with a specified product at no increase in
298 contract price and contract time.

299

300 **(C) Substitution Denial.** Any substitution request not complying with
301 the above requirements will be denied.

302

303 **102.15 Preferences.** Preferences shall not apply to this project. 

304

305 **102.16 Certification for Safety and Health Program for Bids in excess of**
306 **\$100,000.** In accordance with HRS Chapter 396-18, the bidder or offeror, by
307 signing and submitting this proposal, certifies that a written safety and health
308 plan for this project will be available and implemented by the notice to proceed
309 date for this project. Details of the requirements of this plan may be obtained
310 from the State Department of Labor and Industrial Relations, Occupational
311 Safety and Health Division (HIOSH).

312

313

314

315 **102.17 Addenda.** Addenda issued shall become part of the contract
316 documents. Addenda to the bid documents will be provided to all prospective
317 bidders via HlePRO. Each addendum shall be an addition to the contract
318 documents. The terms and requirements of the bid documents (i.e., drawings,
319 specifications and other bid and contract documents) cannot be changed prior to
320 the bid opening except by a duly issued addendum.”

321

322
323

END OF SECTION 102

1 Make the following Section a part of the Standard Specifications:

2
3 **“SECTION 675 – PREPARATION AND COATING OF GALVANIZED BRIDGE**
4 **COMPONENTS**

5
6 **675.01 Description of Work.** This specification defines the material and
7 execution requirements for the preparation and coating of hot dip galvanized
8 (HDG) **overhead steel signage structures on** the Island of Oahu.



9
10 This specification is to supplement the specification Section 697 - Clean and
11 Paint New Steel. It is limited in scope to cleaning, surface preparation and
12 coating of galvanized steel substrates. The galvanized pieces will be prepared
13 as described herein, and coated with a 2 coat epoxy and fluoropolymer system,
14 including stripe coating of edges.

15
16 **REFERENCE STANDARDS**

17
18 **American Society for Testing Materials (ASTM)**

19
20 ASTM D-4285 “Standard Test Method for Indicating Oil and Water in
21 Compressed Air”

22
23 ASTM D-4940 “Standard Test Method for Conductimetric Analysis of Blasting
24 Media.

25
26 ASTM D-6386 “Standard Practice for Preparation of Zinc (Hot-Dip Galvanized)
27 Coated Iron and Steel Product and Hardware Surfaces for Painting”

28
29 ASTM D-4417C “Standard Test Method for Field Measurement of Surface Profile
30 of Blast Cleaned Steel

31
32 **Society of Protective Coatings (SSPC), now AMPP**

33
34 SSPC Volume 1 “Good Painting Practices”

35
36 SSPC-SP-1 “Solvent Cleaning

37
38 SSPC – SP-2 “Hand Tool Cleaning”

39
40 SSPC-SP-3 “Power Tool Cleaning”

41
42 SSPC-PA-2 “Measurement of Dry Coating Thickness with Magnetic Gages”

43
44 SSPC-QP-3, “Quality Procedure for Shop Painting Accreditation Program.”

45 SSPC-SP-16 “Brush off Blast Cleaning of Uncoated and Coated Galvanized
46 Steel”

47

48 **Other Standards**

49

50 American Galvanizers Assn. (AGA) publication “Suggested Specification for
51 Preparing Hot-Dip Galvanized Surfaces for Painting”, February 2002

52

53 Federal Standard 595B, Federal Standard Colors, FED-STD-595B

54

55 **675.02 Material Requirements.**

56

57 **(A) General.** Coating material requirements in this section supersede
58 coating material listed in the base specification Section 697 – Clean and
59 Paint New Steel.

60

61 For the galvanized components: A duplex system, consisting of an epoxy
62 intermediate and a fluoro-urethane topcoat will be applied over the HDG
63 system. The intermediate, stripe, and topcoat shall all be supplied by the
64 same manufacturer.

65

66 (1) Primer - An industrial grade epoxy polyamide intermediate
67 manufactured by the following companies are authorized for use in
68 this application: Sherwin Williams, and Tnemec Company, Inc.

69

70 (2) Stripe coat - The stripe coat shall be the same product as the
71 intermediate coat and supplied in a contrasting color.

72

73 (3) Topcoat- The topcoat shall be of Fluoropolymer FEVE
74 technology and selected from the following manufacturers: Sherwin
75 Williams (Fluorekem 100HS), and Tnemec Company, Inc.(Fluoronar
76 Series 1070).

77

78 (4) Topcoat color - The formulated color of the topcoat shall
79 conform to Federal Standard 595B color 14062 Dark Green,
80 possessing a minimum 80° gloss finish.

81

82 **(B) Thinners and Additives.** Thinners or additives shall be those
83 recommended by the coating manufacturer. Thinner shall be primarily used
84 for cleaning of equipment. Thinner may not be added in amounts exceeding
85 the limits set forth in the manufacturer’s product data sheet (PDS)

86

87 **675.03 Construction Requirements.** The work of this section shall
88 compliment ASTM D-6386 and AGA Suggested Specification listed in the Other
89 Standards section. Surface preparation method will be chosen based on the

90 condition of the new HDG steel, per ASTM D6386 and the AGA Suggested
91 Specification.

92
93 All coating work shall be performed in an enclosed shop facility holding a current
94 SSPC-QP-3 accreditation.

95
96 **(A) Inspection.** Inspect surfaces to verify suitability of the surfaces to
97 receive paints prior to the commencement of surface preparation and paint
98 application. Establish an initial average applied DFT of the galvanizing using
99 equipment described in SSPC-PA-2. Report, in writing, to the Engineer or
100 his designated representative any condition that may affect proper
101 application or overall performance.

102
103 **(1) Surface Smoothing.** Zinc high spots, such as a metal
104 drip line, shall be removed by cleaning with hand tools or
105 power tools as described in SSPC Surface Preparation
106 Specification SSPC-SP-2 or SSPC-SP3. The zinc shall be
107 removed until it is level with the surrounding area, taking care
108 that the base galvanized layer is not damaged.

109
110 **(B) Surface Preparation.**

111
112 **(1) Solvent Cleaning:** Visible grease and oil shall be
113 removed prior to the surface preparation. This shall be
114 accomplished in accordance with SSPC-SP-1 (Solvent
115 Cleaning) or power washing (low pressure water cleaning
116 under 5000psi). Water break test may be performed to insure
117 removal of contaminants prior to surface preparation and
118 coating.

119
120 **(2) Ambient Conditions:** Final surface preparation which
121 exposes bare steel shall not be performed under damp
122 environmental conditions or when the surface temperature is
123 less than 5°F above the dew point temperature of the
124 surrounding air.

125
126 **(3) Compressed Air Cleanliness:** The supply air used for
127 cleaning, blow down, or paint application using conventional
128 and airless paint equipment shall be free from moisture and oil
129 contamination. The air cleanliness shall be verified daily using
130 the ASTM D 4285 method.

131

132
NOTE: Items (4) through (10) apply to abrasive brush-off blasting. Abrasive blasting per SSPC-SP-16 of the galvanized pieces may be required by the guidelines set forth in ASTM D6386, the AGA publication referenced herein, or any on-site agent authorized by the Engineer.

(4) Abrasives/ Profile: Abrasives used for sweep blasting shall be clean and uniformly graded, free of oil, soluble salts and other similar substances. Sweep blast abrasives shall have hardness less than 5 on the Mohs scale and a particle size in the 200-500 micron range. All abrasives shall be tested per ASTM D-4940 prior to use.

(5) Abrasive Brush-Off blasting of galvanized surfaces shall be accomplished according to SSPC-SP-16, to achieve a general, uniform roughened texture of no more than 0.75 mils.

(6) Abrasive size and nozzle pressure should be adequate to achieve the desired profile.

(7) After SSPC-SP-16 has been accomplished, blow down all surfaces with clean-dry compressed air to ensure all dust is removed prior to painting.

(8) Subsequent to brush-off blasting, visually examine all surfaces to ensure completeness of surface preparation.

(9) Random profile measurements shall be made according to ASTM-D4417C to ensure proper technique. Baseline DFT measurements shall be taken over brush-off blasted galvanizing to ensure preservation of the original galvanized thickness and to establish a baseline thickness to be used to evaluate final coating system thickness.

(10) Any areas of galvanizing that have been blasted to bare steel or damaged during mechanical tool cleaning shall be touched up with an organic zinc rich epoxy (from the selected NEPCOAT List B) prior to subsequent coating application.



171
172
173
174
175
176
177
178
179
180
181
182
183

184
185
186

187
188
189
190

191
192
193
194
195
196
197

198
199
200
201
202
203
204
205
206
207
208

209

(C) Coating Application.

(1) Surface Condition: The surface shall exhibit the degree of preparation specified immediately prior to painting. Coating of the prepared pieces shall be accomplished within 24 hours of completion of surface preparation.

(2) Surface Cleanliness:

(a) Prior to coating, thoroughly clean all surfaces to be coated and remove spent abrasive, dirt, dust, or other contaminants.

(b) Follow these cleaning steps on the initial cleaning and between coats of a multi-coat system and during curing process.

(c) Adequate dust collection, containment and/or dust removal is required for the project. Proper ventilation shall be maintained during surface preparation, coating application and cure.

(d) No dust is allowed to remain on the substrate or allowed to fall on the freshly applied coating during the coating application and/or during curing process.

(e) Embedded abrasive or dust on the substrate or in the coating film must be removed prior to any coating application.

(3) Grease / Oil. Remove any oil and grease that may have been deposited on the prepared surface prior to application of the specified coating system by solvent cleaning (SP-1).

(4) Ambient Conditions: Apply coatings within the environmental condition ranges specified in the individual Product Data Sheets (PDS). As a general rule, the following conditions apply:

(a) Surface and Air Temperature: Maintain between 50°F and 95°F.

(b) Relative Humidity: 85% or less.

210 (c) Dew Point: Surface temperatures of the
211 substrate shall be at least 5°F greater than the dew
212 point temperature of the surrounding air.

213 (d) Atmosphere: Do not paint when the air adjacent
214 to the surface contains a fog, mist, dust, or other
215 particulate matter. Do not perform coating operations
216 during winds in excess of 15 mph.

217 **(D) Coating Coverage and Continuity.**
218

219 **(1) Stripe Coat:** Apply a stripe coat of the un-thinned
220 intermediate coat by brush to, crevices, bolt heads, welds, and
221 pits or other surface continuities prior to the application of the
222 intermediate coat.

223 **(2) Coverage:** Apply coatings via conventional spray or
224 airless spray to all surfaces with special attention to hard-to-
225 reach areas such as underneath support brackets, back to
226 back angles, skip welding or deep pits.

227 **(3) Continuity:** All coats shall have a smooth surface and be
228 free from dryspray, overspray, and orange peel. Pinholes,
229 bubbles, and misses are not acceptable. Brush out runs and
230 sags while material is still wet.

231 **(4) Observe all applicable recoat windows as specified in**
232 **the respective coating Product Data Sheet (PDS). If no recoat**
233 **window is specified, a minimum of 12 hours and maximum of**
234 **24 hours shall be observed as the applicable recoat window.**
235

236 **(5) Dry Film Thickness**
237

238 (a) Apply each coat to the thickness range specified
239 in the PDS. Contractor shall be required to record DFT
240 readings.
241

242 (b) Dry Film Deficiencies: Apply additional coat(s) to
243 all surfaces having less dry film thickness specified, at
244 no additional cost to the owner.
245

246 (c) Average baseline galvanized steel thickness
247 shall be subtracted from average DFT readings of each
248 coat to calculate true coating thickness.
249

250 **(E) Repair of Damaged or Deficient Coating on the Substrate.** Repair
251 all damaged or deficient coatings prior to the project completion.

252
253 **(1) Preparation of Localized Damages:** Power tool clean the
254 damaged area in accordance with the appropriate power tool
255 cleaning specification, SSPC-SP-3 "Power Tool Cleaning".
256 After preparation, the area shall be needle-gunned to re-
257 establish a profile if any grinding was performed. Follow ASTM
258 D 6386 for galvanized substrate repairs.

259 **(2) Preparation of Extensive Damage:** Repair in accordance
260 with the original specification.

261 **(3) Coating Application:** When the base of the substrate is
262 exposed, re-apply all coats of the coating system. When the
263 damage area does not extend to the base substrate, re-apply
264 only the affected coats. Exercise special care to maintain the
265 specified thickness of the system in the overlapped area onto
266 the existing intact coat.

267 **(G) Holdpoints.** All Hold Points for Quality Control listed in Section 697 –
268 Clean and Paint New Steel, shall be accomplished, in addition to the
269 following:

270
271 **(1) Masking of slip critical bolted areas**

272
273 **(2) Calculation of baseline DFT of galvanizing**

274
275 **(3) Surface smoothing of galvanizing defects**

276
277 **(4) Surface cleanliness (water break test) prior to surface**
278 **preparation by brush-off blasting**

279
280 **(5) Blast air quality, blast grit cleanliness**

281
282 **(6) Visual examination for dust after blasting and prior to**
283 **striping of bolted connections and crevices**

284
285 **(7) Visual cleanliness examination prior to intermediate**
286 **coat and topcoat application**

287
288 **(8) Profile of brush-off blasted surface**

289
290 **(9) Repair of defects**

291

292 (10) Final DFT and workmanship

293

294 **675.04 Measurement.** The Engineer will not measure Preparation and
295 Coating of Galvanized Bridge Components for payment.

296

297 **675.05 Payment.** The Engineer will not pay for accepted Preparation and
298 Coating of Galvanized Bridge Components separately. The Engineer shall consider
299 the cost for the accepted Preparation and Coating of Galvanized Bridge
300 Components as included in the contract price of the various contract items. The cost
301 is for the work prescribed in this section and the contract documents.”

302

303

END OF SECTION 675

1 Make the following Section a part of the Standard Specifications:



2 **“SECTION 697– CLEAN AND PAINT NEW STEEL**

4
5 **697.01 Description of Work.** This work includes power washing, near
6 white metal blast finishing (if required), and painting all new structural steel for
7 overhead sign structures. Painting includes application of primer, stripe coat to
8 all edges, corner and bolted connections (see exclusions), intermediate coat and
9 topcoat. Bolted connections (faying surfaces) are to be masked as detailed in
10 this specification. Field touch up is to be accomplished after erection and will
11 include application of intermediate and topcoat to the bolted connections after
12 proper cleaning.



13
14 This specification is to be used as a “base specification” for more detailed work,
15 such as painting of Hot Dip Galvanized (HDG) steel, supplemented in Section
16 675 – Preparation and Coating of Galvanized Bridge Components.

17
18 The Contractor awarded the work will be required to attend a pre-job conference to
19 discuss the pertinent issues of the work, discuss schedule, and to address the
20 specification. A walk-through of the location where the painting is to take place and
21 additional walk-throughs at each work site must be part of the pre-job conference.
22 The field work site walk-through must have an explanation of how the steel structure
23 is to be offloaded, erected, and repair touch-up painting to be done. At a minimum
24 the Contractor’s field foreman and QC representative shall be present. The pre-job
25 conference will be required for shop painting of new steel, galvanized steel, as well
26 as field touch-up after erection.

27
28 **697.02 Material Requirements.**

29
30 **(A) General.** In this section, the terms: coat; paint; coating and painting
31 are interchangeable. The term “system”, when referencing coat or paint, means
32 the final product of several different, compatible coatings of paint.

33
34 **(1) The coating system for all steel surfaces to be painted on this**
35 **project shall be in accordance with Special Provisions Section 675.**
36 Include a separate brush applied coat over all edges, corners, bolts,
37 rivet heads, and weld seams (stripe coat).



38
39 **(2) Do not mix manufacturers.** The same manufacturer shall
40 furnish the primer, intermediate, stripe, and topcoat.

41
42 **(3) Color.** Final colors shall be as determined by the Engineer or
43 other referenced State Specifications. Paint sheen and specific color
44 scheme shall be determined by Engineer.

45
46
Colors shall be according to Federal Standard 595B 'Federal Standard Colors'. The Contractor shall submit color selection to the Engineer for review and final selection before ordering paint system products. Each coat of paint, in its wet and cured conditions, shall have distinctly contrasting shades between subsequent coats applied to aid in application and inspection of the coating.

(4) The Manufacturer shall submit a Certificate of Compliance for the protective coatings stating that the Contractor can apply each coating between temperatures of 50-95F, and at relative humidity no greater than 85%.

(5) The manufacturer shall prepare the paint at the factory, ready for application. The Engineer will not permit the addition of a thinner or other material to the paint after shipping the paint.

(6) The Contractor shall furnish paint manufacturer's certification that the paint complies with paint system requirements as specified herein.

(7) **Tinting.** The Manufacturer shall add the tinting materials required to the paint at the factory. The Engineer shall not allow field tinting.

(8) **Labeling.** Labels on containers shall show the exact title of the paint. The title must indicate which layer it must be used for, the manufacturer's name, date of manufacture, date of expiration, the manufacturer's batch number, product code and the lot number if appropriate. Package the paint in new approved containers. Precautions concerning the handling and application of paint shall be shown on the label of all paint and solvent containers.

(B) **Coatings Specified.** See Special Provisions Section 675 for specific paint system requirements.

(C) **Paint System Requirements.**



(1) When the proposed Paint System manufacturer's literature requires a higher degree of surface preparation or a greater film



88
89
90
91
92
93
94
95
96
97
98
99
100
101
102
103
104
105
106
107
108
109
110
111
112
113
114
115
116
117
118
119
120
121
122
123
124
125
126
127
128
129
130
131

thickness than specified herein, that degree of surface preparation and film thickness shall be applied, at no additional cost to the State.

(2) The proposed paint system shall have a minimum of two years' field exposure on similar structures.

(3) The Contractor shall submit any proposed equivalent paint system for review and approval after award of contract.

697.03 Construction Requirements.

(A) General.

(1) The coating Contractor shall comply with the current, State, Federal and local laws and regulations pertaining to the protection of the environment in the performance of this type of work. These include but are not limited to regulations required by the State Department of Health (DOH), Federal Environmental Protection Agency (EPA), rules and regulations.

(2) The coating Contractor shall comply with the current Federal Occupational Safety and Health Administration (OSHA) and Hawaii Occupational Safety and Health (HIOSH) requirements for worker protection and safety equipment during all work on this project.

(3) The shop facility performing the blasting and painting (prior to shipment to the construction site) shall be certified to SSPC-QP-3, Shop Painting Certification Program.

(4) The field touch-up contractor shall be certified to SSPC-QP-1, Field Application to Complex Marine and Industrial Structures.

(5) All surface preparation and painting operations, whether in the shop or field, shall be inspected by a NACE CIP Level 2 certified coating inspector.

(B) Site Preparations.

(1) The Contractor's work shall, at all times, be made accessible to the Engineer. Contractor shall provide all safety, fall protection, access and scaffolding needs for the Engineer. The Contractor shall make ground level or superstructure access to all bents using man-lifts, ladders and/or scaffolding or stairs.

132
133
134
135
136
137
138
139
140
141
142
143
144
145
146
147
148
149
150
151
152
153
154
155
156
157
158
159
160
161
162
163
164
165
166
167
168
169
170
171
172
173
174
175

(C) Containment of Work and Protection of the Environment

- (1)** SHOP: This specification requires all fabricated steel be cleaned via pressure washing with fresh-water to remove construction debris and any other surface contaminants. Solvent cleaning will be necessary to remove any fabrication grease, oils and markings.
- (2)** FIELD: In order to protect the surrounding natural environment and work environment, the Contractor will be required to contain each work area so that there is no escape of water-wash effluent to the surrounding area. In addition, care should be taken to contain any overspray to escape into the surrounding environment, above and under the structure.
- (3)** Wash water effluent shall be removed on an ongoing basis throughout the project as to not interfere with ongoing operations. Containment of the work area shall remain in place until the final coat of paint has been cured, inspected, and accepted by the Engineer.

(D) Surface Cleaning and Preparation. The coating shop shall prepare the steel as specified below:

- (1)** Before any surface preparation, remove all visible and non-visible contaminants described herein by methods specified in SSPC-SP1 Solvent Cleaning. General cleaning shall be accomplished using Low Pressure Water Cleaning (as defined in SSPC WJ-2/NACE WJ-2) at minimum working pressures of 1000 psi, not to exceed 3000 psi using fresh water. For the purposes of this specification, fresh water shall be defined as local potable water quality.
- (2)** (NOTE: For field touch-up, after arrival at the erection site, if the existing steel member coatings have any surface contaminants such as sea salts, dirt, construction debris, grease, oils, bird droppings, and other contamination not listed herein they shall be cleaned according to Subsection 697.03(D)(1).
- (3)** Vacuum or air blow-down (using clean, dry and oil-free air) shall be used to remove any standing water and to aid in drying surfaces prior to mechanical methods of surface preparation.



176
177
178
179
180
181
182
183
184
185
186
187
188
189
190
191
192
193
194
195
196
197
198
199
200
201
202
203
204
205
206
207
208
209
210
211
212
213
214
215
216
217
218
219
220

(4) Surface preparation of all new steel (does not apply to HDG steel) shall be in accordance with Society of Protective Coatings standard SSPC-SP-10 Near White Metal Blasting. Blast profile shall be an anchor tooth profile of 2.0 – 3.5 mils, and shall be accomplished with a proper steel shot/grit mix. Brush-off blasting of hot dip galvanized components shall be in accordance with SSPC-SP-16, and **Special Provisions Section 675**.

NOTE ON QC CHECKPOINTS - Coating Contractor shall inform Engineer at least one working day prior to QC Checkpoint operations. In the event the Engineer is not present at the requested time, the Contractor may proceed to the next evolution, provided that Contractor documents QC data on the required data sheets.

QC Checkpoint - Cleanliness

All surfaces to be prepared shall meet the requirements of SSPC-SP-1 Solvent Cleaning. Surfaces shall be cleaned so that chloride measurements taken on the washed steel measure under 10 µg/cm² chlorides as measured with any method detailed in SSPC TU-4, Shop Methods for Retrieval and Analysis of Soluble Salts on Substrates. A minimum of 1 measurement shall be made for each 1000 ft² of surface washed.

(E) Surface Preparation and Coating Application for Touch-up areas. (Applicable to both shop and field painting.) A touch-up area is any area on the steel which includes a surface defect such as a gouge, scrape, or any area that has been damaged during the handling, transportation, ongoing construction, or erection of the structure. Areas burned by torch cutting and welding are also included as touch-up.

(1) Prepare damaged area(s) to sound coating or steel using methods described in SSPC-SP-2 Hand Tool Cleaning, SSPC-SP-3 Power Tool Cleaning, and SSPC-SP-11 Power tool cleaning to Bare Metal. If damaged area is to bare steel, ensure that the exposed steel has a surface profile of 1.0 – 3.5 mils profile, using methods described in ASTM D4417. Note that rotary disc sanding will destroy existing profile on the steel, so establishment of a profile by mechanical impact tooling such as needle guns, Bristle Blasters™, or roto-peens will be necessary.

(2) Ensure that the surrounding area to intact coating is feathered smooth to eliminate rough edges.

221
222
223
224
225
226
227
228
229
230
231
232
233
234
235
236
237
238
239
240
241
242
243
244
245
246
247
248
249
250
251
252
253
254
255
256
257
258
259
260
261
262
263
264
265

(3) Any single repair area under 4 in² may be repaired with SP-2/SP-3 methods when accepted by the Engineer. Any repair area over 4 in² or that has bare rusting steel shall be prepared in accordance with SP-11.

(4) Remove any dust, residue and debris prior to paint touch-up according to SP-1.

(5) Apply touch-up coats of the entire **approved paint system including primer, intermediate, and topcoat** by brush to specified thicknesses, in accordance with manufacturer's Product Data Sheet (PDS)

(6) Follow Subsection 697.03(G) Application Requirements (Primer, Intermediate and Topcoat)" for application of coats.

QC Preparation and Application for Touch-Up areas - All areas prepared and touched-up shall be verified for completeness by the Engineer prior to application of stripe coat.

(F) Application of Stripe Coat

(1) Prior to strip coating, verify all surfaces are clean and contaminant free according to SSPC SP-1.

(2) All stripe coating shall be accomplished by brush. Striping shall be applied to all edges, crevices, nuts, bolts, weld seams and tight metal-to-metal joints, with the selected epoxy intermediate coating. Splice connections that have been bolted up will receive a brush stripe coat of intermediate, followed up by application of topcoat, as described in this specification, or supplemental referenced State Specification.. Stripe coat shall be of distinctly contrasting color of intermediate and topcoat to aid in determining coverage. During application, immediately brush out any runs, drips, sags or puddles. Stripe coating shall cover all edges of the structure, extending approximately 1/2" on either side of the edge, where applicable.

(3) Galvanized nuts and bolts shall be wire brushed, solvent wiped and striped and painted as described herein.

QC Checkpoint – Stripe Coat



266 Verify stripe coat is applied to all applicable surfaces with no visible holidays
267 and in accordance with good painting practice as detailed in SSPC PA-1.
268

269 **(G) Application Requirements (Prime Coat, Intermediate, and**
270 **Topcoat).**

271
272 **(1)** The Contractor shall paint the repair areas according to the
273 best practices of the trade, in conformance with the recommendations
274 of the coating manufacturer as delineated in the Product Data Sheets,
275 observing all recommended environmental conditions, recoat
276 windows, wet and dry film thicknesses, and in conformance with
277 applicable portions of the Steel Structures Painting Council
278 Specification SSPC-PA 1, except where superseded by these
279 specifications.
280

281 **(2)** Coating applicators shall use wet film thickness (WFT) gages
282 periodically to ensure proper application thicknesses. Periodic WFT
283 measurements shall be made during paint application utilizing an
284 approved wet film thickness gage. After sufficient cure time, dry film
285 thickness readings shall be taken with a calibrated electronic gage, of
286 each coat in accordance with SSPC- PA-2. DFT measurements shall
287 not be made in areas of stripe coat, as these will be higher than
288 specified ranges. Where thickness measurements fall below the
289 specified minimum, make additional application of paint as necessary
290 to meet the thickness required, at no additional cost to the State.
291

292 **QC Checkpoints- Intermediate and Topcoat**

293
294 Verify substrate cleanliness immediately prior to prime coat
295 application. Clean in accordance with SSPC SP-1 if not clean prior
296 to application of prime coat.
297

298 After cure of prime coat, accomplish a visual holiday inspection and
299 rectify any discrepancies according to the Engineer.
300


301 Verify substrate cleanliness immediately prior to intermediate
302 application. Clean in accordance with SSPC SP-1 if not clean prior
303 to application of intermediate coat.
304

305 **NOTE for MASKING:**

306 Masking will apply to all slip-critical connections which include splice
307 plate connection and cross-bracing connection faying surfaces. After
308 sufficient cure of primer (or Hot Dip Galvanizing, if the structure is
309 galvanized steel), slip critical splice connection surfaces shall be
310 masked according to the detail below using suitable means that will

311
312
313
314

not damage the underlying primer or surrounding area. Masking shall be removed from all connection areas within 48 hours of topcoat application.

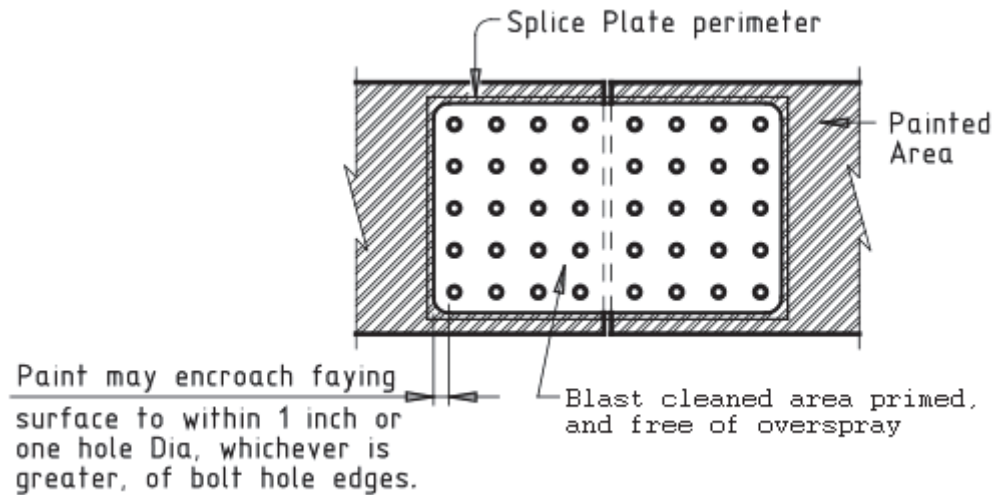

315
316
Slip critical splice plates, shall only be blasted and primed according to this specification. After erection, the primed splice plates and bolts shall be touched up with intermediate and topcoat according to this specification.

NOTE: See plan sheets for additional paint masking details. After cure of intermediate coat, accomplish a visual holiday inspection and rectify any discrepancies according to the Engineer.

Verify substrate cleanliness immediately prior to topcoat application. Clean in accordance with SSPC SP-1 if not clean prior to application of topcoat.

After cure of topcoat, accomplish a visual holiday inspection and rectify any discrepancies according to the Engineer.

Verify DFT readings of prime, intermediate and topcoats in accordance with SSPC PA-2, according to the DFT schedule listed for the selected coating system from NEPCOAT List B.

(3) Sufficient time shall elapse between successive coats to permit them to dry properly for recoating. Consult specific Product Data Sheet (PDS) for proper cure times. If any appreciable time elapses between painting operations, as judged by the Engineer, the coating manufacturer or Contractor shall re-clean surfaces before restarting painting operations.

343
344
(4) Apply coatings via airless spray utilizing approved equipment standard to the industry according to the instruction of the paint manufacturer. (All stripe coating shall be applied by brush.)

(H) Submittals.

(1) **Paint Manufacturer's Product Data Sheet (PDS).** The Contractor shall submit paint manufacturer's paint product data sheet with their written warranty, including the conditions limiting the warranty. Product Certificates of Conformance (CoC's) shall accompany all material used under this specification and shall be submitted. Any alternate materials, as described above shall be submitted to the Engineer at least 30 days before the start of production work for review and acceptance.

(2) **Paint Manufacturer's Safety Data Sheets (SDS).** The contractor shall submit the corresponding SDS for each material supplied, including intermediate, stripe, and topcoats, along with thinning/cleaning solvents.

(3) **Abrasive.** If applicable, type and size of abrasive, along with any pertinent documentation and Certificates of Conformance shall be submitted for the abrasive used in abrasive blasting operations.

(4) **Coating contractor's Quality Control (QC) reports.** The Contractor shall maintain daily surface preparation and coating inspection reports in accordance with details of the QP-3 Shop Certification, which detail the work performed, noting areas prepared/painted, environmental conditions throughout the day (to include Substrate Temperature, Ambient Temperature, Dew Point, and Relative Humidity), product applied, batch numbers, date of manufacture, acceptance criteria, QC data, notes and any problems encountered. A weekly report shall be compiled from the daily reports and submitted to the Engineer on a weekly basis. A sample blank copy of the daily inspection report to be used shall be submitted to the Engineer prior to the start of production work.

(5) **Coating Contractor's Work Plan.** Within two weeks of starting production work, the contractor shall submit a Coating Work Plan, detailing a timetable of significant events for the entire process. The work plan, at a minimum, will detail coating or

388 shop facility name and location, dates of
389 mobilization/demobilization, preparation and coating activities,
390 specific equipment and methods used, and abrasive media (if
391 applicable) data sheets.

392
393 (6) Name and resume of proposed NACE CIP Level 2 coating
394 inspector, detailing past inspection activities
395

396 (I) **Cleanup and Disposal.** The Contractor shall clean up the entire
397 project site of painting, cleaning debris, containment, masking material,
398 BMP's and other debris caused by the Contractor's operations, before
399 receiving final payment. This work shall be considered incidental to the
400 other contract items.

401

402 **697.04 Measurement.**

403

404 (A) The Engineer will not measure Clean and Paint New Steel Members
405 for payment.

406

407 **697.05 Payment.** The Engineer will not pay for accepted Clean and Paint New
408 Steel Members separately. The Engineer shall consider the cost for the accepted
409 Clean and Paint New Steel Members as included in the contract price of the various
410 contract items. The cost is for the work prescribed in this section and the contract
411 documents."

412

413

414

END OF SECTION 697

PROPOSAL SCHEDULE

ITEM NO.	ITEM	APPROX. QUANTITY	UNIT	UNIT PRICE	AMOUNT
201.1000	Clearing and Grubbing	150	SY	\$ _____	\$ _____
202.0100	Removal of Existing Signs and Sign Structures	LS	LS	LS	\$ _____
202.0200	Removal of Existing Barriers	LS	LS	LS	\$ _____
203.1000	Roadway Excavation	35	CY	\$ _____	\$ _____
209.0100	Installation, Maintenance, Monitoring, and Removal of BMP	LS	LS	LS	\$ _____
209.0200	Additional Water Pollution, Dust, and Erosion Control	FA	FA	FA	\$ <u>10,000.00</u>
301.1000	Hot Mix Asphalt Base Course	60	Ton	\$ _____	\$ _____
401.1000	HMA Pavement, Mix No. IV	15	Ton	\$ _____	\$ _____
503.0100	Concrete for Sign Structure Pedestal and Corbel on Bridge for H1WB-505	15	CY	\$ _____	\$ _____
503.0200	Concrete for Sign Structure Pier and Pedestal on Bridge for H1WB-511	10	CY	\$ _____	\$ _____
503.0300	Concrete for Drilled Shaft Pedestals	41	CY	\$ _____	\$ _____
507.1000	Concrete Barrier Reconstruction for H1EBR-253	LS	LS	LS	\$ _____
507.2000	Concrete Barrier Reconstruction for H1EB-305	LS	LS	LS	\$ _____

PROPOSAL SCHEDULE

ITEM NO.	ITEM	APPROX. QUANTITY	UNIT	UNIT PRICE	AMOUNT
507.3000	Concrete Barrier Reconstruction for H1WB-511	LS	LS	LS	\$ _____
511.0100	Furnishing Drilled Shaft Drilling Equipment	LS	LS	LS	\$ _____
511.0200	Obstructions	20	Hour	\$ _____	\$ _____
511.0300	Unclassified Shaft Excavation (60-inch Diameter Shafts)	98	LF	\$ _____	\$ _____
511.0400	Drilled Shaft (60-inch Drilled Shafts)	98	LF	\$ _____	\$ _____
511.0500	Coring for Integrity Testing for Acceptable Drilled Shaft	30	LF	\$ _____	\$ _____
603.0400	Clean Existing Culverts	FA	FA	FA	\$ 25,000.00
606.1100	Guardrail Type 3, Strong Post W-Beam Guardrail	100	LF	\$ _____	\$ _____
607.1000	3-Foot, Chain Link Fence for H1 EBR-253	40	LF	\$ _____	\$ _____
607.2000	6-Foot, chain Link Fence for H1-305	20	LF	\$ _____	\$ _____
629.1100	1/2-Inch Pavement Striping (Thermoplastic Extrusion)	1,100	LF	\$ _____	\$ _____
629.1200	4-Inch Pavement Striping (Profiled Thermoplastic)	3,300	LF	\$ _____	\$ _____
629.1300	6-Inch Pavement Striping (Thermoplastic Extrusion)	1,100	LF	\$ _____	\$ _____
629.2100	Type C Pavement Marker	85	Each	\$ _____	\$ _____

PROPOSAL SCHEDULE

ITEM NO.	ITEM	APPROX. QUANTITY	UNIT	UNIT PRICE	AMOUNT
629.2200	Type H Pavement Marker	30	Each	\$ _____	\$ _____
630.1000	Panel for Destination Signs	2,700	SF	\$ _____	\$ _____
630.2000	Type I Post and Arms for H1EBR-253	1	Each	\$ _____	\$ _____
630.0300	Type I Post and Arms for 78EBR-830	1	Each	\$ _____	\$ _____
630.0400	Type III Post and Arms for H1EB-305	1	Each	\$ _____	\$ _____
630.0500	Type I Post and Arms for H1WB-505	1	Each	\$ _____	\$ _____
630.0600	Type I Post and Arms for H1WB-511	1	Each	\$ _____	\$ _____
636.1000	Additional E-Construction Programs, additional licenses or additional equipment	FA	FA	FA	\$ <u>\$ 10,000.00</u>
641.1000	Hydro-mulch Seeding	LS	LS	LS	\$ _____
643.0100	Maintenance of Existing Landscape Areas	FA	FA	FA	\$ <u>\$ 25,000.00</u>
645.1101	Traffic Control - Sign H1EBR-253	LS	LS	LS	\$ _____
645.1102	Traffic Control - Sign 78EBR-830	LS	LS	LS	\$ _____
645.1103	Traffic Control - Sign H1EB-305	LS	LS	LS	\$ _____
645.1104	Traffic Control - Sign H1WB-505	LS	LS	LS	\$ _____

PROPOSAL SCHEDULE

ITEM NO.	ITEM	APPROX. QUANTITY	UNIT	UNIT PRICE	AMOUNT
645.1105	Traffic Control - Sign H1WB-511	LS	LS	LS	\$ _____
645.2000	Additional Police Officers, Additional Traffic Control Devices and Advertisement	FA	FA	FA	\$ <u>200,000.00</u>
648.1000	FieldPosted Drawings	LS	LS	LS	\$ _____
695.1000	Removal and Disposal of Lead Based Paint	FA	FA	FA	\$ <u>300,000.00</u>
696.1000	Maintenance of Trailers	FA	FA	FA	\$ <u>50,000.00</u>
699.0100	Mobilization (Not to Exceed 6 Percent of the Sum of All Items Excluding the Bid Price of this Item)	LS	LS	LS	\$ _____

a. TOTAL AMOUNT FOR COMPARISON OF BIDS..... \$ _____


Bids shall include all Federal, State, County and other applicable taxes.

The TOTAL AMOUNT FOR COMPARISON OF BIDS will be used to determine the lowest responsible bidder.

In case of a discrepancy between unit price and the total in said bid, the unit price shall prevail.

NOTE: Bidders must complete all unit prices and amounts. Failure to do so may be grounds for rejection of bid.

FED. ROAD DIST. NO.	STATE	FEDERAL AID PROJ. NO.	FISCAL YEAR	SHEET NO.	TOTAL SHEETS
HAWAII	HAW.	NH-0300(144)	2023	ADD. 13	175

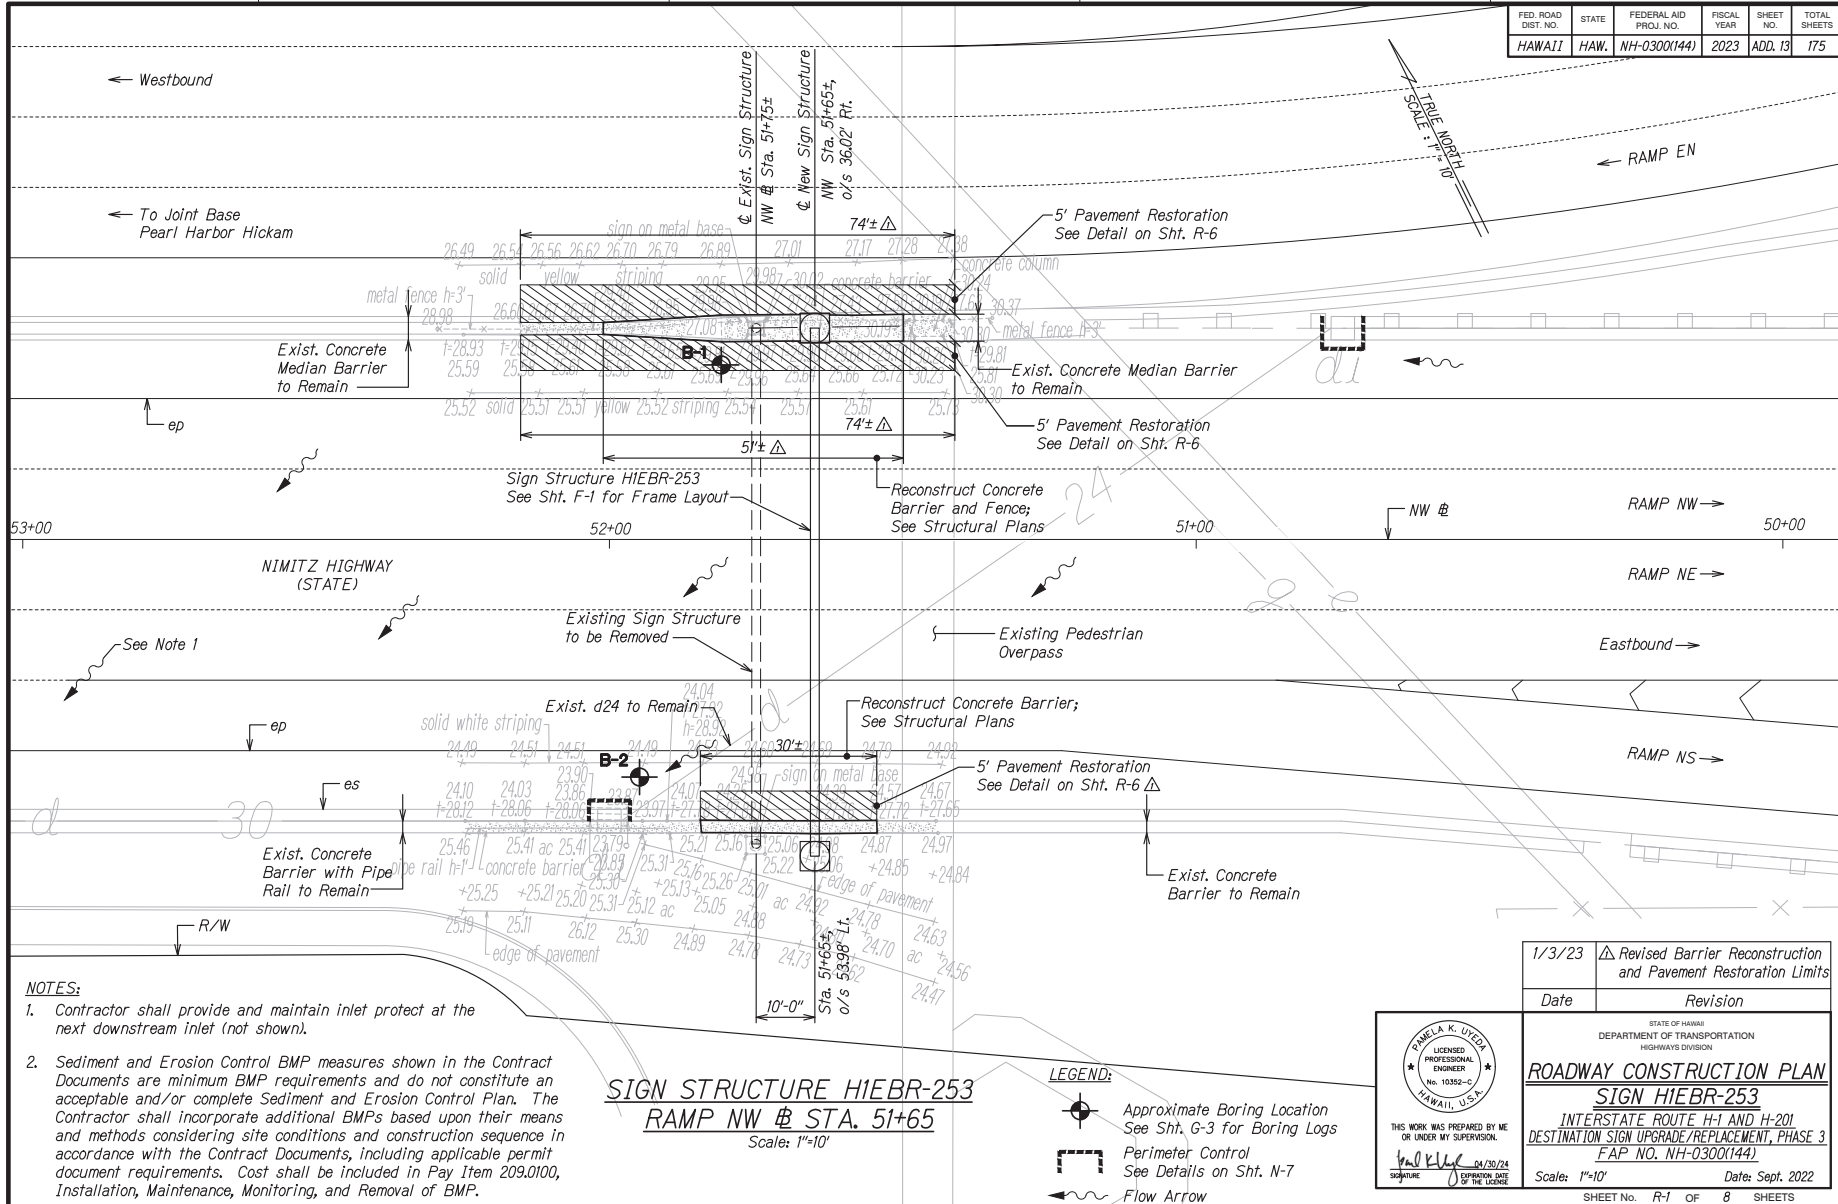

- NOTES:**
- Contractor shall provide and maintain inlet protect at the next downstream inlet (not shown).
 - Sediment and Erosion Control BMP measures shown in the Contract Documents are minimum BMP requirements and do not constitute an acceptable and/or complete Sediment and Erosion Control Plan. The Contractor shall incorporate additional BMPs based upon their means and methods considering site conditions and construction sequence in accordance with the Contract Documents, including applicable permit document requirements. Cost shall be included in Pay Item 209.0100, Installation, Maintenance, Monitoring, and Removal of BMP.

**SIGN STRUCTURE HIEBR-253
RAMP NW @ STA. 51+65**
Scale: 1"=10'

- LEGEND:**
- Approximate Boring Location
See Sht. G-3 for Boring Logs
 - Perimeter Control
See Details on Sht. N-7
 - Flow Arrow

PAMELA K. UVODA
 LICENSED PROFESSIONAL ENGINEER
 No. 10352-C
 HAWAII, U.S.A.
 THIS WORK WAS PREPARED BY ME OR UNDER MY SUPERVISION.
 Signature: *P. Uvoda* Date: 04/30/24
 EXP. DATE OF SEAL: 04/30/24

1/3/23	△ Revised Barrier Reconstruction and Pavement Restoration Limits
Date	Revision
STATE OF HAWAII DEPARTMENT OF TRANSPORTATION HIGHWAYS DIVISION ROADWAY CONSTRUCTION PLAN SIGN HIEBR-253 INTERSTATE ROUTE H-1 AND H-201 DESTINATION SIGN UPGRADE/REPLACEMENT, PHASE 3 FAP NO. NH-0300(144)	
Scale: 1"=10'	Date: Sept. 2022
SHEET No. R-1 OF 8 SHEETS	

INDEX OF STRUCTURAL DRAWINGS

FED. ROAD DIST. NO.	STATE	FEDERAL AID PROJ. NO.	FISCAL YEAR	SHEET NO.	TOTAL SHEETS
HAWAII	HAW.	NH-0300(144)	2023	ADD. 105	175

SHEET NO.	DESCRIPTION	SHEET NO.	DESCRIPTION	SHEET NO.	DESCRIPTION
S1.1	INDEX OF STRUCTURAL DRAWINGS	S6.1	SIGN STRUCTURE HIWB-511 - SITE PLAN	S8.7	DOUBLE CANTILEVER BOX TRUSS SIGN STRUCTURE - SECTIONS
S1.2	STRUCTURAL GENERAL NOTES	S6.2	SIGN STRUCTURE HIWB-511 - ELEVATION	S8.8	DOUBLE CANTILEVER BOX TRUSS SIGN STRUCTURE - MICROWAVE RADAR SUPPORT PLAN, SECTS., AND DETAILS
S1.3	STRUCTURAL GENERAL NOTES	S6.3	SIGN STRUCTURE HIWB-511 - DEMOLITION SECTIONS		
S1.4	STRUCTURAL GENERAL NOTES	S6.4	SIGN STRUCTURE HIWB-511 - DEMOLITION SECTION	S9.1	TYPICAL DRILLED SHAFT AND PEDESTAL
S1.5	SYMBOLS AND ABBREVIATIONS	S6.5	SIGN STRUCTURE HIWB-511 - DEMOLITION PLAN AND ELEVATION	S9.2	TYPICAL BASE PLATE AND ANCHOR BOLT DETAILS
		S6.6	SIGN STRUCTURE HIWB-511 - DEMOLITION SECTIONS	S9.3	TYPICAL BASE PLATE AND ANCHOR BOLT DETAILS
S2.1	SIGN STRUCTURE HIEBR-253 - ELEVATION	S6.7	SIGN STRUCTURE HIWB-511 - SECTIONS	S9.4	TYPICAL COLUMN SECTIONS AND DETAILS
S2.2	SIGN STRUCTURE HIEBR-253 - BARRIER DEMO. PLAN, ELEV, AND SECTS.	S6.8	SIGN STRUCTURE HIWB-511 - SECTIONS	S9.5	TYPICAL CONNECTION DETAILS
S2.3	SIGN STRUCTURE HIEBR-253 - BARRIER DEMO. PLAN, ELEV, AND SECTS.	S6.9	SIGN STRUCTURE HIWB-511 - SECTION	S9.6	TYPICAL SIGN PANEL ELEVATION
S2.4	SIGN STRUCTURE HIEBR-253 - BARRIER PLAN, ELEV., AND SECTION	S6.10	SIGN STRUCTURE HIWB-511 - SECTION	S9.7	TYPICAL MOUNTING BEAM DETAILS
S2.5	SIGN STRUCTURE HIEBR-253 - BARRIER REINFORCING ELEVATION	S6.11	SIGN STRUCTURE HIWB-511 - PLAN AND ELEVATION	S9.8	TYPICAL SIGN PANEL ASSEMBLY AND HARDWARE DETAILS
S2.6	SIGN STRUCTURE HIEBR-253 - SECTIONS	S6.12	SIGN STRUCTURE HIWB-511 - SECTION	S9.9	TYPICAL SIGN PANEL ASSEMBLY
S2.7	SIGN STRUCTURE HIEBR-253 - BARRIER PLAN, ELEV., AND SECTS.	S6.13	SIGN STRUCTURE HIWB-511 - SECTIONS	S9.10	TYPICAL RIBBED SHEET METAL DETAILS
S2.8	SIGN STRUCTURE HIEBR-253 - BARRIER JOINTING DETAILS	S6.14	SIGN STRUCTURE HIWB-511 - SECTIONS		
S2.9	SIGN STRUCTURE HIEBR-253 - TYPICAL DETAILS			S10.1	SIGN SCHEDULE
		S7.1	BOX TRUSS SIGN STRUCTURE - PLAN AND ELEVATION	S10.2	SIGN SCHEDULE
S3.1	SIGN STRUCTURE 78EBR-830 - ELEVATION	S7.2	BOX TRUSS SIGN STRUCTURE - TRUSS FRAME ELEVATION		
		S7.3	BOX TRUSS SIGN STRUCTURE - DETAILS		
S4.1	SIGN STRUCTURE HIEB-305 - ELEVATION	S7.4	BOX TRUSS SIGN STRUCTURE - DETAILS		
S4.2	SIGN STRUCTURE HIEB-305 - DEMOLITION ELEVATION	S7.5	BOX TRUSS SIGN STRUCTURE - SECTIONS		
S4.3	SIGN STRUCTURE HIEB-305 - BARRIER ELEVATION	S7.6	BOX TRUSS SIGN STRUCTURE - DETAIL		
S4.4	SIGN STRUCTURE HIEB-305 - SECTION	S7.7	BOX TRUSS SIGN STRUCTURE - MICROWAVE RADAR SUPPORT PLAN, SECTS., AND DETAILS		
S5.1	SIGN STRUCTURE HIWB-505 - ELEVATION	S8.1	DOUBLE CANTILEVER BOX TRUSS SIGN STRUCTURE - PLAN AND ELEVATION		
S5.2	SIGN STRUCTURE HIWB-505 - PEDESTAL SUPPORT DEMOLITION PLAN AND SECTS.	S8.2	DOUBLE CANTILEVER BOX TRUSS SIGN STRUCTURE - SECTIONS		
S5.3	SIGN STRUCTURE HIWB-505 - PIER CAP DEMOLITION ELEV. AND SECTION	S8.3	DOUBLE CANTILEVER BOX TRUSS SIGN STRUCTURE - SECTION		
S5.4	SIGN STRUCTURE HIWB-505 - CORBEL SUPPORT PLAN AND SECTIONS	S8.4	DOUBLE CANTILEVER BOX TRUSS SIGN STRUCTURE - SECTIONS		
△ S5.4A	SIGN STRUCTURE HIWB-505 - CORBEL SUPPORT SECTIONS	S8.5	DOUBLE CANTILEVER BOX TRUSS SIGN STRUCTURE - SECTION		
S5.5	SIGN STRUCTURE HIWB-505 - PEDESTAL SUPPORT PLAN, ELEV. AND SECTION	S8.6	DOUBLE CANTILEVER BOX TRUSS SIGN STRUCTURE - SECTIONS		
S5.6	SIGN STRUCTURE HIWB-505 - PEDESTAL SUPPORT SECTS. AND DET.				

DESIGNED BY	CHECKED BY
DRAWN BY	APPROVED BY
SCALE	DATE
SHEET NO.	TOTAL SHEETS

DRAWING NAME: 2-100 ENGINEERING PROJECTS (LE-006-DESTINATION SIGN) (CA-01-03-23) (REVISED) - SIGN INDEX - ADDITIONAL SHEETS - 01-03-23, 8:48 PM

1/3/23 △ Add. 1 - Revised Index

Scale: None Date: Sept. 2022

STATE OF HAWAII
DEPARTMENT OF TRANSPORTATION
HIGHWAYS DIVISION

INDEX OF STRUCTURAL DRAWINGS

INTERSTATE ROUTE H-1 AND H-201
DESTINATION SIGN UPGRADE/REPLACEMENT, PHASE 3
FAP NO. NH-0300(144)

SHEET No. *S11* OF 5 SHEETS



THIS WORK WAS PREPARED BY ME OR UNDER MY SUPERVISION

Nathan T. Miyamoto

DATE: 9-20-24

STRUCTURAL GENERAL NOTES

FED. ROAD DIST. NO.	STATE	FEDERAL AID PROJ. NO.	FISCAL YEAR	SHEET NO.	TOTAL SHEETS
HAWAII	HAW.	NH-0300(144)	2023	ADD. 106	175

1. Standard Specifications and Plans:

- A. Hawaii Department of Transportation (HDOT), Hawaii Standard Specifications for Road and Bridge Construction, 2005.
- B. HDOT Highways Division Design Branch - Standard Plans dated 2008.

2. Design Specifications:

- A. American Association of State Highway and Transportation Officials (AASHTO) 2020 "LRFD Bridge Design Specifications", 9th Edition as amended by HDOT document dated August 8, 2014 with subject title "Design Criteria for Bridges and Structures".
- B. AASHTO LRFD Specifications for Structural Supports for Highway Signs, Luminaires, and Traffic Signals, 1st Edition, including the 2017 Interim Revisions.
- C. HDOT document dated August 8th, 2014 with subject title "Design Criteria for Bridges and Structures" and HDOT memorandum dated January 8, 2018 with subject title "Changes to Design Criteria for Bridges and Structures".

3. General:

- A. Before preparation of shop drawings for the sign support frame structures, the Contractor shall verify in the field the exact location of each anchor bolt and the shelf elevation at the top of pier caps.

4. Wind Loads:

- A. Basic Wind Speed: 130 mph
- B. Recurrence Interval: 1700 years
- C. Fatigue Importance Factor shall be based on Fatigue Category I.
- D. Galloping and natural wind gusts have been considered for cantilevered sign structures.
- E. Natural wind gusts have been considered for all sign structures.
- F. Sign structures have been designed for a truck induced gust based on a truck speed of 20 mph over the posted speed.
- G. An additional 9 square foot sign that is centered 10-feet above finish grade is included in the design for all sign structures.
- H. Railing Test Level: TL-3

5. Steel:

A. All structural steel shall conform to the following requirements:

- 1. Plates, splice plates, cover plates, and base plates ASTM A709, fy =36 ksi
- 2. Angles ASTM A709, fy = 36 ksi
- 3. Wide Flanges ASTM A709, fy = 50 ksi
- 4. All others ASTM A709, fy = 36 ksi

B. All new steel structures shall be ASTM A123 hot-dip zinc galvanized after fabrication. Post-galvanizing quenching/passivation shall not be utilized if steel is going directly to paint. Coordinate with coating Contractor.

C. Vent holes shall be provided in members for hot-dip zinc galvanized operation. Size and location of holes shall be determined by galvanizing contractor, unless otherwise shown on the drawings.

Vent hole sizes and locations shall be included on the structural steel shop drawings. All holes shall be filled with zinc plugs following galvanizing operation.

D. All shop fabricated holes shall be full-size drilled or sub-punched and reamed.

E. Plates for columns, cover plates, base plates, angles, HSS tubes, and wide flange sections shall meet the longitudinal Charpy V-Notch requirements for a non-fracture critical member in Zone 1.

F. Steel plates for columns shall be cut and fabricated so that the primary direction of rolling is parallel to the column length. For splice plates, the direction shall be parallel to the direction of the splice.

G. Bolts which connect steel to steel shall be high-strength bolts conforming to ASTM F3125, Grade A325, Type 1. Bolts shall be snug tightened unless otherwise shown on plans. All pretensioned/slip-critical bolts shall utilize Direct Tension Indicating (DTI) washers. Bolts shall be inspected following installation.

H. Anchor bolts which connect steel to concrete shall be high-strength threaded rods conforming to ASTM F1554, Grade 105 and shall be straight rod with anchor plate details at the end as shown in the contract drawings. Anchor bolts shall be pretensioned by the turn of the nut method. See anchor bolt pretensioning schedule.

I. New and existing anchor bolts shall utilize a double nut connection with a leveling nut and top nut.

J. All nuts shall be ASTM A563 DH heavy-hex and all hardened washers shall be ASTM F436. DTI Washer shall be ASTM F959 and shall be installed under either the bolt head or a hardened washer.

K. Threaded couplers shall be ASTM A194 heavy-hex and capable of developing 125% of the full yield strength of the anchor bolts.

5. Steel (Cont.):

L. All hardware, including bolts, anchor bolts, nuts, washers, and couplers shall be ASTM A153 hot-dip zinc galvanized. Nut and coupler threads may be chased following the galvanizing process.

M. All welding shall conform to the latest ANSI/AASHTO/AWS D1.5 Bridge Welding Code. Welding shall be performed in accordance with a Welding Procedure Specification (WPS) and Procedure Qualification Record (PQR) as required in AWS D1.5 and approved by the Engineer. The WPS variables shall be within the parameters established by the filler-metal manufacturer.

N. All weld sizes are shown in inches.

O. All welds shall utilize E70XX Electrodes where Shielded Metal Arc Welding is utilized. Where other welding processes are used, filler metal shall have matching strength to base metal.

P. All welding shall be done in a manner to minimize distortion.


Q. Field welding shall not be permitted except at field splice locations as shown on the drawings.

R. Shop welds and field welds shall be identified in the shop drawings.

S. Fabricate sign structures with camber as specified on the plans. Two post sign structures shall have a smooth parabolic camber.

CHECKED BY: _____ DRAWN BY: _____ DATE: _____	REVIEWED BY: _____ DATE: _____
---	-----------------------------------

DRAWING NAME: Z:\03 ENGINEERING\PROJECTS\14-006-DESTINATION SIGN\01 CAD\01-03-23 INTERMEDIATE-SIGN GENERAL NOTES ADD.106 PLOT TIME: 01-03-23 8:42 PM

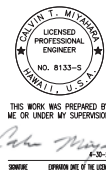

THIS WORK WAS PREPARED BY ME OR UNDER MY SUPERVISION
 P.E. 8133-G
 STATE OF HAWAII

STATE OF HAWAII
DEPARTMENT OF TRANSPORTATION
HIGHWAYS DIVISION

STRUCTURAL GENERAL NOTES

INTERSTATE ROUTE H-1 AND H-201
DESTINATION SIGN UPGRADE/REPLACEMENT, PHASE 3
FAP NO. NH-0300(144)

Scale: None Date: Sept. 2022

SHEET No. 512 OF 5 SHEETS

1/3/23		Add. 1 - Revised notes
DATE	REVISION	

STRUCTURAL GENERAL NOTES

FED. ROAD DIST. NO.	STATE	FEDERAL AID PROJ. NO.	FISCAL YEAR	SHEET NO.	TOTAL SHEETS
HAWAII	HAW.	NH-0300(144)	2023	ADD. 107	175

6. Concrete:

- A. All concrete, other than drilled shafts, shall have a minimum 28-day compressive strength $f'_c = 5000$ psi, maximum W/C ratio of 0.45, and a maximum cementitious material content of 615 (lbs/cyd) unless otherwise noted.
- B. An alkali-resistant glass macro fiber shall be added to the concrete mix. The fiber shall have an aspect ratio of 67 and a length of 1 1/2". The dosage shall be 13 lbs per cubic yard of concrete.
- C. A migrating corrosion inhibitor amine carboxylate water-based admixture shall be added to the concrete mix. The minimum dosage requirement shall be 24 ounces per cubic yard of concrete.

1 D. Drilled shaft concrete shall have a minimum cementitious material content of 720 (lbs/cyd). For drilled shaft concrete see Special Provisions Section 511.

1 E. All concrete must comply with the CO2 footprint reduction requirements of Special Provisions Section 601.

7. Steel Reinforcing:

- A. All reinforcing steel shall be ASTM A615 Grade 60 deformed bars unless otherwise noted.
- B. Reinforcing steel shall be ASTM A706 Type W where welded connections are required.
- C. The clear cover, measured from the surface of the concrete to the face of any reinforcing bars, shall be as follows, except as otherwise shown.

- 1). Concrete cast against and permanently exposed to earth = 3" unless otherwise noted
- 2). All others unless otherwise noted = 2"

- D. Reinforcing bars shall be detailed in accordance with the latest edition of the American Concrete Institute (ACI) Detailing Manual, unless otherwise noted.
- E. Reinforcing bars shall be placed and installed in accordance with the CRSI Manual of Standard Practice and CRSI Placing Reinforcing Bars, unless otherwise noted.
- F. Minimum clear spacing between parallel bars shall be 1 1/2 times the diameter of bars (for non-bundled bars). In no case shall the clear distance between edge of the bars be less than 1 1/2 times the maximum size of the coarse aggregate or 1 1/2", whichever is greater.
- G. All dimensions relating to reinforcing bars are to centers of bars unless otherwise noted.
- H. Reinforcing bars shall be securely tied at all intersections and lap splices except where the spacing of intersections is less than one foot in each directions, in which case alternate intersections shall be tied.

8. Construction Notes:

- A. The Contractor shall verify all dimensions and site conditions and shall report any discrepancies in writing to the Engineer before commencing work or ordering materials.
- B. The Contractor shall verify all site conditions and not rely upon these plans for existing dimensions, elevations and azimuths. Roadway location, gutters, curbs and sidewalks, etc., conditions may differ from those shown.
- C. The Contractor shall be solely responsible for the protection of adjacent properties, utilities and existing and new structures from damage due to construction. Repairing any damage shall be at the Contractor's own expense, to the satisfaction of the Engineer.
- D. The Contractor shall verify the location of all utility lines and notify the respective owners before commencing with excavation, and any temporary piling or sheeting.
- E. Except as otherwise noted, all vertical dimensions are measured plumb.
- F. For concrete finish see Standard Specifications.
- G. Construction joints may be relocated or additional ones added subject to the acceptance of the Engineer.
- H. Unless otherwise noted, all exposed concrete edges shall be chamfered 3/4" x 3/4".

1 I. Prior to performing any drilling or coring operations into existing reinforced concrete, the Contractor shall verify the location of all existing reinforcing steel using an appropriate ground penetrating radar rebar scanner. Inform the Engineer of any conflicts, for review, if the planned drilled/cored hole cannot be moved.

- J. Epoxy anchoring material shall be an injectable, two-component adhesive that has a current Evaluation Service Report from ICC-ES (International Code Council Evaluation Service Inc.) and has a characteristic bond strength, τ_{kicker} , of at least 1,600 psi for a #5 reinforcing bar at Temperature Range A.
- K. Epoxy anchoring adhesive shall be injected into drilled hole using a piston-plug delivery system when installed overhead.
- L. All individuals performing drilled reinforcing dowel work shall hold a current ACI/CRSI Adhesive Anchor Installer certification.
- M. Drilling procedures, equipment, material and certifications shall be submitted to the Engineer for approval.
- N. In no case shall any adhesive anchor be installed closer than 6-inches to any concrete edge or joint unless shown on plans.
- O. All holes drilled into concrete that go unused shall be completely filled with a fast setting, two-component, polymer-modified, non-sag, cementitious patching and repair mortar containing a migratory corrosion inhibitor.

8. Construction Notes (Cont.):

P. All drilled holes shall have dowels installed within same work shift or shall otherwise be completely filled with a patching and repair mortar.

1 Q. Contractor shall follow all epoxy anchoring adhesive Manufacturer's Printed Installation Instructions (MPII).

R. Location of drilled holes in existing concrete for reinforcing steel dowels as shown on the plans are approximate. Prior to placing holes in concrete, the Contractor shall locate all reinforcing steel, anchor bolts, thru bolts holes, etc. and adjust the location of the drilled holes to clear all of them. Final hole locations are subject to the acceptance of the Engineer.

S. Epoxy shall fully cure prior to pouring concrete around reinforcing steel dowels.

T. All holes shall be hammer drilled using a hollow bit connected to a vacuum system in accordance with a current Evaluation Service Report from ICC-ES.

U. All demolition work of concrete, unless otherwise explicitly stated, shall be performed using no larger than a 30-lb demolition hammer.

V. When only portions of concrete are to be demolished the intersections between the demolished concrete and the concrete that are to remain shall have a 1/2-inch deep sawcut around the entire perimeter of the demolished area.

1 W. All existing concrete substrate surfaces which new concrete is poured against shall be roughened to a minimum 1/4" amplitude and Saturated Surface Dry (SSD) prior to the placement of new concrete.



THIS WORK WAS PREPARED BY ME OR UNDER MY SUPERVISION
Nathan T. Milward
 P.E. 8-28-24
 SIGNATURE EXPIRES DATE OF THE SEALS

STATE OF HAWAII
DEPARTMENT OF TRANSPORTATION
HIGHWAYS DIVISION

STRUCTURAL GENERAL NOTES

INTERSTATE ROUTE H-1 AND H-201
DESTINATION SIGN UPGRADE/REPLACEMENT, PHASE 3
FAP NO. NH-0300(144)

Scale: None Date: Sept. 2022

SHEET No. 51.3 OF 5 SHEETS

1/3/23	1 Add. 1 - Revised notes
DATE	REVISION

DESIGNED BY	CHECKED BY	DATE	
DRAWN BY	SCALE		
DATE			
PROJECT NO.			
DATE			
PROJECT NAME			

DRAWING NAME: Z:\03_ENGINEERING\PROJECTS\14-006_DESTINATION_SIGN\01-03-23_INTERSECTION_SIGN_GENERAL NOTES ADD.107.PLT PLOT TIME: 01-03-23, 8:46 PM

FED. ROAD DIST. NO.	STATE	FEDERAL AID PROJ. NO.	FISCAL YEAR	SHEET NO.	TOTAL SHEETS
HAWAII	HAW.	NH-0300(144)	2023	ADD. 108	175

8. Construction Notes (Cont.):

- X. All existing reinforcing shall remain in place unless otherwise noted. Any existing reinforcing damaged during concrete removal that was not permitted to be removed shall be repaired, with approval from the Engineer, at no cost to the State.
- Y. Existing reinforcing that is to be partially removed shall be cut back to provide 2" clear from finish concrete surface.
- Z. New concrete surfaces shall match the finish of the existing structure. Any reveals, patterns, or decorative features shall also match the existing structure, unless otherwise noted.

- \triangle AA. Aluminum members, stainless steel and other dissimilar metals in contact with structural steel shall be isolated with an appropriate dielectric material as approved by the Engineer.
- AB. Anchor bolts shall be installed using a template to ensure proper layout. Anchor bolts shall be installed with misalignments of less than 1:40 from vertical. After installation, firm contact shall exist between the anchor bolt nuts, washers, and base plate on any anchor bolt installed in a misaligned position.
- AC. New roadway signs shall be installed before existing signs are removed. Existing roadway signs shall be removed immediately after new signs are installed.
- AD. Existing pavement, concrete, riprap, etc. shall be restored to its original condition after completion of work.
- AE. All attachments on the sign structures shall be considered as part of the sign structure and its removal will not be paid for separately.
- AF. Existing sign structures HIEBR-253, 78EBR-830, and HWB-511 are believed to contain lead-based paint in excess of 5000 PPM as defined by the U.S. Environmental Protection Agency (EPA). See Special Provisions Section 695 for removal and disposal requirements.
- AG. Existing sign structures HIEB-305 and HWB-505 are believed to contain lead-containing paint below the 5000 PPM concentration threshold.
- AH. The Contractor is responsible for conducting work in accordance with 29 CFR 1926.62 OSHA Lead Construction Standard including an air monitoring assessment during lead paint disturbance if necessary.
- AI. The Contractor is responsible for conducting their own independent paint chip sampling of the existing sign structures to identify the presence, extent, and condition of existing paint suspected of containing lead.

- \triangle AJ. The Contractor shall perform a thorough survey of all sign structure locations to verify elevations of existing roadway, bridge decks, bent caps, corbels, barriers, pedestals, etc. and to verify sign structure lengths. This survey shall be performed prior to submittal of structural steel shop drawings.

9. Paint:

- \triangle A. New sign structures shall be hot-dip zinc galvanized prior to being painted with an epoxy intermediate and a highly weatherable Fluoropolymer top coat.
- B. Sign structures shall be painted at an offsite location by an \triangle approved SSPC-QP-3 certified shop approved by the Engineer. Only touch up painting shall be allowed at the construction site.
- C. Finish color shall be Dark Green. \triangle
- D. See Special Provisions Section 675 and 697 for further coating requirements including surface preparation and stripecoating.

DESIGNED BY	DATE
CHECKED BY	
APPROVED BY	
SCALE	
NO.	

DRAWING NAME: 2-102 ENGINEERING PROJECTS (E-306-DESTINATION SIGNAGE) CAD/01-03-23 (01/03/23) 01-03-23, 8:46 PM

1/3/23	\triangle Add. 1 - Revised notes
DATE	REVISION



THIS WORK WAS PREPARED BY ME OR UNDER MY SUPERVISION
Nathan T. Milward
 LICENSED PROFESSIONAL ENGINEER
 NO. 8133-G
 HAWAII, U.S.A.

STATE OF HAWAII
 DEPARTMENT OF TRANSPORTATION
 HIGHWAYS DIVISION


STRUCTURAL GENERAL NOTES

INTERSTATE ROUTE H-1 AND H-201
 DESTINATION SIGN UPGRADE/REPLACEMENT, PHASE 3
 FAP NO. NH-0300(144)

Scale: None Date: Sept. 2022

SHEET No. 114 OF 5 SHEETS

FED. ROAD DIST. NO.	STATE	FEDERAL AID PROJ. NO.	FISCAL YEAR	SHEET NO.	TOTAL SHEETS
HAWAII	HAW.	NH-0300(144)	2023	ADD. 110	175

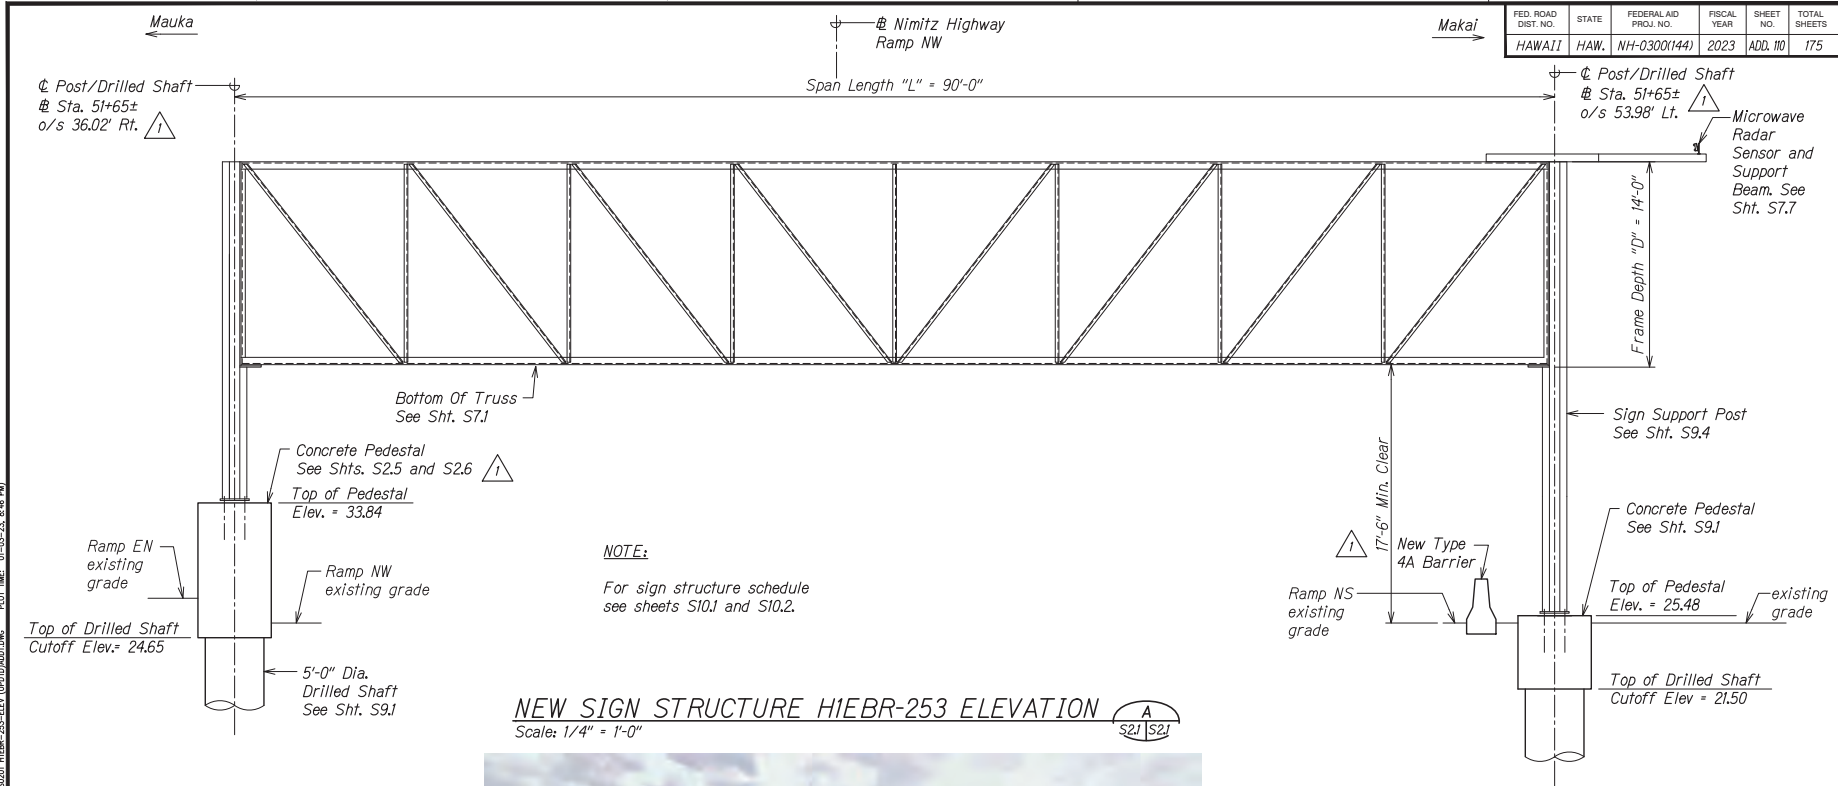

NEW SIGN STRUCTURE HIEBR-253 ELEVATION
 Scale: 1/4" = 1'-0" A
S21 S22



EXISTING SIGN STRUCTURE HIEBR-253

DESIGNED BY	DATE
DRAWN BY	
CHECKED BY	
APPROVED BY	
SCALE	

DRAWING NAME: 2.102 ENGINEERING PROJECTS (C-306) DESTINATION SIGNAGE CAD/01-03-23 001/01/01-2020 HIEBR-253-ELEV (UPDATES)ADD.DWG PLOT TIME: 01-03-23, 8:46 PM


1/3/23	△ Add. 1 - Revised callouts
DATE	REVISION

STATE OF HAWAII
 DEPARTMENT OF TRANSPORTATION
 HIGHWAYS DIVISION





**SIGN STRUCTURE
 HIEBR-253 ELEVATION**

INTERSTATE ROUTE H-1 AND H-201
 DESTINATION SIGN UPGRADE/REPLACEMENT, PHASE 3
 FAP NO. NH-0300(144)

Scale: As Noted Date: Sept. 2022
 SHEET No. S21 OF 9 SHEETS

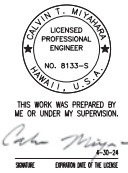

FED. ROAD DIST. NO.	STATE	FEDERAL AID PROJ. NO.	FISCAL YEAR	SHEET NO.	TOTAL SHEETS
HAWAII	HAW.	NH-0300(144)	2023	ADD. III	175

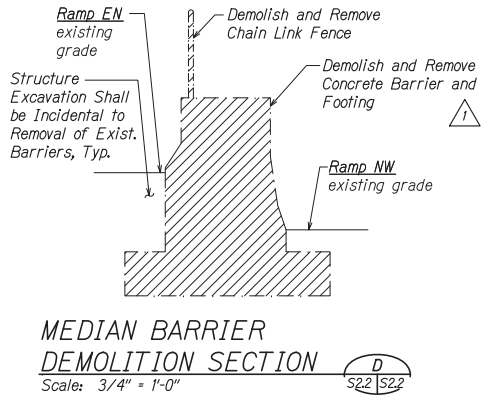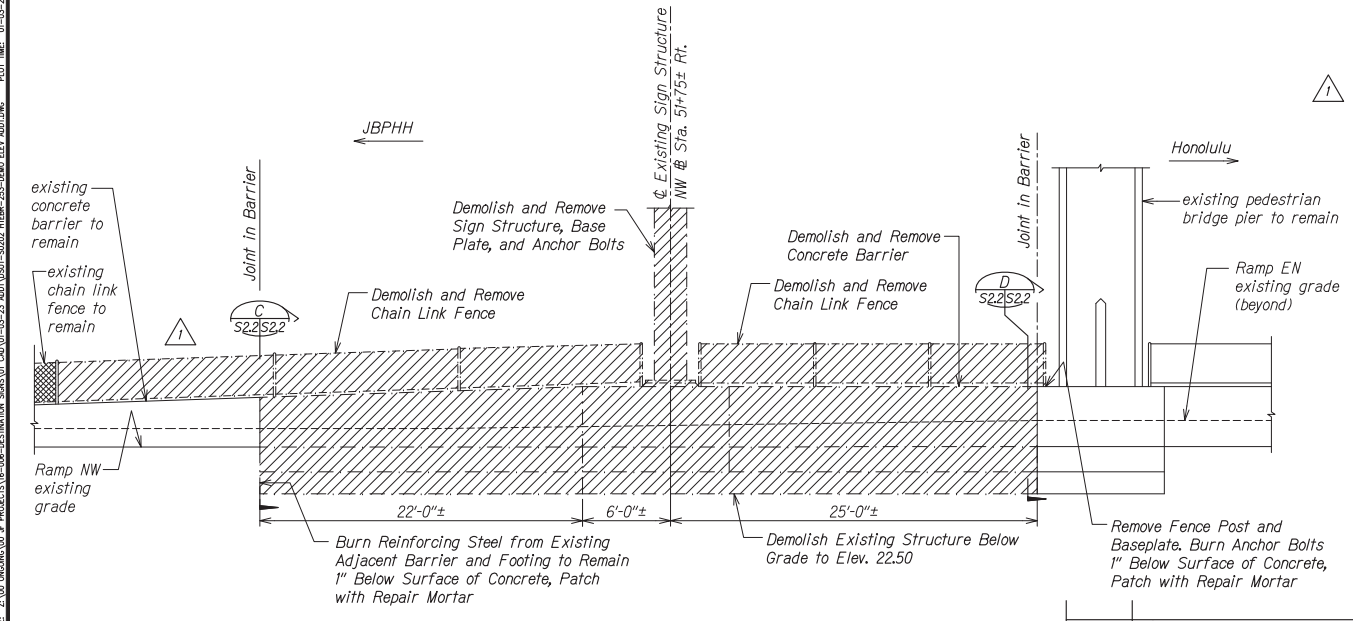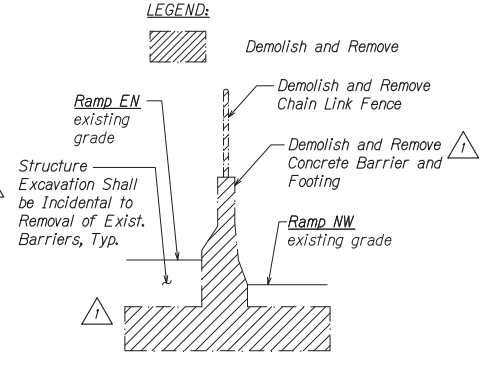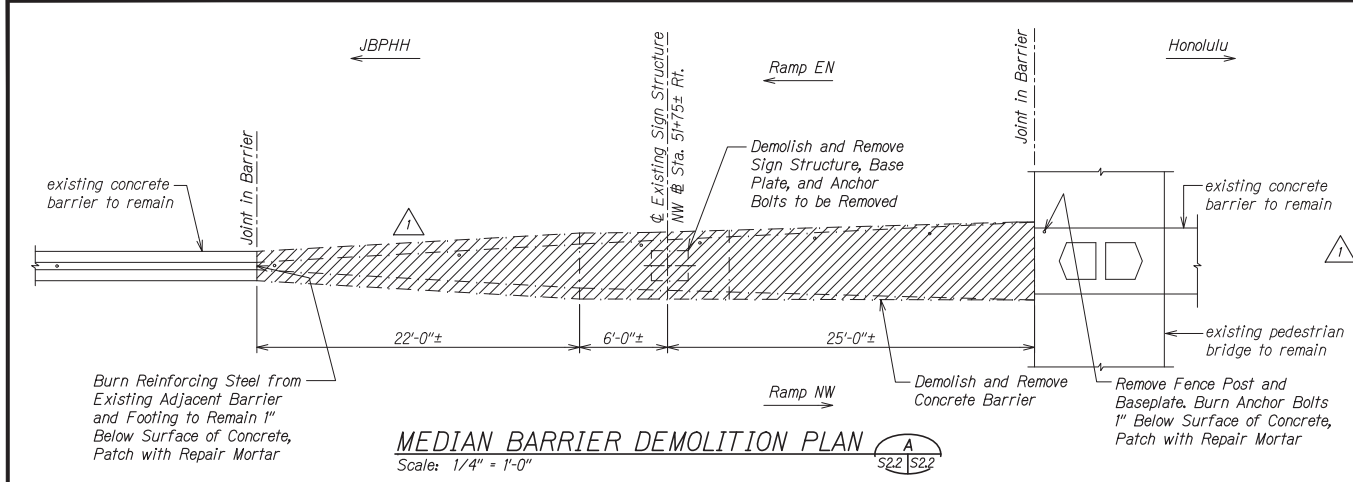

DESIGNED BY	DATE
DRAWN BY	DATE
CHECKED BY	DATE
APPROVED BY	DATE

DRAWING NAME: 2.300 ENGINEERING OF PROJECTS (U.S. DESTINATION SIGN) (ADD. III) - 03-23 DESTINATION SIGN - HIEBR-253-DEMO PLAN, ELEV. AND SECTS. PLOT TIME: 01-03-23 8:47 AM

DATE	REVISION
1/3/23	△ Add. 1 - Revised details

STATE OF HAWAII
DEPARTMENT OF TRANSPORTATION
HIGHWAYS DIVISION


**SIGN STRUCTURE - HIEBR-253
BARRIER DEMO. PLAN, ELEV. AND SECTS.**

INTERSTATE ROUTE H-1 AND H-201
DESTINATION SIGN UPGRADE/REPLACEMENT, PHASE 3
FAP NO. NH-0300(144)

Scale: As Noted Date: Sept. 2022


SHEET No. S2.2 OF 9 SHEETS

FED. ROAD DIST. NO.	STATE	FEDERAL AID PROJ. NO.	FISCAL YEAR	SHEET NO.	TOTAL SHEETS
HAWAII	HAW.	NH-0300(144)	2023	ADD. 112	175

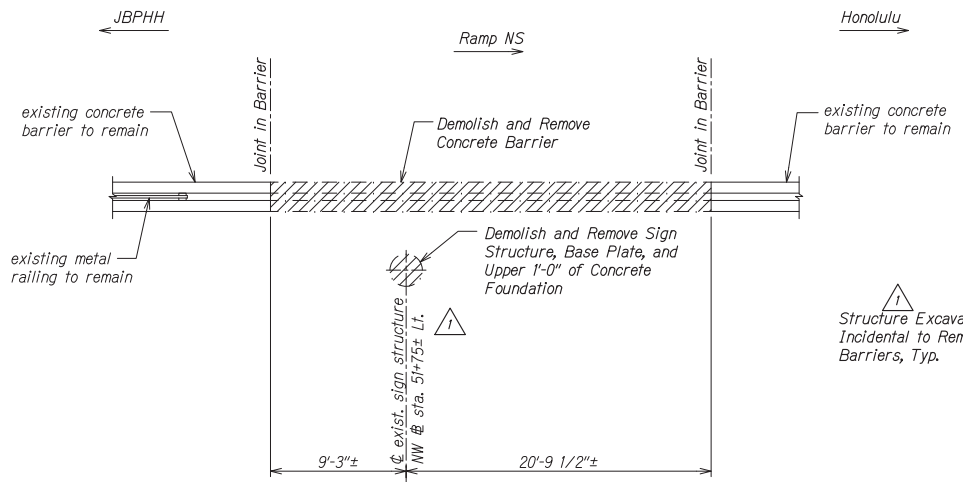


BARRIER DEMOLITION PLAN (A)
Scale: 1/4" = 1'-0"


LEGEND:

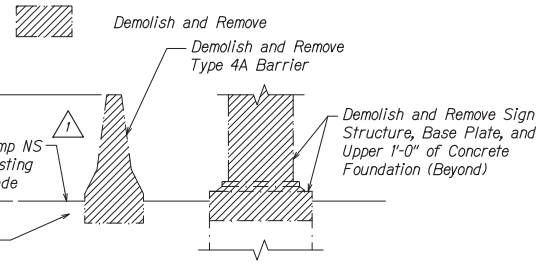


BARRIER DEMOLITION SECTION C
Scale: 1/2" = 1'-0"

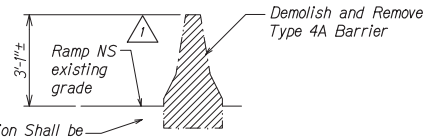

BARRIER DEMOLITION SECTION D
Scale: 1/2" = 1'-0"

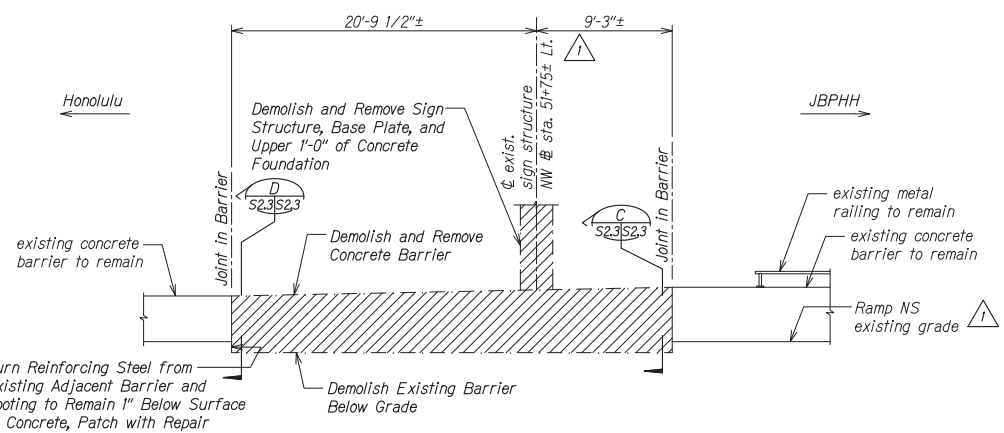


BARRIER DEMOLITION ELEVATION (B)
Scale: 1/4" = 1'-0"

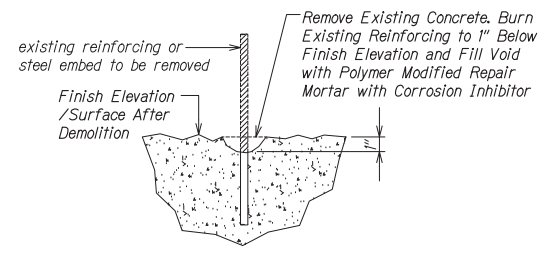

REINFORCING REMOVAL DETAIL (A)
Scale: 3" = 1'-0"

DESIGNED BY	SAFETY CHECKED BY
DRAWN BY	REVIEWED BY
IN CHARGE BY	APPROVED BY
DATE	

DRAWING NAME: 2303 ENHANCED DESTINATION SIGNAGE (ADD. 112) - DESTINATION SIGNAGE - HIEBR-253-BARR. DEMO. ADDITIONAL SHEETS - 01-02-23, 8.07 PM

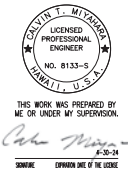

STATE OF HAWAII
DEPARTMENT OF TRANSPORTATION
HIGHWAYS DIVISION

SIGN STRUCTURE HIEBR-253
BARRIER DEMO. PLAN, ELEV. AND SECTS.


INTERSTATE ROUTE H-1 AND H-201
DESTINATION SIGN UPGRADE/REPLACE, PHASE 3
FAP NO. NH-0300(144)

Scale: As Noted Date: Sept. 2022


SHEET No. S2.3 OF 9 SHEETS

DATE	REVISION
1/3/23	1 Add. 1 - Revised callouts


FED. ROAD DIST. NO.	STATE	FEDERAL AID PROJ. NO.	FISCAL YEAR	SHEET NO.	TOTAL SHEETS
HAWAII	HAW.	NH-0300(144)	2023	ADD. 113	175

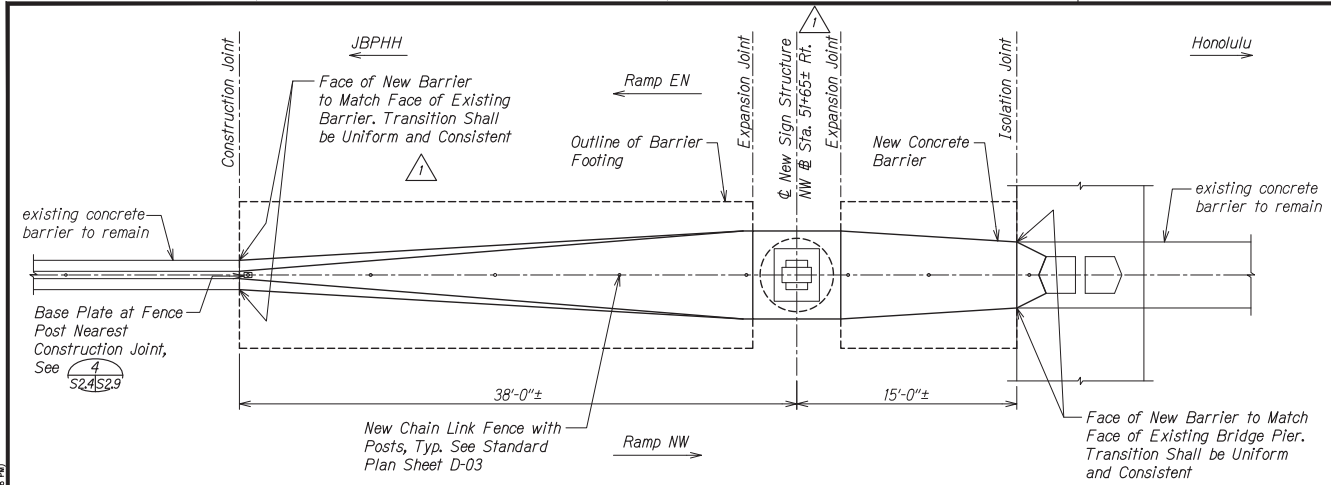


MEDIAN BARRIER PLAN
Scale: 1/4" = 1'-0"
A
S24 S24

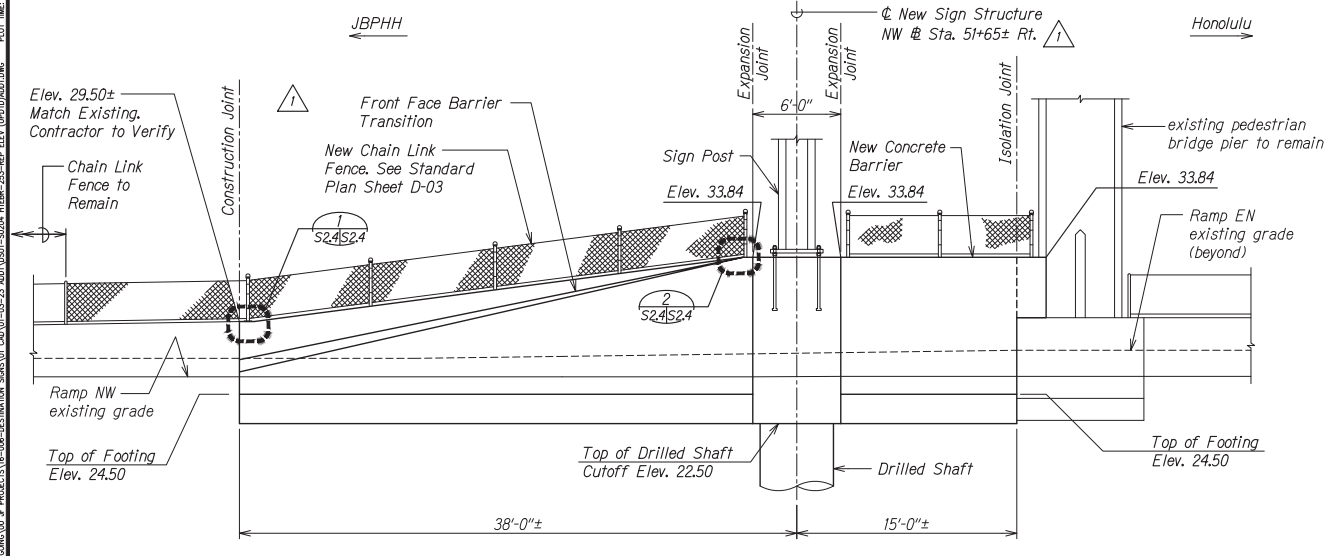

MEDIAN BARRIER ELEVATION
Scale: 1/4" = 1'-0"
B
S24 S24

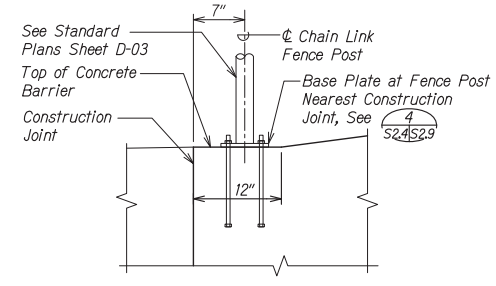


DETAIL 1
Scale: 1 1/2" = 1'-0"
S24 S24

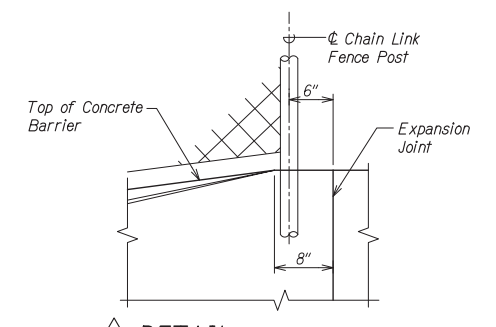

DETAIL 2
Scale: 1 1/2" = 1'-0"
S24 S24

DESIGNED BY	DATE
DRAWN BY	
CHECKED BY	
APPROVED BY	
SCALE	
NO.	

DRAWING NAME: 2.102 ENGINEERING PROJECTS (C-000-DESTINATION SIGNAGE) CAD/01-03-23 2023 HIEBR-253-SEP ELEV. (REPRODUCTION) PLOT TIME: 01-03-23 4:48 PM

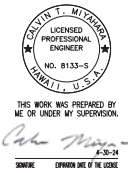

STATE OF HAWAII
DEPARTMENT OF TRANSPORTATION
HIGHWAYS DIVISION

**SIGN STRUCTURE HIEBR-253
BARRIER PLAN AND ELEVATION**


INTERSTATE ROUTE H-1 AND H-201
DESTINATION SIGN UPGRADE/REPLACEMENT, PHASE 3
FAP NO. NH-0300(144)

Scale: As Noted Date: Sept. 2022

SHEET No. S24 OF 9 SHEETS

DATE	REVISION
1/3/23	1 Add. 1 - Added details


FED. ROAD DIST. NO.	STATE	FEDERAL AID PROJ. NO.	FISCAL YEAR	SHEET NO.	TOTAL SHEETS
HAWAII	HAW.	NH-0300(144)	2023	ADD. 114	175

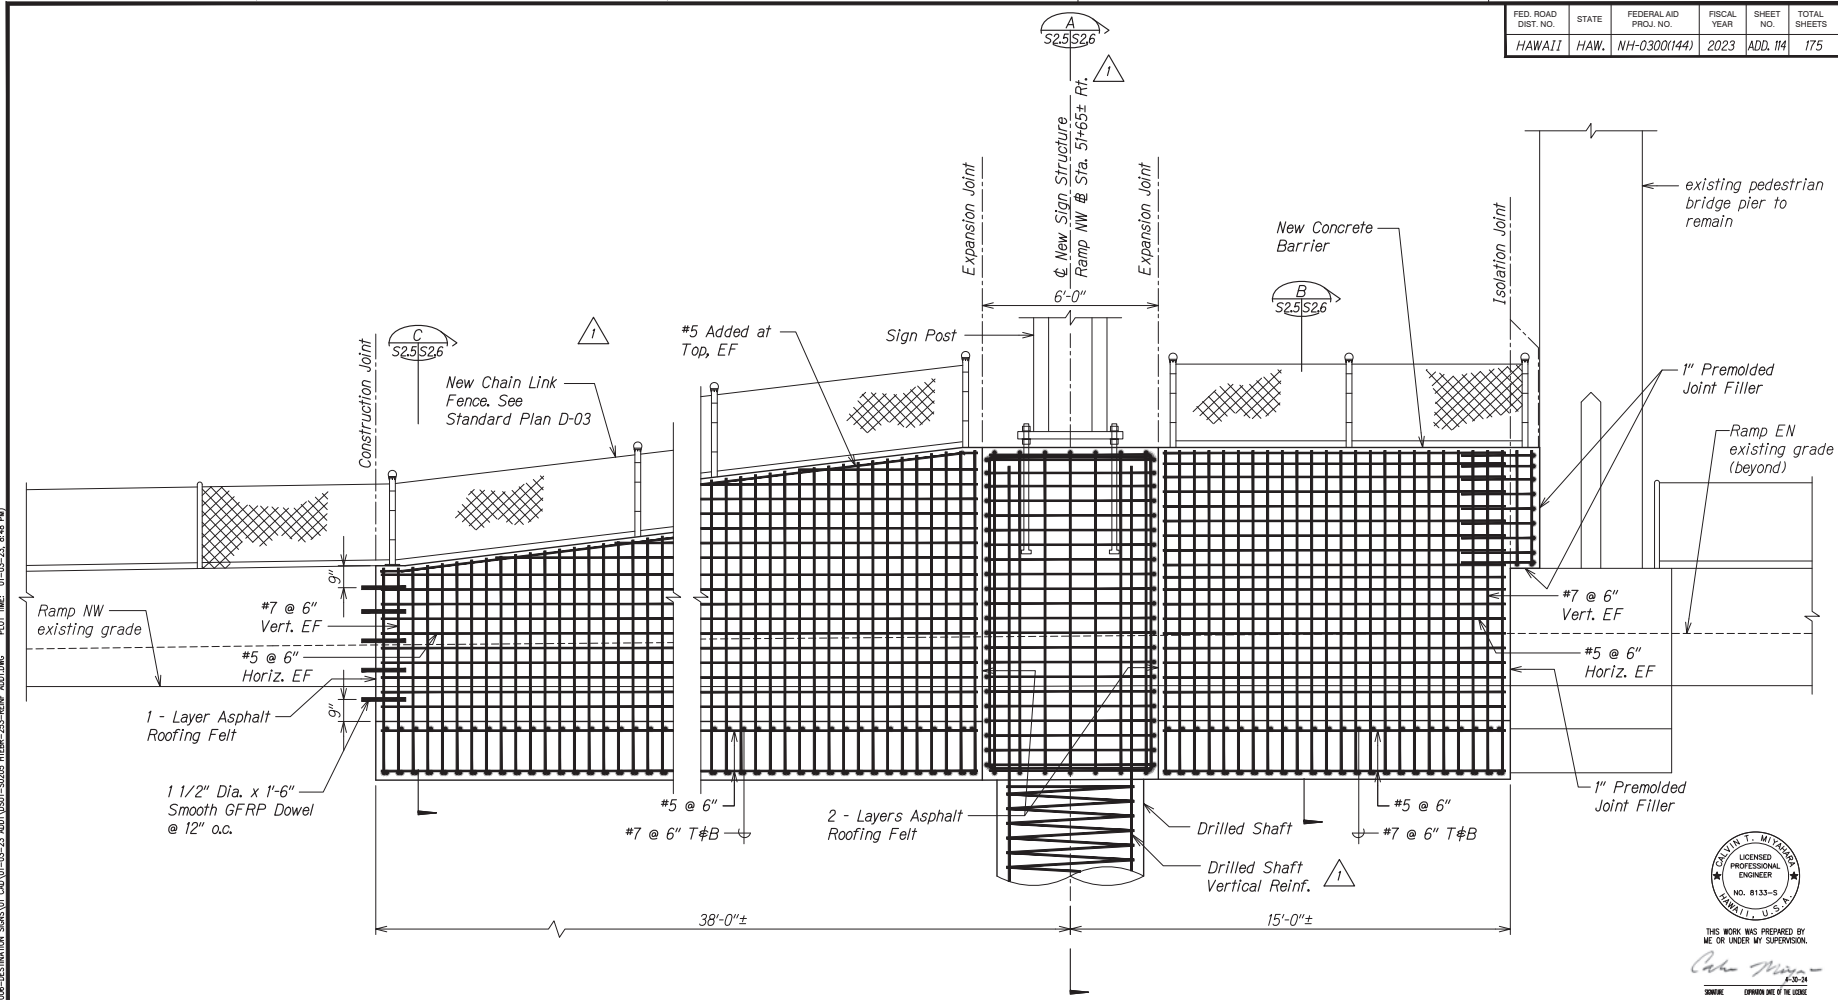

DRAWING NAME: 2.102 ENGINEERING PROJECTS (C-30P-DESTINATION SIGN) (C-30-23) (HAWAII) (HIEBR-253-REVF) (ADD) (FAC) (TIME: 01-03-23, 8:48 PM)

DESIGNED BY	DATE
DRAWN BY	
CHECKED BY	
APPROVED BY	
SCALE	
NO.	

BARRIER REINFORCING ELEVATION A
 Scale: 1/2" = 1'-0" S25 S25

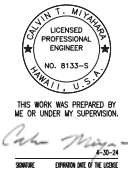

THIS WORK WAS PREPARED BY ME OR UNDER MY SUPERVISION
Kevin Milward
 ENGINEER

DATE	REVISION
1/3/23	△ Add. 1 - Revised details


STATE OF HAWAII
 DEPARTMENT OF TRANSPORTATION
 HIGHWAYS DIVISION

SIGN STRUCTURE HIEBR-253
BARRIER REINFORCING ELEVATION


INTERSTATE ROUTE H-1 AND H-201
 DESTINATION SIGN UPGRADE/REPLACEMENT, PHASE 3
 FAP NO. NH-0300(144)

Scale: As Noted Date: Sept. 2022
 SHEET No. S25 OF 9 SHEETS


FED. ROAD DIST. NO.	STATE	FEDERAL AID PROJ. NO.	FISCAL YEAR	SHEET NO.	TOTAL SHEETS

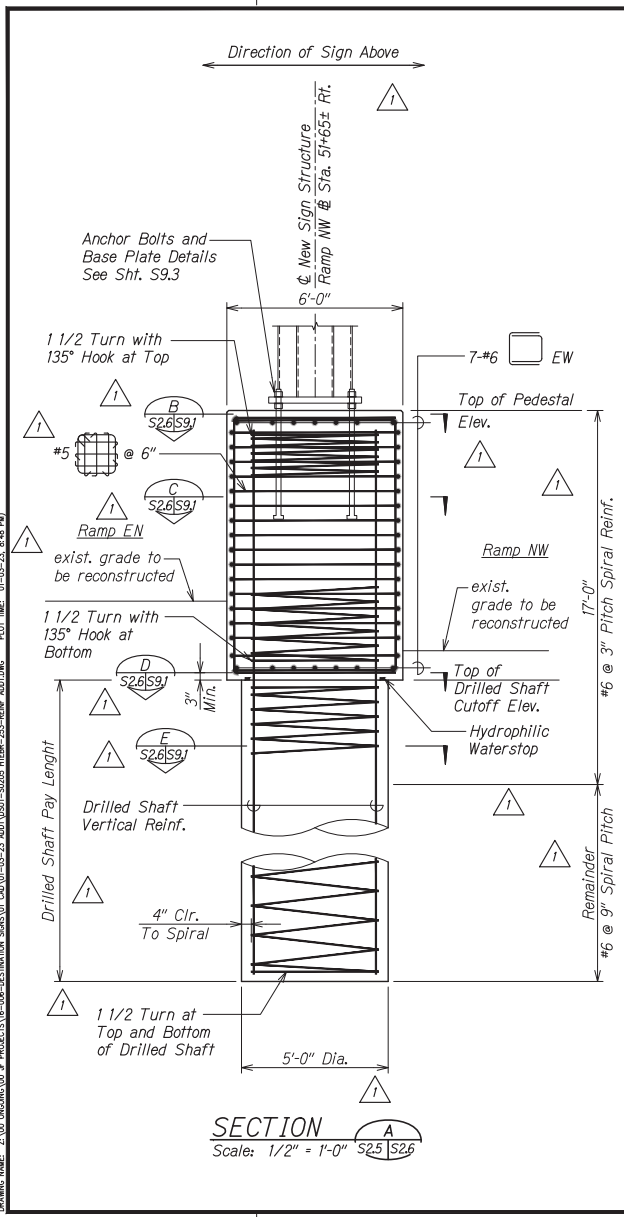

SECTION A
Scale: 1/2" = 1'-0" S2.5 S2.6

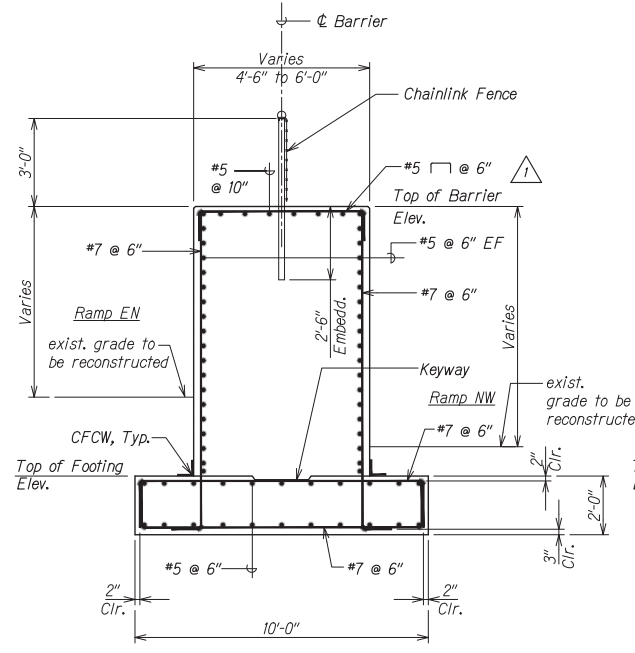

SECTION B
Scale: 1/2" = 1'-0" S2.5 S2.6

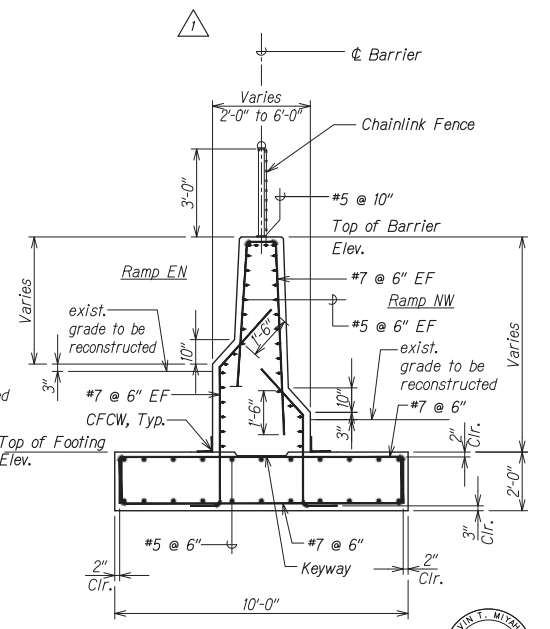


SECTION C
Scale: 1/2" = 1'-0" S2.5 S2.6

Note:
Structure backfill work adjacent to barriers shall be incidental to barrier work.

DESIGNED BY	DATE
CHECKED BY	DATE
APPROVED BY	DATE
SCALE	
PROJECT NO.	
SHEET NO.	
TOTAL SHEETS	

DRAWING NAME: 2:100 ENGINEERING PROJECTS (U.S. DEPARTMENT OF TRANSPORTATION) DESTINATION SIGN UPGRADE/REPLACEMENT, PHASE 3 FAP NO. NH-0300(144) SHEET NO. 115 OF 175 DATE: 01-30-23, 8:48 PM

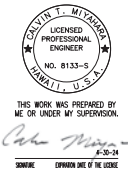

STATE OF HAWAII
DEPARTMENT OF TRANSPORTATION
HIGHWAYS DIVISION

SIGN STRUCTURE HIEBR-253
SECTIONS


INTERSTATE ROUTE H-1 AND H-201
DESTINATION SIGN UPGRADE/REPLACEMENT, PHASE 3
FAP NO. NH-0300(144)

Scale: As Noted Date: Sept. 2022


SHEET No. S2.6 OF 9 SHEETS

DATE	REVISION
1/3/23	1 Add. 1 - Revised details


FED. ROAD DIST. NO.	STATE	FEDERAL AID PROJ. NO.	FISCAL YEAR	SHEET NO.	TOTAL SHEETS
HAWAII	HAW.	NH-0300(144)	2023	ADD. 116	175

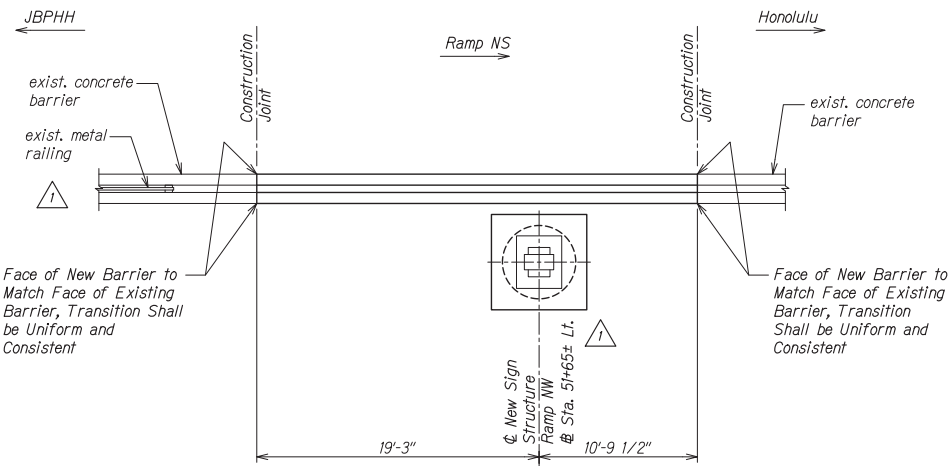


BARRIER PLAN
Scale: 1/4" = 1'-0"
A S27 S27

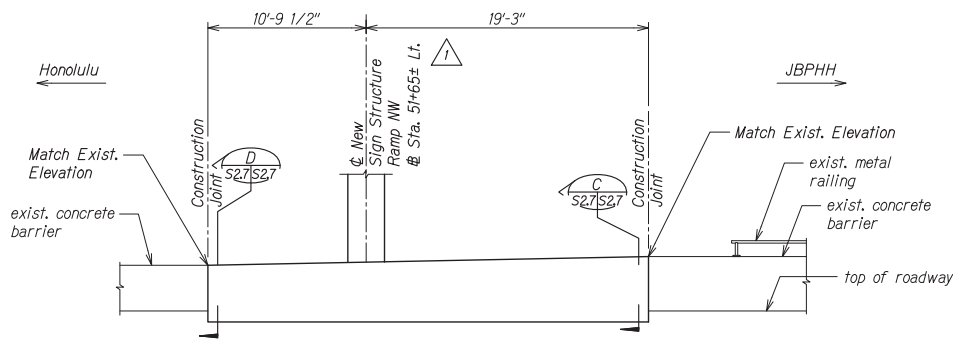

BARRIER ELEVATION
Scale: 1/4" = 1'-0"
B S27 S27

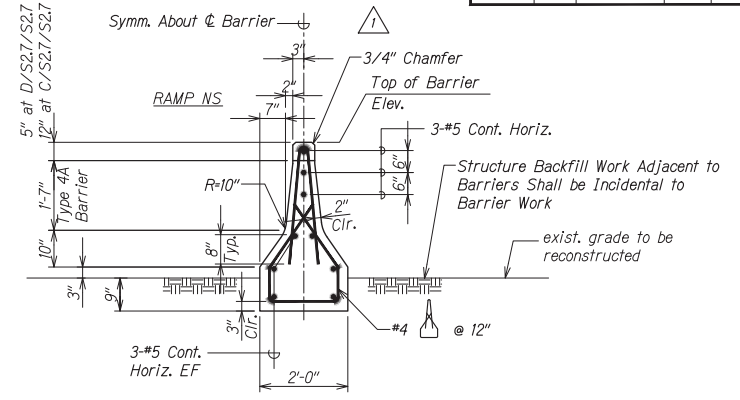

BARRIER SECTION
Scale: 3/4" = 1'-0"
C S27 S27 D S27 S27

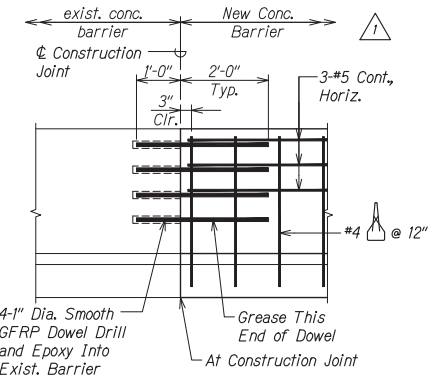

CONSTRUCTION JOINT DETAIL
Scale: 3/4" = 1'-0"
I S27 S27

DESIGNED BY	DATE
CHECKED BY	DATE
APPROVED BY	DATE
SCALE	
PROJECT NO.	
DATE	

DRAWING NAME: 2-102 ENGINEERING PROJECTS (C-306-DESTINATION SIGN) (C-307-03-23) (HONOLULU) - S2023 HIEBR-253-BARR RAILING - PLAN TIME: 01-03-23, 4:48 PM

1/3/23	△ Add. 1 - Revised details
DATE	REVISION

STATE OF HAWAII
DEPARTMENT OF TRANSPORTATION
HIGHWAYS DIVISION

SIGNATURE
LICENSED PROFESSIONAL ENGINEER
NO. 8133-S
HAWAII, U.S.A.

THIS WORK WAS PREPARED BY ME OR UNDER MY SUPERVISION.
Colin Wilson
A-30-24
SIGNATURE EXPIRATION DATE OF THE LICENSE

STATE OF HAWAII
DEPARTMENT OF TRANSPORTATION
HIGHWAYS DIVISION


**SIGN STRUCTURE HIEBR-253
BARRIER PLAN, ELEV., AND SECTS.**

INTERSTATE ROUTE H-1 AND H-201
DESTINATION SIGN UPGRADE/REPLACEMENT, PHASE 3
FAP NO. NH-0300(144)


Scale: As Noted Date: Sept. 2022

SHEET No. S27 OF 9 SHEETS


FED. ROAD DIST. NO.	STATE	FEDERAL AID PROJ. NO.	FISCAL YEAR	SHEET NO.	TOTAL SHEETS
HAWAII	HAW.	NH-0300(144)	2023	ADD. 117	175

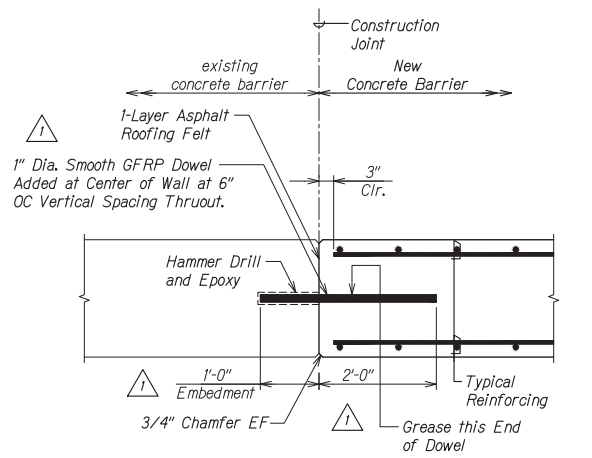


CONSTRUCTION JOINT DETAIL 1
Scale: 1" = 1'-0"

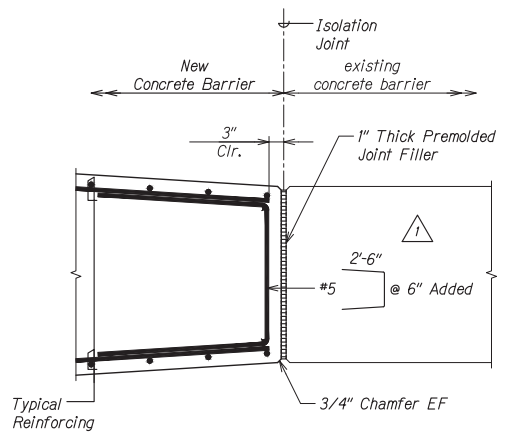

ISOLATION JOINT DETAIL IN MEDIAN BARRIER 3
Scale: 1" = 1'-0"

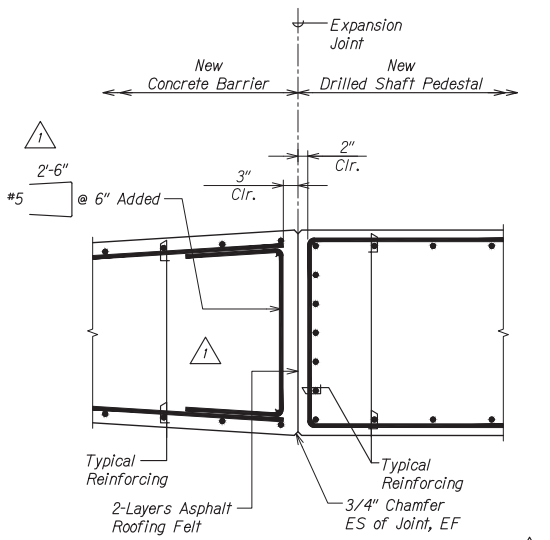

EXPANSION JOINT DETAIL 2
Scale: 1" = 1'-0"

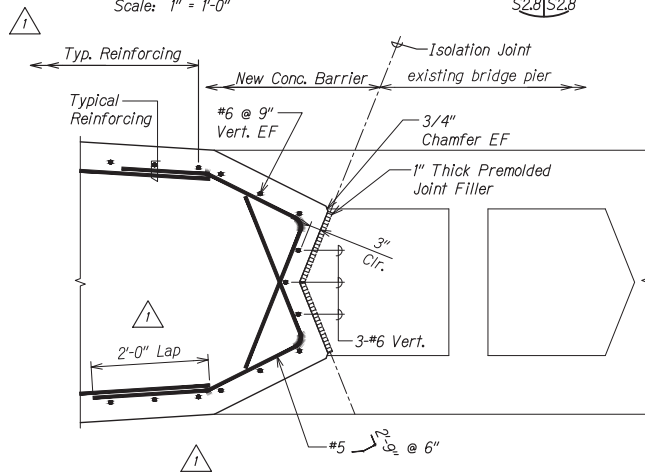


ISOLATION JOINT DETAIL IN MEDIAN BARRIER 4
Scale: 1" = 1'-0"

DESIGNED BY	DATE
CHECKED BY	DATE
APPROVED BY	DATE
SCALE	

DRAWING NAME: 2-100 ENGINEERING OF PROJECTS (E-300-DESTINATION SIGN) CAD (01-03-23) INDIVIDUAL-30208 TYP DLS ADD (P)M PLOT TIME: 01-03-23, 8:48 PM

1/3/23	△ Add. 1 - Revised details
DATE	REVISION

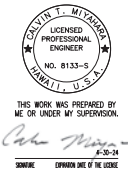

STATE OF HAWAII
DEPARTMENT OF TRANSPORTATION
HIGHWAYS DIVISION


**SIGN STRUCTURE HIEBR-253
BARRIER JOINTING DETAILS**

INTERSTATE ROUTE H-1 AND H-201
DESTINATION SIGN UPGRADE/REPLACEMENT, PHASE 3
FAP NO. NH-0300(144)


Scale: As Noted Date: Sept. 2022

SHEET No. S2.8 OF 9 SHEETS


FED. ROAD DIST. NO.	STATE	FEDERAL AID PROJ. NO.	FISCAL YEAR	SHEET NO.	TOTAL SHEETS
HAWAII	HAW.	NH-0300(144)	2023	ADD. 118	175

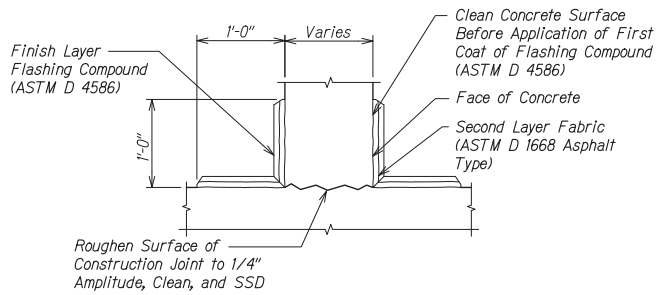


CFCW DETAIL 1
Scale: 1 1/2" = 1'-0" S29 S29

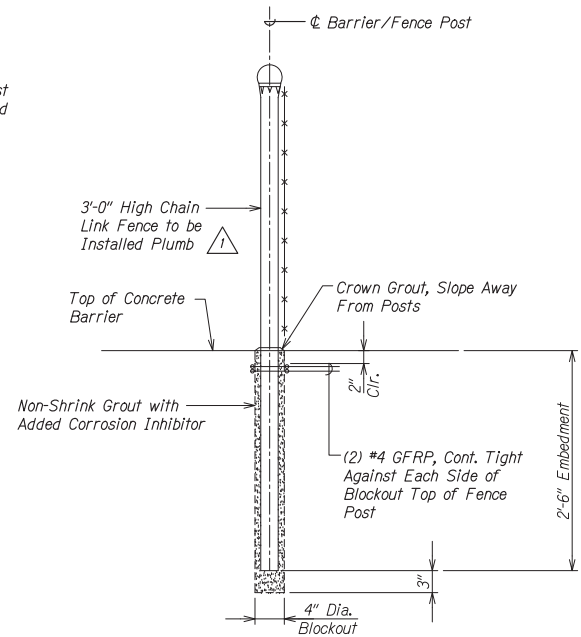

FENCE POST DETAIL 2
Scale: 1 1/2" = 1'-0" S29 S29

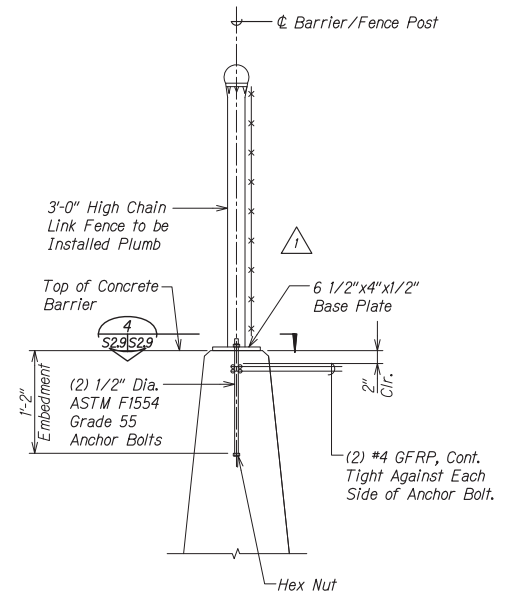


FENCE POST DETAIL 3
Scale: 1 1/2" = 1'-0" S29 S29

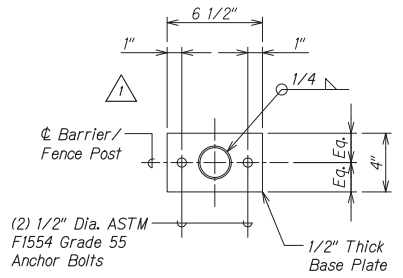

BASE PLATE DETAIL 4
Scale: 3" = 1'-0" S29 S29

NOTE:
Base plate shall be welded to fence post prior to hot-dip zinc galvanizing per ASTM A123.

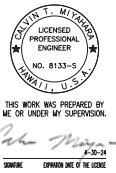

DESIGNED BY	DATE
CHECKED BY	
APPROVED BY	
SCALE	
PROJECT NO.	
DATE	
BY	
DATE	
BY	
DATE	

DRAWING NAME: 2.102 ENGINEERING PROJECTS (C-306-DESTINATION SIGN) (C-307-03-23) (HAWAII)-S29S29-TYP DTL5 ADD LINE PLOT TIME: 01-03-23, 8:46 PM

DATE	REVISION
1/3/23	1 Add. 1 - Added details

STATE OF HAWAII
DEPARTMENT OF TRANSPORTATION
HIGHWAYS DIVISION


SIGN STRUCTURE HIEBR-2S3
TYPICAL DETAILS

INTERSTATE ROUTE H-1 AND H-201
DESTINATION SIGN UPGRADE/REPLACEMENT, PHASE 3
FAP NO. NH-0300(144)

Scale: As Noted Date: Sept. 2022

SHEET No. S29 OF 9 SHEETS

FED. ROAD DIST. NO.	STATE	FEDERAL AID PROJ. NO.	FISCAL YEAR	SHEET NO.	TOTAL SHEETS
HAWAII	HAW.	NH-0300(144)	2023	ADD. 119	175

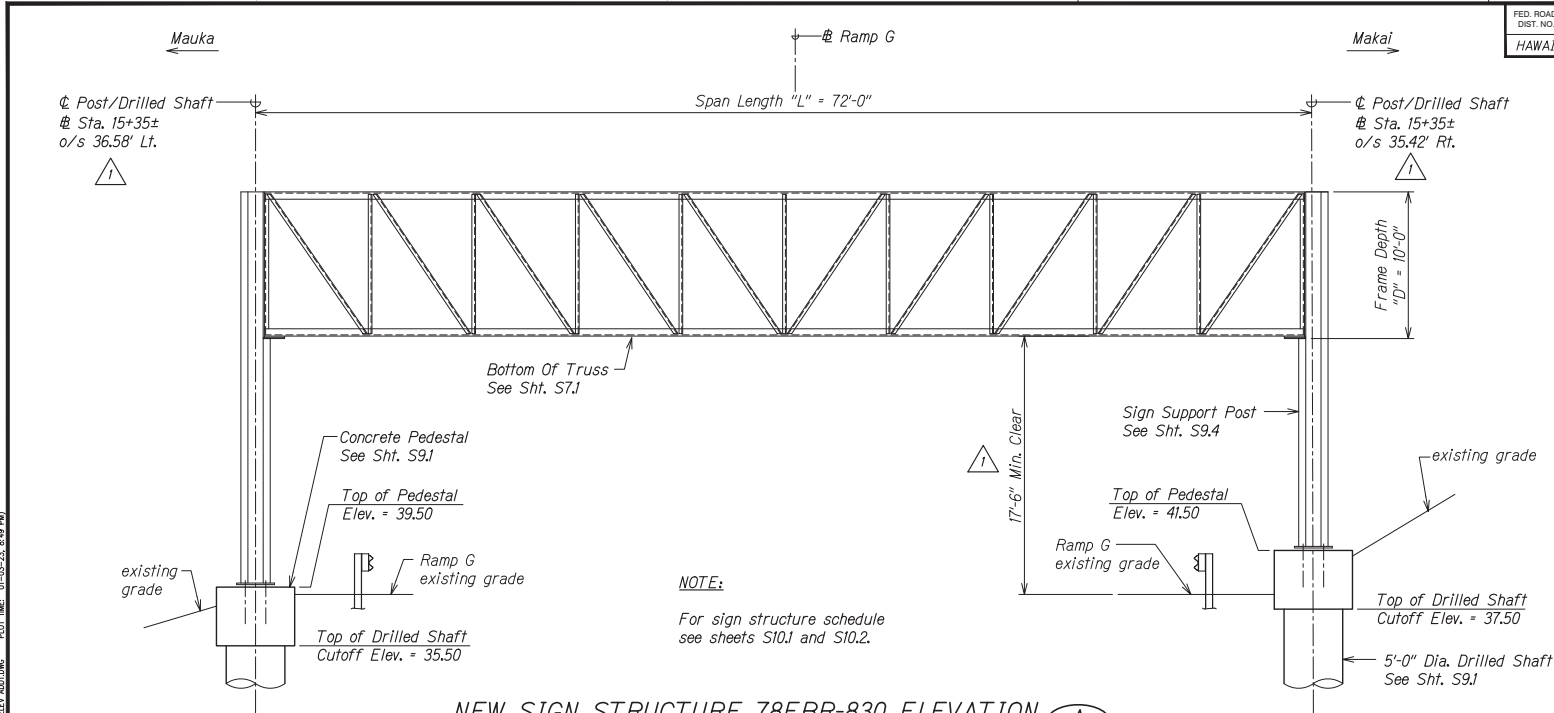

NEW SIGN STRUCTURE 78EBR-830 ELEVATION
 Scale: 1/4" = 1'-0" A
S3J | S3I



EXISTING SIGN STRUCTURE 78EBR-830

DESIGNED BY	DATE
CHECKED BY	
APPROVED BY	
SCALE	
PROJECT NO.	
DATE	

DRAWING NAME: 2.100 ENGINEERING PROJECTS (IC-00P-DESTINATION SIGN) CAD/01-03-23 2023 01/03/23 10:49 AM




THIS WORK WAS PREPARED BY ME OR UNDER MY SUPERVISION
Martin T. Milward
 ENGINEER

STATE OF HAWAII
 DEPARTMENT OF TRANSPORTATION
 HIGHWAYS DIVISION
**SIGN STRUCTURE
 78EBR-830 ELEVATION**
 INTERSTATE ROUTE H-1 AND H-201
 DESTINATION SIGN UPGRADE/REPLACEMENT, PHASE 3
 FAP NO. NH-0300(144)
 Scale: As Noted Date: Sept. 2022
 SHEET No. S3J OF 1 SHEETS

1/3/23	△ Add. 1 - Revised callouts
DATE	REVISION

FED. ROAD DIST. NO.	STATE	FEDERAL AID PROJ. NO.	FISCAL YEAR	SHEET NO.	TOTAL SHEETS
HAWAII	HAW.	NH-0300(144)	2023	ADD. 120	175

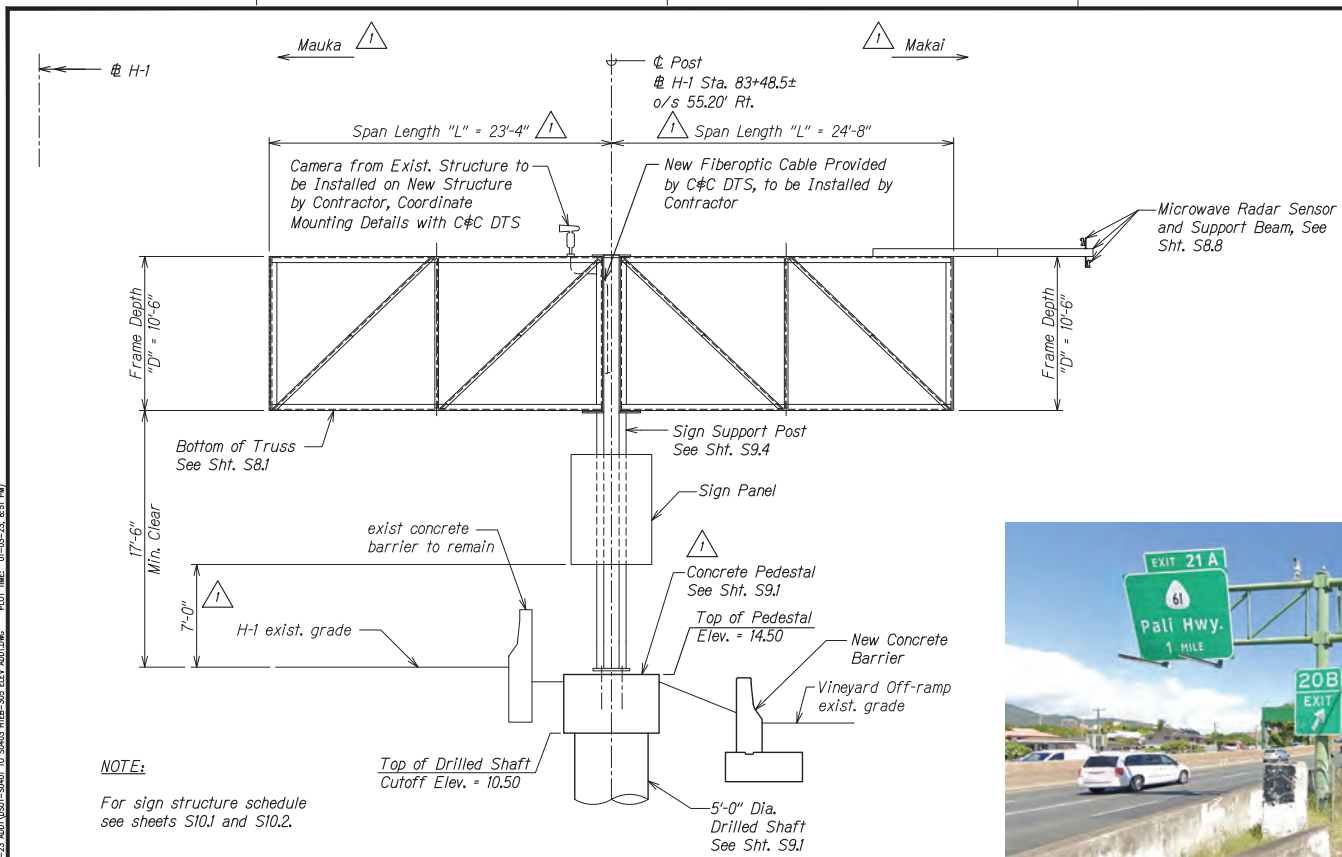

NOTE:
For sign structure schedule see sheets S10.1 and S10.2.

NEW SIGN STRUCTURE HIEB-305 ELEVATION
Scale: 1/4" = 1'-0" A
S41 S41



EXISTING SIGN STRUCTURE HIEB-305

DESIGNED BY	DATE
DRAWN BY	
CHECKED BY	
APPROVED BY	

DRAWING NAME: 2.100 ENGINEERING PROJECTS (C#C-DISTRICT) SIGNED TO 30403 HIEB-305 ELEV ADD.DWG. PLOT TIME: 01-10-23, 8:51 PM

1/3/23	△ Add. 1 - Revised callouts
DATE	REVISION

CALVIN T. MUYERS
 LICENSED PROFESSIONAL ENGINEER
 NO. 8133-S
 HAWAII, U.S.A.
 THIS WORK WAS PREPARED BY ME OR UNDER MY SUPERVISION.
 4-30-24
 SIGNIFICANT EXPRESSION OF THE LICENSEE

STATE OF HAWAII
DEPARTMENT OF TRANSPORTATION
HIGHWAYS DIVISION


SIGN STRUCTURE HIEB-305 ELEVATION

INTERSTATE ROUTE H-1 AND H-201
DESTINATION SIGN UPGRADE/REPLACEMENT, PHASE 3
FAP NO. NH-0300(144)

Scale: As Noted Date: Sept. 2022

SHEET No. S41 OF 4 SHEETS

FED. ROAD DIST. NO.	STATE	FEDERAL AID PROJ. NO.	FISCAL YEAR	SHEET NO.	TOTAL SHEETS
HAWAII	HAW.	NH-0300(144)	2023	ADD. 121	175

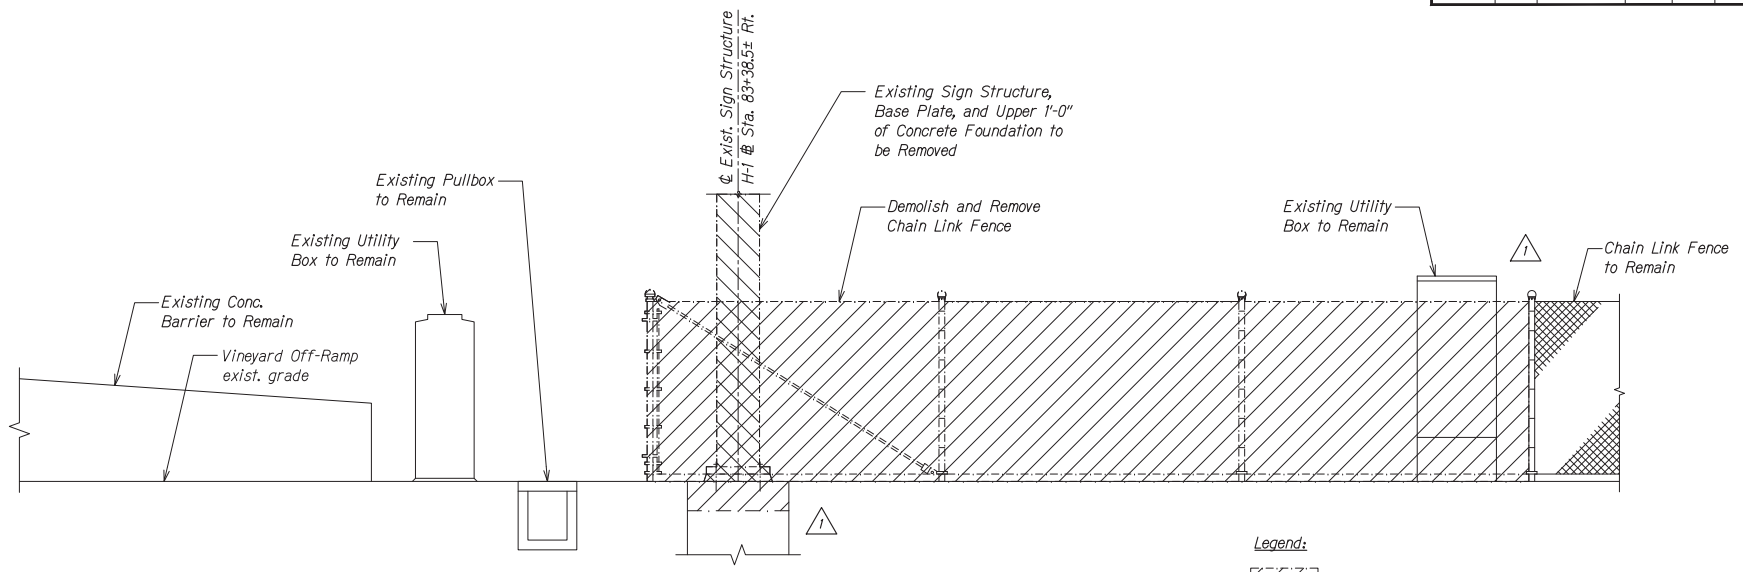

DEMOLITION ELEVATION
 Scale: 1/2" = 1'-0" A
S4.2 S4.2

Legend:
 Demolish and Remove

Note:
 Elevation is shown from Vineyard Boulevard.

DESIGNED BY	DATE
DRAWN BY	
CHECKED BY	
IN CHARGE BY	

DRAWING NAME: 2.102 ENGINEER OF PROJECTS (E-06)-DESTINATION SIGNAGE (ADD. 121) TO 30403 HIEB-305 ELEV. ADD. 121M - PLOT TIME: 01-10-23, 8:51 PM

1/3/23	Add. 1 - Revised details
DATE	REVISION

STATE OF HAWAII
 DEPARTMENT OF TRANSPORTATION
 HIGHWAYS DIVISION

**SIGN STRUCTURE HIEB-305
 DEMOLITION ELEVATION**


INTERSTATE ROUTE H-1 AND H-201
 DESTINATION SIGN UPGRADE/REPLACEMENT, PHASE 3
 FAP NO. NH-0300(144)

Scale: As Noted Date: Sept. 2022

SHEET No. S4.2 OF 4 SHEETS



FED. ROAD DIST. NO.	STATE	FEDERAL AID PROJ. NO.	FISCAL YEAR	SHEET NO.	TOTAL SHEETS
HAWAII	HAW.	NH-0300(144)	2023	ADD. 122	175

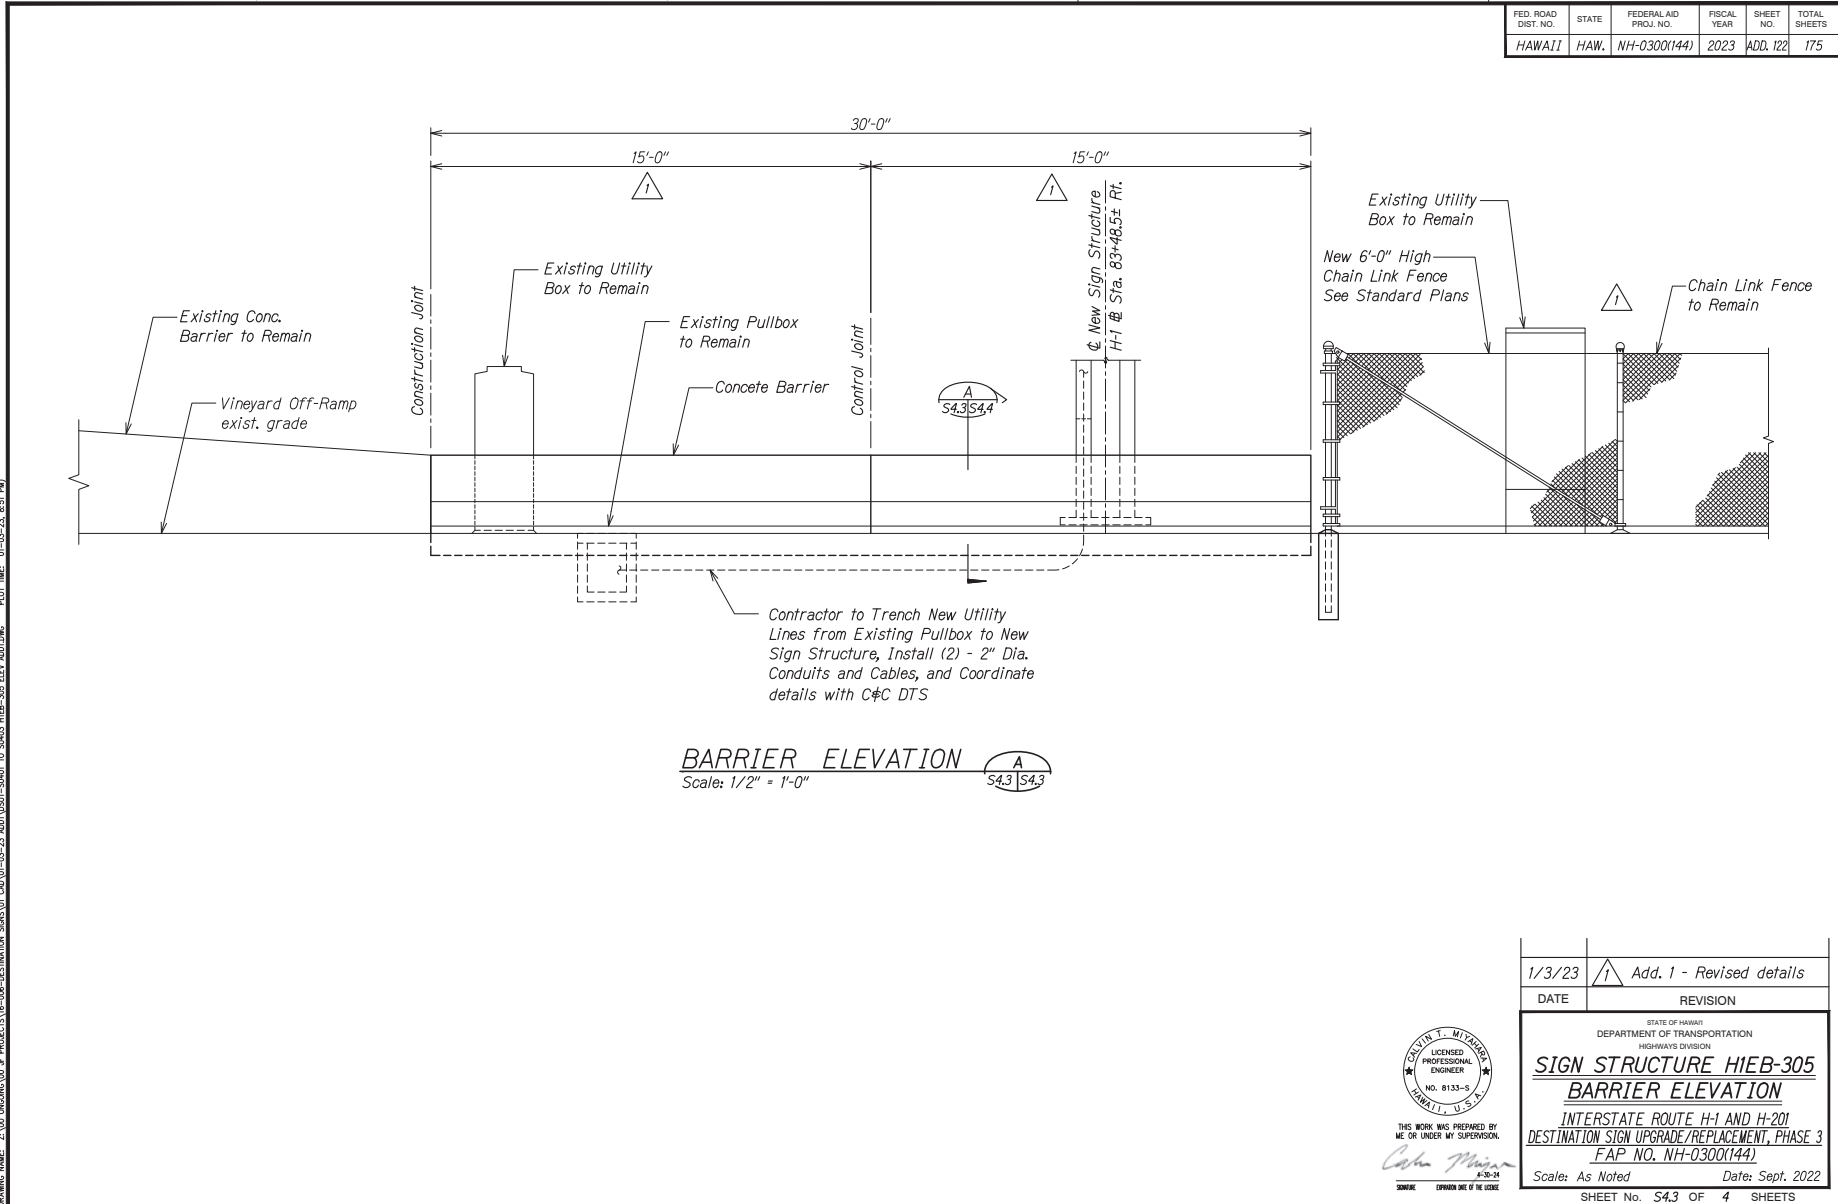

BARRIER ELEVATION A
 Scale: 1/2" = 1'-0" S4.3 | S4.3

DESIGNED BY	DATE
DRAWN BY	
CHECKED BY	
APPROVED BY	
SCALE	
NO.	

DRAWING NAME: 2.102 ENGINEERING PROJECTS (C#C) DESTINATION SIGNAGE TO 30403 HIEB-305 ELEV. ADDITION. PLOT TIME: 01-05-23, 8:51 PM

1/3/23	△ Add. 1 - Revised details
DATE	REVISION

STATE OF HAWAII
DEPARTMENT OF TRANSPORTATION
HIGHWAYS DIVISION

**SIGN STRUCTURE HIEB-305
BARRIER ELEVATION**


INTERSTATE ROUTE H-1 AND H-201
DESTINATION SIGN UPGRADE/REPLACEMENT, PHASE 3
FAP NO. NH-0300(144)

Scale: As Noted Date: Sept. 2022

SHEET No. S4.3 OF 4 SHEETS




FED. ROAD DIST. NO.	STATE	FEDERAL AID PROJ. NO.	FISCAL YEAR	SHEET NO.	TOTAL SHEETS
HAWAII	HAW.	NH-0300(144)	2023	ADD. 123	175

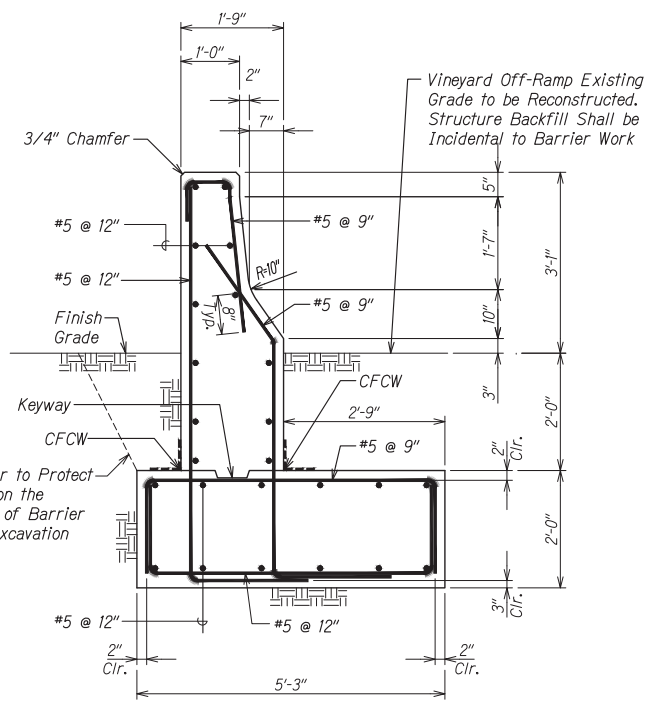


SECTION A
Scale: 1" = 1'-0"
S4.3 S4.4


Contractor to Protect Utilities on the Backside of Barrier During Excavation

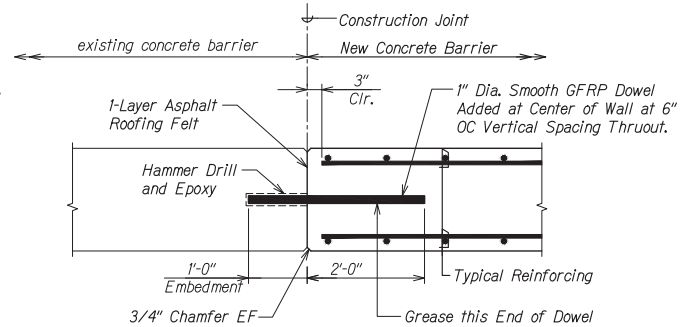

CONSTRUCTION JOINT DETAIL 1
Scale: 1" = 1'-0"
S4.4 S4.4

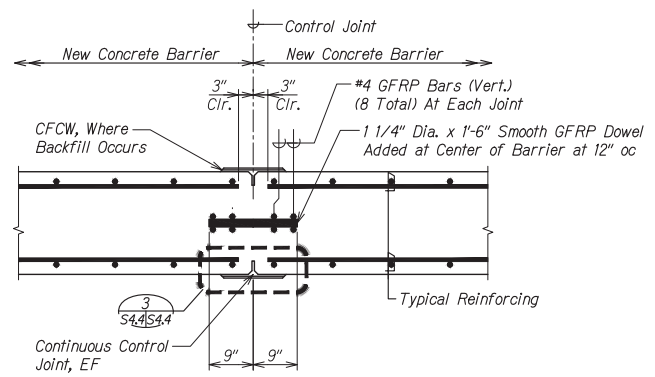

CONTROL JOINT DETAIL 2
Scale: 1" = 1'-0"
S4.4 S4.4

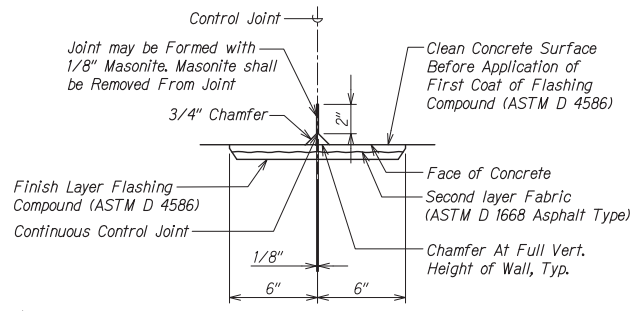

CONTROL JOINT DETAIL WITH CFCW 3
Scale: 1" = 1'-0"
S4.4 S4.4

DESIGNED BY	DATE
CHECKED BY	
APPROVED BY	
SCALE	
NO.	

DRAWING NAME: 2-103 ENGINEERING PROJECTS (I-508-DESTINATION SIGNAGE) CAD: 01-03-23 REVISED: 01-03-23, 02:02 PM




THIS WORK WAS PREPARED BY ME OR UNDER MY SUPERVISION
Kevin Milward
P-30-24
ENGINEER

DATE	REVISION
1/3/23	1 Add. 1 - Added details

STATE OF HAWAII
DEPARTMENT OF TRANSPORTATION
HIGHWAYS DIVISION
**SIGN STRUCTURE HIEB-305
BARRIER SECTION**
INTERSTATE ROUTE H-1 AND H-201
DESTINATION SIGN UPGRADE/REPLACEMENT, PHASE 3
FAP NO. NH-0300(144)
Scale: As Noted Date: Sept. 2022
SHEET No. S4.4 OF 4 SHEETS

FED. ROAD DIST. NO.	STATE	FEDERAL AID PROJ. NO.	FISCAL YEAR	SHEET NO.	TOTAL SHEETS
HAWAII	HAW.	NH-0300(144)	2023	ADD. 124	175

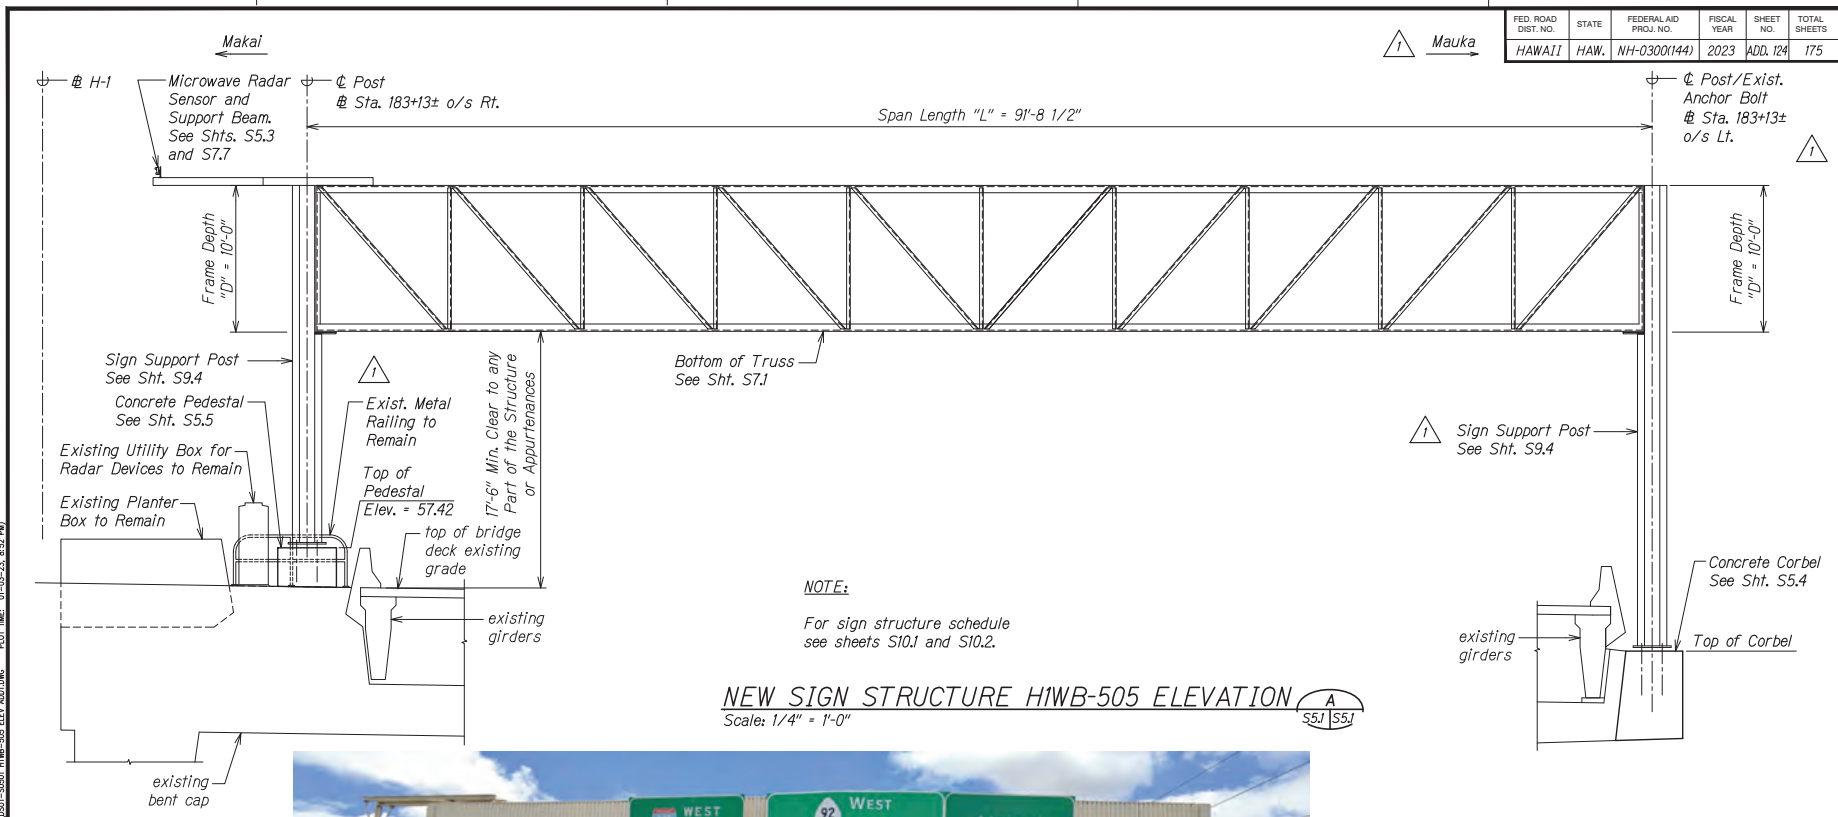

EXISTING SIGN STRUCTURE HIWB-505

DESIGNED BY	DATE
DRAWN BY	
CHECKED BY	
APPROVED BY	
SCALE	
NO.	

DRAWING NAME: 2.102 ENGINEERING PROJECTS (C-306-DESTINATION SIGNAGE) CAD/01-03-23 001/02/01-5500 HIWB-505 ELEV. ASD/IMG PLOT TIME: 04-25-24, 8:52 PM

1/3/23	△ Add. 1 - Revised callouts
DATE	REVISION


STATE OF HAWAII
DEPARTMENT OF TRANSPORTATION
HIGHWAYS DIVISION

**SIGN STRUCTURE
HIWB-505 ELEVATION**


INTERSTATE ROUTE H-1 AND H-201
DESTINATION SIGN UPGRADE/REPLACEMENT, PHASE 3
FAP NO. NH-0300(144)

Scale: As Noted Date: Sept. 2022


SHEET No. S5.1 OF 6 SHEETS

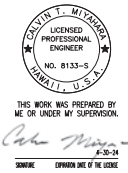


FED. ROAD DIST. NO.	STATE	FEDERAL AID PROJ. NO.	FISCAL YEAR	SHEET NO.	TOTAL SHEETS
HAWAII	HAW.	NH-0300(144)	2023	ADD. 125	175

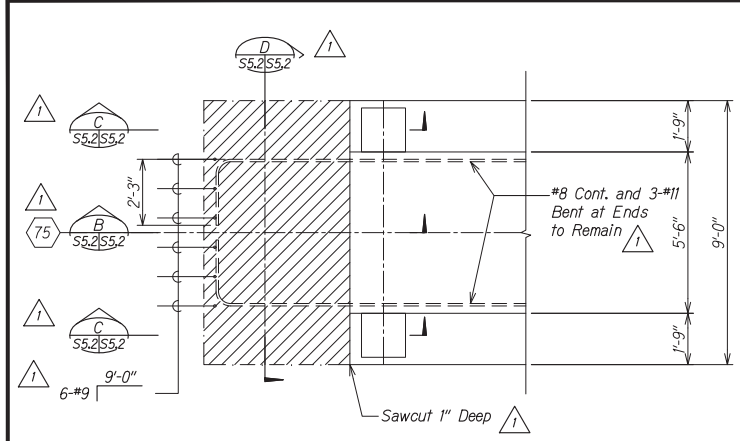


DEMOLITION PLAN A
Scale: 1/2" = 1'-0"
S5.2 S5.2

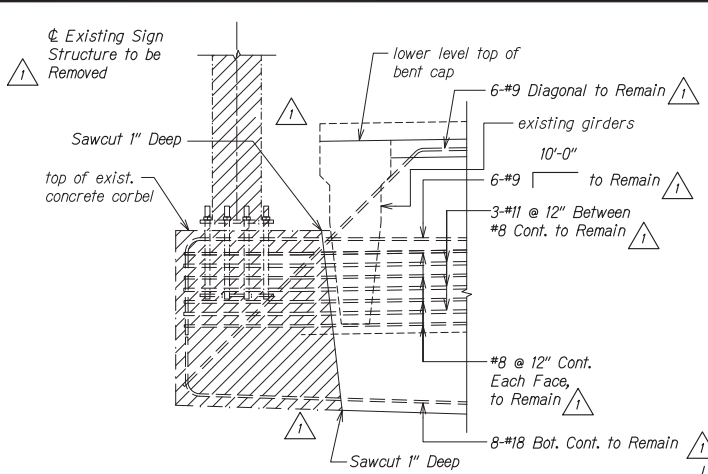

DEMOLITION SECTION B
Scale: 1/2" = 1'-0"
S5.2 S5.2

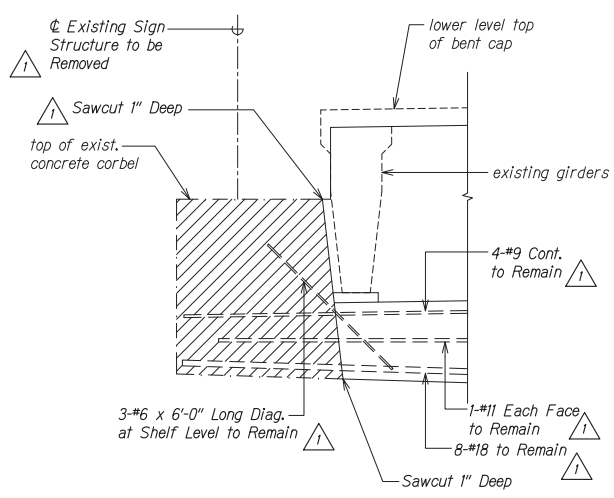

DEMOLITION SECTION C
Scale: 1/2" = 1'-0"
S5.2 S5.2

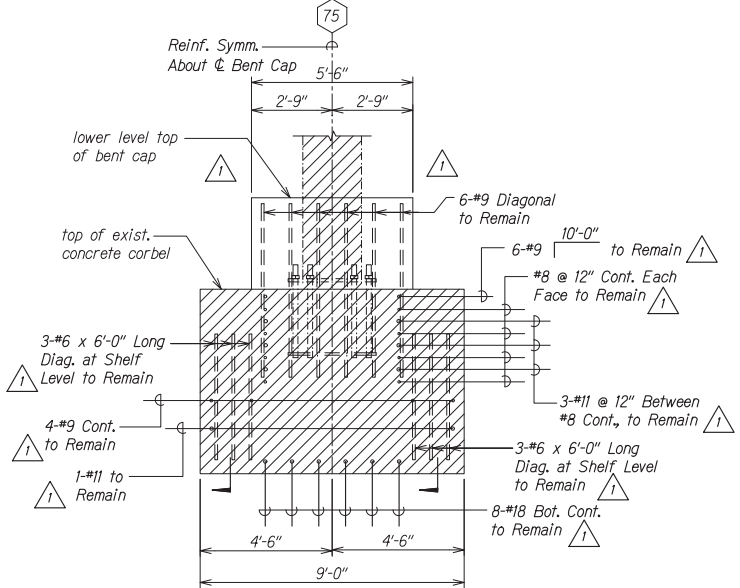

DEMOLITION SECTION D
Scale: 1/2" = 1'-0"
S5.2 S5.2

- Legend:**
- Demolish and Remove
 - Existing Reinforcing to Remain. Do Not Damage.
- Notes:**
- All reinforcing steel noted as "to Remain" shall not be damaged during concrete removal. The Contractor shall use extreme care while chipping concrete in the vicinity of the reinforcing steel.
 - Demolition hammer shall be no larger than 30-pounds.



THIS WORK WAS PREPARED BY ME OR UNDER MY SUPERVISION
DATE: 09/2022

STATE OF HAWAII
DEPARTMENT OF TRANSPORTATION
HIGHWAYS DIVISION

SIGN STRUCTURE - HWB-505
PEDESTAL SUPPORT DEMOLITION PLAN AND SECTS.

INTERSTATE ROUTE H-1 AND H-201
DESTINATION SIGN UPGRADE/REPLACEMENT, PHASE 3
FAP NO. NH-0300(144)

Scale: As Noted Date: Sept. 2022


SHEET No. S5.2 OF 6 SHEETS

DATE	REVISION
1/3/23	1 Add. 1 - Revised callouts, legend & added notes


DESIGNED BY	SAFETY CHECKED BY
DRAWN BY	REVIEWED BY
IN CHARGE BY	DATE

DRAWING NAME: 2.102 ENGINEERING PROJECTS (U.S. DESTINATION SIGN) (ADD. 125) (REV. 01-03-23, 8:54 PM) PLOT TIME: 01-03-23, 8:54 PM

FED. ROAD DIST. NO.	STATE	FEDERAL AID PROJ. NO.	FISCAL YEAR	SHEET NO.	TOTAL SHEETS
HAWAII	HAW.	NH-0300(144)	2023	ADD. 126	175

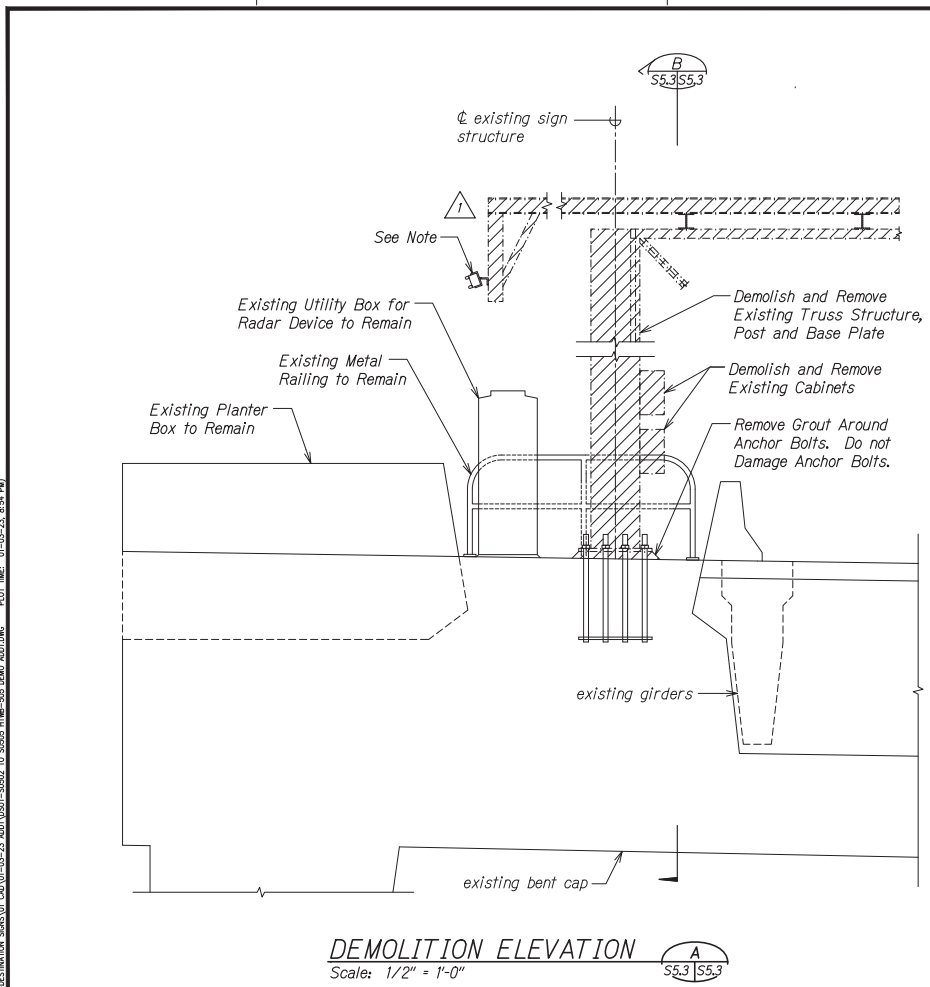

DEMOLITION ELEVATION
Scale: 1/2" = 1'-0"
A
S5.3|S5.3

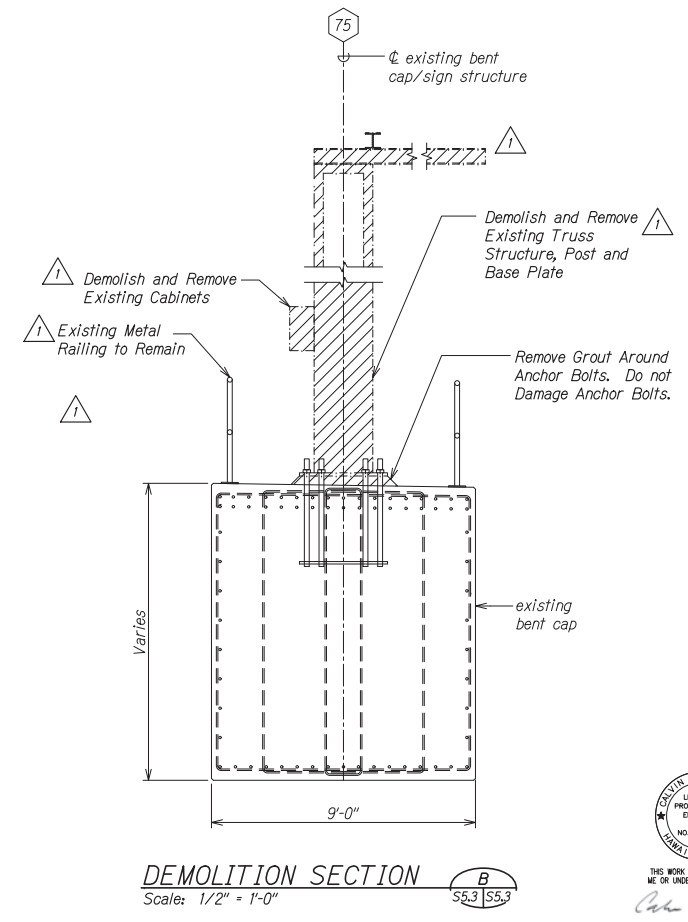


DEMOLITION SECTION
Scale: 1/2" = 1'-0"
B
S5.3|S5.3

NOTE:
Notify Jonathan Lott at (808) 587-6335 a minimum of 2-weeks before the sign structure is removed. The State will remove the radar sensors and hardware that is to be recycled. Everything that remains shall be removed and disposed of. This cost shall be considered incidental to the various pay items.

DESIGNED BY	DATE
DRAWN BY	
CHECKED BY	
APPROVED BY	
SCALE	
PROJECT NO.	
DATE	

DRAWING NAME: 2.102 DEMOLITION OF PIER CAP DESTINATION SIGN FOR CA01-03-23 INDIVIDUAL-5505 TO 5505 HWB-505 DEMO ADDITIONAL PLOT TIME: 01-03-23, 8:54 PM

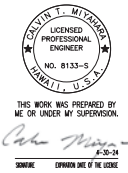

STATE OF HAWAII
DEPARTMENT OF TRANSPORTATION
HIGHWAYS DIVISION

SIGN STRUCTURE - HIWB-505
PIER CAP DEMOLITION ELEV. AND SECTION

INTERSTATE ROUTE H-1 AND H-201
DESTINATION SIGN UPGRADE/REPLACEMENT, PHASE 3
FAP NO. NH-0300(144)



Scale: As Noted Date: Sept. 2022

SHEET No. S5.3 OF 6 SHEETS



1/3/23	1	ADD. 1 - Revised callouts
DATE	REVISION	

FED. ROAD DIST. NO.	STATE	FEDERAL AID PROJ. NO.	FISCAL YEAR	SHEET NO.	TOTAL SHEETS
HAWAII	HAW.	NH-0300(144)	2023	ADD. 127	175


DRAWING NAME: 2.102 ENGINEERING OF PROJECTS (E-306-DESTINATION SIGNAGE) CAD/01-03-23 (REVISED) - 50505 HWB-505 SIGN UPGRADE - 01-03-23, 9:13 PM

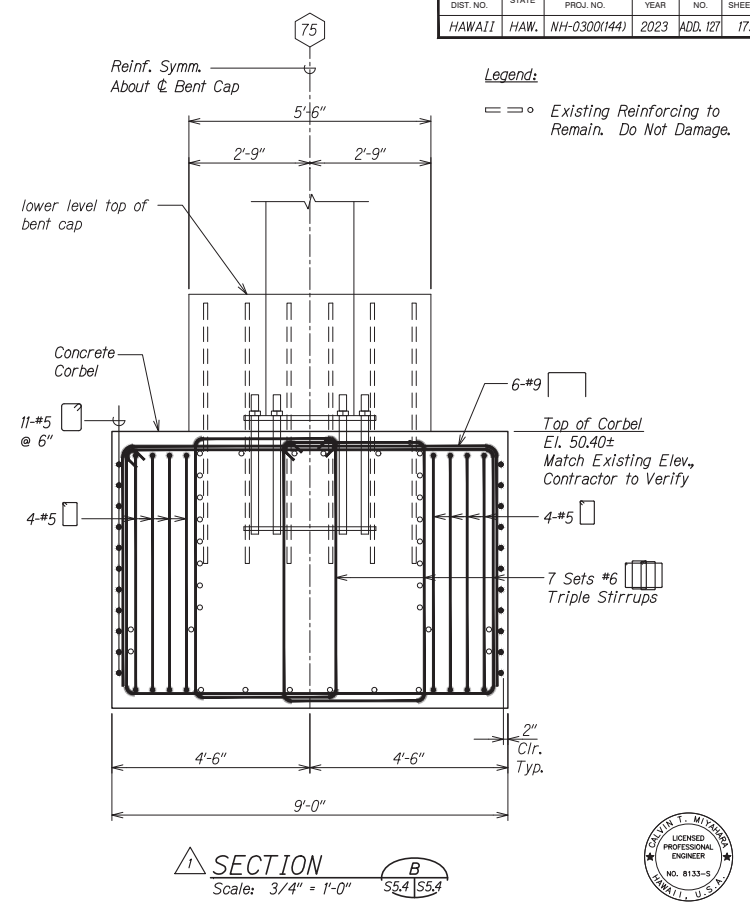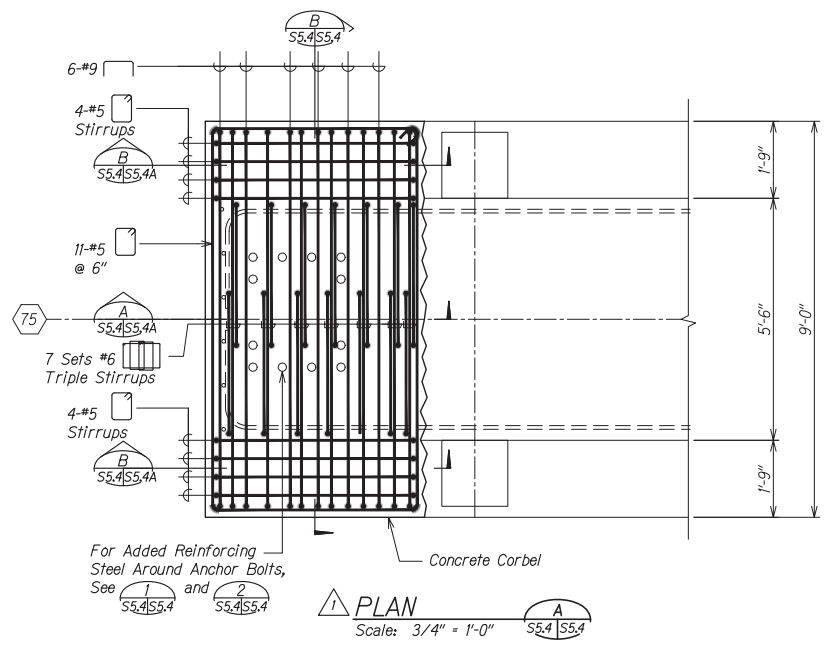

Legend:
 Existing Reinforcing to Remain. Do Not Damage.

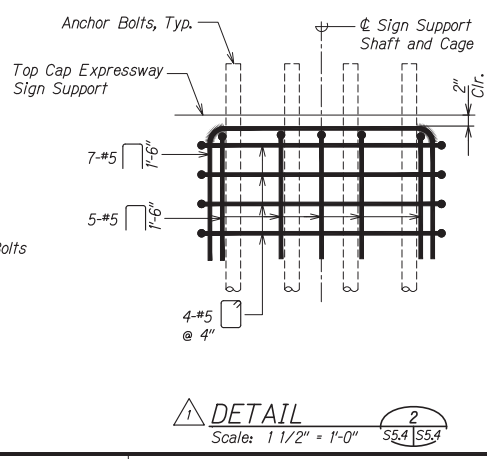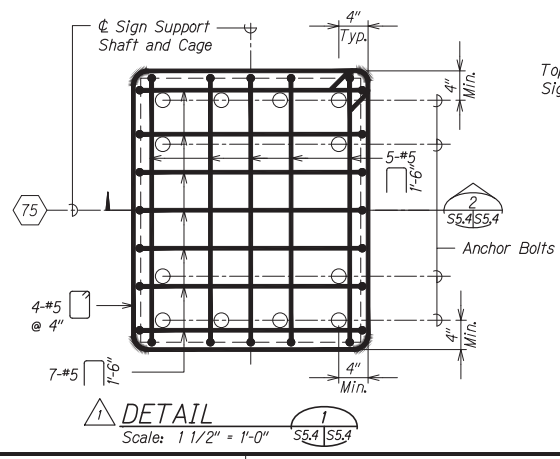

DESIGNED BY	DATE
CHECKED BY	
APPROVED BY	
SCALE	
PROJECT NO.	
DATE	

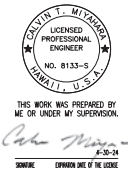

STATE OF HAWAII
DEPARTMENT OF TRANSPORTATION
HIGHWAYS DIVISION

SIGN STRUCTURE - HWB-505
CORBEL SUPPORT PLAN AND SECTIONS


INTERSTATE ROUTE H-1 AND H-201
DESTINATION SIGN UPGRADE/REPLACEMENT, PHASE 3
FAP NO. NH-0300(144)


Scale: As Noted Date: Sept. 2022

SHEET No. S5.4 OF 6 SHEETS


1/3/23	ADD. 1 - Revised callouts and added details
DATE	REVISION

FED. ROAD DIST. NO.	STATE	FEDERAL AID PROJ. NO.	FISCAL YEAR	SHEET NO.	TOTAL SHEETS
HAWAII	HAW.	NH-0300(144)	2023	ADD. 127S-1	175

Legend:
 Existing Reinforcing to Remain. Do Not Damage.

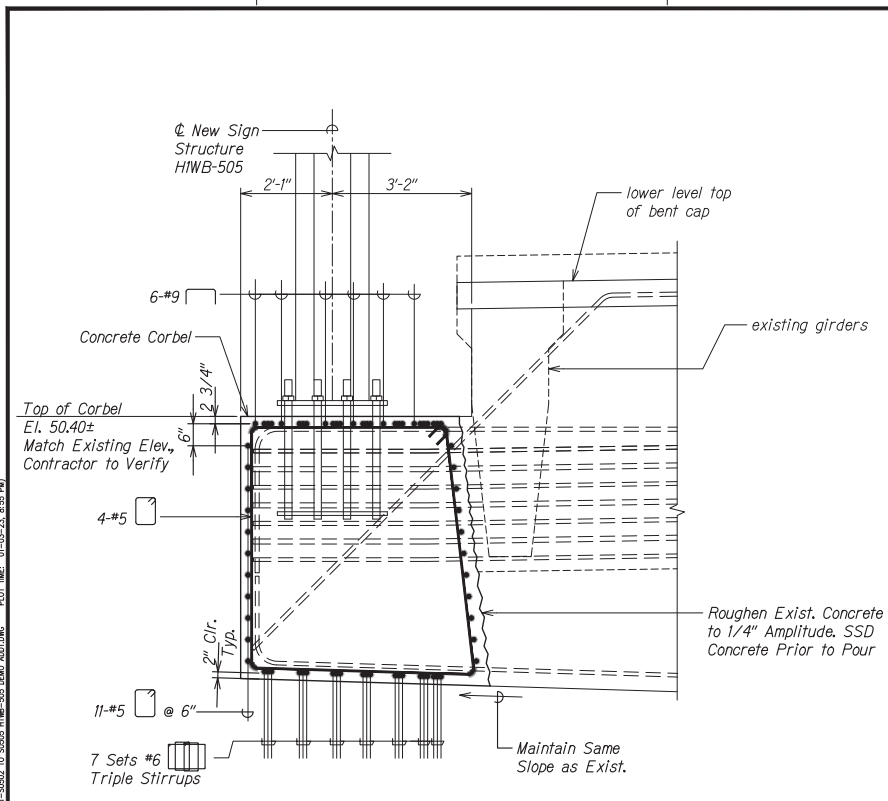

SECTION A
 Scale: 3/4" = 1'-0"
 S5.4 | S5.4A

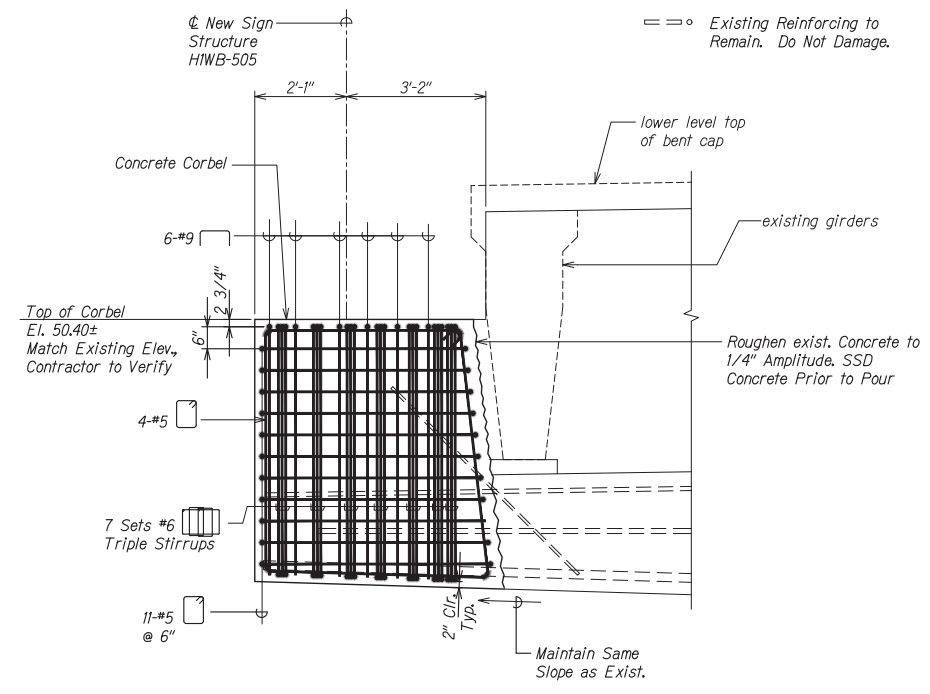

SECTION B
 Scale: 1/2" = 1'-0"
 S5.4 | S5.4A

DESIGNED BY	DATE
CHECKED BY	
APPROVED BY	
DATE	

DRAWING NAME: 2.102 ENGINEERING PROJECTS (I-505-DESTINATION SIGN) (ADD. 127S-1) SHEET NO. 127S-1 OF 175 SHEETS. DATE: 01-03-23, 8:52 PM



THIS WORK WAS PREPARED BY ME OR UNDER MY SUPERVISION.
 LICENSED PROFESSIONAL ENGINEER
 NO. 8133-S
 HAWAII, U.S.A.

STATE OF HAWAII
 DEPARTMENT OF TRANSPORTATION
 HIGHWAYS DIVISION

**SIGN STRUCTURE - HWB-505
 CORBEL SUPPORT SECTIONS**

INTERSTATE ROUTE H-1 AND H-201
 DESTINATION SIGN UPGRADE/REPLACEMENT, PHASE 3
 FAP NO. NH-0300(144)


Scale: As Noted Date: Sept. 2022

SHEET No. S5.4A OF 6 SHEETS


1/3/23	ADD. 1 - New sheet
DATE	REVISION

ADD. 127S-1

FED. ROAD DIST. NO.	STATE	FEDERAL AID PROJ. NO.	FISCAL YEAR	SHEET NO.	TOTAL SHEETS
HAWAII	HAW.	NH-0300(144)	2023	ADD. 128	175

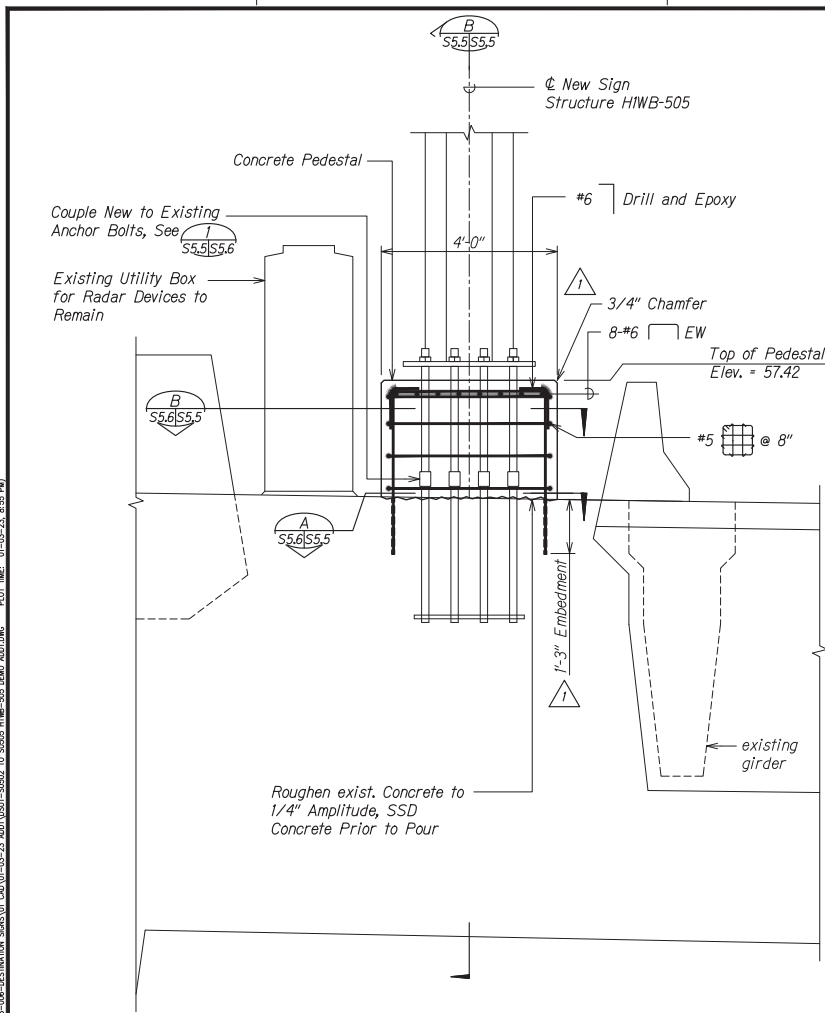

PEDESTAL SECTION A
Scale: 3/4" = 1'-0"

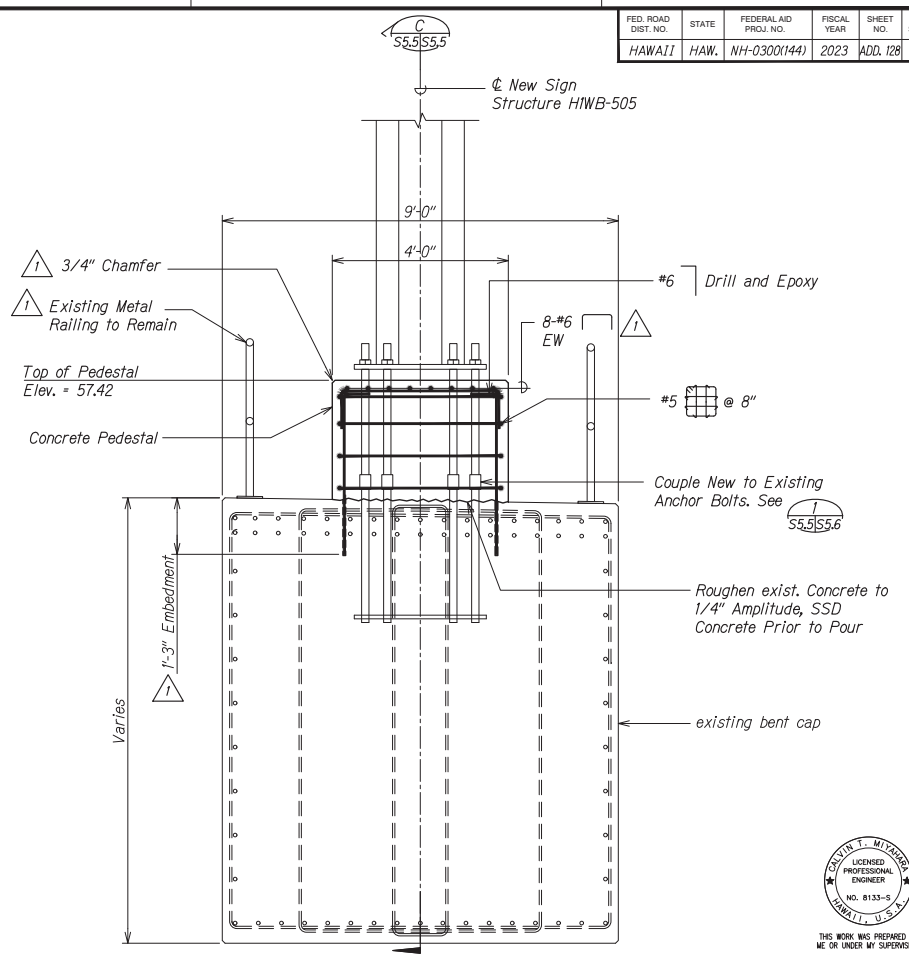

PEDESTAL SECTION B
Scale: 3/4" = 1'-0"



THIS WORK WAS PREPARED BY ME OR UNDER MY SUPERVISION
P-30-24
SIGNER ENGINEER OR HIS DELEGATE

DESIGNED BY	DATE
DRAWN BY	
CHECKED BY	
APPROVED BY	

DRAWING NAME: 2-102 ENGINEERING PROJECTS/144-DESTINATION SIGN/144-03-23 ADDITIONAL-5656 TO 5656S HIWB-505 SIGN ADD/DWG PLOT TIME: 01-05-23, 8:52 PM

1/3/23	1	ADD. 1 - Revised details
DATE	REVISION	

STATE OF HAWAII
DEPARTMENT OF TRANSPORTATION
HIGHWAYS DIVISION


**SIGN STRUCTURE - HIWB-505
PEDESTAL SUPPORT ELEV. AND SECTION**

INTERSTATE ROUTE H-1 AND H-201
DESTINATION SIGN UPGRADE/REPLACEMENT, PHASE 3
FAP NO. NH-0300(144)

Scale: As Noted Date: Sept. 2022


SHEET No. S5.5 OF 6 SHEETS

FED. ROAD DIST. NO.	STATE	FEDERAL AID PROJ. NO.	FISCAL YEAR	SHEET NO.	TOTAL SHEETS
HAWAII	HAW.	NH-0300(144)	2023	ADD. 129	175

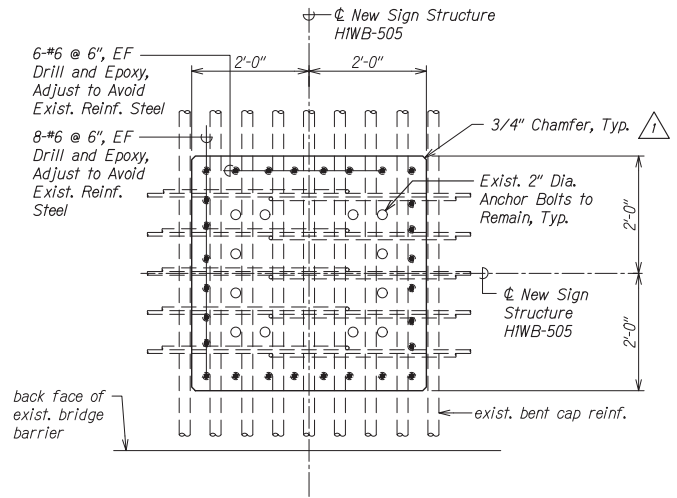


SECTION A
Scale: 1" = 1'-0" S5.6 | S5.6

Direction Of Travel
Direction Of Sign Above

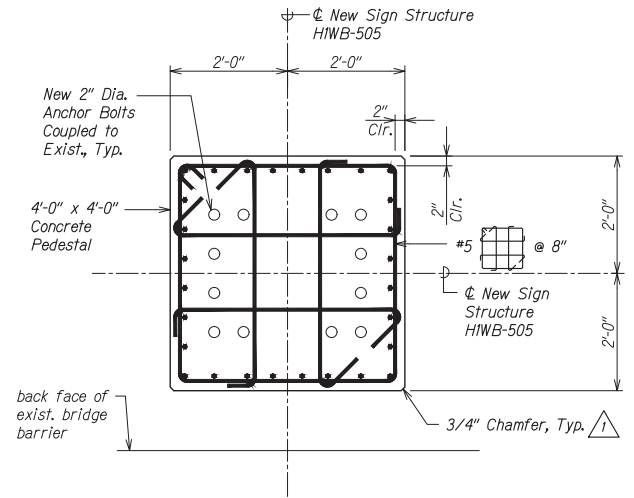

SECTION B
Scale: 1" = 1'-0" S5.6 | S5.6

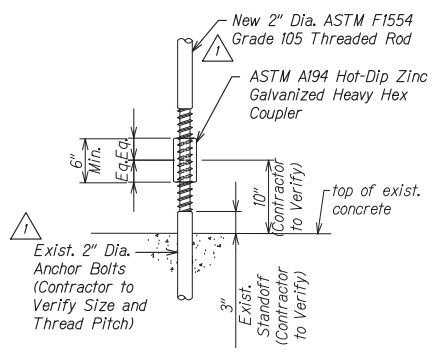

COUPLING DETAIL
Scale: 1 1/2" = 1'-0" S5.5 | S5.6

NOTE:
Prior to any hammer drilling work, a survey of the concrete bent cap top in the area of the new concrete pedestal shall be completed. The survey shall be conducted using a ground penetrating radar scanner to located all existing top layer reinforcing steel. Adjust locations of #6 dowel bars to avoid conflict with or damaging existing reinforcing steel.

DESIGNED BY	DATE
CHECKED BY	
APPROVED BY	
SCALE	
PROJECT NO.	
DATE	

DRAWING NAME: 2-102 ENGINEERING PROJECTS (E-306-DESTINATION SIGN) CAD/01-03-23 INDIVIDUAL-S006 PED SPR/DWG. PLOT TIME: 01-03-23 8:58 PM



THIS WORK WAS PREPARED BY ME OR UNDER MY SUPERVISION
ENGINEER

STATE OF HAWAII
DEPARTMENT OF TRANSPORTATION
HIGHWAYS DIVISION

**SIGN STRUCTURE HWB-505
PEDESTAL SUPPORT SECTS. AND DET.**


INTERSTATE ROUTE H-1 AND H-201
DESTINATION SIGN UPGRADE/REPLACEMENT, PHASE 3
FAP NO. NH-0300(144)

Scale: As Noted Date: Sept. 2022

SHEET No. S5.6 OF 6 SHEETS

1/3/23	1	Add. 1 - Revised callouts
DATE	REVISION	

FED. ROAD DIST. NO.	STATE	FEDERAL AID PROJ. NO.	FISCAL YEAR	SHEET NO.	TOTAL SHEETS
HAWAII	HAW.	NH-0300(144)	2023	ADD. 130	175

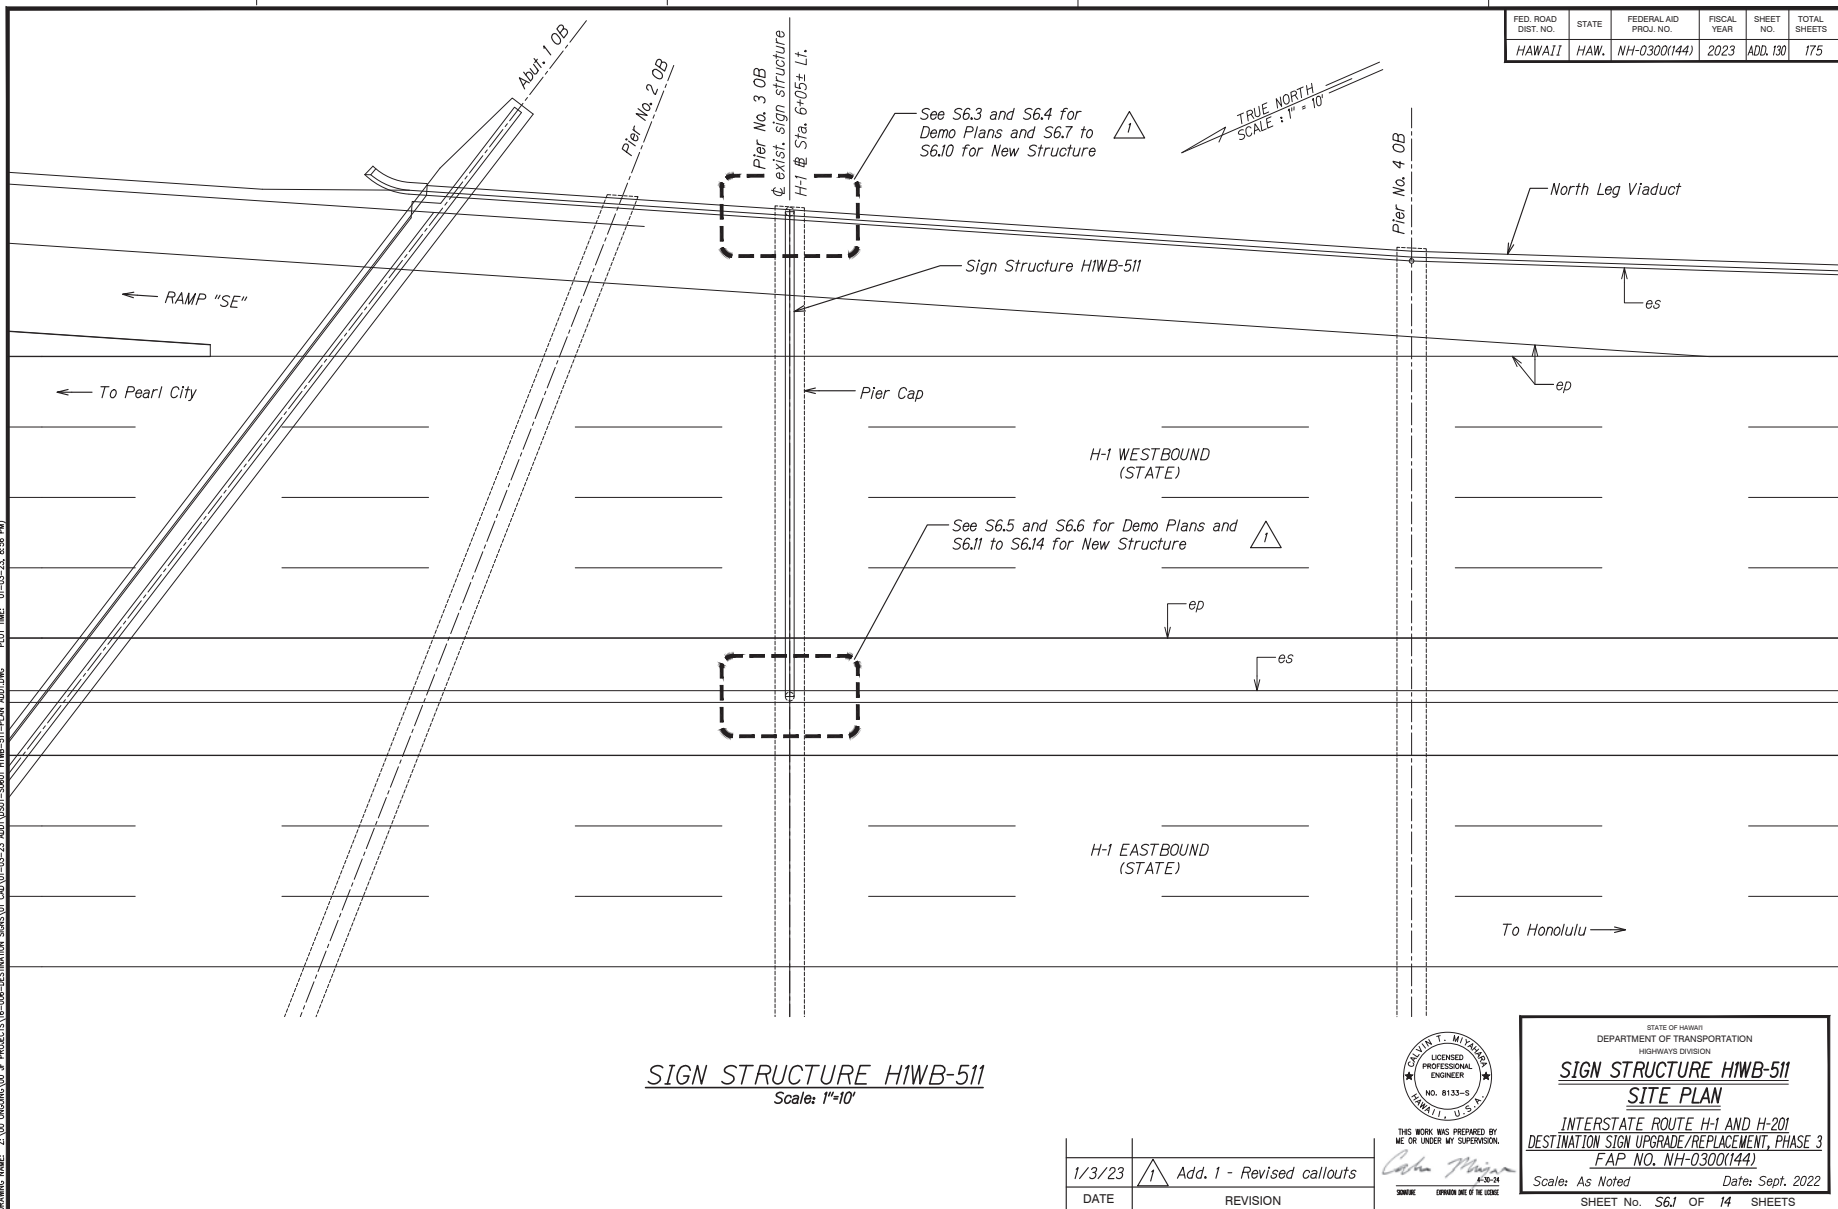

SIGN STRUCTURE HWB-511
Scale: 1"=10'

DESIGNED BY	DATE
DRAWN BY	
CHECKED BY	
APPROVED BY	

DRAWING NAME: 2.102 ENGINEERING PROJECTS (CADD) DESTINATION SIGNAGE (CADD) - 05-23 2019 (U.S.) - SIGNAGE HWB-511 - PLAN AND ELEVATION PLOT TIME: 01-05-23, 8:56 AM

DATE	REVISION
1/3/23	△ Add. 1 - Revised callouts



THIS WORK WAS PREPARED BY ME OR UNDER MY SUPERVISION.
Calvin Milner
A-30-24
EXPIRES ONE OF THE LICENSE


STATE OF HAWAII
DEPARTMENT OF TRANSPORTATION
HIGHWAYS DIVISION

SIGN STRUCTURE HWB-511
SITE PLAN


INTERSTATE ROUTE H-1 AND H-201
DESTINATION SIGN UPGRADE/REPLACEMENT, PHASE 3
FAP NO. NH-0300(144)

Scale: As Noted Date: Sept. 2022
SHEET No. S61 OF 14 SHEETS


FED. ROAD DIST. NO.	STATE	FEDERAL AID PROJ. NO.	FISCAL YEAR	SHEET NO.	TOTAL SHEETS

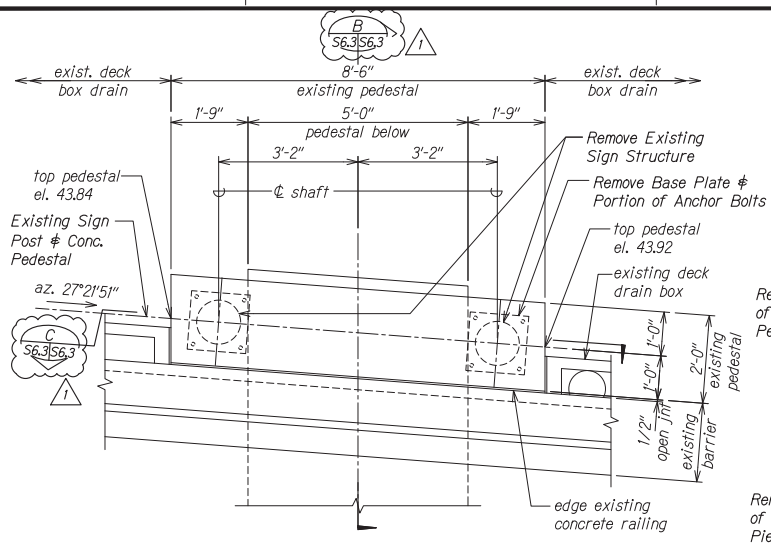


SECTION A
Scale: 3/4" = 1'-0" S6.3 | S6.3

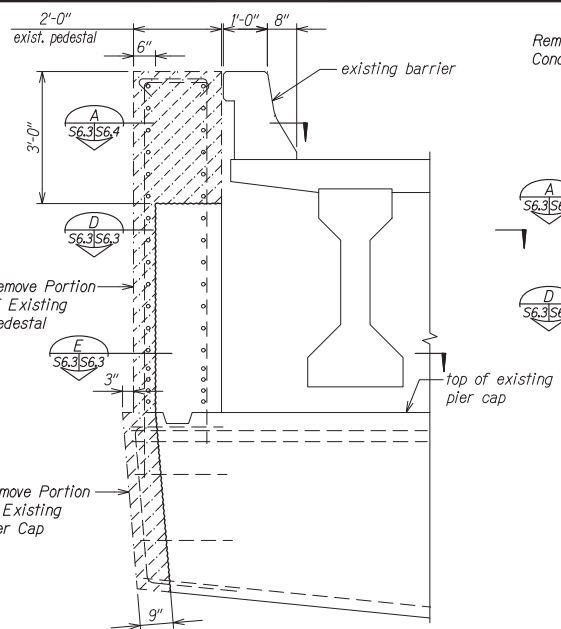


SECTION B
Scale: 3/4" = 1'-0" S6.3 | S6.3

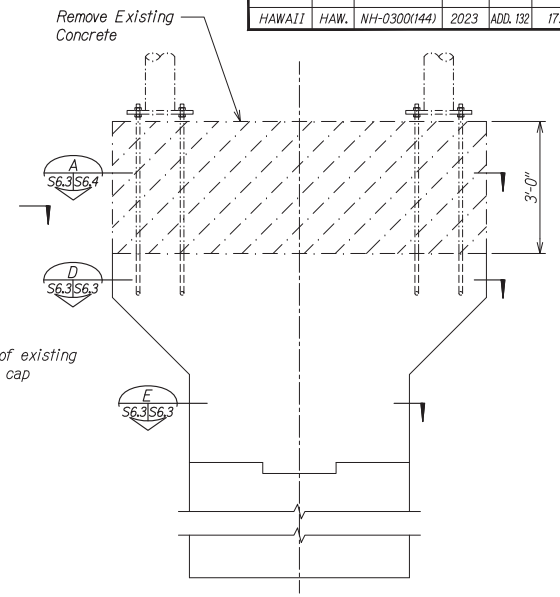

SECTION C
Scale: 3/4" = 1'-0" S6.3 | S6.3

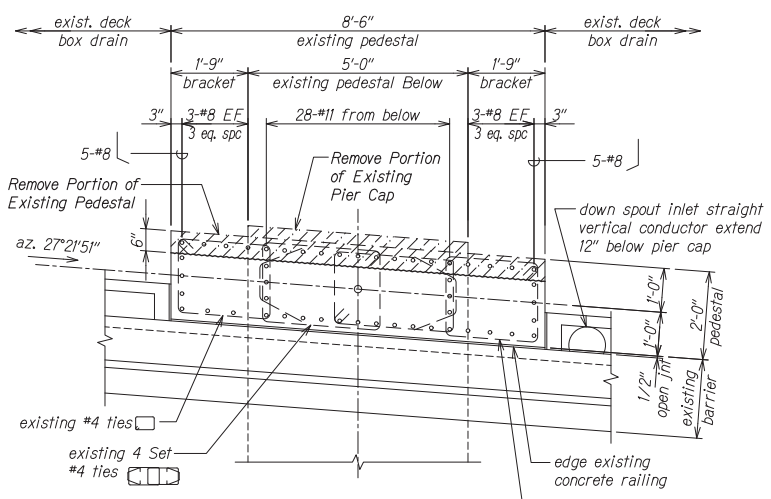

SECTION D
Scale: 3/4" = 1'-0" S6.3 | S6.3

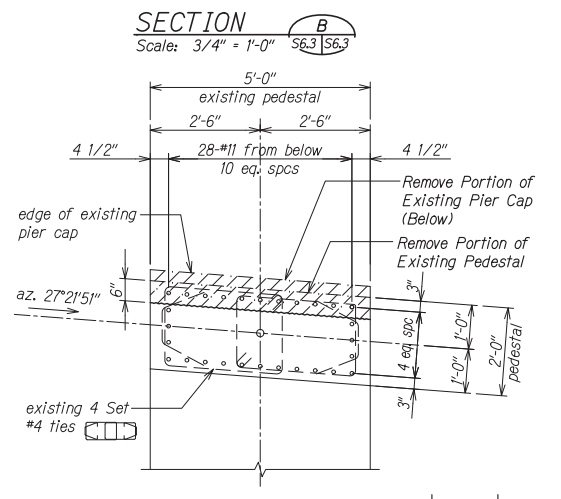

SECTION E
Scale: 3/4" = 1'-0" S6.3 | S6.3

NOTE:
All reinforcing is existing and shall remain in place and shall not be damaged unless otherwise noted.



THIS WORK WAS PREPARED BY ME OR UNDER MY SUPERVISION
Nathan T. Milward
DATE: 09/2022

STATE OF HAWAII
DEPARTMENT OF TRANSPORTATION
HIGHWAYS DIVISION

**SIGN STRUCTURE HWB-511
DEMOLITION SECTIONS**

INTERSTATE ROUTE H-1 AND H-201
DESTINATION SIGN UPGRADE/REPLACEMENT, PHASE 3
FAP NO. NH-0300(144)


Scale: As Noted Date: Sept. 2022
SHEET No. S6.3 OF 14 SHEETS

DATE	REVISION
1/3/23	△ Add. 1 - Added section cuts


DESIGNED BY	DATE
CHECKED BY	
APPROVED BY	
SCALE	
PROJECT NO.	
DATE	

DRAWING NAME: 2.100 ENGINEERING PROJECTS (U.S. DESTINATION SIGNAGE) CAD/01-03-23 INDIVIDUALS/ROAD TO 59006 HWB-511-DEM DEMO ADD/14M DATE TIME: 01-03-23 09:52 PM

FED. ROAD DIST. NO.	STATE	FEDERAL AID PROJ. NO.	FISCAL YEAR	SHEET NO.	TOTAL SHEETS
HAWAII	HAW.	NH-0300(144)	2023	ADD. 136	175

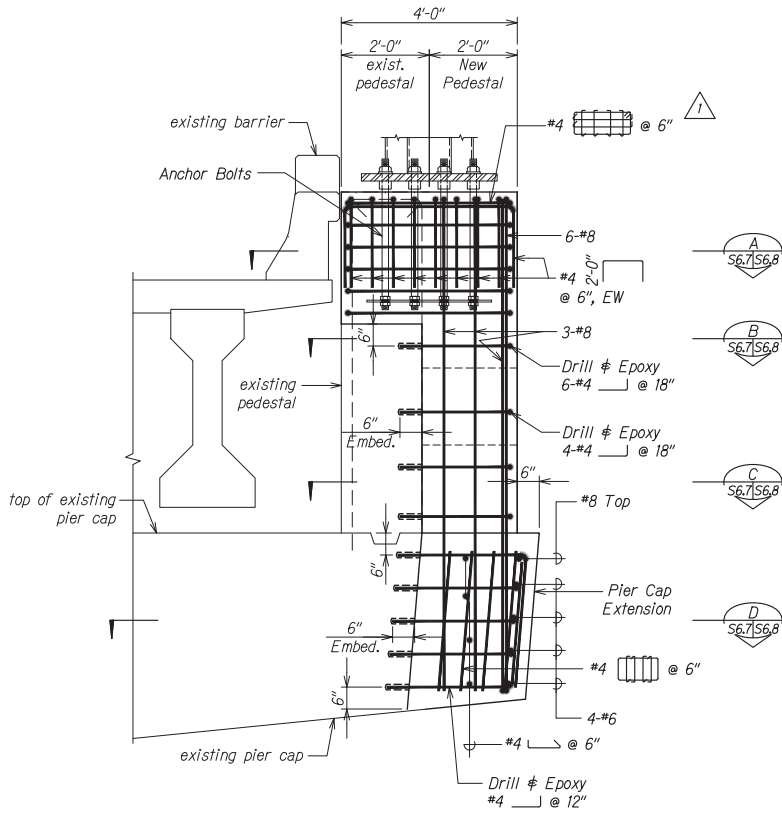

SECTION A
Scale: 3/4" = 1'-0"
S6.8 | S6.7

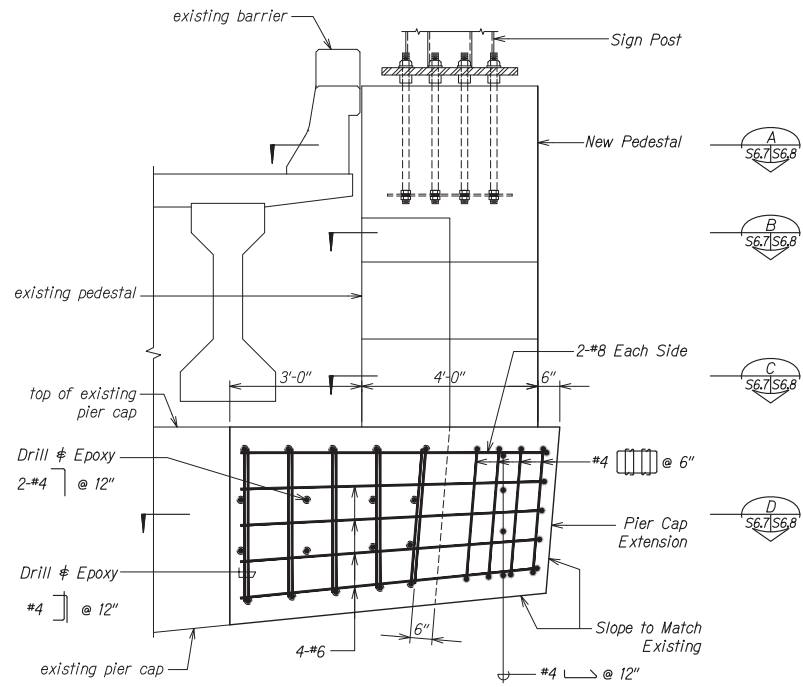

SECTION B
Scale: 3/4" = 1'-0"
S6.8 | S6.7

DESIGNED BY	DATE
CHECKED BY	
APPROVED BY	
SCALE	
NO. OF SHEETS	
TITLE	

DRAWING NAME: 2.102 ENGINEERING PROJECTS (C-30P-DESTINATION SIGN) CADD (01-03-23) SHEETS ADD.136 PLOT TIME: 01-03-23 8:58 PM



THIS WORK WAS PREPARED BY ME OR UNDER MY SUPERVISION
Martin T. Milward
DATE: 01-03-23

STATE OF HAWAII
DEPARTMENT OF TRANSPORTATION
HIGHWAYS DIVISION

SIGN STRUCTURE HWB-511
SECTIONS


INTERSTATE ROUTE H-1 AND H-201
DESTINATION SIGN UPGRADE/REPLACEMENT, PHASE 3
FAP NO. NH-0300(144)

Scale: As Noted Date: Sept. 2022


SHEET No. S6.7 OF 14 SHEETS

1/3/23	△	Add. 1 - Revised callout
DATE	REVISION	


FED. ROAD DIST. NO.	STATE	FEDERAL AID PROJ. NO.	FISCAL YEAR	SHEET NO.	TOTAL SHEETS
HAWAII	HAW.	NH-0300(144)	2023	ADD. 137	175

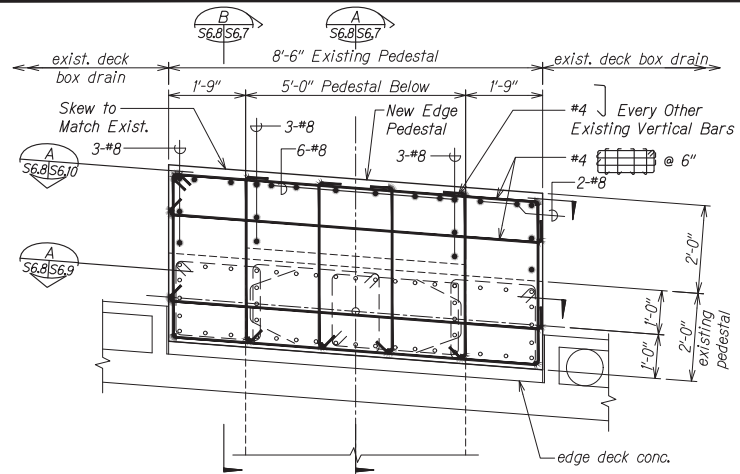


SECTION A
Scale: 3/4" = 1'-0"
S6.9, S6.10

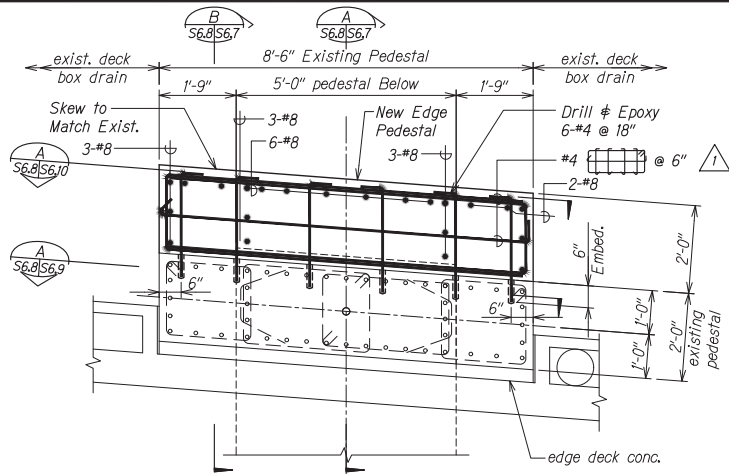

SECTION B
Scale: 3/4" = 1'-0"
S6.9, S6.10

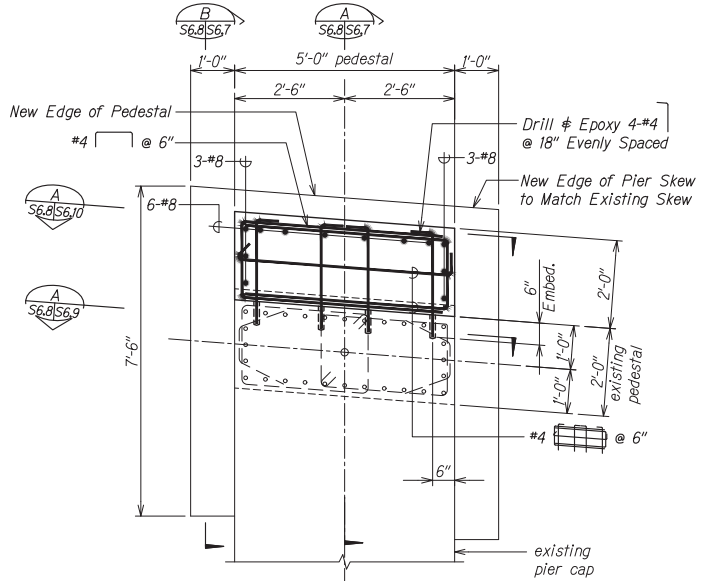

SECTION C
Scale: 3/4" = 1'-0"
S6.7, S6.8

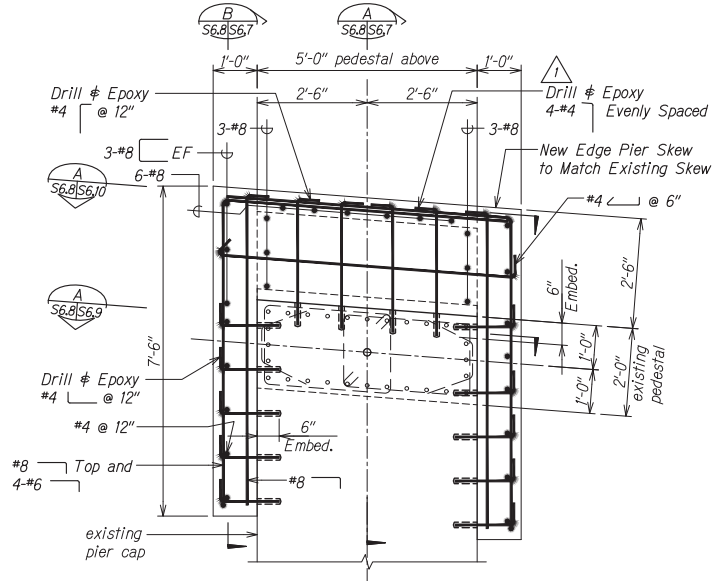

SECTION D
Scale: 3/4" = 1'-0"
S6.9, S6.10

DRAWING NAME: 2.100 ENGINEERING PROJECTS (U.S. DESTINATION SIGNAGE) CAD/01-03-23 INDIVIDUAL-SIGNAGE TO SIGNAGE HWB-511-SIGNS ADD/146 PLOT TIME: 01-03-23 8:58 PM

DESIGNED BY	DATE
DRAWN BY	
CHECKED BY	
APPROVED BY	
SCALE	
NO.	

1/3/23	1	ADD. 1 - Revised callout
DATE		REVISION



THIS WORK WAS PREPARED BY ME OR UNDER MY SUPERVISION
Nathan T. Milward
ENGINEER


STATE OF HAWAII
DEPARTMENT OF TRANSPORTATION
HIGHWAYS DIVISION

SIGN STRUCTURE HWB-511 SECTIONS

INTERSTATE ROUTE H-1 AND H-201
DESTINATION SIGN UPGRADE/REPLACEMENT, PHASE 3
FAP NO. NH-0300(144)

Scale: As Noted Date: Sept. 2022
SHEET No. S6.8 OF 14 SHEETS

FED. ROAD DIST. NO.	STATE	FEDERAL AID PROJ. NO.	FISCAL YEAR	SHEET NO.	TOTAL SHEETS
HAWAII	HAW.	NH-0300(144)	2023	ADD. 139	175

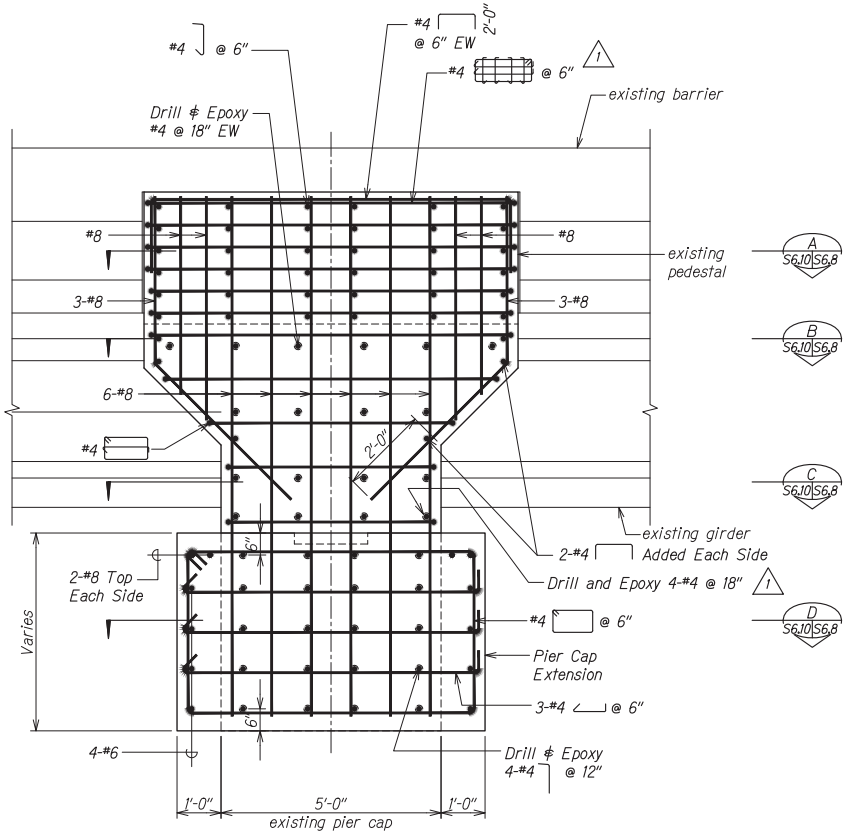

SECTION A
Scale: 3/4" = 1'-0"
S6.8 S6.10

DRAWING NAME: 2.102 ENGINEERING PROJECTS (C-06-DESTINATION SIGN) CADD-03-23 ADDITIONAL-SHEET-ADD-139 PLOT TIME: 01-03-23 8:59 AM

DESIGNED BY	DATE
CHECKED BY	
APPROVED BY	
SCALE	
NO.	



THIS WORK WAS PREPARED BY ME OR UNDER MY SUPERVISION
Kevin Milward
ENGINEER EXAMINED DATE OF THE SEALS

STATE OF HAWAII
DEPARTMENT OF TRANSPORTATION
HIGHWAYS DIVISION

SIGN STRUCTURE HWB-511
SECTION


INTERSTATE ROUTE H-1 AND H-201
DESTINATION SIGN UPGRADE/REPLACEMENT, PHASE 3
FAP NO. NH-0300(144)

Scale: As Noted Date: Sept. 2022


SHEET No. S6.10 OF 14 SHEETS

1/3/23	△ Add. 1 - Revised callouts
DATE	REVISION

FED. ROAD DIST. NO.	STATE	FEDERAL AID PROJ. NO.	FISCAL YEAR	SHEET NO.	TOTAL SHEETS
HAWAII	HAW.	NH-0300(144)	2023	ADD. 143	175

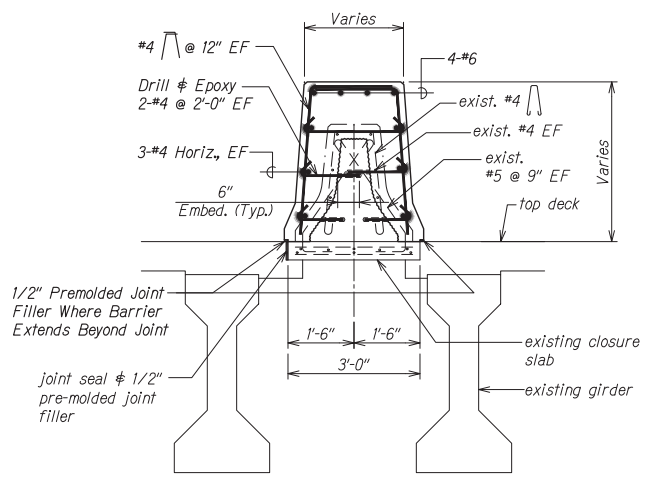

SECTION A
Scale: 3/4" = 1'-0"
S6.11 | S6.14

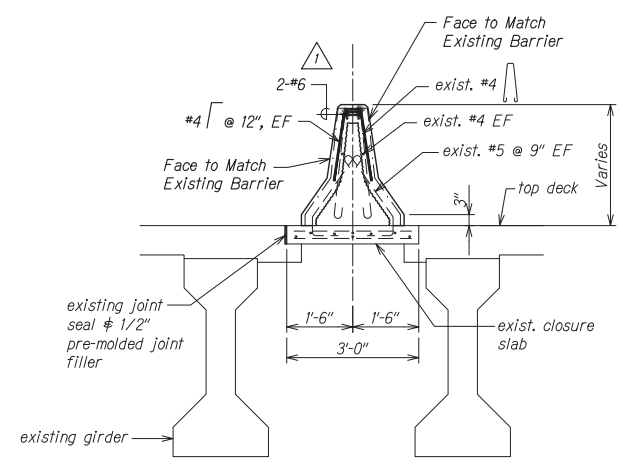

SECTION B
Scale: 3/4" = 1'-0"
S6.11 | S6.14

DESIGNED BY	DATE
DRAWN BY	
CHECKED BY	
APPROVED BY	
SCALE	
NO.	

DRAWING NAME: 2.100 ENGINEERING PROJECTS (IC-00P-DESTINATION SIGN) (IC-00-23) (ADD) (143) - 50011 TO 50044 HWB-511-SECTS ADDING PLOT TIME: 01-05-23, 9:50 PM



THIS WORK WAS PREPARED BY ME OR UNDER MY SUPERVISION
Kevin Mitchell
ENGINEER

STATE OF HAWAII
DEPARTMENT OF TRANSPORTATION
HIGHWAYS DIVISION

SIGN STRUCTURE HWB-511 SECTIONS


INTERSTATE ROUTE H-1 AND H-201
DESTINATION SIGN UPGRADE/REPLACEMENT, PHASE 3
FAP NO. NH-0300(144)

Scale: As Noted Date: Sept. 2022

SHEET No. S6.14 OF 14 SHEETS


1/3/23	△	Add. 1 - Revised callouts
DATE	REVISION	

FED. ROAD DIST. NO.	STATE	FEDERAL AID PROJ. NO.	FISCAL YEAR	SHEET NO.	TOTAL SHEETS
HAWAII	HAW.	NH-0300(144)	2023	ADD. 144	175

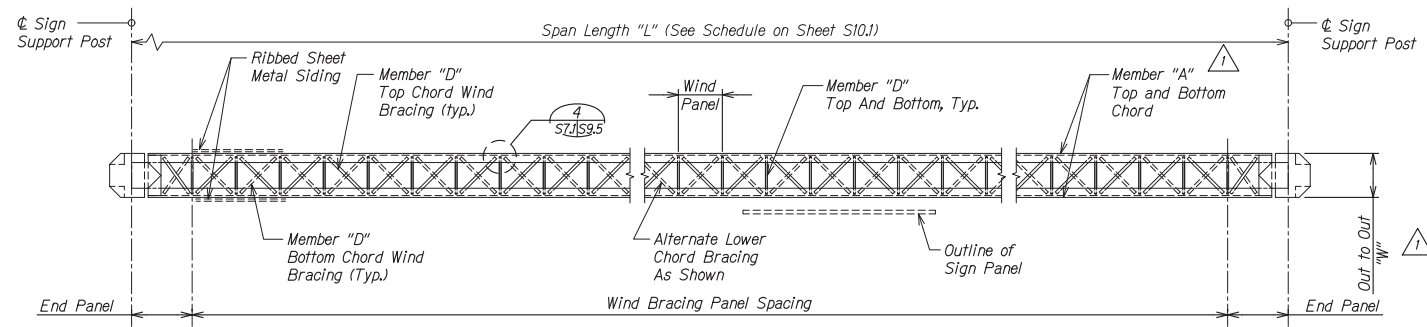

BOX TRUSS PLAN - TOP AND BOTTOM WIND BRACE FRAMING
 Scale: 3/8" = 1'-0"
 A
 S7J S7J


- NOTES:**
1. For sign structure schedule see sheet S10.1 and S10.2
 2. This sign structure type shall be paid for under "Type 1" as shown on the proposal schedule.

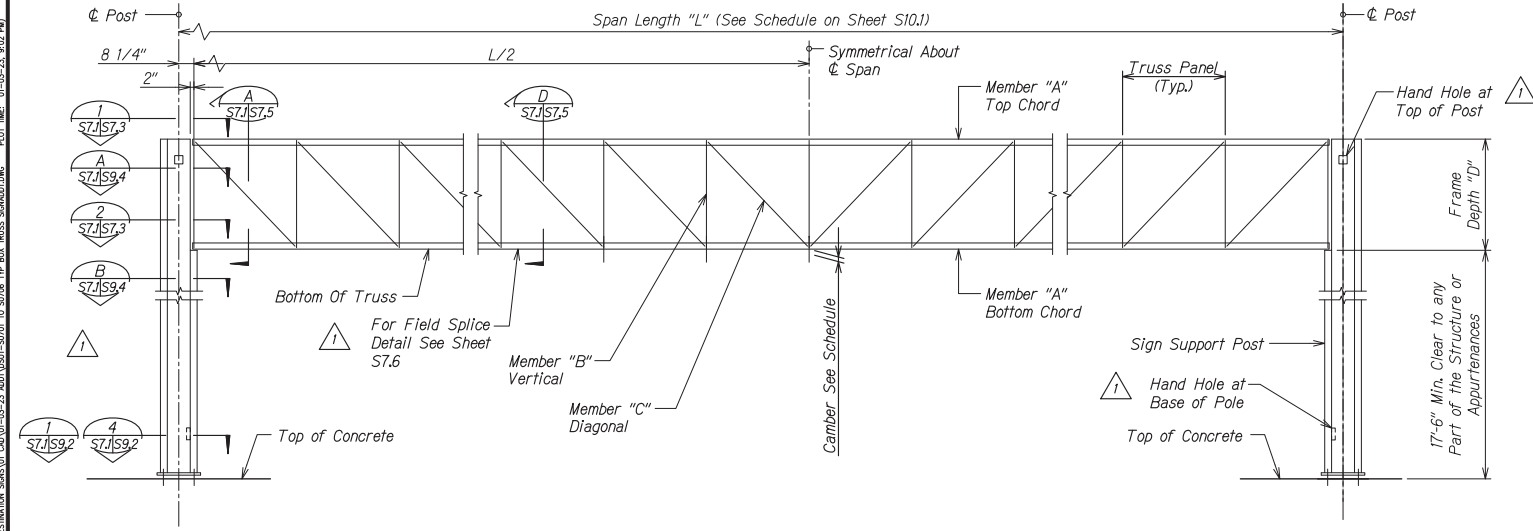

BOX TRUSS SIGN STRUCTURE ELEVATION
 Scale: 3/8" = 1'-0"
 B
 S7J S7J

DESIGNED BY	DATE
CHECKED BY	
APPROVED BY	
DATE	
PROJECT NO.	
SHEET NO.	
TOTAL SHEETS	

DRAWING NAME: 2.102 ENGINEERING PROJECTS (C-30P-DESTINATION SIGN) CADD (03-23) INDIVIDUAL-SHOW TO SHOW TOP BOX TRUSS SPACING TIME: 01-03-23, 8:52 PM

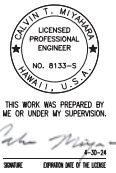

THIS WORK WAS PREPARED BY ME OR UNDER MY SUPERVISION
 Martin T. Milward
 LICENSED PROFESSIONAL ENGINEER
 STATE OF HAWAII

STATE OF HAWAII
 DEPARTMENT OF TRANSPORTATION
 HIGHWAYS DIVISION

**BOX TRUSS SIGN STRUCTURE
 PLAN AND ELEVATION**

INTERSTATE ROUTE H-1 AND H-201
 DESTINATION SIGN UPGRADE/REPLACEMENT, PHASE 3
 FAP NO. NH-0300(144)


Scale: As Noted Date: Sept. 2022
 SHEET No. S7J OF 7 SHEETS

1/3/23	1	Add. 1 - Revised callouts
DATE	REVISION	


FED. ROAD DIST. NO.	STATE	FEDERAL AID PROJ. NO.	FISCAL YEAR	SHEET NO.	TOTAL SHEETS
HAWAII	HAW.	NH-0300(144)	2023	ADD. 146	175

DRAWING NAME: 2-102 ENGINEERING OF PROJECTS (UC-DOT-DESTINATION SIGN) CAD(01-05-23 INDIVIDUAL)-SD(2) TO S(2026 TYP BOX TRUSS SIGN) DWG. PLOT TIME: 01-05-23, 8:42 PM

DESIGNED BY	DRAWN BY	CHECKED BY
APPROVED BY	DATE	
SCALE		

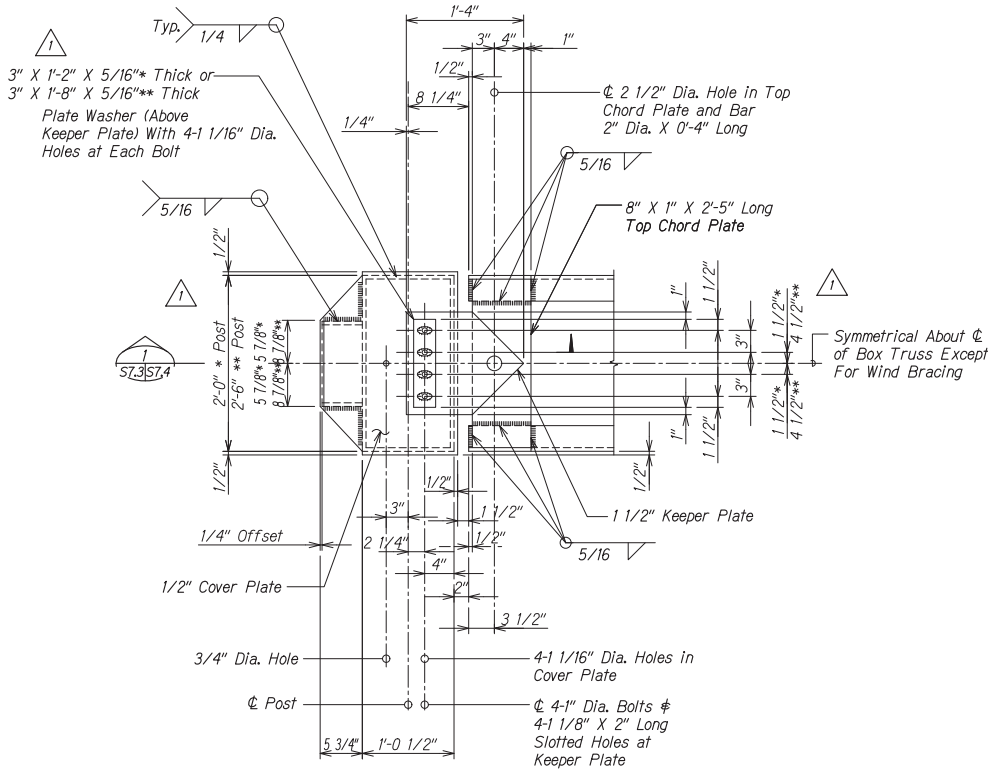

PLAN AT TOP OF COLUMN 1
Scale: 1 1/2" = 1'-0"

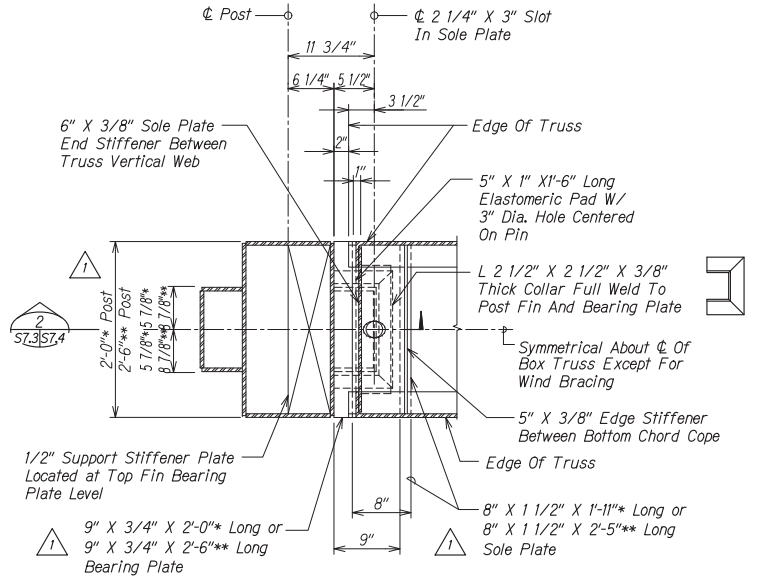

PLAN AT TRUSS BEARING SUPPORT 2
Scale: 1 1/2" = 1'-0"



THIS WORK WAS PREPARED BY ME OR UNDER MY SUPERVISION
Martin T. Milward
 ENGINEER EXPLANED AND SEAL

STATE OF HAWAII
 DEPARTMENT OF TRANSPORTATION
 HIGHWAYS DIVISION


**BOX TRUSS SIGN STRUCTURE
 DETAILS**

INTERSTATE ROUTE H-1 AND H-201
 DESTINATION SIGN UPGRADE/REPLACEMENT, PHASE 3
 FAP NO. NH-0300(144)


Scale: As Noted Date: Sept. 2022
 SHEET No. S7.3 OF 7 SHEETS

1/3/23	1	Add. 1 - Revised callouts
DATE		REVISION

FED. ROAD DIST. NO.	STATE	FEDERAL AID PROJ. NO.	FISCAL YEAR	SHEET NO.	TOTAL SHEETS
HAWAII	HAW.	NH-0300(144)	2023	ADD. 147	175

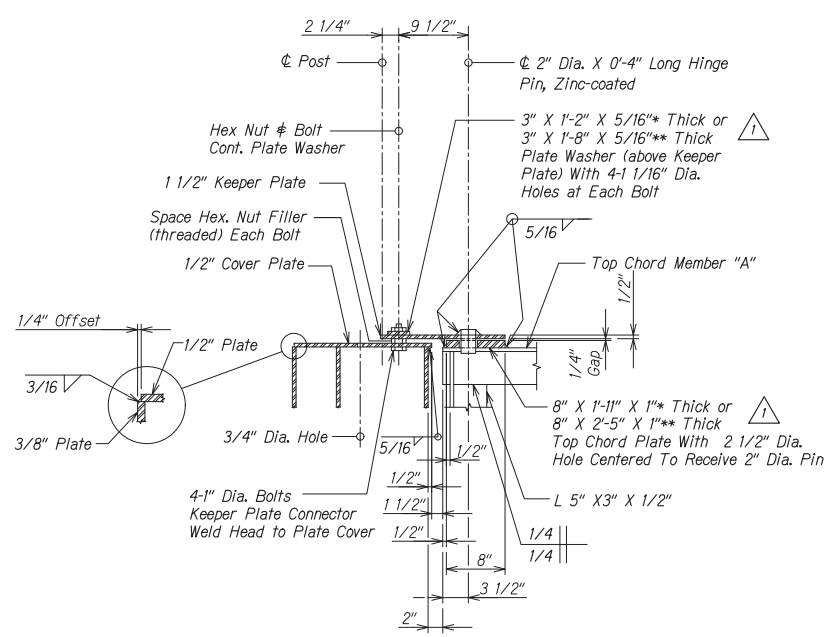

TYPICAL UPPER JUNCTURE CONNECTION DETAIL
 Scale: 1 1/2" = 1'-0"
 1
 S7.3 S7.4

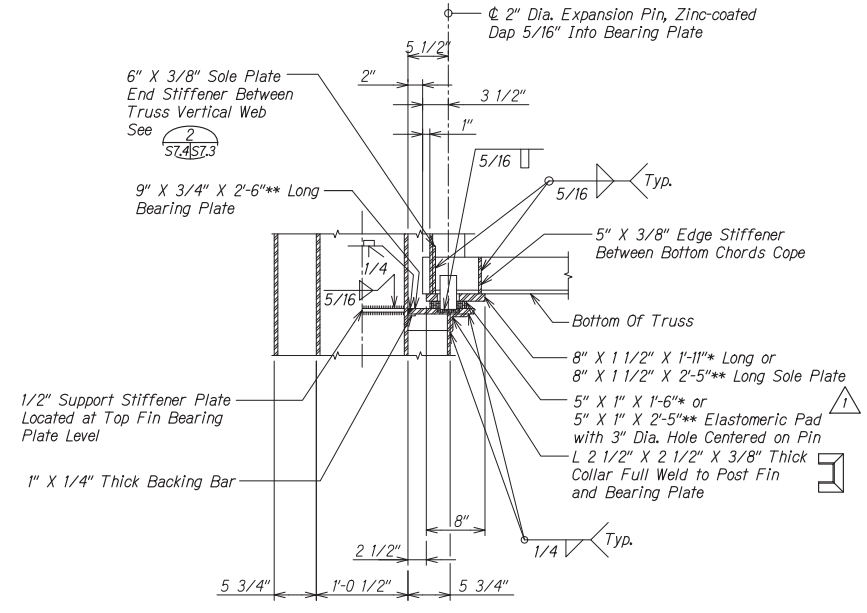

TYPICAL LOWER JUNCTURE CONNECTION DETAIL
 Scale: 1 1/2" = 1'-0"
 2
 S7.3 S7.4



THIS WORK WAS PREPARED BY ME OR UNDER MY SUPERVISION
Nathan T. Milward
 ENGINEER EXPIRES DATE 06-30-24

DESIGNED BY	DATE
DRAWN BY	
CHECKED BY	
APPROVED BY	
DATE	

DRAWING NAME: 2.102 ENGINEERING PROJECTS (C&D)-DESTINATION SIGNAGE CAD(1)-03-23 (REVISED) PLOT TIME: 01-10-23, 8:03 PM

1/3/23	1	Add. 1 - Revised callouts
DATE	REVISION	


STATE OF HAWAII
 DEPARTMENT OF TRANSPORTATION
 HIGHWAYS DIVISION

BOX TRUSS SIGN STRUCTURE DETAILS


INTERSTATE ROUTE H-1 AND H-201
 DESTINATION SIGN UPGRADE/REPLACEMENT, PHASE 3
 FAP NO. NH-0300(144)

Scale: As Noted Date: Sept. 2022
 SHEET No. S7.4 OF 7 SHEETS


FED. ROAD DIST. NO.	STATE	FEDERAL AID PROJ. NO.	FISCAL YEAR	SHEET NO.	TOTAL SHEETS
HAWAII	HAW.	NH-0300(144)	2023	ADD. 146	175

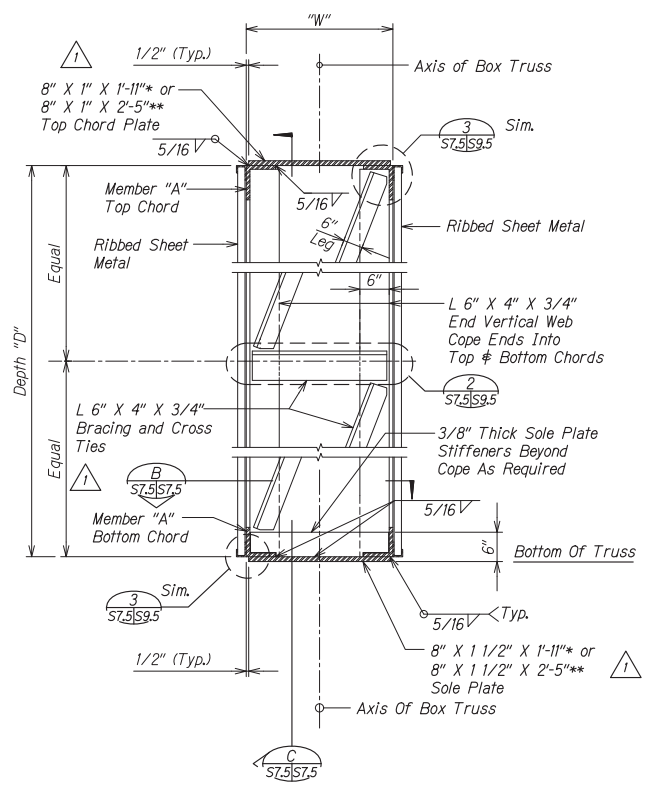


SECTION AT ENDS A
Scale: 1" = 1'-0"

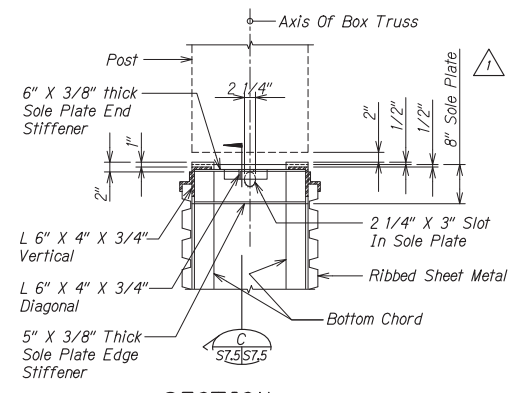

SECTION B
Scale: 1" = 1'-0"

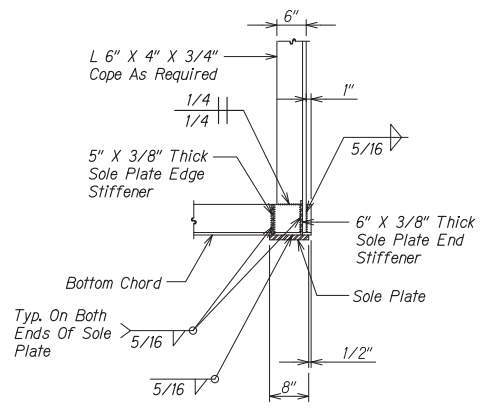

SECTION C
Scale: 1" = 1'-0"

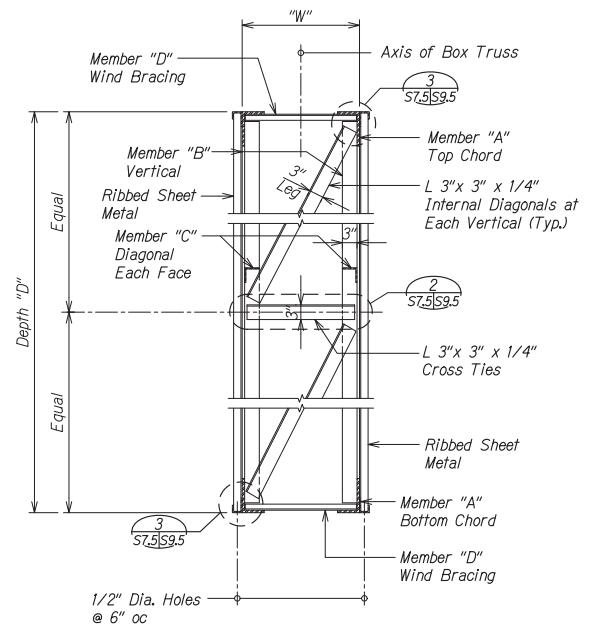


TYPICAL SECTION D
Scale: 1" = 1'-0"

- NOTES:**
1. See S7.1 for sign structure elevation.
 2. See S10.1 for sign structure schedule.

DESIGNED BY	DATE
DRAWN BY	
CHECKED BY	
APPROVED BY	

DRAWING NAME: 2.102 ENGINEER OF PROJECTS (E-CORP-DESTINATION SIGN) (ADD. 146-175) TO 50706 TYP. BOX TRUSS SPANDED TRUSS. PLOT TIME: 01-10-23, 8:43 PM

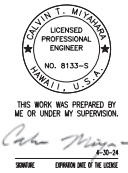

THIS WORK WAS PREPARED BY ME OR UNDER MY SUPERVISION
Kevin Milward
 ENGINEER

DATE	REVISION
1/3/23	1 Add. 1 - Revised callouts


STATE OF HAWAII
 DEPARTMENT OF TRANSPORTATION
 HIGHWAYS DIVISION

BOX TRUSS SIGN STRUCTURE SECTIONS

INTERSTATE ROUTE H-1 AND H-201
 DESTINATION SIGN UPGRADE/REPLACEMENT, PHASE 3
 FAP NO. NH-0300(144)


Scale: As Noted Date: Sept. 2022
 SHEET No. S7.5 OF 7 SHEETS

FED. ROAD DIST. NO.	STATE	FEDERAL AID PROJ. NO.	FISCAL YEAR	SHEET NO.	TOTAL SHEETS
HAWAII	HAW.	NH-0300(144)	2023	ADD. 149	175

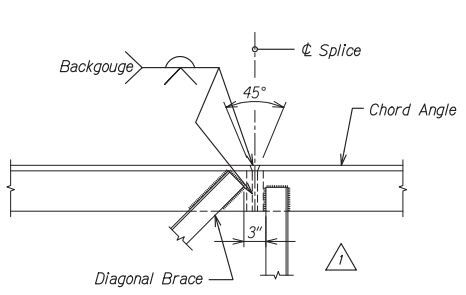


ELEVATION

TYPICAL SHOP SPLICE DETAIL 1
Scale: 1 1/2" = 1'-0"

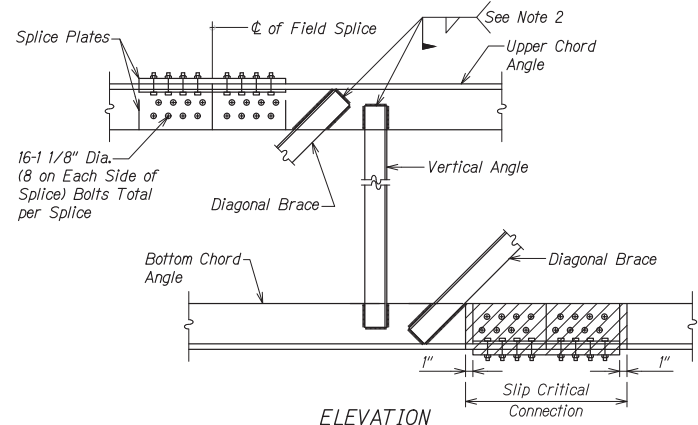

ELEVATION

1 TYPICAL FIELD SPLICE DETAIL 2
Scale: 1 1/2" = 1'-0"

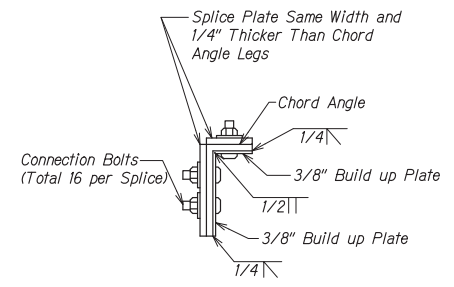

SECTION

SPLICE NOTES:

1. Splices are for signs with 2 posts. No splices are allowed for cantilever sign frames.
2. Splice location of top and bottom chords at each truss shall be staggered and at alternate locations. Submit splice locations on shop fabrication drawings to the Engineer for approval.
3. In no case shall splices be located at ends or near midspan of truss.
- 1 4. The build-up plates welded to the angle legs on the inside shall be welded before punching/drilling the bolt holes. They shall be the same length as the splice plate.
- 1 5. All galvanized metal surfaces damaged by field splice welding shall be properly cleaned, and repaired by a zinc-based solder in accordance with ASTM A780, and coated using the approved paint system.

1 LEGEND:

Do not shop paint. To be field painted following pre-tensioned bolting.

DESIGNED BY	DATE
CHECKED BY	
APPROVED BY	
SCALE	
PROJECT NO.	
DATE	

DRAWING NAME: Z:\03 ENGINEERING\PROJECTS\14-0300-DESTINATION SIGN\14-03-23 ADDITIONAL SHEETS TO 50706 TYP BOX TRUSS SIGNAGE.DWG PLOT TIME: 01-10-23, 3:04 PM



THIS WORK WAS PREPARED BY ME OR UNDER MY SUPERVISION
Martin T. Milward
ENGINEER EXAMINED DATE OF THE SEALS

STATE OF HAWAII
DEPARTMENT OF TRANSPORTATION
HIGHWAYS DIVISION

BOX TRUSS SIGN STRUCTURE
DETAIL


INTERSTATE ROUTE H-1 AND H-201
DESTINATION SIGN UPGRADE/REPLACEMENT, PHASE 3
FAP NO. NH-0300(144)

Scale: As Noted Date: Sept. 2022


SHEET No. S7.6 OF 7 SHEETS

1/3/23	1 Add. 1 - Revised Details
DATE	REVISION


FED. ROAD DIST. NO.	STATE	FEDERAL AID PROJ. NO.	FISCAL YEAR	SHEET NO.	TOTAL SHEETS
HAWAII	HAW.	NH-0300(144)	2023	ADD. 150	175

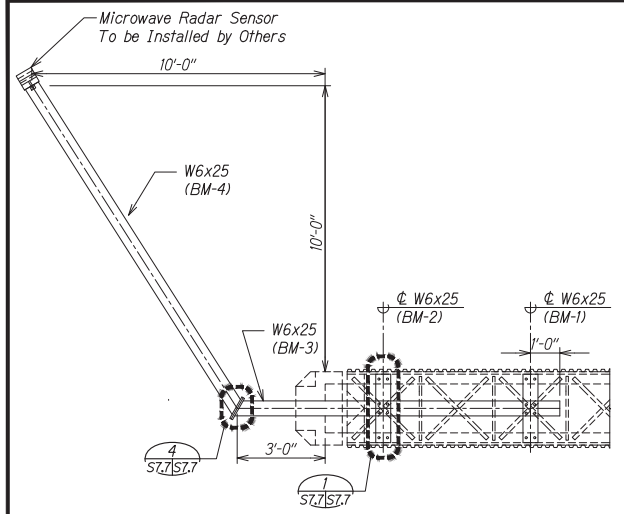


PLAN - HIEBR-253 AND HWB-505
Scale: 1/2" = 1'-0" A

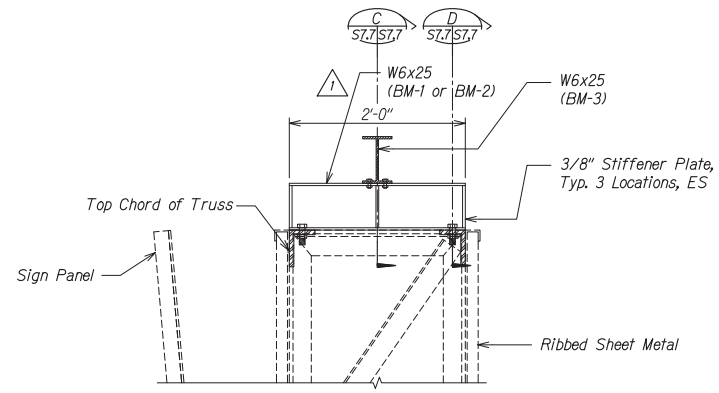


SECTION B
Scale: 1 1/2" = 1'-0" B

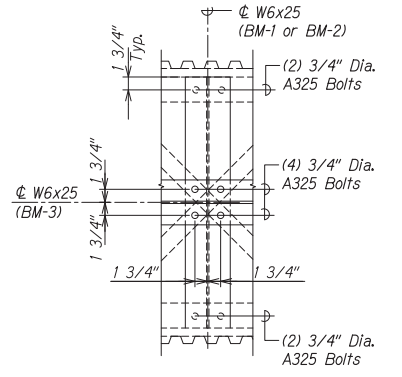


DETAIL 1
Scale: 1 1/2" = 1'-0" I

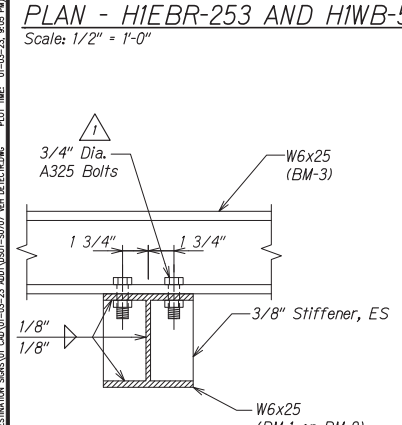


SECTION C
Scale: 3" = 1'-0" C

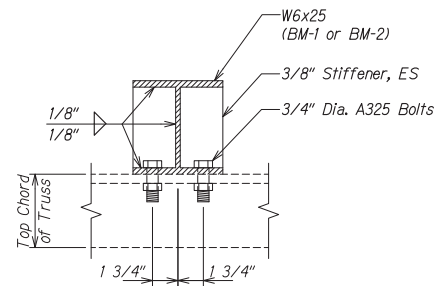

SECTION D
Scale: 3" = 1'-0" D

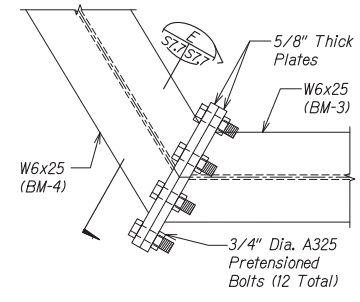

DETAIL 4
Scale: 3" = 1'-0" 4

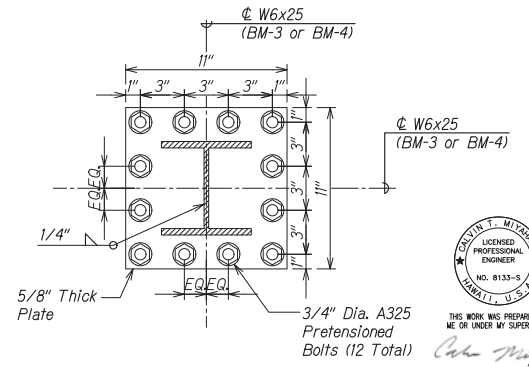


SECTION E
Scale: 3" = 1'-0" E

NOTE:

Ship W6x25 Beams and Hardware loose. To be field installed by General Contractor. Installation of Microwave Radar Sensors by others.

DESIGNED BY	DATE
CHECKED BY	
APPROVED BY	
SCALE	
PROJECT NO.	
DATE	

DRAWING NAME: 2.100 ENGINEERING PROJECTS (VENDOR DESTINATION SIGNAGE) CAD/03-03-23 MODIFIED-SHOW VENDOR DESTINATION SIGNAGE # 03-03-23 8:05 AM

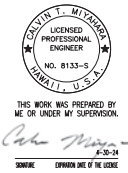

STATE OF HAWAII
DEPARTMENT OF TRANSPORTATION
HIGHWAYS DIVISION

BOX TRUSS SIGN STRUCTURE - MICROWAVE RADAR SUPPORT PLAN, SECTS., AND DETAILS


INTERSTATE ROUTE H-1 AND H-201
DESTINATION SIGN UPGRADE/REPLACEMENT, PHASE 3
FAP NO. NH-0300(144)

Scale: As Noted Date: Sept. 2022

SHEET No. S7.7 OF 7 SHEETS

DATE	REVISION
1/3/23	△ Add. 1 - Revised callouts

FED. ROAD DIST. NO.	STATE	FEDERAL AID PROJ. NO.	FISCAL YEAR	SHEET NO.	TOTAL SHEETS
HAWAII	HAW.	NH-0300(144)	2023	ADD. 151	175

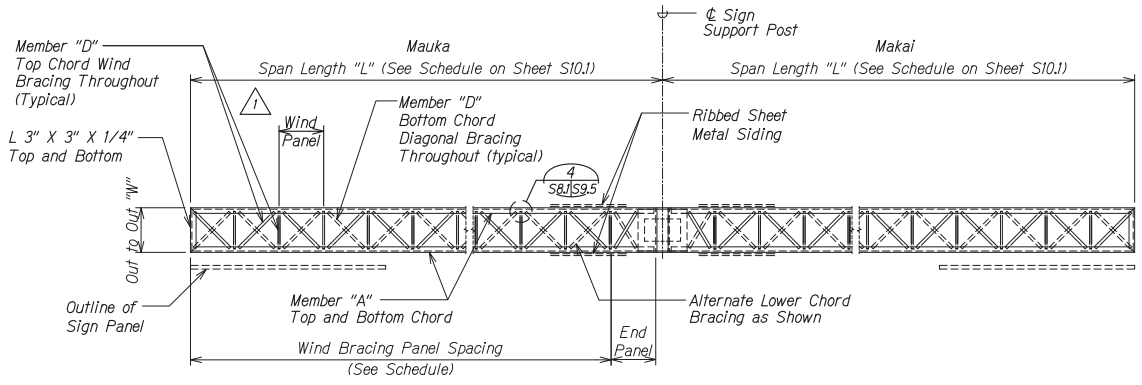


DOUBLE CANTILEVER BOX TRUSS PLAN - TOP AND BOTTOM WIND BRACE FRAMING
 Scale: 1/4" = 1'-0" A
S&J/S&J

- NOTES:**
- For sign structure schedule see sheets S10.1 and S10.2.
 - This sign structure type shall be paid for under "Type III" as shown on the proposal schedule.
 - Truss panels at each end are measured from back of angle at end vertical members to center angles at intermediate vertical members.

DRAWING NAME: 2.100 ENGINEERING PROJECTS (U.S. DESTINATION SIGNS) CAD/01-03-23 2023 INDIVIDUAL - S&J TO 5987 DEL CANTILEVER BOX TRUSS SIGN ASSEMBLING PLOT TIME: 01-03-23 9:05 AM

DESIGNED BY	DATE
CHECKED BY	DATE
APPROVED BY	DATE
DATE	

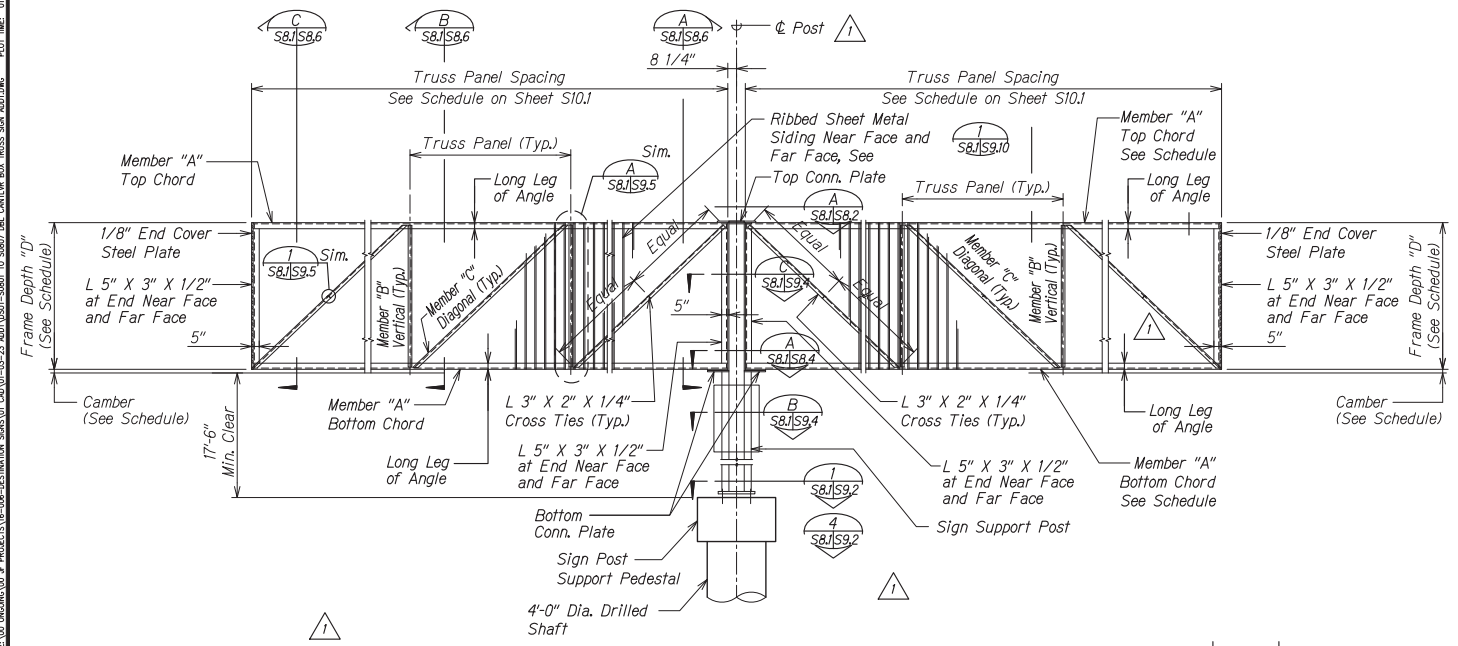

DOUBLE CANTILEVER BOX TRUSS ELEVATION
 Scale: 1/4" = 1'-0" B
S&J/S&J

DATE	REVISION
1/3/23	1 Add. 1 - Revised callouts


STATE OF HAWAII
 DEPARTMENT OF TRANSPORTATION
 HIGHWAYS DIVISION

DOUBLE CANTILEVER BOX TRUSS SIGN STRUCTURE
PLAN AND ELEVATION


INTERSTATE ROUTE H-1 AND H-201
 DESTINATION SIGN UPGRADE/REPLACEMENT, PHASE 3
 F&P NO. NH-0300(144)

Scale: As Noted Date: Sept. 2022


SHEET No. S&J OF 8 SHEETS

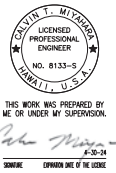

FED. ROAD DIST. NO.	STATE	FEDERAL AID PROJ. NO.	FISCAL YEAR	SHEET NO.	TOTAL SHEETS
HAWAII	HAW.	NH-0300(144)	2023	ADD. 152	175

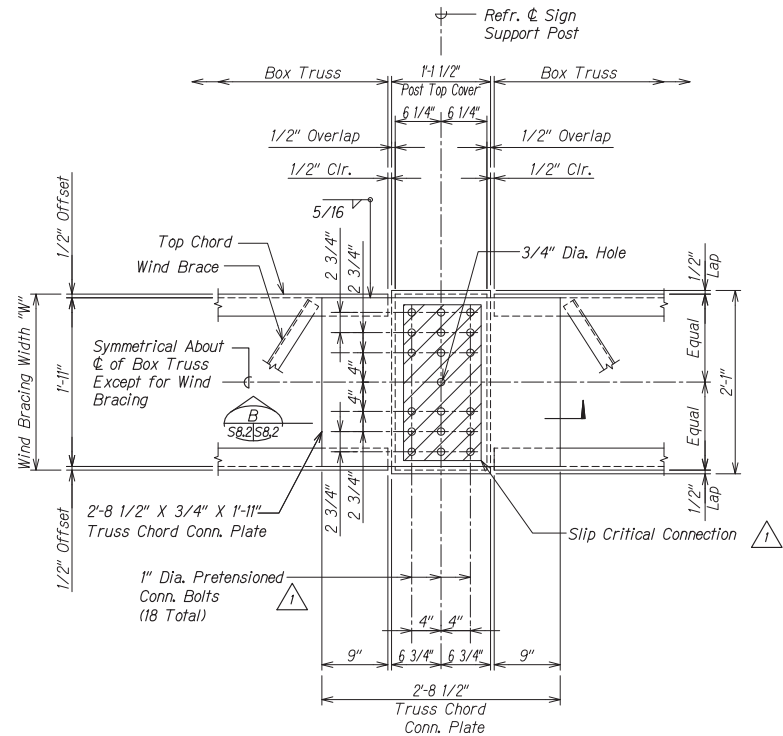

PLAN - SECTION AT TOP OF COLUMN A
 Scale: 1 1/2" = 1'-0" S8.1 S8.2

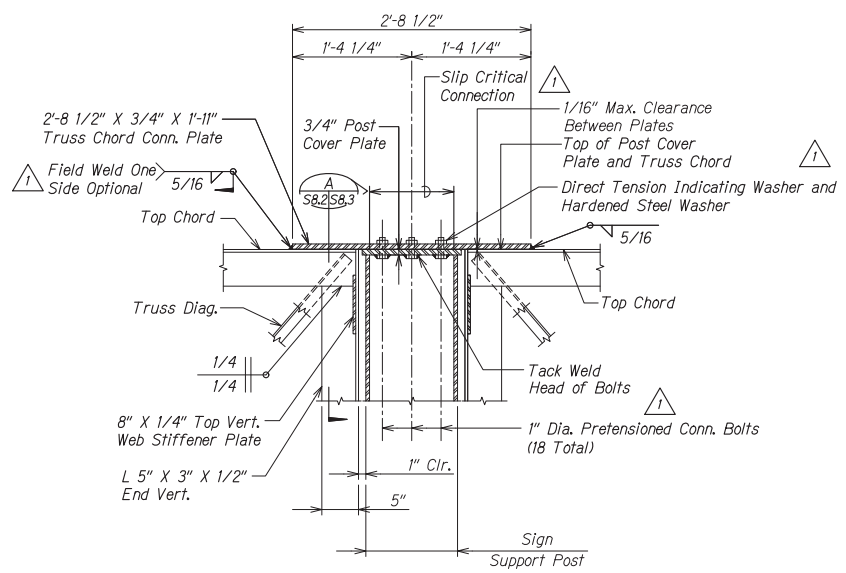

SECTION B
 Scale: 1 1/2" = 1'-0" S8.2 S8.2

LEGEND:


Do not shop paint top surface of truss chord conn. plate. To be field painted following pre-tensioned bolting. 1

NOTE:

All field welds shall be sufficiently cleaned, repaired using a zinc based solder in accordance with ASTM A780, and coated using the entire approved paint system.

DESIGNED BY	DATE
DRAWN BY	
CHECKED BY	
APPROVED BY	
SCALE	
NO.	

DRAWING NAME: 2-102 ENGINEERING PROJECTS (C-30P-DESTINATION SIGN) (C-01-03-23) (ADD. 152) TO 2022 DEL. CANTILEVER BOX TRUSS SIGN ASSEMBLY. PLOT TIME: 01-03-23 9:08 PM

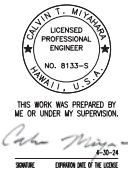

STATE OF HAWAII
 DEPARTMENT OF TRANSPORTATION
 HIGHWAYS DIVISION


DOUBLE CANTILEVER BOX TRUSS SIGN STRUCTURE
SECTIONS

INTERSTATE ROUTE H-1 AND H-201
 DESTINATION SIGN UPGRADE/REPLACEMENT, PHASE 3
 F.A.P. NO. NH-0300(144)

DATE: 1/3/23
 REVISION: 1 Add. 1 - Revised details

Scale: As Noted Date: Sept. 2022
 SHEET No. S8.2 OF 8 SHEETS

FED. ROAD DIST. NO.	STATE	FEDERAL AID PROJ. NO.	FISCAL YEAR	SHEET NO.	TOTAL SHEETS
HAWAII	HAW.	NH-0300(144)	2023	ADD. 153	175

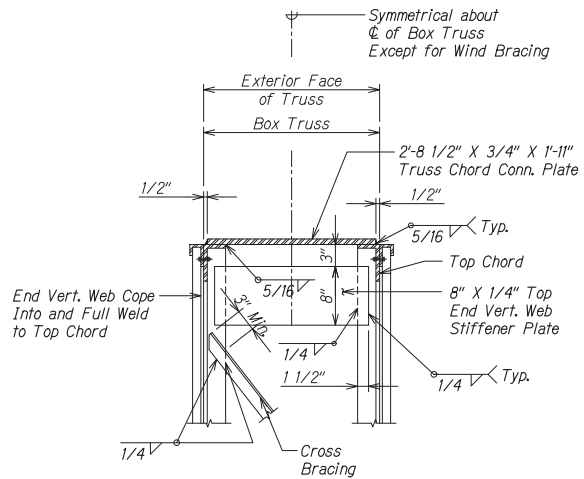

SECTION A
 Scale: 1 1/2" = 1'-0" S8.2 S8.3 1

DRAWING NAME: 2.102 ENGINEERING PROJECTS (IC-00P-DESTINATION SIGNS) (IC-00-03-23 ADDITIONAL SIGN) TO 20027 DEL CANTILEVER BOX TRUSS SIGN ASSEMBLY PLOT TIME: 01-05-23 9:08 PM

DESIGNED BY	DATE
DRAWN BY	
CHECKED BY	
APPROVED BY	
NO.	



THIS WORK WAS PREPARED BY ME OR UNDER MY SUPERVISION
Nathan T. Miyahara
 ENGINEER

1/3/23	1	Add. 1 - Revised callouts
DATE	REVISION	

STATE OF HAWAII
 DEPARTMENT OF TRANSPORTATION
 HIGHWAYS DIVISION



DOUBLE CANTILEVER BOX TRUSS SIGN STRUCTURE
SECTION

INTERSTATE ROUTE H-1 AND H-201
 DESTINATION SIGN UPGRADE/REPLACEMENT, PHASE 3
 FAP NO. NH-0300(144)

Scale: As Noted Date: Sept. 2022

SHEET No. S8.3 OF 8 SHEETS

FED. ROAD DIST. NO.	STATE	FEDERAL AID PROJ. NO.	FISCAL YEAR	SHEET NO.	TOTAL SHEETS
HAWAII	HAW.	NH-0300(144)	2023	ADD. 154	175

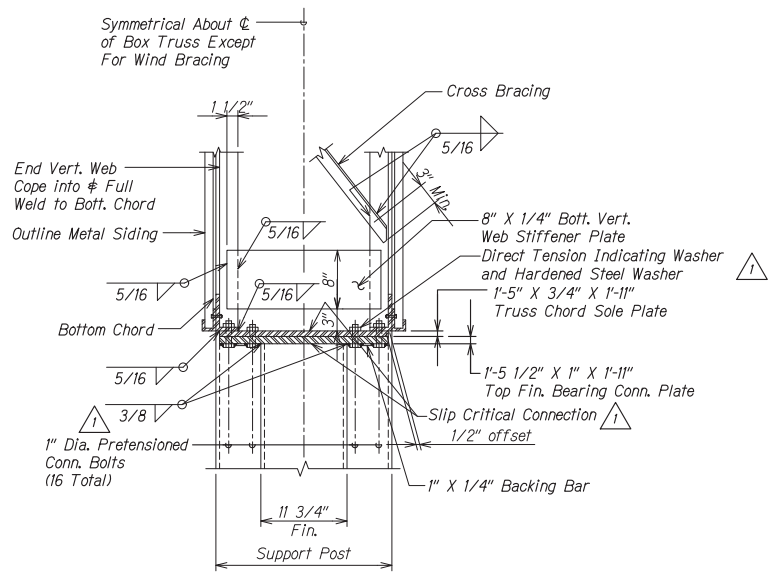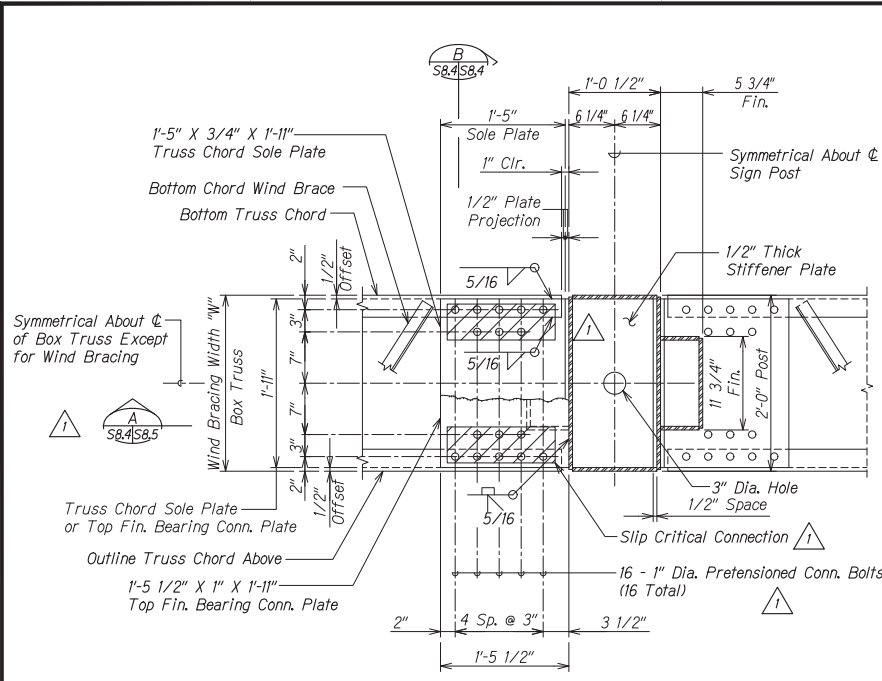

PLAN - SECTION AT TRUSS BEARING SUPPORT
Scale: 1 1/2" = 1'-0"

SECTION
Scale: 1 1/2" = 1'-0"



LEGEND:



Do not shop paint bottom of bearing conn. plate, top of truss chord sole plate, or ends of bottom chord. To be field painted following pre-tensioned bolting.


DESIGNED BY	CHECKED BY
DRAWN BY	APPROVED BY
SCALE	DATE
PROJECT NO.	SHEET NO.
TITLE	




THIS WORK WAS PREPARED BY ME OR UNDER MY SUPERVISION

STATE OF HAWAII DEPARTMENT OF TRANSPORTATION HIGHWAYS DIVISION	
DOUBLE CANTILEVER BOX TRUSS SIGN STRUCTURE SECTIONS	
INTERSTATE ROUTE H-1 AND H-201 DESTINATION SIGN UPGRADE/REPLACEMENT, PHASE 3 FAP NO. NH-0300(144)	
1/3/23	Add. 1 - Revised details
DATE	REVISION
Scale: As Noted Date: Sept. 2022	
SHEET No. S8.4 OF 8 SHEETS	


FED. ROAD DIST. NO.	STATE	FEDERAL AID PROJ. NO.	FISCAL YEAR	SHEET NO.	TOTAL SHEETS
HAWAII	HAW.	NH-0300(144)	2023	ADD. 155	175

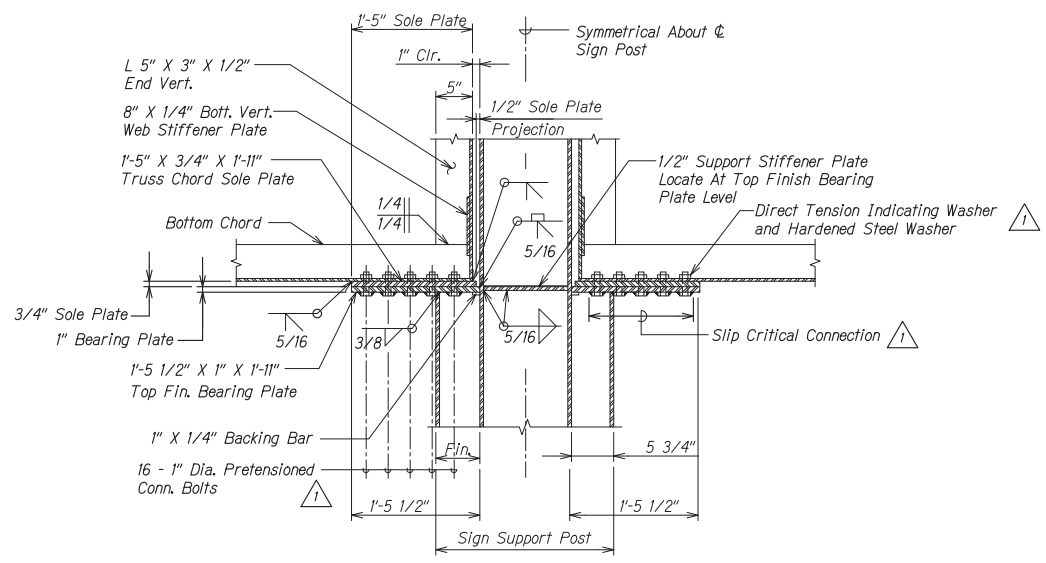

SECTION A
Scale: 1 1/2" = 1'-0" S8.4 S8.5

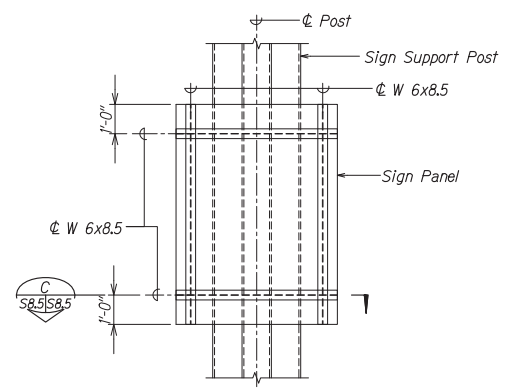


SECTION B
COLUMN MOUNT SIGN PANEL FRAMING ELEVATION
Scale: 1/2" = 1'-0" S8.5 S8.5

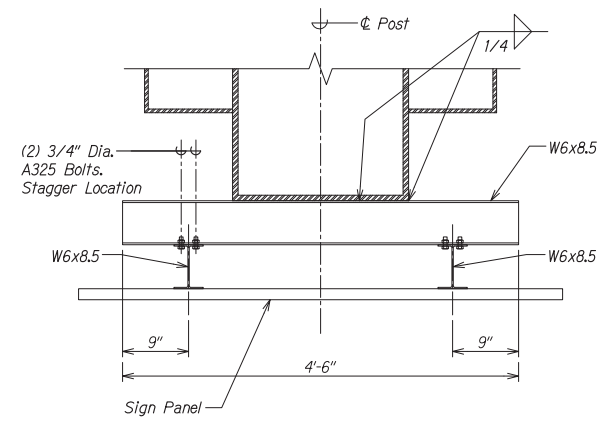

SECTION C
Scale: 1 1/2" = 1'-0" S8.5 S8.5

DESIGNED BY	DATE
CHECKED BY	
APPROVED BY	
SCALE	
PROJECT NO.	
DATE	
BY	
DATE	
BY	
DATE	
BY	
DATE	

DRAWING NAME: 2.100 ENGINEERING PROJECTS (E-300-DESTINATION SIGN) OF CATEGORY: E-300-23 (DESTINATION SIGN) TO 2007 DEL CANTILEVER BOX TRUSS SIGN ASSEMBLY PLOT TIME: 01-05-23 9:07 PM

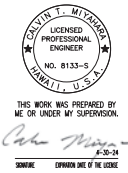

STATE OF HAWAII
DEPARTMENT OF TRANSPORTATION
HIGHWAYS DIVISION

DOUBLE CANTILEVER BOX TRUSS SIGN STRUCTURE SECTION


INTERSTATE ROUTE H-1 AND H-201
DESTINATION SIGN UPGRADE/REPLACEMENT, PHASE 3
FAP NO. NH-0300(144)

Scale: As Noted Date: Sept. 2022


SHEET No. S8.5 OF 8 SHEETS

DATE	REVISION
1/3/23	△ Add. 1 - Added details


FED. ROAD DIST. NO.	STATE	FEDERAL AID PROJ. NO.	FISCAL YEAR	SHEET NO.	TOTAL SHEETS
HAWAII	HAW.	NH-0300(144)	2023	ADD. 156	175

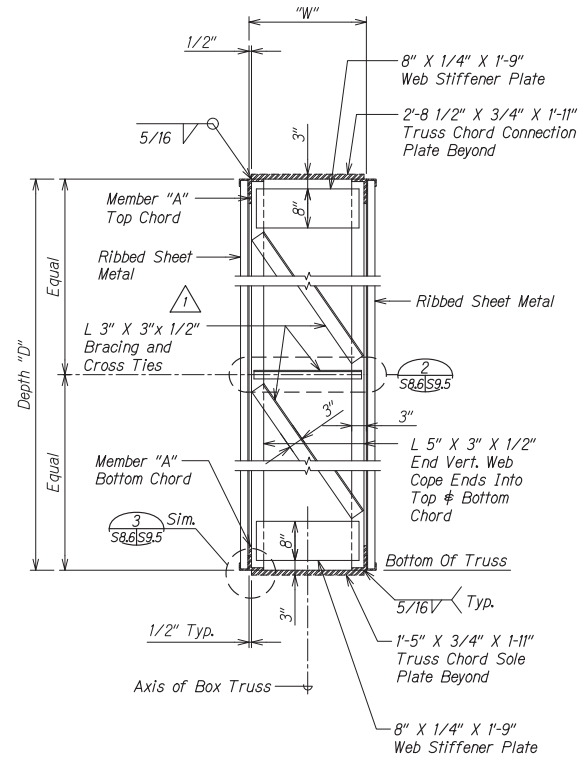

SECTION AT COLUMN END (A)
Scale: 1" = 1'-0"

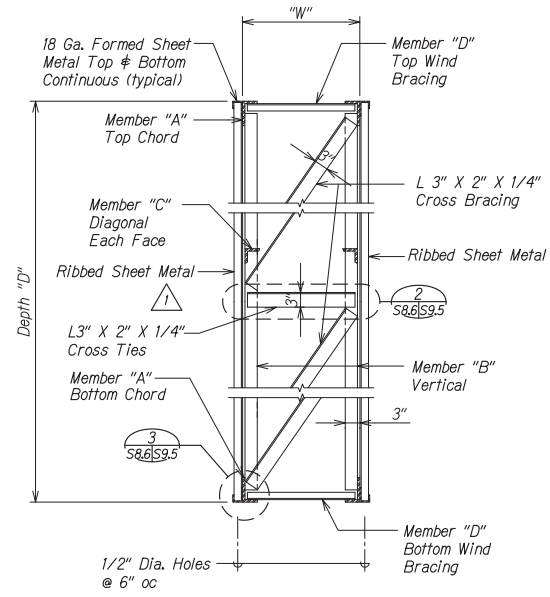


TYPICAL SECTION (B)
Scale: 1" = 1'-0"

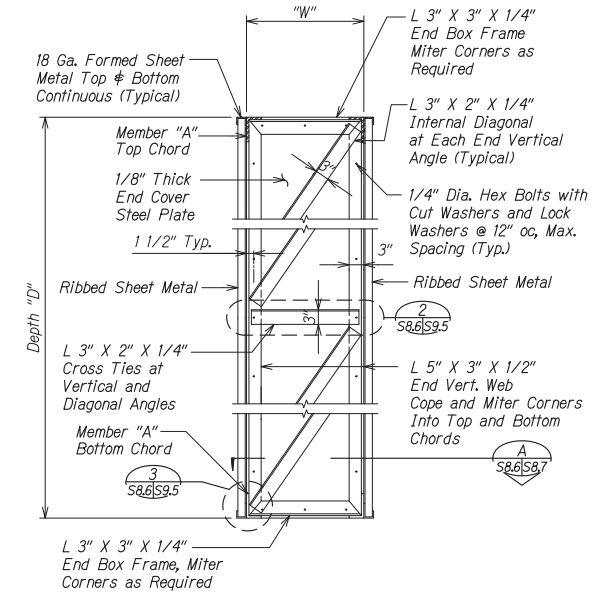

SECTION AT FREE END (C)
Scale: 1" = 1'-0"

DESIGNED BY	DATE
DRAWN BY	
CHECKED BY	
APPROVED BY	
SCALE	
PROJECT NO.	
DATE	

DRAWING NAME: 2.102 ENGINEERING PROJECTS (10-2023) DESTINATION SIGNAGE (10-2023) INDIVIDUAL SIGNAGE TO 5987 DEL CANTILEVER BOX TRUSS SIGN ASSEMBLY (10-2023) 8:17 PM

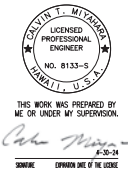

THIS WORK WAS PREPARED BY ME OR UNDER MY SUPERVISION
ENGINEER

STATE OF HAWAII
DEPARTMENT OF TRANSPORTATION
HIGHWAYS DIVISION

DOUBLE CANTILEVER BOX TRUSS SIGN STRUCTURE SECTIONS

INTERSTATE ROUTE H-1 AND H-201
DESTINATION SIGN UPGRADE/REPLACEMENT, PHASE 3
FAP NO. NH-0300(144)








DATE: 1/3/23
REVISION: Add. 1 - Revised callouts

Scale: As Noted
Date: Sept. 2022

SHEET No. S8.6 OF 8 SHEETS

DATE	REVISION
1/3/23	Add. 1 - Revised callouts

FED. ROAD DIST. NO.	STATE	FEDERAL AID PROJ. NO.	FISCAL YEAR	SHEET NO.	TOTAL SHEETS
HAWAII	HAW.	NH-0300(144)	2023	ADD. 158	175

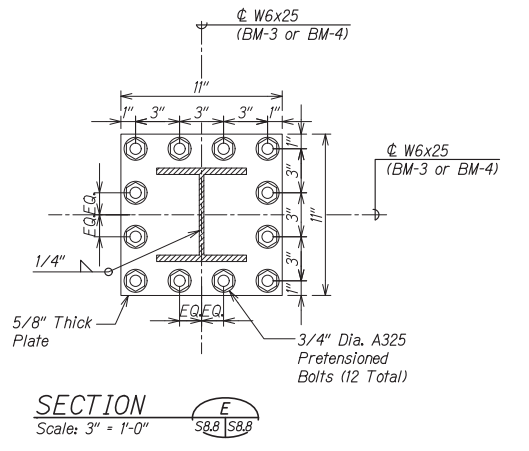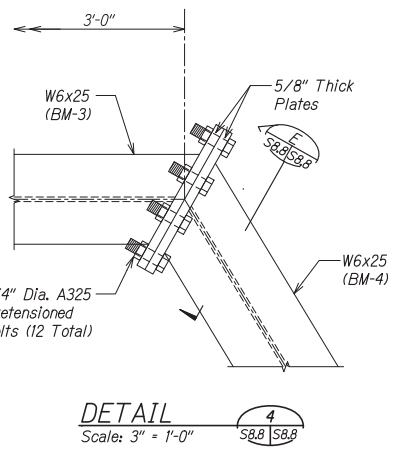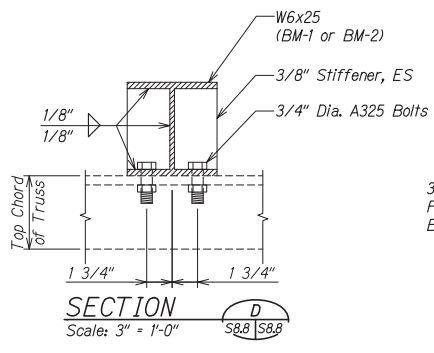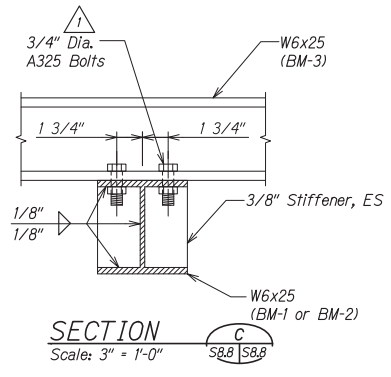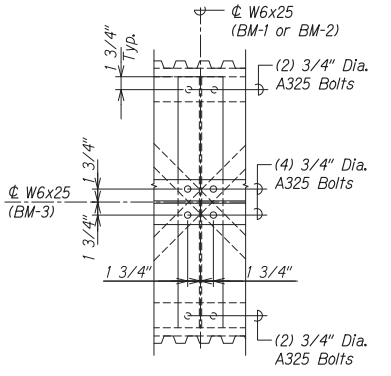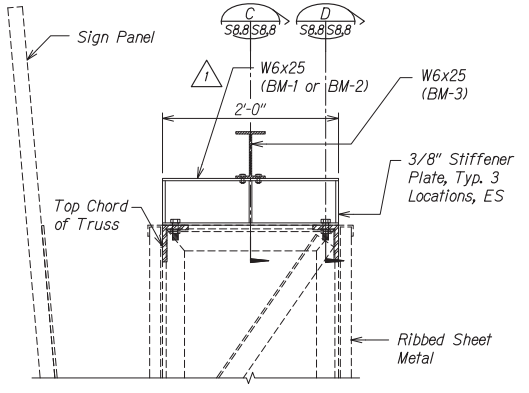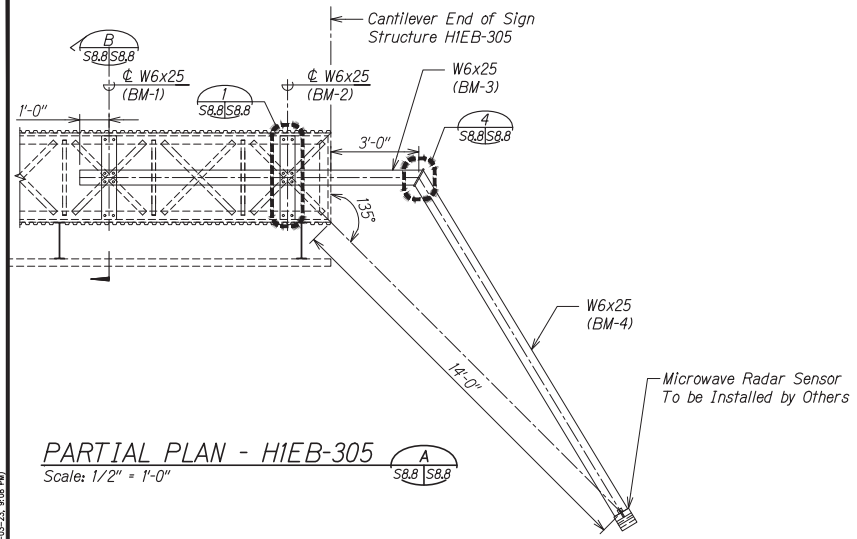

NOTE:

Ship W6x25 Beams and Hardware loose. To be field installed by General Contractor. Installation of Microwave Radar Sensors by others.

1/3/23	ADD. 1 - Revised callouts
DATE	REVISION

STATE OF HAWAII
DEPARTMENT OF TRANSPORTATION
HIGHWAYS DIVISION

THIS WORK WAS PREPARED BY ME OR UNDER MY SUPERVISION.

A-30-24
ENGINEER

STATE OF HAWAII
DEPARTMENT OF TRANSPORTATION
HIGHWAYS DIVISION

**DOUBLE CANTILEVER BOX TRUSS SIGN STRUCTURE
MICROWAVE RADAR SUPPORT PLAN, SECTS, AND DETAILS**

INTERSTATE ROUTE H-1 AND H-201
DESTINATION SIGN UPGRADE/REPLACEMENT, PHASE 3
FAP NO. NH-0300(144)






Scale: As Noted Date: Sept. 2022

SHEET No. **S8.8** OF 8 SHEETS


DESIGNED BY	DATE
CHECKED BY	DATE
APPROVED BY	DATE
DATE	

DRAWING NAME: 2-100 ENGINEERING PROJECTS (U.S. DESTINATION SIGN) CAD: 01-05-23 REVISED: 01-05-23, 02-08-24 PLOT TIME: 01-05-23, 9:28 AM

FED. ROAD DIST. NO.	STATE	FEDERAL AID PROJ. NO.	FISCAL YEAR	SHEET NO.	TOTAL SHEETS
HAWAII	HAW.	NH-0300(144)	2023	ADD. 159	175

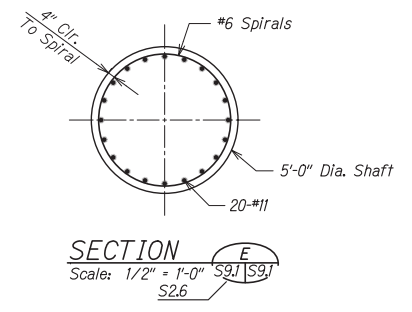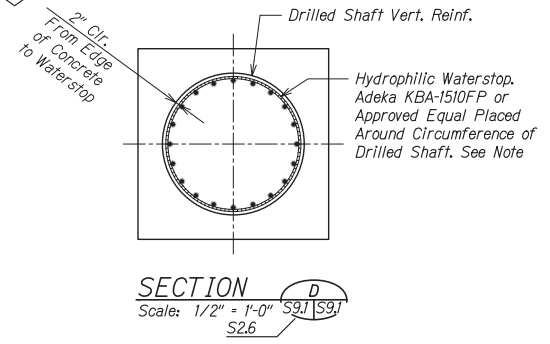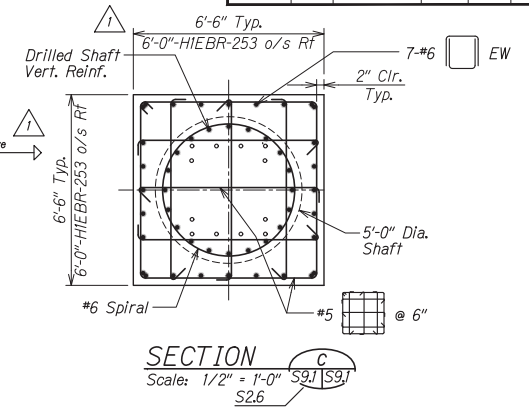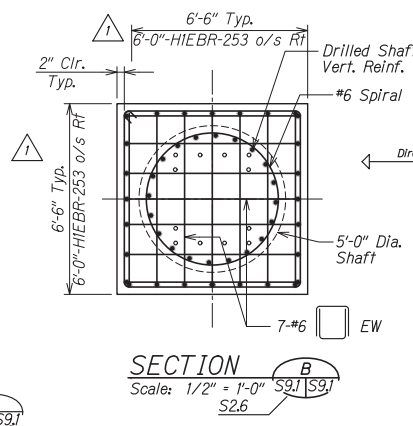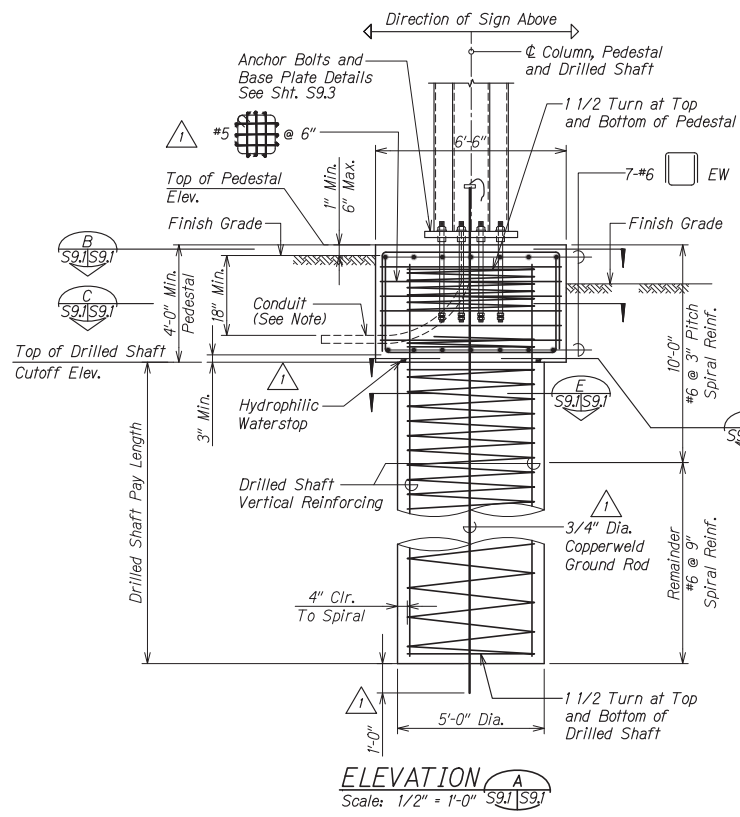

- NOTES:**
1. Install (2)-2" Dia. Conduits at Sign Structure HIEB-305 only.
 2. Grounding conductor shall be bonded to sign support as directed by the Engineer.
 3. Drilled shaft vertical reinforcing shall be placed so that it does not conflict with the anchor and anchor plates.
 4. Hydrophilic Waterstop shall be submitted to the Engineer for review and approval.

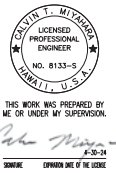

STATE OF HAWAII
DEPARTMENT OF TRANSPORTATION
HIGHWAYS DIVISION

TYPICAL DRILLED SHAFT AND PEDESTAL

INTERSTATE ROUTE H-1 AND H-201
DESTINATION SIGN UPGRADE/REPLACEMENT, PHASE 3
FAP NO. NH-0300(144)


Scale: As Noted Date: Sept. 2022
SHEET No. S9.1 OF 10 SHEETS

DATE	REVISION
1/3/23	1 Add. 1 - Revised details


DESIGNED BY	DATE
DRAWN BY	REVISED BY
CHECKED BY	APPROVED BY
IN CHARGE	

DRAWING NAME: 2.102 ENGINEERING PROJECTS (I-508-DESTINATION SIGN) (I-508-23 INDIVIDUAL SIGN) TYP. 05 PEDESTAL ADD. 159S. PL01 TIME: 01-10-23, 8:08 PM


FED. ROAD DIST. NO.	STATE	FEDERAL AID PROJ. NO.	FISCAL YEAR	SHEET NO.	TOTAL SHEETS
HAWAII	HAW.	NH-0300(144)	2023	ADD. 160	175

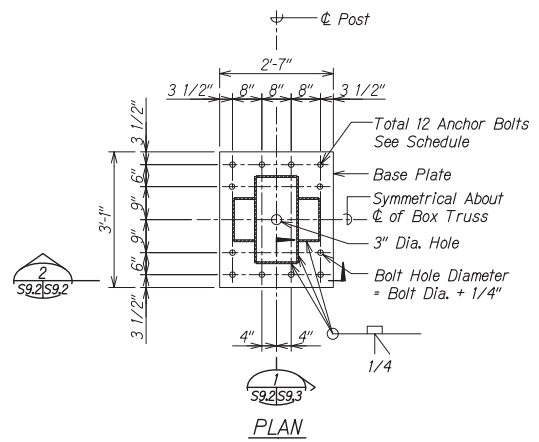


TYPICAL BASE PLATE DETAIL
"W"=2'-0" FOR BOX TRUSS STRUCTURE
 Not to Scale

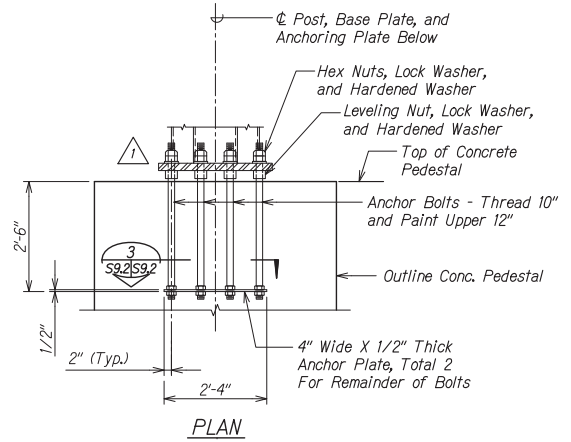


ANCHORAGE DETAIL
"W"=2'-0" FOR BOX TRUSS STRUCTURE
 Not to Scale

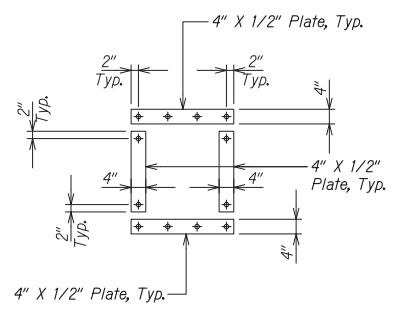


SECTION 3
 Not to Scale S9.2 | S9.2

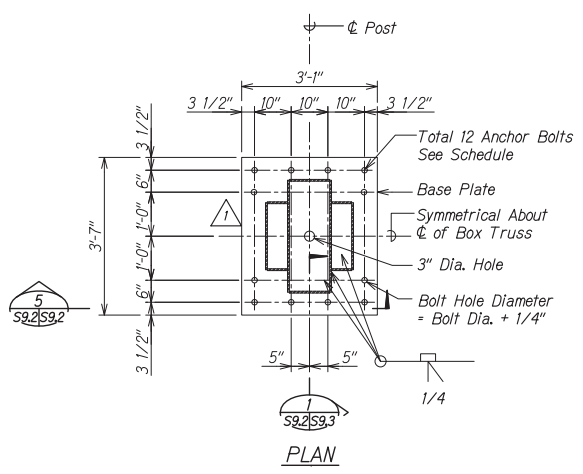

BASE PLATE DETAIL
"W"=2'-6" FOR BOX TRUSS STRUCTURE
 Not to Scale

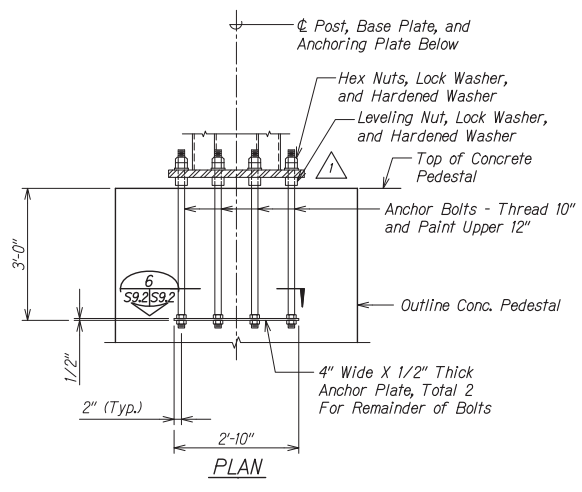

TYPICAL ANCHORAGE DETAIL
"W"=2'-6" FOR BOX TRUSS STRUCTURE
 Not to Scale

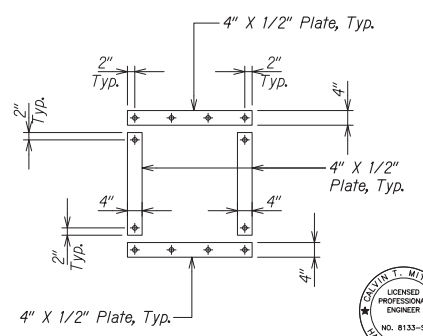

SECTION 6
 Not to Scale S9.2 | S9.2



THIS WORK WAS PREPARED BY ME OR UNDER MY SUPERVISION
 LICENSED PROFESSIONAL ENGINEER
 NO. 8133-S
 HAWAII, U.S.A.
 SIGNED: [Signature] EXPIRES: [Date]

STATE OF HAWAII
 DEPARTMENT OF TRANSPORTATION
 HIGHWAYS DIVISION

TYPICAL BASE PLATE AND ANCHOR BOLT DETAILS

INTERSTATE ROUTE H-1 AND H-201
 DESTINATION SIGN UPGRADE/REPLACEMENT, PHASE 3
 FAP NO. NH-0300(144)


Scale: As Noted Date: Sept. 2022
 SHEET No. S9.2 OF 10 SHEETS

DATE	REVISION
1/3/23	1 Add. 1 - Revised callouts


DESIGNED BY	SAFETY CHECKED BY
DRAWN BY	REVIEWED BY
IN CHARGE BY	APPROVED BY
DATE	

DRAWING NAME: 2.100 ENGINEERING PROJECTS (U.S. DESTINATION SIGN) CAD/01-03-23 INDIVIDUAL-SIGNED TYP. DIMS. ADD/FORM. PLOT TIME: 01-03-23, 8:06 PM

FED. ROAD DIST. NO.	STATE	FEDERAL AID PROJ. NO.	FISCAL YEAR	SHEET NO.	TOTAL SHEETS
HAWAII	HAW.	NH-0300(144)	2023	ADD. 161	175

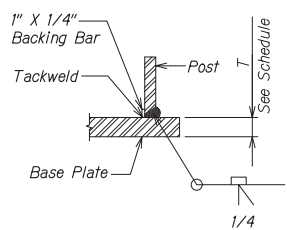


TYPICAL POST TO BASE PLATE WELDING DETAIL
 Not to Scale 1
 S9.2 | S9.3

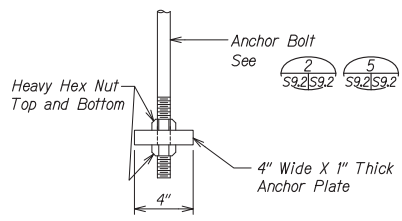

ANCHOR PLATE DETAIL
 Not to Scale 2
 S9.3 | S9.3

Provide Welded Galvanized Cloth 1/16" X 7/16" Square. Wrap Around Base Plate Perimeter with 3" Min. Lap. Fasten with 1/4" Dia. Capscrew ASTM F593 with SS Washer Spaced at Approx. 9" oc. Drilled and Tapped into Perimeter of Base Plate

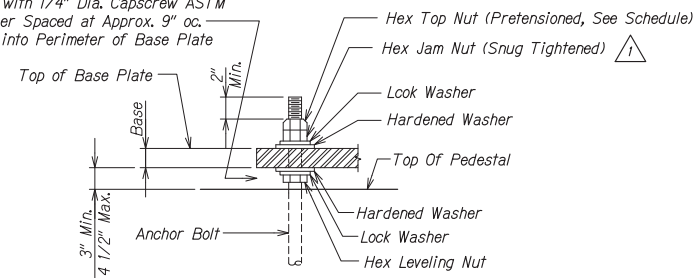

TYPICAL BASE PLATE ANCHOR BOLT CONNECTION DETAIL
 Not to Scale 3
 S9.2 | S9.3

DESIGNED BY	DATE
DRAWN BY	
CHECKED BY	
APPROVED BY	
SCALE	
PROJECT NO.	
SHEET NO.	

DRAWING NAME: 2.102 ENGINEERING PROJECTS (IC-00P-DESTINATION SIGN) (IC-03-23) (INDIVIDUAL SIGN) (TP DLS ADD) (PME) PLOT TIME: 01-05-23, 8:08 PM



THIS WORK WAS PREPARED BY ME OR UNDER MY SUPERVISION
Coke Moran
 ENGINEER IN CHARGE OF THE WORK

STATE OF HAWAII
 DEPARTMENT OF TRANSPORTATION
 HIGHWAYS DIVISION

TYPICAL BASE PLATE AND ANCHOR BOLT DETAILS


INTERSTATE ROUTE H-1 AND H-201
 DESTINATION SIGN UPGRADE/REPLACEMENT, PHASE 3
 FAP NO. NH-0300(144)

Scale: As Noted Date: Sept. 2022


SHEET No. S9.3 OF 10 SHEETS

1/3/23	△ Add. 1 - Revised details
DATE	REVISION


FED. ROAD DIST. NO.	STATE	FEDERAL AID PROJ. NO.	FISCAL YEAR	SHEET NO.	TOTAL SHEETS
HAWAII	HAW.	NH-0300(144)	2023	ADD. 162	175

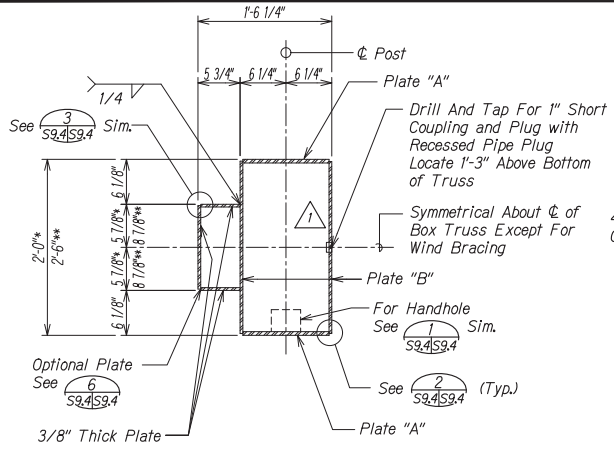


TYPICAL COLUMN SECTION ABOVE BEARING SUPPORT
 Not to Scale
 S7J | S9.4

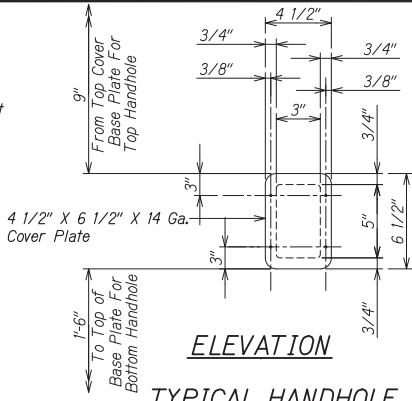


TYPICAL HANDHOLE AND COVER PLATE DETAIL
 Not to Scale
 S9.4 | S9.4

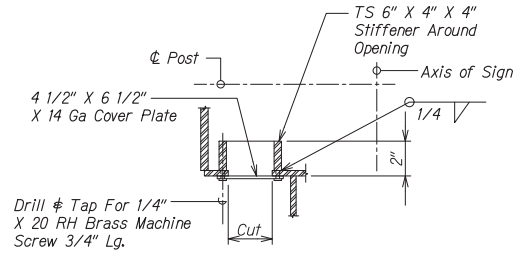


SECTION

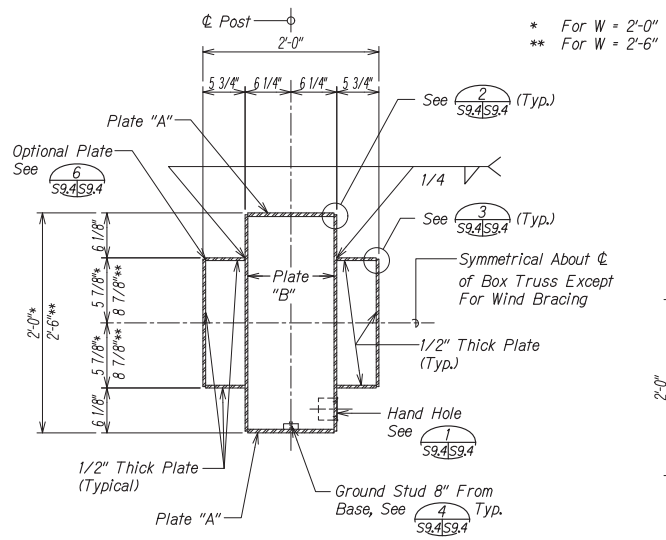


TYPICAL COLUMN SECTION BELOW BEARING SUPPORT
 Not to Scale
 S8J | S7J | S9.4

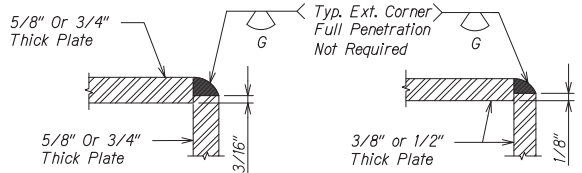


CONN. DETAIL
 Not to Scale
 S9.4 | S9.4

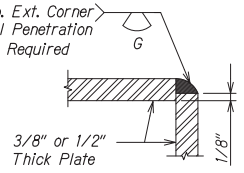

CONN. DETAIL
 Not to Scale
 S9.4 | S9.4

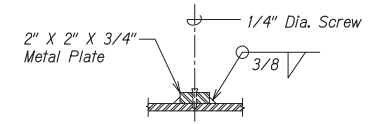


TYPICAL GROUND STUD DETAIL
 Not to Scale
 S9.4 | S9.4

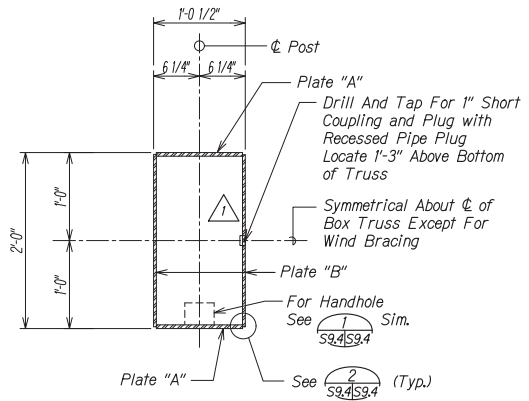

DOUBLE CANTILEVER COLUMN SECTION ABOVE BEARING SUPPORT
 Not to Scale
 S8J | S7J | S9.4

DESIGNED BY	SAFETY CHECKED BY
DRAWN BY	REVIEWED BY
CHECKED BY	APPROVED BY
DATE	

DRAWING NAME: 2-102 ENGINEERING PROJECTS (C-306) DESTINATION SIGNAGE (C-101-103-104) INDIVIDUAL SIGNAGE TYP. DTL'S ADDITONE PLOT TIME: 01-10-23, 9:10 PM

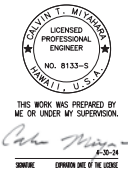

STATE OF HAWAII
 DEPARTMENT OF TRANSPORTATION
 HIGHWAYS DIVISION


TYPICAL COLUMN SECTIONS AND DETAILS

INTERSTATE ROUTE H-1 AND H-201
 DESTINATION SIGN UPGRADE/REPLACEMENT, PHASE 3
 FAP NO. NH-0300(144)


Scale: As Noted Date: Sept. 2022
 SHEET No. S9.4 OF 10 SHEETS

DATE	REVISION
1/3/23	△ Add. 1 - Revised details


FED. ROAD DIST. NO.	STATE	FEDERAL AID PROJ. NO.	FISCAL YEAR	SHEET NO.	TOTAL SHEETS
HAWAII	HAW.	NH-0300(144)	2023	ADD. 163	175

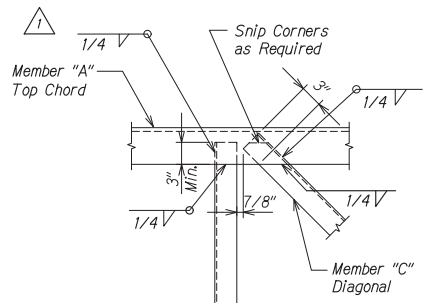



TYPICAL SECTION A
Not to Scale
S8.1 S7.2 S9.5

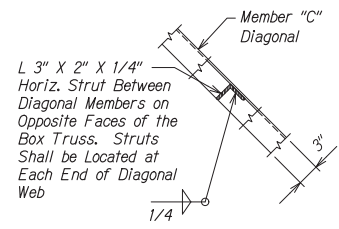


TYP. CONN. DETAIL 1
Not to Scale
S8.1 S7.2 S9.5

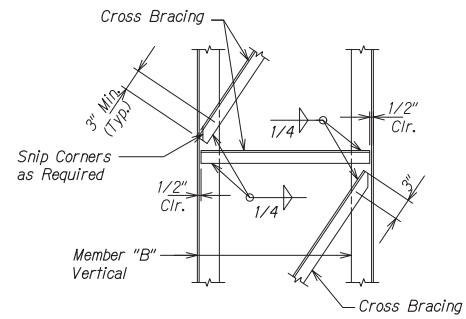

TYP. DETAIL 2
Not to Scale
S8.6 S7.5 S9.5

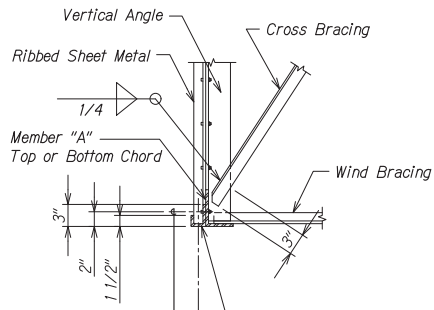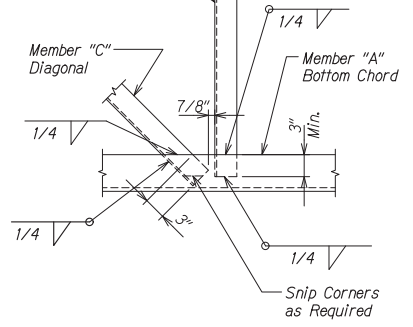

TYPICAL DIAGONAL CROSS BRACING CONNECTION DETAIL 3
Not to Scale
S8.6 S7.5 S9.5

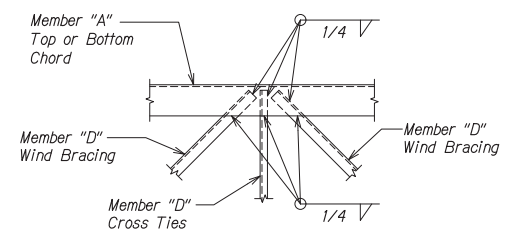

TYPICAL TOP AND BOTTOM WIND BRACING CONNECTION DETAIL 4
Not to Scale
S8.1 S7.2 S9.5

NOTE:
At top chord similar except as noted.



THIS WORK WAS PREPARED BY ME OR UNDER MY SUPERVISION
DATE: 9-20-24
SCALE: DRAWING DATE: 9-20-24

DESIGNED BY	DATE
CHECKED BY	
APPROVED BY	
DATE	

DRAWING NAME: 2.102 ENGINEERING PROJECTS (U.S. DESTINATION SIGNAGE) CAD/01-03-23 INDIVIDUAL-SIGNED TYP. DLS ADD/FORME PLOT TIME: 01-03-23, 9:10 PM

DATE	REVISION
1/3/23	1 Add. 1 - Revised callouts

STATE OF HAWAII
DEPARTMENT OF TRANSPORTATION
HIGHWAYS DIVISION


TYPICAL CONNECTION DETAILS

INTERSTATE ROUTE H-1 AND H-201
DESTINATION SIGN UPGRADE/REPLACE, PHASE 3
FAP NO. NH-0300(144)


Scale: As Noted Date: Sept. 2022

SHEET No. S9.5 OF 10 SHEETS

FED. ROAD DIST. NO.	STATE	FEDERAL AID PROJ. NO.	FISCAL YEAR	SHEET NO.	TOTAL SHEETS
HAWAII	HAW.	NH-0300(144)	2023	ADD. 164	175

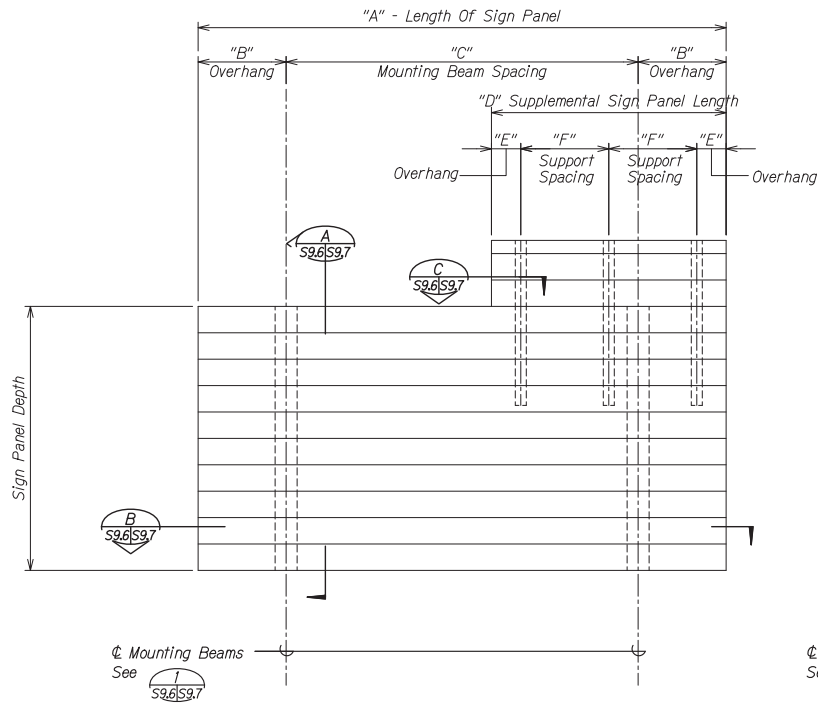

SIGN PANEL LENGTH 5'-0" TO 14'-0"

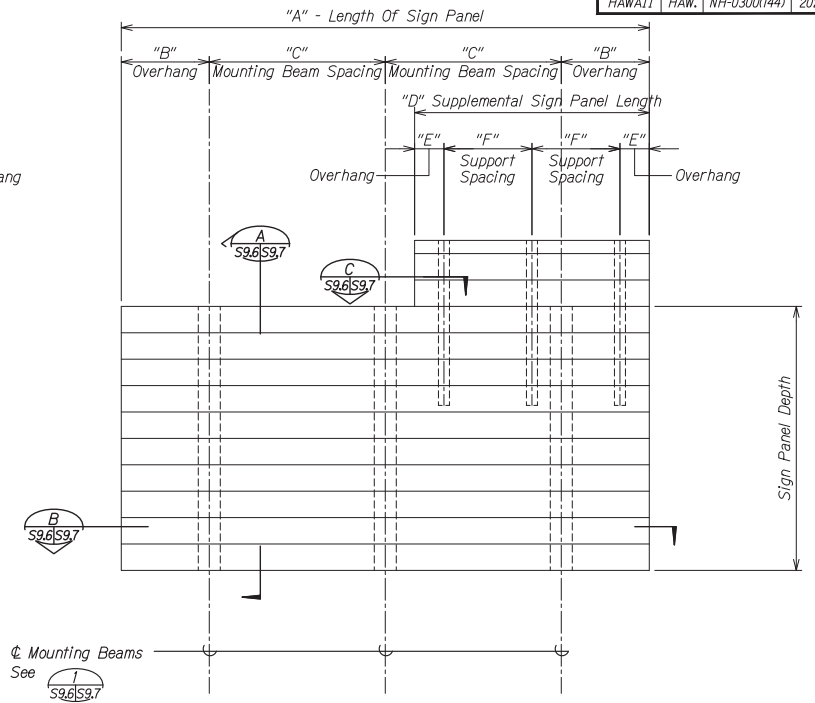

SIGN PANEL LENGTH 15'-0" TO 29'-0" \triangle

TYPICAL SIGN PANEL ELEVATION \triangle
Not to Scale

- NOTES:
- See schedule on sheet S9.7 for "A", "B", and "D" dimensions.

DESIGNED BY	DATE
DRAWN BY	
CHECKED BY	
APPROVED BY	
SCALE	
PROJECT NO.	
SHEET NO.	

DRAWING NAME: 2.102 ENGINEERING PROJECTS (U.S. DESTINATION SIGNS) CAD/01-03-23 (REVISED) - SOME TYP DITS ADD/CHANGE PLOT TIME: 01-03-23, 9:11 PM



THIS WORK WAS PREPARED BY ME OR UNDER MY SUPERVISION
ENGINEER

STATE OF HAWAII
DEPARTMENT OF TRANSPORTATION
HIGHWAYS DIVISION

TYPICAL SIGN PANEL ELEVATION



INTERSTATE ROUTE H-1 AND H-201
DESTINATION SIGN UPGRADE/REPLACEMENT, PHASE 3
FAP NO. NH-0300(144)

Scale: As Noted Date: Sept. 2022

SHEET No. S9.6 OF 10 SHEETS

1/3/23	\triangle Add. 1 - Revised panel length
DATE	REVISION


FED. ROAD DIST. NO.	STATE	FEDERAL AID PROJ. NO.	FISCAL YEAR	SHEET NO.	TOTAL SHEETS
HAWAII	HAW.	NH-0300(144)	2023	ADD. 165	175

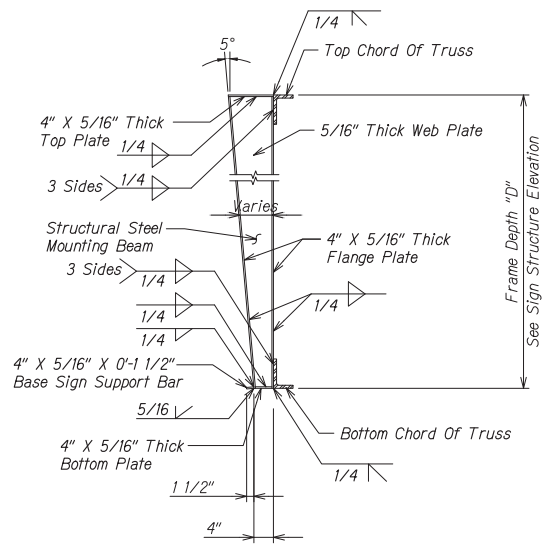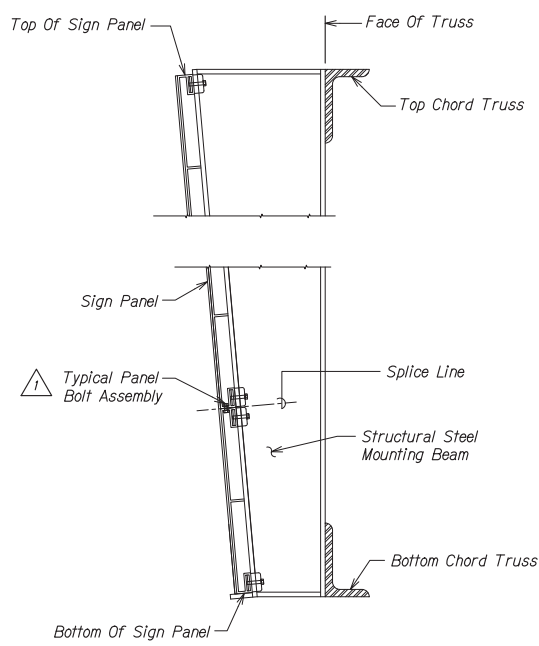


TYPICAL MOUNTING BEAM DETAIL
Not to Scale 1 S9.6/S9.7

MOUNTING BEAM SCHEDULE				SUPPLEMENTAL SIGN PANEL SUPPORT SCHEDULE			
Sign Panel Length "A"	Number of Mounting Beams	Overhang "B"	Mounting Beam Spacing "C"	Supplemental Sign Panel Length "D"	Number of Supports	Overhang "E"	Support Spacing "F"
5'-0"	2	6"	4'-0"	9'-0"	3	6" Min. 12" Max.	3'-6" Min. 4'-0" Max.
6'-0"	2	6"	5'-0"				
7'-0"	2	12"	5'-0"				
8'-0"	2	12"	6'-0"				
9'-0"	2	12"	7'-0"				
10'-0"	2	18"	7'-0"				
11'-0"	2	18"	8'-0"				
12'-0"	2	24"	8'-0"				
13'-0"	2	24"	9'-0"				
14'-0"	2	24"	10'-0"				
15'-0"	3	6"	7'-0"				
16'-0"	3	6"	7'-6"				
17'-0"	3	12"	7'-6"				
18'-0"	3	12"	8'-0"				
19'-0"	3	12"	8'-6"				
20'-0"	3	18"	8'-6"				
21'-0"	3	18"	9'-0"				
22'-0"	3	24"	9'-0"				
23'-0"	3	24"	9'-6"				
24'-0"	3	24"	10'-0"				
25'-0"	4	6"	8'-0"				
26'-0"	4	12"	8'-0"				
27'-0"	4	18"	8'-0"				
28'-0"	4	24"	8'-0"				
29'-0"	4	12"	9'-0"				

SECTION A
Not to Scale S9.6/S9.7

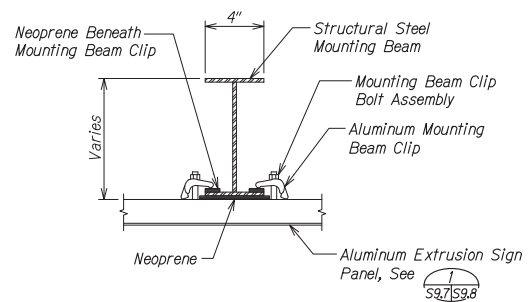

SECTION B
Scale: 3/4" = 1'-0" S9.6/S9.7

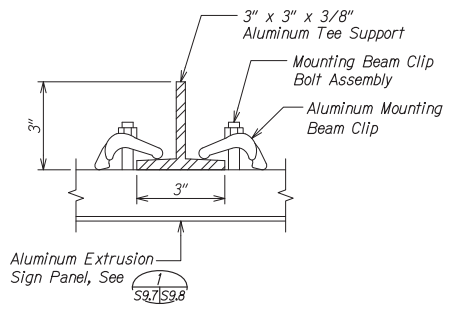

SECTION C
Scale: 6" = 1'-0" S9.6/S9.7

DESIGNED BY	SAFETY CHECKED BY
DRAWN BY	REVIEWED BY
IN CHARGE	DATE

DRAWING NAME: 2.102 ENGINEERING PROJECTS (U.S. DEPARTMENT OF TRANSPORTATION) DESTINATION SIGNAGE (U.S. DEPARTMENT OF TRANSPORTATION) TYP. DTS. ADD. 165. PLOT TIME: 01-10-23, 9:11 PM

DATE	REVISION
1/3/23	1 Add. 1 - Revised schedule


STATE OF HAWAII
DEPARTMENT OF TRANSPORTATION
HIGHWAYS DIVISION

TYPICAL MOUNTING BEAM DETAILS


INTERSTATE ROUTE H-1 AND H-201
DESTINATION SIGN UPGRADE/REPLACEMENT, PHASE 3
FAP NO. NH-0300(144)

Scale: As Noted Date: Sept. 2022

SHEET No. S9.7 OF 10 SHEETS

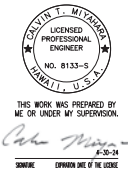

FED. ROAD DIST. NO.	STATE	FEDERAL AID PROJ. NO.	FISCAL YEAR	SHEET NO.	TOTAL SHEETS
HAWAII	HAW.	NH-0300(144)	2023	ADD. 167	175

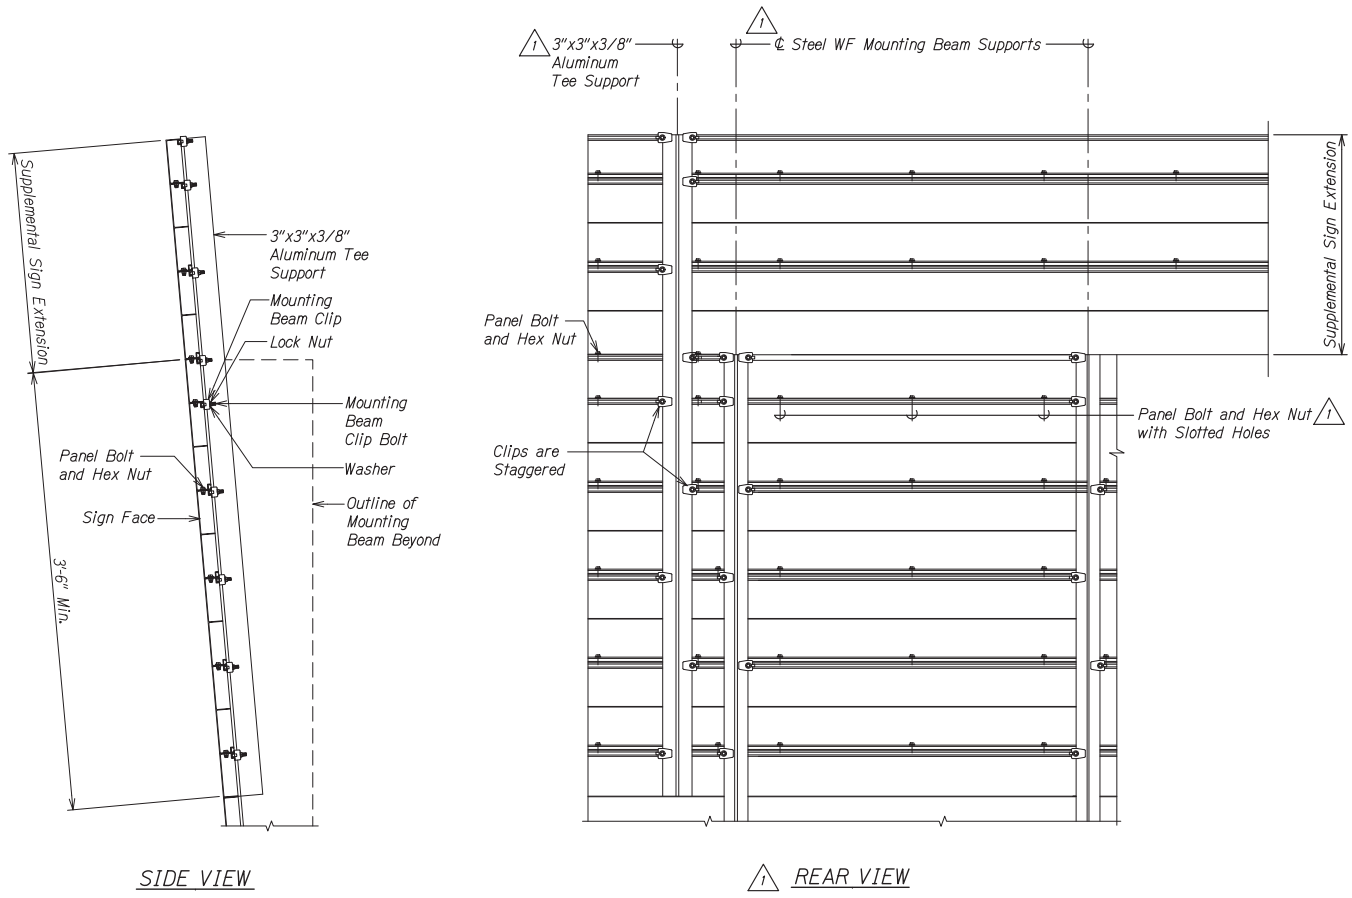

SIDE VIEW

REAR VIEW

ASSEMBLY AT SUPPLEMENTAL SIGN EXTENSION A
 Scale: 1 1/2" = 1'-0" S9.9

DESIGNED BY	DATE
DRAWN BY	
CHECKED BY	
IN CHARGE BY	
DATE	

DRAWING NAME: 2.102 ENGINEERING PROJECTS (E-306-DESTINATION SIGN) (ADD. 167) SHEET NO. 167 OF 175



THIS WORK WAS PREPARED BY ME OR UNDER MY SUPERVISION
 ENGINEER

STATE OF HAWAII
 DEPARTMENT OF TRANSPORTATION
 HIGHWAYS DIVISION

TYPICAL SIGN PANEL ASSEMBLY


INTERSTATE ROUTE H-1 AND H-201
 DESTINATION SIGN UPGRADE/REPLACEMENT, PHASE 3
 F.A.P. NO. NH-0300(144)

Scale: As Noted Date: Sept. 2022


SHEET No. **S9.9** OF 10 SHEETS

1/3/23	△ Add. 1 - Revised callouts, and Rear View
DATE	REVISION

FED. ROAD DIST. NO.	STATE	FEDERAL AID PROJ. NO.	FISCAL YEAR	SHEET NO.	TOTAL SHEETS
HAWAII	HAW.	NH-0300(144)	2023	ADD. 166	175

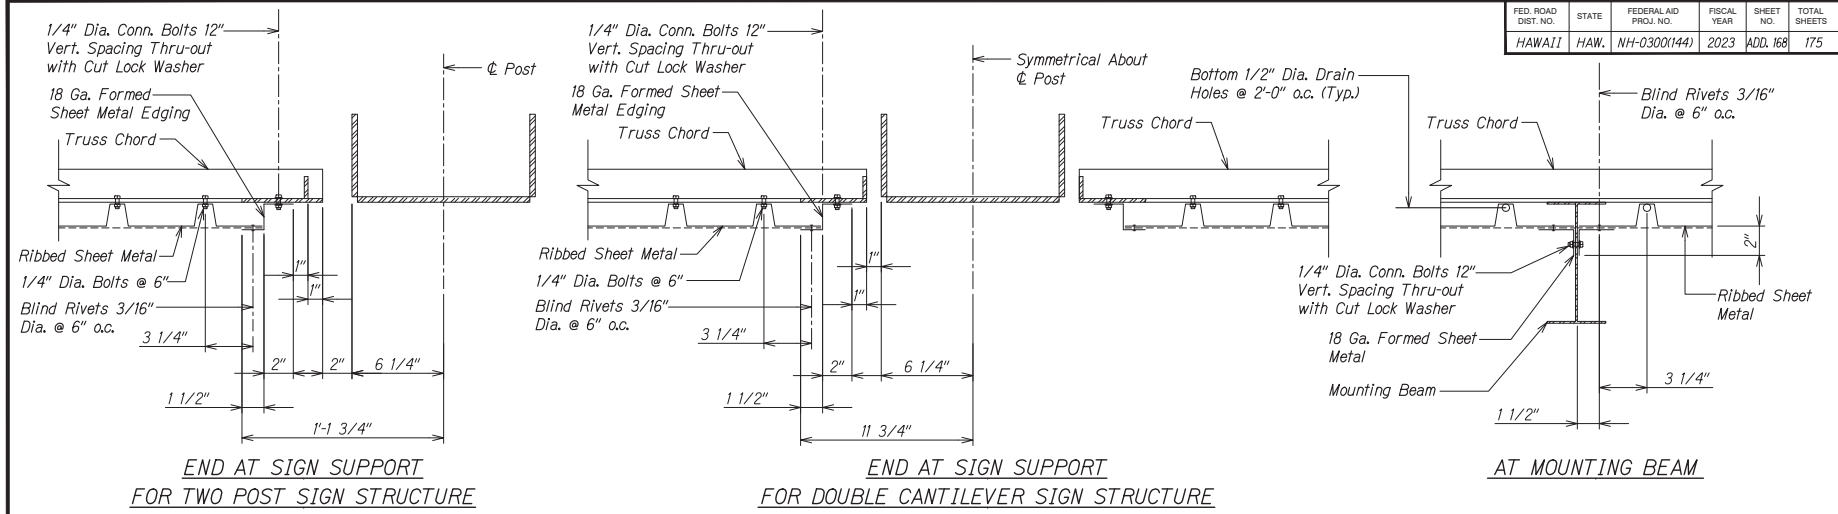

TYPICAL HORIZONTAL SECTION AT POST
Not to Scale

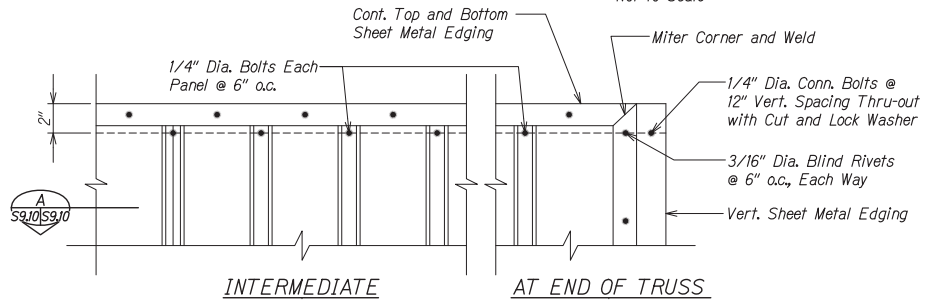

TYPICAL RIBBED SHEET METAL DETAIL
Not to Scale

RIBBED SHEET METAL NOTES:

- All ribbed sheet metal formed edging and the connections shall be capable of resisting the loads described on the Structural General Notes sheet. The ribbed sheet metal shall span from top chord to bottom chord. Shop drawings and calculations shall be submitted to the Engineer for approval.
- All ribbed sheet metal and formed edging shall be galvanized steel conforming to ASTM designation A653-SS, Grade 50 minimum with a minimum yield of 50 ksi. Coating designation shall conform to ASTM designation: A653, G90.
- Ribbed sheet metal shall be a minimum 18 gage thickness, typical. Ribbed sheet metal shall be a minimum 16 gage thickness for Sign Structures HIEBR-253 and HIWB-511.
- Connection bolts, nuts and washers to be hot-dip galvanized steel ASTM A307.
- Blind rivets shall be galvanized and submitted to the Engineer for approval.



THIS WORK WAS PREPARED BY ME OR UNDER MY SUPERVISION
DATE: 09/20/22

STATE OF HAWAII
DEPARTMENT OF TRANSPORTATION
HIGHWAYS DIVISION

TYPICAL RIBBED SHEET METAL DETAILS

INTERSTATE ROUTE H-1 AND H-201
DESTINATION SIGN UPGRADE/REPLACEMENT, PHASE 3
FAP NO. NH-0300(144)

Scale: As Noted Date: Sept. 2022

SHEET No. S9.10 OF 10 SHEETS

1/3/23	1	ADD. 1 - Revised callouts, # added notes
DATE	REVISION	

DRAWING NAME: 2-102 ENGINEERING PROJECTS (C-306) DESTINATION SIGN UPGRADE/REPLACEMENT PHASE 3 FAP NO. NH-0300(144) PLOT TIME: 09-25-23 9:12 AM

DESIGNED BY	DATE
DRAWN BY	
CHECKED BY	
APPROVED BY	
SCALE	
NO.	

FED. ROAD DIST. NO.	STATE	FEDERAL AID PROJ. NO.	FISCAL YEAR	SHEET NO.	TOTAL SHEETS
HAWAII	HAW.	NH-0300(144)	2023	ADD. 169	175

SIGN SCHEDULE

SIGN	SPAN LENGTH "L"	DEPTH "D"	TRUSS PANELS NO.	SPACING	WIND PANELS NO.	SPACING	WIDTH "W"	FRAMING SIZES				CAMBER	COMMENTS
								MEMBER "A" T#B CHORDS	MEMBER "B" VERTICAL	MEMBER "C" DIAGONAL	MEMBER "D" T#B CHORD WIND BRACING		
HIEBR-253	90'-0"	14'-0"	8	Equal Spaces	40	Equal Spaces	2'-6"	L6 x 6 x 7/8	L3 1/2 x 3 x 1/4	L3 x 3 x 1/4	L3 x 3 x 3/8	1"	
78EBR-830	72'-0"	$\triangle 10'-0"$	10	Equal Spaces	32	Equal Spaces	2'-6"	L6 x 4 x 3/4	L3 1/2 x 3 x 1/4	L3 x 3 x 1/4	L2 x 2 x 1/4	1/2"	
HIEB-305 (Maui) HIEB-305 (Makai)	23'-4" 24'-8"	10'-6" $\triangle 10'-6"$	2 2	Equal Spaces	12 12	Equal Spaces	2'-0" 2'-0"	L5 x 3 1/2 x 3/4 $\triangle 1$ L5 x 3 1/2 x 3/4	L3 x 3 x 1/4 L3 x 3 x 1/4	L3 x 3 x 1/4 L3 x 3 x 1/4	L2 x 2 x 1/4 L2 x 2 x 1/4	1 1/2" $\triangle 1$ 1 1/2"	Double Cantilever
HIWB-505	91'-8 1/2"	10'-0"	$\triangle 1$ 10	Equal Spaces	$\triangle 1$ 46	Equal Spaces	$\triangle 1$ 2'-0"	$\triangle 1$ L6 x 6 x 7/8	L3 1/2 x 3 x 1/4	L3 x 3 x 1/4	L3 x 3 x 3/8	1"	On Structure
HIWB-511	82'-8"	$\triangle 1$ 12'-6"	8	Equal Spaces	$\triangle 1$ 36	Equal Spaces	2'-6"	L6 x 4 x 7/8	L3 1/2 x 3 x 1/4	L3 x 3 x 1/4	L2 x 2 x 3/8	3/4"	On Structure

DRAWING NAME: Z:\02 ENGINEERING\PROJECTS\16-006-DESTINATION SIGNS\16-03-23 ADDITIONAL SIGN TO SIGN SCHEDULES PLOT TIME: 01-05-23, 8:13 PM

DESIGNED BY	DATE
CHECKED BY	
APPROVED BY	
SCALE	
PROJECT NO.	
SHEET NO.	



THIS WORK WAS PREPARED BY ME OR UNDER MY SUPERVISION.
 ENGINEER

STATE OF HAWAII
 DEPARTMENT OF TRANSPORTATION
 HIGHWAYS DIVISION

SIGN SCHEDULE

INTERSTATE ROUTE H-1 AND H-201
 DESTINATION SIGN UPGRADE/REPLACEMENT, PHASE 3
 FAP NO. NH-0300(144)

Scale: As Noted Date: Sept. 2022

SHEET No. 101 OF 2 SHEETS

1/3/23	$\triangle 1$ Add. 1 - Revised values
DATE	REVISION