

**STATE OF HAWAII  
DEPARTMENT OF TRANSPORTATION  
HIGHWAYS**

**ADDENDUM NO. 2  
FOR  
INTERSTATE ROUTE H-1 RESURFACING,  
MILLER PEDESTRIAN OVERPASS TO KAPIOLANI INTERCHANGE  
DISTRICT OF HONOLULU  
ISLAND OF OAHU**

**FEDERAL-AID PROJECT NO. NH-H1-1(279)R**

**February 5, 2025**

This Addendum shall make the following amendment(s) to the Solicitation:

**A. SPECIAL PROVISIONS**

1. Delete **SECTION 202 – REMOVAL OF STRUCTURES AND OBSTRUCTIONS** dated 8/13/24 in its entirety and replace with attached **SECTION 202 – REMOVAL OF STRUCTURES AND OBSTRUCTIONS** dated r2/5/2025.
2. Delete **SECTION 401 – HOT MIX ASPHALT (HMA) PAVEMENT** dated 10/20/22 in its entirety and replace with attached **SECTION 401 – HOT MIX ASPHALT (HMA) PAVEMENT** dated r2/5/2025.
3. Delete **SECTION 629 – PAVEMENT MARKINGS** dated 12/12/24 in its entirety and replace with attached **SECTION 629 – PAVEMENT MARKINGS** dated r2/5/2025.
4. Delete **SECTION 630 – TRAFFIC CONTROL GUIDE SIGNS** dated 4/6/24 in its entirety and replace with attached **SECTION 630 – TRAFFIC CONTROL GUIDE SIGNS** dated r2/5/2025.

**B. PROPOSAL SCHEDULE**

1. Delete **PROPOSAL SCHEDULE** pages P-8 through P-20 dated 12/12/24 and replace with attached **PROPOSAL SCHEDULE** pages P-8 through P-20 dated r2/5/2025.

**C. FEDERAL WAGE RATES**

1. Delete **FEDERAL WAGE RATES** dated 11/15/2024 in its entirety and replace with attached **FEDERAL WAGE RATES** dated 01/31/2025.

**D. PLANS**

1. Delete **PLAN SHEET NO. 26 DEMOLITION AND EROSION CONTROL** and replace with attached **PLAN SHEET NO. ADD. 26 DEMOLITION AND EROSION CONTROL**.
2. Delete **PLAN SHEET NO. 38 RAMP TYPICAL SECTIONS** and replace with attached **PLAN SHEET NO. ADD. 38 RAMP TYPICAL SECTIONS**.
3. Delete **PLAN SHEET NO. 39 RAMP TYPICAL SECTIONS** and replace with attached **PLAN SHEET NO. ADD. 39 RAMP TYPICAL SECTIONS**.
4. Delete **PLAN SHEET NO. 41 RAMP TYPICAL SECTIONS** and replace with attached **PLAN SHEET NO. ADD. 41 RAMP TYPICAL SECTIONS**.
5. Delete **PLAN SHEET NO. 42 RAMP TYPICAL SECTIONS** and replace with attached **PLAN SHEET NO. ADD. 42 RAMP TYPICAL SECTIONS**.
6. Delete **PLAN SHEET NO. 43 LUNALILO ST. TYPICAL SECTIONS** and replace with attached **PLAN SHEET NO. ADD. 43 LUNALILO ST. TYPICAL SECTIONS**.
7. Delete **PLAN SHEET NO. 64 ROADWAY PLAN** and replace with attached **PLAN SHEET NO. ADD. 64 ROADWAY PLAN**.
8. Delete **PLAN SHEET NO. 65 ROADWAY PLAN** and replace with attached **PLAN SHEET NO. ADD. 65 ROADWAY PLAN**.
9. Delete **PLAN SHEET NO. 76 ROADWAY PLAN** and replace with attached **PLAN SHEET NO. ADD. 76 ROADWAY PLAN**.

10. Delete **PLAN SHEET NO. 90 GUARDRAIL SCHEDULE** and replace with attached **PLAN SHEET NO. ADD. 90 GUARDRAIL SCHEDULE**.
11. Delete **PLAN SHEET NO. 95 GUARDRAIL SCHEDULE** and replace with attached **PLAN SHEET NO. ADD. 95 GUARDRAIL SCHEDULE**.
12. Delete **PLAN SHEET NO. 102 STIFFENED MGS HALF POST SPACING** and replace with attached **PLAN SHEET NO. ADD. 102 STIFFENED MGS HALF POST SPACING**.
13. Delete **PLAN SHEET NO. 133 TRAFFIC COUNTING STATION PLAN AT MILEPOST 22.10** and replace with attached **PLAN SHEET NO. ADD. 133 TRAFFIC COUNTING STATION PLAN AT MILEPOST 22.10**.
14. Delete **PLAN SHEET NO. 182 PAVEMENT MARKING & SIGNING PLAN** and replace with attached **PLAN SHEET NO. ADD. 182 PAVEMENT MARKING & SIGNING PLAN**.
15. Delete **PLAN SHEET NO. 186 PAVEMENT MARKING & SIGNING PLAN** and replace with attached **PLAN SHEET NO. ADD. 186 PAVEMENT MARKING & SIGNING PLAN**.
16. Delete **PLAN SHEET NO. 189 PAVEMENT MARKING & SIGNING PLAN** and replace with attached **PLAN SHEET NO. ADD. 189 PAVEMENT MARKING & SIGNING PLAN**.
17. Delete **PLAN SHEET NO. 190 PAVEMENT MARKING & SIGNING PLAN** and replace with attached **PLAN SHEET NO. ADD. 190 PAVEMENT MARKING & SIGNING PLAN**.
18. Delete **PLAN SHEET NO. 191 PAVEMENT MARKING & SIGNING PLAN** and replace with attached **PLAN SHEET NO. ADD. 191 PAVEMENT MARKING & SIGNING PLAN**.
19. Delete **PLAN SHEET NO. 192 PAVEMENT MARKING & SIGNING PLAN** and replace with attached **PLAN SHEET NO. ADD. 192 PAVEMENT MARKING & SIGNING PLAN**.

20. Delete **PLAN SHEET NO. 195 PAVEMENT MARKING & SIGNING PLAN** and replace with attached **PLAN SHEET NO. ADD. 195 PAVEMENT MARKING & SIGNING PLAN**.
21. Delete **PLAN SHEET NO. 196 PAVEMENT MARKING & SIGNING PLAN** and replace with attached **PLAN SHEET NO. ADD. 196 PAVEMENT MARKING & SIGNING PLAN**.

The following is provided for information.

**E. PRE-BID MEETING MINUTES**

The attached PRE-BID MEETING MINUTES is provided for your information.

**F. RESPONSES TO REQUEST FOR INFORMATION (RFI'S/QUESTIONS)**

The attached RESPONSES to REQUEST FOR INFORMATION are provided for your information.

Please acknowledge receipt of this **Addendum No. 2** by recording the date of its receipt in the space provided on **PAGE P-4** of the Proposal.

*Henry Kennedy*

---

HENRY KENNEDY  
Engineering Program Manager

1           **SECTION 202 – REMOVAL OF STRUCTURES AND OBSTRUCTIONS**

2  
3    Make the following amendments to said Section:

4  
5    **(I)**    Amend **202.04 – Measurement** by revising lines 119 to 120 to read as  
6 follows:

7  
8    **“202.04 Measurement.** Removal of structures and obstructions will be measured  
9 per linear foot, square yard or each as shown in the contract documents.”

10  
11   **(II)**   Amend **202.05 – Payment** by revising lines 122 to 131 to read as follows:

12  
13   **“202.05 Payment.** If the proposal does not show a contract item for the removal  
14 of structures and obstructions, the Engineer will not pay for the removal of  
15 structures and obstructions separately. The Contractor shall consider them  
16 incidental to the various contract items.

17  
18   The Engineer will pay for specific items stipulated for removal and disposal at the  
19 contract price bid per linear foot, square yard or each as specified in the proposal.  
20 The price shall be full compensation for removal and disposal of that items,  
21 excavation, backfill, salvage of materials removed. Salvaging of materials  
22 removed includes their custody, preservation, storage on the right-of-way. Also,  
23 the price shall be full compensation for equipment, tools, labor materials and  
24 incidentals necessary to complete the work.

25  
26   The Engineer will pay for the following pay item when included in the proposal  
27 schedule.

28

| <b>Pay Item</b>                                     | <b>Pay Unit</b> |
|---|-----------------|
| Removal of Concrete Curb                            | Linear Foot     |
| Removal of Concrete Curb and Gutter                 | Linear Foot     |
| Removal of Bridge Railing - Concrete                | Linear Foot     |
| Removal of Bridge Railing - Metal                   | Linear Foot     |
| Removal of Guardrail, End Terminals and Attenuators | Linear Foot     |
| Removal of Signs and Single Post                    | Each            |
| Removal of Signs and Double Post                    | Each            |
| Removal of Signs                                    | Each            |

46

|    |                                       |              |
|----|---------------------------------------|--------------|
| 47 | Removal of 4-Foot Chain Link Fence    | Linear Foot  |
| 48 |                                       |              |
| 49 | Removal of Flexible Delineators       | Linear Foot  |
| 50 |                                       |              |
| 51 | Removal of Steel Reflector Posts      | Each         |
| 52 |                                       |              |
| 53 | Removal of Survey Monuments           | Each         |
| 54 |                                       |              |
| 55 | Removal of Existing Geotextile Fabric | Square Yard" |
| 56 |                                       |              |
| 57 | <b>END OF SECTION 202</b>             |              |

1 **Amend Section 401- HOT MIX ASPHALT (HMA) PAVEMENT to read as follows:**

2  
3 **“SECTION 401 – HOT MIX ASPHALT (HMA) PAVEMENT**

4  
5 **401.01 Description.** This section describes furnishing and placing dense graded  
6 HMA pavement (herein referred to as HMA) on a prepared surface.

7  
8 **401.02 Materials.**

9  
10 Asphalt Cement (PG 64-16) 702.01(A)

11  
12 Use for non-surface mixes, unless otherwise specified in the project documents.

13  
14 Asphalt Cement (PG 64E-22) 702.01(B)

15  
16 Use for all surface mixes, except for on Lanai and Molokai, and unless otherwise  
17 specified in the project documents. Polymer modified asphalt (PMA) pavement  
18 refers to asphalt mix using PG 64E-22, unless otherwise indicated.

19  
20 Emulsified Asphalt 702.04

21  
22 Warm Mix Asphalt Additive 702.06

23  
24 Aggregate for Hot Mix Asphalt Pavement 703.09

25  
26 Filler 703.15

27  
28 Hydrated Lime or a liquid anti-strip approved by the engineer 712.03

29  
30 **(A) General.** HMA pavement shall be plant mixed and shall include  
31 mixture of aggregate and asphalt binder and may include reclaimed asphalt  
32 pavement (RAP) or filler, or both.

33  
34 The manufacture of HMA may include warm mix asphalt (WMA)  
35 processes in accordance with these specifications. WMA processes include  
36 combinations of organic additives, chemical additives, and foaming.

37  
38 HMA pavement shall include surface course and may include one or  
39 more binder courses, depending on HMA pavement thickness indicated in  
40 the contract documents.

41  
42 RAP is defined as removed or reprocessed pavement materials  
43 containing asphalt and aggregates. Process RAP by crushing until 100  
44 percent of RAP passes 3/4-inch sieve. Size, grade uniformly, and combine  
45 materials such that blend of RAP and aggregate material conforms to grading  
46 requirements of Subsection 703.09 - Aggregate for Hot Mix Asphalt

401.02

47 Pavement.

48

49

In surface and binder courses, aggregate for HMA may include RAP quantities up to 20 percent of total mix weight.

50

51

52

Quantity of filler material to correct deficiencies in aggregate gradation passing the No. 200 sieve shall not exceed 3 percent by weight of fine aggregates.

53

54

55

56

**(B) Job-Mix Formula and Tests.** Design job-mix formula in accordance with procedures contained in current edition of Asphalt Institute's *Mix Design Methods for Asphalt Concrete and Other Hot Mix Types*, Manual Series No. 2 (MS-2) for either Marshall Method or Hveem Method of Mix Design.

57

58

59

60

61

Limit compacted lift thickness and asphalt content of job-mix formula as specified in Table 401.02-1 - Limits of Compacted Lift Thickness and Asphalt Content.

62

63

64

| TABLE 401.02-1 - LIMITS OF COMPACTED LIFT THICKNESS AND ASPHALT CONTENT |                  |                  |                  |                  |
|---|------------------|------------------|------------------|------------------|
| MIX NO.   | II               | III              | IV               | V                |
| Minimum to Maximum Compacted Thickness for Individual Lifts (Inches)    | 2-1/4<br>to<br>3 | 2<br>to<br>3     | 1-1/2<br>to<br>3 | 1-1/4<br>to<br>3 |
| Asphalt Content Limits (Percent of Total Weight of Mix)                 | 3.8<br>to<br>6.1 | 4.3<br>to<br>6.1 | 4.3<br>to<br>6.5 | 4.8<br>to<br>7.0 |

65

66

Asphalt content limits for porous aggregate may be exceeded only if it is requested ahead of placement and is reviewed then accepted in writing by the Engineer.

67

68

69

70

Meet job-mix formula design criteria specified in Table 401.02-2 - Job-Mix Formula Design Criteria.

71

72

73



74

| <b>TABLE 401.02-2 - JOB-MIX FORMULA DESIGN CRITERIA</b>                 |        |
|---|--------|
| <b>Hveem Method Mix Criteria (AASHTO T 246 and AASHTO T 247)</b>        |        |
| Stability, minimum  | 37     |
| Air Voids (percent) <sup>1</sup>  | 3 - 5  |
| <b>Marshall Method Mix Criteria (AASHTO T 245)</b>                      |        |
| Compaction (number of blows each end of specimen)                       | 75     |
| Stability, minimum (pounds)   | 1,800  |
| Flow (x 0.01 inch)  | 8 - 16 |
| Air Voids (percent) <sup>1</sup>  | 3 - 5  |
| <b>Notes:</b>   |        |
| 1. Air Voids: AASHTO T 166 or AASHTO T 275; AASHTO T 209, AASHTO T 269. |        |

75

76

77

78

79

Minimum percent voids in mineral aggregates (VMA) of job-mix formula shall be as specified in Table 401.02-3 - Minimum Percent Voids in Mineral Aggregates (VMA).

| <b>TABLE 401.02-3 - MINIMUM PERCENT VOIDS IN MINERAL AGGREGATES (VMA)</b> |       |      |      |      |      |
|---|-------|------|------|------|------|
| Nominal Maximum Particle Size, (Inches)                                   | 1-1/2 | 1    | 3/4  | 1/2  | 3/8  |
| VMA, (percent) <sup>1</sup>   | 11.0  | 12.0 | 13.0 | 14.0 | 15.0 |
| <b>Notes:</b>   |       |      |      |      |      |
| 1. VMA: See Asphalt Institute Manual MS-2                                 |       |      |      |      |      |

80

81

82

83

84

85

86

87

88

89

90

91

92

93

94

95

**(C) Submittals.** Establish and submit job-mix formula for each type of HMA pavement mix indicated in the contract documents a minimum of 30 days before paving production. Job mix shall include the following applicable information:

- (1) Design percent of aggregate passing each required sieve size.
- (2) Design percent of asphalt binder material (type determined by type of mix) added to the aggregate (expressed as % by weight of total mix),
- (3) Design proportion of processed RAP.
- (4) Design temperature of mixture at point of discharge at paver.

- 96                   (5)    Source of aggregate.  
 97  
 98                   (6)    Grade of asphalt binder.  
 99  
 100                  (7)    Test data used to develop job-mix formula.  
 101

102                   Except for item (4) in this subsection, if design requirements are  
 103 modified after the Engineer accepts job-mix formula, submit new job-mix  
 104 formula before using HMA produced from modified mix design. Submit any  
 105 changes to the design temperature of mixture at point of discharge for  
 106 acceptance by the Engineer.  
 107

108                   Submit a certificate of compliance for the asphalt binder, accompanied  
 109 by substantiating test data from a certified testing laboratory.  
 110

111                   **(D) Range of Tolerances for HMA.** Provide HMA within allowable  
 112 tolerances of accepted job mix formula as specified in Table 401.02-4 -  
 113 Range of Tolerances HMA. These tolerances are not to be used for the  
 114 design of the job mix, they are solely to be used during the testing of the  
 115 production field sample of the HMA mix.  
 116

| <b>TABLE 401.02-4 - RANGE OF TOLERANCES HMA</b>       |       |
|---|-------|
| Passing No. 4 and larger sieves (percent)             | ± 7.0 |
| Passing No. 8 to No. 100 sieves (inclusive) (percent) | ± 4.0 |
| Passing No. 200 sieve (percent)                       | ± 3.0 |
| Asphalt Content (percent)                             | ± 0.4 |
| Mixture Temperature (degrees F)                       | ± 20  |

117  
 118                   The tolerances shown are the allowable variance between the physical  
 119 characteristics of laboratory job mix submitted mix design and the production  
 120 or operational mix, i.e., field samples.  
 121

### 122 **401.03 Construction.**

123  
 124                   **(A) Weather Limitations.** Placement of HMA shall not be allowed under  
 125 the following conditions:  
 126

- 127                   (1)    On wet surfaces, e.g., surface with ponding or running water,  
 128 surface that has aggregate or surface that appears beyond surface  
 129 saturated dry, as determined by the Engineer.  
 130

131 (2) When air temperature is below 50 degrees F and falling. HMA  
132 may be applied when air temperature is above 40 degrees F and  
133 rising. Air temperature will be measured in shade and away from  
134 artificial heat.

135  
136 (3) When weather conditions prevent proper method of  
137 construction.

138  
139 **(B) Equipment.**

140  
141 **(1) Mixing Plant.** Use mixing plants that conform to AASHTO M  
142 156, supplemented as follows:

143  
144 **(a) All Plants.**

145  
146 **1. Automated Controls.** Control proportioning,  
147 mixing, and mix discharging automatically. When RAP  
148 is incorporated into mixture, provide positive controls for  
149 proportioning processed RAP.

150  
151 **2. Dust Collector.** AASHTO M 156, Requirements  
152 for All Plants, Emission Controls is amended as follows:

153  
154 Equip plant with dust collector. Dispose of  
155 collected material. In the case of baghouse dust  
156 collectors, dispose of collected material or return  
157 collected material uniformly.

158  
159 **3. Modifications for Processing RAP.** When RAP  
160 is incorporated into mixture, modify mixing plant in  
161 accordance with plant manufacturer's recommendations  
162 to process RAP.

163  
164 **(b) Drum Dryer-Mixer Plants.**

165  
166 **1. Bins.** Provide separate bin in cold aggregate  
167 feeder for each individual aggregate stockpile in mix.  
168 Use bins of sufficient size to keep plant in continuous  
169 operation and of proper design to prevent overflow of  
170 material from one bin to another.

131  
132  
**2. Stockpiling Procedures.** Separate aggregate for Mix II, Mix III and Mix IV into at least three stockpiles with different gradations as follows: coarse, intermediate, and fine. Separate aggregates for Mix V into at least two stockpiles. Stockpile RAP separately from virgin aggregates.

**3. Checking Aggregate Stockpile.** Check condition of the aggregate stockpile often enough to ensure that the aggregate is in optimal condition.

**(c) Batch and Continuous Mix Plants.**

**1. Hot Aggregate Bin.** Provide bin with three or more separate compartments for storage of screened aggregate fractions to be combined for mix. Make partitions between compartments tight and of sufficient height to prevent spillage of aggregate from one compartment into another.

**2. Load Cells.** Calibrated load cells may be used in batch plants instead of scales.

**(2) Hauling Equipment.** Use trucks that have tight, clean, smooth metal beds for hauling HMA.

Thinly coat truck beds with a minimum quantity of non-stripping release agent to prevent mixture from adhering to beds. Diesel or petroleum-based liquid release agents, except for paraffin oil, shall not be used. Drain excess release agent from truck bed before loading with HMA.

Provide a designated clean up area for the haul trucks.

Equip each truck with a tarpaulin conforming to the following:

**(a)** In good condition, without tears and holes.

**(b)** Large enough to be stretched tightly over truck bed, completely covering mix. The tarpaulin shall be secured in such a manner that it remains stretched tightly over truck bed and HMA mix until the bed is about to be raised up in preparation for discharge.

218  
219  
- (3) **Asphalt Pavers.** Use asphalt pavers that are:
- (a) Self-contained, power-propelled units.
  - (b) Equipped with activated screed or strike-off assembly, heated if necessary.
  - (c) Capable of spreading and finishing courses of HMA mixtures in lane widths applicable to typical section and thicknesses indicated in the contract documents.
  - (d) Equipped with receiving hopper having sufficient capacity for uniform spreading operation.
  - (e) Equipped with automatic feed controls to maintain uniform depth of material ahead of screed.
  - (f) Equipped with automatic screed controls with sensors capable of sensing grade from outside reference line, sensing transverse slope of screed, and providing automatic signals to control screed grade and transverse slope.
  - (g) Capable of operating at constant forward speeds consistent with satisfactory laying of mixture.
  - (h) Equipped with a means of preventing the segregation of the coarse aggregate particles from the remainder of the bituminous plant mix when that mix is carried from the paver hopper back to the paver augers. The means and methods used shall be approved by the paver manufacturer and may consist of chain curtains, deflector plates, or other such devices and any combination of these.

The following specific requirements shall apply to the identified bituminous pavers:

1. **Blaw-Knox Bituminous Pavers.** Blaw-Knox bituminous pavers shall be equipped with the Blaw-Knox Materials Management Kit (MMK).
2. **Cedarapids Bituminous Pavers.** Cedarapids bituminous pavers shall be those that were manufactured in 1989 or later.

262  
263  
- 3. Barber-Green/Caterpillar Bituminous Pavers.** Barber-Green/Caterpillar bituminous pavers shall be equipped with deflector plates as identified in the December 2000 Service Magazine entitled "New Asphalt Deflector Kit {6630, 6631, 6640}".

Bituminous pavers not listed above shall have similar attachments or designs that shall make them equivalent to the bituminous pavers listed above. The Engineer will solely decide if it is equal to or better than the setups described for the equipment listed above.

Submit for review and acceptance, prior to the start of using the paver for the placing of plant mix, a full description in writing of the means and methods that will be used to prevent the bituminous paver from having both aggregate and temperature segregation. Use of any paver that has not been accepted is prohibited until acceptance of the paver is received from the Engineer. Any pavement placed with an unaccepted paver will be regarded as not compliant work and may not be paid for and may require removal.

Supply a Certificate of Compliance that verifies that the manufacturer's approved means and methods used to prevent bituminous paver from having both aggregate and temperature segregation have been implemented on all pavers used on the project and are working in accordance with the manufacturer's requirements and Contract Documents.

- (4) Rollers.** Rollers shall be self-propelled, steel-tired tandem, pneumatic-tired, or vibratory-type rollers capable of reversing without shoving or tearing the just placed HMA mixture. Provide sufficient number, sequencing, type, and rollers of sufficient weight to compact the mixture to required density while mixture is still in workable condition. Equipment shall not excessively crush aggregate. Operate rollers in accordance with manufacturer's recommendations and Contract Documents. The use of intelligent compaction is encouraged and may be required elsewhere in the Contract Documents.

- (a) Steel-Tired Tandem Rollers.** Steel-tired tandem rollers used for initial breakdown or intermediate roller passes shall have minimum gross weight of 12 tons and shall provide minimum 250-pound weight per linear inch of width on drive wheel.

308 Steel-tired tandem rollers used for finish roller passes  
309 shall have minimum total gross weight of 3 tons.  
310

311 Do not use roller with grooved or pitted rolling drum or  
312 worn scrapers or wetting pads. Replace excessively worn  
313 scrapers and wetting pads before use.  
314

315 **(b) Pneumatic-Tired Rollers.** Pneumatic-tired rollers shall  
316 be oscillating-type, equipped with smooth-tread pneumatic tires  
317 of equal size and diameter. Maintain tire pressure within 5  
318 pounds per square inch of designated operational pressure  
319 when hot. Space tires so that gaps between adjacent tires are  
320 covered by following set of tires.  
321

322 Pneumatic-tired rollers used for breakdown or  
323 intermediate roller passes shall have a ballast capable of  
324 establishing an operating weight per tire of not less than 3,000  
325 pounds. Equip rollers with tires having minimum 20-inch wheel  
326 diameter with tires inflated to 70 to 75 pounds per square inch  
327 pressure when cold and 90 pounds per square inch when hot.  
328 Equip rollers with skirt-type devices to maintain temperature of  
329 tires during rolling operations.  
330

331 Pneumatic-tired rollers used for kneading finished  
332 asphalt surfaces shall have a ballast capable of establishing an  
333 operating weight per tire of not less than 1,500 pounds. Equip  
334 rollers with tires having minimum 15-inch wheel diameter with  
335 tires inflated to 50 to 60 pounds per square inch pressure. If  
336 required, equip rollers with skirt-type devices to maintain  
337 temperature of tires during rolling operations.  
338

339 **(c) Vibratory Rollers.** Vibratory rollers shall be steel-tired  
340 tandem rollers having minimum total weight of 3 tons. Equip  
341 vibratory rollers with amplitude and frequency controls and  
342 speedometer. Operate vibratory roller in accordance with  
343 manufacturer's recommendations. For very thin lifts, 1 inch or  
344 less in thickness, vibratory rollers shall not be used in the  
345 vibratory mode. Instead, operate the unit in the static mode.  
346

347 **(5) Hand Tools.** Keep hand tools used in production, hauling, and  
348 placement of HMA clean and free of contaminants. Diesel or mineral  
349 spirits or other cleaning material that is potentially deleterious to HMA  
350 may be used to clean hand tools providing:  
351

352 **(a)** It does not contaminate HMA with cleaning material.  
353

354  
(b) Clean hand tools over catch pan with capacity to hold all the cleaning material.

(c) Remove all diesel or mineral spirits or other cleaning material that is potentially deleterious to HMA from hand tools before using with HMA.

(d) Hand tools used shall be in a condition such that it meets the requirements that it was manufactured for, e.g., a straightedge shall meet the straightness requirement of the manufacturer.

**(6) Material Transfer Vehicle (MTV).**

(a) **Usage.** MTV usage applies to surface courses of paving projects on all Islands except Lanai, unless otherwise indicated. When placing HMA surface course use MTV to independently deliver mixtures from hauling equipment to paving equipment. MTV usage will not be required for the following:

1. Projects with less than 1,000 tons of HMA.
2. Temporary pavements.
3. Bridge deck approaches.
4. Shoulders.
5. Tapers.
6. Turning lanes.
7. Driveways.
8. Areas with low overhead clearances.

(b) **Equipment.** When using MTV, install minimum 10-ton-capacity hopper insert in conventional paver hopper. Provide the following equipment:

1. High-capacity truck unloading system in MTV capable of receiving HMA from hauling equipment.
2. MTV storage bin with minimum 15-ton capacity.



400 3. An auger mixing system in one of the following:  
401 the MTV storage bin, or paver hopper insert, or paver  
402 hopper to continuously mix HMA prior to discharging to  
403 the paver's conveyor system.

404  
405 Avoid stop-and-go operations by coordinating plant  
406 production rate, number of haul units, and MTV and paver  
407 speeds to provide a continuous, uniform, segregation-free  
408 material flow and smooth HMA pavement. Maintain uniform  
409 paver speed to produce smooth pavements.

410  
411 **(c) Performance Evaluation.** Evaluate the performance  
412 of MTV and mixing equipment by measuring mat temperature  
413 profile immediately behind paver screed on first day of paving  
414 and when it feels the need to do so due to perceived changes  
415 in performance or as directed by the Engineer.

416  
417 Use a hand-held temperature device that has been  
418 calibrated within the past 12 months. It shall be an infrared  
419 temperature gun is capable of measuring in one degree or finer  
420 increments between the temperatures of 80 degrees to 400  
421 degrees F with a laser to indicate where the temperature  
422 reading is being taken. Six temperature profile measurements  
423 shall be taken of mat surface using infrared temperature gun at  
424 50-foot intervals behind paver. Each temperature profile shall  
425 consist of three surface temperature measurements taken  
426 transversely across the mat in approximately a straight line  
427 from screed while paver is operating. For each profile,  
428 temperatures shall be measured approximately 1 foot from  
429 each edge and in middle of mat. The difference between  
430 maximum and minimum temperature measurements for each  
431 temperature profile shall not exceed 10 degrees F. If any two  
432 or more temperature profiles exceeds the allowable 10-degree  
433 F temperature differential, halt paving operation and adjust  
434 MTV or mixing equipment to ensure that material placed by  
435 paver meets specified temperature requirements. Redo the  
436 measuring of mat temperature profile until adjustment of the  
437 MTV or mixing equipment is adequate. Submit all temperature  
438 profiles to the Engineer by next business day. Information on  
439 the report shall show location and temperature readings and  
440 time test was performed. Enough information shall be given,  
441 so the Engineer will be able to easily locate the test site of the  
442 individual measurement.

443  
444 When requested temperature profile measurements  
445 shall be done in the presence of the Engineer.

446 Once adjustments are made, repeat measurement  
447 procedure for the next two placements to verify that material  
448 placed by paver meets specified temperature requirements.  
449 Terminate paving if temperature profile requirements are not  
450 met during repeated measurement procedure. If equipment  
451 fails to meet requirements after measurement procedure is  
452 repeated once, replace equipment before conducting any  
453 further temperature profile measurements  
454

455 The Engineer may perform surface temperature profile  
456 measurements at any time during project. The Engineer may  
457 in lieu of a hand-held infrared temperature device use an  
458 infrared camera or device that is capable of measuring  
459 temperatures to locate cold spots. If such cold spots exist, the  
460 Engineer may require adjustments to the MTV.  
461

462 If bleeding or fat spots occur in the pavement adjust  
463 means and methods to eliminate such pavement defects and  
464 perform remedial repair to pavement acceptable to the  
465 Engineer. Bleeding is defined as excess binder occurring on  
466 the surface of the pavement. It may create a shiny, glass-like,  
467 reflective appearance and may be tacky to the touch. Fat spots  
468 are localized bleeding.  
469

470 **(d) Transport.**  
471

472 **1. Trailered MTV.** Transport MTV by means of  
473 truck-tractor/trailer combination in accordance with  
474 Chapter 104 of Title 19, Department of Transportation,  
475 entitled "The Movement by Permit of Oversize and  
476 Overweight Vehicles on State Highways".  
477

478 **2. Crossing Bridges for Self-Powered MTV.**  
479 When self-powered MTV exceeds legal axle or total  
480 weight limits for vehicles under the HRS, Chapter 291,  
481 conform to the following when crossing bridges within  
482 project limits unless otherwise indicated in the Contract  
483 Documents:  
484

- 485 **a.** Completely remove mix from MTV.  
486  
487 **b.** Move MTV at relatively constant speed not  
488 exceeding 5 miles per hour. MTV will not be  
489 allowed to stop on bridge.  
490

491 c. No other vehicle or equipment will be  
492 allowed on bridge.

493  
494 d. The MTV shall not attempt to cross a  
495 bridge where the posted load limit is less than or  
496 equal to the weight of the MTV empty.  
497 Permission to cross the bridge shall be obtained  
498 from the Engineer and Highways Division, Bridge  
499 Design Section (HWY-DB) in writing.  
500

501 **(C) Preparation of Surface.** Clean existing pavement in accordance with  
502 Section 310 - Brooming Off. Apply tack coat in accordance with Section 407  
503 - Tack Coat. Tack coat shall not be applied to surfaces to receive an  
504 application of joint adhesive.  
505

506 Where indicated in the Contract Documents, bring irregular surfaces  
507 to uniform grade and cross section by furnishing and placing one or more  
508 leveling courses of HMA Mix V. Spread leveling course in variable  
509 thicknesses to eliminate irregularities in existing surface. Place leveling  
510 course such that maximum depth of each course, when thoroughly  
511 compacted, does not exceed 3 inches.  
512

513 In multiple-lift leveling course construction, spread subsequent lifts  
514 beyond edges of previously spread lifts in accordance with procedures  
515 contained in current edition of the Asphalt Institute's *Construction of Hot Mix*  
516 *Asphalt Pavements*, Manual Series No. 22 (MS-22) for leveling wedges.  
517

518 Notify the Engineer of existing surfaces that may not be in a condition  
519 that will have enough strength to be a good bonding surface or foundation  
520 and should be removed or have remedial repairs done before new pavement  
521 placement.  
522

523 **(D) Plant Operation.**  
524

525 **(1) Preparation of Asphalt Binder.** Uniformly heat asphalt binder  
526 and provide continuous supply of heated asphalt cement from storage  
527 to mixer. Do not heat asphalt binder above the recommendation of  
528 the supplier for modified binders or above 350 degrees F for neat  
529 binders.  
530

531 **(2) Preparation of Aggregate.** Dry and heat aggregate material  
532 at temperature sufficient to produce design temperature of job-mix  
533 formula. Do not exceed 350 degrees F. Adjust heat source used for  
534 drying and heating to avoid damage to and contamination of  
535 aggregate. When dry, aggregate shall not contain more than 1  
536 percent moisture by weight.

537 For batch plants, screen aggregates immediately after heating  
 538 and drying into three or more fractions. Convey aggregates into  
 539 separate compartments ready for batching and mixing with asphalt  
 540 binder.

541  
 542 **(3) Mixing.** Measure aggregate and asphalt; or aggregate, RAP,  
 543 and asphalt into mixer in accordance with an accepted job-mix  
 544 formula. Mix until components are completely mixed and adequately  
 545 coated with asphalt binder in accordance with AASHTO M 156.  
 546 Percent of coated particles shall be 95 percent when tested in  
 547 accordance with AASHTO T 195.

548  
 549 **(4) Plant Inspection.** For control and acceptance testing during  
 550 periods of production, provide a testing laboratory that meets the  
 551 requirements of AASHTO M 156. Provide space, utilities, and  
 552 equipment required for performing specified tests.

553  
 554 **(E) Spreading and Finishing.** Prior to each day's paving operation,  
 555 check screed or strike-off assembly surface with straight edge to ensure  
 556 straight alignment and there is no damage or wear to the machine that will  
 557 affect performance. Provide screed or strike-off assembly that produces  
 558 finished surface without tearing, shoving, and gouging HMA. Discontinue  
 559 using spreading equipment that leaves ridges, indentations, or other marks,  
 560 or combination thereof in surface that cannot be eliminated by rolling or  
 561 affects the final smoothness of the pavement or be prevented by adjustment  
 562 in operation.

563  
 564 Maintain HMA at minimum 250 degrees F temperature at discharge to  
 565 paver. The Engineer shall observe the contractor measuring the temperature  
 566 of mix in hauling vehicle just before depositing into spreader or paver or MTV.

567  
 568 Deposit HMA in a manner that minimizes segregation. Raise truck  
 569 beds with tailgates closed before discharging HMA.

570  
 571 Lay, spread, and strike off HMA upon prepared surface. Where  
 572 practical, use asphalt pavers to distribute mixture.

573  
 574 Where practical, control horizontal alignment using automatic grade  
 575 and slope controls from reference line, slope control device. Existing  
 576 pavements or features shall not be used for grade control alone.

577  
 578 Obtain sensor grade reference, horizontal alignment by using  
 579 established grade and slope controls. For subsequent passes, substitution  
 580 of one ski with joint-matching shoe riding on finished adjacent pavement is  
 581 acceptable. Use of a comparable non-contact mobile reference system and  
 582 joint matching shoe is acceptable.

583           Avoid stop-and-go operation. Maintain a constant forward speed of  
584 paver during paving operation and minimize other methods that impact  
585 smoothness.  
586

587           Offset longitudinal joint in successive lifts by approximately 6 inches.  
588 Incorporate into paving method an overlap of material of 1-inch +/- 0.5 inches  
589 at the longitudinal joint. The HMA overlap material shall be left alone when  
590 initially placed and shall not be bumped back or pushed back with a lute or  
591 any other hand-held device. If the overlap exceeds the maximum amount,  
592 remove the excess with a flat shovel, allowing recommended amount of  
593 overlap HMA material to remain in place to be compacted. Do not throw the  
594 removed excess HMA material on to the paving mat. The longitudinal joint  
595 in a surface course when total roadway width is comprised of two lanes shall  
596 be near the centerline of pavement or near lane lines when roadway is more  
597 than two lanes in width. The longitudinal joint shall not be constructed in the  
598 wheel path or under the longitudinal lane lines. Make a paving plan drawing  
599 showing how the longitudinal joint will not be located in these areas.  
600

601           Control the horizontal alignment of the longitudinal edge of the HMA  
602 mat being installed so that the edge is parallel to the centerline or has a  
603 uniform alignment, e.g., the edge of the mat is straight line or uniform curve,  
604 no wavy edge, etc. to have a consistent amount of HMA material at the joint.  
605

606           Check the compaction of the longitudinal joint during paving often  
607 enough to ensure that it will meet the compaction requirements.  
608

609           If nuclear gauges and ground penetrating radar are used as the  
610 contractor's quality control method, they shall be properly calibrated and  
611 periodically checked by comparison to cores taken from the pavement. The  
612 use of sand as an aid in properly seating the gauge may also be considered  
613 for improving the accuracy of the gauge.  
614

615           In areas where irregularities or unavoidable obstacles make use of  
616 mechanical spreading and finishing equipment impracticable, spread, rake,  
617 and lute mixture by hand tools. For such areas, deposit, spread evenly, and  
618 screed mixture to required compacted thickness.  
619

620           Demonstrate competence of personnel operating grade and crown  
621 control device before placing surface courses. If automatic control system  
622 becomes inoperative during the day's work, the Engineer will permit the  
623 Contractor to finish day's work using manual controls. The Engineer may  
624 also allow additional HMA to be ordered and placed using manual controls if  
625 it will provide a safer work site for the public to travel through. Do not resume  
626 work until automatic control system is made operative. The Engineer may  
627 waive requirement for electronic screed control device when paving gores,

## 401.03

628 shoulders, transitions, and miscellaneous reconstruction areas where the  
629 use of the devices is not practical.

630  
631 When production of HMA can be maintained and when practicable,  
632 use pavers in echelon shall be used to place surface course in adjacent  
633 lanes.

634  
635 At the end of each workday, HMA pavement that is open to traffic shall  
636 not extend beyond the panel of the adjacent new lane pavement by more  
637 than the distance normally placed in one workday. At end of each day's  
638 production, construct tapered transitions along all longitudinal and transverse  
639 pavement drop-offs; this shall apply to areas where existing pavement is to  
640 meet newly placed pavement. Use slopes of 6:1 for longitudinal taper  
641 transitions and 48:1 for transverse tapered transitions. Maximum drop-off  
642 height along the joints shall be 2 inches. Also, using a 48:1 slope provides a  
643 taper around any protruding object, e.g., manholes, drain boxes, survey  
644 monuments, inlets, etc., that may be above pavement surface when opened  
645 to the public. If the object is below the surface of the pavement then fill the  
646 depression until it is level with the surrounding pavement or raise depressed  
647 objects to the finish grade of the placed pavement. Remove and dispose of  
648 all transition tapers before placing adjoining panel or next layer of HMA.  
649 Notify traveling public of pavement drop-offs or raised objects with signs  
650 placed in every direction of traffic that may use and encounter pavement  
651 drop-offs or protruding objects or holes.

652  
653 Use the same taper rates for areas where there is a difference in  
654 elevation due to construction work.

655  
656 At end of each workweek, complete full width of the roadway's  
657 pavement, including shoulders, to same elevation with no drop-offs.

658  
659 **(F) Compaction.** Immediately after spreading and striking off HMA and  
660 adjusting surface irregularities, uniformly compact mixture by rolling.

661  
662 Initiate compaction at highest mix temperature allowing compaction  
663 without excessive horizontal movement. Temperature shall not be less than  
664 220 degrees F.

665  
666 Finish rolling using tandem roller while HMA temperature is at or  
667 above 175 degrees F.

668  
669 On superelevated curves, begin rolling at lower edge and progress to  
670 higher edge by overlapping of longitudinal trips parallel to centerline.

671  
672 If necessary, repair damage immediately using rakes and fresh mix.  
673 Do not displace line and grade of HMA edges during rolling.

674  
675  
Keep roller wheels properly moistened with water or water mixed with small quantities of detergent. Use of excess liquid, diesel, and petroleum-based liquids will not be allowed on rollers.

Along forms, curbs, headers, walls and other places not accessible to rollers, compact mixture with hot hand tampers, smoothing irons, or mechanical tampers. On depressed areas, trench roller or cleated compression strips under roller may be used to transmit compression.

Before the start of compaction or during compaction or both remove pavement that is loose, broken, or contaminated, or combination thereof; pavement that shows an excess or deficiency in asphalt binder content; and pavement that is defective in any way. Replace with fresh HMA pavement of same type, and compact. Remove and replace defective pavement and compact at no increase in contract price or contract time.

Operate rollers at slow and uniform speed with no sudden stops. The drive wheels shall be nearest to the paver. Continue rolling to attain specified density and until roller marks are eliminated.

Rollers shall not be parked on the pavement placed that day or shift.

**(1) HMA Pavement Courses One and a Half Inches Thick or Greater.** Where HMA pavement compacted thickness indicated in the Contract Documents is 1-1/2 inches or greater, compact to not less than 93.0 percent nor greater than 97.0 percent of the maximum specific gravity determined in accordance with AASHTO T 209, modified by deletion of Supplemental Procedure for Mixtures Containing Porous Aggregate.

Place HMA pavement in individual lifts that are within minimum and maximum allowable compacted thickness for various types of mixture as specified in Table 401.02-1 - Limits of Compacted Lift Thickness and Asphalt Content.

**(2) HMA Pavement Courses Less Than One and a Half Inches Thick.** Where HMA pavement compacted thickness indicated in the contract documents is less than 1-1/2 inches, compaction to a specified density will not be required.

Use only non-vibratory, steel-tired, tandem roller. Roll entire surface with minimum of two roller passes. A roller pass is defined as one trip of the roller in one direction over any one spot.

720 For intermediate rolling, roll entire surface with minimum of four  
721 passes of roller.

722  
723 Finish rolling using steel-tired, tandem roller. Continue rolling  
724 until entire surface has been compacted with minimum of three passes  
725 of roller, and roller marks have been eliminated.

726  
727 Do not use rollers that will excessively crush aggregate.

728  
729 **(3) HMA Pavement Courses One and a Half Inches Thick or**  
730 **Greater In Special Areas Not Designated For Vehicular Traffic.**

731 For areas such as bikeways that are not part of roadway and other  
732 areas not subjected to vehicular traffic, compact to not less than 90.0  
733 percent of maximum specific gravity determined in accordance with  
734 AASHTO T 209, modified by deletion of Supplemental Procedure for  
735 Mixtures Containing Porous Aggregate. Increase asphalt content by  
736 at least 0.5 percent above that used for HMA pavements designed for  
737 vehicular traffic. Paved shoulders shall be compacted in the same  
738 manner as pavements designed for vehicular traffic.

739  
740 **(G) Joints, Trimming Edges and Utility Marking.** At HMA pavement  
741 connections to existing pavements, make joints vertical to depth of new  
742 pavement. Saw cut existing pavement and cold plane in accordance with  
743 Section 415 - Cold Planing of Existing Pavement to depth equal to thickness  
744 of surface course or as indicated in the Contract Documents.

745  
746 At HMA connections to previously placed lifts, form transverse joints  
747 by cutting back on previous run to expose full depth of course. Dispose of  
748 material trimmed from edges. Protect end of freshly laid mixture from rollers.

749  
750 Before and after paving, identify and mark location of existing utility  
751 manholes, valves, and handholes on finished surface. Adjust existing frames  
752 and covers and valve boxes to final pavement finish grade in accordance with  
753 Section 604 - Manholes, Inlets and Catch Basins and Section 626 - Manholes  
754 and Valve Boxes for Water and Sewer Systems.

755  
756 **(1) Longitudinal joints.** Submit for review the means and methods  
757 that will be used to install longitudinal joints at the required compaction  
758 and density. Compact longitudinal joints to be not less than 91.0  
759 percent of the maximum specific gravity determined in accordance  
760 with AASHTO T 209, modified by deletion of Supplemental Procedure  
761 for Mixtures Containing Porous Aggregate. Verify the compaction of  
762 the longitudinal joints meets requirements by using non-destructive  
763 testing methods during paving and submit the results on the daily  
764 quality control test reports.

765



766 Test for compaction and density regardless of layer thickness.  
767 Compaction and density of the longitudinal joint shall be determined by using  
768 six-inch diameter cores. For longitudinal joints made using butt joints cores  
769 shall be taken over the joint with half of the core being on each side of the  
770 joint. For longitudinal joints using notch wedge joints, center core over the  
771 center of the wedge so that 50 percent of the material is from the most  
772 recently paved material and the remaining 50 percent of the core is from the  
773 material used to pave the previous layer. One core shall be taken at a  
774 maximum frequency of every 1,500 lineal feet (LF) of the second side of the  
775 longitudinal joint and any fraction of that length for each day of paving with a  
776 minimum of one core taken for each longitudinal joint per day. Cores taken  
777 for the testing of the longitudinal joint may be used to determine pavement  
778 thickness.  
779

780 When the longitudinal joints are found to have less than 91.0 percent  
781 of the maximum specific gravity, overband all longitudinal joints within the  
782 entire lot represented by the non-compliant core, PG binder seal coat, or  
783 other type of joint enrichment accepted by the Engineer. The overband shall  
784 not decrease the skid resistance of the pavement under any ambient weather  
785 condition. Submit overband material's catalog cuts, test results and  
786 application procedure for review and acceptance by the Engineer before use.  
787 Center the overband over the longitudinal joint. The overband shall be placed  
788 in a uniform width and horizontal alignment. The overband shall have no  
789 holidays or streaking in its placement. The width of the overband shall be  
790 based on how the longitudinal joint was constructed or as directed by the  
791 Engineer. If a notch joint is used, the overband width shall be a minimum of  
792 12-inches. For butt wedge or wedge joints the overband width shall be the  
793 width of the wedge plus an additional six-inches minimum. Replace any  
794 pavement markings damaged or soiled by the overband remedial repair  
795 process.  
796

797 For longitudinal joints that have a compaction of less than 89 percent  
798 of the maximum specific gravity; removal may be required by the Engineer  
799 instead of overbanding the non-compliant joint.  
800

801 Persistent low compaction results may be cause to suspend work and  
802 remove non-conforming work. During the suspension of paving, revise  
803 means and methods used in constructing longitudinal joints and submit to the  
804 Engineer for review and acceptance. Suspension may occur when:  
805

- 806 (1) Two or more longitudinal joints tests fail to meet the minimum  
807 compaction
- 808 (2) One sample reveals that the joint compaction is 89 percent or  
809 less.  
810

811 **(H) HMA Pavement Samples.** Obtain test samples from compacted  
 812 HMA pavement within 72 hours of lay down. Provide minimum 4-inch  
 813 diameter cores consisting of undisturbed, full-depth portion of compacted  
 814 mixture taken at locations designated by the Engineer in accordance with the  
 815 “Sampling and Testing Guide for Acceptance and Verification” in Hawaii DOT  
 816 Highways Division, *Quality Assurance Manual for Materials*, Appendix 3.  
 817 Cores shall be taken in the presence of the Engineer. Turn cores over to  
 818 Engineer immediately after cores have been taken.

819  
 820 For pavement samples for longitudinal joints provide 6-inch diameter  
 821 cores minimum. For pavement samples for other than longitudinal joints  
 822 4-inch diameter cores minimum shall be taken. All cores shall consist of  
 823 undisturbed, full-depth of the lift of the compacted mixture taken at locations  
 824 designated by the Engineer in accordance with the “Sampling and Testing  
 825 Guide for Acceptance and Verification” in Hawaii DOT Highways Division,  
 826 *Quality Assurance Manual for Materials*, appendix 3. Coring of longitudinal  
 827 joints shall use a modified HDOT Sampling and Testing Guide as required  
 828 by the Contract Documents.

829  
 830 Cores that separate shall indicate to the Engineer that there is  
 831 insufficient bonding of layers. Modify the previously used paving means and  
 832 methods to prevent future debonding of layers. Debonding of a core sample  
 833 after adjustment of the Contractor’s methods will be an indication of  
 834 continued non-conforming work and the Engineer may direct removal of the  
 835 layer at no additional cost or contract time.

836  
 837 Restore HMA pavement immediately after obtaining samples. Clean core  
 838 hole and walls of all deleterious material that will prevent the complete filling  
 839 of the core hole and the bonding of the new HMA to the existing. Apply tack  
 840 coat to vertical faces of sample holes. Fill sampled area with new HMA  
 841 pavement of same type as that removed. If hand compaction is used; fill in  
 842 layers not exceeding the minimum thickness stated in Table 401.02-1 - Limits  
 843 of Compacted Lift Thickness And Asphalt Content. Compact each layer to  
 844 compaction requirements. If Mechanical Compaction methods are used, then  
 845 layers may be the maximum layer thickness stated in Table 401.02-1 - Limits  
 846 of Compacted Lift Thickness And Asphalt Content. Using tires or hand  
 847 tamping to compact the HMA material to restore the pavement shall not be  
 848 considered as mechanical compaction.

849  
 850 Only sample and test leveling course if 1-1/2 inches or greater. No  
 851 compaction requirements for less than 1-1/2 inches.

852  
 853 **(I) HMA Pavement Thickness Tolerances.**

854  
 855 Thickness of finished HMA pavement shall be within 0.25 inch of  
 856 thickness indicated in the Contract Documents. Pavement not meeting the

857 thickness requirements of the Contract Documents may be required by the  
858 Engineer to be removed and replaced.

859  
860 Corrective methods taken on pavement exceeding specified  
861 tolerances, e.g., insufficient thickness by methods accepted by the Engineer,  
862 including removal and replacement, shall be at no increase in contract price  
863 or contract time.

864  
865 The checking of pavement thickness shall be done after all remedial  
866 repairs, e.g., smoothness compliance repairs, compaction, have been  
867 completed, reviewed, and accepted by the Engineer.

868  
869 **(J) Quality Control Using New Technology.** The Engineer and MTRB  
870 reserves the right to utilize new technology and methods to improve the  
871 detection of noncompliant work on the project. The technology or method  
872 may be used to locate defects in the work, e.g., ground penetrating radar to  
873 locate delaminations, moisture damage, thin sections, voids, non-compliant  
874 compaction, other non-destructive testing to locate flaws. The defect will be  
875 verified by the methods stated in the Contract Documents or by other  
876 established conventional means. If the technology or method has already  
877 been accepted elsewhere or has standardized testing procedures the results  
878 may be judged acceptable by the Engineer and no further testing will be  
879 required. These new technologies and methods may be used for the  
880 selection of sampling locations.

881  
882 **(K) Protection of HMA Pavement.** Except for construction equipment  
883 directly connected with paving operations, keep traffic off HMA pavement.

884  
885 Protect HMA pavement from damage until it has cooled and set.

886  
887 Do not refuel equipment or clean equipment or hand tools over paved  
888 surfaces unless catch pan or device that will contain spilled fuel and other  
889 products is provided. After completion of refueling or cleaning, remove catch  
890 pan or device without spilling any of the collected content.

891  
892 Do not park roller or other paving equipment on HMA pavement paved  
893 within 24 hours of laydown.

894  
895 **(L) Pavement Joint Adhesive**

896  
897 **(1) Pavement Joint Adhesive on Joints.** Use on all asphalt  
898 pavement construction where joints are formed at such  
899 locations but not limited to the following:

900  
901 **(a)** Adjacent asphalt pavements, e.g., trafficked lanes,  
902 shoulders, etc.

**401.03**

903  
 904  
**(b)** Asphalt pavement and adjacent concrete pavement or curb and gutter or any other surface where the bonding of the asphalt pavement and concrete surface is desired,

**(c)** Transverse joints between asphalt pavements not placed at the same time or if the pavement's temperature on one side of the joint is below the minimum temperature the mix can be at, during asphalt pavement compaction or installation.

**(d)** Cut face of an existing pavement where it will have new HMA pavement placed against it, e.g., utility trenches, partial or full depth repairs, etc.

Pavement joint adhesive is not required on a longitudinal construction joint between adjacent hot mix asphalt pavements formed by echelon paving. Echelon paving is defined as paving multiple lanes side-by-side with adjacent pavers slightly offset at the same time.

A longitudinal construction joint between one shift's work and another shall have pavement joint adhesive applied at the joint. Any longitudinal construction joint formed, with the temperature on one side of the joint that is below the minimum temperature the mix can be when compacted to contract requirements during asphalt pavement installation, shall have pavement joint adhesive applied at the joint.

**(2) Material requirements.** Asphalt joint adhesive shall meet requirements as specified in Table 401.03-1 - Asphalt Joint Adhesive Specifications.

| <b>TABLE 401.03-1 – ASPHALT JOINT ADHESIVE SPECIFICATIONS</b> |             |                      |
|---|-------------|----------------------|
| <b>TEST</b>   |             | <b>SPECIFICATION</b> |
| Brookfield Viscosity, 204 °C [400 °F]                         | ASTM D 3236 | 4,000-10,000 cp      |
| Cone Penetration, 25 °C [77 °F]                               | ASTM D 5329 | 60-100 dmm           |
| Resilience, 25 °C [77 °F]                                     | ASTM D 5329 | 30% minimum          |
| Ductility, 25 °C [77 °F]                                      | ASTM D 113  | 30 cm minimum        |
| Ductility, 4 °C [39.2 °F]                                     | ASTM D 113  | 30 cm minimum        |
| Tensile Adhesion, 25 °C [77 °F]                               | ASTM D 5329 | 500% minimum         |
| Softening Point   | ASTM D 36   | 77 °C [170 °F] min.  |
| Asphalt Compatibility   | ASTM D 5329 | Pass                 |

934  
 935

**(3) Construction Requirements for Asphalt Joint Adhesive**

936  
 937  
**(a) Equipment Requirements.** Use a jacketed double boiler type melting unit, with both agitation and recirculation systems. Provide a pressure feed wand application system.

**(b) Material Handling.** Submit a copy of the manufacturer's recommendations for heating, re-heating, and applying the joint adhesive material. Follow manufacturer's recommendations. Do not remove the joint adhesive from the package until immediately before it is placed in the melter. Joint adhesive boxes must be clearly marked with the name of the manufacturer, the trade name of the adhesive, the manufacturer's batch and lot number, the application/pour temperature, and the safe heating temperature. Feed additional material into the melter at a rate equal to the rate of material used.

Verify the pouring temperature of the joint adhesive at least once per hour at the point of discharge. Stop production if the adhesive falls below the recommended application/pour temperature. When the temperature of the adhesive exceeds the maximum safe heating temperature, stop production, empty the melter, and dispose of that adhesive in an environmentally safe method. No payment will be made for this material or its disposal.

Do not blend or mix different manufacturer's brands or different types of adhesives.

**(c) Joint Adhesive Application:** The face of the joint that the new asphalt pavement will bind to shall be clean and dry before the joint adhesive is applied. Apply the pavement joint adhesive material to the entire face of the surface where HMA pavement shall be installed. The thickness of the asphalt adhesive application shall be approximately 1/8 inch. Use an application shoe attached to the end of application wand. Do not overlap the joint by greater than 1/2-inch at the top of the joint or two-inches at the bottom of the joint. Apply the joint adhesive immediately in front of the paving operation. If the adhesive is tracked by construction vehicles, repair the damaged area, and restrict traffic from driving on the adhesive.

979  
980  
**(d) Field Sampling.** Take a sample from the application wand during the first 20 minutes of placing sealant. One sample should be taken per manufacturer’s batch or minimum of every 6 months on the Project in the presence of the Engineer.

Each sample shall consist of one quart in an aluminum or steel sample container. The sampling container shall be labeled with Contractor’s name; project name and number; date and time sample taken; location of where material was used at, e.g., from where to where it was used at in stations; manufacturer and lot number of the sealant. Turn over samples to Engineer without Engineer losing sight of the sample. The Engineer reserves the right to conduct supplementary sampling and testing of the sealant material.

**(M) Pavement Smoothness Rideability Test.** Perform surface profile tests frequently to ensure that the means and methods being used produces pavement that is compliant with the surface profile smoothness requirement. Test the pavement surface for smoothness with High-Speed Inertial Profiler to determine the International Roughness Index (IRI) of the pavement. For the locations determined by the Engineer, a 10-foot straightedge shall be used to measure smoothness.

All smoothness testing must be performed with the presence of the Engineer. The High-Speed Inertial Profiler operator shall be a certified operator by MTRB or the manufacturer.

The High-Speed Inertial Profiler operator’s certification shall be no older than five years old at the date of the Notice to Proceed and at the day of the pavement profile measurement.

The finished pavement shall comply to all the following requirements:

**(a) Smoothness Test using 10-Foot Straightedge (Manual or rolling)** The 10-foot straightedge is used to identify the locations that vary more than 3/16 inch from the lower edge when the 10-foot straightedge is laid on finished pavement on the direction parallel with the centerline or perpendicular to centerline. Remove the high points that cause the surface to exceed that 3/16 inch tolerance by grinding.

The Contractor shall use a 10-foot straightedge for the following locations:

- 1023 1. Longitudinal profiling parallel to centerline, when within  
 1024 15 feet of a bridge approach or existing pavement which is  
 1025 being joined.  
 1026
- 1027 2. Transverse profiling of cross slopes, approaches, and as  
 1028 otherwise directed. Lay the straightedge in a direction  
 1029 perpendicular to the centerline.  
 1030
- 1031 3. When pavement abuts bridge approaches or pavement  
 1032 not under this Contract, ensure that the longitudinal slope  
 1033 deviations of the finished pavement comply with Contract  
 1034 Document's requirements.  
 1035
- 1036 4. Short pavement sections up to 600 feet long, including  
 1037 both mainline and non-mainline sections on tangent sections  
 1038 and on horizontal curves with a centerline radius of curve less  
 1039 than 1,000 feet.  
 1040
- 1041 5. Within a superelevation transition on horizontal curves  
 1042 having centerline curve radius less than 1,000 feet, e.g.,  
 1043 curves, turn lanes, ramps, tapers, and other non-mainline  
 1044 pavements.  
 1045
- 1046 6. Within 15 feet of transverse joint that separates  
 1047 pavement from existing pavement not constructed under the  
 1048 contract, or from bridge deck or approach slab for longitudinal  
 1049 profiling.  
 1050
- 1051 7. At miscellaneous areas of improvement where width is  
 1052 less than 11 feet, such as medians, gore areas, and shoulders.  
 1053
- 1054 8. As otherwise directed by the Engineer. The Engineer  
 1055 may confine the checking of through traffic lanes with the  
 1056 straightedge to joints and obvious irregularities or choose to  
 1057 use it at locations not specifically stated in this Section.  
 1058

1059 **(b) High-Speed Inertial Profiler**  
 1060

1061 There shall be a minimum 3 profile runs per lane, for each wheel path  
 1062 (left and right) which is approximately three feet from edge lane line. The  
 1063 segment length shall be 0.1 mi. The final segments in a lane that are less  
 1064 than 0.1 mi shall be evaluated as an independent segment and pay  
 1065 adjustments will be prorated for length. The profiles shall be taken in the  
 1066 direction of traffic only.  
 1067

1068 The latest version of FHWA ProVAL software shall be used to conduct

**401.03**

1069  
1070  
profile analysis to determine IRI and areas of localized roughness. The IRI values shall be reported in units of in/mi.

Areas of localized roughness will be identified by using ProVAL’s “Smoothness Assurance” analysis, calculating IRI with a continuous short interval of 25 feet and the 250-mm filter applied.

Additional runs may be required by the Engineer if the data indicate a lack of repeatability of results. A 92% agreement is required for repeatability and IRI values shall have at minimum a 95% confidence level.

**(N) Required Pavement Smoothness**

The IRI for the left and right wheel paths in an individual lane will be computed and then averaged to determine the Mean Roughness Index (MRI) values. The MRI will be used to determine acceptance and pay adjustment. Each lane shall be tested and evaluated separately.

There are three (3) categories of target MRI values:

| <b>TABLE 401.03-2 – PAVEMENT SMOOTHNESS CATEGORIES</b> |  |                           |
|--|--|---------------------------|
| <b>Category</b>  | <b>Description</b>                             | <b>MRI</b>                |
| Type A   | Three or more opportunities for improving ride | Shall not exceed 60 in/mi |
| Type B   | Two opportunities for improving ride           | Shall not exceed 70 in/mi |
| Type C   | One opportunity for improving ride             | Shall not exceed 75 in/mi |

1089  
1090  
1091  
1092  
1093  
1094  
1095  
1096  
1097  
1098  
1099  
1100  
1101  
1102  
1103  
1104  
1105  
1106

An opportunity for improving ride is considered as one (1) lift of asphalt pavement, including but not limited to HMAB, HMA, PMA, and SMA.

For the location where a 10-foot manual straightedge is required, the surface shall not vary more than 3/16 inch from the lower edge of a straightedge.

No pre-final inspection, final inspection, and substantial completion granted will be made until the pavement meets smoothness requirement and all required profile reports are submitted to the Engineer and MTRB and are accepted.

**(O) Request for Profile Testing by the Department.**

For Type C, prior to pavement activities, the Engineer will measure the smoothness of the existing pavement.



1107 The Contractor shall submit a written request to the Engineer to  
1108 perform all required profile tests.

1109  
1110 The request shall be made at least 30 days before desired testing date  
1111 and shall include an approximate acceptance profile testing date, a plan view  
1112 drawing of the area to be tested with the limits of the test area highlighted.

1113 The Contractor shall reimburse HDOT for any incurred cost related to  
1114 any Contractor-caused cancellation or a deduction to the monthly payment  
1115 will be made.

1116  
1117 **(P) Department Requirements for Profile Testing.** When a request for  
1118 testing is made, the requested area to be tested shall be 100% of the total  
1119 area indicated to be paved in the Contract Documents unless the requirement  
1120 is waived by the Engineer and MTRB.

1121  
1122 Department acceptance surface tests will not be performed earlier  
1123 than 14 days after HMA placement.

1124  
1125 Clean debris and clear obstructions from area to be tested, as well as  
1126 a minimum of 100 feet before and beyond the area to be tested before testing  
1127 starts for use as staging areas. Provide traffic control for all profile testing.

1128  
1129 The Engineer or MTRB or both may cancel the profile testing if the test  
1130 area is not sufficiently clean, traffic control is unsatisfactory, or the area is not  
1131 a safe work environment or test area does not meet Contract Document  
1132 requirements. This canceled profile test will count as one profile test.

1133  
1134 **(Q) Cost of Acceptance Profile Testing by The Department.** The  
1135 Engineer, MTRB, or State's Third-Party Consultant will perform one initial  
1136 profile test, at no cost to the Contractor for each area to be tested.

1137  
1138 The Department's High-Speed Inertial Profiler pavement profile will be  
1139 used to determine if the pavement's profile, i.e., smoothness is acceptable.

1140  
1141 If the profile of the pavement does not meet the requirements of the  
1142 Contract Documents, the Contractor shall perform remedial work, i.e.  
1143 corrective work then retest the area to ensure that the area has the required  
1144 MRI, i.e., smoothness, before requesting another profile test by the Engineer.

1145  
1146 **(1) Additional testing.** Additional testing, by the Department  
1147 beyond the initial test will be performed at cost to the Contractor as  
1148 follows:

1149  
1150 **(a)** \$2,500 per test will be required when Department  
1151 personnel or State's Third-Party Consultant is used.

1152

1153  
**(R) Remedial Work for Pavements.**

**(1)** Corrective work shall be required for any 25 ft interval with a localized roughness in excess of 160 in/ mi. The Engineer may waive localized roughness requirements for deficiencies resulting from manholes or other similar appurtenances. Adjust manholes or other similar appurtenances so that using a 10-ft. straightedge the area around that manhole or other similar appurtenance shall not have more than 3/16-in. variation between any 2 contacts on the straightedge.

If corrective action is not successful, the Engineer may require continued corrective action, or apply a payment adjustment of \$250 per occurrence.

**(2)** Corrective work shall also be required for any 0.1 mile interval with an average MRI above 95.0 in/mi for Types A and B. For Type A, correct the deficient section to an MRI of 60 in/mi or less. For Type B, correct the deficient section to an MRI of 70 in/mi or less. For Type C, corrective work may be required by the Engineer for 0.1 mile intervals that have an average MRI above the threshold shown in Tables 401.03-4 (Smoothness Pay Disincentives with MRI) and 5 (Smoothness Pay Disincentives for Percent Improvement) as applicable.

If corrective action does not produce the required improvement, the Engineer may require continued corrective action, or apply payment adjustment as shown in Tables 401.03-4 (Smoothness Pay Disincentives with MRI) and 5 (Smoothness Pay Disincentives for Percent Improvement).

**(3)** The Contractor shall notify the Engineer at least 24 hours prior to commencement of the corrective work. The Contractor shall not commence corrective work until the methods and procedure have been approved in writing by the Engineer.

**(4)** All smoothness corrective work for areas of localized roughness shall be for the entire lane width. Pavement cross slope shall be maintained through corrective areas.

**(5)** The remedial repair areas shall be neat, rectangular areas having a uniform surface appearance.

- 1199 (6) If grinding is used on HMA pavement, the surface shall have  
1200 nearly invisible grinding marks to passing motorist.  
1201
- 1202 (7) Other methods may include milling and overlaying HMA  
1203 pavement. The length, depth of the milling and the replacement  
1204 material will be solely decided by the Engineer.  
1205
- 1206 (8) The finished repaired pavement surface shall leave no ridges  
1207 or valleys or fins of pavement other than those allowed below.  
1208
- 1209 (9) Remedial repairs shall not leave any drainage structures' inlets  
1210 higher than the surrounding pavement or alter the Contract  
1211 Document's drainage pattern.  
1212
- 1213 (10) For items in the pavement other than drainage structures, e.g.,  
1214 manhole frame and covers, survey monuments, expansion joints etc.,  
1215 the finish pavement, ground or not, shall not be more than 1/4 inch in  
1216 elevation difference. Submit to the Engineer remedial repair method  
1217 to correct these conditions for acceptance.  
1218
- 1219 (11) Pick up immediately grinding operation residue by using a  
1220 vacuum attached to grinding machine or other method acceptable to  
1221 the Engineer.  
1222
- 1223 (a) Any remaining residue shall be picked up before the end  
1224 of shift or before the area is open to traffic, whichever is earlier.  
1225
- 1226 (b) Prevent residue from flowing across pavement or from  
1227 being left on pavement surface or both.  
1228
- 1229 (c) Residue shall not be allowed to enter the drainage  
1230 system.  
1231
- 1232 (d) The residue shall not be allowed to dry or remain on the  
1233 pavement.  
1234
- 1235 (e) Dispose of all material that is the result of the remedial  
1236 repair operation, e.g., HMA residue, wastewater, and dust at a  
1237 legal facility.  
1238
- 1239 (12) Complete corrective work before determining pavement  
1240 thickness for HMA pavements in accordance with Subsection  
1241 401.03(I) – HMA Pavement Thickness Tolerances.  
1242
- 1243 (13) All HMA wearing surface areas that have been ground shall  
1244 receive a coating, e.g., a coating material that will restore any lost

1245 impermeability of the HMA due to the grinding of the surface. The  
 1246 coating used shall not be picked up or tracked by passing vehicles or  
 1247 be degraded after a short period of time has passed, i.e., it shall have  
 1248 a service life equal to or greater than the HMA pavement. The coating  
 1249 shall not decrease the pavement's friction value. The coating's limits  
 1250 shall be the full width of the lane regardless how small. If the remedial  
 1251 repair area extends into the next lane, then the repair area will be full  
 1252 lane width also. Extend the length of coating areas in order for the  
 1253 coating area to look like the rest of the road and does not have patches  
 1254 on it, i.e., make the road look uniform in color. The coating shall be of  
 1255 a color that matches the surrounding pavement. The areas receiving  
 1256 the coating shall not be open to traffic until it has cured enough so that  
 1257 it cannot be picked up or tracked by passing vehicles or degrade.  
 1258 Submit means and methods of the coating and type of coating to the  
 1259 Engineer or MTRB for review and acceptance. Do not proceed with  
 1260 the coating without acceptance from the Engineer.

1261  
 1262 **(14)** Recompacting cold HMA, i.e., HMA that has reached ambient  
 1263 temperature is not an acceptable remedial repair method.

1264  
 1265 **(15)** Replace all pavement markings damaged or discolored by  
 1266 remedial repairs.

1267  
 1268 **(16)** Reprofile the corrected area and provide the Engineer the  
 1269 results that show the corrective action, i.e., remedial repairs were  
 1270 successful.

1271  
 1272 **(S) Pavement Smoothness and Acceptance.**

1273  
 1274 **(1)** Price and payment in various paving sections, e.g., 401 (Hot  
 1275 Mix Asphalt Pavement), shall be full compensation for all work and  
 1276 materials specified in the various paving sections and this section,  
 1277 including but not limited to furnishing all labor, materials, tools,  
 1278 equipment, testing, incidentals and for doing all work involved in micro  
 1279 milling, milling (cold planing), grinding existing or new pavement,  
 1280 removing residue, cleaning the pavement, necessary disposal of  
 1281 residue, furnishing of any water or air used in cleaning the pavement  
 1282 and any other related ancillary work or material or services. Also, it  
 1283 includes any remedial work, e.g., re-paving, surface grinding,  
 1284 application of a coating, curing compound, and replacement of  
 1285 damaged pavement markings.

1286  
 1287 **(2)** The contract price in those sections may be adjusted for  
 1288 pavement smoothness by the Engineer. The pavement smoothness  
 1289 contract unit price adjustments and work acceptance will be made in  
 1290 accordance with the following schedules.

| <b>TABLE 401.03-3 –SMOOTHNESS PAY INCENTIVES</b> |                      |   |
|--|----------------------|---|
| <b>Category</b>                                  | <b>MRI (in/mi)</b>   | <b>Pay Adjustment<br/>\$ per 0.1 mi</b> |
| Type A   | <30.0                | \$580                                   |
|  | 30.0- less than 35.0 | \$480                                   |
|  | 35.0- less than 40.0 | \$380                                   |
|  | 40.0- less than 45.0 | \$280                                   |
|  | 45.0- less than 50.0 | \$180                                   |
|  | 50.0- less than 55.0 | \$80                                    |
|  | 55.0- less than 60.0 | \$0                                     |
| Type B   | <35.0                | \$420                                   |
|  | 35.0- less than 40.0 | \$360                                   |
|  | 40.0- less than 45.0 | \$300                                   |
|  | 45.0- less than 50.0 | \$240                                   |
|  | 50.0- less than 55.0 | \$180                                   |
|  | 55.0- less than 60.0 | \$120                                   |
|  | 60.0- less than 65.0 | \$60                                    |
|  | 65.0- less than 70.0 | \$0                                     |
| Type C   | <40.0                | \$280                                   |
|  | 40.0- less than 45.0 | \$240                                   |
|  | 45.0- less than 50.0 | \$200                                   |
|  | 50.0- less than 55.0 | \$160                                   |
|  | 55.0- less than 60.0 | \$120                                   |
|  | 60.0- less than 65.0 | \$80                                    |
|  | 65.0- less than 70.0 | \$40                                    |
|  | 70.0- less than 75.0 | \$0                                     |

1291  
1292

**401.03**

1293  
1294  
**(3)** Pay Pavement Smoothness Adjustment will be based on the initial measured MRI for both left and right wheel path, prior to any corrective work for the 0.10-mile section, except for sections that the Contractor has chosen to remove and replace. For sections that are replaced, assessments will be based on the MRI determined after replacement.

**(a)** The Pavement Smoothness Adjustment will be computed using the plan surface area of pavement shown in the Contract Documents. This Pavement Smoothness Adjustment will apply to the total area of the 0.10-mile section for the lane width represented by MRI for the same lane. It does not include any other price adjustments specified in the Contract Documents. Those price adjustments will be, for each adjustment, calculated separately using the original contract price to determine the amount of adjustment to be made to the contract price. Sections shorter than 0.1 mile and longer than 50 feet shall be prorated.

**(b)** For 0.1 mile intervals with an average MRI above the threshold shown in Table 401.03-3 (Smoothness Pay Incentives), the Engineer shall apply a disincentive payment adjustment up to the limit shown.

- i. For Types A and B, payment adjustments shall be applied up to an MRI of 95.0 per Table 401.03-4 (Smoothness Pay Disincentives with MRI).
- ii. For Type C, the payment adjustment shall be dependent on the average MRI of the pavement prior to paving activities
  - 1. If the MRI of the pavement prior to paving activities is 125.0 in/mi or less, the payment adjustment shall be per Table 401.03-4 (Smoothness Pay Disincentives with MRI).
  - 2. If the MRI of the pavement prior to paving activities is more than 125.0 in/mi, the disincentive payment adjustment shall be per Table 401.03-5 (Smoothness Pay Disincentives for Percent Improvement), and based on the percent improvement using the following formula:

$$\% \text{ Improvement} = (\text{Initial segment MRI} - \text{Final segment MRI}) \times 100 / (\text{Initial Segment MRI})$$

1339

| <b>TABLE 401.03-4 –SMOOTHNESS PAY DISINCENTIVES WITH MRI</b> |                       |   |
|--|-----------------------|---|
| <b>Category</b>  | <b>MRI (in/mi)</b>    | <b>Pay Adjustment<br/>\$ per 0.1 mi</b> |
| Type A   | 60.0- less than 70.0  | -\$100                                  |
|  | 70.0- less than 75.0  | -\$250                                  |
|  | 75.0- less than 80.0  | -\$350                                  |
|  | 80.0- less than 85.0  | -\$450                                  |
|  | 85.0- less than 95.0  | -\$550                                  |
|  | > 95.0                | Corrective Work                         |
| Type B   | 70.0- less than 75.0  | -\$100                                  |
|  | 75.0- less than 80.0  | -\$200                                  |
|  | 80.0- less than 85.0  | -\$300                                  |
|  | 85.0- less than 95.0  | -\$400                                  |
|  | > 95.0                | Corrective Work                         |
| Type C<br>(pre-paving<br>MRI < 125)                          | 75.0- less than 80.0  | -\$50                                   |
|  | 80.0- less than 85.0  | -\$100                                  |
|  | 85.0- less than 90.0  | -\$150                                  |
|  | 90.0- less than 100.0 | -\$200                                  |
|  | >100.0                | -\$250                                  |

1340

| <b>TABLE 401.03-5 –SMOOTHNESS PAY DISINCENTIVES FOR<br/>PERCENT IMPROVEMENT</b> |                              |   |
|---|------------------------------|---|
| <b>Category</b>   | <b>Percent Improvement %</b> | <b>Pay Adjustment<br/>\$ per 0.1 mi</b> |
| Type C  | ≥ 40                         | \$0                                     |
| (pre-paving<br>MRI > 125)   | 20.0- less than 40.0         | -\$100                                  |
|   | < 20                         | -\$200                                  |

1341

1342

1343

1344

1345

1346

1347

1348

(c) Incentives will not apply to areas where payment deductions or remedial repairs has been made for non-compliant work, e.g., low compaction, thin pavement, thermal segregation, low compressive or flexural strength, non-compliant alignment. Incentives will also not apply to areas where corrective work was required to meet contract

## 401.05

1349 smoothness requirements, unless the pavement section was  
1350 replaced. All areas where corrective work was performed shall  
1351 be tested again to ensure the smoothness requirements are  
1352 met.

1353  
1354 **(d)** There will be no incentive price adjustments to the  
1355 contract prices regardless of the pavement meeting the  
1356 Contract Documents' requirements for incentive contract price  
1357 adjustment, when 25% of the total area paved of that particular  
1358 type of pavement on the project has failed to meet any of the  
1359 Contract document requirements, e.g., smoothness, thickness,  
1360 unit weight, asphalt content, pavement defects, compaction,  
1361 flexural or compressive strength. Areas exempt from the  
1362 smoothness requirements may not be included in the total area  
1363 calculation unless it is non-compliant.

1364  
1365 **(e)** For contracts using lump sum the method described in  
1366 Subsection 104.06 Methods of Price Adjustment paragraph (3),  
1367 will be used to calculate proportionate unit price, i.e., the  
1368 Engineer's calculated theoretical unit price. This calculated  
1369 proportionate unit price will be used to calculate the unit price  
1370 adjustment.

1371

### 401.04 Measurement.

1372

1373  
1374 **(A)** The Engineer will measure HMA and PMA pavement per ton in  
1375 accordance with the Contract Documents.

1376

1377 **(B)** The Engineer will measure Pavement Smoothness Incentive from an  
1378 allowance.

1379

1380 **(C)** Engineer will measure additional State pavement profiling work when  
1381 applicable on a cost-plus basis as specified in this section and as ordered by  
1382 Engineer. The Engineer will issue a billing for the pavement profile work done  
1383 for the time period with the invoices and receipts that the billing was based  
1384 on attached to the Contractor for each contract item. The Contractor's  
1385 pavement profile work required in this section will not be measured and will  
1386 be considered incidental to the various paving items unless stated otherwise.

1387

1388 **401.05 Payment.** The Engineer will pay for the accepted HMA and PMA  
1389 pavement at the contract price per pay unit, as shown in the proposal schedule.  
1390 Payment will be full compensation for the work prescribed in this section and the  
1391 contract documents.

1392

1393 **(A)** Price and payment in Section 401 – Hot Mix Asphalt (HMA) Pavement  
1394 will be full compensation for all work and materials specified in this Section



1395 including furnishing all labor, materials, tools, equipment, testing, pavement  
 1396 profiles and incidentals and for doing all work involved in grinding existing or  
 1397 new pavement, removing residue, and cleaning the pavement, including  
 1398 necessary disposal of residue and furnishing any water or air used in  
 1399 cleaning the pavement and remedial work needed to conform to the  
 1400 requirements of the Contract Documents.

1401  
 1402 **(B)** No payment for the Contractor’s pavement profile work required in this  
 1403 section will be made. The Contractor’s pavement profile work shall be  
 1404 considered incidental to the various paving items unless stated otherwise.

1405  
 1406 **(C)** Engineer will pay or deduct for the following pay items when included  
 1407 in proposal schedule:

| 1408 <b>Pay Item</b>                         | 1409 <b>Pay Unit</b> |
|--|----------------------|
| 1410   |                      |
| 1411 Pavement Smoothness Incentive           | 1412 Allowance       |
| 1413 HMA Pavement, Mix No. IV                | 1414 Ton             |
| 1415 HMA Pavement, Mix No. V                 | 1416 Ton             |
| 1417 PMA Pavement, Mix No. IV with PG 64E-22 | 1418 Ton             |

1419 **(1)** 70% of the contract unit price or the theoretical calculated unit  
 1420 price upon completion of submitting a job-mix formula acceptable to  
 1421 the Engineer; preparing the surface, spreading, and finishing the  
 1422 mixture; and compacting the mixture.

1423  
 1424 **(2)** 20% of the contract unit price or the theoretical calculated unit  
 1425 price upon completion of cutting samples from the compacted  
 1426 pavement for testing; placing and compacting the sampled area with  
 1427 new material conforming to the surrounding area; protecting the  
 1428 pavement; and compaction acceptance. Maintain temporary  
 1429 pavement markings and other temporary work zone items, maintain a  
 1430 clean work site.

1431  
 1432 **(3)** 10% of the contract unit price or calculate the unit price when  
 1433 the final configuration of the pavement markings is in place.

1434  
 1435 Emulsified Asphalt – Low Tracking Bond Coat (LTBC) 1436 Square Yard

1437 The Engineer will pay for adjusting existing frames and covers and valve  
 1438 boxes in accordance with and under Section 604 – Manholes, Inlets and Catch  
 1439 Basins. Adjustments for existing street survey monument frames and covers will be  
 1440 paid for as if each were a valve box frame and cover.

**401.05**

1441  
1442  
1443  
1444  
1445  
1446  
1447  
1448  
1449  
1450  
1451  
1452  
1453  
1454

The Engineer may, at his sole discretion, use the sliding scale factor as specified in Table 401.05-1 – Sliding Scale Pay Factor for Compaction to accept HMA pavements compacted between 90.0 percent and 98.0 percent. If the sliding scale factor is used, the Engineer will make payment for the material in that production day at a reduced price by multiplying the contract unit price by the pay factor. The Engineer is not obligated to allow non-compliant work to remain in place and may choose to require removal of the pavement that is less than 93.0 percent or greater than 97.0 percent.

Removal of non-compliant pavement shall be in accordance with Subsection 105.12 Removal of Non-Conforming and Unauthorized Work.

| <b>Table 401.05-1 – Sliding Scale Pay Factor for Compaction</b> |                                 |
|---|---------------------------------|
| <b>Percent Compaction</b>                                       | <b>Percent of Quantity Paid</b> |
| > 98.0  | Removal                         |
| >97.0 - 98.0  | 95                              |
| 93.0- 97.0  | 100                             |
| 90.0 - <93.0  | 80                              |
| <90.0   | Removal                         |

1455  
1456  
1457  
1458  
1459

**END OF SECTION 401”**

1 Amend Section 629 – Pavement Markings to read as follows:

2  
3 **“SECTION 629 - PAVEMENT MARKINGS**

4  
5  
6 **629.01 Description.** This section describes furnishing, installing, and removing  
7 pavement markings.

8  
9 **629.02 Materials.**

|    |  |        |
|----|--|--------|
| 10 |  |        |
| 11 | White and Yellow Traffic Paint                           | 755.01 |
| 12 |  |        |
| 13 | Pavement Markers   | 755.02 |
| 14 |  |        |
| 15 | Adhesives for Pavement Markers                           | 755.03 |
| 16 |  |        |
| 17 | Preformed Pavement Marking Tape                          | 755.04 |
| 18 |  |        |
| 19 | Retroreflective Thermoplastic Compound Pavement Markings | 755.05 |
| 20 |  |        |

21 Pavement markers shall be of uniform composition, free from surface  
22 irregularities, and free from other physical damage or defects that affect  
23 appearance or performance, or both.

24  
25 **629.03 Construction.**

26  
27 **(A) General.** Pavement markings shall conform to most recent edition  
28 of MUTCD, and as amended; and shall be applied as indicated in the  
29 contract documents.

30  
31 Establish control points and layout pavement markings.

32  
33 Remove surface moisture and other materials that may adversely  
34 affect bonding before applying pavement markings.

35  
36 If bituminous adhesive is used, apply pavement markers not less  
37 than 7 days after completing pavement. If epoxy adhesive is used, apply  
38 markers not less than 14 days after completing pavement.

39  
40 Do not allow more than 1-inch deviation from intended alignment of  
41 longitudinal pavement markings on tangents and curves with radii greater  
42 than 5,000 feet. Do not allow more than 2-inch deviation from intended  
43 alignment of longitudinal pavement markings on curves with radii of 5,000  
44 feet or less. Correct misalignments by removing and reinstalling misaligned  
45 portion(s), plus an additional 25-foot segment from each end, within one  
46 working day after notification of misalignment by the Engineer.

48  
49  
**(B) Temporary Pavement Markings.** Install temporary pavement markings by end of work day in accordance with Table 629.03-1 - Temporary Pavement Markings when the following conditions exist:

- (1) Permanent pavement markings are not installed after completion of each day's final paving.
- (2) Additional guidance through area is required.
- (3) Markings for special traffic patterns are warranted.

Install temporary, solid, 6-inch pavement marking tapes on edges of traveled way for newly paved, scarified, or cold-planed surfaces, reconstructed areas, and unmarked areas. Where curbs are present at edges of traveled way, 6-inch pavement marking tapes may be eliminated.

Maintain and replace temporary pavement markings, flexible delineators, and barricades.

Remove temporary markings before installing permanent pavement markings.

Cover or temporarily remove signs that conflict with temporary pavement markings.

When pavement markings are not installed by the completion of construction operations for each day, the Engineer will suspend work and progress payment in accordance with Subsection 105.01(A) - Authority of the Engineer.

| <b>TABLE 629.03-1 TEMPORARY PAVEMENT MARKINGS</b> |  |
|---|--|
| <b>TYPE</b>                                       | <b>PAVEMENT MARKINGS</b>   |
| Passing Permitted - Both Sides                    | Single 4-inch yellow stripe 5 feet in length spaced 20 feet on center with Type D markers spaced 40 feet on center and located on center of 5-foot length of stripe. |
| Passing Prohibited - Both Sides                   | Double solid 4-inch yellow stripes with Type D markers placed 20 feet on center on one of 4-inch yellow stripes selected by the Engineer.                            |
| Passing Permitted - One Side Only                 | Single continuous 4-inch yellow stripe with Type D markers placed on stripe 20 feet on center on no-passing  |

|   |   |
|---|---|
|   | side and single 4-inch yellow stripes 5 feet in length spaced 20 feet on center on passing side.  |
| Lane Lines -<br>Lane Changing<br>Permitted  | Single 4-inch yellow or white stripe 5 feet in length spaced 20 feet on center with Type C or Type D markers spaced 40 feet on center.      |
| Lane Lines -<br>Lane Changing<br>Prohibited   | Double solid 4-inch white stripes with Type C markers placed 20 feet on center on one of the 4-inch white stripes selected by the Engineer. |
| Crosswalk   | Two 12-inch white transverse lines spaced 8 feet on center or as ordered by the Engineer.   |
| Stop Line   | Single 12-inch white transverse line.   |
| <b>Note:</b> Paint may be used for temporary markings in areas where final paving is not complete.” |   |

80  
81  
**(C) Permanent Pavement Markings.**

**(1) Permanent Pavement Markers.** Provide pavement markers conforming to shapes, dimensions, tolerances, types, uses, and layout as indicated in the contract documents.

Submit samples of pavement markers and adhesives for testing and acceptance 10 days before usage. The Engineer will sample and test pavement markers in accordance with Subsection 755.02 – Pavement Markers.

Use bituminous adhesive or standard set type epoxy adhesive to bond pavement markers to pavement.

Heat and dispense bituminous adhesive from equipment that can maintain required temperature.

When using epoxy adhesive, mix components by employing two-component type automatic mixing and extruding apparatus. Automatic mixing equipment shall use positive displacement pumps and shall properly meter components in ratio of 1:1, ± 5 percent by volume. Check ratio in presence of the Engineer at beginning of each day or as ordered by the Engineer.

Mix only standard set type adhesive manually, and do not mix more than 1 quart.

Place pavement markers within 60 seconds after mixing and extruding adhesive. No further movement of placed marker will be

110  
 111  
allowed. Use completely each mixed batch of adhesive within 5 minutes after start of mixing. Place adhesive on pavement surface or on bottom of marker, covering entire area of contact, without voids and with uniform thickness, to produce slight excess after pressing marker in place. Place marker in position and apply pressure with slight twisting motion until firm contact is made with pavement. If adhesive cannot be readily extruded from under marker when pressure is applied, discard remaining batch of adhesive. Immediately remove excess adhesive around edge of marker, on surrounding pavement, and on exposed surfaces of markers.

Remove adhesive from exposed faces of markers, using soft rags moistened with mineral spirits conforming to MIL-PRF-680A(1) or kerosene. Other solvents will not be allowed.

Where bituminous adhesive is used, protect marker against impact until adhesive has hardened to the degree designated by the Engineer. Where epoxy adhesive is used, protect pavement markers against impact until adhesive has hardened in accordance with Table 629.03-2 – Adhesive Set Time For Epoxy Pavement Markers:

| <b>TABLE 629.03-2 - ADHESIVE SET TIME FOR EPOXY PAVEMENT MARKERS</b> |                                      |                                     |
|--|--------------------------------------|-------------------------------------|
| <b>Temperature*<br/>(Degrees F)</b>                                  | <b>Standard Set Type<br/>(Hours)</b> | <b>Rapid Set Type<br/>(Minutes)</b> |
| 100  | 1.5                                  | 15                                  |
| 90   | 2                                    | 20                                  |
| 80   | 3                                    | 25                                  |
| 70   | 4                                    | 30                                  |
| 60   | 5                                    | 35                                  |
| 50   | 7                                    | 45                                  |
| 40   | No application below 50 degrees F    | 65                                  |
| 30   |                                      | 85                                  |
| 20   |                                      | No application                      |

|  |  |                       |
|--|--|-----------------------|
| 10   |  | below 30<br>degrees F |
| *Either pavement surface temperature or ambient air temperature, whichever is lower. |  |                       |

132  
133  
134  
135  
136  
137  
138  
139  
140  
141  
142  
143  
144  
145  
146  
147  
148  
149  
150  
151  
152  
153  
154  
155  
156  
157  
158  
159  
160  
161  
162  
163  
164  
165  
166  
167  
168  
169  
170  
171  
172

Do not use hardness of epoxy rim around marker as an indication of degree of cure.

Remove and replace pavement markers that do not meet set time requirements indicated in Table 629.03-2 - Adhesive Set Time For Epoxy Pavement Markers.

Do not install pavement markers when relative humidity is greater than 80 percent, or when pavement surface is not dry.

When using Types A and J pavement markers for delineating 10-foot lane stripes, install markers in sets of four, with no fractional sets allowed. Adjust lengths of each 10-foot stripe and each 30-foot gap for skip striping  $\pm$  1 foot, to present uniform and balanced pattern.

Do not install pavement markers over longitudinal or transverse joints of pavement surface, pavement marking tape, and thermoplastic extrusion markings.

**(2) Traffic Paint.** Use wheeled, manually or motor-propelled applicator machine to apply traffic paint at nominal thickness of 0.015 inch or at rate of 300 linear feet of single 4-inch stripe for 1 gallon paint. Use applicator having appropriate shields around nozzles to permit sharp stripe definition, and separate nozzle to direct air stream immediately ahead of paint application for clearing debris, dust, and other foreign matter. Immediately remove misted, dripped, and spattered paint from pavements.

Protect freshly painted pavement markings from traffic until paint will not transfer to tires or other devices.

Repair or correct pavement markings damaged by traffic and paint marks on pavement caused by traffic crossing wet paint.

**(3) Thermoplastic Extrusion Pavement Marking.**

**(a) Equipment.** Apply material to pavement by extrusion method. One side of shaping die shall be pavement surface and other three sides shall be contained by, or shall be part of

173  
174  
175  
176  
177  
178  
179  
180  
181  
182  
183  
184  
185  
186  
187  
188  
189  
190  
191  
192  
193  
194  
195  
196  
197  
198  
199  
200  
201  
202  
203  
204  
205  
206  
207  
208  
209  
210  
211  
212  
213  
214  
215  
216  
217  
218  
219

equipment for heating and controlling flow of material.

Equipment shall provide continuous mixing and agitation of material. Conveying parts of equipment shall be constructed to prevent accumulation and clogging.

Mixing and conveying parts, including shaping die, shall maintain material at plastic temperature.

Equipment shall produce continuously uniform stripe dimensions.

Applicator shall cleanly and squarely cut off stripe ends. Pans, aprons, or similar appliances that the die overruns will not be allowed.

Apply beads to entire surface of completed stripe by automatic bead dispenser attached to liner.

Equip bead dispenser with automatic cutoff control synchronized with cutoff of thermoplastic material.

Use equipment that provides for varying die widths to produce varying widths of traffic markings.

Provide kettle for melting and heating composition. Equip kettle with automatic thermoplastic control device so that heating can be done by controlled heat transfer liquid rather than direct flame.

Equip and arrange applicator and kettle in accordance with National Fire Underwriters requirements.

Use mobile and maneuverable applicator that is capable of following straight lines and making curves in true arcs.

Use applicator capable of containing minimum of 125 pounds of molten material.

**(b) Application.** Clean off dirt, blaze, paint, tape, and grease. Apply thermoplastic extrusion pavement marking only when pavement surface is dry.

Use equipment that can apply material in variable widths from 2 inches to 12 inches. Apply material for full width of stripe in one application or pass.



220  
221  
On concrete pavements, on HMA pavements more than seven days old, and on HMA pavements paved within seven days containing less than 6 percent bituminous asphalt, pre-stripe application area with binder material, primer, or prime seal coat recommended by pavement marker manufacturer.

Line thickness, as viewed from lateral cross section, shall measure not less than 90 mils at edges, and not less than 125 mils in center.

Take measurements as average throughout 36-inch sections of line. Two thousand pounds of thermoplastic materials supplied in granular or block form shall yield approximately 6,600 feet of 4-inch striping with 90-mil thickness.

Where required by the contract documents to apply new markings over existing markings, bond new line over old line so that no splitting or separation takes place during its useful life.

Provide finished lines with well-defined edges, free of waviness.

**(c) Profiled marking.** Profiled thermoplastic markings shall be produced in one continuous integral process consisting of an extruded base line with raised ribs positioned at regular and predetermined intervals. The product shall be available in standard widths and standard colors of white and yellow.

The base line shall consist of thermoplastic materials extruded to a thickness of not less than 100 mils nor more than 125 mils. The width of the line shall be in accordance with the plans. The edges of the lines shall be well defined and free from waviness.

The raised ribs shall be positioned at regular 36 inch intervals when measure center to center. The general shape of the ribs approximates a trapezoid when viewed from a profile aspect. The raised rib shall stand a minimum of 265 mils above the extruded base line. The length of the raised rib shall be a minimum of 2.5 inches measured at the widest portion of the crown of the rib. In addition, the ribs shall be approximately rectangular in shape.

267  
268  
**(4) Preformed Pavement Marking Tape.** Apply temporary or permanent preformed pavement marking tape manually or with tape applicators, in accordance with tape manufacturer's recommendations and the contract documents. Install preformed pavement marking tape only when pavement surface is dry.

Do not apply preformed pavement marking tape over other markings. Remove existing pavement markings and prepare surface for tape application in accordance with Subsection 629.03(A) - General.

Apply preformed pavement marking tape only when ambient air temperature is at least 60 degrees F and rising, and roadway surface temperature is at least 70 degrees F and rising. Application of preformed pavement marking tape will not be allowed when roadway surface temperature exceeds 150 degrees F.

Before applying preformed pavement marking tape, prime existing roadway surfaces with primer in accordance with tape manufacturer's recommendations.

Use tapes of specified width or use tapes of different widths to form specified stripe width. The Engineer will pay for specified width of stripe when different tape widths are used to form specified width.

Use butt splices only. Tape material shall not be overlapped.

Areas marked with preformed pavement marking tape shall be ready for traffic immediately after application.

**(5) Thermoplastic Hot Spray Pavement Marking.**

**(a) Equipment.** Use equipment constructed for preparation and application of thermoplastic hot spray pavement marking.

Equipment shall provide continuous mixing and agitation of material. Conveying parts of equipment shall be constructed to prevent accumulation and clogging.

Use applicator capable of containing minimum of 125 pounds of molten material.

Provide kettle for melting and heating composition. Equip kettle with automatic thermostat control device so that

314  
315  
316  
317  
318  
319  
320  
321  
322  
323  
324  
325  
326  
327  
328  
329  
330  
331  
332  
333  
334  
335  
336  
337  
338  
339  
340  
341  
342  
343  
344  
345  
346  
347  
348  
349  
350  
351  
352  
353  
354  
355  
356  
357  
358  
359  
360

heating can be done by controlled heat transfer liquid rather than direct flame.

Equip and arrange applicator and kettle in accordance with National Fire Underwriters requirements.

Mixing and conveying parts, including the spray gun, shall maintain material at molten temperature.

Apply beads to entire surface of completed stripe by automatic bead dispenser attached to hot spray applicator.

Equip bead dispenser with automatic cutoff control synchronized with cutoff of thermoplastic material.

Use equipment that provides for varying spray widths to produce varying widths of traffic markings.

Use mobile and maneuverable applicator that is capable of following straight lines and making curves in true arcs.

**(b) Application.** Clean off dirt, debris, blaze, paint, tape, and grease. Apply thermoplastic hot spray pavement marking only when pavement surface is dry.

Use equipment that can apply material in variable widths from 2 inches to 12 inches. Apply material for full width of stripe in one application or pass.

On concrete pavements, or on HMA pavements more than seven days old, or on HMA pavements paved within seven days containing less than 6 percent bituminous asphalt, pre-stripe application area with binder material, primer, or prime seal coat recommended by pavement marker's manufacturer and accepted by the Engineer.

Line thickness, as viewed from lateral cross section, shall measure not less than 90 mils at edges, and not less than 125 mils in center.

Where required by the contract documents to apply new markings over existing markings, bond new line over old line so that no splitting or separation takes place during its useful life.

361 Provide finished lines with well-defined edges, free of  
362 waviness.

363  
364 **(D) Removal of Existing Pavement Markings.** Remove and  
365 dispose of existing pavement markings before performing the following  
366 activities: applying temporary or permanent traffic paint, thermoplastic  
367 extrusion pavement marking, or preformed pavement marking tape; and  
368 making changes in traffic pattern. Dispose of material in accordance with  
369 Subsection 201.03(F) - Removal and Disposal of Material. Use one of the  
370 following removal methods:

371  
372 **(1) Grinding.** Feather edges of grinding to make smooth  
373 transition to existing roadway surface. Limit feathering to 3 inches  
374 beyond edge of existing striping to be removed. Vary feathered  
375 edges to differentiate them from traffic stripes. Coat ground asphalt  
376 pavement with rapid-setting slurry.

377  
378 **(2) Burning.** Burn off existing painted pavement markings using  
379 excess oxygen method.

380  
381 **(3) Sandblasting.** As work progresses, immediately remove  
382 sand and other material deposited on pavement.

383  
384 **(4) Other.** Remove preformed pavement marking tape by  
385 methods recommended by manufacturers. Eradication of existing  
386 markings by painting over them will not be allowed.

387  
388 Areas where pavement markings, temporary or permanent, have  
389 been removed, must match existing pavement, be matt, no depressions and  
390 should not look like a pavement marking when wet or the sun is low in the sky.  
391 The removal area must have the approximate appearance and friction of the  
392 existing pavement and have no trace of the previous pavement markings.

#### 393 394 **629.04 Measurement.**

395  
396 **(A)**The Engineer will measure thermoplastic and preformed pavement  
397 marking tape per linear foot in accordance with the contract documents.  
398 The longitudinal pavement markings will be measured per linear foot as  
399 a single stripe for the width specified in the contract and in the proposal.  
400 The Engineer will include the longitudinal gaps for skip striping, up to  
401 thirty (30) feet long, in the measurement.

402  
403 The Engineer will measure the transverse markings by the linear foot  
404 or per each according to the contract.

405  
406 The Engineer will measure crosswalk markings per lane according  
407 to the contract.

408  
409  
The Engineer will measure pavement arrows (single and multiple heads), symbols, and words per each according to the contract.

The Engineer will not measure temporary pavement markings including flexible delineator posts with reflector markers or Type I Barricades and temporary signs installed for the longitudinal guidance of public traffic over reconstructed areas, cold planed surfaces, newly paved surfaces or other unmarked or scarified areas for payment.

The Engineer will measure the temporary pavement markings and temporary signs installed as ordered by the Engineer for special temporary traffic patterns on a force account basis per Subsection 109.06 – Force Account Provisions and Compensation, if the contract specifies payment in the proposal.

The Contractor shall consider the work required for the removal of pavement markings incidental to the various contract items, except as provided in the proposal or elsewhere in the contract. If the contract stipulates that the Engineer will make payment for the removal of pavement markings, the Engineer will measure the removal of pavement markings.

**(B)** The Engineer will measure the pavement markers per each for the types shown in the proposal.

**(C)** The Engineer will measure the painted stripes that are twelve (12) inches wide or less as a single stripe. The Engineer will measure the painted stripes over twelve (12) inches wide as two (2) stripes. The Engineer will measure the double stripes that are twelve (12) inches or less in total width including the transverse space between the stripes as a single stripe.

The Engineer will measure the longitudinal pavement markings by the linear foot according to the contract. Longitudinal gaps for skip striping that are 30 feet or less will be included in the measurement.

**629.05 Payment.**

**(A)** The Engineer will pay for thermoplastic and preformed pavement marking tape at the contract price per linear foot according to the contract, complete in place, including primers.

The Engineer will pay for double four (4) inch striping with a four (4) inch space between stripes at the contract price per linear foot basis according to the contract.

455 The Engineer will pay for crosswalk markings at the contract price of  
456 per lane basis according to the contract.

457  
458 The Engineer will pay for profiled thermoplastic striping at the  
459 contract price of per each basis according to the contract.

460  
461 The Engineer will pay for pavement arrows (single and multiple  
462 heads), symbols, and words at the contract price per each according to  
463 the contract.

464  
465 The contract unit price paid shall be full compensation for furnishing  
466 labors, materials, tools, equipment and incidentals and for doing the  
467 work involved in furnishing and installing pavement markings complete  
468 in place according to the contract.

469  
470 The Engineer will not pay for the temporary pavement markings  
471 including flexible delineator posts with reflector markers or Type I  
472 Barricades and temporary signs installed for the longitudinal guidance  
473 of public traffic over reconstructed areas, cold planed surfaces, newly  
474 paved surfaces or other unmarked or scarified areas for payment if not  
475 shown in the proposal separately. The Engineer will consider them  
476 incidental to the various contract items.

477  
478 If the contract specifies payment for temporary pavement markings  
479 installed as ordered by the Engineer for special temporary traffic  
480 patterns, the Engineer will pay from an allowance for "Temporary  
481 Construction Zone Markings".

482  
483 The Engineer will compute the actual amount paid to the Contractor  
484 for force account work according to Subsection 109.06 – Force Account  
485 Provisions and Compensation.

486  
487 If the contact specifies payment for removal of pavement markings  
488 under unit price pay items, the Engineer will pay for the accepted  
489 quantities at the contract unit prices bid. The prices shall be full  
490 compensation for removing such items according to the contract.

491  
492 **(B)** The Engineer will pay for the various types of pavement markers at the  
493 contract price per each according to the contract, complete in place,  
494 including adhesives.

495  
496 The Engineer will pay for the following pay items when included in  
497 the proposal schedule:  
498  
499

|     | <b>Pay Item</b>  | <b>Pay Unit</b> |
|-----|--|-----------------|
| 500 |  |                 |
| 501 |  |                 |
| 502 | Single 4-Inch White Pavement Striping                    |                 |
| 503 | (Thermoplastic Extrusion)                                | Linear Foot     |
| 504 |  |                 |
| 505 | Single 4-Inch Yellow Pavement Striping                   |                 |
| 506 | (Thermoplastic Extrusion) (Bike Lane)                    | Linear Foot     |
| 507 |  |                 |
| 508 | Single 4-Inch White Guide Line (Thermoplastic Extrusion) | Linear Foot     |
| 509 |  |                 |
| 510 | Double 4-Inch White Pavement Striping                    |                 |
| 511 | (Thermoplastic Extrusion)                                | Linear Foot     |
| 512 |  |                 |
| 513 | Double 4-Inch Yellow Pavement Striping                   |                 |
| 514 | (Thermoplastic Extrusion)                                | Linear Foot     |
| 515 |  |                 |
| 516 | Double 4-Inch Yellow Dashed Pavement Striping            |                 |
| 517 | (Thermoplastic Extrusion)                                | Linear Foot     |
| 518 |  |                 |
| 519 | Single 6-Inch White Pavement Striping                    |                 |
| 520 | (Thermoplastic Extrusion)                                | Linear Foot     |
| 521 |  |                 |
| 522 | Single 6-Inch Yellow Pavement Striping                   |                 |
| 523 | (Thermoplastic Extrusion)                                | Linear Foot     |
| 524 |  |                 |
| 525 | Single 8-Inch White Pavement Striping                    |                 |
| 526 | (Thermoplastic Extrusion)                                | Linear Foot     |
| 527 |  |                 |
| 528 | Single 8-Inch White Lane Drop Marking                    |                 |
| 529 | (Thermoplastic Extrusion)                                | Linear Foot     |
| 530 |  |                 |
| 531 | Single 12-Inch White Pavement Striping                   |                 |
| 532 | (Thermoplastic Extrusion)                                | Linear Foot     |
| 533 |  |                 |
| 534 | Single 12-Inch Yellow Pavement Striping                  |                 |
| 535 | (Thermoplastic Extrusion)                                | Linear Foot     |
| 536 |  |                 |
| 537 | 24-Inch Green Bicycle Crossing                           | Linear Foot     |
| 538 |  |                 |
| 539 | 24-Inch Crosswalk Marking                                | Lane            |
| 540 |  |                 |
| 541 | Profiled Thermoplastic Striping (White)                  | Each            |
| 542 |  |                 |
| 543 | Profiled Thermoplastic Striping (Rumble Strip)           | Each            |
| 544 |  |                 |
| 545 | Type C Pavement Marker                                   | Each            |
| 546 |  |                 |

|     |   |       |
|-----|---|-------|
| 547 | Type D Pavement Marker                                  | Each  |
| 548 |   |       |
| 549 | Type F Pavement Marker (BWS Fire Hydrant Marker)        | Each  |
| 550 |   |       |
| 551 | Type H Pavement Marker                                  | Each  |
| 552 |   |       |
| 553 | Pavement Arrow (Thermoplastic Extrusion)                | Each  |
| 554 |   |       |
| 555 | Pavement Word Marking (Thermoplastic Extrusion)         | Each  |
| 556 |   |       |
| 557 | Pavement Symbol (Thermoplastic Extrusion) (Yield Ahead) | Each  |
| 558 |   |       |
| 559 | Pavement Symbol (Thermoplastic Extrusion) (Bike Lane)   | Each  |
| 560 |   |       |
| 561 | Yield Line Marking                                      | Each” |
| 562 |   |       |
| 563 |   |       |
| 564 |   |       |

**END OF SECTION 629**



1                                   **SECTION 630 – TRAFFIC CONTROL GUIDE SIGNS**

2  
3    Make the following amendment to said Section:

4  
5    **(I)**     Amend **Section 630.02 - Materials**, by replacing lines 28 to 29 to read:

6  
7             “Retroreflective sheeting shall conform to criteria listed in ASTM D 4956  
8     for the applicable type and class, or as amended in accordance with Subsection  
9     750.01 - Signs.”

10  
11   **(II)**    Amend **Section 630.04 - Measurement**, by replacing lines 204 to 221 to  
12    read:

13  
14    **“630.04 Measurement.** The Engineer will measure destination and guide sign  
15    panels by the square foot of sign face.

16  
17             The Engineer will measure destination and guide signs per each as  
18    indicated in the contract documents.

19  
20             The Engineer will measure reinstalling existing street name signs per each  
21    as indicated in the contract documents.

22  
23             When the Engineer accepts an alternative design, the method of  
24    measurement for the various contract items affected by the design shall be  
25    identical with the various original contract items shown in the contract. The  
26    Engineer will not measure the additional items that the Contractor requires for the  
27    alternate design.

28  
29             The Engineer will not measure removal and disposal and storing of  
30    existing and temporary signs and markers that the Contractor will not incorporate  
31    in the completed highway for payment.”

32  
33    **(III)**   Amend **630.05 – Payment** by revising lines 223 to 303 to read as follows:

34  
35    **“630.05 Payment.** The Engineer will pay for destination and guide sign panels  
36    at the contract price per square foot for the type specified complete in place.  
37    Payment will be full compensation for the work prescribed in this section and the  
38    contract documents.

39  
40             The Engineer will pay for destination and guide signs per each as indicated in the  
41    contract documents. Payment will be full compensation for the work prescribed in  
42    this section and the contract documents.

43  
44             The Engineer will measure reinstalling existing street name signs per  
45    each as indicated in the contract documents. Payment will be full compensation  
46    for the work prescribed in this section and the contract documents.

47  
48  
The Engineer will not pay for removing and disposing or storing of existing and temporary signs that the Contractor will not incorporate in the completed highway separately. The Engineer will consider them incidental to the various contract items.

The Engineer will pay for the following pay items when included in the proposal schedule:

| <b>Pay Item</b>  | <b>Pay Unit</b> |
|--|-----------------|
| Replacement of Existing Sign Panel with New Destination and Guide Sign Panels (Extruded Aluminum Panels) | Square Feet     |
| Replacement of Existing Sign Panel with New Destination and Guide Sign Panels (Sheet Aluminum)           | Square Feet     |
| Destination Sign (10 Sq. Feet or Less) with Post   | Each            |
| Destination Sign (10 Sq. Feet or Less) without Post  | Each            |
| Destination Sign (more than 10 Sq. Feet) without Post  | Each            |
| Guide Sign – Conventional Road (10 Sq. Feet or Less) with Post   | Each            |
| Guide Sign – Conventional Road (10 Sq. Feet or Less) without Post  | Each            |
| Reinstall Existing Street Name Signs to New Post   | Each            |

When the Engineer accepts an alternate design, the total amount paid shall be full compensation for furnishing and installing materials and furnishing equipment, tools, labors, and incidentals necessary to complete the work. The Engineer will not make payment for additional materials, equipment, tools, labor and other incidentals that might become necessary to complete the installation due to the alternate design.

**END OF SECTION 630**

"General Decision Number: HI20250001 01/31/2025

Superseded General Decision Number: HI20240001

State: Hawaii

Construction Types: Building, Heavy (Heavy and Dredging), Highway and Residential

Counties: Hawaii Statewide.

BUILDING CONSTRUCTION PROJECTS; RESIDENTIAL CONSTRUCTION PROJECTS (consisting of single family homes and apartments up to and including 4 stories); HEAVY AND HIGHWAY CONSTRUCTION PROJECTS AND DREDGING

Note: Contracts subject to the Davis-Bacon Act are generally required to pay at least the applicable minimum wage rate required under Executive Order 14026 or Executive Order 13658. Please note that these Executive Orders apply to covered contracts entered into by the federal government that are subject to the Davis-Bacon Act itself, but do not apply to contracts subject only to the Davis-Bacon Related Acts, including those set forth at 29 CFR 5.1(a)(1).

|   |   |
|---|---|
| If the contract is entered into on or after January 30, 2022, or the contract is renewed or extended (e.g., an option is exercised) on or after January 30, 2022: | . Executive Order 14026 generally applies to the contract.<br>. The contractor must pay all covered workers at least \$17.75 per hour (or the applicable wage rate listed on this wage determination, if it is higher) for all hours spent performing on the contract in 2025.  |
| If the contract was awarded on or between January 1, 2015 and January 29, 2022, and the contract is not renewed or extended on or after January 30, 2022:         | . Executive Order 13658 generally applies to the contract.<br>. The contractor must pay all covered workers at least \$13.30 per hour (or the applicable wage rate listed on this wage determination, if it is higher) for all hours spent performing on that contract in 2025. |

The applicable Executive Order minimum wage rate will be adjusted annually. If this contract is covered by one of the Executive Orders and a classification considered necessary for performance of work on the contract does not appear on this wage determination, the contractor must still submit a conformance request.

Additional information on contractor requirements and worker protections under the Executive Orders is available at <http://www.dol.gov/whd/govcontracts>.

| Modification Number | Publication Date |
|---------------------|------------------|
| 0                   | 01/03/2025       |
| 1                   | 01/24/2025       |
| 2                   | 01/31/2025       |

ASBE0132-001 09/01/2024

|   | Rates    | Fringes |
|---|----------|---------|
| Asbestos Workers/Insulator<br>Includes application of<br>all insulating materials,<br>protective coverings,<br>coatings and finishes to<br>all types of mechanical<br>systems. Also the<br>application of<br>firestopping material for<br>wall openings and<br>penetrations in walls,<br>floors, ceilings and<br>curtain walls..... | \$ 45.80 | 30.35   |

-----  
BOIL0627-005 01/01/2021

|                  | Rates    | Fringes |
|------------------|----------|---------|
| BOILERMAKER..... | \$ 37.25 | 31.25   |

-----  
BRHI0001-001 09/05/2023

|  | Rates    | Fringes |
|--|----------|---------|
| BRICKLAYER<br>Bricklayers and Stonemasons.     | \$ 48.03 | 32.23   |
| Pointers, Caulkers and<br>Weatherproofers..... | \$ 48.28 | 32.23   |

-----  
BRHI0001-002 09/05/2023

|   | Rates    | Fringes |
|---|----------|---------|
| Tile, Marble & Terrazzo Worker<br>Terrazzo Base Grinders..... | \$ 44.69 | 33.00   |
| Terrazzo Floor Grinders<br>and Tenders.....                   | \$ 43.14 | 33.00   |
| Tile, Marble and Terrazzo<br>Workers.....                     | \$ 46.50 | 33.00   |

-----  
CARP0745-001 10/01/2021

|   | Rates    | Fringes |
|---|----------|---------|
| Carpenters:<br>Carpenters; Hardwood Floor<br>Layers; Patent Scaffold<br>Erectors (14 ft. and<br>over); Piledrivers;<br>Pneumatic Nailers; Wood<br>Shinglers and Transit<br>and/or Layout Man..... | \$ 51.25 | 24.84   |
| Millwrights and Machine   |          |         |

|   |          |       |
|---|----------|-------|
| Erectors.....                                 | \$ 51.50 | 24.84 |
| Power Saw Operators (2<br>h.p. and over)..... | \$ 51.40 | 24.84 |

-----  
 CARP0745-002 09/04/2023

|  | Rates    | Fringes |
|--|----------|---------|
| Drywall and Acoustical<br>Workers and Lathers..... | \$ 53.00 | 27.74   |

-----  
 ELEC1186-001 08/25/2024

|                              | Rates    | Fringes |
|------------------------------|----------|---------|
| Electricians:                |          |         |
| Cable Splicers.....          | \$ 62.77 | 32.46   |
| Electricians.....            | \$ 55.55 | 32.25   |
| Telecommunication worker.... | \$ 40.00 | 15.50   |

-----  
 ELEC1186-002 08/25/2024

|                                | Rates    | Fringes |
|--------------------------------|----------|---------|
| Line Construction:             |          |         |
| Cable Splicers.....            | \$ 62.77 | 32.46   |
| Groundmen/Truck Drivers.....   | \$ 41.66 | 26.50   |
| Heavy Equipment Operators...\$ | 50.00    | 29.90   |
| Linemen.....                   | \$ 55.55 | 32.25   |
| Telecommunication worker....\$ | 40.00    | 15.50   |

-----  
 ELEV0126-001 01/01/2024

|                        | Rates    | Fringes    |
|------------------------|----------|------------|
| ELEVATOR MECHANIC..... | \$ 70.90 | 37.885+a+b |

a. VACATION: Employer contributes 8% of basic hourly rate for 5 years service and 6% of basic hourly rate for 6 months to 5 years service as vacation pay credit.

b. PAID HOLIDAYS: New Year's Day, Memorial Day, Independence Day, Labor Day, Veterans' Day, Thanksgiving Day, the Friday after Thanksgiving Day and Christmas Day.

-----  
 ENGI0003-002 09/02/2024

|   | Rates    | Fringes |
|---|----------|---------|
| Diver (Aqua Lung) (Scuba))                                |          |         |
| Diver (Aqua Lung) (Scuba)<br>(over a depth of 30 feet)... | \$ 78.96 | 36.825  |
| Diver (Aqua Lung) (Scuba)<br>(up to a depth of 30 feet).. | \$ 69.59 | 36.825  |
| Stand-by Diver (Aqua Lung)<br>(Scuba).....                | \$ 60.21 | 36.825  |
| Diver (Other than Aqua Lung)                              |          |         |
| Diver (Other than Aqua<br>Lung).....                      | \$ 78.96 | 36.825  |
| Diver Tender (Other than<br>Aqua Lung).....               | \$ 57.18 | 36.825  |
| Stand-by Diver (Other than<br>Aqua Lung).....             | \$ 60.21 | 36.825  |

Helicopter Work

|  |          |        |
|--|----------|--------|
| Airborne Hoist Operator<br>for Helicopter..... | \$ 58.76 | 36.825 |
| Co-Pilot of Helicopter.....                    | \$ 58.90 | 36.825 |
| Pilot of Helicopter.....                       | \$ 59.07 | 36.825 |

Power equipment operator -  
tunnel work

|                |          |        |
|----------------|----------|--------|
| GROUP 1.....   | \$ 55.20 | 36.825 |
| GROUP 2.....   | \$ 55.31 | 36.825 |
| GROUP 3.....   | \$ 55.48 | 36.825 |
| GROUP 4.....   | \$ 55.75 | 36.825 |
| GROUP 5.....   | \$ 56.06 | 36.825 |
| GROUP 6.....   | \$ 56.71 | 36.825 |
| GROUP 7.....   | \$ 57.03 | 36.825 |
| GROUP 8.....   | \$ 57.14 | 36.825 |
| GROUP 9.....   | \$ 57.25 | 36.825 |
| GROUP 9A.....  | \$ 57.48 | 36.825 |
| GROUP 10.....  | \$ 57.54 | 36.825 |
| GROUP 10A..... | \$ 57.69 | 36.825 |
| GROUP 11.....  | \$ 57.84 | 36.825 |
| GROUP 12.....  | \$ 58.20 | 36.825 |
| GROUP 12A..... | \$ 58.56 | 36.825 |

Power equipment operators:

|                |          |        |
|----------------|----------|--------|
| GROUP 1.....   | \$ 54.90 | 36.825 |
| GROUP 2.....   | \$ 55.01 | 36.825 |
| GROUP 3.....   | \$ 55.18 | 36.825 |
| GROUP 4.....   | \$ 55.45 | 36.825 |
| GROUP 5.....   | \$ 55.76 | 36.825 |
| GROUP 6.....   | \$ 56.41 | 36.825 |
| GROUP 7.....   | \$ 56.73 | 36.825 |
| GROUP 8.....   | \$ 56.84 | 36.825 |
| GROUP 9.....   | \$ 56.95 | 36.825 |
| GROUP 9A.....  | \$ 57.18 | 36.825 |
| GROUP 10.....  | \$ 57.24 | 36.825 |
| GROUP 10A..... | \$ 57.39 | 36.825 |
| GROUP 11.....  | \$ 57.54 | 36.825 |
| GROUP 12.....  | \$ 57.90 | 36.825 |
| GROUP 12A..... | \$ 58.26 | 36.825 |
| GROUP 13.....  | \$ 55.18 | 36.825 |
| GROUP 13A..... | \$ 55.45 | 36.825 |
| GROUP 13B..... | \$ 55.76 | 36.825 |
| GROUP 13C..... | \$ 56.41 | 36.825 |
| GROUP 13D..... | \$ 56.73 | 36.825 |
| GROUP 13E..... | \$ 56.84 | 36.825 |

POWER EQUIPMENT OPERATORS CLASSIFICATIONS

GROUP 1: Fork Lift (up to and including 10 tons); Partsman (heavy duty repair shop parts room when needed).

GROUP 2: Conveyor Operator (Handling building material); Hydraulic Monitor; Mixer Box Operator (Concrete Plant).

GROUP 3: Brakeman; Deckhand; Fireman; Oiler; Oiler/Gradechecker; Signalman; Switchman; Highline Cableway Signalman; Bargeman; Bunkerman; Concrete Curing Machine (self-propelled, automatically applied unit on streets, highways, airports and canals); Leveeman; Roller (5 tons and under); Tugger Hoist.

GROUP 4: Boom Truck or dual purpose "A" Frame Truck (5 tons or less); Concrete Placing Boom (Building Construction); Dinky Operator; Elevator Operator; Hoist and/or Winch (one drum); Straddle Truck (Ross Carrier, Hyster and similar).

GROUP 5: Asphalt Plant Fireman; Compressors, Pumps, Generators and Welding Machines ("Bank" of 9 or more, individually or collectively); Concrete Pumps or Pumpcrete Guns; Lubrication and Service Engineer (Grease Rack); Screedman.

GROUP 6: Boom Truck or Dual Purpose "A" Frame Truck (over 5 tons); Combination Loader/Backhoe (up to and including 3/4 cu. yd.); Concrete Batch Plants (wet or dry); Concrete Cutter, Groover and/or Grinder (self-propelled unit on streets, highways, airports, and canals); Conveyor or Concrete Pump (Truck or Equipment Mounted); Drilling Machinery (not to apply to waterliners, wagon drills or jack hammers); Fork Lift (over 10 tons); Loader (up to and including 3 and 1/2 cu. yds); Lull High Lift (under 40 feet); Lubrication and Service Engineer (Mobile); Maginnis Internal Full Slab Vibrator (on airports, highways, canals and warehouses); Man or Material Hoist; Mechanical Concrete Finisher (Large Clary, Johnson Bidwell, Bridge Deck and similar); Mobile Truck Crane Driver; Portable Shotblast Concrete Cleaning Machine; Portable Boring Machine (under streets, highways, etc.); Portable Crusher; Power Jumbo Operator (setting slip forms, etc., in tunnels); Rollers (over 5 tons); Self-propelled Compactor (single engine); Self-propelled Pavement Breaker; Skidsteer Loader with attachments; Slip Form Pumps (Power driven by hydraulic, electric, air, gas, etc., lifting device for concrete forms); Small Rubber Tired Tractors; Trencher (up to and including 6 feet); Underbridge Personnel Aerial Platform (50 feet of platform or less).

GROUP 7: Crusher Plant Engineer, Dozer (D-4, Case 450, John Deere 450, and similar); Dual Drum Mixer, Extend Lift; Hoist and/or Winch (2 drums); Loader (over 3 and 1/2 cu. yds. up to and including 6 yards.); Mechanical Finisher or Spreader Machine (asphalt), (Barber Greene and similar) (Screedman required); Mine or Shaft Hoist; Mobile Concrete Mixer (over 5 tons); Pipe Bending Machine (pipelines only); Pipe Cleaning Machine (tractor propelled and supported); Pipe Wrapping Machine (tractor propelled and supported); Roller Operator (Asphalt); Self-Propelled Elevating Grade Plane; Slusher Operator; Tractor (with boom) (D-6, or similar); Trencher (over 6 feet and less than 200 h.p.); Water Tanker (pulled by Euclids, T-Pulls, DW-10, 20 or 21, or similar); Winchman (Stern Winch on Dredge).

GROUP 8: Asphalt Plant Operator; Barge Mate (Seagoing); Cast-in-Place Pipe Laying Machine; Concrete Batch Plant (multiple units); Conveyor Operator (tunnel); Deckmate; Dozer (D-6 and similar); Finishing Machine Operator (airports and highways); Gradesetter; Kolman Loader (and similar); Mucking Machine (Crawler-type); Mucking Machine (Conveyor-type); No-Joint Pipe Laying Machine; Portable Crushing and Screening Plant; Power Blade Operator (under 12); Saurman Type Dragline (up to and including 5 yds.); Stationary Pipe Wrapping, Cleaning and Bending Machine; Surface Heater and Planer Operator, Tractor (D-6 and similar); Tri-Batch Paver; Tunnel Badger; Tunnel Mole and/or Boring Machine Operator Underbridge Personnel Aerial Platform (over 50 feet of platform).

GROUP 9: Combination Mixer and Compressor (gunite); Do-Mor Loader and Adams Elegrader; Dozer (D-7 or equal); Wheel

and/or Ladder Trencher (over 6 feet and 200 to 749 h.p.).

GROUP 9A: Dozer (D-8 and similar); Gradesetter (when required by the Contractor to work from drawings, plans or specifications without the direct supervision of a foreman or superintendent); Push Cat; Scrapers (up to and including 20 cu. yds); Self-propelled Compactor with Dozer; Self-Propelled, Rubber-Tired Earthmoving Equipment (up to and including 20 cu. yds) (621 Band and similar); Sheep's Foot; Tractor (D-8 and similar); Tractors with boom (larger than D-6, and similar).

GROUP 10: Chicago Boom; Cold Planers; Heavy Duty Repairman or Welder; Hoist and/or Winch (3 drums); Hydraulic Skooper (Koehring and similar); Loader (over 6 cu. yds. up to and including 12 cu. yds.); Saurman type Dragline (over 5 cu. yds.); Self-propelled, rubber-tired Earthmoving Equipment (over 20 cu. yds. up to and including 31 cu. yds.) (637D and similar); Soil Stabilizer (P & H or equal); Sub-Grader (Gurries or other automatic type); Tractors (D-9 or equivalent, all attachments); Tractor (Tandem Scraper); Watch Engineer.

GROUP 10A: Boat Operator; Cable-operated Crawler Crane (up to and including 25 tons); Cable-operated Power Shovel, Clamshell, Dragline and Backhoe (up to and including 1 cu. yd.); Dozer D9-L; Dozer (D-10, HD41 and similar) (all attachments); Gradall (up to and including 1 cu. yd.); Hydraulic Backhoe (over 3/4 cu. yds. up to and including 2 cu. yds.); Mobile Truck Crane Operator (up to and including 25 tons) (Mobile Truck Crane Driver Required); Self-propelled Boom Type Lifting Device (Center Mount) (up to and including 25 tons) (Grove, Drott, P&H, Pettibone and similar); Trencher (over 6 feet and 750 h.p. or more); Watch Engineer (steam or electric).

GROUP 11: Automatic Slip Form Paver (concrete or asphalt); Band Wagon (in conjunction with Wheel Excavator); Cable-operated Crawler Cranes (over 25 tons but less than 50 tons); Cable-operated Power Shovel, Clamshell, Dragline and Backhoe (over 1 cu. yd. up to 7 cu. yds.); Gradall (over 1 cu. yds. up to 7 cu. yds.); DW-10, 20, etc. (Tandem); Earthmoving Machines (multiple propulsion power units and 2 or more Scrapers) (up to and including 35 cu. yds., "" struck "" m.r.c.); Highline Cableway; Hydraulic Backhoe (over 2 cu. yds. up to and including 4 cu. yds.); Leverman; Lift Slab Machine; Loader (over 12 cu. yds); Master Boat Operator; Mobile Truck Crane Operator (over 25 tons but less than 50 tons); (Mobile Truck Crane Driver required); Pre-stress Wire Wrapping Machine; Self-propelled Boom-type Lifting Device (Center Mount) (over 25 tons m.r.c); Self-propelled Compactor (with multiple-propulsion power units); Single Engine Rubber Tired Earthmoving Machine (with Tandem Scraper); Tandem Cats; Trencher (pulling attached shield).

GROUP 12: Clamshell or Dipper Operator; Derricks; Drill Rigs; Multi-Propulsion Earthmoving Machines (2 or more Scrapers) (over 35 cu. yds ""struck""m.r.c.); Operators (Derricks, Piledrivers and Cranes); Power Shovels and Draglines (7 cu. yds. m.r.c. and over); Self-propelled rubber-tired Earthmoving equipment (over 31 cu. yds.) (657B and similar); Wheel Excavator (up to and including 750 cu. yds. per hour); Wheel Excavator (over 750 cu. yds. per hour).



GROUP 12A: Dozer (D-11 or similar or larger); Hydraulic Excavators (over 4 cu. yds.); Lifting cranes (50 tons and over); Pioneering Dozer/Backhoe (initial clearing and excavation for the purpose of providing access for other equipment where the terrain worked involves 1-to-1 slopes that are 50 feet in height or depth, the scope of this work does not include normal clearing and grubbing on usual hilly terrain nor the excavation work once the access is provided); Power Blade Operator (Cat 12 or equivalent or over); Straddle Lifts (over 50 tons); Tower Crane, Mobile; Traveling Truss Cranes; Universal, Liebherr, Linden, and similar types of Tower Cranes (in the erection, dismantling, and moving of equipment there shall be an additional Operating Engineer or Heavy Duty Repairman); Yo-Yo Cat or Dozer.

GROUP 13: Truck Driver (Utility, Flatbed, etc.)

GROUP 13A: Dump Truck, 8 cu.yds. and under (water level); Water Truck (up to and including 2,000 gallons).

GROUP 13B: Water Truck (over 2,000 gallons); Tandem Dump Truck, over 8 cu. yds. (water level).

GROUP 13C: Truck Driver (Semi-trailer. Rock Cans, Semi-Dump or Roll-Offs).

GROUP 13D: Truck Driver (Slip-In or Pup).

GROUP 13E: End Dumps, Unlicensed (Euclid, Mack, Caterpillar or similar); Tractor Trailer (Hauling Equipment); Tandem Trucks hooked up to Trailer (Hauling Equipment)

BOOMS AND/OR LEADS (HOURLY PREMIUMS):

The Operator of a crane (under 50 tons) with a boom of 80 feet or more (including jib), or of a crane (under 50 tons) with leads of 100 feet or more, shall receive a per hour premium for each hour worked on said crane (under 50 tons) in accordance with the following schedule:

|   |      |
|---|------|
| Booms of 80 feet up to but not including 130 feet or Leads of 100 feet up to but not including 130 feet | 0.50 |
| Booms and/or Leads of 130 feet up to but not including 180 feet   | 0.75 |
| Booms and/or Leads of 180 feet up to and including 250 feet   | 1.15 |
| Booms and/or Leads over 250 feet  | 1.50 |

The Operator of a crane (50 tons and over) with a boom of 180 feet or more (including jib) shall receive a per hour premium for each hour worked on said crane (50 tons and over) in accordance with the following schedule:

|  |      |
|--|------|
| Booms of 180 feet up to and including 250 feet | 1.25 |
| Booms over 250 feet                            | 1.75 |

|  | Rates    | Fringes |
|--|----------|---------|
| Dredging: (Boat Operators)               |          |         |
| Boat Deckhand.....                       | \$ 55.18 | 36.70   |
| Boat Operator.....                       | \$ 57.39 | 36.70   |
| Master Boat Operator.....                | \$ 57.54 | 36.70   |
| Dredging: (Clamshell or Dipper Dredging) |          |         |
| GROUP 1.....                             | \$ 57.90 | 36.70   |
| GROUP 2.....                             | \$ 57.24 | 36.70   |
| GROUP 3.....                             | \$ 56.84 | 36.70   |
| GROUP 4.....                             | \$ 55.18 | 36.70   |
| Dredging: (Derricks)                     |          |         |
| GROUP 1.....                             | \$ 57.90 | 36.70   |
| GROUP 2.....                             | \$ 57.24 | 36.70   |
| GROUP 3.....                             | \$ 56.84 | 36.70   |
| GROUP 4.....                             | \$ 55.18 | 36.70   |
| Dredging: (Hydraulic Suction Dredges)    |          |         |
| GROUP 1.....                             | \$ 57.54 | 36.70   |
| GROUP 2.....                             | \$ 57.39 | 36.70   |
| GROUP 3.....                             | \$ 57.24 | 36.70   |
| GROUP 4.....                             | \$ 57.18 | 36.70   |
| GROUP 5.....                             | \$ 37.88 | 26.76   |
| Group 5.....                             | \$ 56.84 | 36.70   |
| GROUP 6.....                             | \$ 37.77 | 26.76   |
| Group 6.....                             | \$ 56.73 | 36.70   |
| GROUP 7.....                             | \$ 36.22 | 26.76   |
| Group 7.....                             | \$ 55.18 | 36.70   |

CLAMSHELL OR DIPPER DREDGING CLASSIFICATIONS

- GROUP 1: Clamshell or Dipper Operator.
- GROUP 2: Mechanic or Welder; Watch Engineer.
- GROUP 3: Barge Mate; Deckmate.
- GROUP 4: Bargeman; Deckhand; Fireman; Oiler.

HYDRAULIC SUCTION DREDGING CLASSIFICATIONS

- GROUP 1: Leverman.
- GROUP 2: Watch Engineer (steam or electric).
- GROUP 3: Mechanic or Welder.
- GROUP 4: Dozer Operator.
- GROUP 5: Deckmate.
- GROUP 6: Winchman (Stern Winch on Dredge)
- GROUP 7: Deckhand (can operate anchor scow under direction of Deckmate); Fireman; Leveeman; Oiler.

DERRICK CLASSIFICATIONS

- GROUP 1: Operators (Derricks, Piledrivers and Cranes).
- GROUP 2: Saurman Type Dragline (over 5 cubic yards).
- GROUP 3: Deckmate; Saurman Type Dragline (up to and including 5 yards).
- GROUP 4: Deckhand, Fireman, Oiler.

-----  
 ENGI003-044 09/02/2024

|                                       | Rates | Fringes |
|---------------------------------------|-------|---------|
| Power Equipment Operators<br>(PAVING) |       |         |

|  |          |       |
|--|----------|-------|
| Asphalt Concrete Material  |          |       |
| Transfer.....  | \$ 55.88 | 37.32 |
| Asphalt Plant Operator.....  | \$ 56.31 | 37.32 |
| Asphalt Raker.....   | \$ 54.92 | 37.32 |
| Asphalt Spreader Operator...   | \$ 56.40 | 37.32 |
| Cold Planer.....   | \$ 56.71 | 37.32 |
| Combination Loader/Backhoe<br>(over 3/4 cu.yd.).....   | \$ 54.92 | 37.32 |
| Combination Loader/Backhoe<br>(up to 3/4 cu.yd.).....  | \$ 53.94 | 37.32 |
| Concrete Saws and/or<br>Grinder (self-propelled<br>unit on streets, highways,<br>airports and canals)..... | \$ 55.88 | 37.32 |
| Grader.....  | \$ 56.71 | 37.32 |
| Laborer, Hand Roller.....  | \$ 54.42 | 37.32 |
| Loader (2 1/2 cu. yds. and<br>under).....  | \$ 55.88 | 37.32 |
| Loader (over 2 1/2 cu.<br>yds. to and including 5<br>cu. yds.).....  | \$ 56.20 | 37.32 |
| Roller Operator (five tons<br>and under).....  | \$ 54.65 | 37.32 |
| Roller Operator (over five<br>tons).....   | \$ 56.08 | 37.32 |
| Screed Person.....   | \$ 55.88 | 37.32 |
| Soil Stabilizer.....   | \$ 56.71 | 37.32 |

-----  
IRON0625-001 09/01/2024

|   | Rates    | Fringes |
|---|----------|---------|
| Ironworkers:.....   | \$ 48.00 | 41.86   |
| a. Employees will be paid \$.50 per hour more while working in tunnels and coffer dams; \$1.00 per hour more when required to work under or are covered with water (submerged) and when they are required to work on the summit of Mauna Kea, Mauna Loa or Haleakala. |          |         |

-----  
LAB00368-001 09/02/2024

|   | Rates    | Fringes |
|---|----------|---------|
| Laborers:   |          |         |
| Driller.....                                      | \$ 44.75 | 25.96   |
| Final Clean Up.....                               | \$ 31.40 | 21.37   |
| Gunite/Shotcrete Operator<br>and High Scaler..... | \$ 42.25 | 25.96   |
| Laborer I.....                                    | \$ 41.75 | 25.96   |
| Laborer II.....                                   | \$ 39.15 | 25.96   |
| Mason Tender/Hod Carrier...                       | \$ 42.25 | 25.96   |
| Powderman.....                                    | \$ 42.75 | 25.96   |
| Window Washer (bosun chair).                      | \$ 41.25 | 25.96   |

LABORERS CLASSIFICATIONS

Laborer I: Air Blasting run by electric or pneumatic compressor; Asphalt Laborer, Ironer, Raker, Luteman, and Handroller, and all types of Asphalt Spreader Boxes; Asphalt Shoveler; Assembly and Installation of Multiplates, Liner Plates, Rings, Mesh, Mats; Batching Plant (portable and temporary); Boring Machine Operator (under streets and sidewalks); Buggymobile; Burning and Welding; Chainsaw, Faller, Logloader, and Bucker; Compactors (Jackson Jumping

Jack and similar); Concrete Bucket Dumpman; Concrete Chipping; Concrete Chuteman/Hoseman (pouring concrete) (the handling of the chute from ready-mix trucks for such jobs as walls, slabs, decks, floors, foundations, footings, curbs, gutters, and sidewalks); Concrete Core Cutter (Walls, Floors, and Ceiling); Concrete Grinding or Sanding; Concrete: Hooking on, signaling, dumping of concrete for tremie work over water on caissons, pilings, abutments, etc.; Concrete: Mixing, handling, conveying, pouring, vibrating, otherwise placing of concrete or aggregates or by any other process; Concrete: Operation of motorized wheelbarrows or buggies or machines of similar character, whether run by gas, diesel, or electric power; Concrete Placement Machine Operator: operation of Somero Hammerhead, Copperheads, or similar machines; Concrete Pump Machine (laying, coupling, uncoupling of all connections and cleaning of equipment); Concrete and/or Asphalt Saw (Walking or Handtype) (cutting walls or flatwork) (scoring old or new concrete and/or asphalt) (cutting for expansion joints) (streets and ways for laying of pipe, cable or conduit for all purposes); Concrete Shovelers/Laborers (Wet or Dry); Concrete Screeding for Rough Strike-Off: Rodding or striking-off, by hand or mechanical means prior to finishing; Concrete Vibrator Operator; Coring Holes: Walls, footings, piers or other obstructions for passage of pipes or conduits for any purpose and the pouring of concrete to secure the hole; Cribbers, Shorer, Lagging, Sheeting, and Trench Jacking and Bracing, Hand-Guided Lagging Hammer Whaling Bracing; Curbing (Concrete and Asphalt); Curing of Concrete (impervious membrane and form oiler) mortar and other materials by any mode or method; Cut Granite Curb Setter (setting, leveling and grouting of all precast concrete or stone curbs); Cutting and Burning Torch (demolition); Dri Pak-It Machine; Environmental Abatement: removal of asbestos, lead, and bio hazardous materials (EPA and/or OSHA certified); Falling, bucking, yarding, loading or burning of all trees or timber on construction site; Forklift (9 ft. and under); Gas, Pneumatic, and Electric tools; Grating and Grill work for drains or other purposes; Green Cutter of concrete or aggregate in any form, by hand, mechanical means, grindstone or air and/or water; Grout: Spreading for any purpose; Guinea Chaser (Grade Checker) for general utility trenches, sitework, and excavation; Headerboard Man (Asphalt or Concrete); Heat Welder of Plastic (Laborers' AGC certified workers) (when work involves waterproofing for waterponds, artificial lakes and reservoir) heat welding for sewer pipes and fusion of HDPE pipes; Heavy Highway Laborer (Rigging, signaling, handling, and installation of pre-cast catch basins, manholes, curbs and gutters); High Pressure Nozzleman - Hydraulic Monitor (over 100# pressure); Jackhammer Operator; Jacking of slip forms: All semi and unskilled work connected therewithin; Laying of all multi-cell conduit or multi-purpose pipe; Magnesite and Mastic Workers (Wet or Dry)(including mixer operator);Mortar Man; Mortar Mixer (Block, Brick, Masonry, and Plastering); Nozzleman (Sandblasting and/or Water Blasting): handling, placing and operation of nozzle; Operation, Manual or Hydraulic jacking of shields and the use of such other mechanical equipment as may be necessary; Pavement Breakers; Paving, curbing and surfacing of streets, ways, courts, under and overpasses, bridges, approaches, slope walls, and all other labor connected therewith; Pilecutters; Pipe Accessment in place, bolting and lining up of sectional metal or other pipe including

corrugated pipe; Pipelayer performing all services in the laying and installation of pipe from the point of receiving pipe in the ditch until completion of operation, including any and all forms of tubular material, whether pipe, HDPE, metallic or non-metallic, conduit, and any other stationary-type of tubular device used for conveying of any substance or element, whether water, sewage, solid, gas, air, or other product whatsoever and without regard to the nature of material from which tubular material is fabricated; No-joint pipe and stripping of same, Pipewrapper, Caulker, Bander, Kettlemen, and men applying asphalt, Laykold, treating Creosote and similar-type materials (6-inch pipe and over); Piping: resurfacing and paving of all ditches in preparation for laying of all pipes; Pipe laying of lateral sewer pipe from main or side sewer to buildings or structure (except Contactor may direct work be done under proper supervision); Pipe laying, leveling and marking of the joint used for main or side sewers and storm sewers; Laying of all clay, terra cotta, ironstone, vitrified concrete, HDPE or other pipe for drainage; Placing and setting of water mains, gas mains and all pipe including removal of skids; Plaster Mortar Mixer/Pump; Pneumatic Impact Wrench; Portable Sawmill Operation: Choker setters, off bearers, and lumber handlers connected with clearing; Posthole Digger (Hand Held, Gas, Air and Electric); Powderman's Tender; Power Broom Sweepers (Small); Preparation and Compaction of roadbeds for railroad track laying, highway construction, and the preparation of trenches, footings, etc., for cross-country transmission by pipelines, electrical transmission or underground lines or cables (by mechanical means); Raising of structure by manual or hydraulic jacks or other methods and resetting of structure in new locations, including all concrete work; Ramming or compaction; Rigging in connection with Laborers' work (except demolition), Signaling (including the use of walkie talkie) Choke Setting, tag line usage; Tagging and Signaling of building materials into high rise units; Riprap, Stonepaver, and Rock Slinger (includes placement of stacked concrete, wet or dry and loading, unloading, signaling, slinging and setting of other similar materials); Rotary Scarifier (including multiple head concrete chipping Scarifier); Salamander Heater, Drying of plaster, concrete mortar or other aggregate; Scaffold Erector Leadman; Scaffolds: (Swing and hanging) including maintenance thereof; Scaler; Septic Tank/Cesspool and Drain Fields Digger and Installer; Shredder/Chipper (tree branches, brush, etc.); Stripping and Setting Forms; Stripping of Forms: Other than panel forms which are to be re-used in their original form, and stripping of forms on all flat arch work; Tampers (Barko, Wacker, and similar type); Tank Scaler and Cleaners; Tarman; Tree Climbers and Trimmers; Trencher (includes hand-held, Davis T-66 and similar type); Trucks (flatbed up to and including 2 1/2 tons when used in connection with on-site Laborers' work; Trucks (Refuse and Garbage Disposal) (from job site to dump); Vibra-Screed (Bull Float in connection with Laborers' work); Well Points, Installation of or any other dewatering system.

Laborer II: Asphalt Plant Laborer; Boring Machine Tender; Bridge Laborer; Burning of all debris (crates, boxes, packaging waste materials); Chainman, Rodmen, and Grade Markers; Cleaning, clearing, grading and/or removal for streets, highways, roadways, aprons, runways, sidewalks,

parking areas, airports, approaches, and other similar installations; Cleaning or reconditioning of streets, ways, sewers and waterlines, all maintenance work and work of an unskilled and semi-skilled nature; Concrete Bucket Tender (Groundman) hooking and unhooking of bucket; Concrete Forms; moving, cleaning, oiling and carrying to the next point of erection of all forms; Concrete Products Plant Laborers; Conveyor Tender (conveying of building materials); Crushed Stone Yards and Gravel and Sand Pit Laborers and all other similar plants; Demolition, Wrecking and Salvage Laborers: Wrecking and dismantling of buildings and all structures, with use of cutting or wrecking tools, breaking away, cleaning and removal of all fixtures, All hooking, unhooking, signaling of materials for salvage or scrap removed by crane or derrick; Digging under streets, roadways, aprons or other paved surfaces; Driller's Tender; Chuck Tender, Outside Nipper; Dry-packing of concrete (plugging and filling of she-bolt holes); Fence and/or Guardrail Erector: Dismantling and/or re-installation of all fence; Finegrader; Firewatcher; Flagman (Coning, preparing, stablishing and removing portable roadway barricade devices); Signal Men on all construction work defined herein, including Traffic Control Signal Men at construction site; General Excavation; Backfilling, Grading and all other labor connected therewith; Digging of trenches, ditches and manholes and the leveling, grading and other preparation prior to laying pipe or conduit for any purpose; Excavations and foundations for buildings, piers, foundations and holes, and all other construction. Preparation of street ways and bridges; General Laborer: Cleaning and Clearing of all debris and surplus material. Clean-up of right-of-way. Clearing and slashing of brush or trees by hand or mechanical cutting. General Clean up: sweeping, cleaning, wash-down, wiping of construction facility and equipment (other than "Light Clean up (Janitorial) Laborer. Garbage and Debris Handlers and Cleaners. Appliance Handling (job site) (after delivery unloading in storage area); Ground and Soil Treatment Work (Pest Control); Gunite/Shotcrete Operator Tender; Junk Yard Laborers (same as Salvage Yard); Laser Beam "Target Man" in connection with Laborers' work; Layout Person for Plastic (when work involves waterproofing for waterponds, artificial lakes and reservoirs); Limbers, Brush Loaders, and Pilers; Loading, Unloading, carrying, distributing and handling of all rods and material for use in reinforcing concrete construction (except when a derrick or outrigger operated by other than hand power is used); Loading, unloading, sorting, stockpiling, handling and distribution of water mains, gas mains and all pipes; Loading and unloading of all materials, fixtures, furnishings and appliances from point of delivery to stockpile to point of installation; hooking and signaling from truck, conveyance or stockpile; Material Yard Laborers; Pipelayer Tender; Pipewrapper, Caulker, Bander, Kettlemen, and men applying asphalt, Laykold, Creosote, and similar-type materials (pipe under 6 inches); Plasterer Laborer; Preparation, construction and maintenance of roadbeds and sub-grade for all paving, including excavation, dumping, and spreading of sub-grade material; Prestressed or precast concrete slabs, walls, or sections: all loading, unloading, stockpiling, hooking on of such slabs, walls or sections; Quarry Laborers; Railroad, Streetcar, and Rail Transit Maintenance and Repair; Roustabout; Rubbish Trucks in connection with Building Construction Projects (excluding clearing,

grubbing, and excavating); Salvage Yard: All work connected with cutting, cleaning, storing, stockpiling or handling of materials, all cleanup, removal of debris, burning, back-filling and landscaping of the site; Sandblasting Tender (Pot Tender): Hoses and pots or markers; Scaffolds: Erection, planking and removal of all scaffolds used for support for lathers, plasters, brick layers, masons, and other construction trades crafts; Scaffolds: (Specially designed by carpenters) laborers shall tend said carpenter on erection and dismantling thereof, preparation for foundation or mudsills, maintenance; Scraping of floors; Screeds: Handling of all screeds to be reused; handling, dismantling and conveyance of screeds; Setting, leveling and securing or bracing of metal or other road forms and expansion joints; Sheeting Piling/trench shoring (handling and placing of skip sheet or wood plank trench shoring); Ship Scalers; Shipwright Tender; Sign Erector (subdivision traffic, regulatory, and street-name signs); Sloper; Slurry Seal Crews (Mixer Operator, Applicator, Squeegee Man, Shuttle Man, Top Man); Snapping of wall ties and removal of tie rods; Soil Test operations of semi and unskilled labor such as filling sand bags; Striper (Asphalt, Concrete or other Paved Surfaces); Tool Room Attendant (Job Site); Traffic Delineating Device Applicator; Underpinning, lagging, bracing, propping and shoring, loading, signaling, right-of-way clearance along the route of movement, The clearance of new site, excavation of foundation when moving a house or structure from old site to new site; Utilities employees; Water Man; Waterscape/Hardscape Laborers; Wire Mesh Pulling (all concrete pouring operations); Wrecking, stripping, dismantling and handling concrete forms an false work.

-----  
 LAB00368-002 09/03/2024

|                        | Rates    | Fringes |
|------------------------|----------|---------|
| Landscape & Irrigation |          |         |
| Laborers               |          |         |
| GROUP 1.....           | \$ 28.40 | 17.15   |
| GROUP 2.....           | \$ 29.40 | 17.15   |
| GROUP 3.....           | \$ 23.00 | 17.15   |

LABORERS CLASSIFICATIONS

GROUP 1: Installation of non-potable permanent or temporary irrigation water systems performed for the purposes of Landscaping and Irrigation architectural horticultural work; the installation of drinking fountains and permanent or temporary irrigation systems using potable water for Landscaping and Irrigation architectural horticultural purposes only. This work includes (a) the installation of all heads, risers, valves, valve boxes, vacuum breakers (pressure and non-pressure), low voltage electrical lines and, provided such work involves electrical wiring that will carry 24 volts or less, the installation of sensors, master control panels, display boards, junction boxes, conductors, including all other components for controllers, (b) and metallic (copper, brass, galvanized, or similar) pipe, as well as PVC or other plastic pipe including all work incidental thereto, i.e., unloading, handling and distribution of all pipes fittings, tools, materials and equipment, (c) all soldering work in connection with the

above whether done by torch, soldering iron, or other means; (d) tie-in to main lines, thrust blocks (both precast and poured in place), pipe hangers and supports incidental to installation of the entire irrigation system, (e) making of pressure tests, start-up testing, flushing, purging, water balancing, placing into operation all irrigation equipment, fixtures and appurtenances installed under this agreement, and (f) the fabrication, replacement, repair and servicing of landscaping and irrigation systems. Operation of hand-held gas, air, electric, or self-powered tools and equipment used in the performance of Landscape and Irrigation work in connection with architectural horticulture; Choke-setting, signaling, and rigging for equipment operators on job-site in the performance of such Landscaping and Irrigation work; Concrete work (wet or dry) performed in connection with such Landscaping and Irrigation work. This work shall also include the setting of rock, stone, or riprap in connection with such Landscape, Waterscape, Rockscape, and Irrigation work; Grubbing, pick and shovel excavation, and hand rolling or tamping in connection with the performance of such Landscaping and Irrigation work; Sprigging, handseeding, and planting of trees, shrubs, ground covers, and other plantings and the performance of all types of gardening and horticultural work relating to said planting; Operation of flat bed trucks (up to and including 2 1/2 tons).:

GROUP 2. Layout of irrigation and other non-potable irrigation water systems and the layout of drinking fountains and other potable irrigation water systems in connection with such Landscaping and Irrigation work. This includes the layout of all heads, risers, valves, valve boxes, vacuum breakers, low voltage electrical lines, hydraulic and electrical controllers, and metallic (coppers, brass, galvanized, or similar) pipe, as well as PVC or other plastic pipe. This work also includes the reading and interpretation of plans and specifications in connection with the layout of Landscaping, Rockscape, Waterscape, and Irrigation work; Operation of Hydro-Mulching machines (sprayman and driver), Drillers, Trenchers (riding type, Davis T-66, and similar) and fork lifts used in connection with the performance of such Landscaping and Irrigation work; Tree climbers and chain saw tree trimmers, Sporadic operation (when used in connection with Landscaping, Rockscape, Waterscape, and Irrigation work) of Skid-Steer Loaders (Bobcat and similar), Cranes (Bantam, Grove, and similar), Hoptos, Backhoes, Loaders, Rollers, and Dozers (Case, John Deere, and similar), Water Trucks, Trucks requiring a State of Hawaii Public Utilities Commission Type 5 and/or type 7 license, sit-down type and "gang" mowers, and other self-propelled, sit-down operated machines not listed under Landscape & Irrigation Maintenance Laborer; Chemical spraying using self-propelled power spraying equipment (200 gallon capacity or more).

GROUP 3: Maintenance of trees, shrubs, ground covers, lawns and other planted areas, including the replanting of trees, shrubs, ground covers, and other plantings that did not "take" or which are damaged; provided, however, that re-planting that requires the use of equipment, machinery, or power tools shall be paid for at the rate of pay specified under Landscape and Irrigation Laborer, Group 1; Raking, mowing, trimming, and runing, including the use of



"weed eaters", hedge trimmers, vacuums, blowers, and other hand-held gas, air, electric, or self-powered tools, and the operation of lawn mowers (Note: The operation of sit-down type and "gang" mowers shall be paid for at the rate of pay specified under Landscape & Irrigation Laborer, Group 2); Guywiring, staking, propping, and supporting trees; Fertilizing, Chemical spraying using spray equipment with less than 200 gallon capacity, Maintaining irrigation and sprinkler systems, including the staking, clamping, and adjustment of risers, and the adjustment and/or replacement of sprinkler heads, (Note: the cleaning and gluing of pipe and fittings shall be paid for at the rate of pay specified under Landscape & Irrigation Laborer(Group 1); Watering by hand or sprinkler system and the performance of other types of gardening, yardman, and horticultural-related work.

-----  
LAB00368-003 09/05/2023

|                     | Rates    | Fringes |
|---------------------|----------|---------|
| Underground Laborer |          |         |
| GROUP 1.....        | \$ 41.25 | 24.96   |
| GROUP 2.....        | \$ 42.75 | 24.96   |
| GROUP 3.....        | \$ 43.25 | 24.96   |
| GROUP 4.....        | \$ 44.25 | 24.96   |
| GROUP 5.....        | \$ 44.50 | 24.96   |
| GROUP 6.....        | \$ 44.60 | 24.96   |
| GROUP 7.....        | \$ 44.85 | 24.96   |

GROUP 1: Watchmen; Change House Attendant.

GROUP 2: Swamper; Brakeman; Bull Gang-Muckers, Trackmen; Dumpmen (any method); Concrete Crew (includes rodding and spreading); Grout Crew; Reboundmen

GROUP 3: Chucktenders and Cabletenders; Powderman (Prime House); Vibratorman, Pavement Breakers

GROUP 4: Miners - Tunnel (including top and bottom man on shaft and raise work); Timberman, Retimberman (wood or steel or substitute materials thereof); Blasters, Drillers, Powderman (in heading); Microtunnel Laborer; Headman; Cherry Pickerman (where car is lifted); Nipper; Grout Gunmen; Grout Pumpman & Potman; Gunite, Shotcrete Gunmen & Potmen; Concrete Finisher (in tunnel); Concrete Screed Man; Bit Grinder; Steel Form Raisers & Setters; High Pressure Nozzlemans; Nozzlemans (on slick line); Sandblaster-Potman (combination work assignment interchangeable); Tugger

GROUP 5: Shaft Work & Raise (below actual or excavated ground level); Diamond Driller; Gunite or Shotcrete Nozzlemans; Rodman; Groundman

GROUP 6: Shifter

GROUP 7: Shifter (Shaft Work & Raiser)

-----  
PAIN1791-001 01/01/2025

|           | Rates | Fringes |
|-----------|-------|---------|
| Painters: |       |         |

|  |             |         |
|--|-------------|---------|
| Brush.....   | \$ 43.40    | 30.05   |
| Sandblaster; Spray.....  | \$ 43.40    | 30.05   |
| -----  |             |         |
| PAIN1889-001 07/01/2024  |             |         |
|  | Rates       | Fringes |
| Glaziers.....  | \$ 46.00    | 39.70   |
| -----  |             |         |
| PAIN1926-001 03/05/2023  |             |         |
|  | Rates       | Fringes |
| Soft Floor Layers.....   | \$ 39.77    | 33.80   |
| -----  |             |         |
| PAIN1944-001 01/07/2024  |             |         |
|  | Rates       | Fringes |
| Taper.....   | \$ 45.20    | 31.40   |
| -----  |             |         |
| PLAS0630-001 09/04/2023  |             |         |
|  | Rates       | Fringes |
| PLASTERER.....   | \$ 46.12    | 34.53   |
| -----  |             |         |
| PLAS0630-002 09/04/2023  |             |         |
|  | Rates       | Fringes |
| Cement Masons:   |             |         |
| Cement Masons.....   | \$ 44.12    | 33.63   |
| Trowel Machine Operators....                                     | \$ 44.27    | 33.63   |
| -----  |             |         |
| PLUM0675-001 01/05/2025  |             |         |
|  | Rates       | Fringes |
| Plumber, Pipefitter,<br>Steamfitter & Sprinkler Fitter...        | \$ 53.33    | 32.00   |
| -----  |             |         |
| ROOF0221-001 11/06/2022  |             |         |
|  | Rates       | Fringes |
| Roofers (Including Built Up,<br>Composition and Single Ply)..... | \$ 43.15    | 21.21   |
| -----  |             |         |
| SHEE0293-001 03/05/2023  |             |         |
|  | Rates       | Fringes |
| Sheet metal worker.....  | \$ 47.37    | 31.71   |
| -----  |             |         |
| * SUHI1997-002 09/15/1997  |             |         |
|  | Rates       | Fringes |
| Drapery Installer.....   | \$ 13.60 ** | 1.20    |
| FENCE ERECTOR (Chain Link<br>Fence).....                         | \$ 9.33 **  | 1.65    |
| -----  |             |         |

WELDERS - Receive rate prescribed for craft performing operation to which welding is incidental.

=====

\*\* Workers in this classification may be entitled to a higher minimum wage under Executive Order 14026 (\$17.75) or 13658 (\$13.30). Please see the Note at the top of the wage determination for more information. Please also note that the minimum wage requirements of Executive Order 14026 are not currently being enforced as to any contract or subcontract to which the states of Texas, Louisiana, or Mississippi, including their agencies, are a party.

Note: Executive Order (EO) 13706, Establishing Paid Sick Leave for Federal Contractors applies to all contracts subject to the Davis-Bacon Act for which the contract is awarded (and any solicitation was issued) on or after January 1, 2017. If this contract is covered by the EO, the contractor must provide employees with 1 hour of paid sick leave for every 30 hours they work, up to 56 hours of paid sick leave each year. Employees must be permitted to use paid sick leave for their own illness, injury or other health-related needs, including preventive care; to assist a family member (or person who is like family to the employee) who is ill, injured, or has other health-related needs, including preventive care; or for reasons resulting from, or to assist a family member (or person who is like family to the employee) who is a victim of, domestic violence, sexual assault, or stalking. Additional information on contractor requirements and worker protections under the EO is available at <https://www.dol.gov/agencies/whd/government-contracts>.

Unlisted classifications needed for work not included within the scope of the classifications listed may be added after award only as provided in the labor standards contract clauses (29CFR 5.5 (a) (1) (iii)).

-----

The body of each wage determination lists the classifications and wage rates that have been found to be prevailing for the type(s) of construction and geographic area covered by the wage determination. The classifications are listed in alphabetical order under rate identifiers indicating whether the particular rate is a union rate (current union negotiated rate), a survey rate, a weighted union average rate, a state adopted rate, or a supplemental classification rate.

#### Union Rate Identifiers

A four-letter identifier beginning with characters other than "SU", "UAVG", ?SA?, or ?SC? denotes that a union rate was prevailing for that classification in the survey. Example: PLUM0198-005 07/01/2024. PLUM is an identifier of the union whose collectively bargained rate prevailed in the survey for this classification, which in this example would be Plumbers. 0198 indicates the local union number or district council number where applicable, i.e., Plumbers Local 0198. The next number, 005 in the example, is an internal number used in processing the wage determination. The date, 07/01/2024 in the example, is the effective date of the most current negotiated

rate.

Union prevailing wage rates are updated to reflect all changes over time that are reported to WHD in the rates in the collective bargaining agreement (CBA) governing the classification.

Union Average Rate Identifiers

The UAVG identifier indicates that no single rate prevailed for those classifications, but that 100% of the data reported for the classifications reflected union rates. EXAMPLE: UAVG-OH-0010 01/01/2024. UAVG indicates that the rate is a weighted union average rate. OH indicates the State of Ohio. The next number, 0010 in the example, is an internal number used in producing the wage determination. The date, 01/01/2024 in the example, indicates the date the wage determination was updated to reflect the most current union average rate.

A UAVG rate will be updated once a year, usually in January, to reflect a weighted average of the current rates in the collective bargaining agreements on which the rate is based.

Survey Rate Identifiers

The "SU" identifier indicates that either a single non-union rate prevailed (as defined in 29 CFR 1.2) for this classification in the survey or that the rate was derived by computing a weighted average rate based on all the rates reported in the survey for that classification. As a weighted average rate includes all rates reported in the survey, it may include both union and non-union rates. Example: SUFL2022-007 6/27/2024. SU indicates the rate is a single non-union prevailing rate or a weighted average of survey data for that classification. FL indicates the State of Florida. 2022 is the year of the survey on which these classifications and rates are based. The next number, 007 in the example, is an internal number used in producing the wage determination. The date, 6/27/2024 in the example, indicates the survey completion date for the classifications and rates under that identifier.

?SU? wage rates typically remain in effect until a new survey is conducted. However, the Wage and Hour Division (WHD) has the discretion to update such rates under 29 CFR 1.6(c)(1).

State Adopted Rate Identifiers

The "SA" identifier indicates that the classifications and prevailing wage rates set by a state (or local) government were adopted under 29 C.F.R 1.3(g)-(h). Example: SAME2023-007 01/03/2024. SA reflects that the rates are state adopted. ME refers to the State of Maine. 2023 is the year during which the state completed the survey on which the listed classifications and rates are based. The next number, 007 in the example, is an internal number used in producing the wage determination. The date, 01/03/2024 in the example, reflects the date on which the classifications and rates under the ?SA? identifier took effect under state law in the state from which the rates were adopted.

-----

1) Has there been an initial decision in the matter? This can be:

- a) a survey underlying a wage determination
- b) an existing published wage determination
- c) an initial WHD letter setting forth a position on a wage determination matter
- d) an initial conformance (additional classification and rate) determination

On survey related matters, initial contact, including requests for summaries of surveys, should be directed to the WHD Branch of Wage Surveys. Requests can be submitted via email to [davisbaconinfo@dol.gov](mailto:davisbaconinfo@dol.gov) or by mail to:

Branch of Wage Surveys  
Wage and Hour Division  
U.S. Department of Labor  
200 Constitution Avenue, N.W.  
Washington, DC 20210

Regarding any other wage determination matter such as conformance decisions, requests for initial decisions should be directed to the WHD Branch of Construction Wage Determinations. Requests can be submitted via email to [BCWD-Office@dol.gov](mailto:BCWD-Office@dol.gov) or by mail to:

Branch of Construction Wage Determinations  
Wage and Hour Division  
U.S. Department of Labor  
200 Constitution Avenue, N.W.  
Washington, DC 20210

2) If an initial decision has been issued, then any interested party (those affected by the action) that disagrees with the decision can request review and reconsideration from the Wage and Hour Administrator (See 29 CFR Part 1.8 and 29 CFR Part 7). Requests for review and reconsideration can be submitted via email to [dba.reconsideration@dol.gov](mailto:dba.reconsideration@dol.gov) or by mail to:

Wage and Hour Administrator  
U.S. Department of Labor  
200 Constitution Avenue, N.W.  
Washington, DC 20210

The request should be accompanied by a full statement of the interested party's position and any information (wage payment data, project description, area practice material, etc.) that the requestor considers relevant to the issue.

3) If the decision of the Administrator is not favorable, an interested party may appeal directly to the Administrative Review Board (formerly the Wage Appeals Board). Write to:

Administrative Review Board  
U.S. Department of Labor  
200 Constitution Avenue, N.W.  
Washington, DC 20210.

=====

END OF GENERAL DECISION"

## PROPOSAL SCHEDULE

| ITEM NO. | ITEM   | APPROX.<br>QUANTITY | UNIT | UNIT<br>PRICE | AMOUNT   |
|----------|--|---------------------|------|---------------|----------|
| 201.0100 | Clearing and Grubbing                                  | 5,100               | S.Y. | \$ _____      | \$ _____ |
| 202.0100 | Removal of Concrete Curb                               | 3,010               | L.F. | \$ _____      | \$ _____ |
| 202.0200 | Removal of Concrete Curb and Gutter                    | 690                 | L.F. | \$ _____      | \$ _____ |
| 202.0300 | Removal of Bridge Railing - Concrete                   | 161                 | L.F. | \$ _____      | \$ _____ |
| 202.0400 | Removal of Bridge Railing - Metal                      | 570                 | L.F. | \$ _____      | \$ _____ |
| 202.0500 | Removal of Guardrail, End Terminals and Attenuators    | 11,650              | L.F. | \$ _____      | \$ _____ |
| 202.0600 | Removal of Signs and Single Posts                      | 204                 | EA   | \$ _____      | \$ _____ |
| 202.0700 | Removal of Signs and Double Posts                      | 45                  | EA   | \$ _____      | \$ _____ |
| 202.0800 | Removal of Signs                                       | 171                 | EA   | \$ _____      | \$ _____ |
| 202.0900 | Removal of 4-Foot Chain Link Fence                     | 60                  | L.F. | \$ _____      | \$ _____ |
| 202.1000 | Removal of Flexible Delineators                        | 1,300               | L.F. | \$ _____      | \$ _____ |
| 202.1100 | Removal of Steel Reflector Posts                       | 1,600               | L.F. | \$ _____      | \$ _____ |
| 202.1200 | Removal of Survey Monuments                            | 23                  | EA   | \$ _____      | \$ _____ |
| 202.1000 | Removal of Existing Geotextile Fabric                  | 4,750               | S.Y. | \$ _____      | \$ _____ |
| 203.0100 | Roadway Excavation                                     | 810                 | C.Y. | \$ _____      | \$ _____ |
| 204.0100 | Trench Excavation for Traffic Counting Station Systems | 45                  | C.Y. | \$ _____      | \$ _____ |
| 204.0200 | Trench Backfill for Traffic Counting Station Systems   | 45                  | C.Y. | \$ _____      | \$ _____ |

## PROPOSAL SCHEDULE

| ITEM NO. | ITEM  | APPROX. QUANTITY | UNIT      | UNIT PRICE | AMOUNT               |
|----------|---|------------------|-----------|------------|----------------------|
| 209.0100 | Installation, Maintenance, Monitoring, and Removal of BMP             | L.S.             | L.S.      | L.S.       | \$ _____             |
| 209.0200 | Additional Water Pollution, Dust, and Erosion Control                 | F.A.             | F.A.      | F.A.       | \$ <u>100,000.00</u> |
| 219.0100 | Hazardous Waste Remediation   | F.A.             | F.A.      | F.A.       | \$ <u>150,000.00</u> |
| 301.0100 | Hot Mix Asphalt Base Course   | 910              | TON       | \$ _____   | \$ _____             |
| 301.0200 | Hot Mix Asphalt Base Course with Polymer Modified Asphalt (PG 64E-22) | 1,266            | TON       | \$ _____   | \$ _____             |
| 314.0100 | CLSM  | 350              | C.Y.      | \$ _____   | \$ _____             |
| 401.0100 | Pavement Smoothness Incentive   | Allowance        | Allowance | Allowance  | \$ <u>145,000.00</u> |
| 401.0200 | HMA Pavement, Mix No. IV  | 405              | TON       | \$ _____   | \$ _____             |
| 401.0300 | HMA Pavement, Mix No. V   | 76               | TON       | \$ _____   | \$ _____             |
| 401.0400 | PMA Pavement, Mix No. IV with PG 64E-22                               | 10,500           | TON       | \$ _____   | \$ _____             |
| 401.0500 | Emulsified Asphalt - Low Tracking Bond Coat (LTBC)                    | 2,300            | S.Y.      | \$ _____   | \$ _____             |
| 406.0100 | Stone Matrix Asphalt (SMA) Pavement                                   | 190              | TON       | \$ _____   | \$ _____             |
| 411.0100 | 11-inch Concrete Pavement   | 14               | C.Y.      | \$ _____   | \$ _____             |
| 414.0100 | Excavation of Weakened Pavement Areas                                 | 190              | C.Y.      | \$ _____   | \$ _____             |
| 414.0200 | Furnishing and Installing Geogrid (GlassGrid 8511TF)                  | 3,300            | S.Y.      | \$ _____   | \$ _____             |
| 414.0300 | Furnishing and Installing Geogrid (PG100)                             | 7,700            | S.Y.      | \$ _____   | \$ _____             |
| 415.0100 | Cold Planing  | 61,000           | S.Y.      | \$ _____   | \$ _____             |

## PROPOSAL SCHEDULE

| ITEM NO. | ITEM   | APPROX.<br>QUANTITY | UNIT | UNIT<br>PRICE | AMOUNT              |
|----------|--|---------------------|------|---------------|---------------------|
| 503.0100 | Retaining Wall (Traffic Counting Station Cabinet), Max Height 5.0' | 30                  | L.F. | \$ _____      | \$ _____            |
| 503.0200 | 34" Type KAT Transition  | 32                  | EA   | \$ _____      | \$ _____            |
| 503.0300 | Modified 34" Type KAT Concrete Transition                          | 370                 | L.F. | \$ _____      | \$ _____            |
| 503.0400 | Concrete Patch on Existing Guardrail End Posts                     | 26                  | EA   | \$ _____      | \$ _____            |
| 503.0500 | 34" Tall Aesthetic Concrete Bridge Rail                            | 920                 | L.F. | \$ _____      | \$ _____            |
| 503.0600 | Type D2 End Post   | 3                   | EA   | \$ _____      | \$ _____            |
| 507.0100 | Metal Bridge Railing   | 570                 | L.F. | \$ _____      | \$ _____            |
| 507.0200 | Concrete Bridge Railing  | 220                 | L.F. | \$ _____      | \$ _____            |
| 512.0100 | Concrete Rehabilitation of Cracks                                  | 49                  | L.F. | \$ _____      | \$ _____            |
| 512.0200 | Concrete Rehabilitation of Spalls                                  | 200                 | S.F. | \$ _____      | \$ _____            |
| 520.0100 | Bridge Joint Repair  | 1,110               | L.F. | \$ _____      | \$ _____            |
| 602.0100 | Replace Reinforcing Steel  | F.A.                | F.A. | F.A.          | \$ <u>50,000.00</u> |
| 603.0100 | Adjusting Storm Drain Manhole Frame and Cover                      | 20                  | EA   | \$ _____      | \$ _____            |
| 603.0200 | Clean Existing Culverts  | F.A.                | F.A. | F.A.          | \$ <u>75,000.00</u> |
| 604.0100 | Cast Iron Grate 8 ¼"x1'-11 ¾"x1" (Viaduct Deck Scuppers)           | 5                   | EA   | \$ _____      | \$ _____            |
| 606.0100 | Midwest Guardrail System, MGS                                      | 7,200               | L.F. | \$ _____      | \$ _____            |
| 606.0200 | Midwest Guardrail System on 2:1 Fill Slope (9ft Posts)             | 432                 | L.F. | \$ _____      | \$ _____            |



## PROPOSAL SCHEDULE

| ITEM NO. | ITEM  | APPROX. QUANTITY | UNIT | UNIT PRICE | AMOUNT   |
|----------|---|------------------|------|------------|----------|
| 606.0300 | Thrie Beam Connection with Transition to Midwest Guardrail (25 LF Railing Replacement only) | 6                | EA   | \$ _____   | \$ _____ |
| 606.0400 | Transition Section, Thrie Beam to Strong Post   | 1                | EA   | \$ _____   | \$ _____ |
| 606.0500 | MGS Transition to Strong Post Guardrail   | 10               | EA   | \$ _____   | \$ _____ |
| 606.0600 | W-Beam Guardrail (Railing only, existing posts to remain, omitted post, nested)             | 670              | L.F. | \$ _____   | \$ _____ |
| 606.0700 | Thrie Beam Guardrail, Type 3 (Railing only, existing posts to remain)                       | 650              | L.F. | \$ _____   | \$ _____ |
| 606.0800 | Thrie Beam with 18 3/4" Post Spacing  | 26               | L.F. | \$ _____   | \$ _____ |
| 606.0900 | Thrie Beam Terminal Connector   | 1                | EA   | \$ _____   | \$ _____ |
| 606.1000 | Thrie Beam Rounded End Section  | 1                | EA   | \$ _____   | \$ _____ |
| 606.1100 | W-Beam Rounded End Section  | 5                | EA   | \$ _____   | \$ _____ |
| 606.1200 | MSKT - SP - MGS (TL-3) End Treatment  | 10               | EA   | \$ _____   | \$ _____ |
| 606.1300 | RubRail   | 25               | LF   | \$ _____   | \$ _____ |
| 606.1400 | MGS with 18 3/4" Post Spacing   | 38               | LF   | \$ _____   | \$ _____ |
| 606.1500 | HSS 8x8x3/16 Block Replacement  | 38               | LF   | \$ _____   | \$ _____ |
| 606.1600 | Trailing-End Anchorage System   | 13               | EA   | \$ _____   | \$ _____ |
| 606.1700 | MAX-Tension TL-2  | 1                | EA   | \$ _____   | \$ _____ |
| 606.1800 | Asymmetrical Transition Section (Left) (37 1/2" Post Spacing)                               | 4                | EA   | \$ _____   | \$ _____ |
| 606.1900 | Asymmetrical Transition Section (Right) (37 1/2" Post Spacing)                              | 4                | EA   | \$ _____   | \$ _____ |

## PROPOSAL SCHEDULE

| ITEM NO. | ITEM   | APPROX.<br>QUANTITY | UNIT | UNIT<br>PRICE | AMOUNT              |
|----------|--|---------------------|------|---------------|---------------------|
| 606.2000 | MGS Long Span LSC-2  | 2                   | EA   | \$ _____      | \$ _____            |
| 606.2100 | Guardrail Type 3 MASH Transition   | 32                  | EA   | \$ _____      | \$ _____            |
| 606.2200 | Retro-Rail System  | 116                 | LF   | \$ _____      | \$ _____            |
| 606.2300 | Modified Hawaii Thrie Beam Approach Guardrail Transition   | 3                   | EA   | \$ _____      | \$ _____            |
| 606.2400 | 12.5 LF Thrie Beam Guardrail   | 1                   | EA   | \$ _____      | \$ _____            |
| 606.2500 | 12.5 LF Nested Thrie Beam Guardrail  | 1                   | EA   | \$ _____      | \$ _____            |
| 606.2600 | 6.25 LF Transition Section Thrie Beam to Strong Post<br>(Railing only, existing posts to remain) | 1                   | EA   | \$ _____      | \$ _____            |
| 607.0100 | 6-Foot Chain Link Fence, without Toprail   | 45                  | L.F. | \$ _____      | \$ _____            |
| 612.0100 | Grouted Rubble Paving Type 1 (GRP1)  | 4,975               | S.F. | \$ _____      | \$ _____            |
| 612.0200 | Grouted Rubble Paving Type 2 (GRP2)  | 3,075               | S.F. | \$ _____      | \$ _____            |
| 612.0300 | 4-inch Layer 2.5-inch Dia. Recycled Crushed Concrete or Basalt Gravel                            | 3,770               | S.F. | \$ _____      | \$ _____            |
| 613.0100 | Reconstructing Centerline and Reference Survey Monuments   | 23                  | EA   | \$ _____      | \$ _____            |
| 613.0200 | Adjusting Centerline and Reference Survey Monuments  | 1                   | EA   | \$ _____      | \$ _____            |
| 616.0100 | Temporary Irrigation System  | L.S.                | L.S. | L.S.          | \$ _____            |
| 616.0200 | Relocation of Sprinkler System   | F.A.                | F.A. | F.A.          | \$ <u>20,000.00</u> |
| 617.0100 | Imported Planting Soil   | L.S.                | L.S. | L.S.          | \$ _____            |
| 619.0100 | Wilhelmina Tenney Rainbow Shower Trees   | 2                   | EA   | \$ _____      | \$ _____            |

## PROPOSAL SCHEDULE

| ITEM NO. | ITEM   | APPROX. QUANTITY | UNIT | UNIT PRICE | AMOUNT              |
|----------|--|------------------|------|------------|---------------------|
| 619.0200 | Beach Naupaka Shrubs   | 74               | EA   | \$ _____   | \$ _____            |
| 619.0300 | Pohinahina Shrubs  | 5                | EA   | \$ _____   | \$ _____            |
| 619.0400 | Yellow Allamanda Shrubs  | 45               | EA   | \$ _____   | \$ _____            |
| 619.0500 | Hydroseed Buffel Grass   | 21,480           | S.F. | \$ _____   | \$ _____            |
| 619.0600 | Wood Chip Mulch  | 2,500            | S.F. | \$ _____   | \$ _____            |
| 622.0100 | Roadway Lighting System  | L.S.             | L.S. | L.S.       | \$ _____            |
| 622.0200 | Relocation of Highway Lighting   | F.A.             | F.A. | F.A.       | \$ <u>50,000.00</u> |
| 622.0300 | Adjust Electrical Manhole  | 3                | EA   | \$ _____   | \$ _____            |
| 622.0400 | Adjust Hawaiian Telcom Manhole   | 7                | EA   | \$ _____   | \$ _____            |
| 623.0100 | Traffic Signal System  | L.S.             | L.S. | L.S.       | \$ _____            |
| 626.0100 | Adjusting Water Manhole Frame and Cover                                      | 26               | EA   | \$ _____   | \$ _____            |
| 626.0200 | Adjusting Water Standard Valve Box   | 49               | EA   | \$ _____   | \$ _____            |
| 626.0300 | Adjusting Sewer Manhole Frame and Cover                                      | 29               | EA   | \$ _____   | \$ _____            |
| 627.0100 | EVC Traffic Counting Systems   | 23               | EA   | \$ _____   | \$ _____            |
| 627.0200 | Restore EVC Traffic Counting Systems   | 3                | EA   | \$ _____   | \$ _____            |
| 629.0100 | Single 4-Inch White Pavement Striping (Thermoplastic Extrusion)              | 950              | L.F. | \$ _____   | \$ _____            |
| 629.0200 | Single 4-Inch Yellow Pavement Striping (Thermoplastic Extrusion) (Bike Lane) | 50               | L.F. | \$ _____   | \$ _____            |

## PROPOSAL SCHEDULE

| ITEM NO. | ITEM  | APPROX.<br>QUANTITY | UNIT | UNIT<br>PRICE | AMOUNT   |
|----------|---|---------------------|------|---------------|----------|
| 629.0300 | Single 4-Inch White Guide Line (Thermoplastic Extrusion)                | 850                 | L.F. | \$ _____      | \$ _____ |
| 629.0400 | Double 4-Inch White Pavement Striping (Thermoplastic Extrusion)         | 100                 | L.F. | \$ _____      | \$ _____ |
| 629.0500 | Double 4-Inch Yellow Pavement Striping (Thermoplastic Extrusion)        | 3,100               | L.F. | \$ _____      | \$ _____ |
| 629.0600 | Double 4-Inch Yellow Dashed Pavement Striping (Thermoplastic Extrusion) | 150                 | L.F. | \$ _____      | \$ _____ |
| 629.0700 | Single 6-Inch White Pavement Striping (Thermoplastic Extrusion)         | 13,000              | L.F. | \$ _____      | \$ _____ |
| 629.0800 | Single 6-Inch Yellow Pavement Striping (Thermoplastic Extrusion)        | 12,750              | L.F. | \$ _____      | \$ _____ |
| 629.0900 | Single 8-Inch White Pavement Striping (Thermoplastic Extrusion)         | 8,400               | L.F. | \$ _____      | \$ _____ |
| 629.1000 | Single 8-Inch White Lane Drop Marking (Thermoplastic Extrusion)         | 400                 | L.F. | \$ _____      | \$ _____ |
| 629.1100 | Single 12-Inch White Pavement Striping (Thermoplastic Extrusion)        | 1,900               | L.F. | \$ _____      | \$ _____ |
| 629.1200 | Single 12-Inch Yellow Pavement Striping (Thermoplastic Extrusion)       | 100                 | L.F. | \$ _____      | \$ _____ |
| 629.1300 | 24-Inch Green Bicycle Crossing  | 110                 | L.F. | \$ _____      | \$ _____ |
| 629.1400 | 24-Inch Crosswalk Marking   | 85                  | LANE | \$ _____      | \$ _____ |
| 629.1500 | Profiled Thermoplastic Striping (White)                                 | 250                 | EA   | \$ _____      | \$ _____ |
| 629.1600 | Profiled Thermoplastic Striping (Rumble Strip)                          | 50                  | EA   | \$ _____      | \$ _____ |
| 629.1700 | Type C Pavement Marker  | 1,050               | EA   | \$ _____      | \$ _____ |
| 629.1800 | Type D Pavement Marker  | 150                 | EA   | \$ _____      | \$ _____ |
| 629.1900 | Type F Pavement Marker (BWS Fire Hydrant Marker)                        | 40                  | EA   | \$ _____      | \$ _____ |

## PROPOSAL SCHEDULE

| ITEM NO. | ITEM   | APPROX.<br>QUANTITY | UNIT | UNIT<br>PRICE | AMOUNT   |
|----------|--|---------------------|------|---------------|----------|
| 629.2000 | Type H Pavement Marker   | 400                 | EA   | \$ _____      | \$ _____ |
| 629.2100 | Pavement Arrow (Thermoplastic Extrusion)   | 48                  | EA   | \$ _____      | \$ _____ |
| 629.2200 | Pavement Word Marking (Thermoplastic Extrusion)  | 13                  | EA   | \$ _____      | \$ _____ |
| 629.2300 | Pavement Symbol (Thermoplastic Extrusion) (Yield Ahead)  | 1                   | EA   | \$ _____      | \$ _____ |
| 629.2400 | Pavement Symbol (Thermoplastic Extrusion) (Bike Lane)  | 4                   | EA   | \$ _____      | \$ _____ |
| 629.2500 | Yield Line Marking   | 70                  | L.F. | \$ _____      | \$ _____ |
| 630.0100 | Replacement of Existing Sign Panel with New Destination and Guide Sign Panels (Extruded Aluminum Panels) | 3,000               | S.F. | \$ _____      | \$ _____ |
| 630.0200 | Replacement of Existing Sign Panel with New Destination and Guide Sign Panels (Sheet Aluminum)           | 600                 | S.F. | \$ _____      | \$ _____ |
| 630.0300 | Destination Sign (10 Sq. Feet or less) with Post   | 4                   | EA   | \$ _____      | \$ _____ |
| 630.0400 | Destination Sign (10 Sq. Feet or less) without Post  | 7                   | EA   | \$ _____      | \$ _____ |
| 630.0500 | Destination Sign (more than 10 Sq. Feet) without Post  | 10                  | EA   | \$ _____      | \$ _____ |
| 630.0600 | Guide Sign - Conventional Rd. (10 Sq. Feet or less) with Post  | 9                   | EA   | \$ _____      | \$ _____ |
| 630.0700 | Guide Sign - Conventional Rd. (10 Sq. Feet or less) without Post   | 26                  | EA   | \$ _____      | \$ _____ |
| 630.0800 | Reinstall Existing Street Name Signs to new posts  | 15                  | EA   | \$ _____      | \$ _____ |
| 631.0100 | Regulatory Sign (10 Sq. Feet or less) with Post  | 137                 | EA   | \$ _____      | \$ _____ |
| 631.0200 | Regulatory Sign (10 Sq. Feet or less) without Post   | 209                 | EA   | \$ _____      | \$ _____ |

## PROPOSAL SCHEDULE

| ITEM NO. | ITEM  | APPROX.<br>QUANTITY | UNIT | UNIT<br>PRICE | AMOUNT   |
|----------|---|---------------------|------|---------------|----------|
| 631.0300 | Regulatory Sign (more than 10 Sq. Feet) with Post       | 13                  | EA   | \$ _____      | \$ _____ |
| 631.0400 | Regulatory Sign (more than 10 Sq. Feet) without Post    | 23                  | EA   | \$ _____      | \$ _____ |
| 631.0500 | Warning Sign (10 Sq. Feet or less) with Post            | 31                  | EA   | \$ _____      | \$ _____ |
| 631.0600 | Warning Sign (10 Sq. Feet or less) without Post         | 18                  | EA   | \$ _____      | \$ _____ |
| 631.0700 | Warning Sign (more than 10 Sq. Feet) with Post          | 22                  | EA   | \$ _____      | \$ _____ |
| 631.0800 | Warning Sign (more than 10 Sq. Feet) without Post       | 15                  | EA   | \$ _____      | \$ _____ |
| 631.0900 | School Sign (10 Sq. Feet or less) with Post             | 1                   | EA   | \$ _____      | \$ _____ |
| 631.1000 | School Sign (10 Sq. Feet or less) without Post          | 1                   | EA   | \$ _____      | \$ _____ |
| 631.1100 | Miscellaneous Sign (10 Sq. Feet or less) with Post      | 3                   | EA   | \$ _____      | \$ _____ |
| 631.1200 | Miscellaneous Sign (10 Sq. Feet or less) without Post   | 5                   | EA   | \$ _____      | \$ _____ |
| 631.1300 | Miscellaneous Sign (more than 10 Sq. Feet) with Post    | 3                   | EA   | \$ _____      | \$ _____ |
| 631.1400 | Miscellaneous Sign (more than 10 Sq. Feet) without Post | 6                   | EA   | \$ _____      | \$ _____ |
| 632.0100 | Reflector Marker RM-2 (with Flexible Post)              | 151                 | EA   | \$ _____      | \$ _____ |
| 632.0200 | Reflector Marker RM-2 (without Post)                    | 271                 | EA   | \$ _____      | \$ _____ |
| 632.0300 | Type III Object Marker (OM1-1) without Post             | 27                  | EA   | \$ _____      | \$ _____ |
| 632.0400 | Type III Object Marker (OM1-1) with Post                | 3                   | EA   | \$ _____      | \$ _____ |
| 632.0500 | Type III Object Marker (OM2-2V) without Post            | 18                  | EA   | \$ _____      | \$ _____ |

## PROPOSAL SCHEDULE

| ITEM NO. | ITEM  | APPROX. QUANTITY | UNIT | UNIT PRICE | AMOUNT       |
|----------|---|------------------|------|------------|--------------|
| 632.0600 | Type III Object Marker (OM3-1L) without Post                                    | 1                | EA   | \$ _____   | \$ _____     |
| 632.0700 | Type III Object Marker (OM3-1R) with Post                                       | 7                | EA   | \$ _____   | \$ _____     |
| 632.0800 | Type III Object Marker (OM3-1R) without Post                                    | 4                | EA   | \$ _____   | \$ _____     |
| 632.0900 | Mile Post Marker (with Post)  | 6                | EA   | \$ _____   | \$ _____     |
| 632.1000 | Mile Post Marker (without Post)   | 4                | EA   | \$ _____   | \$ _____     |
| 632.1100 | Mile Post Marker with Post (Bi-directional)                                     | 1                | EA   | \$ _____   | \$ _____     |
| 634.0100 | Portland Cement Concrete Sidewalk   | 12               | C.Y. | \$ _____   | \$ _____     |
| 636.0100 | Additional E-Construction Programs, additional licenses or additional equipment | F.A.             | F.A. | F.A.       | \$ 10,000.00 |
| 638.0100 | Curb, Type 2D   | 790              | L.F. | \$ _____   | \$ _____     |
| 638.0200 | Concrete Gutter   | 356              | LF   | \$ _____   | \$ _____     |
| 638.0300 | 2" Concrete Curb  | 74               | L.F. | \$ _____   | \$ _____     |
| 638.0400 | HDOT Driveway Curb  | 440              | L.F. | \$ _____   | \$ _____     |
| 638.0500 | HDOT Driveway Curb and Gutter   | 338              | L.F. | \$ _____   | \$ _____     |
| 638.0600 | 4" Curb and Gutter  | 15               | L.F. | \$ _____   | \$ _____     |
| 638.0700 | 0" to 4" Curb Height Transition   | 58               | L.F. | \$ _____   | \$ _____     |
| 638.0800 | 0" to 6" Curb Height Transition   | 76               | L.F. | \$ _____   | \$ _____     |
| 638.0900 | 2" Curb to 6" Curb Height Transition  | 70               | L.F. | \$ _____   | \$ _____     |

## PROPOSAL SCHEDULE

| ITEM NO. | ITEM  | APPROX. QUANTITY | UNIT  | UNIT PRICE | AMOUNT               |
|----------|---|------------------|-------|------------|----------------------|
| 638.1000 | 4" Curb to HDOT Driveway Curb Transition  | 46               | L.F.  | \$ _____   | \$ _____             |
| 638.1100 | 6" Curb to HDOT Driveway Curb Transition  | 90               | L.F.  | \$ _____   | \$ _____             |
| 638.1200 | 3" Curb and Gutter to HDOT Driveway Curb and Gutter Transition                    | 20               | L.F.  | \$ _____   | \$ _____             |
| 638.1300 | 6" Curb and Gutter to HDOT Driveway Curb and Gutter Transition                    | 60               | L.F.  | \$ _____   | \$ _____             |
| 638.1400 | Type E Curb to HDOT Driveway Curb Transition                                      | 20               | L.F.  | \$ _____   | \$ _____             |
| 638.1500 | Type E Curb and Gutter to HDOT Driveway Curb and Gutter Transition                | 30               | L.F.  | \$ _____   | \$ _____             |
| 642.0100 | Plant Maintenance   | 14               | Month | \$ _____   | \$ _____             |
| 642.0200 | Irrigation Maintenance  | 14               | Month | \$ _____   | \$ _____             |
| 645.0100 | Traffic Control   | L.S.             | L.S.  | L.S.       | \$ _____             |
| 645.0200 | Additional Police Officers, Additional Traffic Control Devices, And Advertisement | F.A.             | F.A.  | F.A.       | \$ <u>500,000.00</u> |
| 648.0100 | Field-Posted Drawings   | L.S.             | L.S.  | L.S.       | \$ _____             |
| 676.0100 | Repair for Concrete Deck  | 770              | S.F.  | \$ _____   | \$ _____             |
| 692.0100 | Voluntary Partnering  | F.A.             | F.A.  | F.A.       | \$ <u>25,000.00</u>  |
| 693.0100 | Quadguard Elite M10 Wide (with Tension Strut Backup), TL-3                        | 7                | EA    | \$ _____   | \$ _____             |
| 693.0200 | Transition, QUAD M10 to Thrie-Beam (37 1/2" Post Spacing)                         | 10               | EA    | \$ _____   | \$ _____             |
| 693.0300 | Quadguard M10 TL-2  | 4                | EA    | \$ _____   | \$ _____             |
| 693.0400 | Transition, QUAD-W,610,QG,L,G   | 2                | EA    | \$ _____   | \$ _____             |



## PROPOSAL SCHEDULE

| ITEM NO. | ITEM  | APPROX. QUANTITY | UNIT | UNIT PRICE | AMOUNT               |
|----------|---|------------------|------|------------|----------------------|
| 693.0500 | Transition, QUAD-W,610,QG,R,G   | 1                | EA   | \$ _____   | \$ _____             |
| 694.0100 | Longitudinal Channelizing Curb System   | 780              | L.F. | \$ _____   | \$ _____             |
| 694.0200 | Yellow Surface Mounted Delineators  | 310              | L.F. | \$ _____   | \$ _____             |
| 695.0100 | Inertial Barrier Module, 200 Pounds   | 8                | EA   | \$ _____   | \$ _____             |
| 695.0200 | Inertial Barrier Module, 400 Pounds   | 21               | EA   | \$ _____   | \$ _____             |
| 695.0300 | Inertial Barrier Module, 700 Pounds   | 47               | EA   | \$ _____   | \$ _____             |
| 695.0400 | Inertial Barrier Module, 1400 Pounds  | 20               | EA   | \$ _____   | \$ _____             |
| 695.0500 | Inertial Barrier Module, 2100 Pounds  | 21               | EA   | \$ _____   | \$ _____             |
| 696.0100 | Field Office Trailer (Not to Exceed \$32,000.00)  | L.S.             | L.S. | L.S.       | \$ _____             |
| 696.0200 | Maintenance of Trailers   | F.A.             | F.A. | F.A.       | \$ <u>40,000.00</u>  |
| 697.0100 | Additional Public Educational Materials or Services   | F.A.             | F.A. | F.A.       | \$ <u>250,000.00</u> |
| 699.0100 | Mobilization (Not to exceed 6 percent of the sum of all items excluding bid price of this item) | L.S.             | L.S. | L.S.       | \$ _____             |

### SUMMARY FOR PROPOSAL SCHEDULES

a. TOTAL AMOUNT FOR COMPARISON OF BIDS ..... \$ \_\_\_\_\_



**NOTES:**

1. Bids shall include all Federal, State, County and other applicable taxes and fees.
2. The TOTAL AMOUNT FOR COMPARISON OF BIDS shall be used to determine the lowest responsible bidder.
3. Bidders shall complete all unit prices and amounts. Failure to do so shall be grounds for rejection of bid.
4. If a discrepancy occurs between the unit bid price and the bid price, the unit bid price shall govern.

## PROPOSAL SCHEDULE

| ITEM NO. | ITEM  | APPROX.<br>QUANTITY | UNIT | UNIT<br>PRICE | AMOUNT |
|----------|---|---------------------|------|---------------|--------|
|          | <p>5. Bidders shall submit and <u>upload the complete proposal to HlePRO</u> prior to the bid opening date and time. Proposals received after said due date and time shall not be considered. Any additional support documents explicitly designated as <u>confidential and/or proprietary</u> shall be uploaded as a <u>separate file</u> to HlePRO. Bidders shall not include confidential and/or proprietary documents with the proposal. The record of each bidder and respective bid shall be open to public inspection. Original (wet ink, hard copy) proposal documents are not required to be submitted. Contract award shall be based on evaluation of proposals submitted and uploaded to HlePRO. <b><u>FAILURE TO UPLOAD THE COMPLETE PROPOSAL TO HlePRO SHALL BE GROUNDS FOR REJECTION OF THE BID.</u></b></p> <p>If there is a conflict between the specification document and the HlePRO solicitation, the specifications shall govern and control, unless otherwise specified.</p> |                     |      |               |        |

| FED. ROAD DIST. NO. | STATE | FED-AID PROJ. NO. | FISCAL YEAR | SHEET NO. | TOTAL SHEETS |
|---------------------|-------|-------------------|-------------|-----------|--------------|

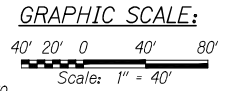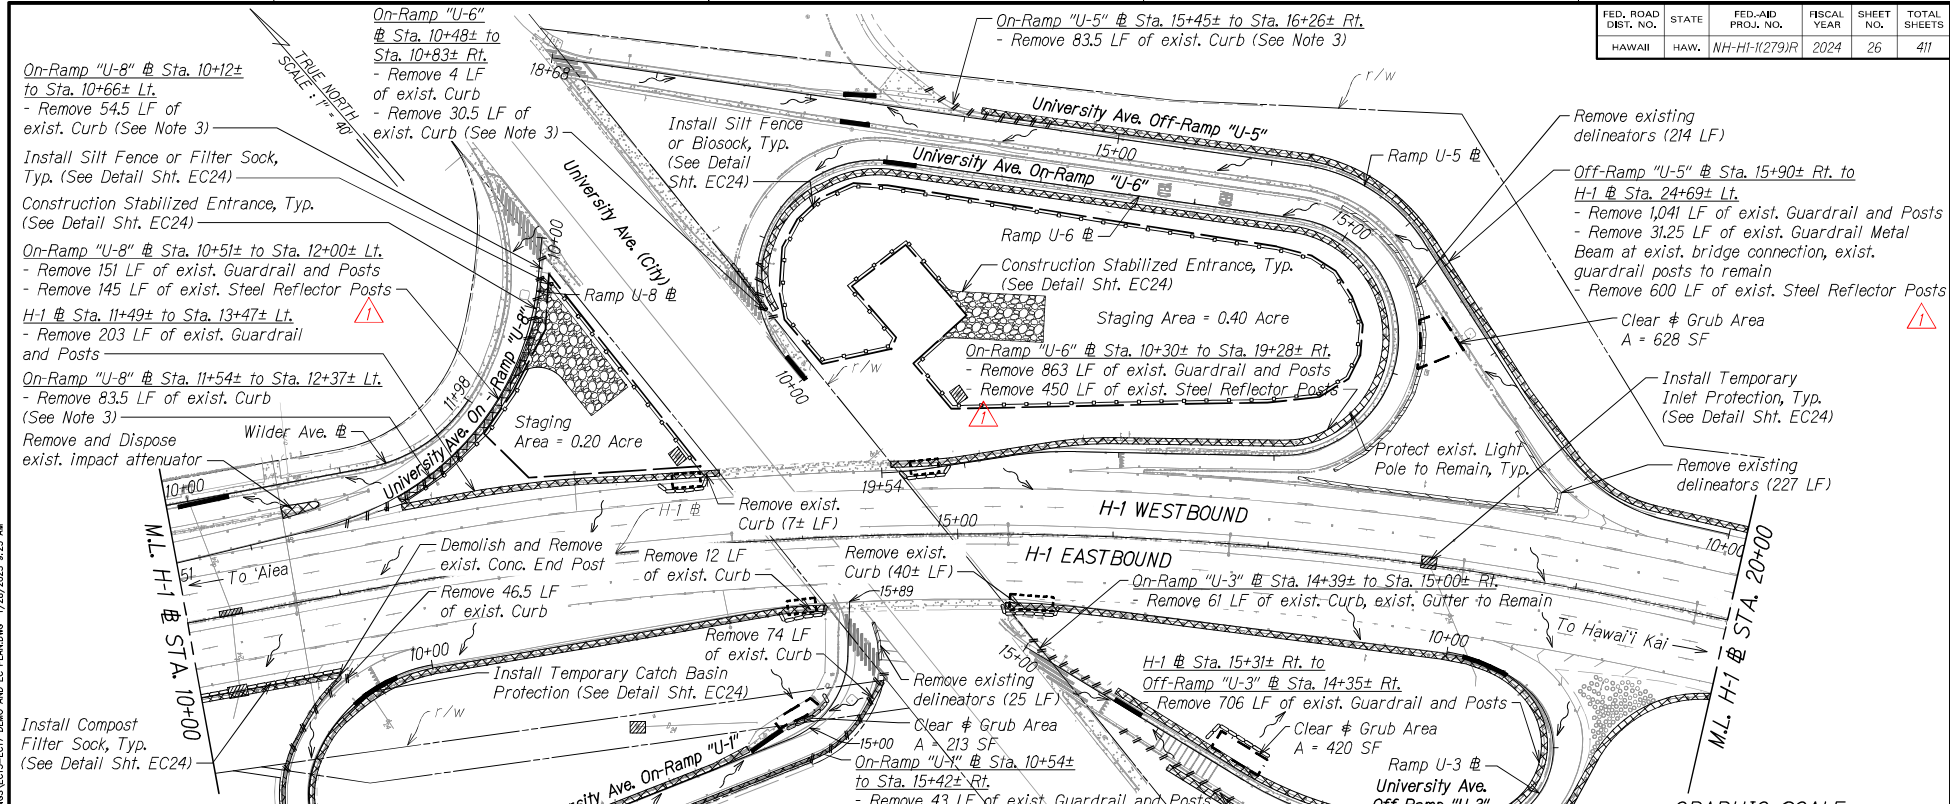

|   |   |
|---|---|
| 2/5/25  | Added Removal of Steel Reflector Posts. |
| DATE  | REVISION                                |
| STATE OF HAWAII<br>DEPARTMENT OF TRANSPORTATION<br>HIGHWAYS DIVISION  |   |
| <b>DEMOLITION AND EROSION CONTROL</b>   |   |
| INTERSTATE ROUTE H-1 RESURFACING<br>Miller Pedestrian Overpass to Kapiolani Interchange<br>Federal-Aid Project No. NH-HI-K279/R |   |
| Scale: 1" = 40'      Date: February 2025  |   |
| SHEET No. EC13 OF 24 SHEETS   |   |




THIS WORK WAS PREPARED BY ME OR UNDER MY SUPERVISION

*Rodney R. McKinney* 04/30/26  
SIGNATURE      EXPIRATION DATE OF THE LICENSE

M.L. CIVIL 3D PROJECTS/2016-2025/000 001-HIWS H1 RESURFACING - MILLER TO KAPIOLANI CIVIL DRAWINGS/EC13-EC15 DEM AND EG PLAN/REV 1/28/2025 9:25 AM


| FED. ROAD DIST. NO. | STATE | FED-AID PROJ. NO. | FISCAL YEAR | SHEET NO. | TOTAL SHEETS |
|---------------------|-------|-------------------|-------------|-----------|--------------|
| HAWAII              | HAW.  | NH-HI-1(279)R     | 2024        | 38        | 411          |

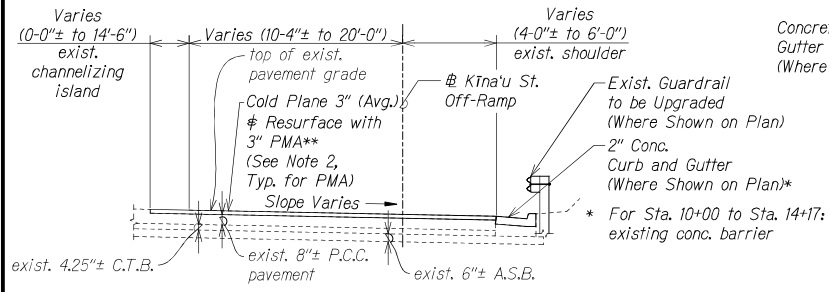


**(STA. 10+00± TO STA. 16+85±)  
EB KINA'U ST. OFF-RAMP  
PAVEMENT RESURFACING SECTION**  
Scale: 1/4" = 1'-0"

\*\* Place Tensar Rapid Repair PG100 under PMA


Concrete Railing and Gutter (Where Shown on Plan)

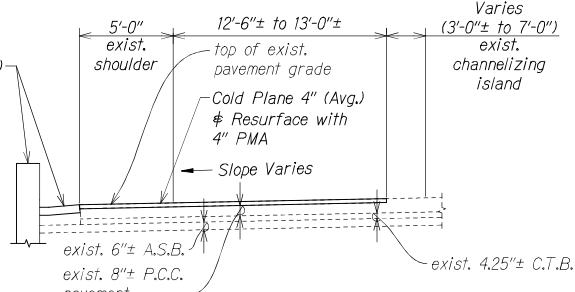


**(H-1 BL STA. 200+66 TO STA. 202+68±)  
WB LUNALILO ST. ON-RAMP  
PAVEMENT RESURFACING SECTION**  
Scale: 1/4" = 1'-0"

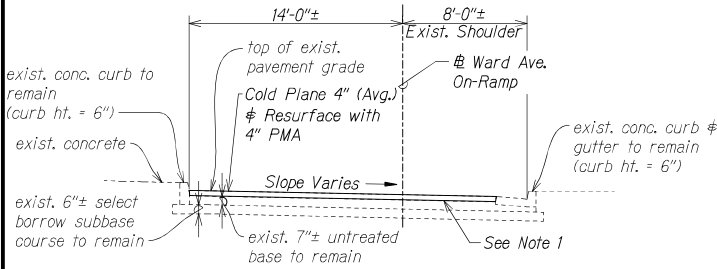


**(STA. 10+26± TO STA. 13+71±)  
EB WARD AVE. ON-RAMP  
PAVEMENT RESURFACING SECTION**  
Scale: 1/4" = 1'-0"

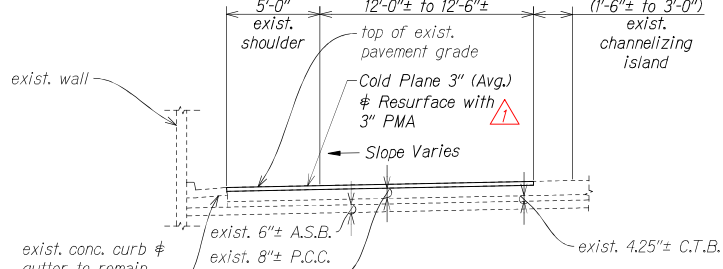

**(H-1 BL STA. 200+00± TO STA. 200+66)  
WB LUNALILO ST. ON-RAMP  
PAVEMENT RESURFACING SECTION**  
Scale: 1/4" = 1'-0"

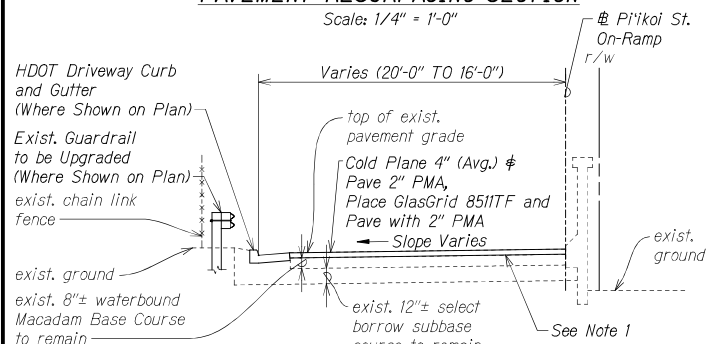

**(STA. 10+15± TO STA. 17+35±)  
EB PI'IKOI ST. ON-RAMP  
PAVEMENT RESURFACING SECTION**  
Scale: 1/4" = 1'-0"

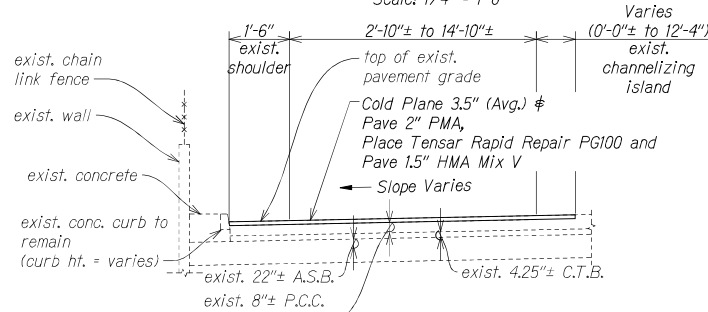

**(H-1 BL STA. 225+12± TO STA. 228+38±)  
WB LUNALILO ST. OFF-RAMP  
PAVEMENT RESURFACING SECTION**  
Scale: 1/4" = 1'-0"

- NOTES:**
1. Apply Tack Coat in between exist. and new A.C. Pavement.
  2. PMA refers to Mix No. IV with PG 64E-22.

|  |                           |
|--|---------------------------|
| 2/5/25   | Revised Pavement Section. |
| DATE   | REVISION                  |
| STATE OF HAWAII<br>DEPARTMENT OF TRANSPORTATION<br>HIGHWAYS DIVISION   |                           |
| <b>RAMP TYPICAL SECTIONS</b>   |                           |
| INTERSTATE ROUTE H-1 RESURFACING<br>Miller Pedestrian Overpass to Kapiolani Interchange<br>Federal-Aid Project No. NH-HI-1(279)R |                           |
| Scale: As Shown  | Date: February 2025       |
| SHEET No. 01 OF 19 SHEETS  |                           |









THIS WORK WAS PREPARED BY ME OR UNDER MY SUPERVISION

Signature: *Rodney McKinney* 04/30/26  
EXPIRATION DATE OF THE LICENSE

W:\\_civil\_3D\_PROJECTS\0316\_20240601-HI-1(279)R\_H1\_RESURFACING - MILLER TO KAPOLANI CIVIL DRAWINGS\CI RAMP TYPICAL SECTIONS.DWG 7/24/2024 12:22 AM

| FED. ROAD DIST. NO. | STATE | FED-AID PROJ. NO. | FISCAL YEAR | SHEET NO. | TOTAL SHEETS |
|---------------------|-------|-------------------|-------------|-----------|--------------|
| HAWAII              | HAW.  | NH-HI-1(279)R     | 2024        | 39        | 411          |

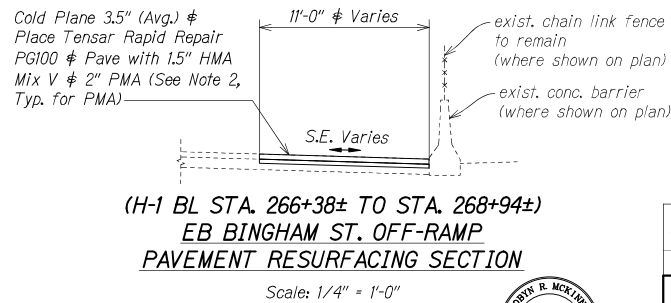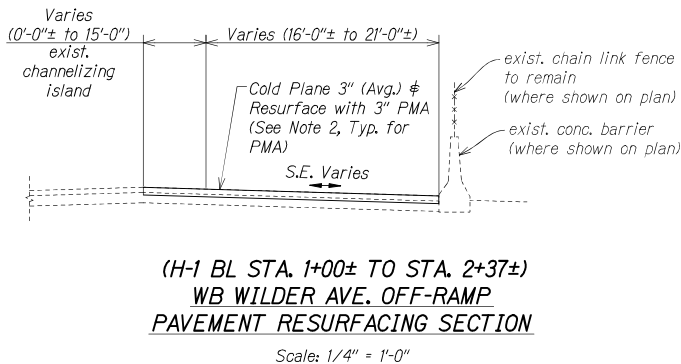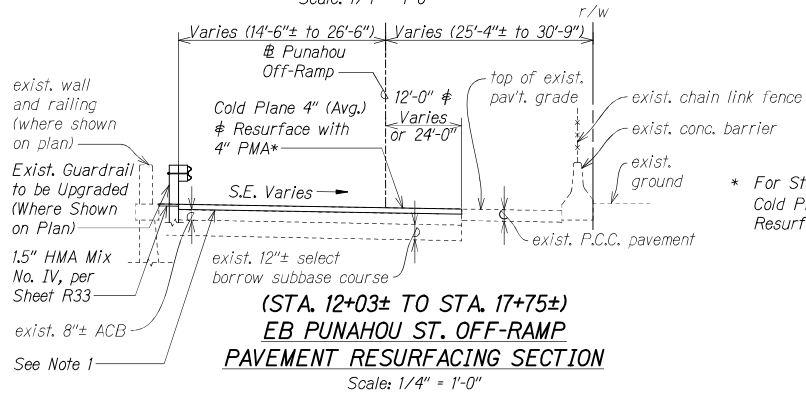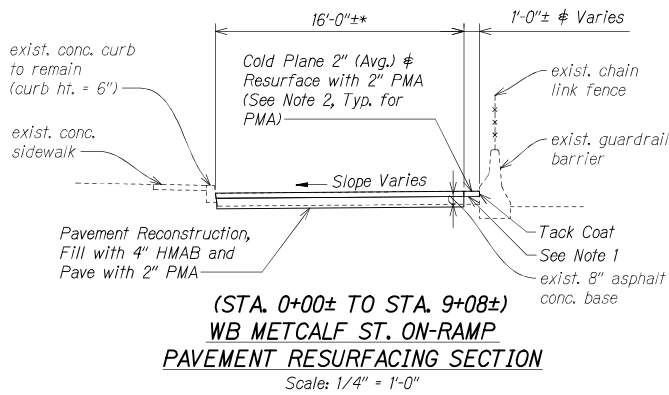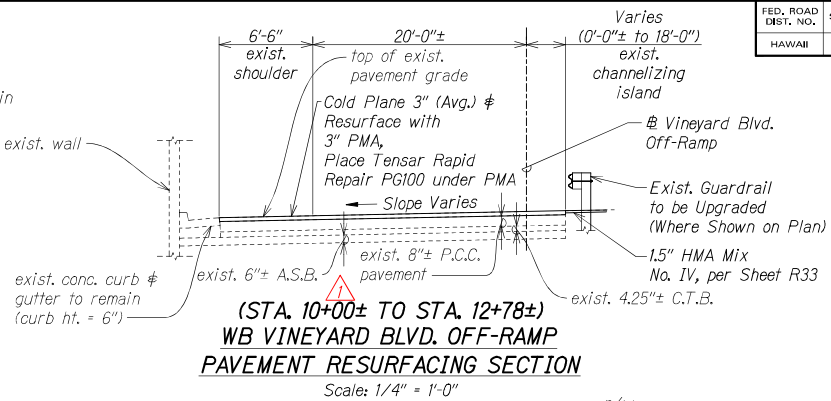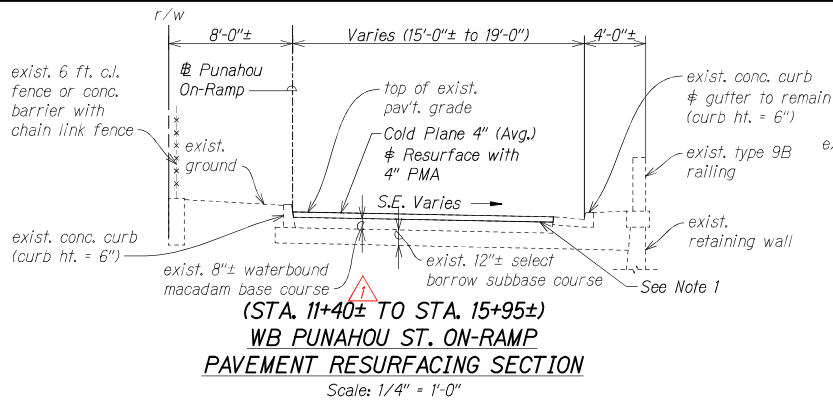

\* For Sta. 12+03 to Sta. 12+97:  
Cold Plane 3" (Avg.) Resurface with 3" PMA

- NOTES:**
1. Apply Tack Coat in between exist. and new A.C. Pavement.
  2. PMA refers to Mix No. IV with PG 64E-22.




THIS WORK WAS PREPARED BY ME OR UNDER MY SUPERVISION

Signature: *Rodney R. McKinnis*  
EXPIRATION DATE: 04/30/26


|  |                        |
|--|------------------------|
| 2/5/25   | Revised Start Station. |
| DATE   | REVISION               |
| STATE OF HAWAII<br>DEPARTMENT OF TRANSPORTATION<br>HIGHWAYS DIVISION   |                        |
| <b>RAMP TYPICAL SECTIONS</b>   |                        |
| INTERSTATE ROUTE H-1 RESURFACING<br>Miller Pedestrian Overpass to Kapiolani Interchange<br>Federal-Aid Project No. NH-HI-1(279)R |                        |
| Scale: As Shown  | Date: February 2025    |
| SHEET No. C2 OF 19 SHEETS  |                        |

W:\\_civil\_3D\_PROJECTS\0216\_202400\_001-HIHS H1 RESURFACING - MILLER TO KAPOLANI CIVIL DRAWINGS\C2 RAMP TYPICAL SECTIONS.DWG 7/24/2024 8:05 AM


| FED. ROAD DIST. NO. | STATE | FED-AID PROJ. NO. | FISCAL YEAR | SHEET NO. | TOTAL SHEETS |
|---------------------|-------|-------------------|-------------|-----------|--------------|
| HAWAII              | HAW.  | NH-HI-K279JR      | 2024        | 41        | 411          |

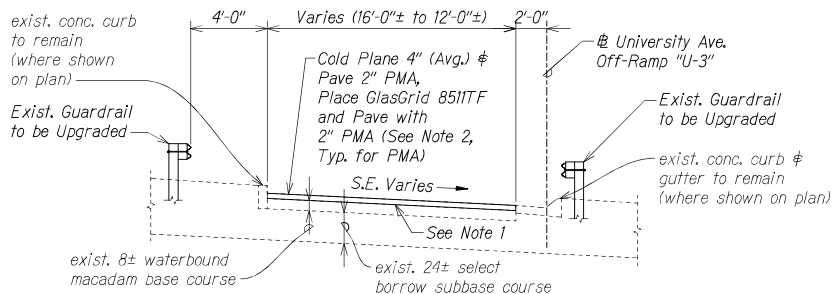


(STA. 10+49± TO STA. 14+97±)  
**EB UNIVERSITY AVE. OFF-RAMP "U-3"**  
 PAVEMENT RESURFACING SECTION  
 Scale: 1/4" = 1'-0"

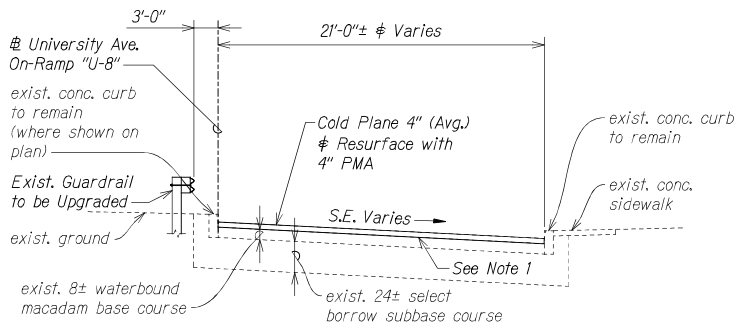

(STA. 10+00 TO STA. 12+77±)  
**WB UNIVERSITY AVE. ON-RAMP "U-8"**  
 PAVEMENT RESURFACING SECTION  
 Scale: 1/4" = 1'-0"

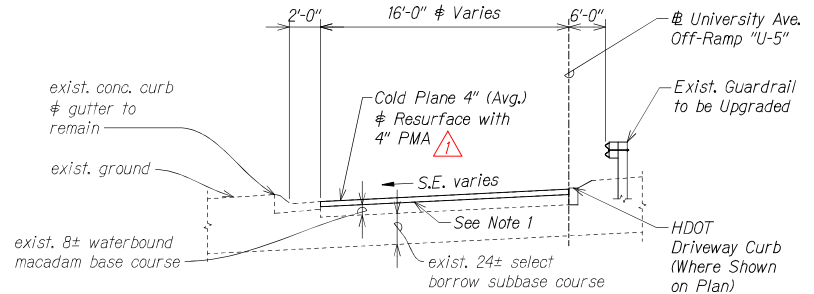

(STA. 10+86± TO STA. 18+68±)  
**WB UNIVERSITY AVE. OFF-RAMP "U-5"**  
 PAVEMENT RESURFACING SECTION  
 Scale: 1/4" = 1'-0"

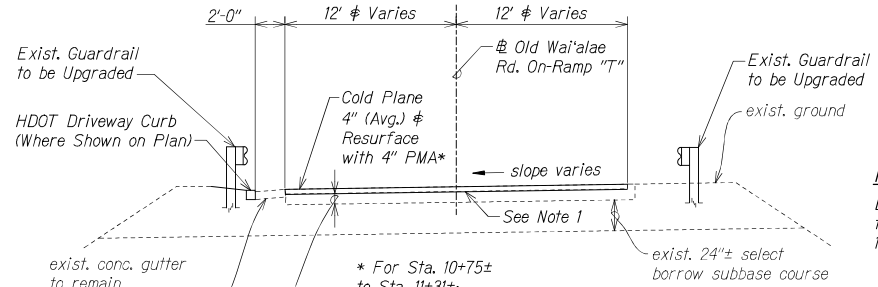


(STA. 10+75± TO STA. 17+55±)  
**WB OLD WAI'ALAE RD. ON-RAMP "T"**  
 PAVEMENT RESURFACING SECTION  
 Scale: 1/4" = 1'-0"



**NOTE:**  
 Existing Type A-1 Curb from Sta. 11+64± to Sta. 13+40± (Rt.) not shown.

\* For Ramp "U-6" Sta. 17+27 to Sta. 19+11±:  
 Cold Plane 3" (Avg.) with 3" PMA

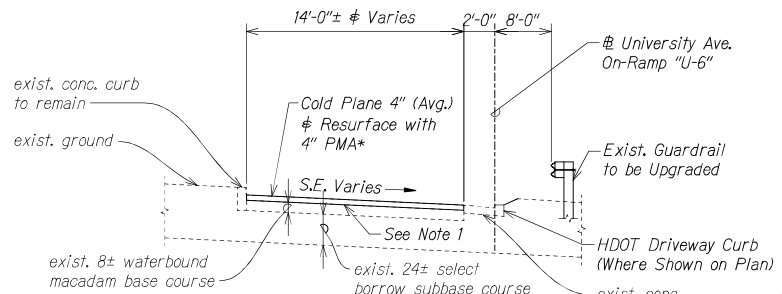

(STA. 10+45± TO STA. 19+11±)  
**WB UNIVERSITY AVE. ON-RAMP "U-6"**  
 PAVEMENT RESURFACING SECTION  
 Scale: 1/4" = 1'-0"

- NOTES:**
1. Apply Tack Coat in between exist. and new A.C. Pavement.
  2. PMA refers to Mix No. IV with PG 64E-22.







THIS WORK WAS PREPARED BY ME OR UNDER MY SUPERVISION

Signature: *Rodney R. McKeown*  
 EXPIRATION DATE OF THE LICENSE: 04/30/26

|   |                        |
|---|------------------------|
| 2/5/25  | Removed Pavement Note. |
| DATE  | REVISION               |
| STATE OF HAWAII<br>DEPARTMENT OF TRANSPORTATION<br>HIGHWAYS DIVISION  |                        |
| <b>RAMP TYPICAL SECTIONS</b>  |                        |
| INTERSTATE ROUTE H-1 RESURFACING<br>Miller Pedestrian Overpass to Kapiolani Interchange<br>Federal-Aid Project No. NH-HI-K279JR |                        |
| Scale: As Shown   | Date: February 2025    |
| SHEET No. C4 OF 19 SHEETS   |                        |

W:\\_CIVIL\_3D\_PROJECTS\0316\_202406\_001-HIHS H1 RESURFACING - MILLER TO KAPIOLANI RAMP TYPICAL SECTIONS.DWG 1/23/2025 8:45 AM

| FED. ROAD DIST. NO. | STATE | FED-AID PROJ. NO. | FISCAL YEAR | SHEET NO. | TOTAL SHEETS |
|---------------------|-------|-------------------|-------------|-----------|--------------|
| HAWAII              | HAW.  | NH-HI-1(279)R     | 2024        | 42        | 411          |

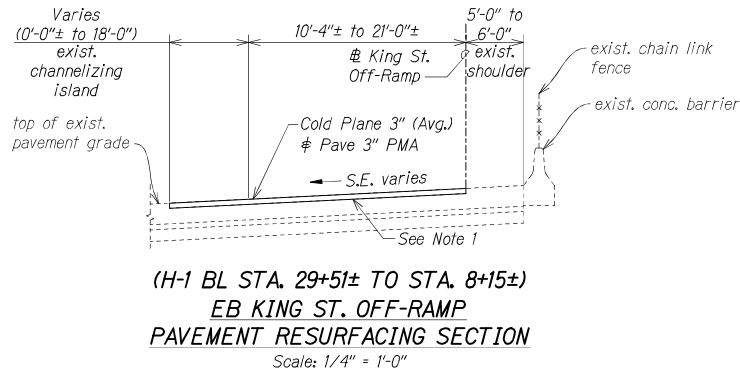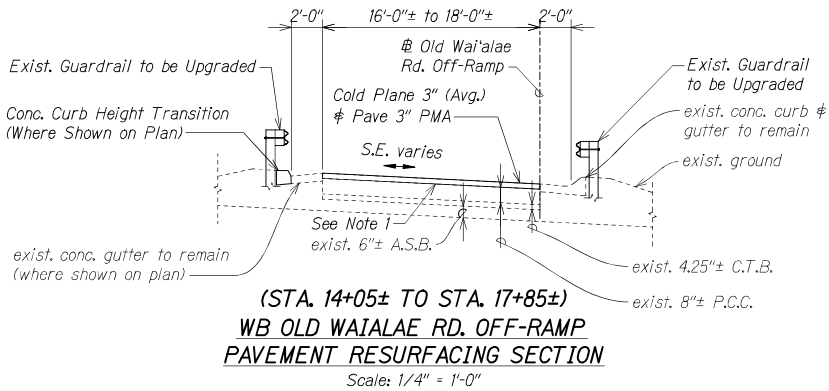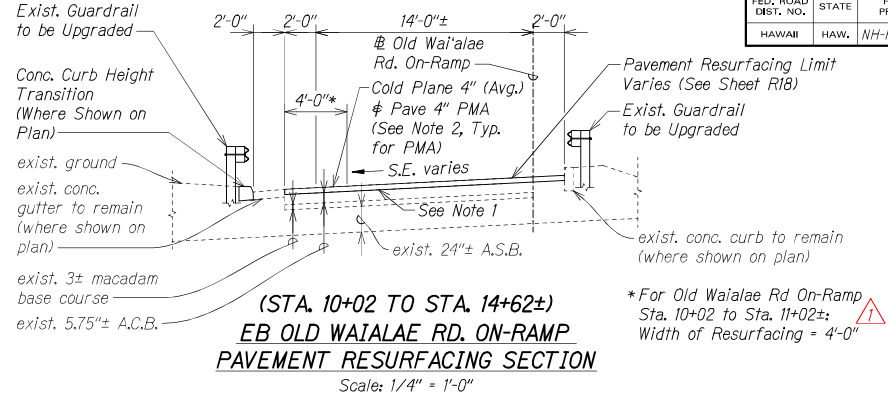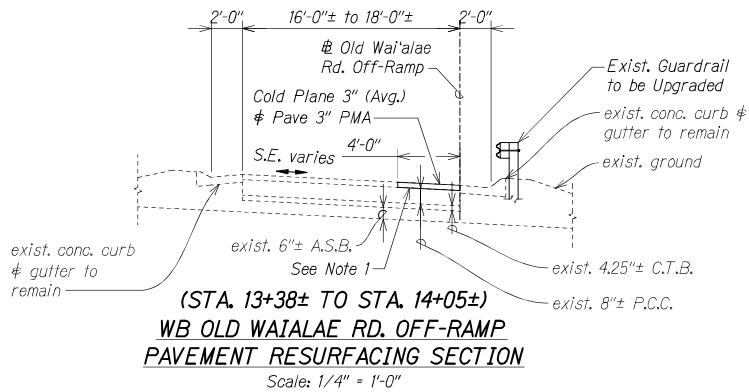

- NOTES:**
1. Apply Tack Coat in between exist. and new A.C. Pavement.
  2. PMA refers to Mix No. IV with PG 64E-22.




THIS WORK WAS PREPARED BY ME OR UNDER MY SUPERVISION

Signature: *Rodney R. McKinney*  
 EXPIRATION DATE OF THE LICENSE: 04/30/26


|  |                      |
|--|----------------------|
| 2/5/25   | Revised End Station. |
| DATE   | REVISION             |
| STATE OF HAWAII<br>DEPARTMENT OF TRANSPORTATION<br>HIGHWAYS DIVISION   |                      |
| <b>RAMP TYPICAL SECTIONS</b>   |                      |
| INTERSTATE ROUTE H-1 RESURFACING<br>Miller Pedestrian Overpass to Kapiolani Interchange<br>Federal-Aid Project No. NH-HI-1(279)R |                      |
| Scale: As Shown  | Date: February 2025  |
| SHEET No. C5 OF 19 SHEETS  |                      |

W:\\_DWL\_3D\_PROJECTS\0316\_202406\_001-HWS-H1 RESURFACING - MILLER TO KAPIOLANI RAMP TYPICAL SECTIONS.DWG 7/24/2024 8:48 AM

| FED. ROAD DIST. NO. | STATE | FED-AID PROJ. NO. | FISCAL YEAR | SHEET NO. | TOTAL SHEETS |
|---------------------|-------|-------------------|-------------|-----------|--------------|
| HAWAII              | HAW.  | NH-HI-1279JR      | 2024        | 43        | 411          |

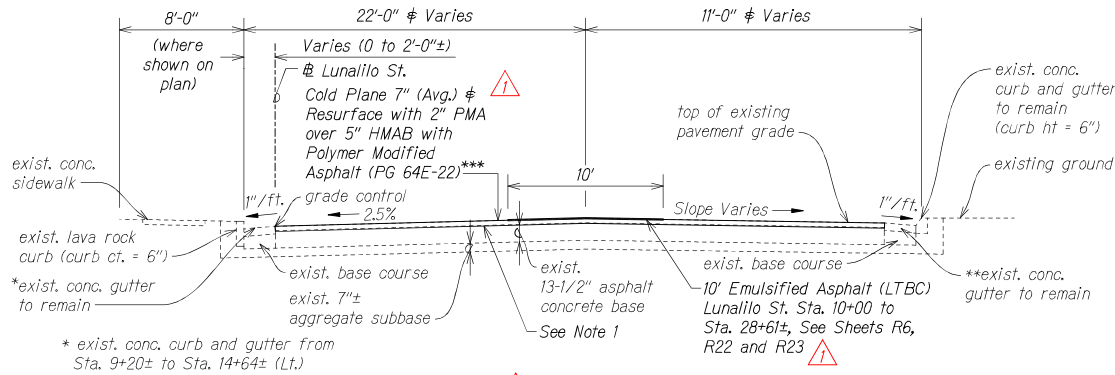


(STA. 9+20 TO STA. 28+61±)  
**LUNALILO STREET**  
 PAVEMENT RESURFACING SECTION  
 Scale: 1/4" = 1'-0"

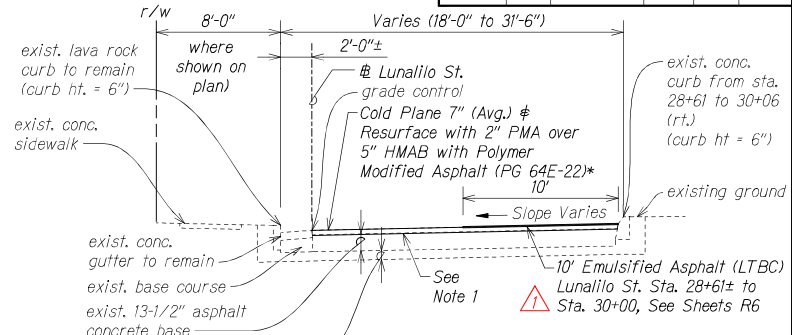


(STA. 28+61± TO STA. 39+41±)  
**LUNALILO STREET**  
 PAVEMENT RESURFACING SECTION  
 Scale: 1/4" = 1'-0"

\* exist. conc. curb and gutter from Sta. 9+20± to Sta. 14+64± (Lt.)  
 \*\* exist. conc. curb from Sta. 10+00 to Sta. 11+00 (Rt.) & 26+63 to Sta. 28+61 (Rt.)  
 \*\*\* For Lunalilo St. Sta. 14+64 to Sta. 28+61±: Cold Plane 4" (Avg.) & Resurface with 4" PMA

\* For Lunalilo St. Sta. 36+32 to Sta. 39+41±: Cold Plane 4" (Avg.) & Resurface with 4" PMA

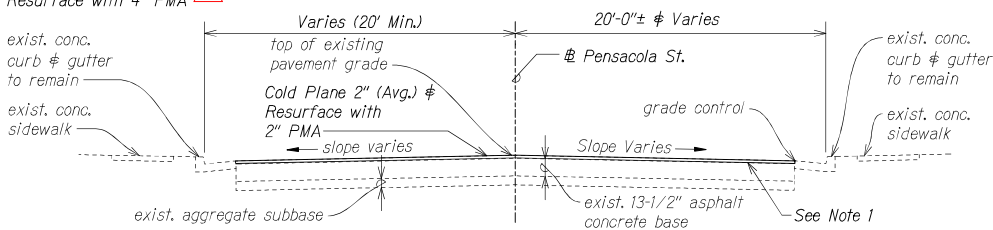

(STA. 10+00 TO STA. 11+04)  
 (STA. 11+49 TO STA. 12+79)  
**PENSACOLA STREET**  
 PAVEMENT RESURFACING SECTION  
 Scale: 1/4" = 1'-0"

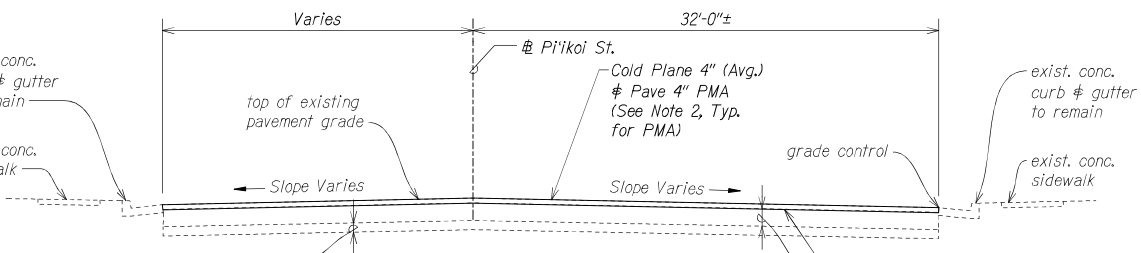

(STA. 10+00 TO STA. 12+56)  
**PI'IKOI STREET**  
 PAVEMENT RESURFACING SECTION  
 Scale: 1/4" = 1'-0"

- NOTES:**
1. Apply Tack Coat in between exist. and new A.C. Pavement
  2. PMA refers to Mix No. IV with PG 64E-22.



THIS WORK WAS PREPARED BY ME OR UNDER MY SUPERVISION

Signature: *Rodney R. McKinney*  
 EXPIRATION DATE OF THE LICENSE: 04/30/26


|   |  |
|---|--|
| 2/5/25  | Added Station Range, Revised End Station and Pavement Section Notes. |
| DATE  | REVISION   |
| STATE OF HAWAII<br>DEPARTMENT OF TRANSPORTATION<br>HIGHWAYS DIVISION  |  |
| <b>LUNALILO ST. TYPICAL SECTIONS</b>  |  |
| INTERSTATE ROUTE H-1 RESURFACING<br>Miller Pedestrian Overpass to Kapiolani Interchange<br>Federal-Aid Project No. NH-HI-1279JR |  |
| Scale: As Shown   | Date: February 2025  |
| SHEET No. 06 OF 19 SHEETS   |  |

W:\\_civil\_3D\_PROJECTS\016\_2024000\_001-HIHS H1 RESURFACING - MILLER TO KAPOLANI CIVIL DRAWINGS\01 LUNALILO ST. TYPICAL SECTIONS.DWG 1/24/2025 7:31 AM



| FED. ROAD DIST. NO. | STATE | FED-AID PROJ. NO. | FISCAL YEAR | SHEET NO. | TOTAL SHEETS |
|---------------------|-------|-------------------|-------------|-----------|--------------|
| HAWAII              | HAW.  | NH-HI-K279/R      | 2024        | 64        | 411          |

**H-1 CURVE DATA**  
 $\Delta=52^{\circ} 41' 32''$   
 $\Delta/2=26^{\circ} 20' 46''$   
 $R=1200.00'$   
 $T=594.28'$   
 $C=1065.10'$   
 $L=1103.58'$

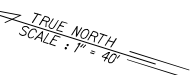


BM: Target-21  
Mag. Nail  
H-1 @ Sta. 170+17.53  
O/S 46.16' Lt.

BEGIN PROJECT  
FAP No. NH-HI-K(279)/R  
H-1 @ Sta. 172+64

BM: Target-44  
Mag. Nail  
H-1 @ Sta. 170+18.93  
O/S 2.99' Rt.


Kina'u St. Off-Ramp Sta. 10+00  
=H-1 @ Sta. 172+64  
Limits of Resurfacing

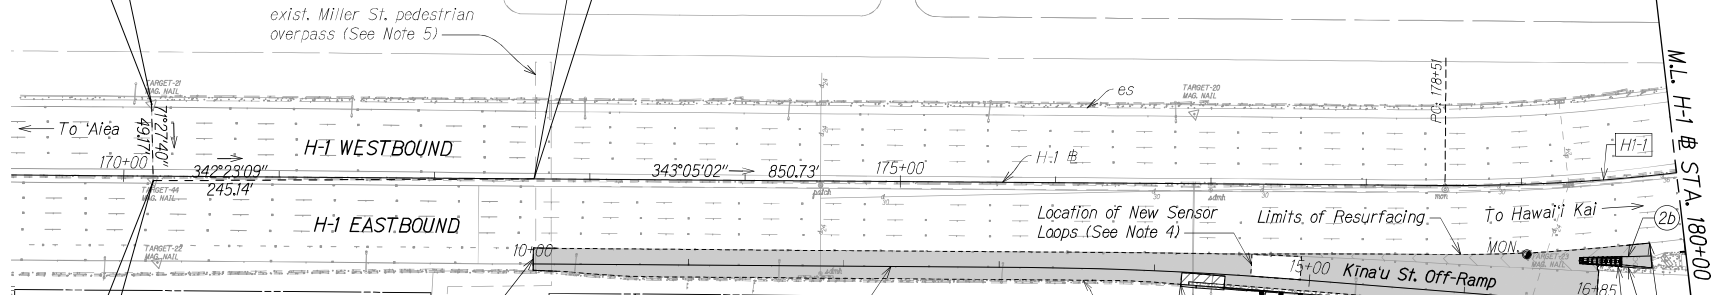

- ① Kinau St. Off-Ramp @ Sta. 14+23±, 8± Rt. to Sta. 14+80±, 9± Rt.
  - 38 LF Conc. Gutter (Connect to exist. Gutter at Both Ends)
  - 10 LF 2" Conc. Curb (with exist. Gutter)
  - 10 LF 2" Conc. Curb to exist. 6" Curb Transition (with exist. Gutter)
  - Connect to exist. Curb (See Sheets C14 and C17)

- ① Kinau St. Off-Ramp @ Sta. 14+17±, 8± Rt. to Sta. 16+23±, 9± Rt. (See Note 2)
  - 10 LF Modified 34" Type KAT Conc. Transition (Condition 1)
  - 34" Type KAT Transition
  - Guardrail Type 3 MASH Transition (Reverse)
  - 125 LF Midwest Guardrail System
  - MGS Transition to Strong Post Guardrail

- ②a H-1 @ Sta. 179+59±, 57± Rt. to Sta. 179+77±, 60± Rt. (See Notes 2 and 6)
  - 19 LF Transition, QUADGUARD (TL-3) to Thrie Beam or Approved Equal
- ②b H-1 @ Sta. 179+60±, 50± Rt. to Sta. 179+78±, 51± Rt. (See Notes 2 and 6)
  - 19 LF Transition, QUADGUARD (TL-3) to Thrie Beam or Approved Equal

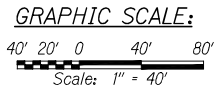

**LEGEND:**

- Resurfacing Limits:  
3" Cold Plane  
3" Mix No. IV with PG 64E-22  
(Place Tensar Rapid Repair PG100 Under AC Mix No. IV)
- Pavt. Recon. Limits (Ramp):  
3" Mix No. IV with PG 64E-22 CLSM (Thickness varies to meet Exist. Pavt. Grade, 2" Min.)
- MON. Monument to be Reinstalled (See Notes 50 and 64 on Sheet G5)

**NOTES:**

1. The Contractor shall inspect and clean all drain culverts within the project limits and shall be paid under Item No. 603.0200 Clean Existing Culverts, as directed by the Engineer.
2. For Schedule of Existing Guardrail Upgrade, See Sheets R27 to R32. For Details, See Sheets R33 to R61.
3. The Contractor shall survey and stake out the roadway work in accordance with Section 105.10 Construction Stakes, Lines and Grades from the HDOT Standard Specifications.
4. For Traffic Counting Station Plan and Pavement Section at Sensor Loops on Kinau Street Off-Ramp, See Sheet TCI.
5. For work on Miller Street Pedestrian Overpass, See Structural Sheet SM-1.
6. The impact attenuator transition assembly shall include all metal beam panels, posts, blockouts, bolts and other necessary parts.



THIS WORK WAS PREPARED BY ME OR UNDER MY SUPERVISION


SIGNATURE: *Rodney McKinney* EXPIRATION DATE: 04/30/26  
 OF THE LICENSE

|   |                             |
|---|-----------------------------|
| 2/5/25  | ① Revised to include PG100. |
| DATE  | REVISION                    |
| STATE OF HAWAII<br>DEPARTMENT OF TRANSPORTATION<br>HIGHWAYS DIVISION  |                             |
| <b>ROADWAY PLAN</b>   |                             |
| INTERSTATE ROUTE H-1 RESURFACING<br>Miller Pedestrian Overpass to Kapiolani Interchange<br>Federal-Aid Project No. NH-HI-K(279)/R |                             |
| Scale: 1" = 40'   | Date: February 2025         |
| SHEET No. <i>RI</i> OF 68 SHEETS  |                             |

**ADD.64**

W:\\_civil\_3D\_PROJECTS\016\_2024\001\_001-HIHS H1 RESURFACING - MILLER TO KAPOLANI CIVIL DRAWINGS\RI-64 - ROADWAY PLAN.DWG 1/22/2025 3:45 PM

| FED. ROAD DIST. NO. | STATE | FED-AID PROJ. NO. | FISCAL YEAR | SHEET NO. | TOTAL SHEETS |
|---------------------|-------|-------------------|-------------|-----------|--------------|
| HAWAII              | HAW.  | NH-HI-K279/R      | 2024        | 65        | 411          |

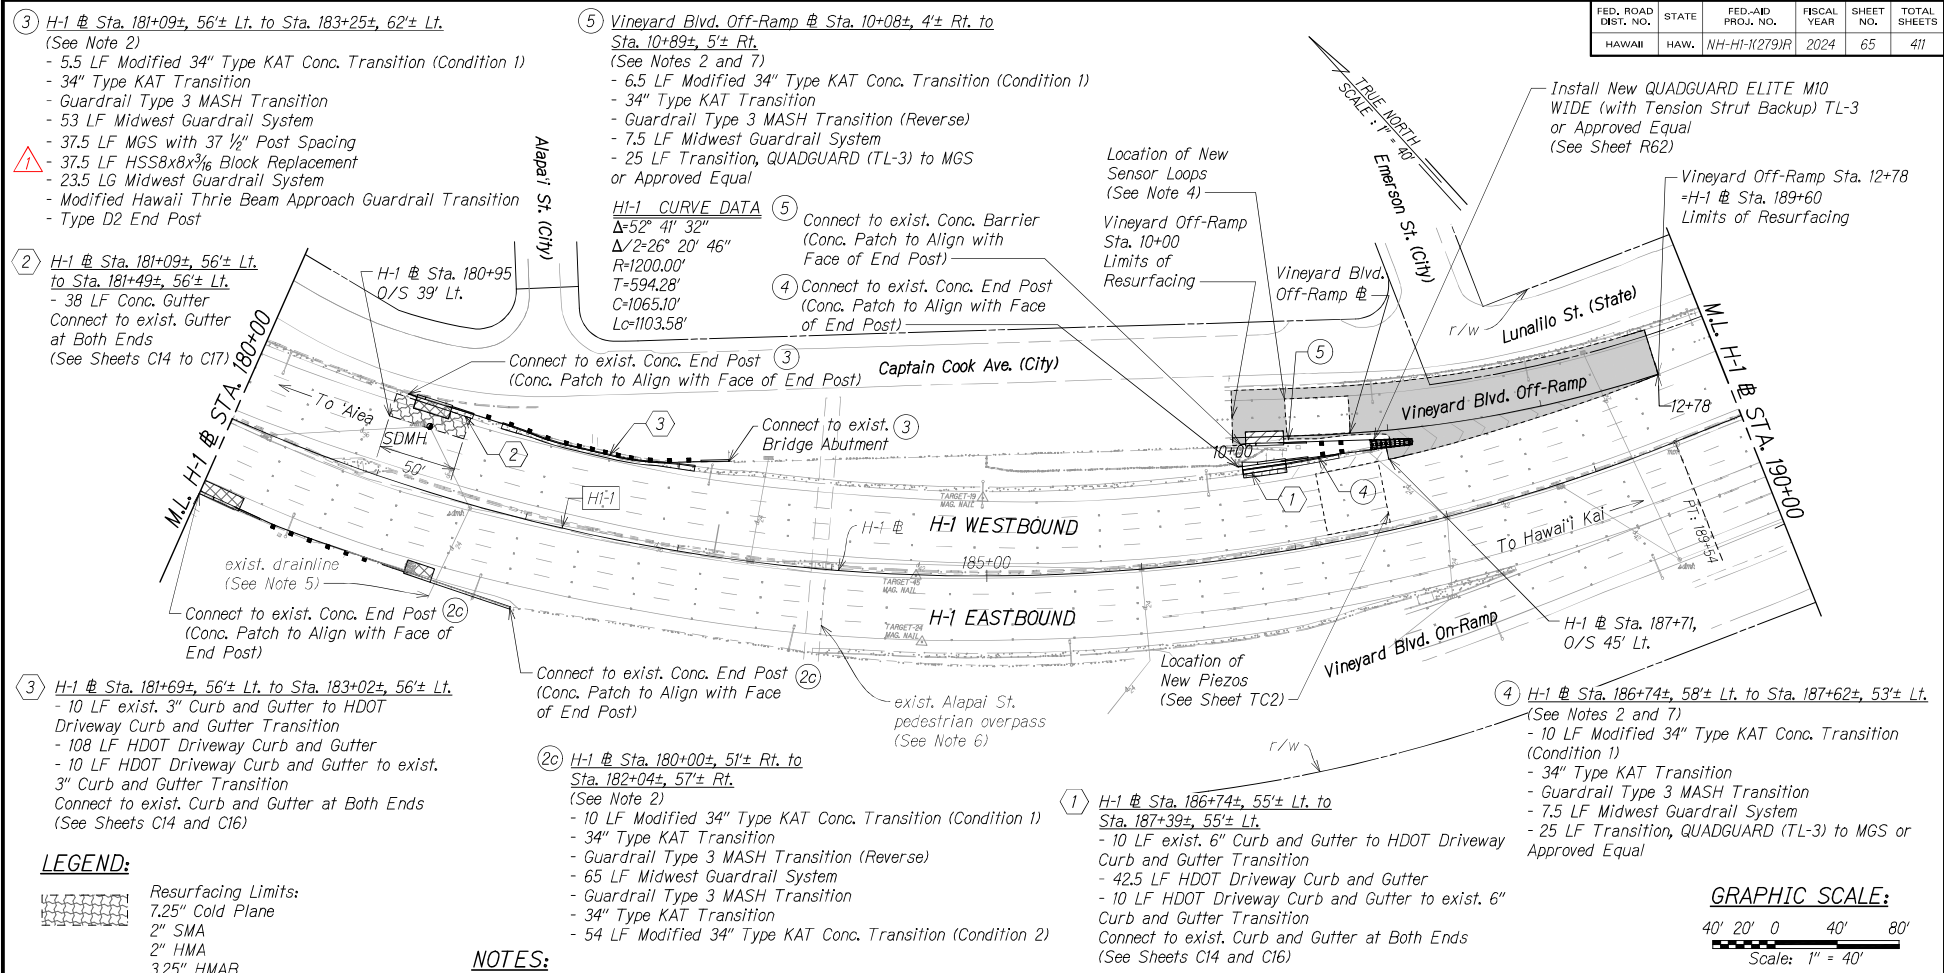

- ③ H-1 @ Sta. 181+09±, 56± Lt. to Sta. 183+25±, 62± Lt.  
(See Note 2)
- 5.5 LF Modified 34" Type KAT Conc. Transition (Condition 1)
  - 34" Type KAT Transition
  - Guardrail Type 3 MASH Transition
  - 53 LF Midwest Guardrail System
  - 37.5 LF MGS with 37 1/2" Post Spacing
  - 23.5 LG Midwest Guardrail System
  - Modified Hawaii Thrie Beam Approach Guardrail Transition
  - Type D2 End Post

- ⑤ Vineyard Blvd. Off-Ramp @ Sta. 10+08±, 4± Rt. to Sta. 10+89±, 5± Rt.  
(See Notes 2 and 7)
- 6.5 LF Modified 34" Type KAT Conc. Transition (Condition 1)
  - 34" Type KAT Transition
  - Guardrail Type 3 MASH Transition (Reverse)
  - 7.5 LF Midwest Guardrail System
  - 25 LF Transition, QUADGUARD (TL-3) to MGS or Approved Equal

**HI-1 CURVE DATA**

⑤ Connect to exist. Conc. Barrier (Conc. Patch to Align with Face of End Post)

④ Connect to exist. Conc. End Post (Conc. Patch to Align with Face of End Post)

③ Connect to exist. Conc. End Post (Conc. Patch to Align with Face of End Post)

③ Connect to exist. Bridge Abutment

- ② H-1 @ Sta. 181+09±, 56± Lt. to Sta. 181+49±, 56± Lt.  
(See Sheets C14 to C17)
- 38 LF Conc. Gutter
  - Connect to exist. Gutter at Both Ends

- ③ H-1 @ Sta. 181+69±, 56± Lt. to Sta. 183+02±, 56± Lt.  
(See Sheets C14 and C16)
- 10 LF exist. 3" Curb and Gutter to HDOT Driveway Curb and Gutter Transition
  - 108 LF HDOT Driveway Curb and Gutter
  - 10 LF HDOT Driveway Curb and Gutter to exist. 3" Curb and Gutter Transition
  - Connect to exist. Curb and Gutter at Both Ends

- ②c H-1 @ Sta. 180+00±, 51± Rt. to Sta. 182+04±, 57± Rt.  
(See Note 2)
- 10 LF Modified 34" Type KAT Conc. Transition (Condition 1)
  - 34" Type KAT Transition
  - Guardrail Type 3 MASH Transition (Reverse)
  - 65 LF Midwest Guardrail System
  - Guardrail Type 3 MASH Transition
  - 34" Type KAT Transition
  - 54 LF Modified 34" Type KAT Conc. Transition (Condition 2)

- ① H-1 @ Sta. 186+74±, 55± Lt. to Sta. 187+39±, 55± Lt.  
(See Sheets C14 and C16)
- 10 LF exist. 6" Curb and Gutter to HDOT Driveway Curb and Gutter Transition
  - 42.5 LF HDOT Driveway Curb and Gutter
  - 10 LF HDOT Driveway Curb and Gutter to exist. 6" Curb and Gutter Transition
  - Connect to exist. Curb and Gutter at Both Ends

- ④ H-1 @ Sta. 186+74±, 58± Lt. to Sta. 187+62±, 53± Lt.  
(See Notes 2 and 7)
- 10 LF Modified 34" Type KAT Conc. Transition (Condition 1)
  - 34" Type KAT Transition
  - Guardrail Type 3 MASH Transition
  - 7.5 LF Midwest Guardrail System
  - 25 LF Transition, QUADGUARD (TL-3) to MGS or Approved Equal

**LEGEND:**

Resurfacing Limits:  
7.25" Cold Plane  
2" SMA  
2" HMA  
3.25" HMAB

Resurfacing Limits:  
3" Cold Plane  
3" Mix No. IV with PG 64E-22

Pavt. Recon. Limits (H-1):  
2" SMA  
2" HMA  
CLSM (Thickness varies to meet Exist. Pavt. Grade, 20" Min.)

Pavt. Recon. Limits (Ramp):  
3" Mix No. IV with PG 64E-22  
CLSM (Thickness varies to meet Exist. Pavt. Grade, 21" Min.)

**NOTES:**

- The Contractor shall inspect and clean all drain culverts within the project limits and shall be paid under Item No. 603.0200 Clean Existing Culverts, as directed by the Engineer.
- For Full Guardrail System Upgrade Description, See Sheets R27 to R32. For Details, See Sheets R33 to R61.
- The Contractor shall survey and stake out the roadway work in accordance with Section 105.10 Construction Stakes, Lines and Grades from the HDOT Standard Specifications.
- For Typical Pavement Section at Sensor Loops on Side Street/Ramps, See Sheet TC3. For Traffic Counting Station Plan, see Sheet TC2.
- Verify location and depth of existing drainlines and other existing utilities crossing the guardrails prior to excavation. Contractor to clear guardrail posts from existing utilities.
- For work on Alapai Street Pedestrian Overpass, See Structural Sheet SA-2.
- The impact attenuator transition assembly shall include all metal beam panels, posts, blockouts, bolts and other necessary parts.

**GRAPHIC SCALE:**  
40' 20' 0' 40' 80'  
Scale: 1" = 40'

|  |                              |
|--|------------------------------|
| 2/5/25   | △ Revised guardrail lengths. |
| DATE   | REVISION                     |
| STATE OF HAWAII<br>DEPARTMENT OF TRANSPORTATION<br>HIGHWAYS DIVISION |                              |
| <b>ROADWAY PLAN</b>  |                              |
| <b>INTERSTATE ROUTE H-1 RESURFACING</b>                              |                              |
| <b>Miller Pedestrian Overpass to Kapiolani Interchange</b>           |                              |
| <b>Federal-Aid Project No. NH-HI-K279/R</b>                          |                              |
| Scale: 1" = 40'  | Date: February 2025          |
| SHEET No. R2 OF 68 SHEETS  |                              |



THIS WORK WAS PREPARED BY ME OR UNDER MY SUPERVISION

Robert R. McKinney  
SIGNATURE  
04/30/26  
EXPIRATION DATE OF THE LICENSE



W:\\_LVL\_3D\_PROJECTS\016\_2024000\_001-HIHS H-1 RESURFACING - MILLER TO KAPIOLANI CIVIL DRAWINGS\01-R4 - ROADWAY PLAN\016\_1/23/2025 10:18 AM

W:\\_ENV\_3D\_PROJECTS\0316\_202405\_001-HWS H1 RESURFACING - MILLER TO KAPOLANI CIVIL DRAWINGS\03-R13 ROADWAY PLAN.DWG 8/27/2024 9:58 AM

| FED. ROAD DIST. NO. | STATE | FED-AID PROJ. NO. | FISCAL YEAR | SHEET NO. | TOTAL SHEETS |
|---------------------|-------|-------------------|-------------|-----------|--------------|
| HAWAII              | HAW.  | NH-HI-K279JR      | 2024        | 76        | 411          |

**NOTES:**

- The Contractor shall inspect and clean all drain culverts within the project limits and shall be paid under Item No. 603.0200 Clean Existing Culverts, as directed by the Engineer.
- For Full Guardrail System Upgrade Description, See Sheets R27 to R32. For Details, See Sheets R33 to R61.
- For Pavement Elevations, See Sheet GR1 to GR21.
- The Contractor shall survey and stake out the roadway work in accordance with Section 105.10 Construction Stakes, Lines and Grades from the HDOT Standard Specifications.
- For Typical Pavement Section at Sensor Loops on Side Street and Ramps, see Sheet TC3. For Traffic Counting Station Plan, see Sheet TCI.
- Verify location and depth of existing drainlines and other existing utilities crossing the guardrails prior to excavation. Contractor to clear guardrail posts from existing utilities.
- The impact attenuator transition assembly shall include all metal beam panels, posts, blockouts, bolts and other necessary parts.

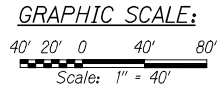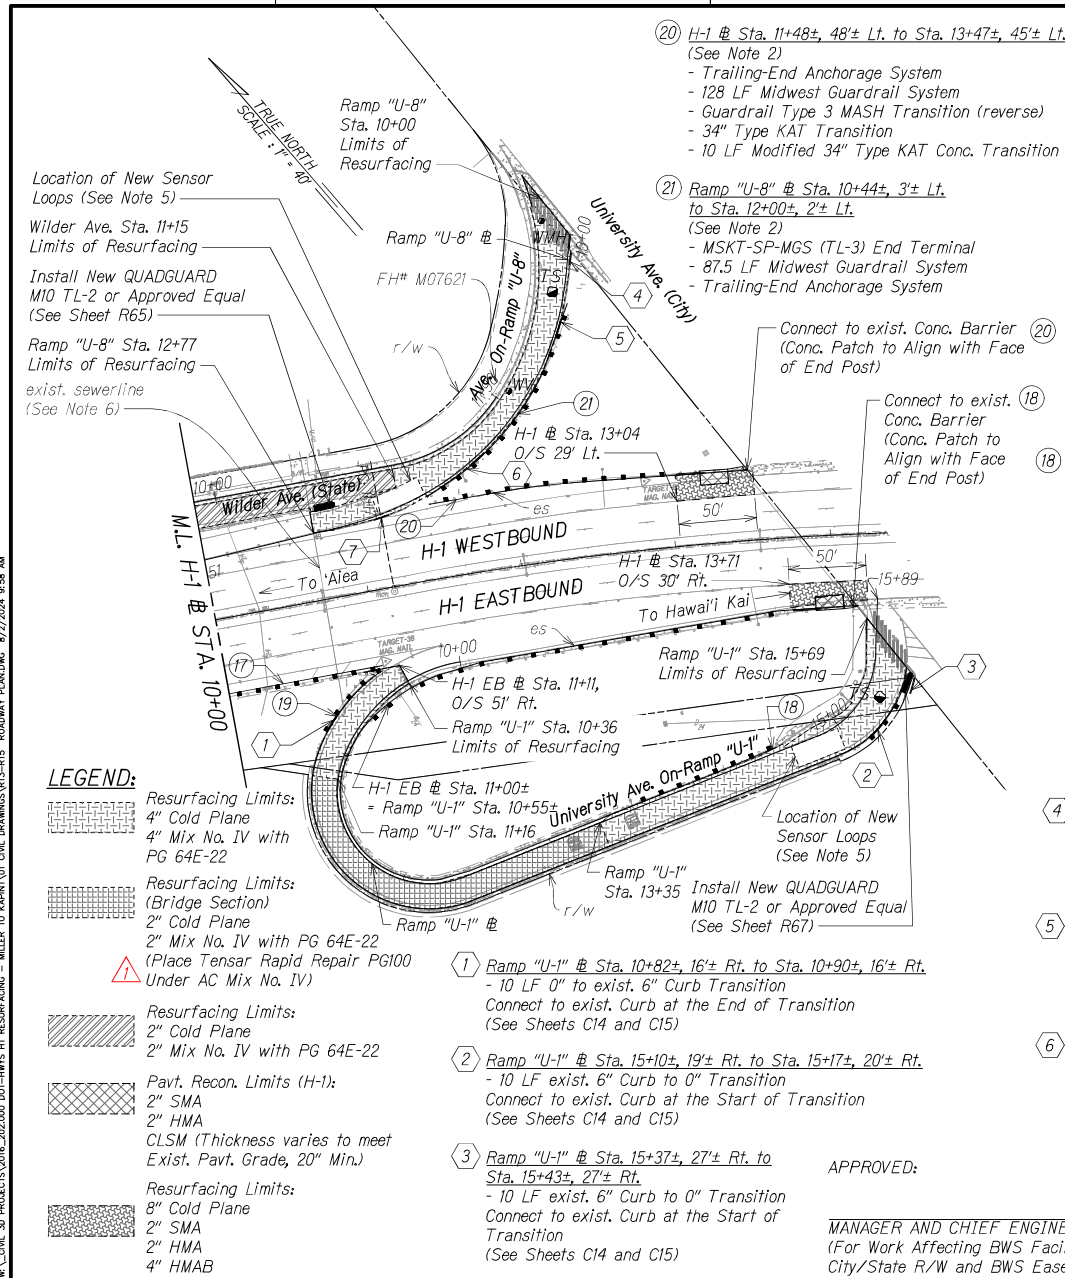

APPROVED:

MANAGER AND CHIEF ENGINEER, BWS DATE  
 (For Work Affecting BWS Facilities in City/State R/W and BWS Easements Only)

THIS WORK WAS PREPARED BY ME OR UNDER MY SUPERVISION



Signature: *Rodney R. McKinney* 04/30/26  
 SIGNATURE EXPIRATION DATE OF THE LICENSE

|   |                           |
|---|---------------------------|
| 2/5/25  | Revised to include PG100. |
| DATE  | REVISION                  |
| STATE OF HAWAII<br>DEPARTMENT OF TRANSPORTATION<br>HIGHWAYS DIVISION  |                           |
| <b>ROADWAY PLAN</b>   |                           |
| INTERSTATE ROUTE H-1 RESURFACING<br>Miller Pedestrian Overpass to Kapiolani Interchange<br>Federal-Aid Project No. NH-HI-K279JR |                           |
| Scale: 1" = 40'   | Date: February 2025       |
| SHEET No. R13 OF 68 SHEETS  |                           |

|                     |       |                   |             |           |              |
|---------------------|-------|-------------------|-------------|-----------|--------------|
| FED. ROAD DIST. NO. | STATE | FED-AID PROJ. NO. | FISCAL YEAR | SHEET NO. | TOTAL SHEETS |
| HAWAII              | HAW.  | NH-HI-1(279)R     | 2024        | 90        | 411          |

**INDEX OF GUARDRAIL DETAILS**

| DRAWING NO. | DESCRIPTION  |
|-------------|--|
| R33         | Guardrail Details and Notes  |
| R34         | 31" W-Beam Guardrail With Standard Offset Block (Midwest Guardrail System)           |
| R35         | MGS with Curb and Omitted Post   |
| R36         | MGS on a 2:1 Fill Slope  |
| R37 to R38  | MGS Long Span LSC-2  |
| R39         | Stiffened MGS Half Post Spacing (MGS with 37 1/2" Post Spacing)                      |
| R40         | Guardrail Terminal Connectors and End Sections                                       |
| R41         | MGS Transition to Strong Post Guardrail  |
| R42         | Modified 34" Type KAT Concrete Transition and Concrete Patch Detail                  |
| R43         | Trailing-End Anchorage System  |
| R44         | MSKT-SP-MGS Terminal (8" Blocks) Test Level 3 (MSKT-SP-MGS (TL-3) End Terminal)      |
| R45         | MAX-Tension TL-2 Guardrail End Terminal  |
| R46         | Standard Bridge Railings and Transitions General Notes and Symbols and Abbreviations |
| R47 to R48  | Standard Bridge Railings and Transitions Metal Guardrail Type 3 Thrie Beam           |
| R49 to R50  | Solid Bridge Railing with Recessed Rectangular Aesthetic Panels                      |
| R51         | 34" Type KAT Transition and Guardrail Type 3 MASH Transition                         |
| R52         | Typical 34" Type KAT Transition Sections and Detail                                  |
| R53         | Thrie Beam Connection to Existing Railing  |
| R54         | Strong Post Modified Thrie-Beam Guardrail (MASH)                                     |
| R55         | Retro Rail System  |
| R56 to R58  | HDOT 34 Inches Tall Aesthetic Concrete Bridge Rail                                   |
| R59 to R60  | Modified Hawaii Thrie Beam Approach Guardrail Transition                             |
| R61         | Type D-2 End Post  |

**SCHEDULE - EXISTING GUARDRAIL UPGRADE**

| DRAWING NO. | DESCRIPTION                | FROM      | TO            | DISTANCE (Feet) | GUARDRAIL UPGRADE (Feet)   |
|-------------|----------------------------|-----------|---------------|-----------------|--|
| R1          | 1 Kinau St. Off-Ramp (Rt.) | --        | --            | --              | - Conc. Patch  |
|             |                            | ± 14+17±  | ± 14+27±      | 10              | - Modified 34" Type KAT Conc. Transition (Condition 1)               |
|             |                            | ± 14+27±  | ± 14+46±      | --              | - 34" Type KAT Transition  |
|             |                            | ± 14+45±  | ± 14+70±      | --              | - Guardrail Type 3 MASH Transition (reverse)                         |
|             |                            | ± 14+70±  | ± 15+95±      | 125             | - Midwest Guardrail System   |
| R1 to R2    | 2a                         | ± 179+59± | ± 179+77±     | --              | - 19 LF Transition, QUADGUARD (TL-3) to Thrie-Beam or Approved Equal |
|             |                            | ± 179+60± | ± 179+78±     | --              | - 19 LF Transition, QUADGUARD (TL-3) to Thrie-Beam or Approved Equal |
|             | 2c                         | --        | --            | --              | - Conc. Patch  |
|             |                            | ± 180+00± | ± 180+09±     | 10              | - Modified 34" Type KAT Conc. Transition (Condition 1)               |
|             |                            | ± 180+09± | ± 180+27±     | --              | - 34" Type KAT Transition  |
|             |                            | ± 180+26± | ± 180+50±     | --              | - Guardrail Type 3 MASH Transition (reverse)                         |
|             |                            | ± 180+50± | ± 181+12±     | 65              | - Midwest Guardrail System   |
|             |                            | ± 181+12± | ± 181+36±     | --              | - Guardrail Type 3 MASH Transition                                   |
|             |                            | ± 181+35± | ± 181+52±     | --              | - 34" Type KAT Transition  |
|             |                            | ± 181+52± | ± 182+04±     | 54              | - Modified 34" Type KAT Conc. Transition (Condition 2)               |
| --          | --                         | --        | - Conc. Patch |                 |  |

**SCHEDULE - EXISTING GUARDRAIL UPGRADE**

| DRAWING NO. | DESCRIPTION                    | FROM      | TO        | DISTANCE (Feet) | GUARDRAIL UPGRADE (Feet)                                      |
|-------------|--------------------------------|-----------|-----------|-----------------|---|
| R2          | 3 H-1 WB Shoulder              | --        | --        | --              | - Conc. Patch   |
|             |                                | ± 181+09± | ± 181+14± | 5.5             | - Modified 34" Type KAT Conc. Transition (Condition 1)        |
|             |                                | ± 181+14± | ± 181+33± | --              | - 34" Type KAT Transition                                     |
|             |                                | ± 181+33± | ± 181+59± | --              | - Guardrail Type 3 MASH Transition                            |
|             |                                | ± 181+59± | ± 182+14± | 53              | - Midwest Guardrail System                                    |
|             |                                | ± 182+14± | ± 182+53± | 37.5            | - MGS with 37 1/2" Post Spacing                               |
|             |                                | ± 182+14± | ± 182+53± | 37.5            | - HSS8x8x3/16 Block Replacement                               |
|             |                                | ± 182+53± | ± 182+78± | 23.5            | - Midwest Guardrail System                                    |
|             |                                | ± 182+78± | ± 183+06± | --              | - Modified Hawaii Thrie Beam Approach Guardrail Transition    |
|             |                                | ± 183+06± | ± 183+25± | --              | - Type D2 End Post  |
| R2          | 4 H-1 WB Shoulder              | --        | --        | --              | - Conc. Patch   |
|             |                                | ± 186+74± | ± 186+84± | 10              | - Modified 34" Type KAT Conc. Transition (Condition 1)        |
|             |                                | ± 186+84± | ± 187+03± | --              | - 34" Type KAT Transition                                     |
|             |                                | ± 187+02± | ± 187+29± | --              | - Guardrail Type 3 MASH Transition                            |
|             |                                | ± 187+29± | ± 187+36± | 7.5             | - Midwest Guardrail System                                    |
| R2          | 5 Vineyard Blvd Off-Ramp (Rt.) | ± 187+36± | ± 187+62± | --              | - 25 LF Transition, QUADGUARD (TL-3) to MGS or Approved Equal |
|             |                                | --        | --        | --              | - Conc. Patch   |
|             |                                | ± 10+08±  | ± 10+15±  | 6.5             | - Modified 34" Type KAT Conc. Transition (Condition 1)        |
|             |                                | ± 10+15±  | ± 10+33±  | --              | - 34" Type KAT Transition                                     |
|             |                                | ± 10+32±  | ± 10+57±  | --              | - Guardrail Type 3 MASH Transition (reverse)                  |
|             |                                | ± 10+57±  | ± 10+64±  | 7.5             | - Midwest Guardrail System                                    |
|             |                                | ± 10+64±  | ± 10+89±  | --              | - 25 LF Transition, QUADGUARD (TL-3) to MGS or Approved Equal |
| R2 to R3    | 6 H-1 EB Shoulder              | ± 189+93± | ± 190+40± | --              | - MSKT-SP-MGS (TL-3) End Terminal                             |
|             |                                | ± 190+40± | ± 190+69± | --              | - Modified Hawaii Thrie Beam Approach Guardrail Transition    |
|             |                                | ± 190+65± | ± 190+83± | --              | - Type D2 End Post  |
|             |                                | ± 190+83± | ± 190+88± | 5               | - Modified 34" Type KAT Conc. Transition (Condition 2)        |
|             |                                | --        | --        | --              | - Conc. Patch   |
| R3          | 7 Ward Ave. On-Ramp (Lt.)      | --        | --        | --              | - Conc. Patch   |
|             |                                | ± 13+31±  | ± 13+49±  | --              | - 34" Type KAT Transition                                     |
|             |                                | ± 13+49±  | ± 13+74±  | --              | - Guardrail Type 3 MASH Transition                            |
|             |                                | ± 13+74±  | ± 13+86±  | 12.5            | - Midwest Guardrail System                                    |
|             |                                | --        | --        | --              | - W-Beam End Section (Rounded RWE03a)                         |



THIS WORK WAS PREPARED BY ME OR UNDER MY SUPERVISION

*Robert R. McKinney*  
SIGNATURE      04/30/26  
EXPIRATION DATE OF THE LICENSE

2/5/25      Revised Quantity.  
DATE      REVISION

STATE OF HAWAII  
DEPARTMENT OF TRANSPORTATION  
HIGHWAYS DIVISION

**GUARDRAIL SCHEDULE**

**INTERSTATE ROUTE H-1 RESURFACING**  
Miller Pedestrian Overpass to Kapiolani Interchange  
Federal-Aid Project No. NH-HI-1(279)R

Scale: N/A      Date: February 2025

SHEET No. **R27** OF **68** SHEETS

**ADD.90**

W:\\_CIVIL\_3D\_PROJECTS\2016-2025\000-001-HWS H1 RESURFACING - MILLER TO KAPIOLANI CIVIL DRAWINGS\R27\_R32 GUARDRAIL SCHEDULE.DWG 1/28/2025 5:25 AM

| FED. ROAD DIST. NO. | STATE | FED-AID PROJ. NO. | FISCAL YEAR | SHEET NO. | TOTAL SHEETS |
|---------------------|-------|-------------------|-------------|-----------|--------------|
| HAWAII              | HAW.  | NH-HI-1(279)R     | 2024        | 95        | 411          |

**SUMMARY - EXISTING GUARDRAIL UPGRADE**

| DESCRIPTION   | QTY                    |
|---|------------------------|
| Midwest Guardrail System  | 7180.5 LF <sup>△</sup> |
| MSKT-SP-MGS (TL-3) End Terminal   | 10 EA                  |
| Trailing-End Anchorage System   | 13 EA                  |
| MGS Transition to Strong Post Guardrail   | 10 EA                  |
| MGS on a 2:1 Fill Slope   | 432 LF                 |
| MGS Long Span LSC-2   | 3 EA                   |
| MAX-Tension TL-2  | 1 EA                   |
| Guardrail Type 3 MASH Transition  | 17 EA                  |
| Guardrail Type 3 MASH Transition (reverse)  | 15 EA                  |
| 34" Type KAT Transition   | 32 EA                  |
| Modified 34" Type KAT Conc. Transition (Condition 1)                              | 171.5 LF               |
| Modified 34" Type KAT Conc. Transition (Condition 2)                              | 193.75 LF              |
| Conc. Patch   | 26 EA                  |
| Retro-Rail System   | 116 LF                 |
| HDOT 34" Tall Aesthetic Conc. Bridge Rail   | 903 LF                 |
| W-Beam End Section (Rounded RWE03a)   | 5 EA                   |
| Modified Hawaii Thrie Beam Approach Guardrail Transition                          | 4 EA                   |
| Type D2 End Post  | 4 EA                   |
| W-Beam (use exist. guardrail posts)   | 141 LF                 |
| W-Beam (One Post Omitted)   | 225 LF                 |
| Nested W-Beam Guardrail   | 262.5 LF               |
| RubRail   | 25 LF                  |
| MGS with 37 1/2" Post Spacing   | 37.5 LF <sup>△</sup>   |
| HSS8x8x3/16 Block Replacement   | 37.5 LF <sup>△</sup>   |
| Thrie Beam (use exist. guardrail posts)   | 644 LF                 |
| Thrie Beam Connection to exist. Railing   | 2 EA                   |
| Thrie Beam Connection to exist. Railing (reverse)                                 | 1 EA                   |
| Thrie Beam Connection to exist. Railing (use exist. guardrail posts)              | 1 EA                   |
| Thrie Beam Connection to exist. Railing (reverse) (use exist. guardrail posts)    | 2 EA                   |
| 6.25 LF Transition Section Thrie Beam to Strong Post (use exist. guardrail posts) | 1 EA                   |
| 12.5 LF Thrie Beam Guardrail (use exist. guardrail posts)                         | 1 EA                   |
| 12.5 LF Nested Thrie Beam Guardrail (use exist. guardrail posts)                  | 1 EA                   |
| Thrie Beam Connector  | 1 EA                   |
| Thrie-Beam End Section (Rounded RTE03b)   | 1 EA                   |
| Crash Attenuators   |                        |
| Quadguard Elite M10 Wide (with Tension Strut Backup) TL-3                         | 7 EA                   |
| 19 LF Transition, QUADGUARD (TL-3) to Thrie-Beam or Approved Equal                | 2 EA                   |
| 25 LF Transition, QUADGUARD (TL-3) to MGS or Approved Equal                       | 8 EA                   |
| Quadguard M10 TL-2  | 3 EA                   |
| 8 LF Transition, QUADGUARD (TL-2) to MGS or Approved Equal                        | 3 EA                   |


**NOTE:**

Refer to Sheet R27 for Index of Guardrail Details.

|        |                                |
|--------|--------------------------------|
| 2/5/25 | <sup>△</sup> Revised Quantity. |
| DATE   | REVISION                       |




THIS WORK WAS PREPARED BY ME OR UNDER MY SUPERVISION

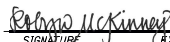  
 SIGNATURE      04/30/26  
 EXPIRATION DATE OF THE LICENSE

STATE OF HAWAII  
 DEPARTMENT OF TRANSPORTATION  
 HIGHWAYS DIVISION  
**GUARDRAIL SCHEDULE**  
 INTERSTATE ROUTE H-1 RESURFACING  
 Miller Pedestrian Overpass to Kapiolani Interchange  
 Federal-Aid Project No. NH-HI-1(279)R  
 Scale: N/A      Date: February 2025  
 SHEET No. **R32** OF 68 SHEETS


W:\\_DWL\_3D\_PROJECTS\0316\_202406\_001-HWS-H1-RESURFACING - MILLER TO KAPOLANI CIVIL DRAWINGS\027\_R32\_GUARDRAIL\_SCHEDULE.DWG 1/24/2025 10:37 AM

|                     |       |                   |             |           |              |
|---------------------|-------|-------------------|-------------|-----------|--------------|
| FED. ROAD DIST. NO. | STATE | FED-AID PROJ. NO. | FISCAL YEAR | SHEET NO. | TOTAL SHEETS |
| HAWAII              | HAW.  | NH-HI-1(279)R     | 2024        | 102       | 411          |

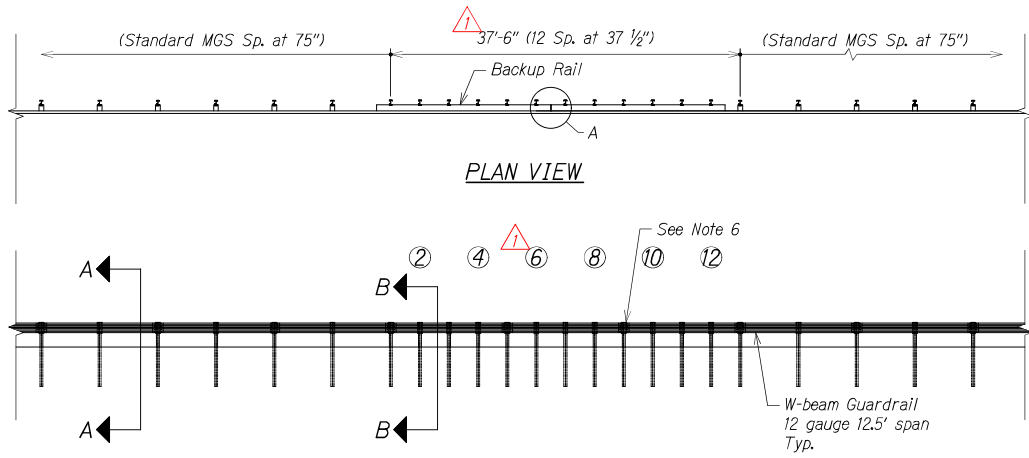

PLAN VIEW

FRONT VIEW

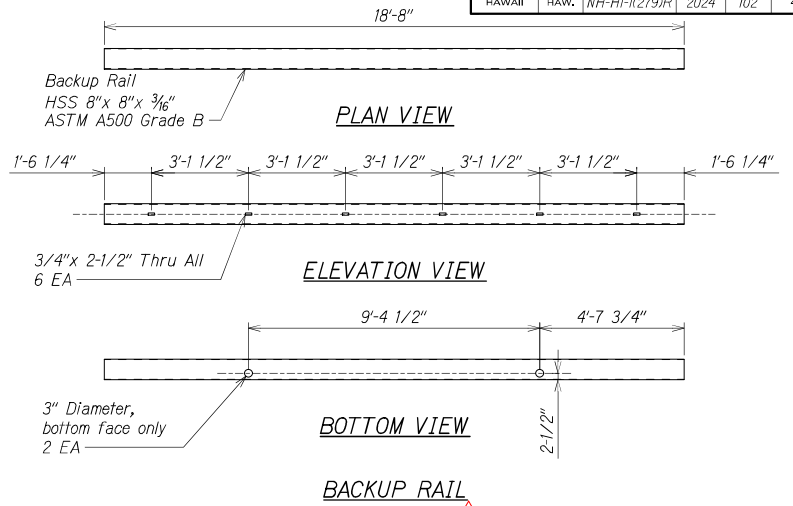

PLAN VIEW


ELEVATION VIEW

BOTTOM VIEW

BACKUP RAIL


NOTES:

1. Drill  $\varnothing 24"$  post holes and backfill with Type D grade 1 crushed concrete road base, compacted according to Geotechnical Report.
2. Recessed Guardrail Nut on all  $\frac{5}{8}"$  Bolts (Button-head Guardrail Bolts and hex head).
3. All steel parts shall be galvanized.
4. Backup Rail Sleeve has no holes, welds, etc, and is not detailed on following sheets.
5.  $\varnothing 3"$  holes in the bottom of the Backup Rails are for access to  $\frac{3}{8}" \times 2"$  (or similar length) bolts used to temporarily secure Backup Rails to Posts for easier W-beam installation. These bolts will be removed and replaced with 10" Guardrail Bolts after placing W-beam rail sections.
6. No guardrail bolts at Posts 6 and 10.

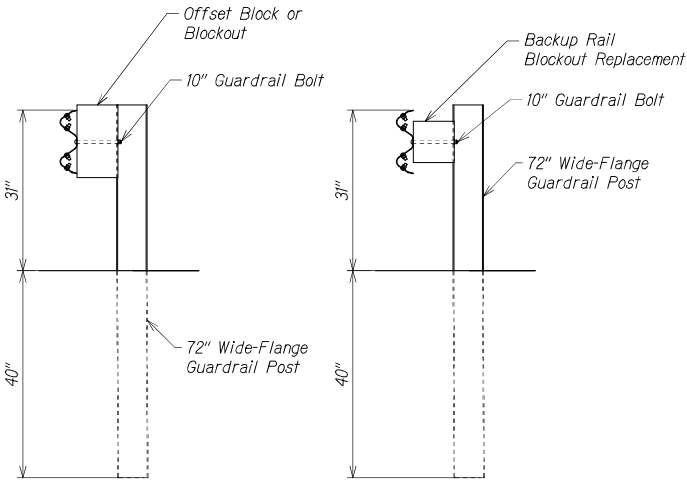

SECTION A-A

SECTION B-B

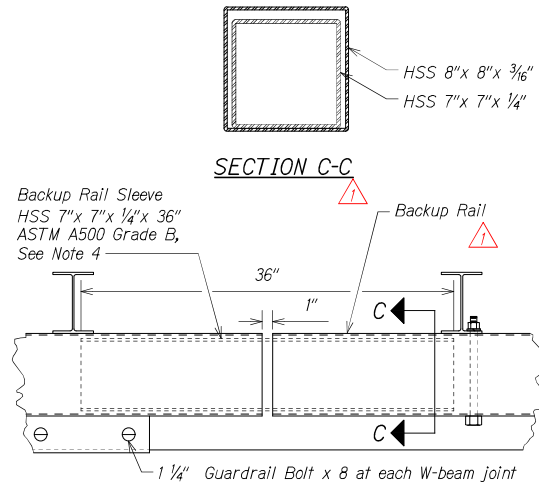

SECTION C-C

DETAIL A



THIS WORK WAS PREPARED BY ME OR UNDER MY SUPERVISION


Signature: *Rodney R. McElwain* 04/30/26  
 EXPIRATION DATE OF THE LICENSE

|   |  |
|---|--|
| 2/5/25  | Revised labels and additional details. |
| DATE  | REVISION                               |
| STATE OF HAWAII<br>DEPARTMENT OF TRANSPORTATION<br>HIGHWAYS DIVISION<br><b>STIFFENED MGS HALF POST SPACING</b><br><b>INTERSTATE ROUTE H-1 RESURFACING</b><br>Miller Pedestrian Overpass to Kapiolani Interchange<br>Federal-Aid Project No. NH-HI-1(279)R |  |
| Scale: NTS  | Date: February 2025                    |
| SHEET No. R39 OF 68 SHEETS  |  |

W:\\_CIVIL\_3D\_PROJECTS\2016\_2025\001-HI-1-RESURFACING - MILLER TO KAPIOLANI CIVIL DRAWINGS\3D STIFFENED MGS QUARTER POST SPACING.DWG - 1/22/2025 2:47 PM


| FED. ROAD DIST. NO. | STATE | FED-AID PROJ. NO. | FISCAL YEAR | SHEET NO. | TOTAL SHEETS |
|---------------------|-------|-------------------|-------------|-----------|--------------|
| HAWAII              | HAW.  | NH-HI-K279/R      | 2024        | 133       | 411          |

See Detail "B" on this Sheet and Sheet TC17 for Double-Loop Spacing, Piezo Sensor Location and Dimensions

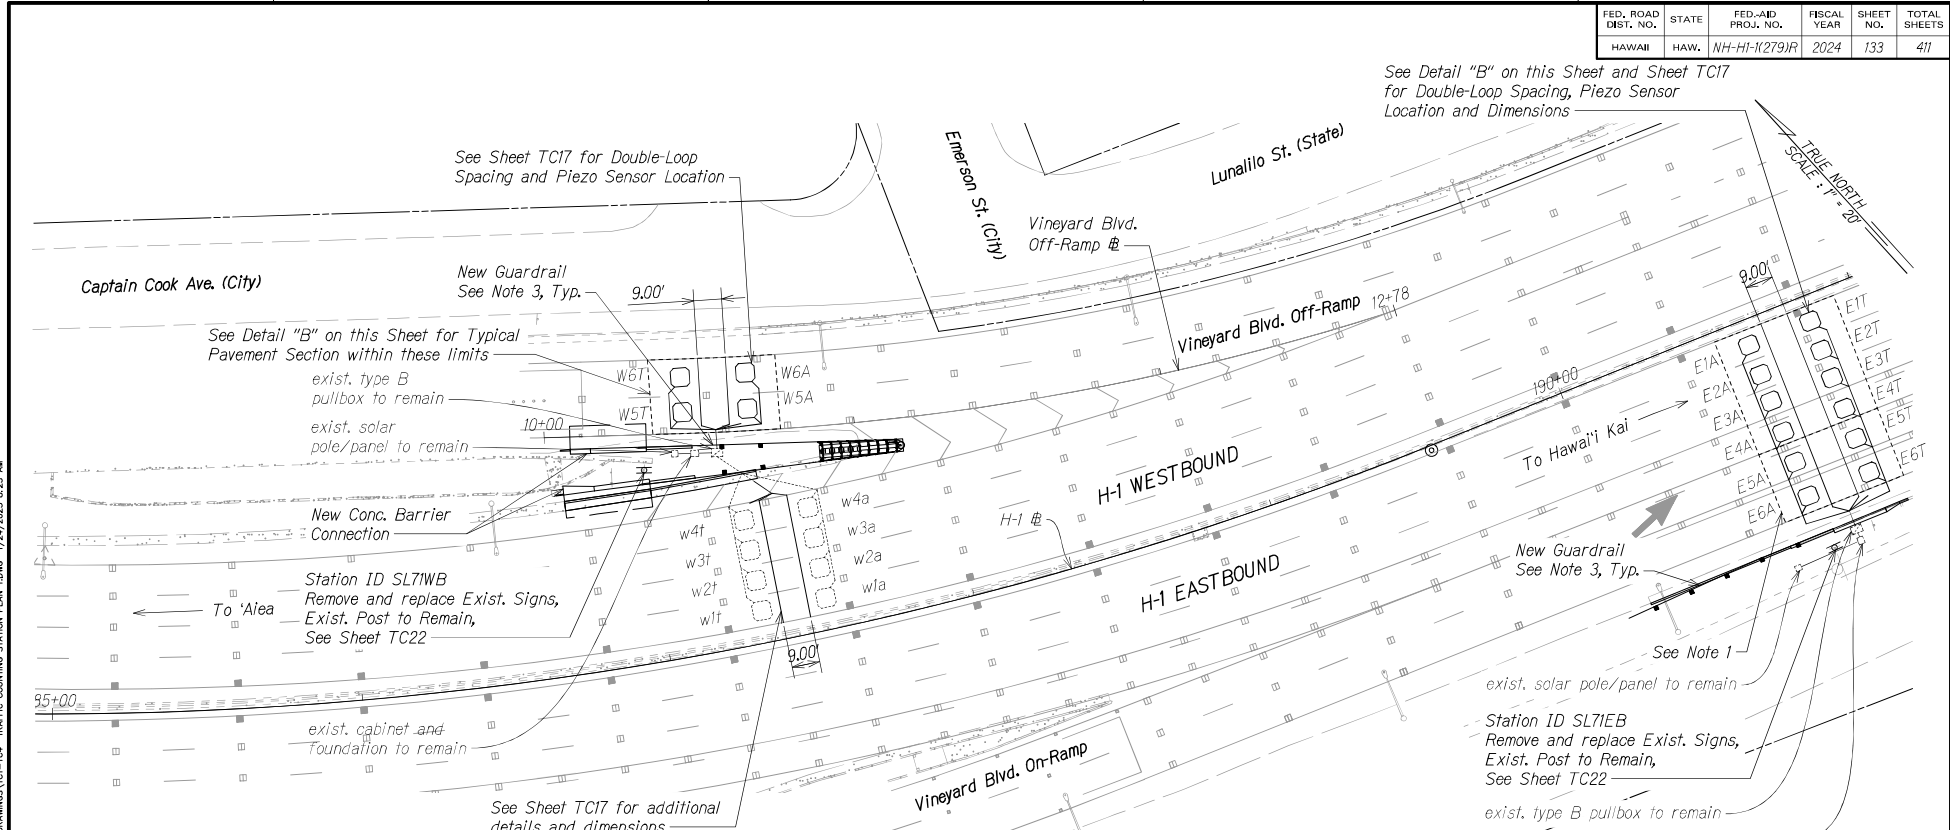

**NOTES:**

- For Freeway Traffic Counting Stations, use the following pavement section within limits shown in Detail "B" on this Sheet, except on Eastbound lanes 5 and 6. For Eastbound lanes 5 and 6, refer to Note 1 on Sheet TC3.
  - 2" SMA
  - GlasGrid 8511TF
  - 2" Mix No. IV with PG 64E-22
  - GlasGrid 8511TF
  - 4" HMAB
- Locations for traffic counting station equipment shown on plan are approximate. Final location of equipment to be determined in the field. The Contractor shall submit the final equipment location plan including the Loops, Piezo and Road temperature sensors for approval prior to installation.
- The Contractor shall coordinate and install conduits clear from guardrail posts.

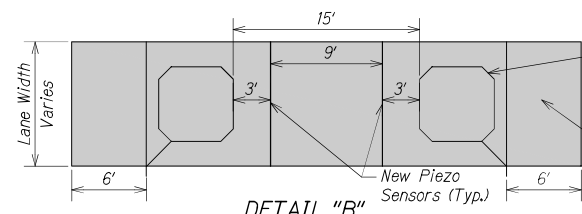

**TYPICAL FREEWAY EVC SENSOR SPACING AND DIMENSIONS**  
Not to Scale


New 6'x 6' Loop Detector Centered in Lane, Typ. See Detail on Sheet TC21

See Note 1 For Pavement Section Required for Limits Shown



THIS WORK WAS PREPARED BY ME OR UNDER MY SUPERVISION


Signature: *Rodney R. McElroy*  
Date: 04/30/26  
Expiration Date of the License

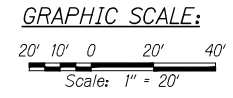

|   |                     |
|---|---------------------|
| 2/5/25  | Revised Note 1.     |
| DATE  | REVISION            |
| STATE OF HAWAII<br>DEPARTMENT OF TRANSPORTATION<br>HIGHWAYS DIVISION                        |                     |
| <b>TRAFFIC COUNTING STATION</b>   |                     |
| <b>PLAN AT MILEPOST 22.10</b>   |                     |
| <b>INTERSTATE ROUTE H-1 RESURFACING</b>   |                     |
| Miller Pedestrian Overpass to Kapiolani Interchange<br>Federal-Aid Project No. NH-HI-K279/R |                     |
| Scale: 1" = 20'   | Date: February 2025 |
| SHEET No. TC2 OF 22 SHEETS  |                     |

W:\\_S\1330 PROJECTS\2024\2024-001-HI-111 RESURFACING - MILLER TO KAPOLANI CIVIL DRAWINGS\TC1-104 TRAFFIC COUNTING STATION PLAN LANS 1/24/2025 8:25 AM

| FED. ROAD DIST. NO. | STATE | FED. AID PROJ. NO. | FISCAL YEAR | SHEET NO. | TOTAL SHEETS |
|---------------------|-------|--------------------|-------------|-----------|--------------|
| HAWAII              | HAW.  | NH-HI-1(279)R      | 2024        | 182       | 411          |

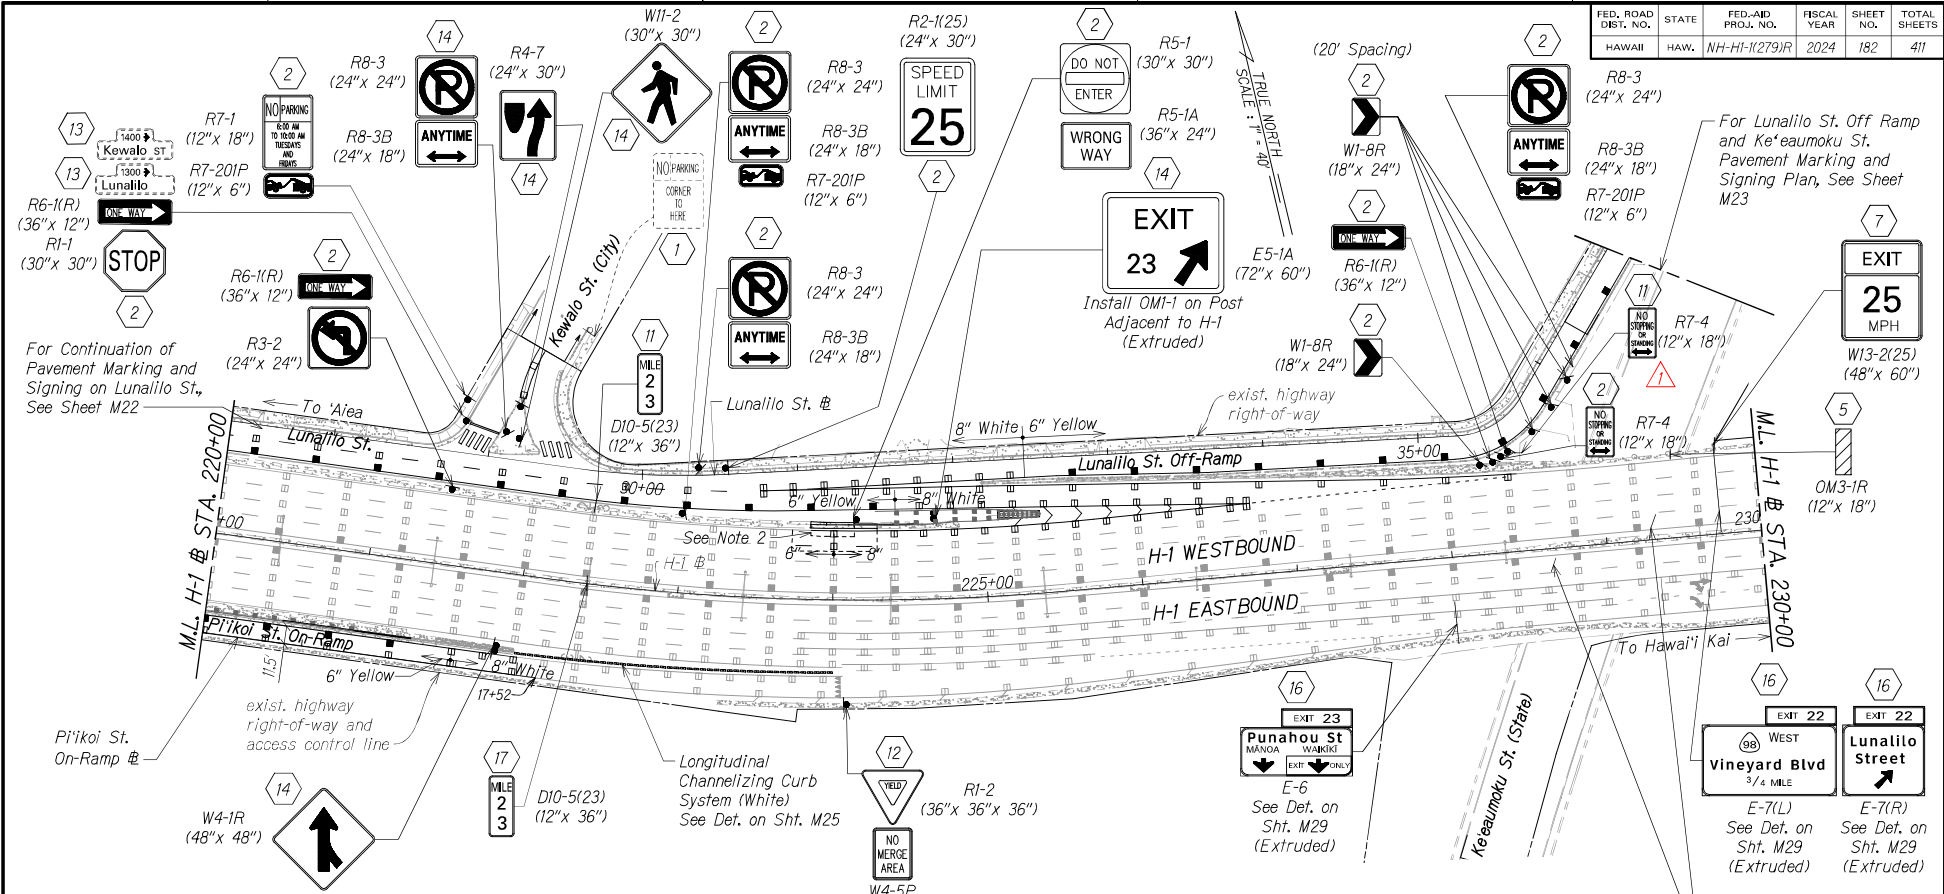

**SIGNING KEY:**


- 1 Exist. Sign(s) & Post(s) to Remain
- 2 Remove Exist. Sign(s) w/ Post(s) & Install New Sign(s) w/ Post(s).
- 5 Remove Exist. Sign(s) & Install New Sign(s) on Bridge Column
- 7 Remove Exist. Sign(s) & Install New Sign(s) on Exist. Column Sign Post
- 8 Remove Exist. Sign(s) & Install New Sign Mounted on Overpass (Bridge) Fascia
- 11 Remove Exist. Sign(s) & Install New Sign(s) on Exist. Street Light Post(s)
- 12 Remove Exist. Sign(s) & Install New Sign(s) on Exist. Concrete Barrier Mounted Posts
- 13 Reinstall Exist. Sign(s) to New Post

- 14 Remove Exist. Sign(s) w/ Post(s) & Install New Sign(s) w/ Post(s). Install Type I Object Marker (OMI-1) on New Posts.
- 16 Remove Exist. Sign(s) & Install New Sign(s) on Exist. Overhead Sign Frame.
- 17 Install New Sign(s) on Exist. Street Light Post.

**NOTES:**

1. For pavement marking and signing legend, see Sheets M1 to M2.
2. For limits of pavement reconstruction and resurfacing at locations of Concrete Barrier Transition footing, see Sheets R1 to R22.

**GRAPHIC SCALE:**

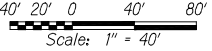

THIS WORK WAS PREPARED BY ME OR UNDER MY SUPERVISION

Signature: *Rodney R. McElrath* 04/30/26  
 EXPIRATION DATE OF THE LICENSE

|        |                      |
|--------|----------------------|
| 2/5/25 | Revised signing key. |
| DATE   | REVISION             |

STATE OF HAWAII  
 DEPARTMENT OF TRANSPORTATION  
 HIGHWAYS DIVISION

**PAVEMENT MARKING & SIGNING PLAN**

INTERSTATE ROUTE H-1 RESURFACING  
 Miller Pedestrian Overpass to Kapiolani Interchange  
 Federal-Aid Project No. NH-HI-1(279)R


Scale: 1" = 40' Date: February 2025  

W:\\_CIVIL\_3D\_PROJECTS\2016\_2024\06\_001-H1HS H1 RESURFACING - MILLER TO KAPIOLANI CIVIL DRAWINGS - MILLER TO KAPIOLANI CIVIL DRAWINGS - MB PAVEMENT MARKING AND SIGNING PLAN.DWG 2/2/2024 4:15 PM



| FED. ROAD DIST. NO. | STATE | FED-AID PROJ. NO. | FISCAL YEAR | SHEET NO. | TOTAL SHEETS |
|---------------------|-------|-------------------|-------------|-----------|--------------|
| HAWAII              | HAW.  | NH-HI-1(279)R     | 2024        | 186       | 411          |

W.A. CIVIL 3D PROJECTS/2016-2024/001-001-HIWS H1 RESURFACING - MILLER TO KAPOLANI CIVIL DRAWINGS/MP - M12 PAVEMENT MARKING AND SIGNING PLANS/ISSUE 8/30/2024 2:27 PM

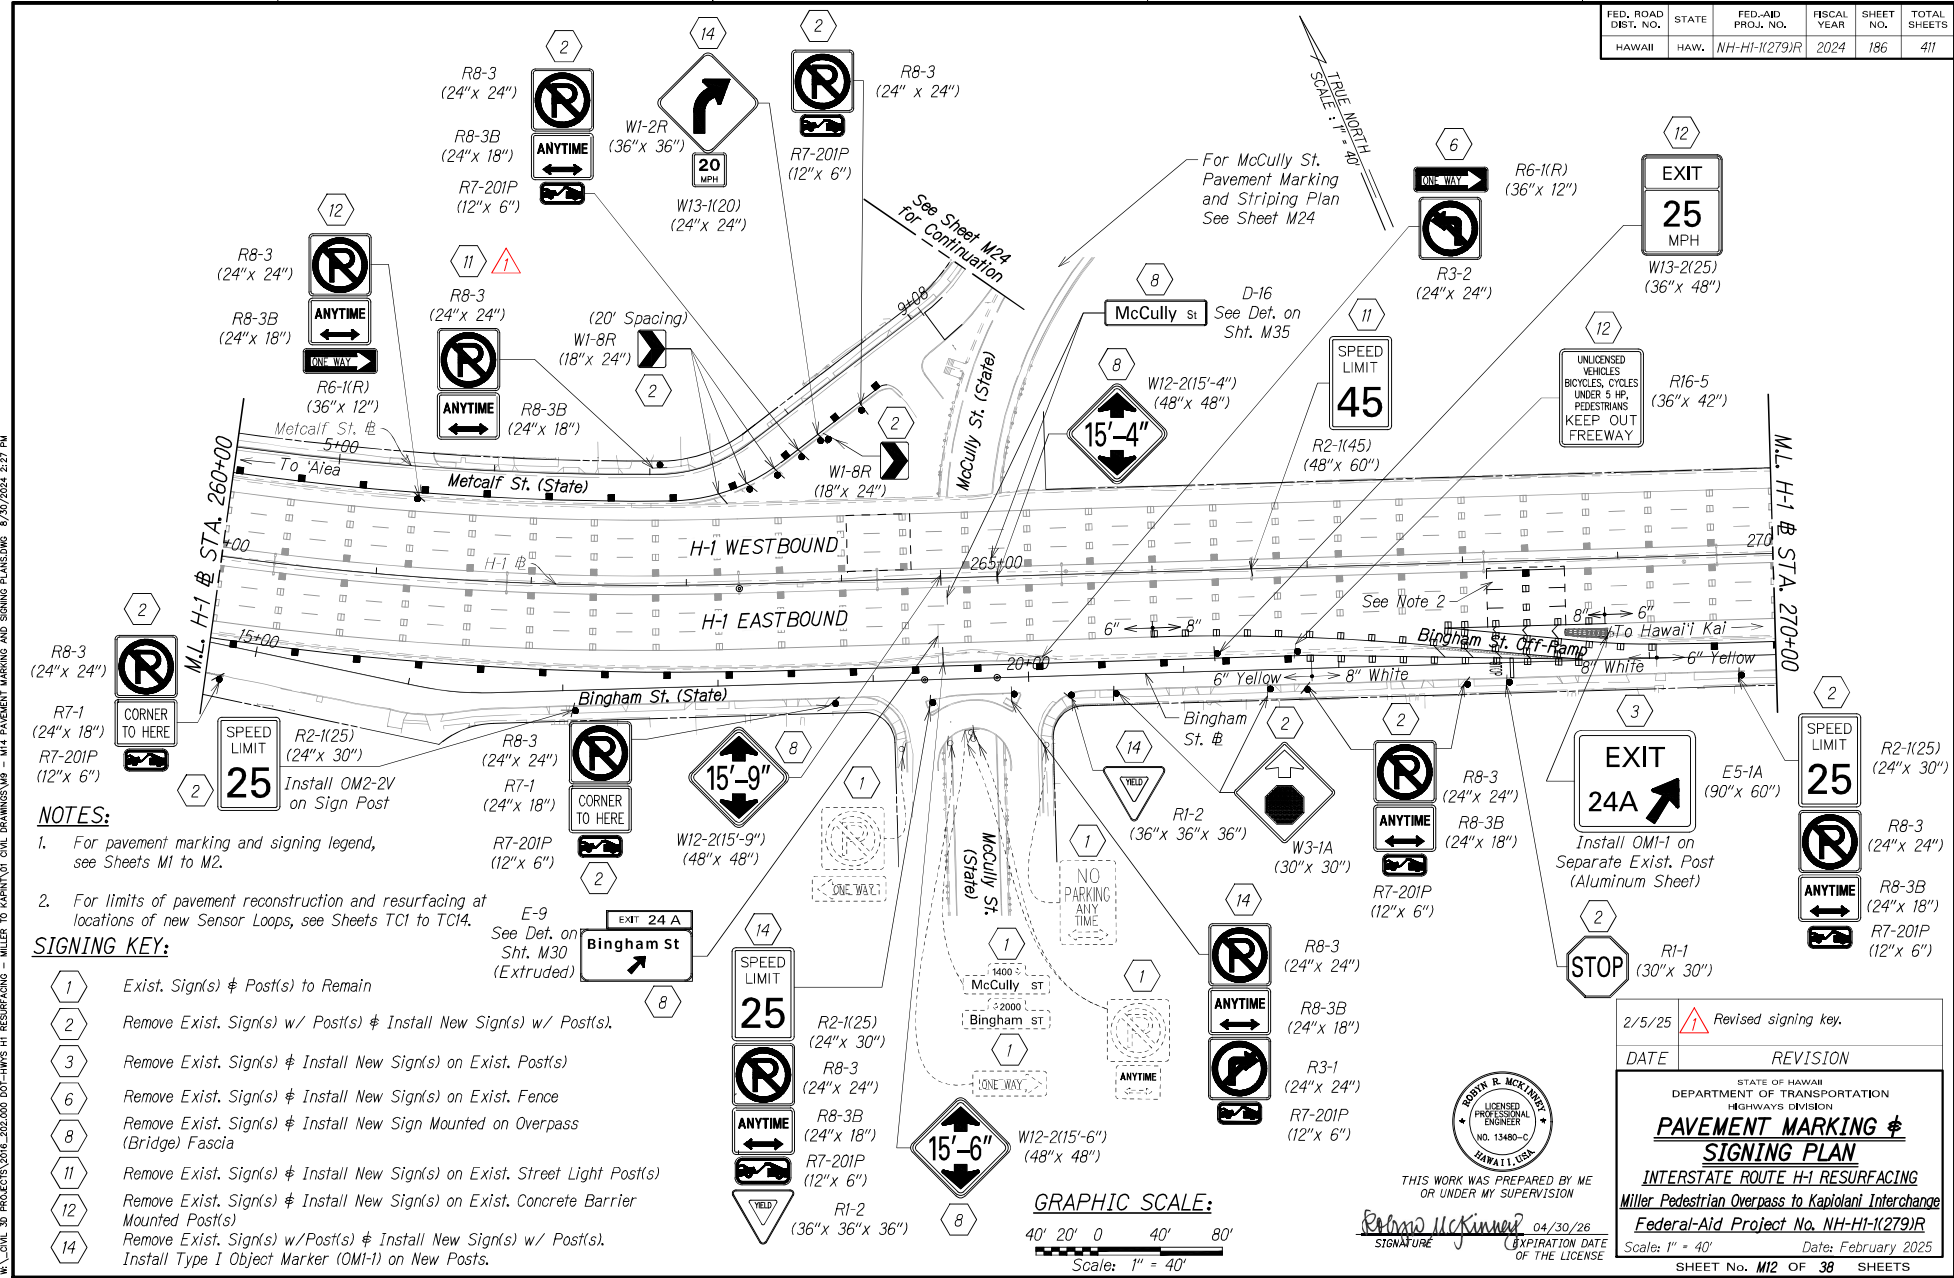


**NOTES:**

- For pavement marking and signing legend, see Sheets M1 to M2.
- For limits of pavement reconstruction and resurfacing at locations of new Sensor Loops, see Sheets TC1 to TC14.

**SIGNING KEY:**

- 1 Exist. Sign(s) & Post(s) to Remain
- 2 Remove Exist. Sign(s) w/ Post(s) & Install New Sign(s) w/ Post(s).
- 3 Remove Exist. Sign(s) & Install New Sign(s) on Exist. Post(s)
- 6 Remove Exist. Sign(s) & Install New Sign(s) on Exist. Fence
- 8 Remove Exist. Sign(s) & Install New Sign Mounted on Overpass (Bridge) Fascia
- 11 Remove Exist. Sign(s) & Install New Sign(s) on Exist. Street Light Post(s)
- 12 Remove Exist. Sign(s) & Install New Sign(s) on Exist. Concrete Barrier Mounted Post(s)
- 14 Remove Exist. Sign(s) w/ Post(s) & Install New Sign(s) w/ Post(s). Install Type I Object Marker (OMI-1) on New Posts.

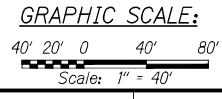

|  |                      |
|--|----------------------|
| 2/5/25   | Revised signing key. |
| DATE   | REVISION             |
| STATE OF HAWAII<br>DEPARTMENT OF TRANSPORTATION<br>HIGHWAYS DIVISION |                      |
| <b>PAVEMENT MARKING &amp; SIGNING PLAN</b>                           |                      |
| INTERSTATE ROUTE H-1 RESURFACING                                     |                      |
| Miller Pedestrian Overpass to Kapiolani Interchange                  |                      |
| Federal-Aid Project No. NH-HI-1(279)R                                |                      |
| Scale: 1" = 40'  | Date: February 2025  |
| SHEET No. M12 OF 38 SHEETS   |                      |




THIS WORK WAS PREPARED BY ME OR UNDER MY SUPERVISION

*Robyn McElroy* 04/30/26  
SIGNATURE EXPIRATION DATE OF THE LICENSE

| FED. ROAD DIST. NO. | STATE | FED. AID PROJ. NO. | FISCAL YEAR | SHEET NO. | TOTAL SHEETS |
|---------------------|-------|--------------------|-------------|-----------|--------------|
| HAWAII              | HAW.  | NH-HI-1(279)R      | 2024        | 189       | 411          |

**SIGNING KEY:**

|    |  |
|----|--|
| 2  | Remove Exist. Sign(s) w/ Post(s) & Install New Sign(s) w/ Post(s).   |
| 3  | Remove Exist. Sign(s) & Install New Sign(s) on Exist. Post(s)  |
| 9  | Remove Exist. Sign(s) & Post(s)  |
| 11 | Remove Exist. Sign(s) & Install New Sign(s) on Exist. Street Light Post(s)   |
| 12 | Remove Exist. Sign(s) & Install New Sign(s) on Exist. Concrete Barrier Mounted Post(s)                               |
| 14 | Remove Exist. Sign(s) w/Post(s) & Install New Sign(s) w/ Post(s). Install Type I Object Marker (OMI-1) on New Posts. |
| 16 | Remove Exist. Sign(s) & Install New Sign(s) on Exist. Overhead Sign Frame.   |

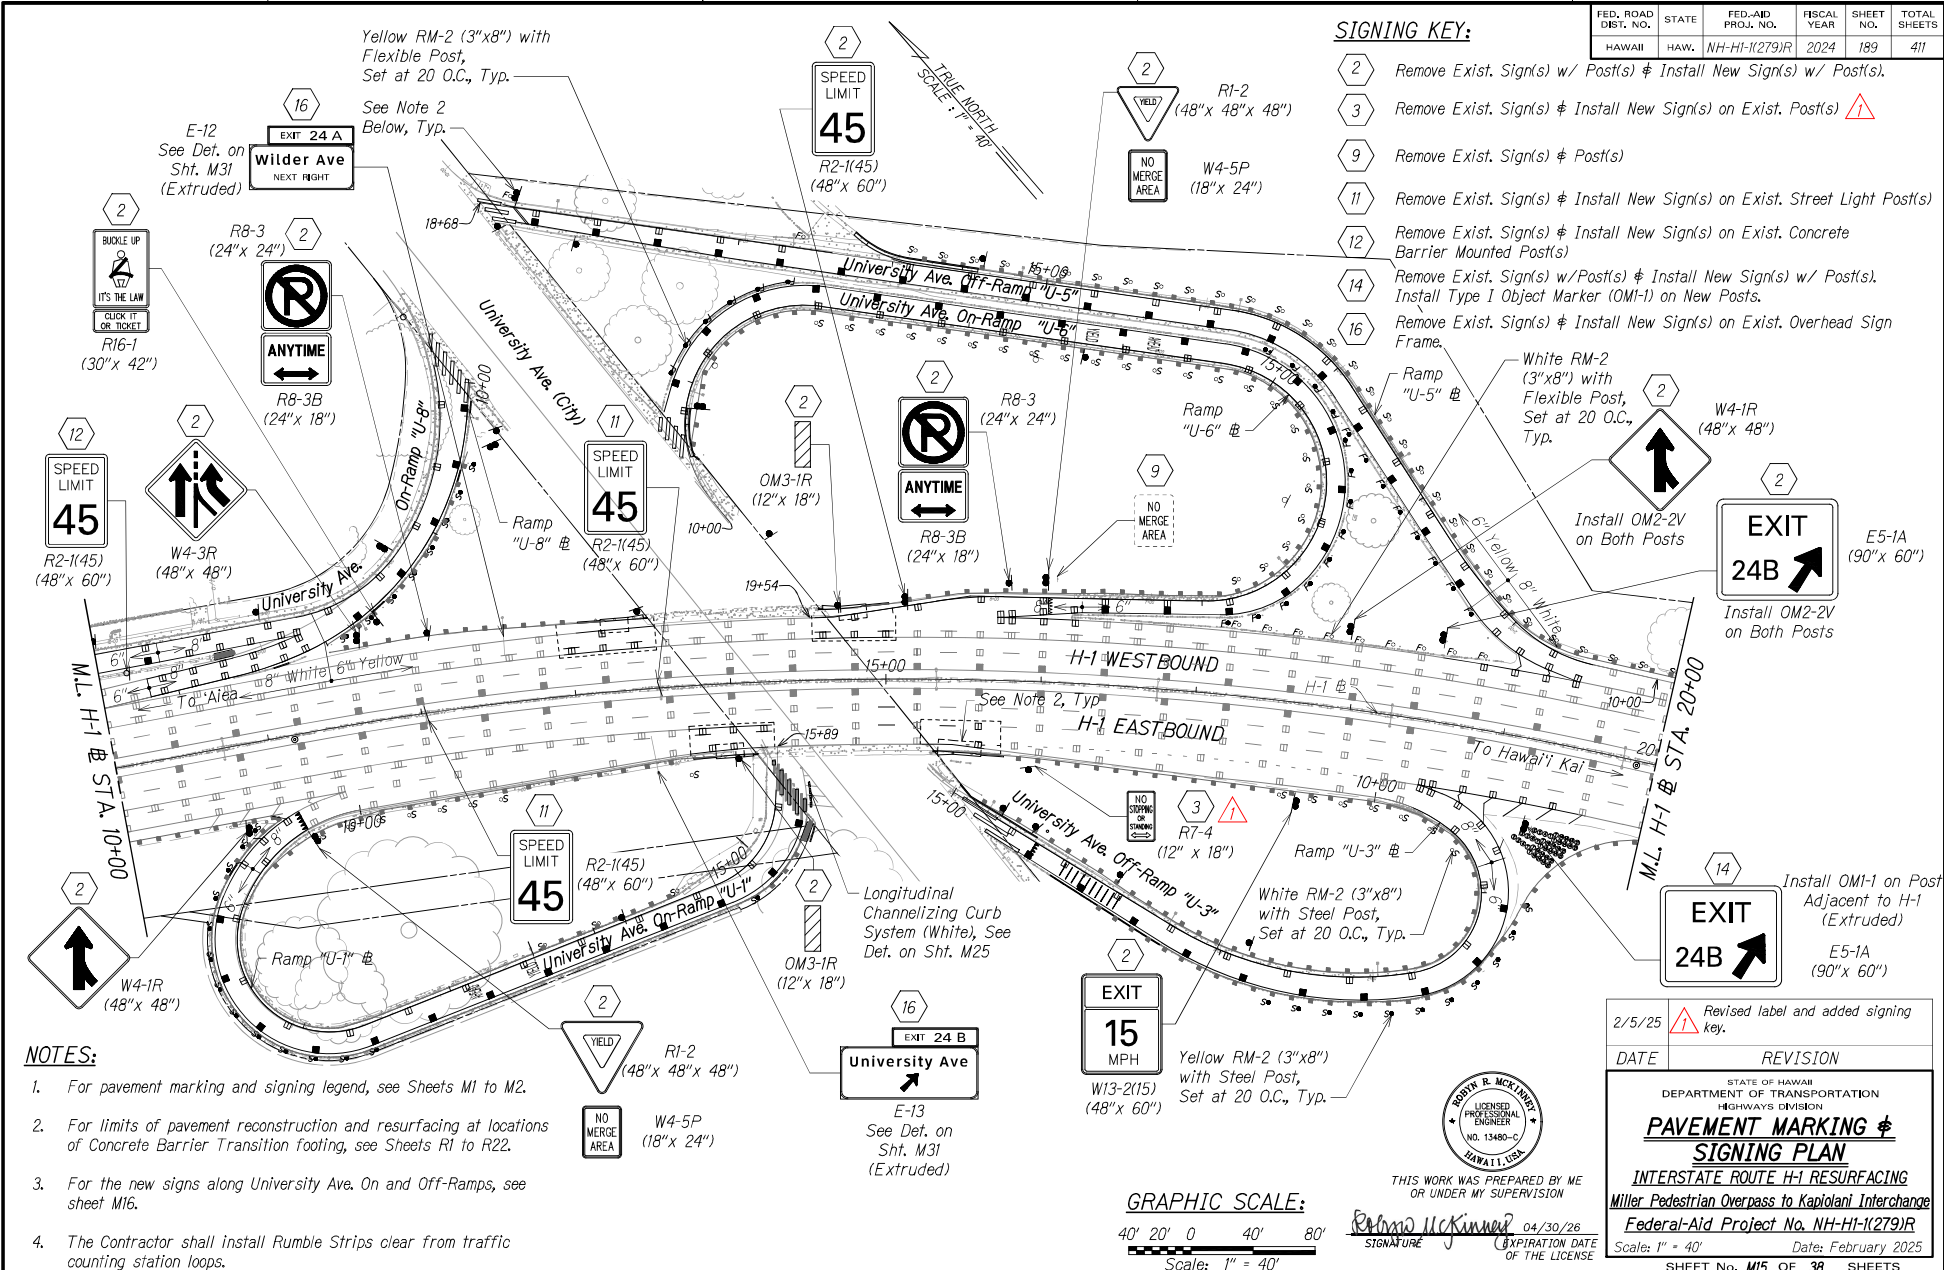

W:\\_CIVIL\_3D\_PROJECTS\2016\_2024\001-HWS-H1-RESURFACING - MILLER TO KAPOLANI CIVIL DRAWINGS\MIS - MIS PAVEMENT MARKING AND SIGNING PLAN\DWG - 1/24/2025 5:30 PM

| FED. ROAD DIST. NO. | STATE | FED-AID PROJ. NO. | FISCAL YEAR | SHEET NO. | TOTAL SHEETS |
|---------------------|-------|-------------------|-------------|-----------|--------------|
| HAWAII              | HAW.  | NH-HI-K279/R      | 2024        | 190       | 411          |


**SIGNING KEY:**

- ① Exist. Sign(s) & Post(s) to Remain
- ② Remove Exist. Sign(s) w/ Post(s) & Install New Sign(s) w/ Post(s).
- ③ Remove Exist. Sign(s) & Install New Sign(s) on Exist. Street Light Post(s)

UNIVERSITY OF HAWAII  
COLLEGE OF TROPICAL AGRICULTURE  
AND HUMAN RESOURCES  

Yellow RM-2 (3"x8") with Flexible Post, Set at 20 O.C., Typ.

White RM-2 (3"x8") with Flexible Post, Set at 20 O.C., Typ.

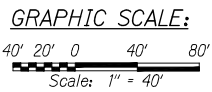


|   |                                       |
|---|---------------------------------------|
| 2/5/25  | ▲ Revised label and sign post symbol. |
| DATE  | REVISION                              |
| STATE OF HAWAII<br>DEPARTMENT OF TRANSPORTATION<br>HIGHWAYS DIVISION  |                                       |
| <b>PAVEMENT MARKING &amp; SIGNING PLAN</b>  |                                       |
| INTERSTATE ROUTE H-1 RESURFACING<br>Miller Pedestrian Overpass to Kapiolani Interchange<br>Federal-Aid Project No. NH-HI-K279/R |                                       |
| Scale: 1" = 40'   | Expiration Date: February 2025        |
| SHEET No. <b>M16</b> OF 38 SHEETS   |                                       |



THIS WORK WAS PREPARED BY ME OR UNDER MY SUPERVISION


*Robyn McElwain*  
SIGNATURE      04/30/26  
EXPIRATION DATE OF THE LICENSE

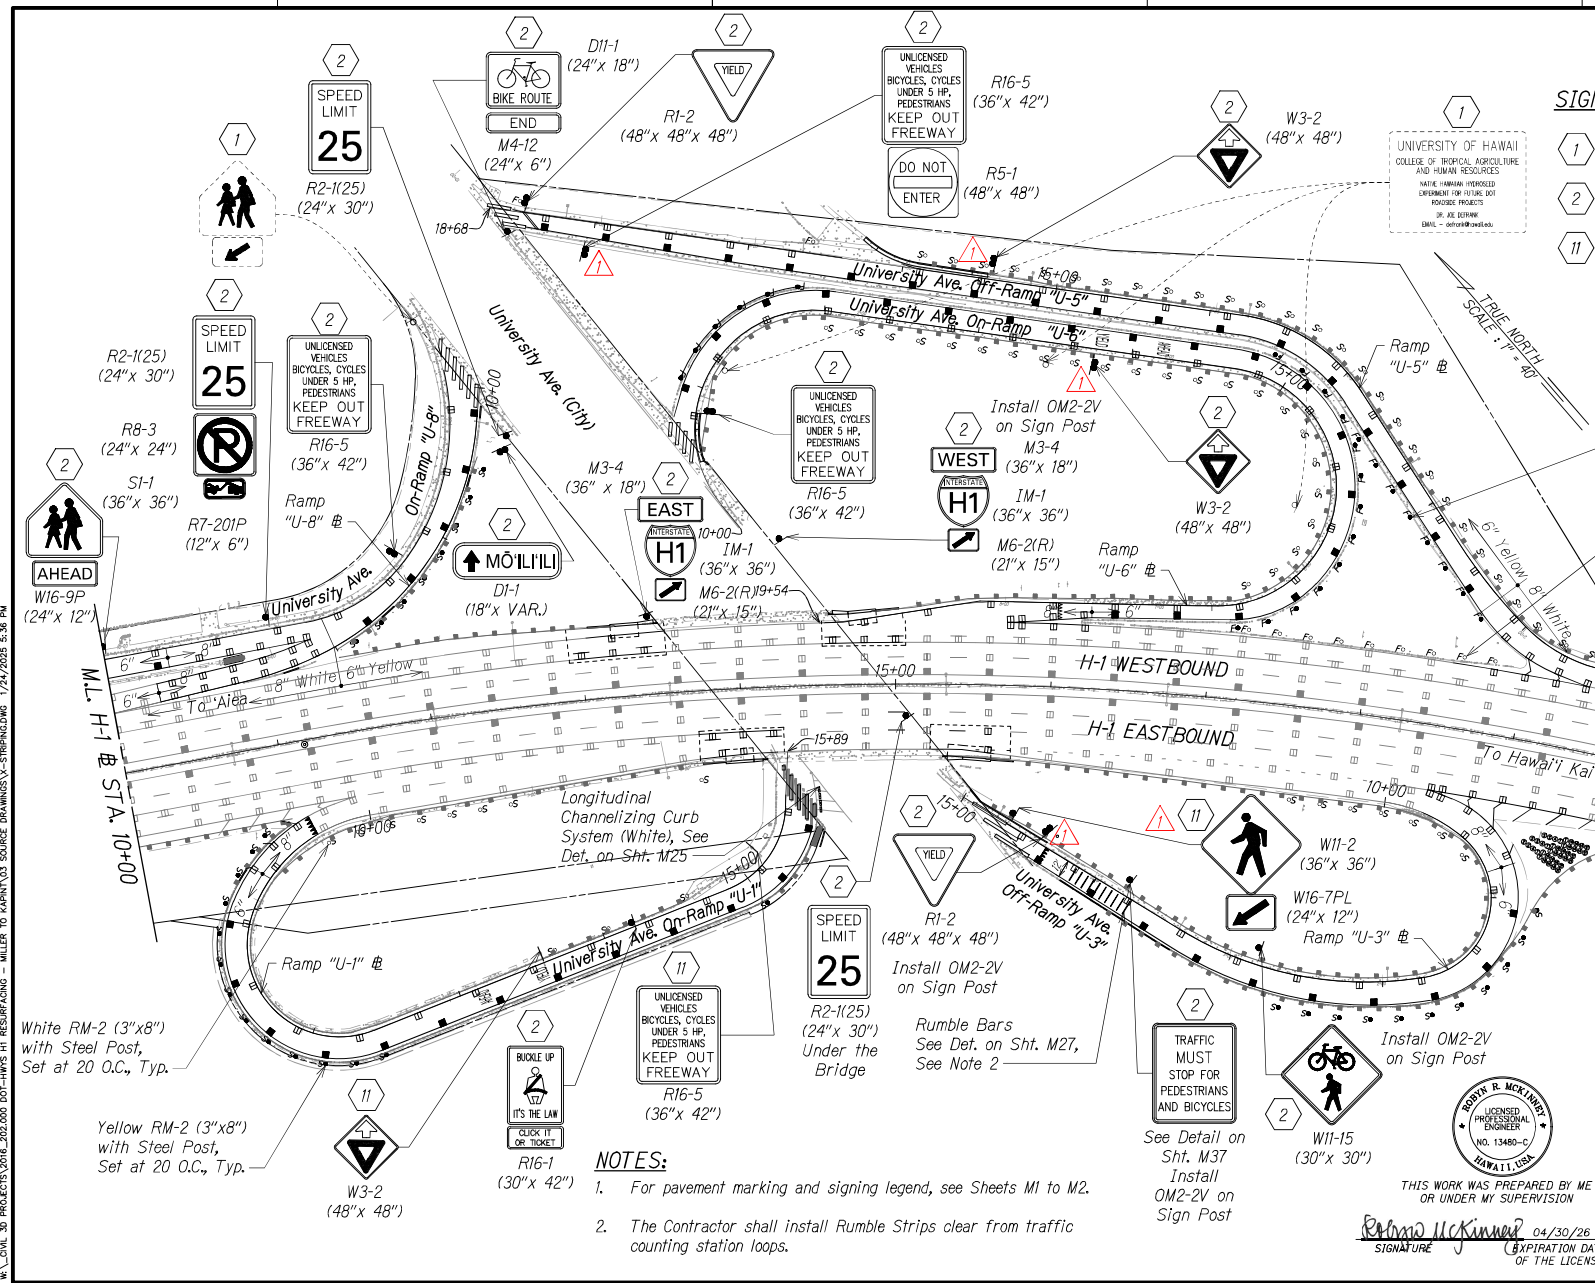

- NOTES:**
- For pavement marking and signing legend, see Sheets M1 to M2.
  - The Contractor shall install Rumble Strips clear from traffic counting station loops.

W:\\_L\161\_30\_PROJECTS\016\_202406\_001-HAWAII HI RESURFACING - MILLER TO KAPIOLANI SOURCE DRAWINGS - SIGNING - 1/24/2025 5:36 PM

| FED. ROAD DIST. NO. | STATE | FED-AID PROJ. NO. | FISCAL YEAR | SHEET NO. | TOTAL SHEETS |
|---------------------|-------|-------------------|-------------|-----------|--------------|
| HAWAII              | HAW.  | NH-HI-1(279)R     | 2024        | 191       | 411          |

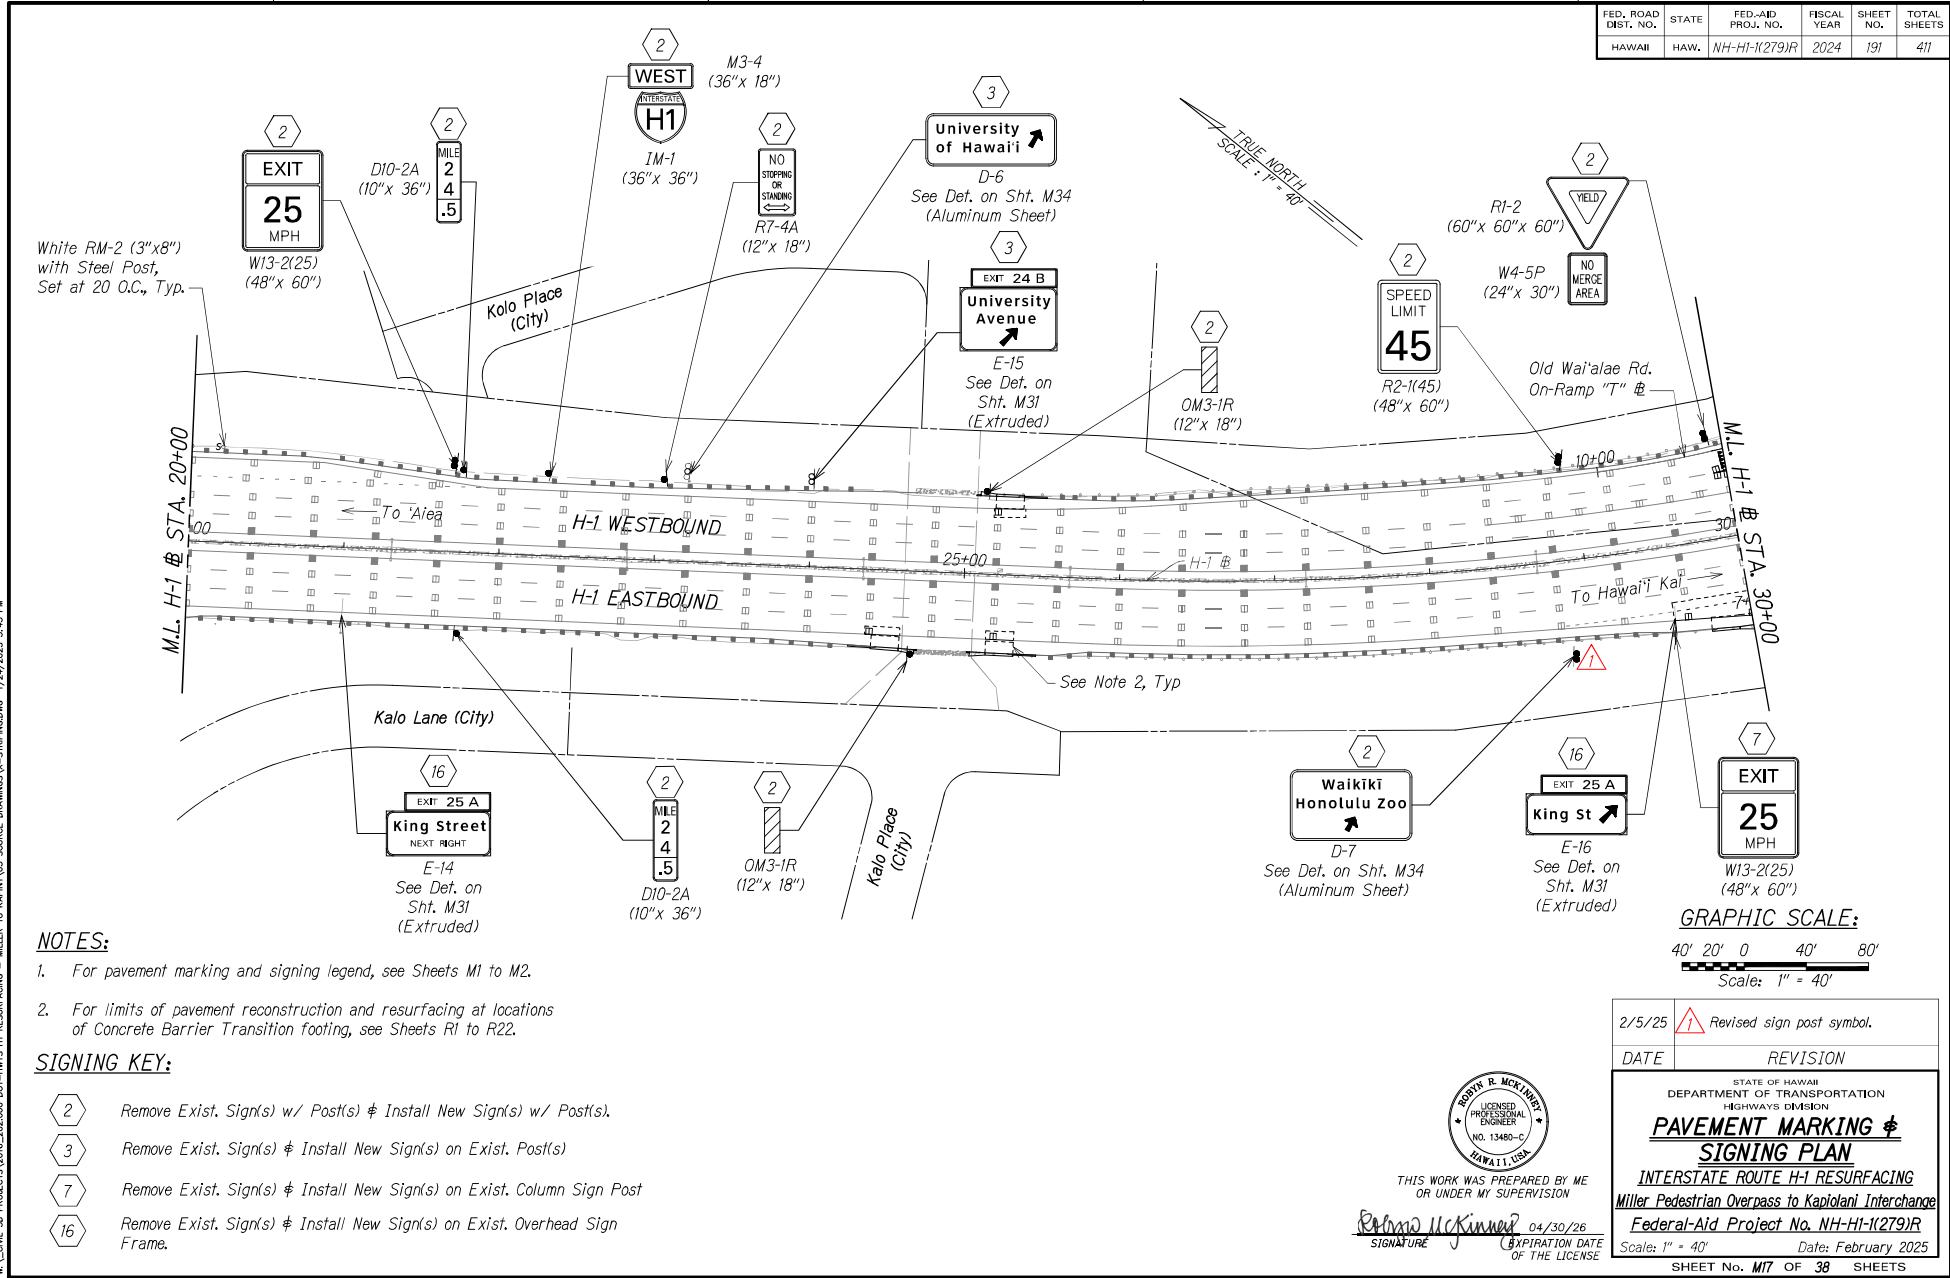


**NOTES:**

- For pavement marking and signing legend, see Sheets M1 to M2.
- For limits of pavement reconstruction and resurfacing at locations of Concrete Barrier Transition footing, see Sheets R1 to R22.

**SIGNING KEY:**

- 2 Remove Exist. Sign(s) w/ Post(s) & Install New Sign(s) w/ Post(s).
- 3 Remove Exist. Sign(s) & Install New Sign(s) on Exist. Post(s)
- 7 Remove Exist. Sign(s) & Install New Sign(s) on Exist. Column Sign Post
- 16 Remove Exist. Sign(s) & Install New Sign(s) on Exist. Overhead Sign Frame.

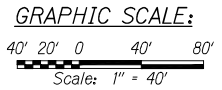

| DATE   | REVISION  |
|--------|---|
| 2/5/25 | <span style="border: 1px solid black; padding: 2px;">▲</span> Revised sign post symbol. |



THIS WORK WAS PREPARED BY ME OR UNDER MY SUPERVISION

*Rodney R. McKinney*  
 SIGNATURE      04/30/26  
 EXPIRATION DATE OF THE LICENSE

STATE OF HAWAII  
 DEPARTMENT OF TRANSPORTATION  
 HIGHWAYS DIVISION

**PAVEMENT MARKING & SIGNING PLAN**


**INTERSTATE ROUTE H-1 RESURFACING**  
 Miller Pedestrian Overpass to Kapiolani Interchange  
 Federal-Aid Project No. NH-HI-1(279)R

Scale: 1" = 40'      Date: February 2025

SHEET No. **M17** OF 38 SHEETS

W:\\_ENV\_3D\_PROJECTS\0316\_202400\_001-HWIS H1 RESURFACING - MILLER TO KAPOLANI SOURCE DRAWINGS\SUBMITTALS\1/24/2025 5:45 PM

| FED. ROAD DIST. NO. | STATE | FED-AID PROJ. NO. | FISCAL YEAR | SHEET NO. | TOTAL SHEETS |
|---------------------|-------|-------------------|-------------|-----------|--------------|
| HAWAII              | HAW.  | NH-HI-K279/R      | 2024        | 192       | 411          |

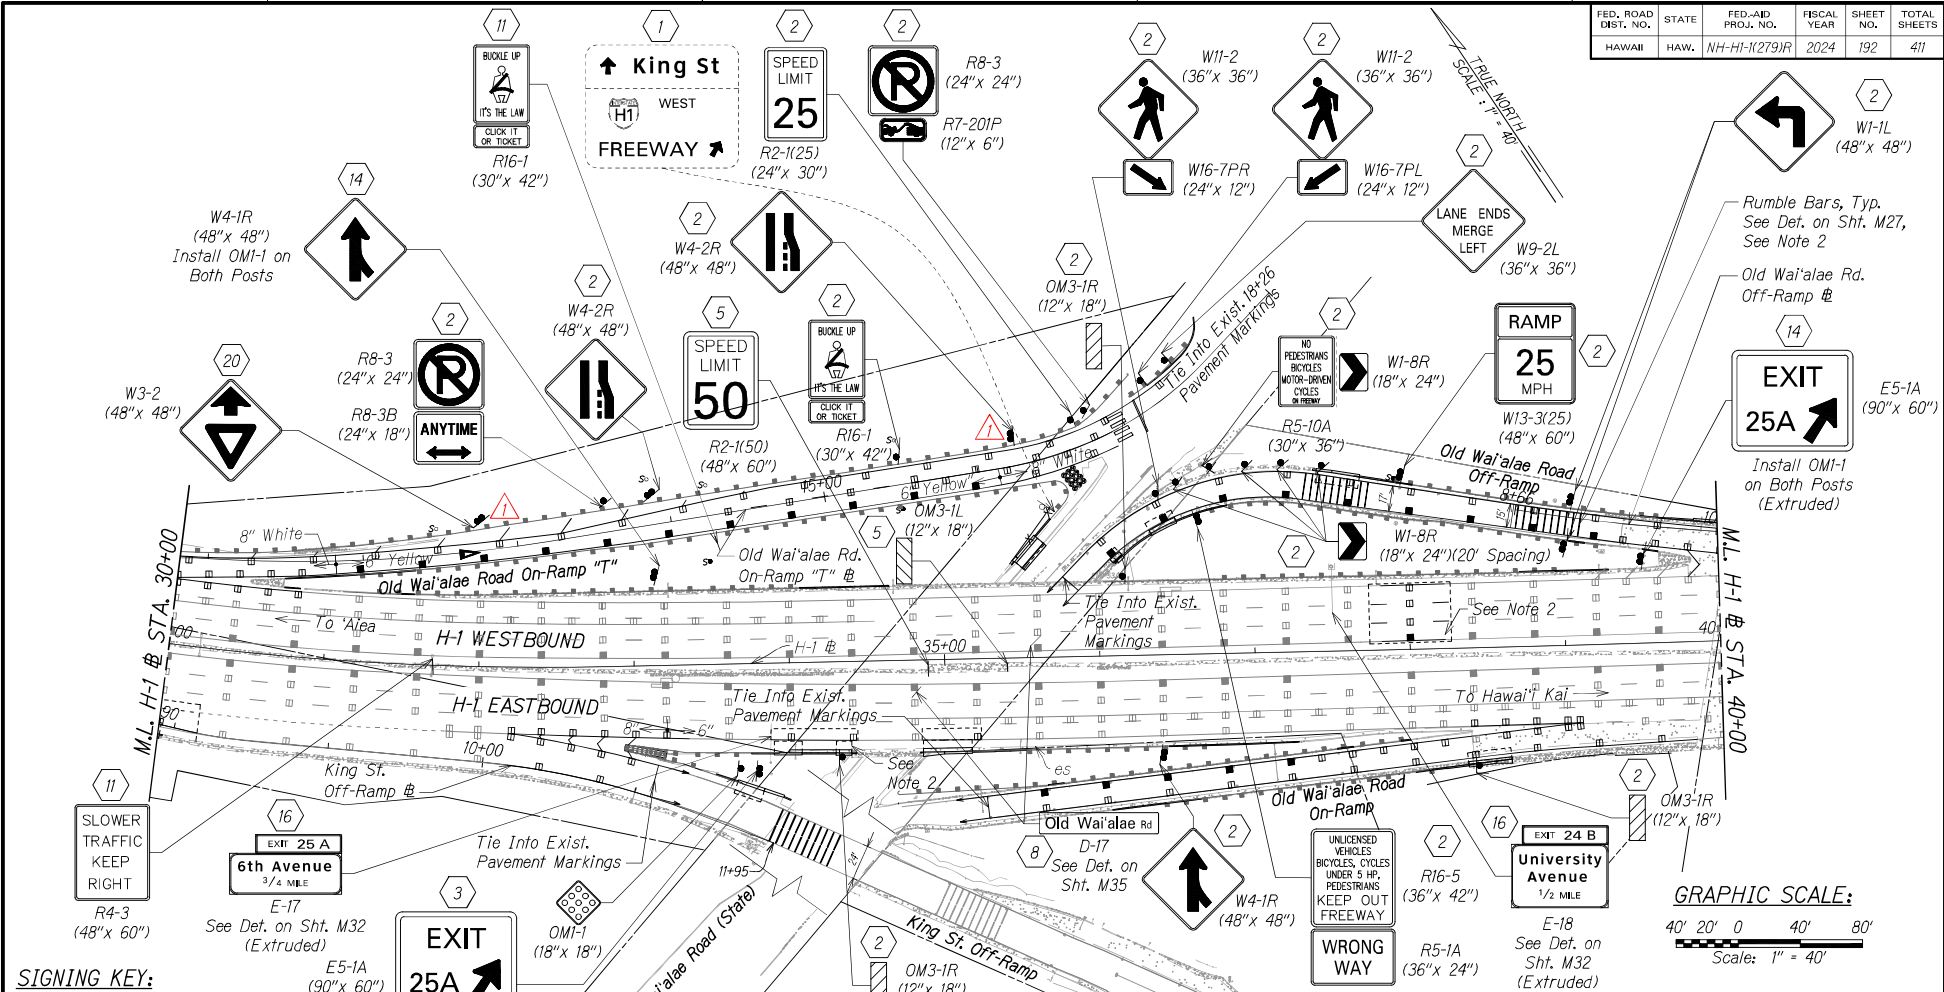

**SIGNING KEY:**

- 1 Exist. Sign(s) & Post(s) to Remain
- 2 Remove Exist. Sign(s) w/ Post(s) & Install New Sign(s) w/ Post(s).
- 3 Remove Exist. Sign(s) & Install New Sign(s) on Exist. Post(s)
- 5 Remove Exist. Sign(s) & Install New Sign(s) on Bridge Column
- 8 Remove Exist. Sign(s) & Install New Sign Mounted on Overpass (Bridge) Fascia
- 11 Remove Exist. Sign(s) & Install New Sign(s) on Exist. Street Light Post(s)
- 14 Remove Exist. Sign(s) w/ Post(s) & Install New Sign(s) w/ Post(s).  
Install Type I Object Marker (OMI-1) on New Posts.

- 16 Remove Exist. Sign(s) & Install New Sign(s) on Exist. Overhead Sign Frame.
- 20 Install New Sign(s) & Post(s)

**NOTES:**

1. For pavement marking and signing legend, see Sheets M1 to M2.
2. For limits of pavement reconstruction and resurfacing at locations of new Sensor Loops and Concrete Barrier Transition footing, see Sheets TC1 to TC14 and Sheets R1 to R22 respectively.
3. The Contractor shall install Rumble Strips clear from traffic counting station loops.

|         |                           |
|---------|---------------------------|
| 2/25/25 | Revised sign post symbol. |
| DATE    | REVISION                  |



THIS WORK WAS PREPARED BY ME OR UNDER MY SUPERVISION

RODNEY R. MCKEOWN  
 SIGNATURE  
 04/30/26  
 EXPIRATION DATE OF THE LICENSE

STATE OF HAWAII  
 DEPARTMENT OF TRANSPORTATION  
 HIGHWAYS DIVISION


**PAVEMENT MARKING & SIGNING PLAN**

INTERSTATE ROUTE H-1 RESURFACING  
 Miller Pedestrian Overpass to Kapiolani Interchange  
 Federal-Aid Project No. NH-HI-K279/R



Scale: 1" = 40' Date: February 2025  
 SHEET No. M18 OF 38 SHEETS

W:\\_L\130 PROJECTS\0406\_2024\000 DOT-HHS-HI RESURFACING - MILLER TO KAPIOLANI SOURCE DRAWINGS-SUBMITTING 1/24/2025 5:50 PM

| FED. ROAD DIST. NO. | STATE | FED-AID PROJ. NO. | FISCAL YEAR | SHEET NO. | TOTAL SHEETS |
|---------------------|-------|-------------------|-------------|-----------|--------------|
| HAWAII              | HAW.  | NH-HI-1(279)R     | 2024        | 195       | 411          |

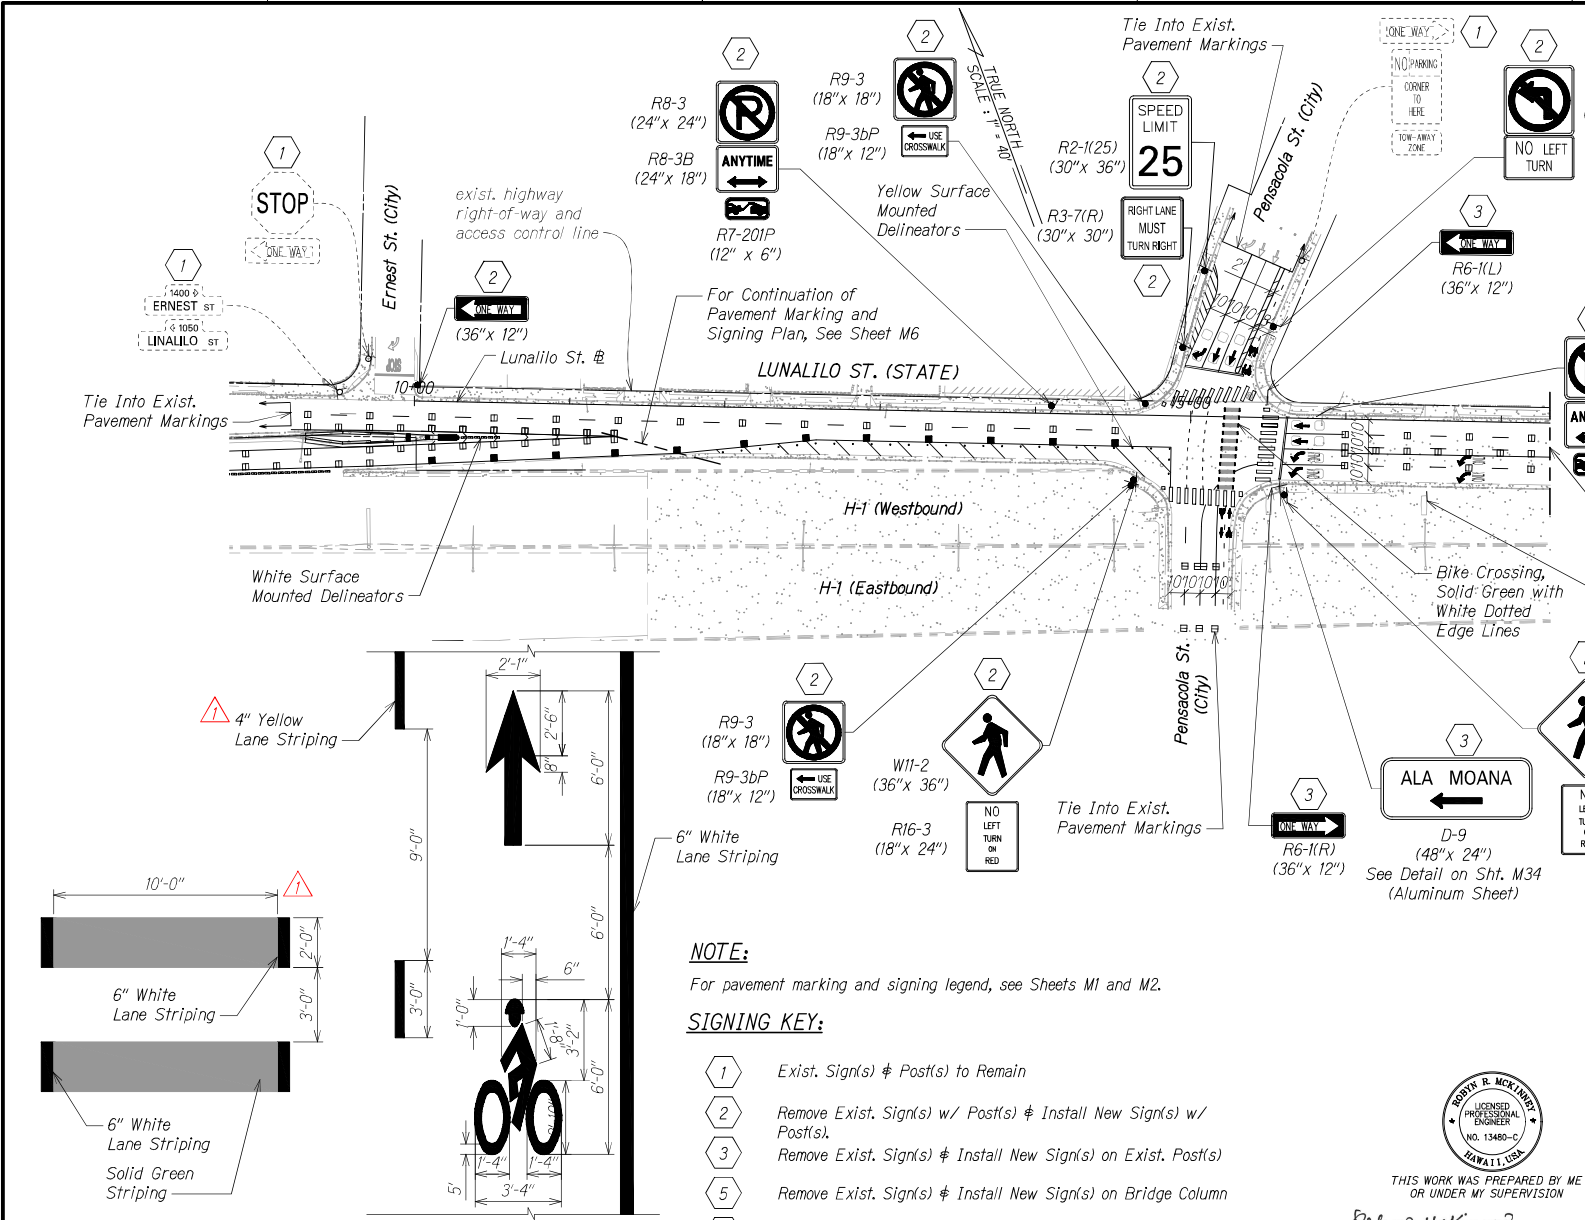


4" Yellow Lane Striping

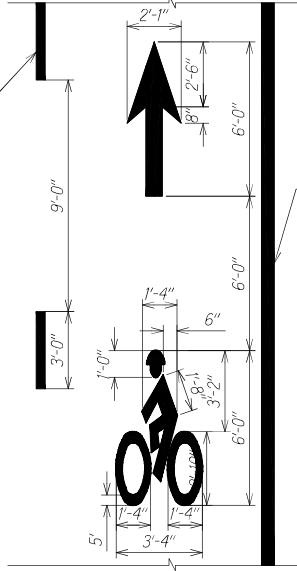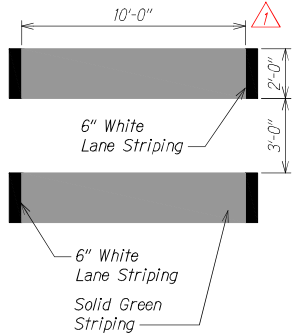

**NOTE:**  
For pavement marking and signing legend, see Sheets M1 and M2.

- SIGNING KEY:**
- 1 Exist. Sign(s) & Post(s) to Remain
  - 2 Remove Exist. Sign(s) w/ Post(s) & Install New Sign(s) w/ Post(s).
  - 3 Remove Exist. Sign(s) & Install New Sign(s) on Exist. Post(s)
  - 5 Remove Exist. Sign(s) & Install New Sign(s) on Bridge Column
  - 11 Remove Exist. Sign(s) & Install New Sign(s) on Exist. Street Light Post(s)

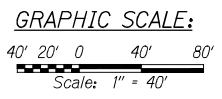

|  |                              |
|--|------------------------------|
| 2/5/25   | Revised label and dimension. |
| DATE   | REVISION                     |
| STATE OF HAWAII<br>DEPARTMENT OF TRANSPORTATION<br>HIGHWAYS DIVISION   |                              |
| <b>PAVEMENT MARKING &amp; SIGNING PLAN</b>   |                              |
| INTERSTATE ROUTE H-1 RESURFACING<br>Miller Pedestrian Overpass to Kapiolani Interchange<br>Federal-Aid Project No. NH-HI-1(279)R |                              |
| Scale: 1" = 40'  | Date: February 2025          |
| SHEET No. <b>M21</b> OF 38 SHEETS  |                              |




THIS WORK WAS PREPARED BY ME OR UNDER MY SUPERVISION

SIGNATURE      04/30/26  
EXPIRATION DATE OF THE LICENSE

W:\\_DRAWING\PROJECTS\2024\001\001-HI-1(279)R\RESURFACING - MILLER TO KAPOLANI CIVIL DRAWINGS\04 - M21 PAVEMENT MARKING AND SIGNING PLAN.DWG - 1/24/2025 5:34 PM

| FED. ROAD DIST. NO. | STATE | FED-AID PROJ. NO. | FISCAL YEAR | SHEET NO. | TOTAL SHEETS |
|---------------------|-------|-------------------|-------------|-----------|--------------|
| HAWAII              | HAW.  | NH-HI-1(279)R     | 2024        | 196       | 411          |

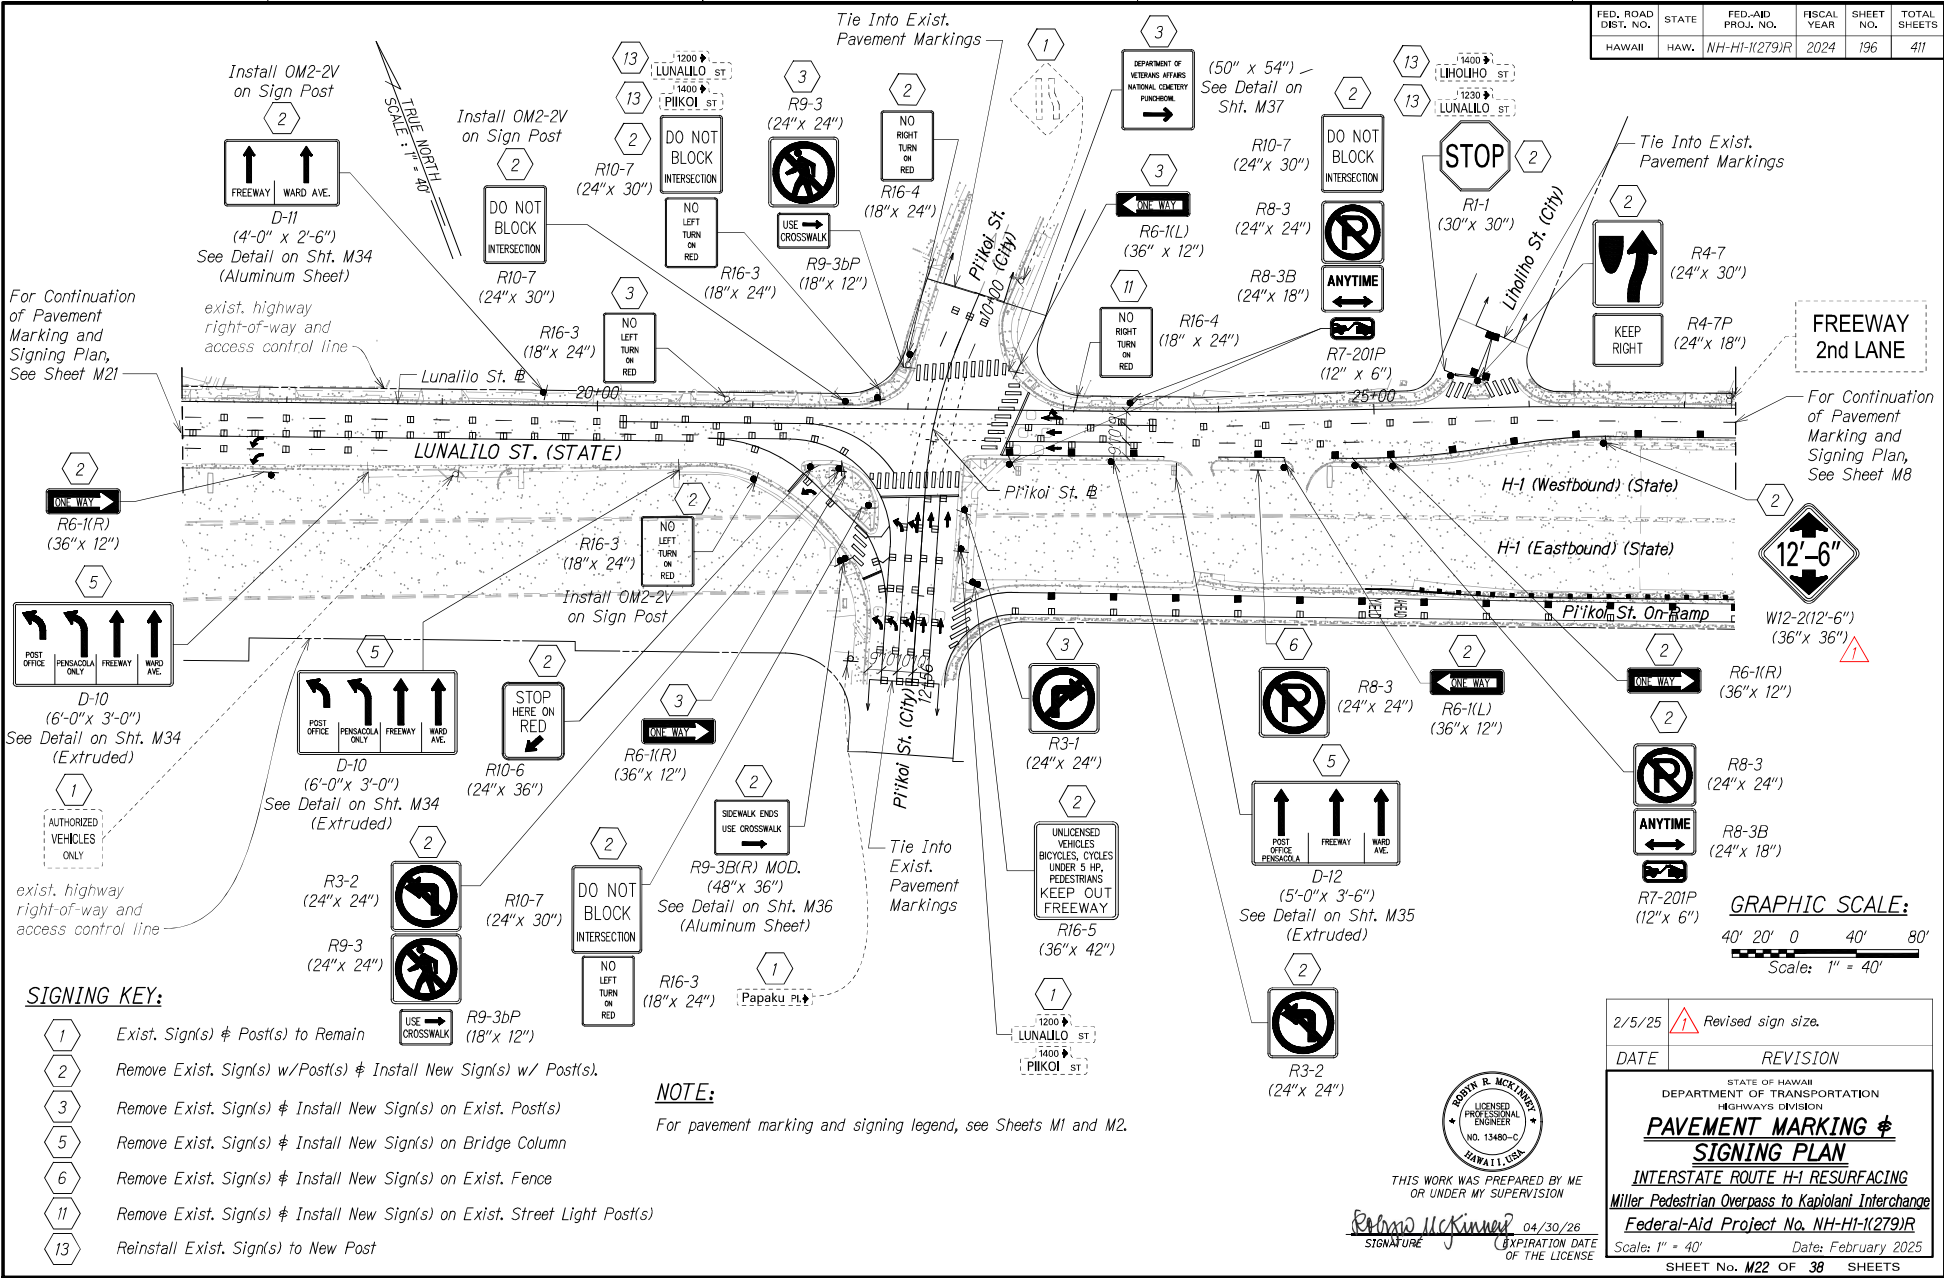

W:\\_Civil\_3D\_PROJECTS\2016-2020\001-001-HWS H1 RESURFACING - MILLER TO KAPIOLANI CIVIL DRAWINGS AND SIGNING PLANS.DWG 1/24/2025 5:23 PM



THIS WORK WAS PREPARED BY ME OR UNDER MY SUPERVISION

 SIGNATURE EXPIRATION DATE OF THE LICENSE

|  |                     |
|--|---------------------|
| 2/5/25   | Revised sign size.  |
| DATE   | REVISION            |
| STATE OF HAWAII<br>DEPARTMENT OF TRANSPORTATION<br>HIGHWAYS DIVISION   |                     |
| <b>PAVEMENT MARKING &amp; SIGNING PLAN</b>   |                     |
| INTERSTATE ROUTE H-1 RESURFACING<br>Miller Pedestrian Overpass to Kapiolani Interchange<br>Federal-Aid Project No. NH-HI-1(279)R |                     |
| Scale: 1" = 40'  | Date: February 2025 |
| SHEET No. M22 OF 38 SHEETS   |                     |

**ADD.196**

**INTERSTATE ROUTE H-1 RESURFACING, MILLER PEDESTRIAN OVERPASS TO  
KAPIOLANI INTERCHANGE**

**FEDERAL-AID PROJECT NO. NH-H1-1(279)R**

**PRE-BID MEETING NOTES**

**January 9, 2025**

The following notes are from the Hawaii Department of Transportation (HDOT) pre-bid meeting with prospective bidders for the Interstate Route H-1 Resurfacing, Miller Pedestrian Overpass to Kapiolani Interchange project.

The meeting was conducted virtually via Microsoft Teams at 9:00 am.

All attendees were notified of the following:

- Scope of work consists of resurfacing, repair and reconstruction of weakened pavement, upgrading of existing guardrails, pavement marking and signage, freeway lighting upgrades, landscaping and other site improvements.
- Please refer to Special Provisions Section 102 for bid security amounts to be submitted.
- The bid opening date is still set for January 31, 2025 at 2:00pm.
- Please submit all RFIs via HlePRO by January 17, 2025 at 2:00pm.
- Submit all required DBE forms by February 5, 2025 at 4:30pm. Failure to submit these documents will be cause for bid/proposal rejection.

Attendance List:     HDOT  
                          SSFM  
                          OCR  
                          Grace Pacific  
                          Jas W. Glover

The meeting ended at 9:25 am.

All items discussed at this meeting are for clarification only. The bid documents shall govern over anything said at the meeting and discrepancies shall be clarified in Addendum No. 1.



**Questions for solicitation: B25001289**  
**INTERSTATE ROUTE H-1 RESURFACING,**  
**MILLER PEDESTRIAN OVERPASS TO KAPIOLANI INTERCHANGE**  
**DISTRICT OF HONOLULU**  
**ISLAND OF OAHU**

**FEDERAL-AID PROJECT NO. NH-H1-1(279)R**

**2/5/2025**

**1. Will there be an opportunity to propose equivalent substitutions to the roadway LED luminaires listed?**

Response: Equivalent substitutions need to be compatible with the current lighting system and can be proposed after bid award.

**2. Request for additional line item for sign and post removal?**

Response: Line item existed but has been updated and split between single post and double posts.

**3. Item: 606.1500 HSS 8x8x3/16 Block Replacement - 35 LF would you provide more detailed drawing for clarity?**

Response: Elevation view, section view, and dimensions added for this Hollow Steel Tube

**4. Item: 606.2200 Retro-Rail System - 116 LF would you provide more detailed drawing for clarification.**

Response: Retro-Rail System is a proprietary product; please check with manufacturer for product information.

**5. Request for additional line item solely for the implementation of the street name signs found on M35?**

Response: These are destinations signs paid for under Item 630.

**6. Please check the PROPOSAL SCHEDULE....Item numbers 507.0100, 507.0200, and 638.0100 already have unit price \$ amounts. Should these unit prices on the schedule be left blank so that the bidders can enter their own unit prices?**

Response: Removed unit price for these line items in the Proposal Schedule.

**7. Reference Drawing ET-19, shows a Solar Pole that's Embedded into the Concrete Foundation. Prior EVC Counting Station Sites with Solar have used a Solar Pole with Base Plate and Anchor Bolts so that it can be replaced in case of a Knock Down. Can we provide a Solar Pole with Base Plate and Anchor Bolts, or must we provide a Solar Pole with Embedded Base?**

Response: Breakaway posts to be used at Lunalilo On-Ramp (TC4), On Ramp U-1 (TC11), in between On-Ramp U-6 and Off-Ramp U-5 (TC12) and Eastbound Old Waialae On-Ramp (TC14). All others shall follow detail.

**8. Request for additional information/details on sheet no R39 of 68 (page 102) - Stiffened MGS Half Post Spacing. Please provide a detailed drawing of the the HSS 8x8x3/16 Block and the Backup Rail Sleeve.**

Response: Elevation view, section view, and dimensions added for this Hollow Steel Tube

**9. Request for additional information/details on sheet no R55 of 68 (page 118) - Retro Rail System. Please provide more details on the cable, length, etc and the brackets.**

Response: Retro-Rail System is a proprietary product; please check with manufacturer for product information.

**10. Item 607.0100 6-Foot Chain Link Fence, without Toprail - can you please confirm if this is being spliced in or at a terminal?**

Response: The whole length of the existing fence, including posts, will be removed. A new chain-link fence will be installed. Therefore, there is no need to splice fence fabric.

**11. • Due to Size of the project, DBE participation requirements, and scheduling conflicts with other agencies' bid dates, we request to extend bid due date for at least 3 week from current bid date. This will encourage more DBE contractors to participate in the bid and allow all bidders to prepare competitive pricing and government will receive best value.**

Response: Bid date was extended in previous Addendum No. 1.

**12. Drawing Sheet No. M16 (page 190) indicates Yield Markings (detail on Sheet No. M1, page 175) on University Ave. On-Ramp "U-1" and University Ave. Off-Ramp "U-3" which are not reflected in the bid proposal. Please provide the bid item number for these items.**

Response: A line item was added for quantity and cost of new Yield Line Markings.

**13. Drawing Sheet No. M21 (Page 195) indicates Bike Crossing Markings and Bike Lane Markings at the intersection of Pensacola Street and Lunalilo Street which are not reflected in the bid proposal. Please provide the bid item number for these items.**

Response: White bike lane markings have been accounted for on 629.06 Single 6-inch White Pavement Striping Pay Item. A separate line item was added for the Bike Symbol. A line item was also added for the quantity and cost of new Yellow Bike Lane Striping and Bike Lane Crossing (Green).

**14. Some of the Typical Sections on Plan Sheet 38 to 50 do not match the hatching description on the roadway plans. For example, hatching on Sheet 67 for WB Lunalilo St On-Ramp at H-1 BL Sta. 200+00 does not match typical section on Sheet 38. Hatching on Sheet 85 for Lunalilo St Sta. 9+00 to 10+00 does not match typical section on Sheet 43. WB University Off-Ramp U-5 Sta. 10+70 to 10+87 is not hatched on Sheet 77 compared to the detail note on Sheet 41. Please clarify if the Roadway Plans on Sheet 64 to 89 should be followed when there are discrepancies between the Roadway Plans and Typical Sections.**

Response: See revised plans.

**15. Please clarify Note 1 on Drawing TC2 regarding the pavement section. Note states "except on Eastbound lanes 5 and 6," please clarify if the intent is for the Westbound Vineyard Off-Ramp Lanes 5 and 6 to use pavement section "2 inch Mix No. IV with PG 64E-22 over 6 inch HMAB."**

Response: Yes. Eastbound lanes 5 and 6 will follow Typical Ramp Pavement Section indicated in Note 1 on Sheet TC3. Note 1 was revised on Sheet TC2 to clarify.

**16. Please confirm if the "pavement sections" as described in Note 1 on Drawing TC1 to TC15 for the traffic counting stations will be paid for under the 203 series and 301 series to 415 series bid items.**

Response: The pavement sections are to be paid for under their respective sections

**17. If the traffic counting stations pavement sections are to be paid for under the 301 series to 415 series bid items, it seems that Bid Item 414.0200 approx. qty. might be low. There seems to be a layer of the GlassGrid 8511TF at the traffic counting stations that might not be accounted for in the approx. qty.**

Response: The quantity for 414.02 has been verified. There is GlassGrid shown on both roadway sheets and Traffic Counting Station sheets.

**18. If the traffic counting stations pavement sections are to be paid for under the 301 series to 415 series bid items, it seems that Bid Item 401.0200 approx. qty. might be high while Bid Item 401.0400 might be low. Please confirm approx. qty. for Bid Item 401.0200 and 401.0400 as there doesn't seem to be 405 Ton of "HMA Pavement, Mix No. IV" from the "resurfacing" and "pavt. recon" work.**

Response: The quantities for 401.0200 and 401.0400 have been verified. There is HMA Mix IV shown on roadway sheets, both 2" thickness and 1.5" thickness. There is Mix No. IV with PG 64E-22 shown on roadway sheets and Traffic Counting Station sheets.

**19. Please clarify which specific work as described on the plans will be paid for under Bid item 203.0100 Roadway Excavation.**

Response: Roadway excavation is for installation of the concrete transitions (e.g. Type KAT Transitions)