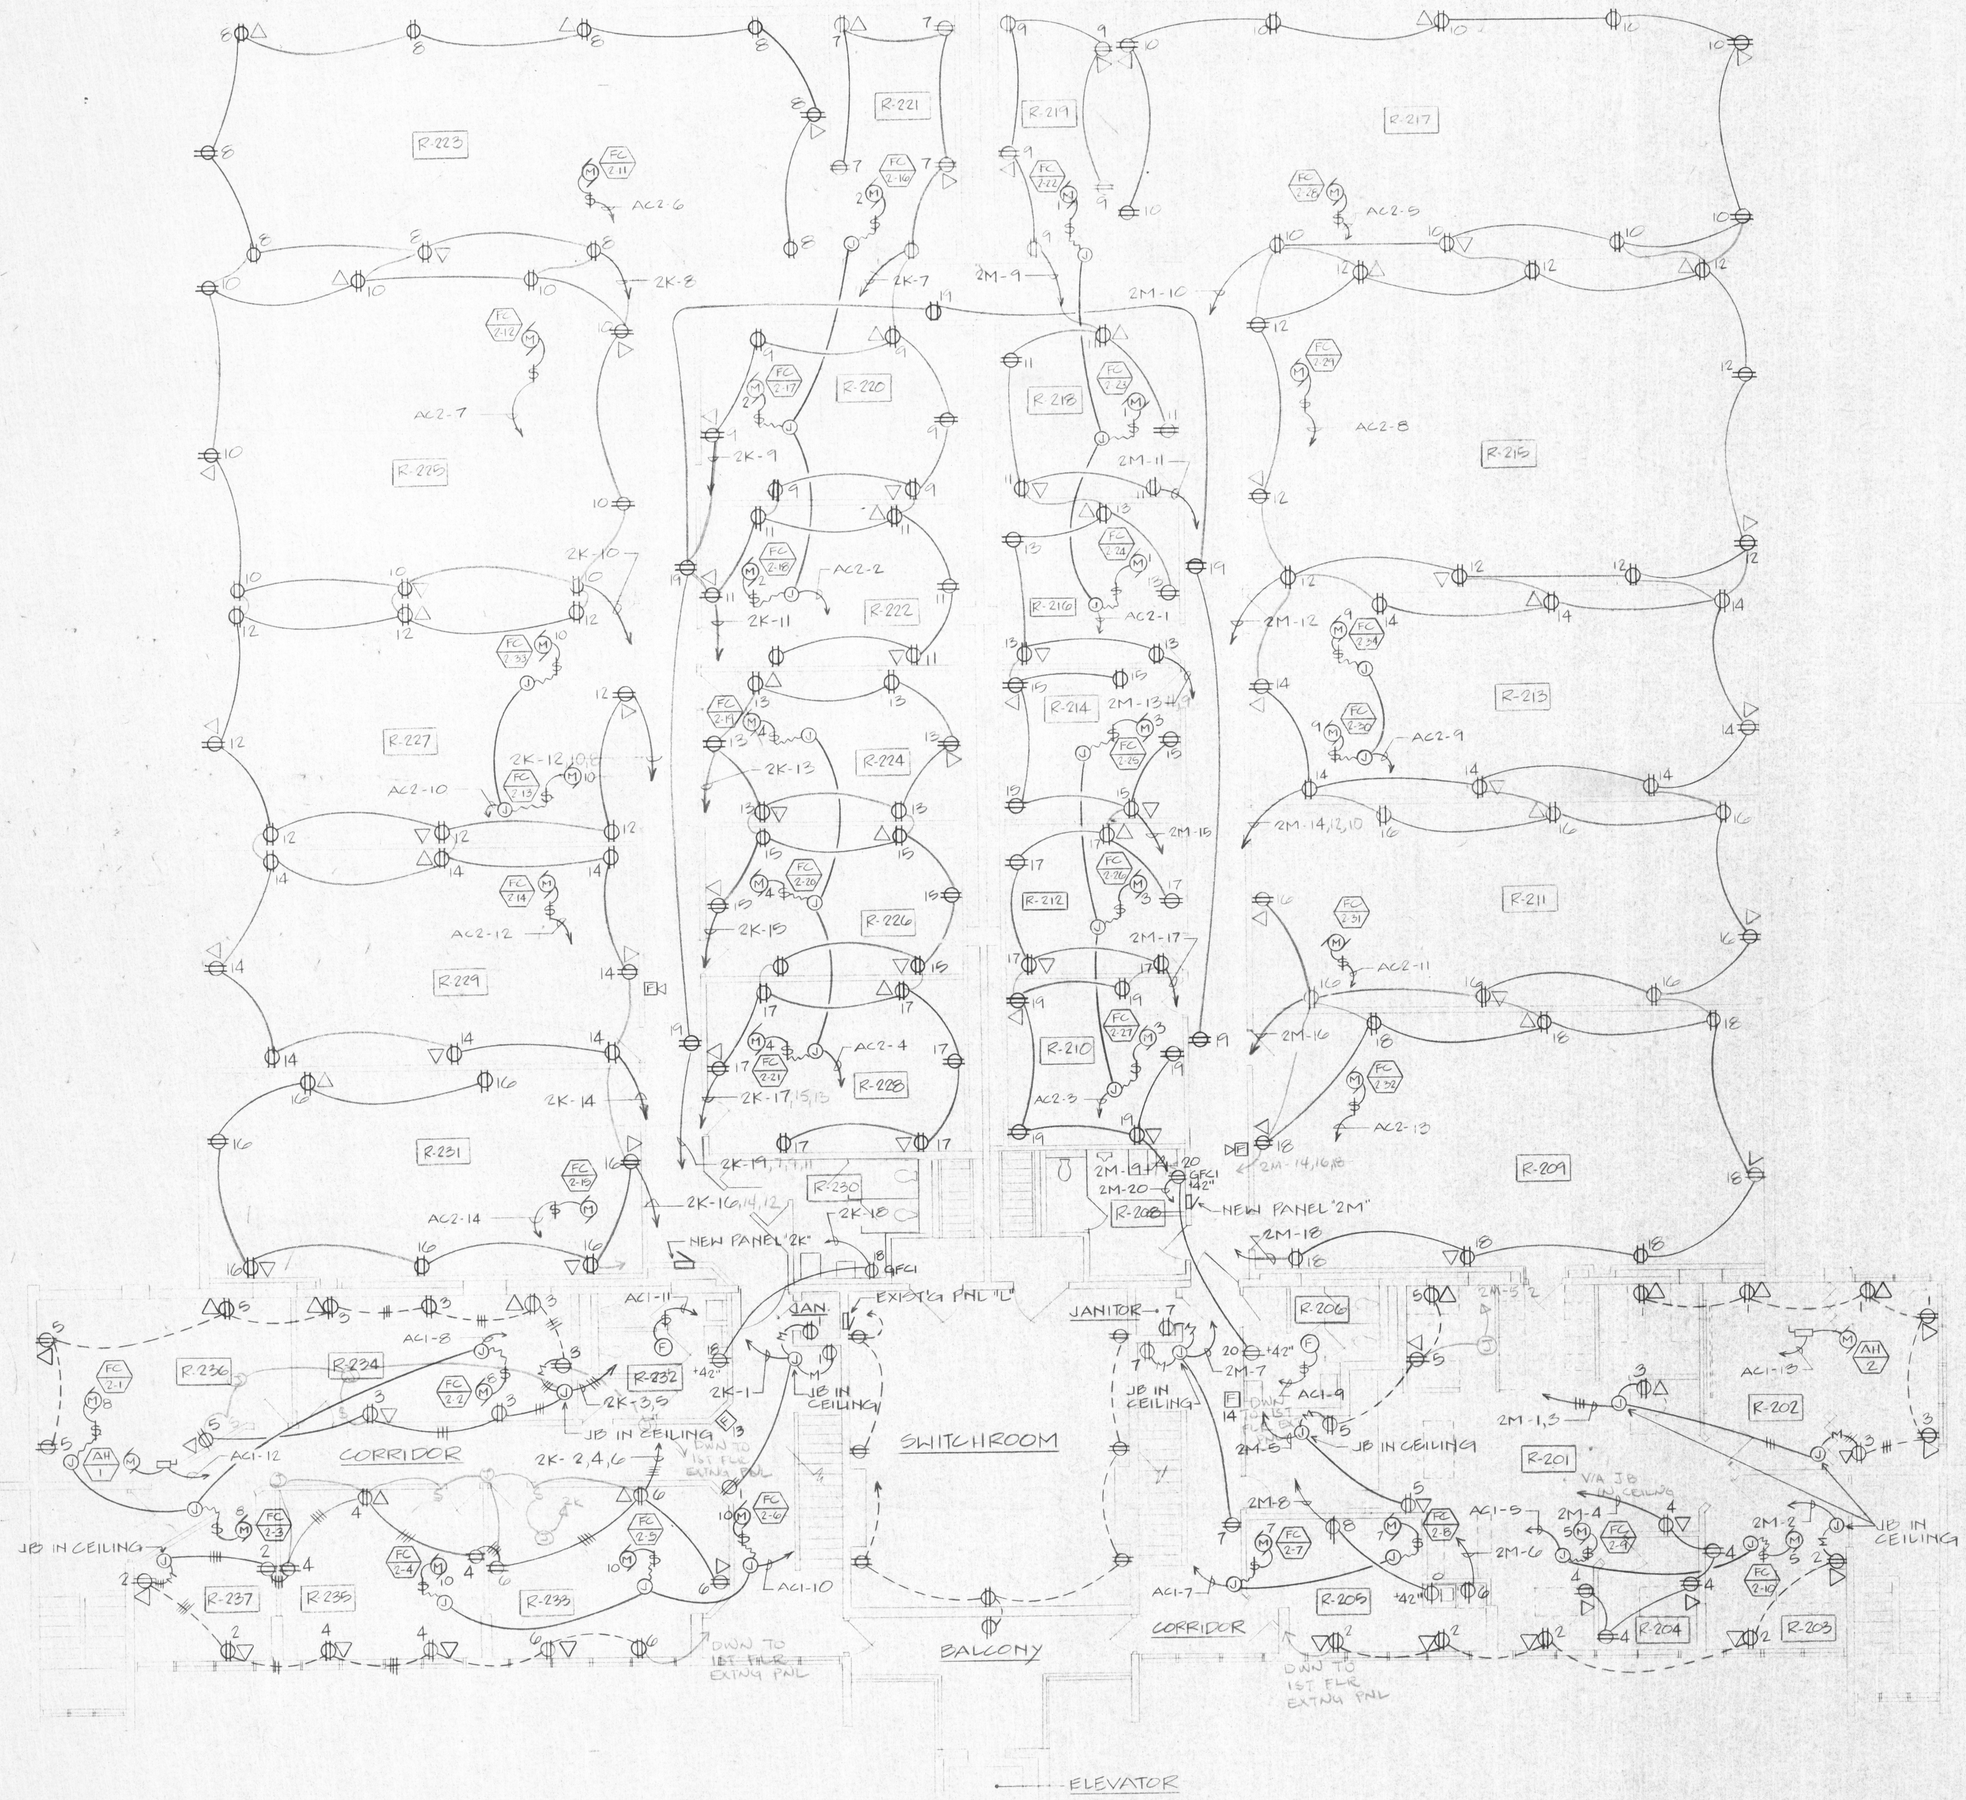

SECOND FLOOR POWER PLAN AT CENTER - WAIKIKI OF BUILDING NEW WORK

SCALE 1/8" = 1'-0"

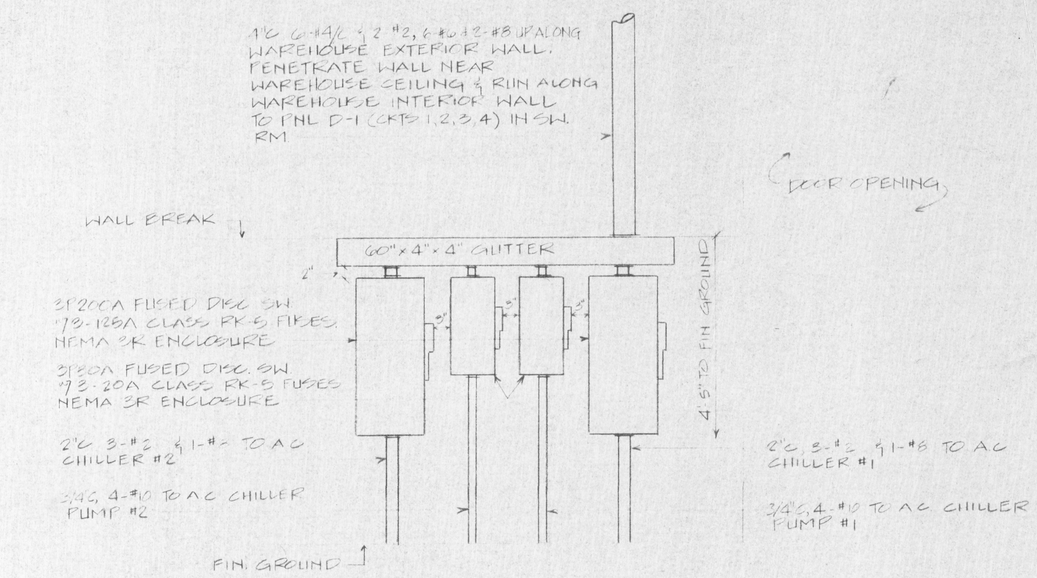

A.C. ELECTRICAL EQUIP. ELEVATION

E-4

NO SCALE

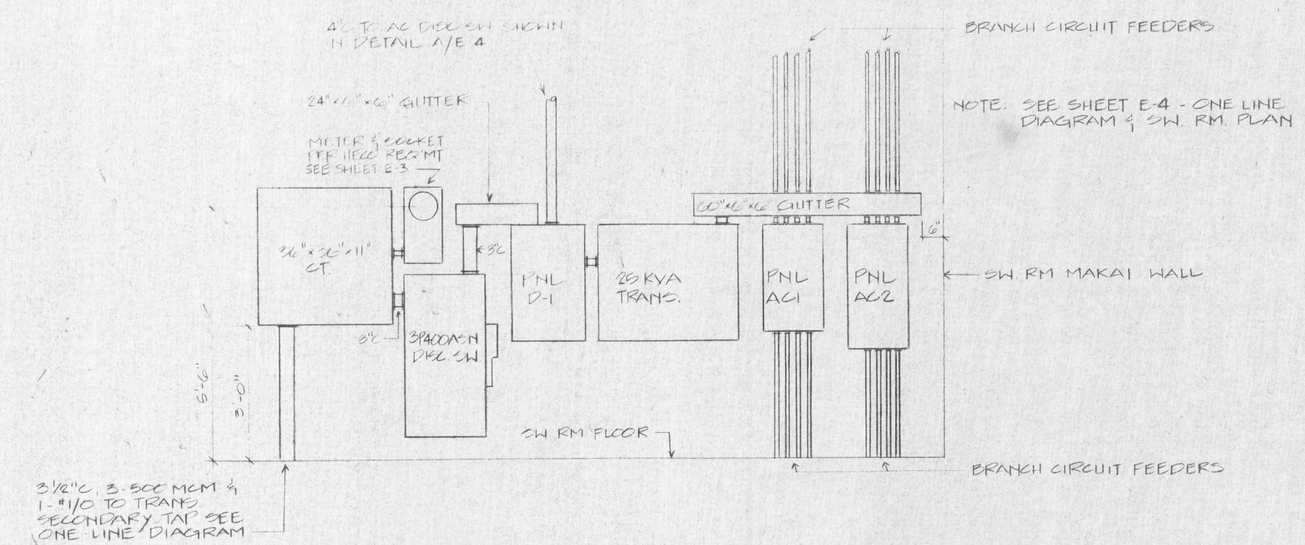

SWITCHROOM A.C. ELECTRICAL EQUIP. ELEVATION

B / E-4

NO SCALE

"AS BUILT" 11-20-80 NAKAI ELECTRIC C. Shingle

REVISION NO.	SYM.	DESCRIPTION	SHT. OF	DATE	APPROVED: STATE PUBLIC WORKS ENGINEER

DEPT. OF ACCOUNTING & GENERAL SERVICES
DIVISION OF PUBLIC WORKS
STATE OF HAWAII

FOREIGN TRADE ZONE NO. 9 - RENOVATION & ALTERATION OF PIER 2
STAGE ONE, HONOLULU, OAHU, HAWAII

SECOND FLOOR POWER PLAN.
A.C. DETAILS

CEDRIC CHONG & ASSOC.

DESIGNED BY: D.K.	CHECKED BY:	DAGS JOB NO. 02-26-2015	DRAWING NO. E-4
DRAWN BY: D.K.	APPROVED BY:	DATE	SHEET OF SHTS
SCALE: AS NOTED			

THIS WORK WAS PREPARED BY ME OR UNDER MY SUPERVISION
4/16/99

FILE E DRAWER 2 FOLDER 4