

ROOM NAME	ROOM NO.
MONITORING RM	3201
STAIR	3202
METAL ANAL	3203
AOR TOXICX ROOM	3204
MICROSCOPY	3205
AIR TOXICS RM 2	3206
AIR TOXICS RM	3207
OFF SEC SUP	3208
OFF SEC SUP	3209
CORRIDOR	3210
CORRIDOR	3211
TRAINING LAB	3212
BALANCE RM	3213
PREP LAB	3214
CORRIDOR	3215
QA MEDICAL LAB	3216
CHEMISTRY LAB	3217
QA CHEMIST	3218
TRAINING COOR	3219
LIBRARY	3220
PREP LAB	3221
CORRIDOR	3222
CYLINDER	3223

GENERAL NOTES:

THE CONTRACTOR SHALL BE RESPONSIBLE FOR COORDINATING THE WORK OF ALL TRADES ON THE JOB. EACH TRADE SHALL HOWEVER, REVIEW AND COORDINATE THE CONTRACT PLANS AND SPECIFICATIONS AS NECESSARY WITH THE OTHER TRADES TO COMPLETE THE WORK AS INTENDED BY THE FINAL CONSTRUCTION DOCUMENTS.

SHOULD ANY DISCREPANCY IN THE PLANS OR SPECIFICATIONS BE DISCOVERED, THE GENERAL CONTRACTOR SHALL IMMEDIATELY NOTIFY THE ADMINISTERING PARTY (IE. DAGS INSPECTION BRANCH, ARCHITECT) BEFORE PROCEEDING WITH ANY FURTHER WORK. OTHERWISE, THE GENERAL CONTRACTOR AS WELL AS THE SUBCONTRACTOR WILL BE HELD RESPONSIBLE FOR ANY COST INVOLVED IN CORRECTION OF WORK PLACED DUE TO SUCH DISCREPANCY.

SEE LAB EQUIPMENT DRAWINGS FOR FUME HOOD AND BIO. SAFETY CABINET FINAL CONNECTIONS.

SEE LA7.1 FOR LABORATORY FUME HOODS BIOLOGICAL SAFETY CABINET & EQUIPMENT CONNECTION INFORMATION.

TERMINATE EXHAUST DUCT FOR LABORATORY FUME HOODS & BIOLOGICAL SAFETY CABINETS AT 8'-6" ABOVE FINISHED FLOOR.

ROOM 3203 (AS21) PROVIDE EXPOXY PAINT FOR ALL SUPPLY DIFFUSER & RETURN GRILLES.

0 2 4 8 16

A / M43.2 **PARTIAL HVAC FLOOR PLAN LEVEL 3 SECTOR 2**
SCALE: 1/4" = 1'-0"

REVISION NO.	SYM.	DESCRIPTION	SHT..... OF.....	DATE	APPROVED: STATE PUBLIC WORKS ENGINEER
FCD 1T	1T	REVISED DUCTWORK	15 19	6/10/93	
ADD 6	2	ADDED DUCT STATIC PRESSURE SENSOR	97 105	5-22-92	
ADD 3	3	RELOCATED VVRD-46 & 12"ø TAP	52 72	5-8-92	

JAMES K. TSUGAWA REGISTERED PROFESSIONAL ENGINEER No. 5189-M HAWAII, U.S.A.

This work was prepared by me or under my supervision and construction of this project will be under my supervision. Services as defined in 16-82-2 of the Rules and Regulations of the Board of Professional Engineers, Architects and Surveyors of the State of Hawaii.

Signature Date

DEPT. OF ACCOUNTING & GENERAL SERVICES
DIVISION OF PUBLIC WORKS
STATE OF HAWAII


HAWAII STATE DEPARTMENT OF HEALTH
LABORATORY FACILITY
HONOLULU, HAWAII

PARTIAL HVAC FLOOR PLAN
LEVEL 3, SECTOR 2

JAMES K. TSUGAWA AIA & ASSOC.		DAGS JOB NO.	DRAWING NO.
DESIGNED BY: WC	CHECKED BY: TC	12-20-2561	M43.2
DRAWN BY: JI	APPROVED BY: BSN	DATE 30 MAR 92	SHEET 321 OF 405 SHTS
SCALE: 1/4" = 1'-0"			

SLD ADMIN 27-006

Exhibit 3 AS-BUILT DRAWINGS KAMA'ULE'ULE BUILDING

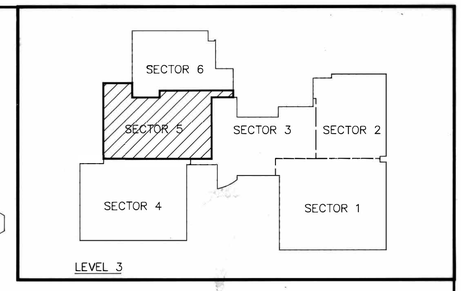

ROOM NAME	ROOM NO.
TOILET	3501
GROUNDWATER LAB 1	3502
GROUNDWATER LAB 2	3503
STOR	3504
STOR	3505
CORRIDOR	3506
CORRIDOR	3507
CYLINDER	3508
CORRIDOR	3509
GC ROOM	3510
OFF	3511
OFF	3512
STAFF OFFICE	3513
CYLINDER	3514
STAFF	3515
STAFF	3516
CORRIDOR	3517
JANITOR	3518
STORAGE (F) ELEV	3519
OFFICE	3520
CORRIDOR	3521
CORRIDOR	3522
CYLINDER	3523
CORRIDOR	3524
TOILET	3525
AFLATOXIN LAB	3526
GC ROOM	3527
EXTRACTION LAB	3528
GC ROOM	3529
CYLINDER	3530
CORRIDOR	3531
CORRIDOR	3532

GENERAL NOTES:

THE CONTRACTOR SHALL BE RESPONSIBLE FOR COORDINATING THE WORK OF ALL TRADES ON THE JOB. EACH TRADE SHALL HOWEVER, REVIEW AND COORDINATE THE CONTRACT PLANS AND SPECIFICATIONS AS NECESSARY WITH THE OTHER TRADES TO COMPLETE THE WORK AS INTENDED BY THE FINAL CONSTRUCTION DOCUMENTS.

SHOULD ANY DISCREPANCY IN THE PLANS OR SPECIFICATIONS BE DISCOVERED, THE GENERAL CONTRACTOR SHALL IMMEDIATELY NOTIFY THE ADMINISTERING PARTY (IE. DAGS INSPECTION BRANCH, ARCHITECT) BEFORE PROCEEDING WITH ANY FURTHER WORK. OTHERWISE, THE GENERAL CONTRACTOR AS WELL AS THE SUBCONTRACTOR WILL BE HELD RESPONSIBLE FOR ANY COST INVOLVED IN CORRECTION OF WORK PLACED DUE TO SUCH DISCREPANCY.

SEE LAB EQUIPMENT DRAWINGS FOR FUME HOOD AND BIO. SAFETY CABINET FINAL CONNECTIONS.

SEE LA7.1 FOR LABORATORY FUME HOODS BIOLOGICAL SAFETY CABINET & EQUIPMENT CONNECTION INFORMATION.

TERMINATE EXHAUST DUCT FOR LABORATORY FUME HOODS & BIOLOGICAL SAFETY CABINETS AT 8'-6" ABOVE FINISHED FLOOR.

REVISION NO.	SYM.	DESCRIPTION	SHT..... OF.....	DATE	APPROVED: STATE PUBLIC WORKS ENGINEER
PCD IT	17	REVISED DUCTWORK	18 19	6/10/93	
ADD 6	16	ADDED DUCT STATIC PRESSURE SENSOR	100 185	8-26-92	

DEPT. OF ACCOUNTING & GENERAL SERVICES
DIVISION OF PUBLIC WORKS
STATE OF HAWAII

HAWAII STATE DEPARTMENT OF HEALTH
LABORATORY FACILITY
HONOLULU, HAWAII

PARTIAL HVAC FLOOR PLAN
LEVEL 3, SECTOR 5

BENJAMIN S. NOTKIN REGISTERED PROFESSIONAL ENGINEER No. 5189-M HAWAII, U.S.A.

This work was prepared by me or under my supervision and construction of this project will be under my supervision. Supervision as defined in 16-82-2 of the Rules and Regulations of the Board of Professional Engineers, Architects and Surveyors of the State of Hawaii.


Signature Date

JAMES K. TSUGAWA AIA & ASSOC.		DAGS JOB NO.	DRAWING NO.
DESIGNED BY: WC	CHECKED BY: TC	12-20-2561	M43.5
DRAWN BY: JI	APPROVED BY: BSN	DATE 30 MAR 92	SHEET 324 OF 465 SHTS
SCALE: 1/4" = 1'-0"			

A / M43.5 **PARTIAL HVAC FLOOR PLAN LEVEL 3 SECTOR 5**
SCALE: 1/4" = 1'-0"

SLD ADMIN 27-006

Exhibit 3 AS-BUILT DRAWINGS KAMA'ULE'ULE BUILDING

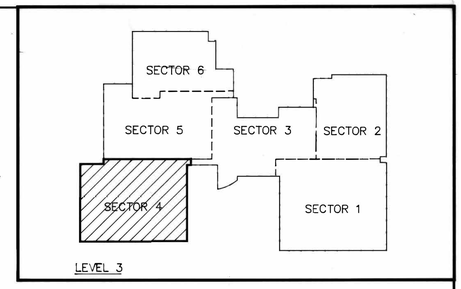

ROOM NAMES	ROOM NO.
CONFERENCE	3401
PURGE/TRAP/INST	3402
WORK ROOM	3403
CYLINER	3404
PURGE/TRAP INST	3405
INST RM V	3406
INST RM IV	3407
GLASSWASH	3408
CORRIDOR	3409
STOR	3410
CORRIDOR	3411
STOR	3412
CYLINDER	3413
INST RM I	3414
TRACE METALS LAB	3415
VEST	3416
AA INST	3417
INST RM III	3418
STOCK ROOM	3419
SUPPLIES STOR	3420
QA LAB	3421
INSTRUMENT ROOM	3422
COMPUTER ROOM	3423
COMPUTER OFFICE	3424
GC/MS	3425
CYLINDER	3426
COMM	3427
ELEC	3428
CORRIDOR	3429
CORRIDOR	3430
STAIR	3431
RC PREP LAB	3432
RC INST LAB	3433
HPLC	3434
INST RM II	3435
CYLINDERD	3436
GC ROOM	3437
CORRIDOR	3438
CORRIDOR	3439

GENERAL NOTES:

THE CONTRACTOR SHALL BE RESPONSIBLE FOR COORDINATING THE WORK OF ALL TRADES ON THE JOB. EACH TRADE SHALL HOWEVER, REVIEW AND COORDINATE THE CONTRACT PLANS AND SPECIFICATIONS AS NECESSARY WITH THE OTHER TRADES TO COMPLETE THE WORK AS INTENDED BY THE FINAL CONSTRUCTION DOCUMENTS.


SHOULD ANY DISCREPANCY IN THE PLANS OR SPECIFICATIONS BE DISCOVERED, THE GENERAL CONTRACTOR SHALL IMMEDIATELY NOTIFY THE ADMINISTERING PARTY (IE. DAGS INSPECTION BRANCH, ARCHITECT) BEFORE PROCEEDING WITH ANY FURTHER WORK. OTHERWISE, THE GENERAL CONTRACTOR AS WELL AS THE SUBCONTRACTOR WILL BE HELD RESPONSIBLE FOR ANY COST INVOLVED IN CORRECTION OF WORK PLACED DUE TO SUCH DISCREPANCY.

SEE LAB EQUIPMENT DRAWINGS FOR FUME HOOD AND BIO. SAFETY CABINET FINAL CONNECTIONS.

SEE LA7.1 FOR LABORATORY FUME HOODS BIOLOGICAL SAFETY CABINET & EQUIPMENT CONNECTION INFORMATION.

TERMINATE EXHAUST DUCT FOR LABORATORY FUME HOODS & BIOLOGICAL SAFETY CABINETS AT 8'-6" ABOVE FINISHED FLOOR.

ROOM 3415 (C108) PROVIDE EXPOXY PAINT FOR RETURN AIR GRILLES.

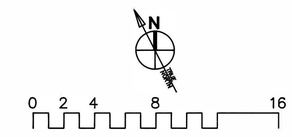

A / M43.4 **PARTIAL HVAC FLOOR PLAN LEVEL 3 SECTOR 4**

SCALE: 1/4" = 1'-0"

REVISION NO.	SYM.	DESCRIPTION	SHT. OF	DATE	APPROVED: STATE PUBLIC WORKS ENGINEER
PCD IT	17	REVISED DUCTWORK	17 19	6/10/93	
ADD 6	16	ROOM 3415 CHANGE "VVRB&VVEB" TO "CVRE & CVEC"	99 185	5-22-92	

BENJAMIN S. MOTKIN REGISTERED PROFESSIONAL ENGINEER No. 5189-M HAWAII, U.S.A.

This work was prepared by me or under my supervision and construction of this project will be under my supervision. Supervision is qualified in 16-82-2 of the Rules and Regulations of the Board of Professional Engineers, Architects and Surveyors of the State of Hawaii.

Signature Date

DEPT. OF ACCOUNTING & GENERAL SERVICES
DIVISION OF PUBLIC WORKS
STATE OF HAWAII

HAWAII STATE DEPARTMENT OF HEALTH
LABORATORY FACILITY
HONOLULU, HAWAII

PARTIAL HVAC FLOOR PLAN
LEVEL 3, SECTOR 4

JAMES K. TSUGAWA AIA & ASSOC.

DESIGNED BY:	CHECKED BY:	DAGS JOB NO.	DRAWING NO.
WC	TC	12-20-2561	M43.4
DRAWN BY: JI	APPROVED BY: BSN	DATE 30 MAR 92	SHEET 33 OF 365 SHTS

SCALE: 1/4" = 1'-0"

SYMBOLS FOR FLOOR PLANS

- WALL HUNG WATER CLOSET
- FLOOR MOUNTED WATER CLOSET
- WALL HUNG URINAL
- COUNTER TOP LAVATORY
- COUNTER TOP SINK
- WALL MOUNTED LAVATORY
- FLOOR MOUNTED SERVICE SINK
- WALL MOUNTED CLINIC SINK
- SHOWER
- FD — FLOOR DRAIN
- RD — ROOF DRAIN
- ROOF OVERFLOW DRAIN
- M.C. — MOVEABLE CART INTEGRAL WITH CASEWORK SYSTEM

DOORS–RELITES–LOUVERS

TYPICAL DOOR CONDITIONS

DOOR NUMBER IS SAME AS NUMBER OF ROOM SERVED

WHEN MORE THAN ONE DOOR, ADD SUFFIX (–1, –2, ETC.)

SHOW 90° SWING TYPICAL
SHOW 180° SWING IF REQUIRED

NEW DOOR IN EXISTING WALL

EXISTING DOOR IN EXISTING WALL

DELETE DOOR NUMBER WHEN NO WORK IS REQUIRED

REMOVE EXISTING DOOR BUILD NEW WALL

RELITES

R–A27

RELITE NUMBER IS SAME AS ROOM NUMBER WITH "R" PREFIX

LOUVER

L1O4

NUMBER CONSECUTIVELY

SYMBOLS FOR REFLECTED CEILING PLANS

- SUPPLY AIR DIFFUSER
- RETURN AIR OR EXHAUST GRILLE
- SLOT OR LINEAR DIFFUSER OF RETURN
- LIGHT FIXTURES
- SEE FIXTURE SCHEDULE FOR TYPE OF FIXTURE
- EXIT LIGHT
- ARROWS POINT TO EXIT
- S — SPEAKER
- D — SMOKE OF IONIZATION DETECTOR
- FIRE SPRINKLER
- SUSPENDED CEILLING GRID
- GYPSUM WALL BOARD OR PLASTER CEILING
- CT — CEILING TRACKS
  CT–CURTAIN TRACK
  CCT–CUBICLE CURTAIN TRACK
  IV–IV TRACK
  LT–LIGHT TRACK
- AP — ACCESS PANEL
- TELEPHONE

SYMBOLS

- PARTITION TYPE INDICATOR
- SEE PARTITION SCHEDULE

SCHEDULE INDICATORS

- W7 — WINDOW SCHEDULE
- L3 — LOUVER SCHEDULE
- P7 — PANEL SCHEDULE
- DOOR No. 3171 / LEVEL No. 3 — DOOR SCHEDULE
- DATUM OR BENCH MARK
- WORK POINT FLOOR ELEVATION
- MATCH LINE
  SHEET NUMBER OF ADJACENT DRAWING
- N — NORTH ARROW

BUILDING SECTION
A / A3.1 — LETTER IDENTIFICATION, SHEET NUMBER

BUILDING ELEVATION
B / A3.2 — LETTER IDENTIFICATION, SHEET NUMBER

WALL SECTION
3 / A3.5 — NUMBER IDENTIFICATION, SHEET NUMBER

DETAIL
LARGE SHEETS
37 / A3.5 — NUMBER IDENTIFICATION, SHEET NUMBER

DETAIL
BOOK SYSTEM
3.1 / 26.4 — CATEGORY 3 SUBDIVISION 1, PAGE NUMBER 26 DRAWING NUMBER 4

INTERIOR ELEVATIONS
KEY TO ELEVATIONS OF LABORATORY WORKBENCHES (1, 2, 3, 4)
KEY TO INTERIOR ELEVATIONS OF ROOMS (A, B, C, D)

DETAIL PLAN
3 / A5.2 — NUMBER IDENTIFICATION, SHEET NUMBER

KEY PLAN INDICATOR
A — LETTER DENOTES BUILDING SECTION OR ELEVATION

REVISION INDICATOR
1 — CLOUD AREA OF REVISION

GRID LINES
1, A

MATERIAL LEGEND

MISCELLANEOUS

SECTION VIEW		ELEVATION VIEW
	ACOUSTIC TILE	
	ROD & SEALANT	
	GLASS	

A / A0.2 — INDEX TO ARCHITECTURAL SYMBOLS — NOT TO SCALE

SYMBOLS FOR INTERIOR ELEVATIONS

- SERVICE OUTLETS
- SWITCHES
- DUPLEX RECEPTACLE
- SPECIAL RECEPTACLE
- T — WALL TYPE TELEPHONE OR INTERCOM
- TV — WALL JACKS
  T TELEPHONE
  TV TELEVISION
  CRT COMPUTER
- MA — GAS OUTLETS
  MA MEDICAL AIR
  VAC VACUUM
  VBS VACUUM BOTTLE SLIDE
  CO_2 CARBON DIOXIDE
  HE HELIUM
  N_2 NITROGEN
  N_2O NITROUS OXIDE
  LA LAB AIR
  G GAS
- STANDARD CLOCK
- ET — ELAPSED TIME CLOCK
- GRILL OR LOUVER
- AP — ACCESS PANEL
- DIRECTION OF AIRFLOW
- EMERGENCY SHOWER (OVERHEAD)
  EMERGENCY EYEWASH (IN WALL)
- FILE CABINET F.I.O.

MATERIAL LEGEND

FLOOR FINISHES

SECTION VIEW		PLAN VIEW
	CERAMIC TILE OR QUARRY TILE THIN SET ON CONCRETE FLOOR	
	CERAMIC TILE OR QUARRY TILE GROUT SET WITH MEMBRANE	
	RESILIENT FLOORING	
	CARPET	

WOOD/PLASTIC

SECTION VIEW		ELEVATION VIEW
	WOOD FRAMING	
	SHIM OR BLOCKING	
	FINISHED WOOD	
	PLYWOOD	
	PLAM ON PARTICLE BOARD	
	PLAM ON PLYWOOD	
	GLUE–LAMINATED SECTION	

INSULATION

SECTION VIEW		ELEVATION VIEW
	RIGID INSULATION	
	BATT OR BLANKET INSULATION	
	SPRAY ON FIREPROOFING	

MATERIAL LEGEND

EARTH/PAVEMENT

SECTION VIEW		ELEVATION VIEW
	EARTH (UNDISTURBED)	
	EARTH (FILL)	
	SAND FILL	
	CAPILLARY FILL	
	ASPHALTIC CONCRETE	

CONCRETE/MASONRY

SECTION VIEW		ELEVATION VIEW
	CONCRETE	
	CONCRETE MASONRY UNIT	
	BRICK	
	CERAMIC TILE QUARRY TILE	
	STONE	
	CLAY TILE	
	GROUT MORTAR	

WALL FINISHES

SECTION VIEW		ELEVATION VIEW
	METAL LATH & PLASTER OR STUCCO	
	GYPSUM WALL BOARD	
	VENEER PLASTER ON BASE BOARD	
	CERAMIC TILE THIN SET	
	CERAMIC TILE GROUT SET	

METAL

SECTION VIEW		ELEVATION VIEW
	STEEL (LARGE SCALE)	
	OTHER METAL (LARGE SCALE)	
I L C	METAL (SMALL SCALE)	
	HOLLOW METAL FRAME	
	METAL STUD	
	METAL FLASHING SHEET METAL	

GENERAL NOTE:
REFER TO CONSULTANTS DRAWINGS FOR ADDITIONAL SYMBOL DESIGNATIONS

Exhibit 3 AS-BUILT DRAWINGS KAMA'ULE'ULE BUILDING

SLD ADMIN 27-006

REVISION NO.	SYM.	DESCRIPTION	SHT. OF	DATE	APPROVED: STATE PUBLIC WORKS ENGINEER

JAMES K. TSUGAWA REGISTERED PROFESSIONAL ARCHITECT No. 5094 HAWAII, U.S.A.

DEPT. OF ACCOUNTING & GENERAL SERVICES
DIVISION OF PUBLIC WORKS
STATE OF HAWAII

HAWAII STATE DEPARTMENT OF HEALTH LABORATORY FACILITY
HONOLULU, HAWAII


INDEX TO ARCHITECTURAL DRAWINGS


James K. Fogan

JAMES K. TSUGAWA AIA & ASSOC.		DAGS JOB NO.	DRAWING NO.
DESIGNED BY: DSK	CHECKED BY: DSK	12-20-2561	A0.2
DRAWN BY: DSK	APPROVED BY: DSK	DATE 30 MAR 92	SHEET 13 OF 44 SHTS
SCALE: 1/4" = 1'-0"			


SLD ADMIN 27-006

Exhibit 3 AS-BUILT DRAWINGS KAMA'ULE'ULE BUILDING

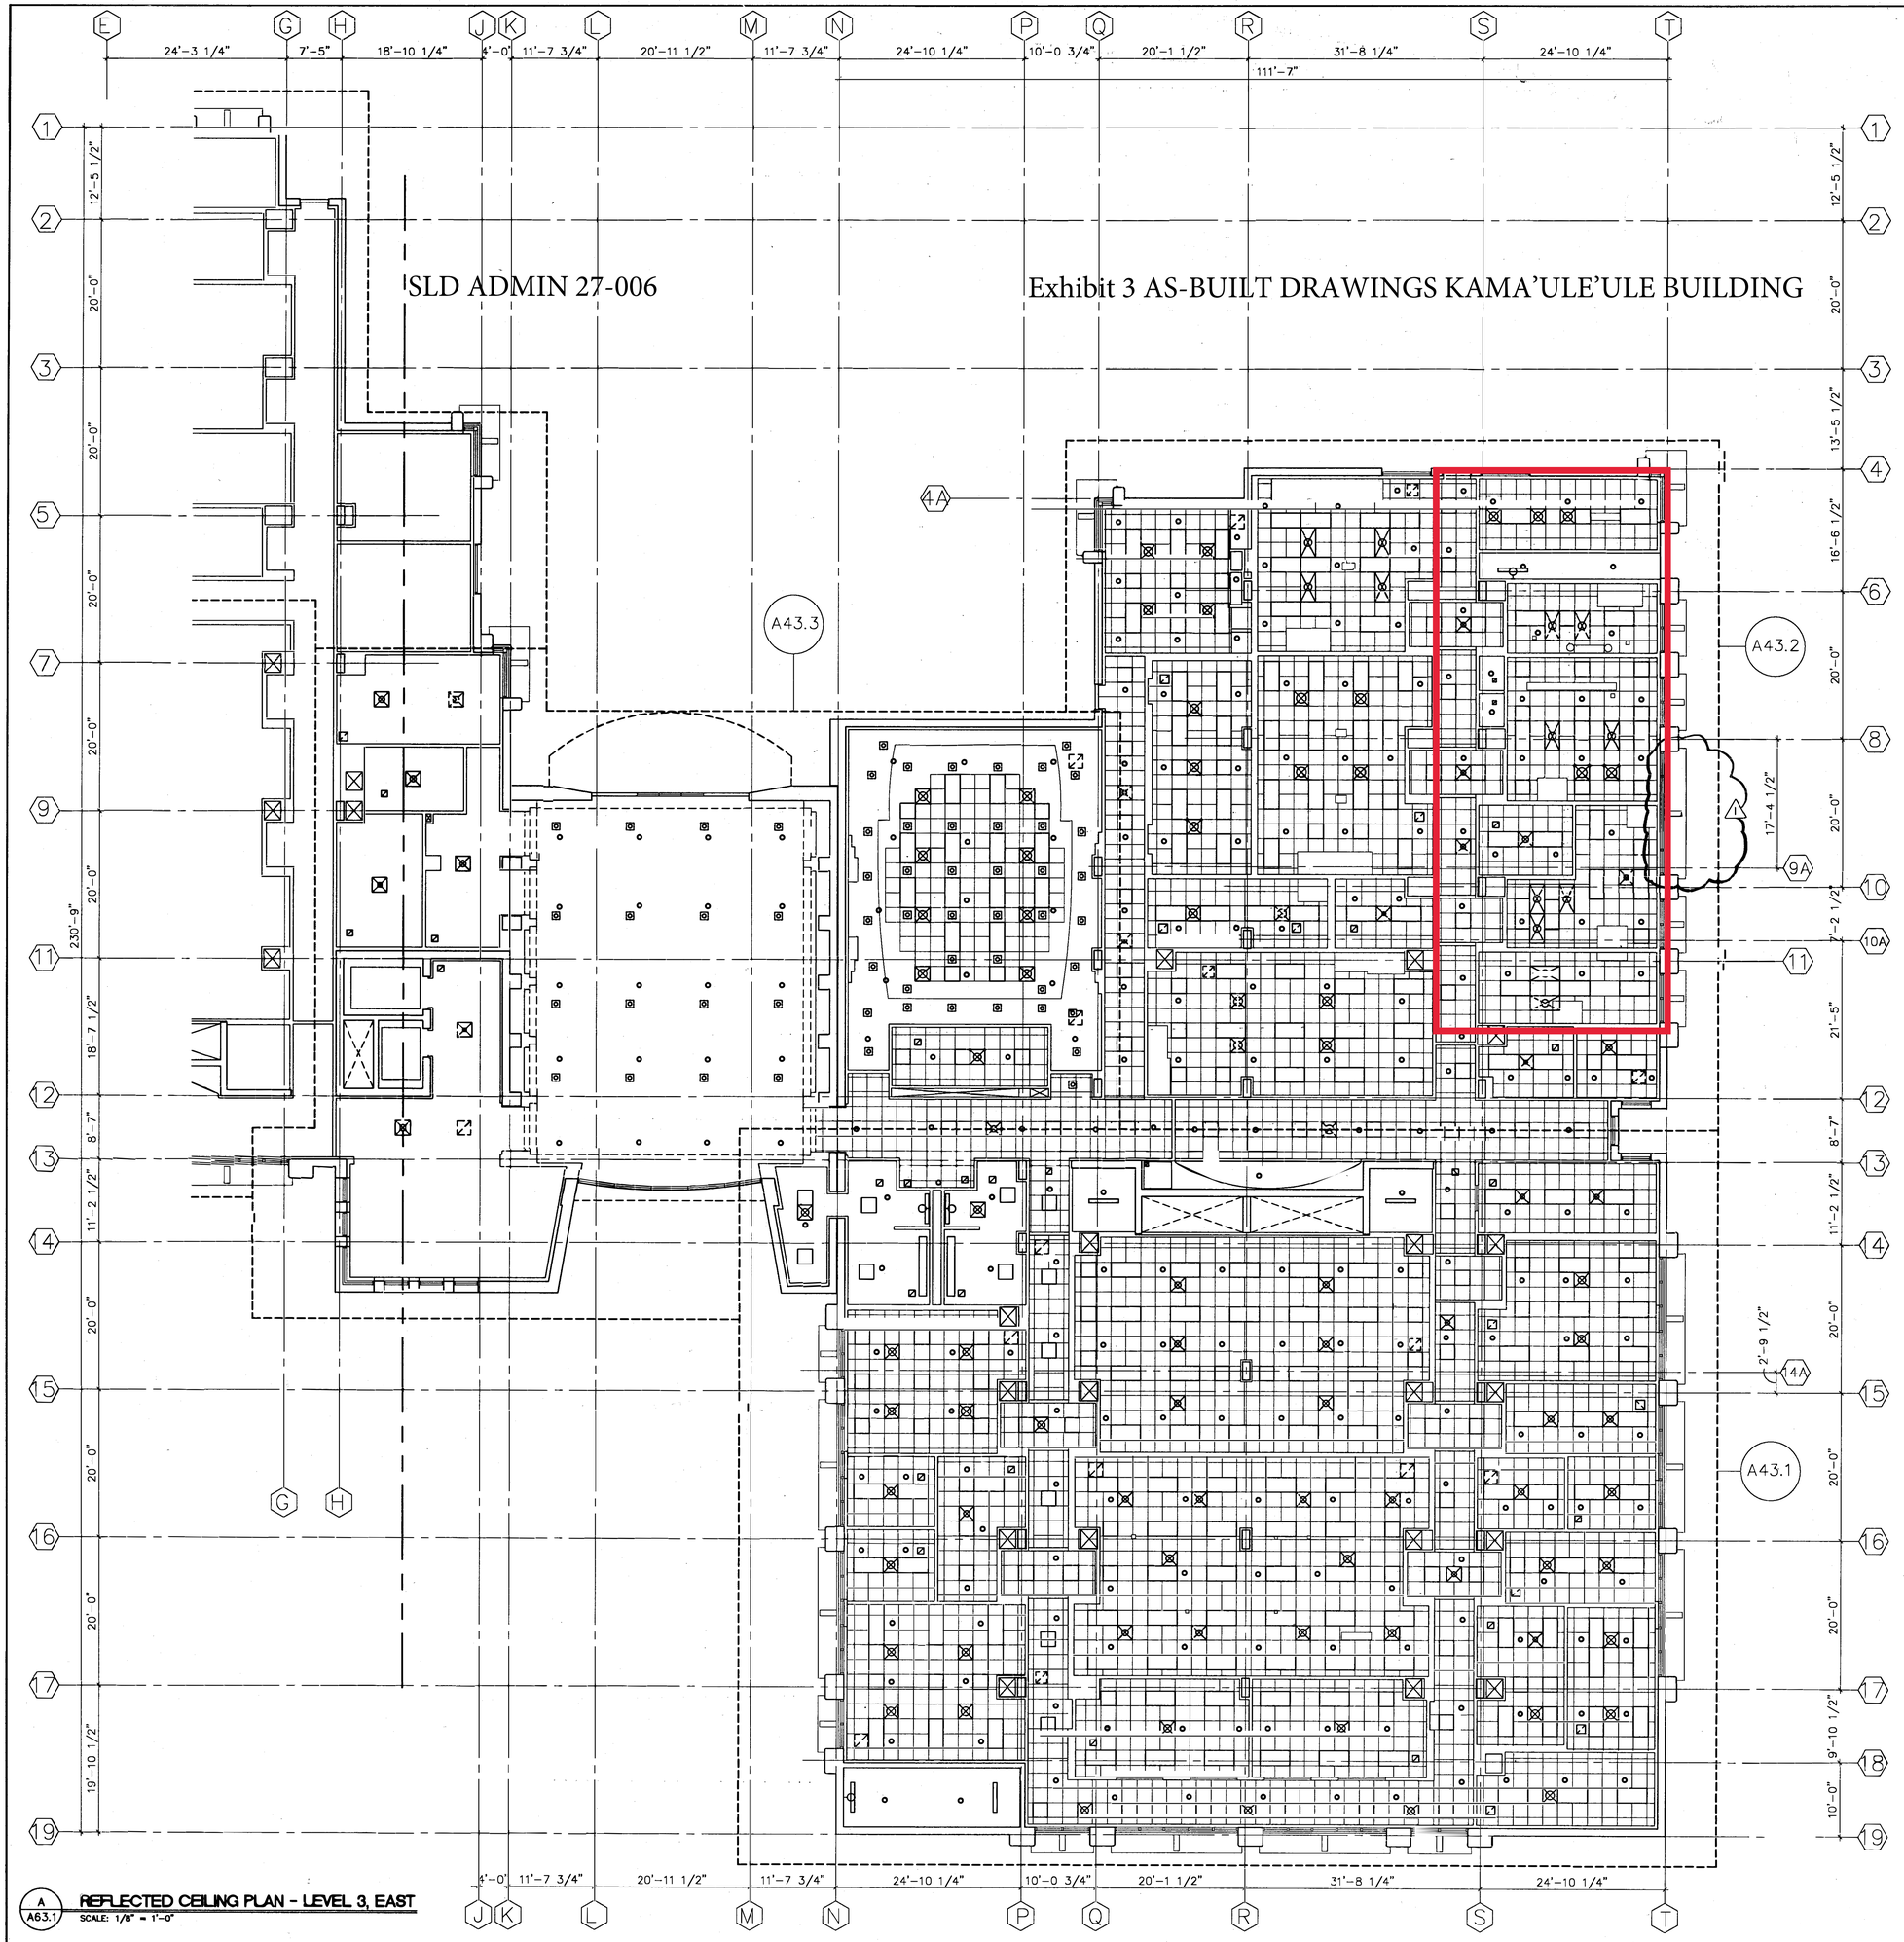

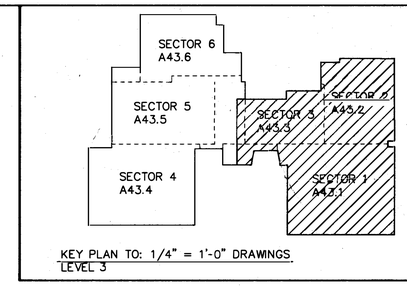

KEY PLAN TO: 1/4" = 1'-0" DRAWINGS
LEVEL 3

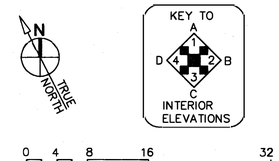

GENERAL NOTES

- 24"X24" SUPPLY DIFFUSER
- 24"X48" SUPPLY DIFFUSER
- 24"X24" RETURN GRILLE

REFER TO A62.2

GENERAL NOTES

THE CONTRACTOR SHALL BE RESPONSIBLE FOR COORDINATING THE WORK OF ALL TRADES ON THE JOB. EACH TRADE SHALL HOWEVER, REVIEW AND COORDINATE THE CONTRACT PLANS AND SPECIFICATIONS AS NECESSARY WITH THE OTHER TRADES TO COMPLETE THE WORK AS INTENDED BY THE FINAL CONSTRUCTION DOCUMENTS.

SHOULD ANY DISCREPANCY IN THE PLANS OR SPECIFICATIONS BE DISCOVERED, THE GENERAL CONTRACTOR SHALL IMMEDIATELY NOTIFY THE ADMINISTERING PARTY (IE DAGS INSPECTION BRANCH, ARCHITECT) BEFORE PROCEEDING WITH ANY FURTHER WORK. OTHERWISE, THE GENERAL CONTRACTOR AS WELL AS THE SUBCONTRACTOR WILL BE HELD RESPONSIBLE FOR ANY COST INVOLVED IN CORRECTION OF WORK PLACED DUE TO SUCH DISCREPANCY.

A / A63.1 REFLECTED CEILING PLAN - LEVEL 3, EAST
SCALE: 1/8" = 1'-0"

REVISION NO.	SYM.	DESCRIPTION	SHT. OF	DATE	APPROVED: STATE PUBLIC WORKS ENGINEER
PCD 1	1	ADDENDA INCORPORATION DRAWING CLARIFICATION	115 279	10AUG92	

DEPT. OF ACCOUNTING & GENERAL SERVICES
DIVISION OF PUBLIC WORKS
STATE OF HAWAII


HAWAII STATE DEPARTMENT OF HEALTH
LABORATORY FACILITY
HONOLULU, HAWAII


PARTIAL REFLECTED CEILING PLAN
LEVEL 3 - EAST

JAMES K. TSUGAWA AIA & ASSOC.

JAMES K. TSUGAWA REGISTERED PROFESSIONAL ARCHITECT No. 5094 HAWAII, U.S.A.


DESIGNED BY:	CHECKED BY:	DAGS JOB NO.	DRAWING NO.
D.K.	D.K.	12-20-2561	A63.1
DRAWN BY: K.C.	APPROVED BY: J.K.T.	DATE 30 MAR 92	SHEET 134 OF 465 SHTS
SCALE: 1/8" = 1'-0"			

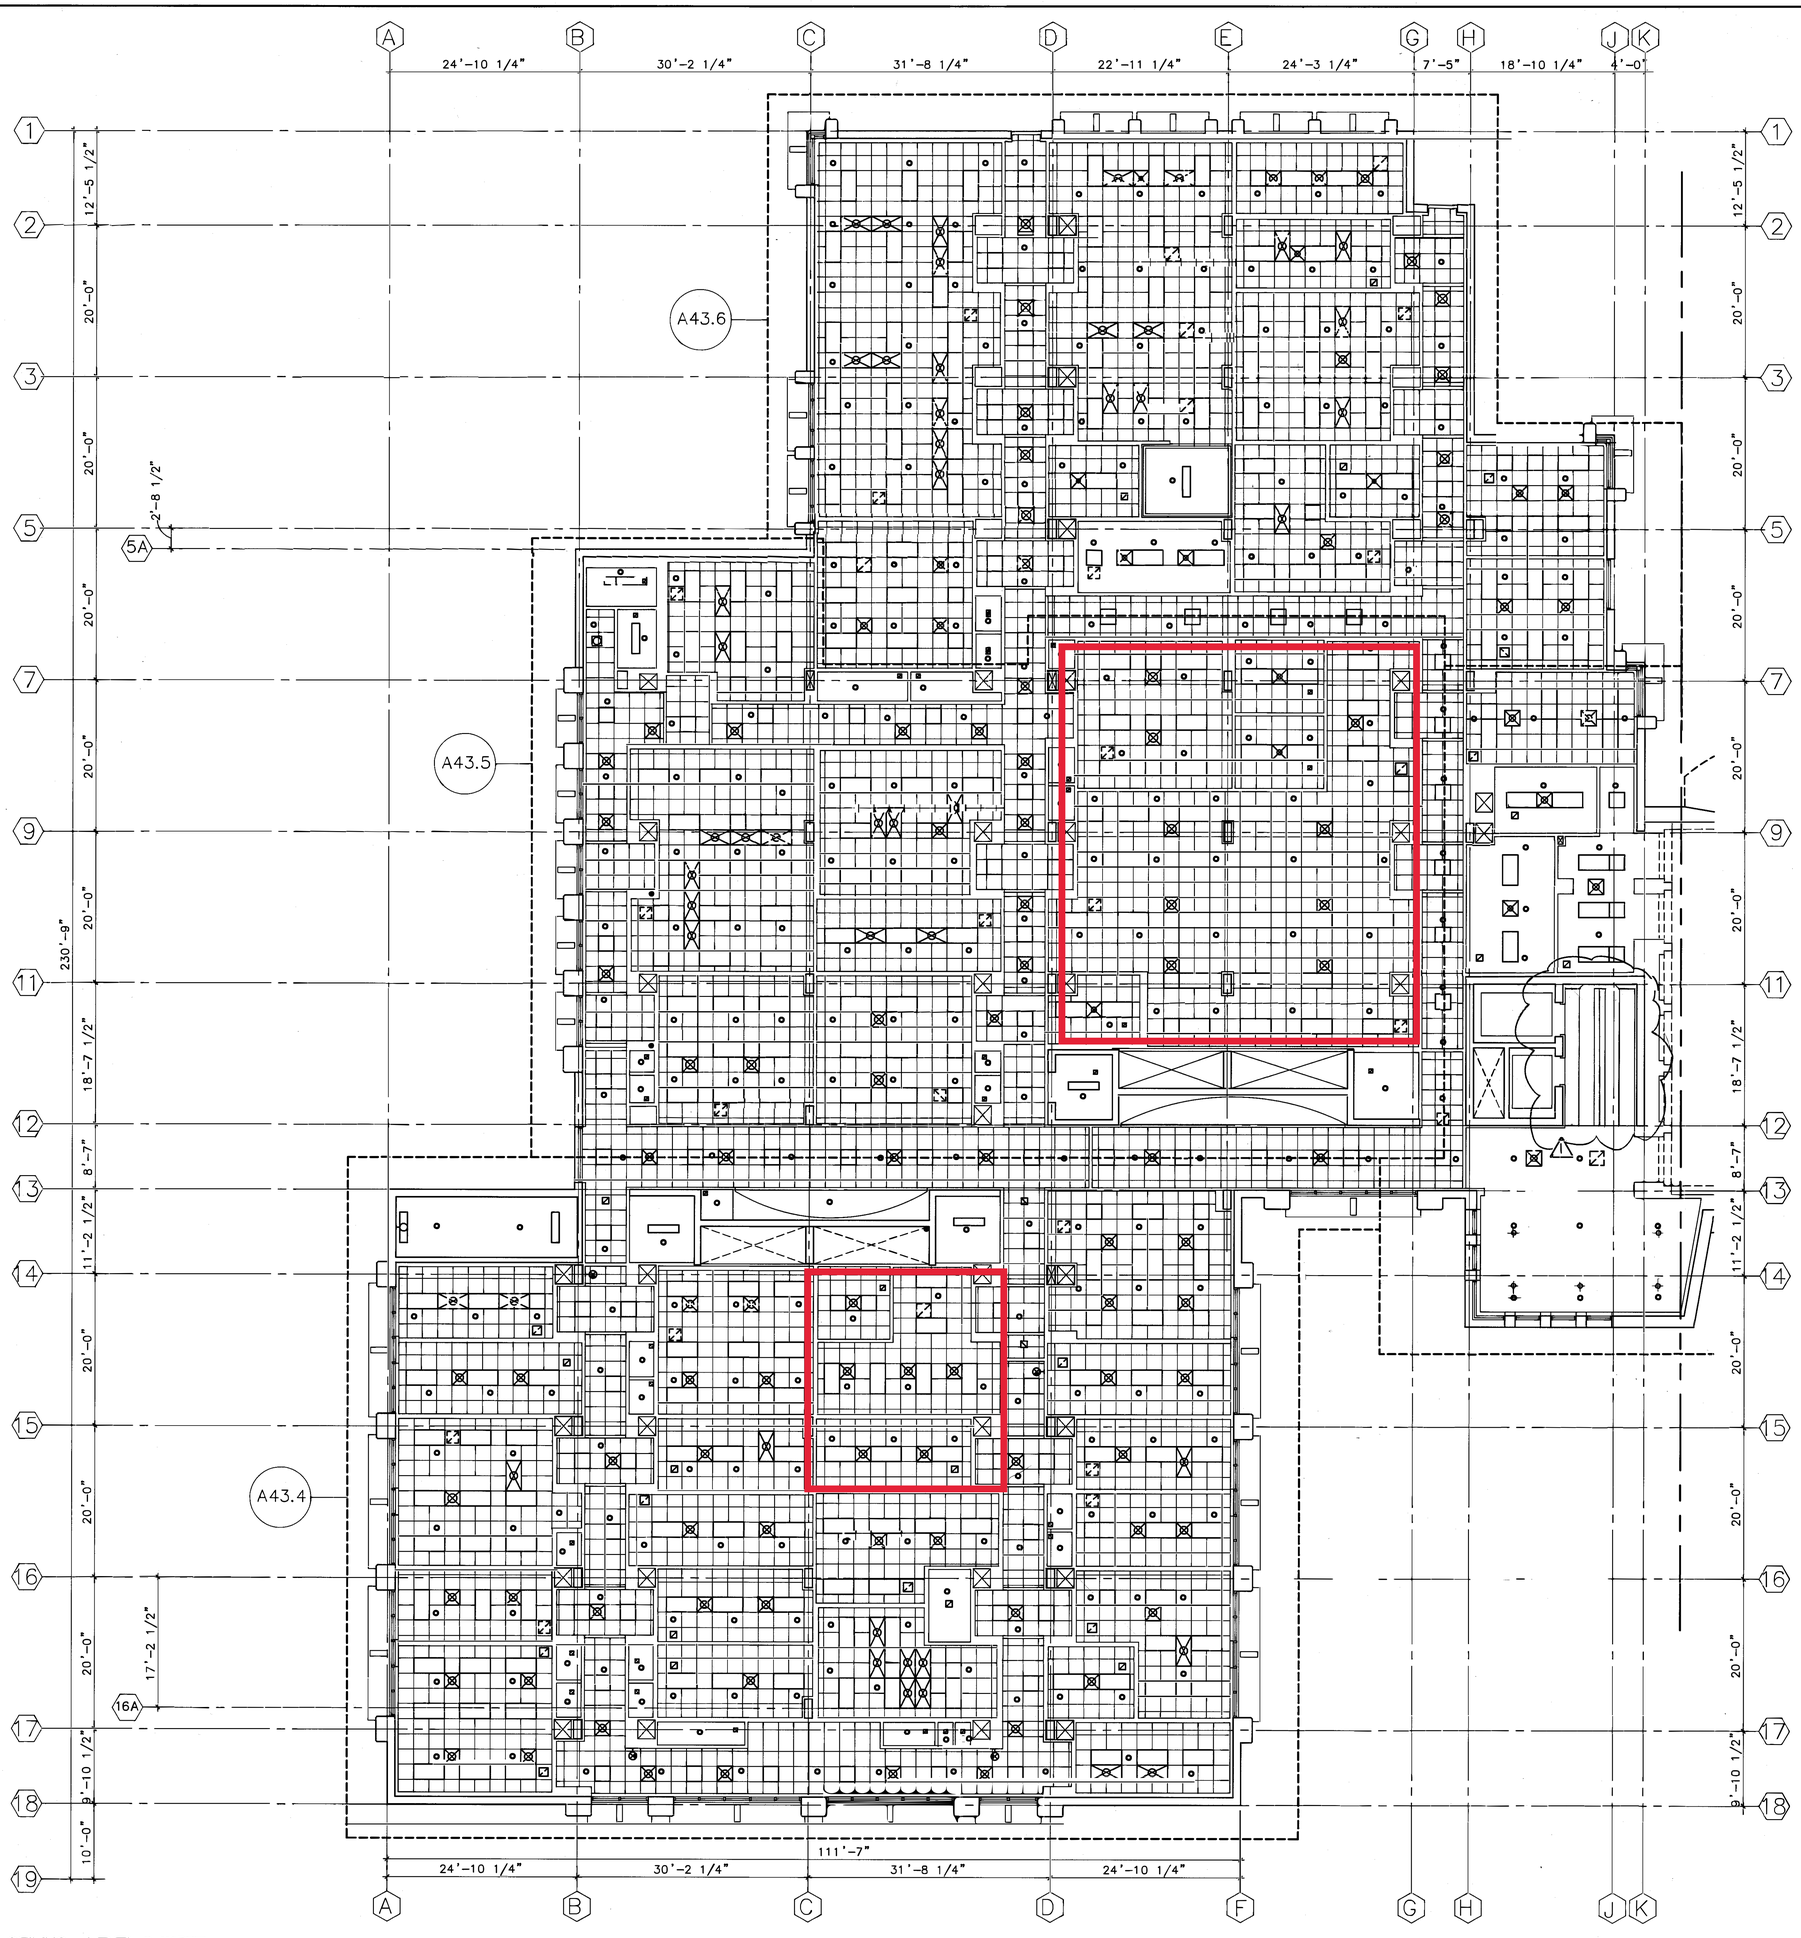

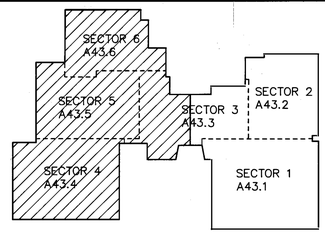

KEY PLAN TO: 1/4" = 1'-0" DRAWINGS
LEVEL 3



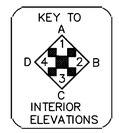

0 4 8 16 32

GENERAL NOTES

THE CONTRACTOR SHALL BE RESPONSIBLE FOR COORDINATING THE WORK OF ALL TRADES ON THE JOB. EACH TRADE SHALL HOWEVER, REVIEW AND COORDINATE THE CONTRACT PLANS AND SPECIFICATIONS AS NECESSARY WITH THE OTHER TRADES TO COMPLETE THE WORK AS INTENDED BY THE FINAL CONSTRUCTION DOCUMENTS.

SHOULD ANY DISCREPANCY IN THE PLANS OR SPECIFICATIONS BE DISCOVERED, THE GENERAL CONTRACTOR SHALL IMMEDIATELY NOTIFY THE ADMINISTERING PARTY (IE DAGS INSPECTION BRANCH, ARCHITECT) BEFORE PROCEEDING WITH ANY FURTHER WORK. OTHERWISE, THE GENERAL CONTRACTOR AS WELL AS THE SUBCONTRACTOR WILL BE HELD RESPONSIBLE FOR ANY COST INVOLVED IN CORRECTION OF WORK PLACED DUE TO SUCH DISCREPANCY.

REFER TO SHT A622

REVISION NO.	SYM.	DESCRIPTION	SHT. OF	DATE	APPROVED: STATE PUBLIC WORKS ENGINEER
RD1	1	ADDENDA INCORPORATION DRAWING CLARIFICATION	116 279	10AUG92	

DEPT. OF ACCOUNTING & GENERAL SERVICES
DIVISION OF PUBLIC WORKS
STATE OF HAWAII

HAWAII STATE DEPARTMENT OF HEALTH
LABORATORY FACILITY
HONOLULU, HAWAII

REFLECTED CEILING PLAN
LEVEL 3 – WEST

JAMES K. TSUGAWA AIA & ASSOC.

DESIGNED BY:	CHECKED BY:	DAGS JOB NO.	DRAWING NO.
DRAWN BY:	APPROVED BY:	12-20-2561	A63.2
SCALE: 1/8" = 1'-0"	DATE: 30 MAR 92	SHEET 135 OF 455 SHTS	

JAMES K. TSUGAWA REGISTERED PROFESSIONAL ARCHITECT No. 5094 HAWAII, U.S.A.

A 63.2 REFLECTED CEILING - LEVEL 3, WEST
SCALE: 1/8" = 1'-0"